

## WEST BAY CROSSING

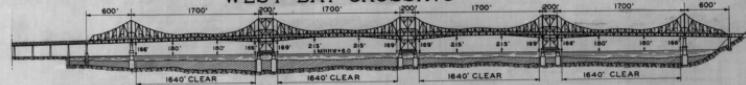


FIGURE "A"

## EAST BAY CROSSING

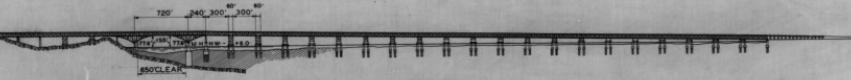


FIGURE "K"



FIGURE "B"

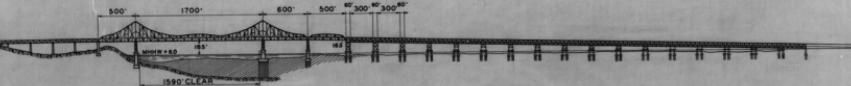


FIGURE "L"



FIGURE "C"

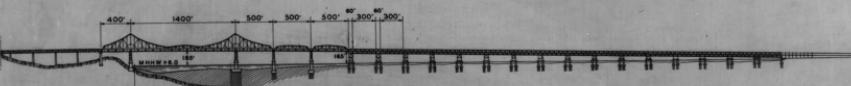


FIGURE "M"



FIGURE "D"

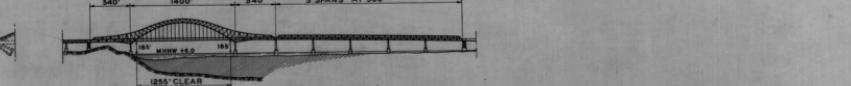


FIGURE "N"



FIGURE "E"

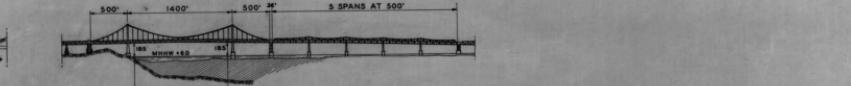


FIGURE "O"

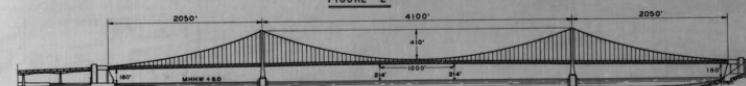


FIGURE "F"

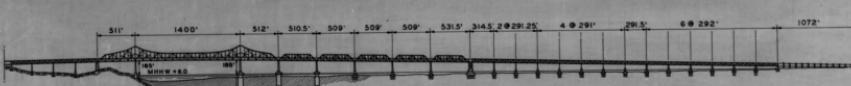


FIGURE "P"

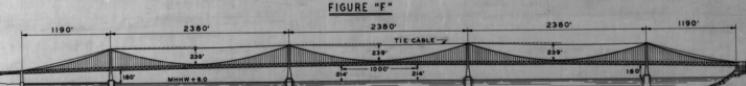


FIGURE "G"

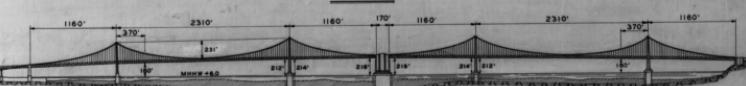


FIGURE "H"

**MICROFILMED**

STATE OF CALIFORNIA  
DEPARTMENT OF PUBLIC WORKS  
SAN FRANCISCO-OAKLAND BAY BRIDGE

PRELIMINARY LAYOUT STUDIES

SCALE IN FEET  
0 300 600 900 1200 1500 1800 2100 2400 2700

## SAN FRANCISCO



## PLAN DATA


PLAN DIMENSIONS OF CAISSON	164'-6" x 108'-0"	28' x 104'-3"	28' x 104'-6"	56' x 112'	52' x 121' 4"	74' 6" x 127' 0"	197' 0" x 92' 0"	157' 0" x 127' 0"	174' 6" x 127' 0"	156' 6" x 101' 9"
TYPE OF CAISSON	COFFERDAM	COFFERDAM	COFFERDAM	COFFERDAM	DOME	DOME	DOME	DOME	DOME	DOME
NUMBER OF CAISSONS					4 x 7 = 28	5 x 11 = 55	3 x 7 = 21	4 x 7 = 28		
SIZES OF WELLS					4 x 7 = 28	5 x 11 = 55	3 x 7 = 21	4 x 7 = 28		
AREA OF CAISSON - IN SQUARE FEET	19000	2919	2931	6272	6309	9452	18142	7239	8662	15648
AREA OF WELLS - IN SQUARE FEET					4938	18142	9452	7239	8662	15648
CONCRETE AREA - PER CENT OF TOTAL					100	42.8	42.3	54.3	50.1	42.8
CONCRETE C.Y.D.S. PER VERTICAL FOOT						4.0	3.6	4.2	3.6	4.0
PERIMETER OF CAISSON						4.0	3.6	4.2	3.6	4.0
PLAN DIMENSIONS OF FENDER						109'9" x 189'3"	236'3" x 141'3"	96'3" x 186'3"	103'9" x 186'3"	


## LOADING DATA


DEAD LOAD	IN TONS	1380	3920	3920	8130	22750	22700	440	22700	22750
LIVE LOAD	IN TONS	3670				4790	5690	220	8020	8020
TOWER LOAD	IN TONS					4790	5690	220	8020	8020
PILER SHAFT	IN TONS	133190	3065	3065	42990	4700	3000	93300	3000	3000
CAISSON	IN TONS					50240	125000	232310	64050	105200
TOTAL	IN TONS	130900	6985	6985	51120	90470	163970	326270	102400	151500
BUOYANCY	IN TONS	10450	995	995	1400	88500	66100	144500	29300	51500
NET LOAD ON ROCK	IN TONS	120450	5990	5990	3920	7100	9100	21700	48760	92250
AVER LOAD ON ROCK-TONS PER SQ.FT.		6.3	2.0	2.0	6.7	11.4	10.3	12.2	10.9	9.75
MAX. LOAD ON ROCK-TONS PER SQ.FT.		10.4			9.4	21.5	41.0	51.3	22.0	27.2


## YERBA BUENA ISLAND


YERBA BUENA ISLAND	1400' CANTILEVER	EAST BAY CROSSING	KEY ROUTE FILL
VIADUCT	191' 0.00 MLLW	191'	191' 0.00 MLLW
Y.B. Y.B. Y.B. E E	1400' CAISSON	504' SPANS	288' SPANS
Y.B. Y.B. Y.B. E E	CAISSON E.3 512' E.4 510'-6" E.5 509'	Y.B. Y.B. Y.B. E E	Y.B. Y.B. Y.B. E E
Y.B. Y.B. Y.B. E E	508'-6" 1400' CAISSON E.6 509' 7 509' 8 506'-6" 9 289' 10 292' 11 292' 12 291' 13 291' 14 291' 15 291' 16 291' 17 291' 18 292' 19 292' 20 292' 21 292' 22 292' 23 292' 24 292' 25 292' 26 292' 27 292' 28 292' 29 292' 30 292' 31 292' 32 292' 33 292' 34 292' 35 292' 36 292' 37 292' 38 292' 39 292' 40 292' 41 292' 42 292' 43 292' 44 292' 45 292' 46 292' 47 292' 48 292' 49 292' 50 292' 51 292' 52 292' 53 292' 54 292' 55 292' 56 292' 57 292' 58 292' 59 292' 60 292' 61 292' 62 292' 63 292' 64 292' 65 292' 66 292' 67 292' 68 292' 69 292' 70 292' 71 292' 72 292' 73 292' 74 292' 75 292' 76 292' 77 292' 78 292' 79 292' 80 292' 81 292' 82 292' 83 292' 84 292' 85 292' 86 292' 87 292' 88 292' 89 292' 90 292' 91 292' 92 292' 93 292' 94 292' 95 292' 96 292' 97 292' 98 292' 99 292' 100 292' 101 292' 102 292' 103 292' 104 292' 105 292' 106 292' 107 292' 108 292' 109 292' 110 292' 111 292' 112 292' 113 292' 114 292' 115 292' 116 292' 117 292' 118 292' 119 292' 120 292' 121 292' 122 292' 123 292' 124 292' 125 292' 126 292' 127 292' 128 292' 129 292' 130 292' 131 292' 132 292' 133 292' 134 292' 135 292' 136 292' 137 292' 138 292' 139 292' 140 292' 141 292' 142 292' 143 292' 144 292' 145 292' 146 292' 147 292' 148 292' 149 292' 150 292' 151 292' 152 292' 153 292' 154 292' 155 292' 156 292' 157 292' 158 292' 159 292' 160 292' **SECTION NEAR C OF BRIDGE**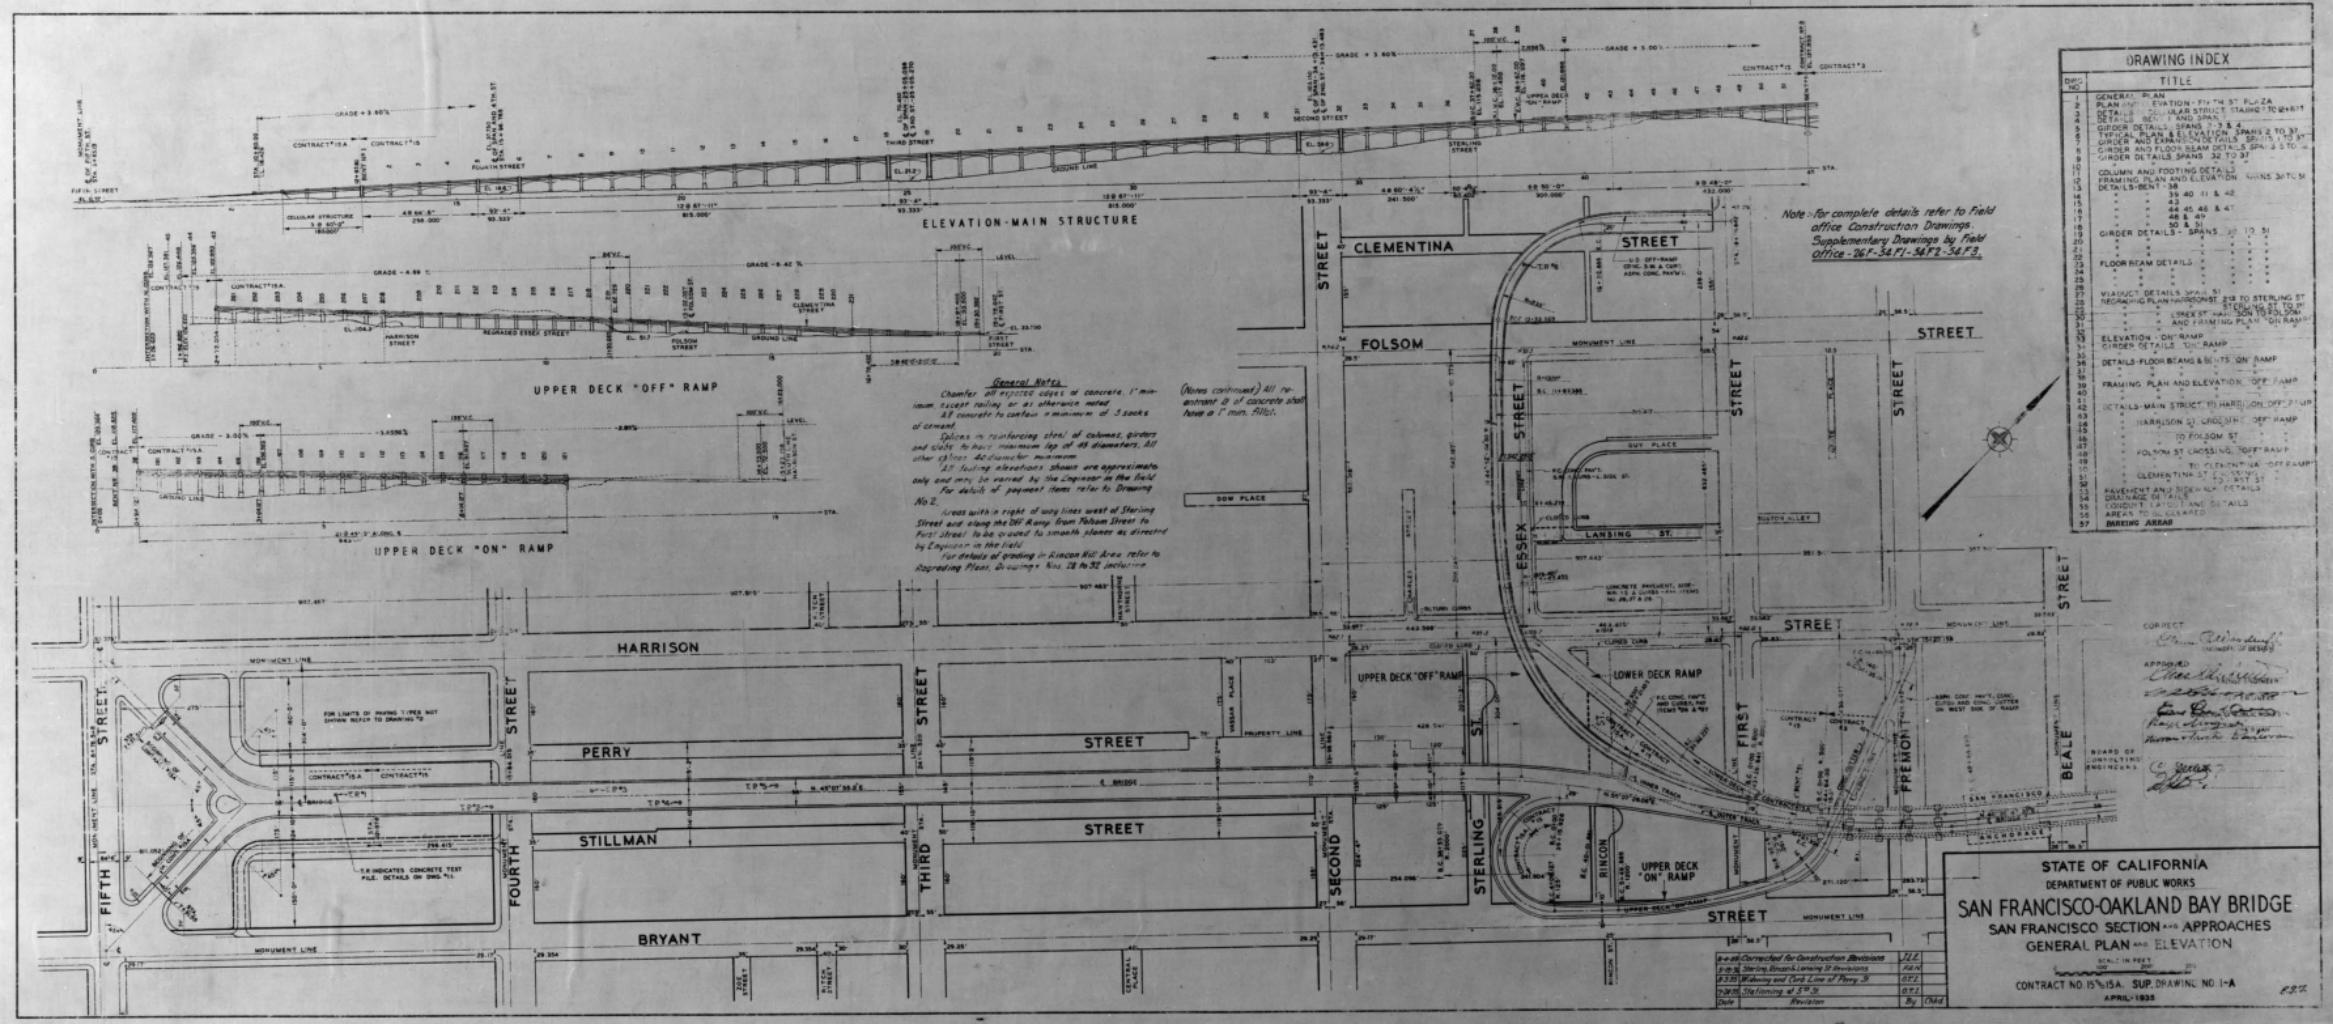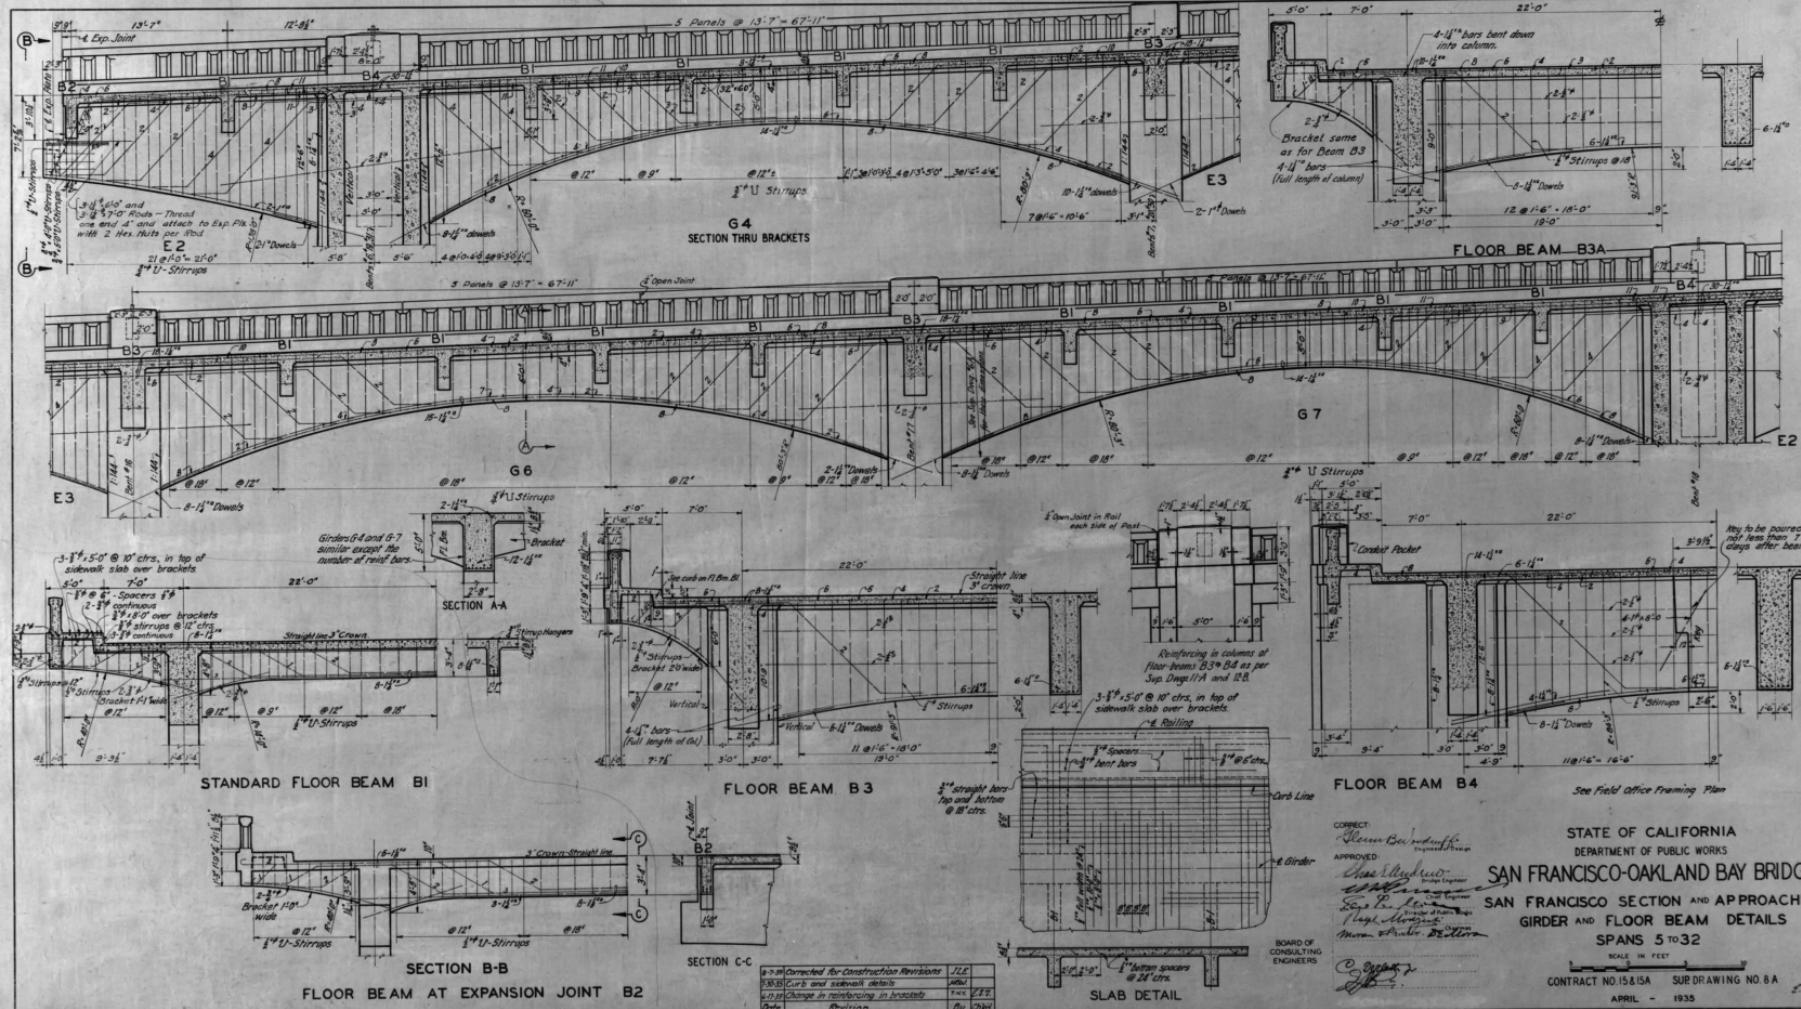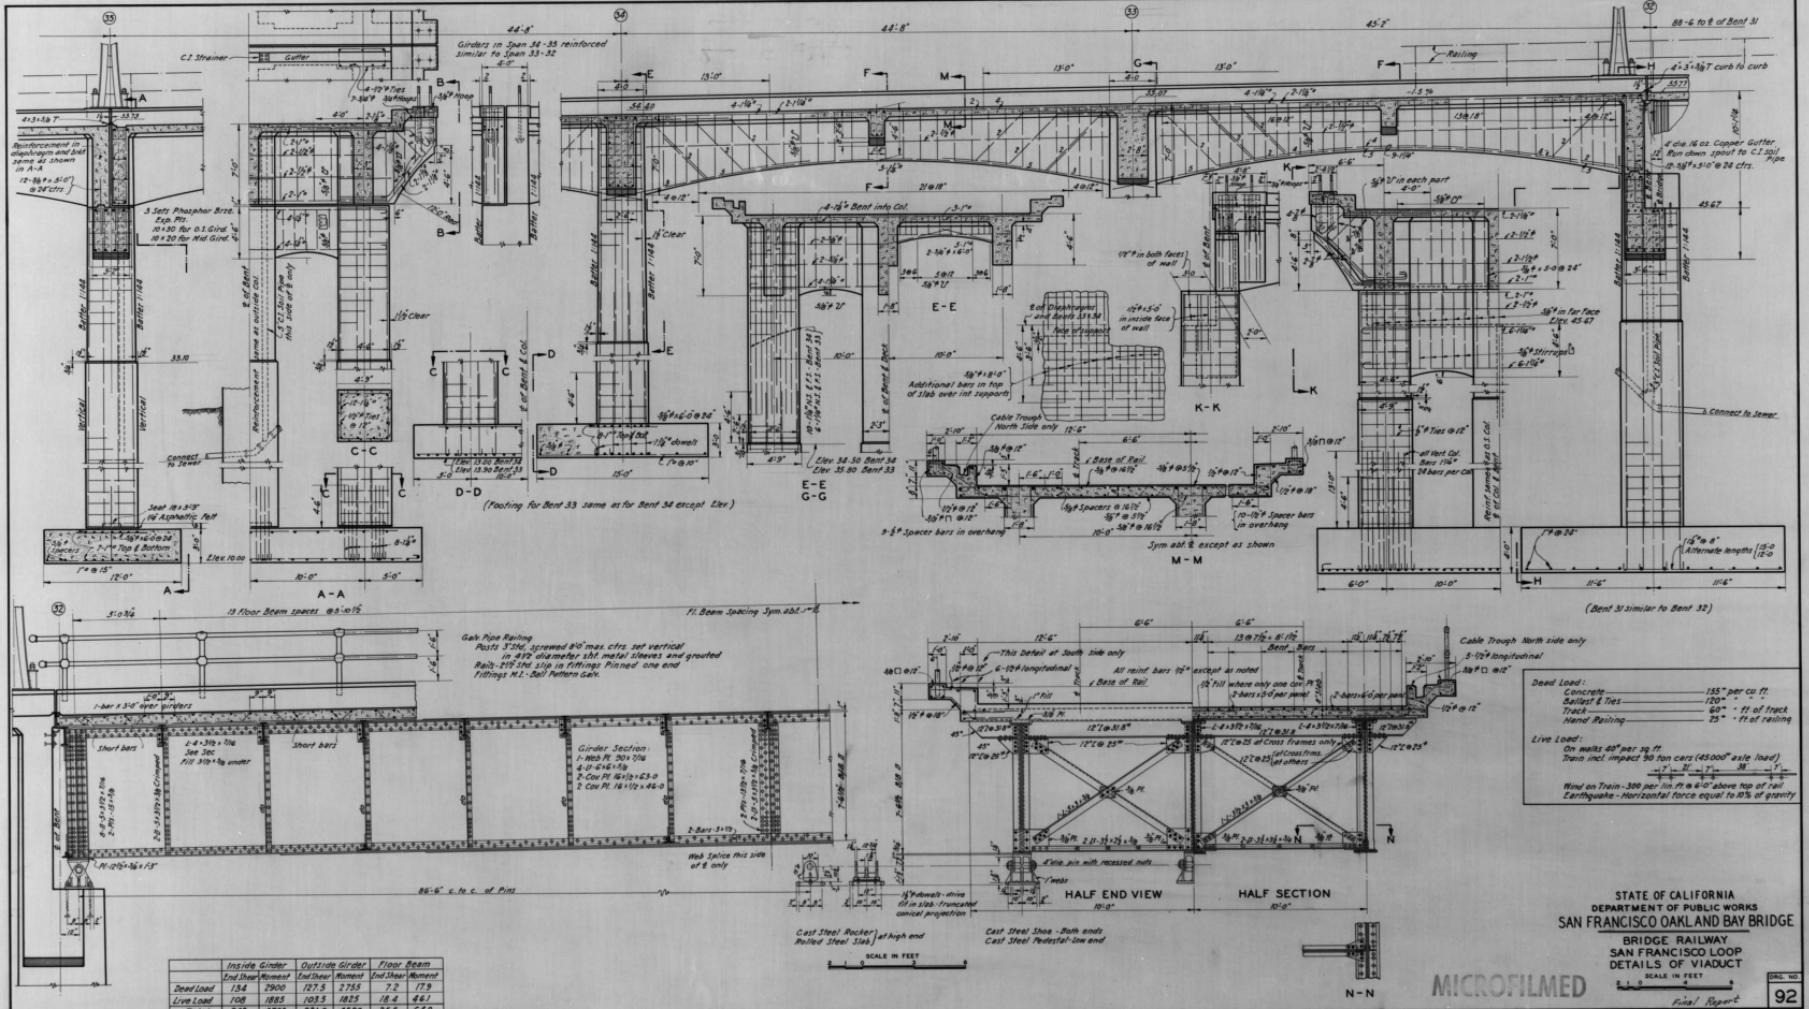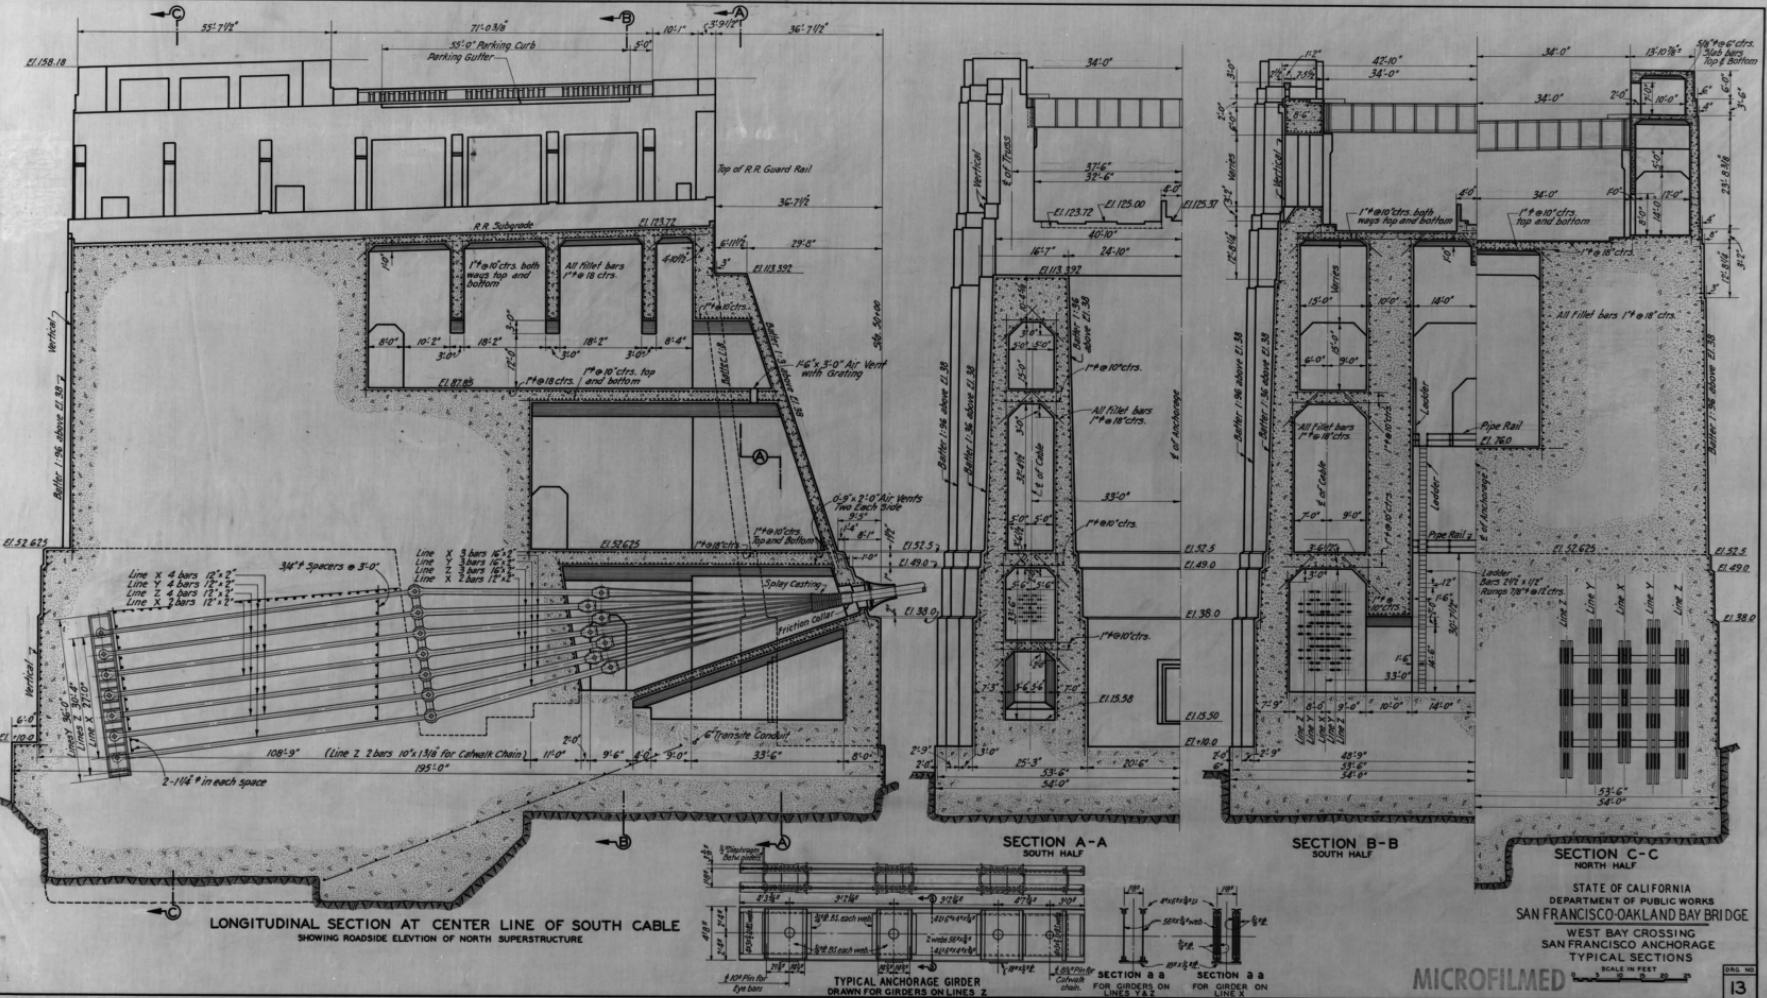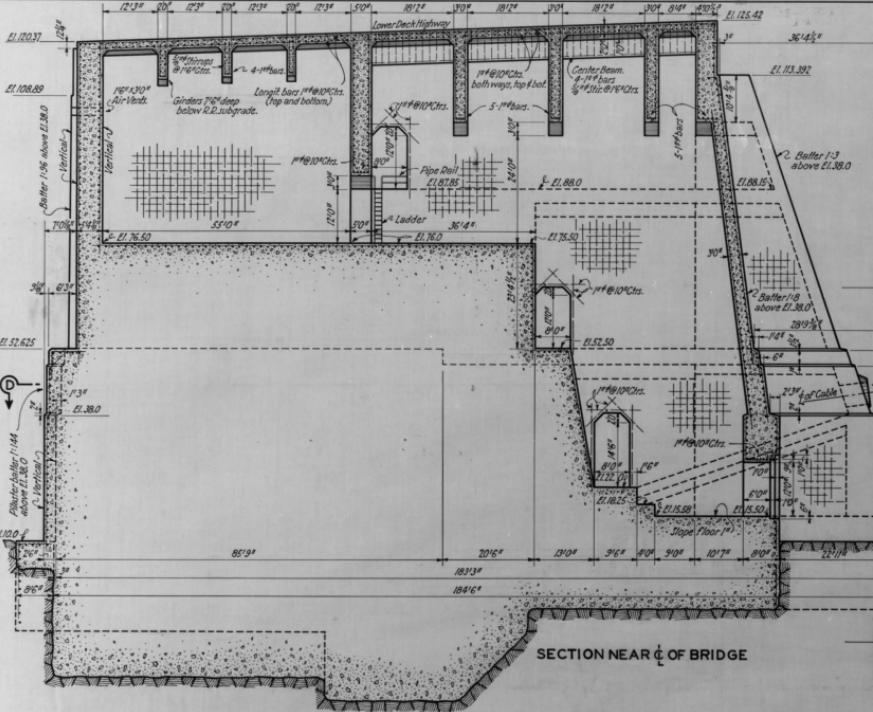

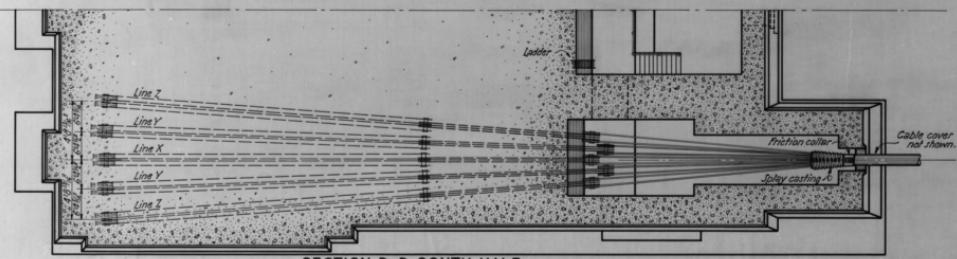

**SECTION D-D SOUTH HALF**

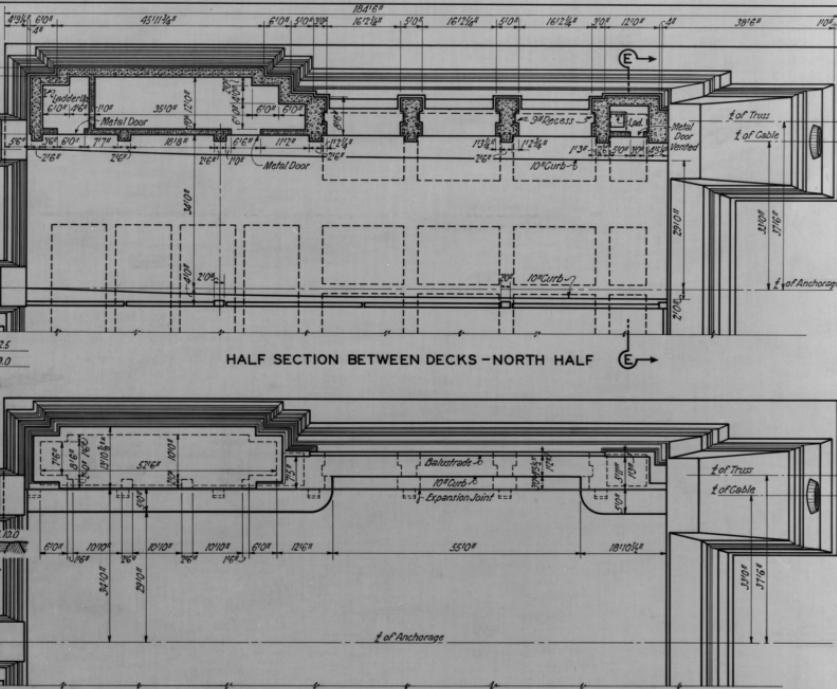


### HALF PLAN UPPER DECK

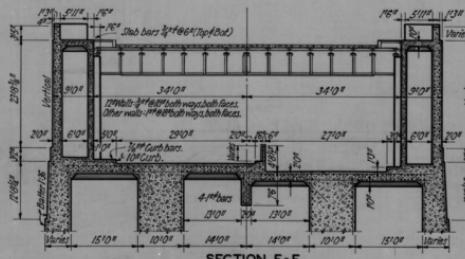


SECTION E-E


**MICROFILMED**  
STATE OF CALIFORNIA  
DEPARTMENT OF PUBLIC WORKS  
**SAN FRANCISCO-OAKLAND BAY BRIDGE**  
WEST BAY CROSSING  
SAN FRANCISCO ANCHORAGE  
TYPICAL SECTIONS

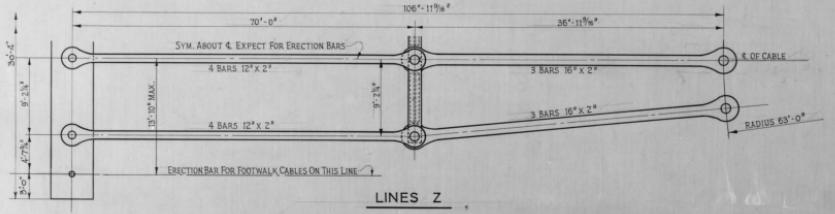


LINES Z

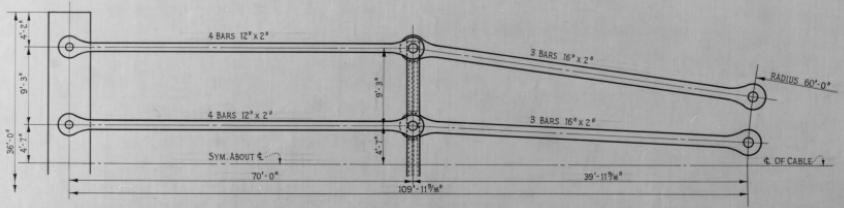


LINES Y

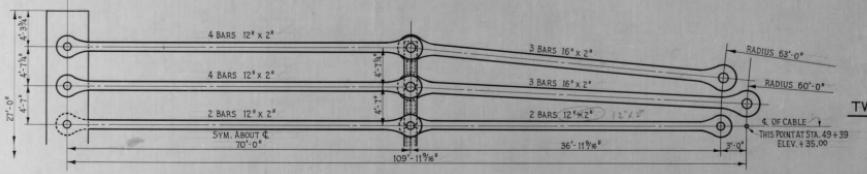

LINE X

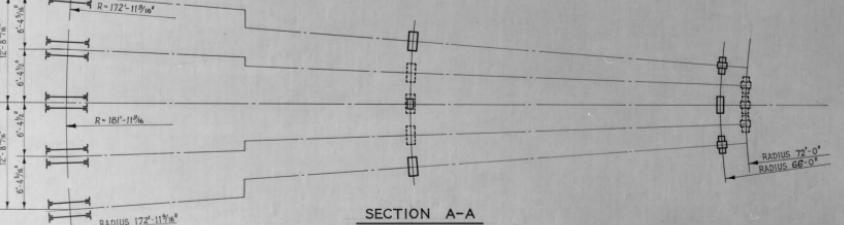

SECTION A-A


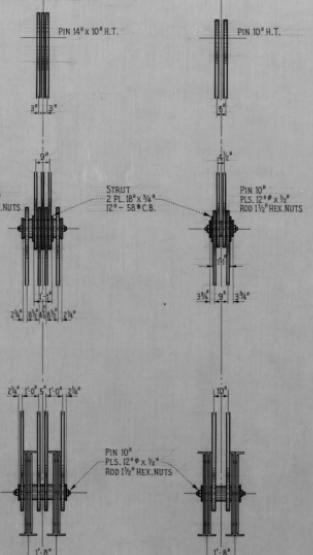


TWO STRAND CHAIN


ONE STRAND CHAIN

NOTE:  
ALL PINS CARBON STEEL EXCEPT AS  
NOTED. H (HEAT TREATED),  
EVE BANDS, OTHER MATERIAL  
CARBON STEEL.  
ALL PINS COUNTERBORED 2".

See A CO DRAWING NO. G-4870-7-E.

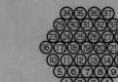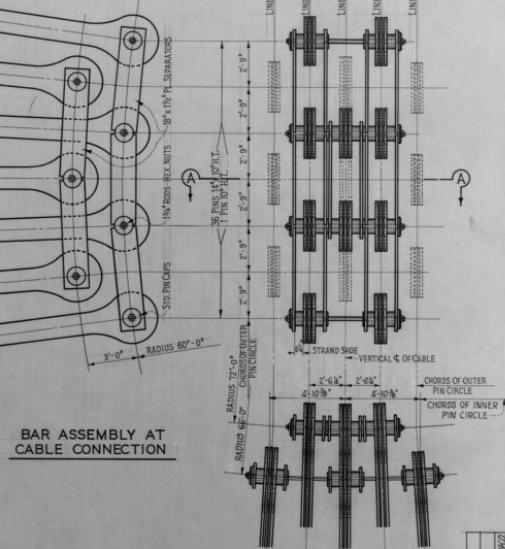


STRANDS IN CABLE

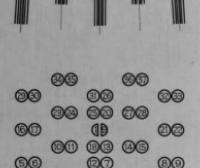



STRANDS IN ANCHORAGE


CORRECT: *Glenn Beale*  
APPROVED: *Glenn Beale*  
Director of Public Works  
State of California  
San Francisco-Oakland Bay Bridge  
San Francisco Anchorage  
Eye Bar Anchor Chain  
Board of Consulting Engineers  
*Frank M. Johnson*  
*Walter C. Miller*  
*C. C. Holt*


G-7-59 Corrected for Construction Drawing No. 4870-7-E  
1/1-7-30 Actual and dimensions changed 6/25  
Date 2/24/22

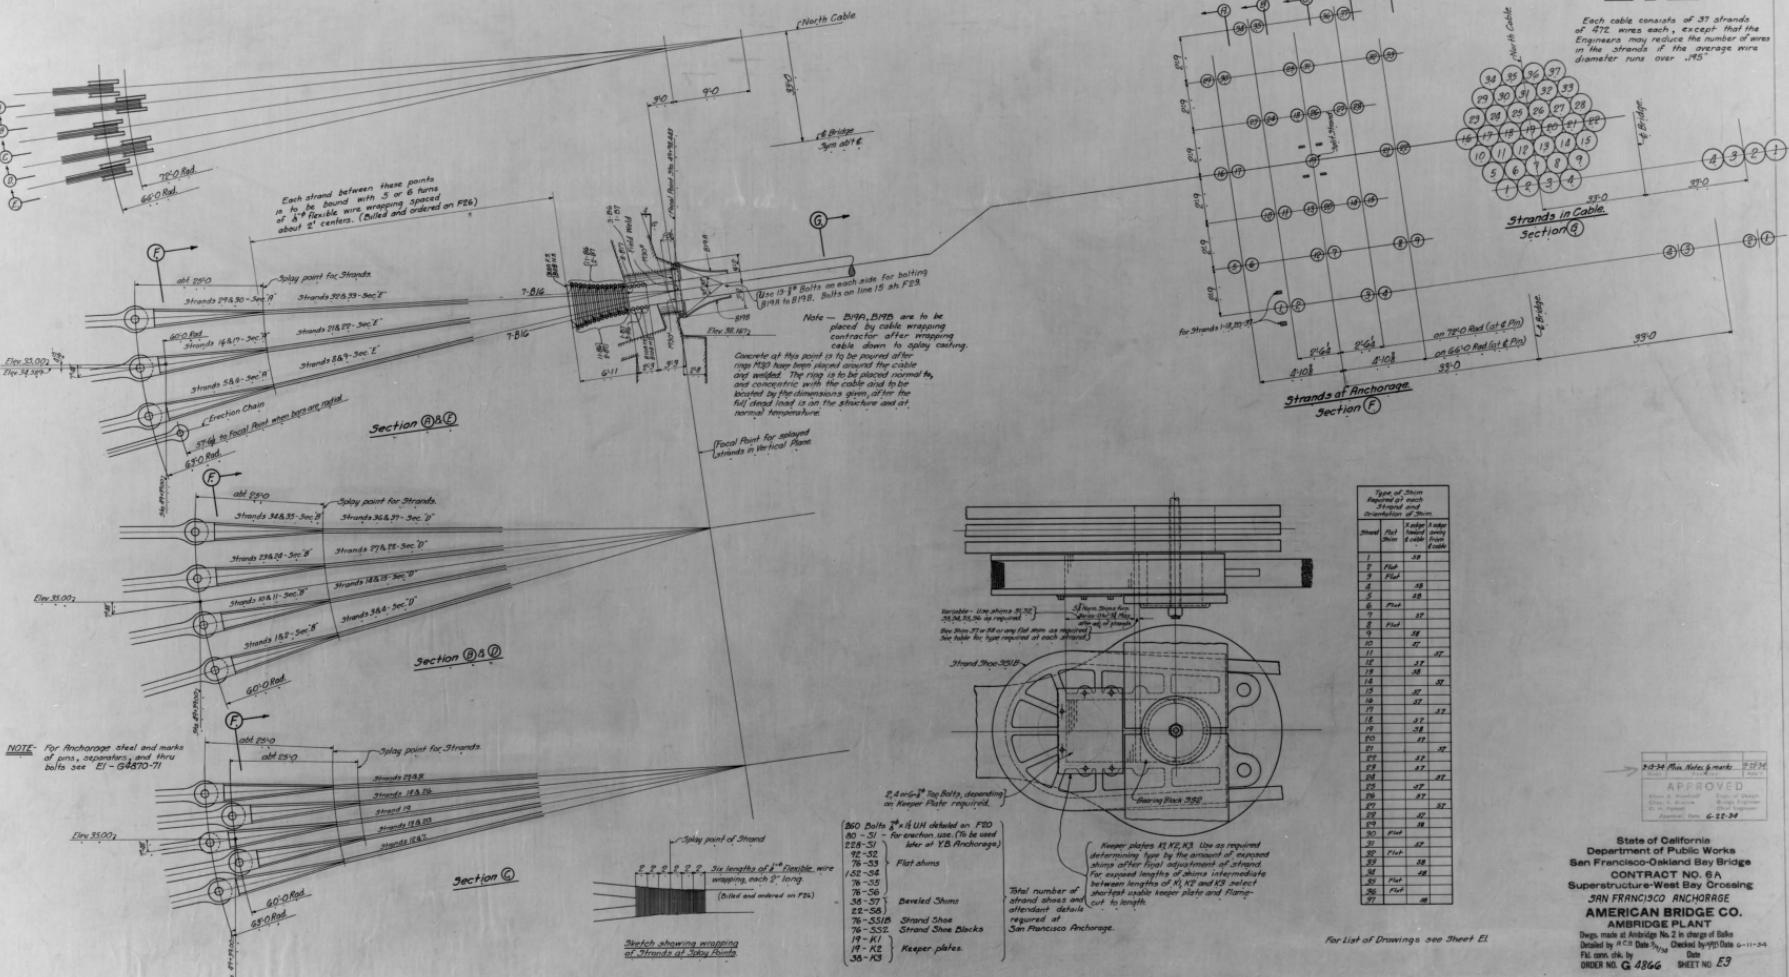


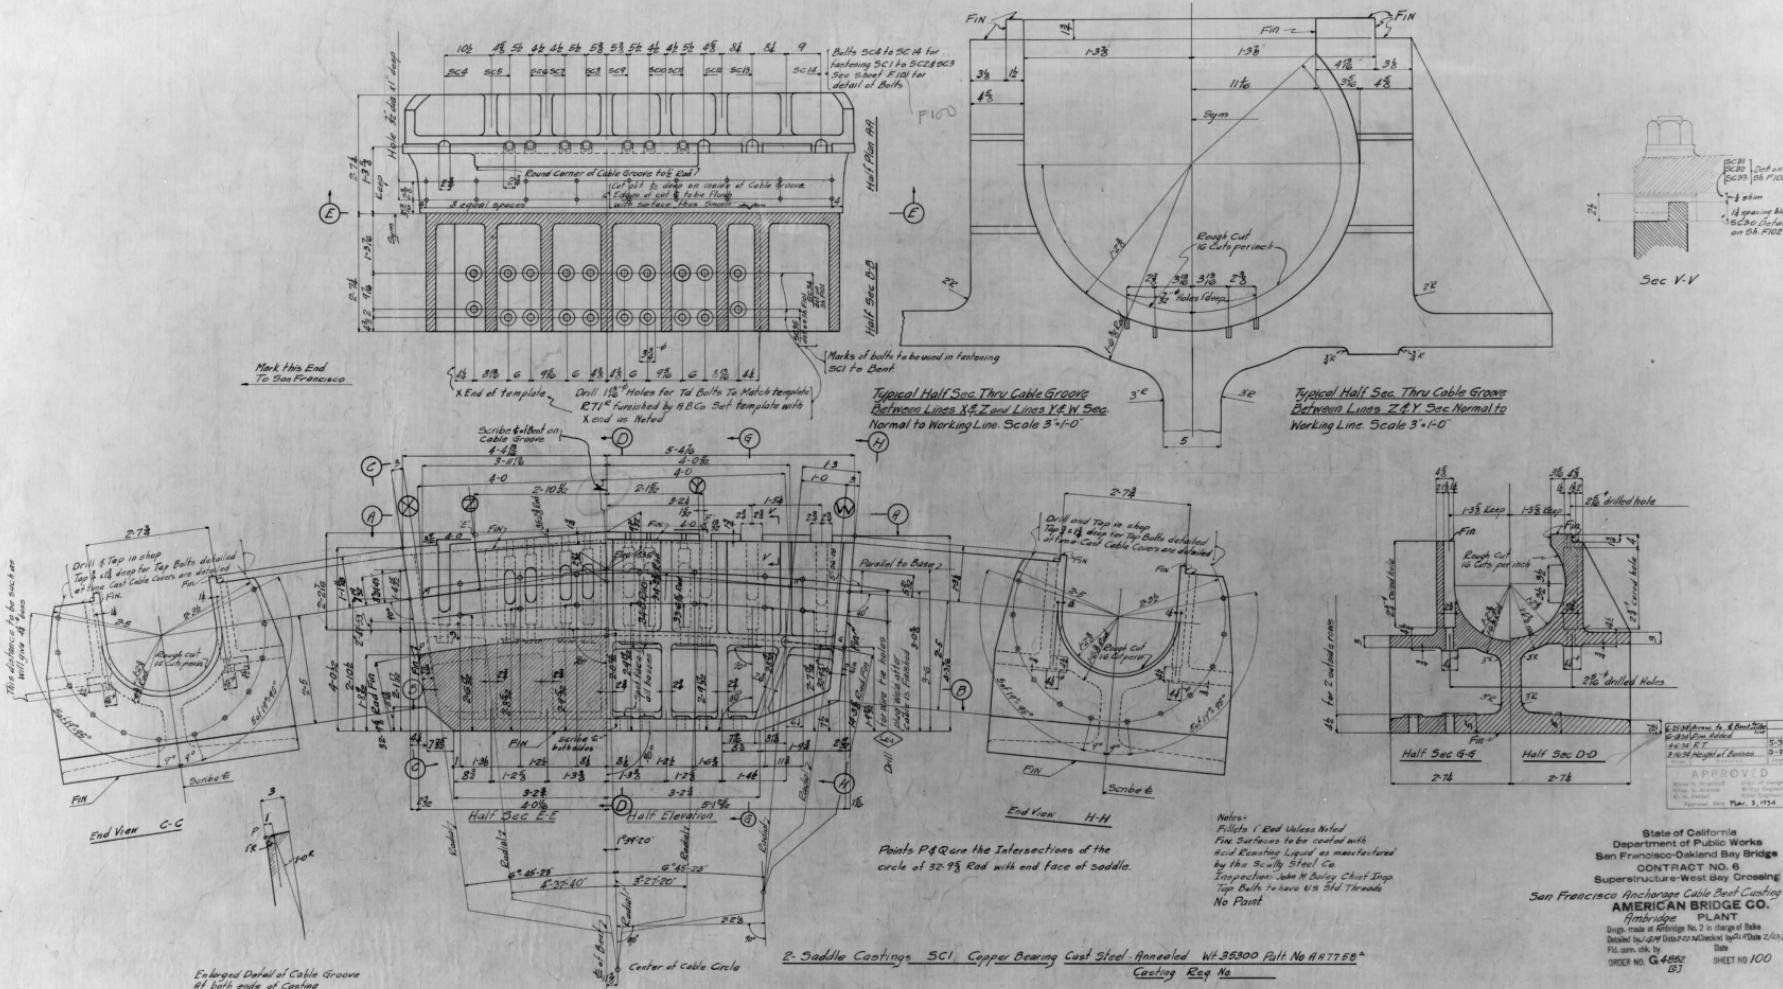

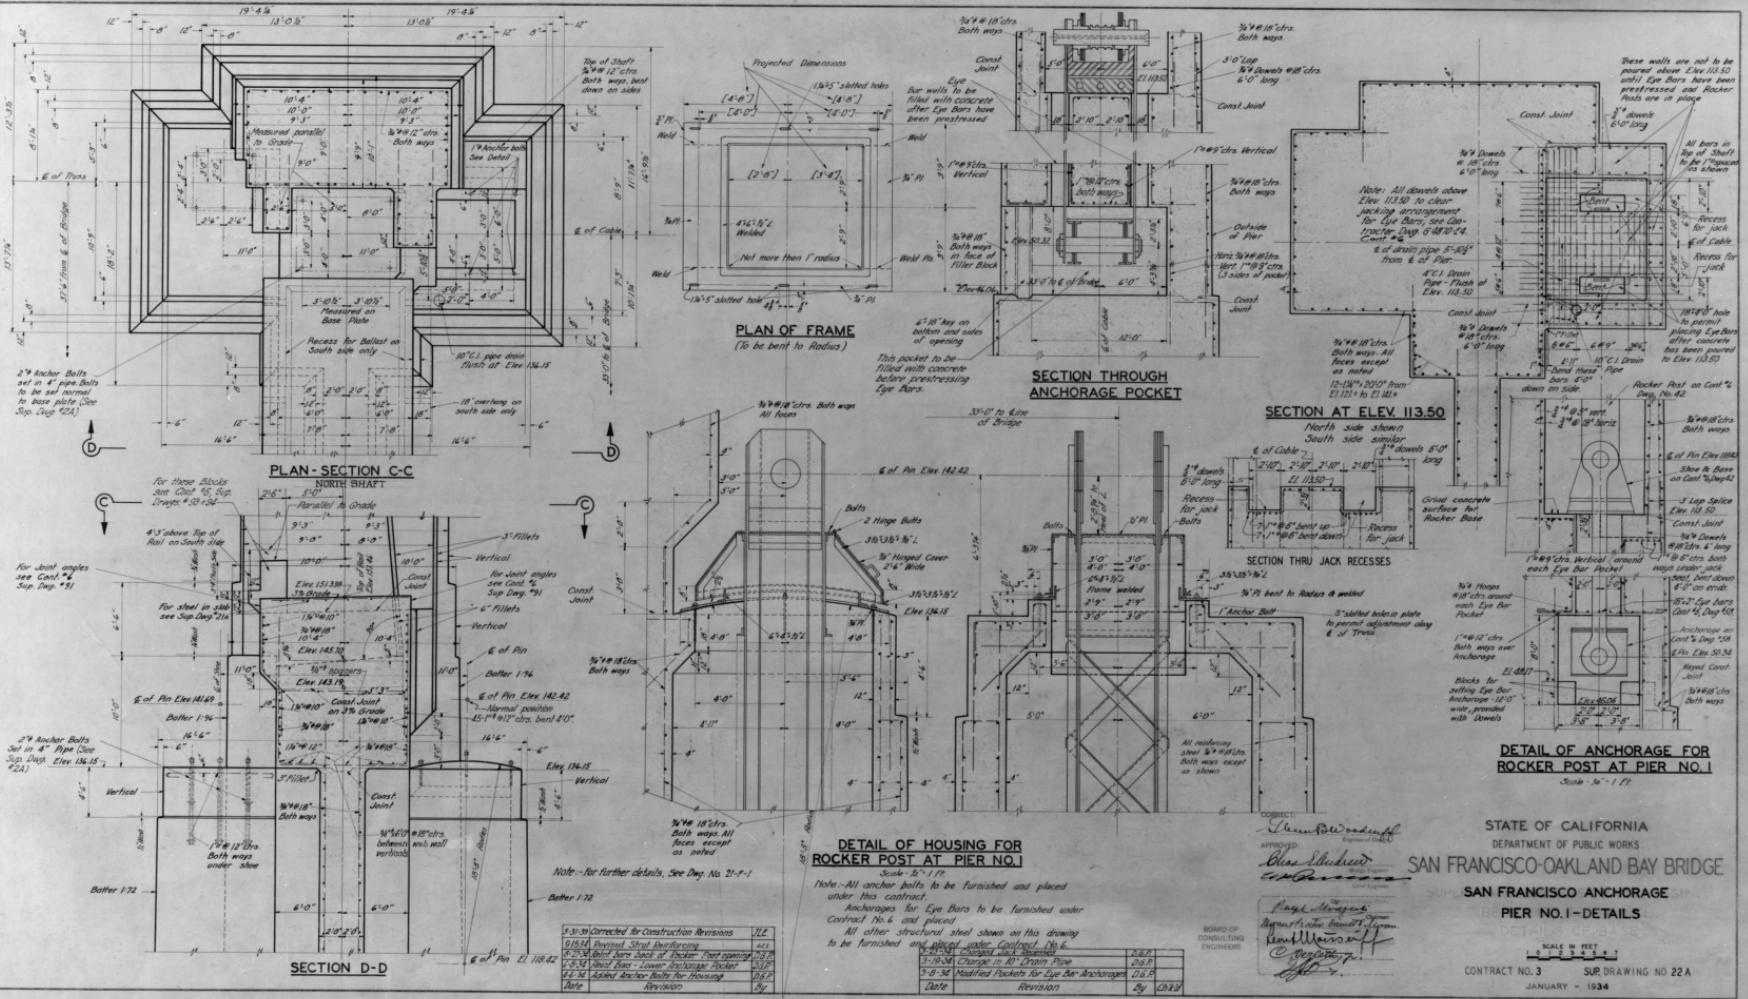


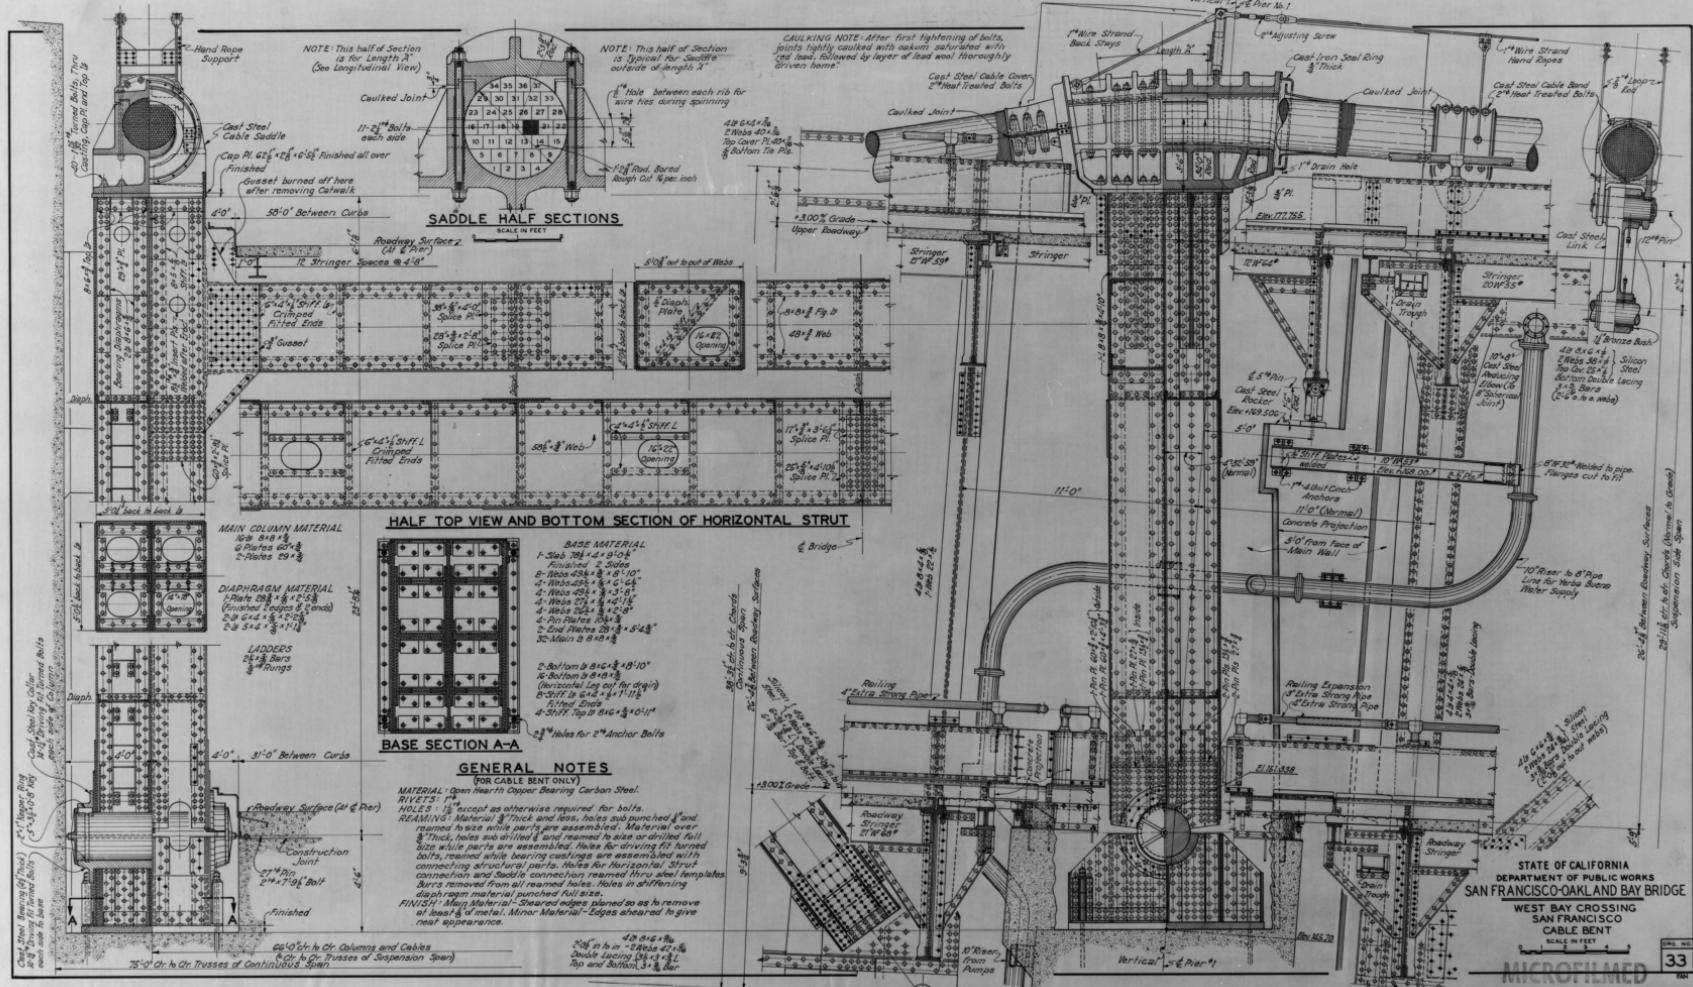


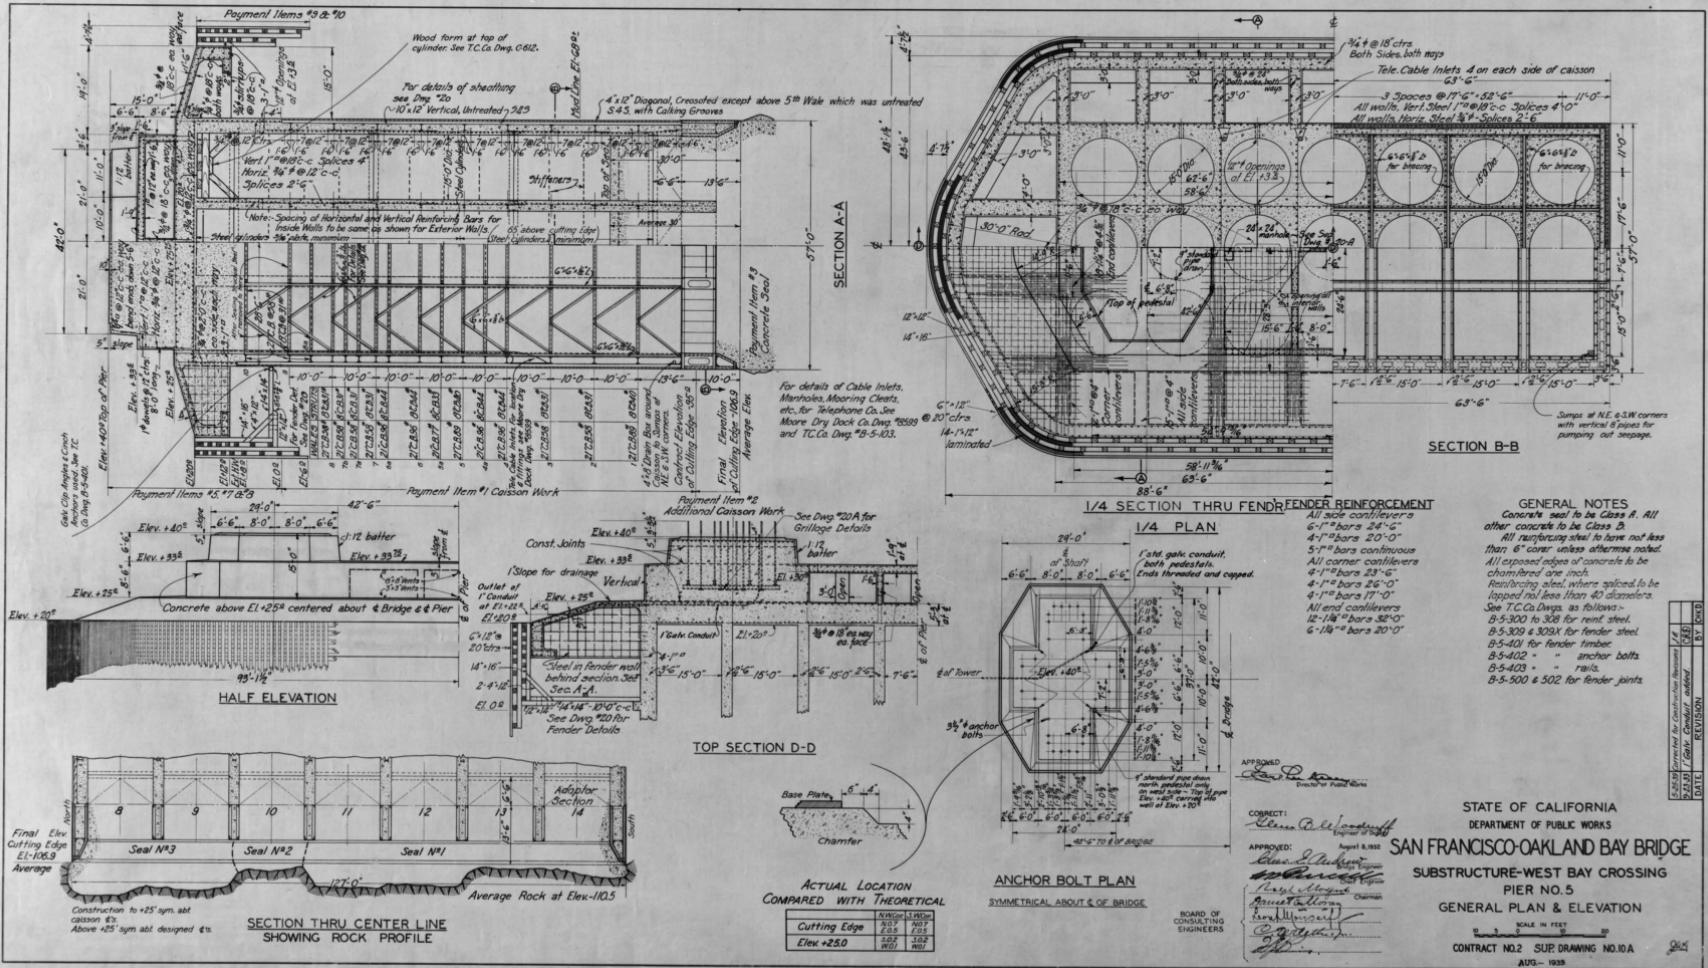


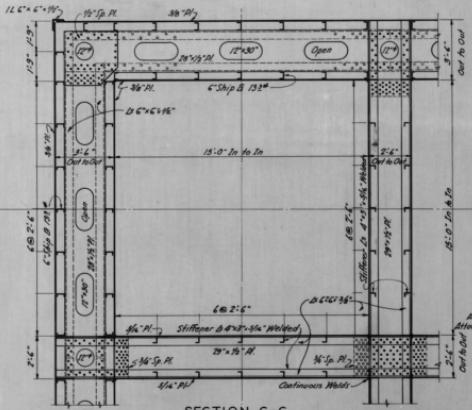


SECTION C-C

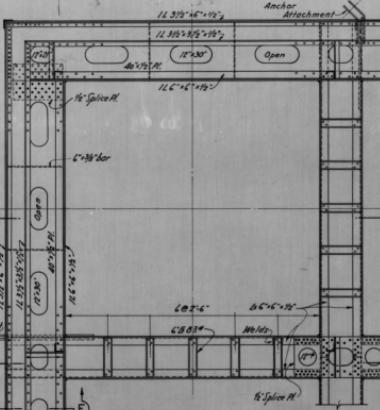


PLAN AT TOP OF CUTTING EDGE

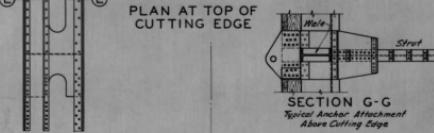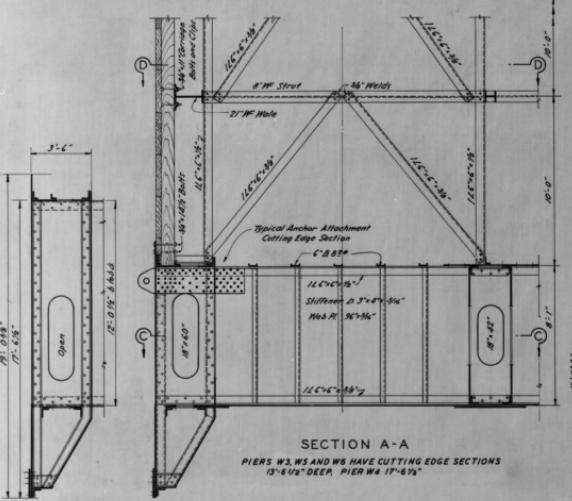SECTION G-G  
Typical Anchor Attachment  
Above Cutting Edge



SECTION A-A

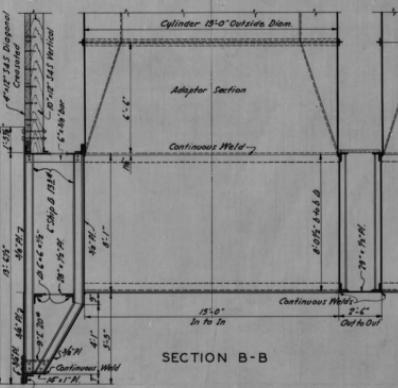PIERS W-3, W-5 AND W-6 HAVE CUTTING EDGE SECTIONS  
13'-6 1/2" DEEP. PIER W-4 17'-6 1/2"

SECTION B-B

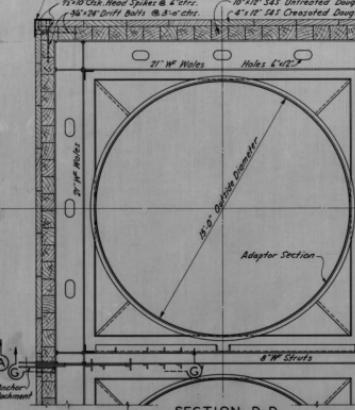

SECTION D-D

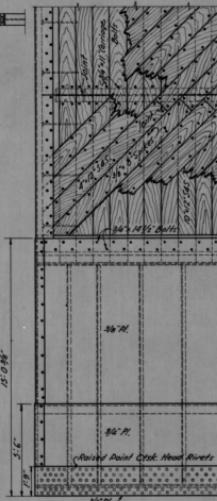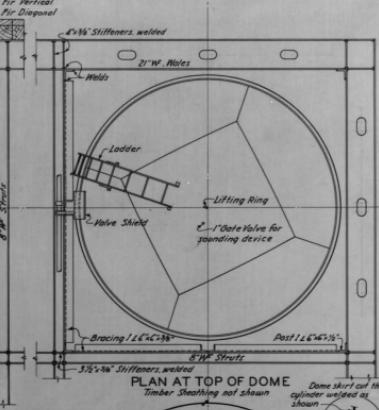PART SIDE ELEVATION  
AT CORNER


PLAN AT TOP OF DOME

Timber Sheathing not shown


STATE OF CALIFORNIA  
DEPARTMENT OF PUBLIC WORKS  
SAN FRANCISCO-OAKLAND BAY BRIDGE  
TYPICAL CAISSON DETAILS  
PIERS W-3, W-4, W-5, & W-6

MICROFILMED

SCALE IN FEET

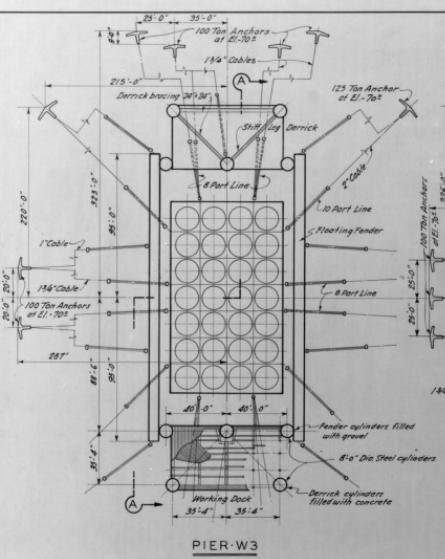


PIER-W3

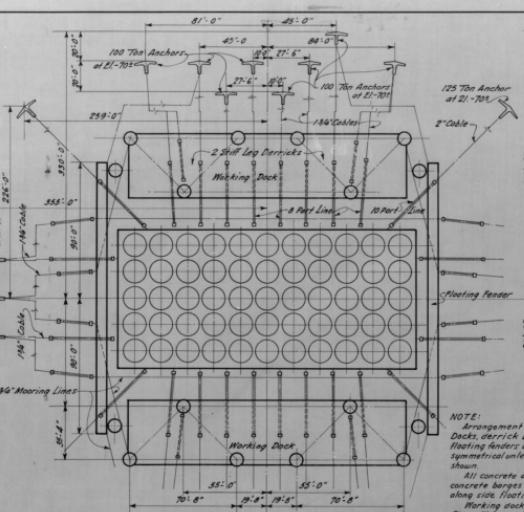


PIER-W4


**NOTE:**  
Arrangement of working  
Docks, derrick barges,  
floating fenders and anchors  
symmetrical unless otherwise  
shown.  
All concrete done from  
concrete barges moored  
along floating working piers.  
Working docks used for  
Piers W-3 and W-4. Floating  
equipment used for Piers  
W-5 and W-6.

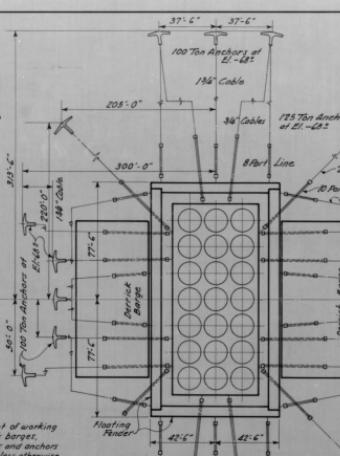


PIER-W5

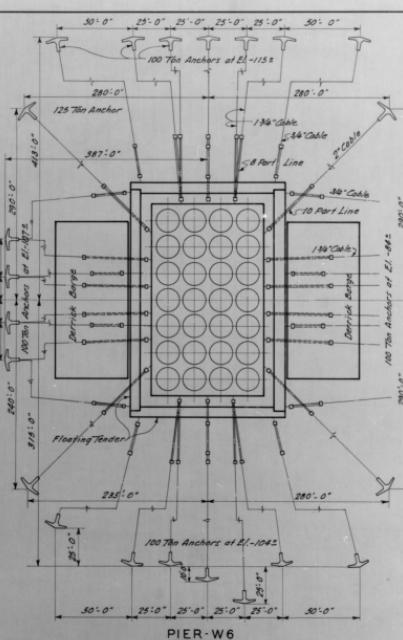


PIER-W

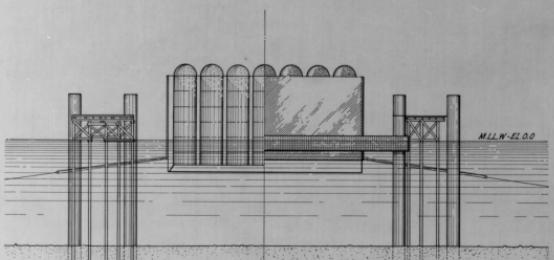


**SECTION A - A**

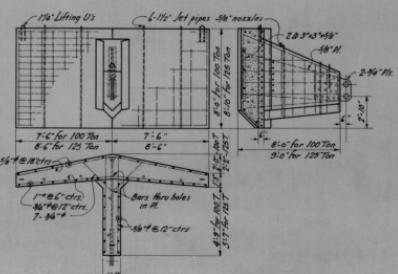

DETAILS OF CONCRETE ANCHOR  
DRAWN FOR 125 TON ANCHORAGE

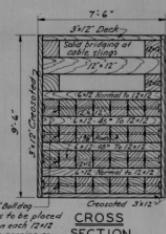

*Creosoted*  
CROSS  
SECTION

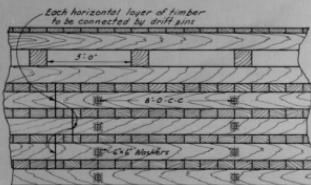



LONGITUDINAL SECTION

#### FENDER DETAILS


STATE OF CALIFORNIA  
DEPARTMENT OF PUBLIC WORKS  
SAN FRANCISCO-OAKLAND BAY BRIDGE  
WEST BAY CROSSING  
CAISSON ANCHORAGE



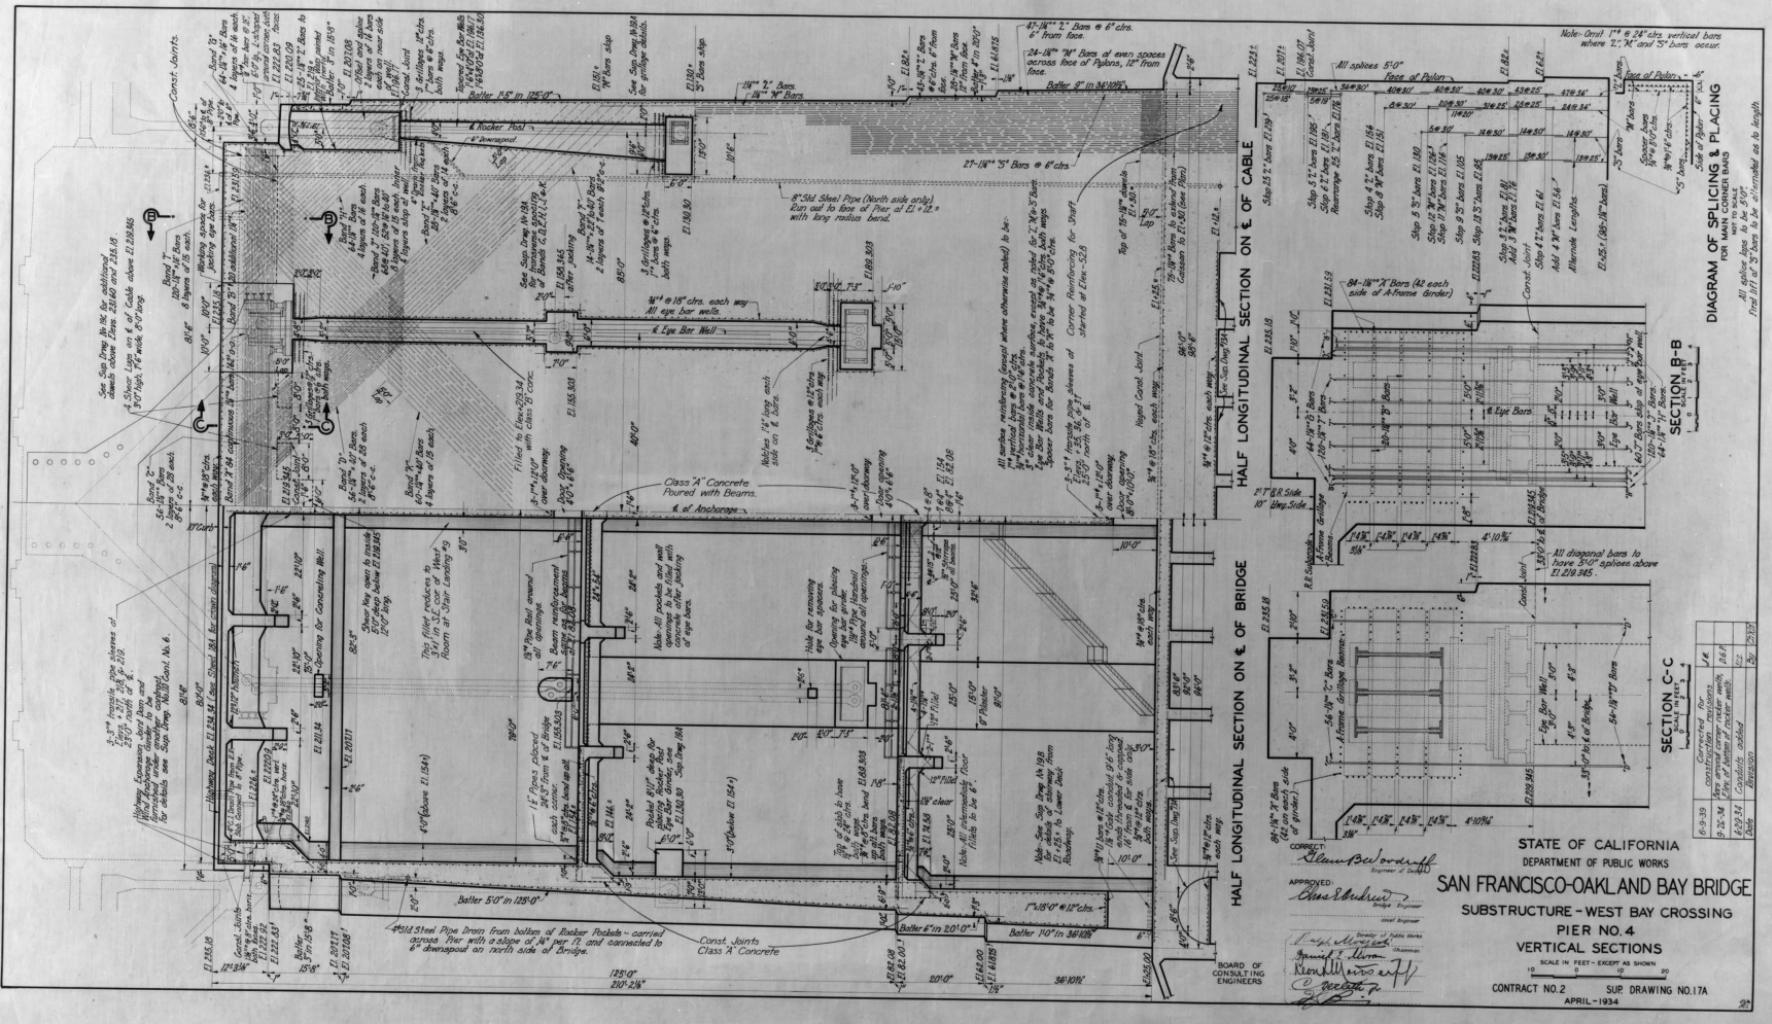


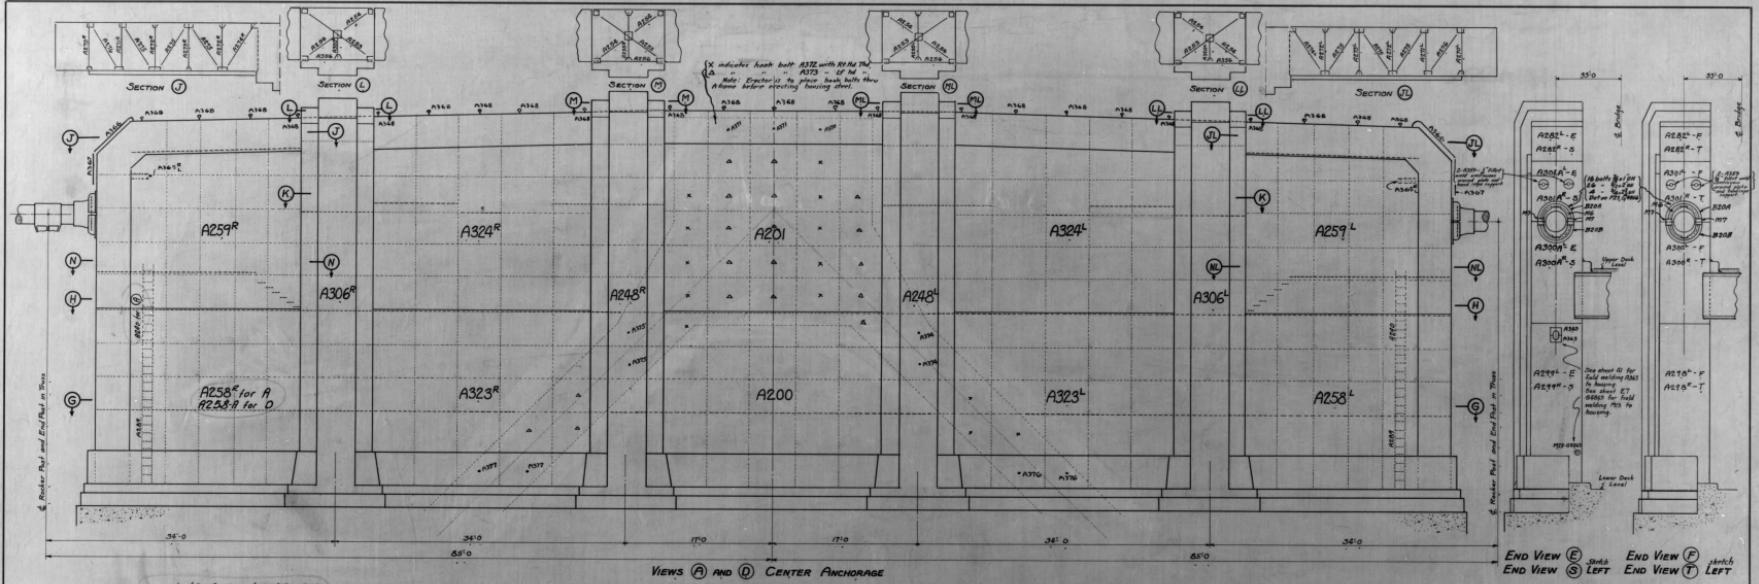


Views A and B CENTER ANCHORAGE

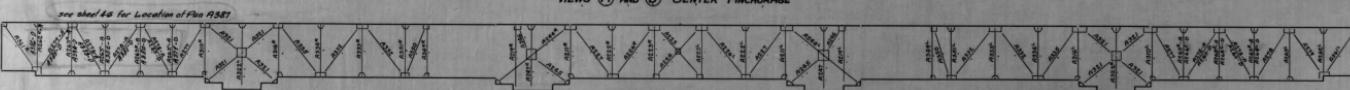

SECTION (G) for View A  
SECTION (G) for View D Same as for (A) except as noted for marks.

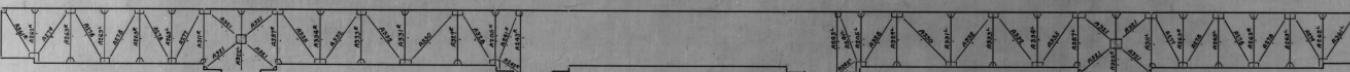

SECTION (H)

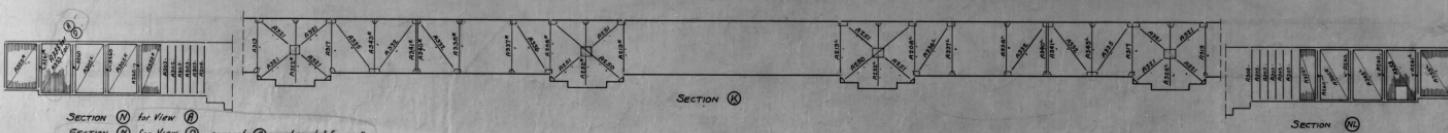


SECTION (N) for View (A)  
SECTION (N) for View (D) same as for (A) except as noted for marks

*Use sheets E7-E8-E9 together.*




State of California  
Department of Public Works  
San Francisco-Oakland Bay Bridge  
CONTRACT NO. 6  
Superstructure-West Bay Crossing  
*Outside Elevation of Housing*  
Center Anchorage - Pier No. 4  
AMERICAN BRIDGE CO.

**AMERICAN BRIDGE CO.**  
**AMBRIDGE PLANT**  
Dwgs. made at Ambridge No. 2 in charge of Balke  
Detailed by J.W.P. Date 8-1 Checked by J.W.B. Date 9-24-54  
File conn. chk. by Date  
**ORDER NO. G4854-X!** **SHEET NO E8**

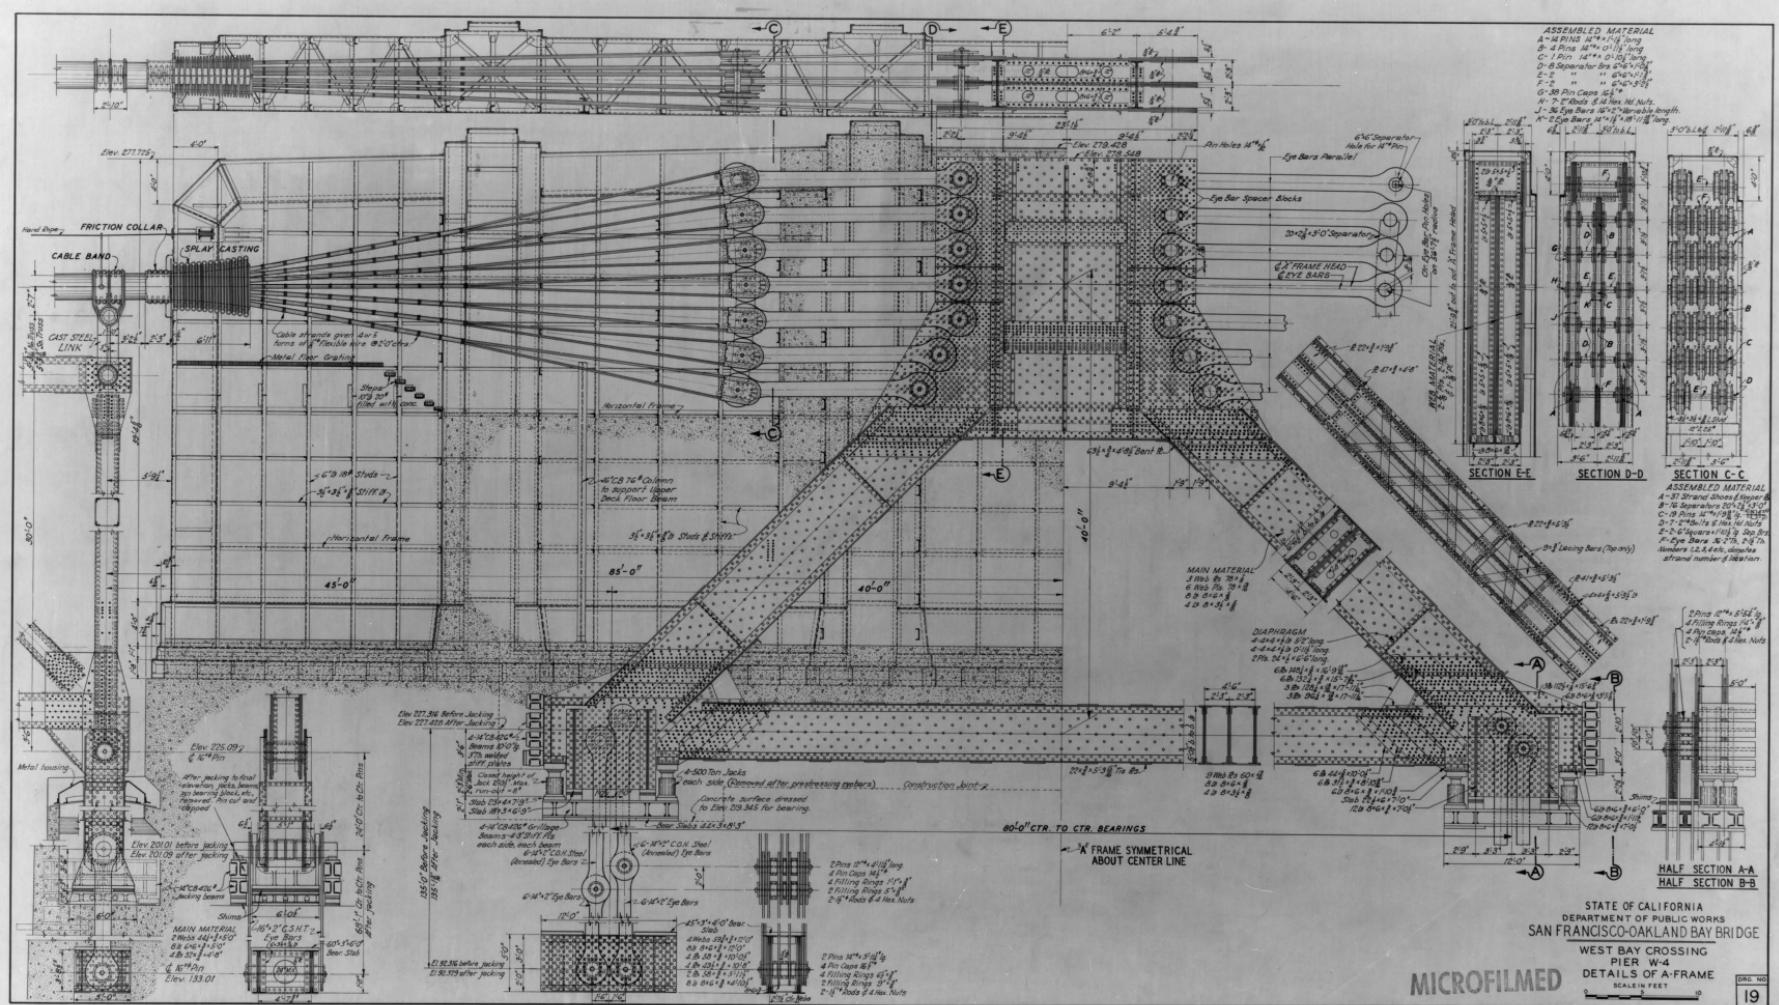

STATE OF CALIFORNIA  
DEPARTMENT OF PUBLIC WORKS  
SAN FRANCISCO-OAKLAND BAY BRIDGE  
WEST BAY CROSSING  
PIER W-4  
DETAILS OF A-FRAME  
SCALE IN FEET

**MICROFILMED**

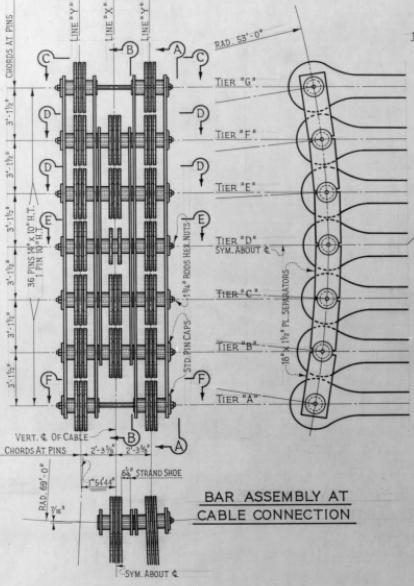

## BAR ASSEMBLY AT CABLE CONNECTION




## STRANDS IN CABLE



## Note

ALL PINS CARBON STEEL EXCEPT AS  
NOTED H. T. (HEAT TREATED).  
EYE BARS AND PLATES - CARBON STEEL.  
ALL PINS TO BE COUNTERBORED 2".  
PINS, PLATES AND RODS AT CABLE  
CONNECTION FURNISHED BUT NOT  
ERECTED UNDER THIS CONTRACT.  
PROTECTIVE COATING AS DIRECTED.

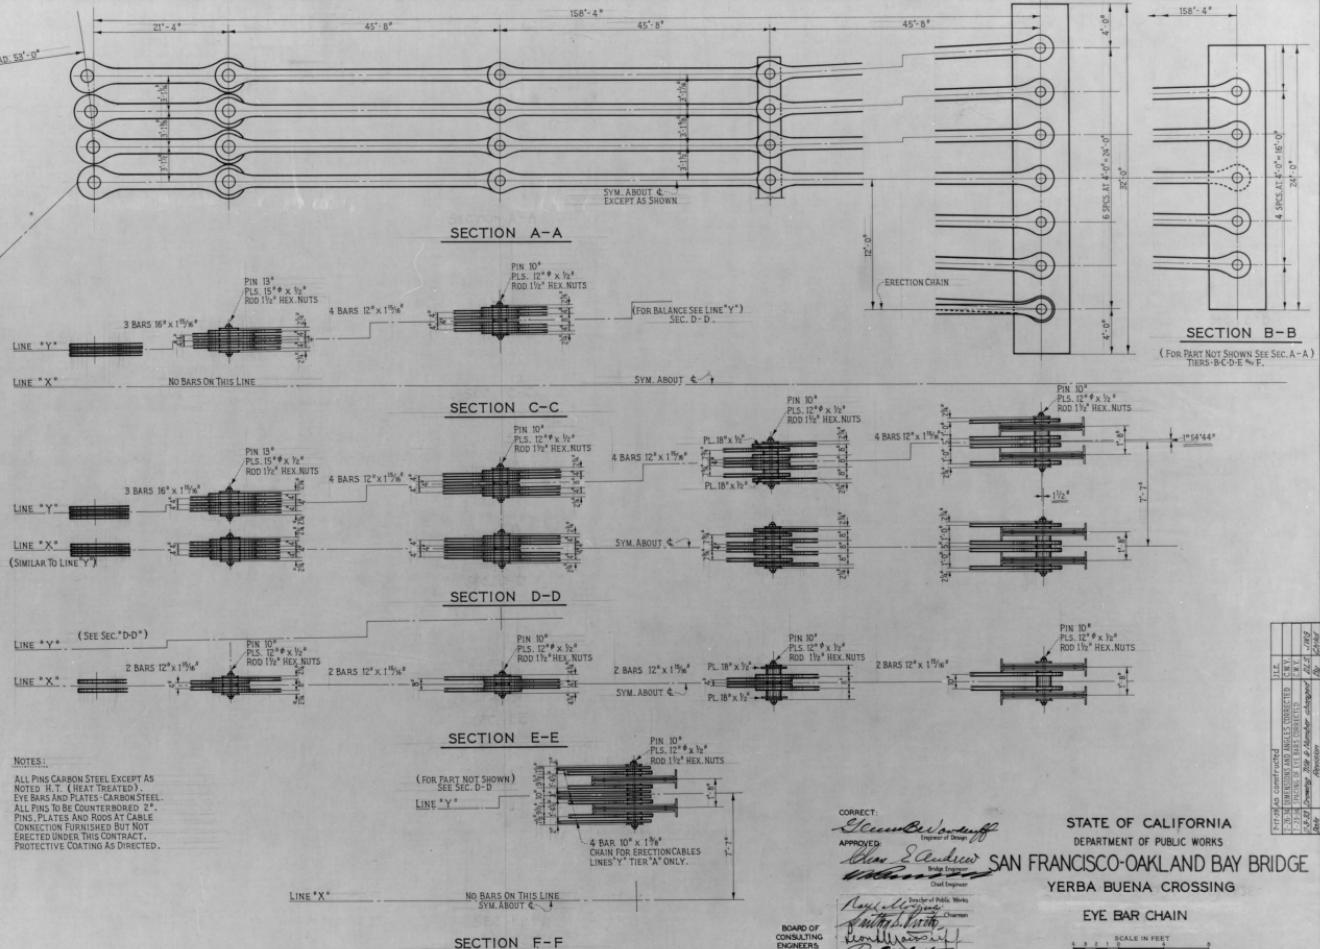

**CORRECT:**  
Glen Bell Woodruff  
Engineer of Design

APPROVED: *Clara E. Andrew*  
Engineer in Design  
Reserve Engineer

W. C. D. -  
Chief Engineer

May 10, 1942  
Fathers' Party  
Meeting  
Chairman

STATE OF CALIFORNIA  
DEPARTMENT OF PUBLIC WORKS

FRANCISCO OAKI AND RAY BRIDGES

# FRANCISCO-OAKLAND BAY BRIDGE

## **YERBA BUENA CROSSING**

## EYE BAR CHAIN


SCALE IN FEET

Figure 1. Schematic diagram of the *luciferase reporter assay* system. The *luciferase reporter construct* contains the *SV40* promoter, the *SV40* polyA signal, and the *luciferase* gene. The *luciferase* gene is under the control of the *SV40* promoter. The *luciferase reporter construct* is transfected into the cells. The *luciferase* gene is expressed and produces *luciferase* enzyme. The *luciferase* enzyme converts the substrate (*luciferin*) into light energy, which is measured by a luminometer.

TRACT NO. 5. SUP. DRAWING NO. 12A.

JUNE - 1933

*Journal of Health Politics, Policy and Law*, Vol. 29, No. 4, December 2004  
ISSN 0361-6878 • 10.1215/03616878-29-4 © 2004 by The University of Chicago

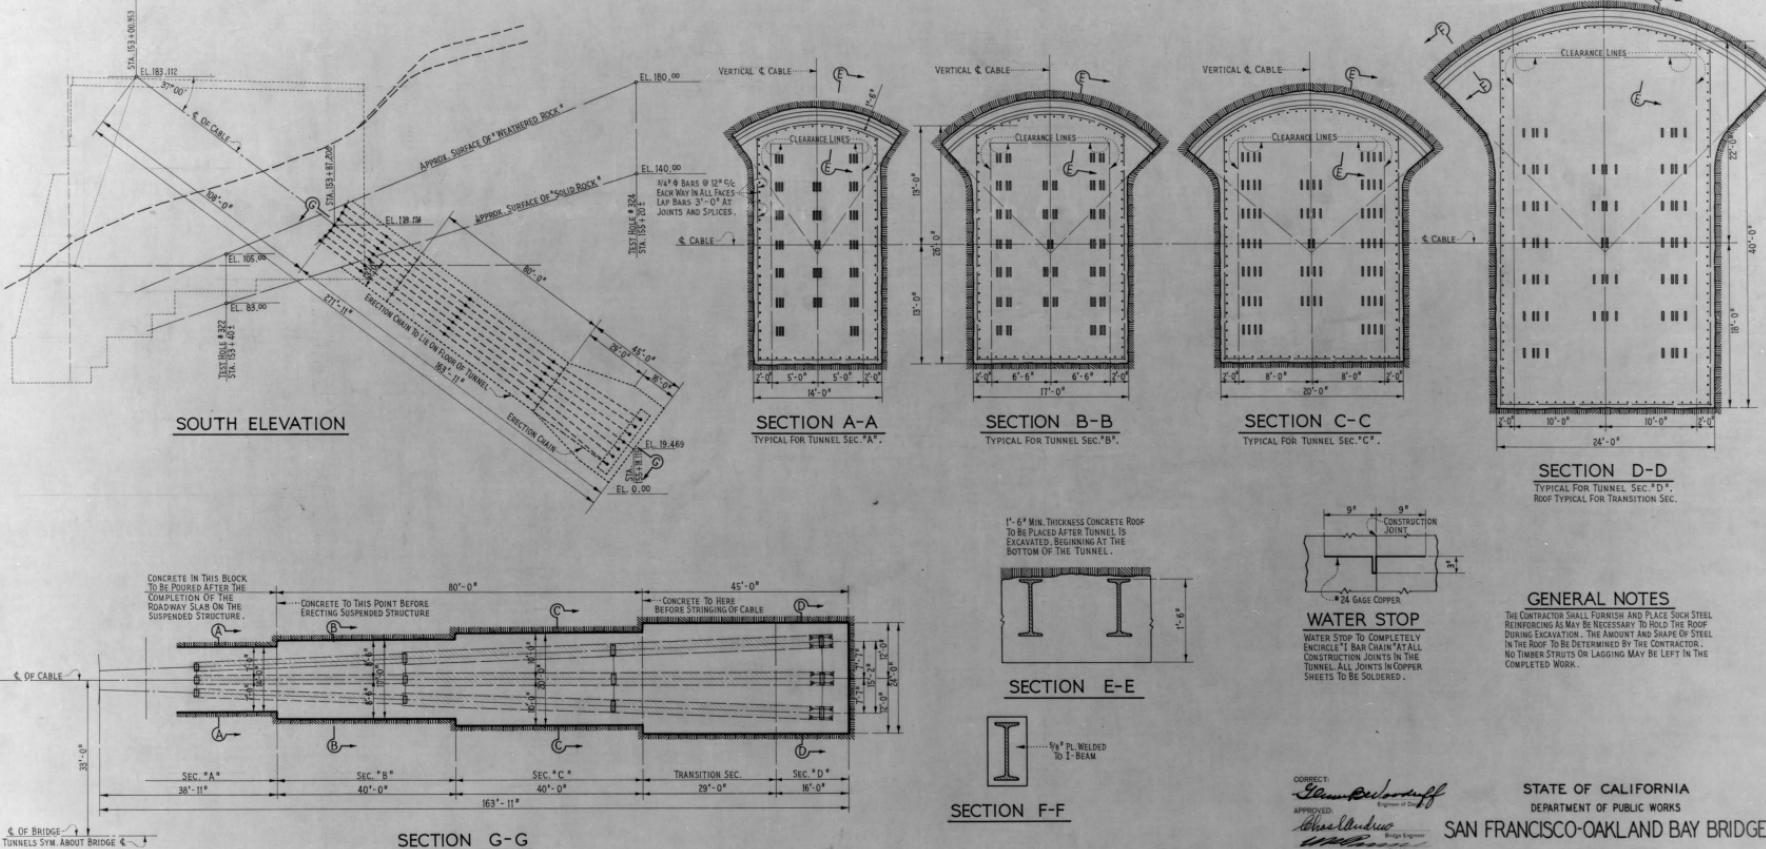

7-18-32	As Constructed	JL
7-18-32	Elevation & Station on Cable & changed	as is
Date	Revision	By

NOTE: ELEVATIONS, STATIONS AND  
SECTIONS REVISED TO  
MARCH 2, 1934.


BOARD OF  
CONSULTING  
ENGINEERS

CORRECT:  
*James B. Edwards*  
APPROVED:  
*Chas. Edwards*  
Bridge Engineer  
Chief Engineer  
General Public Works  
Engineering Department  
State of California  
San Francisco-Oakland Bay Bridge

STATE OF CALIFORNIA  
DEPARTMENT OF PUBLIC WORKS  
SAN FRANCISCO-OAKLAND BAY BRIDGE  
YERBA BUENA CROSSING  
ANCHORAGE TUNNELS

SCALE IN FEET  
4 8 12 16 20 24 28 32 36 40

CONTRACT NO. 5. DRAWING NO. 10A.  
JUNE - 1933

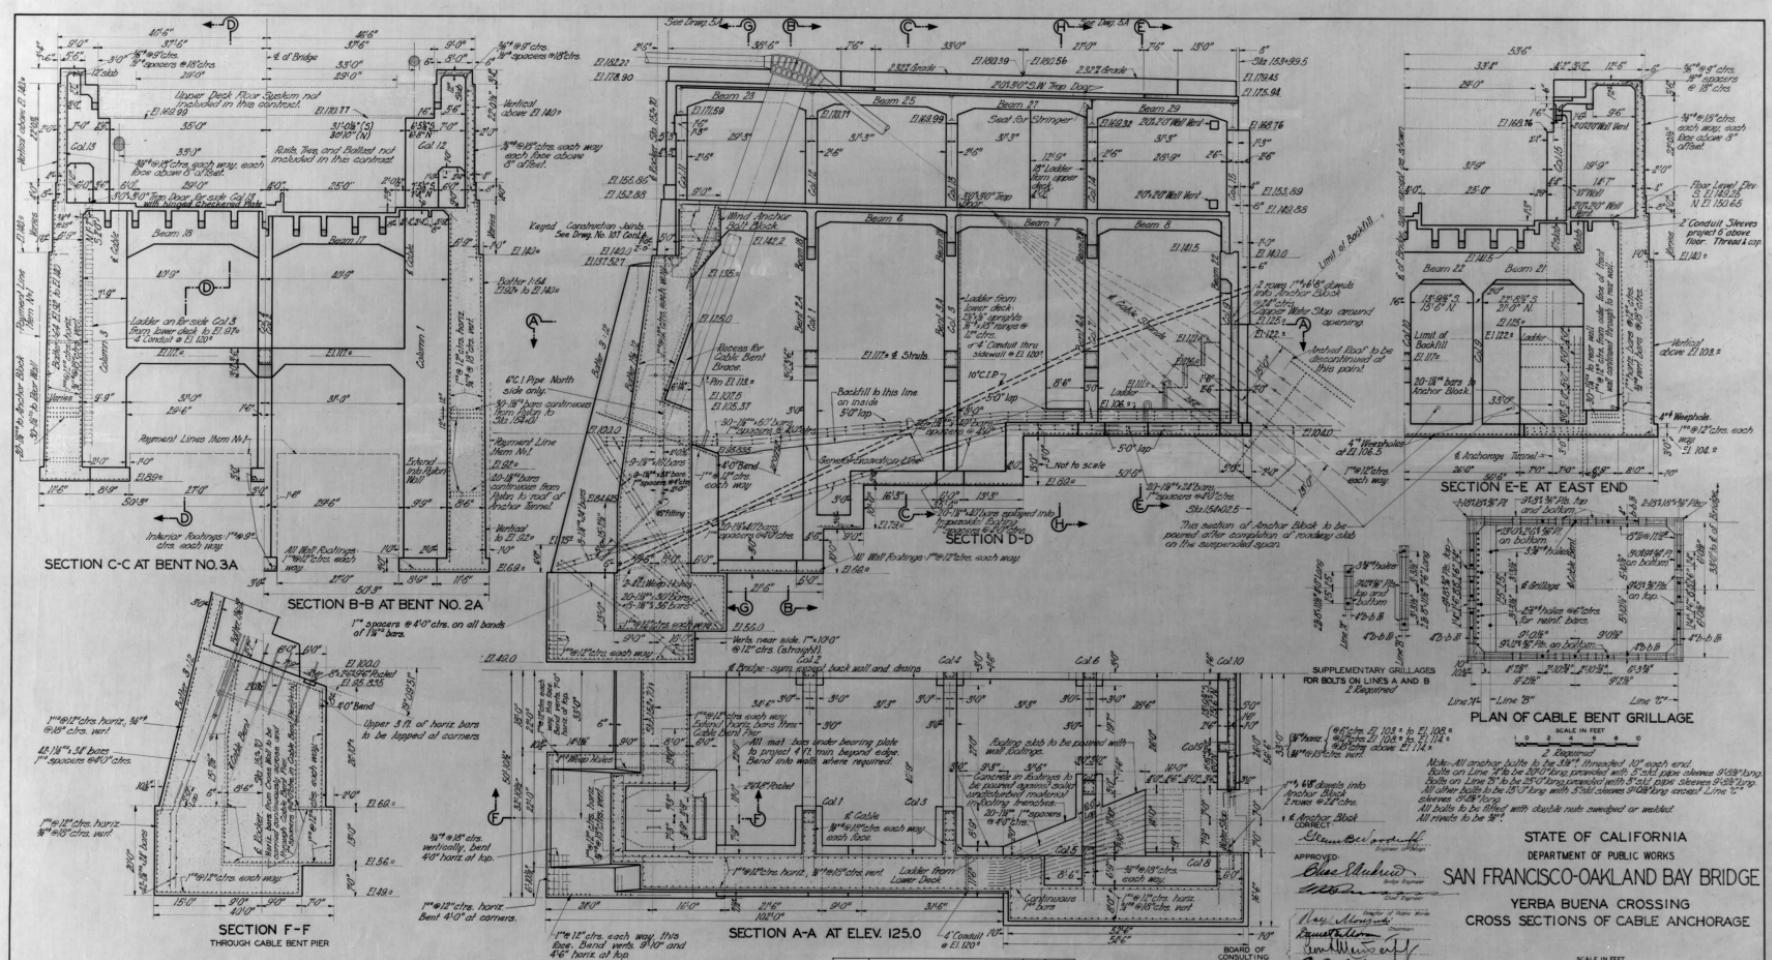

N FRANCISCO-OAKLAND BAY BRIDGE  
YERBA BUENA CROSSING  
CROSS SECTIONS OF CABLE ANCHORAGE


#### CROSS SECTIONS OF CABLE AND


SCALE IN FEET

CONTRACT NO 5 SUP DRAWING NO 4A

FEBRUARY - 1934

February 1984

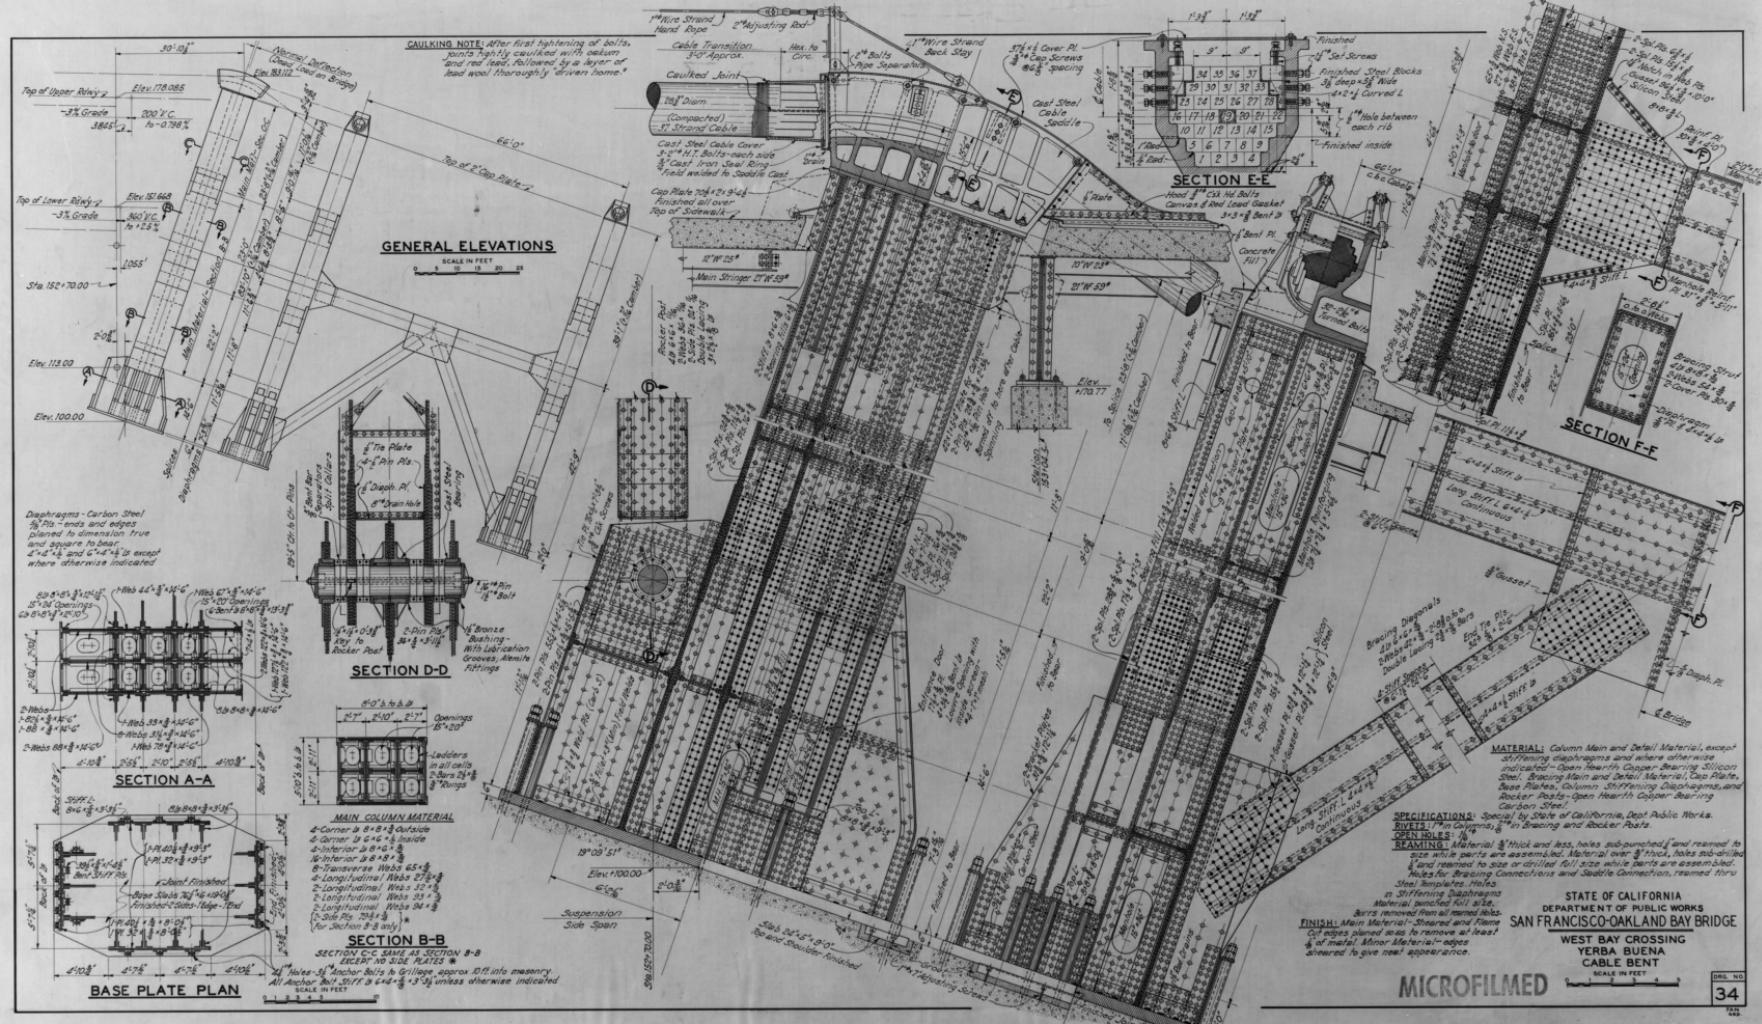

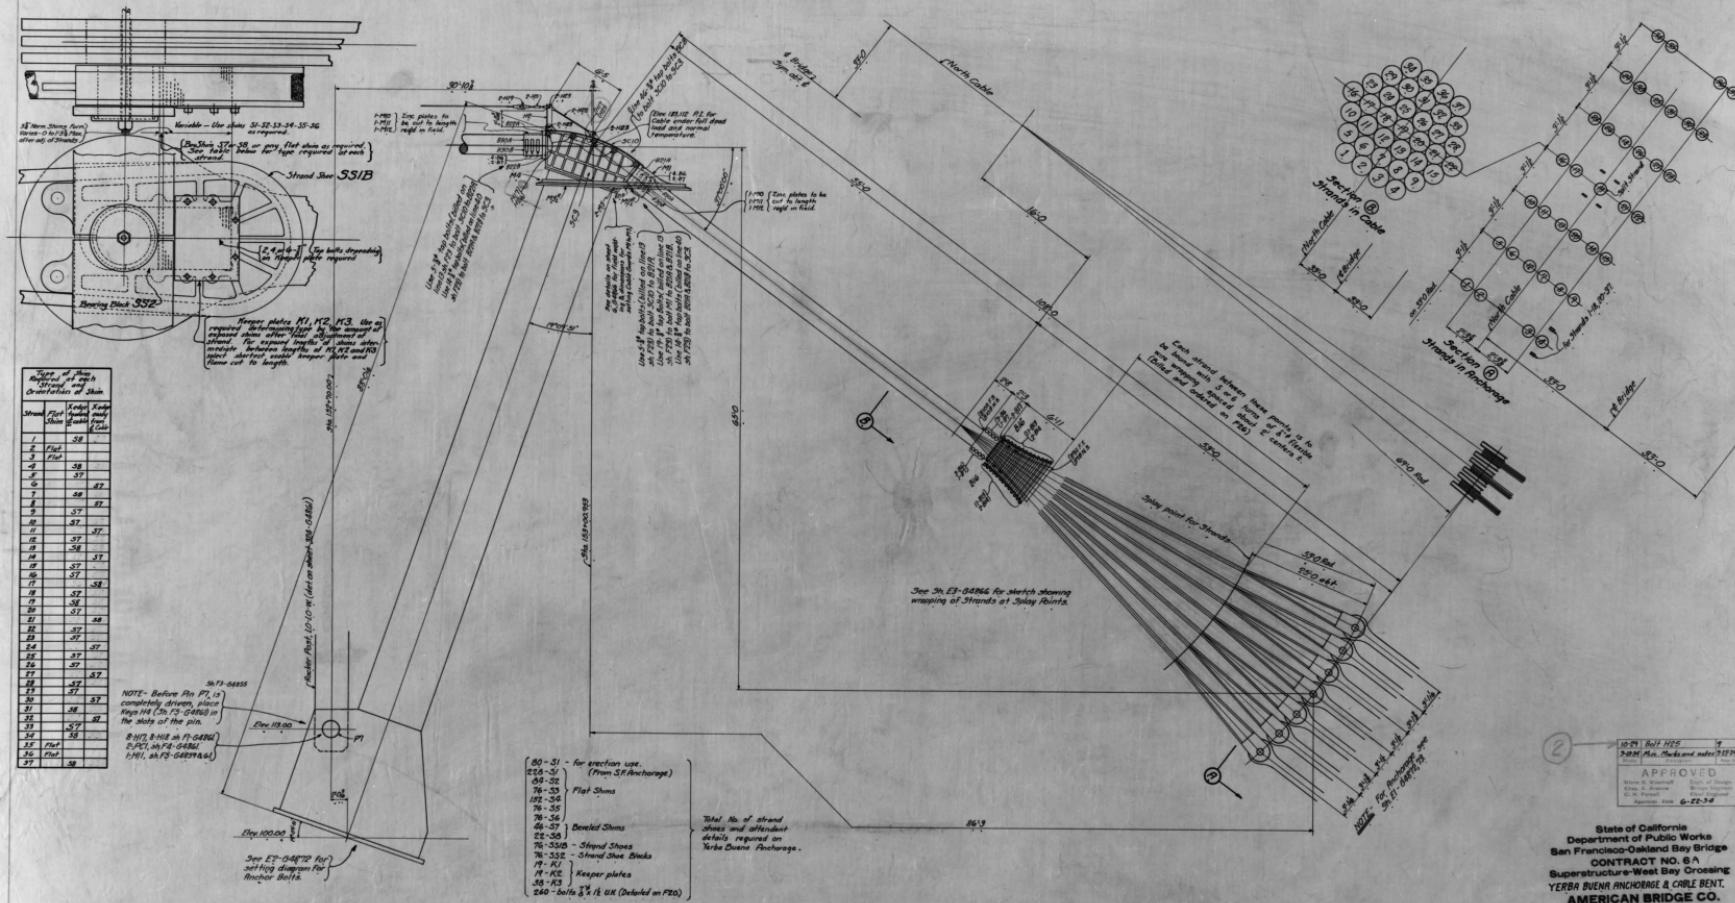


*For List of Drawings, see Sheet 1*

**APPROVED**  
 Glenn S. Viningoff  
 Chief, Structures  
 C. H. Forrest  
 Project Manager  
 Dept. of Design  
 Bridge Engineer  
 Civil Engineer

State of California  
Department of Public Works  
San Francisco-Oakland Bay Bridge  
CONTRACT NO. 6 A  
Superstructure-West Bay Crossing  
YERBA BUENA ANCHORAGE & CABLE BENT.  
**AMERICAN BRIDGE CO.**


**AMBRIDGE PLANT**  
Dwgs. made at Ambridge No. 2 in charge of Balke  
Detailed by A.C.S Date 7/13 Checked by J.P. Date 6-11-  
Fwd. comp. chkd. by Date  
**ORDER NO. G 4866 SHEET NO E4**

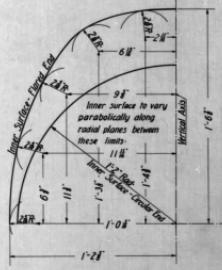


## SPLAY CONTOUR




*sion bolt  
and gasket  
of concrete.*

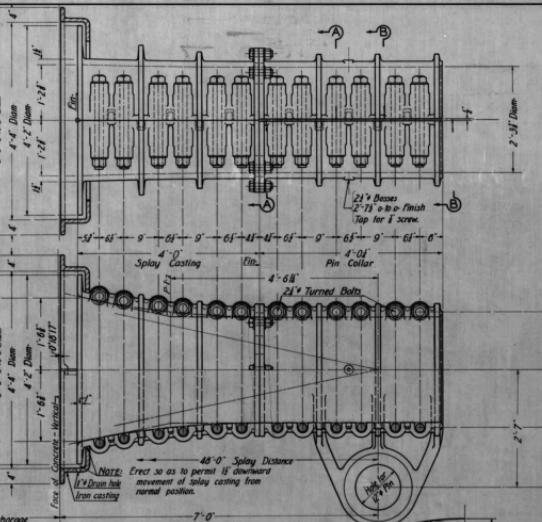


## CENTER ANCHORAGE SPLAY

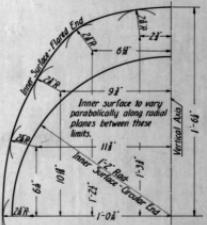


#### SPLAY CONTOUR

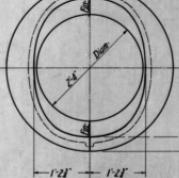

YERBA BUENA ANCHORAGE SPLAY

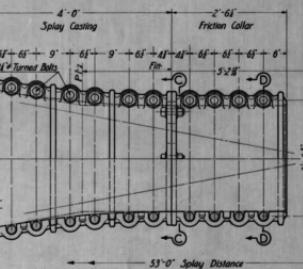


HALF SEC. G-C HALF SEC. D-D

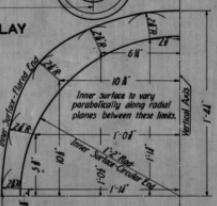

#### DISPLAY CONTOUR







SAN FRANCISCO ANCHORAGE SPLASH

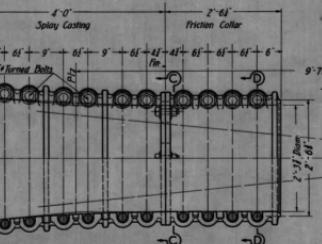

**SAN FRANCISCO-OAKLAND BAY BRIDGE**  
**CABLES & ATTACHMENTS-WEST BAY CROSSING**  
**SPLAY CASTINGS**

SCALE IN FEET  
CONTRACT NO. 6A DRAWING NO. 4  
DECEMBER - 1932

## TYPICAL RIB DETAILS

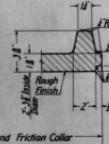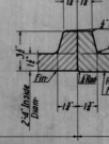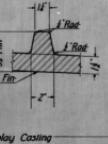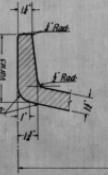

## GENERAL NOTES

Materials: Cast Steel except where otherwise noted and except  
2 $\frac{1}{2}$ " bolts which are High Tensile Steel and 1 $\frac{1}{2}$ " bolts  
which are Carbon Steel.

All dimensions pertaining to inside diameter and contour of castings are tentative only and to be verified or revised after exact compacted size of cable and order of splicing strands has been agreed upon with cable contractor.

*Inside surfaces of all Spray Castings are to be finished smooth. Inside surfaces of all Pin Collars and Friction Collars are to be rough finished, 16 cuts to an inch.*

**SECTION A-A**

**SECTION B-B**

BOARD OF  
CONSULTING


APPROVED: *John L. Koenig*  
Director of Plant Ops  
CORRECT: *Glenn Bell* *Engineering*  
Engineer  
APPROVED: *Steve Blundell*  
*Engineering*  
*John Morris*  
*Plant Manager*  
*Mark Miller* *CFO*  
*John L. Koenig*


~~STATE OF CALIFORNIA~~  
DEPARTMENT OF PUBLIC WORKS


SAN FRANCISCO-OAKLAND BAY BRIDGE  
CABLES & ATTACHMENTS-WEST BAY CROSSING  
SPLAY CASTINGS






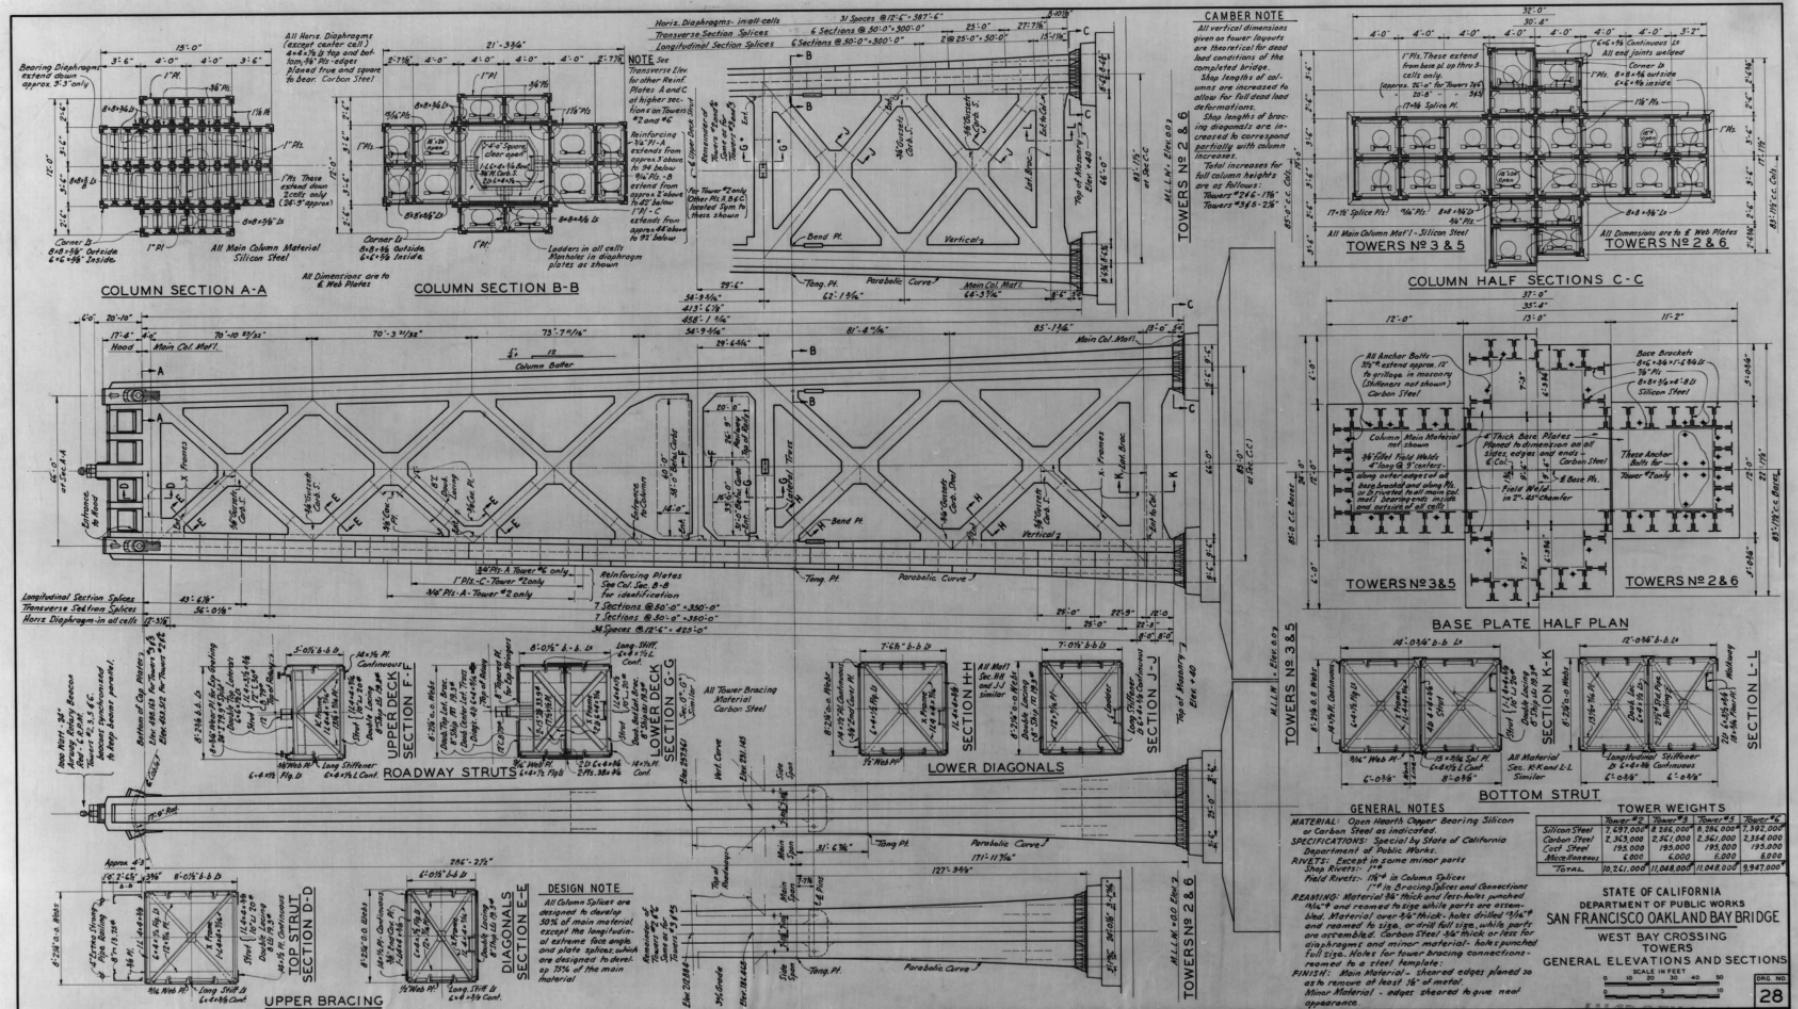

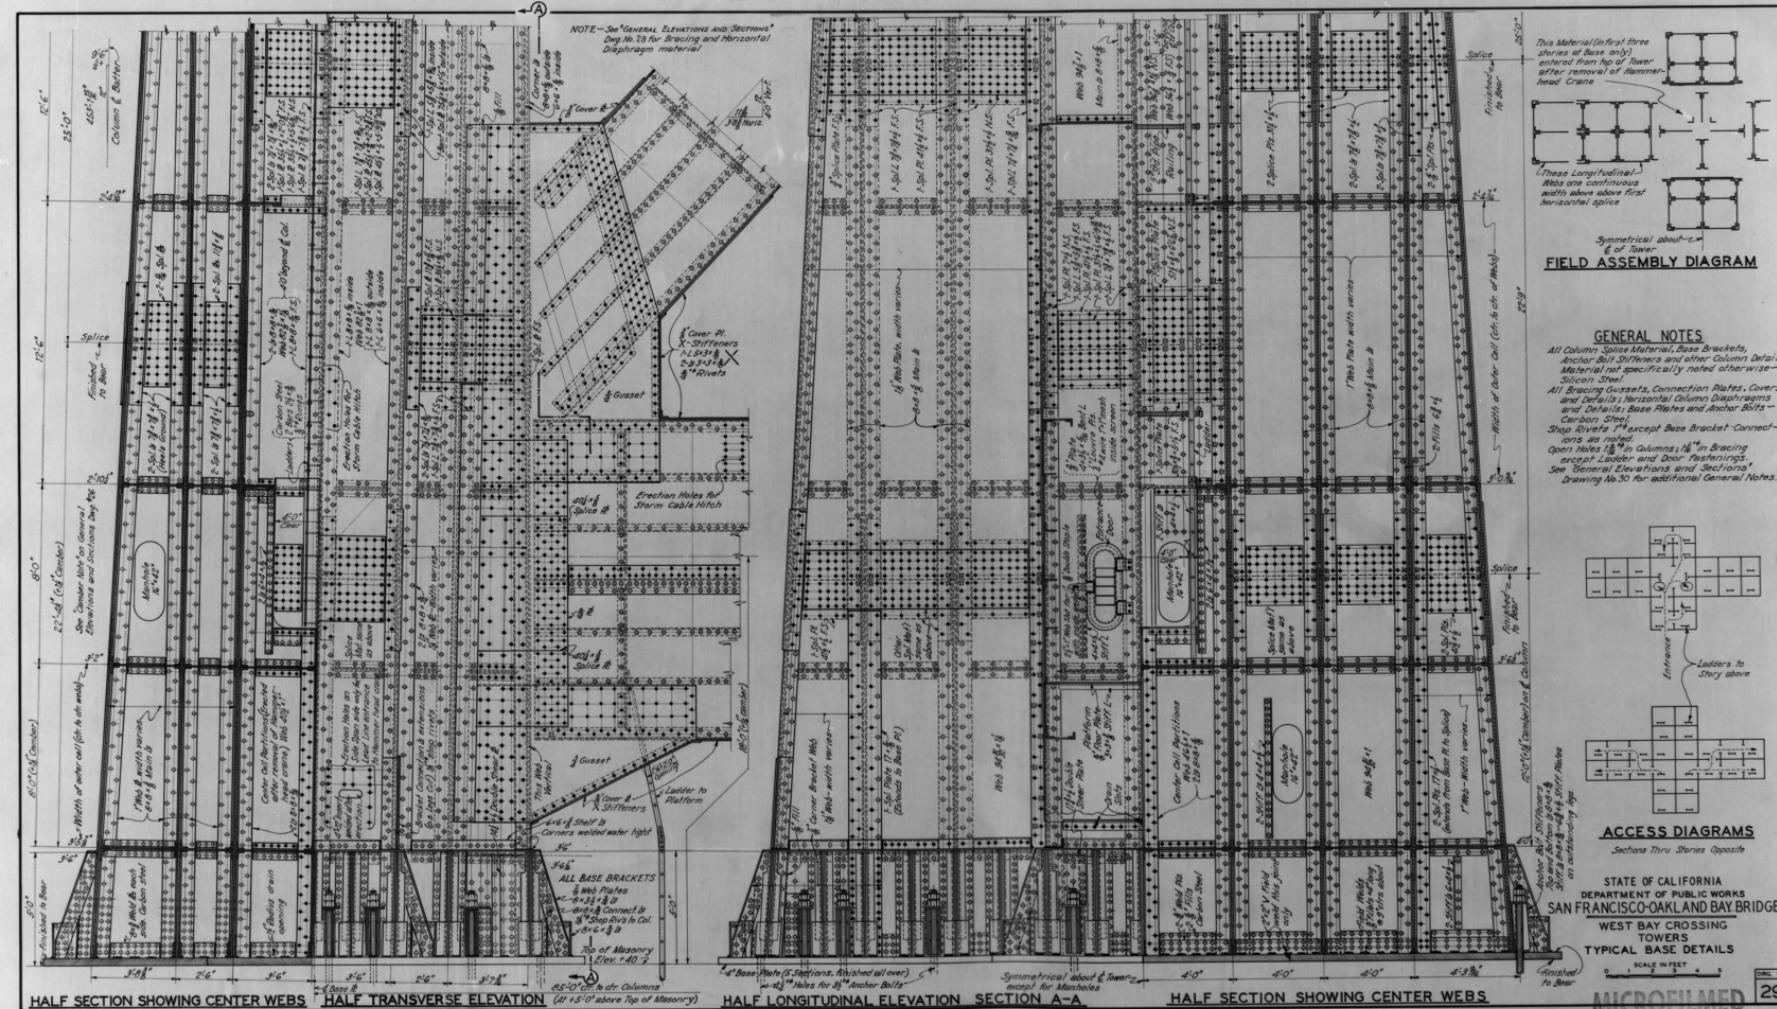


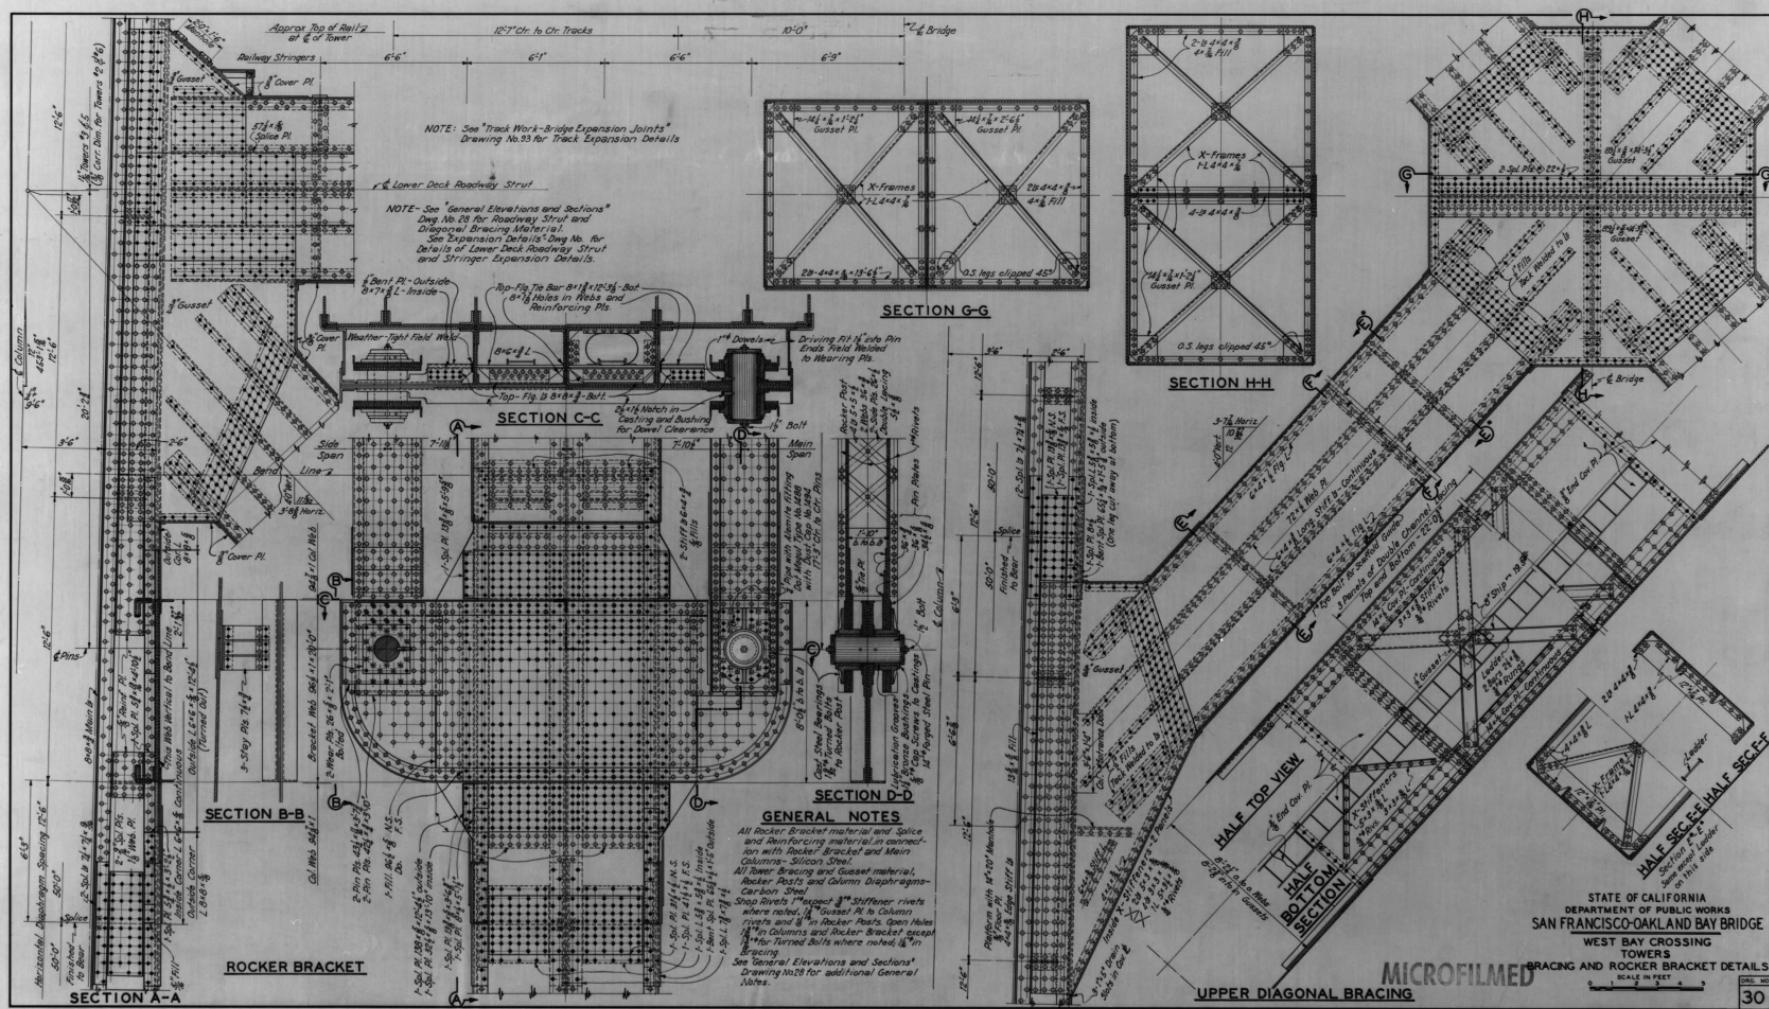

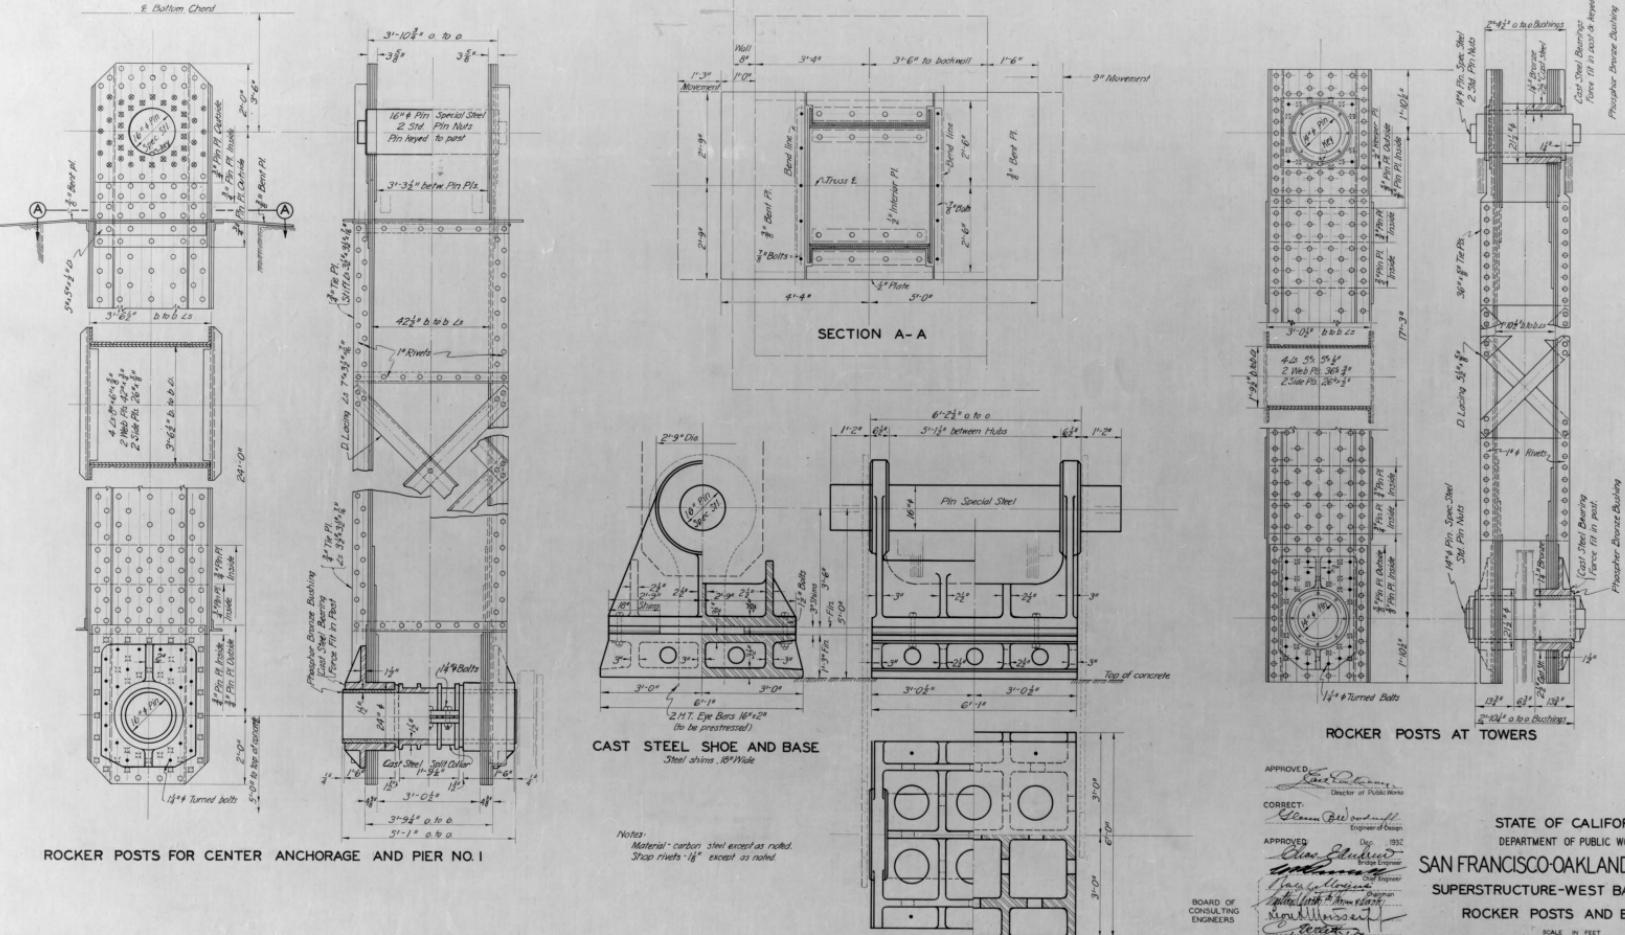

Bolted or Riveted  
All Column and Head Material Riveted to Base  
17-1/2" Head

12-1/2" Column  
Fastened to Required Distances for each segment

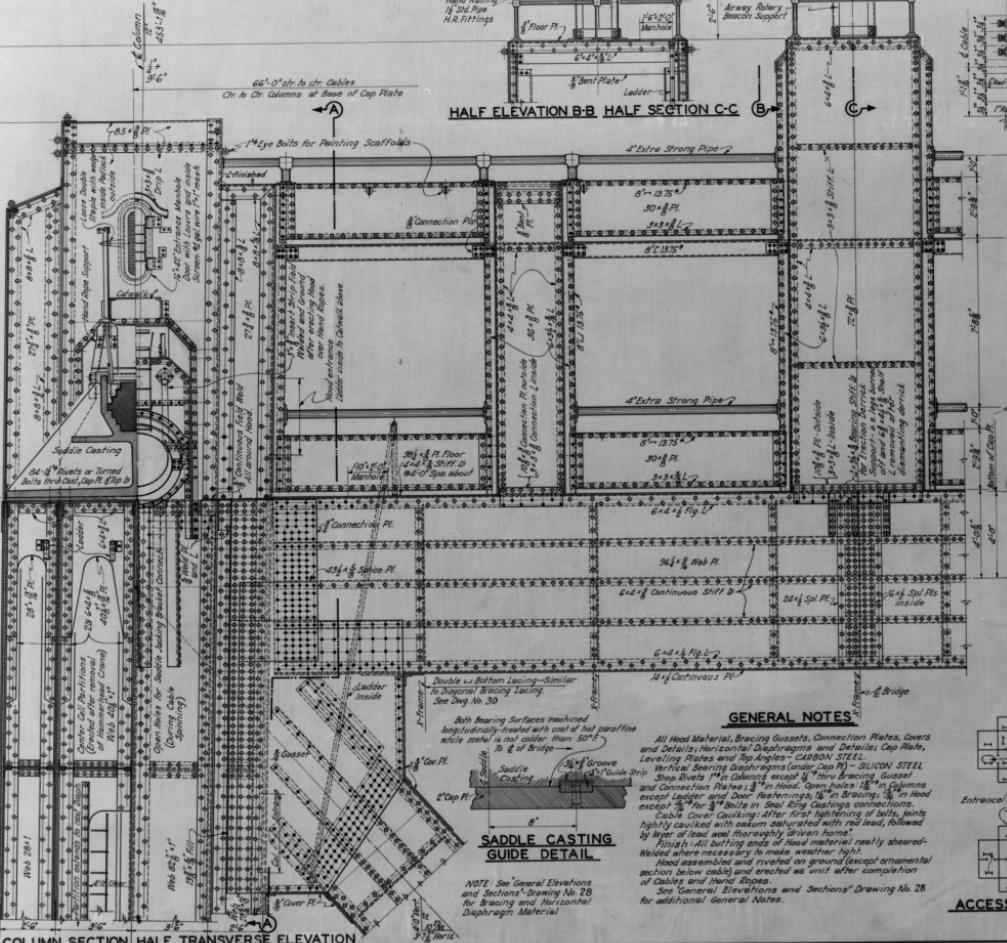

HALF COLUMN SECTION  
HALF TRANSVERSE ELEVATION

### HALF ELEVATION B-B. HALF SECTION C-C

A


B

C

### ACCESS DIAGRAM

HALF LONGITUDINAL ELEVATION  
SECTION A-A


### SIDE SPAN

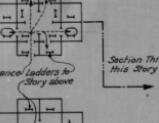


Section Thru this Story

Entrance Ladders to Story above

Section Thru Story Below

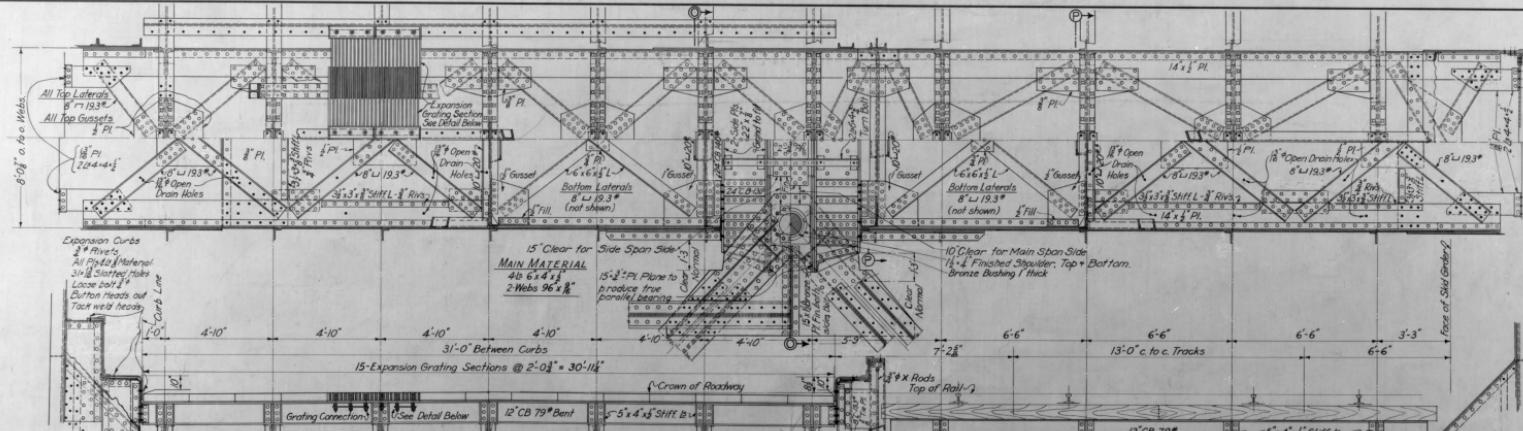

**HALF TOP VIEW**

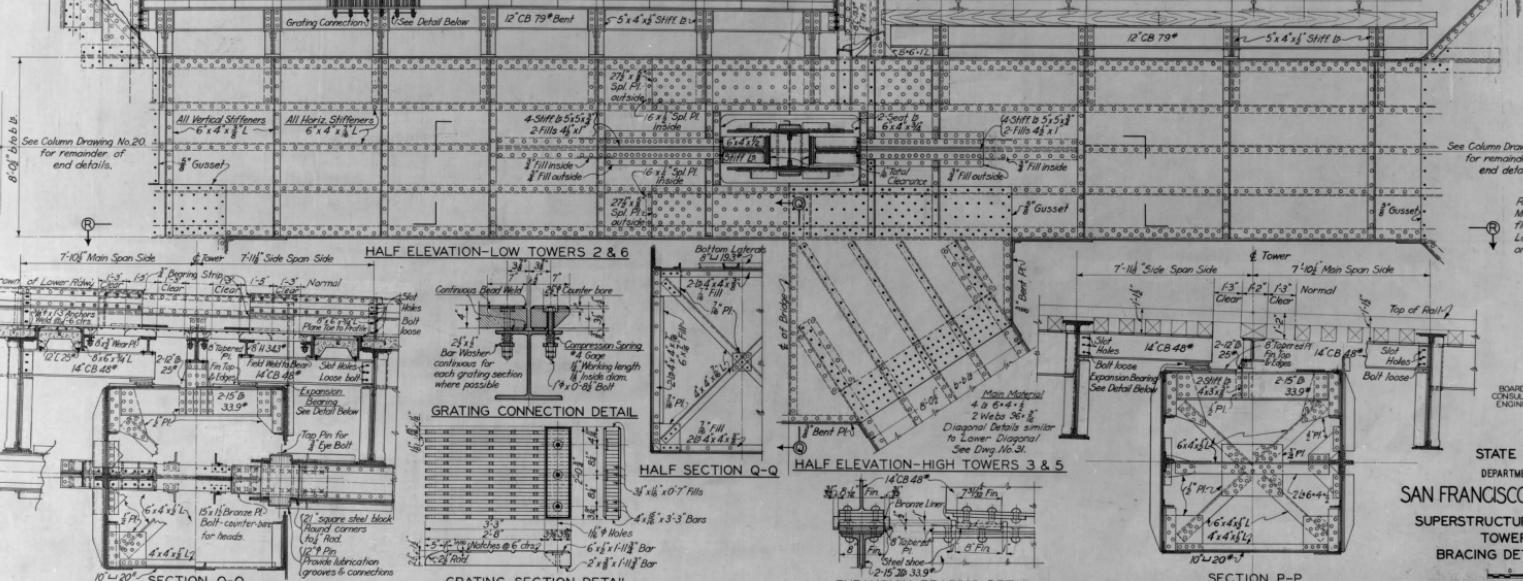

APPROVED   
Lester L. Harvey  
Director of Public Works

**GENERAL NOTE**

Welds 1/8 unless otherwise noted.  
Material: Carbon Steel except end  
floor beams which are Silicon Steel.  
adders and walkways not shown.  
On this drawing- See Drawing No. 35




**CORRECT:**  
Steve B. Wood

APPROVED: *Chas. E. Andrus*  
August 19  
*M. L. Parker* Bridge Engineer  
*Playa Mowitch* Chief Engineer  
*W. H. Smith* Chaplain  
*W. H. Miller* Commissary

STATE OF CALIFORNIA  
DEPARTMENT OF PUBLIC WORKS

SAN FRANCISCO-OAKLAND BAY BRIDGE  
SUPERSTRUCTURE-WEST BAY CROSSING  
TOWERS 2,3,5 & 6  
BRACING DETAILS-LOWER DECK

SCALE IN FEET  
CONTRACT NO. 6 DRAWING NO. 27

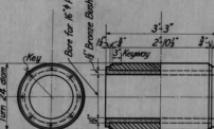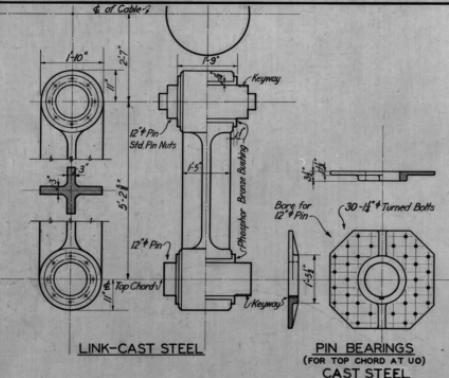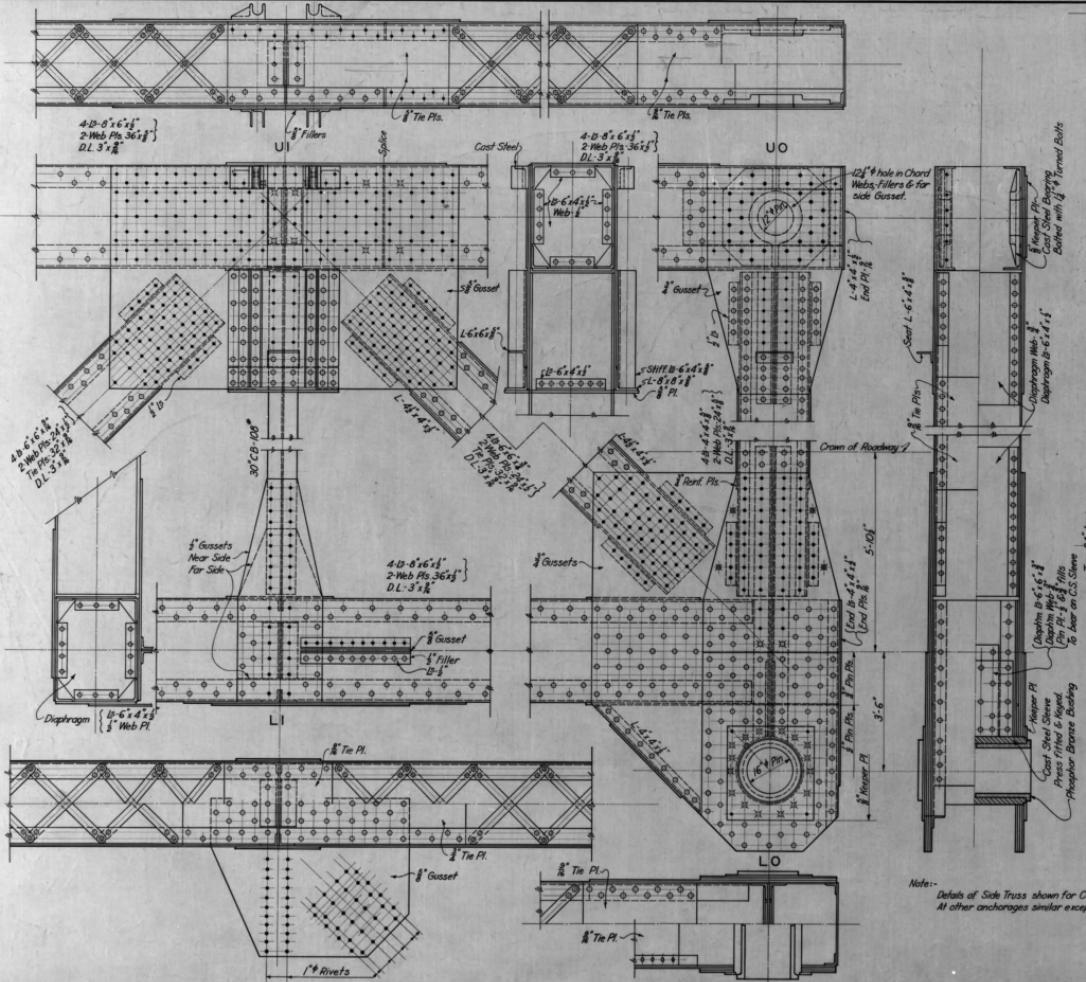

**SLEEVE-CAST STEEL  
PHOSPHOR BRONZE BUSHING  
(FOR BOTTOM CHORD AT L.C.)**

NOTE

Material - as noted  
Silicon steel marked "S."  
Carbon steel marked "C."  
Shop Rivets - 1 $\frac{1}{8}$ " except as noted  
Field Rivets - 1 $\frac{1}{8}$ " manganese steel  
or 1 $\frac{1}{4}$ " carbon steel except  
as noted

APPROVED: 

**CORRECT:** Glenn B. Woodward

APPROVED:

~~\_\_\_\_~~ \_\_\_\_\_ Chief Engine

~~South Park Apartments~~  
South Park Apartments

*C. verreauxi*, p  
216.


STATE OF CALIFORNIA  
DEPARTMENT OF PUBLIC WORKS

**SAN FRANCISCO-OAKLAND BAY BRIDGE  
SUPERSTRUCTURE-WEST BAY CROSSING  
SUSPENDED STRUCTURE  
SIDE SPAN TRUSSES AT ANCHORAGES**

CONTRACT NO.6 DRAWING NO. 4


DECEMBER 193

© 1998, 1999

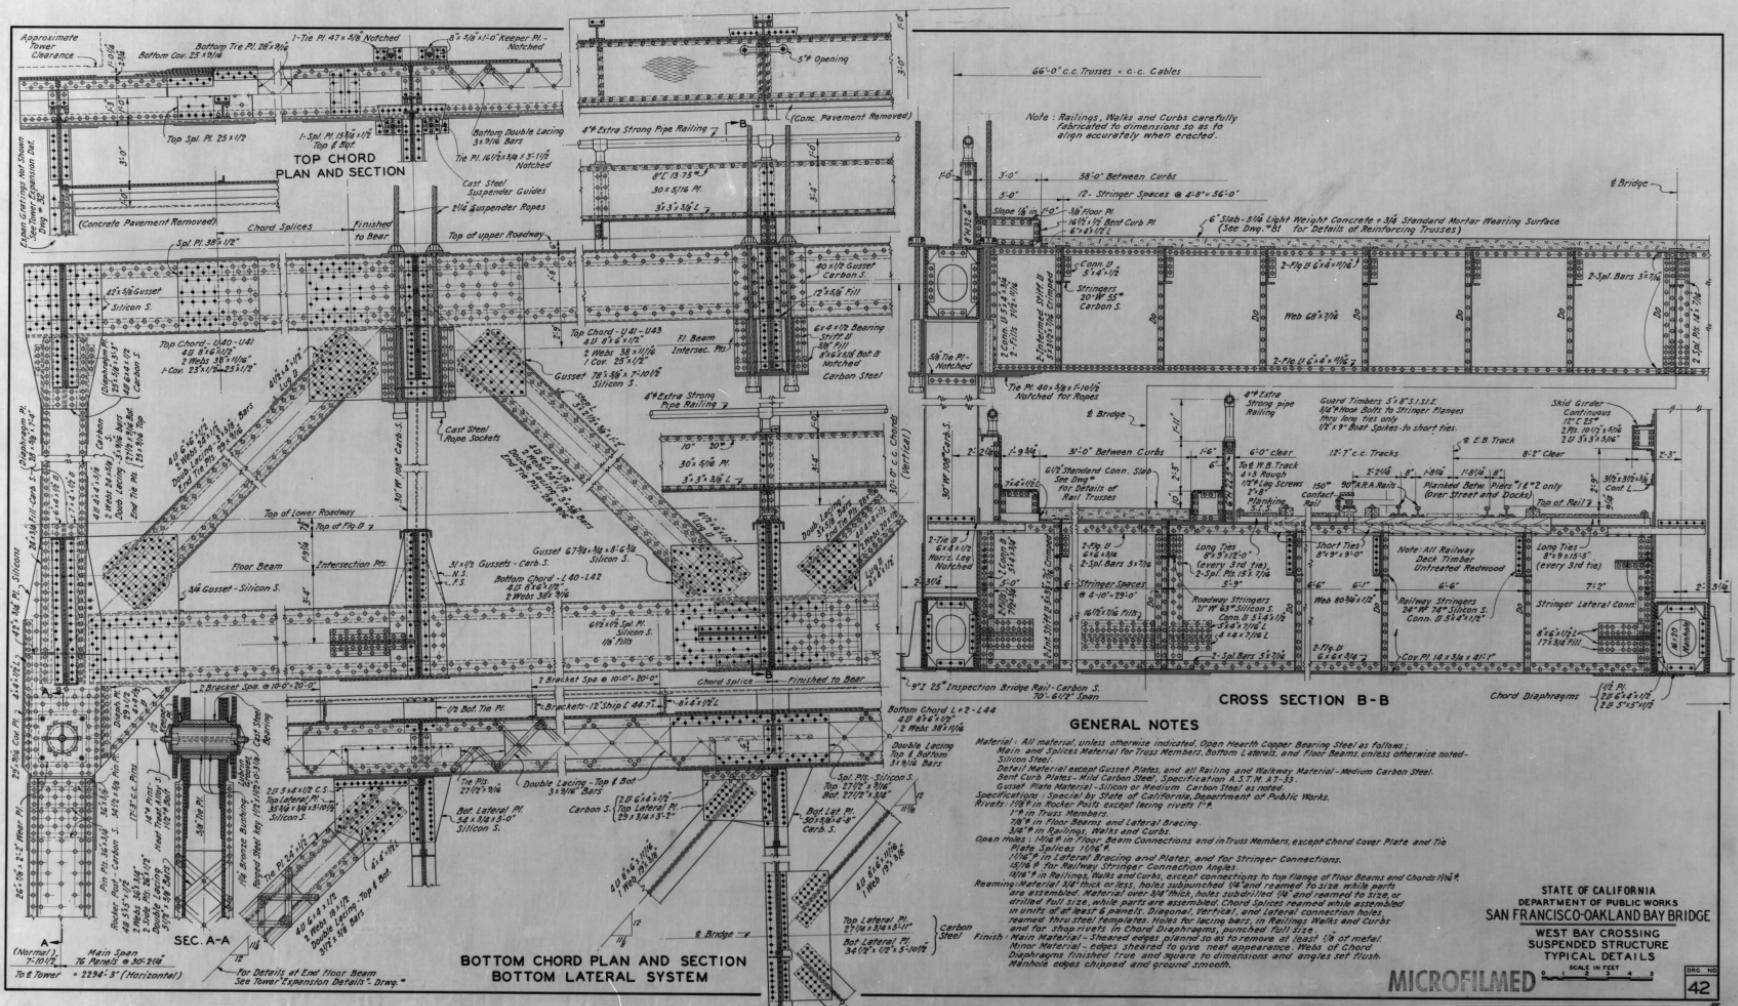

STATE OF CALIFORNIA  
DEPARTMENT OF PUBLIC WORKS  
SAN FRANCISCO-OAKLAND BAY BRIDGE  
WEST BAY CROSSING  
SUSPENDED STRUCTURE  
TYPICAL DETAILS

MICROFILMED

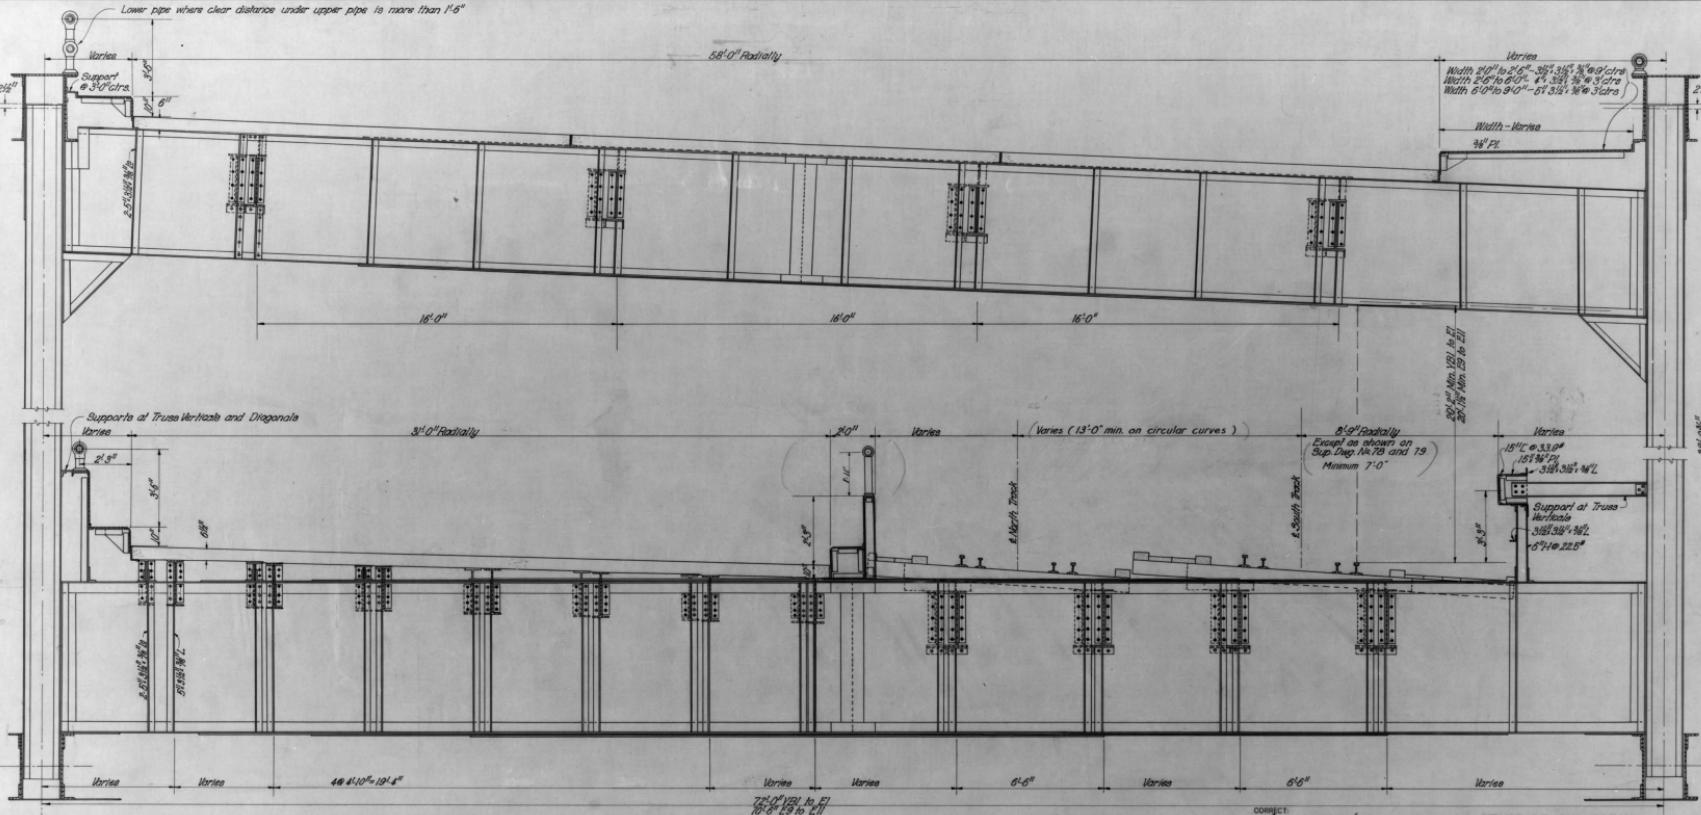

#### TYPICAL CROSS-SECTION

Details which are not shown are the same  
as those shown.  
For materials see Sup. Drawg. No. 6.  
for grades and layout see Sup. Drawg. Nos. 78 & 79.

RECORDED  
*Glenn Beckwith*  
Engineer of Design


APPROVED  
*Bob Culver*  
Architect

Chief Engineer  
Director of Public Works  
Chairman

BOARD OF  
CONSULTING  
ENGINEERS

STATE OF CALIFORNIA  
DEPARTMENT OF PUBLIC WORKS  
SAN FRANCISCO-OAKLAND BAY BRIDGE  
SUPERSTRUCTURE - EAST BAY CROSSING  
SPANS YB1 TO E1 - E9 TO E11  
TYPICAL CROSS - SECTION

SCALE IN FEET  
CONTRACT NO. 7 SUP. DRAWING NO. 82  
OCTOBER - 1933

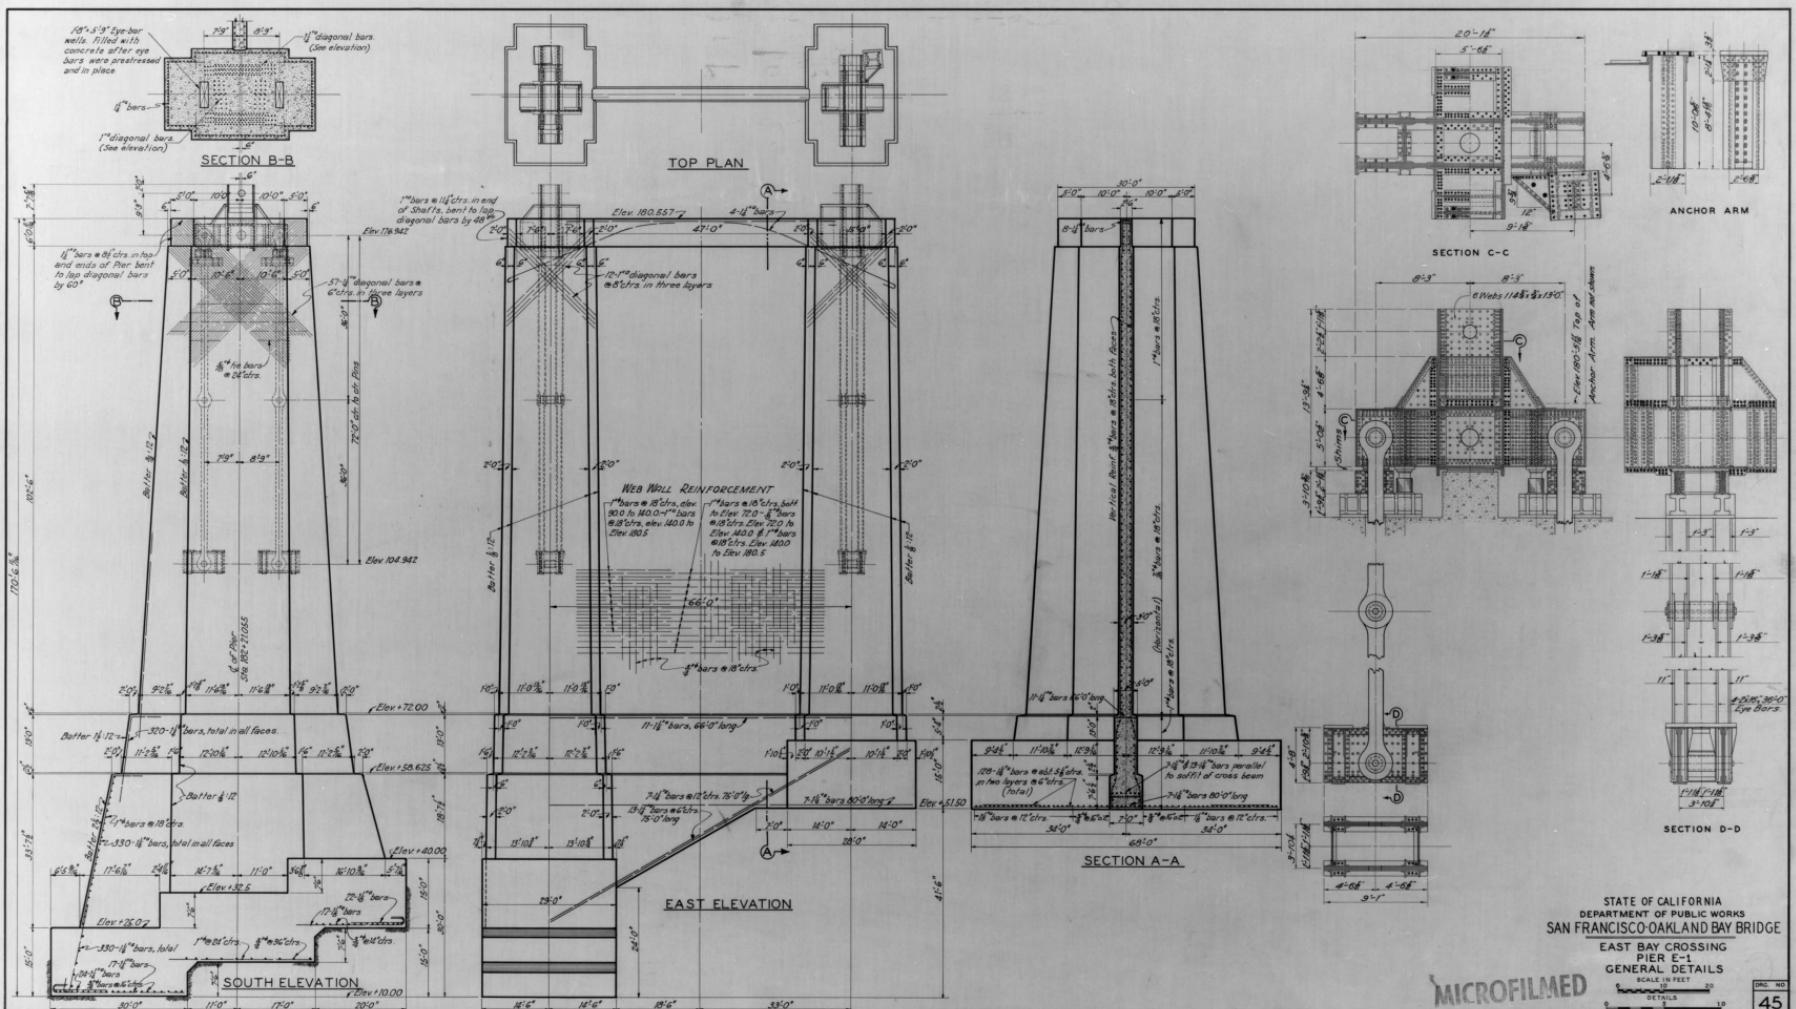




STATE OF CALIFORNIA  
DEPARTMENT OF PUBLIC WORKS  
SAN FRANCISCO-OAKLAND BAY BRIDGE  
EAST BAY CROSSING  
PIER E-1  
GENERAL DETAILS

MICROFILMED



## DETAILS OF REINFORCING STEEL IN CAISSON

SCALE IN FEET

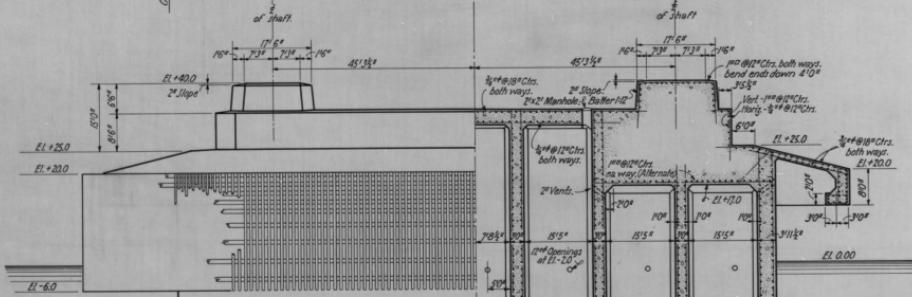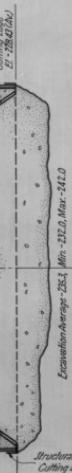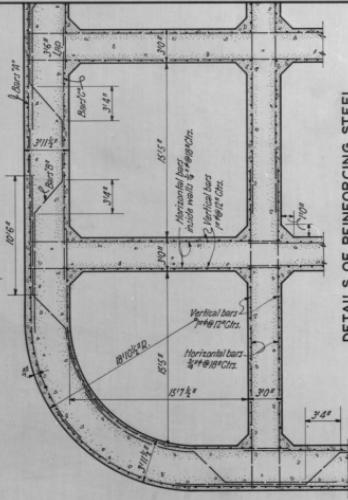



PART ELEVATION-PART SECTION B-

STATE OF CALIFORNIA  
DEPARTMENT OF PUBLIC WORKS  
SAN FRANCISCO OAKLAND BAY BRIDGE  
EAST BAY CROSSING  
PIER • E3  
GENERAL DETAILS

MICROFILMED



## TOP TOWER SECTIONS NO. 1

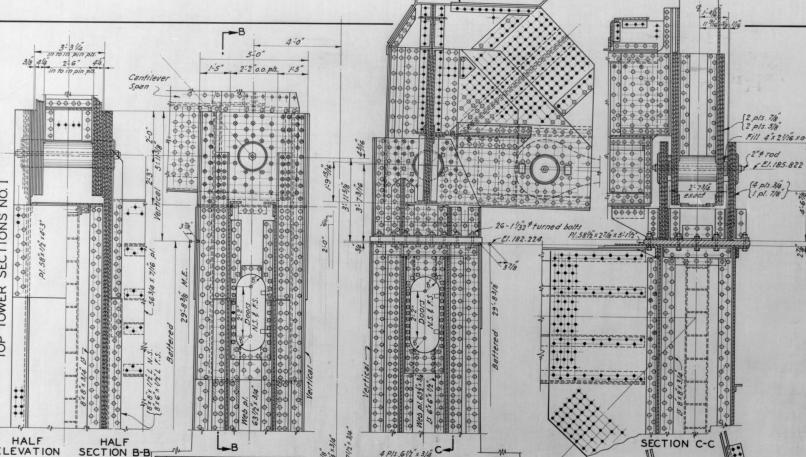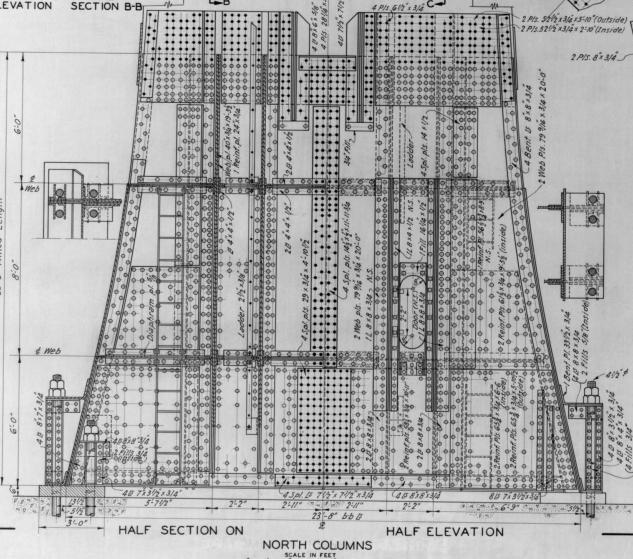BOTTOM TOWER SECTION NO. 4  
20'-0" Walled Length

## HALF ELEVATION

## HALF SECTION B-B

## SECTION C-C

## SECTION D-D

## SECTION E-E


## SECTION F-F

## SECTION G-G

## SECTION H-H

NORTH COLUMNS  
SCALE IN FEET

## HALF ELEVATION

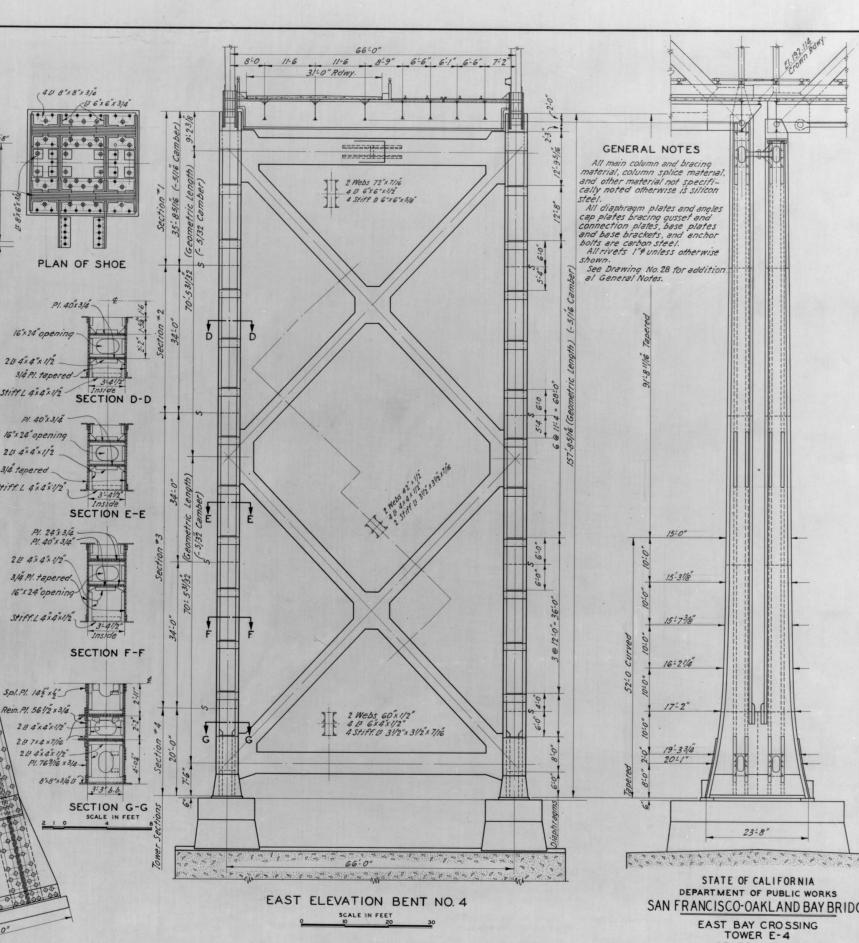


EAST ELEVATION BENT NO. 4


SCALE IN FEET

0 20 40

MICROFILMED

STATE OF CALIFORNIA  
DEPARTMENT OF PUBLIC WORKS  
SAN FRANCISCO-OAKLAND BAY BRIDGE  
EAST BAY CROSSING  
TOWER E-4  
GENERAL PLAN  
SCALE AS SHOWN


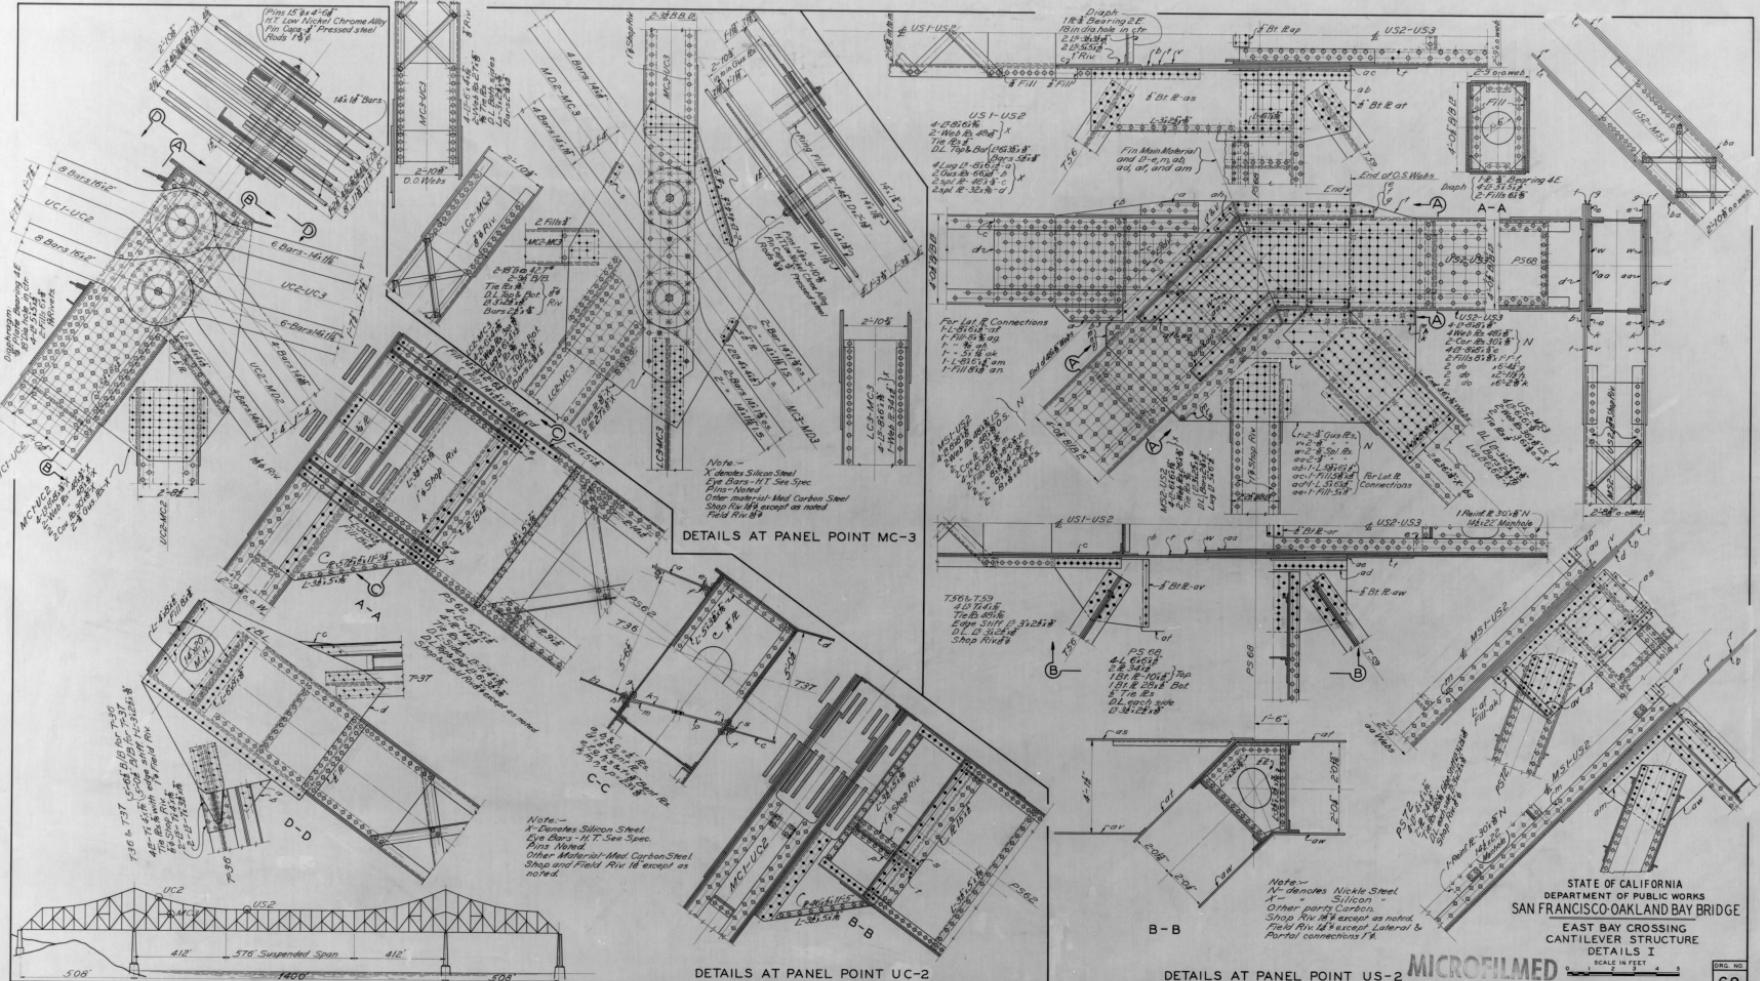


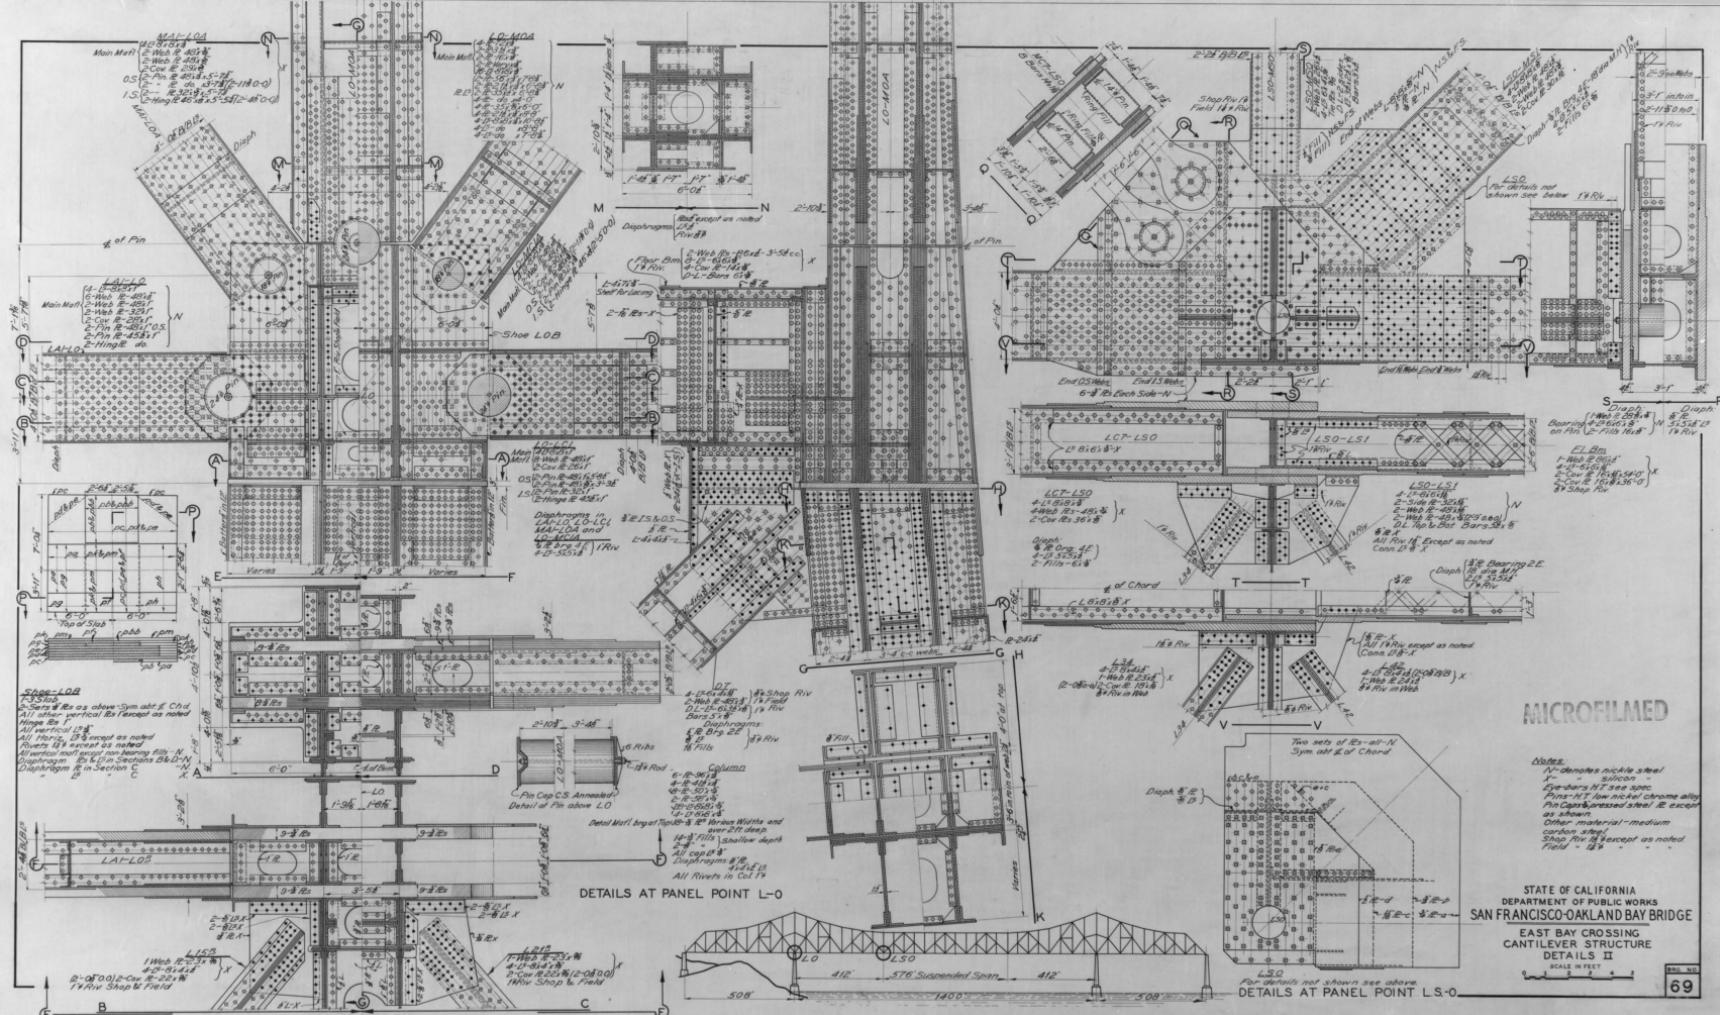

MICROFILMED


*Notes:*  
 N = denotes nickel steel  
 X = silicon  
 Eye-bars H.T. see spec.  
 Pins-H.T. low nickel chrome alloy  
 Pin Caps & pressed steel P except  
 as shown.  
 Other material - medium  
 carbon steel  
 Shop Riv 18% except as noted.  
 Field 18% - -

STATE OF CALIFORNIA  
DEPARTMENT OF PUBLIC WORKS  
SAN FRANCISCO-OAKLAND BAY BRIDGE  
EAST BAY CROSSING  
CANTILEVER STRUCTURE  
DETAILS II

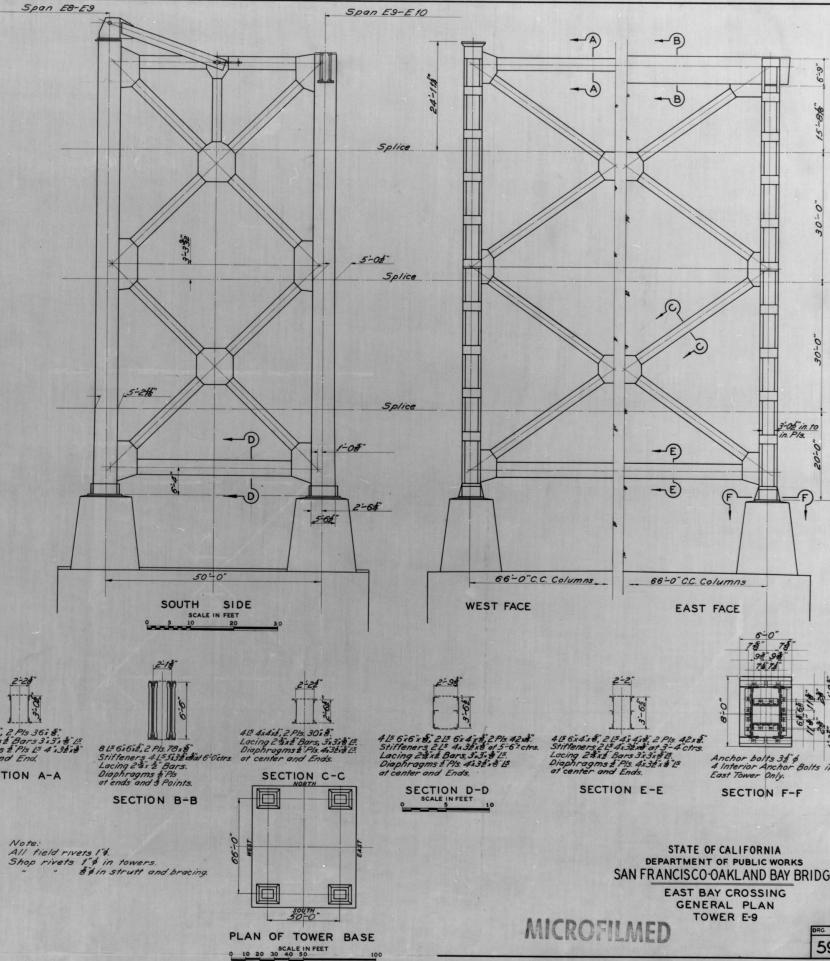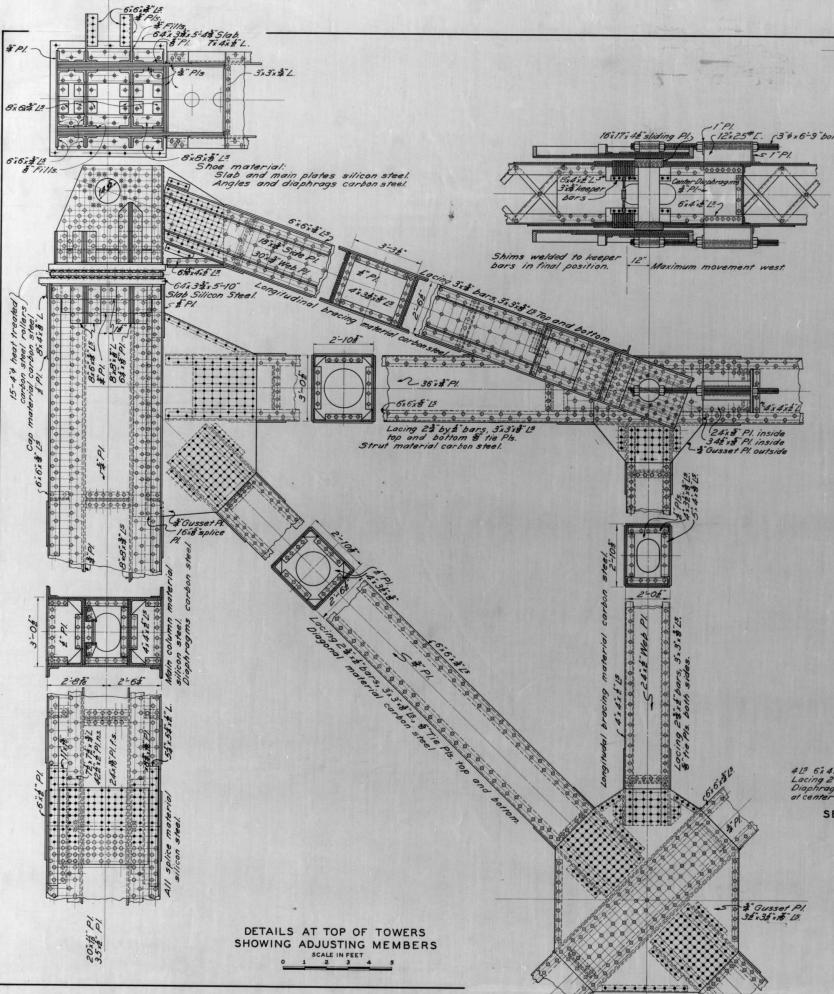


STATE OF CALIFORNIA  
DEPARTMENT OF PUBLIC WORKS  
SAN FRANCISCO-OAKLAND BAY BRIDGE  
EAST BAY CROSSING  
GENERAL PLAN  
TOWER E-9



**MICROFILMED**

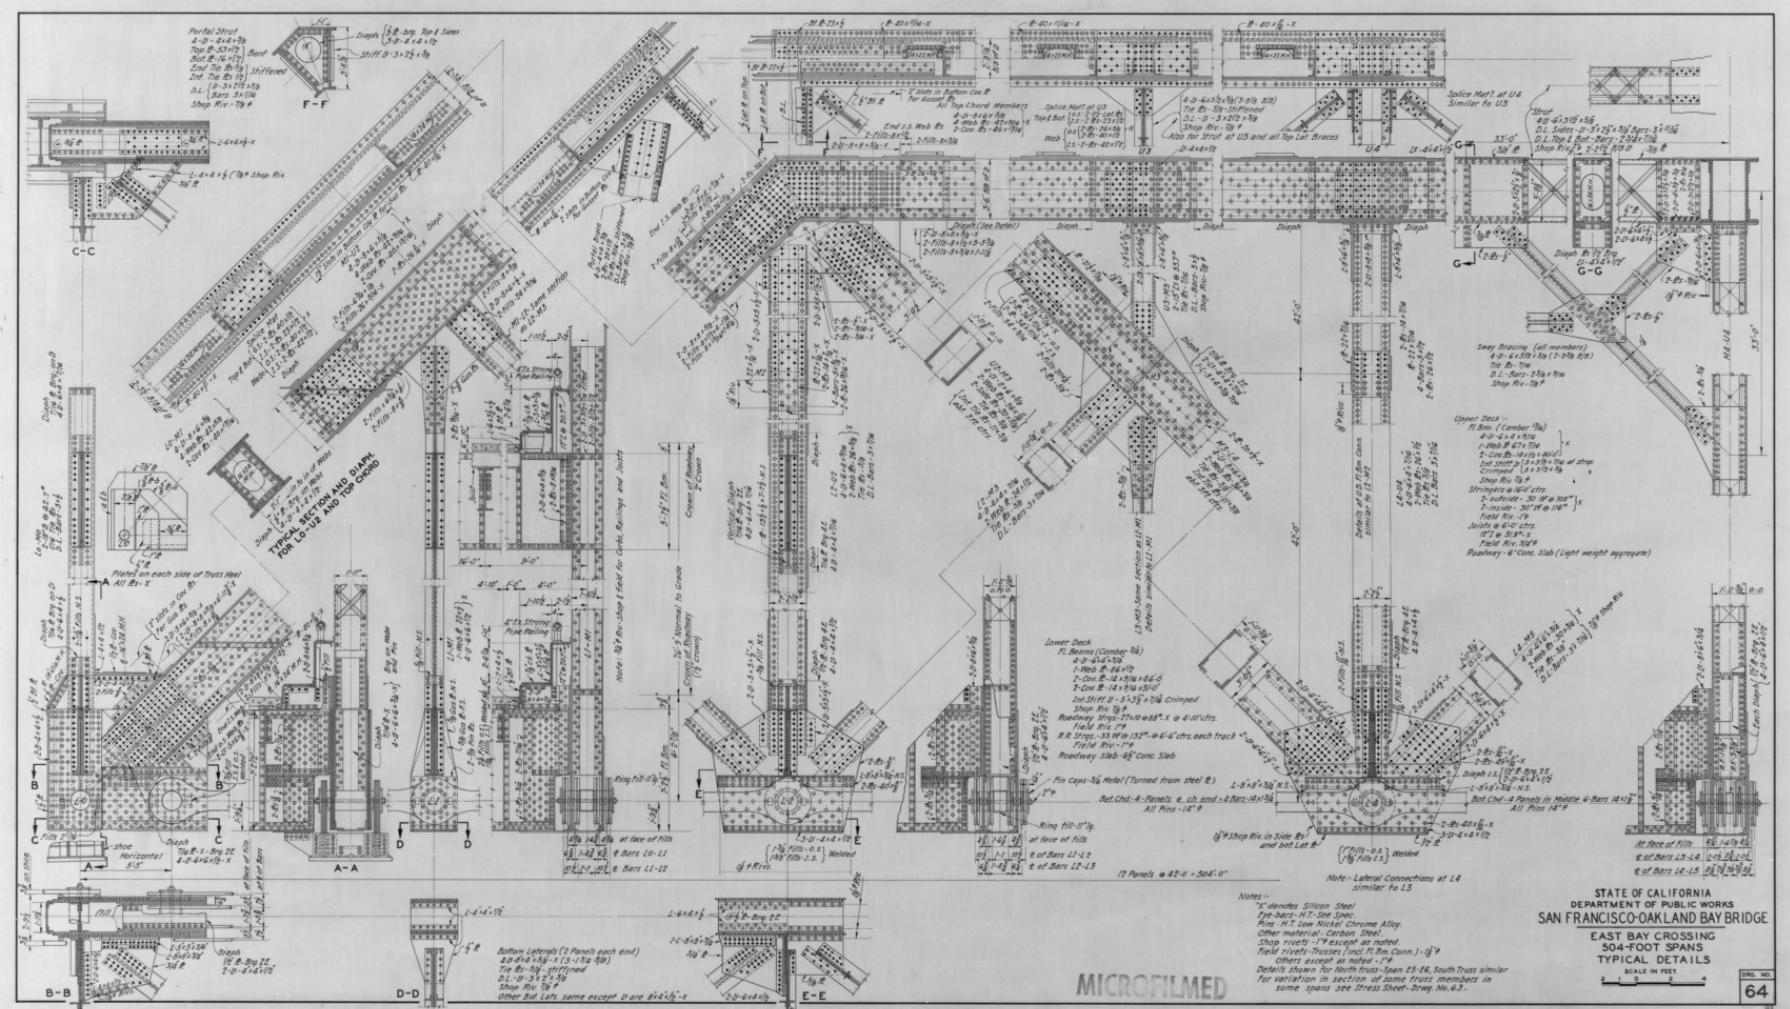


MICROFILMED

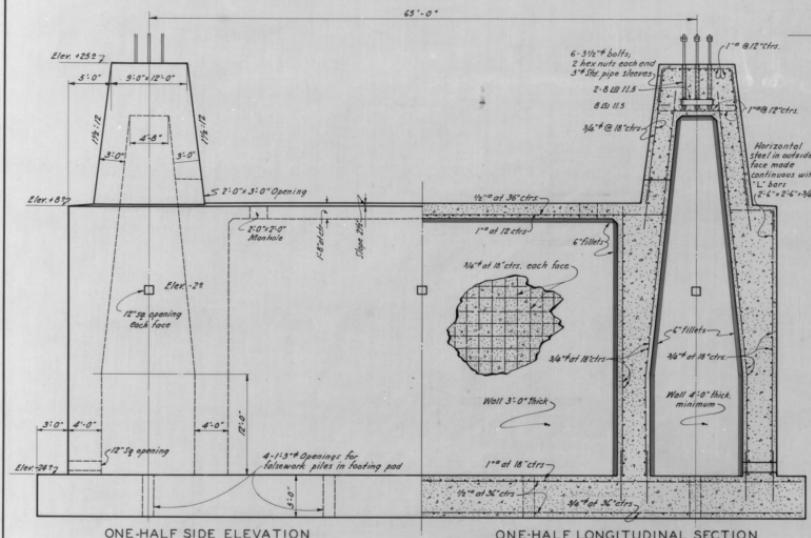

ONE-HALF SIDE ELEVATION

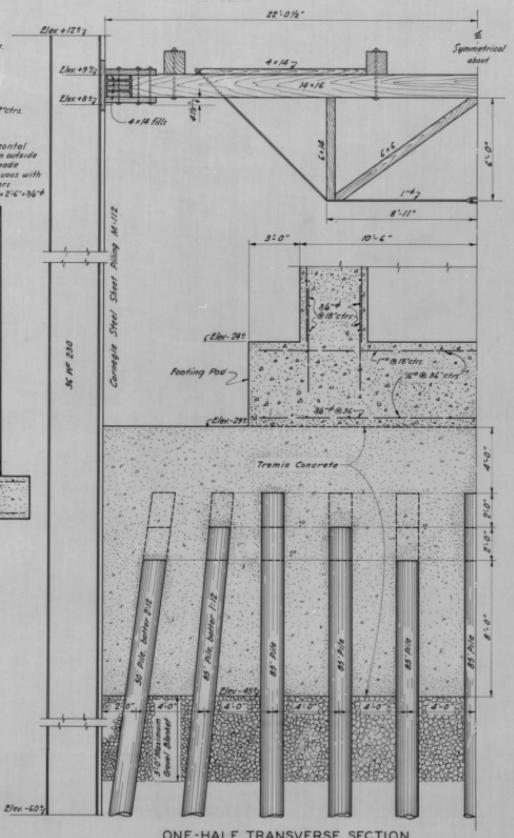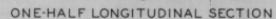

ONE-HALF TRANSVERSE SECTION

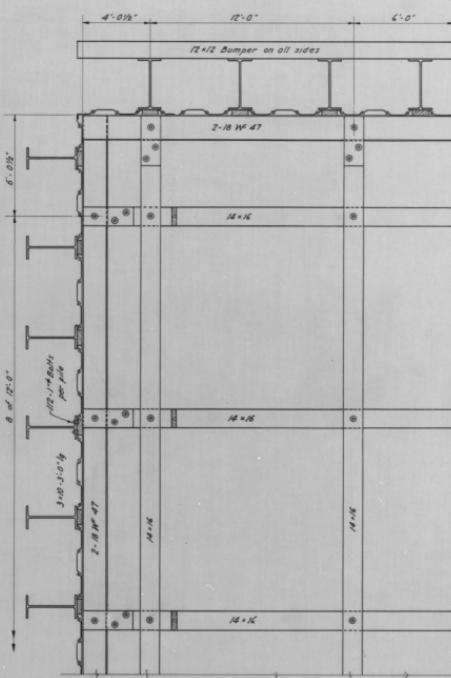


## PART PLAN OF COFFERDAM


STATE OF CALIFORNIA  
DEPARTMENT OF PUBLIC WORKS  
SAN FRANCISCO OAKLAND BAY BRIDGE  
EAST BAY CROSSING  
PIER E-6 TO E-23  
TYPICAL DETAILS

**MICROFILMED**



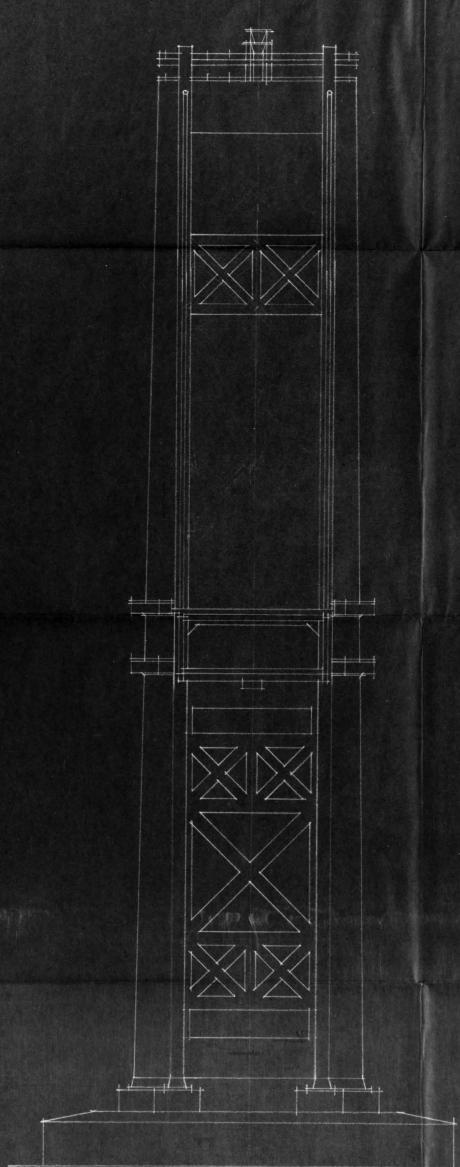

TOWERS № 3 & 5.

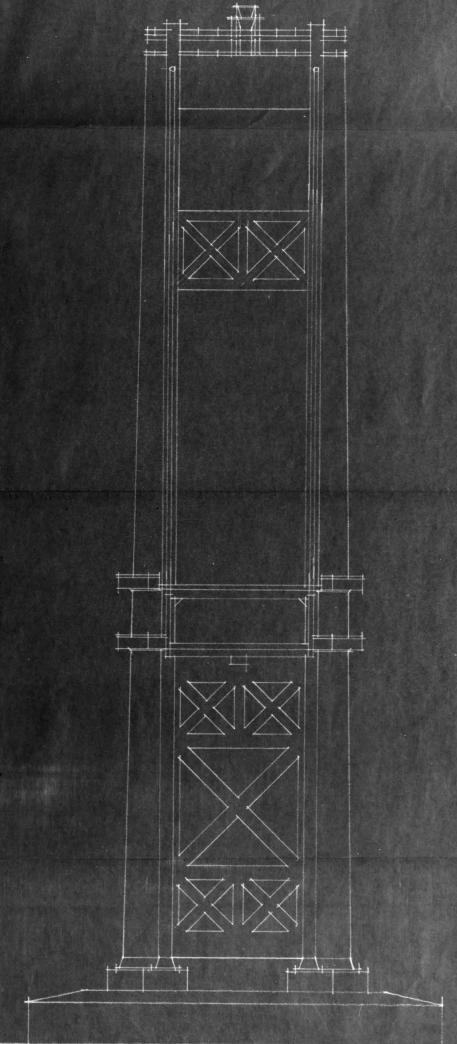


TOWERS № 2 & 6.


STUDY FOR SUSPENSION TOWERS.  
SAN FRANCISCO-OAKLAND BAY BRIDGE.  
TIMOTHY L. PFLUEGER, ARTHUR BROWN JR., JOHN J. DONOVAN,  
SCHEDE. CONSULTING ARCHITECTS. I.A.

OFFICE COPY


S. 1. 26. I.A.

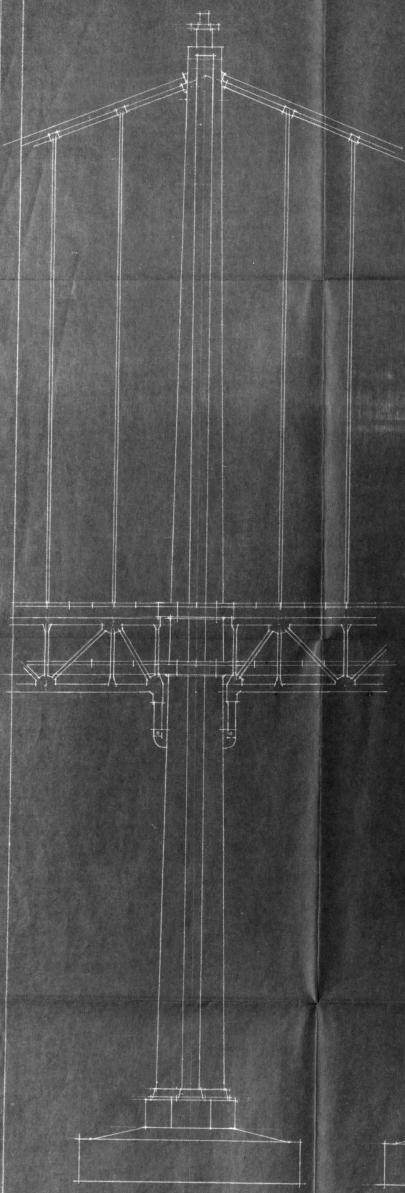




SIDE ELEVATION.

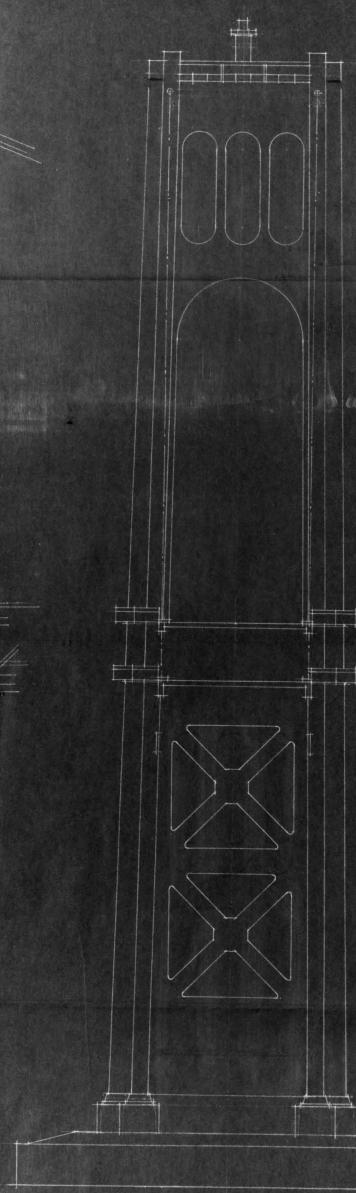

TOWERS № 3 & 5.

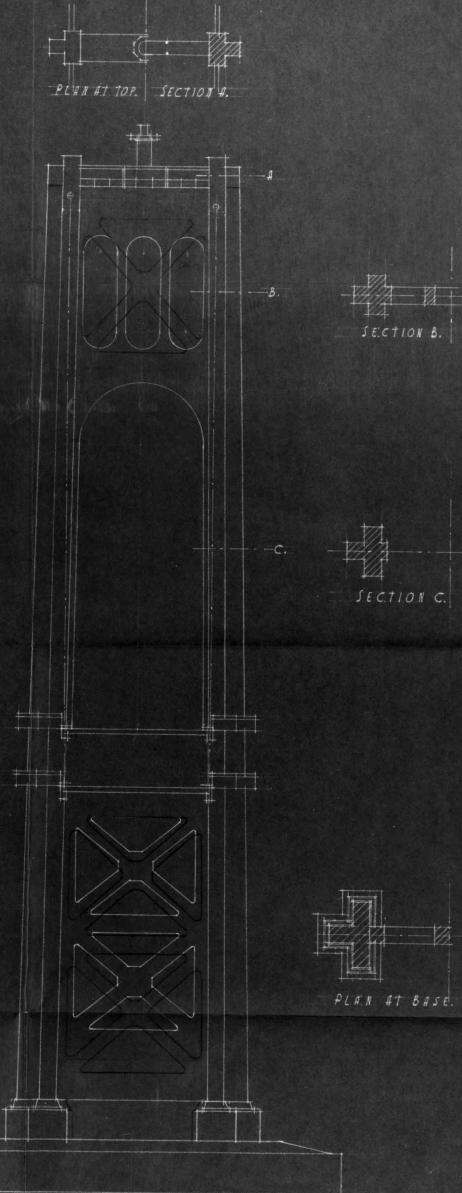

TOWERS № 2 & 6.

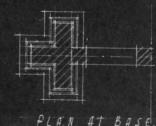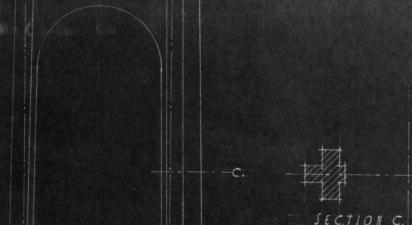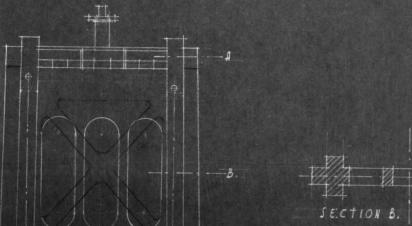

STUDY FOR SUSPENSION TOWERS.  
SAN FRANCISCO-OAKLAND BAY BRIDGE.  
OFFICE COPY


TIMOTHY L. PFLUEGER  
ARTHUR BROWN JR.  
JOHN J. DOKOVAN

BOARD OF  
CONSULTING ARCHITECTS


SCHEME.

(2)

Clarification -  
Additional Information

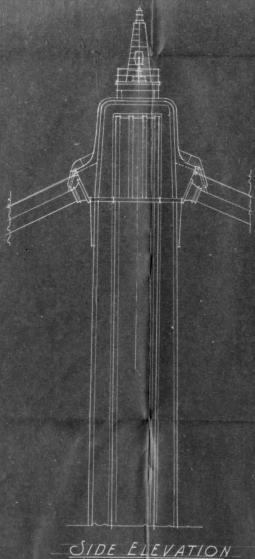

SIDE ELEVATION

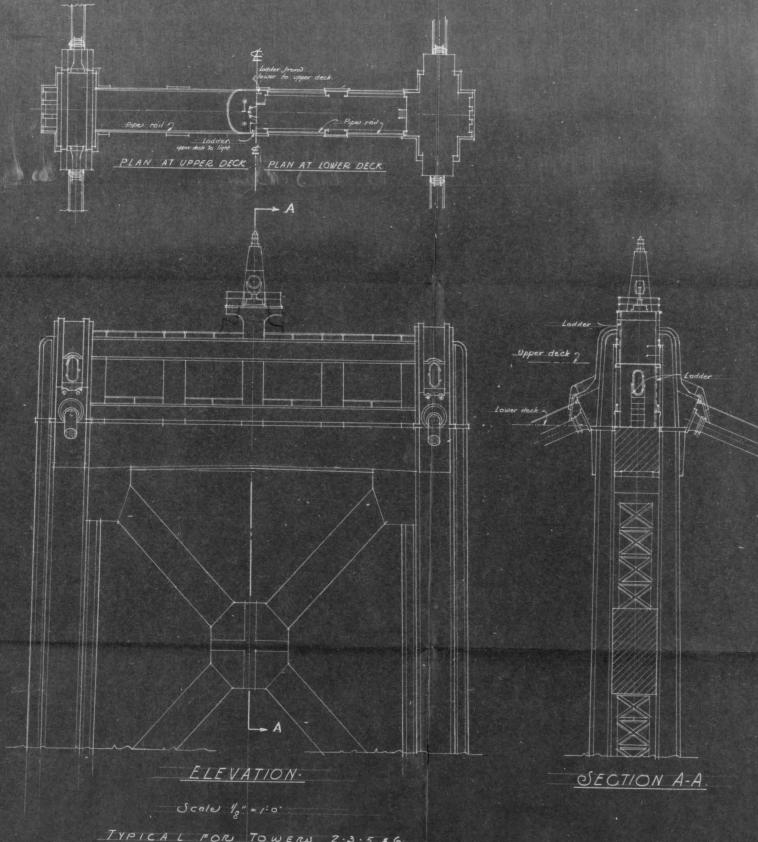


Scale 1" = 1:0  
TYPICAL TOWER 23-586

SECTION A-A


OFFICE COPY

STUDY FOR TOP-OF-SUSPENSION-TOWERS  
SAN FRANCISCO-OAKLAND BAY BRIDGE


TIMOTHY L. PELLEGRIN,  
ARTHUR BROWN JR., BOARD OF  
JOHN J. DONOVAN, CONSULTING ARCHITECTS  
7-A

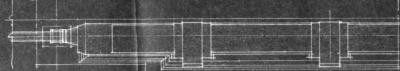


PART PLAN TOP DECK

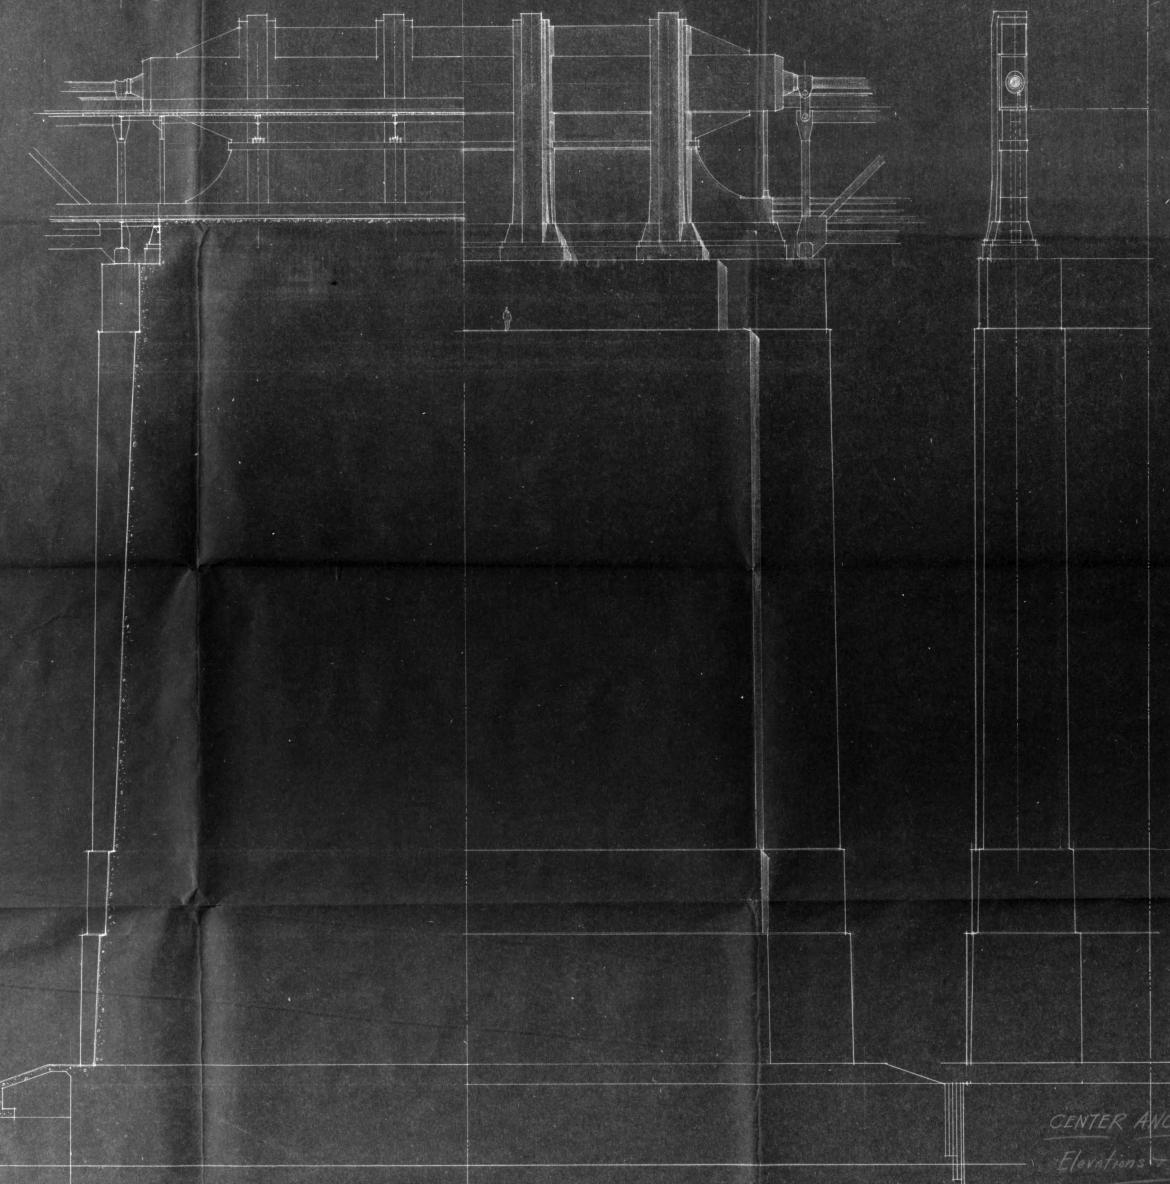

CENTER ANCHORAGE  
Elevations & Sections

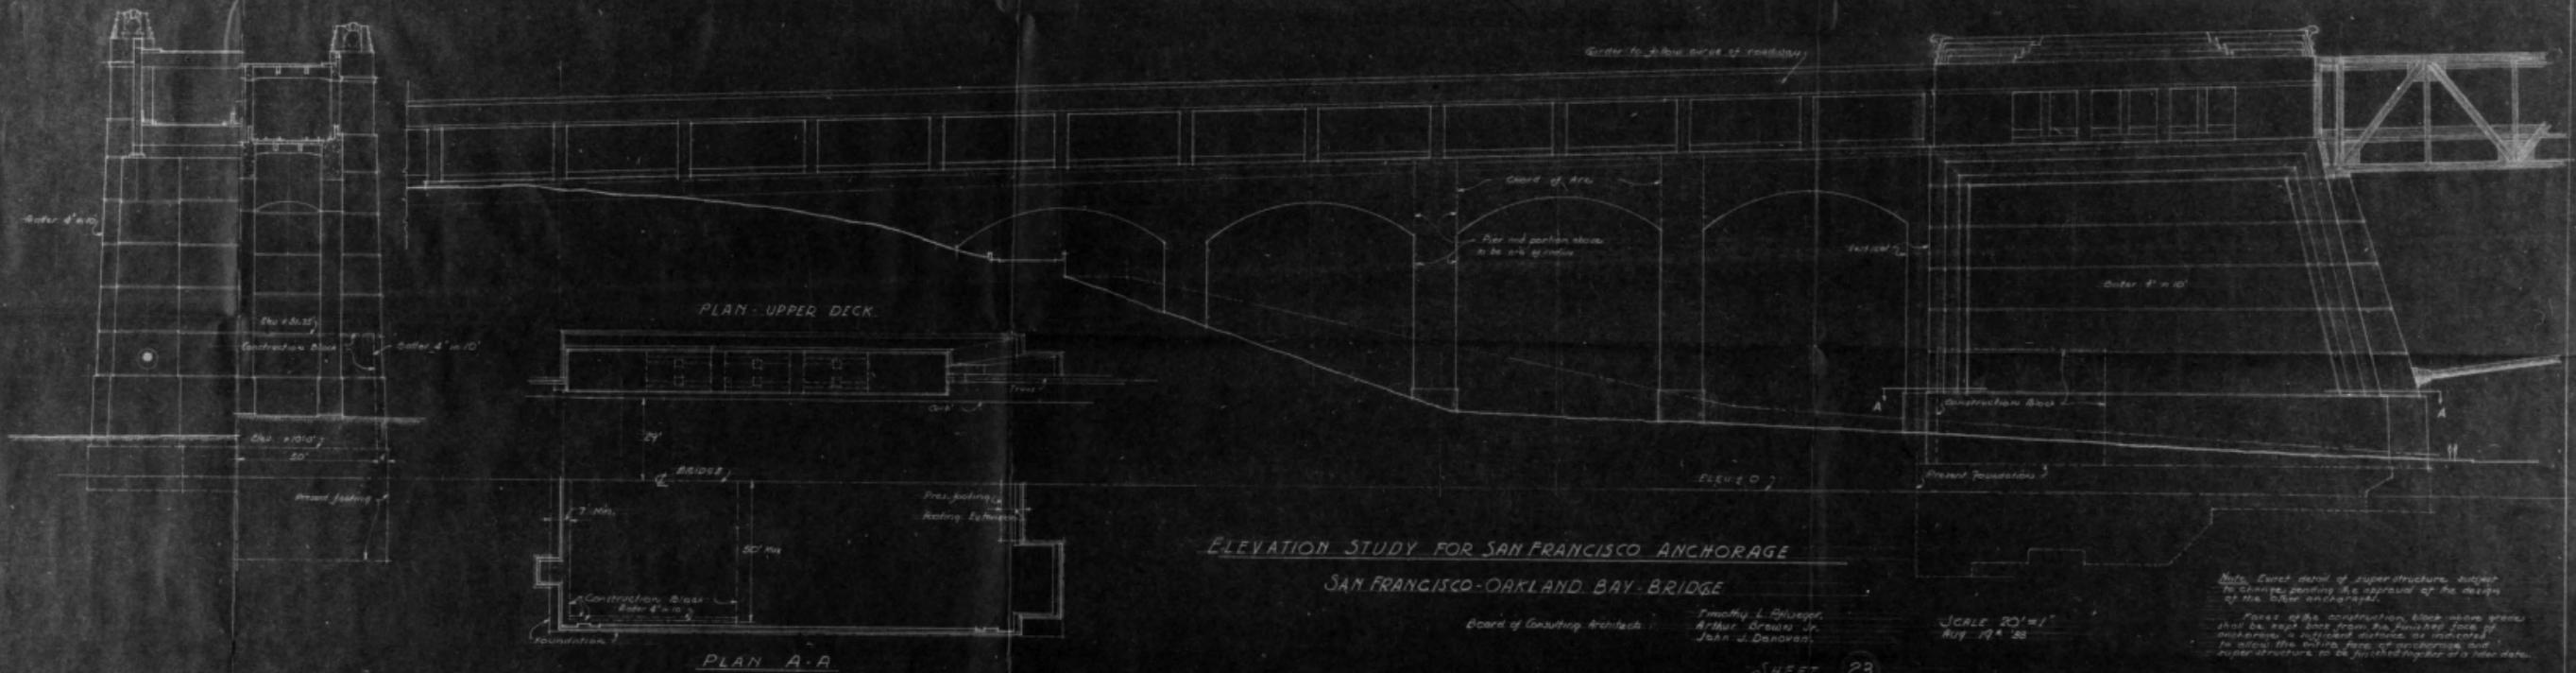

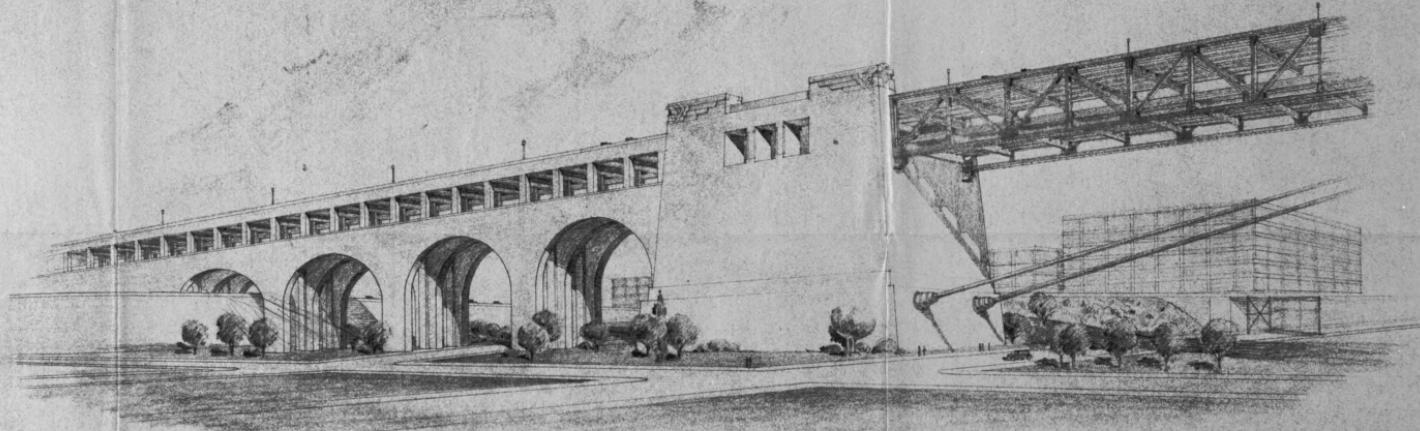


PERSPECTIVE STUDY OF SAN FRANCISCO ANCHORAGE  
SAN FRANCISCO-OAKLAND BAY BRIDGE


TIMOTHY L. PFLEUGER,  
ARTHUR BROWN JR.,  
JOHN J. DONOVAN  
BOARD OF  
CONSULTING ARCHITECTS.

JULY 11, 1933


SHEET 12

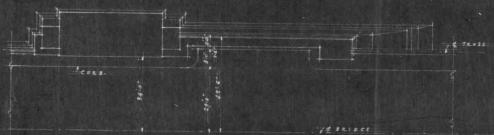

1/2 PLAN OF UPPER DECK AT ANCHOR.

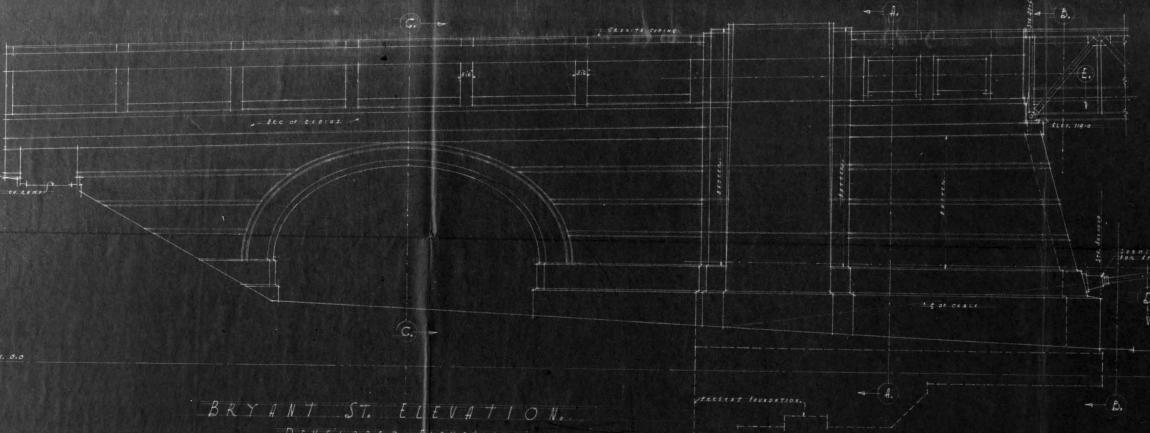

BRYANT ST. ELEVATION.  
DEVELOPED ELEVATION.

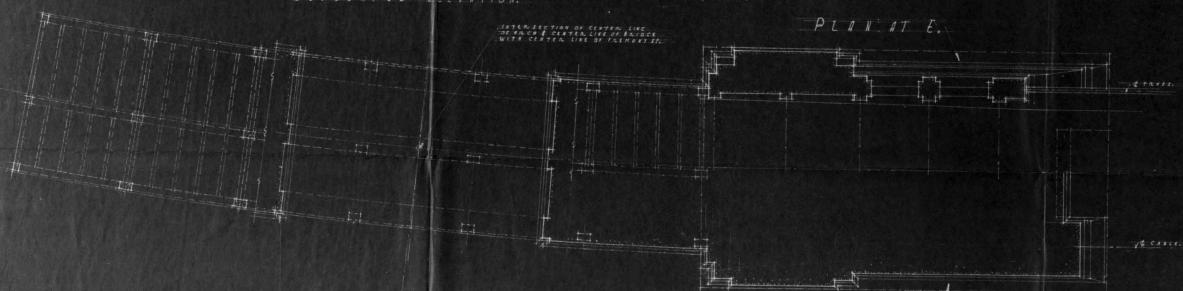

PLAN OF UPPER DECK BEAMS. PLAN THRU IRCH.

PLAN AT D.

NOTES.


ENGINEERING DESIGN SHOWING ARCHITECTURAL FEATURES  
FOR APPROVAL BY THE BOARD OF CONSERVING ARCHITECTURE  
IN CONNECTION WITH THE CONSTRUCTION OF THE SAN FRANCISCO-OAKLAND  
BRIDGE.

SECTION C-C.

SAN FRANCISCO-OAKLAND BAY BRIDGE,  
STUDY FOR SAN FRANCISCO ANCHORAGE,  
SCALE 1/4 INCH = 100 FEET.


TOMMY L. PELLEGRA, LEONARD BROWN JR., BOARD OF CONSULTING  
JOSE J. DODD, ARCHITECTS. DEPT. OF HIGHWAYS. SECT. NO. 26



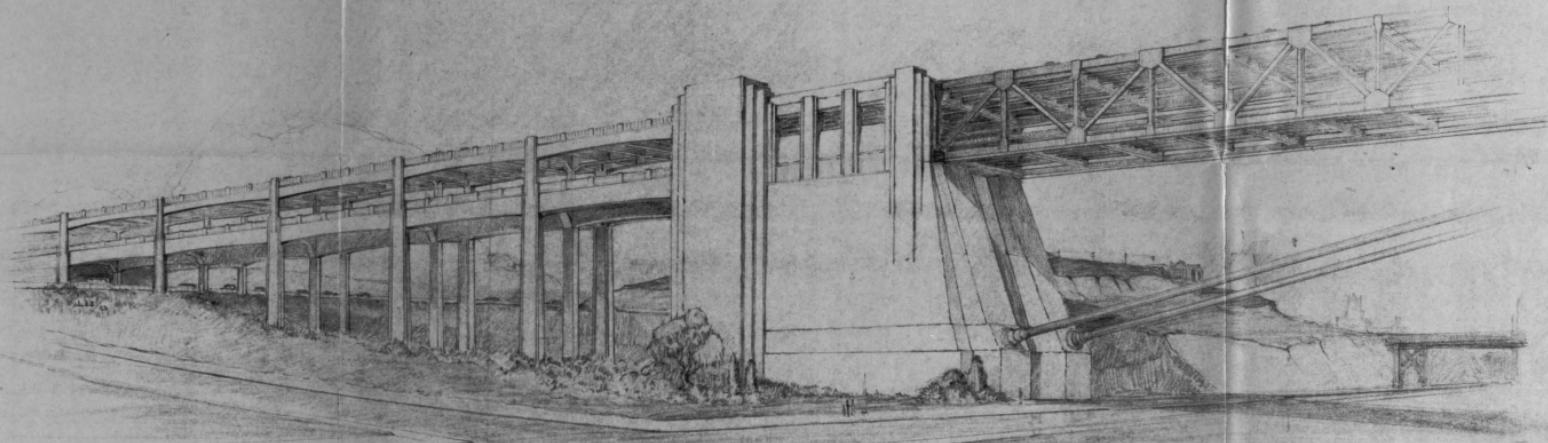


SAN FRANCISCO ANCHORAGE  
SAN FRANCISCO OAKLAND BAY BRIDGE


"A"

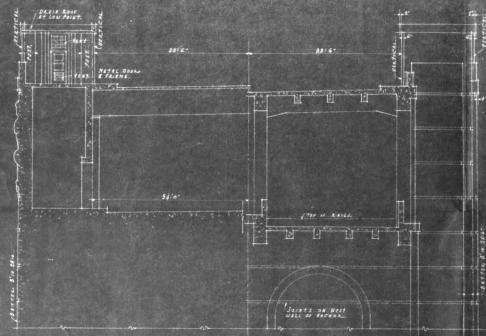


SECTION B-B.

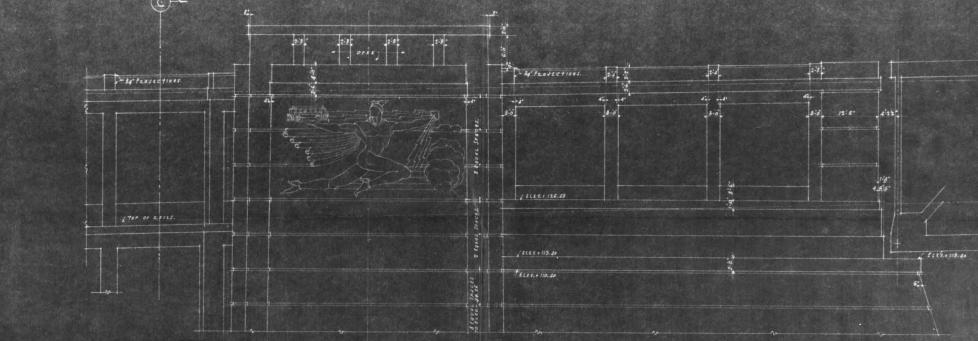

SECTION C-C.

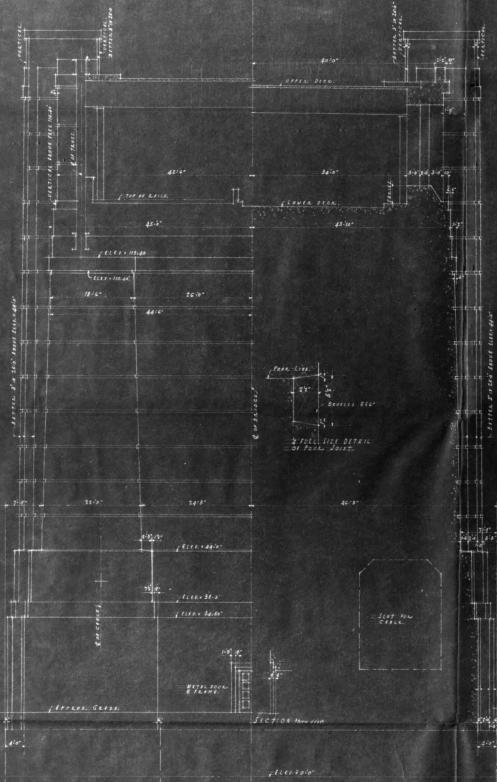

ELEVATION OF EAST END.

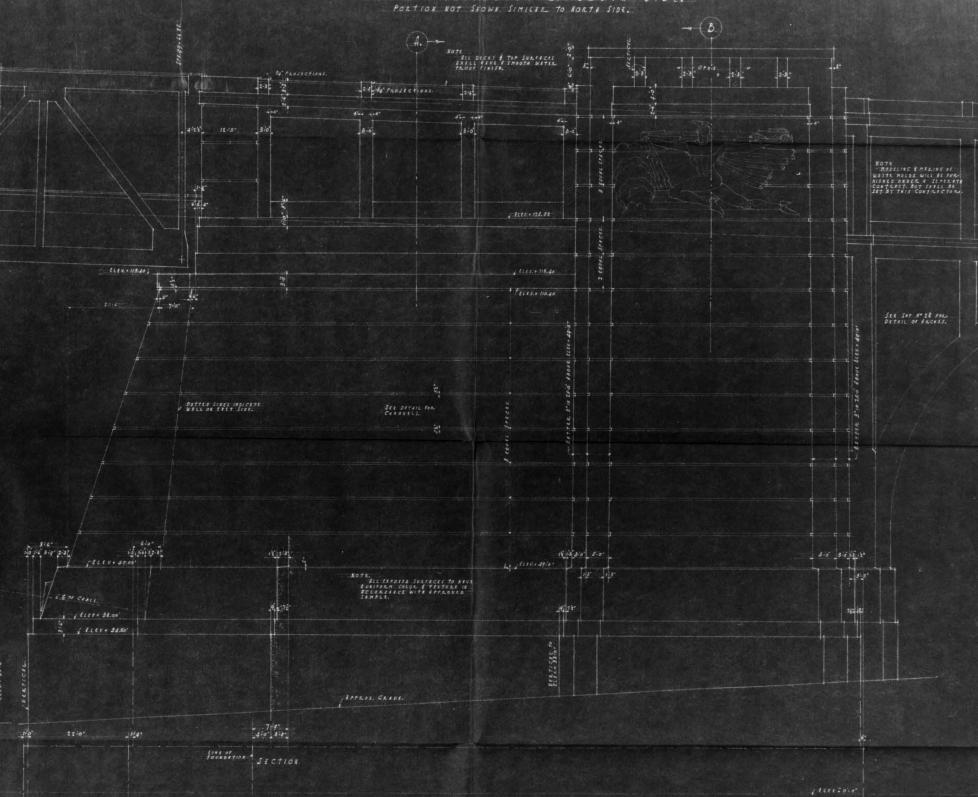


SECTION A-A.

ELEVATION OF NORTH SIDE.

8 SCALE DETAIL STUDY OF S.E. ANCHORAGE.  
SAN FRANCISCO-OAKLAND BAY BRIDGE.  
TOMMY L. PELLEGRINA  
ESTATE BROWN JR. BOARD OF CONSULTING ARCHITECTS  
JOHN J. BOYD JR.



MAY 1, 1958.

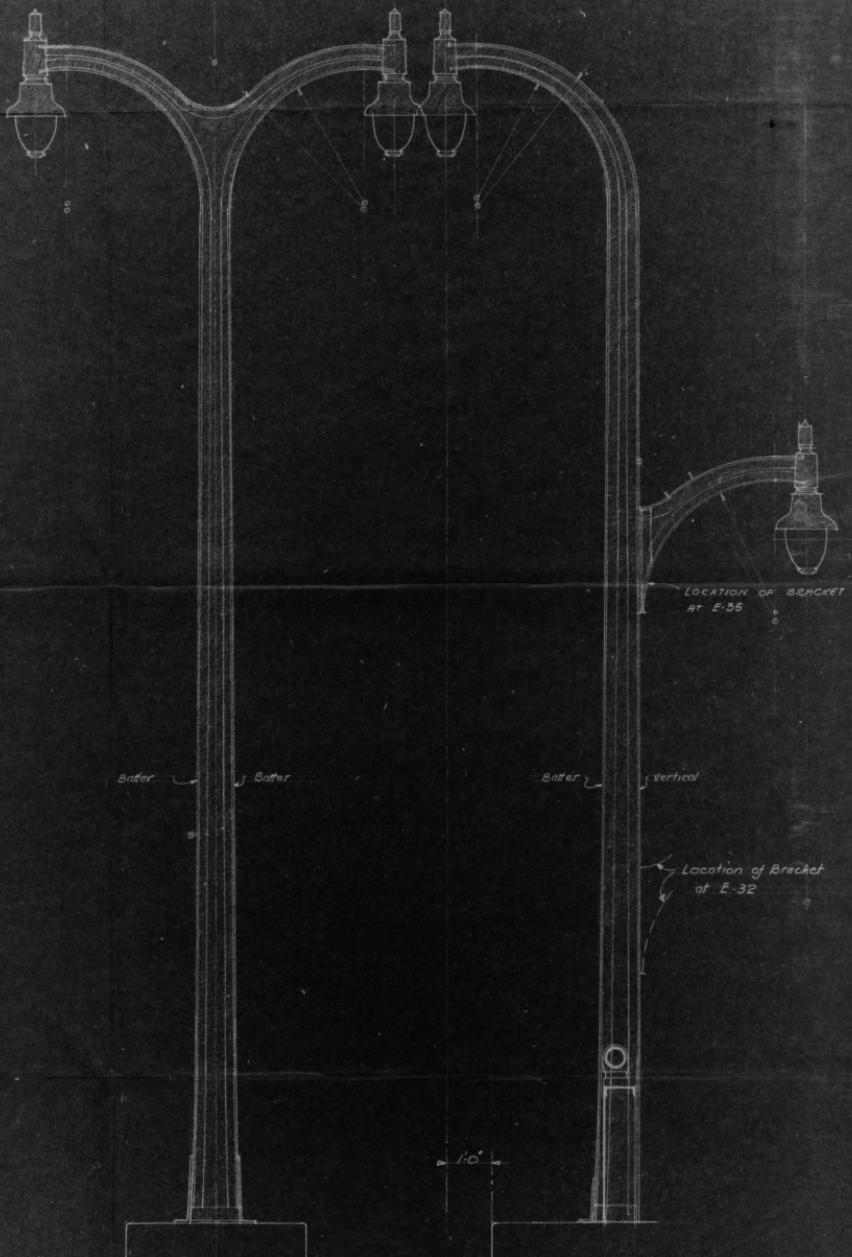

ELECTROLIERS BETWEEN E-39 AND  
TOLL PLAZA

ELECTROLIER AT E-35 & E-32

SAN FRANCISCO-OAKLAND BAY BRIDGE

SCALE  $\frac{3}{4}'' = 1'-0''$


Board of Consulting Architects  
T.L. Pfleuger  
Arthur Brown Jr.  
John J. Donavan

Dec. 22, 1933

DRAWING NO.


42

OFFICE COPY

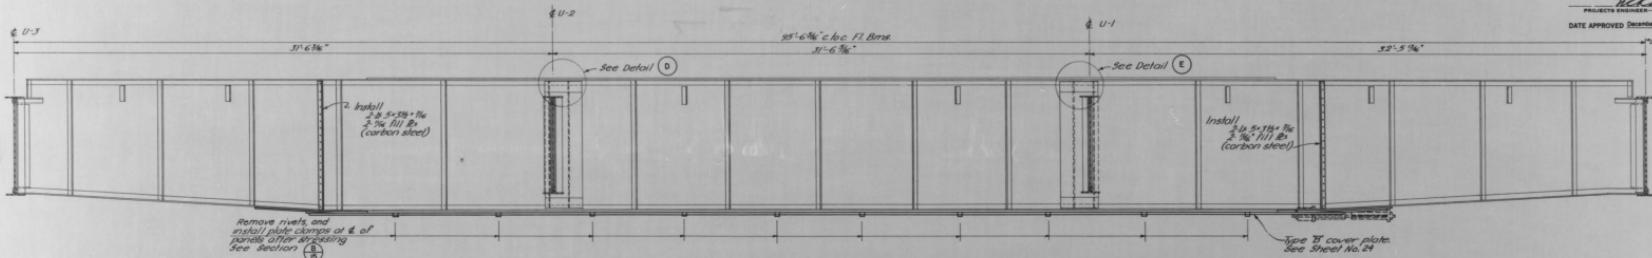

Remove rivets and  
install plate clamps or  $\frac{1}{2}$ "  
panels after stressing  
See Detail **D**


**ELEVATION G-1**  
(6-2 opposite hand)  
Scale:  $\frac{1}{16}$ " = 1'-0"

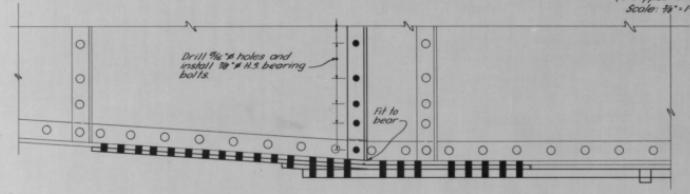

Drill  $\frac{1}{8}$ " holes and  
install 3/8" H.S.  
bearing bolts

**FIXED END OF COVER PLATE**


**PART ELEVATION**

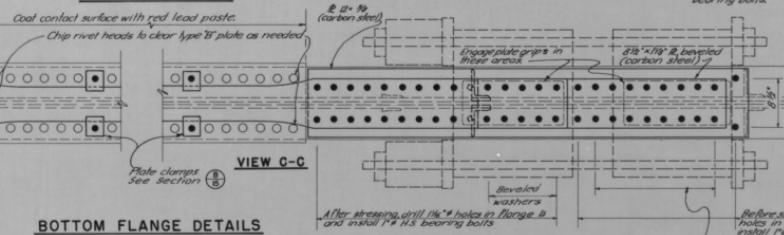

**STRESSING END OF COVER PLATE**

**NOTES**

Use elevation procedure for type B plates (See sheet No. 18) except use assembly shear, or similar, in lieu of flange grip.  
2 Longitudinal girders to be strengthened  
after floor beams U1 and U2.

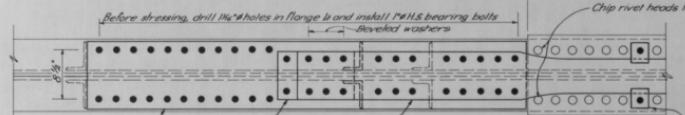


Before stressing, drill  $\frac{1}{8}$ " holes in flange B and install 1/2" H.S. bearing bolts

Bevelled washers

**VIEW B-B**

**BOTTOM FLANGE DETAILS**

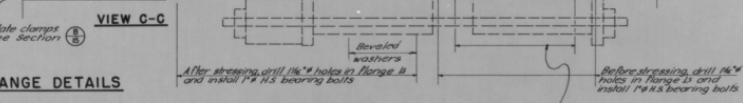


After stressing, drill  $\frac{1}{8}$ " holes in flange B and install 1/2" H.S. bearing bolts







Drill  $\frac{1}{8}$ " holes in flange B and temporarily attach plates and bearing plate grip sets for H.S. bearing plates. After stressing, remove bevelled plate grip sets and install 1/2" H.S. bearing bolts.

Before stressing, drill  $\frac{1}{8}$ " holes in flange B and install 1/2" H.S. bearing bolts

Bevelled washers

**DETAIL D** As shown  
**DETAIL E** Opposite hand

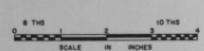

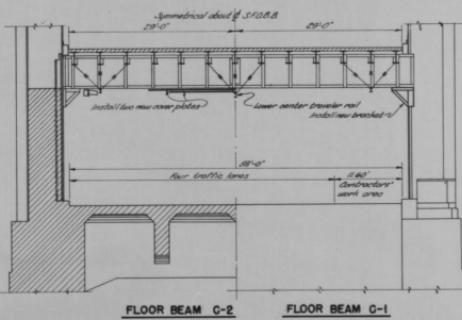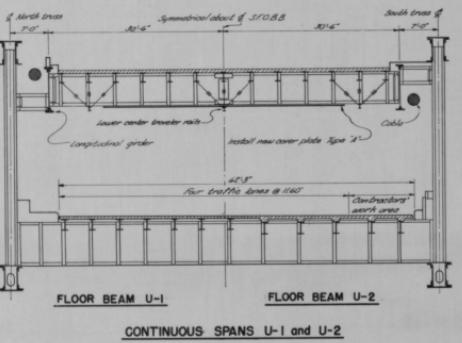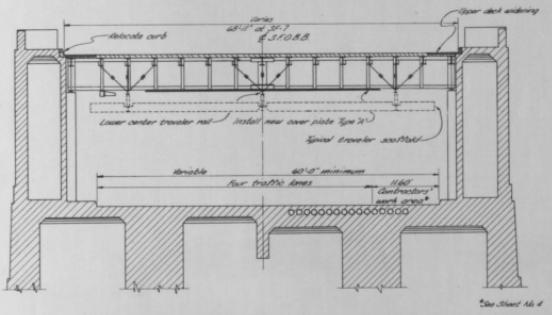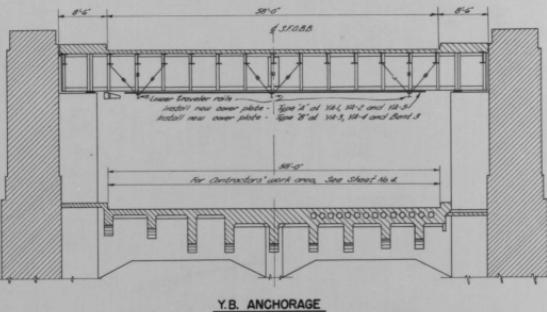
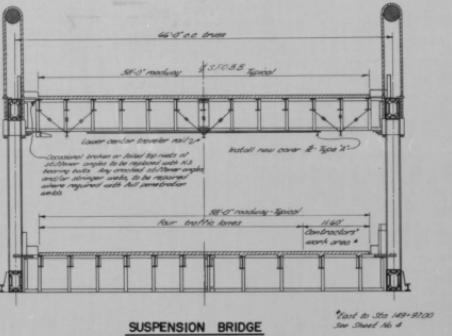
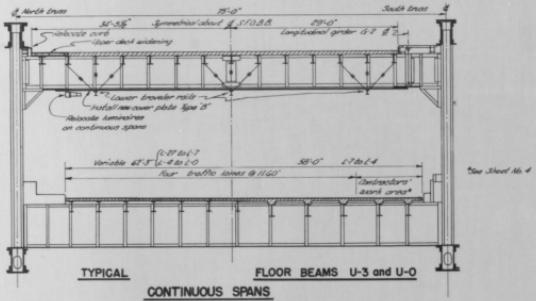


**PIER W-4**

8 THS      10 THS  
SCALE IN INCHES

E.C. 42		As built without revisions		E.C. 42	
MARK	DATE	DESCRIPTION	REVISION	BY	G.H.K.
				33-25	
				34-03	
				BRIDGE	
				34-04	
				SHEET NO. 5	
				DRAWING C-402B	

STATE OF CALIFORNIA  
DIVISION OF HIGHWAYS  
DIVISION OF SAN FRANCISCO BAY TOLL CROSSING  
**SAN FRANCISCO-OAKLAND BAY BRIDGE RECONSTRUCTION STEEL WORK - WEST BAY TYPICAL SECTIONS**

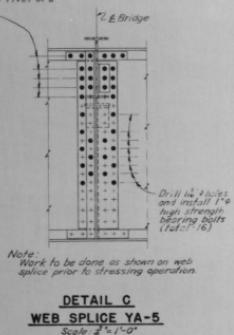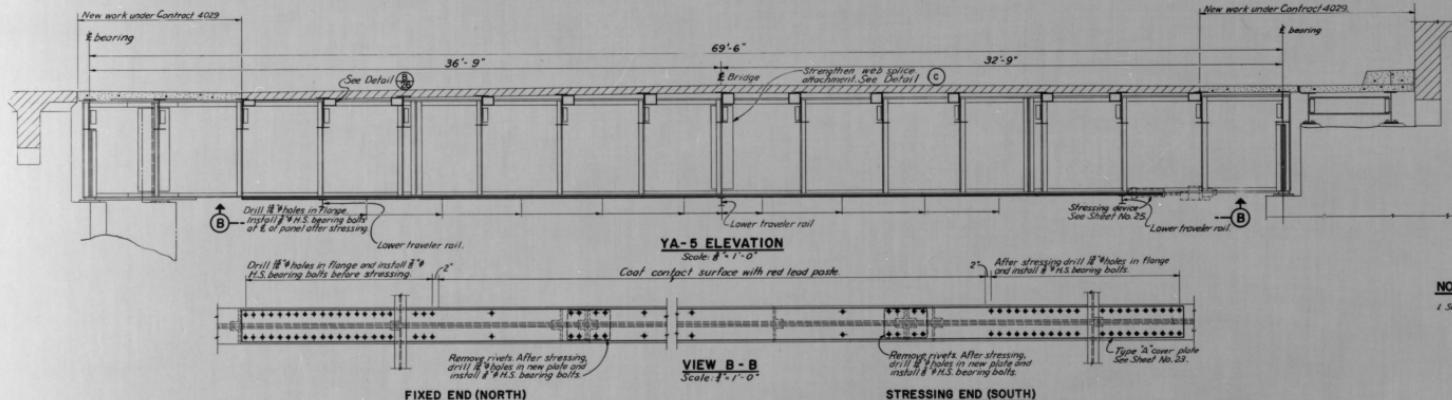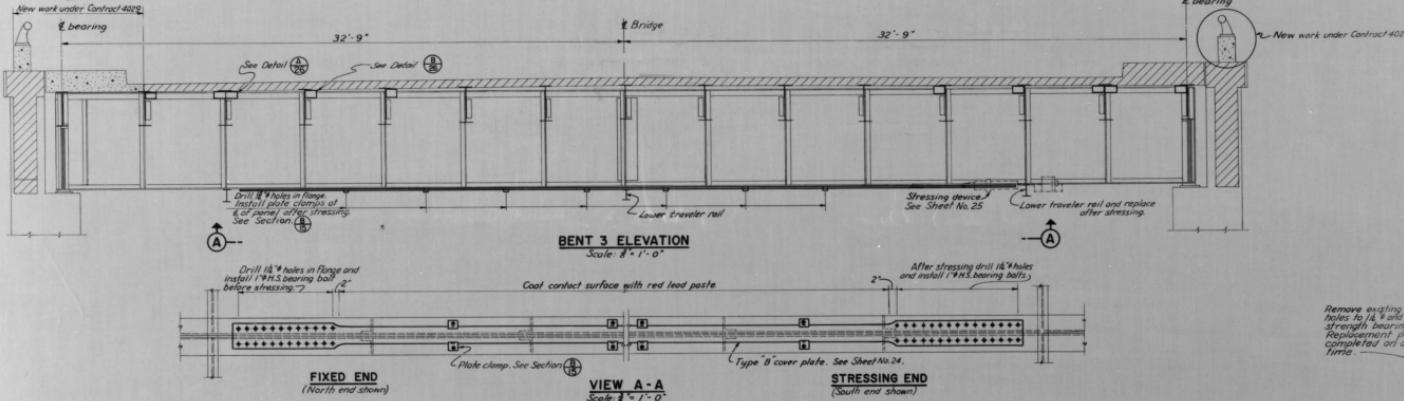

**NOTES:**

1. See Sheet No. 15 for erection procedure.

