


ELEVATION

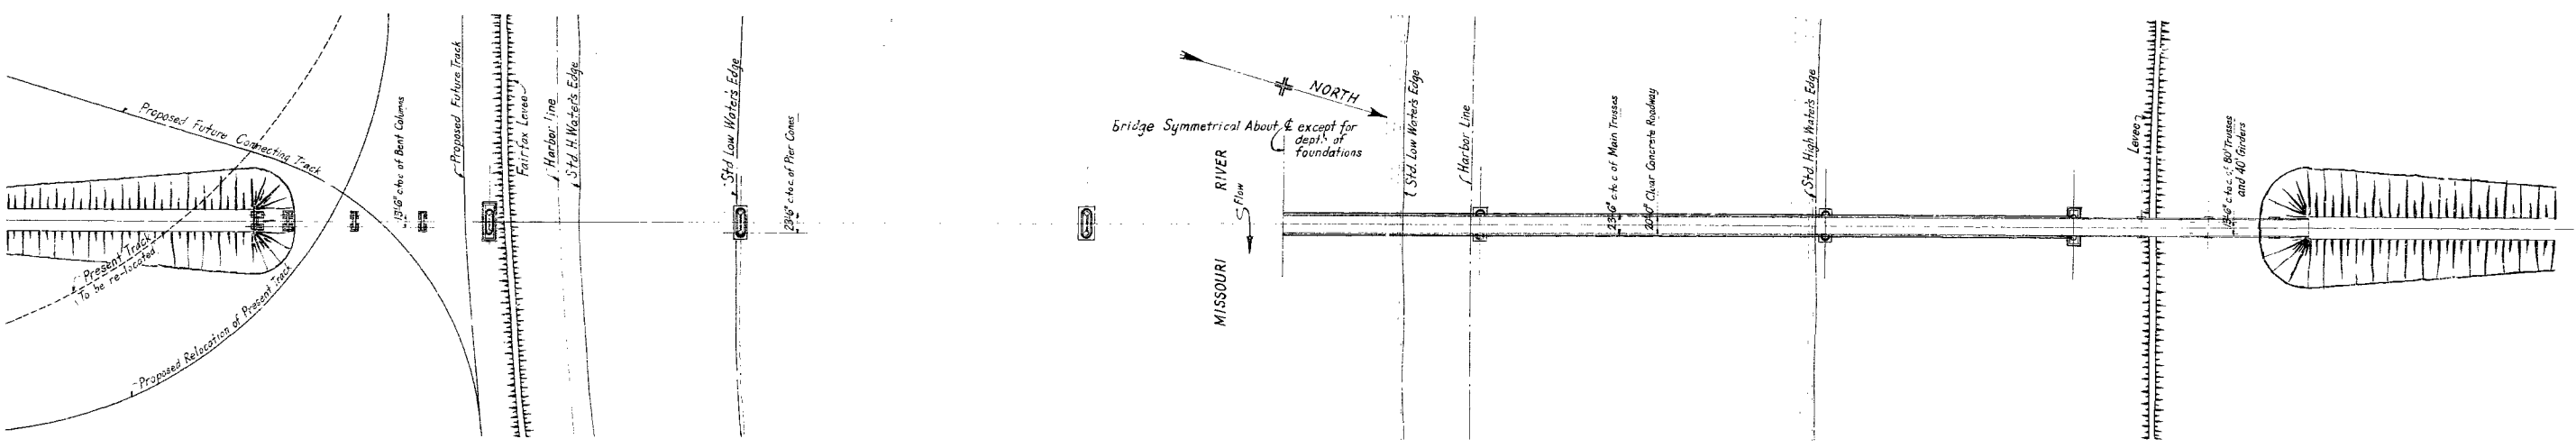

PLAN

GENERAL NOTES:

Concrete in Slab to have a minimum ultimate strength of 3750 pounds per square inch, as specified in the special provision of the Specifications. Concrete in Approach Bents and Abutments, in Pier Shafts, in working chambers of Caissons, in seal course and base of Piers 5 and 10 to be Class B Concrete in bases of Main Piers, except as called for above, to be Class C.

Before commencing construction, the contractor constructing the foundations for the Main Piers shall submit to the Engineers for approval, complete working details of the method he proposes to use. The method and details proposed shall be approved before construction of such foundations is begun.

Bevel exposed edges of all concrete work 3" where no other bevel is noted. Provide substantial keys at all concrete construction joints.

All piling shall be driven to support a load of not less than 25 Tons. No piling shall be ordered until authorized by the Engineer in writing. Piling in Piers 5 and 10 to be plain timber. All other piling to be creosoted.

Lap splices in reinforcing bars 48 diameters unless otherwise noted. Hooks on bars shall be bent to a diameter of not less than six times the diameter of the bar. Bars bent up, shall, unless otherwise noted, be bent to an angle of 45° with the bottom reinforcing, using a radius of bend of not less than four diameters.

INDEX

SHEET	TITLE
1	General Plan and Elevation.
2	Approach Substructure Details.
3	
4	Main Pier Details
5	Stress Sheet - Main Spans.
6	Main Span Structural Details L-1-L4.
7	" " " " L5-L10.
8	" " " " L11-L16.
9	" " " " L17-L22.
10	" " " " Cross Sections.
11	300 Ft. Span " "
12	Expansion and Handrail Details.
13	Structural Details-Approach Spans.
14	Details of Shoes
15	Anchor Bolt Diagram.
SUPP. SHEETS	
16	Detail of Bridger Name Plate.
17	Reinforcing S. Details - Slab & Curb.

PLATTE CO. K-456
RTE. 69

**BRIDGE OVER MISSOURI RIVER
AT KANSAS CITY KANSAS**

FOR REGIONAL BRIDGE CO. INC.

GENERAL PLAN AND ELEVATION



SVERDRUP AND PARCEL
CONSULTING ENGINEERS
ST. LOUIS, MO.

Made by C.E.S. March 1931
Traced by J.H.J. May 1932
Checked by J.H.J. May 1932

FINISHED

SHEET NO. 1


Revision July 1933. Final expansion joints, raised and supported apart.

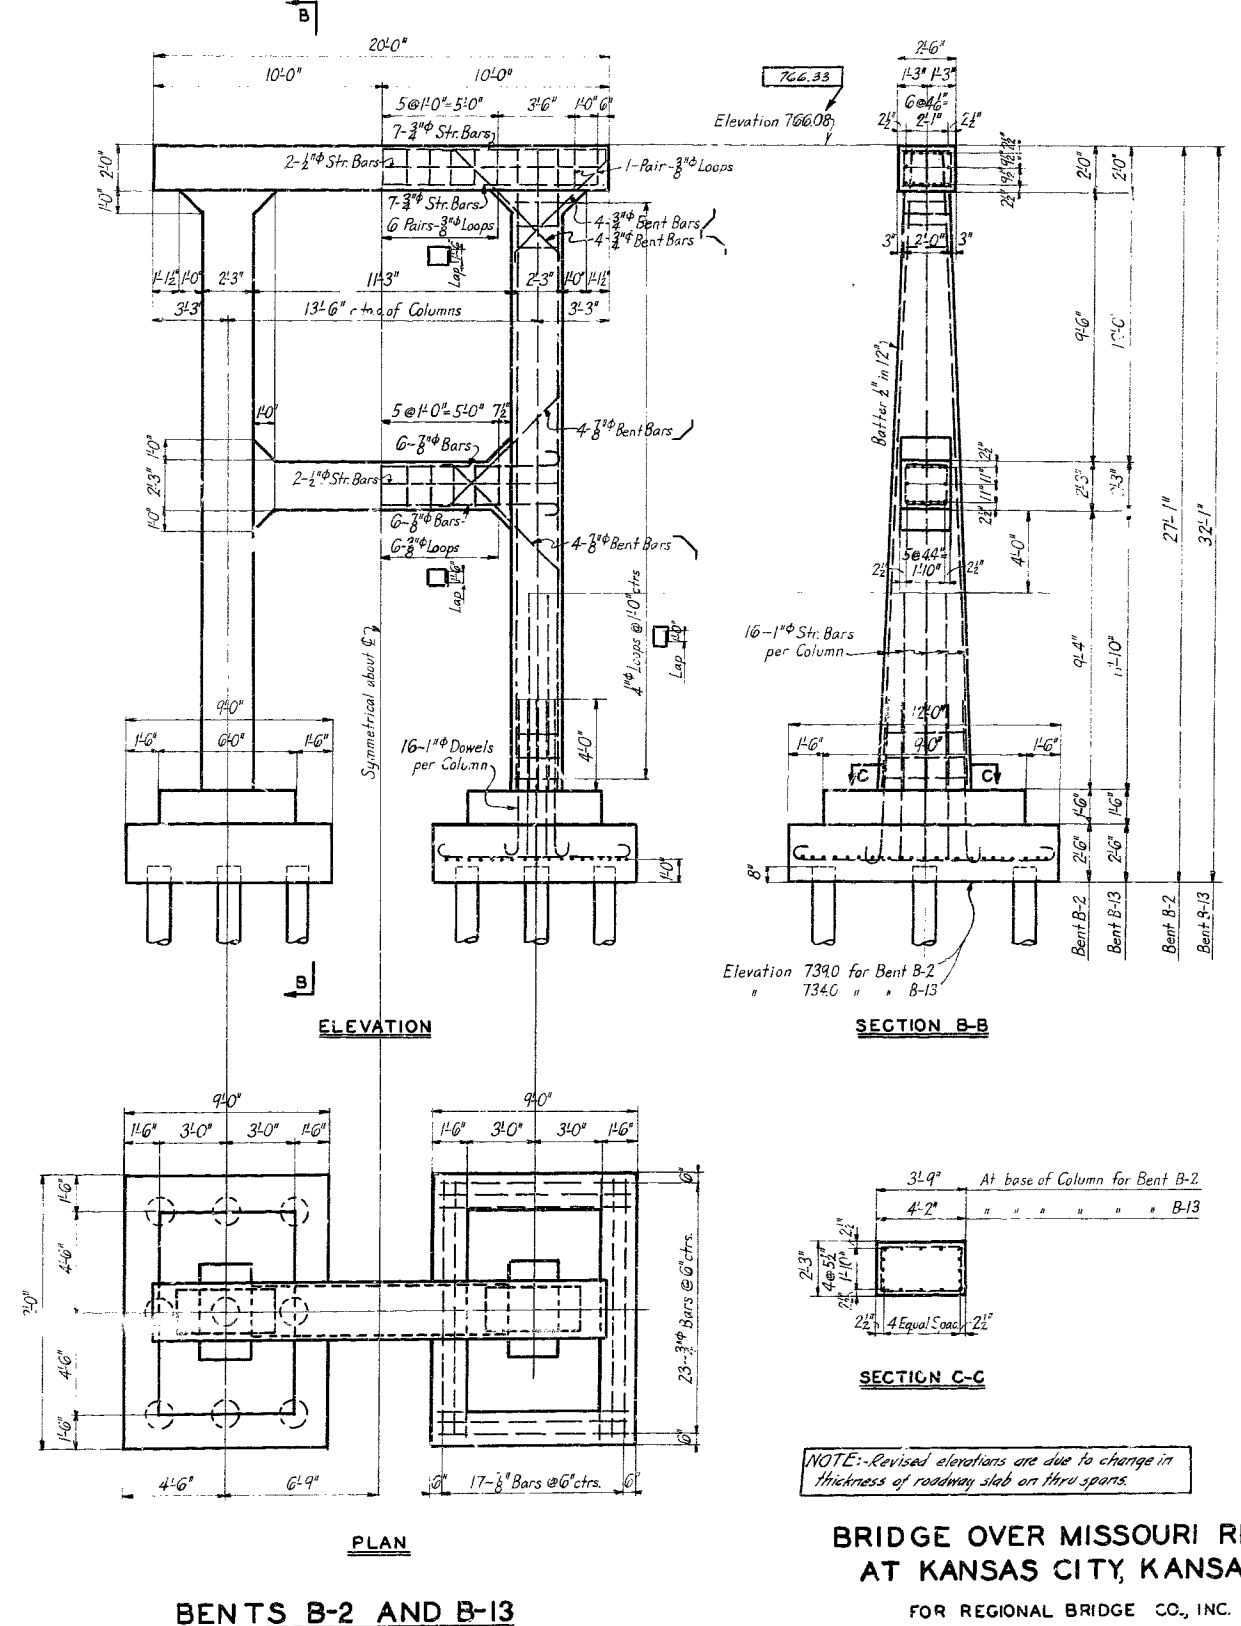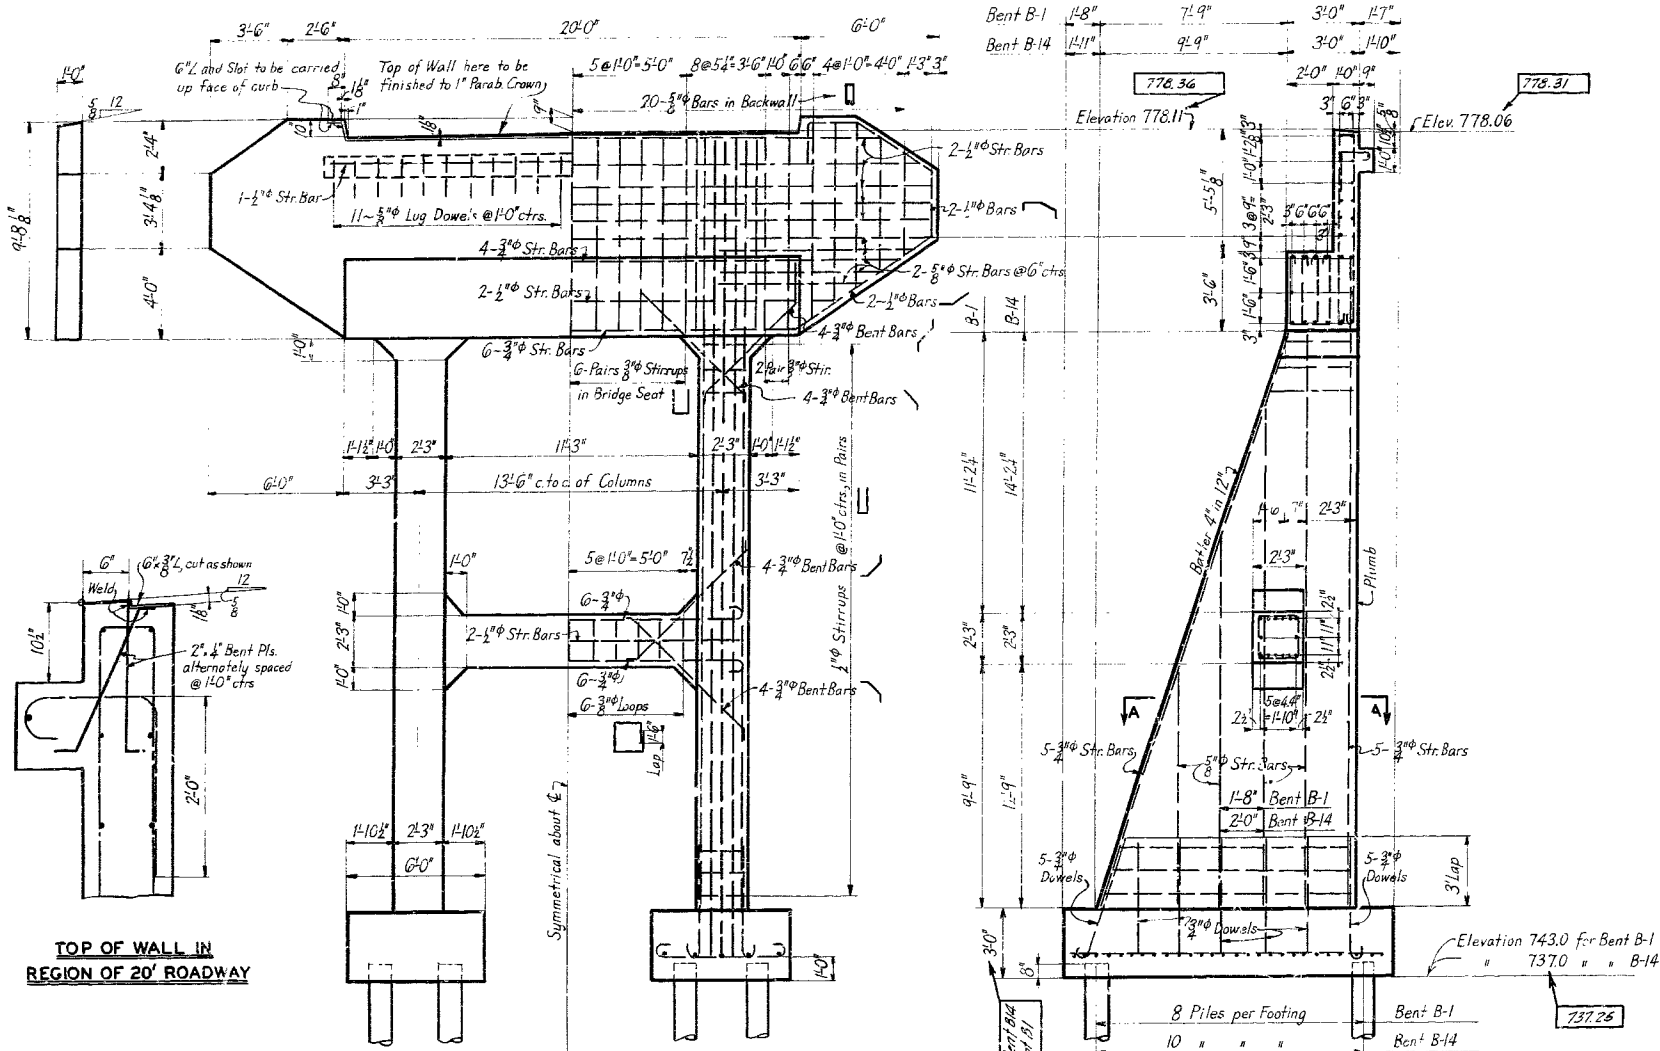

All Piles shown on this Sheet to be of Creosoted Timber - 35'-0" long.
 All Concrete " " " " " Class B.
 Expansion plates on Bents B-1 & B-14 included in the quantity item for Structural Steel.

NOTE:- Revised elevations are due to change in thickness of roadway slab on thru spans.


**BRIDGE OVER MISSOURI RIVER
 AT KANSAS CITY, KANSAS**
 FOR REGIONAL BRIDGE CO., INC.
 APPROACH SUBSTRUCTURE DETAIL.
 SVERDRUP AND PARCEL
 CONSULTING ENGINEERS
 ST. LOUIS, MO.
 Made by CES: April 1933
 Traced by L.F. ECES: May 1933
 Checked by J.A.T. May 1933

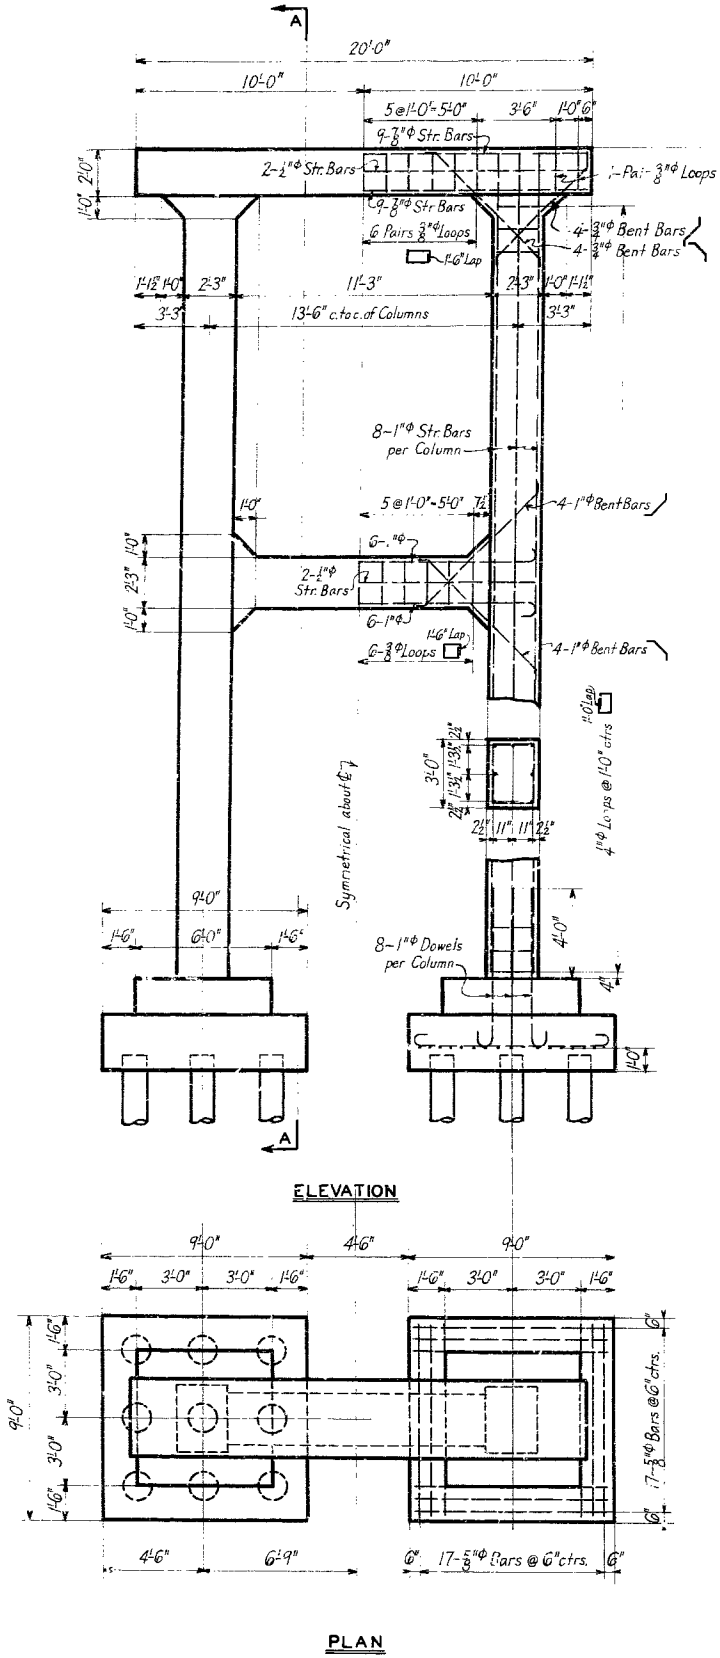

BENTS B-3, B-4, B-11 AND B-12

BENT	B-3	B-4	B-11	B-12
Elev. Top of Bent	770.06	774.16	774.16	770.08
Elev. Bottom Footing	734.00	739.00	734.00	734.00
Dimension A	3'-1"	3'-5"	4'-2"	3'-1"
" B	1'-6"	1'-6"	1'-6"	1'-6"
" C	1'-4"	1'-5"	1'-5"	1'-5"

Timber Piles in Rents above to be 35'-0" long - Creosoted.

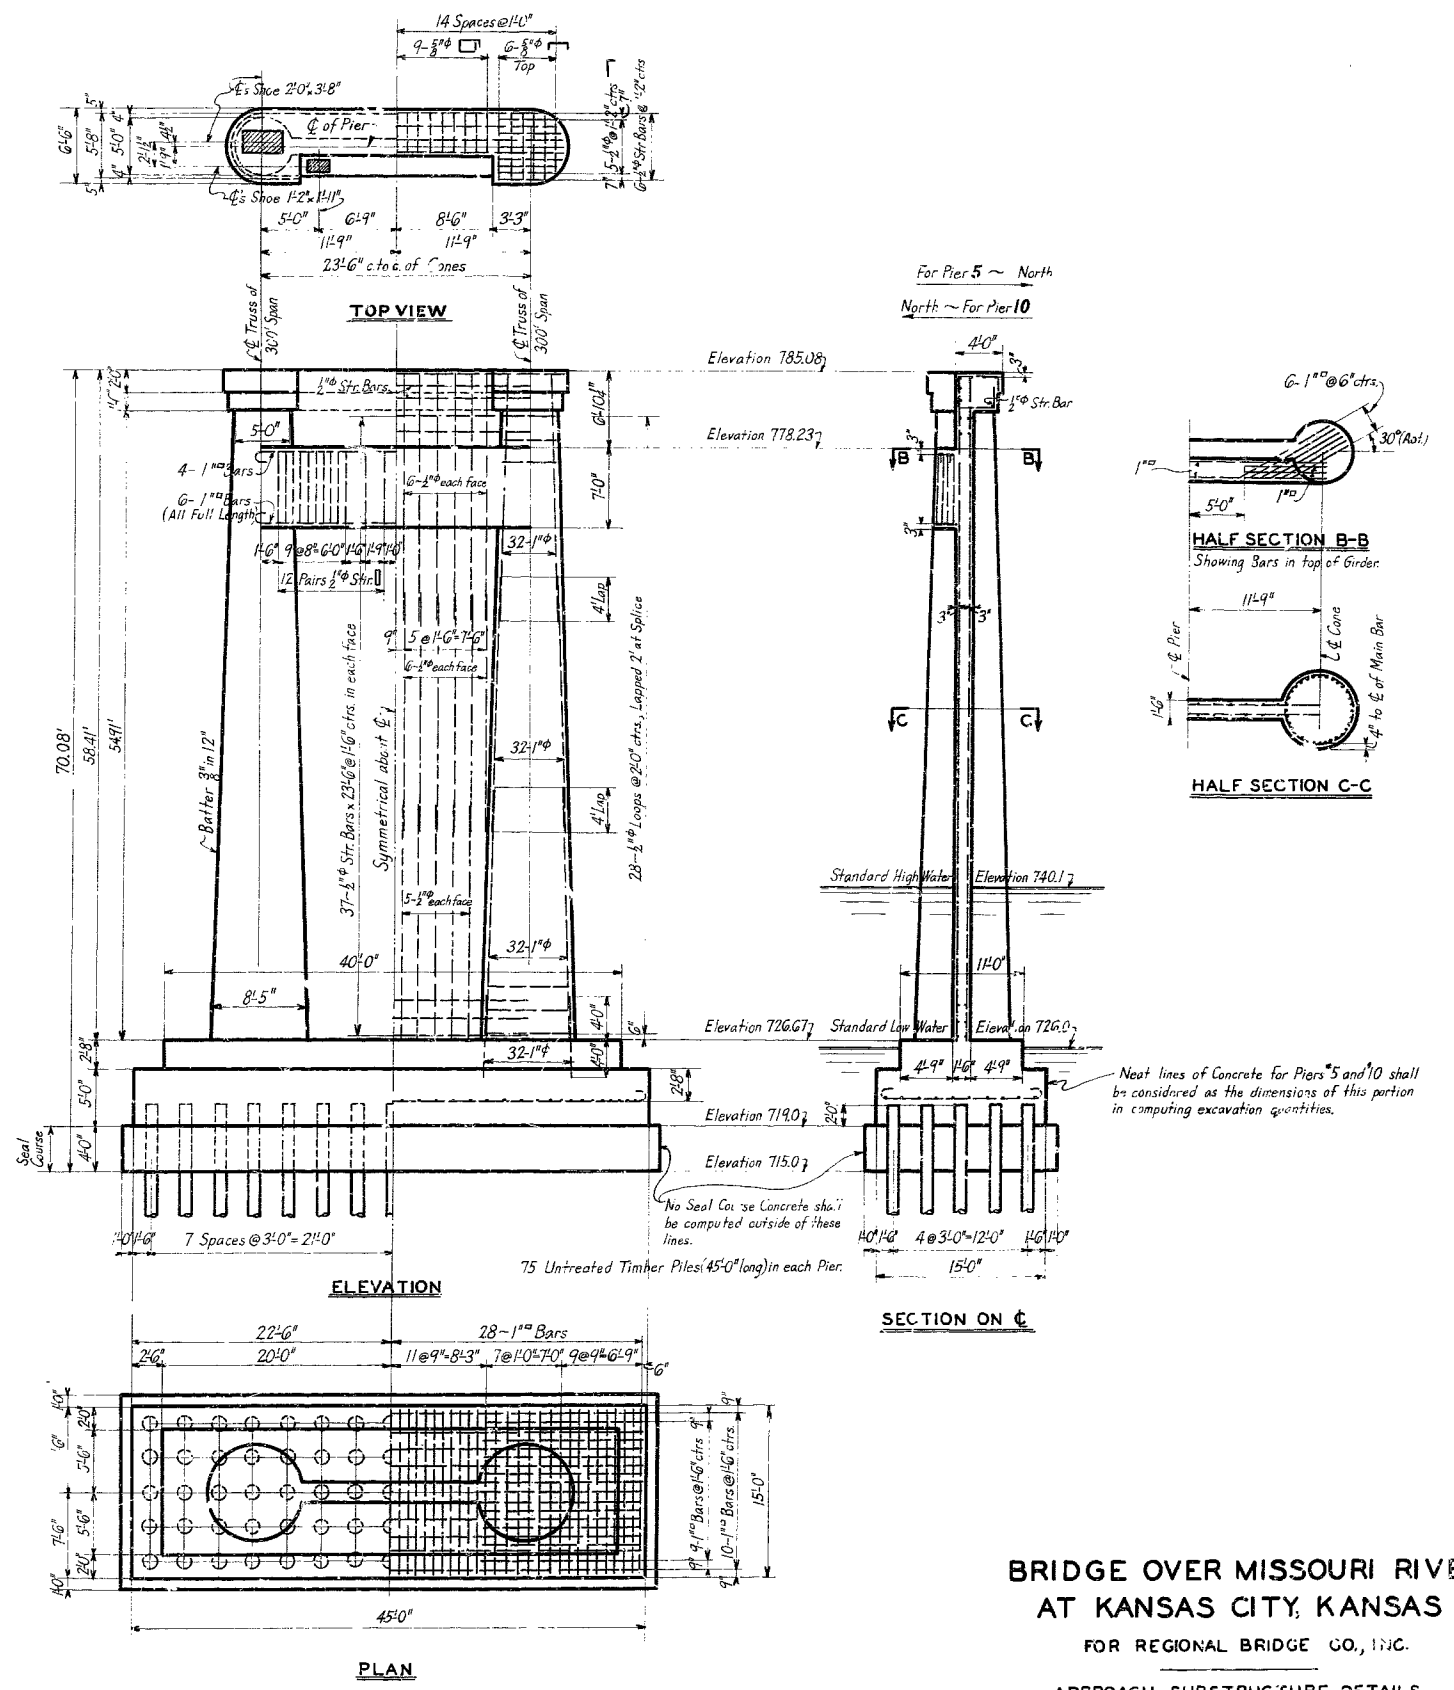


PIERS 5 AND 10

**BRIDGE OVER MISSOURI RIVER
AT KANSAS CITY, KANSAS**
FOR REGIONAL BRIDGE CO., INC.


APPROACH SUBSTRUCTURE DETAILS

SVERDRUP AND PARCEL
CONSULTING ENGINEERS
ST. LOUIS, MO.


Made by C.E.S. Jr April 1933
Traced by May 1933
Checked by J.R.J. May 1933

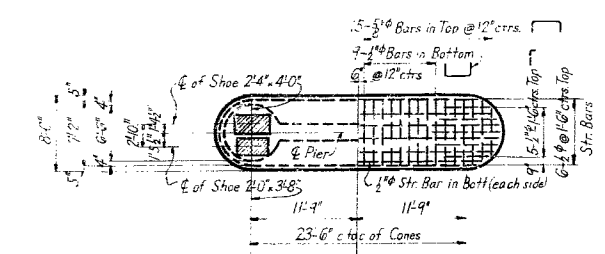

TOP VIEW

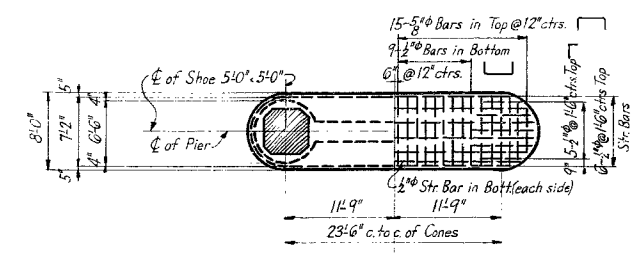


TOP VIEW

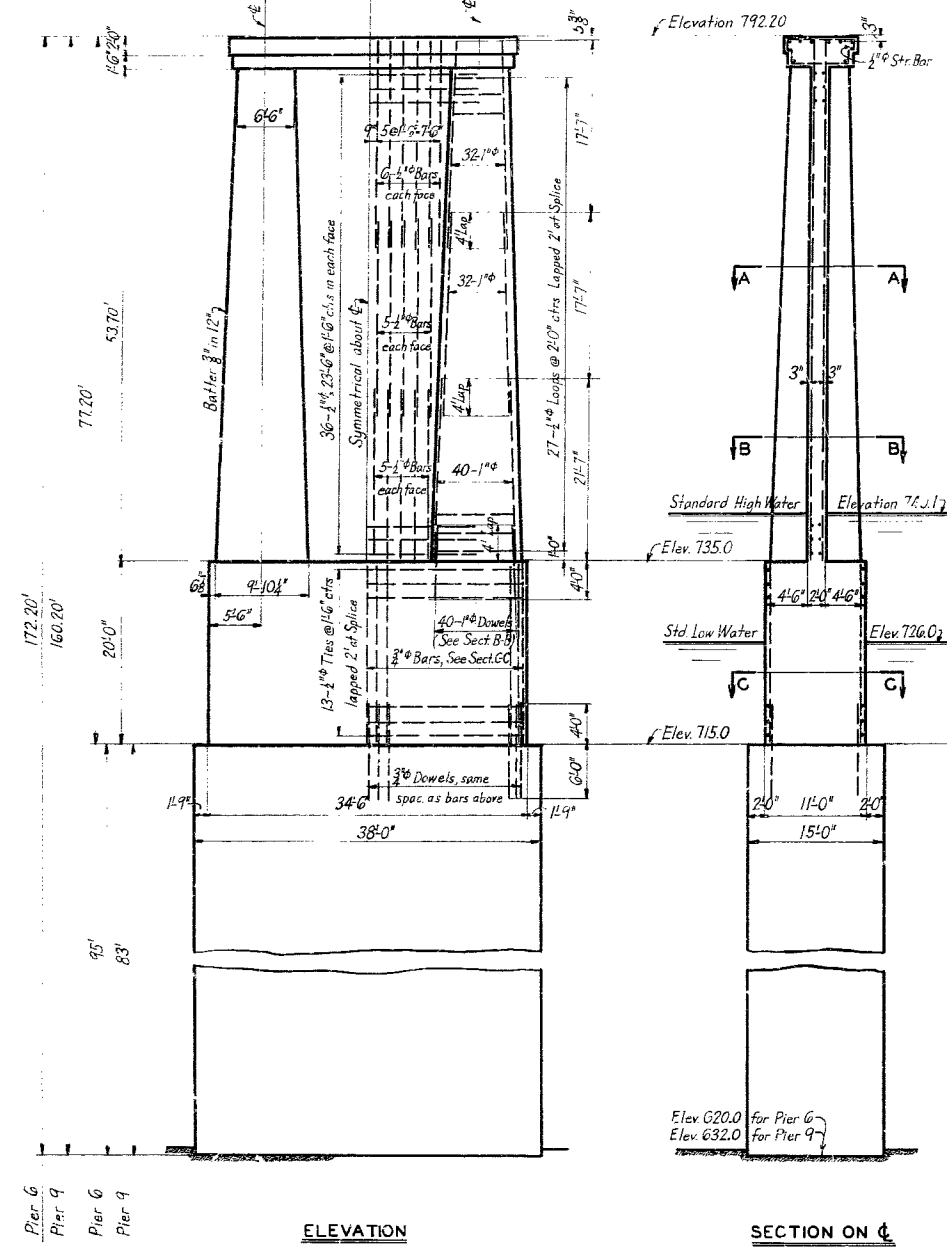

ELEVATION


SECTION ON C-C

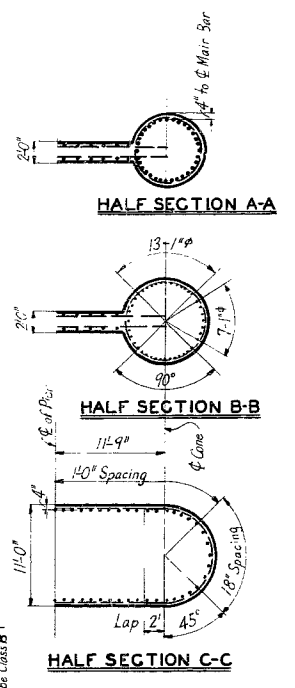

HALF SECTION A-A


HALF SECTION B-B

HALF SECTION C-C

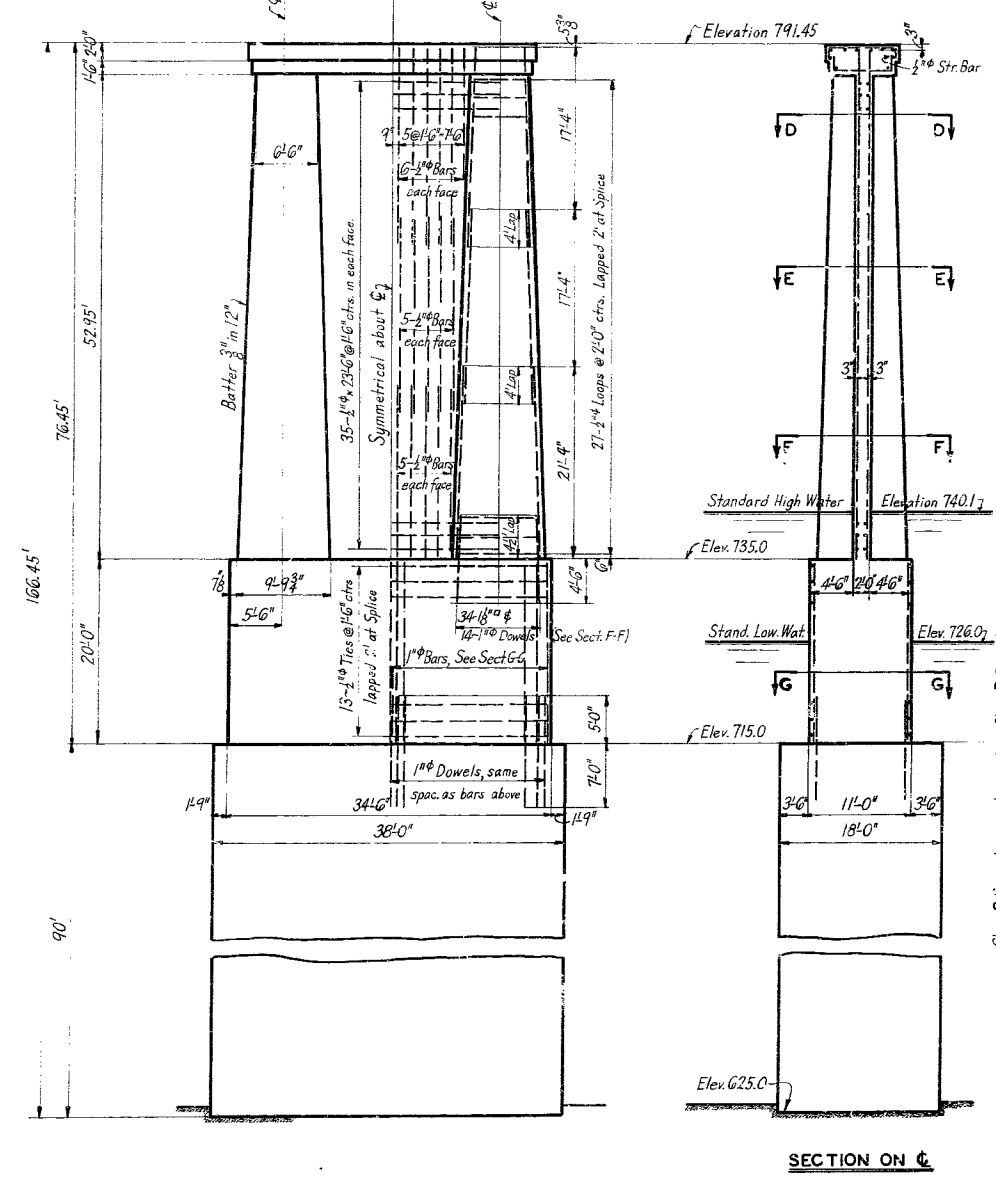

ELEVATION

SECTION ON C-C

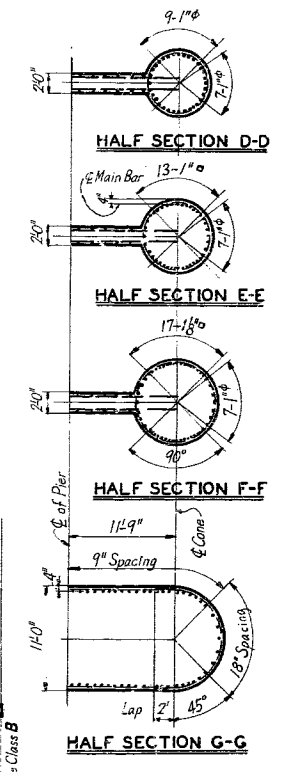

HALF SECTION D-D

HALF SECTION E-E

HALF SECTION F-F

HALF SECTION G-G

PIERS 6 AND 9

PIERS 7 AND 8

BRIDGE OVER MISSOURI RIVER
AT KANSAS CITY, KANSAS

FOR REGIONAL BRIDGE CO., INC

MAIN PIER DETAILS



SVERDRUP AND PARCEL
CONSULTING ENGINEERS
ST. LOUIS, MO.

Concrete in working chamber and shafts to be Class B.
All other Concrete to be Class C.

Made by CESJ April 1933
Traced by L.F. & CESJ May 1933
Checked by J.A.J. May 1933


23'-0" c.c. of Trusses

Unless noted, All Top Struts to be 4L 4" x 3" x 5/16" C.S.

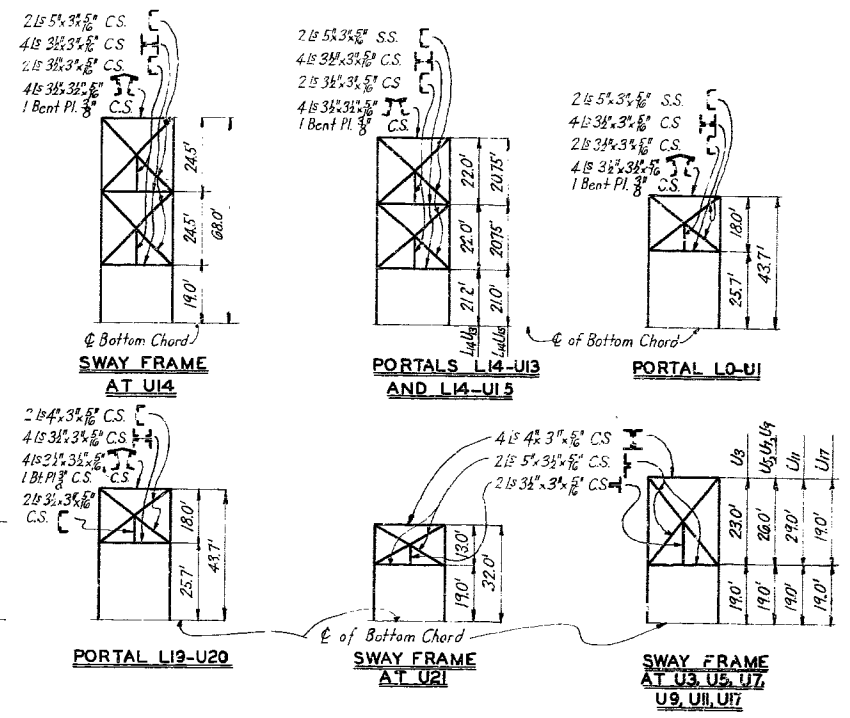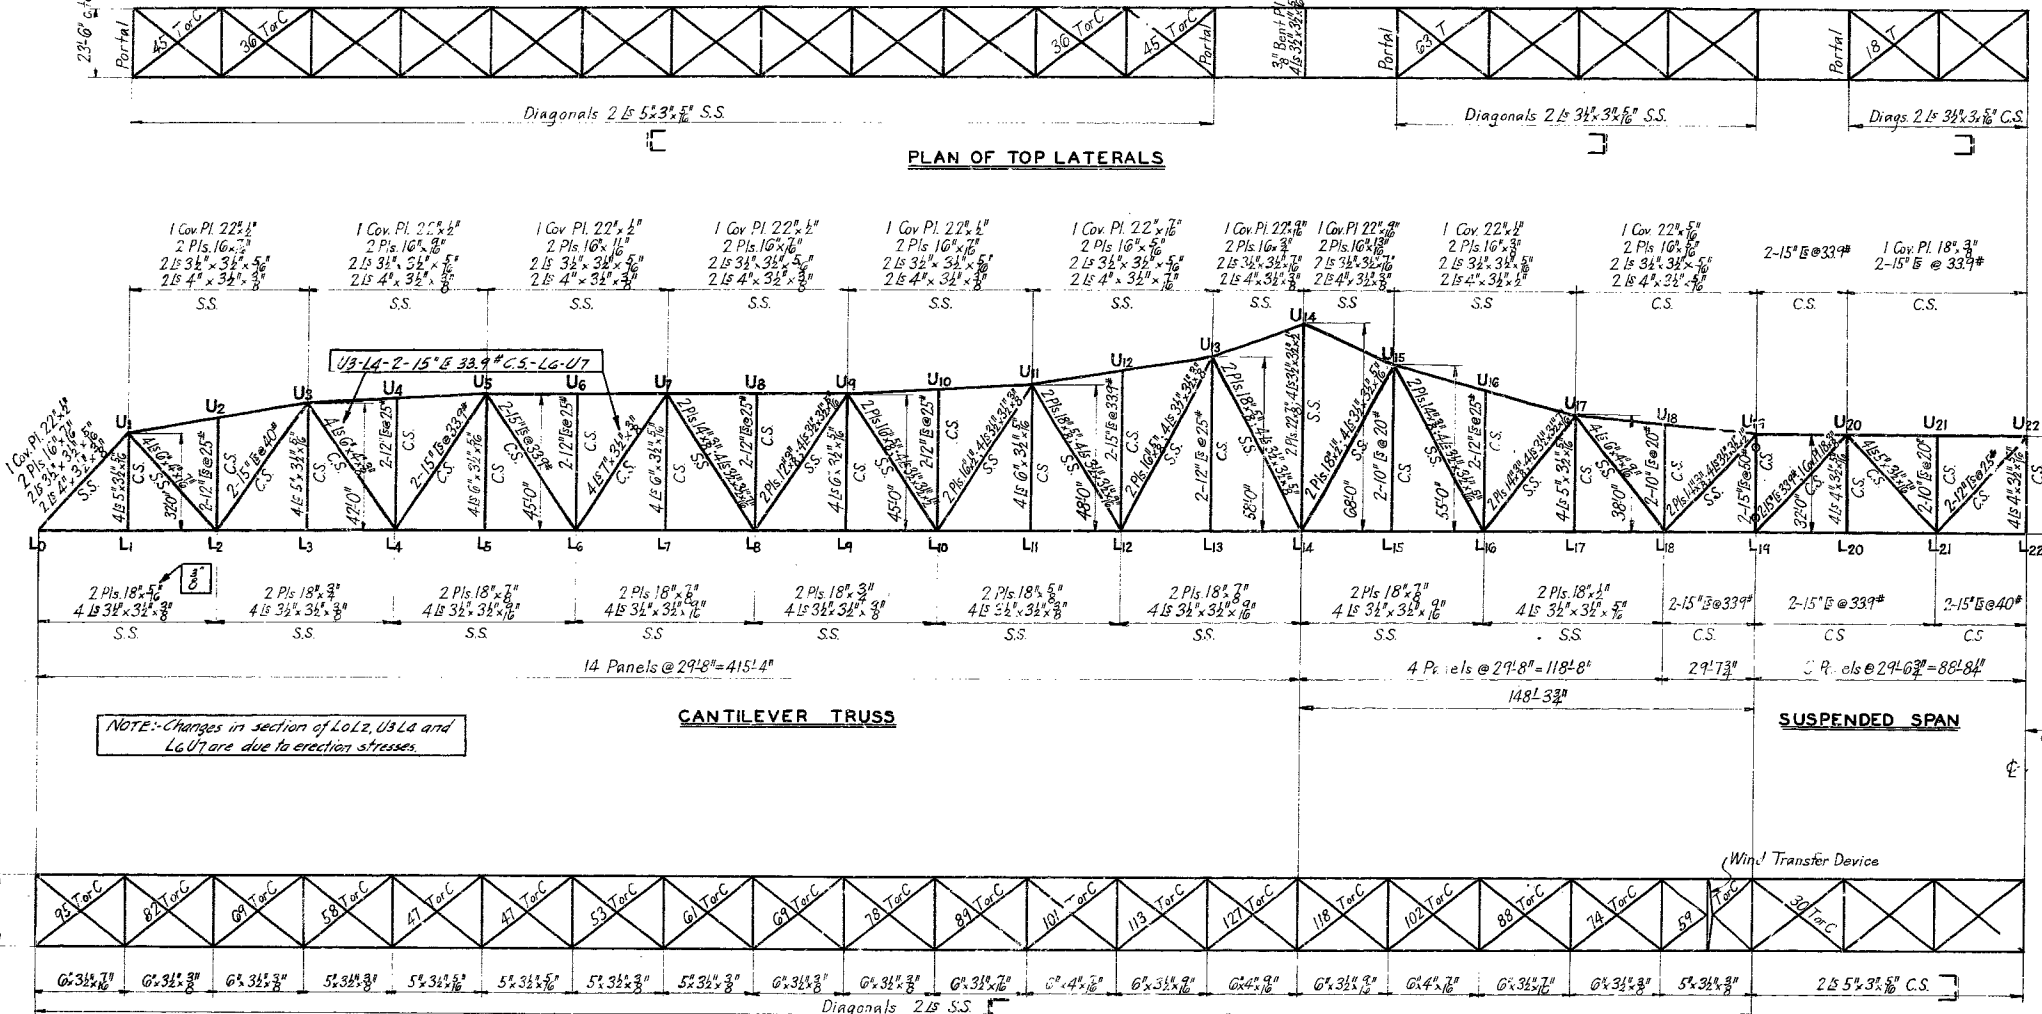

NOTE: Changes in section of L0L2, U3L4 and L6U7 are due to erection stresses.

Symmetrical about C

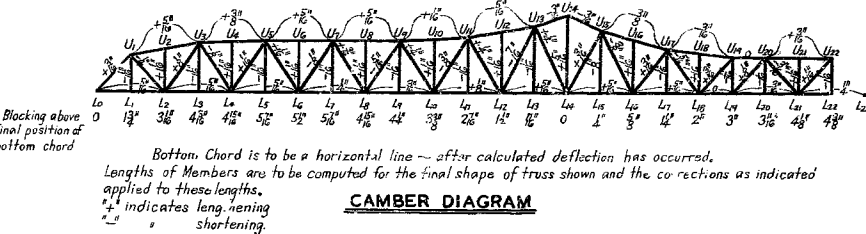

PLAN OF BOTTOM LATERALS

MEMBER	DESIGN STRESS				DESIGN STRESS				DESIGN STRESS				DESIGN STRESS				DESIGN STRESS				
	WIND	DEAD	CONC.	UNIF.	WIND	DEAD	CONC.	UNIF.	WIND	DEAD	CONC.	UNIF.	WIND	DEAD	CONC.	UNIF.	WIND	DEAD	CONC.	UNIF.	
L0L2	265T	238T	15T	103T	160T	356T	516T	U9U11	246C	83C	33C	217C	118C	433C	—	—	—	—	—	—	—
L0L4	473T	435T	30T	149T	244T	664T	952T	U10U12	246T	—	41T	217T	118T	300T	418T	—	—	—	—	—	—
L0L6	588T	500T	38T	254T	368T	742T	1160T	U11U13	161C	—	18C	116C	81C	—	—	—	—	—	—	—	—
L0L8	611T	445T	42T	275T	382T	762T	1144T	U12U14	161T	293T	45T	231T	81T	564T	—	—	—	—	—	—	—
L0L10	588T	427	30C	157C	382C	—	1166C	U13U15	59T	646T	41T	218T	35T	905T	—	—	—	—	—	—	—
L0L12	632T	490T	42T	275T	382T	762T	1144T	U14U16	145C	306C	19C	125C	65C	450C	—	—	—	—	—	—	—
L0L14	729T	567T	47T	317T	442T	884T	1276T	U15U17	145T	—	8T	40T	65T	—	—	—	—	—	—	—	—
L0L16	790T	610T	50T	345T	482T	964T	1356T	U16U18	—	—	—	—	—	—	—	—	—	—	—	—	—
L0L18	838T	652T	55T	371T	512T	1024T	1440T	U17U19	—	—	—	—	—	—	—	—	—	—	—	—	—
L0L20	886T	694T	60T	397T	550T	1092T	1524T	U18U20	—	—	—	—	—	—	—	—	—	—	—	—	—
L0L22	934T	736T	65T	423T	588T	1160T	1608T	U19U21	—	—	—	—	—	—	—	—	—	—	—	—	—
L1L2	265T	238T	15T	103T	160T	356T	516T	U20U22	—	—	—	—	—	—	—	—	—	—	—	—	—
L1L4	473T	435T	30T	149T	244T	664T	952T	U21U23	—	—	—	—	—	—	—	—	—	—	—	—	—
L1L6	588T	500T	38T	254T	368T	742T	1160T	U22U24	—	—	—	—	—	—	—	—	—	—	—	—	—
L1L8	611T	445T	42T	275T	382T	762T	1144T	U23U25	—	—	—	—	—	—	—	—	—	—	—	—	—
L1L10	588T	427	30C	157C	382C	—	1166C	U24U26	—	—	—	—	—	—	—	—	—	—	—	—	—
L1L12	632T	490T	42T	275T	382T	762T	1144T	U25U27	—	—	—	—	—	—	—	—	—	—	—	—	—
L1L14	729T	567T	47T	317T	442T	884T	1276T	U26U28	—	—	—	—	—	—	—	—	—	—	—	—	—
L1L16	790T	610T	50T	345T	482T	964T	1356T	U27U29	—	—	—	—	—	—	—	—	—	—	—	—	—
L1L18	838T	652T	55T	371T	512T	1024T	1440T	U28U30	—	—	—	—	—	—	—	—	—	—	—	—	—
L1L20	886T	694T	60T	397T	550T	1092T	1524T	U29U31	—	—	—	—	—	—	—	—	—	—	—	—	—
L1L22	934T	736T	65T	423T	588T	1160T	1608T	U30U32	—	—	—	—	—	—	—	—	—	—	—	—	—

GENERAL NOTES

- DESIGN ————— In accordance with the A.A.S.H.O. Standard Specifications for Highway Bridges dated 1931, modified.
- LOADING ————— 415 Live Load
- UNIT STRESSES ——— Stresses in Carbon Steel, Cast Steel, etc. are those given in Paragraph 5.4.2. of the Specifications in this column headed: "For live load and lateral forces". Stresses in Silicon Steel are 150% of those allowed for Carbon Steel.
- MATERIALS ————— All Carbon Steel, Silicon Steel, Cast Steel, Forgings, etc. shall conform to the current specifications of the A.S.T.M. "S.S." indicates Silicon Steel; "C.S." Carbon Steel.
- PUNCHING & REAMING — All work shall conform to the Paragraph headed: "Fabrication of Structural Steel" in the special provisions of the Specifications.
- RIVETS ————— Rivets shall be 7/8" except as otherwise noted on detail drawings.
- PAINT ————— Structural Steel and Castings shall receive one shop coat and two field coats of paint as called for in the Paragraph headed: "Paint" of the special provisions of the Specifications.
- GUSSETS ————— All Gusset Plates shall be cut back not more than 1/4" from the back of the chord.

BRIDGE OVER MISSOURI RIVER AT KANSAS CITY, KANSAS

FOR REGIONAL BRIDGE CO., INC.


STRESS SHEET—MAIN SPANS

SVERDRUP AND PARCEL CONSULTING ENGINEERS ST. LOUIS, MO.

Made by J.A.Z. April 1933
Checked by L.F. & C.S.R. May 1933
Checked by B.R.S. June 1933

322


All stresses shown above are in Kips
Design stress including wind shown only where such stress governs
Live load stresses shown include impact.

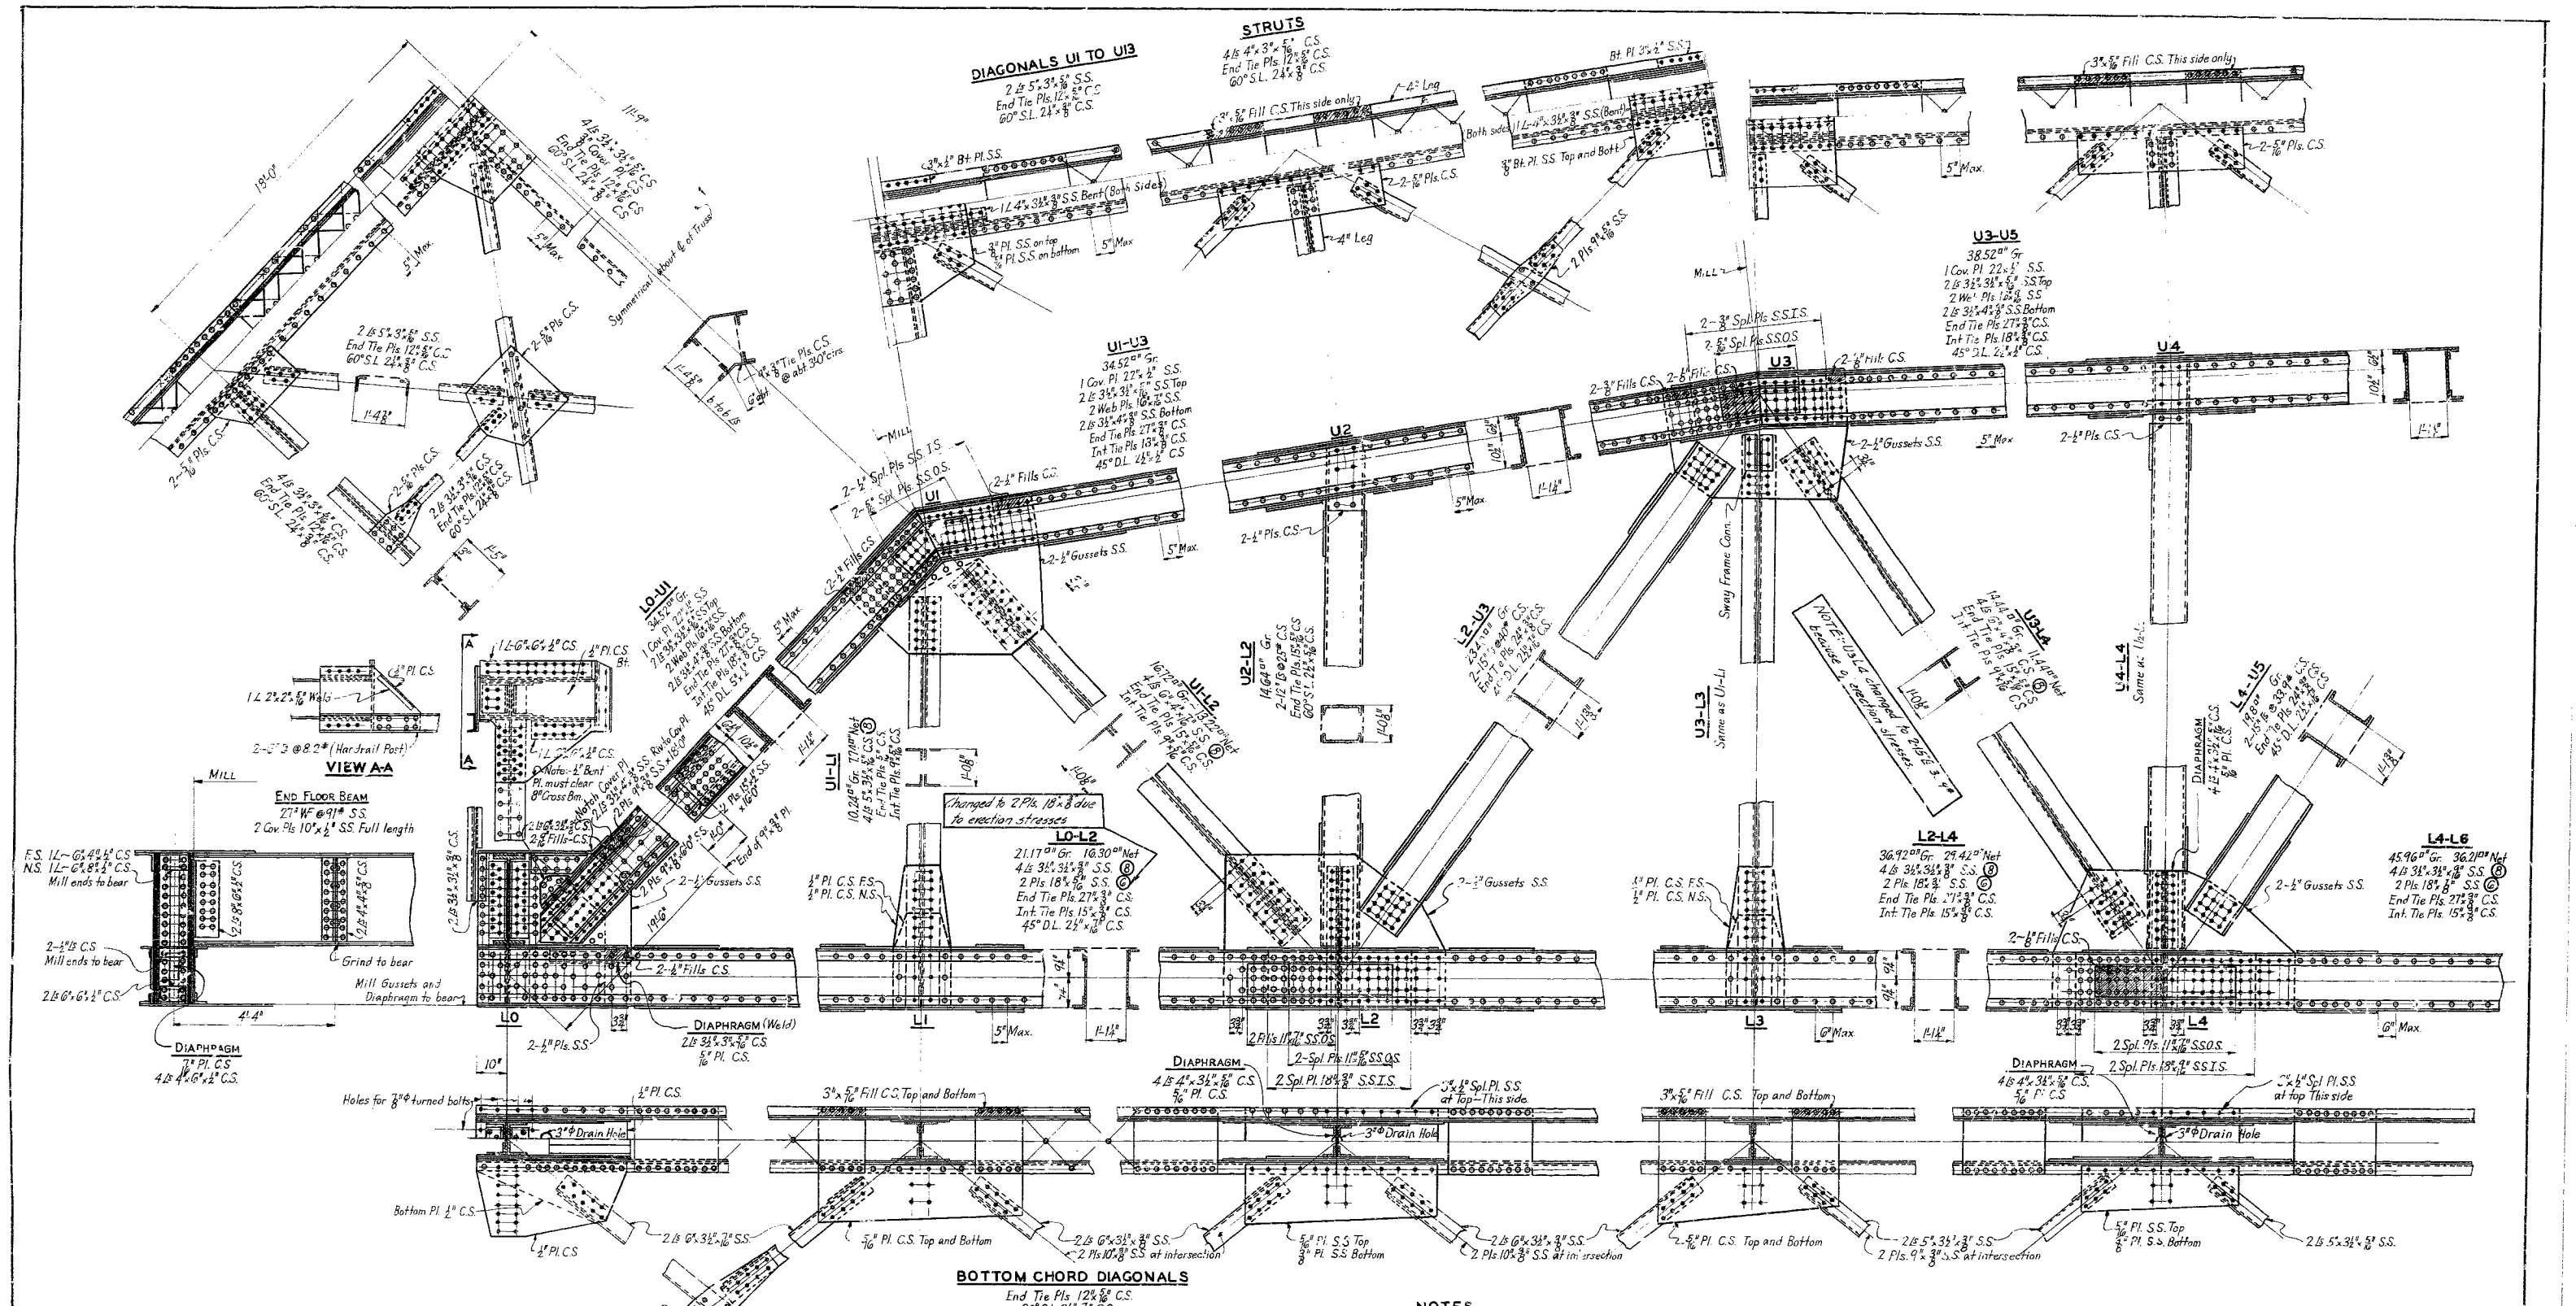

**BRIDGE OVER MISSOURI RIVER
 AT KANSAS CITY, KANSAS**
 FOR REGIONAL BRIDGE CO., INC.
 MAIN SPAN STRUCTURAL DETAILS L0-L4

SVERDRUP AND PARCEL
 CONSULTING ENGINEERS
 ST. LOUIS, MO.

Made by L.F. April 1933
 Traced by L.F. & C.E.S. May 1933
 Checked by J.R.S. June 1933

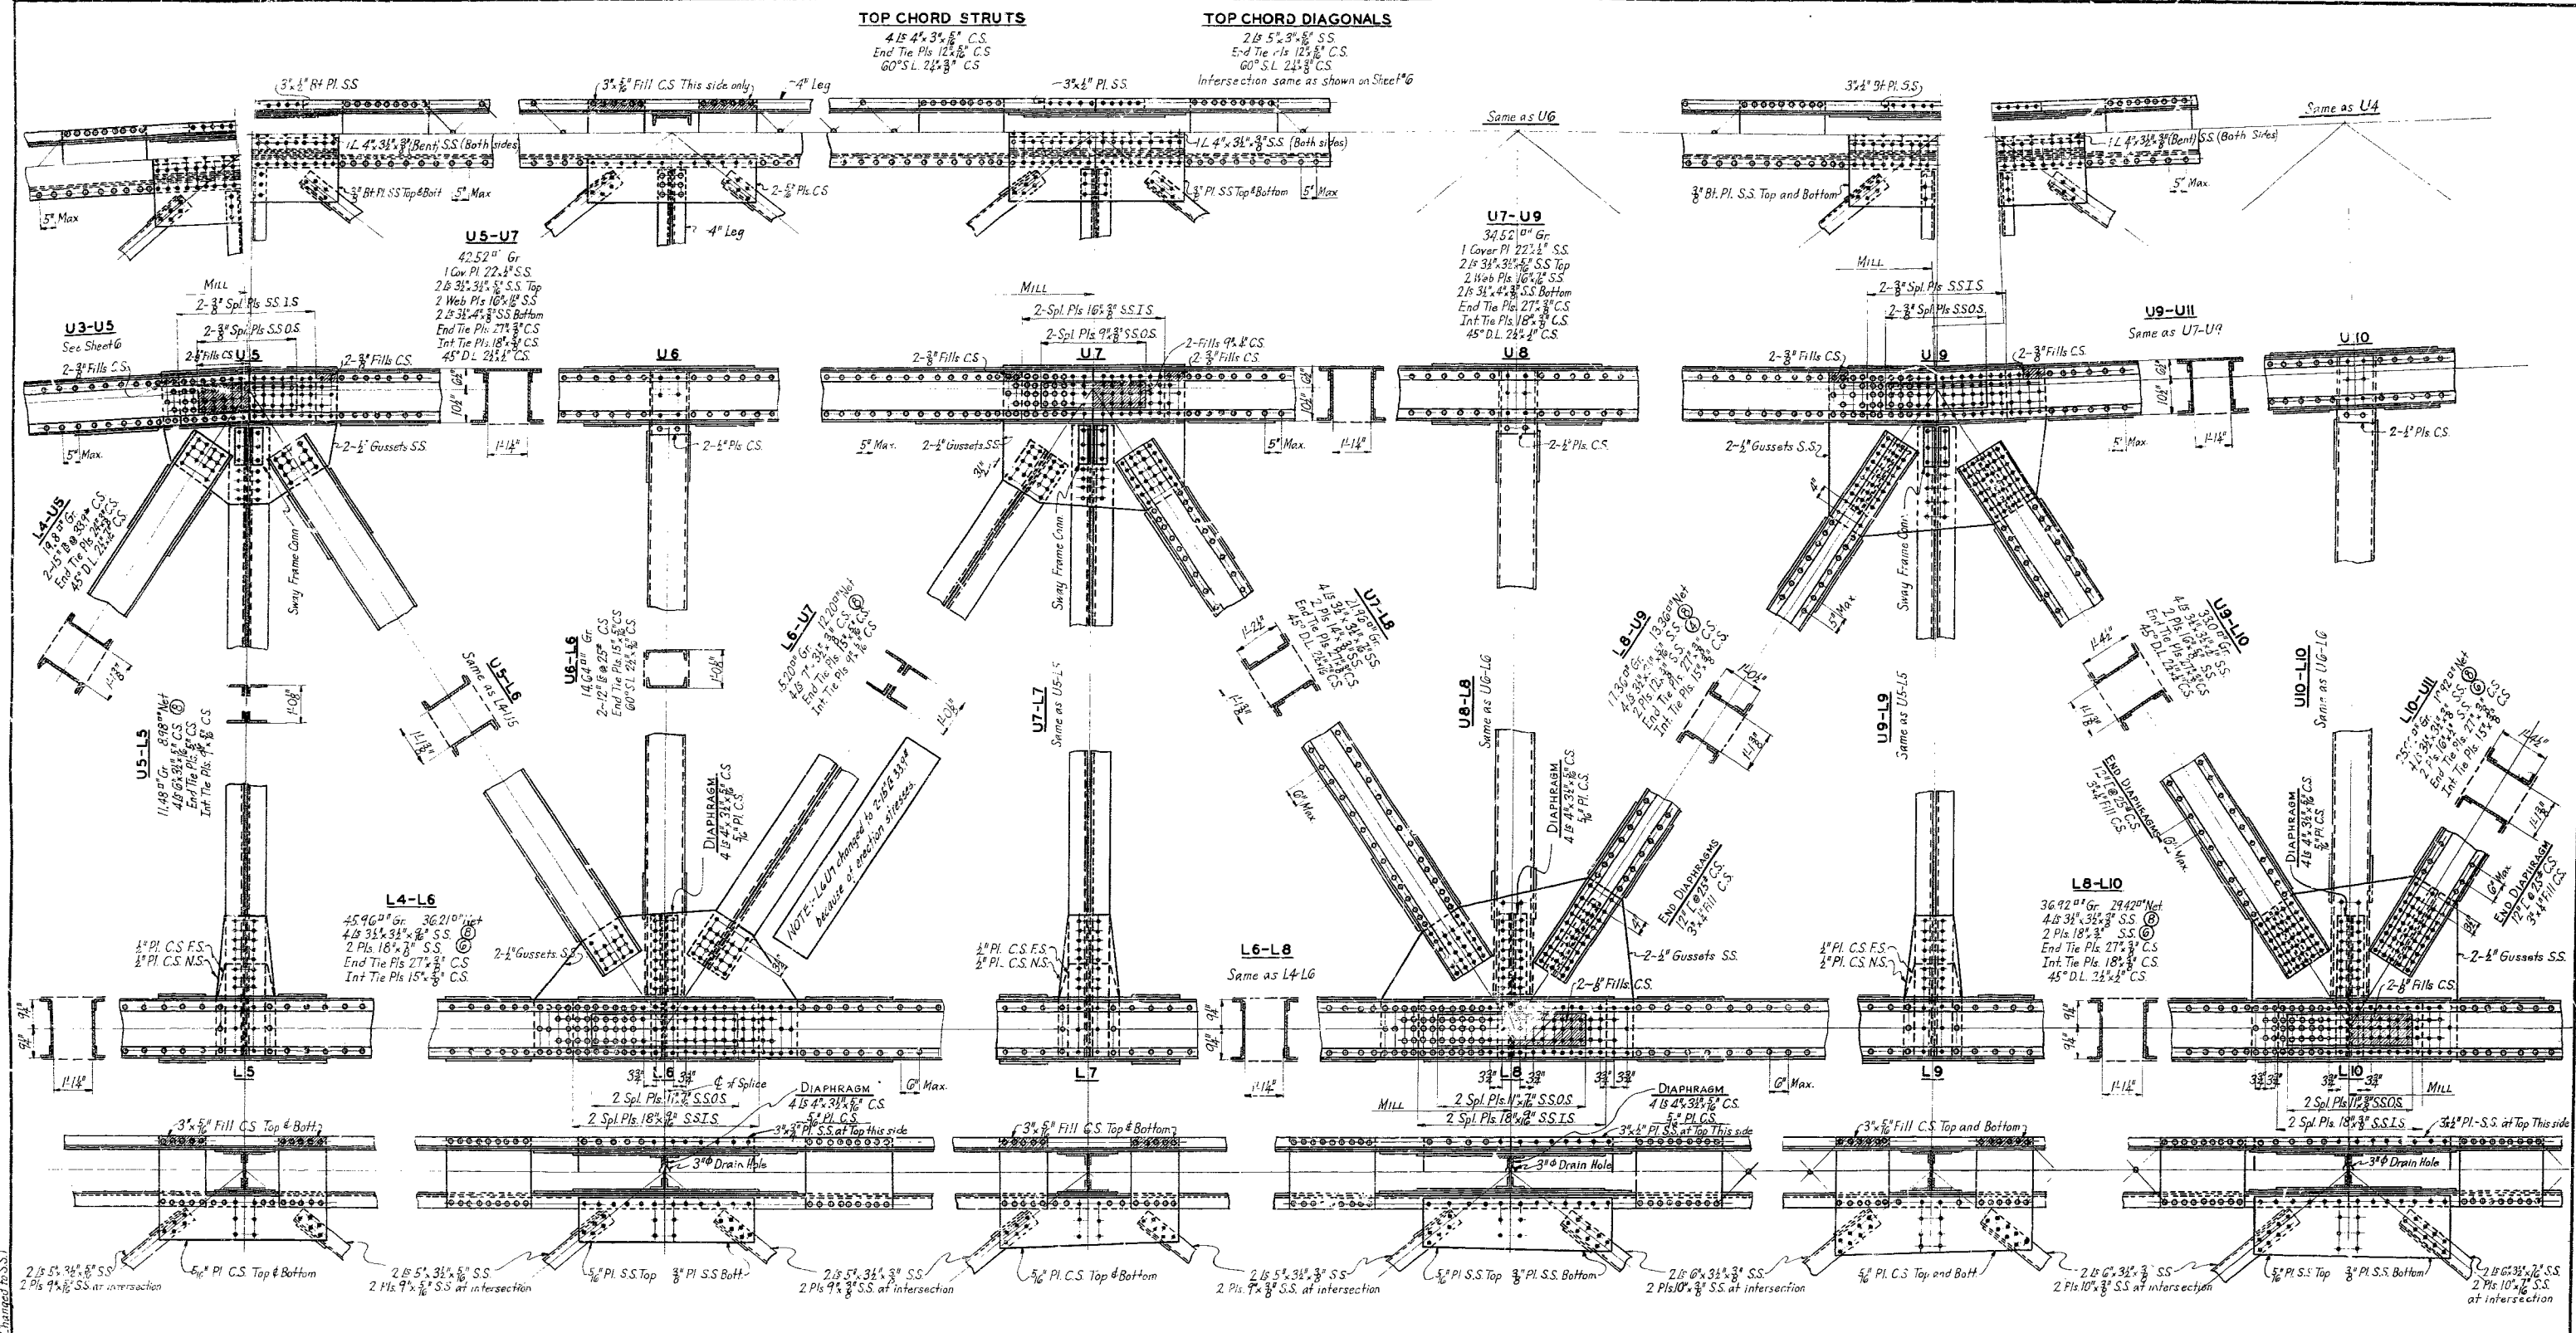

TOP CHORD STRUTS

4 L 4" x 3 1/2" x 3/8" C.S.
End Tie Pls 12 1/2" x 3/8" C.S.
60° S.L. 2 1/2" x 3/8" C.S.

TOP CHORD DIAGONALS

2 L 5" x 3" x 3/8" S.S.
End Tie Pls 12 1/2" x 3/8" C.S.
60° S.L. 2 1/2" x 3/8" C.S.
Intersection same as shown on Sheet #6

U5-U7

42.52' Gr.
1 Cov. Pl. 22 1/2" x 3/8" S.S.
2 L 3 1/2" x 3 1/2" x 3/8" S.S. Top
2 L 3 1/2" x 3 1/2" x 3/8" S.S. Bottom
End Tie Pls 27 1/2" x 3/8" C.S.
Int. Tie Pls 18 1/2" x 3/8" C.S.
45° D.L. 2 1/2" x 3/8" C.S.

U7-U9

34.52' Gr.
1 Cover Pl. 22 1/2" x 3/8" S.S.
2 L 3 1/2" x 3 1/2" x 3/8" S.S. Top
2 L 3 1/2" x 3 1/2" x 3/8" S.S. Bottom
End Tie Pls 27 1/2" x 3/8" C.S.
Int. Tie Pls 18 1/2" x 3/8" C.S.
45° D.L. 2 1/2" x 3/8" C.S.

L4-L6

45.96' Gr.
36.21' Net
4 L 3 1/2" x 3 1/2" x 3/8" S.S.
2 Pls 18 1/2" x 3/8" S.S.
End Tie Pls 27 1/2" x 3/8" C.S.
Int. Tie Pls 15 1/2" x 3/8" C.S.

L8-L10

36.92' Gr.
29.42' Net
4 L 3 1/2" x 3 1/2" x 3/8" S.S.
2 Pls 18 1/2" x 3/8" S.S.
End Tie Pls 27 1/2" x 3/8" C.S.
Int. Tie Pls 18 1/2" x 3/8" C.S.
45° D.L. 2 1/2" x 3/8" C.S.

BOTTOM CHORD DIAGONALS

End Tie Pls 12 1/2" x 3/8" C.S.
60° S.L. 2 1/2" x 3/8" C.S.

NOTES

All material marked "S.S." to be Silicon Steel.
All material marked "C.S." to be Carbon Steel.
⊙ indicates maximum number of holes out to maintain required net section.
All rivets 3/4" except in battens and lacing of bracing, which are to be 3/8".
Clear distance between batten plates on tension members shall not exceed 3'-0".
See Sheet #10 for Typical Cross-Section.

**BRIDGE OVER MISSOURI RIVER
AT KANSAS CITY, KANSAS**

FOR REGIONAL BRIDGE CO., INC.
MAIN SPAN STRUCTURAL DETAILS L5-L10


SVERDRUP AND PARCEL
CONSULTING ENGINEERS
ST. LOUIS, MO.

Made by L.F. April 1933
Traced by L.F. & C.S. Jr. May 1933
Checked by B.R.S. June 1933

SHEET NO. 7

Revised 10-11-33 L.S.L. Splice Pl. at U9 Changed to S.S.

Rev. 8-11-33 (Vertical Pls. at L12 & L14. Changed to S.S.)

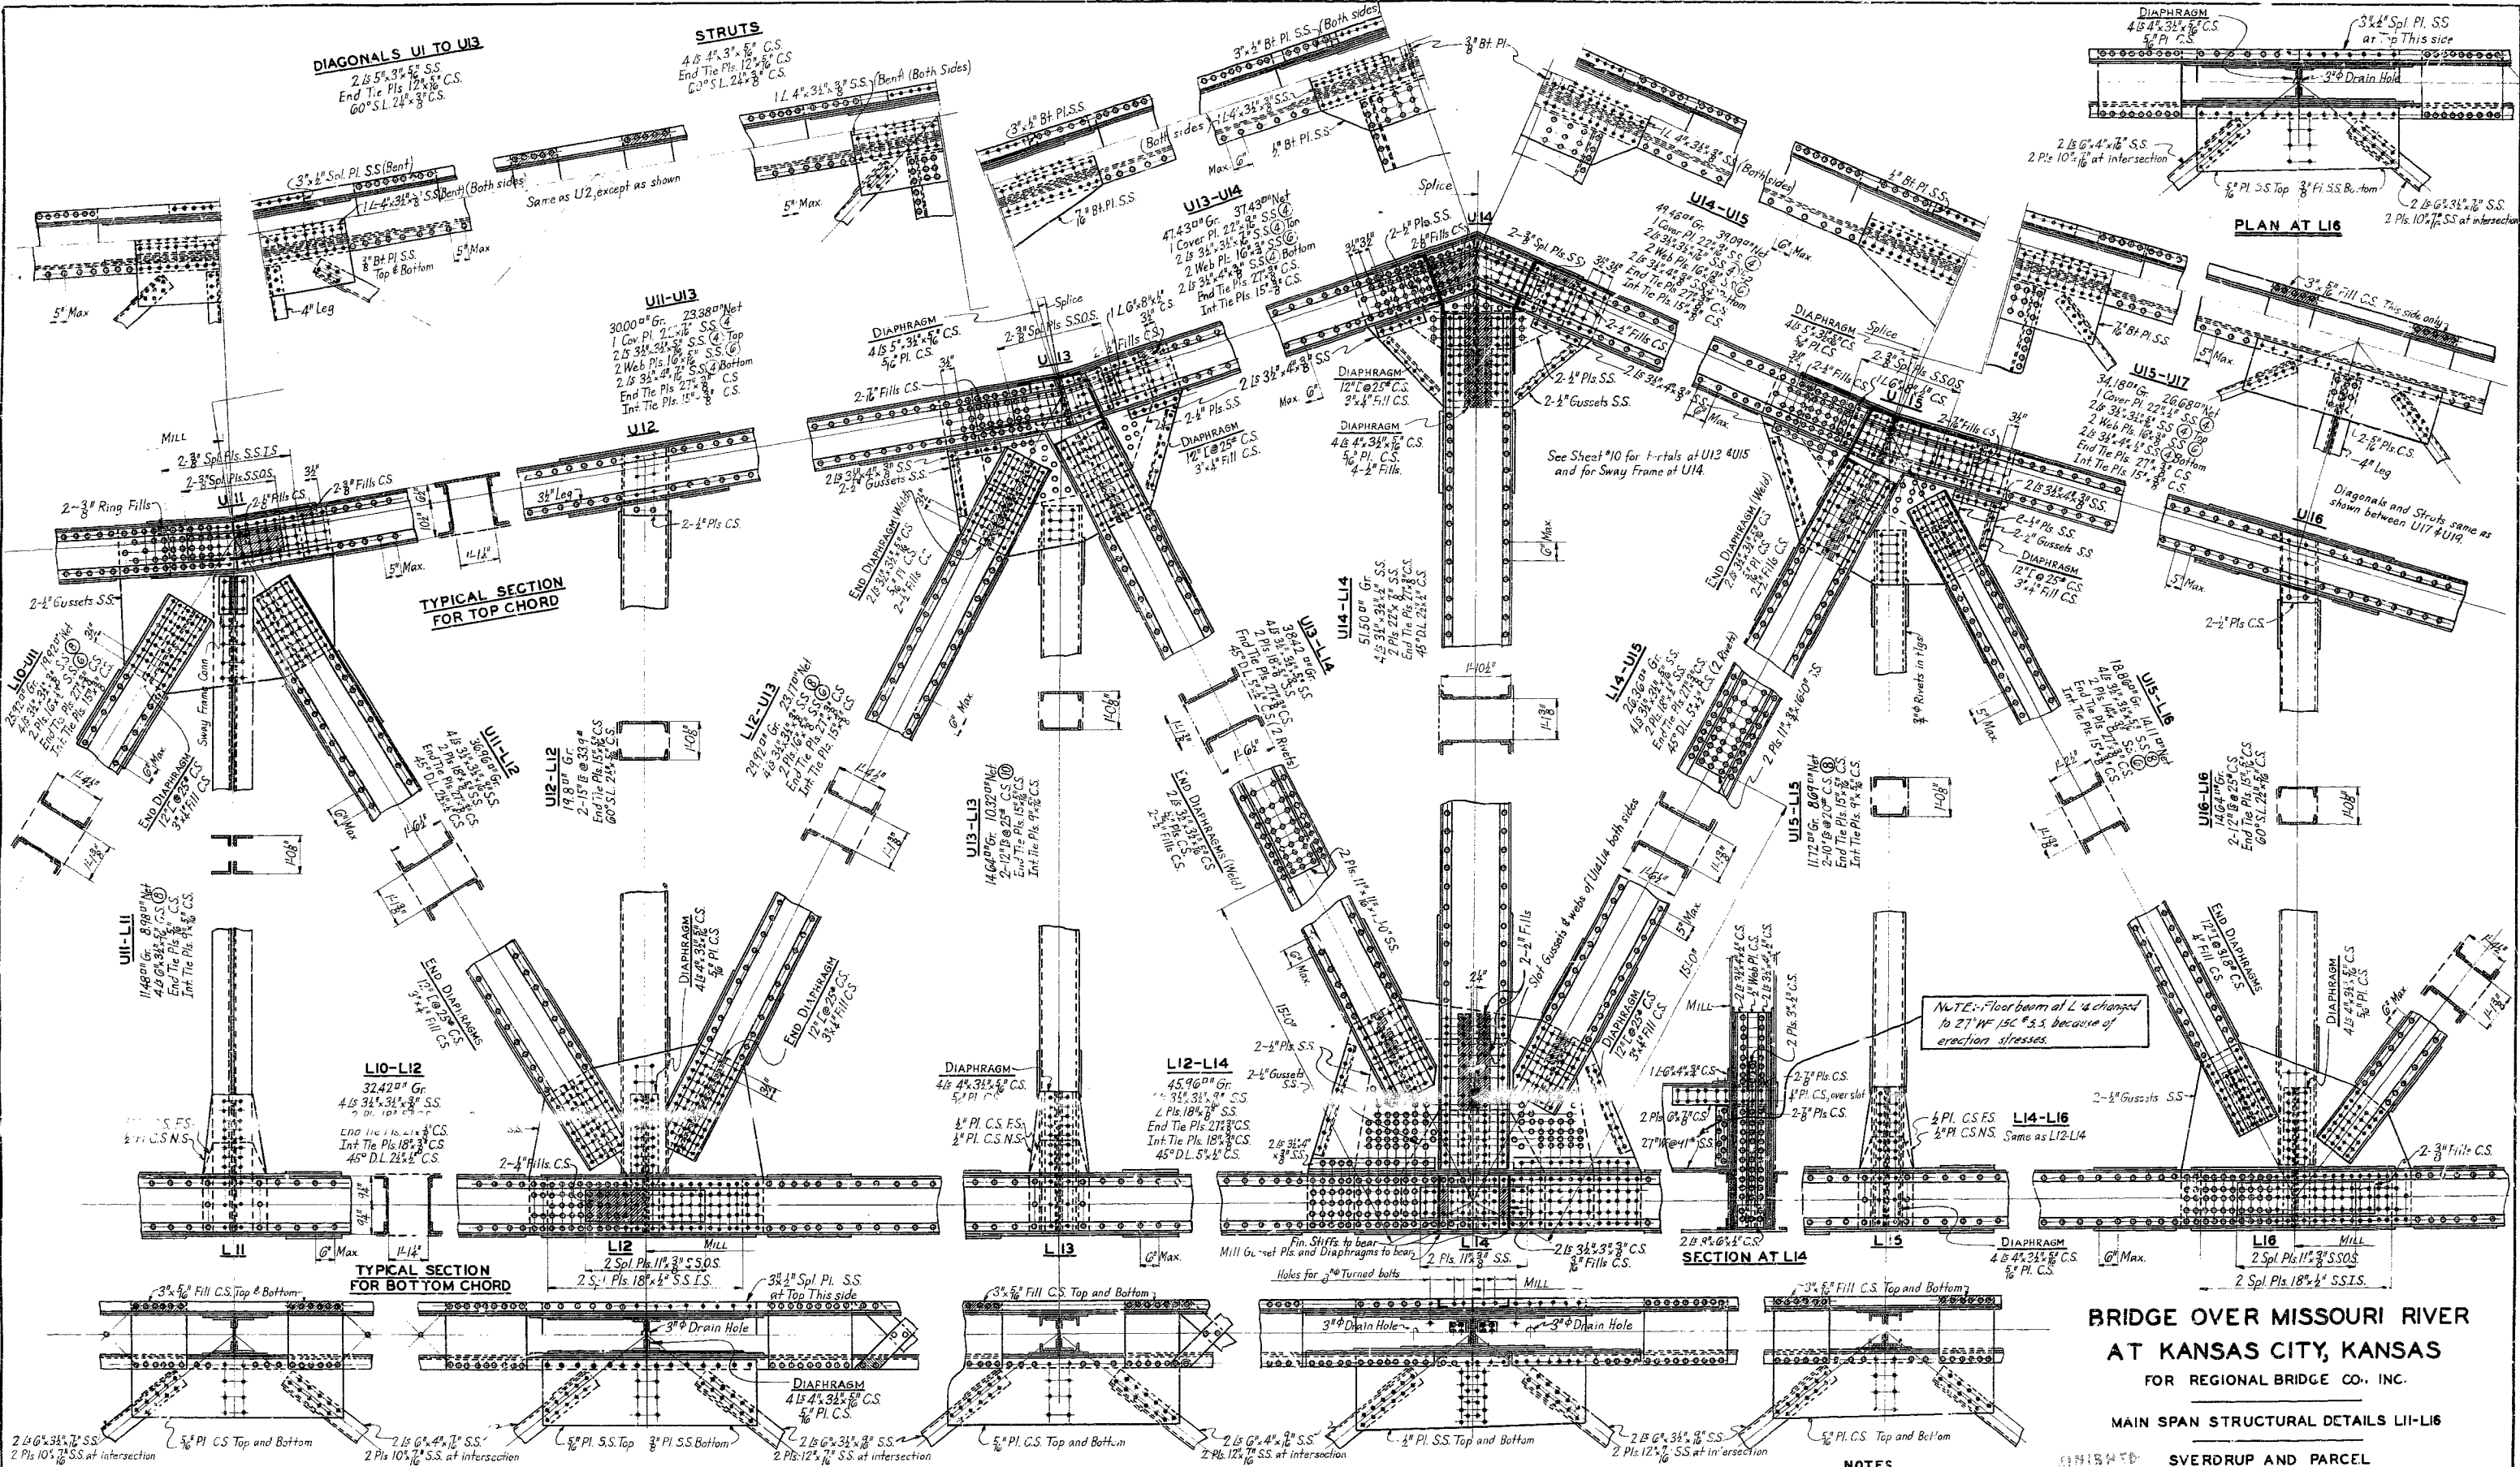

Rev. 8-11-33 (Vertical Pls. at L12 & L14. Changed to S.S.)

BOTTOM CHORD DIAGONALS

End Tie Pls. 12' x 1/2" C.S.
60° S.L. 2 1/2" x 3/8" C.S.

NOTES

All Material marked "S.S." to be Silicon Steel. All Material marked "C.S." to be Carbon Steel.

⊙ indicates maximum number of holes out to maintain required net section.

All rivets ^{3/4"} except in battens and lacing of bracing, which are to be ^{3/8"}.

Clear distance between batten plates on tension members shall not exceed 3'-0".

See Sheet #10 for Typical Cross Section.


**BRIDGE OVER MISSOURI RIVER
AT KANSAS CITY, KANSAS**

FOR REGIONAL BRIDGE CO., INC.

MAIN SPAN STRUCTURAL DETAILS LII-LI6

SVERDRUP AND PARCEL
CONSULTING ENGINEERS
ST. LOUIS, MO.

Made by L.F. April 1933
Traced by L.F. & C.E.S. May 1933
Checked by B.R.S. June 1933

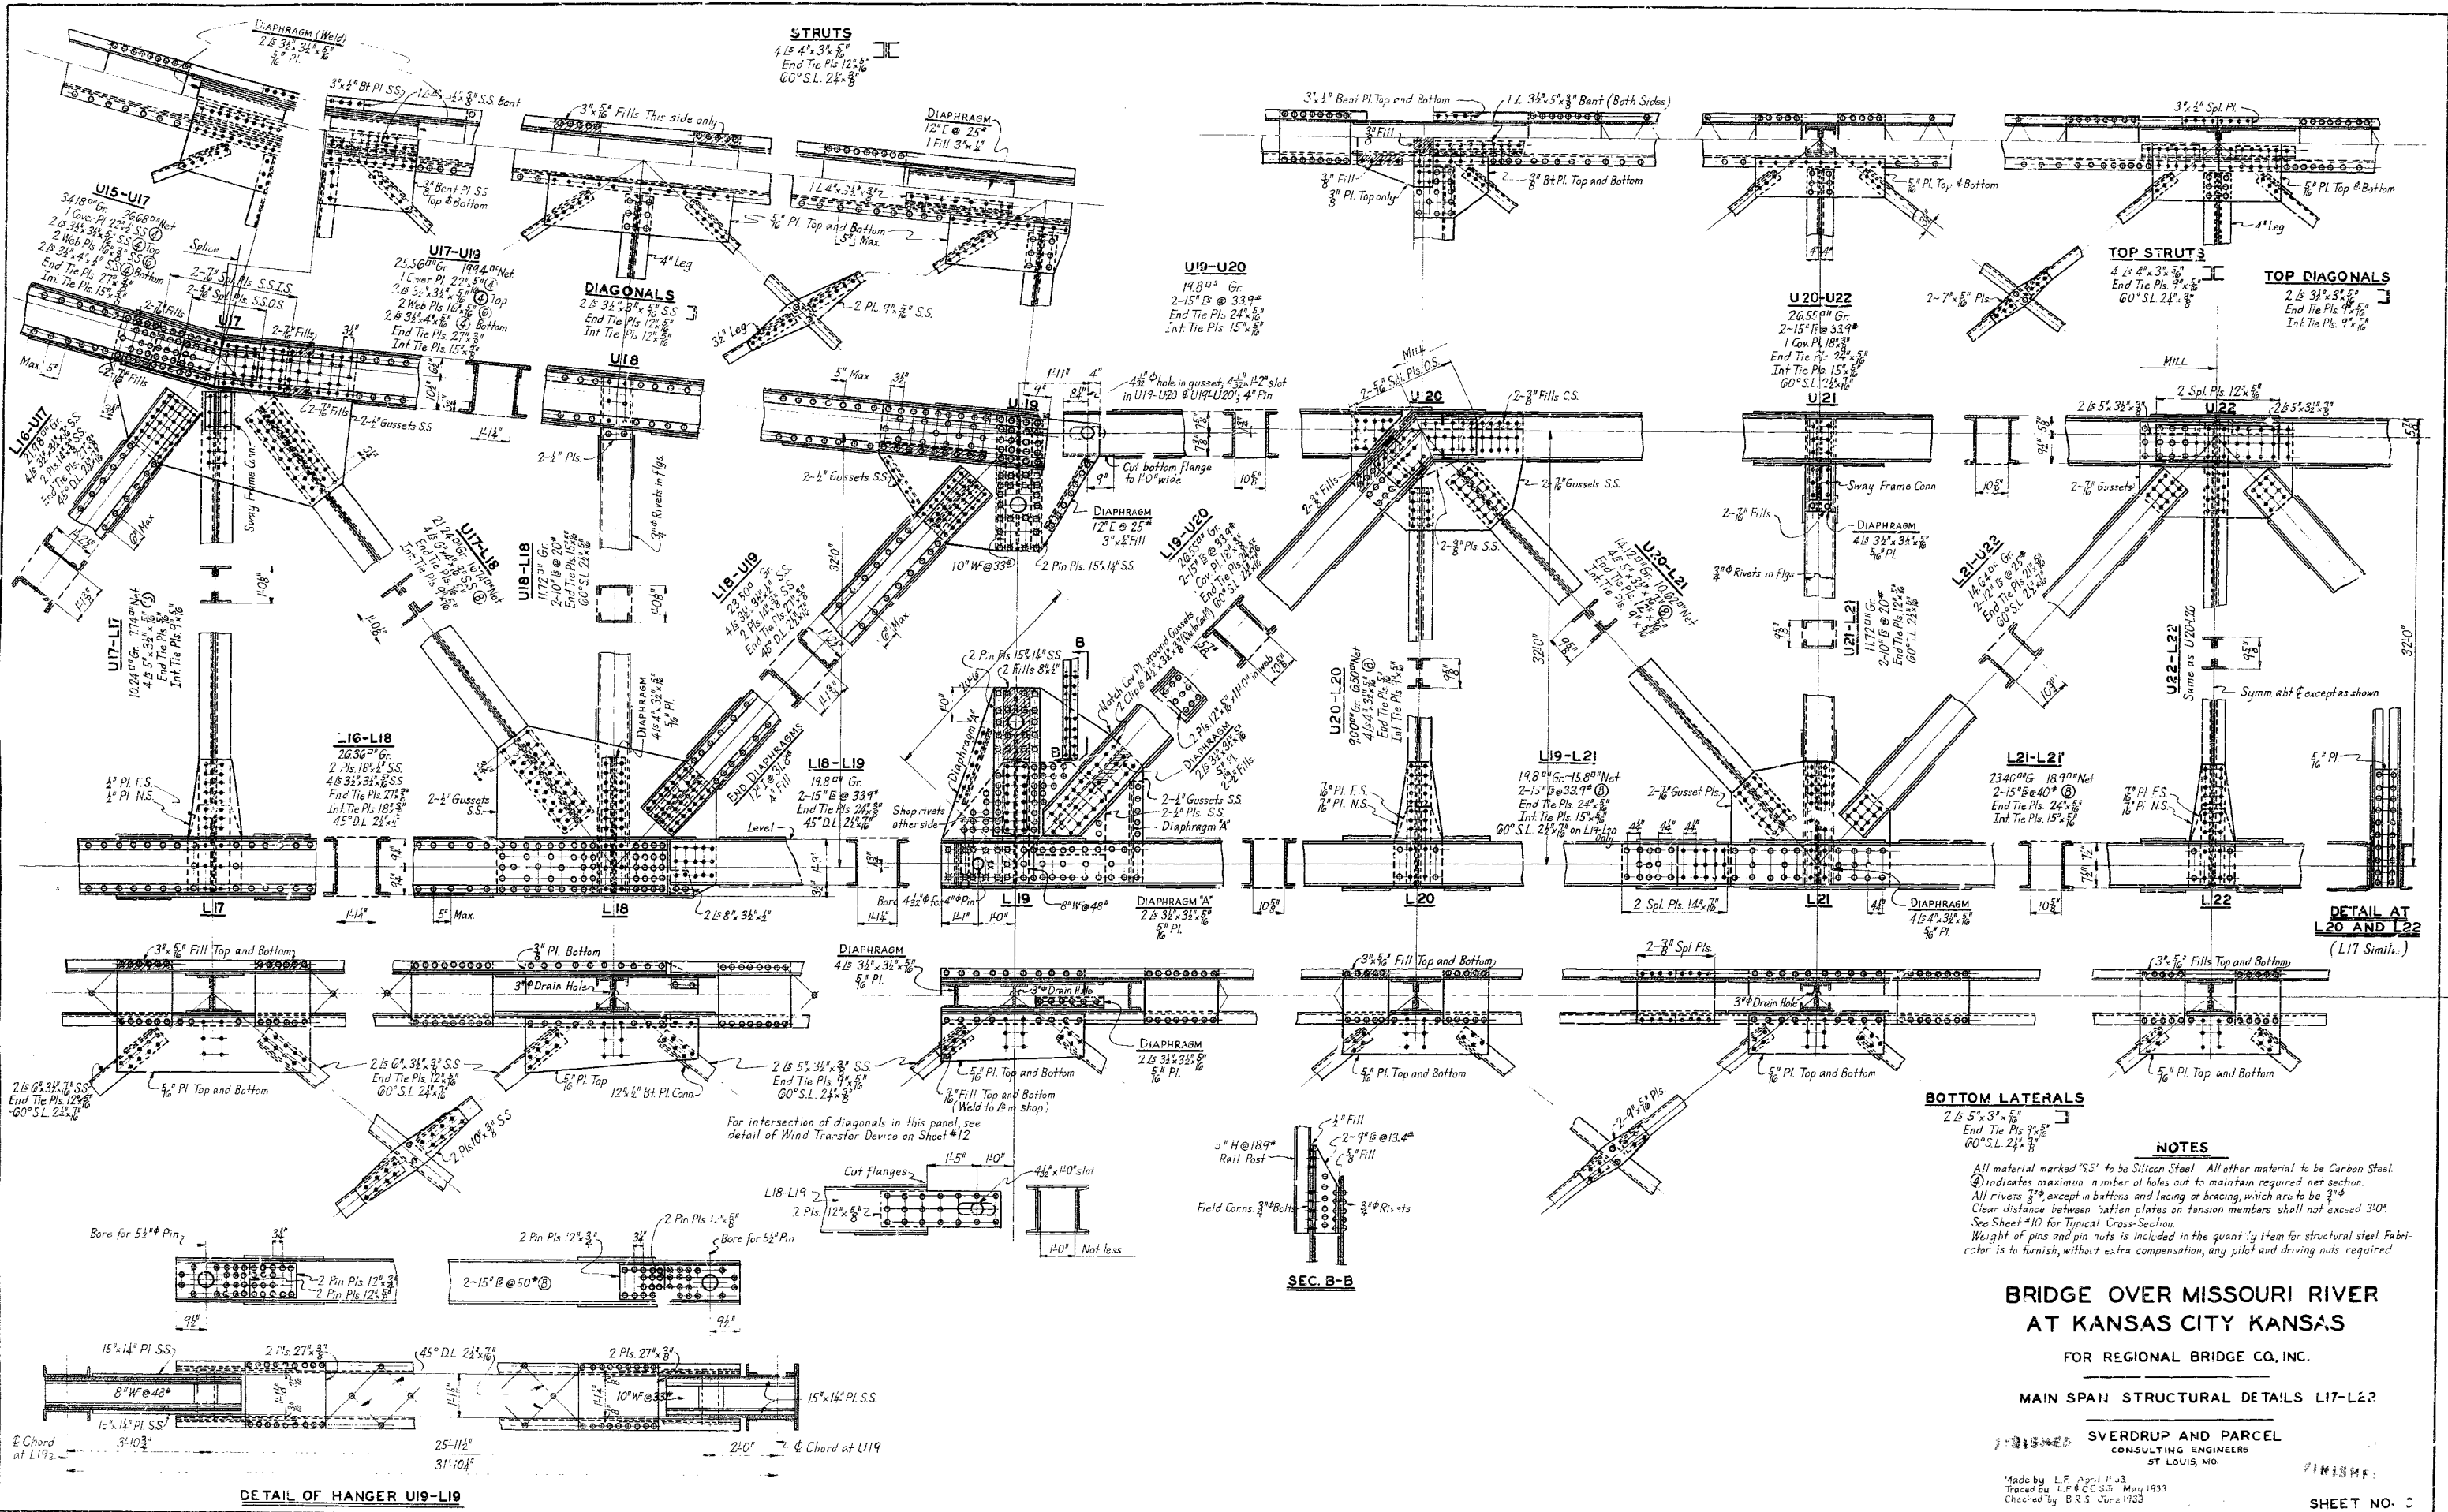

**BRIDGE OVER MISSOURI RIVER
 AT KANSAS CITY KANSAS**

FOR REGIONAL BRIDGE CO., INC.


MAIN SPAN STRUCTURAL DETAILS L17-L22

SVERDRUP AND PARCEL
 CONSULTING ENGINEERS
 ST. LOUIS, MO.


Made by L.F. April 1933
 Traced by L.F. & C.E.S. May 1933
 Checked by B.R.S. June 1933

FINISH:


SHEET NO. C

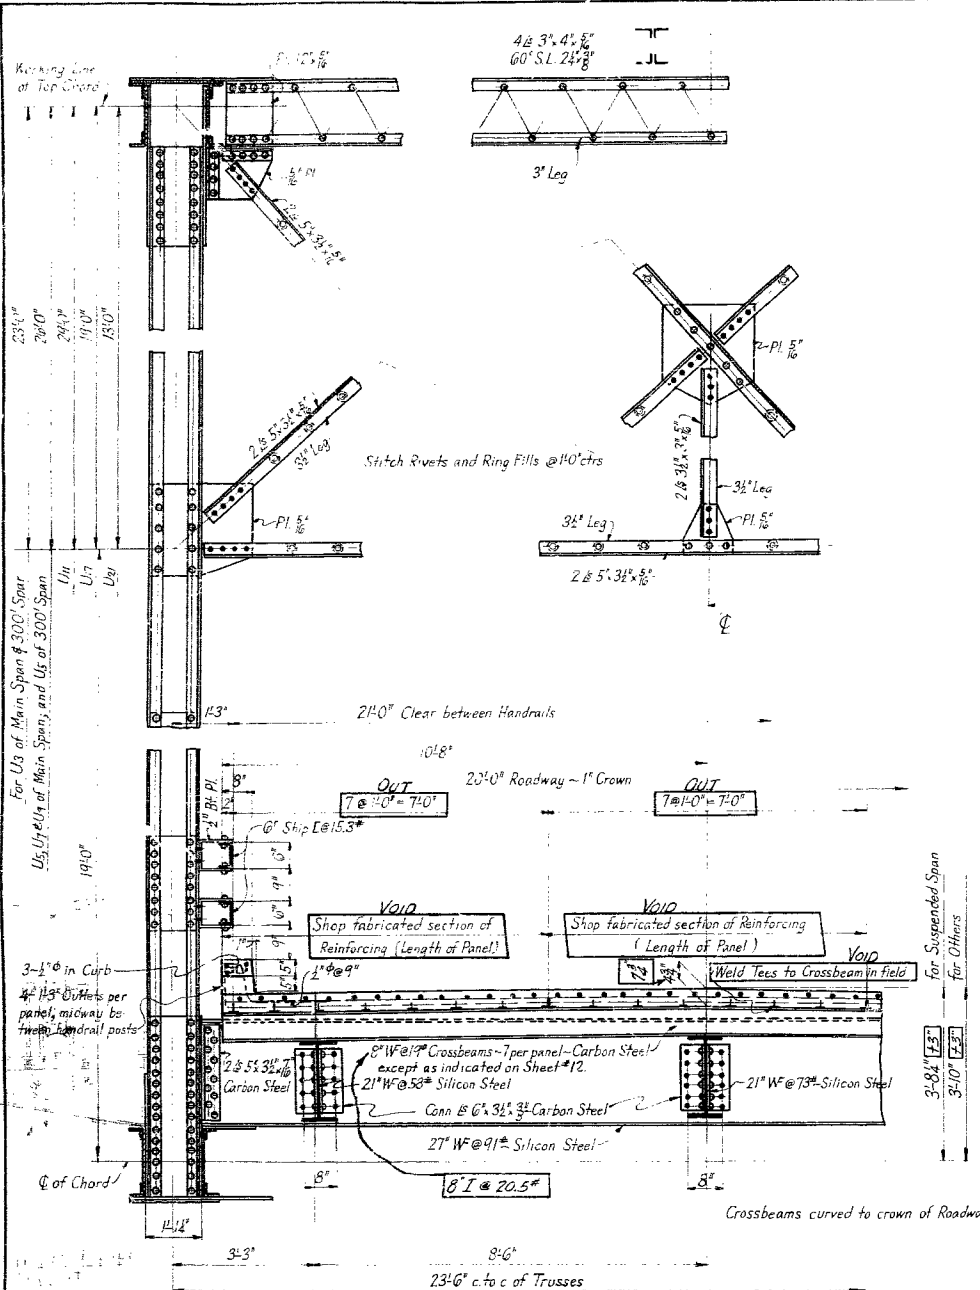


TYPICAL CROSS SECTION

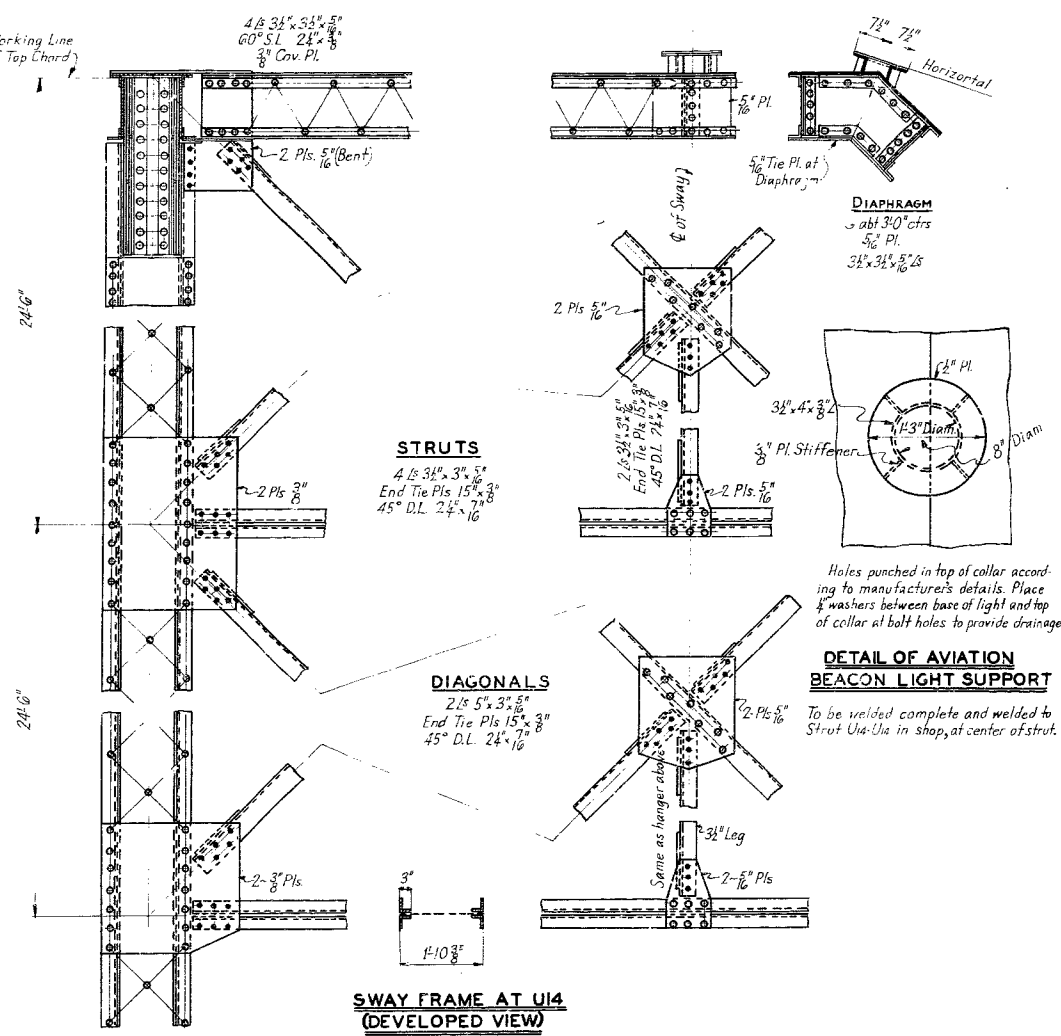


SWAY FRAME AT U14 (DEVELOPED VIEW)

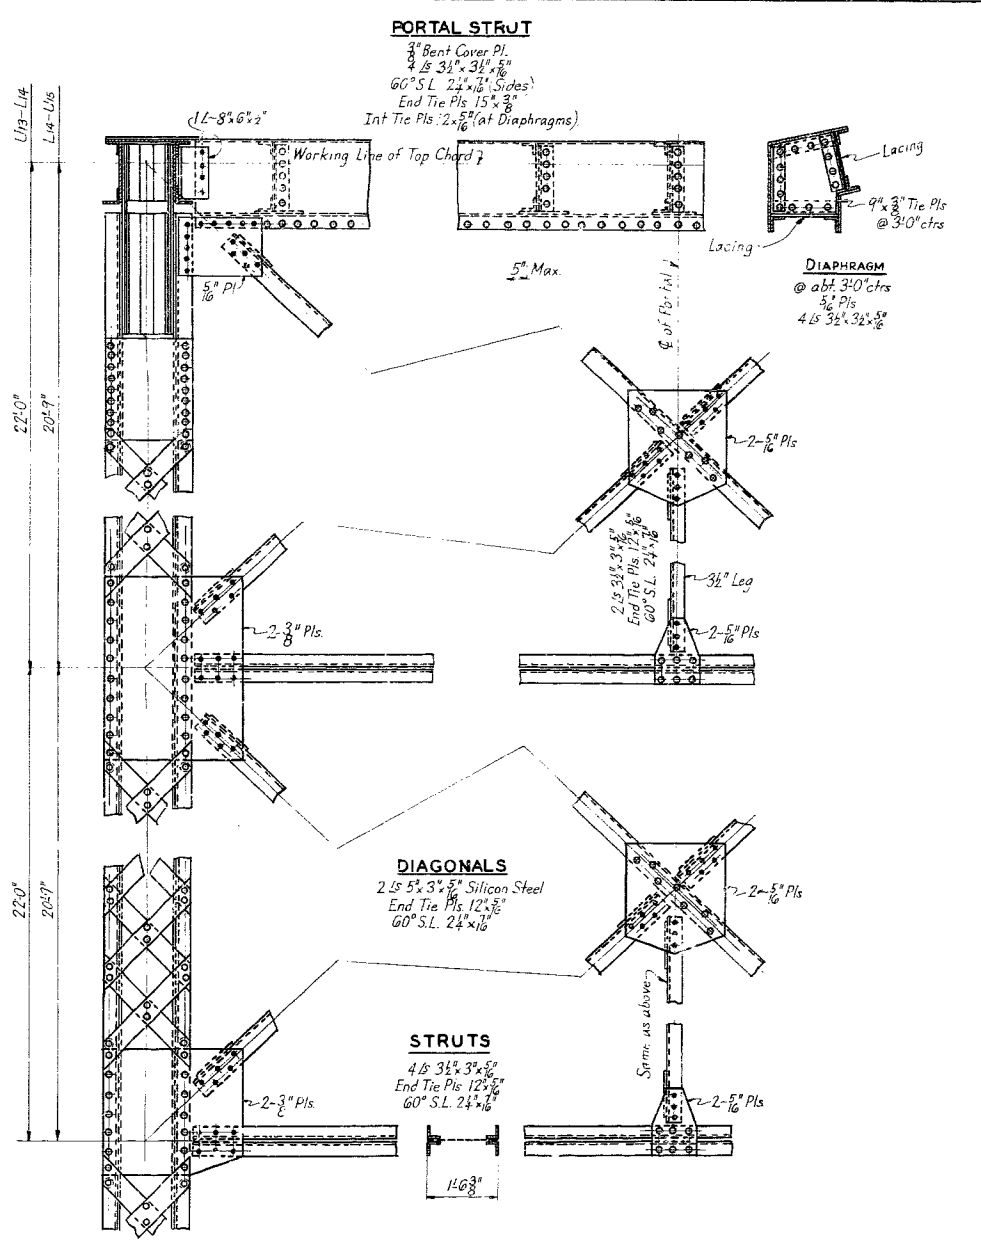

PORTALS AT U13-L14 AND U15-L14

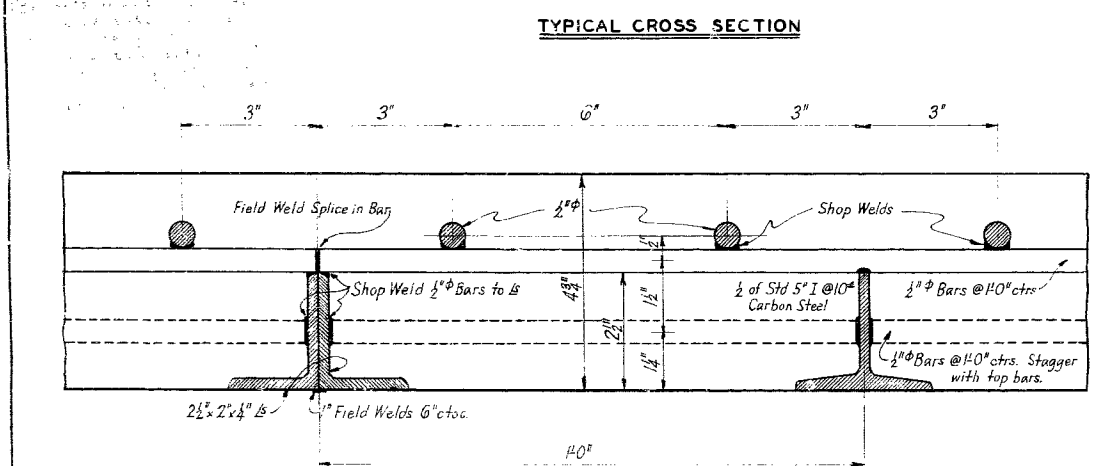

TYPICAL SLAB DETAILS

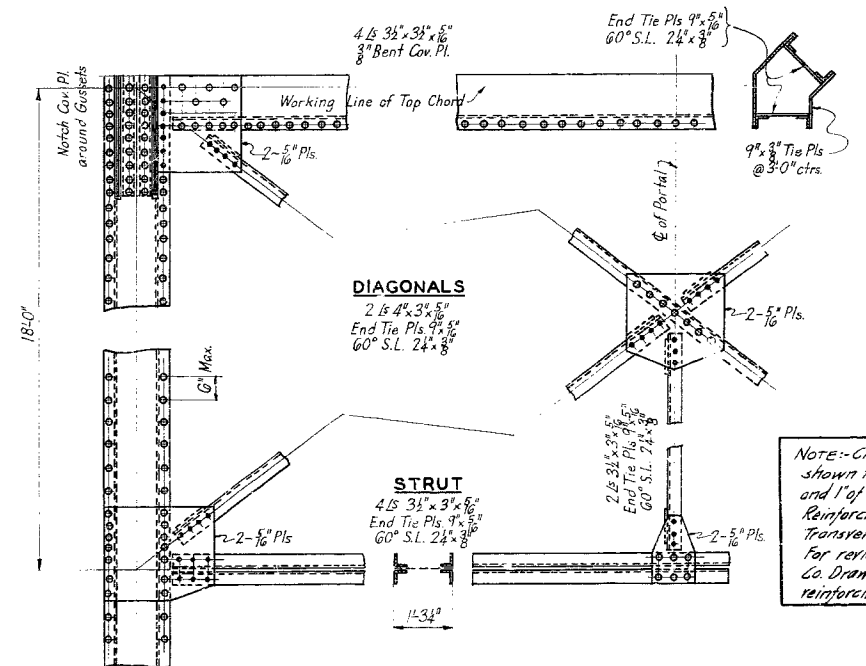

PORTAL AT U19-L20

NOTES

All material in sway frames and portals to be Carbon Steel, unless noted. All rivets $\frac{3}{4}$ " except rivets in batten plates & face bars of bracing, which are $\frac{1}{2}$ ". Slab Reinforcing Steel to have no paint applied in the shop. Field paint to consist of 2 coats of paint similar to that used on the Structural Steel, applied to the exposed flange of the tees after the forms have been removed and surface cleaned with a wire brush.

NOTE:- Changes in cross section are due to change from slab as shown to a slab 7" thick, consisting of 6" Maydite concrete and 1" of portland cement concrete, poured monolithically. Slab Reinforcing:- Longitudinal- 2# @ 4' c to c in bottom, 2# @ 3' c to c. Top Transverse- 2# @ top and bottom between adjacent crossbeams. For revised cross section of thru spurs see Kansas City Bridge Co. Drawing No. 5303. For details and setting plan of all deck reinforcing see Sverdrup & Parcel Drawing No. XI.

BRIDGE OVER MISSOURI RIVER AT KANSAS CITY KANSAS

FOR REGIONAL BRIDGE CO., INC.


MAIN SPAN STRUCTURAL DETAILS-CROSS SECTIONS

SVERDRUP AND PARCEL CONSULTING ENGINEERS ST. LOUIS, MO.

Made by L.F. April 1933
Traced by L.F. E.S. M. 1933
Checked by J.P. June 33


SHEET NO. 10

NOTES

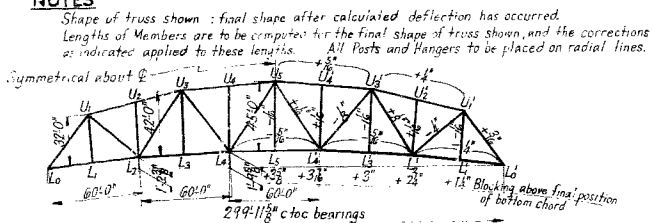


CAMBER DIAGRAM

TABLE OF STRESSES											
MEMBER	50° WIND	DEAD LOAD	CONC. L.L.	UNIF. L.L.	20° WIND	DESIGN STRESS PER WIND	DESIGN STRESS PER DEAD				
LoLz	168 T	218 T	16 T	74 T	102 T	308 T	214 T				
LoLz	185 C				106 C						
LzLz	279 T	342 T	27 T	132 T	180 T	551 T	131 T				
LzLz	279 C				180 C						
LoLz	307 T	438 T	30 T	146 T	194 T	614 T	808 T				
LoLz	307 C				194 C						
LoLz		320 C	22 C	108 C		450 C					
UzLz	55 C	342 C	24 C	115 C	27 C	481 C	508 C				
UzLz	55 T				27 T						
UzLz	90 C	435 C	30 C	144 C	45 C	629 C	854 C				
UzLz	90 T				45 T						
UzLz		175 T	15 T	64 T		254 T					
UzLz		94 C	12 C	44 C		150 C					
UzLz		72 T	12 T	50 T		124 T					
UzLz		8 C		17 C							
LoLz		7 C	11 C	29 C		64 C					
UzLz		11 T		27 T		50 T					
UzLz		40 T	26 T	25 T		91 T					
UzLz		8 C				8 C					
UzLz		42 T	26 T	25 T		93 T					
UzLz		9 C				9 C					
UzLz		43 T	26 T	25 T		94 T					

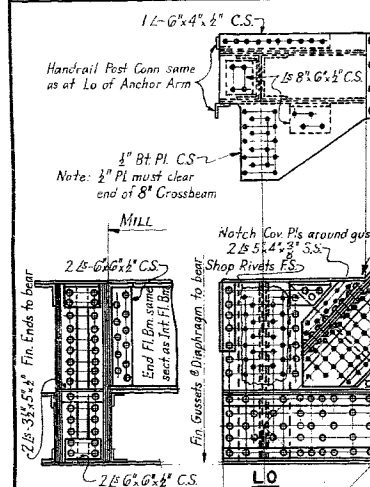

DIAPHRAGM
2x2-6x4x1/2 C.S.
4x4-6x4x1/2 C.S.

NOTE: On account of erection stresses LoLz at north end only of south span only was changed to 2 Pls 18x3/8 S.S. and 4 Ls 3x1/2x3/8 S.S. LoLz at other points is as originally shown.

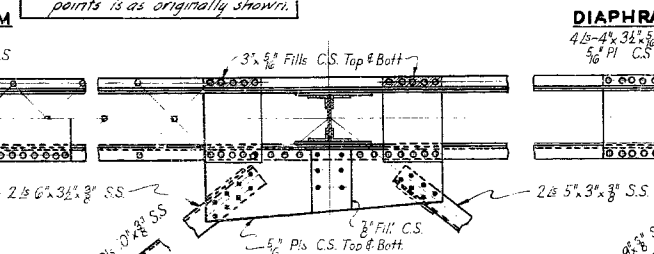

DIAPHRAGM
4x4-6x4x1/2 C.S.
3/8 Pl. C.S.

ALL BOTTOM LATERALS
End Tie Pls 12x3/8 C.S.
60° S.L. 1/4x1/2 C.S.


NOTES
All material marked "S.S." to be Silicon Steel.
All material marked "C.S." to be Carbon Steel.
Ⓞ indicates maximum number of holes out to maintain required net section.
All rivets 3/4" except in battens and lacing of bracing, which are to be 3/8".
Clear distance between batten plates on tension members shall not exceed 3'-0".
See Sheet #10 for Typical Cross Section.
Shop weld 3/8" Fills to bottom Lateral Plates at L1, L2, L3.

ALL TOP LATERALS
2 Ls-5x3/8 S.S.
End Tie Pls 12x3/8 C.S.
60° S.L. 2x3/8 C.S.
For Splice, see Bot. Lats


ALL TOP STRUTS
4 Ls-4x3/8 S.S.
End Tie Pls 12x3/8 C.S.
60° S.L. 2x3/8 C.S.

PORTAL LO-U1
Same as portal Lo-U1 for Main Span. See Sheet #10.


DIAPHRAGM
2x2-6x4x1/2 C.S.
4x4-6x4x1/2 C.S.

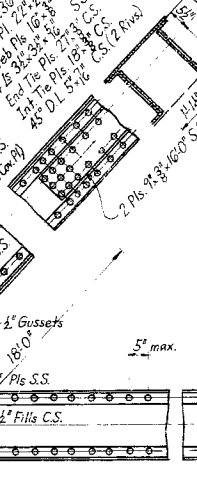


DIAPHRAGM
2x2-6x4x1/2 C.S.
4x4-6x4x1/2 C.S.

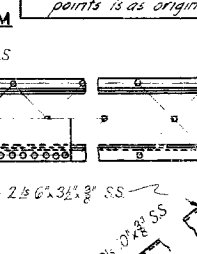

DIAPHRAGM
2x2-6x4x1/2 C.S.
4x4-6x4x1/2 C.S.

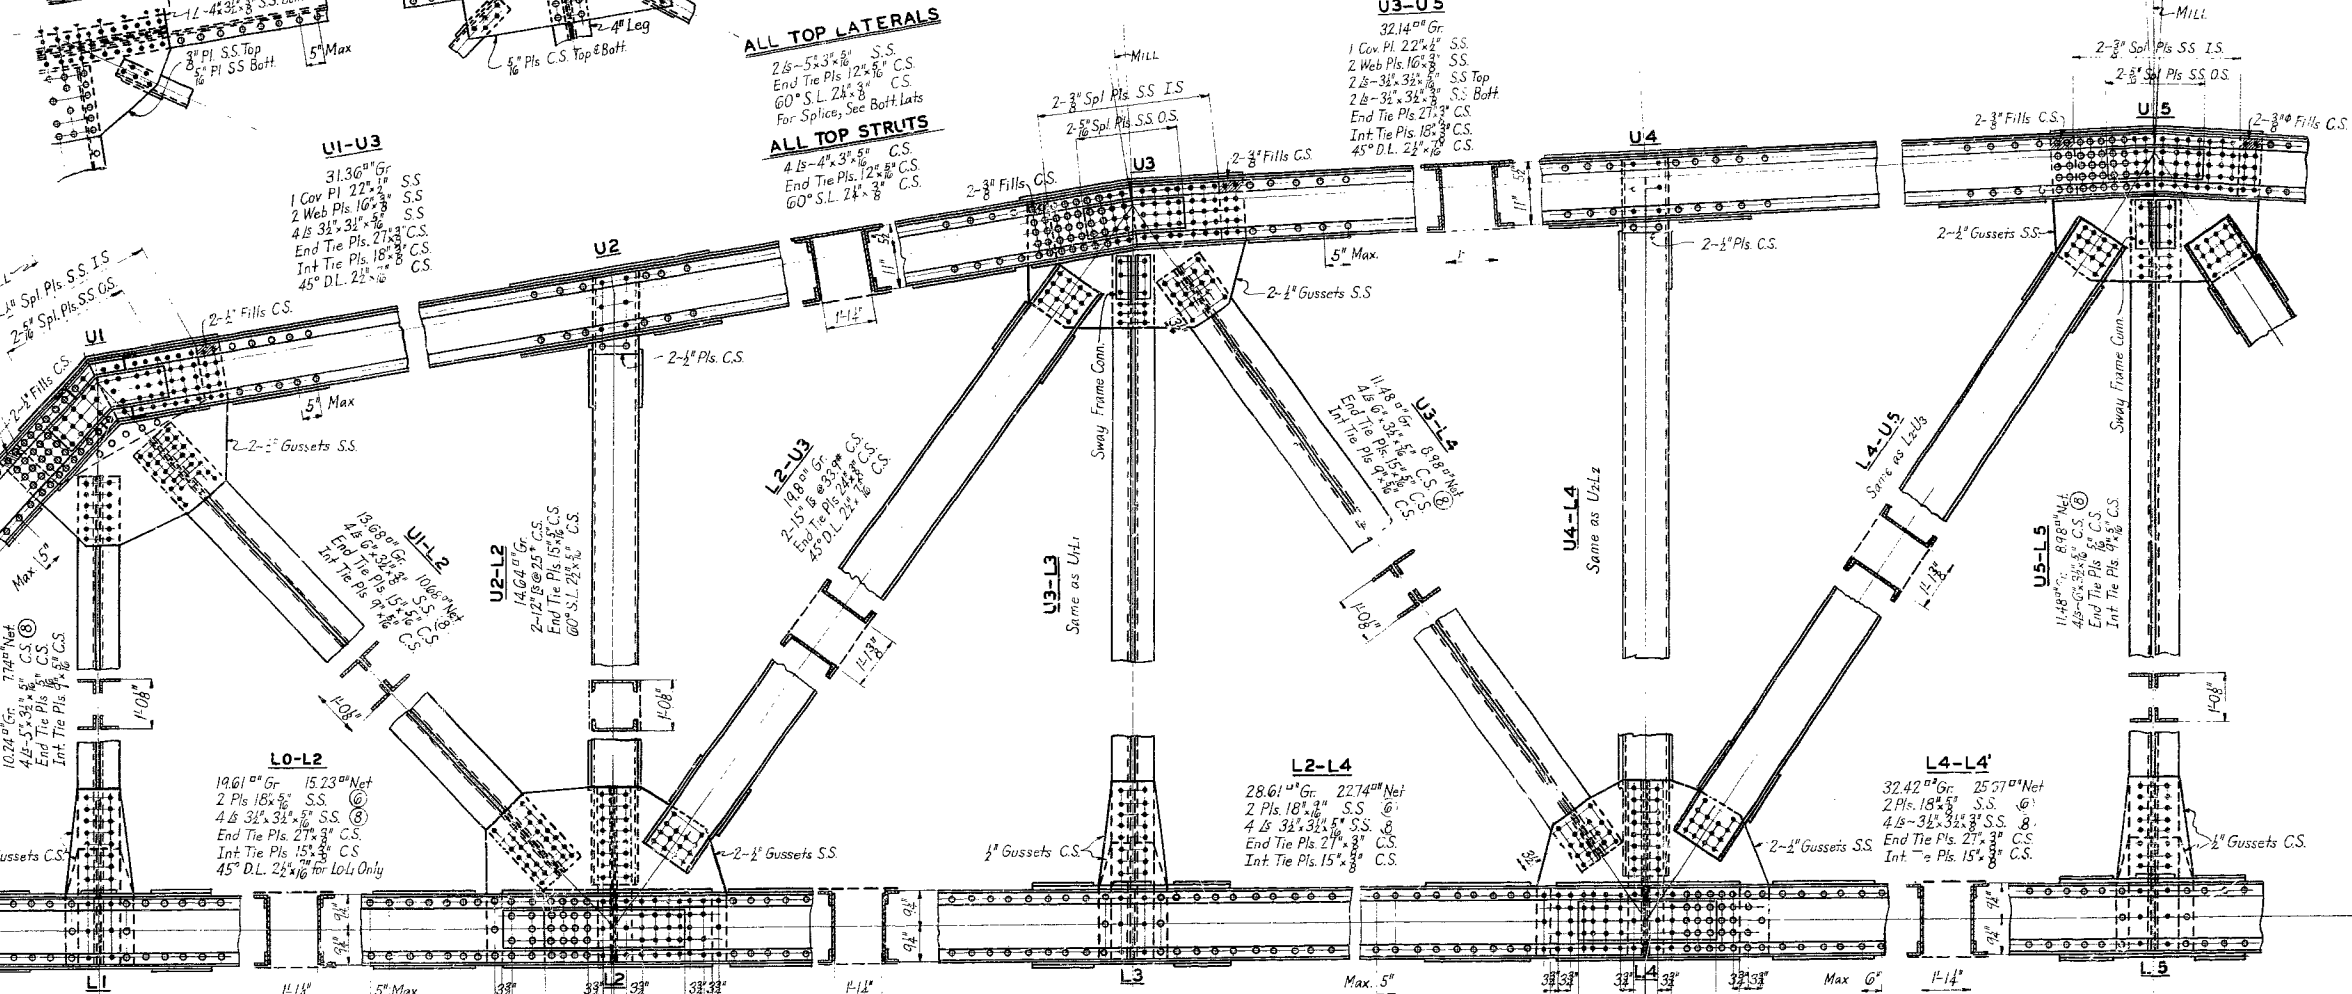

DIAPHRAGM
2x2-6x4x1/2 C.S.
4x4-6x4x1/2 C.S.

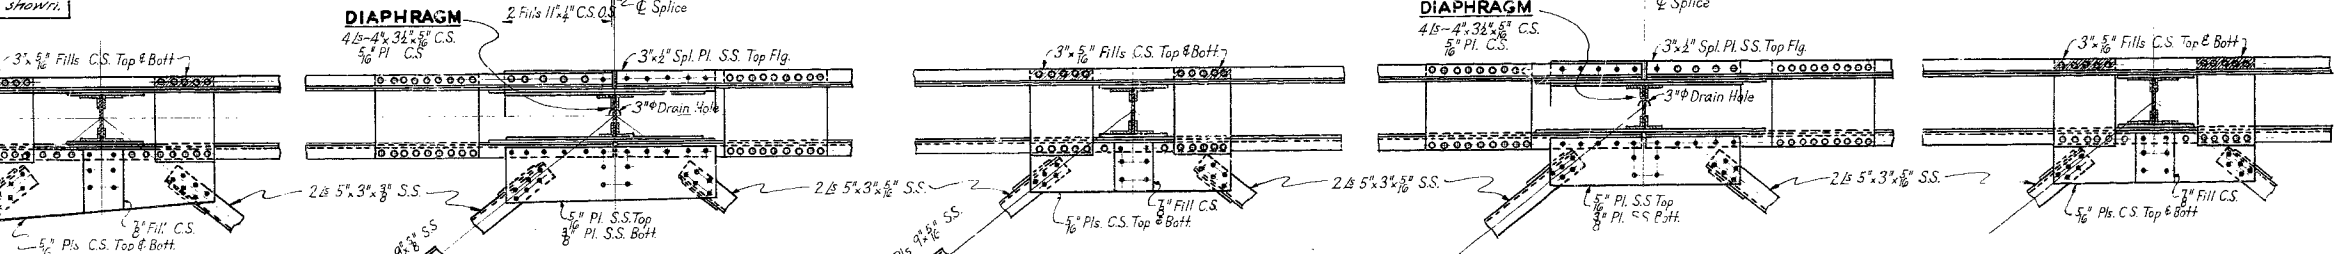


DIAPHRAGM
2x2-6x4x1/2 C.S.
4x4-6x4x1/2 C.S.


**BRIDGE OVER MISSOURI RIVER
AT KANSAS CITY, KANSAS**
FOR REGIONAL BRIDGE CO., INC.
300 FT. SPAN STRUCTURAL DETAILS
SVERDRUP AND PARCEL
CONSULTING ENGINEERS
ST. LOUIS, MO.
Made by B.R.S. April 1933
Traced by L.P. & C.E.S. May 1933
Checked by J.A.J. June 1933

L18


L19

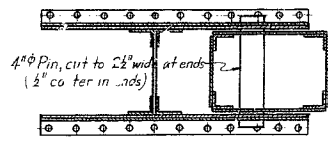


SECTION A-A

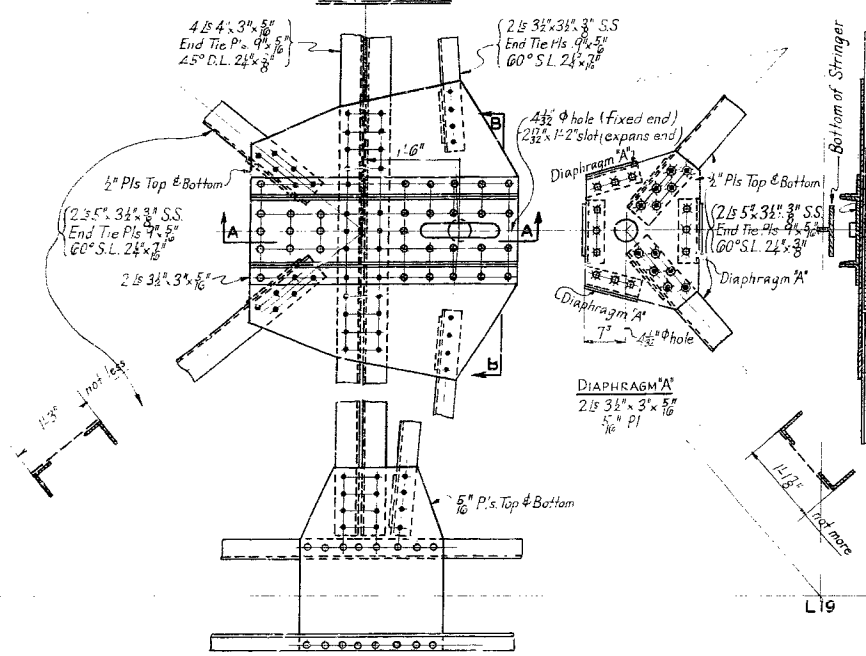


WIND TRANSFER DEVICE AT END OF SUSPENDED SPAN

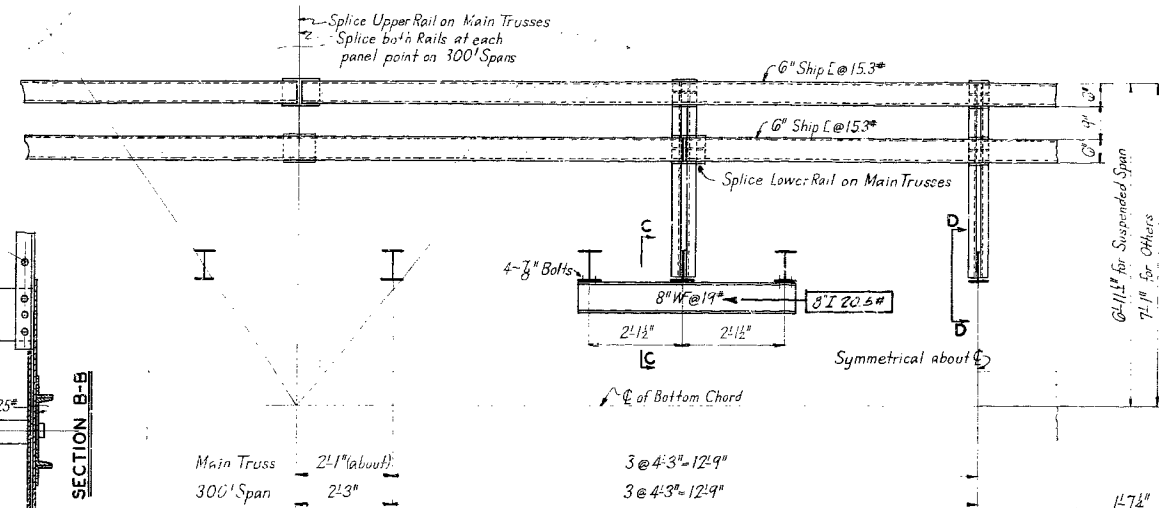


TYPICAL PANEL OF HANDRAILING

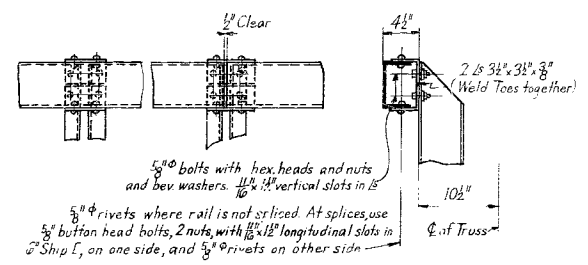

TYPICAL HANDRAIL DETAILS

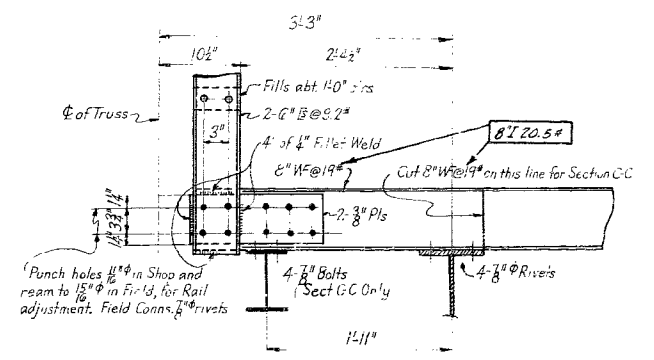


SECTIONS C-C AND D-D

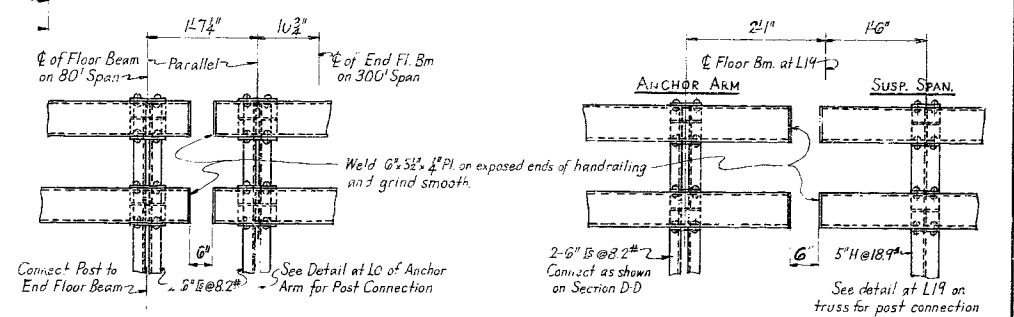


HANDRAIL DETAIL AT PIERS 5 AND 10


HANDRAIL DETAIL AT L19

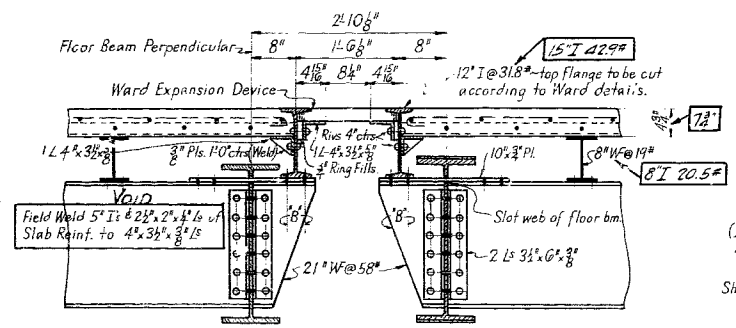


EXPANSION DEVICE AT PIERS 6 AND 9

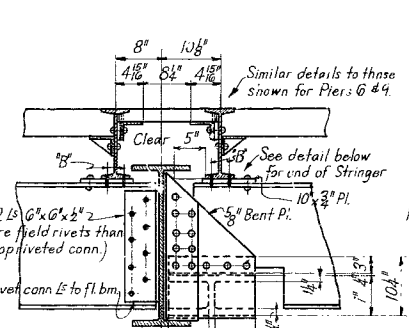

EXPANSION DEVICE AT L19 ONLY

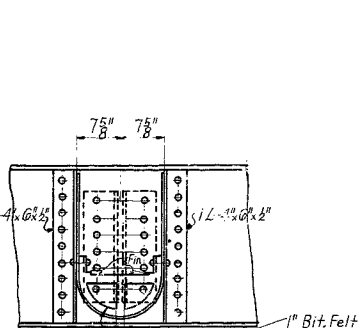


CURB EXPANSION DEVICE

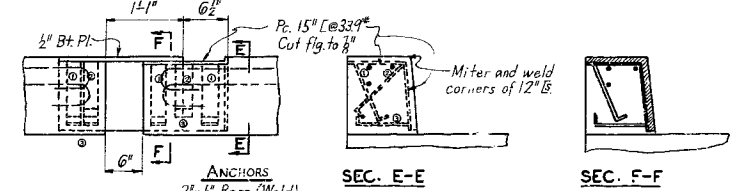


SEC. E-E


SEC. F-F

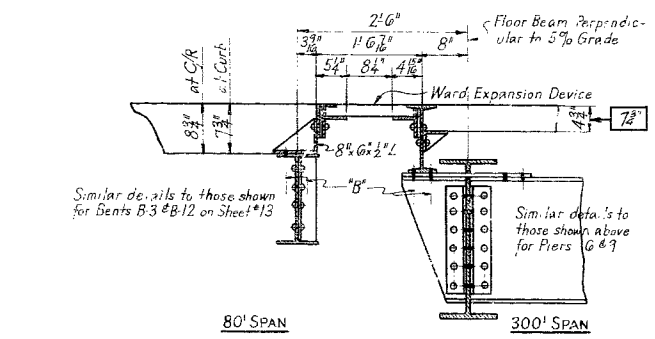

EXPANSION DEVICE AT PIERS 5 AND 10

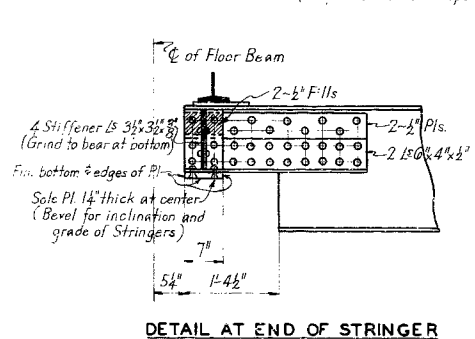


DETAIL AT END OF STRINGER AT L19 ONLY

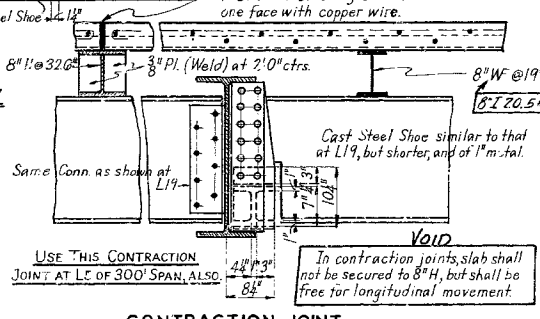


CONTRACTION JOINT AT L6, L8 AND L19

(L19 is fixed end of Suspended Span.)

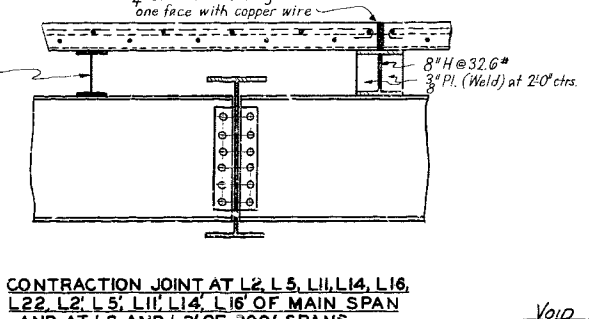

CONTRACTION JOINT AT L2, L5, L11, L14, L16, L22, L2, L5, L11, L14, L16 OF MAIN SPAN AND AT L2 AND L2 OF 300' SPANS

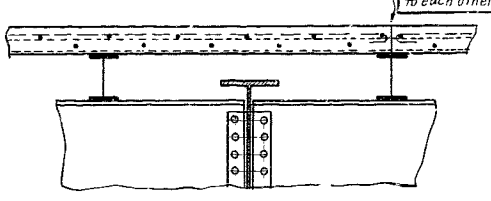

TYPICAL JOINT FOR SLAB REINFORCING

NOTES
 All material marked 'S.S.' to be Silicon Steel. All other material, except as noted, to be Carbon Steel.
 Expansion device supports to be curved to a parabola to conform to crown of roadway.
 Attachment of Ward Expansion Device to be made in accordance with the manufacturer's details.
 Expansion Devices and structural steel supports to be assembled together in shop to insure fit in field.
 Holes marked 'B' to be reamed in shop with pins assembled, and pieces match-marked.
 Weight of Ward Expansion Devices is included in the quantity item for Cast Steel.
 All expansion joints are shown in normal position at a temperature of 60°F.
 Unless otherwise noted, all rivets are to be 3/8 inch except in battens, and lacing of bracing, which are to be 3/4 inch.
 All crossbeams to be curved to conform to crown of roadway.

NOTE: Steel framing remains as shown, unless otherwise noted. For change in roadway slab refer to Sheet No. 10.

BRIDGE OVER MISSOURI RIVER AT KANSAS CITY, KANSAS

FOR REGIONAL BRIDGE CO., INC.

EXPANSION AND HANDRAIL DETAILS



SVERDRUP AND PARCEL
 CONSULTING ENGINEERS
 ST. LOUIS, MO.

Made by L.P. April 1933
 Traced by L.P. & C.E.S. May 1933
 Checked by B.R. June 1933

SHEET NO. 12

Revised 7-17-33 (Dimension in Sec. C-C & D-D changed to 14 1/2")

Revised 7-17-33 (Size of Hanger & Sway Frame Shown)

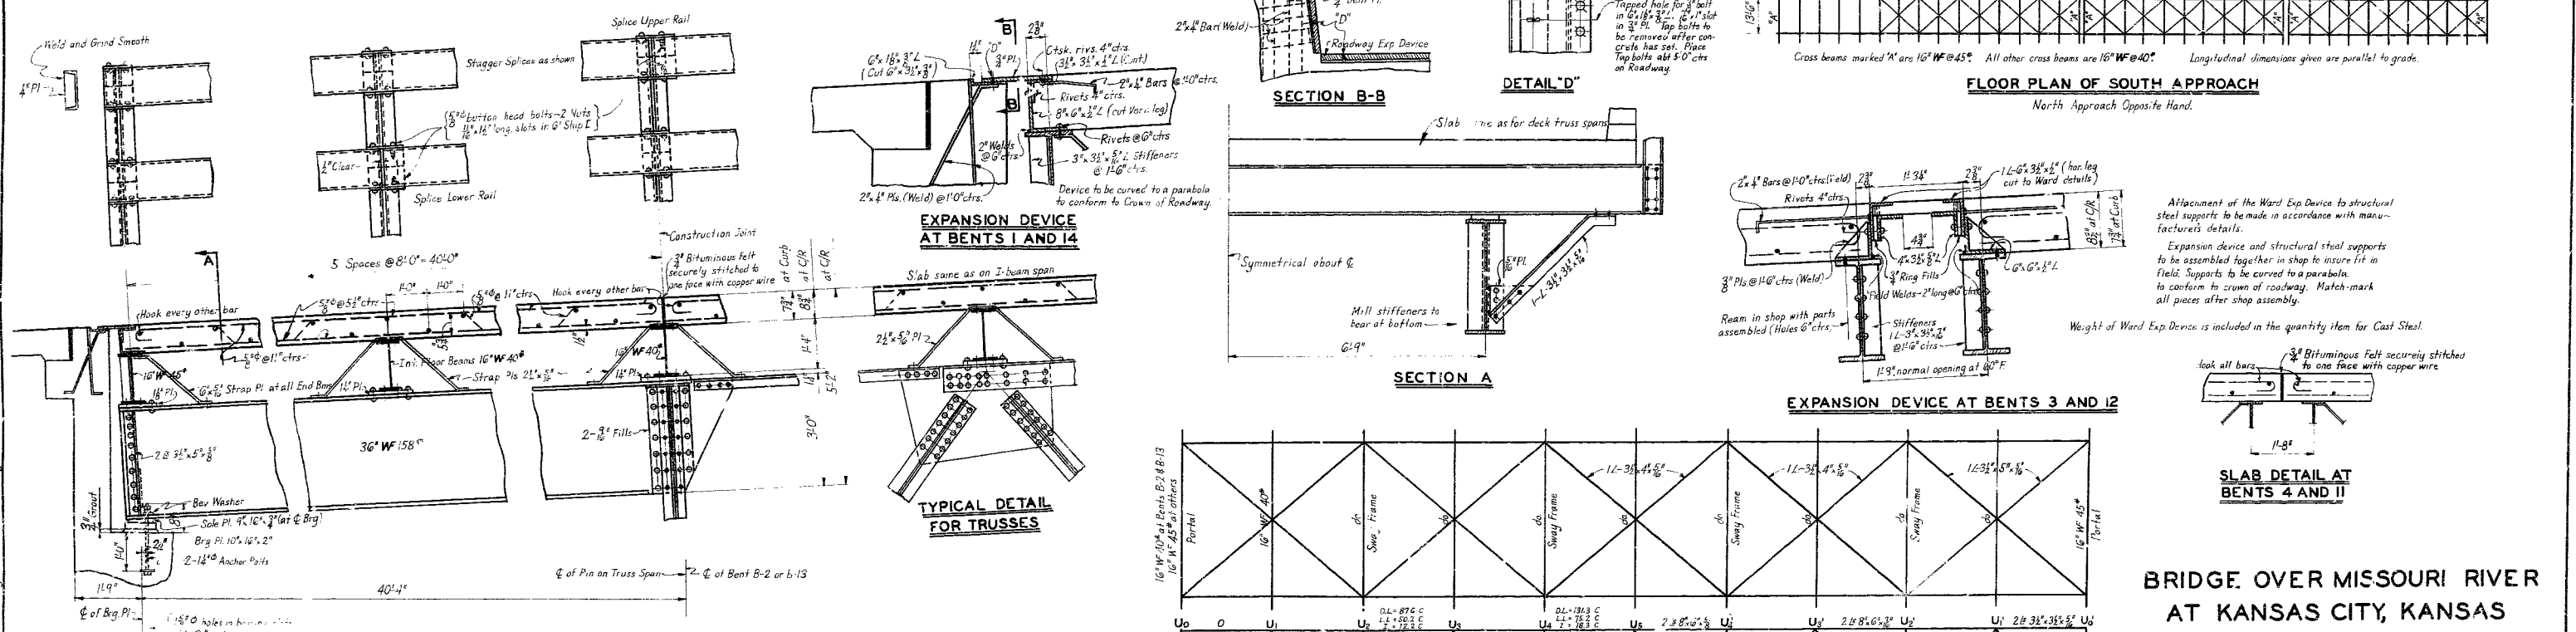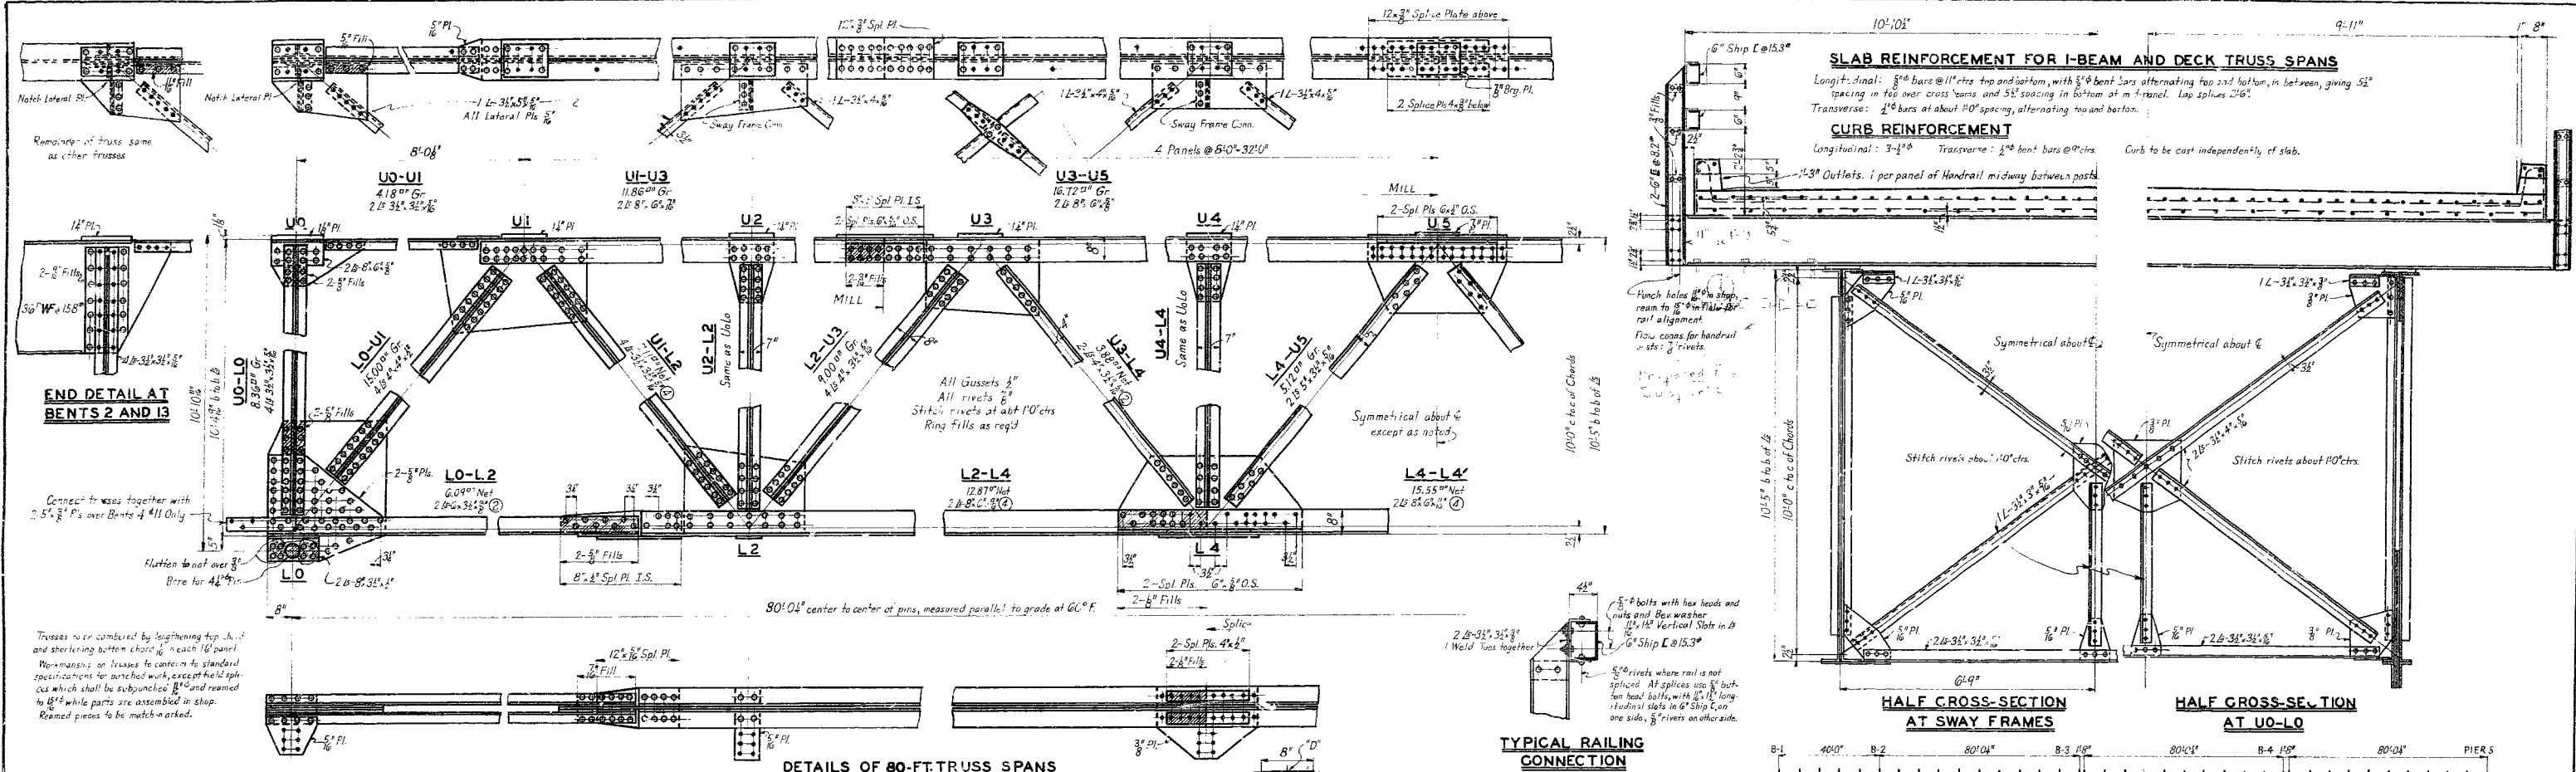

**BRIDGE OVER MISSOURI RIVER
 AT KANSAS CITY, KANSAS**


FOR REGIONAL BRIDGE CO., INC.

STRUCTURAL DETAILS—APPROACH SPANS


Prepared by **SVERDRUP AND PARCEL**
 CONSULTING ENGINEERS
 ST. LOUIS, MO.

Checked by L.F. April 1933
 Traced by L.F. & E.S. May 1933
 Checked by B.S. June 1933


SHEET NO. 13

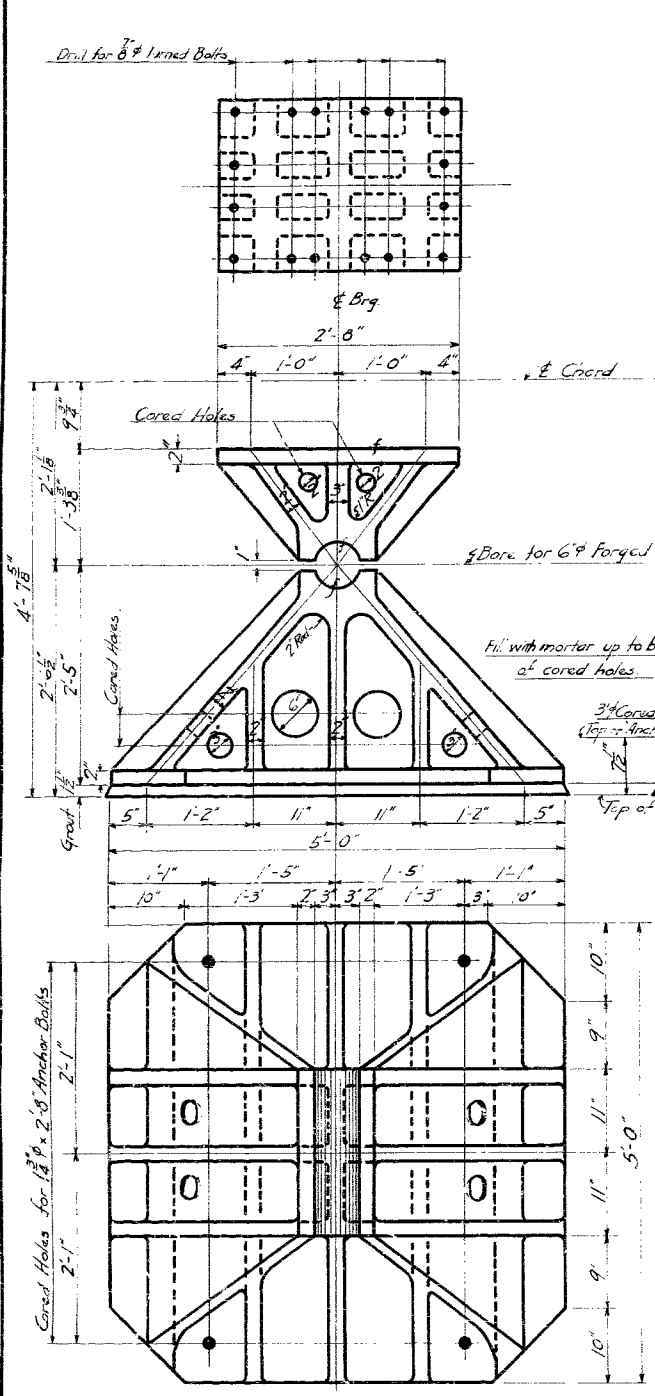

FIXED SHOES FOR 80' SPANS
4 Req'd.

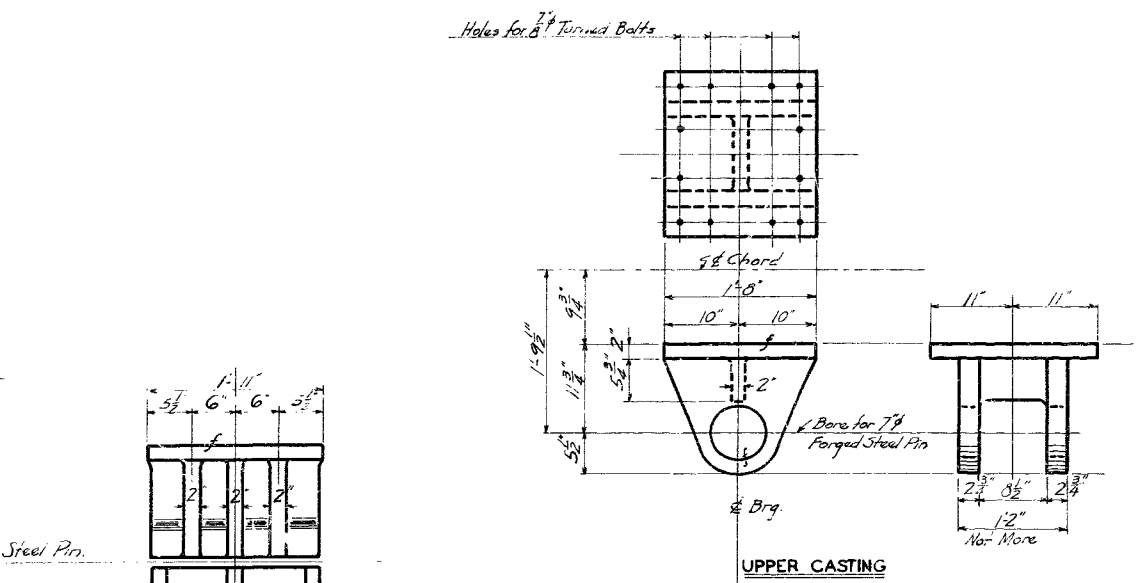


UPPER CASTING

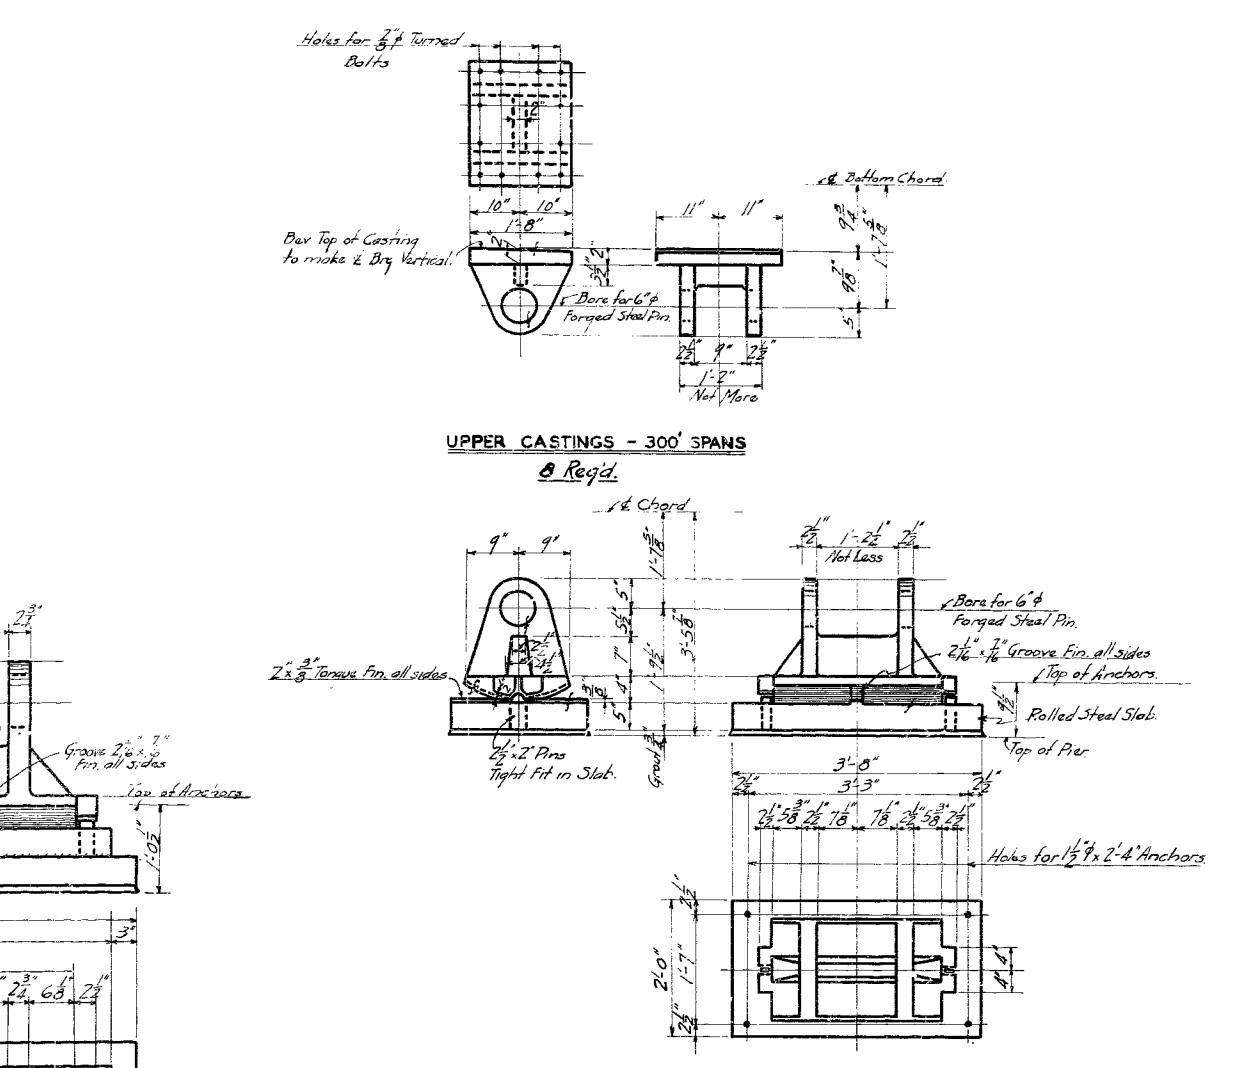


UPPER CASTINGS - 300' SPANS
4 Req'd.

LOWER CASTINGS AND SLABS

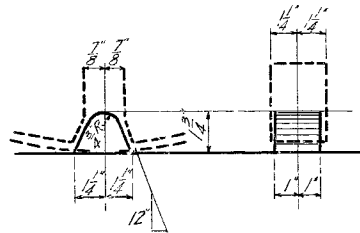


DETAIL OF CENTERING PINS

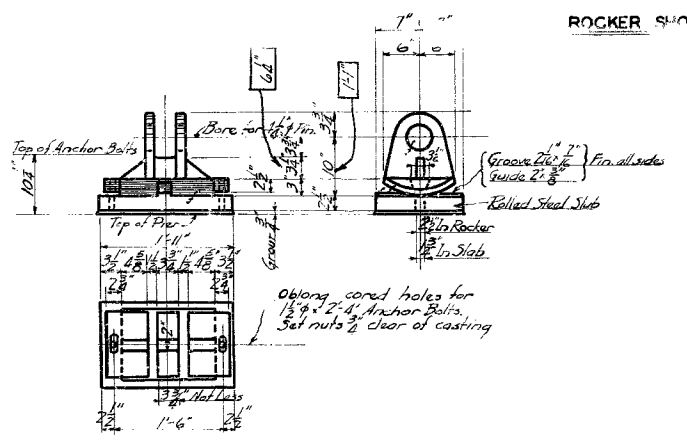

ROCKER SHOES FOR 80' SPANS
16 Req'd.

ROCKER SHOE AT LO OF ANCHOR BOLTS
4 Req'd.

NOTES:
All material cast steel annealed unless noted.
All fillets 1/2" radius unless noted.
Pins, pin nuts, roller steel slabs and anchor bolts included in the quantity item for Structural Steel.
Pin surfaces of pins and castings to be coated with White Lead and tallow at the shop.
All anchor bolts to be furnished with square head, 2 square nuts and 1/2" plate washers.

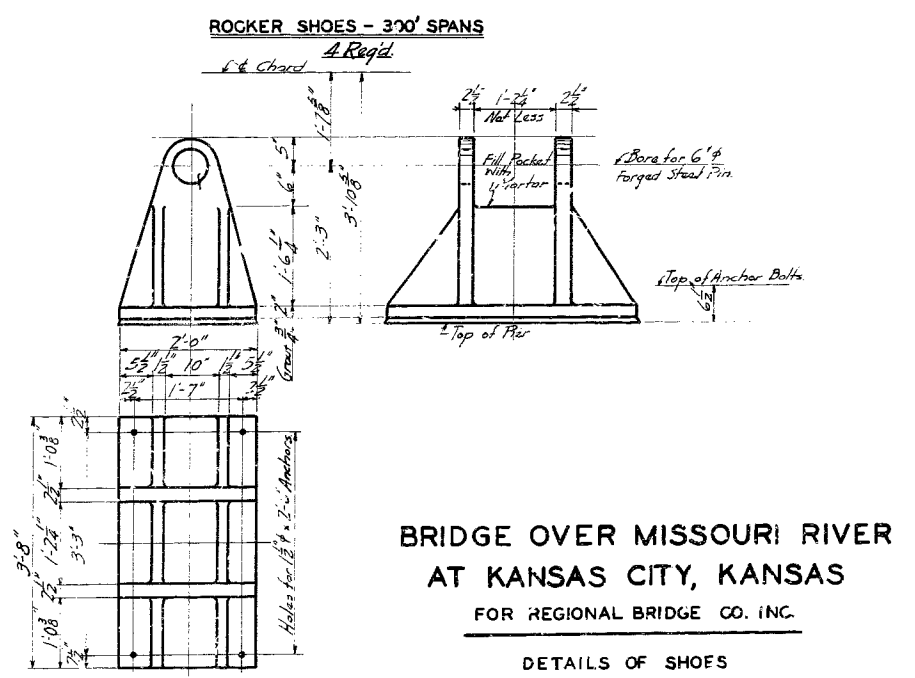

FIXED SHOES - 300' SPANS
4 Req'd.


**BRIDGE OVER MISSOURI RIVER
AT KANSAS CITY, KANSAS**

FOR REGIONAL BRIDGE CO. INC.


DETAILS OF SHOES

SVERDRUP AND PARCEL
CONSULTING ENGINEERS
ST. LOUIS, MO.


Made by B.R.S. April, 1933
Traced E.M. June, 1933
Checked J.A.J. June, 1933

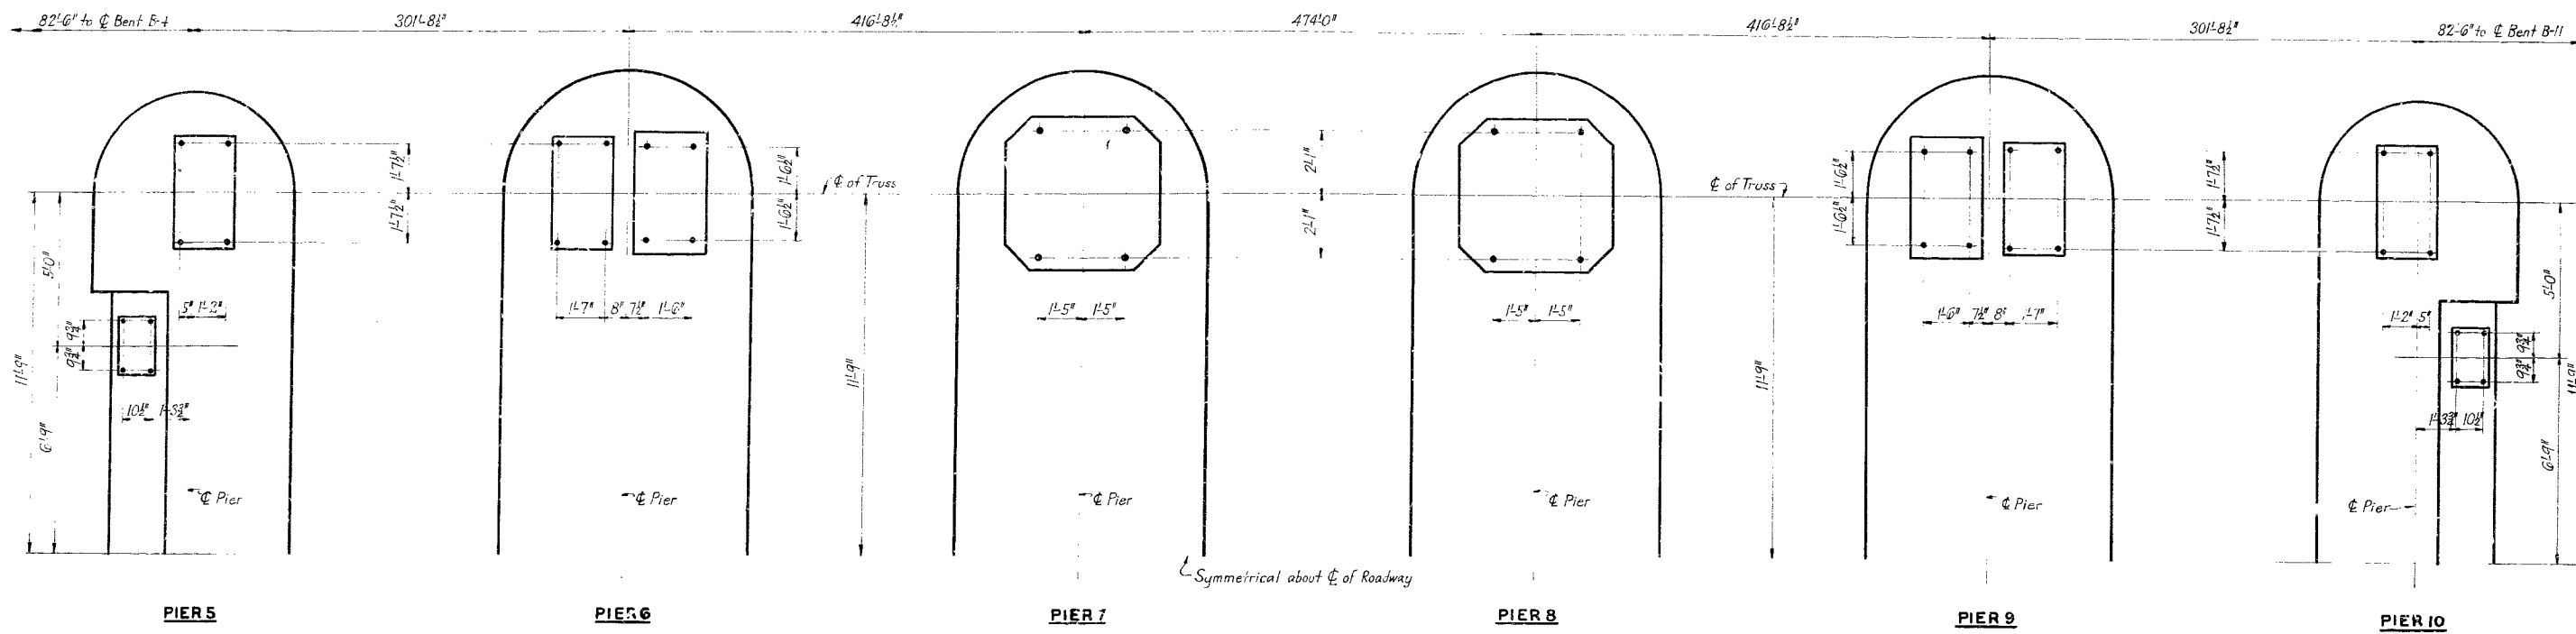

PIERS

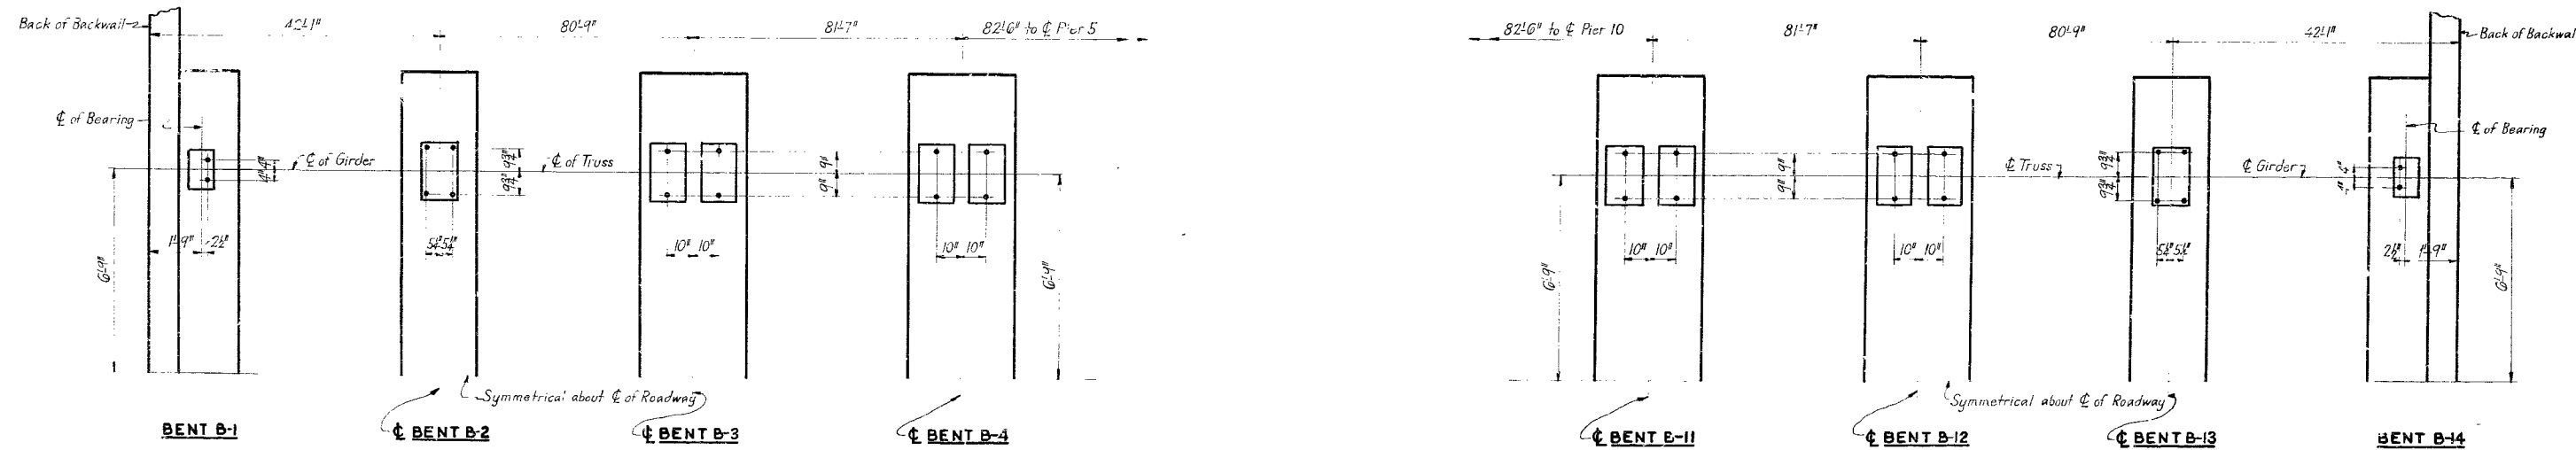

BENTS

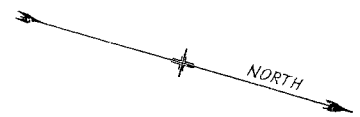



**BRIDGE OVER MISSOURI RIVER
AT KANSAS CITY KANSAS**

FOR REGIONAL BRIDGE CO., INC.

ANCHOR BOLT DIAGRAM

SVERDRUP AND PARCEL
CONSULTING ENGINEERS
ST. LOUIS, MO.

Made by C.E.S. July 1933
Traced by C.E.S. Jr. July 1933
Checked by J.A.J. July 1933

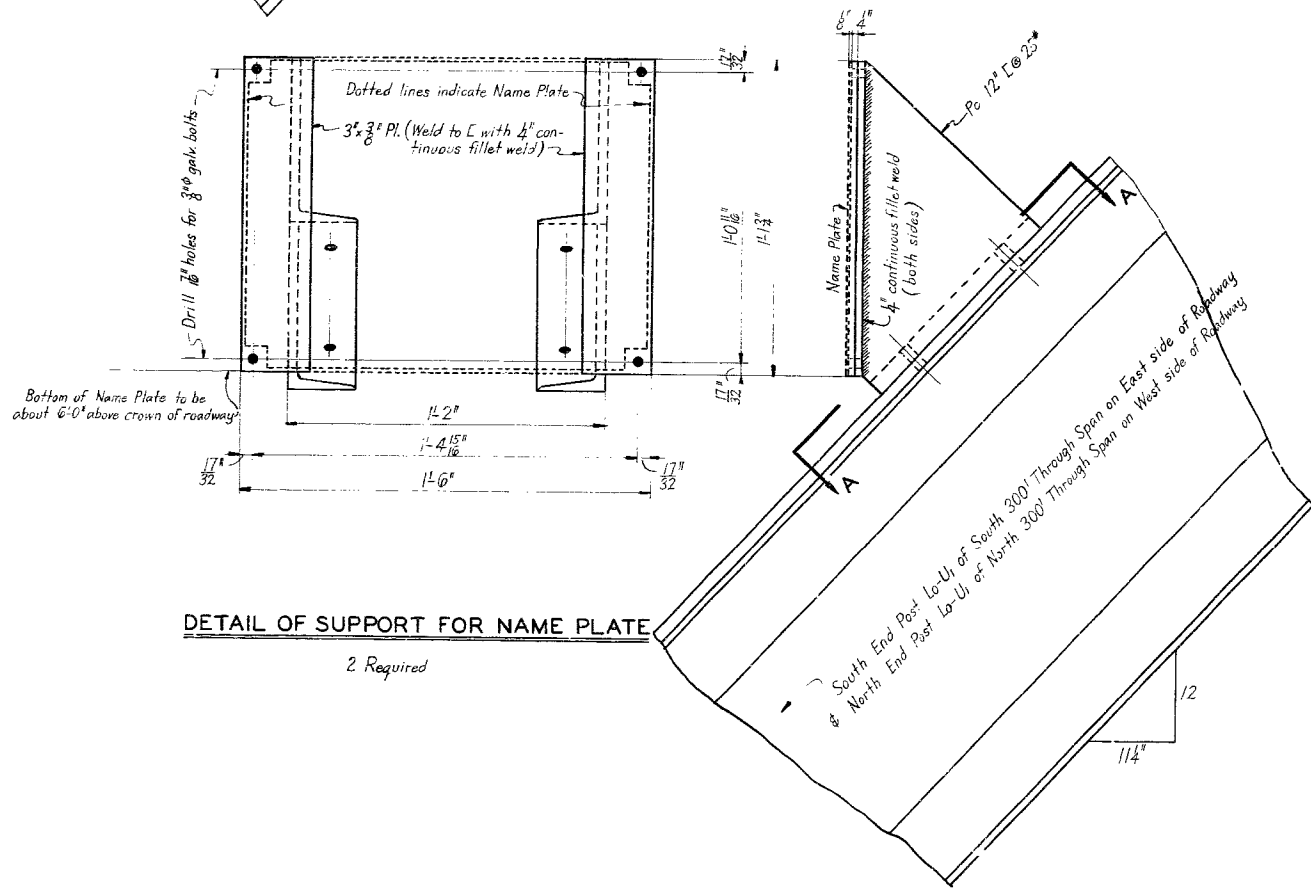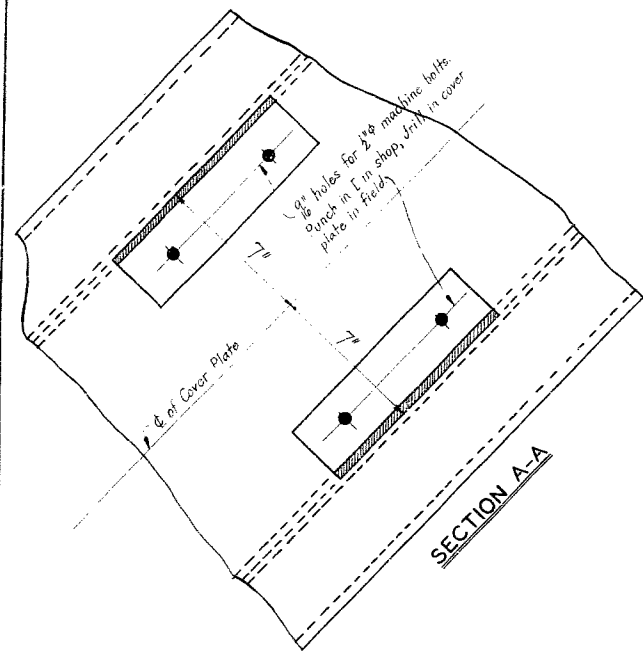

FAIRFAX BRIDGE

INITIATED BY
GREATER KANSAS CITY REGIONAL PLAN ASSOCIATION

FINANCED BY
RECONSTRUCTION FINANCE CORPORATION

IN COOPERATION WITH
STATE HIGHWAY COMMISSION OF MISSOURI
STATE HIGHWAY COMMISSION OF KANSAS
CITY OF KANSAS CITY, KANSAS
PLATTE COUNTY, MISSOURI
WYANDOTTE COUNTY, KANSAS
REGIONAL BRIDGE COMPANY

SVERDRUP AND PARCEL
CONSULTING ENGINEERS

DEDICATED
A.D. 1934

KANSAS CITY BRIDGE CO.
CONTRACTORS

FULL SIZE ELEVATION OF NAME PLATE
2 Required


Name Plates to be cast of an alloy composed of the following metals--
88% Aluminum, 10% Zinc, 2% Copper
Face of letters and edges of plate to have polished finish.
Background to have pebbled finish.
Attachment bolts to be galvanized with hex. heads and galv. hex. nuts.

**BRIDGE OVER MISSOURI RIVER
AT KANSAS CITY, KANSAS**
FOR REGIONAL BRIDGE CO. INC.
DETAIL OF BRIDGE NAME PLATE
SVERDRUP AND PARCEL
CONSULTING ENGINEERS
ST. LOUIS, MO.


Made By C.E.S. Jr. & L.F. May 1931
Traced By C.E.S. Jr. & L.F. May 1931
Checked By R.R.S. May 1934

NOTE



FOR SL2, SL3, SL4, SL6, SL7, SL8, SL9
 in 2 Curbs - 6 Bars
 in top of slab - 33 Bars
 Total - 39 Bars

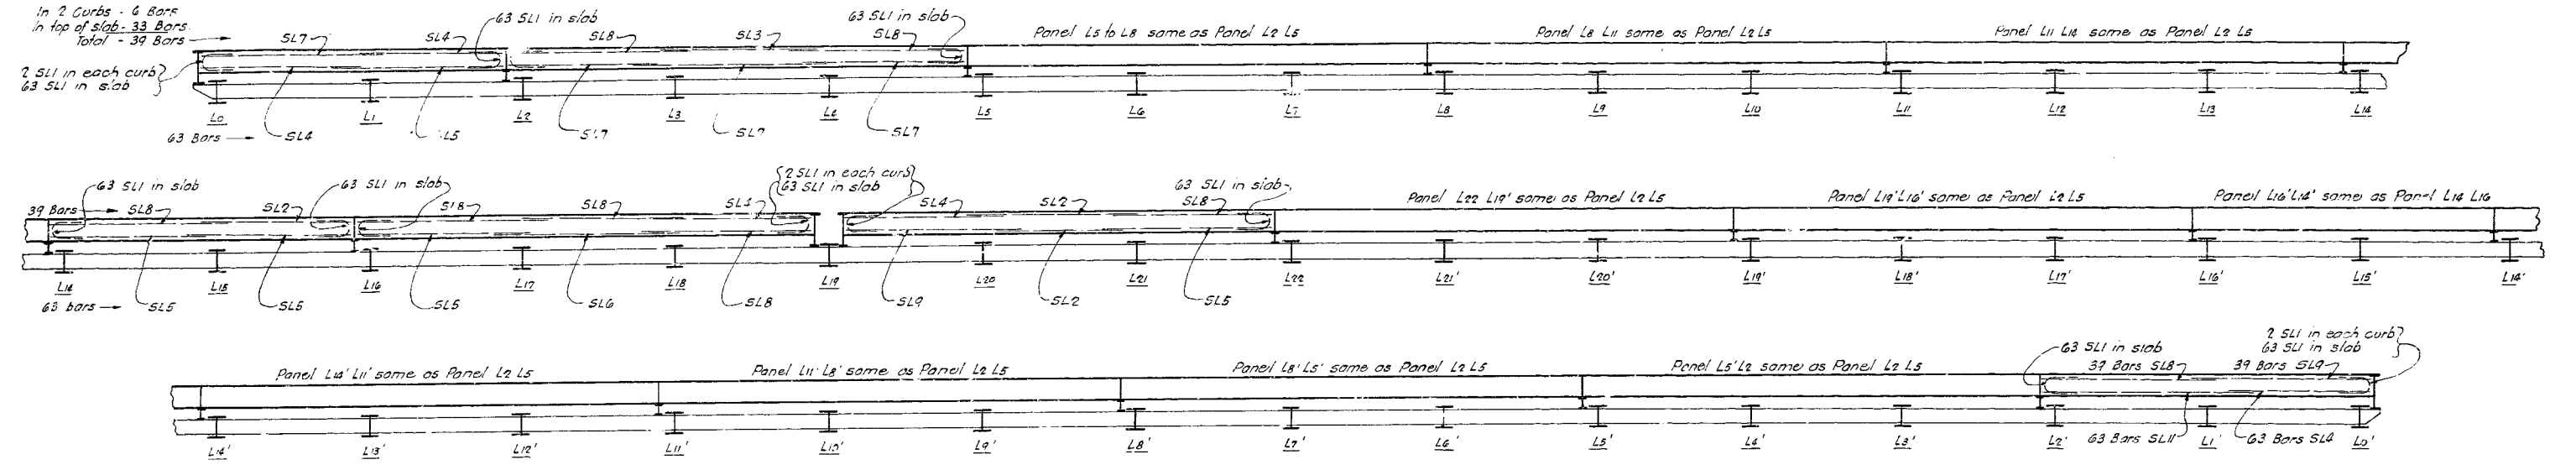


LONGITUDINAL SECTION THROUGH SLAB, MAIN SPAN
 Showing Marks of Longitudinal Bars in Slab & Curb

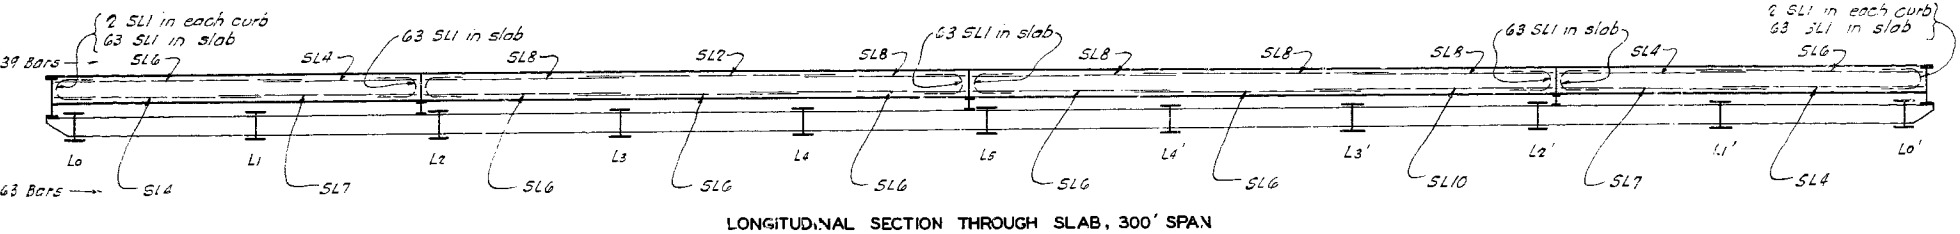


LONGITUDINAL SECTION THROUGH SLAB, 300' SPAN
 Showing Marks of Longitudinal Bars in Slab and Curb

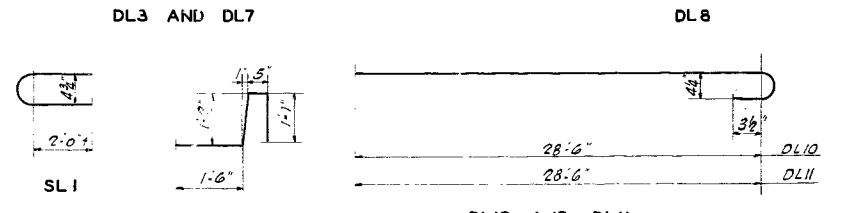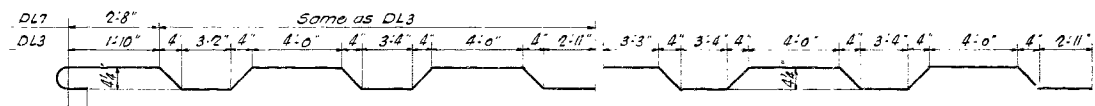


DL3 AND DL7
 DL8
 DL10 AND DL11
 DT2 AND ST2 (ALIKE)

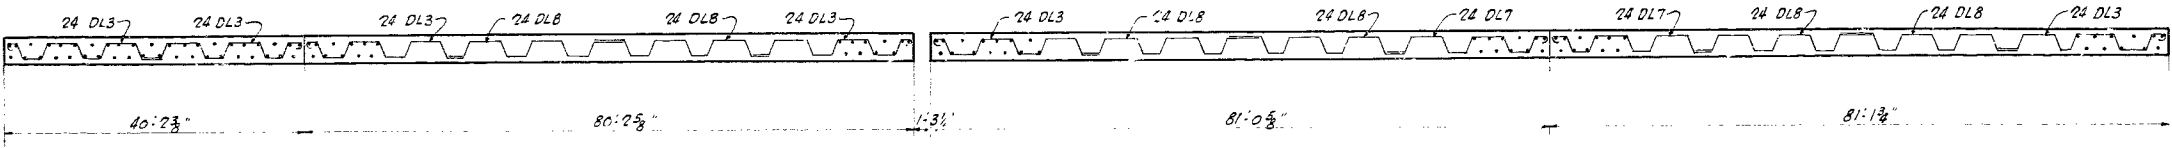


LONGITUDINAL SECTION THROUGH APPROACH SLAB
 Showing Marks of Longitudinal Bent Bars in Slab

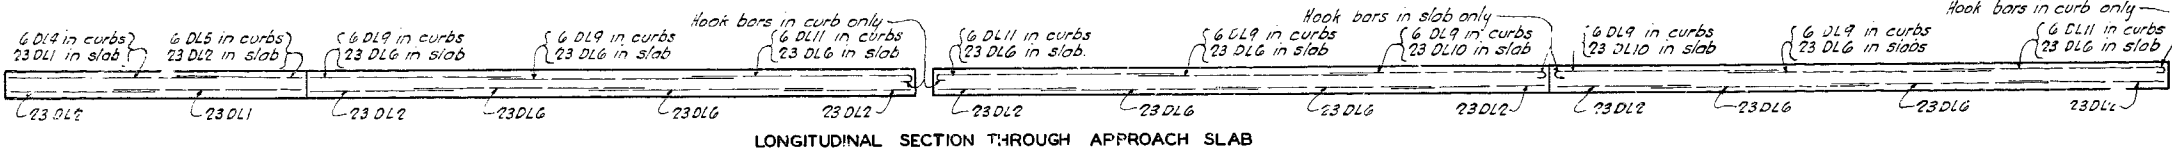

LONGITUDINAL SECTION THROUGH APPROACH SLAB
 Showing Marks of Longitudinal Straight or Hooked Bars in Slab and Curb

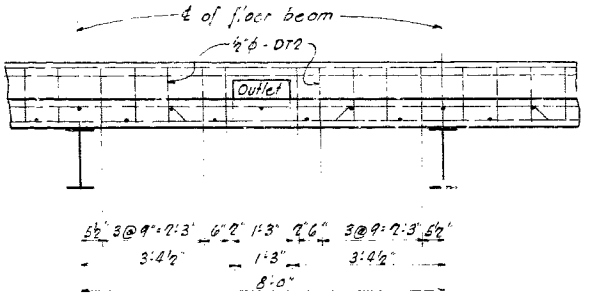

TYPICAL PANEL AT CURB FOR APPROACH SPAN

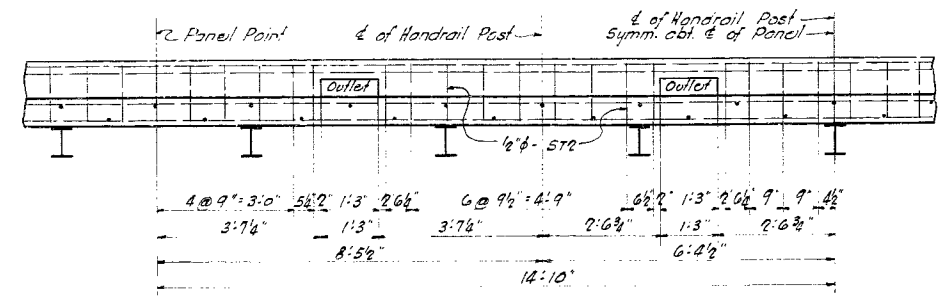

TYPICAL PANEL AT CURB FOR MAIN SPAN
 Panel as shown is for anchor arm and cantilever arm.
 Suspended span and 300' span similar.

BILL OF REINFORCING BARS
 SPANS 5-8 & 9-10

Mark	Reqd. in 1 Span	Total 2 Spans	Size	Length	Shape
ST1	284	568	1/2"	21'-0"	Str.
ST2	748	1496	1/2"	4'-2"	Bent
SL1	512	1024	1/2"	4'-8"	Bent
SL2	39	78	1/2"	28'-2"	Straight
SL4	204	408	1/2"	29'-2"	"
SL6	393	786	1/2"	31'-2"	"
SL7	126	252	1/2"	30'-10"	"
SL8	195	390	1/2"	32'-8"	"
SL10	63	126	1/2"	35'-8"	"

BILL OF REINFORCING BARS
 ENTIRE MAIN SPAN

Mark	Total Reqd.	Size	Length	Shape
ST1	1232	1/2"	21'-0"	Str.
ST2	2964	1/2"	4'-2"	Bent
SL1	2032	1/2"	4'-8"	Bent
SL2	180	1/2"	28'-2"	Str.
SL3	390	1/2"	27'-2"	"
SL4	243	1/2"	29'-2"	"
SL5	441	1/2"	30'-10"	"
SL6	63	1/2"	31'-2"	"
SL7	1929	1/2"	30'-10"	"
SL8	1077	1/2"	32'-8"	"
SL9	102	1/2"	31'-0"	"
SL11	63	1/2"	35'-0"	"

BILL OF REINFORCING BARS
 80 FT. TRUSS SPANS

Mark	Reqd. in 1 Span 2-3 or 12-13	Reqd. in 1 Span 3-4 or 11-12	Reqd. in 1 Span 4-5 or 10-11	Total 6 Spans	Size	Length	Shape
DL1	46	46	46	276	3/8"	15'-6"	Str.
DL3	48	24	24	192	3/8"	22'-7"	Bent
DL6	115	92	92	298	3/8"	28'-6"	Str.
DL7	-	24	24	96	3/8"	23'-5"	Bent
DL8	48	48	48	288	3/8"	23'-4"	"
DL9	12	12	12	72	1/2"	24'-3"	Str.
DL10	-	23	23	92	3/8"	29'-4"	Bent
DL11	6	6	6	36	1/2"	29'-4"	Bent
DT1	81	81	81	486	1/2"	21'-0"	Str.
DT2	200	202	202	1208	1/2"	4'-2"	Bent

BILL OF REINFORCING BARS
 40 FT. BEAM SPANS

Mark	Reqd. in 1 Span	Total 2 Spans	Size	Length	Shape
DL1	46	92	3/8"	26'-9"	Str.
DL2	46	92	3/8"	15'-6"	"
DL3	48	96	3/8"	22'-7"	Bent
DL4	6	12	1/2"	26'-6"	Str.
DL5	6	12	1/2"	15'-2"	"
DT1	41	82	1/2"	21'-0"	"
DT2	102	204	1/2"	4'-2"	Bent

NOTE

For section through slab on through truss spans see Kansas City Bridge Co. Drawing 5303, dated Oct., 1933.

BRIDGE OVER MISSOURI RIVER AT KANSAS CITY, KANSAS
 FOR REGIONAL BRIDGE CO., INC.

REINFORCING SCHEDULE - SLAB AND CURB


SVERDRUP AND PARCEL
 CONSULTING ENGINEERS
 ST. LOUIS, MO.

Bars having 'D' as first letter of mark are used in beam and deck truss spans; those having 'S' as first letter are used in through truss spans.
 Second letter 'L' designates longitudinal bars; 'T' designates transverse bars.
 All reinforcing steel to comply with specifications and general drawings furnished by Sverdrup and Parcel.

Made By L.F. Jan. 1936
 Traced By W.L.W.
 Checked By J.A.D. Feb. 1934

MISSOURI STATE HIGHWAY DEPARTMENT

FED. ROAD DIST. NO.	STATE	FED. AID PROJ. NO.	FISCAL YEAR	SHEET NO.	TOTAL SHEETS
3	MO.		19	6	

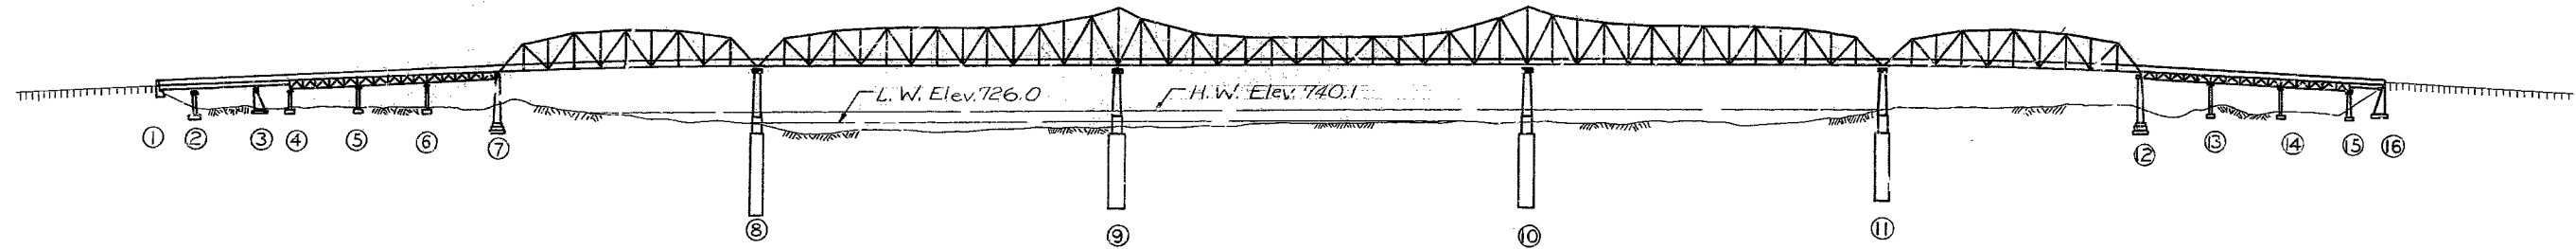

GENERAL NOTES:

Design Specifications: A.A.S.H.T.O.-1977
 Design Loading: HS-20-44 Floor System, No Future Wearing Surface, Earth 120*
 Equivalent Fluid Pressure 30*

Design Unit Stresses:

Class A Concrete (Substr. Repair) $f_c = 1500$ psi.
 Class B Concrete (New Substr.) $f_c = 1,200$ psi.
 Class B1 Spec. Conc. (Superstr. Grid Fill) $f_c = 1,600$ psi.
 Reinforcing Steel $f_y = 60,000$ psi (Grade 60)
 Structural Carbon steel $f_s = 20,000$ psi.
 Minimum clearance to reinforcing steel shall be $1\frac{1}{2}$ unless otherwise shown

Floor System:


Steel Grid Floor (Half Conc. Filled) (See Special Provisions)

GENERAL ELEVATION

Painting: Shop None; Field, System A or B Aluminum. (See Special Provisions)

Note: Light dotted lines indicate old work. Heavy lines indicate new work.
 Contractor shall verify all dimensions in field before ordering new steel.
 Note: For field connections use 3" High Strength Bolts, holes $\frac{1}{8}$ " except as noted.
 Note: A minimum vertical clearance of 21'-6" from top of rails and a minimum lateral clearance of 12'-6" from the centerline of track to nearest temporary construction falsework shall be maintained during construction.
 Note: All joint filler shall meet the requirements of Std. Spec. 1057.2.4.

A36

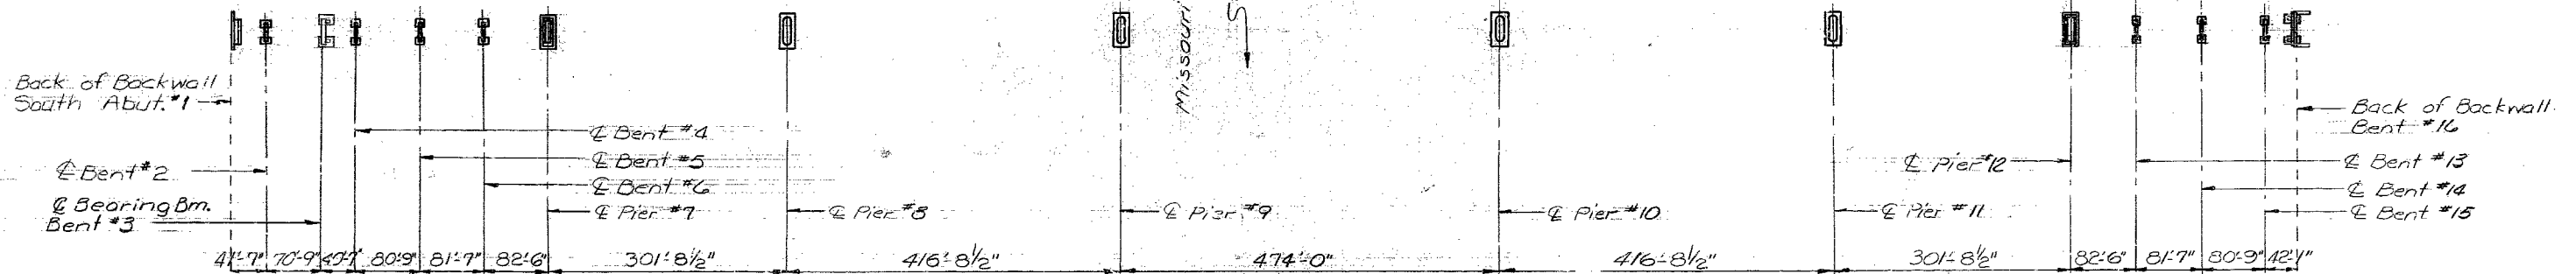

PLAN

ESTIMATED QUANTITIES				ESTIMATED QUANTITIES CONT.			
ITEM	SUBSTR.	SUPERSTR.	TOTAL	ITEM	SUBSTR.	SUPERSTR.	TOTAL
Removal of Existing Bridge Deck	Sq. Ft.	55,640	55,640	Steel Grid Floor (Half Concrete Filled)	Sq. Ft.	56,246	56,246
Special Work	Lump Sum	1	1	Painting (System A or B) Aluminum	Lump Sum	1	1
Asphalt Cement (Asphaltic Concrete)	Ton	24	24	Protective Coating for Piers & Bents	Lump Sum	1	1
Mineral Aggregate (Asphaltic Concrete) (Spec. Mix)	Ton	451.6	451.6	*Cleaning Existing Bearings	Lump Sum	1	1
Subs. Repair (Formed)	Sq. Ft.	323	323	Fab. Str. Steel Revisions	Lb.	200,550	200,550
Substr. Repair (Unformed)	Sq. Ft.	98	98	Bridge Guardrail (2 Tube Str. St.)	Lin. Ft.	5190	5190
Class B Conc. Misa. (Bent #16)	Cu. Yd.	21.9	21.9	Pressure Grouting - Epoxy	Lin. Ft.	130	130
Tack Coat	Gal.	290	290				
Elast. Exp. Jt. Seal (2 in.)	Lin. Ft.	22	22				
Elast. Exp. Jt. Seal (2 1/2 in.)	Lin. Ft.	44	44				
Elast. Exp. Jt. Seal (4 in.)	Lin. Ft.	44	44				
Elast. Exp. Jt. Seal (6 1/2 in.)	Lin. Ft.	66	66				
Preformed Comp. Exp. Jt. Seal (2 1/2)	Lin. Ft.	506	506				
Reinforcing Steel (Grade 60)	Lb.	2360	2360				

*Grout around brgs. to be paid for in price bid for subst. repair. (See Special Provisions)
 Note: All steel is A-36 except as noted on portal details.

B.M. #8 Painted \square on S.W.W. Br. No. K-456
 Elev. 494.51, [U.S.G.S. Datum Elev. 774.18]

**BRIDGE OVER MISSOURI RIVER
 FAIRFAX BRIDGE AT
 RIVERSIDE**

PROJ. BHO-083(3)
 JOB NO. 4-U-69-64 RTE. 69

**PLATTE COUNTY MISSOURI
 WYANDOTTE COUNTY KANSAS**

DETAILED Sept. 19 78
 CHECKED Nov. 19 78


Note: This drawing is not to scale. Follow dimensions.

Sheet No. 1 of 30. Date 4-16-79


STD. 706.30
 K-456R

MISSOURI STATE HIGHWAY DEPARTMENT


FED. ROAD DIST. NO.	STATE	FED. AID PROJ. NO.	FISCAL YEAR	SHEET NO.	TOTAL SHEETS
5	MO.		19	7	

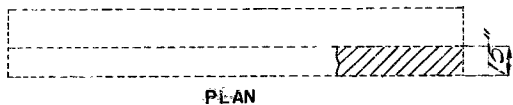


PLAN

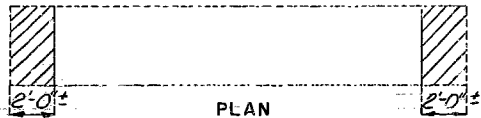


PLAN

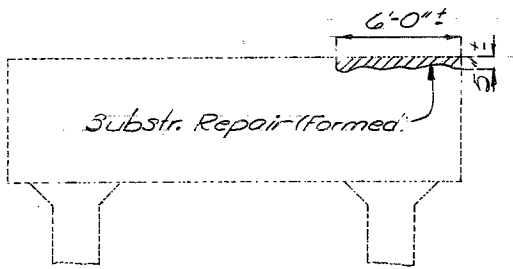


ELEVATION
BENT NO. 2

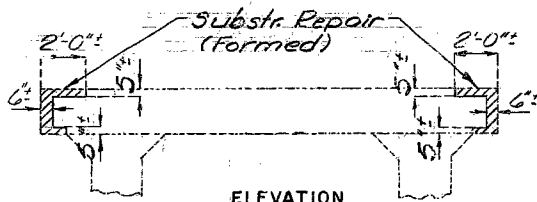


ELEVATION
BENT NO. 5

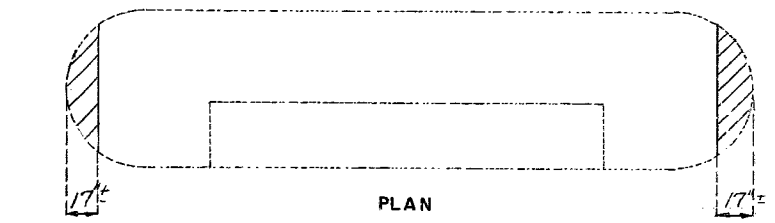


PLAN

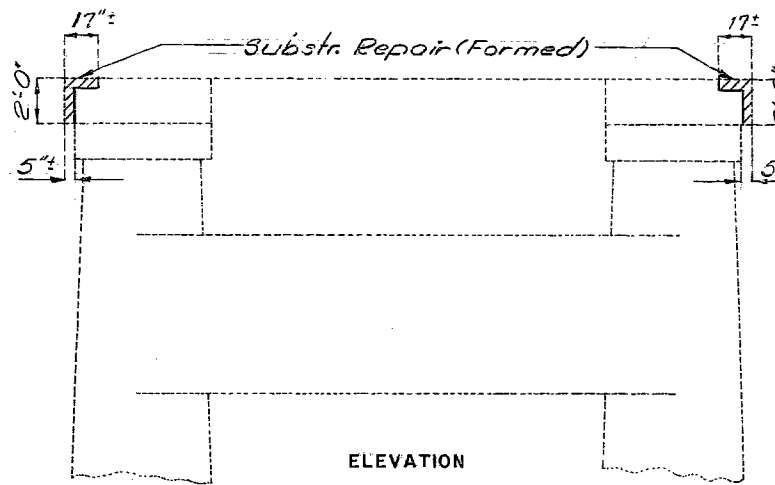


ELEVATION
PIER NO. 7 & 12

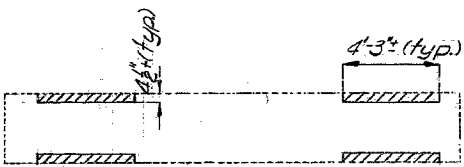


PLAN

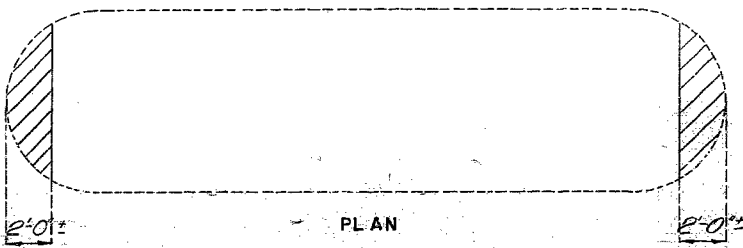

PLAN

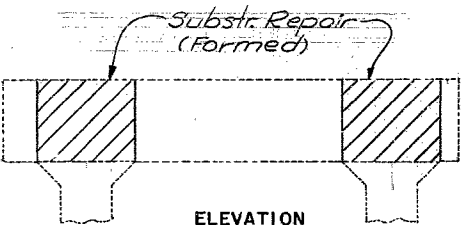

ELEVATION
BENT NO. 3

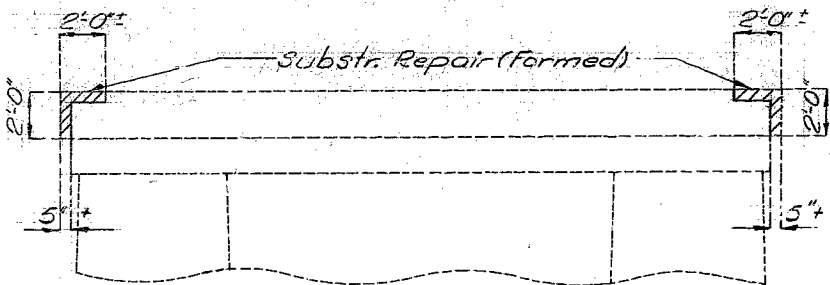

ELEVATION
PIER NO. 8, 9, 10, & 11



Note: Cross hatched areas indicates substructure areas to be repaired. (See Spec. Provisions.)

437


MISSOURI STATE HIGHWAY DEPARTMENT

FED. ROAD DIST. NO.	STATE	FED. AID PROJ. NO.	FISCAL YEAR	SHEET NO.	TOTAL SHEETS
5	MO.		19	3	



Remove and replace concrete in vertical faces of bearing beam as required to a minimum of 2" behind existing reinforcing steel and to sound concrete.

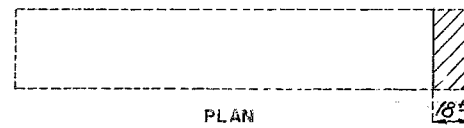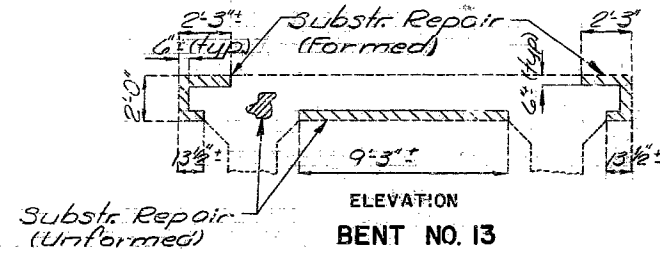

Remove and replace concrete in deteriorated areas of columns to a minimum depth of 2" behind existing reinforcing steel and to sound concrete.

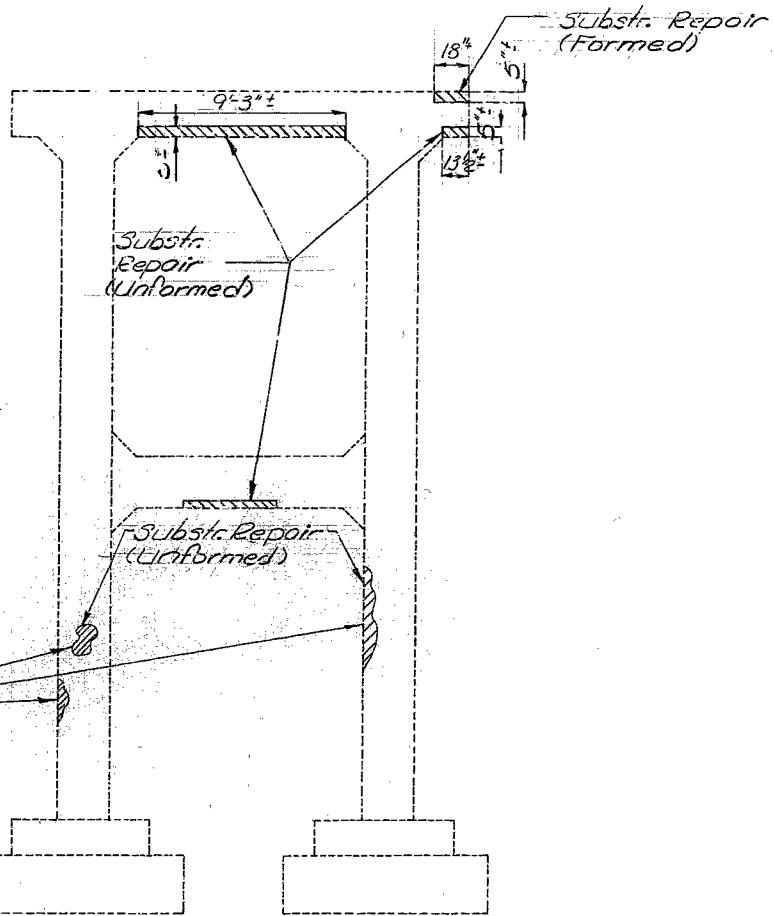

Remove and replace concrete in deteriorated areas of columns to a minimum depth of 2" behind existing reinforcing steel and to sound concrete.

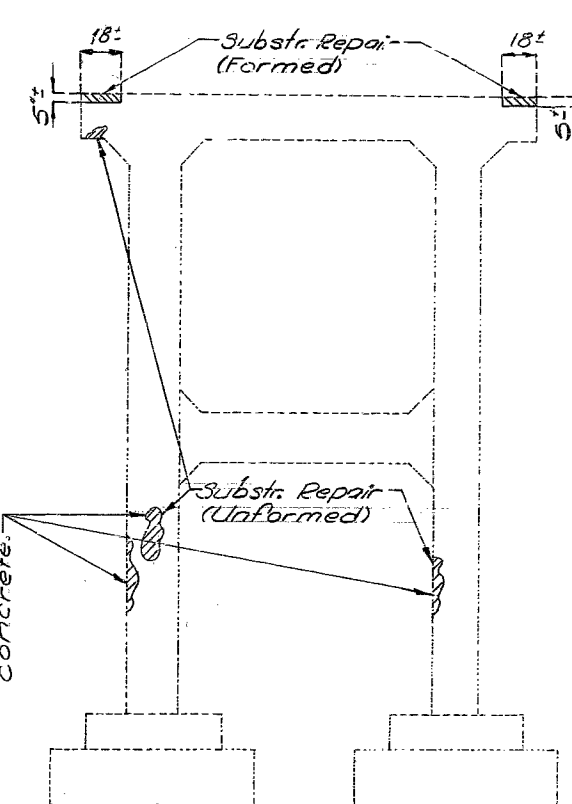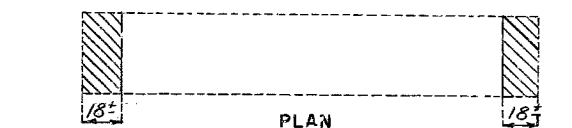

Note: Cross hatched areas indicates substructure areas to be repaired. (See Spec. Provisions.)

438

DETAILED Aug 19 78
CHECKED Oct 19 78

Note: This drawing is not to scale. Follow dimensions.


Sheet No. 3 of 30.

PLATTE COUNTY

K-456R

MISSOURI STATE HIGHWAY DEPARTMENT

FED. ROAD DIST. NO.	STATE	FED. AID PROJ. NO.	FISCAL YEAR	SHEET NO.	TOTAL SHEETS
5	MO.		19	9	

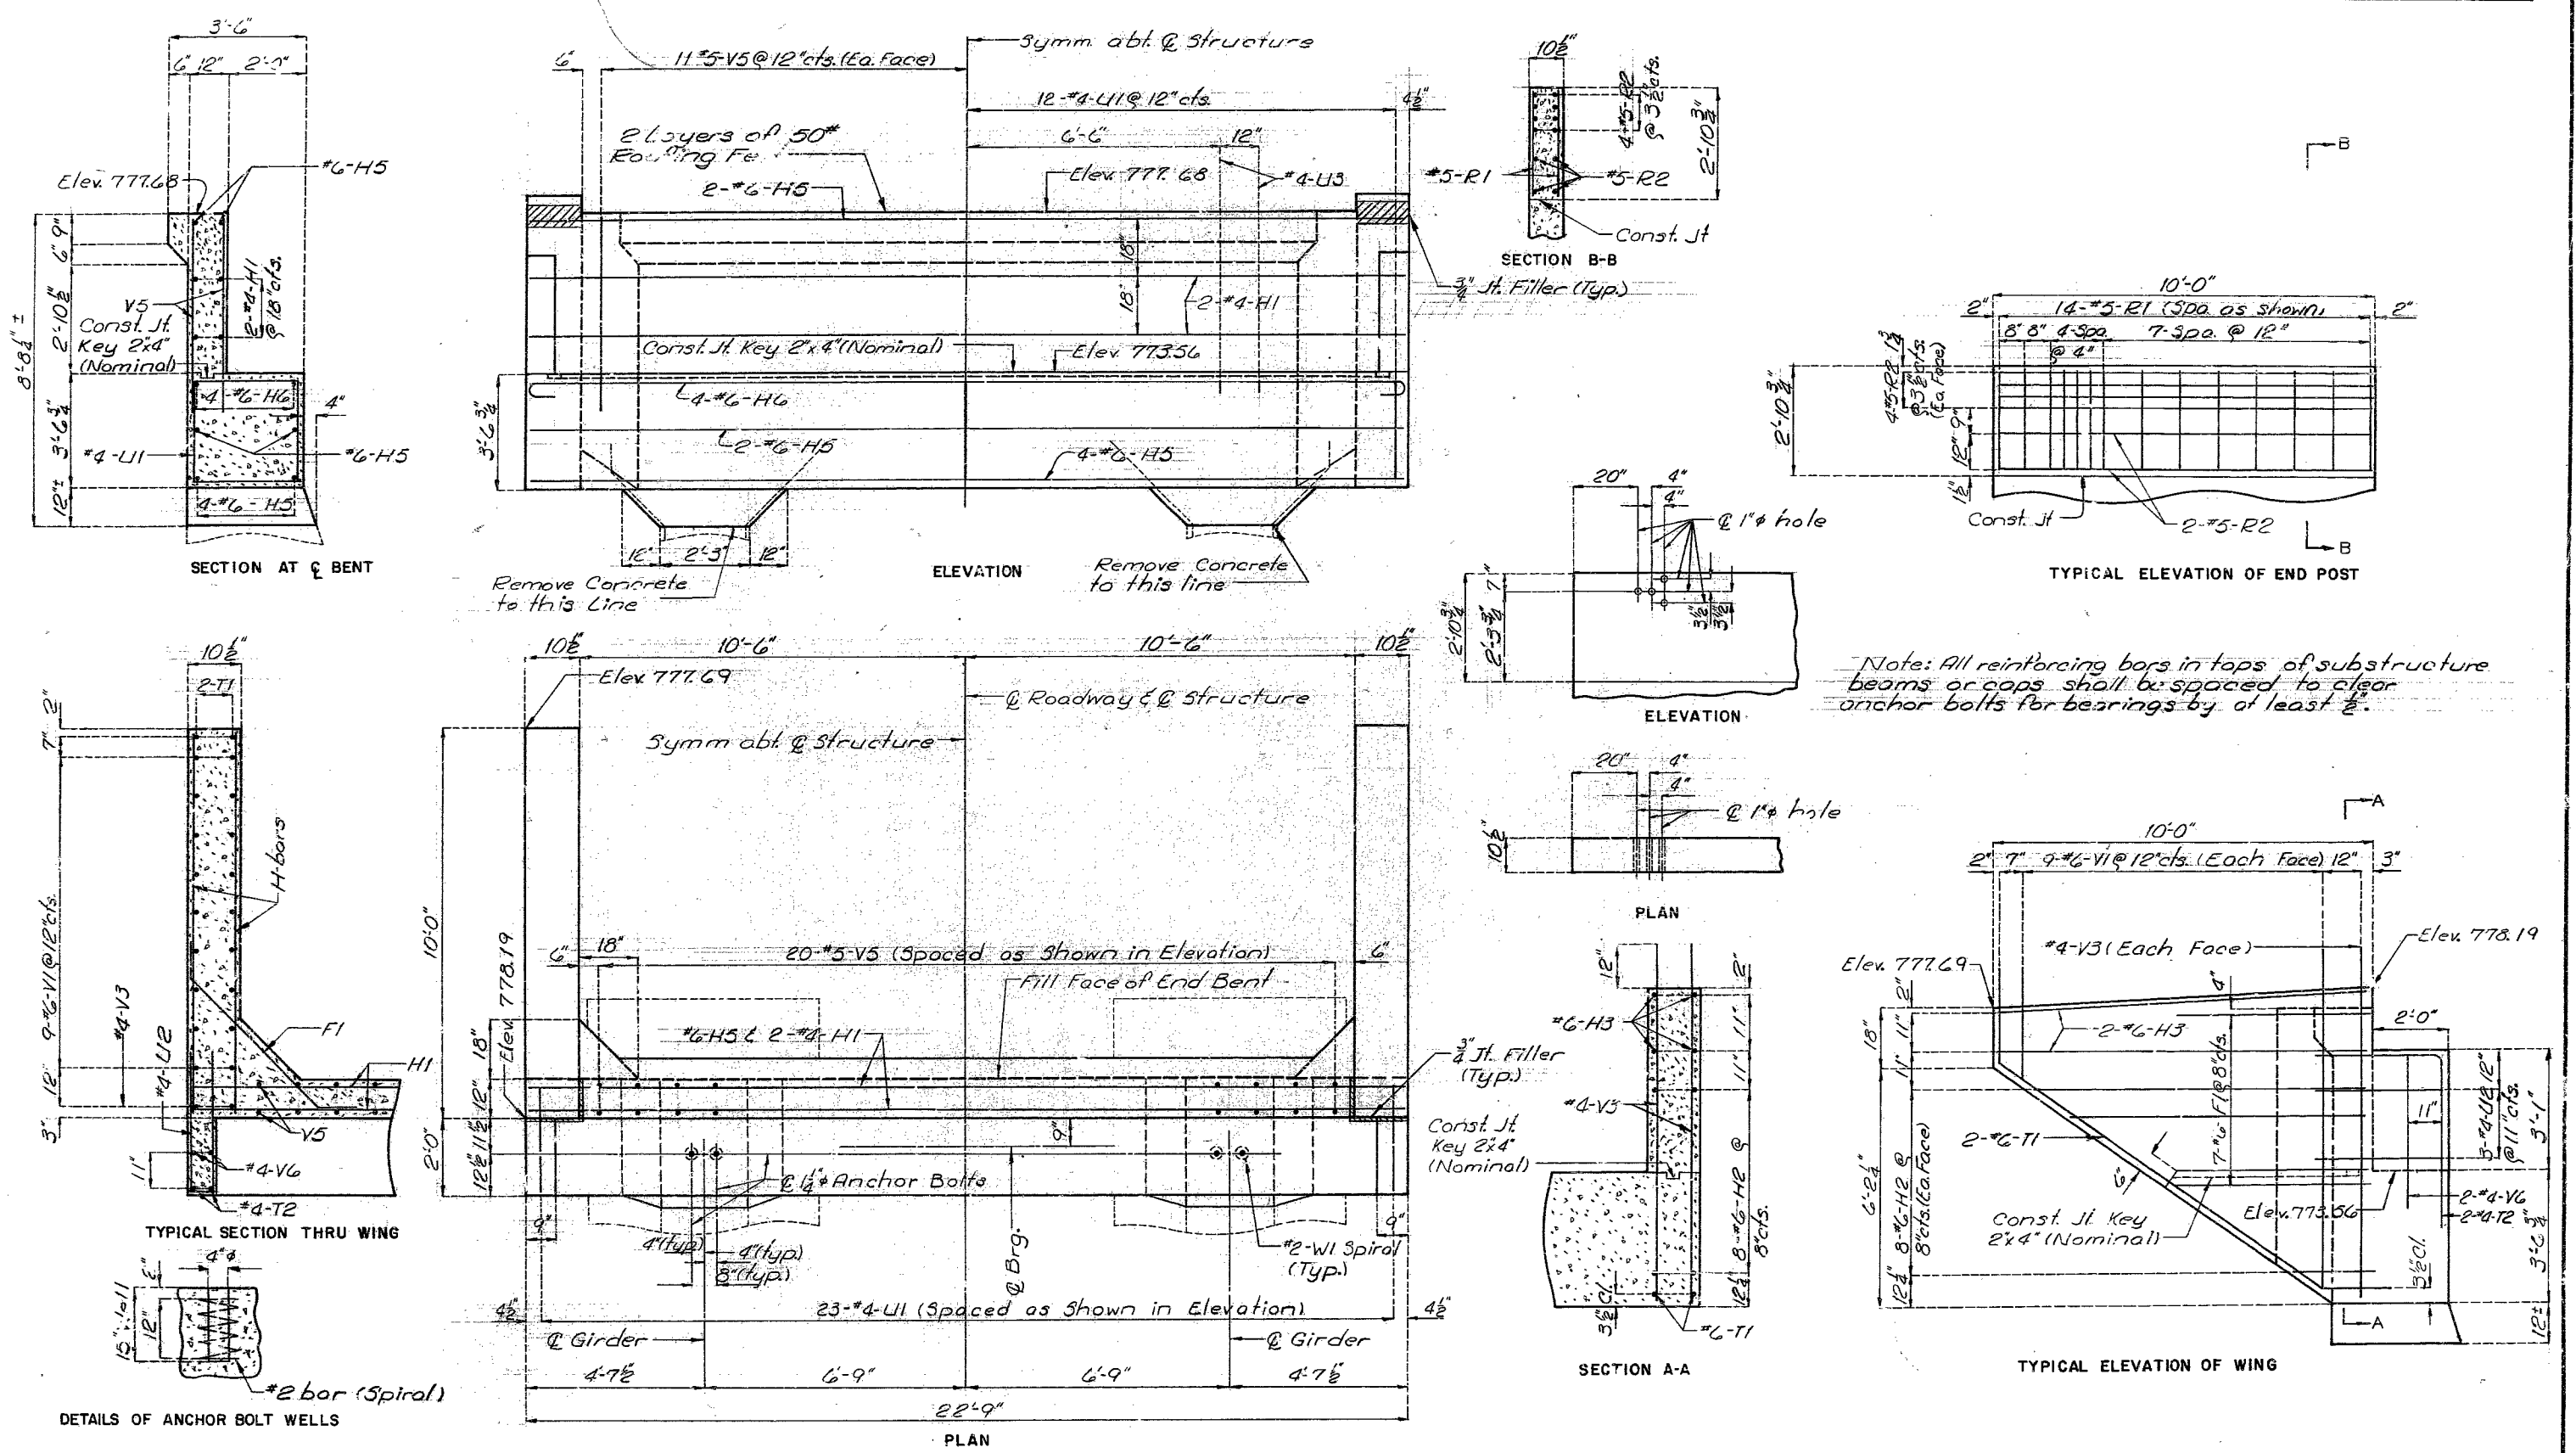

Note: All reinforcing bars in tops of substructure beams or caps shall be spaced to clear anchor bolts for bearings by at least 2".

439

DETAILS OF END BENT NO. 16

DETAILED Sept. 19 78
CHECKED Oct. 19 78

Note: This drawing is not to scale, follow dimensions.


Sheet No. 4 of 30.

PLATTE COUNTY

K-456R

MISSOURI STATE HIGHWAY DEPARTMENT

FED. FUND DIST. NO.	STATE	FED. AID PROJ. NO.	FISCAL YEAR	SHEET NO.	TOTAL SHEETS
5	MO.		19	10	

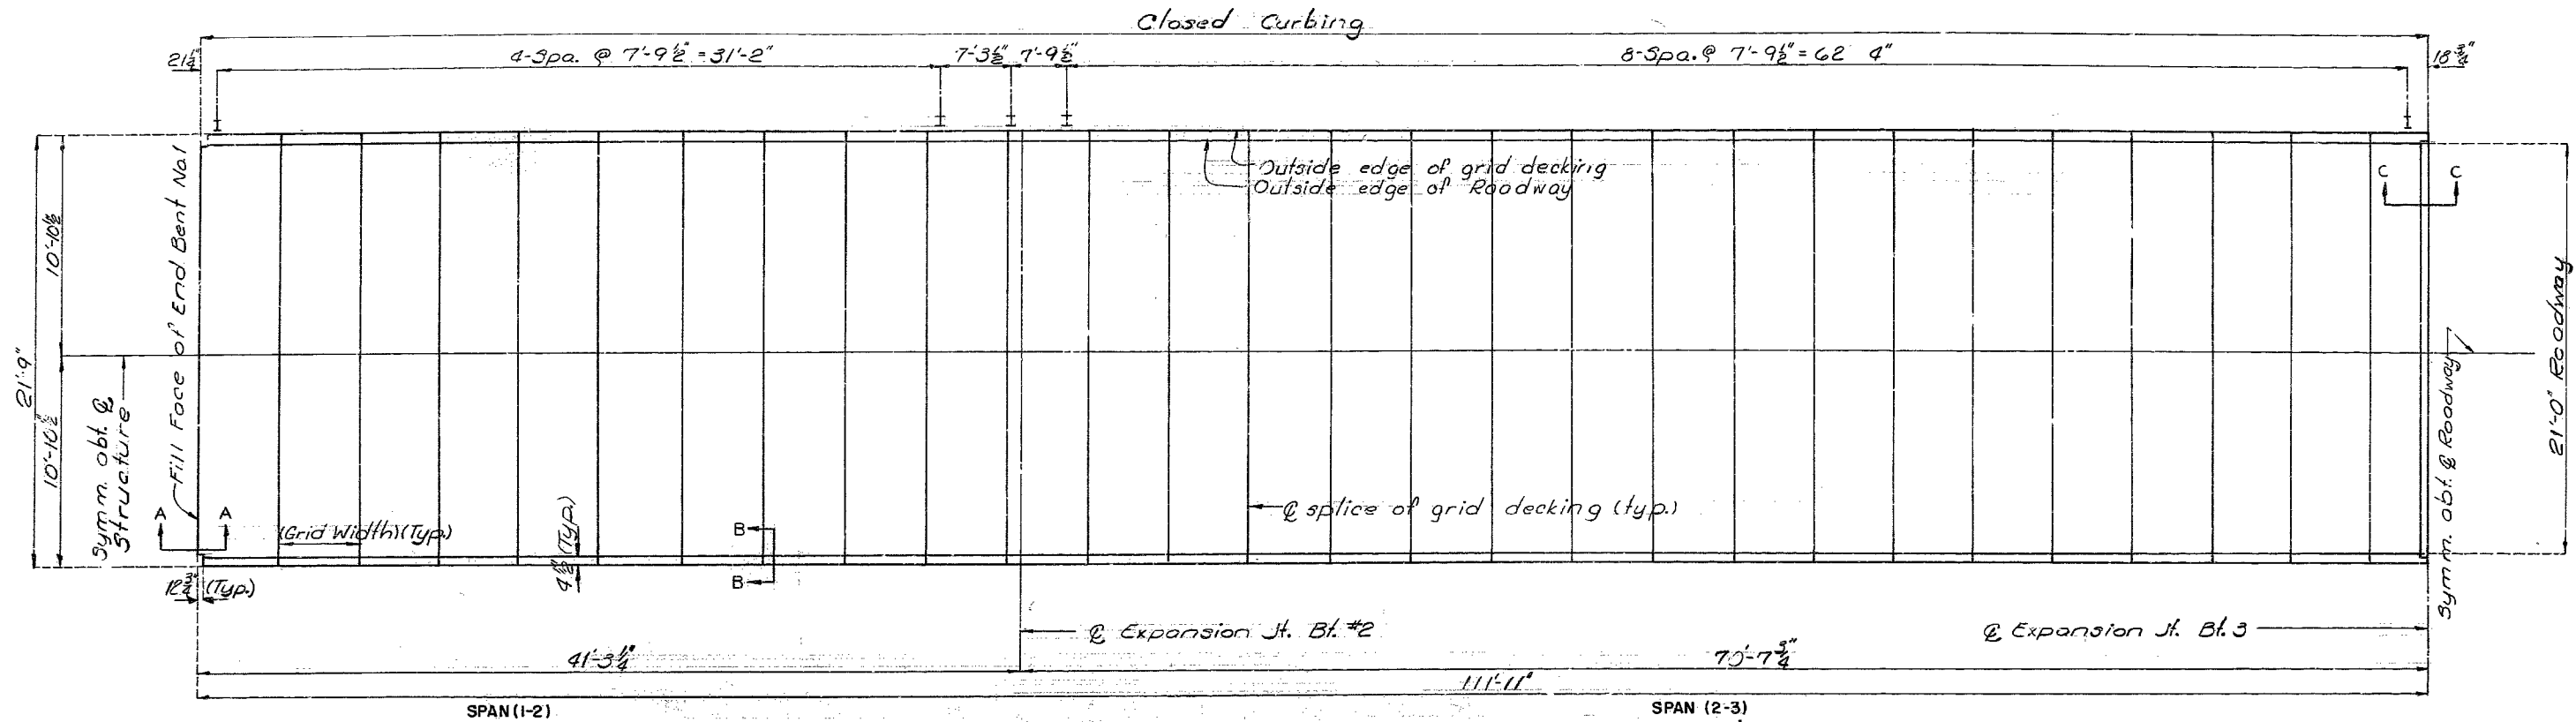


Note: Longitudinal slab dimensions are measured along grade. For Details of Open & Closed Curbing see sheet No. 20

Note: For details of Section C-C see sheet No. 11.


Note: For details of grid splice see sheet No. 10

Note: Handrail posts shall be set normal to grade.

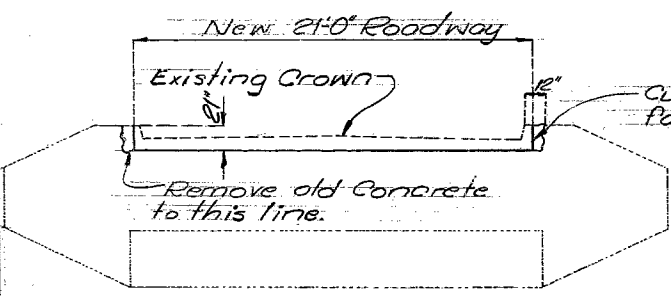

DETAILS OF BENT NO. 1

Note: For details of Section B-B see Sheet No. 21

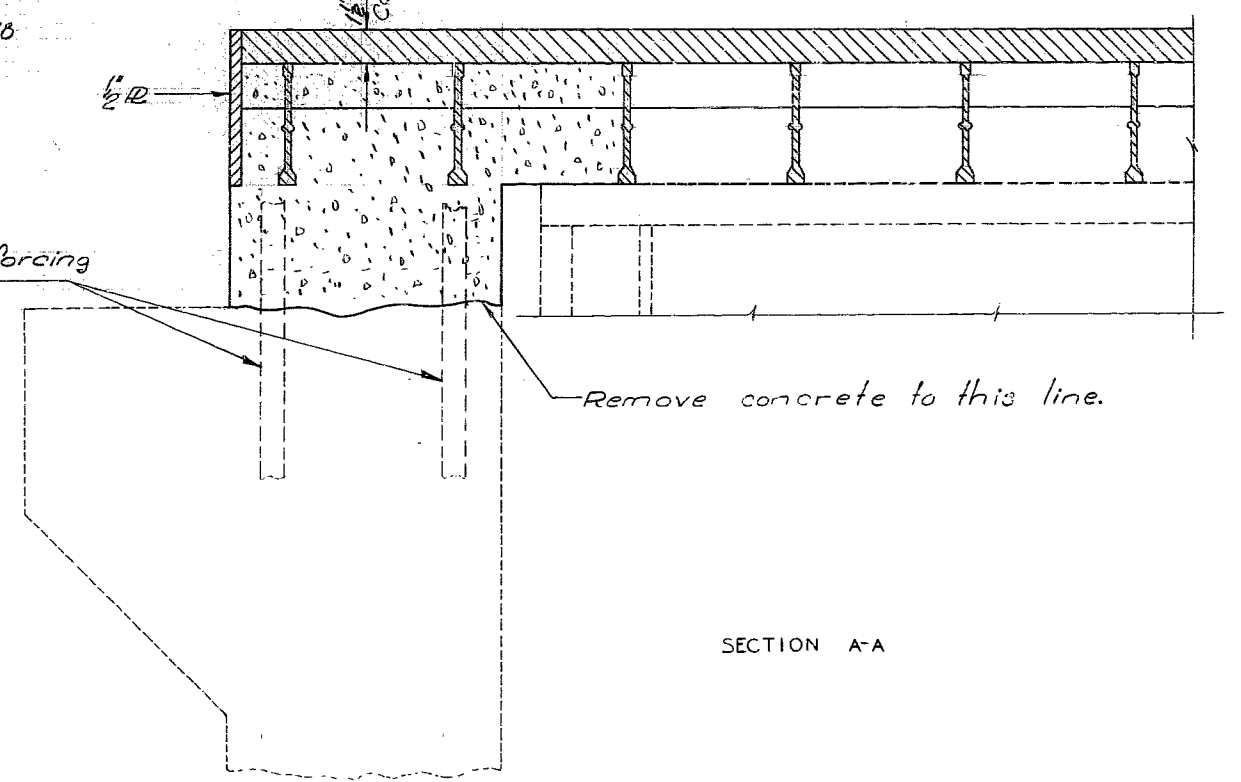

SECTION A-A

440
 DETAILED Aug. 19 78
 CHECKED Sept. 19 78

Note: This drawing is not to scale. Follow dimensions.



Sheet No. 5 of 30.

PLATTE COUNTY

K-4569

MISSOURI STATE HIGHWAY DEPARTMENT

FED. ROAD DIST. NO.	STATE	FED. AID PROJ. NO.	FISCAL YEAR	SHEET NO.	TOTAL SHEETS
5	MO.		19	11	

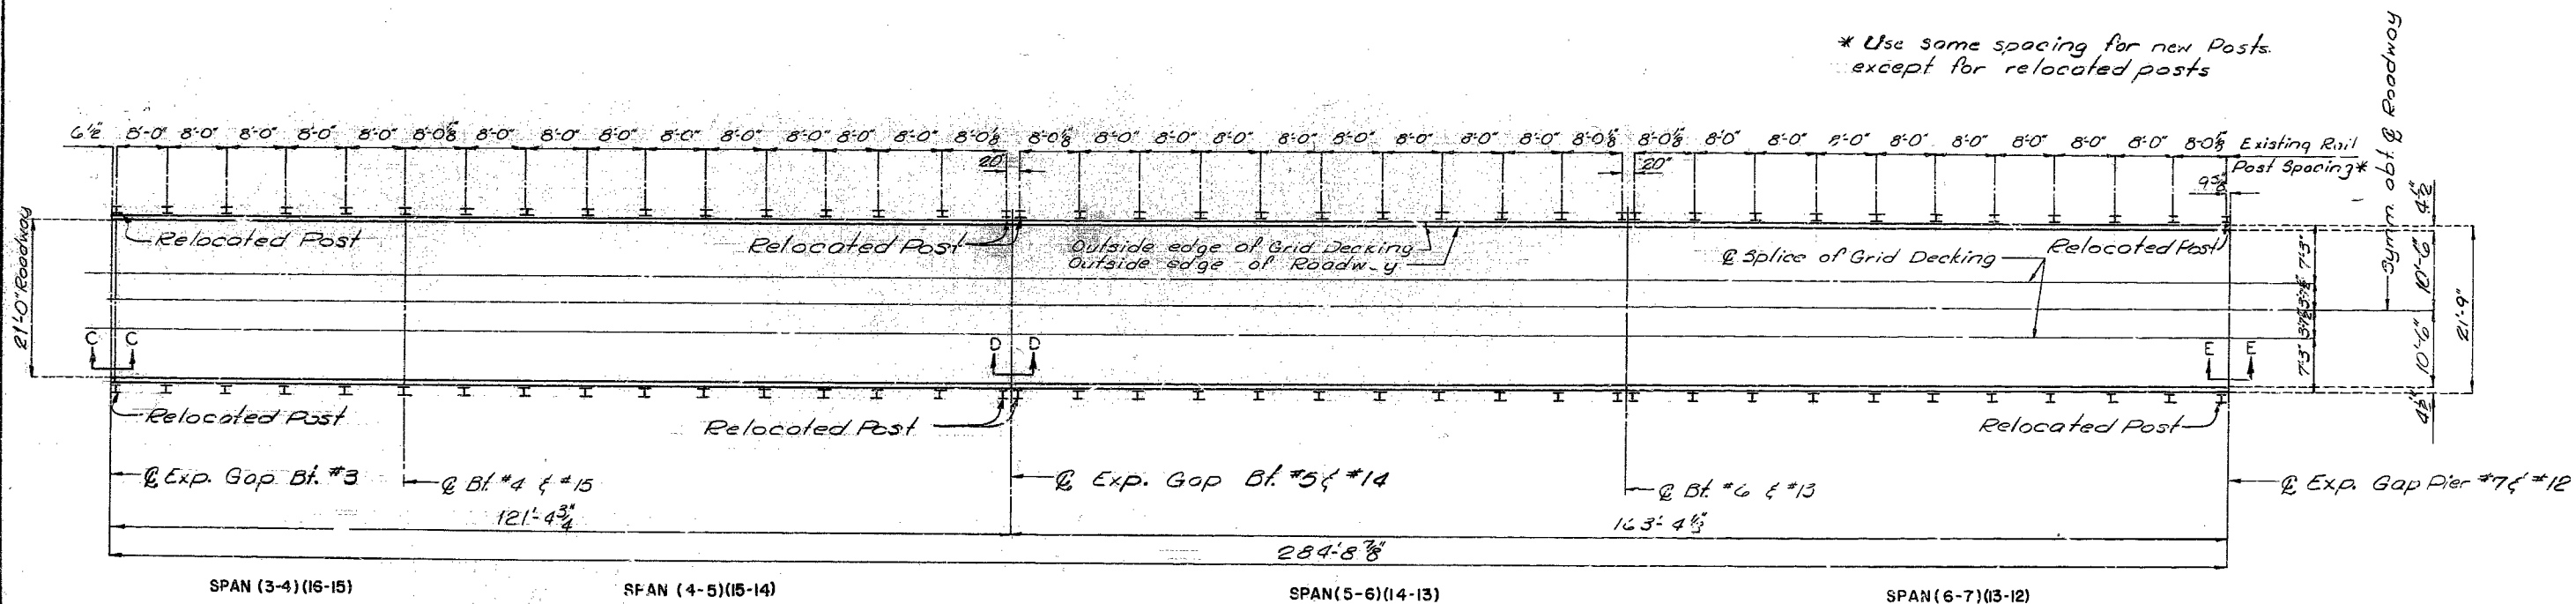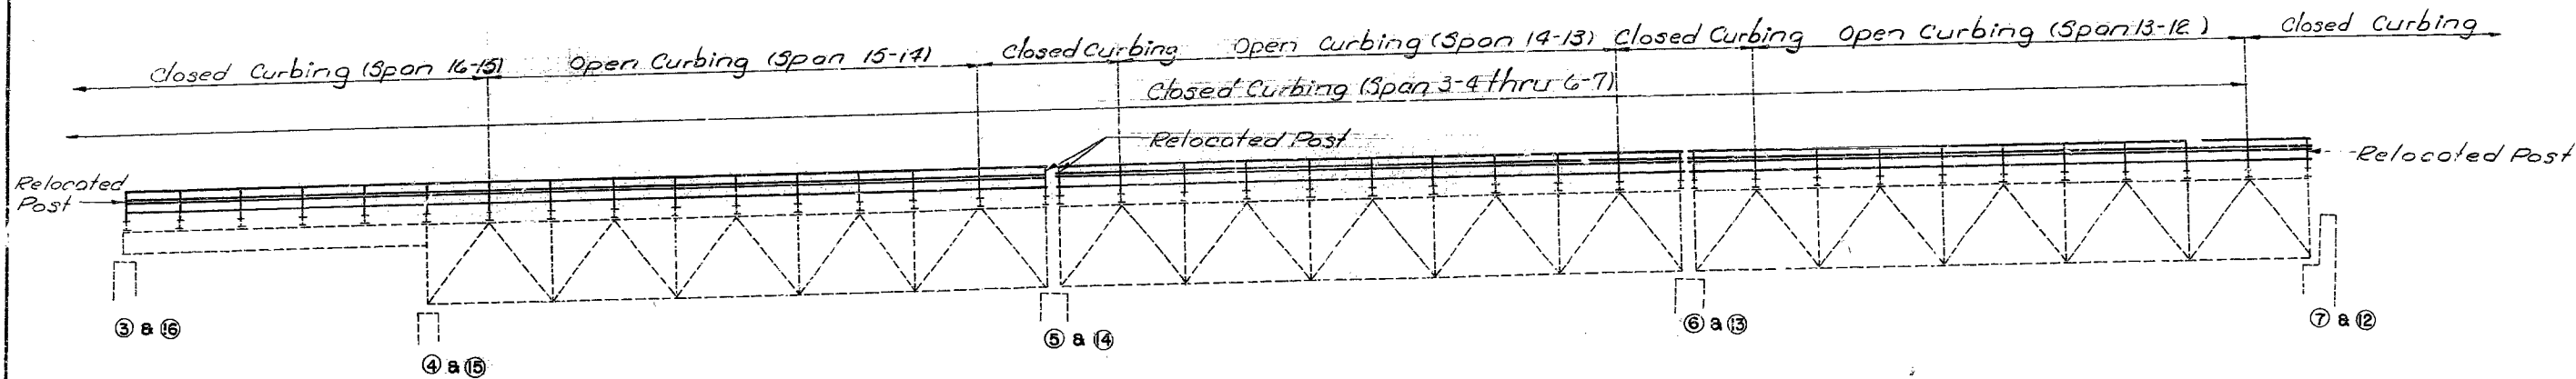

Note: For details of Section C-C see sheet No. 11
 For details of Grid Splices see sheet No. 18.
 Note: For details of relocated rail post see sheet No. 22

Note: Dimensions shown are parallel to grade & crown of Roadway.
 For details of open & closed Curbing see sheet No. 20

Note: For details of Section D-D see sheet No. 13
 For details of Section E-E see sheet No. 14

DETAILED July 19 78
 CHECKED Sept. 19 78

Note: This drawing is not to scale. Follow dimensions.


Sheet No. 6 of 30.

PLATTE COUNTY

K-456R

MISSOURI STATE HIGHWAY DEPARTMENT


FED. ROAD DIST. NO.	STATE	FED. AID PROJ. NO.	FISCAL YEAR	SHEET NO.	TOTAL SHEETS
1	MO.		19	12	

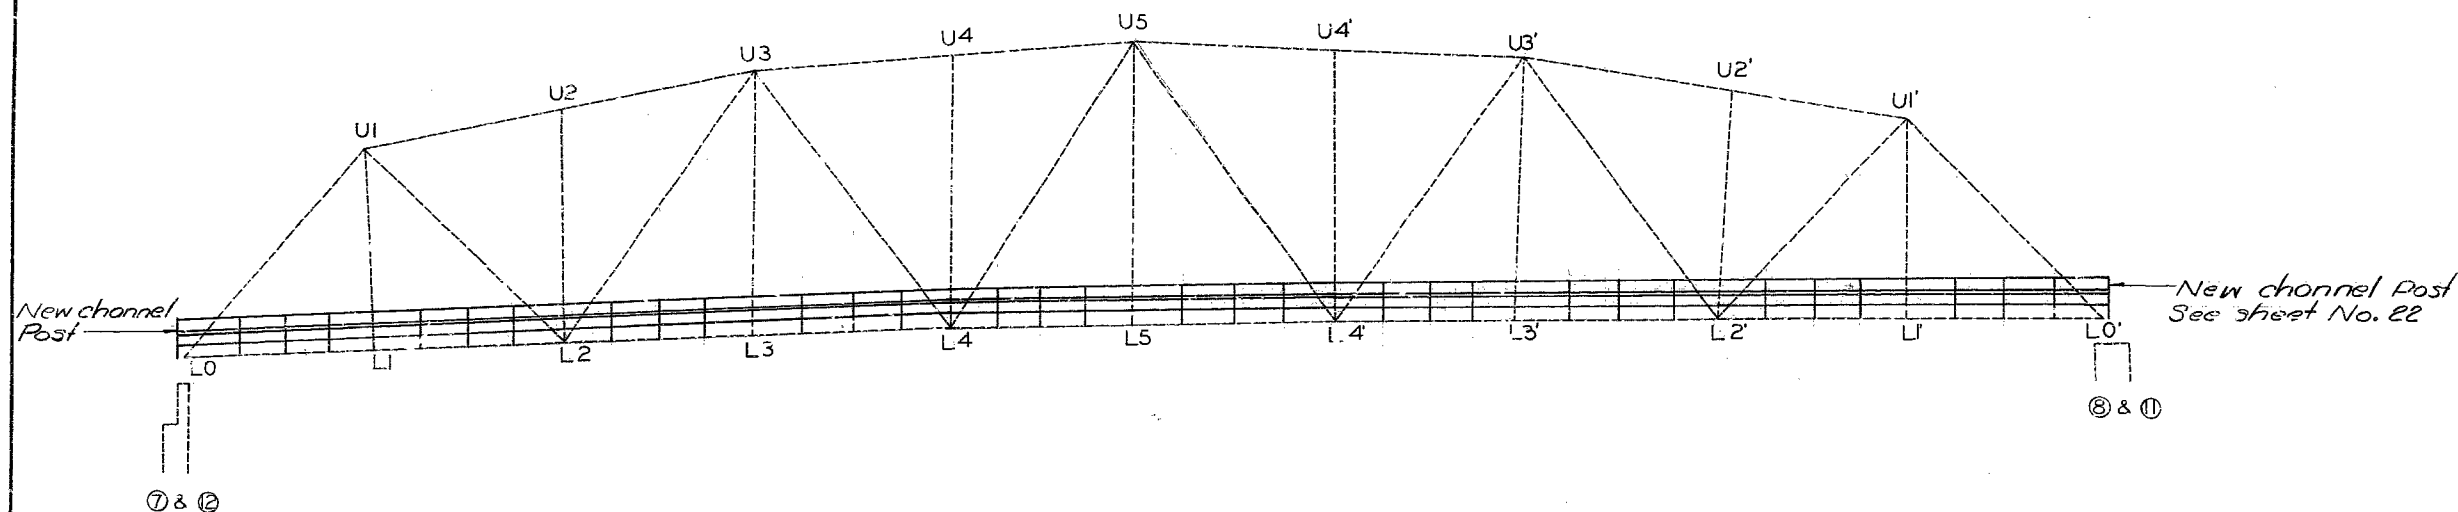

PART ELEVATION

Note: Grid transverse bars may be clipped to fit at truss vertical members when necessary.

442

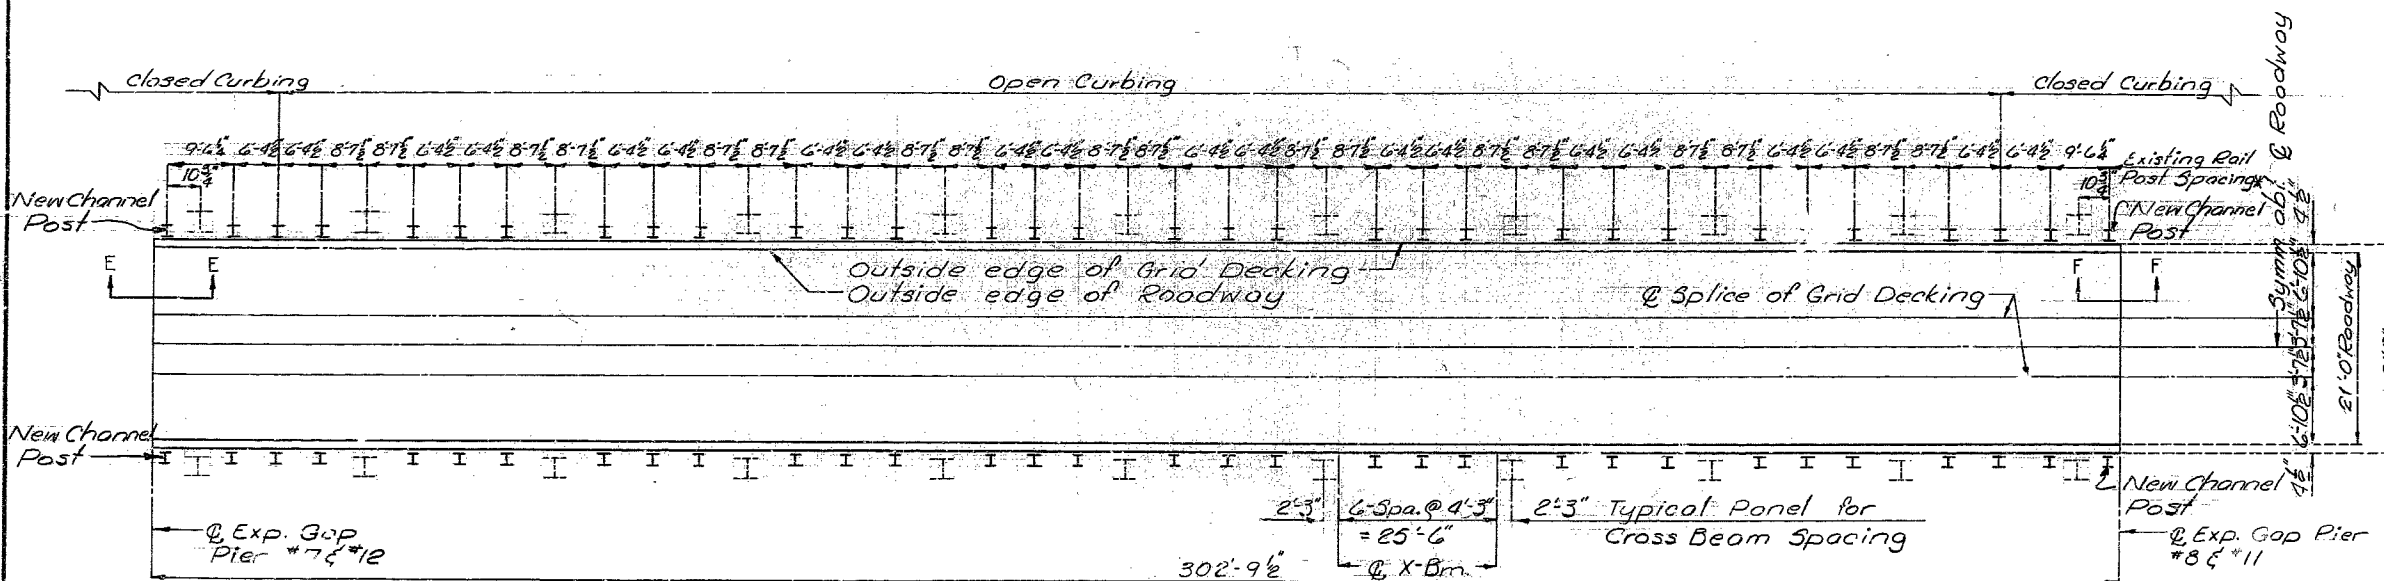


PART PLAN

Note: For details of Section E-E see sheet No. 14.
 For details of Section F-F see sheet No. 15.
 For details of Grid Splice see sheet No. 18.

Note: Dimensions shown are parallel to grade @ Crown of roadway.
 For Details of Open & Closed Curbing see sheet No. 20.


MISSOURI STATE HIGHWAY DEPARTMENT

FED. ROAD DIST. NO.	STATE	FED. AID PROJ. NO.	FISCAL YEAR	SHEET NO.	TOTAL SHEETS
5	MO.		19	13	

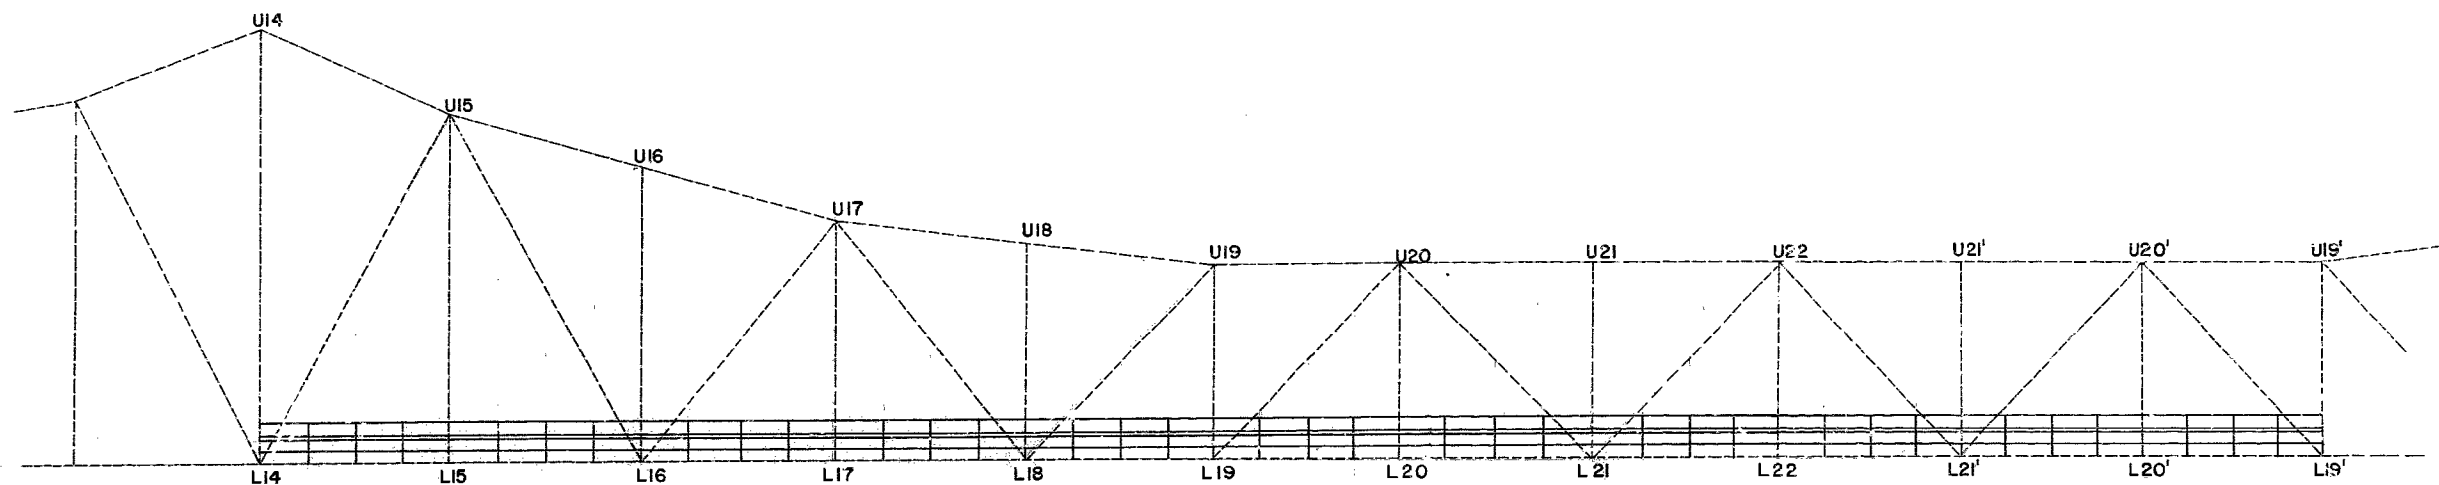

PART ELEVATION

Note: Grid transverse bars may be clipped to fit of truss vertical members when necessary.

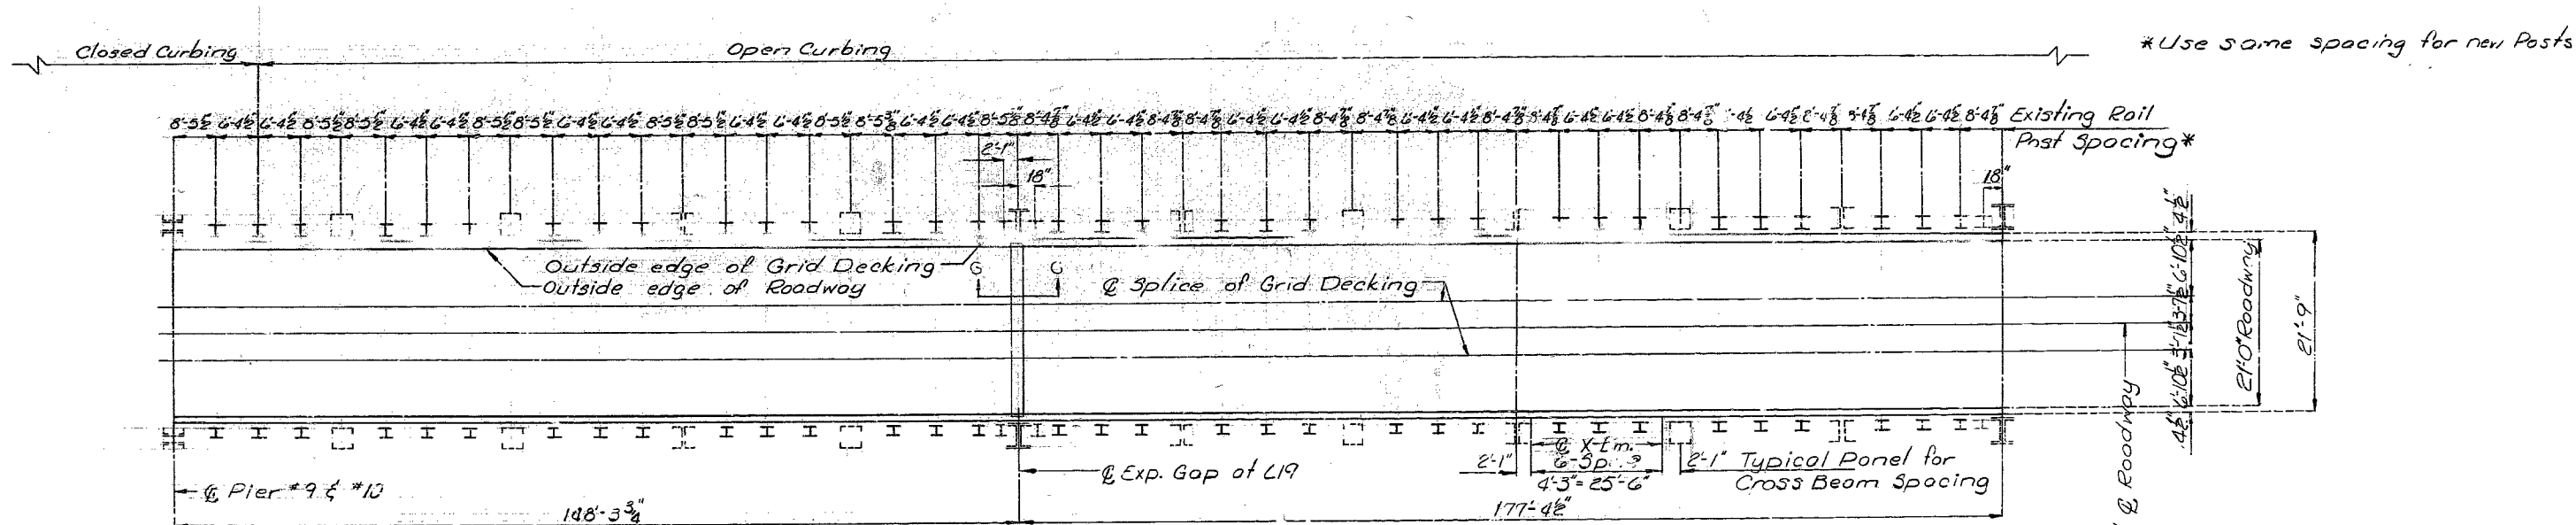

PART PLAN

Note: For details of Grid Splice see sheet No. 18.


Note: Dimensions shown are parallel to grade @ Crown of Roadway. For Details of Open & Closed Curbing see sheet No. 20.

Note: For details of section GG see sheet No. 16. Note: Use existing Rail Posts of L19 and L19'.


A43

MISSOURI STATE HIGHWAY DEPARTMENT

FED. ROAD DIST. NO.	STATE	FED. AID PROJ. NO.	FISCAL YEAR	SHEET NO.	TOTAL SHEETS
3	MO.		19	14	

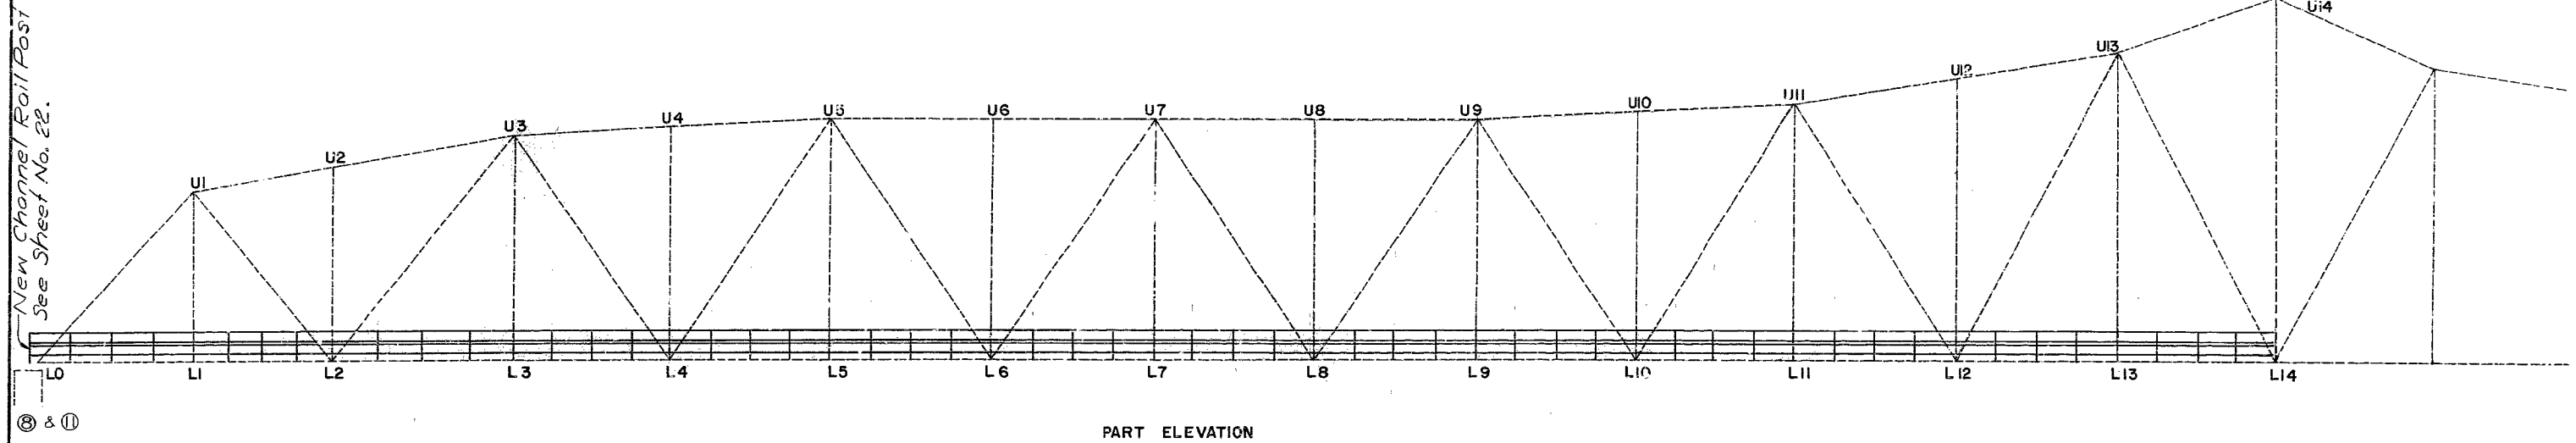

* Use same spacing for new Posts

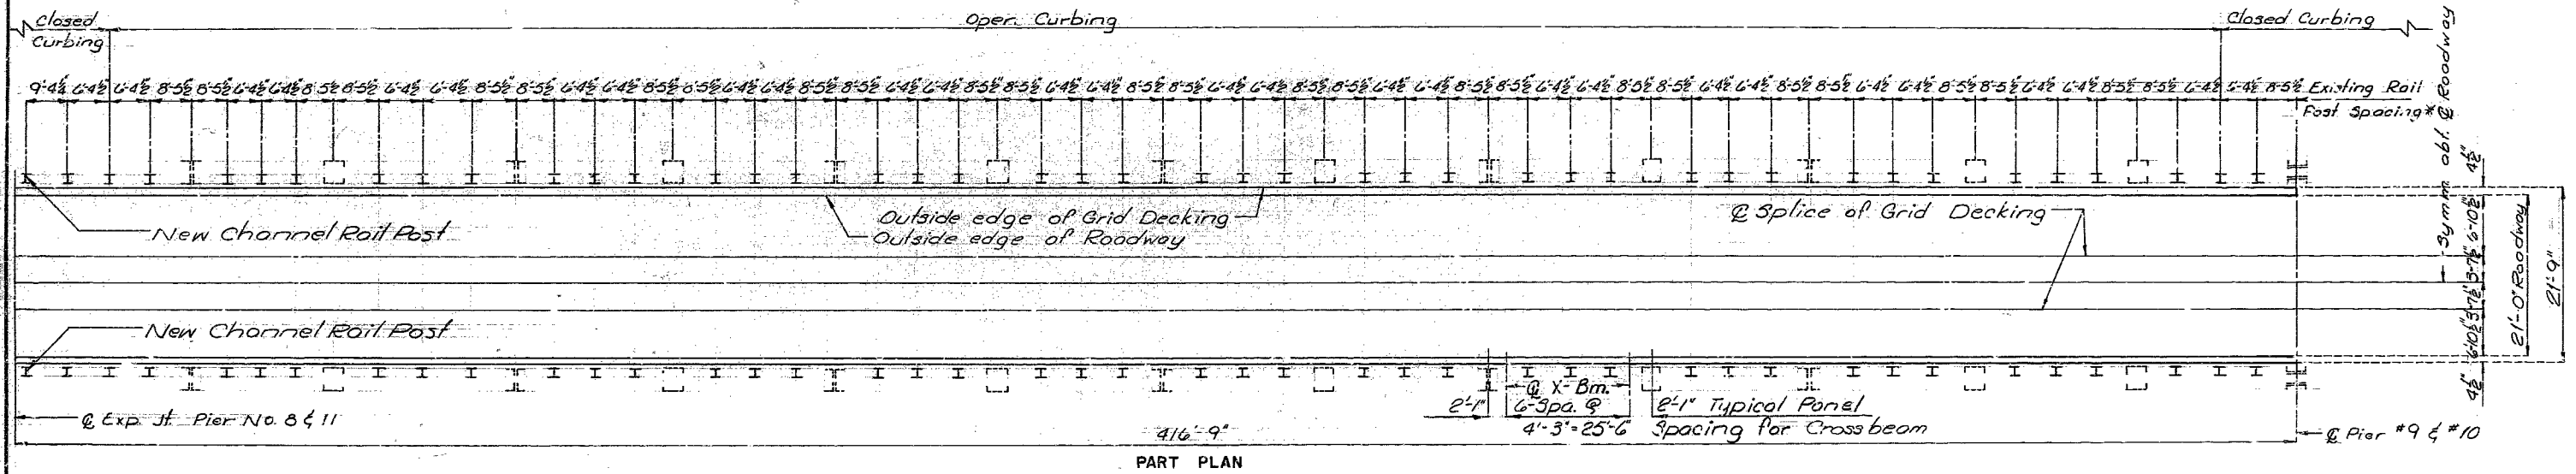

Note: Grid transverse bars may be clipped to fit at vertical truss members when necessary.

Note: Dimensions shown are parallel to grade @ Crown of Roadway.
For details of open & closed curbing see sheet No. 20.

Note: For details of Grid splice see sheet No. 18.

DETAILED April 19 78
CHECKED Sept. 19 78


Note: This drawing is not to scale. Follow dimensions.

Sheet No. 9 of 30.



PLATTE COUNTY K-456R

MISSOURI STATE HIGHWAY DEPARTMENT

FED. ROAD DIST. NO.	STATE	FED. AID PROJ. NO.	FISCAL YEAR	SHEET NO.	TOTAL SHEETS
5	MO.		19	15	

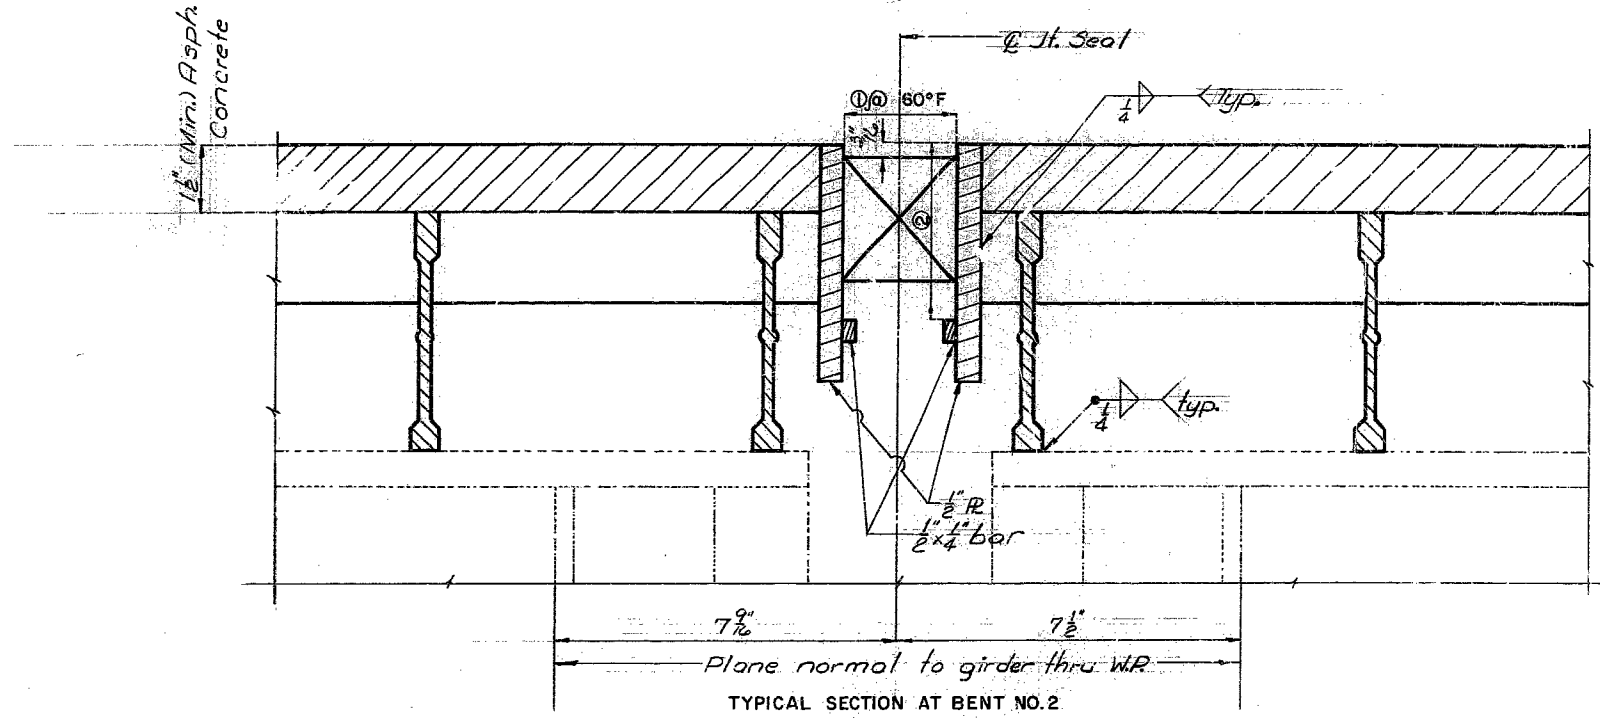

Note: For information on Transverse Seal see sheet No. 12

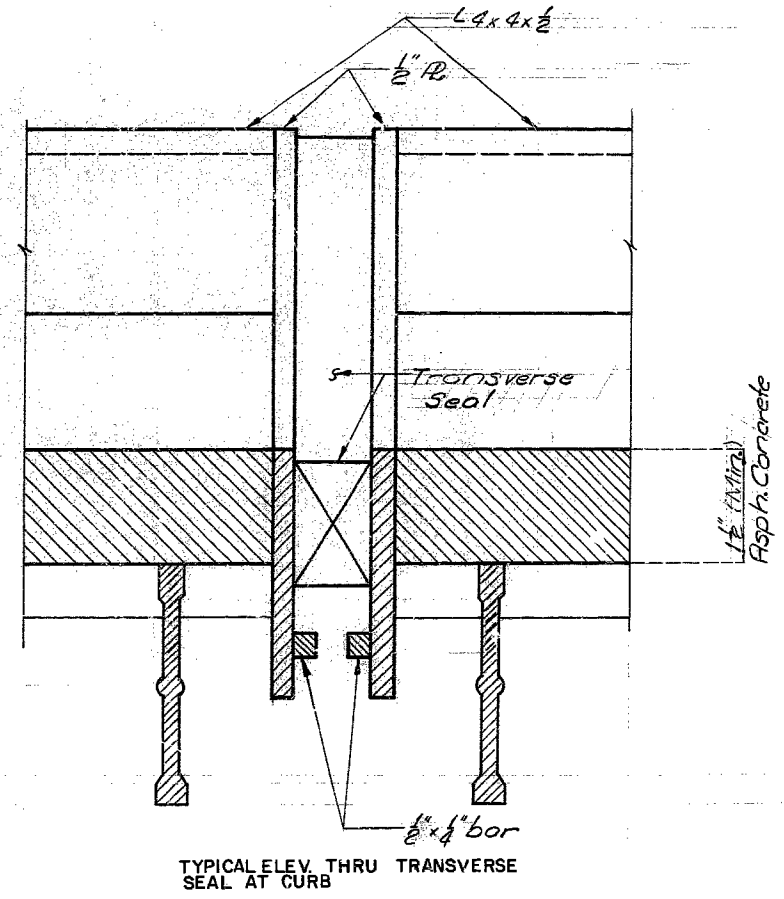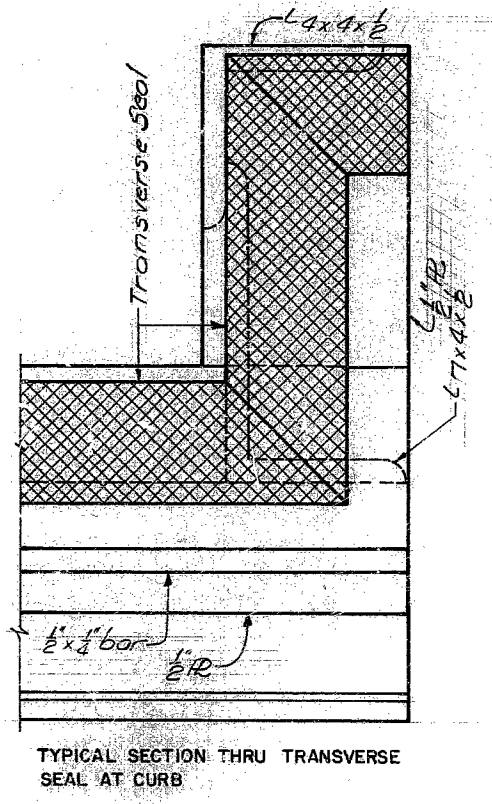

445


DETAILED Nov. 19 76
CHECKED A.D.U. 19 76

Note: This drawing is not to scale. Follow dimensions.

Sheet No. 10 of 30.

MISSOURI STATE HIGHWAY DEPARTMENT


FED. ROAD DIST. NO.	STATE	FED. AID PROJ. NO.	FISCAL YEAR	SHEET NO.	TOTAL SHEETS
5	MO.		19	16	

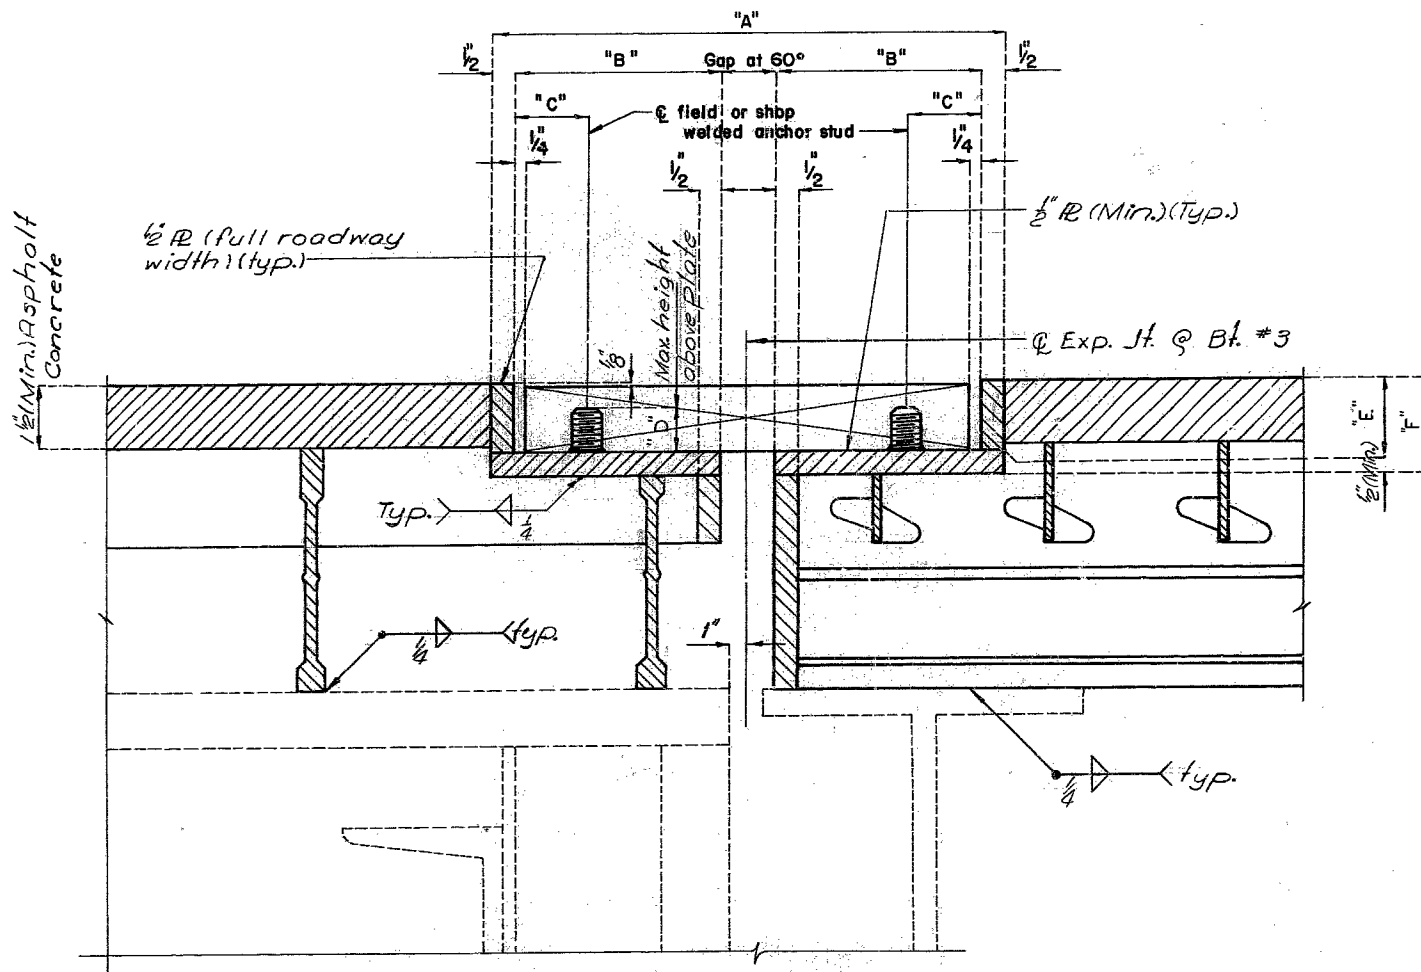

SECTION C-C (Bent No. 3 only)

LOCATION	ACCEPTABLE ALTERNATE TYPES	EXP GAP AT 60°	TABLE OF DIMENSIONS						ANCHOR STUDS SIZE "G"
			"A" AT 60°	"B"	"C"	"D"	"E"	"F"	
BENT NO. 3	FEL-SPAN T20	1 3/8"	11 3/16"	4 1/2"	1 3/8"	1"	1 7/16"	1 3/16"	1/2" 50
	WABO-ELASTODAM 200	1 1/4"	11 1/4"	4 1/2"	1 3/8"	1"	1 7/16"	1 3/16"	1/2" 40
	DELASTIFLEX LM200	1 1/2"	11 7/8"	4 1/16"	2 3/16"	1"	2"	2 1/2"	1/2" 45
	ON-FLEX 25	1 1/2"	11"	4 1/4"	1 3/8"	1 1/4"	1 1/2"	2 3/16"	1/2" 65

Note: For location of Section C-C see sheet No. 5 for Bent #3 only.

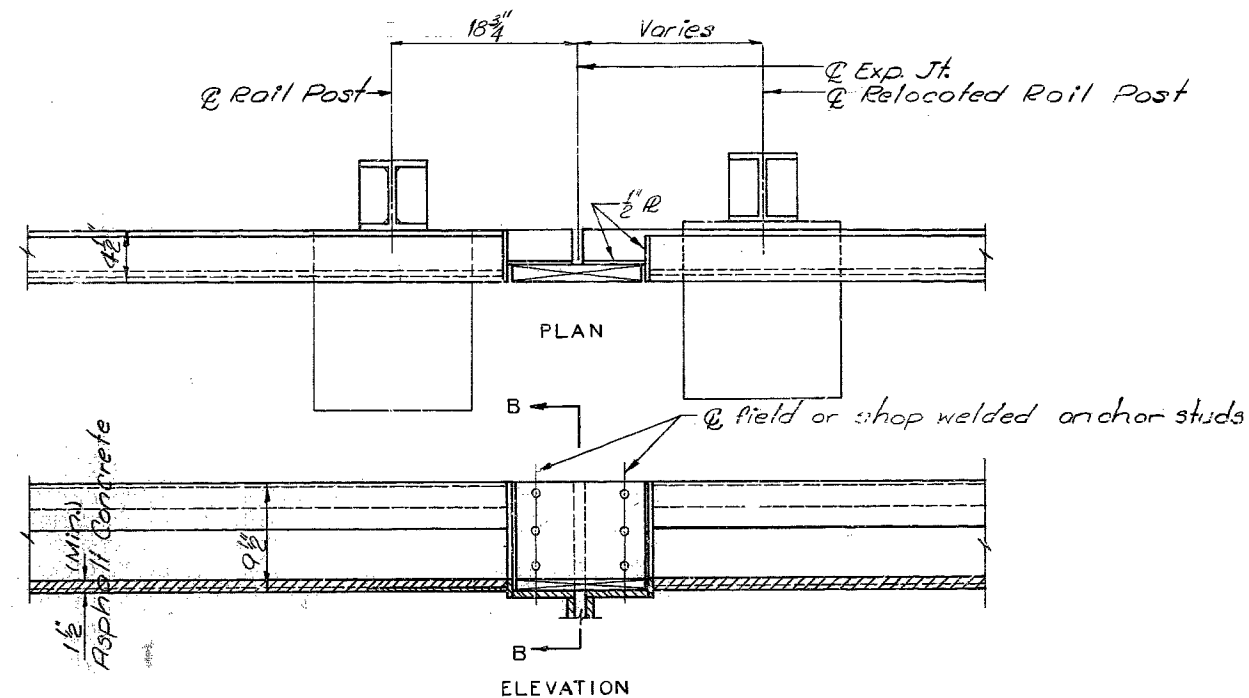

Note: Rail Post not shown in Elevation for clarity.

GENERAL NOTES:

THE EXPANSION JOINT SEAL SHALL BE INSTALLED IN ACCORDANCE WITH THE MANUFACTURER'S INSTRUCTIONS SHOWN ON THE SHOP DRAWINGS AND IN ACCORDANCE WITH THE SPECIAL PROVISIONS.

THE NUTS ON THE ANCHOR STUDS SHALL BE TIGHTENED TO THE FOOT POUNDS "G" SPECIFIED IN THE TABLE OF DIMENSIONS. RETIGHTEN TO "G" FOOT POUNDS A MINIMUM OF 30 MINUTES AFTER INITIAL TIGHTENING. THE WELDED ANCHOR STUDS SHALL BE THE REDUCED BASE TYPE.

MATERIAL FOR THE ARMORED JOINT SHALL BE A36 STRUCTURAL GRADE STEEL.

SEE SPECIAL PROVISIONS FOR PAINTING.

PLAN DIMENSIONS ARE BASED ON INSTALLATION AT 60°F. THE EXPANSION GAP AND OTHER DIMENSIONS SHALL BE ADJUSTED DURING INSTALLATION FOR COMPLIANCE WITH ANY TEMPERATURE CHANGE.


PLATES SHALL BE FIELD ADJUSTED BY ADDING OR REMOVING METAL SHIMS (2 x 3), AS REQUIRED FOR TEMPERATURE CORRECTION. THE EXPANSION GAP SHALL BE ADJUSTED FOR ANY TEMPERATURE CORRECTION PRIOR TO POURING TOP OF END BENT BACKWALL.

CONTACT SURFACE OF STEEL TO ALUMINUM SHALL BE *INCORPORATED* WITH THE MATERIAL SPECIFIED ON THE SHOP DRAWINGS.

FURNISHING AND INSTALLING THE ELASTOMERIC EXPANSION JOINT SEAL WILL BE PAID FOR AT THE CONTRACT BID PRICE PER LINEAR FOOT.

FURNISHING, PAINTING AND INSTALLING THE STRUCTURAL STEEL ARMORED JOINT WILL BE INCLUDED IN THE CONTRACT PRICE BID FOR STEEL GRID FLOOR (CONC. FILLED)

Note: Exp. Device to conform to crown of roadway.

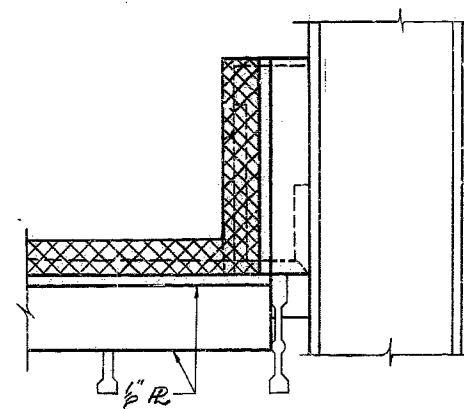

SECTION B-B

DETAILS OF EXPANSION JOINT AT BENT NO. 3

DETAILED May 19 78
CHECKED Sept. 19 78

Note: This drawing is not to scale. Follow dimensions.

Sheet No. 11 of 30.


PLATTE COUNTY

K-456R

446

MISSOURI STATE HIGHWAY DEPARTMENT

FED. ROAD DIST. NO.	STATE	FED. AID PROJ. NO.	FISCAL YEAR	SHEET NO.	TOTAL SHEETS
5	MO.		19	17	

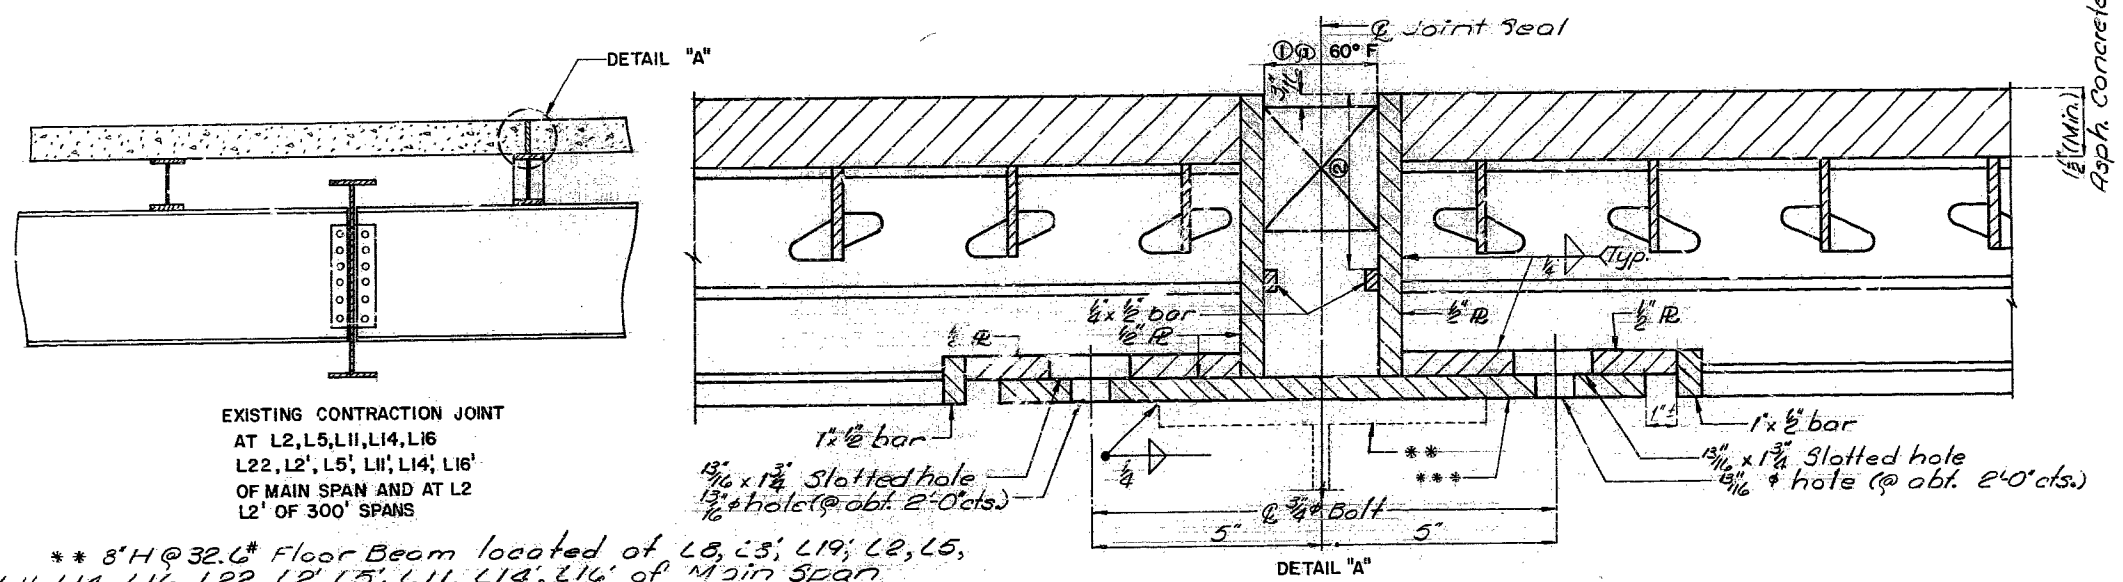

EXISTING CONTRACTION JOINT
AT L2, L5, L11, L14, L16
L22, L2', L5', L11', L14', L16'
OF MAIN SPAN AND AT L2
L2' OF 300' SPANS

** 8" H @ 32.6" Floor Beam located at L8, L3, L19, L2, L5,
L11, L14, L16, L22, L2', L5', L11', L14', L16' of Main Span
and at L2 and L2' of 300' Span.
16" W @ 40" located at Bent No. 4 & 15.

Note: Exp. Device to conform
to crown of roadway.

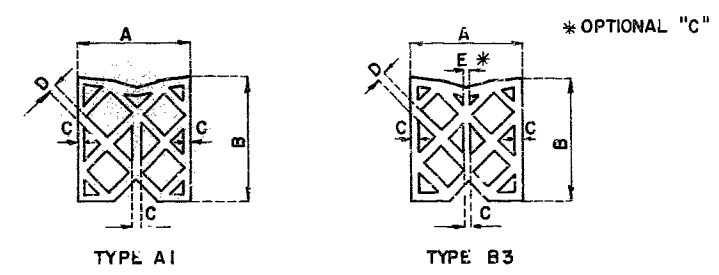


TABLE OF TRANSVERSE SEAL TOLERANCES
(INCHES)

TYPE	"A" (WIDTH)	"B" (HEIGHT)	"C" (SHELL)	"D" (WEBS)	"E" (B3 ONLY) (SMALL WEBS)
AI OR B3	2.500 +.250 -.000	2.750 +.125 -.125	0.187 +.048 -.015	0.093 +.031 -.015	0.062 +.031 -.031


TABLE OF TRANSVERSE SEALS

TYPE	GROOVE SIZE AT 60°F		SEAL SIZE	
	①	②	WIDTH	HEIGHT
AI OR B3	1-5/8"	4"	2-1/2"	2-3/4"


TABLE OF GROOVE SIZE "①"
(INSTALLATION DIMENSIONS)

TEMP (° F)	SEAL WIDTHS	
	STEEL STRUCTURE	
	2 1/2"	
-10°	2 1/8"	
0°	2"	
+20°	1-7/8"	
+40°	1-3/4"	
+60°	1-5/8"	
+80°	1-3/8"	
+100°	1-1/4"	
+110°	1-1/4"	
+120°	1-1/8"	

NOTE: See Special Provisions for requirements
of Compression Joint Seal.

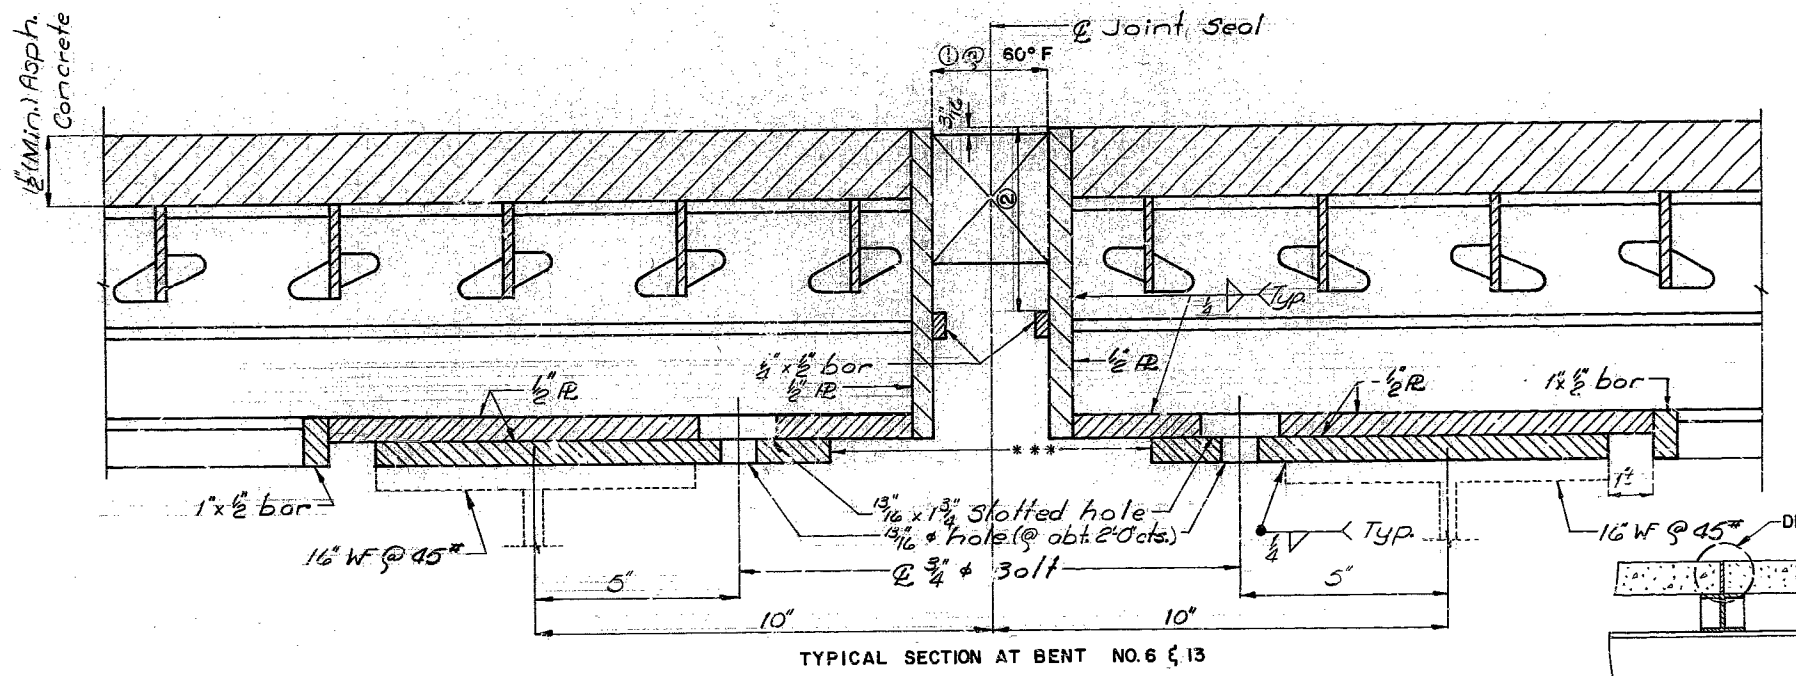

TYPICAL SECTION AT BENT NO. 6 & 13

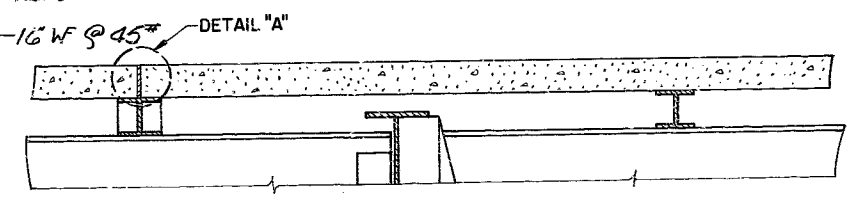

EXISTING CONTRACTION JOINT
AT L8, L8' AND L19'

Note: For details of curb at Transverse Seal
see sheet No. 10

*** Furnishing, Painting and installing the base plates for
exp. device will be included in the price bid for Fabricated
Structural Steel Revisions. The steel for the armored joint
will be included in the price bid for Steel Grid Floor (Conc. filled).

DETAILED Oct. 19 78
CHECKED Nov. 19 78

Note: This drawing is not to scale. Follow dimensions.


Sheet No. 12 of 30.

PLATTE COUNTY

K-456R

MISSOURI STATE HIGHWAY DEPARTMENT


FED. ROAD DIST. NO.	STATE	FED. AID PROJ. NO.	FISCAL YEAR	SHEET NO.	TOTAL SHEETS
3	MO.		78	18	

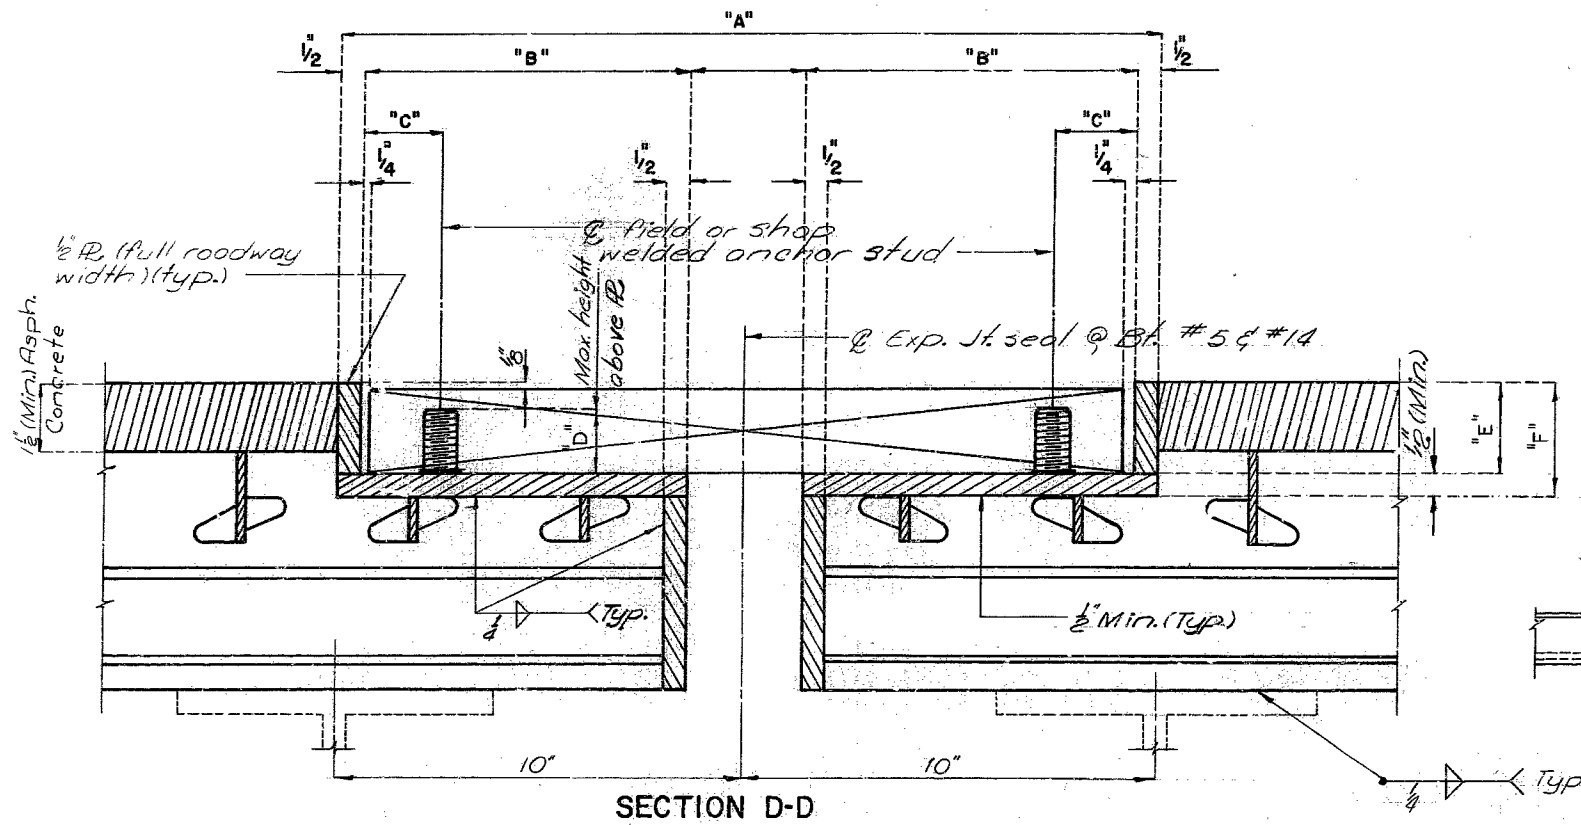


Note: For location of Section D-D see Sheet No. 6

LOCATION	ACCEPTABLE ALTERNATE TYPES	EXP. GAP AT 60°	"A" AT 60°	"B"	"C"	"D"	"E"	"F"	ANCHOR STUDS SIZE	"G"
BENT NO. 5 & 14	DELASTIFLEX LM 300	2"	12 3/8"	4 1/2"	2 3/16"	1"	2"	2 1/2"	1/2"	45
	FEL-SPAN T 30SA	1 3/8"	9 1/8"	3 1/4"	1 3/8"	1 1/4"	1 1/4"	2 3/16"	1/2"	50
	ON-FLEX 45	2"	11 1/2"	4 1/4"	1 5/8"	2 3/8"	2 1/2"	3 3/16"	1/2"	63
	WABO-ELASTODAM 300(S)	1 3/4"	9 1/4"	3 1/4"	1 1/8"	1 1/4"	1 1/4"	2 3/16"	1/2"	40


Note: For General Notes see sheet No. 11.

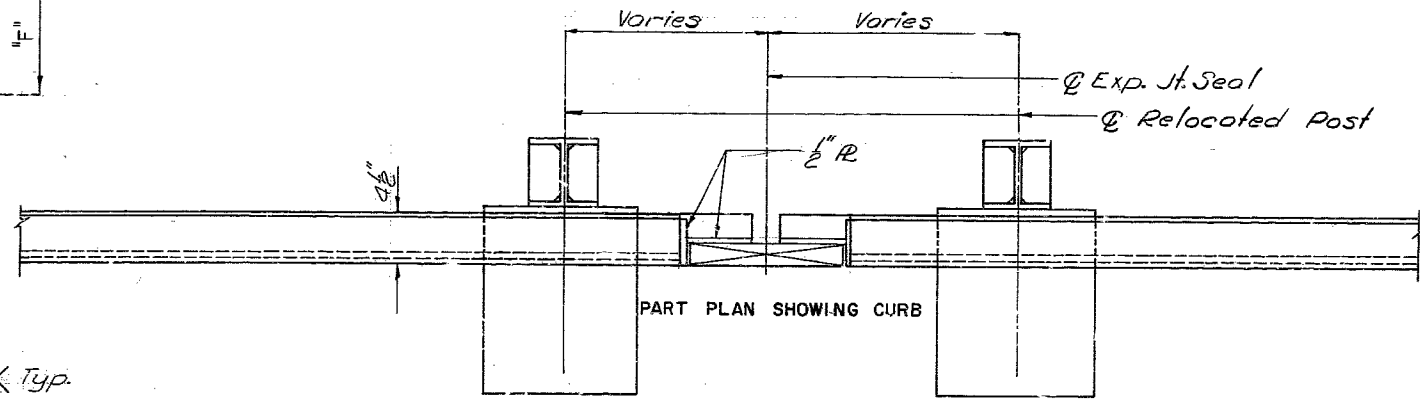

448

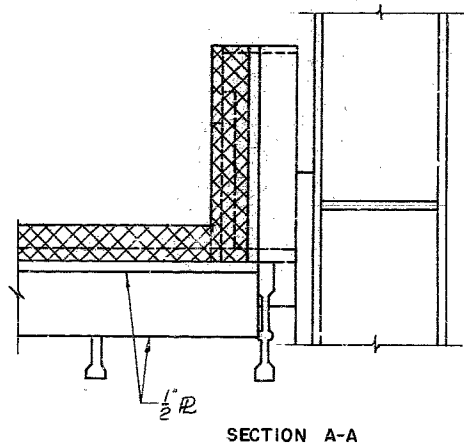

Note: Exp. Device is conform to crown of roadway.

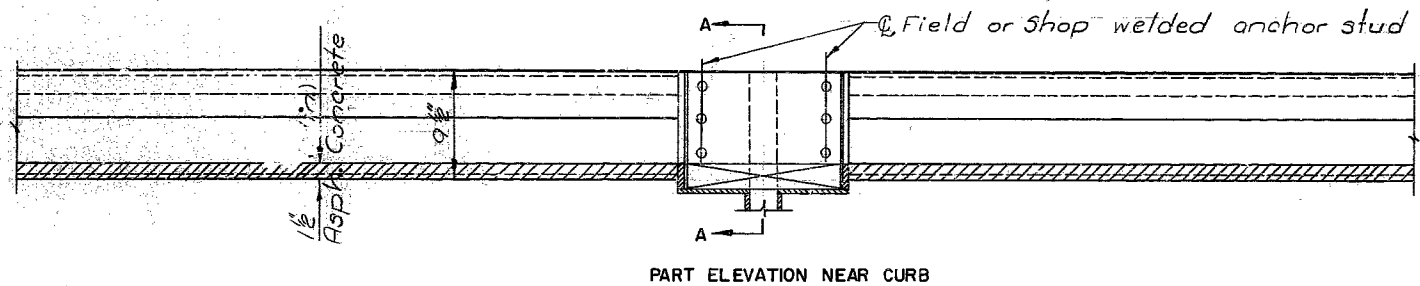

Note: Rail Posts in Elevation not shown for clarity.

DETAILS OF EXPANSION JOINT SEAL AT BENTS NO. 5 & 14

DETAILED July 1978
CHECKED Sept 1978

Note: This drawing is not to scale. Follow dimensions.

Sheet No. 13 of 30.

PLATTE COUNTY




K-456R

MISSOURI STATE HIGHWAY DEPARTMENT


FED. ROAD DIST. NO.	STATE	FED. AID PROJ. NO.	FISCAL YEAR	SHEET NO.	TOTAL SHEETS
5	MO.		19	19	

LOCATION	ACCEPTABLE ALTERNATE TYPES	EXP GAP AT 60°	TABLE OF DIMENSIONS						ANCHOR STUDS SIZE
			"A"	"B"	"C"	"D"	"E"	"F"	
BENT NO. 7 & 12	TRANSFLEX 400A	3 1/8"	24 3/8"	9 1/8"	2 1/16"	1 1/2"	2 3/16"	2 1/16"	3/4" 85
	WABO-Flex SR4A	2 7/8"	24 3/8"	10 1/8"	1 5/16"	1 3/8"	2 3/16"	2 1/16"	3/4" 85

Note: For General Notes see sheet No. 11.
For location of Section E-E see sheet No. 7.

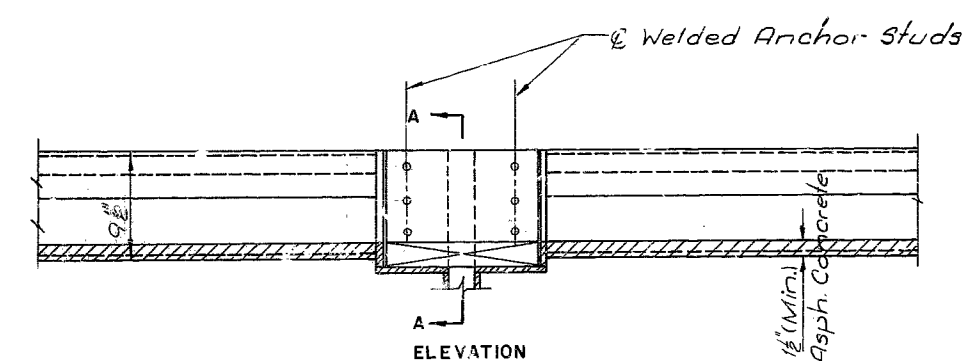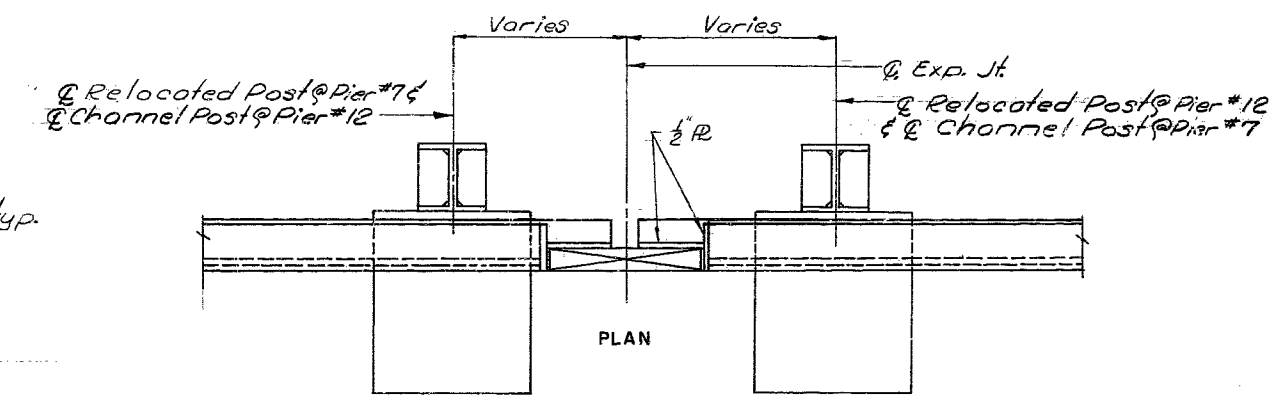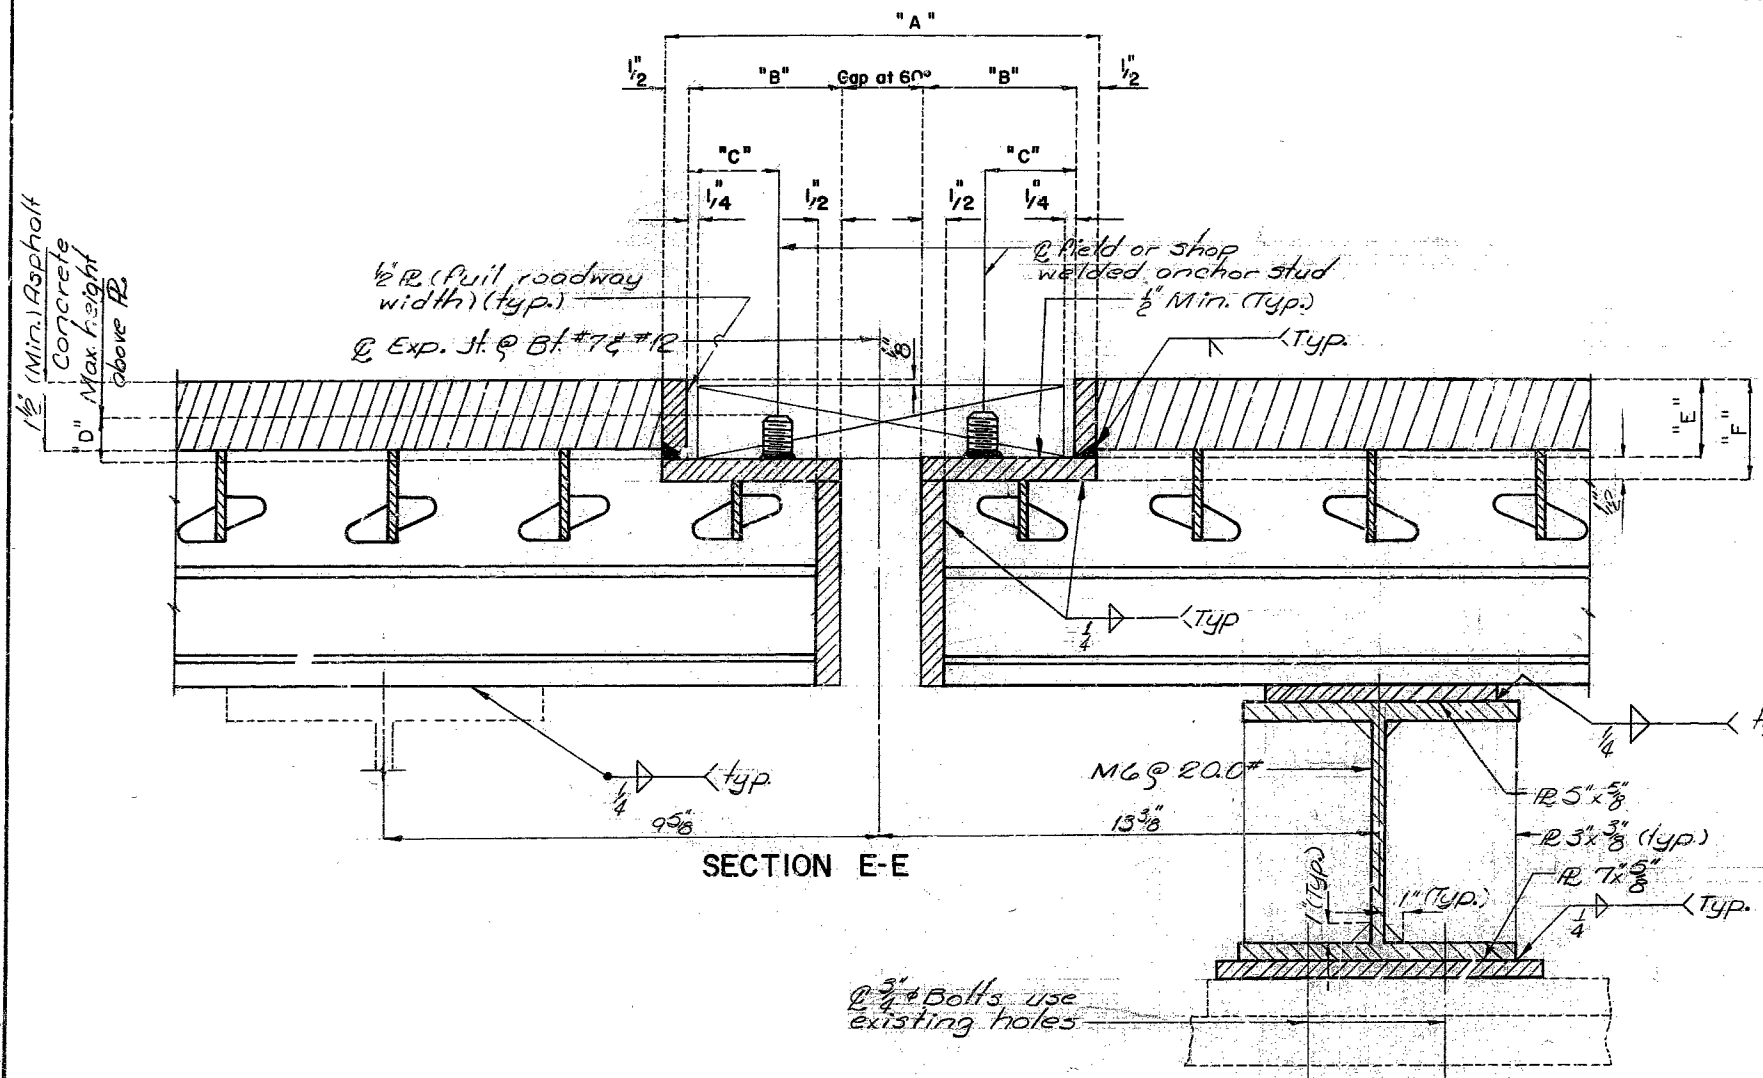

Note: Rail post not shown in Elevation for clarity.

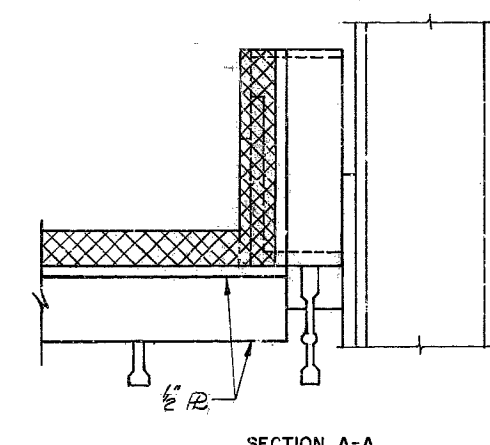

DETAILS OF EXPANSION JOINT SEAL AT PIER NO. 7 & 12

449

Note: Exp. Device to conform to crown of roadway.


Note: This drawing is not to scale. Follow dimensions.

DETAILED Mar. 19 78
CHECKED Sept. 19 78

Sheet No. 14 of 30.

MISSOURI STATE HIGHWAY DEPARTMENT




FED. ROAD DIST. NO.	STATE	FED. AID PROJ. NO.	FISCAL YEAR	SHEET NO.	TOTAL SHEETS
5	MO.		19	20	

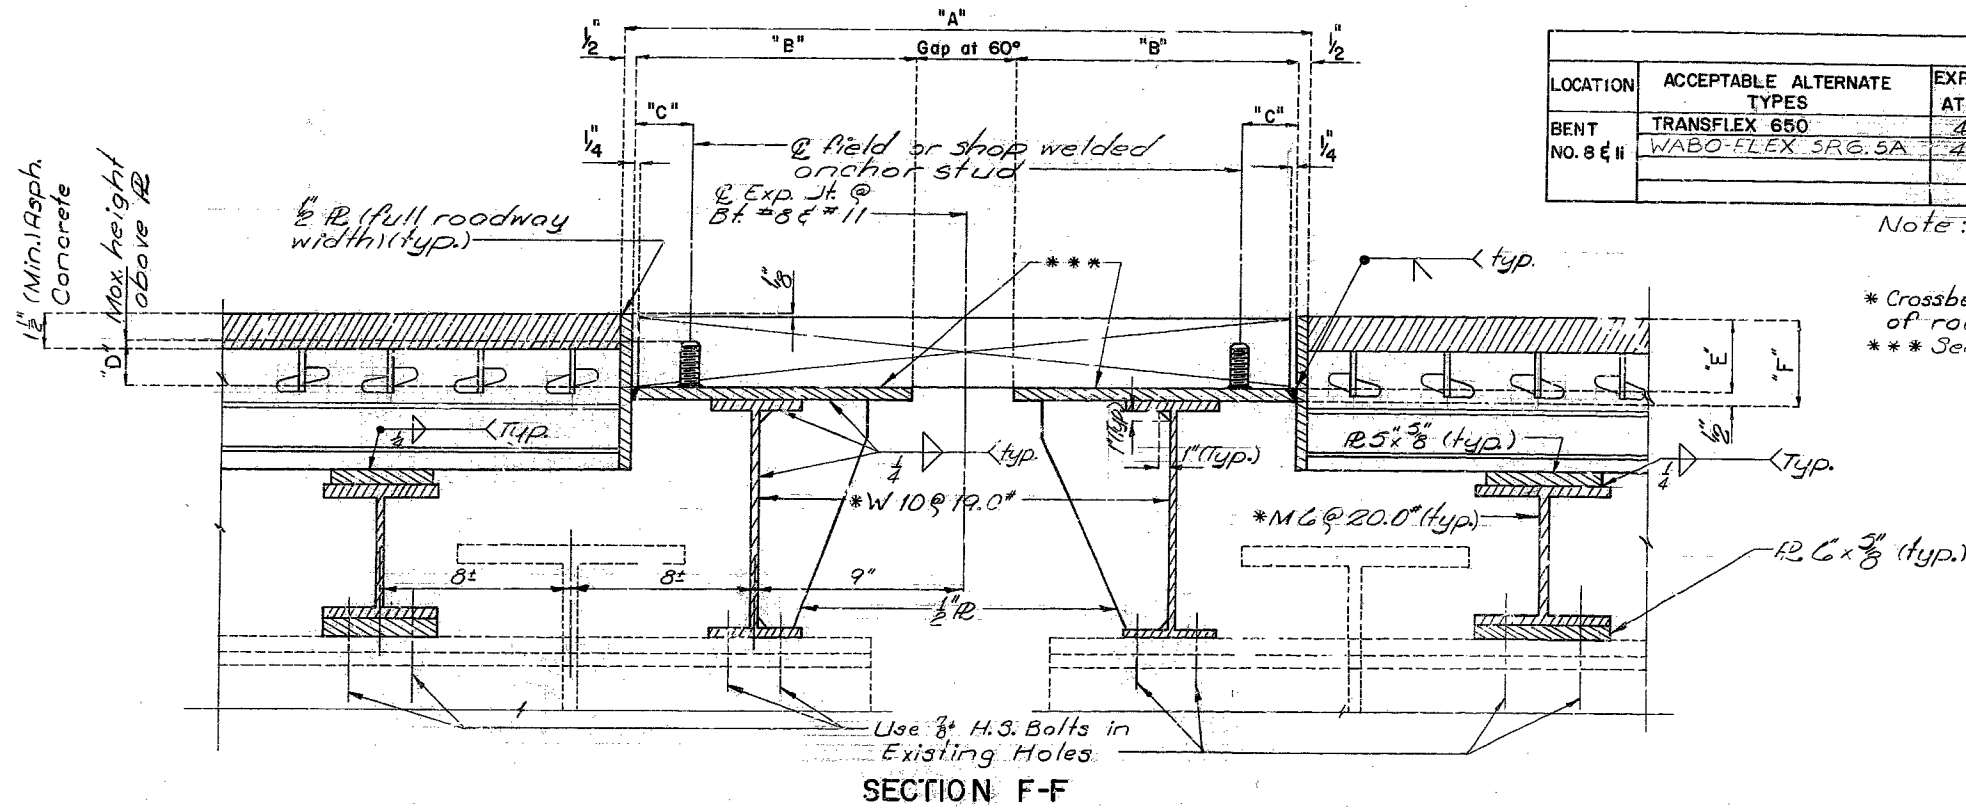

LOCATION	ACCEPTABLE ALTERNATE TYPES	EXP GAP AT 60°	"A" AT 60°	"B"	"C"	"D"	"E"	"F"	ANCHOR STUDS SIZE
BENT NO. 8 & II	TRANSFLEX 650	4 1/2"	24 3/4"	12 1/8"	2 3/8"	2"	3 3/16"	3 1/2"	3/8" 100
	WABO-FLEX SRG. 5A	4 1/2"	25 1/4"	11 1/8"	2 1/8"	2"	3 3/16"	3 1/16"	1/2" 100

Note: For General Notes see sheet No. 11
For location of Section F-F see Sheet No. 7

* Crossbeams to be curved to conform to crown of roadway.
*** See Sheet #12

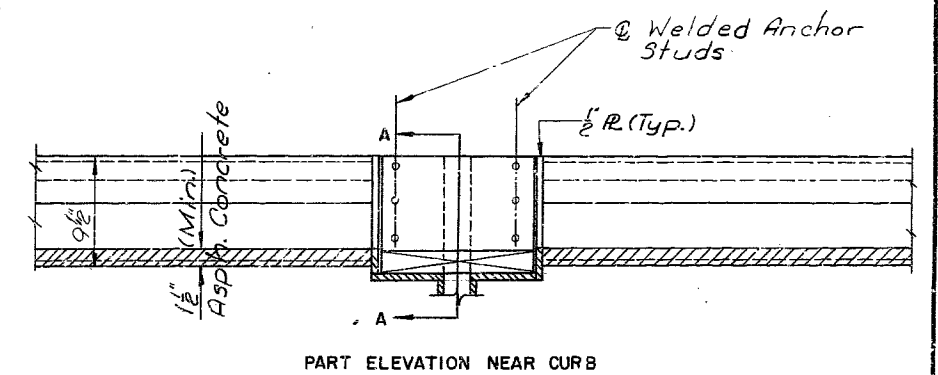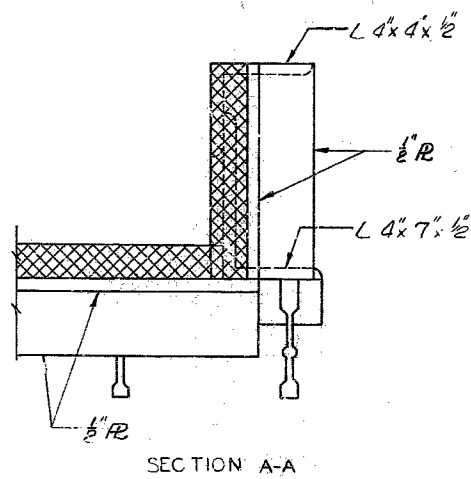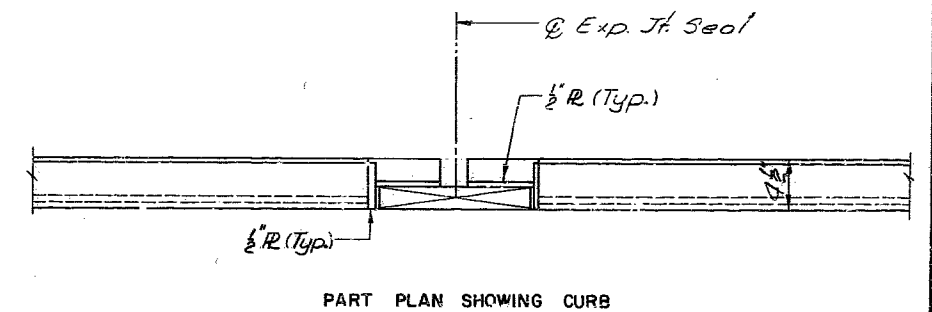

DETAILS OF EXPANSION JOINT SEAL AT PIERS NO. 8 & II

DETAILED April 19 78
CHECKED Sept. 19 78

Note: This drawing is not to scale. Follow dimensions.

Sheet No. 15 of 30.

PLATTE COUNTY

K-456R


450

MISSOURI STATE HIGHWAY DEPARTMENT


FED. RVD DIST. NO.	STATE	FED. AID PROJ. NO.	FISCAL YEAR	SHEET NO.	TOTAL SHEETS
3	MO.		13	21	

LOCATION	ACCEPTABLE ALTERNATE TYPES	EXP. GAP AT 60°	TABLE OF DIMENSIONS						ANCHOR STUDS SIZE "G"
			"A" AT 60°	"B"	"C"	"D"	"E"	"F"	
L 19	TRANSFLX 650	4 1/2"	29 3/4"	12 1/8"	2 3/8"	2"	3 3/16"	3 1/16"	1/8" 100
	WABO-FLEX SR6.5A	4 1/2"	29 1/4"	11 1/8"	2 1/8"	2"	3 3/16"	3 1/16"	1/8" 100


Note: For General Notes see sheet No. 11
 For location of Section G-G see sheet No. 8
 *** See Sheet #12

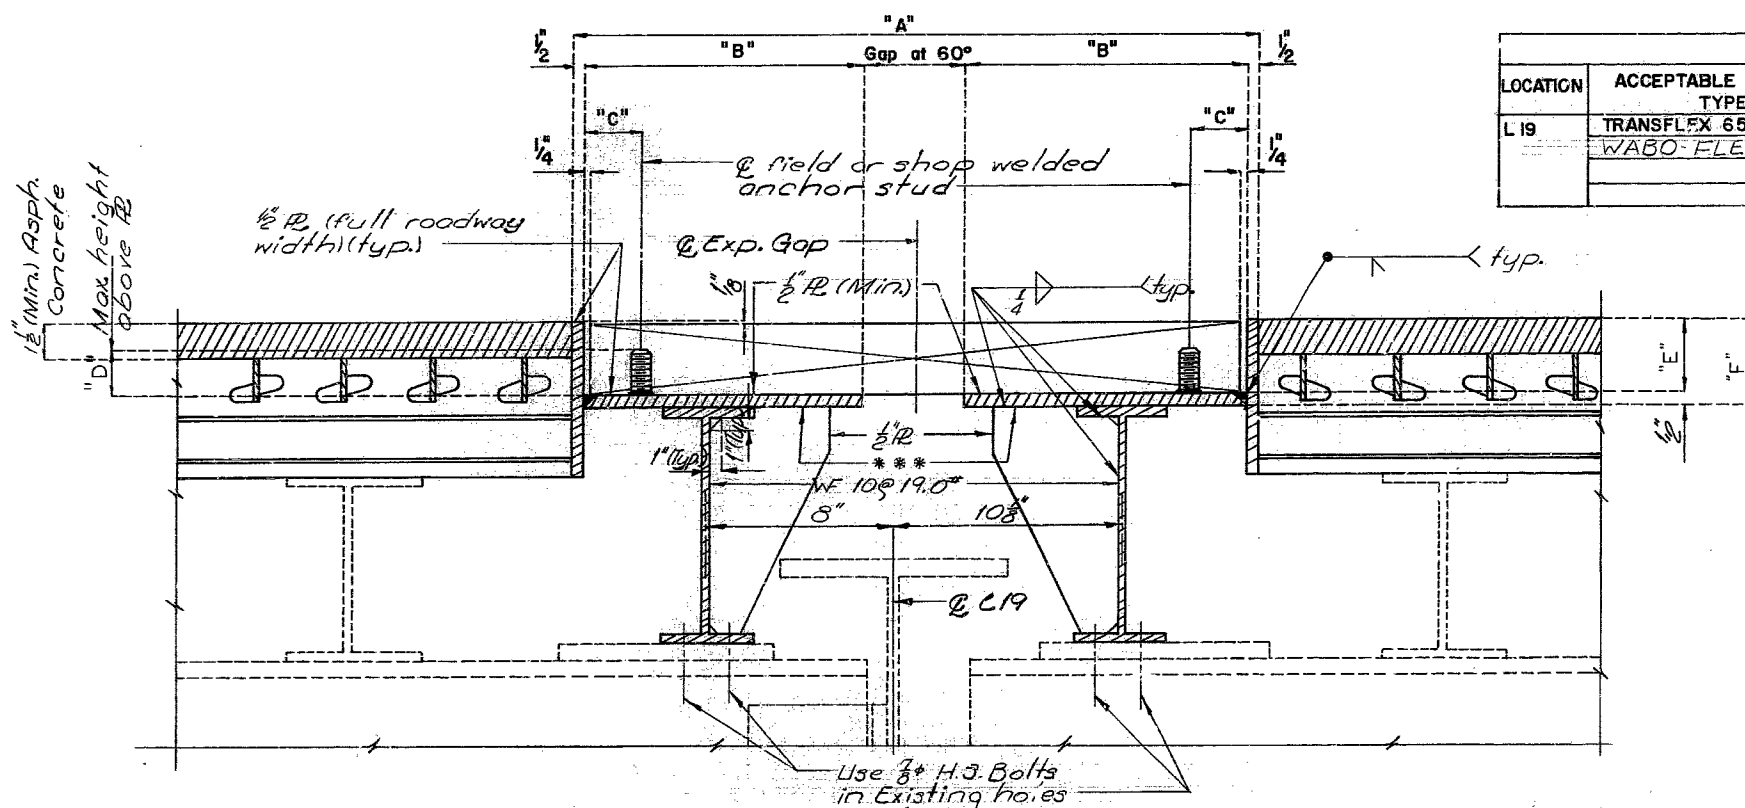


SECTION G-G

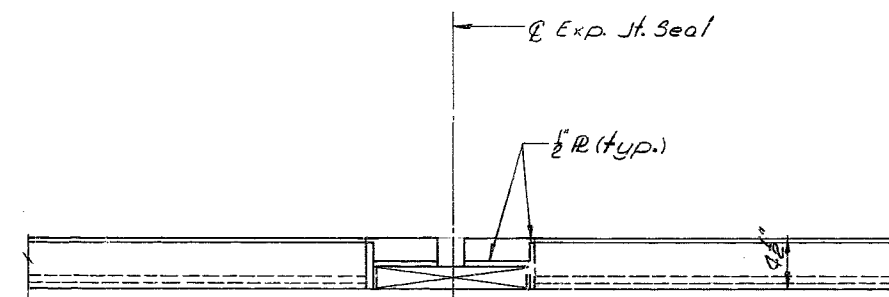

PART PLAN SHOWING CURB

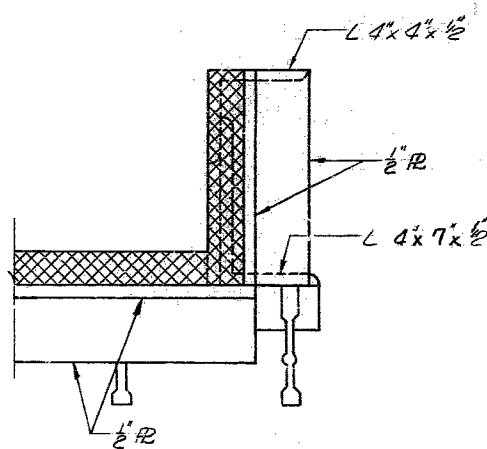

SECTION A-A

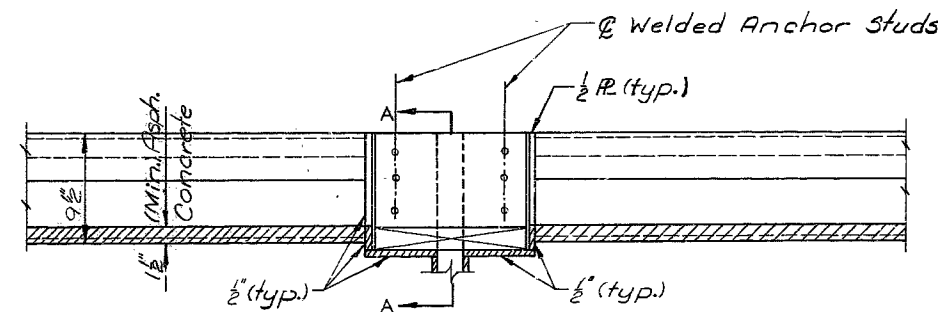

PART ELEVATION NEAR CURB

DETAILS OF EXPANSION JOINT SEAL AT L19

DETAILED April 19 78
 CHECKED Sept. 19 78

Note: This drawing is not to scale. Follow dimensions.

Sheet No. 16 of 30.




PLATTE COUNTY

K-456R





AS1

MISSOURI STATE HIGHWAY DEPARTMENT

FED. ROAD DIST. NO.	STATE	FED. AID PROJ. NO.	FISCAL YEAR	SHEET NO.	TOTAL SHEETS
5	MO.		88	22	

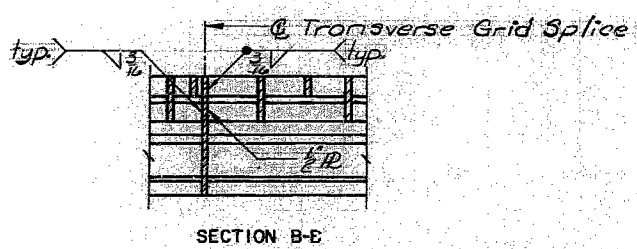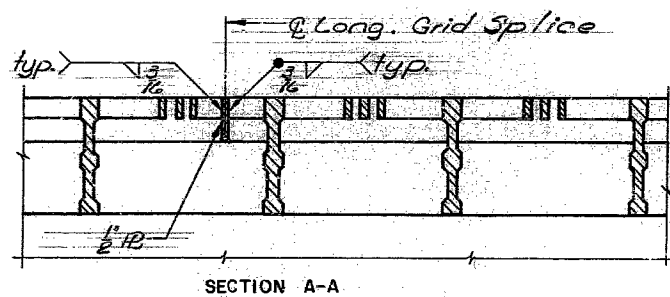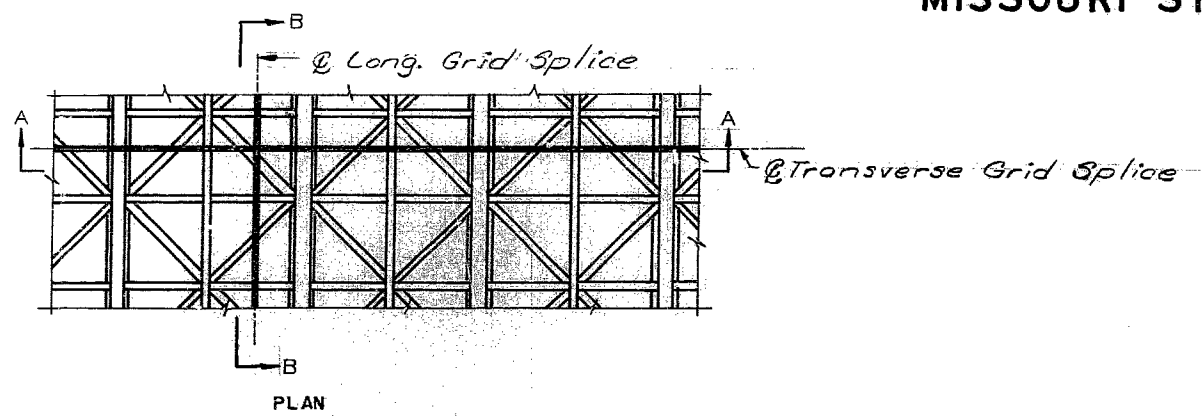

DETAILS OF GRID SPLICES

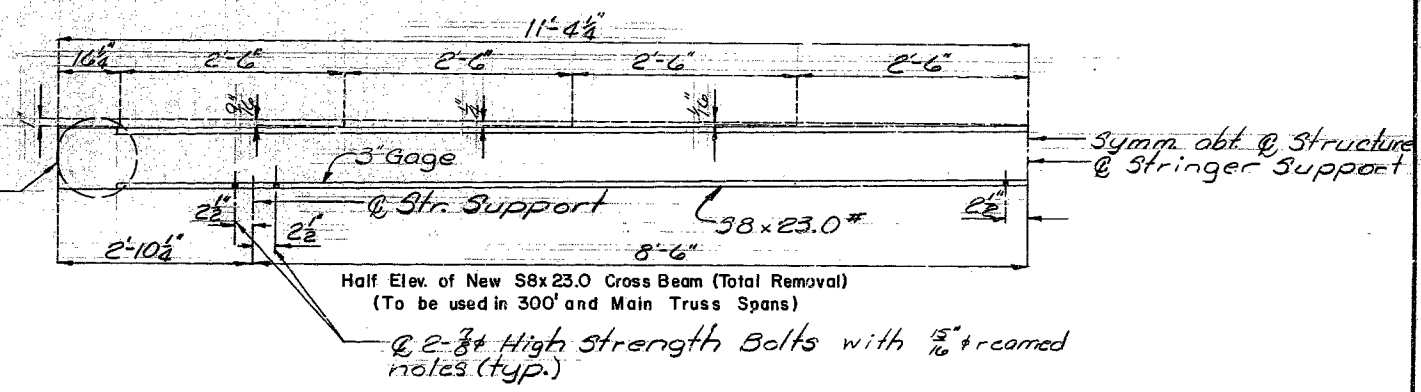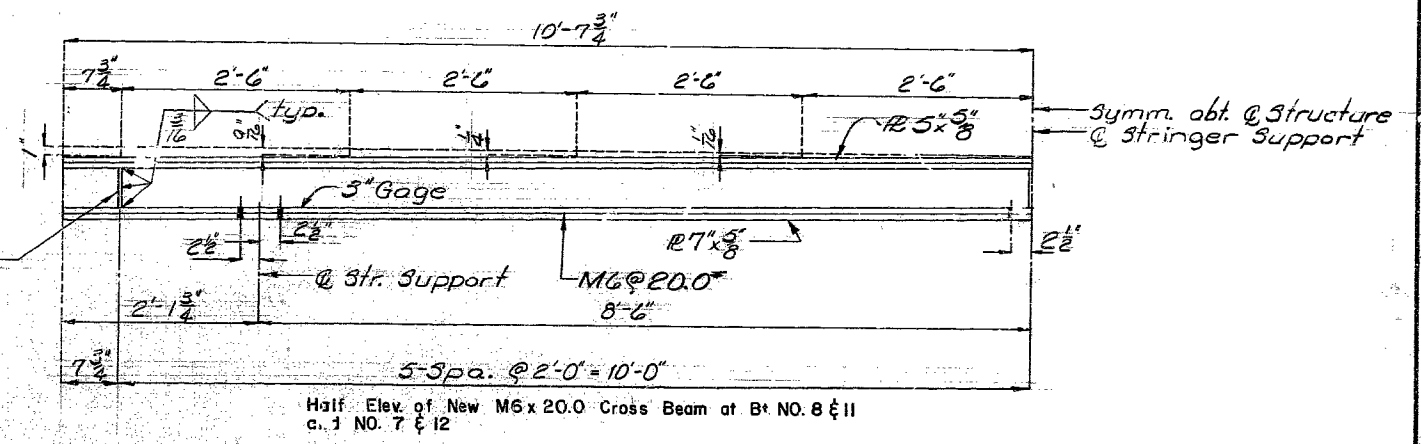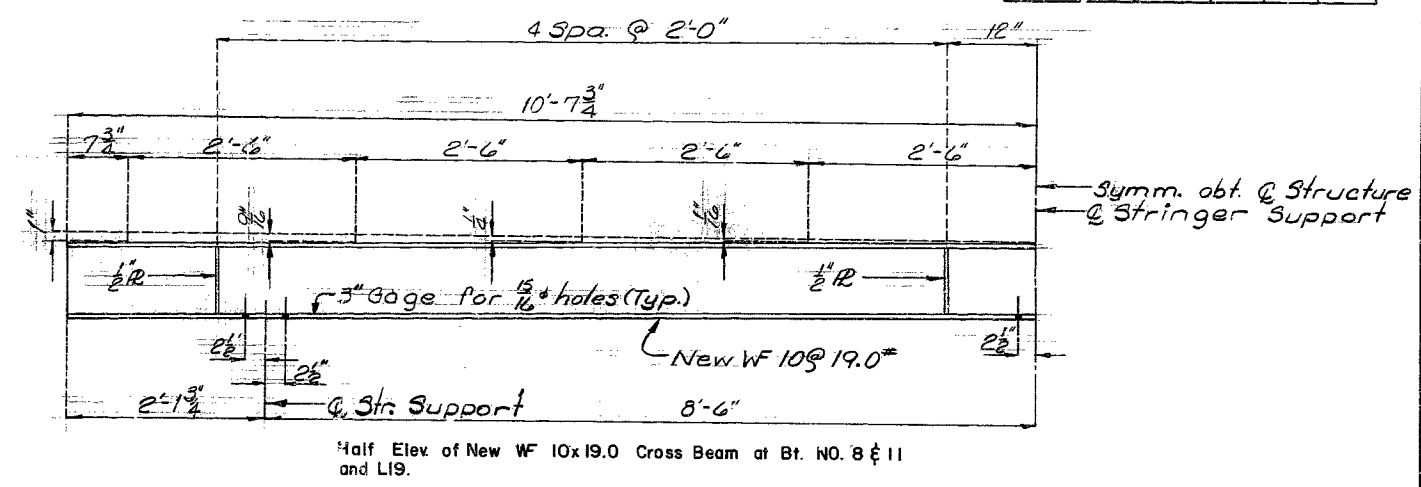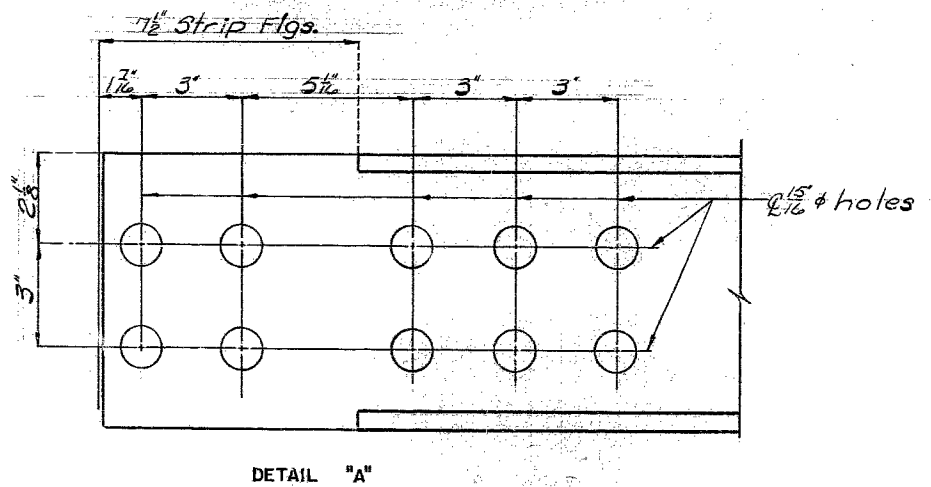

DETAILS OF CROSS BEAM REPLACEMENT

452

DETAILED Dec. 19 78
CHECKED Dec. 19 78


Note: This drawing is not to scale. Follow dimensions.

Sheet No. 17 of 30.


PLATTE COUNTY K-456R

MISSOURI STATE HIGHWAY DEPARTMENT


FED. ROAD DIST. NO.	STATE	FED. AID PROJ. NO.	FISCAL YEAR	SHEET NO.	TOTAL SHEETS
5	MO.		19	23	

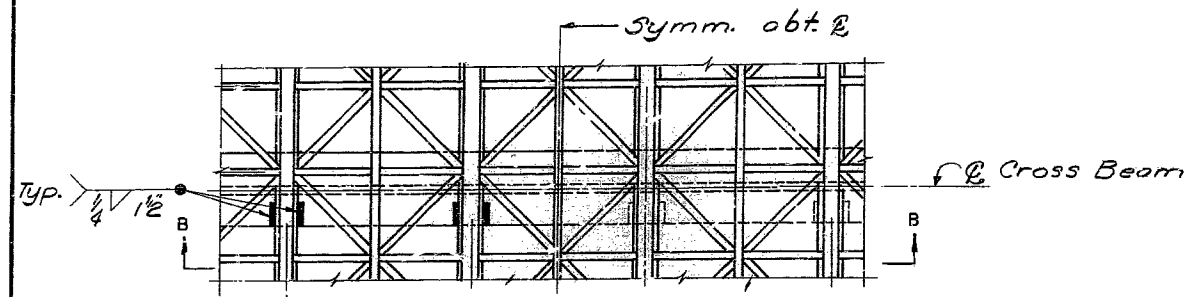

PLAN

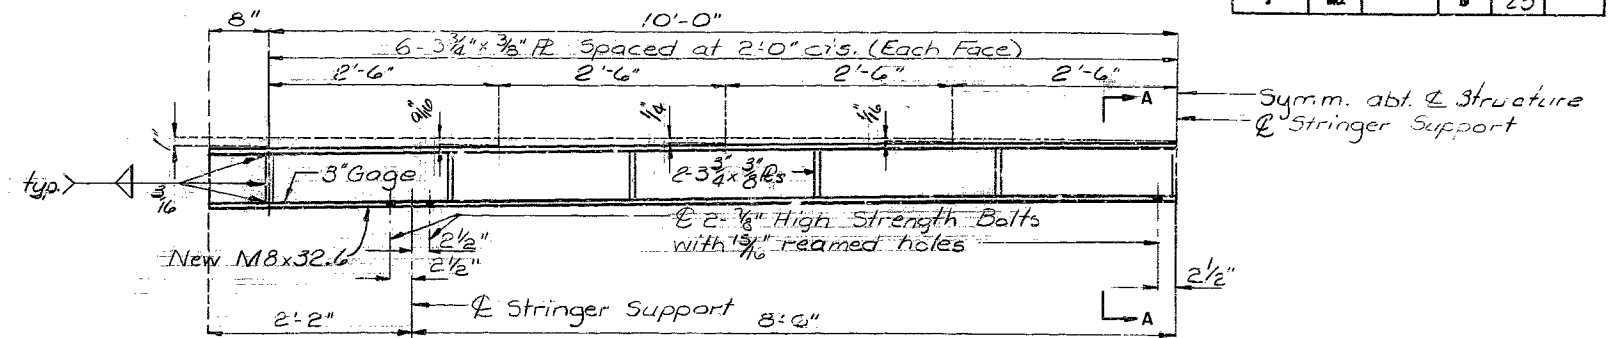


Half Elev. of New M8x32.6 Cross Beam (Total Removal)
(To be used in Spans * at the Preformed Exp. Device locations only)

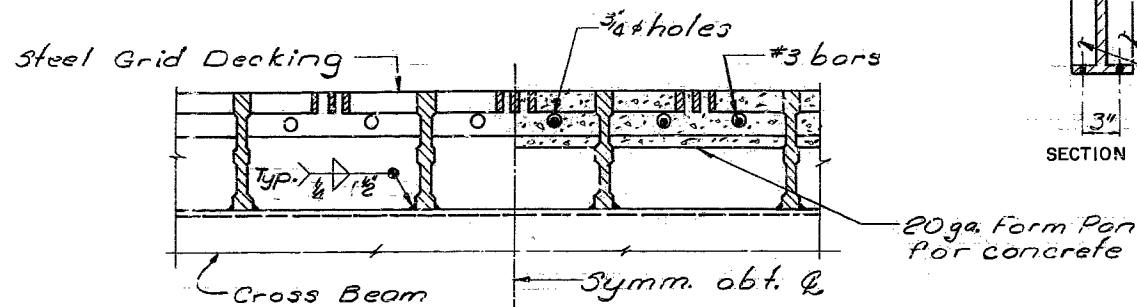


SECTION B-B

TYPICAL GRID SECTION

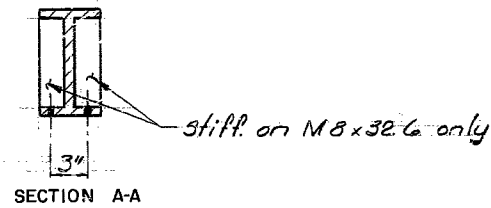


SECTION A-A


stiff. on M8x32.6 only

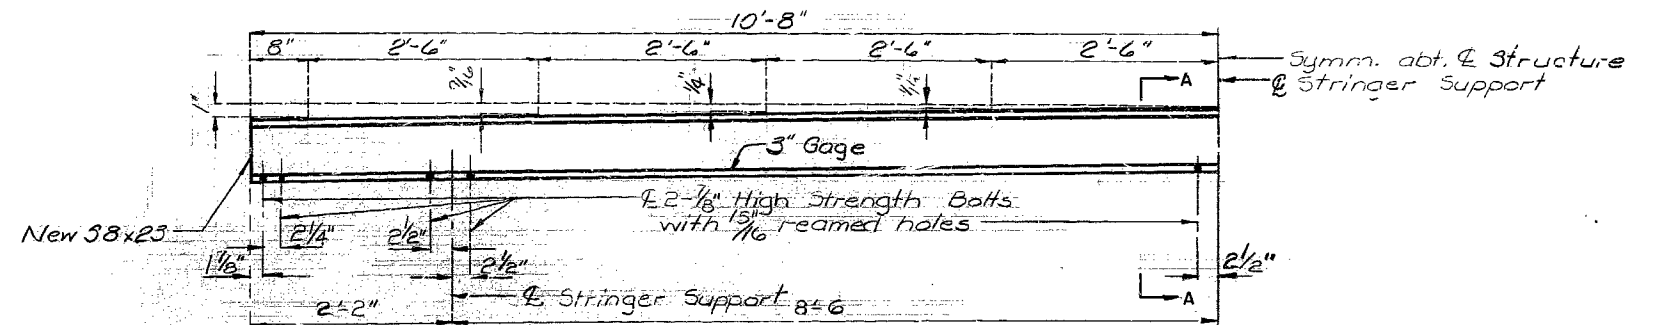

Half Elev. of New S8x23 Cross Beam (Total Removal)
(To be used in Spans *)

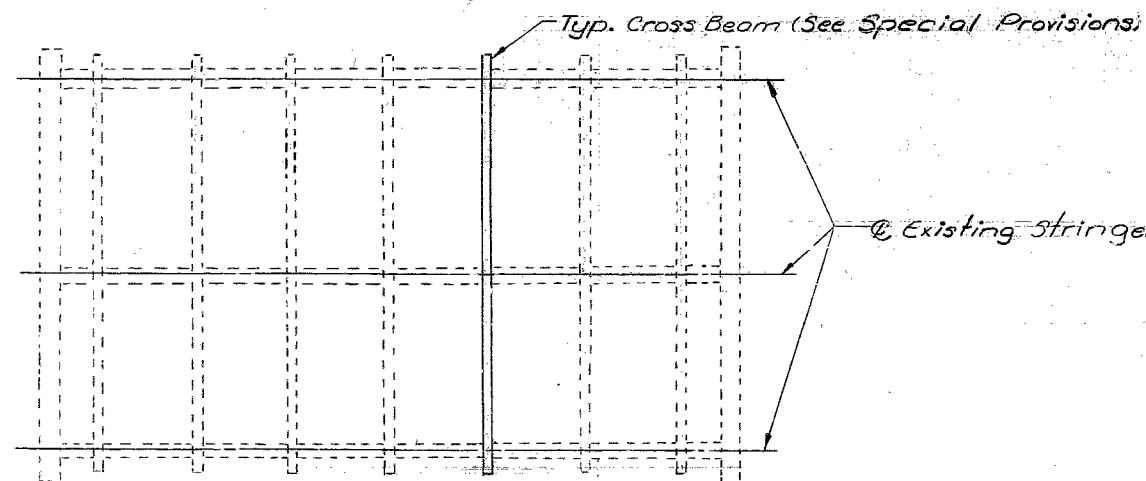

Part Plan of Cross Beams (Span 5-6, 6-7, 7-8, 8-9, & 9-10)
(Showing Typical Removal & Replacement of Cross Beams)
(See Special Provisions)

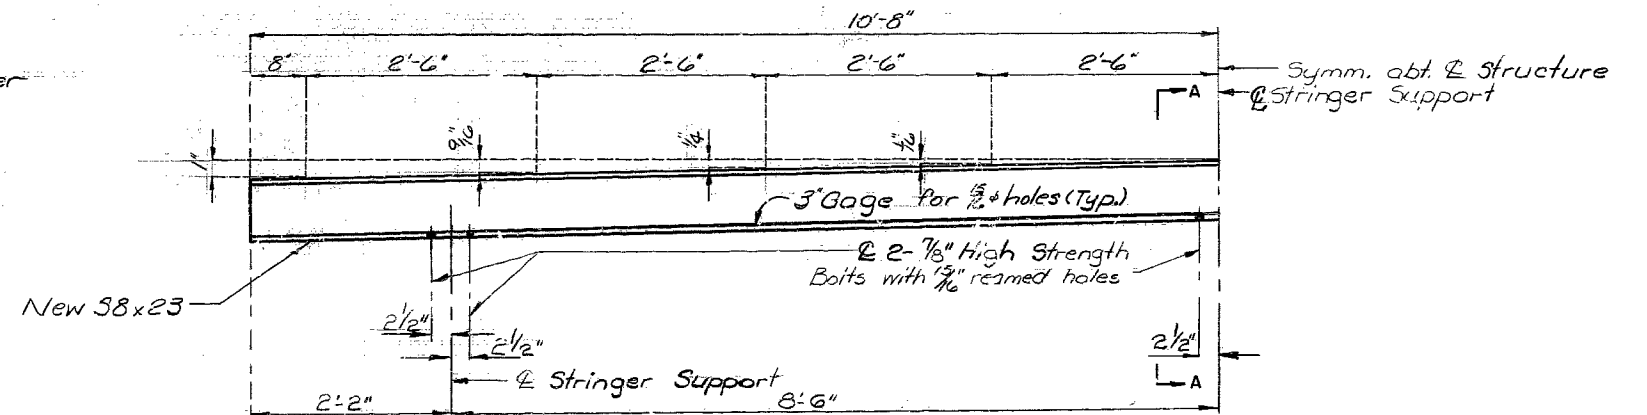

Half Elev. of New S8x23 Cross Beam (Total Removal)
(To be used in Spans *)

* 300' AND MAIN TRUSS SPANS

DETAILS OF CROSS BEAM REPLACEMENT

453
 DETAILED Nov. 19 78
 CHECKED Nov. 19 78

Note: This drawing is not to scale. Follow dimensions.


Sheet No. 18 of 30.

PLATTE COUNTY


K-456R

MISSOURI STATE HIGHWAY DEPARTMENT

FED. ROAD DIST. NO.	STATE	FED. AID PROJ. NO.	FISCAL YEAR	SHEET NO.	TOTAL SHEETS
5	MO.		19	24	

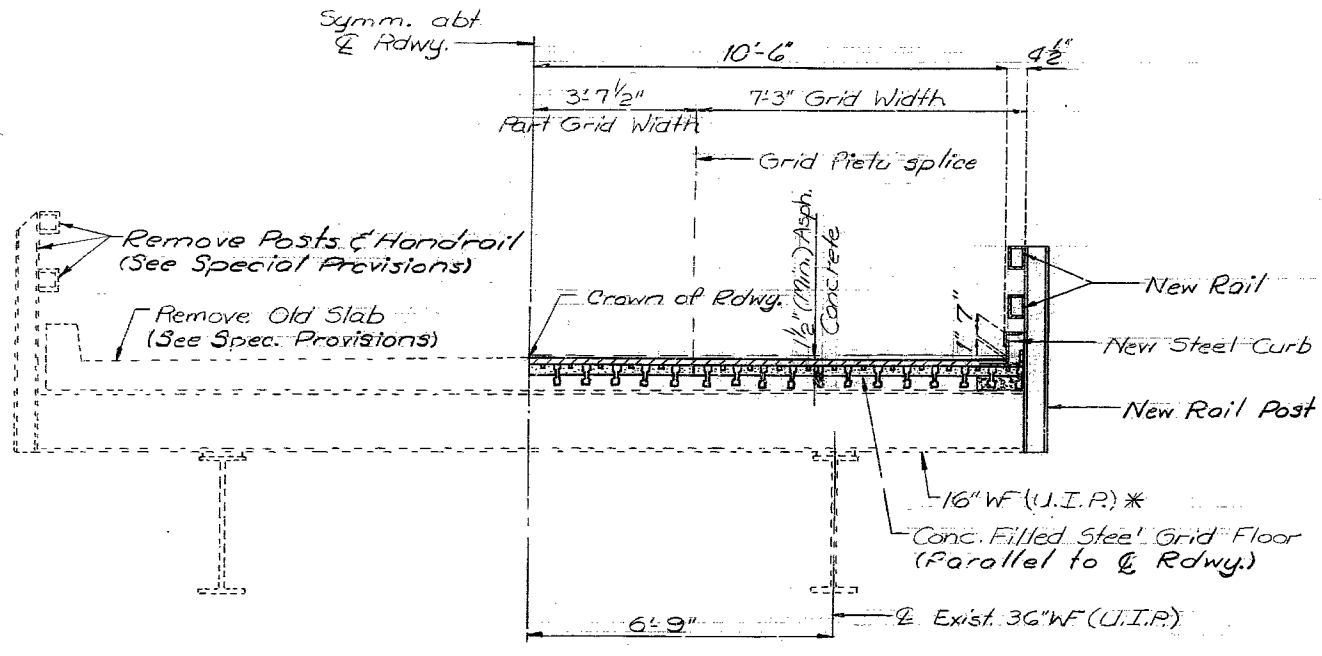


SECTION THRU SPAN (3-4) & (15-16)

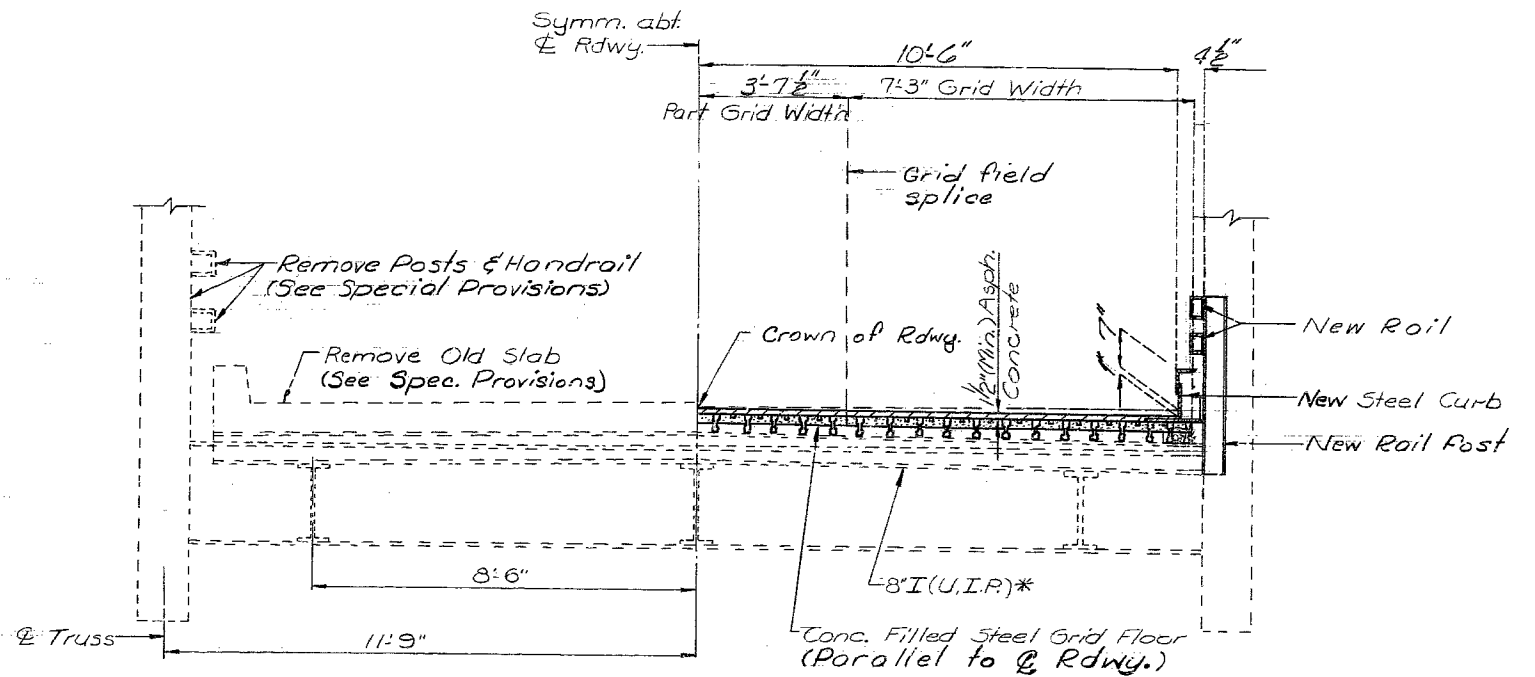


SECTION THRU TRUSS SPANS


* See Special Provisions if replacement is required by the Engineer.

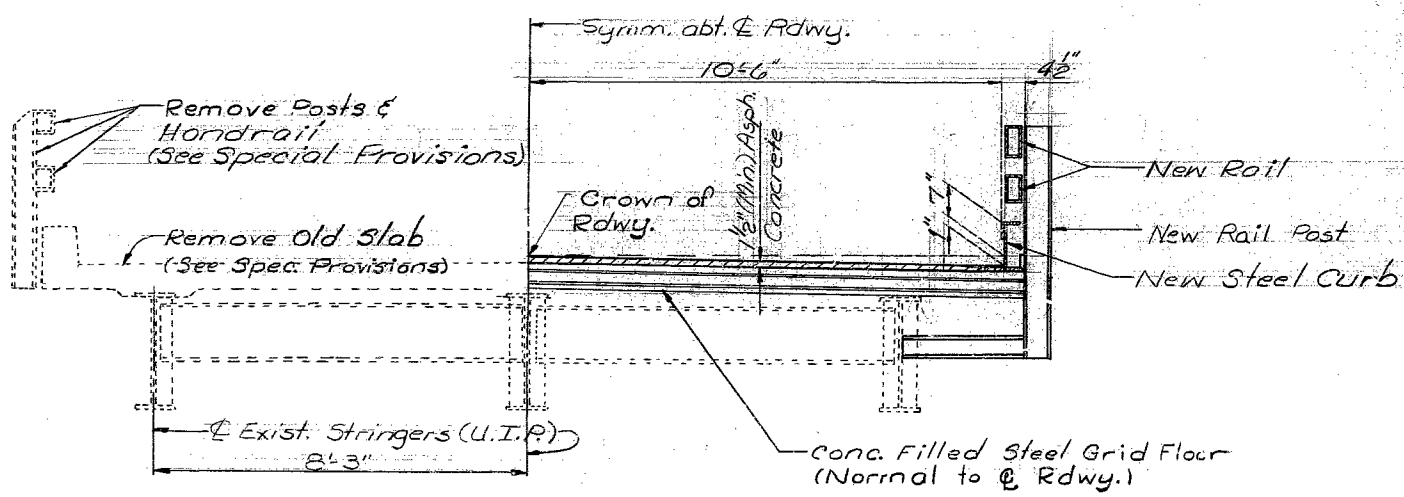

SECTION THRU SPANS (1-2) & (2-3)

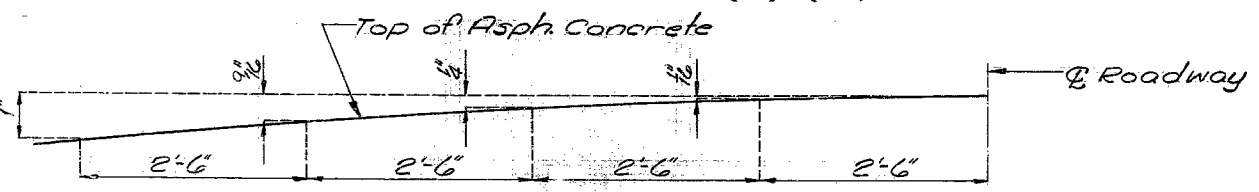

Note: Grid to be attached directly to existing crossbeam stringers.
1" Crown to be constructed out of Asphalt except in the overhead truss spans.



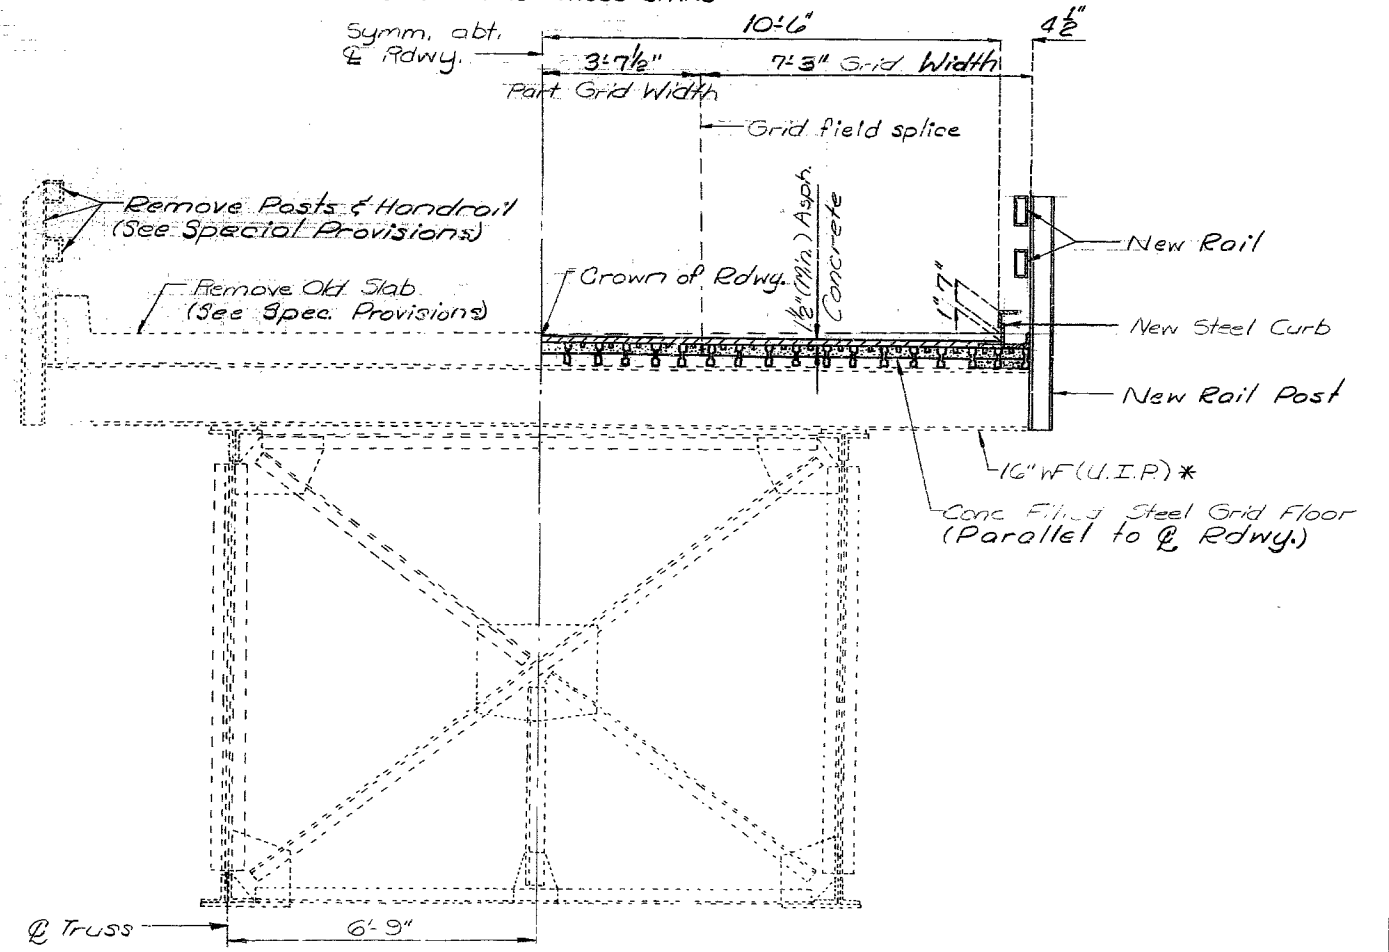


SECTION THRU DECK TRUSS SPANS


454

MISSOURI STATE HIGHWAY DEPARTMENT


FED. ROAD DIST. NO.	STATE	FED. AID PROJ. NO.	FISCAL YEAR	SHEET NO.	TOTAL SHEETS
5	MO.		19	25	

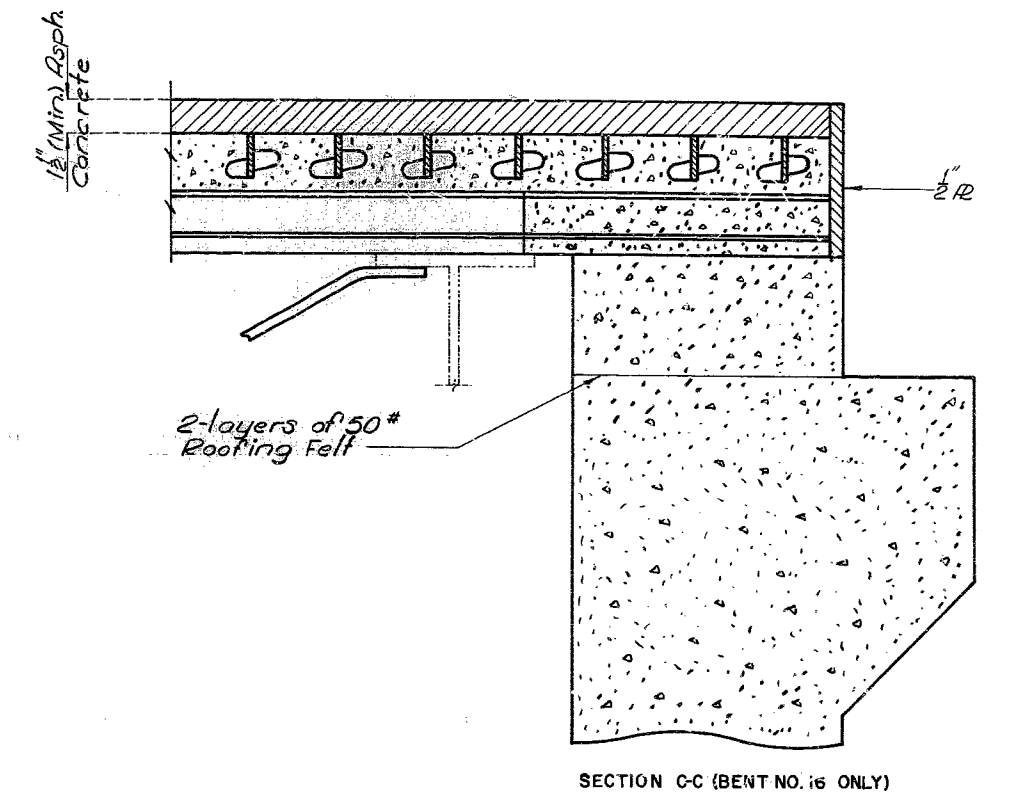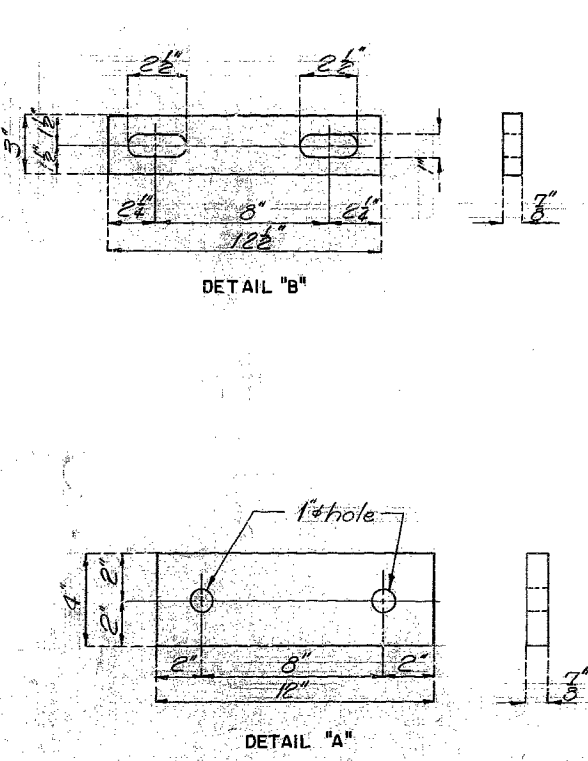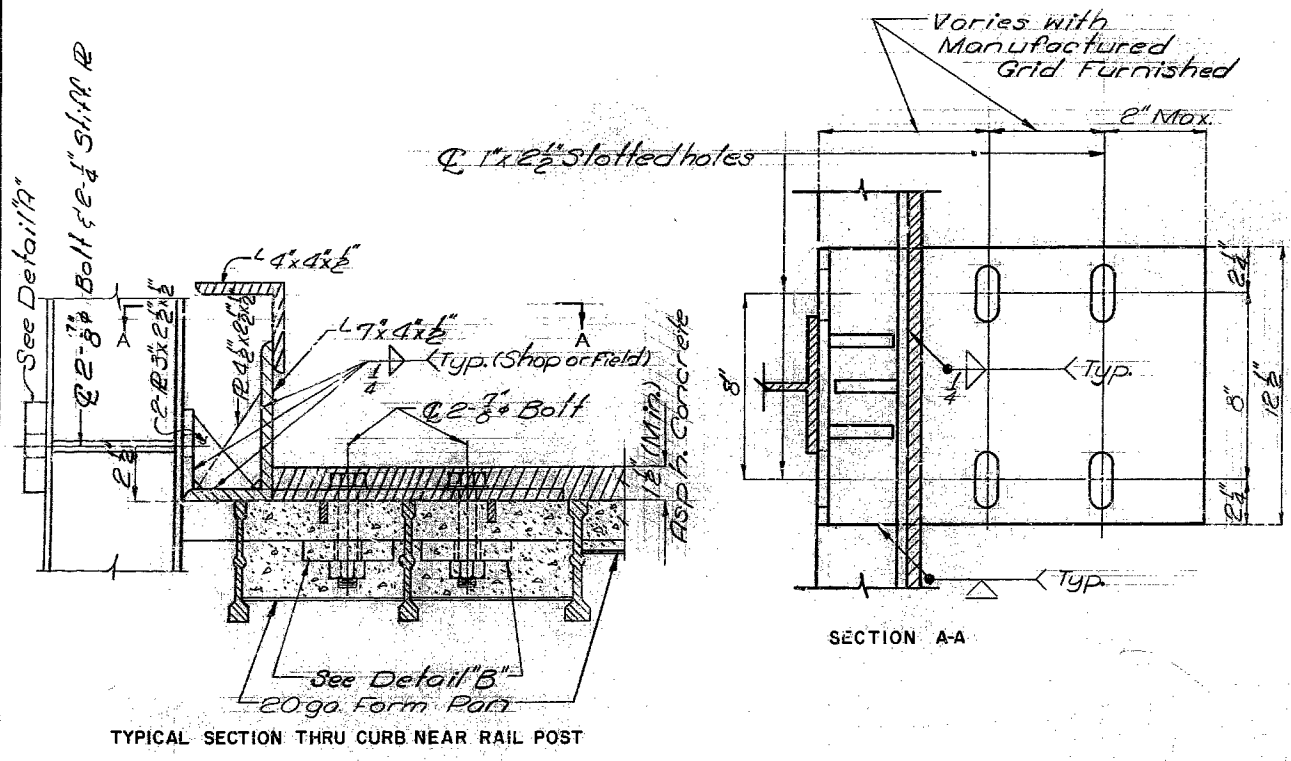

455

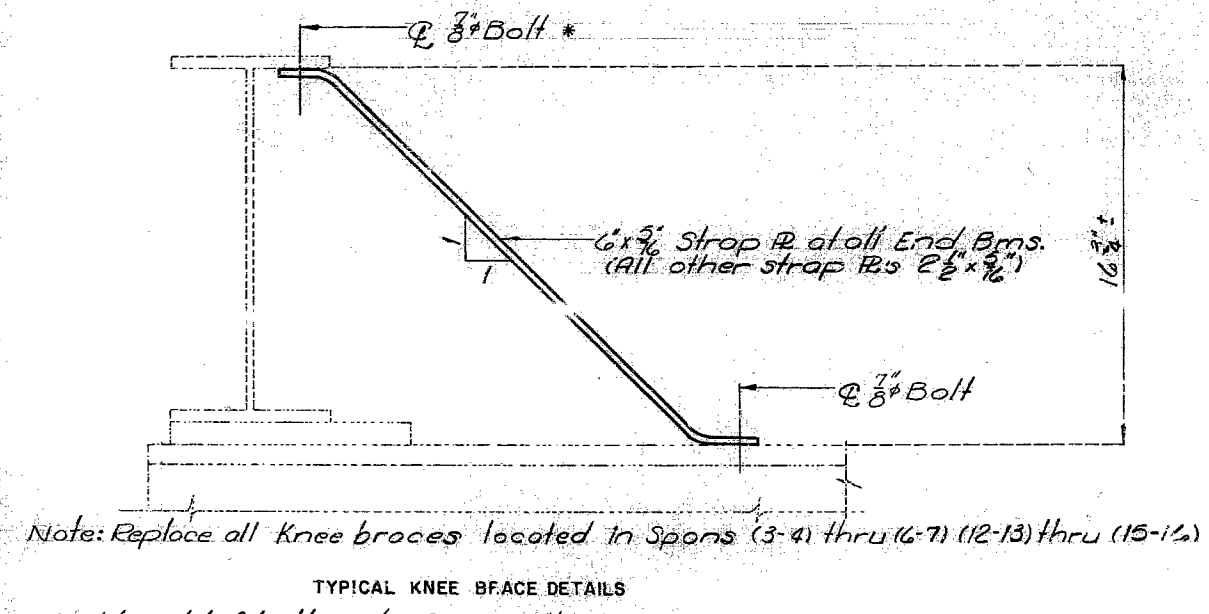

* Field weld if bolts interfere with placement of grid.

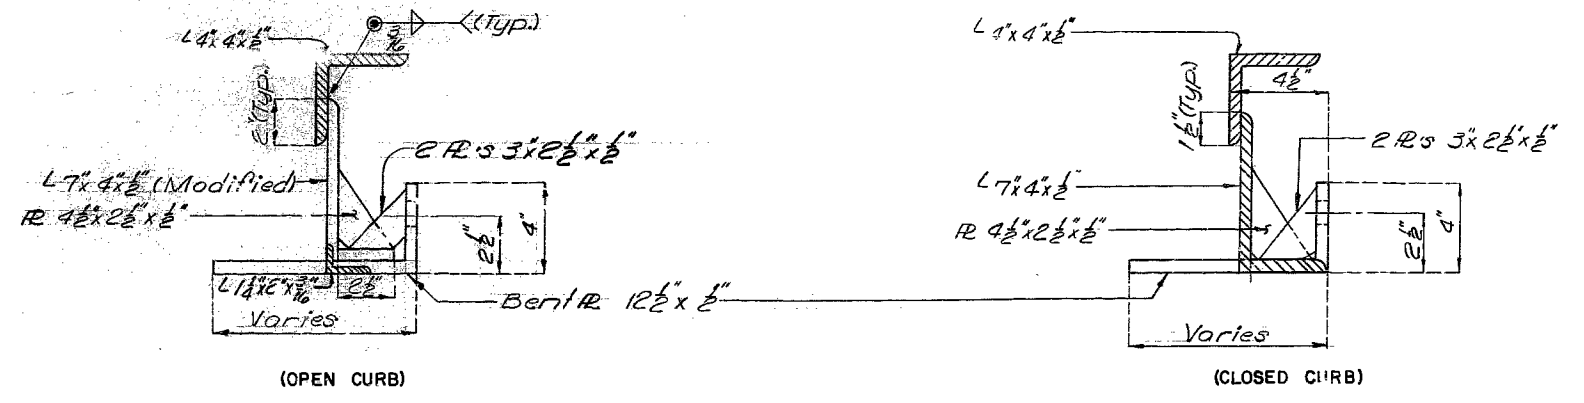

TYPICAL CURB DETAILS

DETAILED Mar. 19 79
CHECKED Mar. 19 79

Note: This drawing is not to scale. Follow dimensions.


Sheet No. 20 of 30.

PLATTE COUNTY


K-456R

MISSOURI STATE HIGHWAY DEPARTMENT


FED. ROAD DIST. NO.	STATE	FED. AID PROJ. NO.	FISCAL YEAR	SHEET NO.	TOTAL SHEETS
5	MO.		19	26	

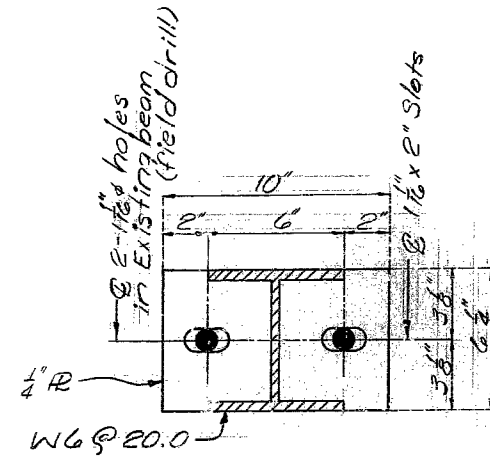


SECTION C-C

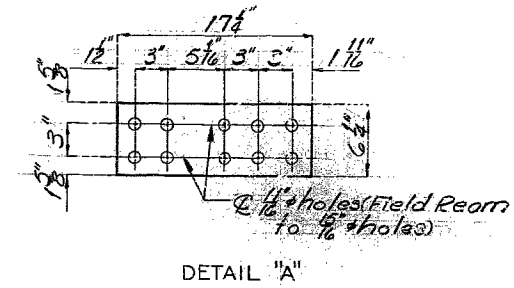


DETAIL "A"

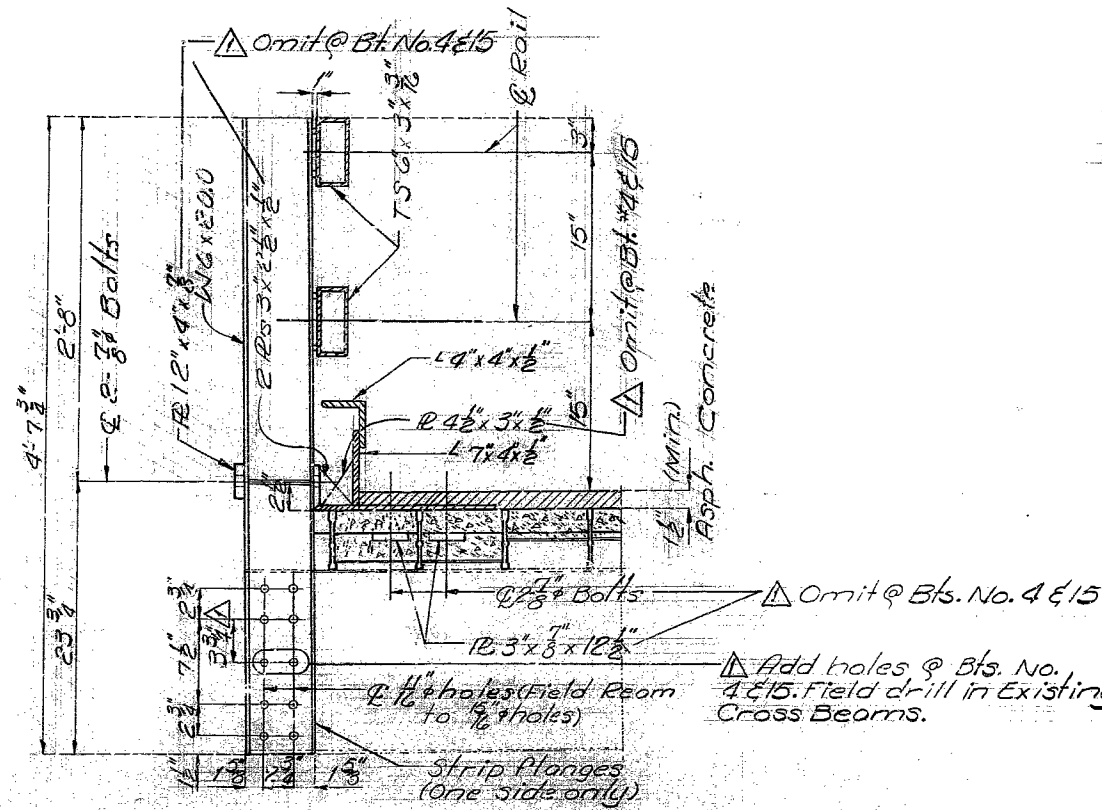

TYPICAL SECTION SHOWING RAIL POST CONNECTION FOR SPANS 3 THRU 6 AND 12 THRU 15

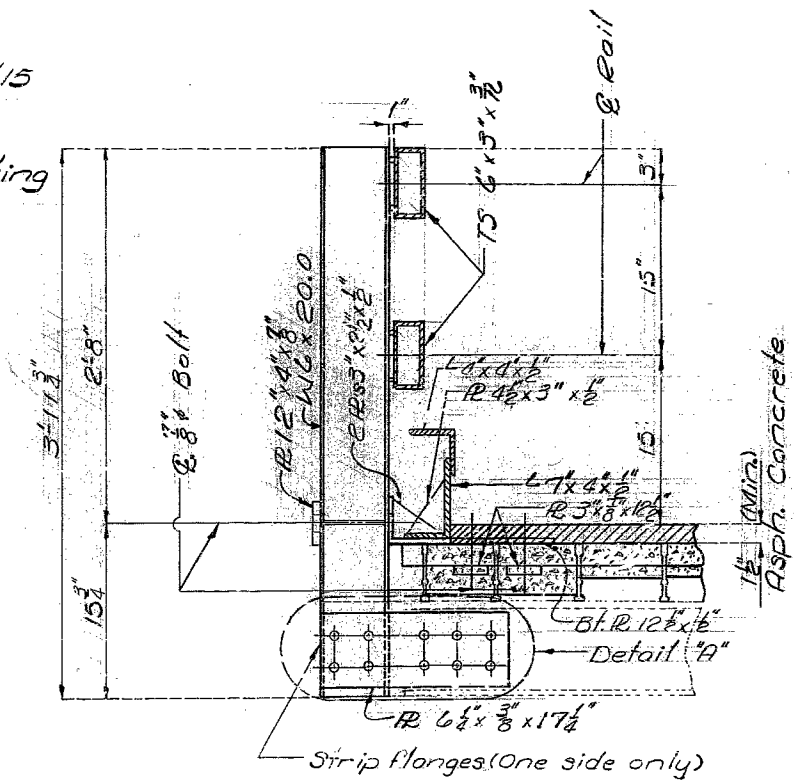


TYPICAL SECTION SHOWING RAIL POST CONNECTION IN TRUSS SPANS

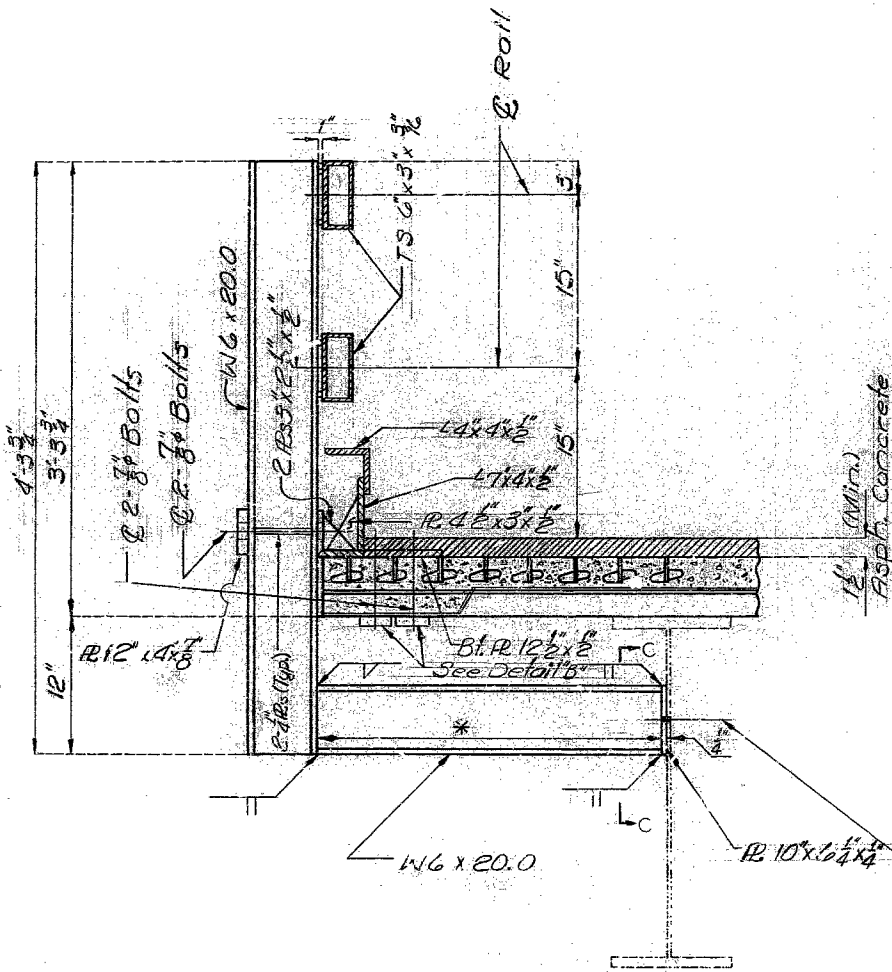

SECTION B-B

* 2-7" For Span 1-2, 2'-6 7/8" For Span (2-3)
 2-1/2" Horiz. slots in 10x6 1/2 x 1/2
 2-1/2" Holes in existing beams (Field drill)
 2-7/8" H.S. Bolts in end of W6 x 20.0

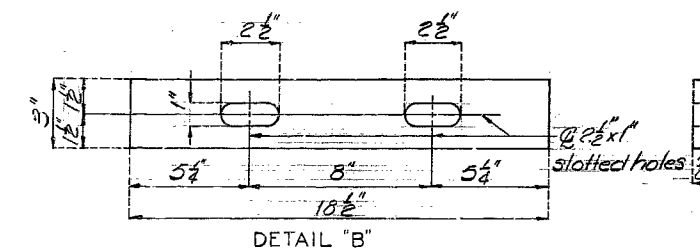

DETAIL "B"

Note: For location of Section B-B see sheet No. 5.
 Note: For Details of connections not shown see sheet No. 20 & 23.

Note: This drawing is not to scale. Follow dimensions.

DETAILED Mar 19 79
 CHECKED Mar 19 79

Sheet No. 21 of 30. Revised 9/26/79

PLATTE COUNTY




K-456R

456

MISSOURI STATE HIGHWAY DEPARTMENT

FED. ROAD DIST. NO.	STATE	FED. AID PROJ. NO.	FISCAL YEAR	SHEET NO.	TOTAL SHEETS
5	MO.		19	27	

457

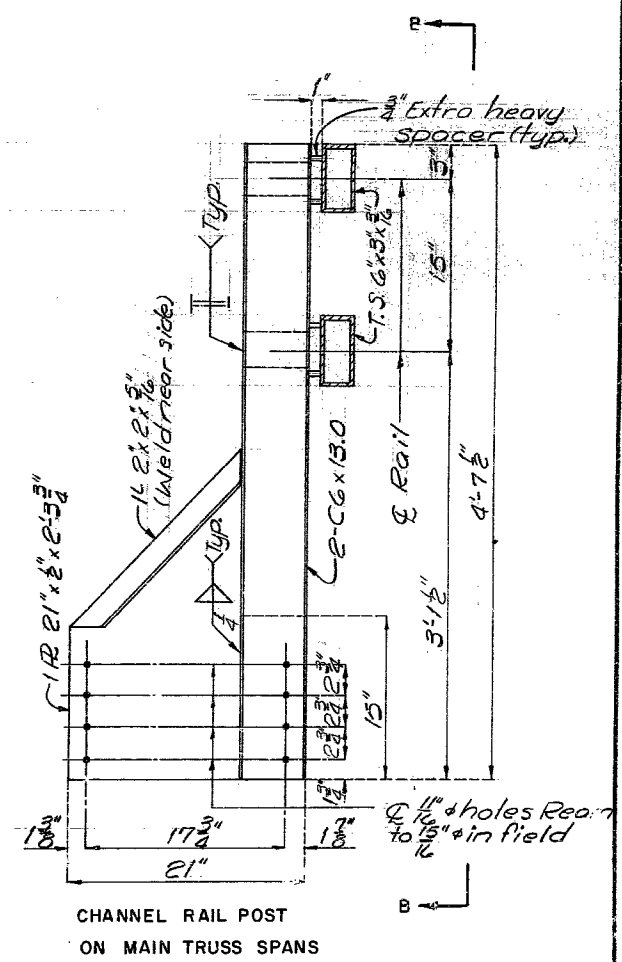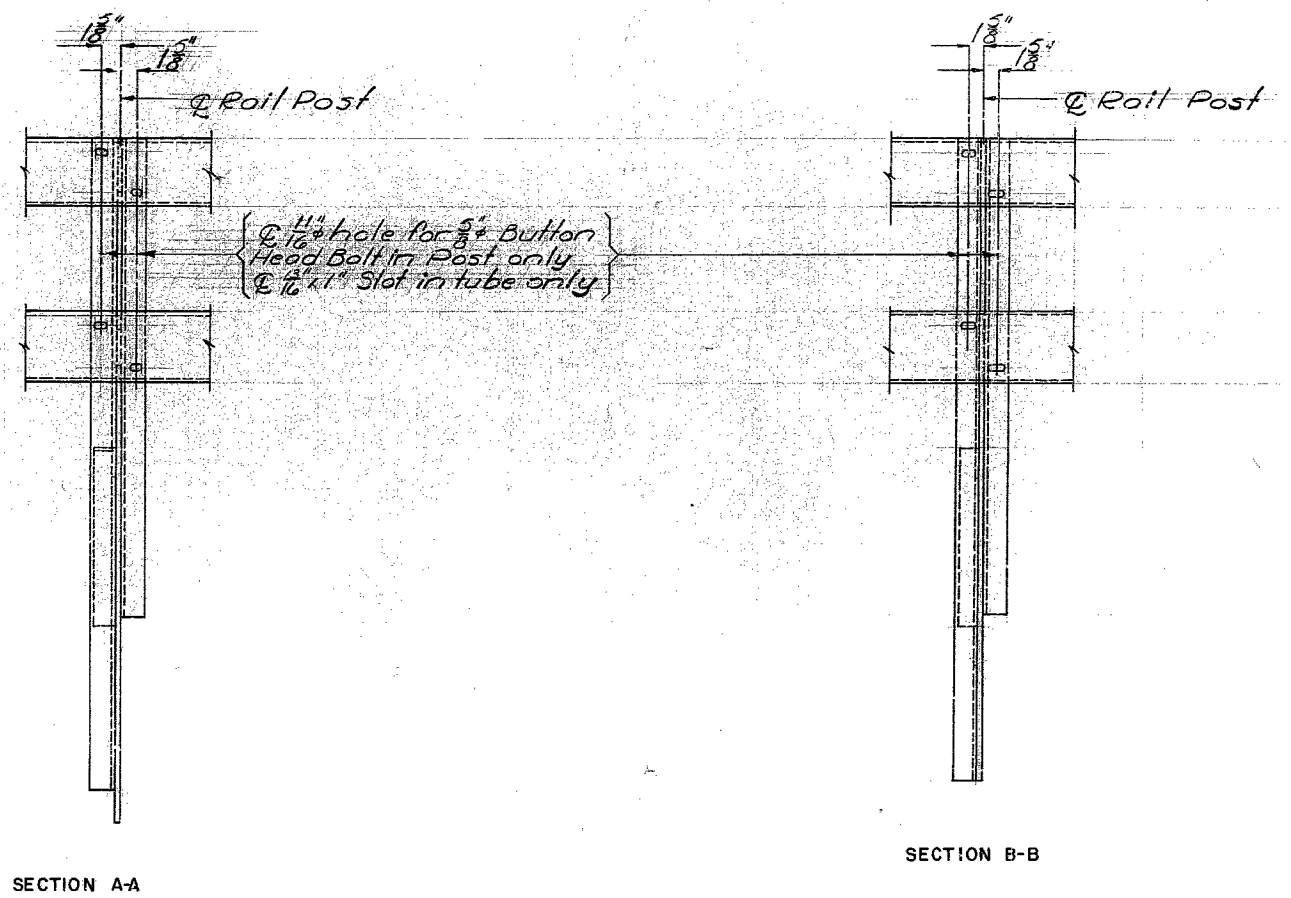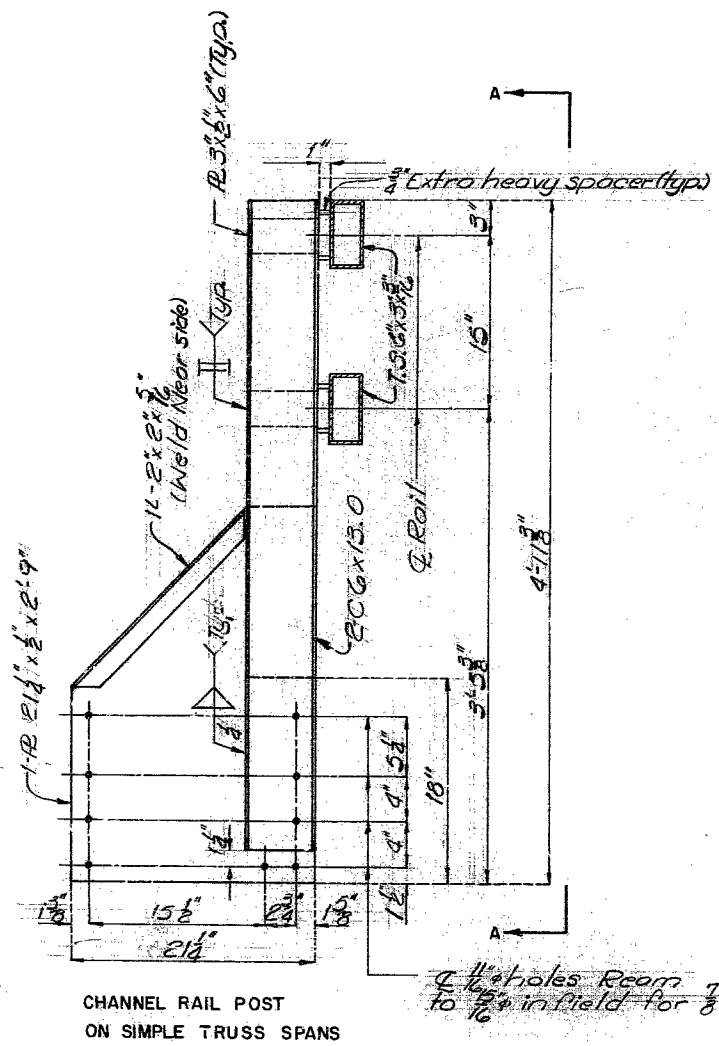

DETAILED MAR 19 79
CHECKED Mar 19 79

Note: This drawing is not to scale. Follow dimensions.

Sheet No. 22 of 30.


PLATTE COUNTY

K-456R


MISSOURI STATE HIGHWAY DEPARTMENT

FED. ROAD DIST. NO.	STATE	FED. AID PROJ. NO.	FISCAL YEAR	SHEET NO.	TOTAL SHEETS
5	MO.		19	28	

$\text{@ } \frac{1}{2} \times \frac{1}{2}$ vertical slots in flange
 (May be provided on both sides of flange at contractor's option).
 Button Head (oval shoulder)
 3/4" galvanized Bolt with one galvanized flat washer (Typ. for all posts)

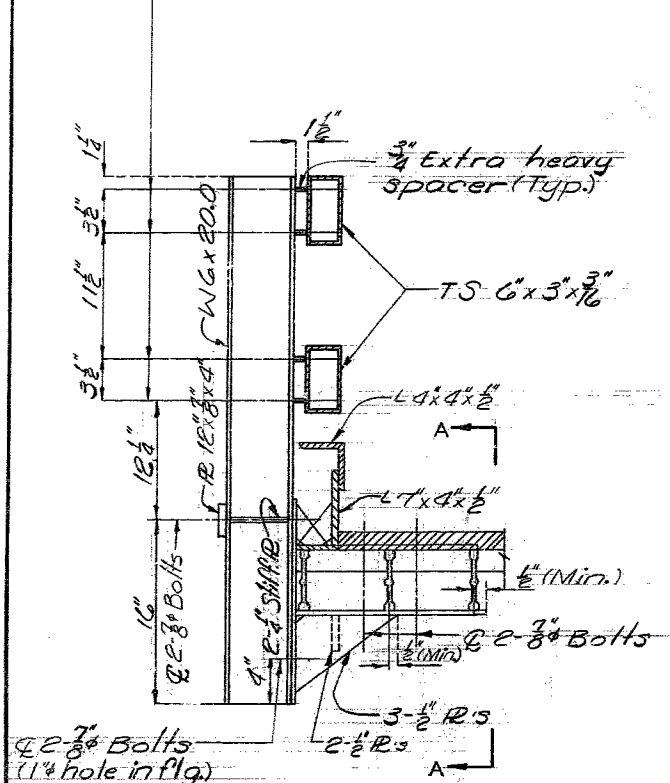

RAIL POST CONNECTION AT RELOCATED POST NEAR EXP. GAP

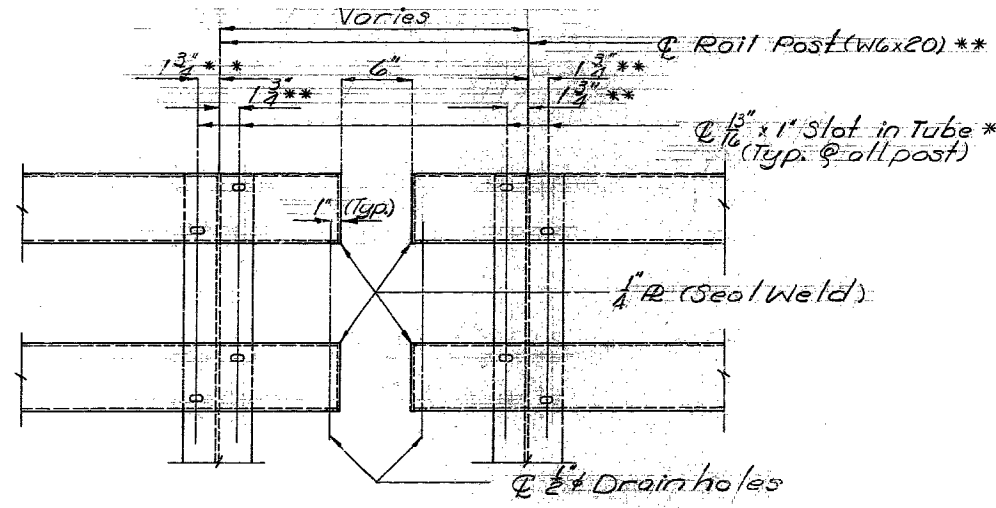


RAIL DETAILS AT EXP. JOINTS AND AT RAIL ENDS AT END RENTS


Note: Rail ends 2" from End Post at End Bt. *16 and rail ends 12" past first post at End Bt. *1.
 Railing shall be fabricated in two or three panel lengths unless otherwise approved.
 Rail post, all steel connecting bolts, washers, & connection plates shall be galvanized after fabrication. For protective coating and material requirement see section 1040 of standard specifications.
 Structural steel tube railing shall be galvanized same as steel rail post and conform to the requirement of ASTM designation A 500 or A 501.
 Splice in rails shall be provided at about 1' head point between post. Rail expansion splice should be provided at Transverse Seal Joints.
 Fabrication of structural steel shall be in accordance with section 712 of standard specifications.
 Note: For rail post details not shown see sheet No. 20 & 21.

*Note: Optional use of 5/8 inch studs to be fastened to T.S. 6x3x3/16 in place of 3/4 inch Button Head Bolts (Shop or field applied) 1 inch Extra heavy spacer to be used in place of 3/4 inch Extra heavy spacer.

** See sheet No. 22 for rail connection details of channel rail post.
 For attachment of rail to vertical truss members see Special Provisions.

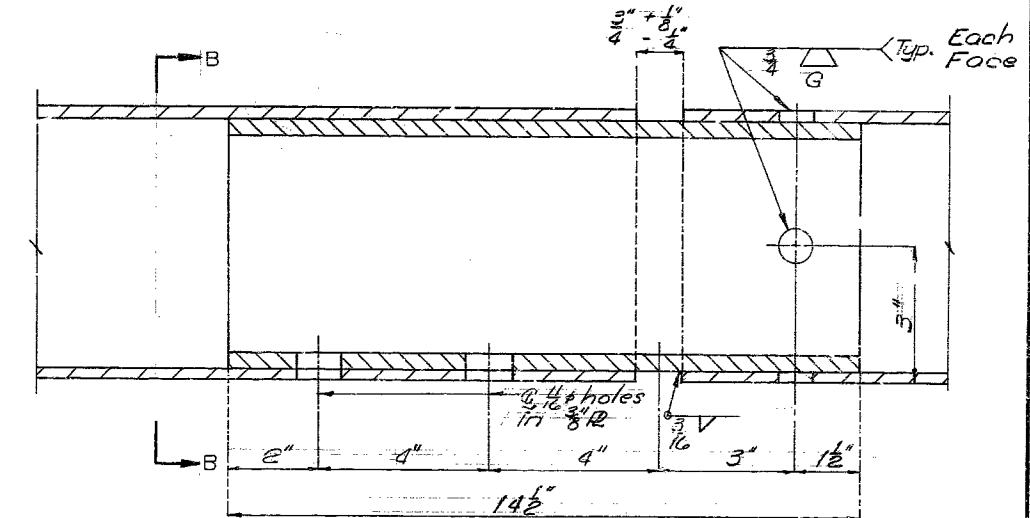


DETAIL OF RAIL EXPANSION OR SPLICE JOINT

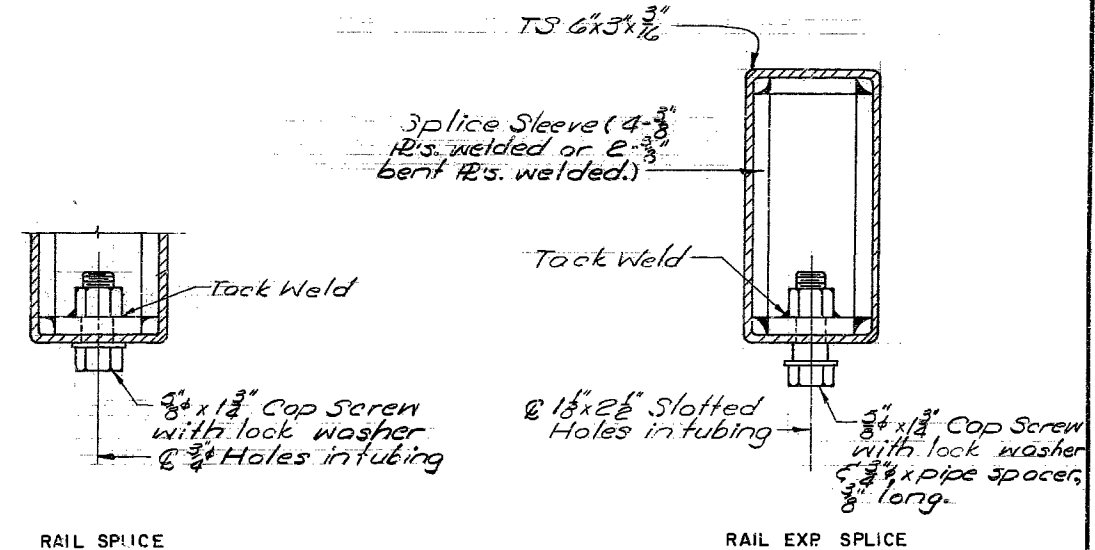

RAIL SPLICE

RAIL EXP SPLICE

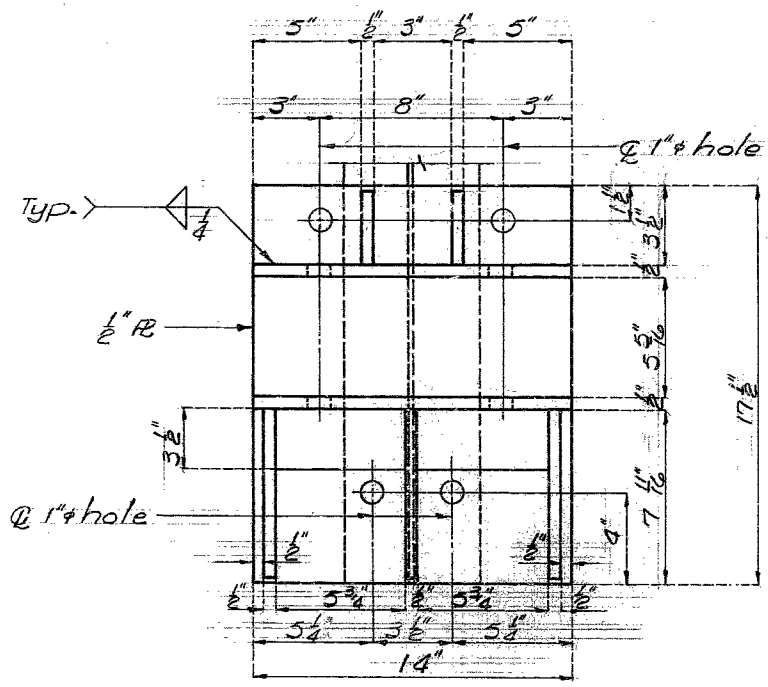

SECTION A-A

SECTION B-B

458

DETAILED MAR 19 79
 CHECKED MAR 19 79

Note: This drawing is not to scale. Follow dimensions.

Sheet No. 23 of 30.


PLATTE

COUNTY







K-456R

MISSOURI STATE HIGHWAY DEPARTMENT

FED. ROAD DIST. NO.	STATE	FED. AID PROJ. NO.	FISCAL YEAR	SHEET NO.	TOTAL SHEETS
5	MO.		19	29	

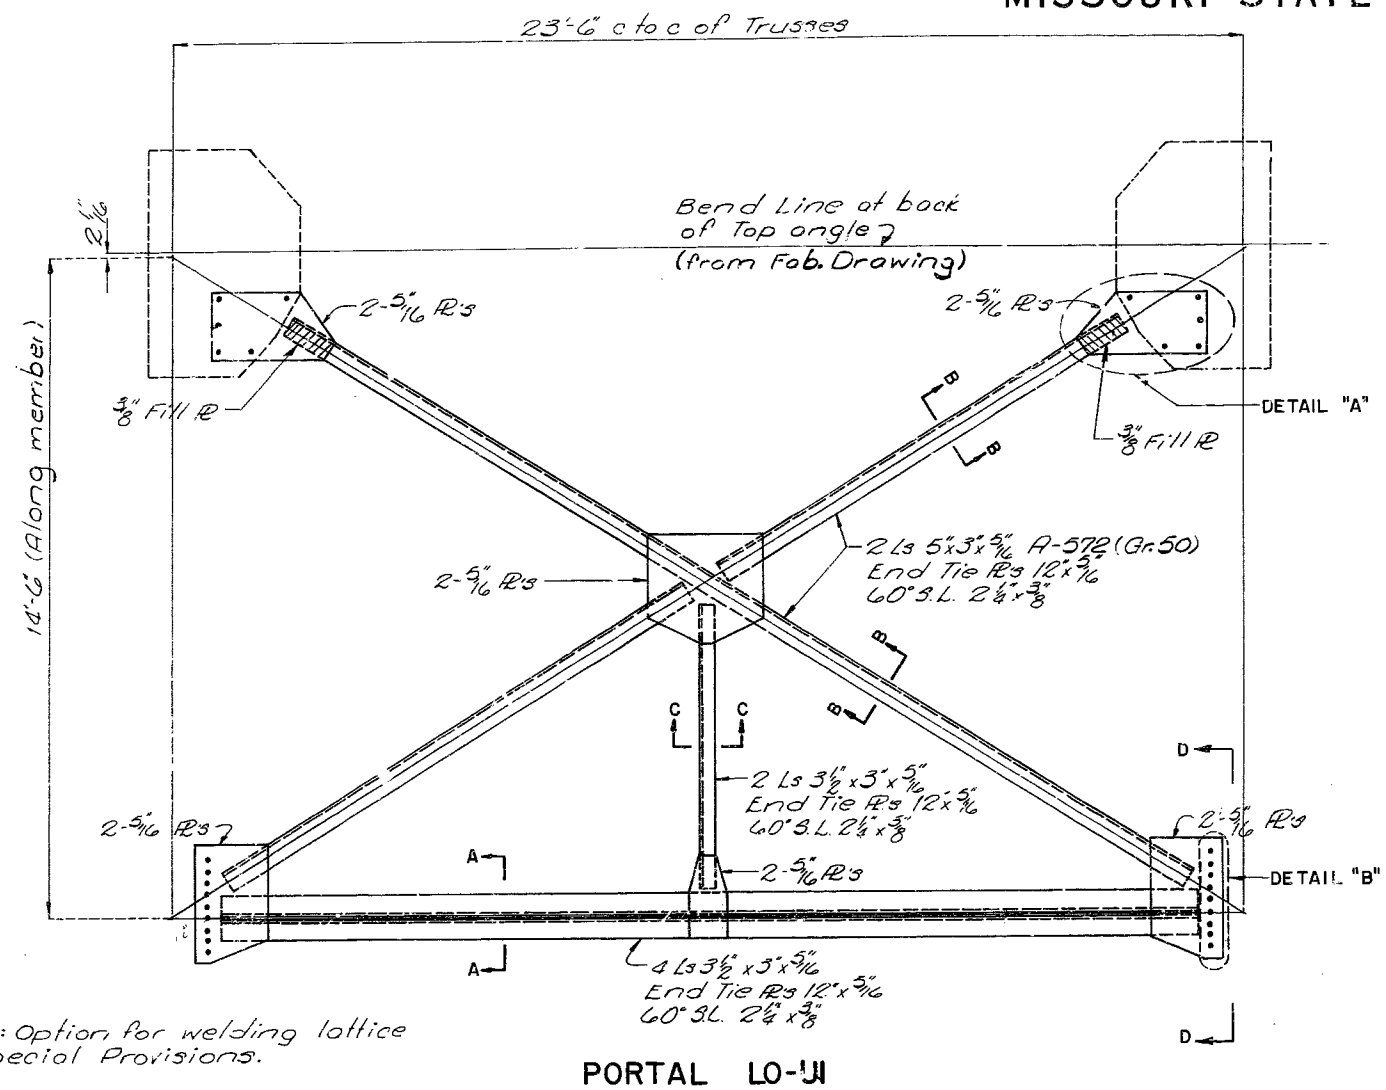

Note: Option for welding lattice in Special Provisions.

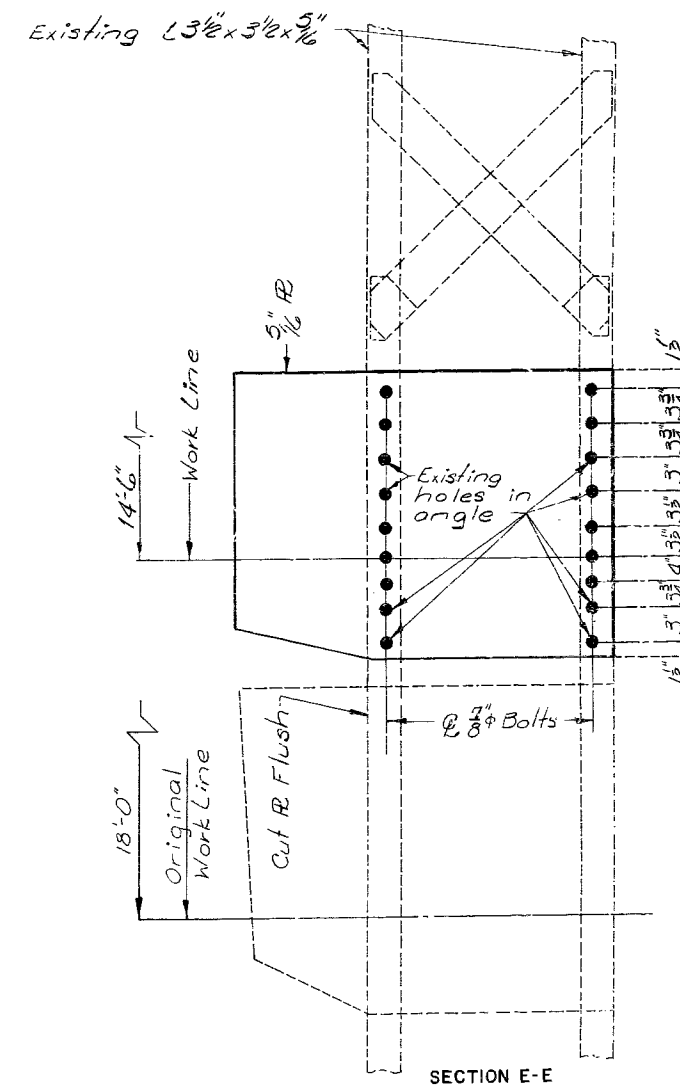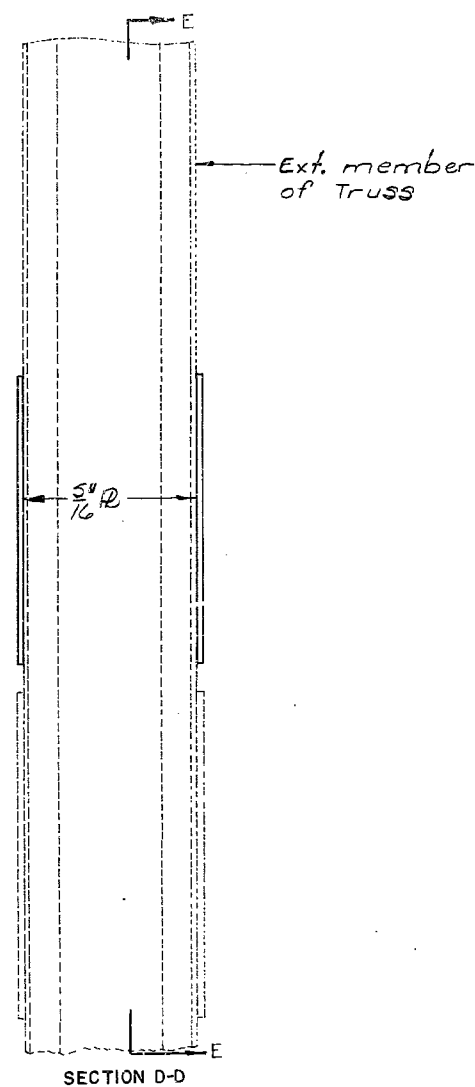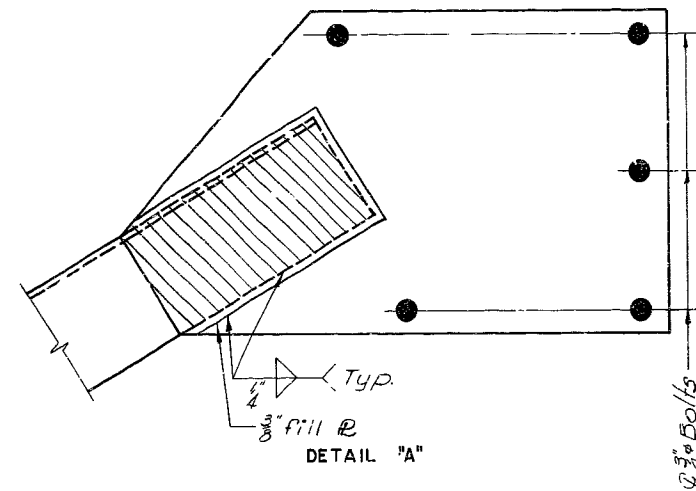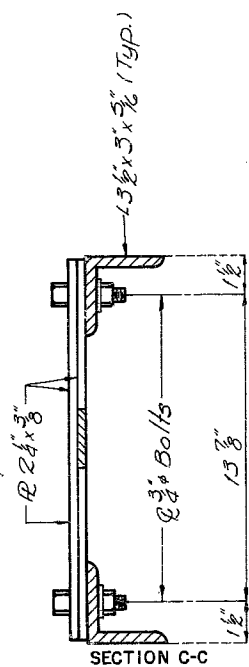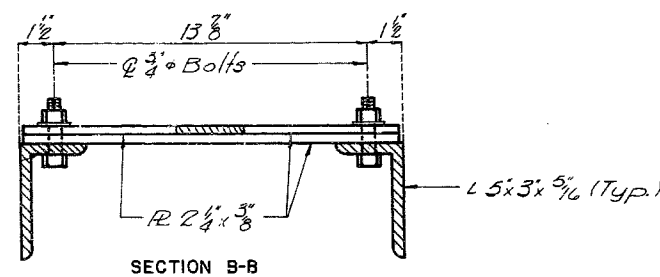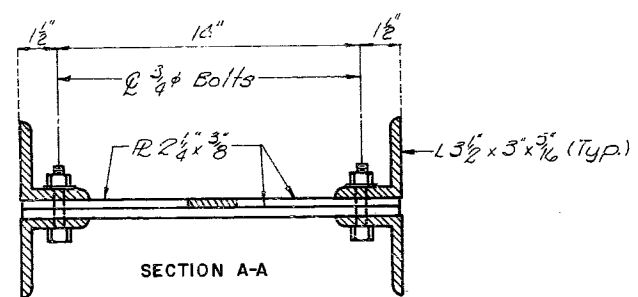

DETAILS OF PORTAL AT LO-UI SIMPLE SPAN

459
 DETAILED June 10 78
 CHECKED Sept. 19 78

Note: This drawing is not to scale. Follow dimensions.




Sheet No. 24 of 30.

PLATTE COUNTY

K-456R

MISSOURI STATE HIGHWAY DEPARTMENT






FED. ROAD DIST. NO.	STATE	FED. AID PROJ. NO.	FISCAL YEAR	SHEET NO.	TOTAL SHEETS
5	MO.		19	30	

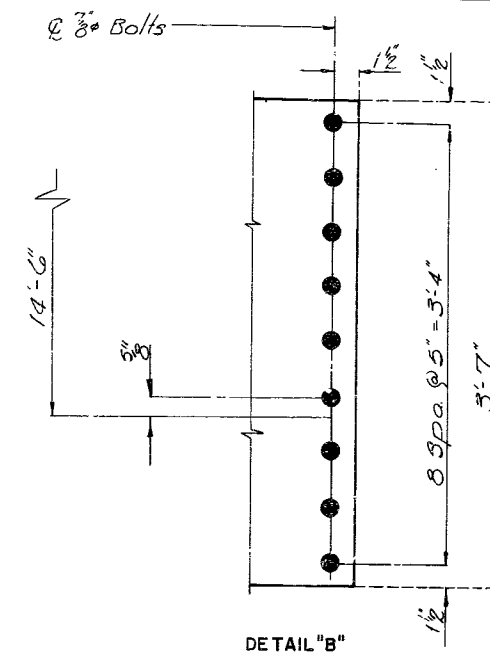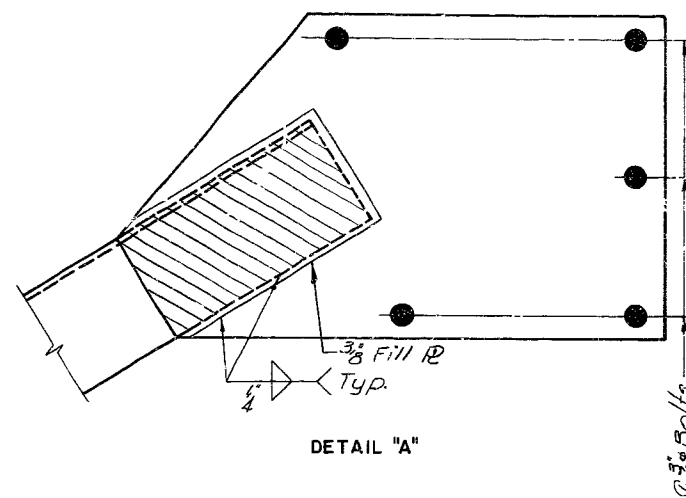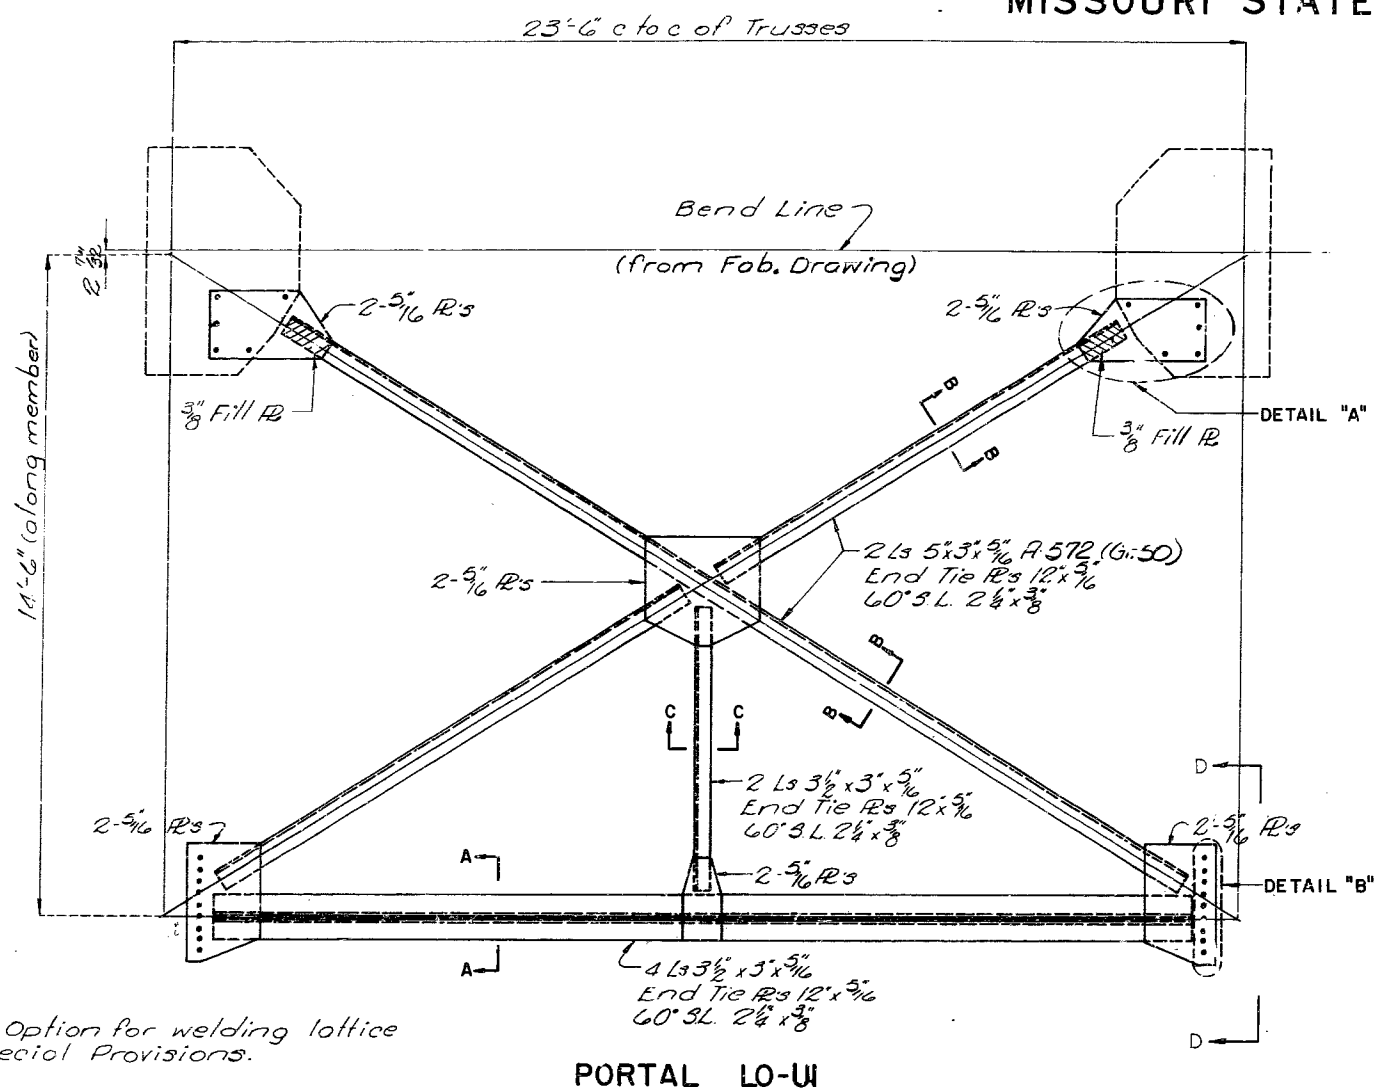

460

Note: Option for welding lattice in Special Provisions.

PORTAL LO-UI

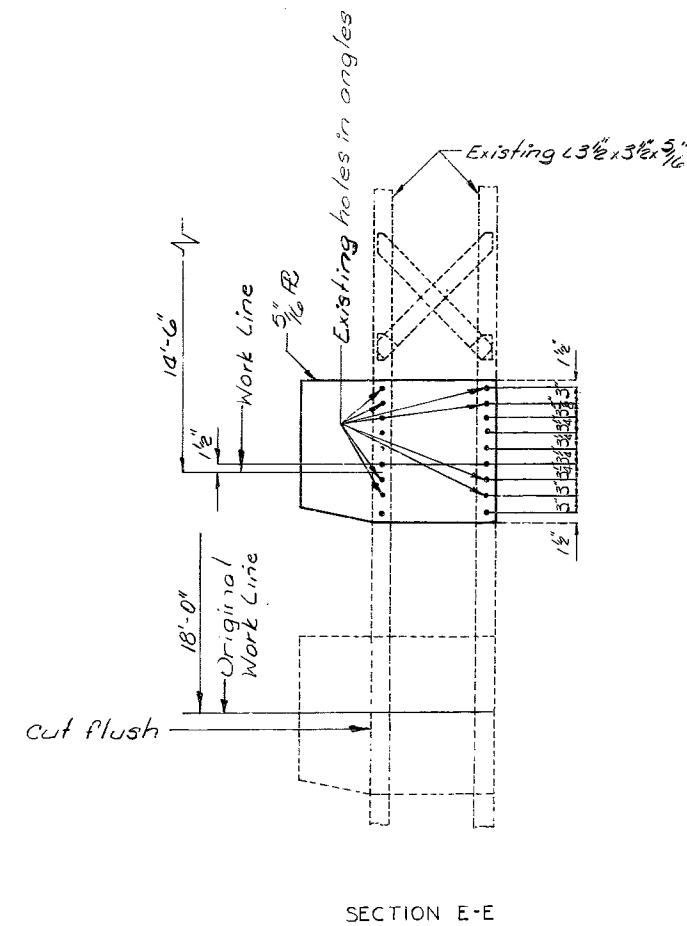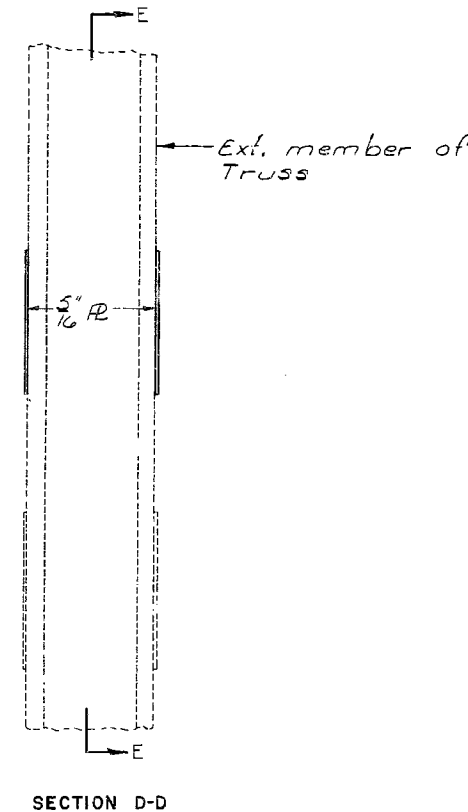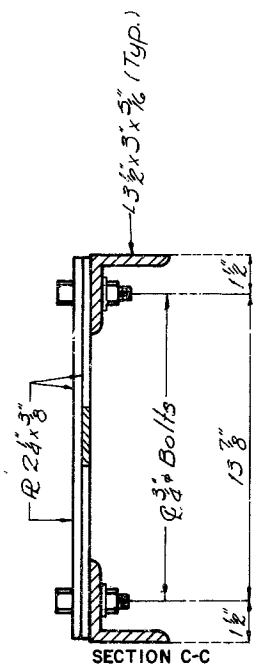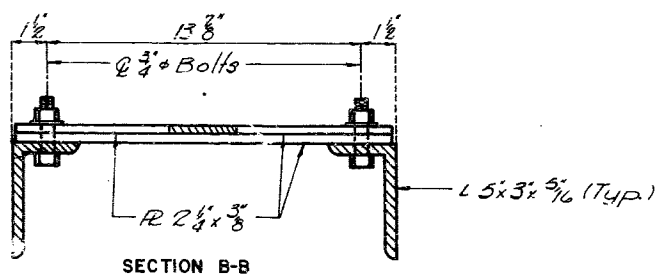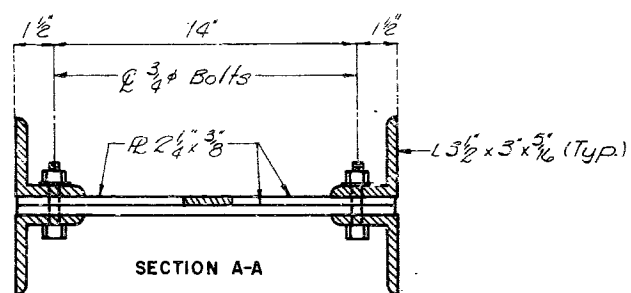

DETAILS OF PORTAL AT LO-UI MAIN SPAN

DETAILED June 19 78
CHECKED Oct. 19 78

Note: This drawing is not to scale. Follow dimensions.


Sheet No. 25 of 30.

PLATTE COUNTY

K-456R

MISSOURI STATE HIGHWAY DEPARTMENT

FED. ROAD DIST. NO.	STATE	FED. AID PROJ. NO.	FISCAL YEAR	SHEET NO.	TOTAL SHEETS
5	MO.		19	31	

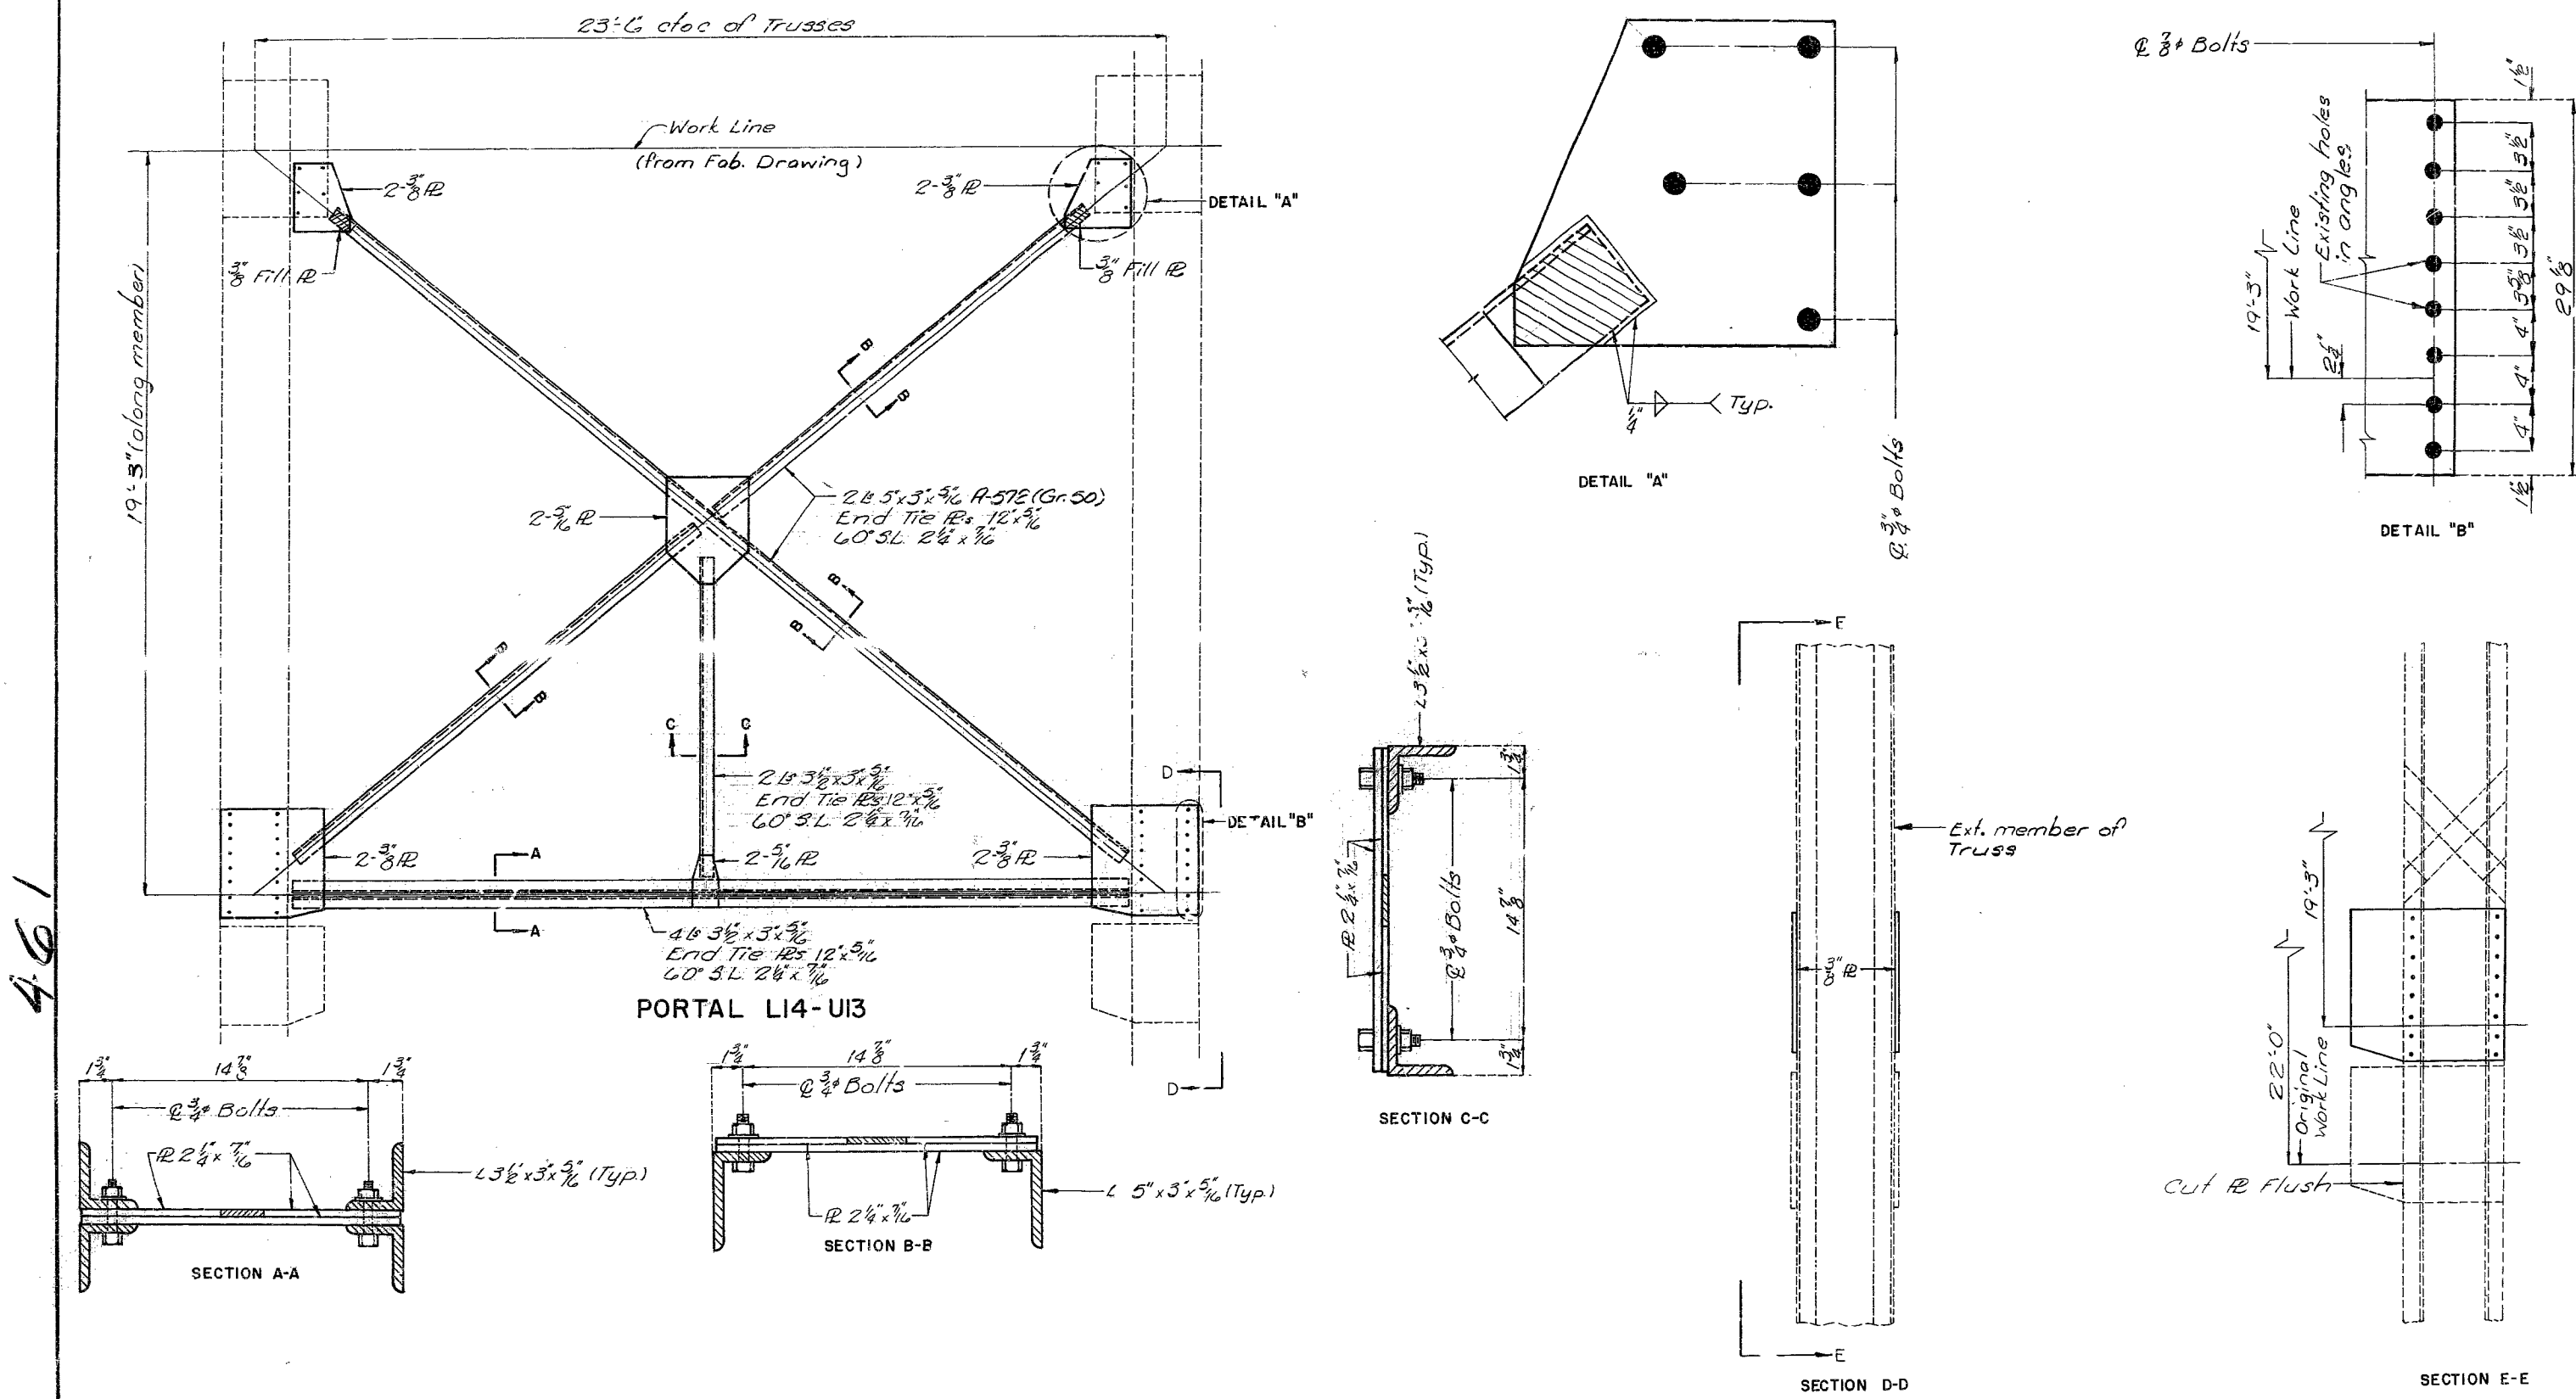

461

DETAILS OF PORTAL AT LI4-UI3 MAIN SPAN

DETAILED July 19 78
 CHECKED Sept. 19 78


Note: This drawing is not to scale. Follow dimensions.

Sheet No. 26 of 30.


PLATTE COUNTY K-456R

MISSOURI STATE HIGHWAY DEPARTMENT


FED. RD. NO.	STATE	FED. AID	FISCAL	SHEET	TOTAL
DIST. NO.	NO.	PROJ. NO.	YEAR	NO.	SHEETS
5	MO.		52	32	

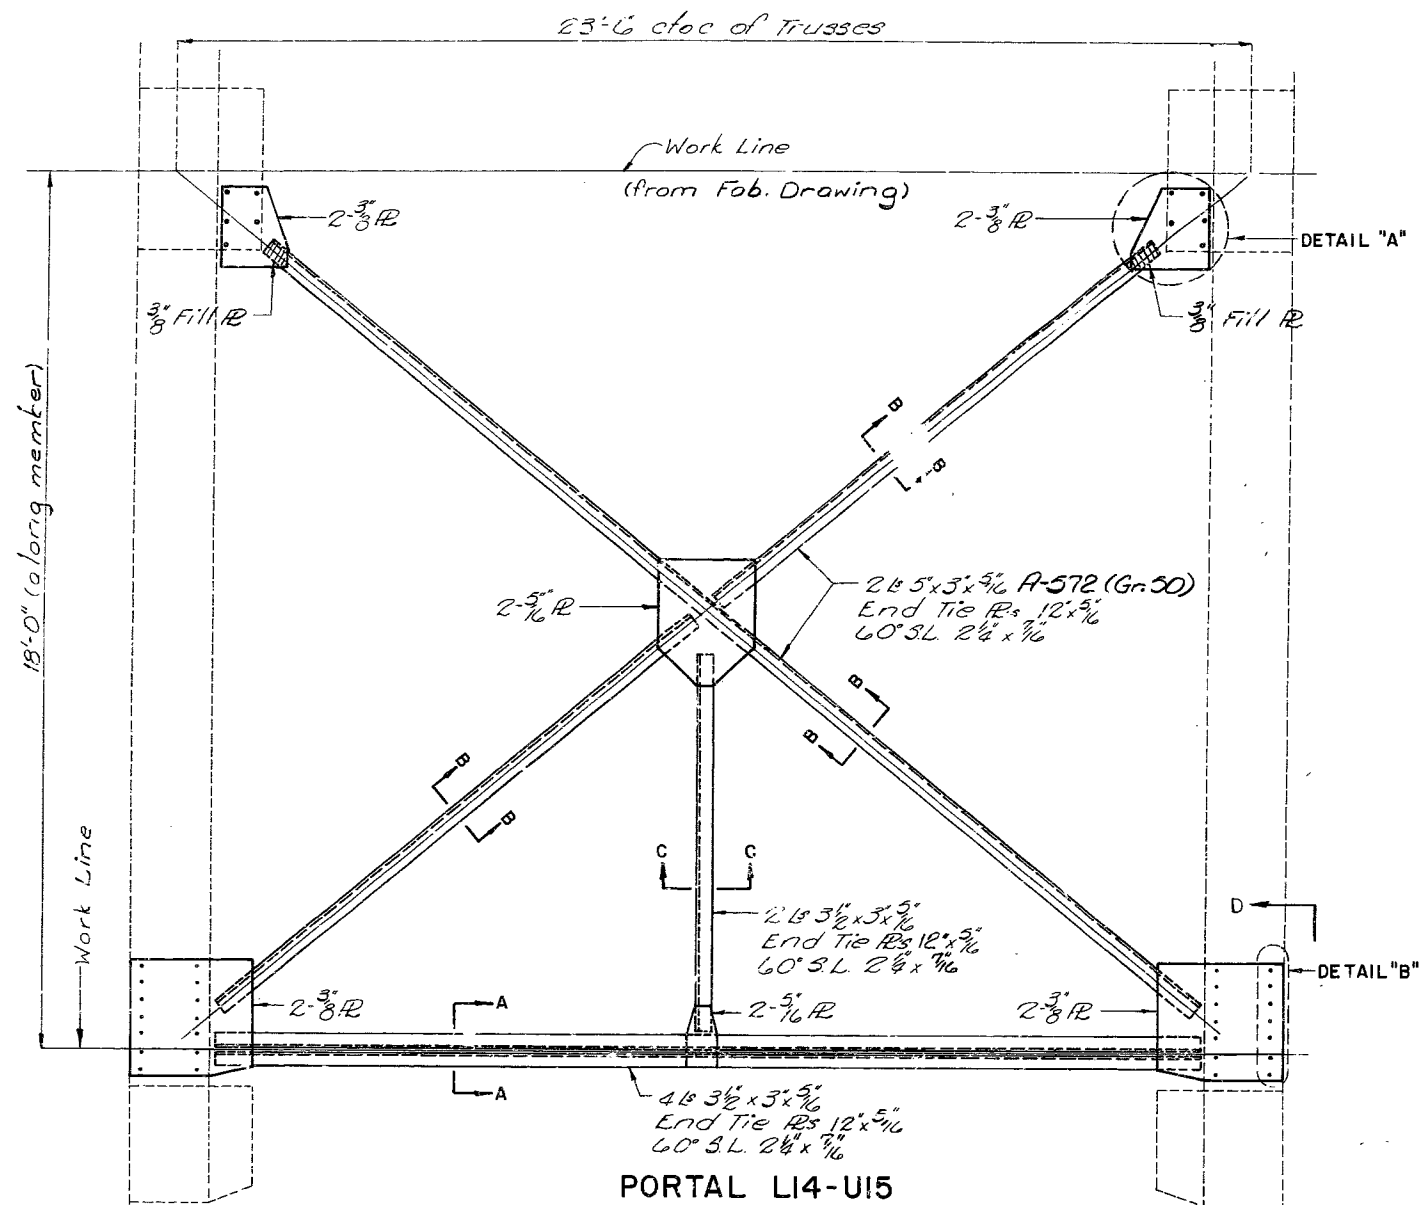


PORTAL LI4-UI5

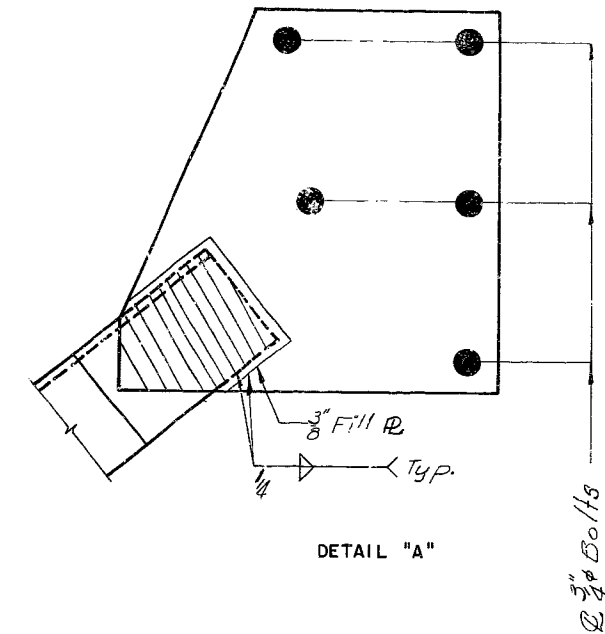


DETAIL "A"

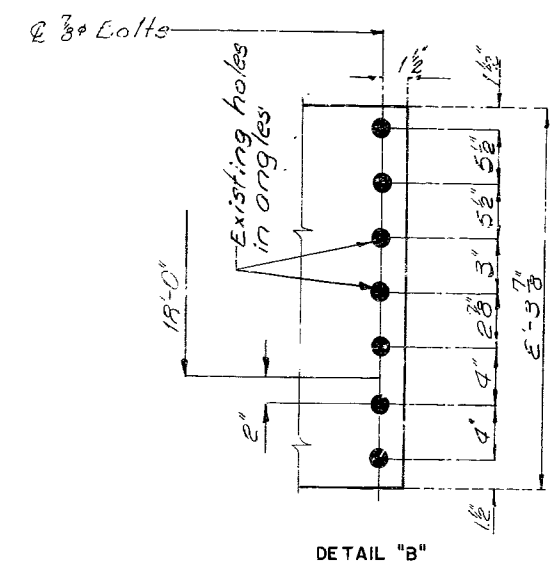


DETAIL "B"

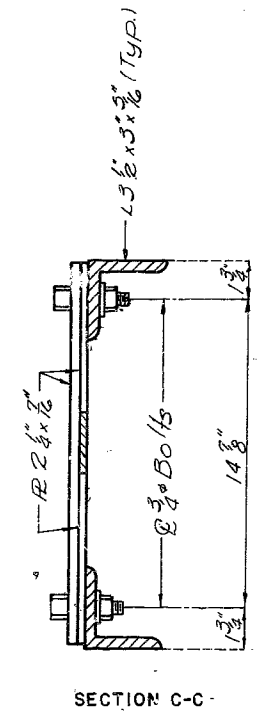


SECTION C-C

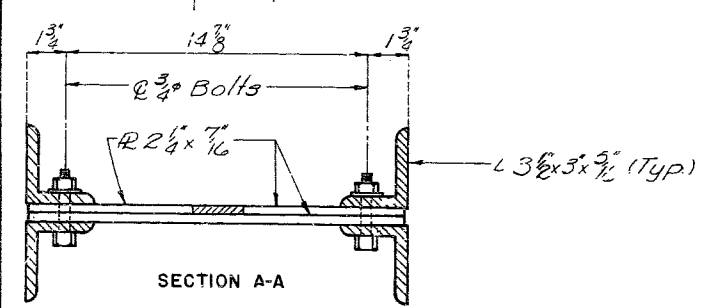


SECTION A-A

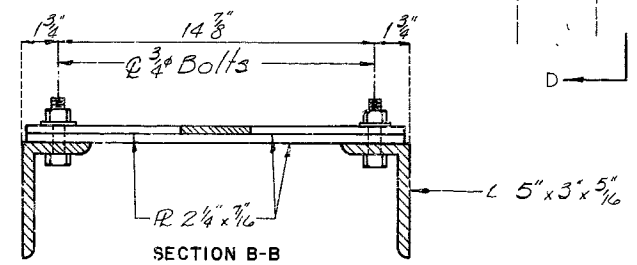

SECTION B-B

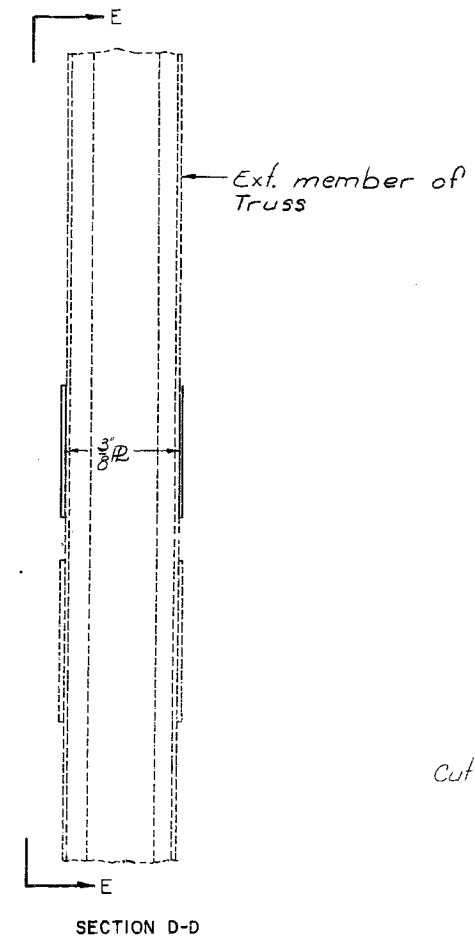

SECTION D-D

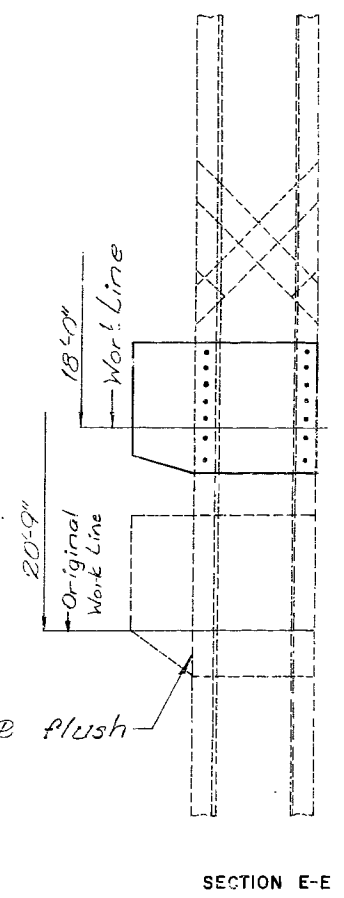

SECTION E-E

DETAILS OF PORTAL AT LI4-UI5 MAIN SPAN

A62

DETAILED June 19 78
CHECKED Sept 19 78

Note: This drawing is not to scale. Follow dimensions.

Sheet No. 27 of 30.






PLATTE

COUNTY




K-456R

MISSOURI STATE HIGHWAY DEPARTMENT

FED. ROAD DIST. NO.	STATE	FED. AID PROJ. NO.	FISCAL YEAR	SHEET NO.	TOTAL SHEETS
1	MO.		19	33	

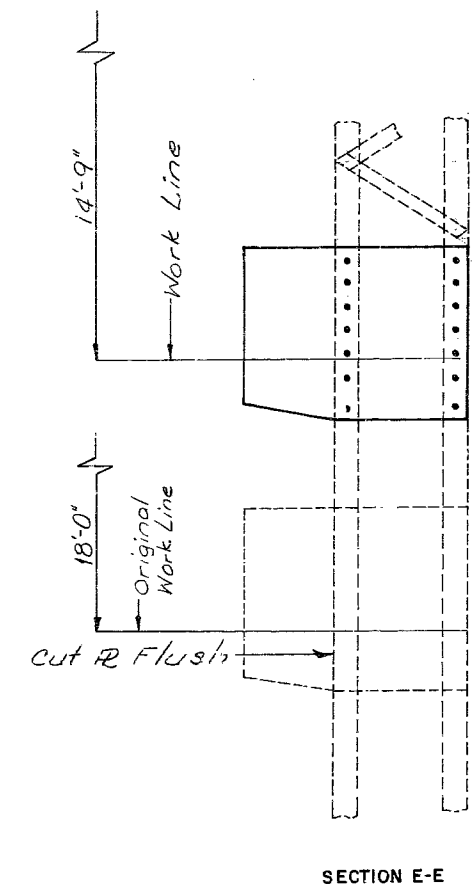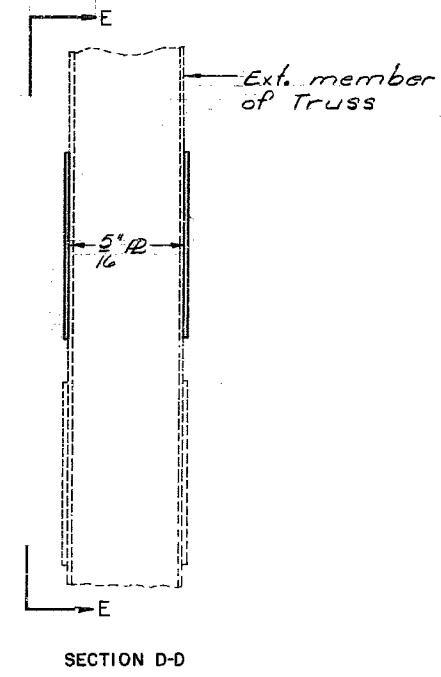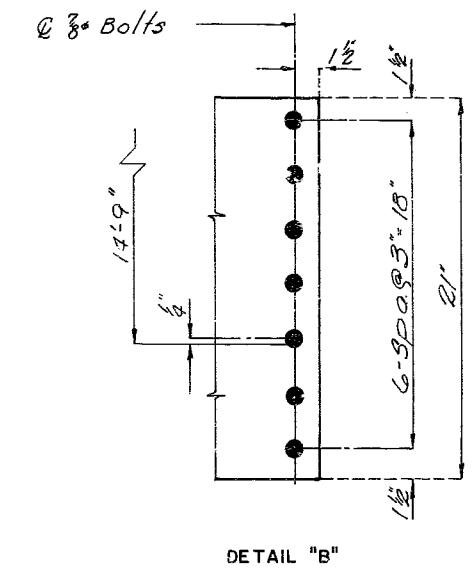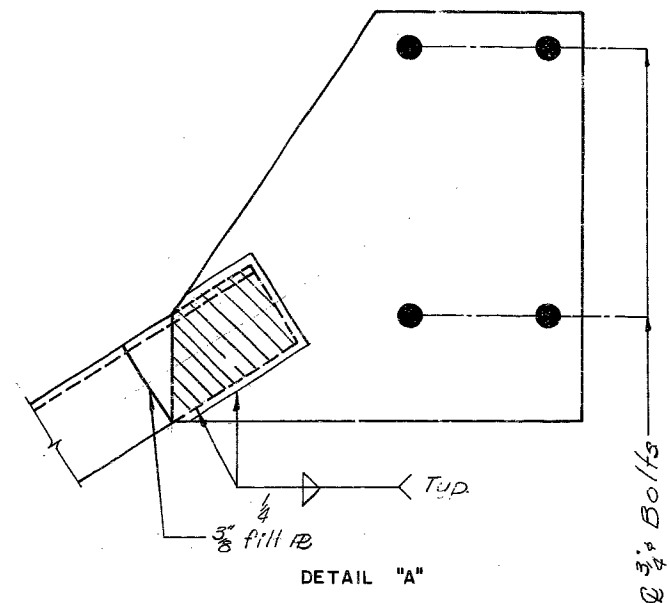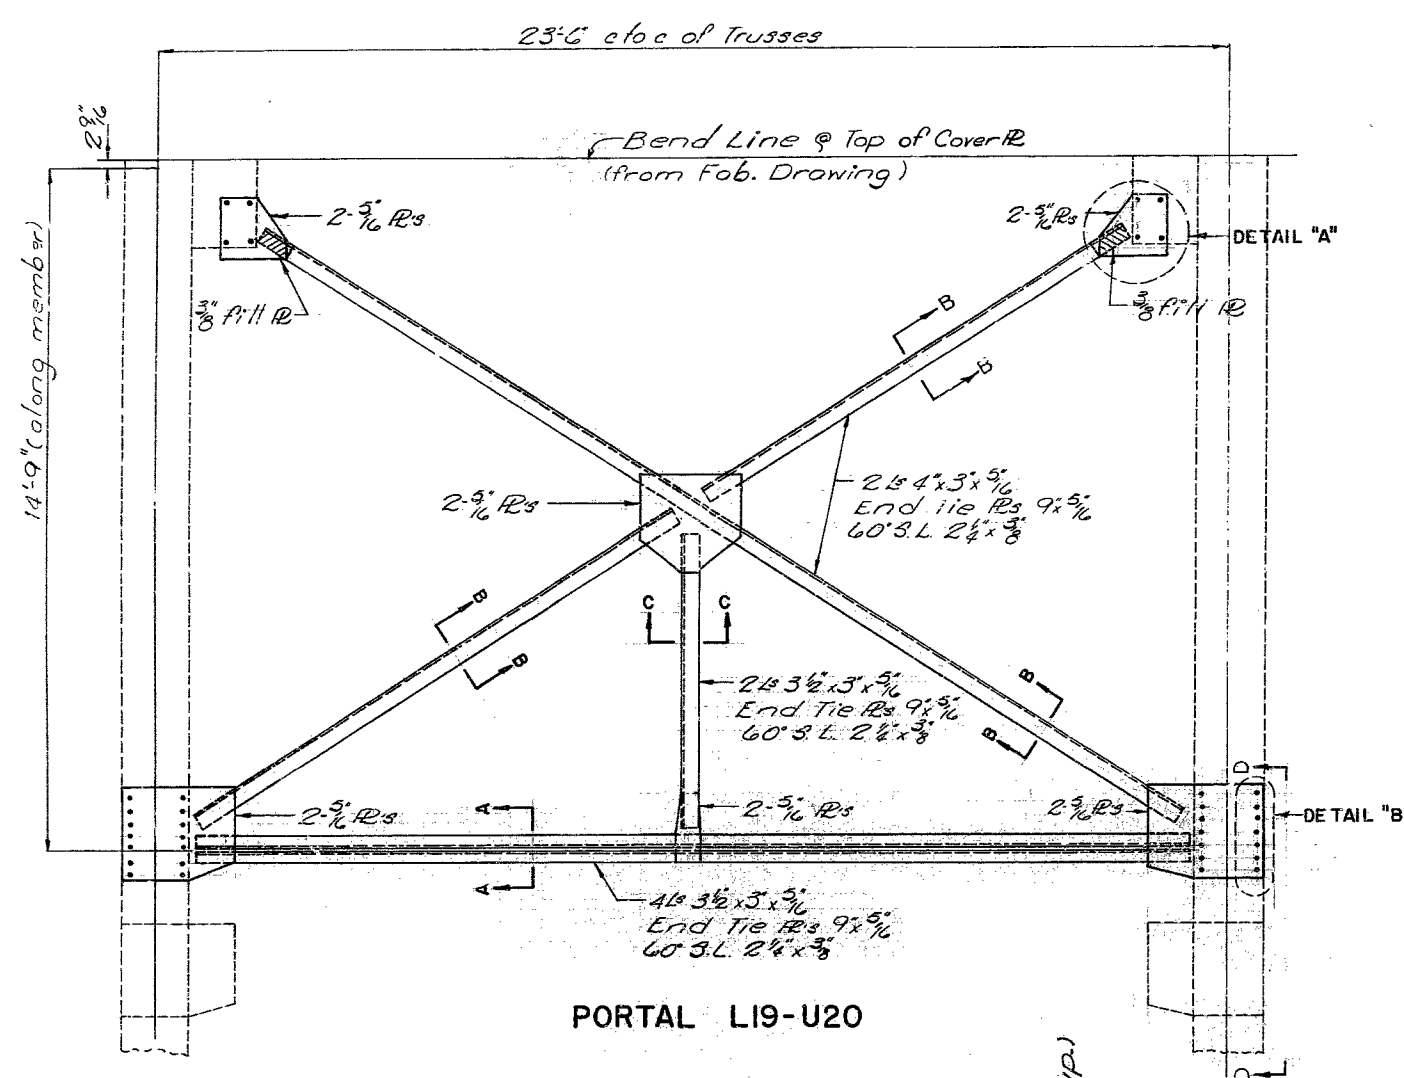

A63

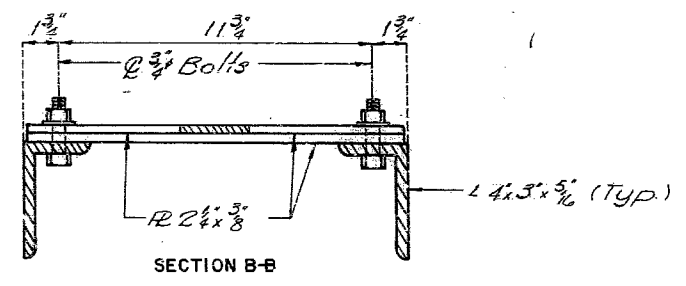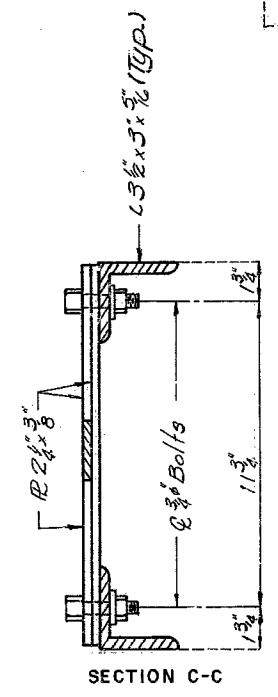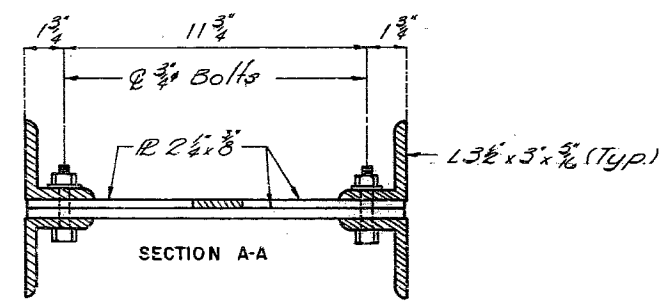

DETAILS OF PORTAL AT LI9-U20 MAIN SPAN

DETAILED May 19 78
 CHECKED Oct. 19 78

Note: This drawing is not to scale. Follow dimensions.





Sheet No. 28 of 30.

PLATTE COUNTY




K-456R

MISSOURI STATE HIGHWAY DEPARTMENT

FED. ROAD DIST. NO.	STATE	FED. AID PROJ. NO.	FISCAL YEAR	SHEET NO.	TOTAL SHEETS
5	MO.		78	30	

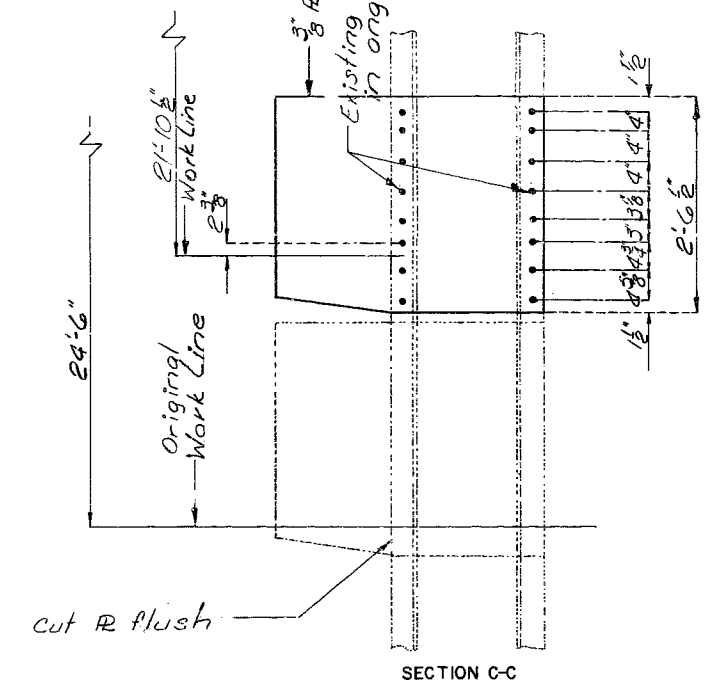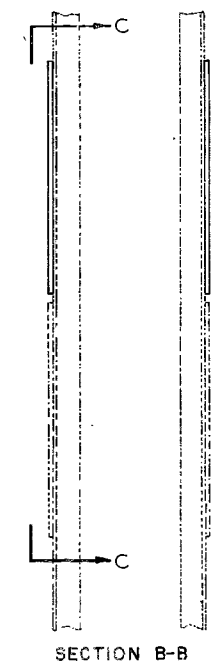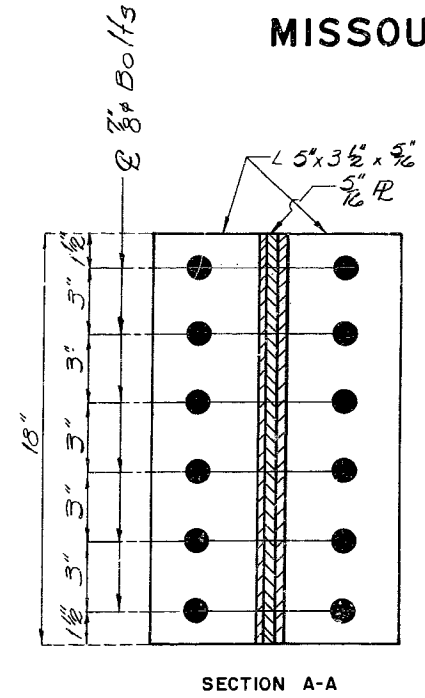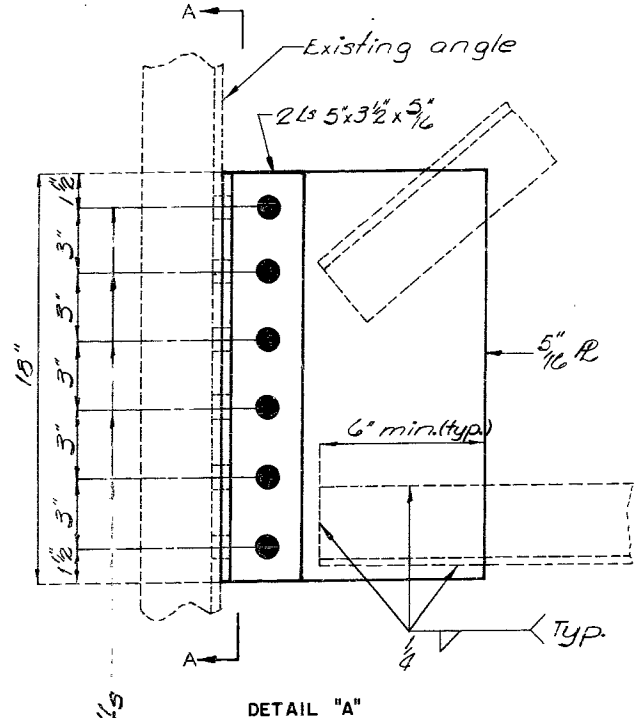

A 64

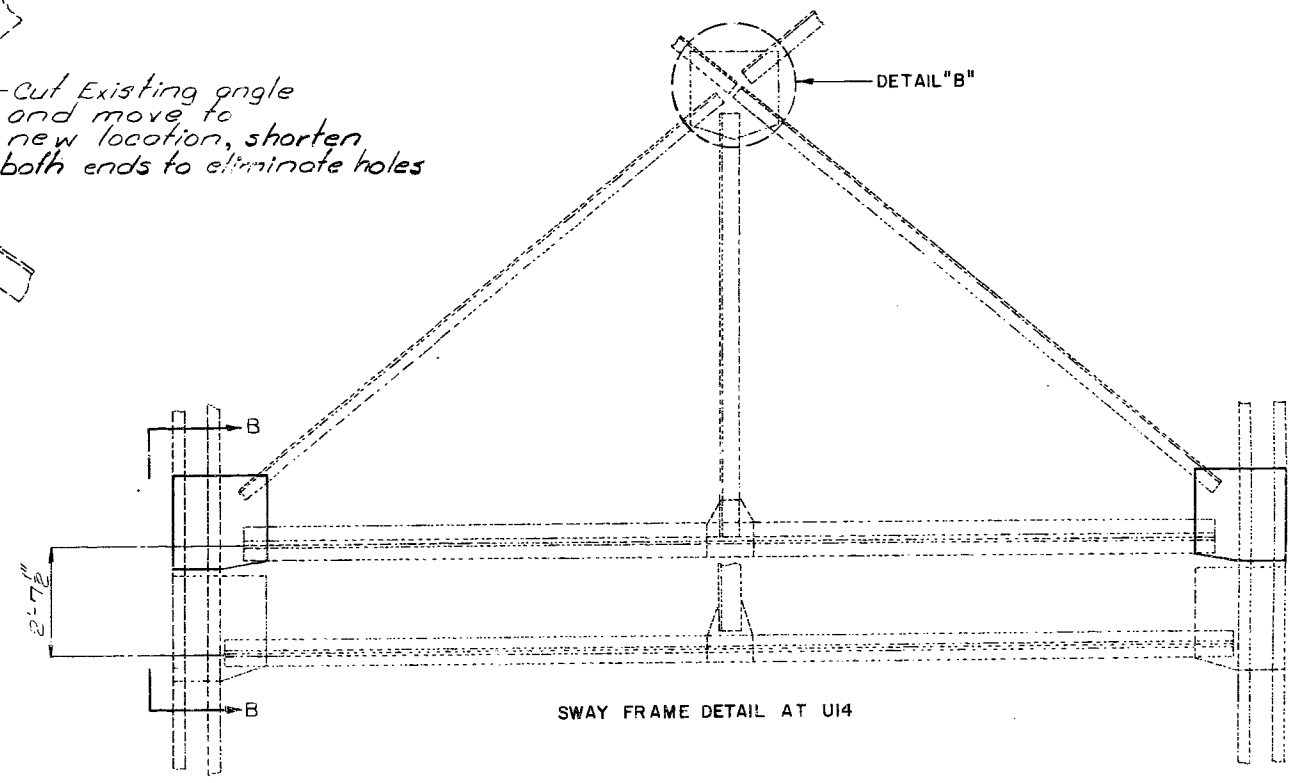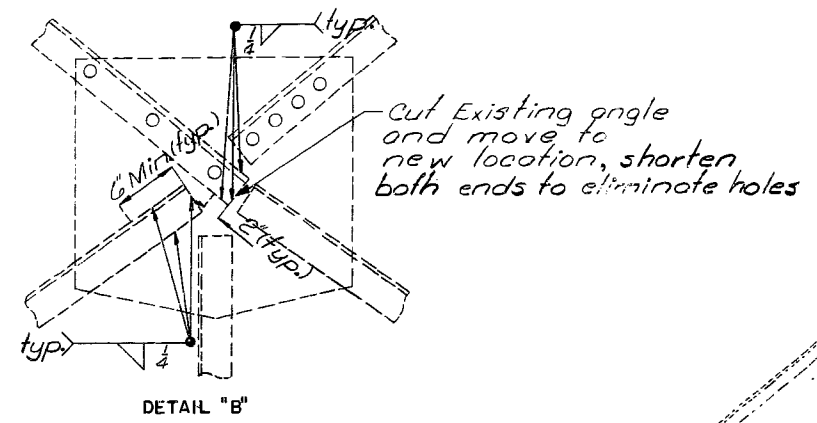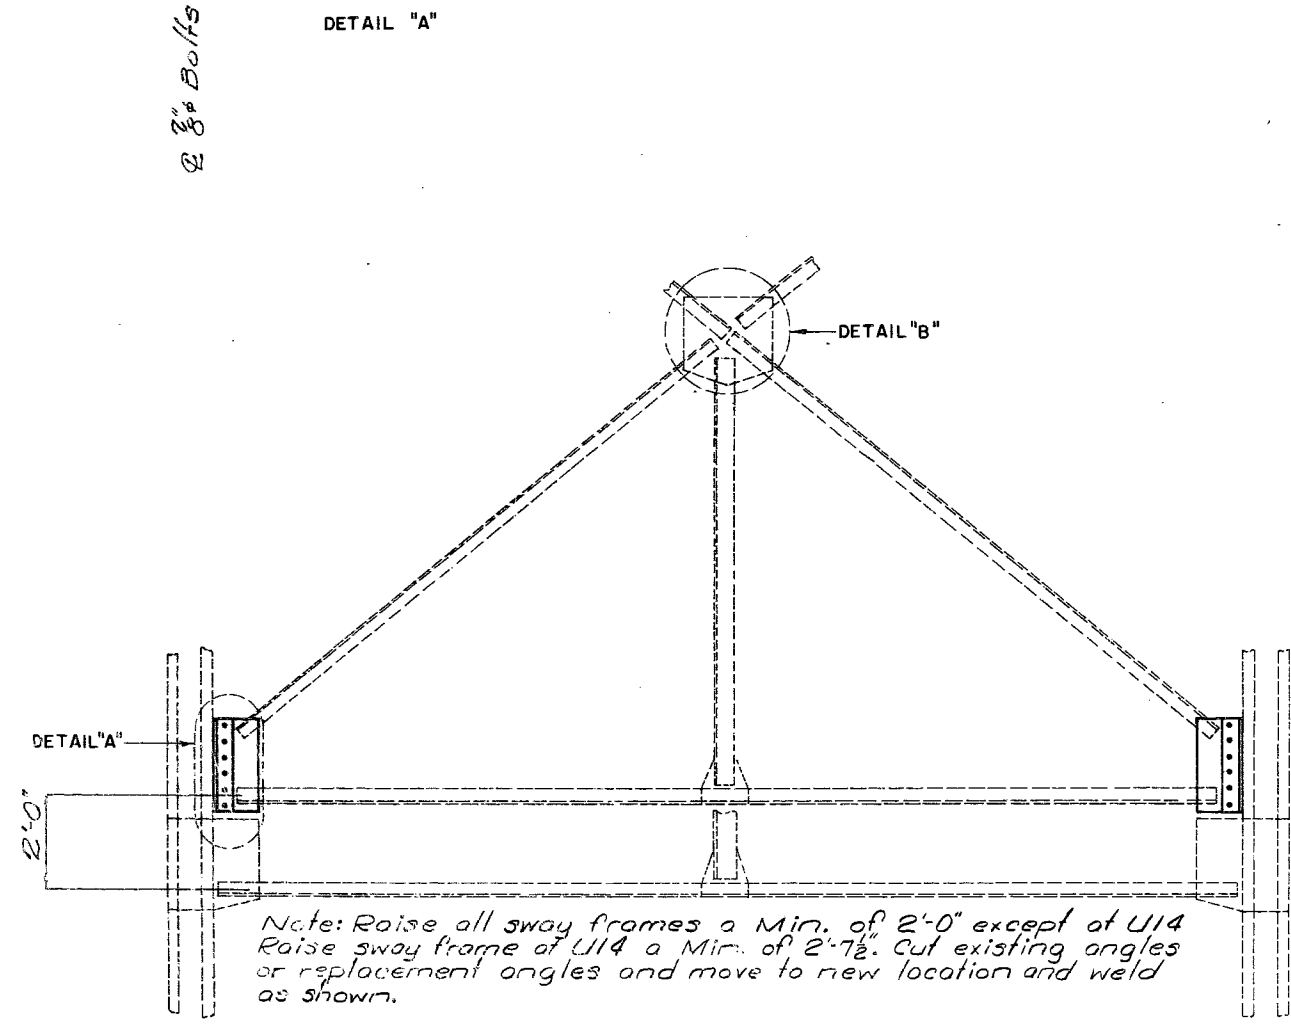

DETAILED Nov 1978
CHECKED Dec. 1978

TYPICAL SWAY FRAME DETAIL AT U3, U5, U7, U9, U11, U17, U21, U3, U5, U7, U9, U11, U17, & U21' of MAIN TRUSS AND U3, U5 & U3' of SIMPLE TRUSS

Note: This drawing is not to scale. Follow dimensions.

SWAY FRAME DETAIL

Sheet No. 29 of 30.

PLATTE COUNTY


K-456R

MISSOURI STATE HIGHWAY DEPARTMENT

COMPLETE BILL OF REINFORCING STEEL


FED. ROAD DIST. NO.	STATE	FED. AID PROJ. NO.	FISCAL YEAR	SHEET NO.	TOTAL SHEETS
5	MO.		19	35	

NO. REQD.	MARK NO.	LOCATION	EPOXY (E)	SHAPE NO.	STIRRUP (S)	SUBSTR. (X)	VARIES (V)	NO. EACH	DIMENSIONS								NOMINAL LENGTH	ACTUAL LENGTH	WEIGHT								
									B	C	D	E	F	H	K	FT.				IN.	FT.	IN.	FT.	IN.	FT.	IN.	FT.
END BFMT NO.16																											
14	6F1	BACKWALL		25	X				14.000	4	8.625	14.000			3	4.000	3	4.000	7	1	7	0	147				
4	4H1	BACKWALL		20	X				22	6.000									22	6	22	6	60				
32	6H2	WING		20	X	V	4		2	1.000									2	1	2	1					
									INCR = 11.625 IN																		
8	6H3	WING		20	X				8	10.000									8	10	8	10	262				
8	6H5	BKWL. & BEAM		20	X				22	6.000									22	6	22	6	270				
4	6H6	BEAM		18	X				22	6.000									23	10	23	10	143				
56	5R1	END POST		19	S	X			2	7.000	6.000								3	1	3	0	180				
24	5R2	END POST		20	X				9	9.000									9	9	9	9	244				
4	6T1	WING		25	X				2	5.000	10	6.500	22.000						6	0.000	8	8.000	14	10	14	9	89
4	4T2	CURTAIN WALL		19	S	X			4	6.000	3	5.000							7	11	7	10	21				
23	4U1	BEAM		13	S	X			2	9.000	3	3.000	2	9.000	3	3.000			12	7	12	6	192				
6	4U2	CURTAIN WALL		10	S	X			2	11.000	6.000								6	4	6	2	25				
4	4U3	BEAM		10	S	X				6.000	2	9.000							3	9	3	7	10				
36	6V1	WING		20	X	V	4		2	11.000									2	11	2	11					
									INCR = 8.750 IN																		
4	4V3	WING		20	X				9	0.000									8	9	8	9	315				
42	5V5	BACKWALL		20	X				5	6.000									5	6	5	6	241				
4	4V6	CURTAIN WALL		20	X				4	0.000									4	0	4	0	11				
4	2W1	BEAM		22	X				12.000	9.125									19	9	19	9	13				
END OF BAR LIST																											

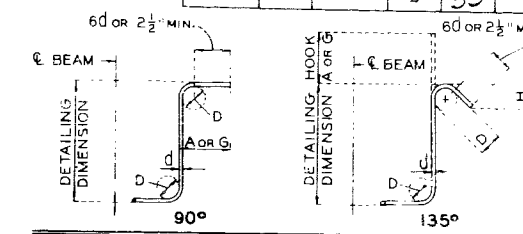

BAR SIZE	D (IN.)	90° HOOK		135° HOOK		APPROX. H
		HOOK A OR G	HOOK A OR G	HOOK A OR G	HOOK A OR G	
#3	1-1/2"	4"	4"	4"	4"	2-1/2"
#4	2"	4-1/2"	4-1/2"	4-1/2"	4-1/2"	3"
#5	2-1/2"	6"	6"	5-1/2"	5-1/2"	3-3/4"
#6	4-1/2"	8"	8"	7"	7"	4-1/2"

NOTE: UNLESS OTHERWISE NOTED DIAMETER "D" IS THE SAME FOR ALL BENDS AND HOOKS ON A BAR.

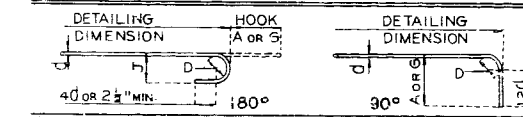

SIZE OF 180° HOOKS (GRADE 40 KSI) AND 180° HOOKS (GRADE 60 KSI)
 D = 3d FOR #3 THRU #11
 D = 10d FOR #14 AND #18

SIZE OF 90° HOOKS (ALL GRADES) AND 135° HOOKS (GRADE 60 KSI)
 D = 6d FOR #3 THRU #8
 D = 8d FOR #9, #10 AND #11
 D = 10d FOR #14 AND #18

BAR SIZE	180° HOOKS					
	GRADE 40		GRADE 60		ALL GRADES	
	A OR G	J	A OR G	J	A OR G	J
#3	5"	2-3/4"	5"	3"	6"	6"
#4	6"	3-1/2"	6"	4"	8"	8"
#5	7"	4-1/2"	7"	5"	10"	10"
#6	8"	5-1/4"	8"	6"	12"	12"
#7	9"	6-1/4"	10"	7"	14"	14"
#8	10"	7"	11"	8"	16"	16"
#9	12"	8"	15"	11-1/4"	19"	19"
#10	13"	9"	17"	12-3/4"	22"	22"
#11	14"	10"	19"	14-1/4"	21-0"	21-0"
#14	21-2"	20-1/2"	21-2"	20-1/2"	21-7"	21-7"
#18	21-11"	21-3"	21-11"	21-3"	31-5"	31-5"

NOTES: ALL STANDARD HOOKS AND BENDS OTHER THAN 180 DEG. TO BE BENT WITH SAME PROCEDURE AS FOR 90 DEG. STD. HOOKS. HOOKS AND BENDS SHALL BE IN ACCORDANCE WITH THE PROCEDURES AS SHOWN ON THIS SHEET.





E - EPOXY COATED REINFORCEMENT.
 S - STIRRUP.
 X - BAR IS INCLUDED IN SUBSTRUCTURE QUANTITIES.
 V - BAR DIMENSIONS VARY IN EQUAL INCREMENTS BETWEEN DIMENSIONS SHOWN ON THIS LINE AND THE FOLLOWING LINE.

NO. EA. - NUMBER OF BARS OF EACH LENGTH.
 NOMINAL LENGTHS - ARE BASED ON OUT TO OUT DIMENSIONS SHOWN IN BENDING DIAGRAMS AND ARE LISTED FOR FABRICATORS USE. (NEAREST INCH)
 ACTUAL LENGTHS - ARE MEASURED ALONG CENTERLINE BAR TO THE NEAREST INCH.

* ALL HOOKS AND BENDS FOR SHAPE NO. 12 - GRADE 40 (ONLY) ARE BASED ON D = 5d.

465

STD. 90.8.5
 MAY 1974
 REVISED OCT. 1978

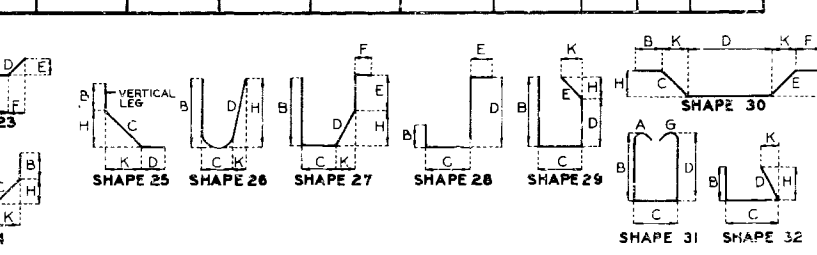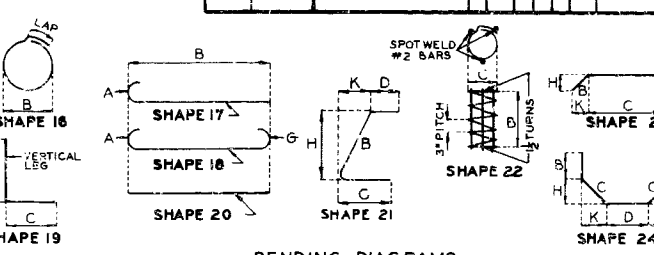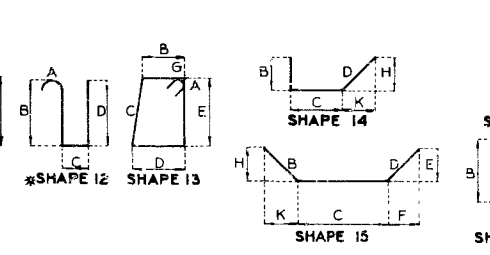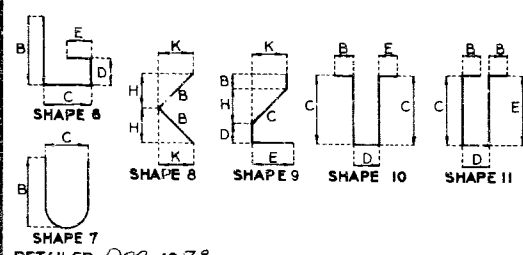


SHAPE 7
 DETAILED Dec. 1978
 CHECKED Dec. 1978

Note: This drawing is not to scale. Follow dimensions.

MISSOURI STATE HIGHWAY DEPARTMENT

FED. ROAD DIST. NO.	STATE	FED. AID PROJ. NO.	FISCAL YEAR	SHEET NO.	TOTAL SHEETS
1	MO.		19	6	

FINAL PLAN

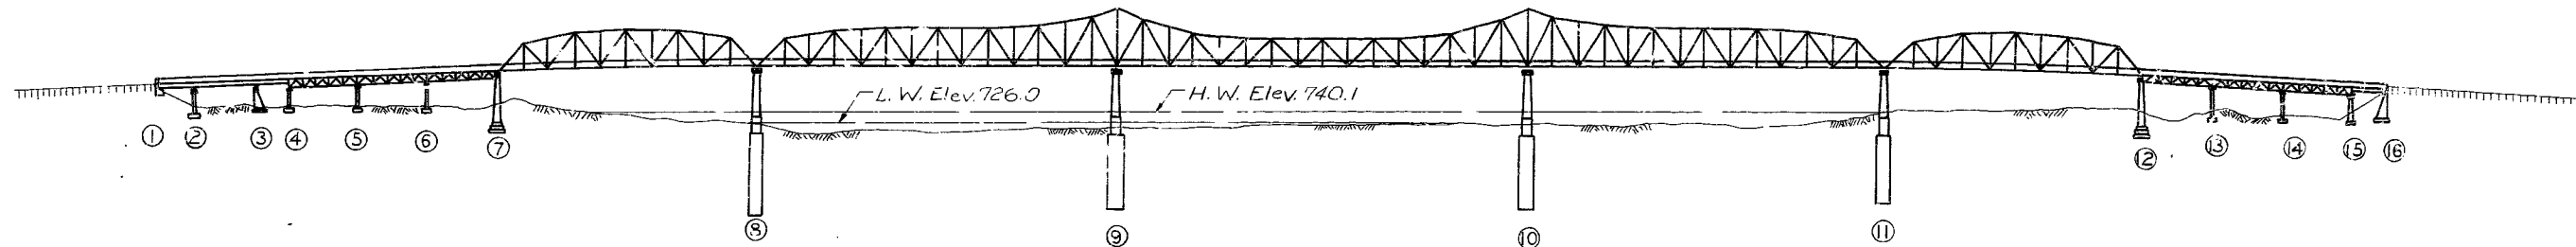

GENERAL ELEVATION

GENERAL NOTES:

Design Specifications: A.A.S.H.T.O. - 1977
 Design Loading
 HS-20-44 Floor System, No Future Wearing Surface, Earth 120*
 Equivalent Fluid Pressure 30*

Design Unit Stresses:

Class A Concrete (Substr. Repair) $f_c = 1500$ psi.
 Class B Concrete (New Substr.) $f_c = 1,200$ psi.
 Class B1 Spec. Conc. (Superstr. Grid Fill) $f_c = 1,600$ psi.
 Reinforcing Steel $f_y = 60,000$ psi (Grade 60)
 Structural Carbon steel $f_s = 20,000$ psi.
 Minimum clearance to reinforcing steel $1\frac{1}{2}$ unless otherwise shown


Floor System:

Steel Grid Floor (Half Conc. Filled) (See Special Provisions)

Painting: Shop None; Field, System A or B Aluminum. (See Special Provisions)

Note: Light dotted lines indicate old work. Heavy lines indicate new work.
 Note: Contractor shall verify all dimensions in field before ordering new steel.
 Note: For field connections use $\frac{3}{8}$ " High Strength Bolts, holes $\frac{1}{8}$ " except as noted.
 Note: A minimum vertical clearance of 21'-6" from top of rails and a minimum lateral clearance of 12'-6" from the centerline of track to nearest temporary construction falsework shall be maintained during construction.
 Note: All joint filler meet the requirements of Std. Spec. 1057.2.4.

466

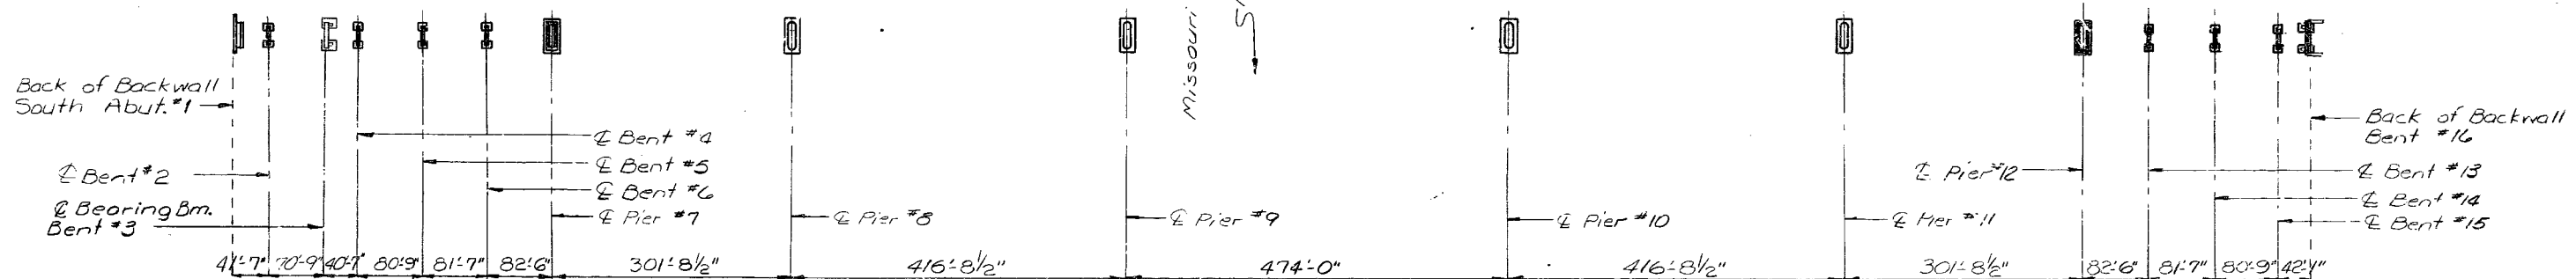

PLAN

FINAL QUANTITIES			
ITEM	SUBSTR.	SUPERSTR.	TOTAL
Removal of Existing Bridge Deck	Sq.Ft.	55,640	55,640
Special Work	Lump Sum	1	1
Asphalt Cement (Asphaltic Concrete)	Ton	27.6	27.6
Mineral Aggregate (Asphaltic Concrete) (Spec. Mix)	Ton	547	547
Substr. Repair (Formed)	Sq.Ft.	769	769
Substr. Repair (Unformed)	Sq.Ft.	262	262
Class B Conc. Misc. (Bent #16)	Cu. yd.	21.9	21.9
Tack Coat	Gal.	420	420
Elast. Exp. Jt. Seal (2 in.)	Lin. Ft.	22	22
Elast. Exp. Jt. Seal (2 1/2 in.)	Lin. Ft.	44	44
Elast. Exp. Jt. Seal (4 in.)	Lin. Ft.	44	44
Elast. Exp. Jt. Seal (6 in.)	Lin. Ft.	.6	.6
Preformed Comp. Exp. Jt. Seal (2 1/2 in.)	Lin. Ft.	506	506
Reinforcing Steel (Grade 60)	Lb.	2360	2360

FINAL QUANTITIES CONT.			
ITEM	SUBSTR.	SUPERSTR.	TOTAL
Steel Grid Floor (Half Concrete Filled)	Sq. Ft.	4,441	4,441
Painting (System B) Aluminum	Lump Sum	1	1
Protective Coating for Piers & Bents	Lump Sum	1	1
Cleaning Existing Bearings	Lump Sum	1	1
Fab. Str. Steel Revisions	Lb.	219,900	219,900
Bridge Guardrail (2 Tube Str. Stl.)	Lin. Ft.	5190	5190
Pressure Grouting-Epoxy	Lin. Ft.	0	0
Contingent Items			
Steel Grid Floor (Modified)	Sq.Ft.	502.07	14,805
Contraction Joint Beams	Lump Sum	502.05	1

Note: All steel is A-36 except as noted on portal details.

FINAL QUANTITIES		
CONTINGENT ITEMS	SUBSTR.	SUPERSTR. TOTAL
MODIFY EXP. JOINT BEAMS		1604.38
INSTALL ANCHORS	3492.48	3492.48
BENT 15 EXCAVATION	1400.88	1400.88
REPLACE BEARINGS	7316.50	7316.50
BEARING REPAIR, BENTS 3 AND 16	4710.67	4710.67
INSPECT REWORK AREAS		7284.44

B.M. #8 Pointed \square on S.W.W.W. Br. No. K-456
 Elev. 494.51, [U.S.G.S. Datum Elev. 774.18]

BRIDGE OVER MISSOURI RIVER FAIRFAX BRIDGE AT RIVERSIDE

PROJ BHO-083(3)
 JOB NO. 4-U-69-64 RTE. 69


PLATTE COUNTY MISSOURI
 WYANDOTTE COUNTY KANSAS

DETAILED Sept. 18 78
 CHECKED Nov. 19 78


Note: This drawing is not to scale. Follow dimensions.

Sheet No. 1A of 30. Date 4-16-79

STD. 706.30
 K-456R

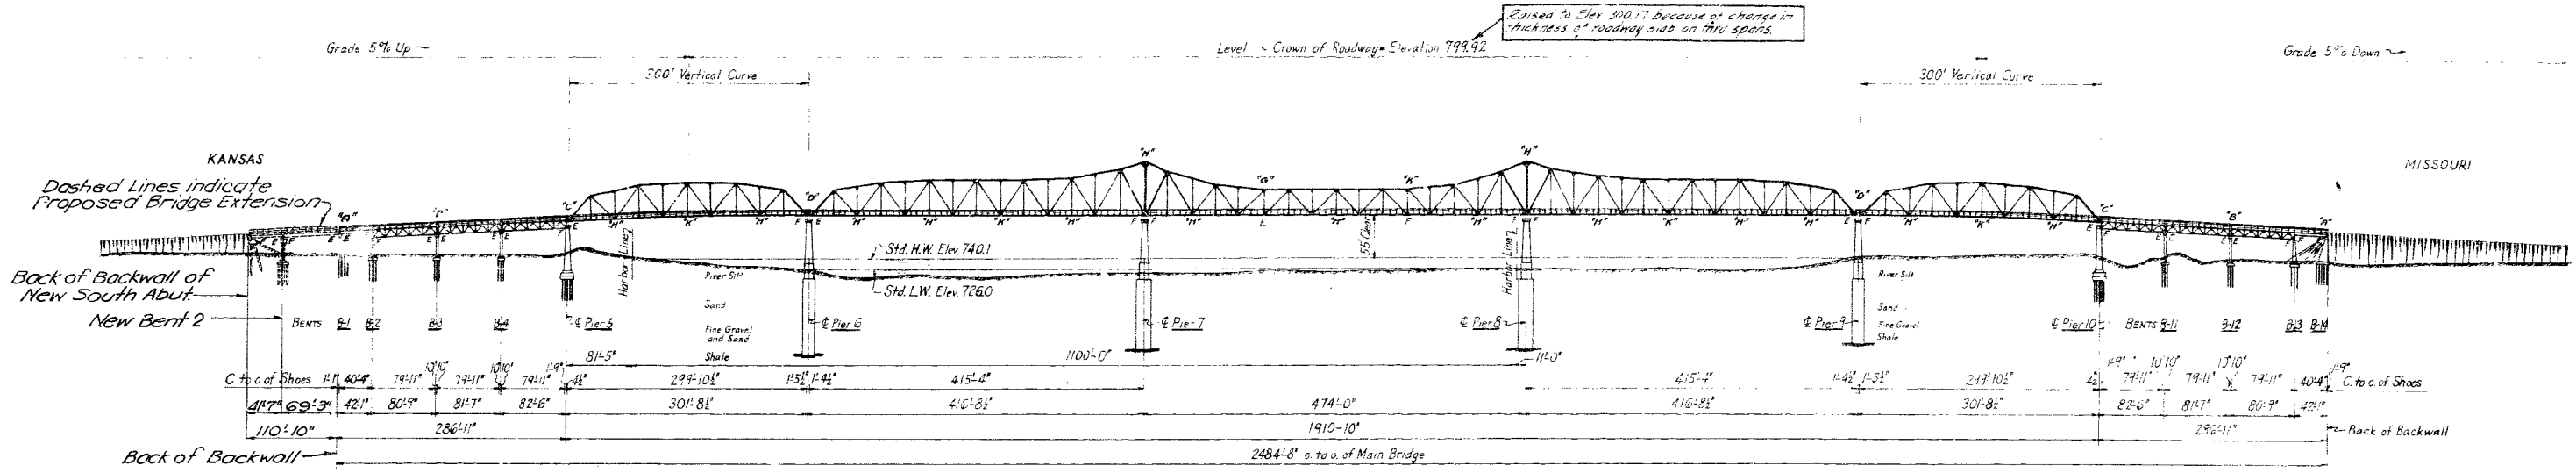

ELEVATION

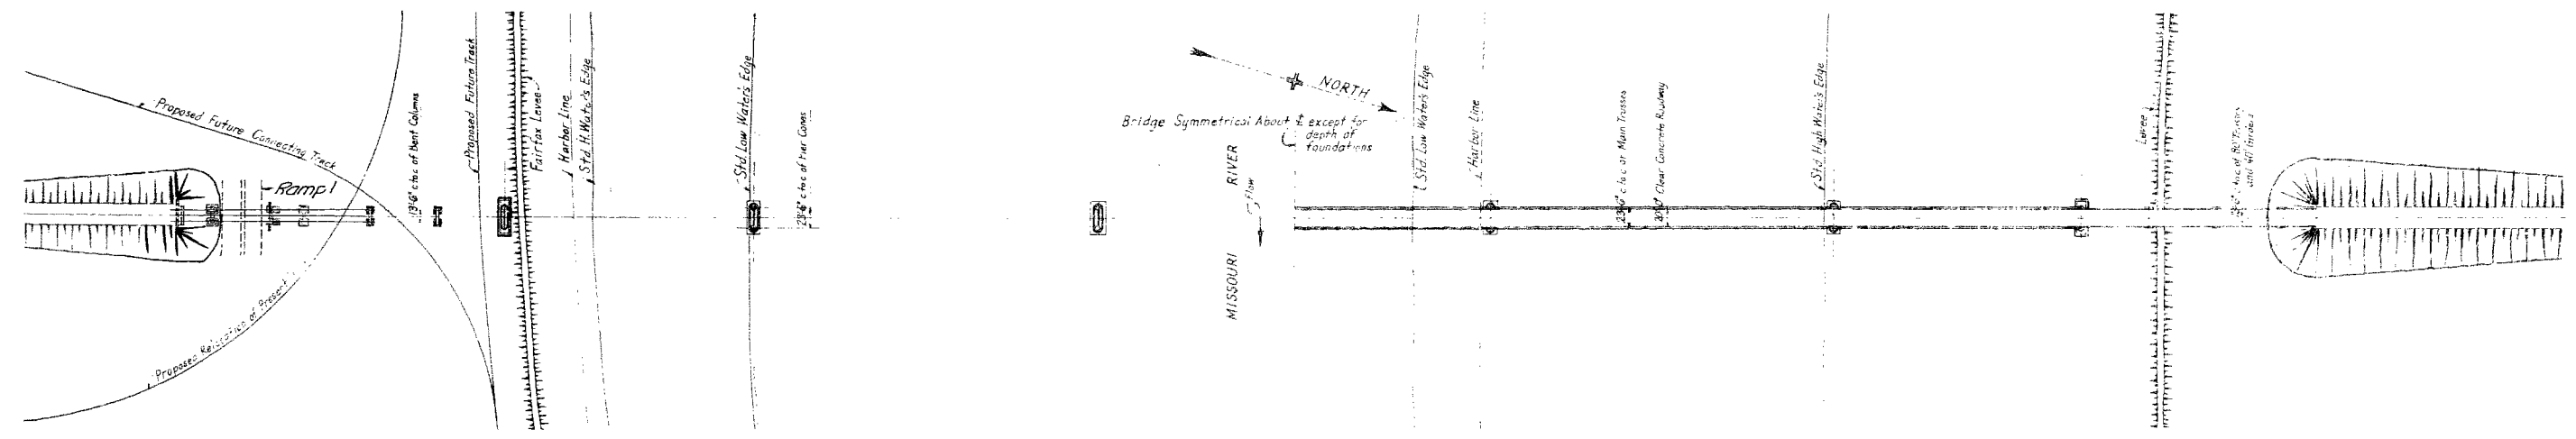

PLAN


ESTIMATED QUANTITIES		
Item		
Class "B" Concrete	Cu. Yds.	71.6
Fabricated Structural Steel	Lbs.	5700
Reinforcing Steel	Lbs.	6440
Primer (RC-0 or GO-100 Penetration Asphalt)	Gals.	270

Note: Estimated quantities of Primer and type "C" Asphaltic Concrete include surfacing of Proposed Bridge Extension and 25' of approach pavement south of New South Abut (See Special Provision)

GENERAL NOTES:

Design Specifications: A.A.S.H.O. 1953
 Structural Steel Stress: 18,000 #/a"
 Reinforcing Steel Stress: 20,000 #/a"
 Concrete Class "B" Stress 4,000 #/a"
 Qualification of welding operators will be required.
 Paint: Shop, none. Field: See Special Provisions.

REINFORCING STEEL			
No.	Size	Length	Mark
880	#4	21"	R1
880	#4	3'-3"	R2
160	#5	21'-0"	R3

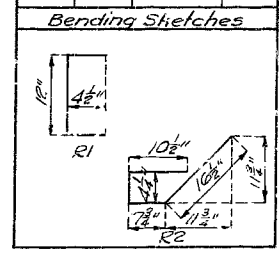

ALTERATIONS TO
BRIDGE OVER MISSOURI RIVER
 STATE ROAD FROM KANSAS CITY KANSAS TO ROUTE 45
 PROJECT NO. P.T. 69-M83 (1)

PLATTE CO. MISSOURI
 WYANDOTTE CO. KANSAS

SUBMITTED BY: J.P. Williams, DATE: 2-20-1958
 BRIDGE ENGINEER

APPROVED BY: R.W. Whitton, DATE: 2-20-1958
 CHIEF ENGINEER

K-456A1

Drawn Jan. 1958 by M.H.P. & J.H.K.
 Checked Feb 1958 by M.E.L.


Note: This drawing is not to scale. Follow dimensions.

Sheet No. 1 of 2.

335


MISSOURI STATE HIGHWAY DEPARTMENT

FED. ROAD DIST. NO.	STATE	FED. AID PROJ. NO.	FISCAL YEAR	SHEET NO.	TOTAL SHEETS
5	MO.		19		

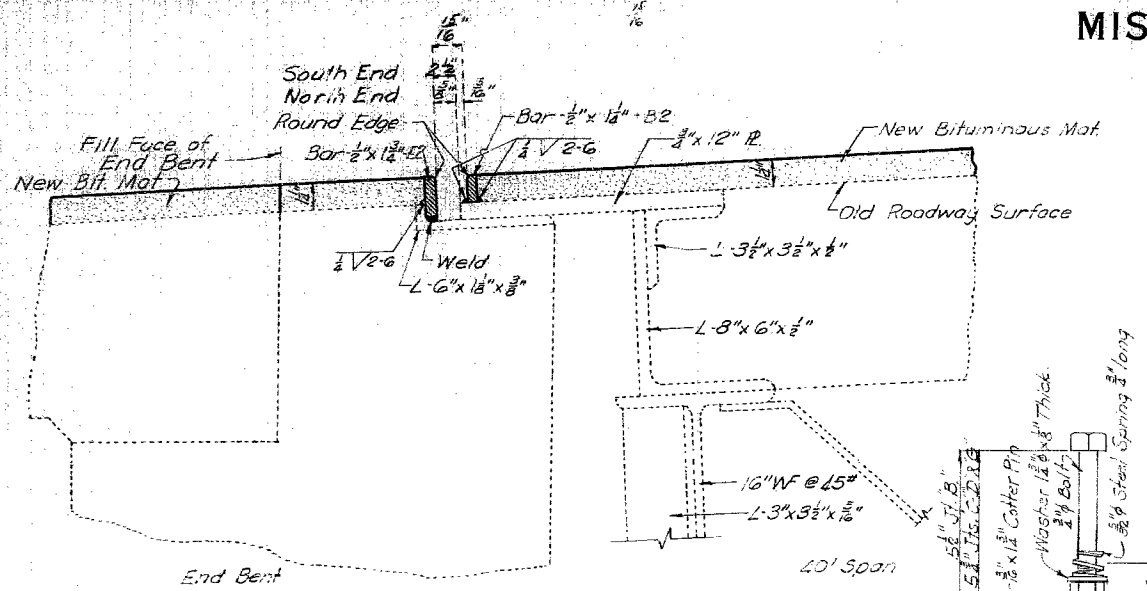


SECTION THRU EXP. JOINT "A"

Cadmium plated .0005 Thick.
Complete.
DETAIL OF BOLTS

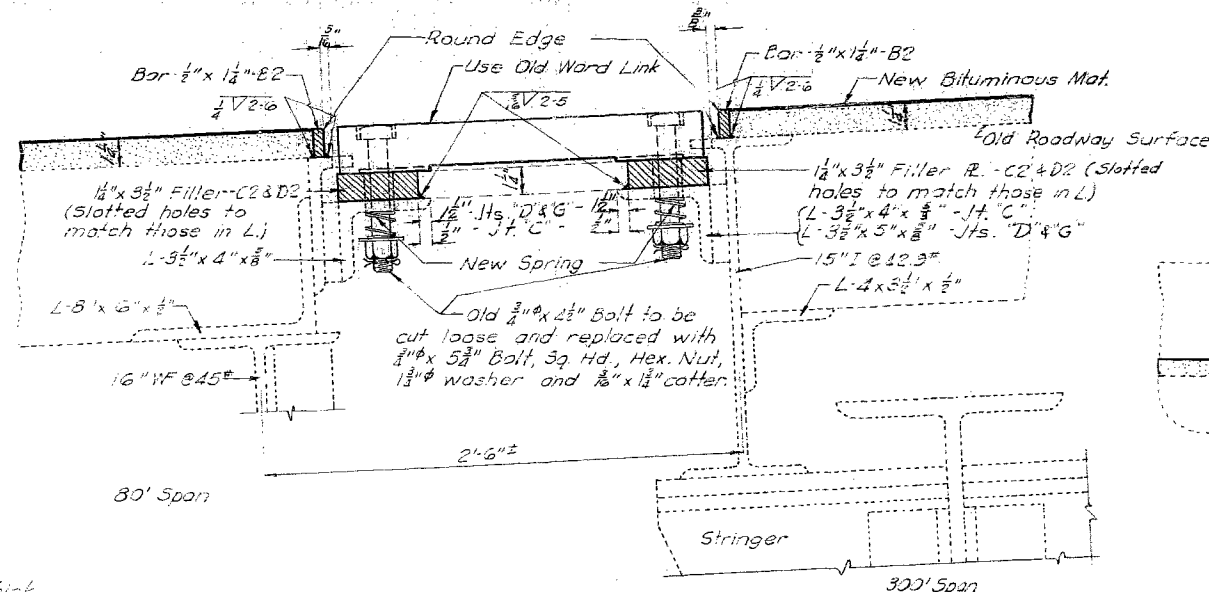


SECTION THRU EXP. JOINT "C"


Note: Joint "C" shown. Both sides of Section Thru Joints "D" & "G" similar to those for 300' Span.

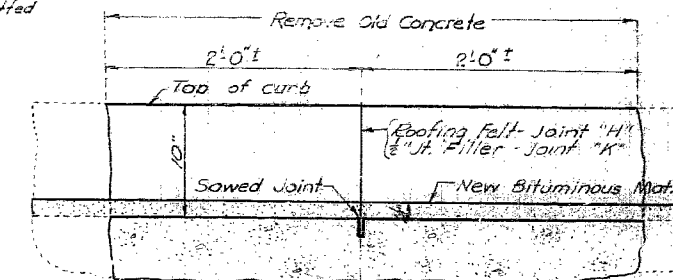


DETAIL OF CURB OVER JOINTS "H" & "K"

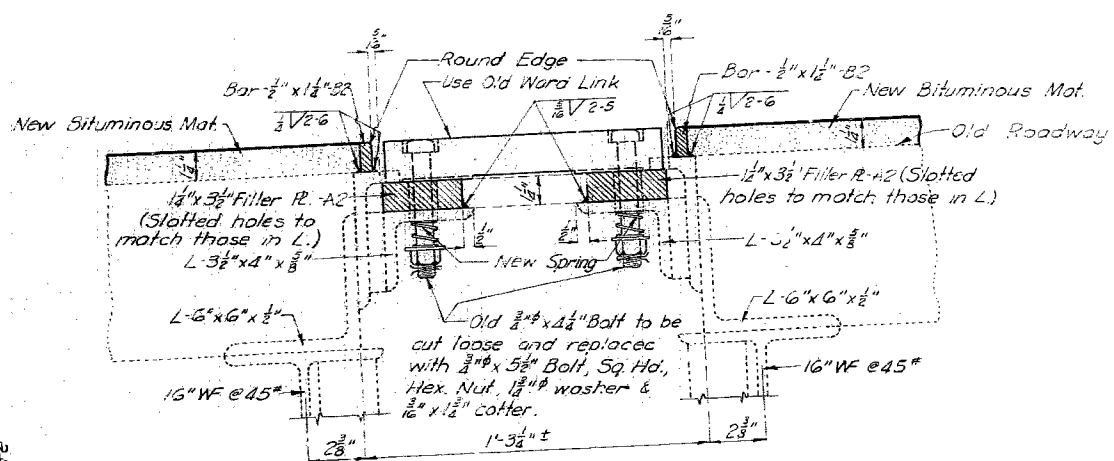


SECTION THRU EXP. JOINT "B"

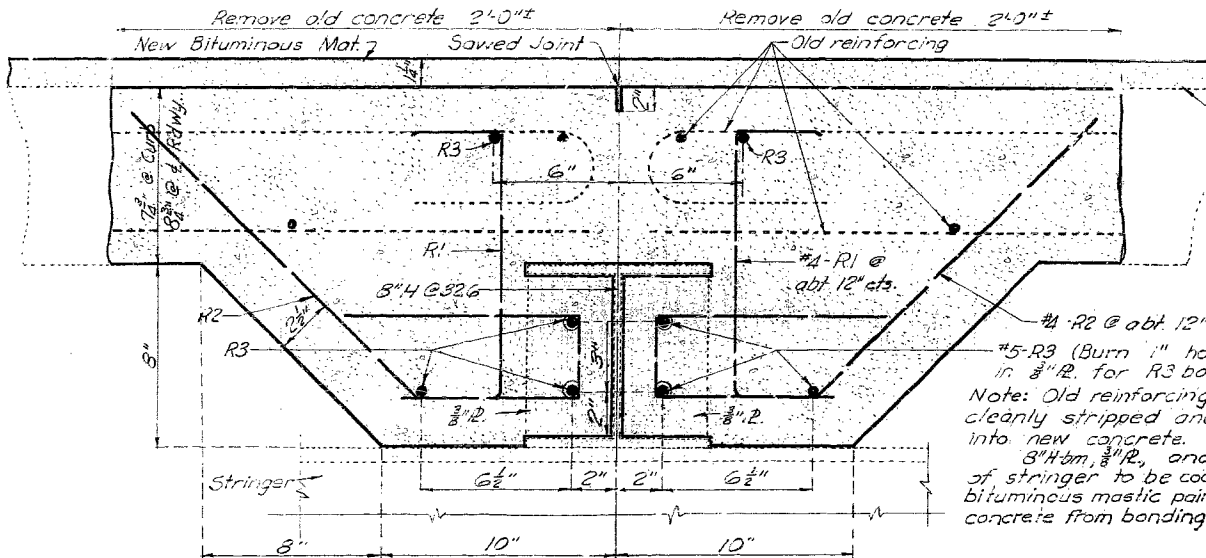

SECTION THRU JOINT "H"

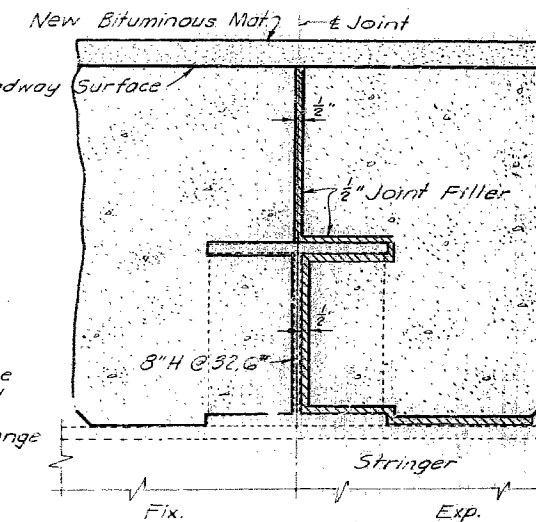

SECTION THRU JOINT "K"
Note: Details not shown are same as those for joint "H".

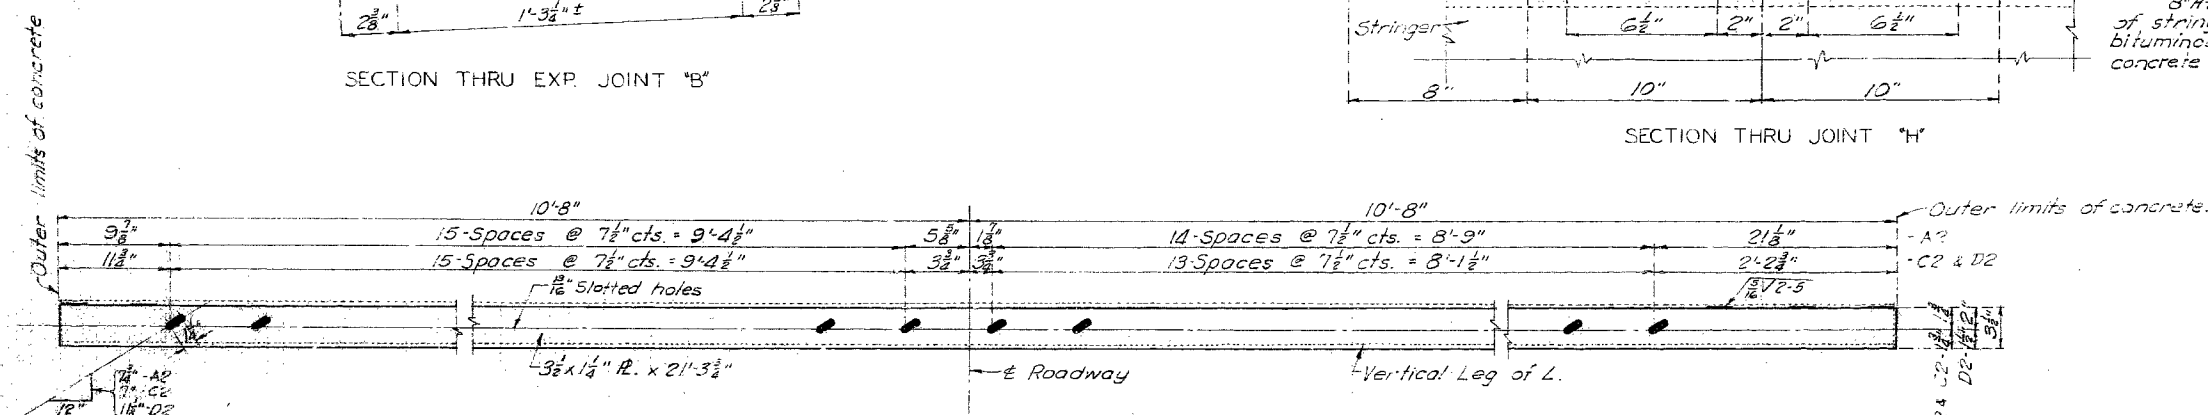

PLAN OF FILLER PLATE

PLAIN MATERIAL		BOLT LIST				
No.	Mark	Description	No.	Size	Length	Location
16	B2	Bar 1/2 x 1 1/2 x 20'-0"	124	3/4"	5 1/2"	A2 to B
2	E2	Bar 1/2 x 1 1/2 x 20'-0"	300	3/4"	5 1/2"	C2 & D2 to G

Make 4-A2 Jts. "B"
Make 4-C2 Jts. "C"
Make 6-D2 Jts. "D" & "G"

Note: Light dashed lines indicate old work. Heavy lines indicate new work.

**ALTERATIONS TO
BRIDGE OVER MISSOURI RIVER**
STATE ROAD FROM KANSAS CITY, KANSAS TO ROUTE 45
ABOUT
PROJECT NO. RT.69-M83 (1) STA.
PLATTE CO. MISSOURI
WYANDOTTE CO. KANSAS

336

NEW FAIRFAX BRIDGE PROJECT

NEAR

KANSAS CITY, KANSAS

FOR

PLATTE COUNTY, MISSOURI

1955

CONTRACT IX - SOUTH APPROACH HIGHWAY

FINAL DESIGN DRAWINGS

APPROVED

COUNTY COURT OF PLATTE COUNTY MISSOURI

----- PRESIDENT JUDGE ----- DATE -----


MISSOURI STATE HIGHWAY COMMISSION


----- CHIEF ENGINEER ----- DATE -----

STATE HIGHWAY COMMISSION OF KANSAS

----- CHIEF ENGINEER ----- DATE -----

SVERDRUP AND PARCEL, INC.
CONSULTING ENGINEERS
ST. LOUIS, MO.



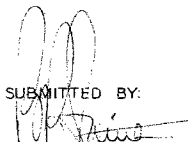
SUBMITTED BY:

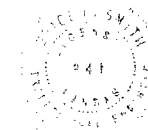REGISTERED PROFESSIONAL ENGINEER
KANSAS NO. 841




4015478

SH 21A Platte Co K-456A2

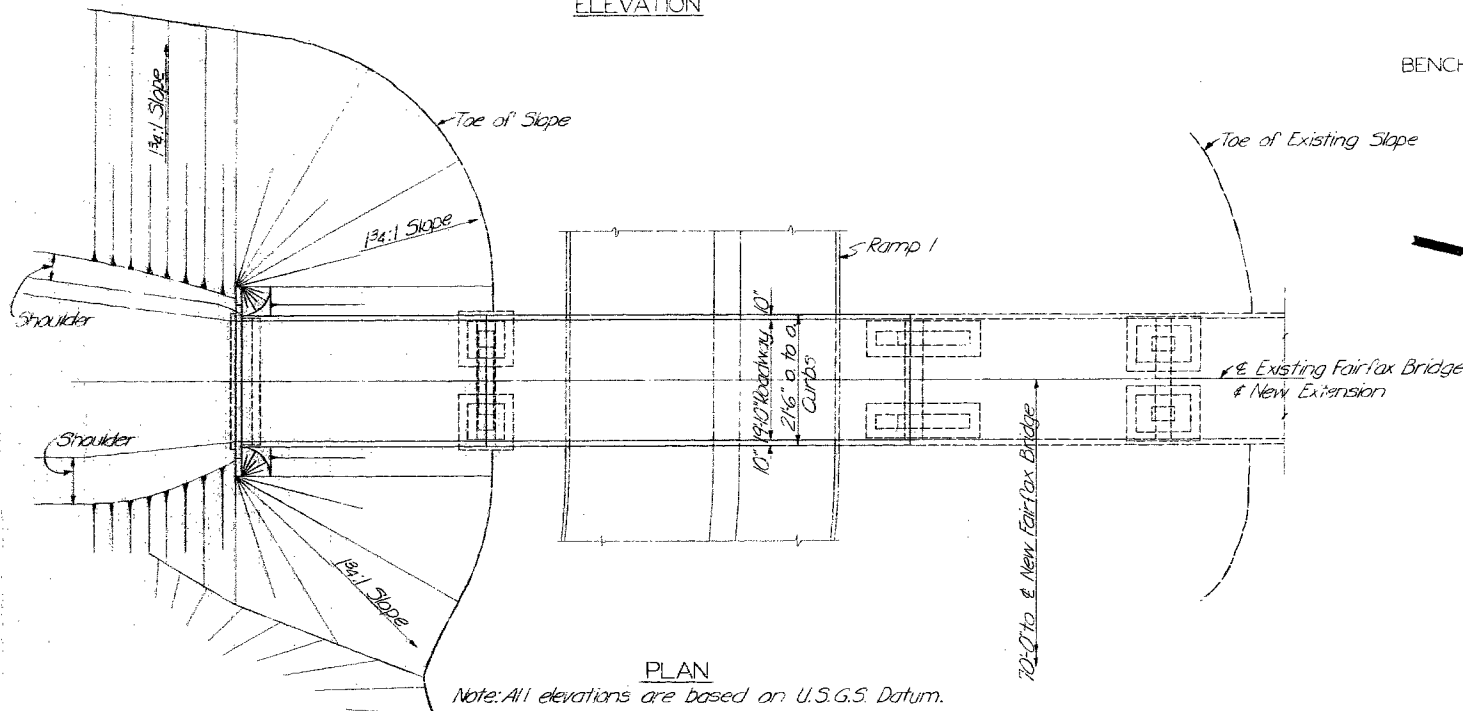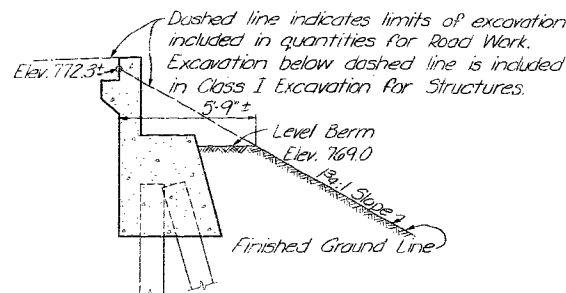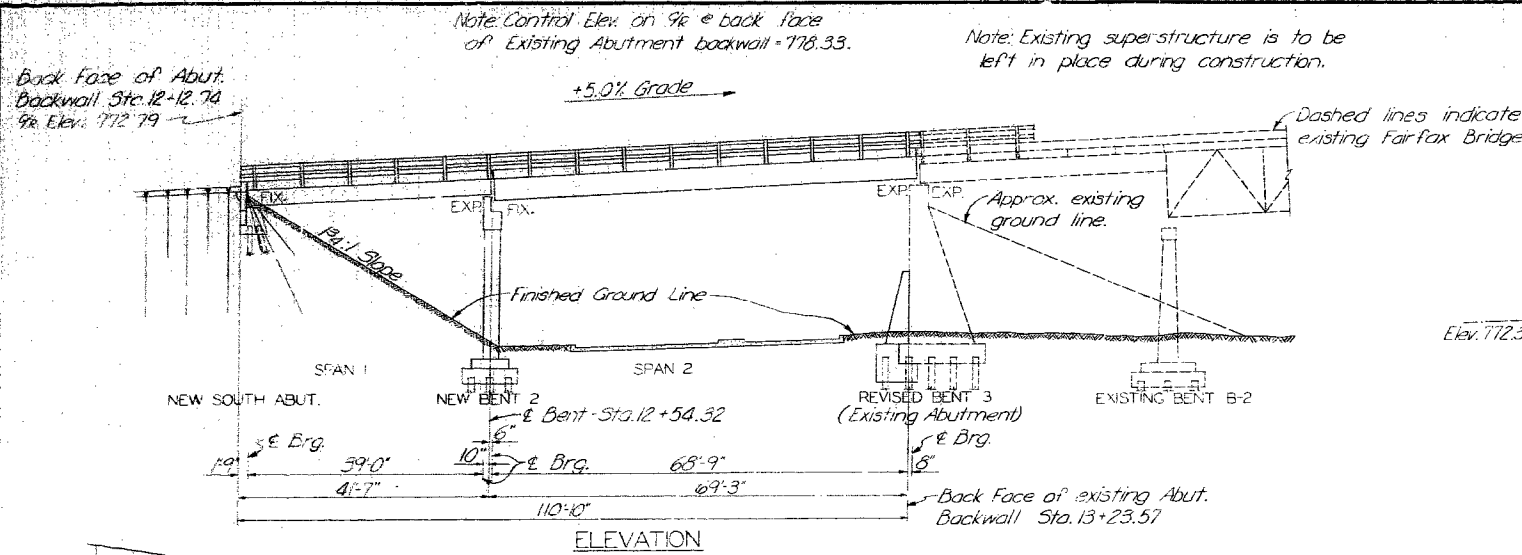337



Item	Unit	ESTIMATED QUANTITIES			AS BUILT QUANTITIES		
		Substr.	Superstr.	Total	Substr.	Superstr.	Total
Class I Excavation for Structures	Sq.Yd.	178		178	178		178
Treated Timber Piles in Place	Lin.Ft.	1160		1160	1004.5		1,004.5
Class "A" Concrete	Cu.Yd.	77.0		77.8	77.8		77.8
Lightweight Concrete	Cu.Yd.		57.6	57.6		57.7	57.7
Fabricated Structural Steel	Lb.		77,600	77,600		77,840	77,840
Reinforcing Steel	Lb.	7,240	12,660	19,900	7,240	12,660	19,900
Steel Castings	Lb.		1,400	1,400		1,520	1,520
Removal of Existing Concrete	Lump Sum	One		One			One

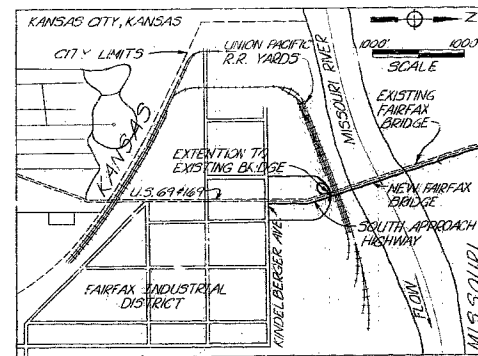

- ### GENERAL NOTES
- SPECIFICATIONS: Standard Specifications of the Kansas State Highway Commission, 1955 Edition, supplemented by General and Special Provisions.
- DESIGN: In accordance with Division III of the A.A.S.H.O. "Standard Specifications for Highway Bridges", 1953 Edition.
- DESIGN LOADING: Live Load - H15-S4.
- Dead Load - Provision is made for a future wearing surface of 15 pounds per square foot of roadway surface.
- DESIGN UNIT STRESSES:
- | | | | |
|----------------------------------|-------|--------|------------------------|
| Structural Steel | ----- | 16,000 | pounds per square inch |
| Reinforcing Steel | ----- | 20,000 | " " " " |
| Concrete (Lightweight Aggregate) | ----- | 1000 | " " " " |
| Concrete (Stone Aggregate) | ----- | 1200 | " " " " |
- CONCRETE: Class "A" air-entrained concrete shall be used for all substructure units. Roadway slab and curbs shall be Haydite, air-entrained concrete. See Special Provisions.
- BEVELED EDGES: All exposed edges of concrete shall be beveled 3/4" unless otherwise shown or noted.
- REINFORCEMENT: All reinforcement steel shall be lapped a minimum of 30 diameters unless otherwise shown. All dimensions to reinforcing steel on detail drawings are to 1/2" of bar, except where the clear distance is noted from the face of concrete.
- TIMBER PILES: All timber piles shall be driven to sustain a load of 25 tons. They shall have a minimum penetration of 30 feet.
- JOINT FILLER: Where joint filler is specified on the plans, it shall conform with the requirements for Expansion Joint Filler, Type "A", as given in Section 117.20 of the Standard Specifications. Payment for filler will be included in unit contract prices for items in which it is placed.
- JOINT SEAL: Where joint seal is specified it shall conform to the requirement as given in the Standard Specifications. Payment for seal will be included in contract prices for other items of work.
- COPPER FLASHING: Payment for Copper Flashing will be included in unit contract price for concrete.
- RIVETS: Rivets are as noted on drawings. Field connections to be riveted unless otherwise shown or noted. No Rivets. Used H.S. Bolts.
- PAINTING OF METALWORK: Shop coat - Red Lead, first field coat - Aluminum, second field coat - Aluminum. The first field coat of Aluminum shall be tinted with Prussian Blue in order to differentiate it from the second field coat. The second field coat shall be Aluminum, untinted. Payment for cleaning and painting shall be included in the price bid for the respective metal work payment items. No paint required for existing steel.
- FABRIKKA PADS: See Special Provisions.
- ROADWAY WEARING SURFACE: The roadway slab as detailed includes a 6" wearing surface poured monolithically with slab.
- EXCAVATION: All excavation above finished ground line is included in quantities for Road Work.
- Class I Excavation for Structures includes all excavation below finished ground line, or as noted on Benching Detail at New South Abut., and within the limits set forth by the Standard Specifications.
- CONSTRUCTION JOINTS: Construction joints shall be made only at the locations shown on the plans. Keys shall be provided at all construction joints.

- ### INDEX OF DRAWINGS
- 21 GENERAL PLAN AND ELEVATION
 - 22 NEW SOUTH ABUTMENT AND NEW BENT 2
 - 23 REVISED BENT 3 AND SUBSTRUCTURE BAR LIST
 - 24 STEEL DETAILS
 - 25 STEEL AND SLAB DETAILS
 - 26 STANDARD BI-TYPICAL BAR TYPES AND HOOK DIMENSIONS

ALTERATIONS TO EXISTING FAIRFAX BRIDGE OVER MISSOURI RIVER NEAR KANSAS CITY, KANSAS FOR PLATTE COUNTY, MISSOURI

GENERAL PLAN AND ELEVATION

SVERDRUP AND PARCEL, INC.
CONSULTING ENGINEERS
ST. LOUIS, MO.

FINISHED

FINISHED

Drawn by: H.T. Sanders, June 1956
Checked by: G.R. Permying, June 1956



Note: Do not scale this drawing. Follow dimensions.

Revision 1: Quantities and Rivets 1-20-59 By R.E.B. Ch'kd. JEC.


SHEET 21 OF 26

AS BUILT DRAWING


FINAL DESIGN DRAWING

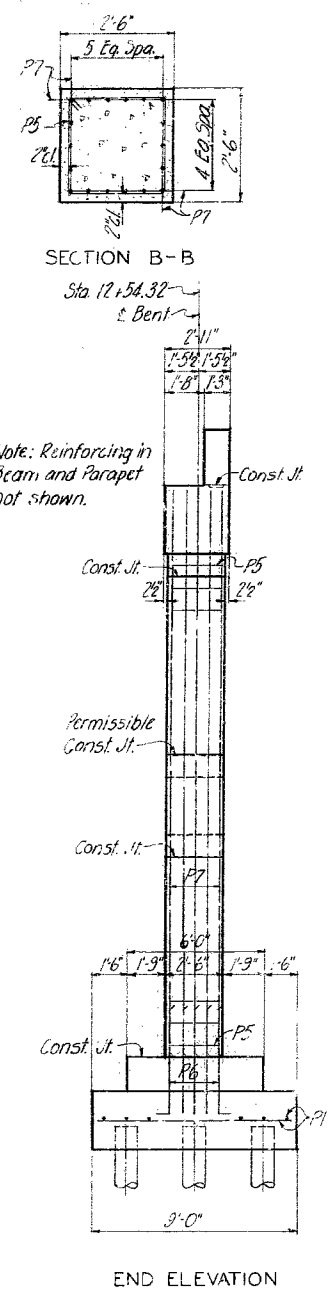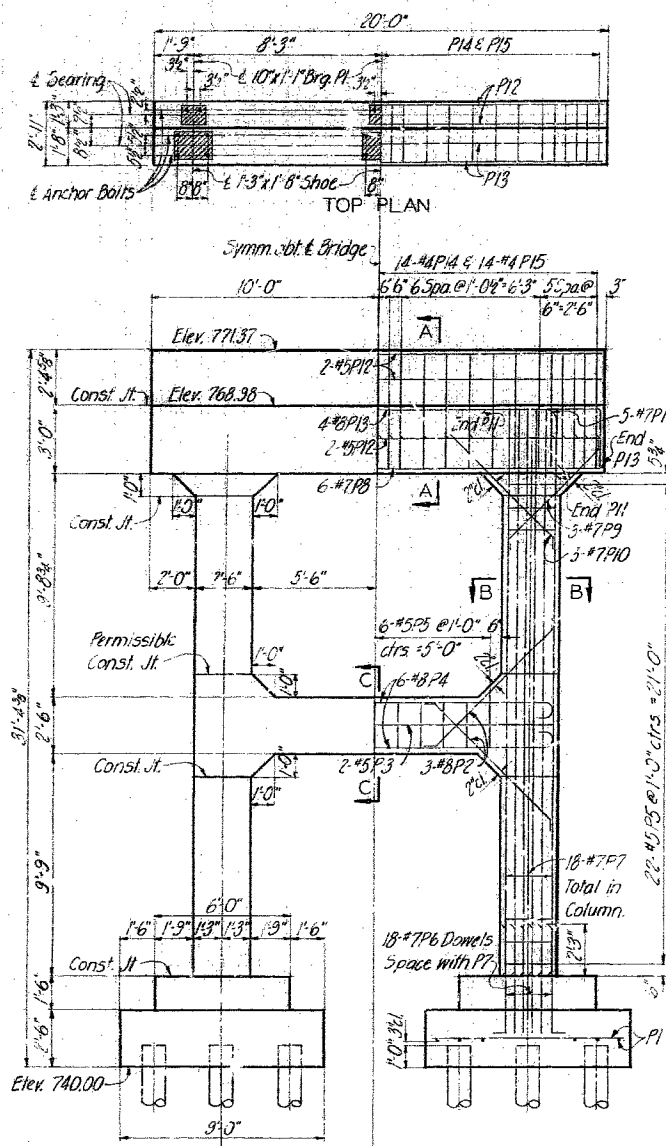


Note: Reinforcing in Beam and Parapet not shown.

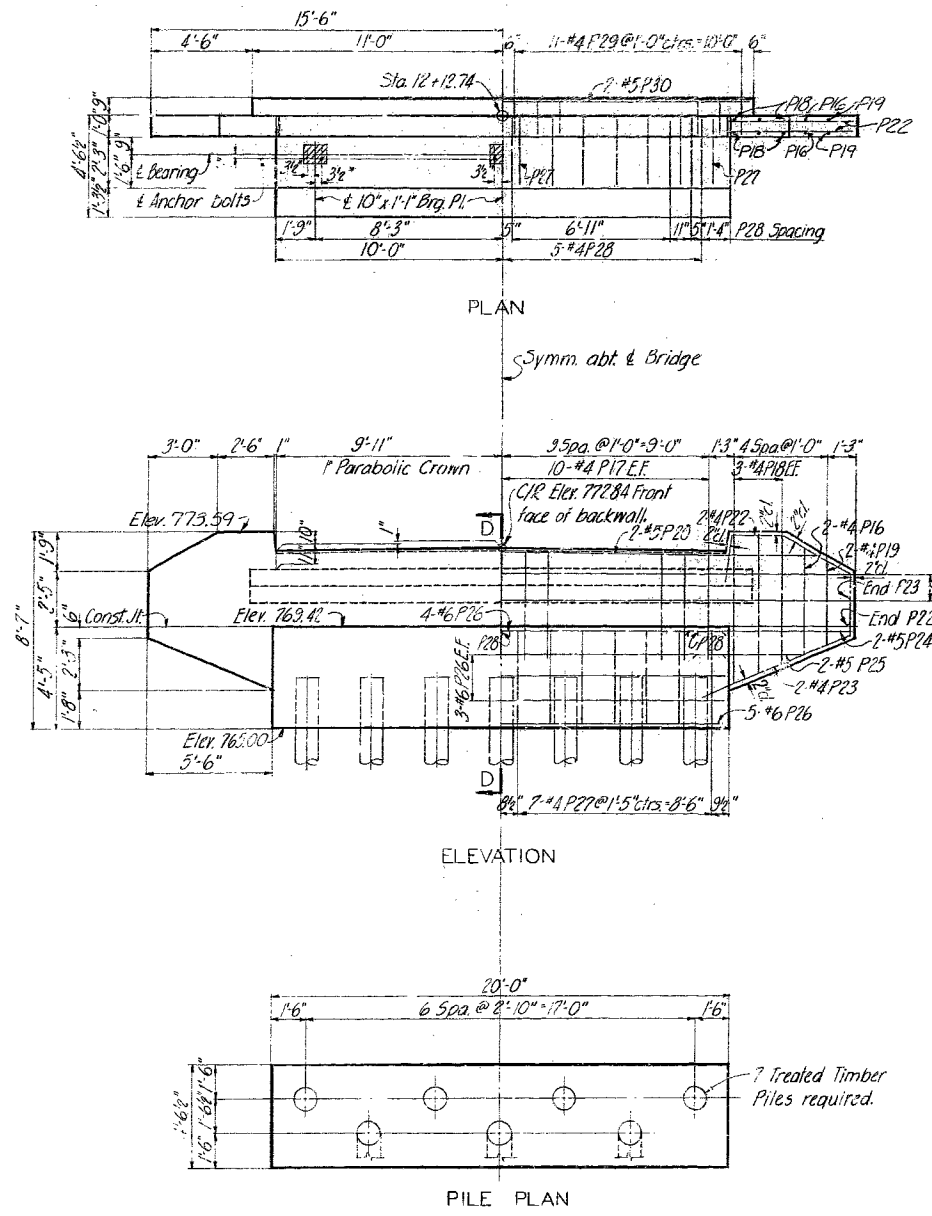


NEW SOUTH ABUTMENT

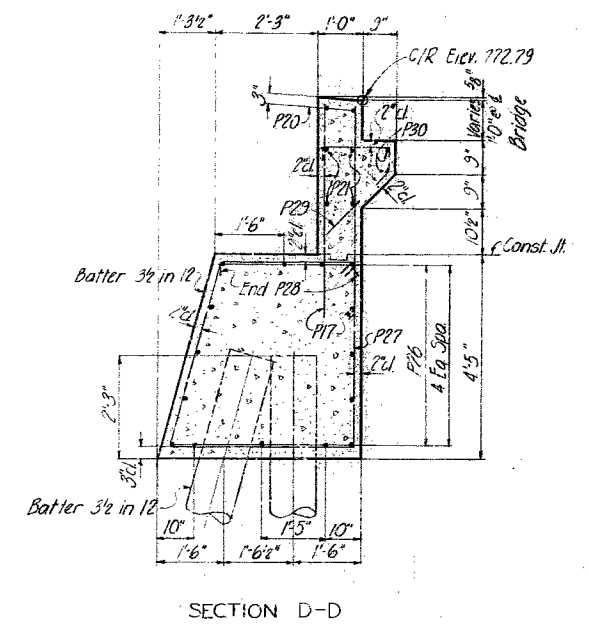

NOTES
 E.F. indicates Each Face.
 Anchor bolts shall be cast in place.
 See Sheet 25 for details of copper flashing to be placed at New South Abutment.

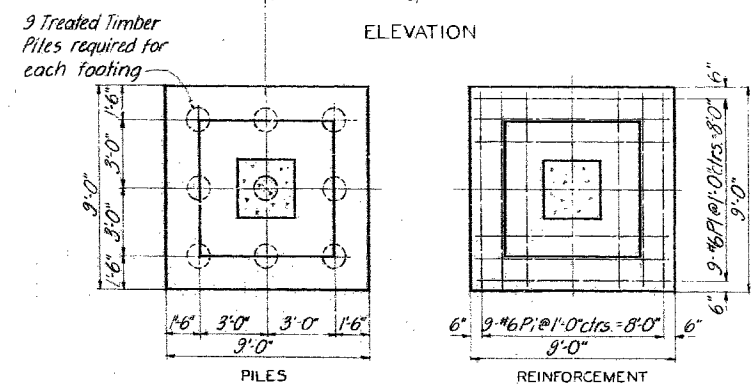

FOOTING PLAN

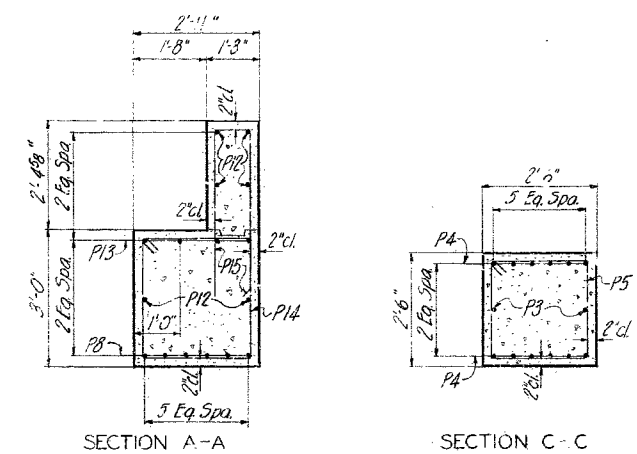

SECTION A-A

SECTION C-C

NEW BENT 2

Drawn by: R.F. Skubiz, May 1956
 Checked by: S.R. Pennington, June 1956

Note: Do not scale this drawing. Follow dimensions.

FINISHED




ALTERATIONS TO
 EXISTING FAIRFAX BRIDGE
 OVER MISSOURI RIVER
 NEAR KANSAS CITY, KANSAS
 FOR
 PLATTE COUNTY, MISSOURI
 NEW SOUTH ABUTMENT
 AND NEW BENT 2
 SVERDRUP AND PARCEL, INC.
 CONSULTING ENGINEERS
 ST. LOUIS, MO.

FINISHED



SHEET 22 OF 26

AS BUILT DRAWING


FINAL DESIGN DRAWING

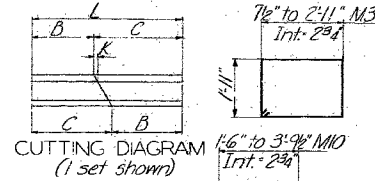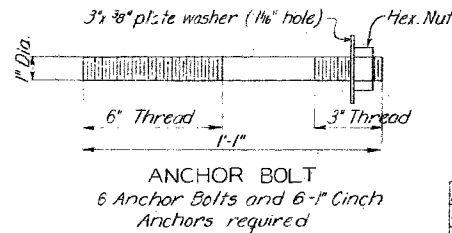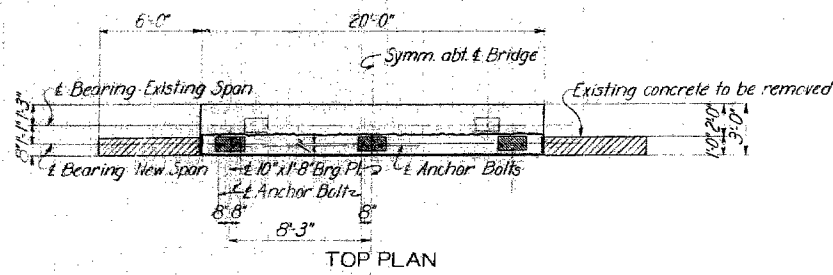


Mark	Cutting Schedule	B	C	K	L
PI8	Cut 2 sets of 3 each	5'-7 1/2"	6'-5 1/2"	5"	12'-1"
M3	Cut 1 set of 11 & Bend	5'-10"	10'-5"	5 1/2"	16'-3"
M10	Cut 2 sets of 11 each & Bend	2'-1"	4'-4 1/2"	2 3/4"	6'-5 1/2"

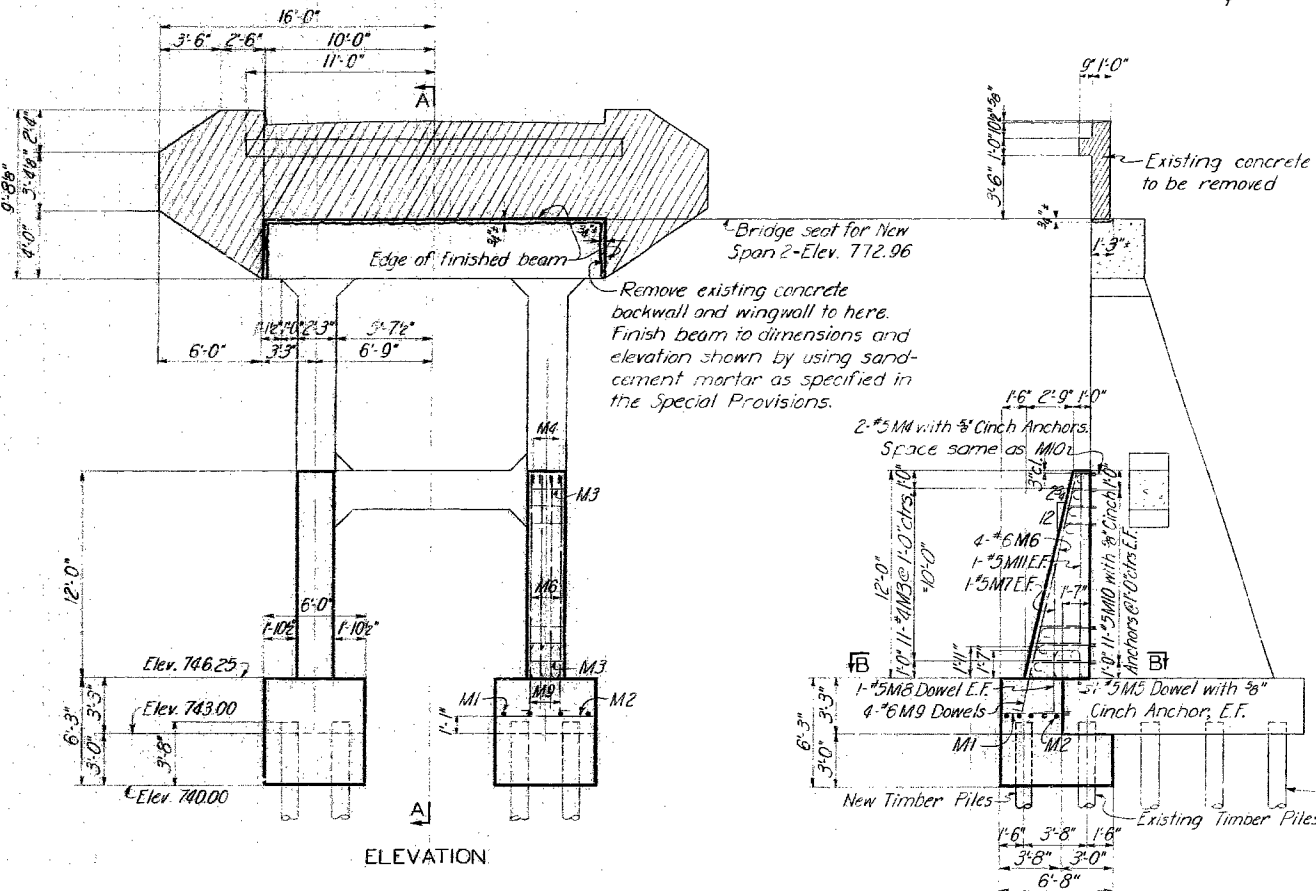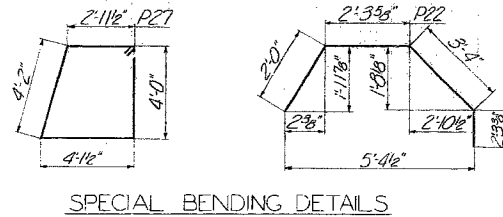


SECTION A-A

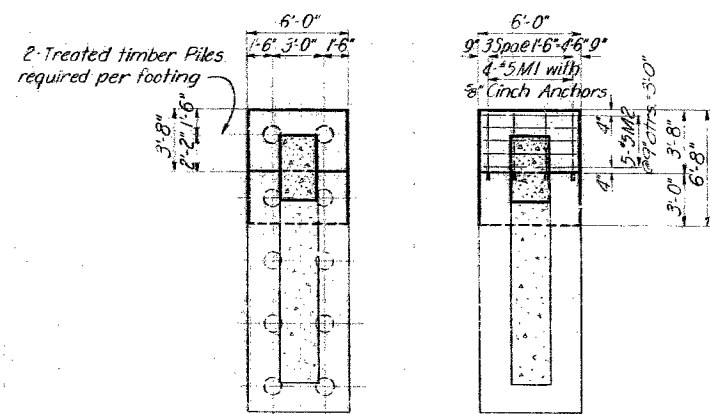

FOOTING PLAN

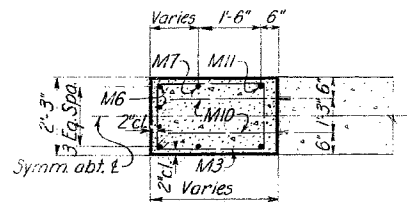

SECTION B-B

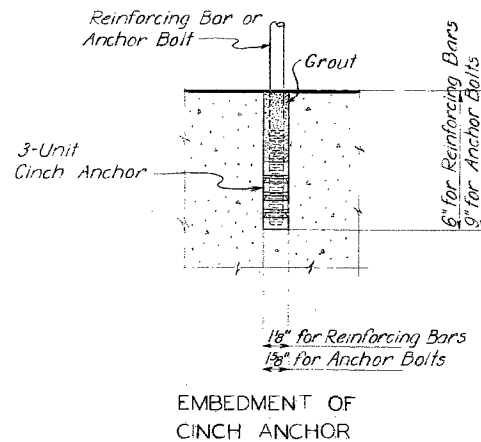

No.	Reinf.	Size	Length	Mark	Type	Location	Dimensions for Bending											
							A	B	C	D	E	F	G	H	J	K	R	O
NEW BENT 2																		
36	#6	8'-6"	PI	Str.	Footing													
12	#8	8'-6"	P2	Str.	Strut		6'	7'-6"	6'				4 1/2"	4 1/2"	8'-2 1/2"			
2	#5	15'-8"	P3	Str.	do													
12	#5	17'-10"	P4	Str.	do	1'-1"	15'-8"						1'-1"					
35	#5	9'-6"	P5	Str.	Strut & Col.	5'	2'-2"	2'-2"	2'-2"	2'-2"			3'					
36	#7	5'-2"	P6	Str.	Column	5'	4'-9"											
36	#7	24'-10"	P7	Str.	do													
6	#7	19'-8"	P8	Str.	Beam													
6	#7	6'-8"	P9	Str.	Column		5'	5'-9 1/2"	5'				3 1/2"	3 1/2"	16'-10 1/2"			
6	#7	7'-2"	P10	Str.	do		5'	6'-9"							17'-0 1/2"			
10	#7	6'-1"	P11	Str.	Beam		2'-3"	1'-6 1/8"	2'-3"						11'-5"			
6	#5	19'-8"	P12	Str.	do													
4	#8	24'-11"	P13	Str.	do		2'-7 1/2"	19'-8"	2'-7 1/2"									
27	#4	11'-3"	P14	Str.	do	4 1/2"	2'-7"	2'-8"	2'-7"	2'-8"			4 1/2"					
27	#4	8'-5"	P15	Str.	do		3'-8"	11"	3'-8"									
NEW SOUTH ABUTMENT																		
4	#4	4'-10"	P16	Str.	Wall													
38	#4	4'-8"	P17	Str.	do													
6	#4	12'-1"	P18	Str.	do													
4	#4	3'-9"	P19	Str.	do													
2	#5	23'-0"	P20	Str.	do													
4	#5	30'-0"	P21	Str.	do													
4	#4	9'-1"	P22	Spcl.	do													
4	#4	8'-9"	P23	Str.	do													
4	#5	7'-1"	P24	Str.	do													
4	#5	5'-1"	P25	Str.	do													
15	#6	19'-8"	P26	Str.	Beam													
14	#4	16'-0"	P27	Spcl.	do													
9	#4	3'-6"	P28	Str.	do		3'	2'-11 1/2"					3'					
22	#4	4'-2"	P29	Wall	do		3'	1'-5"	6'-8"	2'-0"			1'-5"		1'-5"			
2	#5	2'-8"	P30	Str.	do													
REVISED BENT 3																		
8	#5	3'-11"	M1*	Str.	Footing													
10	#5	5'-6"	M2	Str.	do													
11	#4	16'-3"	M3	Spcl.	Shall't													
4	#5	1'-11"	M4*	L	do		7'	1'-4"										
4	#5	2'-8"	M5*	L	Footing													
8	#6	12'-8"	M6	Str.	Shall't								7 1/2"	14"	12'-2 1/2"			
4	#5	6'-6"	M7	Str.	do													
4	#5	4'-1"	M8	Str.	Footing		4'	3'-9"										
8	#6	4'-5"	M9	Str.	do		4'	4'-1"										
22	#5	6'-6"	M10*	Spcl.	Shall't													
4	#5	11'-9"	M11	Str.	do													

Note: Reinf. bars indicated thus * shall be plain bars, threaded 3" on anchor end.

SUBSTRUCTURE BAR LIST

NOTES

Dimensioning, bending and hooks for Special Bending Details shall conform to the standards as shown or noted on Sheet 26.
A dash is used in the appropriate dimension column to indicate that a hook, bend or portion of the standard bar type is to be omitted.
For Typical Bar Types and Hook Dimensions, see Sheet 26.
E.F. indicates Each Face.
Threaded plain reinforcing bars are included in above bar list and will be paid for as "Reinforcing Steel".
Cinch Anchors indicated on this sheet shall be type 2, three-unit threaded Ring Wedge Cinch Anchors, or equal.
Cost of furnishing and placing Cinch Anchors shall be included in Lump Sum bid for "Removal of Existing Concrete."

ALTERATIONS TO EXISTING FAIRFAX BRIDGE OVER MISSOURI RIVER NEAR KANSAS CITY, KANSAS FOR PLATTE COUNTY, MISSOURI

REVISED BENT 3 AND SUBSTRUCTURE BAR LIST


SVERDRUP AND PARCEL, INC. CONSULTING ENGINEERS ST. LOUIS, MO.

FINISHED

FINISHED


Note: Do not scale this drawing. Follow dimensions.

240

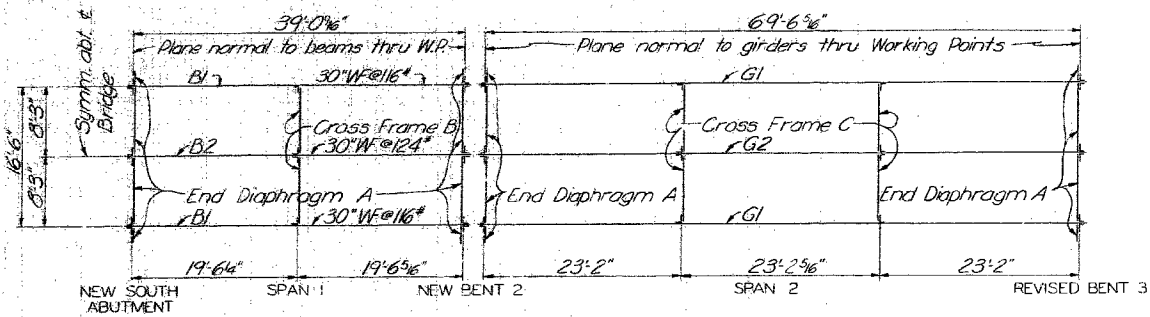


FRAMING PLAN


Longitudinal dimensions are measured parallel to grade.
For girder material in Span 2, see Section Thru G1 & G2.

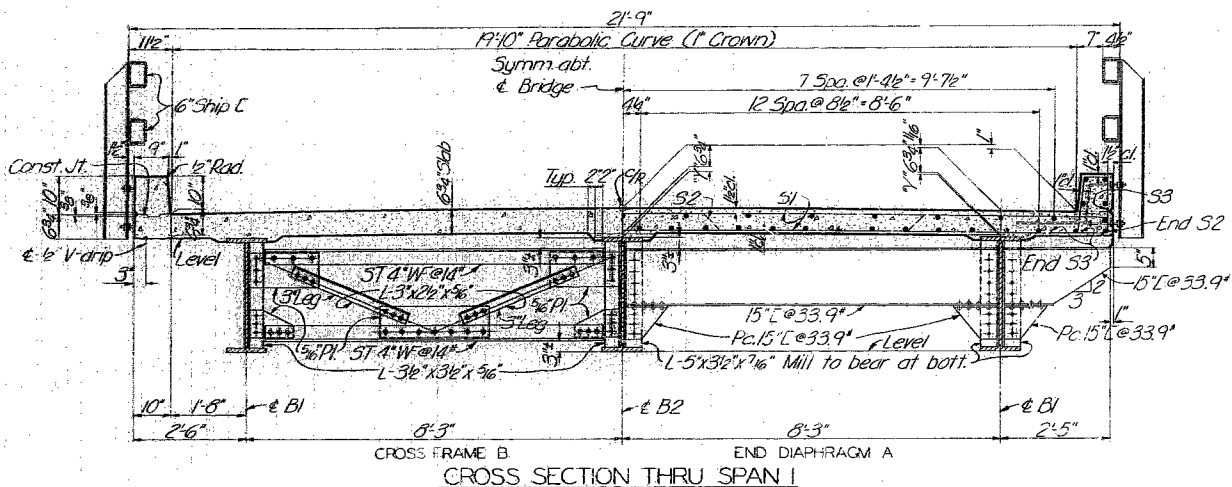


CROSS SECTION THRU SPAN 1

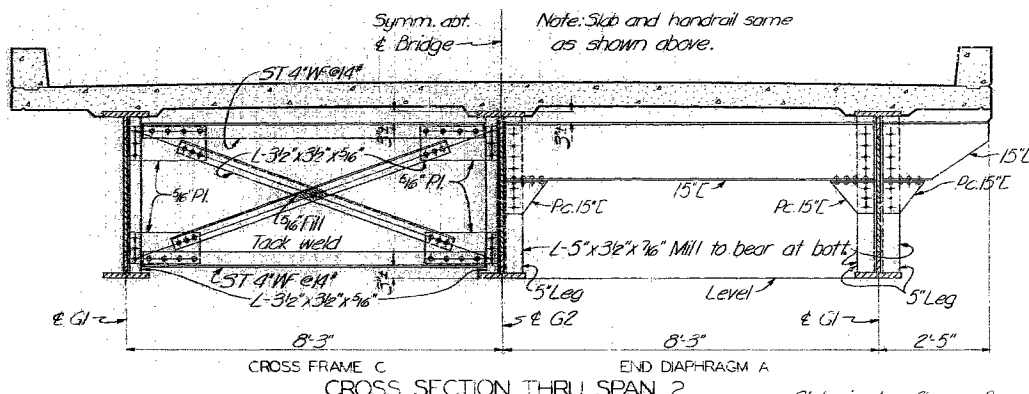

CROSS SECTION THRU SPAN 2

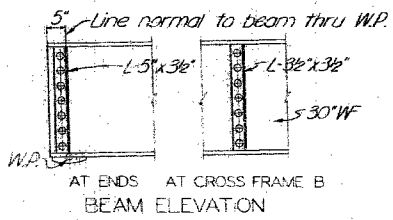


BEAM ELEVATION

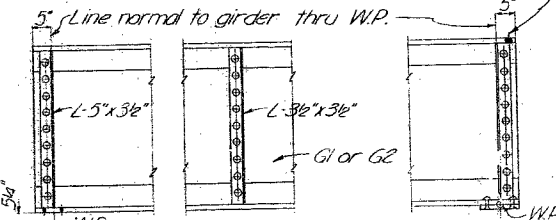


GIRDER ELEVATION

HAUNCH HEIGHTS "Y"		
Span	Beam or Girder	"Y"
1	B1	7/8"
	B2	1"
2	G1	5/8"
	G2	1"


For location of dimension "Y", see Cross Section Thru Span 1. Dimension "Y" is at & bearing. For haunches at intermediate points add "Y" to Dead Load Deflection Ordinates.

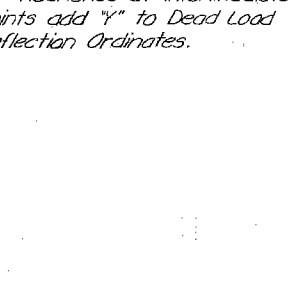


SECTION THRU G1 & G2

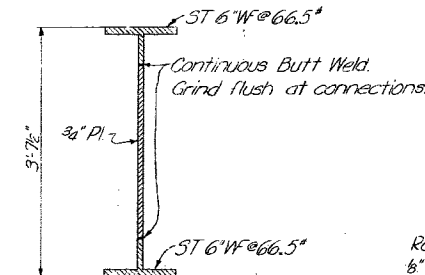

**DETAIL OF PIN ENDS AND PIN CAPS
FIXED SHOE AT NEW BENT 2 - SPAN 2
(3 Required)**

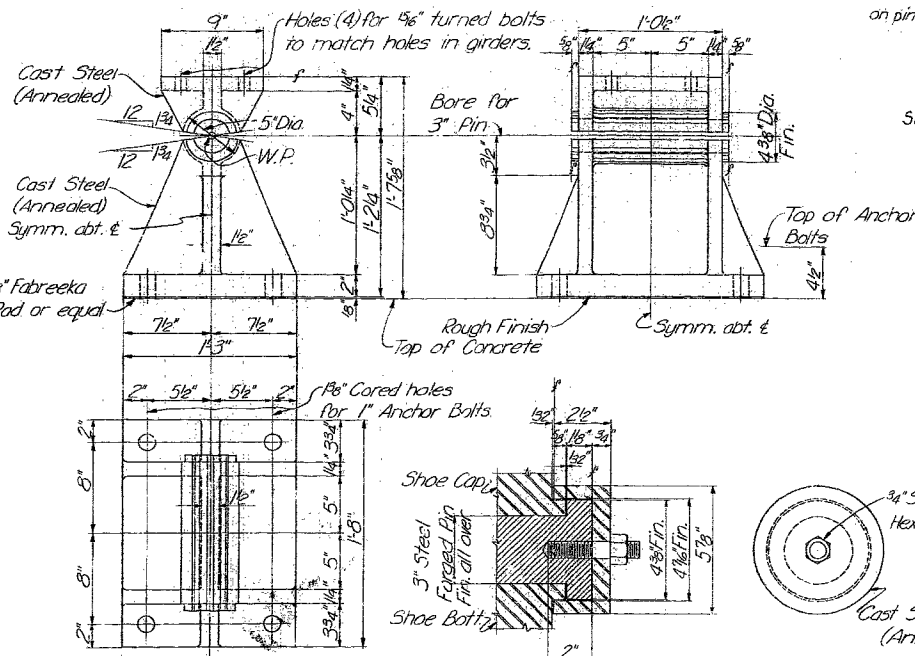


**DETAIL OF PIN ENDS AND PIN CAPS
FIXED SHOE AT NEW BENT 2 - SPAN 1
(3 Exp. Required)
(3 Fixed Required)**

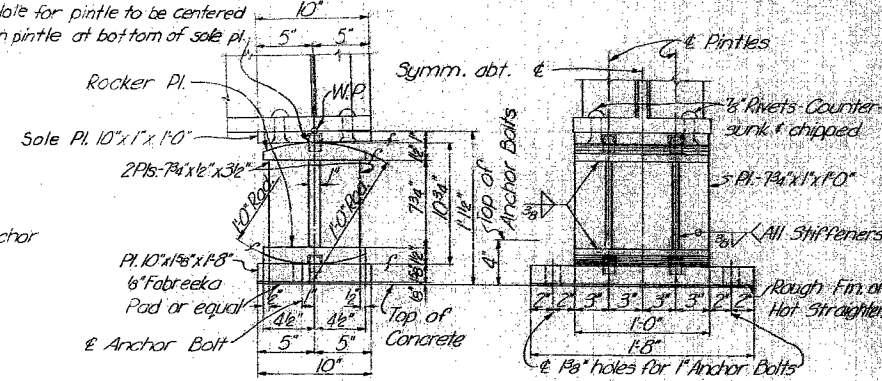


EXPANSION SHOE AT REVISED BENT 3 - SPAN 2

Note: Contact surfaces between rocker plates and plates welded to them, shall be finished prior to welding.

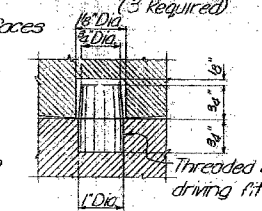

**DETAIL OF PINTLE
(12 Required)
Finish all over.**

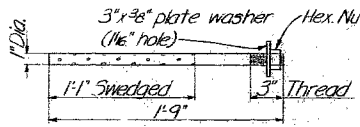


**ANCHOR BOLT
(24 Required)**

Note: Use this anchor bolt at New South Abut. & New Bent 2. For anchor bolt at Revised Bent 3, see Sheet 23.

NOTES

Work this sheet with Sheet 25.
All rivets in beams or girders shall be 3/8". All others shall 3/4". Where desired for convenience in erection, shop and field rivets may be interchanged.
Steel castings shall conform to A.S.T.M. Designation A27, Grade 65-35, fully annealed. All fillets on castings shall be 1/2".
Steel forgings for pins shall conform to A.S.T.M. Designation A235, Class C1, fully annealed.
The diameter of turned bolts as billed shall be the shank diameter. The threaded portion shall be 1/8" smaller in diameter than the shank, and the hole shall be the same diameter as the shank, providing a driving fit.

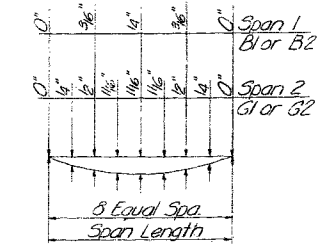

DEAD LOAD DEFLECTION ORDINATES

Note: Beams & Girders are not to be cambered.
Deflection due to dead load of steel only, equals the following percentages of the deflections shown:
Span 1 = 20%
Span 2 = 30%

ALTERATIONS TO EXISTING FAIRFAX BRIDGE OVER MISSOURI RIVER NEAR KANSAS CITY, KANSAS FOR PLATTE COUNTY, MISSOURI


STEEL DETAILS FINISHED

SVERDRUP AND PARCEL, INC.
CONSULTING ENGINEERS
ST. LOUIS, MO.


Note: Do not scale this drawing. Follow dimensions.

341


Drawn by H.T. Sanders, May, 1956
Checked by G.R. Remington, June, 1956

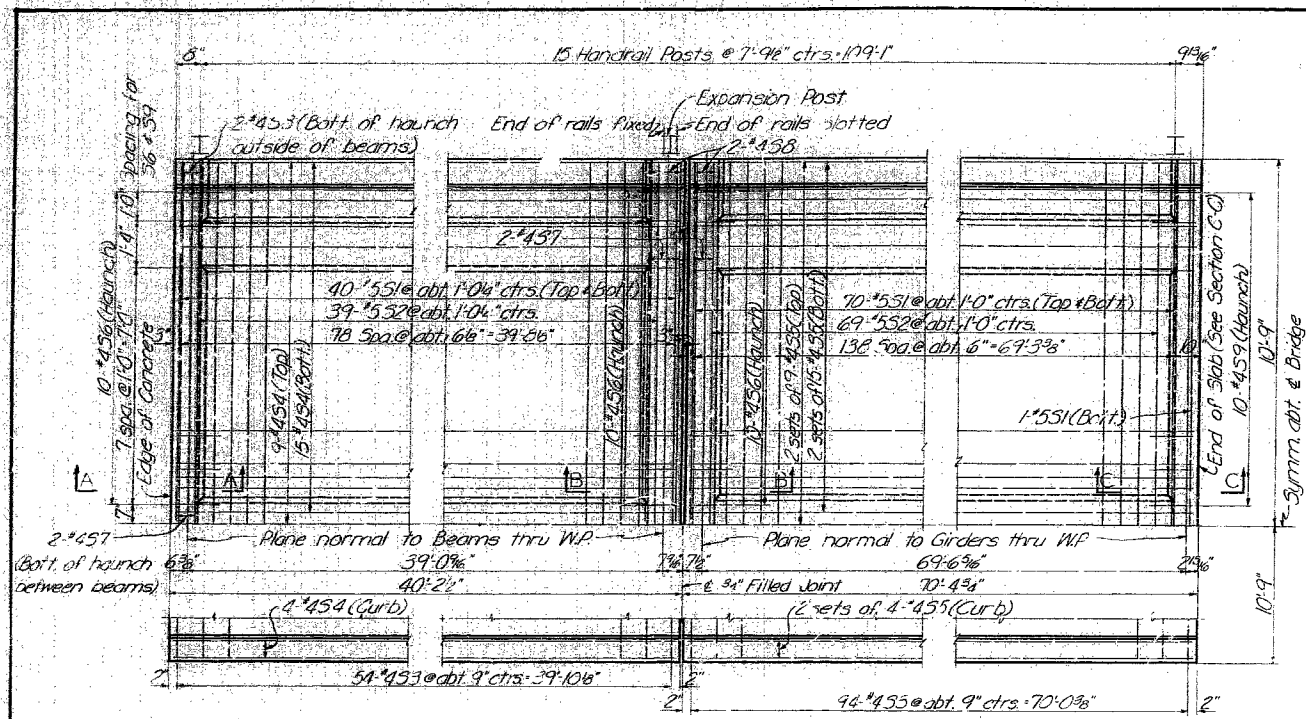


SLAB DETAILS
 Longitudinal slab dimensions are measured along grade.
 Handrail posts are spaced along top of curb.

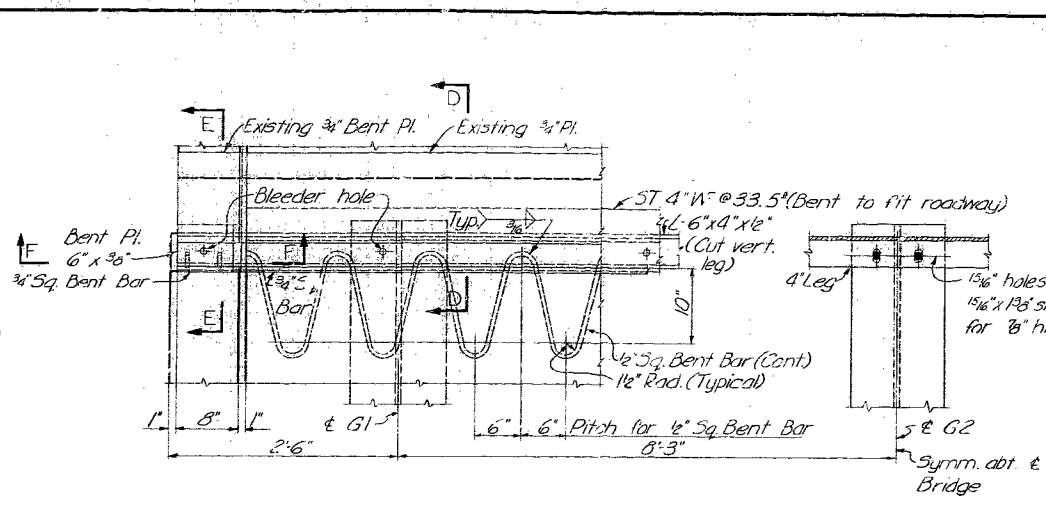


PART PLAN OF EXPANSION DEVICE AT REVISED BENT 3

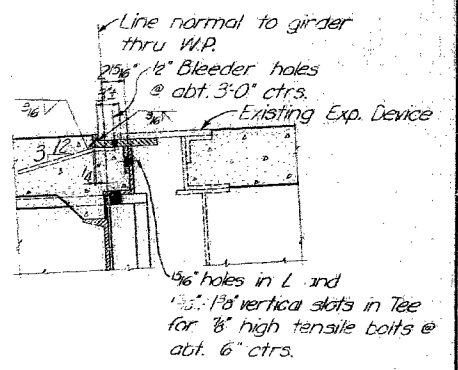




SECTION D-D

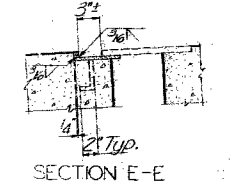

SECTION E-E

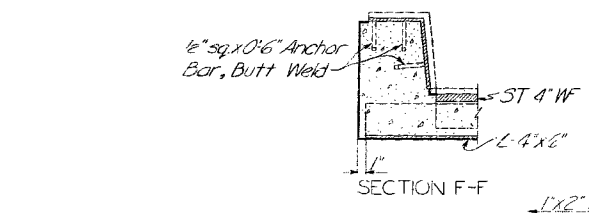


SECTION F-F

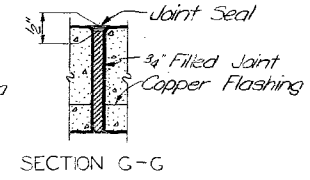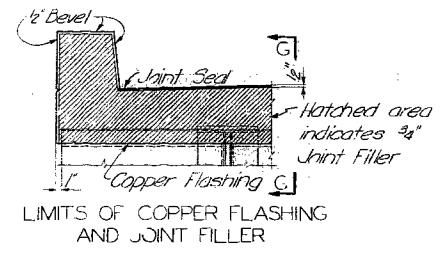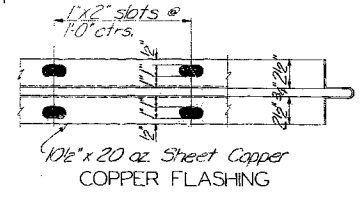


SECTION G-G

SUPERSTRUCTURE BAR LIST					
No. Req'd	Size	Length	Mark	Type	Location
221	#5	21'-3"	51	Str.	Slab
105	#5	22'-6"	52	Spcl.	do
296	#4	4'-7"	53	Spcl.	Curb
55	#4	39'-11"	54	Str.	Slab+Curb
110	#4	35'-8"	55	Str.	do
60	#4	3'-2"	56	Spcl.	Haunch
12	#4	7'-2"	57	Str.	do
12	#4	1'-9"	58	Str.	do
20	#4	2'-7"	59	Spcl.	do


Note: Dimensioning and bending for Special Bending Details shall conform to the standards as shown or noted on Sheet 26.

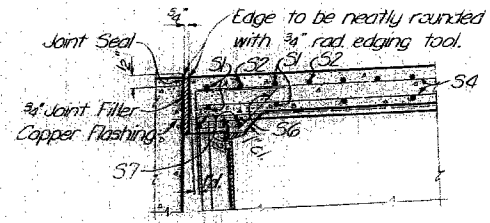


SECTION A-A

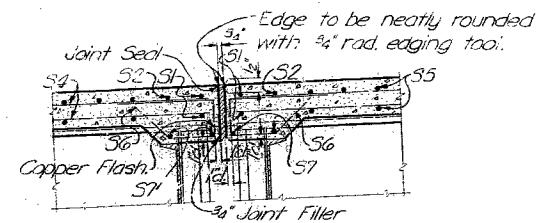

SECTION B-B

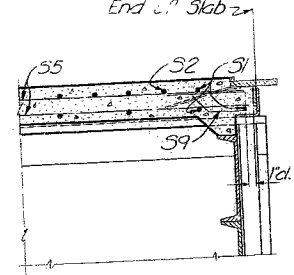


SECTION C-C

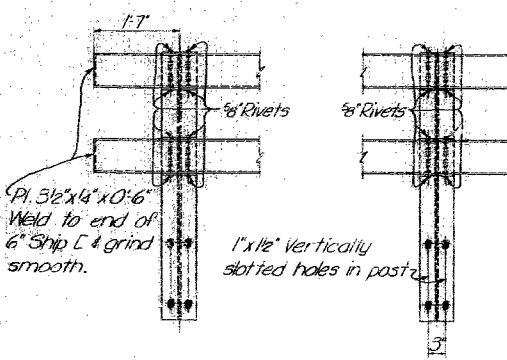


A* NEW SOUTH ABUTMENT

TYPICAL POST

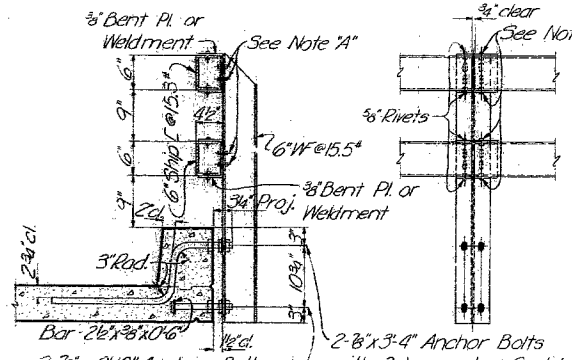

TYPICAL CROSS SECTION

EXPANSION POST

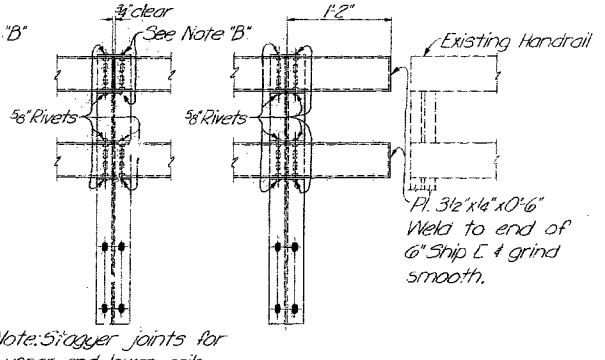

AT SPLICE


AT REVISED BENT 3

STRUCTURAL STEEL HANDRAIL

Note A: 1/16" holes in posts. 1/16" x 1/2" vertical slots in bent plate for 3/8" bolts with hex heads & nuts & std. pl. washer under heads & nuts.

Note B: 1/16" holes in bent plate. 1/16" x 1 1/4" horizontal slots in 6" C for 3/8" button head bolts with 2 hex. nuts & 1 std. pl. washer.

NOTES
 Work this sheet with Sheet 24.

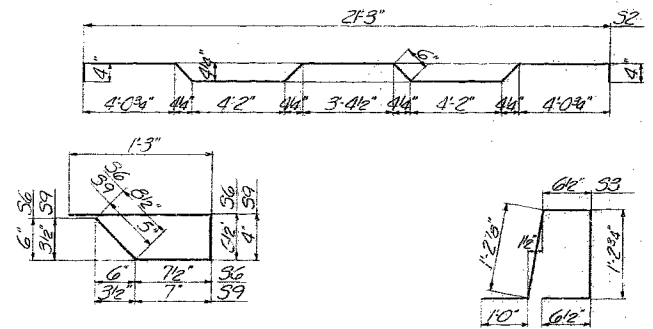

SPECIAL BENDING DETAILS

ALTERATIONS TO EXISTING FAIRFAX BRIDGE OVER MISSOURI RIVER NEAR KANSAS CITY, KANSAS FOR PLATTE COUNTY, MISSOURI

STEEL AND SLAB DETAILS

SVERDRUP AND PARCEL, INC.
 CONSULTING ENGINEERS
 ST. LOUIS, MO.

FINISHED

FINISHED

SHEET 25 OF 28

K-456A2

AS BUILT DRAWING


FINAL DESIGN DRAWING

Drawn by: H.T. Sanders, May 1956
 Checked by: G.R. Pennington, June 1956

Note: Do not scale this drawing. Follow dimensions.

342


TYPICAL BAR TYPES

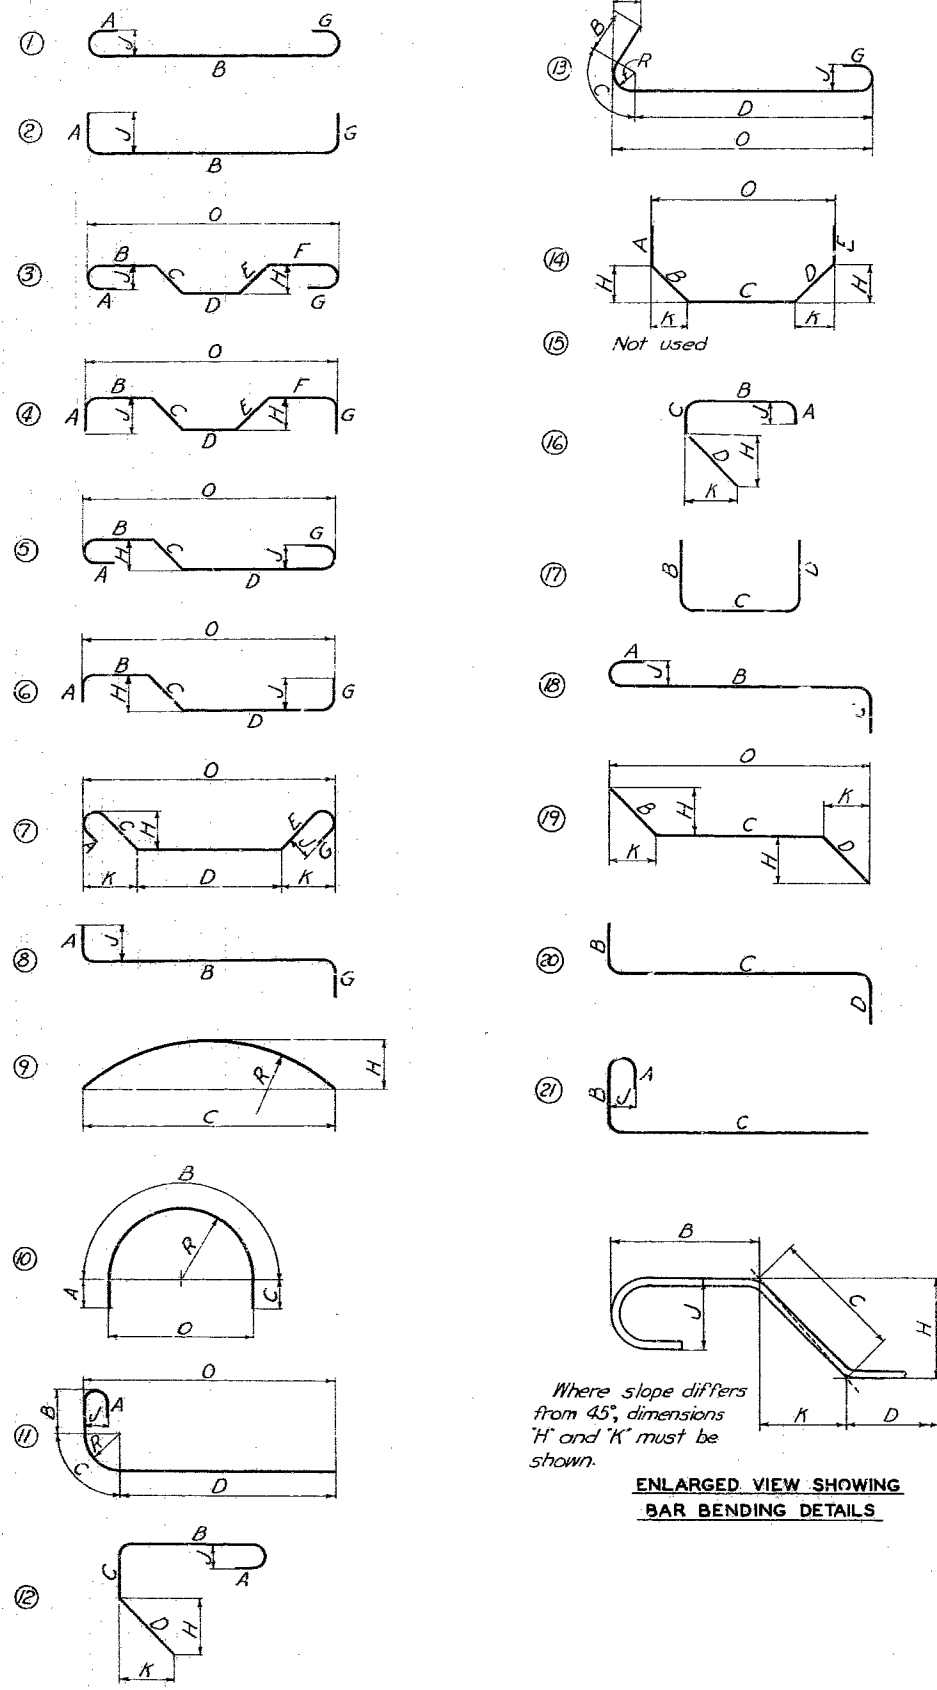


ENLARGED VIEW SHOWING BAR BENDING DETAILS

Where slope differs from 45°, dimensions "H" and "K" must be shown.


STANDARD HOOK DIMENSIONS

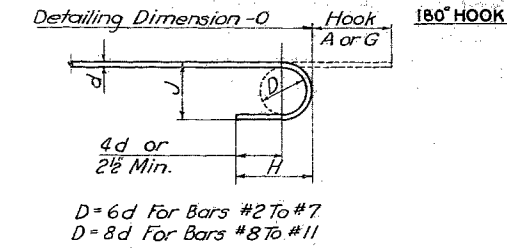

Bar Size	Hook A or G	Approx J	Approx H
#2	4"	2"	3½"
#3	5"	3"	4"
#4	6"	4"	4½"
#5	7"	5"	5"
#6	8"	6"	6"
#7	10"	7"	7"
#8	11"	10"	9"
#9	13"	11½"	10½"
#10	15"	13½"	11½"
#11	17"	15"	13½"

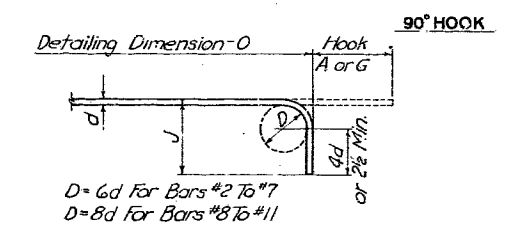

Bar Size	Hook A or G	Approx J	Approx H
#2	3"	3½"	4"
#3	3"	4"	4½"
#4	3"	4½"	5"
#5	4"	5"	6"
#6	4"	6"	7"
#7	5"	7"	9"
#8	6"	10"	11½"
#9	7"	11½"	13½"
#10	8"	13½"	15"
#11	9"	15"	17½"

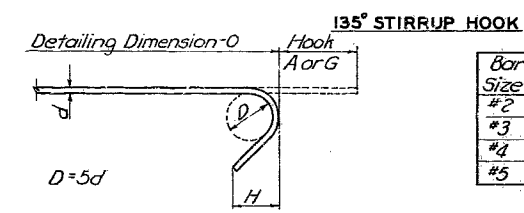

Bar Size	Hook A or G	Approx H
#2	3½"	2"
#3	4"	2½"
#4	4½"	2½"
#5	5"	2½"

BAR SIZE EQUIVALENTS

#2	6 ³ / ₈ "	#7	7 ⁵ / ₈ "
#3	5 ¹ / ₂ "	#8	1" ⁰
#4	1 ¹ / ₂ "	#9	1" ⁰
#5	5 ³ / ₈ "	#10	1 ¹ / ₂ "
#6	3 ¹ / ₂ "	#11	1 ³ / ₄ "

NOTES

- All dimensions are out to out, except "R" which is to inside of bend.
- "J" Dimension on 180° hooks to be shown in Bar List only when necessary to restrict hook size, otherwise standard hooks are to be used.
- Where "J" is not shown, "J" will be kept equal to or less than "H". Where "J" can exceed "H", it should be shown in Bar List.
- "H" Dimension on stirrups to be shown on Bar List where necessary to restrict hooks.
- Corrections in length, due to bending around a mandrel, will be made only when the radius "R" (as in types 11 and 13) exceeds the standard radii indicated in standard hook dimensions. However, the dimensions "A" or "G" shown for standard hooks have been corrected for curvature.
- All bends shown are bent around a standard mandrel, except where radius "R" is indicated.
- Figures in circles show bar types.
- Where "R" is shown on bar types 9, 10, 11 and 13, the length of bend shall be measured along outside of bend. The length of bar type T-3 shall also be measured along outside of bar.

ALTERATIONS TO EXISTING FAIRFAX BRIDGE OVER MISSOURI RIVER NEAR KANSAS CITY, KANSAS FOR PLATTE COUNTY, MISSOURI:

STANDARD BAR TYPES AND HOOK DIMENSIONS

SVERDRUP AND PARCEL, INC. CONSULTING ENGINEERS ST. LOUIS, MO.


1259 Drawn by: A. Anita, Dec. 1951
 251/69 Checked by: L. Glaser, Dec. 1951
 Checked by: W. Littlefield, Jan. 1953
 Revised: Feb., 1953

MISSOURI HIGHWAY AND TRANSPORTATION COMMISSION

State	Proj. No.	Sheet No.
MO		B 1
Sec./Sur. 8	Twp. 50N Rge. 33W	


Wyandotte County, KS

Platte County, MO

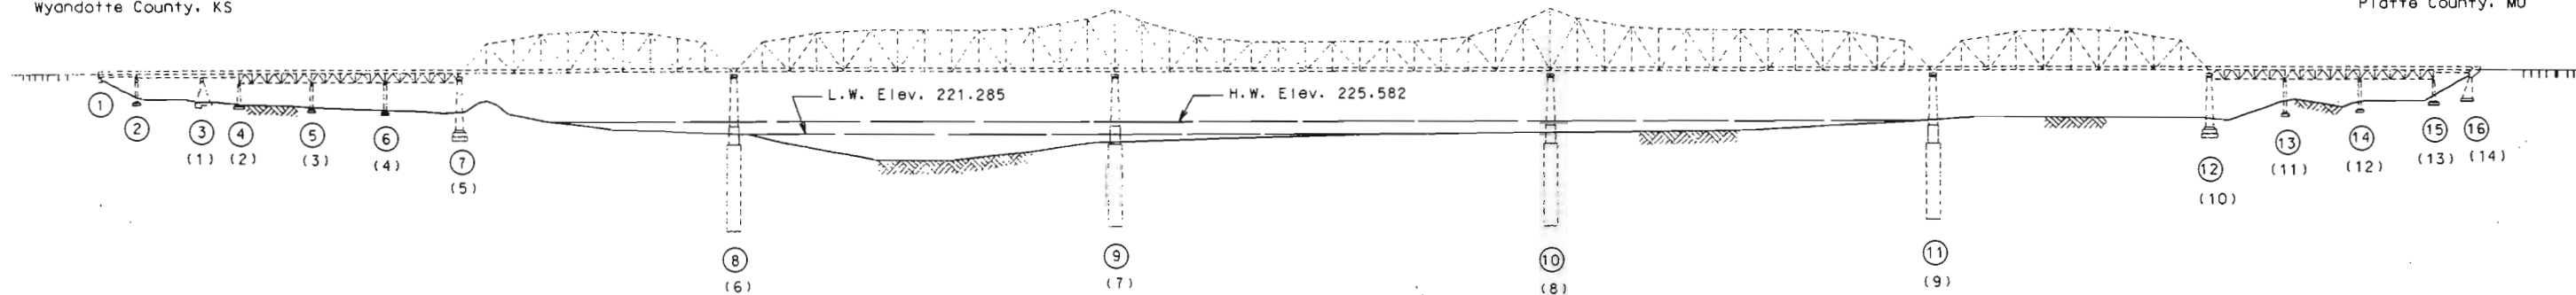

GENERAL ELEVATION

Bent and pier numbers in parentheses indicate numbering of bents and piers prior to rehabilitation of bridge in 1957 (addition of two bents).

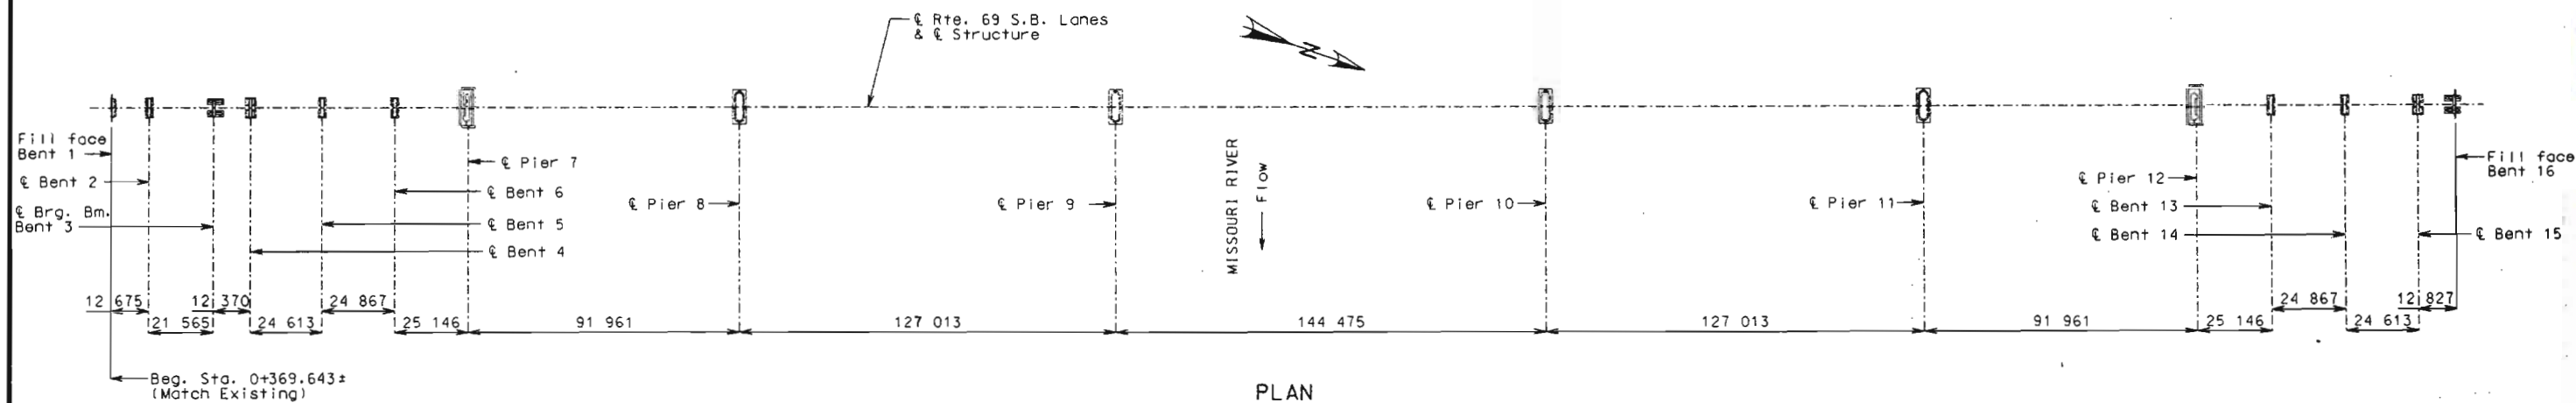

Note: See sheet no. 2 for Estimated Quantities and General Notes.

REPAIRS TO BRIDGE OVER MISSOURI RIVER FAIRFAX BRIDGE AT RIVERSIDE

STATE ROAD FROM PLATTE COUNTY, MO
TO WYANDOTTE COUNTY, KS

PROJECT NO. STA. 0+369.643±
JOB. NO. J4U1292 RTE. 69 S.B.L

PLATTE COUNTY

STD. M706.35
K04563

Designed Oct. 1998
Detailed Oct. 1998
Checked July 1999

GENERAL NOTES:

Design Specifications:
AASHTO - 1996 and Interims thru 1998
Load Factor Design (Slab Replacement)

Design Loading:
MS18

Design Unit Stresses:
Class B Concrete (Substructure) f'c = 21 MPa
Class B1 Concrete (Barrier End Post) f'c = 28 MPa
Class B2 Concrete (Slab Replacement) f'c = 28 MPa
Reinforcing Steel (Grade 420) fy = 420 MPa
Structural Carbon Steel (ASTM A709M Grade 250) fy = 250 MPa

Reinforcing Steel:
Minimum clearance to reinforcing steel shall be 40 mm, unless otherwise shown.

Miscellaneous:
A minimum vertical clearance of 6500 mm from top of rails and a minimum lateral clearance of 3800 mm from track to nearest temporary construction falsework shall be maintained during construction.
Roadway surfacing adjacent to bridge ends to match new bridge overlay.
Structure to be closed to traffic during construction. See roadway plans for traffic control during construction.
High strength bolts, nuts and washers will be sampled for quality assurance as specified in Section 106 of the Missouri Standard Specifications (Metric) and Field Section (FS-712) from Materials Manual.

Dimensions:
All dimensions are shown in millimeters (mm) unless otherwise specified.
Drawings are not to scale. Follow dimensions.
All elevations are specified in meters except as noted.

Old work:
Outline of old work is indicated by light dashed lines.
Heavy lines indicate new work.

Maintain Grade:
In order to maintain grade and a minimum thickness of overlay as shown on plans, it may be necessary to use additional quantities of overlay at various locations throughout the structure. No payment will be allowed for additional labor, materials, or equipment for variations in thickness of overlay.

Verify Dimensions:
Contractor shall verify all dimensions in field before ordering materials.

Bars Bonded in Old Concrete:
Bars bonded in old concrete not removed shall be cleanly stripped and embedded into new concrete where possible. If length is available, old bars shall extend into new concrete at least 40 diameters for smooth bars and 30 diameters for deformed bars, unless otherwise noted.

Structural Steel:
Fabricated structural steel shall be ASTM A709M Grade 250 except as noted.

Coating:
Protective Coating: System G by the contractor. (See Special Provisions.)
All exposed steel including form pans and steel grid shall be prepared, prime coated, intermediate coated and finish coated.
Prime Coat: The cost of the prime coat shall be included in the contract unit price per lump sum of Field Application of Inorganic Zinc Primer. Tint of the prime coat for System G shall be similar to the color of the field coat to be used.
Existing structural steel exposed by the herein described removals which will become inaccessible in the completed rehabilitated structure shall be prepared and coated with a prime coat of the specified coating system while exposed.
Field Coat: The color of the finish coat shall be Gray (Federal Standard #26373). The cost of the intermediate coat shall be included in the contract unit price per lump sum of Intermediate Field Coat (System G) Gray. The cost of the finish coat shall be included in the contract unit price per lump sum of Finish Field Coat (System G) Gray.

ESTIMATED QUANTITIES				
ITEM		SUBSTR.	SUPERSTR.	TOTAL
Asphalt Removal (Bridges)	sq. meter		5083.7	5083.7
Partial Removal of Existing Steel Grid Deck	sq. meter		256.9	256.9
Remove & Replace Dam Angle @ Open Curb Areas	meter		1053.5	1053.5
Remove and Replace End Posts	each		2	2
Partial Removal of Substructure Concrete	lump sum	1		1
Temporary Falsework	lump sum	1		1
Alternate Asphaltic Concrete Wearing Surface (Bridge)	sq. meter		4847	4847
Polymer Modified Asphalt (Seal Coat)	Liter		8250	8250
Cover Aggregate	Megagram		73	73
Class B Concrete (Substr)	cu. meter	8.6		8.6
Substructure Repair (Formed)	sq. meter	15.0		15.0
Substructure Repair (Unformed)	sq. meter	60.0		60.0
Protective Coating - Concrete Bents (Deleterious Agents)	lump sum	1		1
Slab on Steel	sq. meter		257	257
Concrete Repair in Steel Grid Deck	sq. meter		50.0	50.0
Strip Seal Expansion Device (@ Bent No. 3)	meter		6.5	6.5
Strip Seal Expansion Device (@ Bents No. 5 & 14)	meter		13.0	13.0
Navigation Lighting System	lump sum		1	1
Reinforcing Steel (Epoxy Coated)	kilogram	975		975
Expansion Device (Finger Plate) (@ Piers No. 7 & 12)	meter		13.0	13.0
Expansion Device (Finger Plate) (@ Piers No. 8 & 11)	meter		13.0	13.0
Expansion Device (Finger Plate) (@ Panel Point L19)	meter		6.5	6.5
Steel Curb	meter		79.5	79.5
Remove & Replace Rail Tubes	meter		49.0	49.0
Existing Diaphragm Connections to Flange	lump sum		1	1
Surface Preparation for Recoating Structural Steel	lump sum		1	1
Field Application of Inorganic Zinc Primer	lump sum		1	1
Transporting Lead Contaminated Residue to Storage Area	lump sum		1	1
Transporting Lead Contaminated Residue to the Smelter	lump sum		1	1
Disposal of Lead Contaminated Residue	lump sum		1	1
Intermediate Field Coat (System G) Gray	lump sum		1	1
Finish Field Coat (System G) Gray	lump sum		1	1

Estimated Quantities for Alternate Asphaltic Concrete Wearing Surface				
Type of Wearing Surface	Asphaltic Binder (Megagram)	Mineral Aggregate (Megagram)	SM Fibers (kilogram)	Mix Used (✓)
SP125MCSM Mix	29.9	445	1468	
SP125MCLP Mix	26.9	439	N/A	

MoDOT construction personnel shall complete column labeled "Mix Used (✓)".
Type PG 70-22 asphalt binder is required in the asphaltic concrete mix for the bridge deck overlay.
The polymer modified asphalt shall be applied at the rate of 1.7 liters per square meter.
The cover aggregate shall be applied at a rate of 15.0 kg per square meter.


Estimated Quantities for Slab on Steel		
Item		Total
Reinforcing Steel (Epoxy Coated)	kilogram	10 700
Concrete	cu. meter	45.5

The table of Estimated Quantities for Slab on Steel represents the quantities used by the state in preparing the cost estimate for concrete slabs. Variations may be encountered in these estimated quantities, but these variations cannot be used for an adjustment in the contract unit price per square meter of Slab on Steel.




Note: Contractor shall protect existing 305 mm gas line and maintain navigation lighting system during construction.


QUANTITIES & GENERAL NOTES

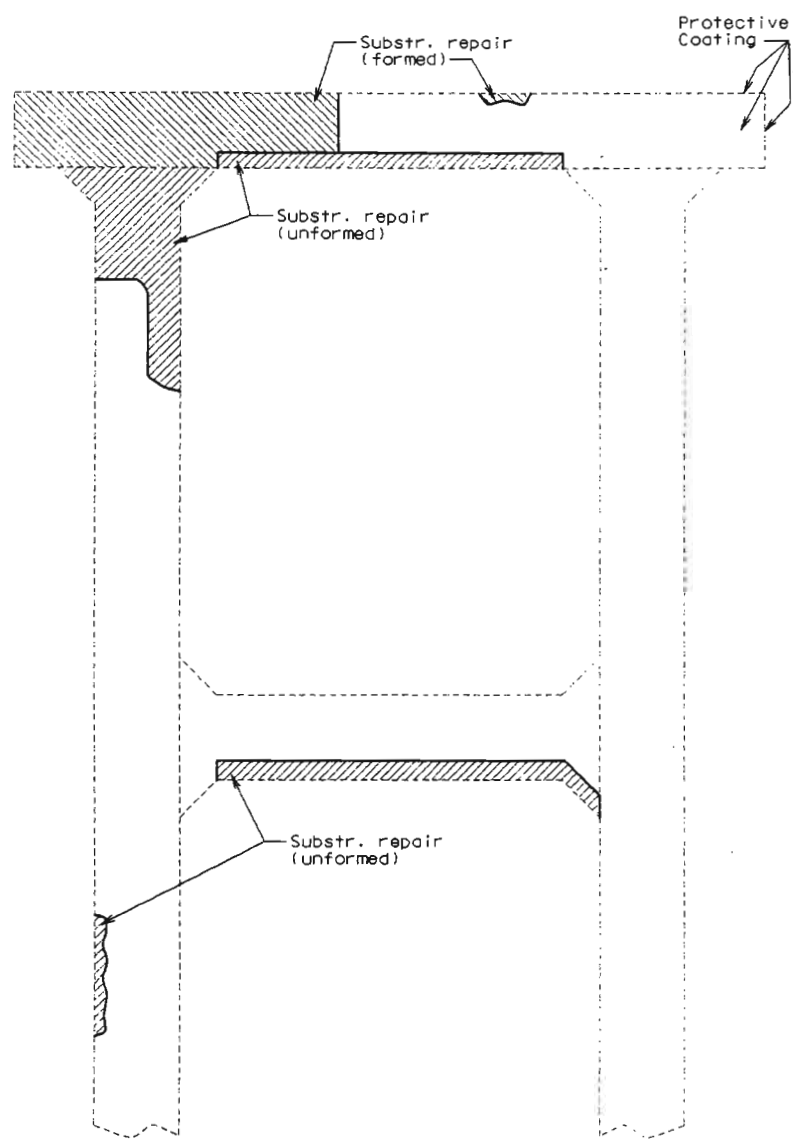


PART ELEVATION OF BENT 5
SHOWING SUBSTRUCTURE REPAIR

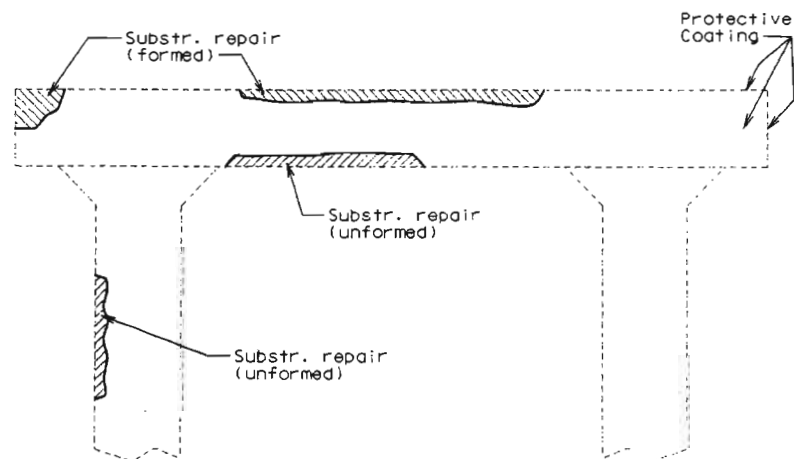


PART ELEVATION OF BENTS 4, 6, 13, & 15
SHOWING SUBSTRUCTURE REPAIR

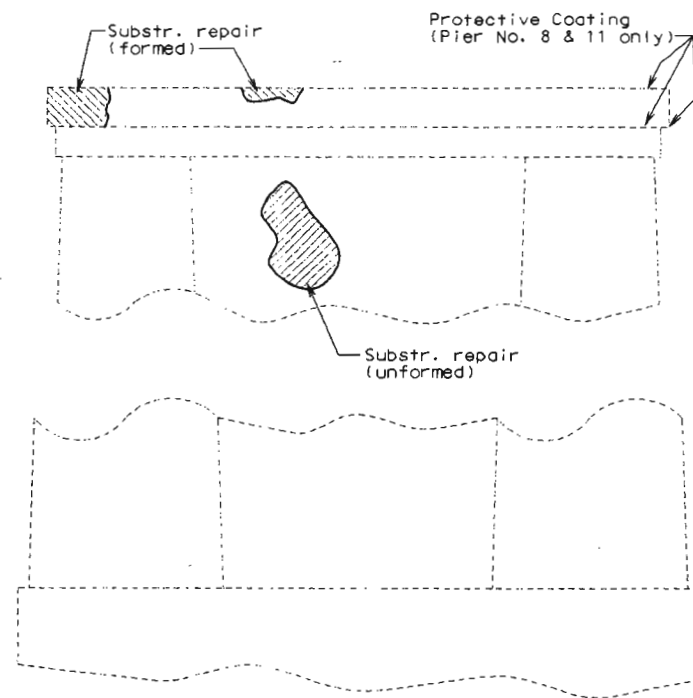

PART ELEVATION OF PIERS 8 THRU 11
SHOWING SUBSTRUCTURE REPAIR

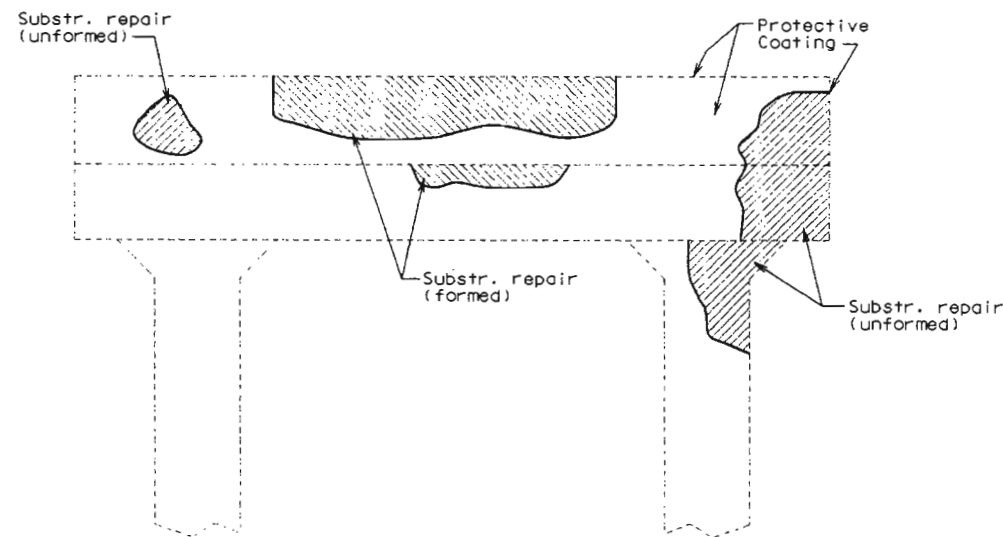

PART ELEVATION OF BENT 2
SHOWING SUBSTRUCTURE REPAIR

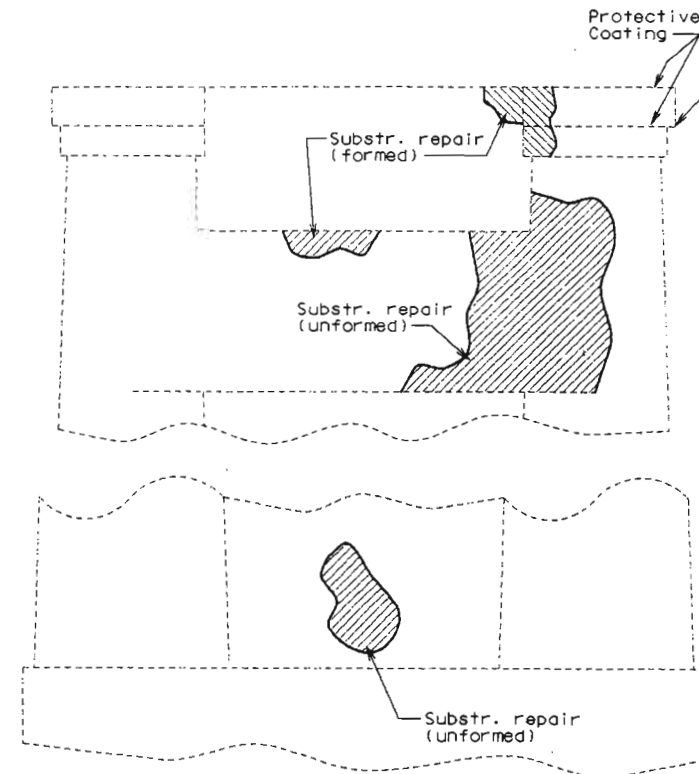

PART ELEVATION OF PIERS 7 & 12
SHOWING SUBSTRUCTURE REPAIR

Estimated Quantities for
Substructure Repair
(Formed and Unformed)

Location	Area (sq. meters)
Bent No. 1	0.6
Bent No. 2	9.5
Bent No. 3	2.8
Bent No. 4	0.4
Bent No. 5	16.1
Bent No. 6	10.6
Pier No. 7	11.1
Pier No. 8	0.7
Pier No. 9	2.2
Pier No. 10	1.7
Pier No. 11	0.1
Pier No. 12	0.2
Bent No. 13	3.2
Bent No. 14	7.7
Bent No. 15	8.1
Bent No. 16	0.0
Total	75.0


Note: The table of Estimated Quantities for Substructure Repair (Formed and Unformed) represents the quantities used by the state in preparing the cost estimate for substructure repairs. Variation may be encountered in these estimated quantities, but these variations cannot be used for an adjustment in the contract unit price per square meter of Substructure Repair (Formed) or Substructure Repair (Unformed).

Some typical substructure repair areas are shown here. Actual repair areas shall be designated by the Engineer.


Clean and seal all areas of substructure caps at Bent/Pier Nos. 2, 3, 4, 5, 6, 7, 8, 11, 12, 13, 14 & 15.



DATE 8-20-99

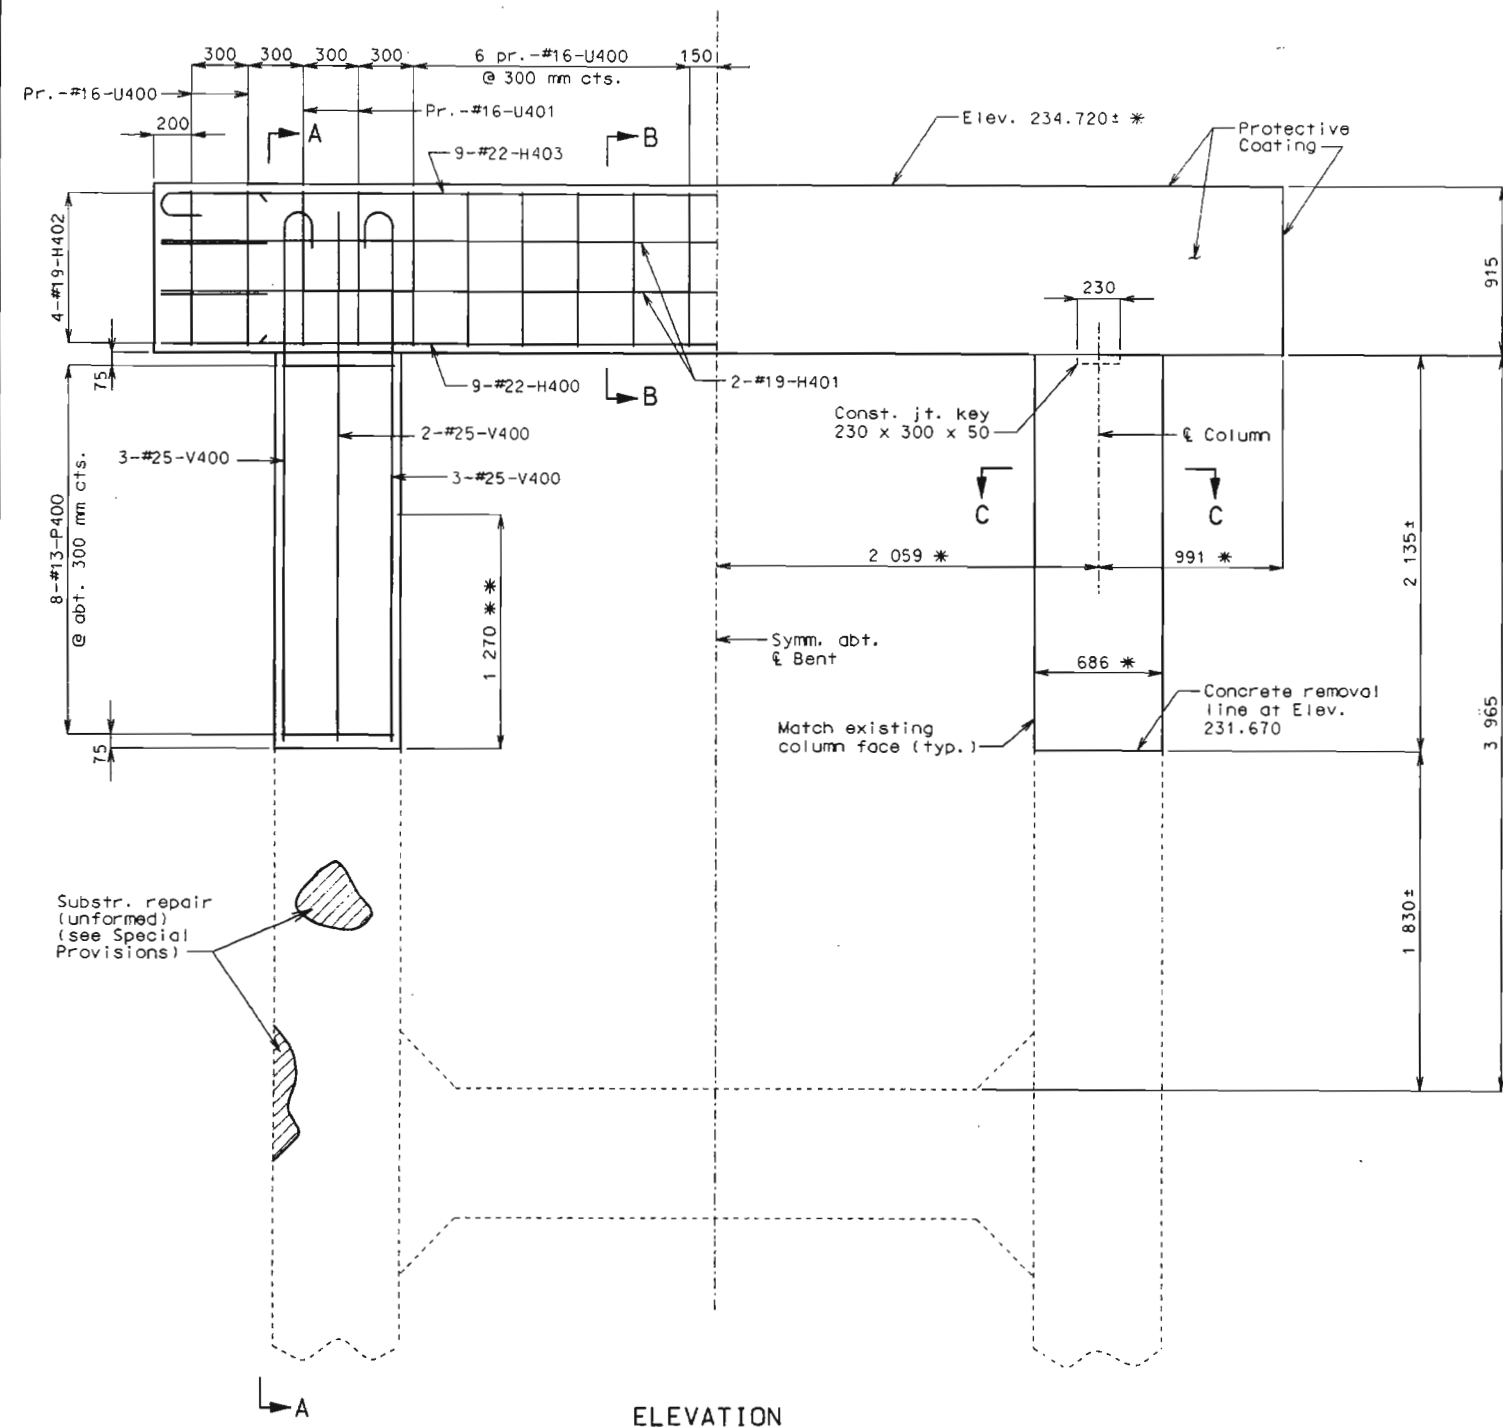

ELEVATION

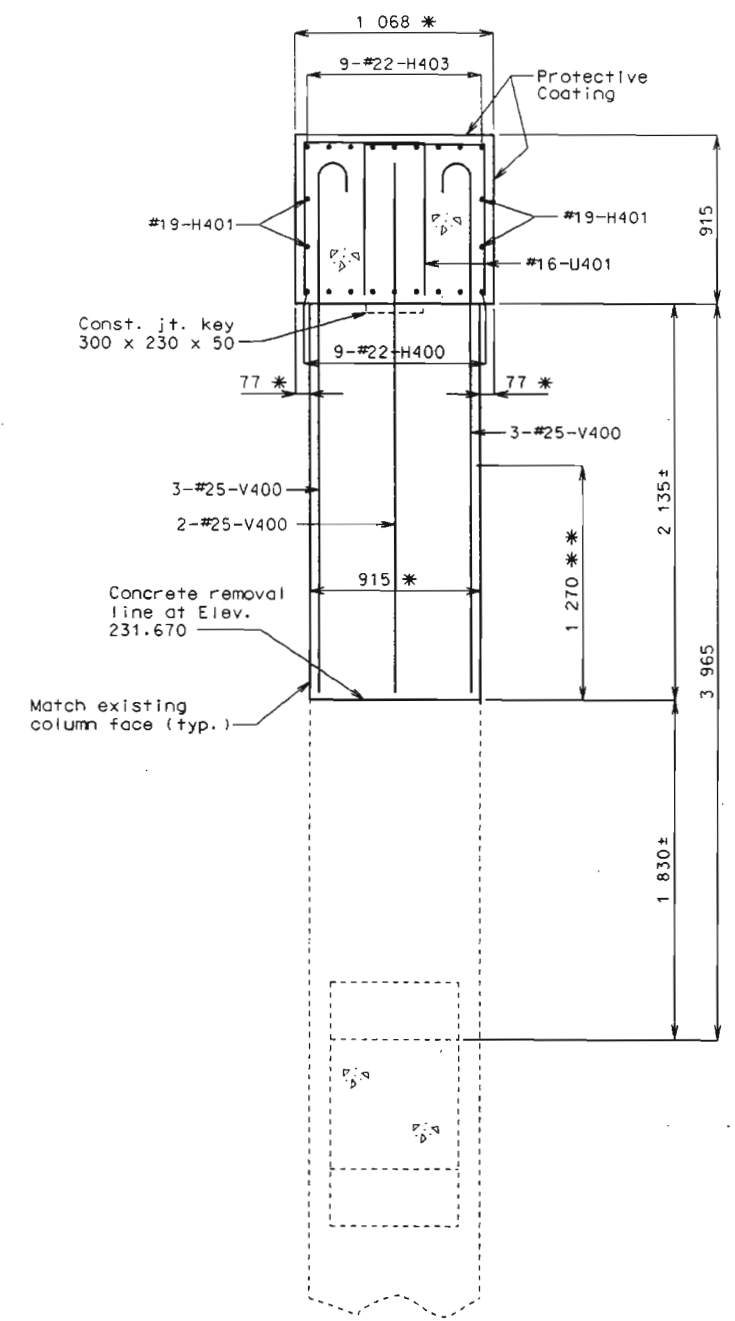

SECTION A-A

* Match existing.
 ** Cut off existing vertical bars with 1270 mm projection into new column concrete and lap with new #25-V400 bars.
 For Sections B-B and C-C, see sheet no. 5.
 For Plan of Beam, see sheet no. 5.
 Contractor shall provide temporary falsework to support approximately 321 kN at the end of each deck truss (total load = 321 x 4 = 1284 kN) during rehabilitation of Bent No. 14. See Special Provisions.



SUBSTRUCTURE QUANTITY TABLE FOR BT. NO. 14		
ITEM		QUANTITY
Partial Removal of Substructure Concrete	lump sum	1
Temporary Falsework	lump sum	1
Class B Concrete (Substr)	cu. meter	8.6
Reinforcing Steel (Epoxy Coated)	kg	975

These quantities are included in the estimated quantities table on sheet no. 2.





Detailed Sept 1998
 Checked July 1999

DETAILS OF BENT NO. 14 REHABILITATION

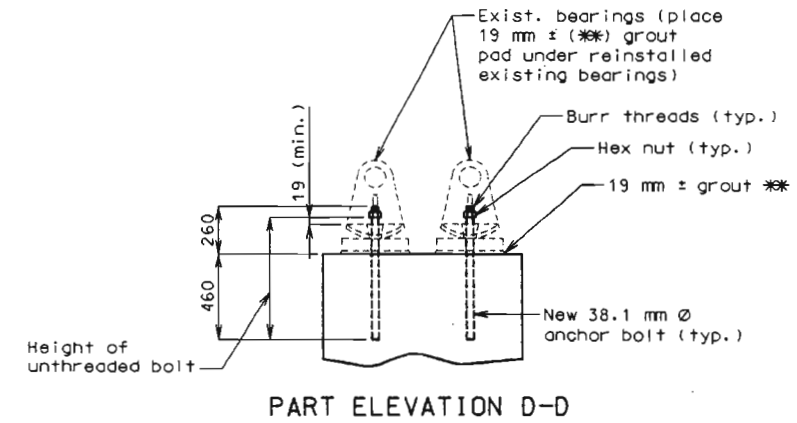
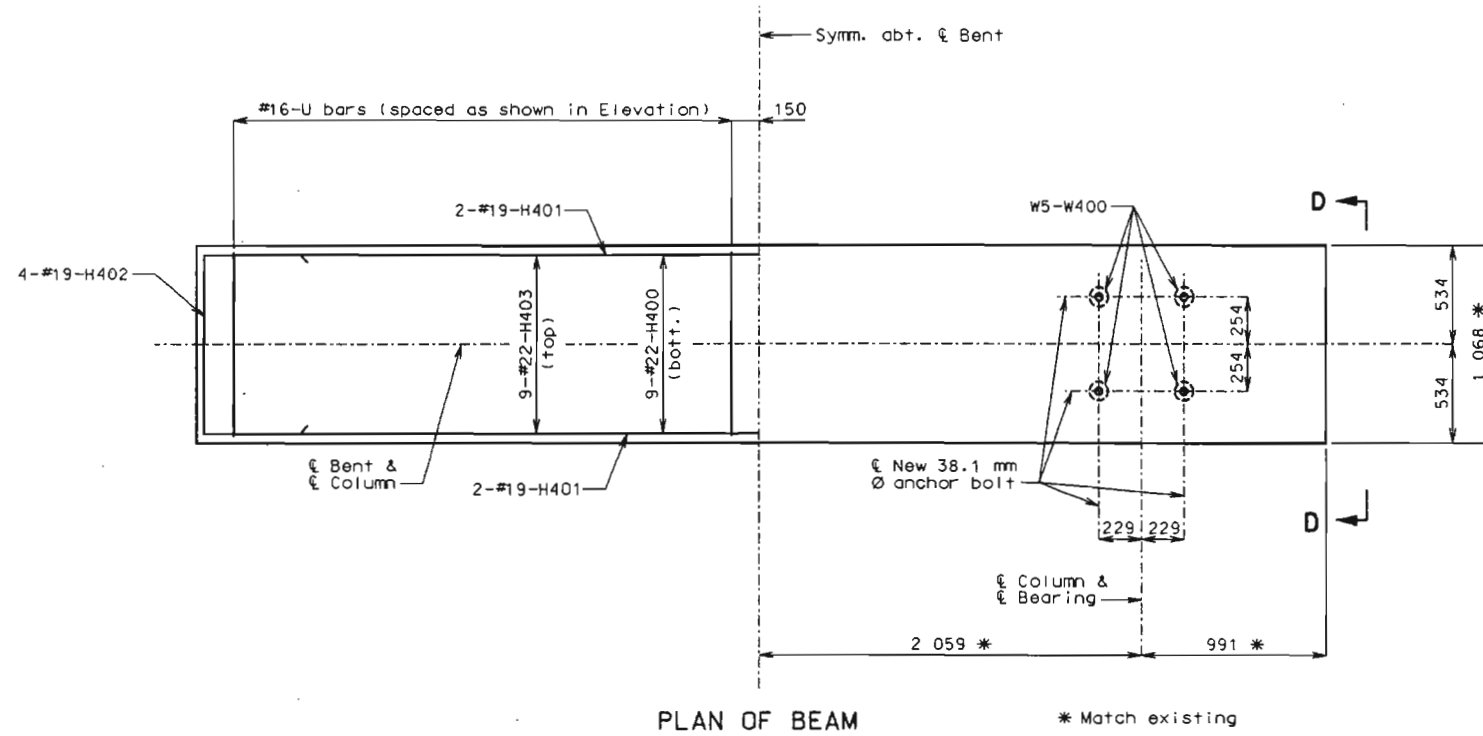


** Grout under bearing as required to maintain grade of roadway surface.

Note: Secure bearings with a hex nut per anchor bolt. The hex nut shall clear the rocker casting by 19 mm min.

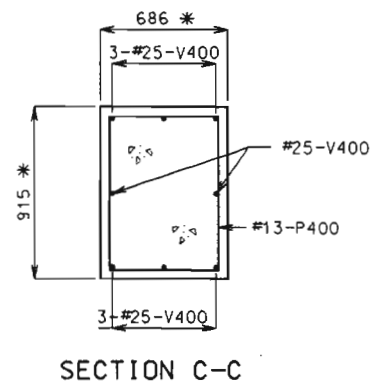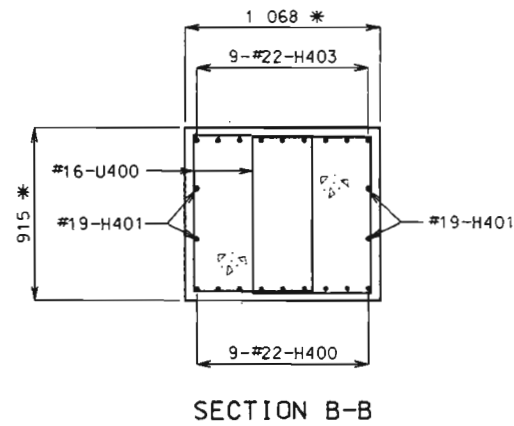

Note: For location of Sections B-B and C-C, see sheet no. 4.

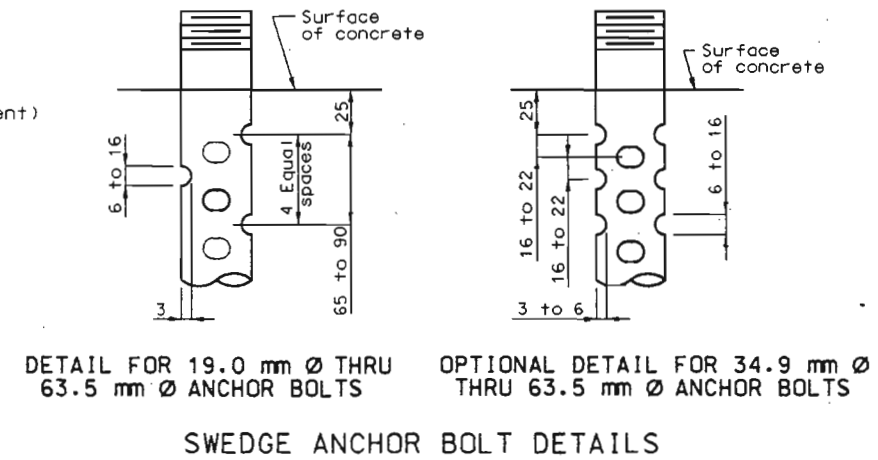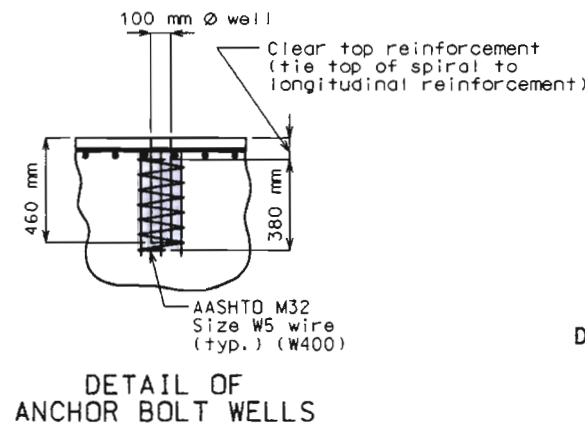

Anchor bolts shall be 38.1 mm diameter ASTM A709M Grade 345W steel swedged bolts and shall extend 380 mm into the concrete with ASTM A194M-2, 2H, or ASTM A563M-C, D, DH, DH3 heavy hexagon nuts. Actual manufacturer's certified mill test reports (chemical and mechanical) shall be provided. Swedging shall be 25 mm less than the extension into the concrete.


All structural steel for the anchor bolts and heavy hexagon nuts shall be coated with a minimum of two coats of inorganic zinc primer (125 micrometers minimum thickness) or galvanized in accordance with ASTM A153.

Cost of anchor bolts, hardened washers and heavy hexagon nuts for bearings shall be included in the price bid for Class B Concrete.






DATE 8-20-99


DETAILS OF BENT NO. 14 REHABILITATION

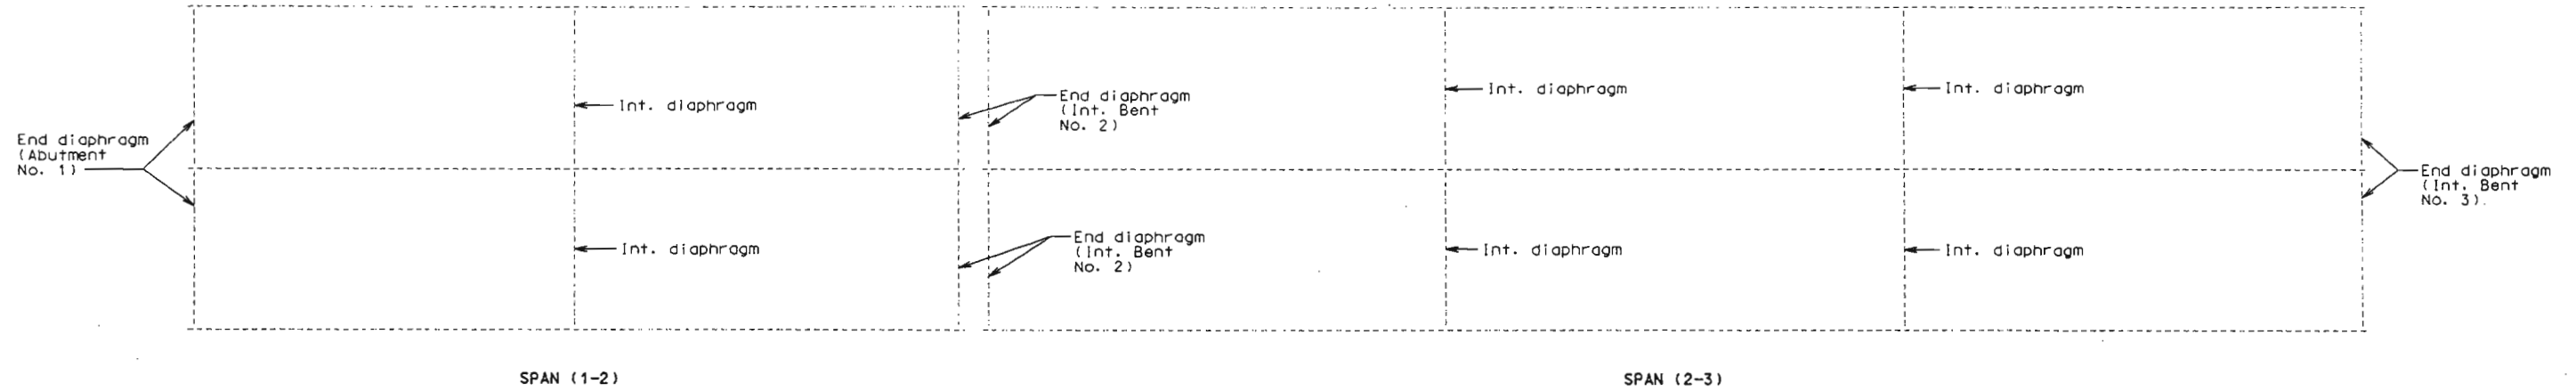


PART PLAN

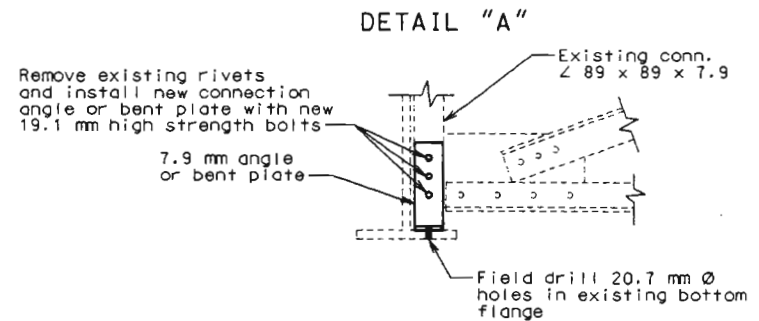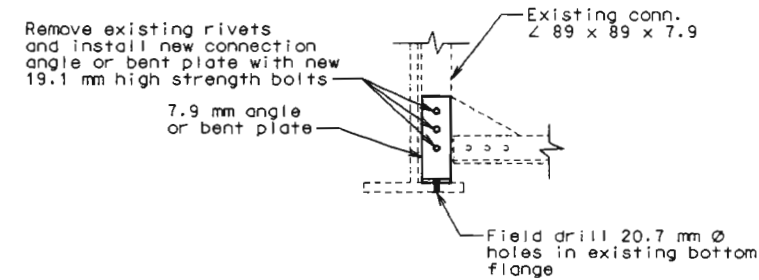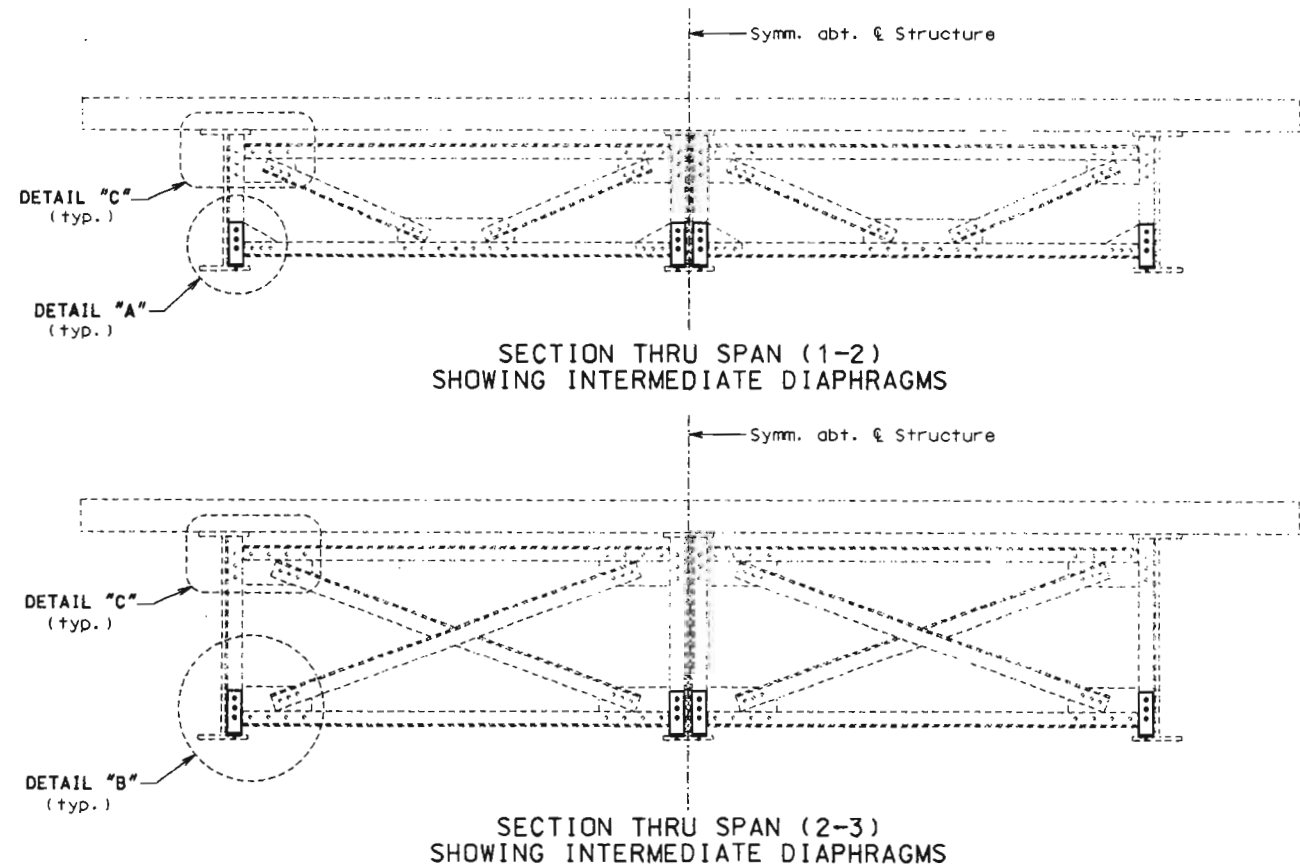

DETAIL "B"

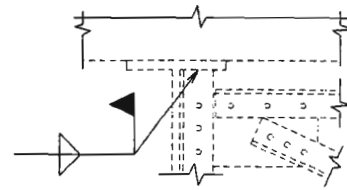

DETAIL "C"

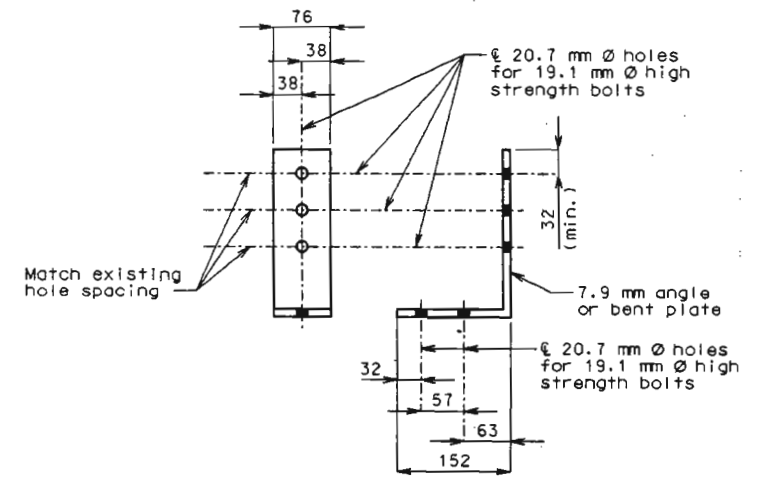


DETAILS OF 7.9 mm CLIP ANGLE OR BENT PLATE (12 REQ'D)

DETAILS OF EXISTING DIAPHRAGM CONNECTIONS TO FLANGE

Detailed May 1999
Checked July 1999



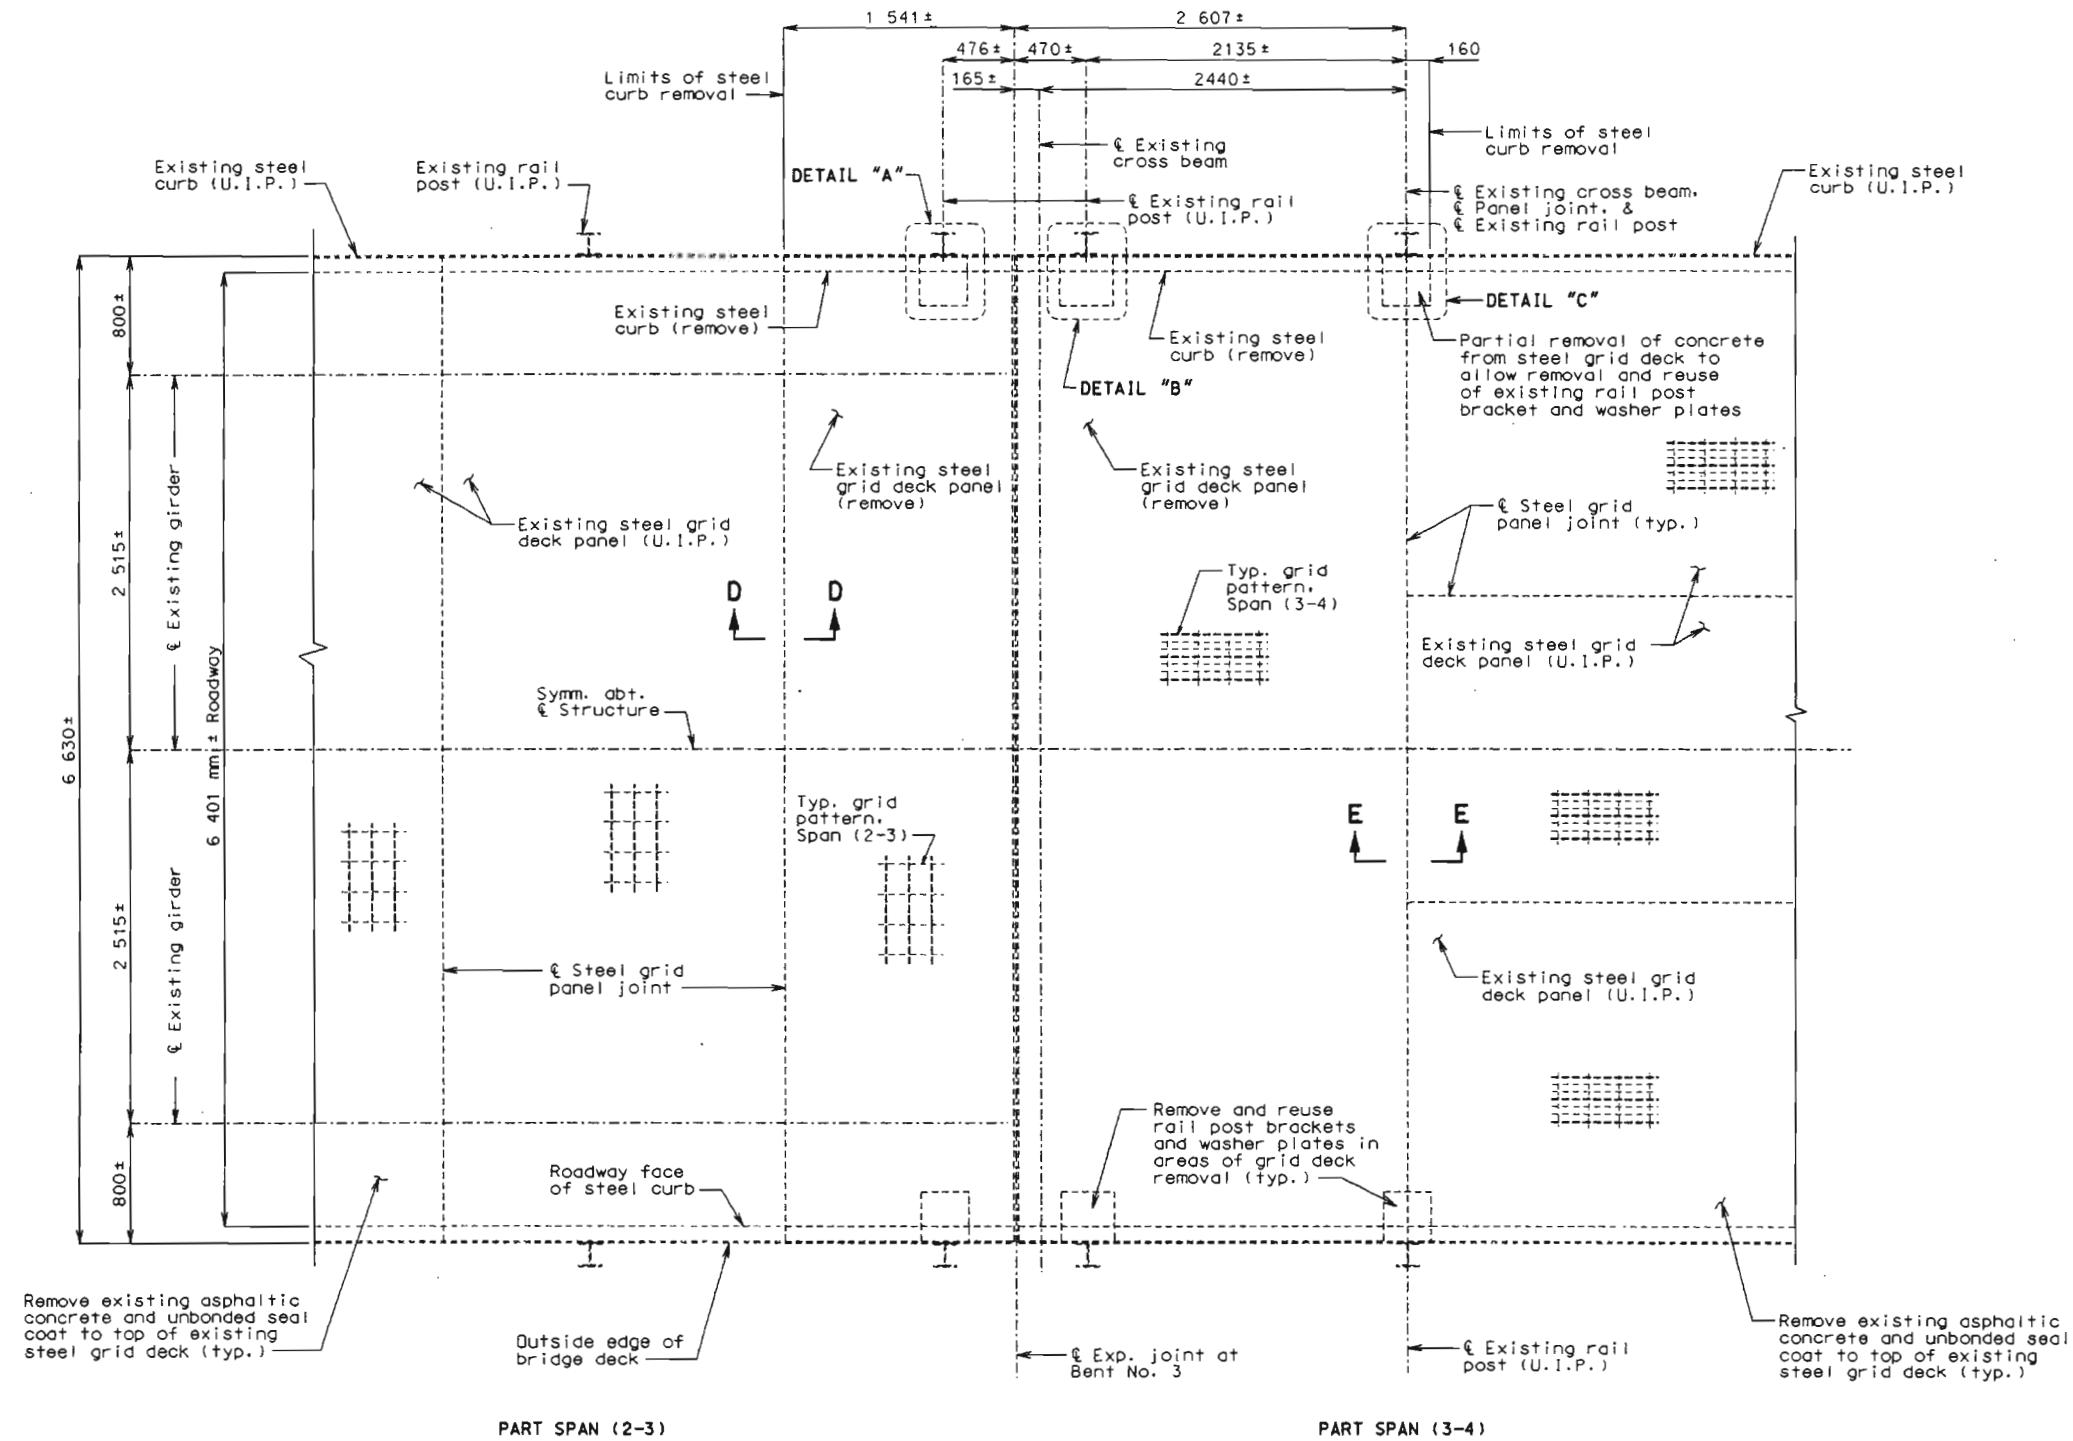

PART PLAN OF EXISTING DECK

Note: Removed rail post brackets and washer plates shall be cleaned and coated with a prime coat of the specified coating system before reinstallation with the new slab.

Payment for the removal of steel curb, rail post brackets and washer plates, as designated on the plans, shall be included in the contract unit price for Partial Removal of Existing Steel Grid Deck.

Note: For Details "A", "B", & "C" and Sections D-D & E-E, see sheet no. 8.



DATE 8-20-99


DETAILS OF DECK REMOVAL AT BENT NO. 3

Detailed June 1999
Checked July 1999

Sheet No. 7 of 46


PLATTE COUNTY

K04563

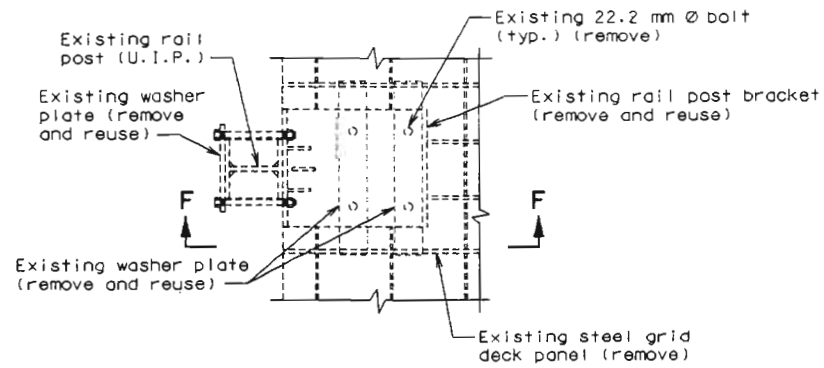


DETAIL "A"

(Rotated 90° counterclockwise)
Note: Steel curb not shown for clarity.

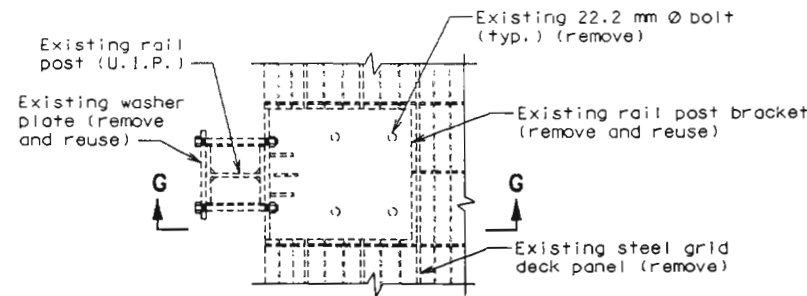


DETAIL "B"

(Rotated 90° counterclockwise)
Note: Steel curb not shown for clarity.

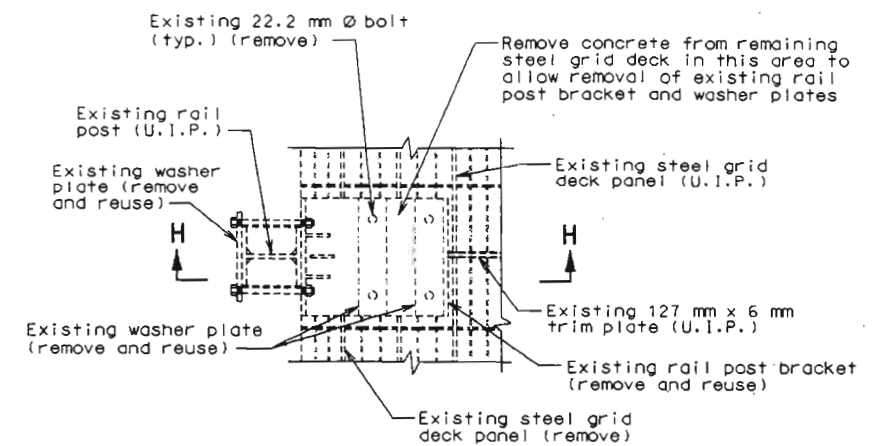


DETAIL "C"

(Rotated 90° counterclockwise)
Note: Steel curb not shown for clarity.

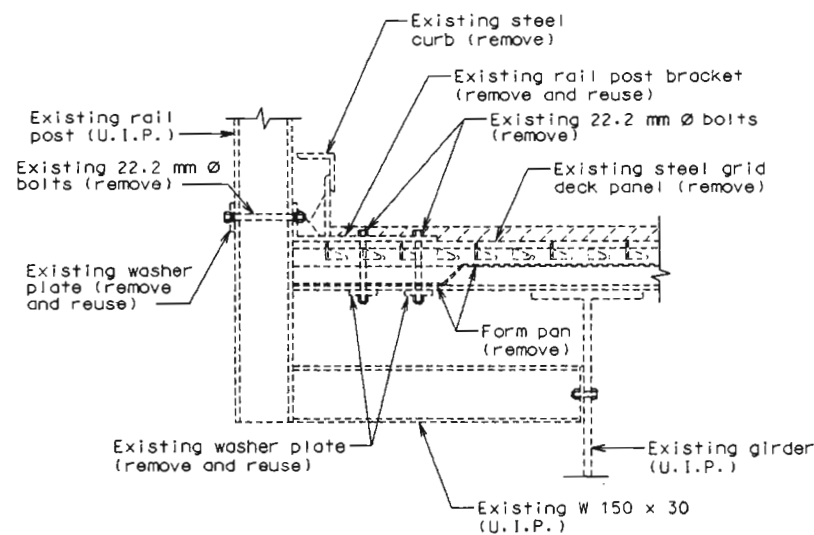


SECTION F-F

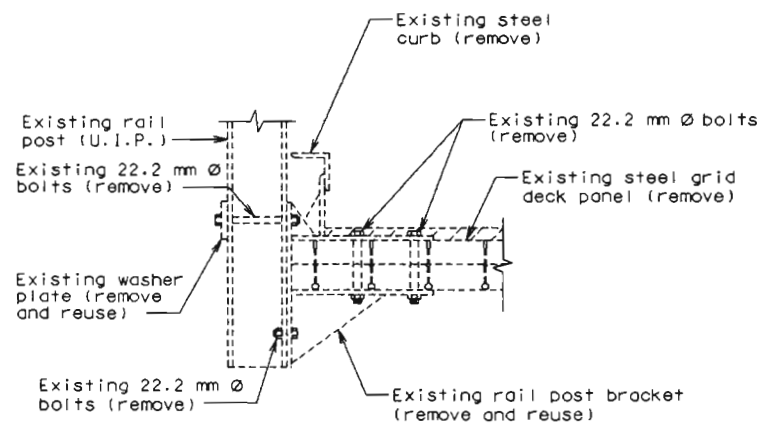


SECTION G-G

Note: For location of Details "A", "B", and "C", see sheet no. 7.


For location of Sections D-D and E-E, see sheet no. 7.

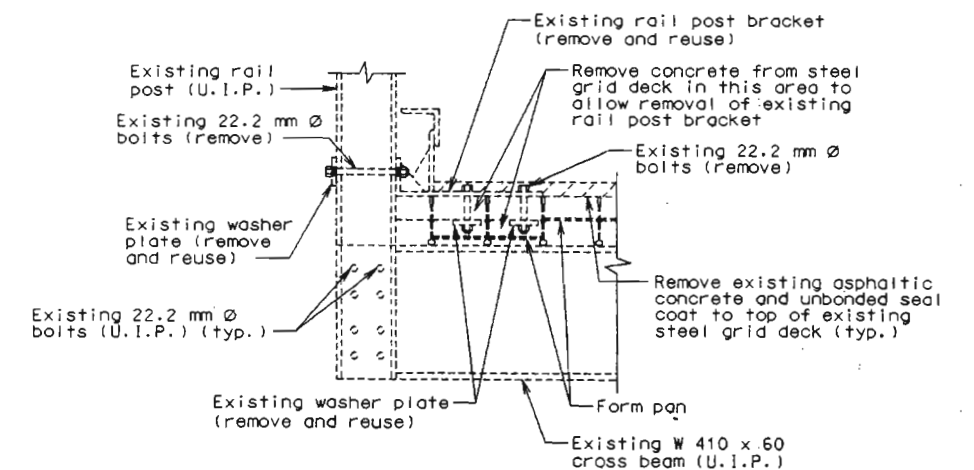


SECTION H-H

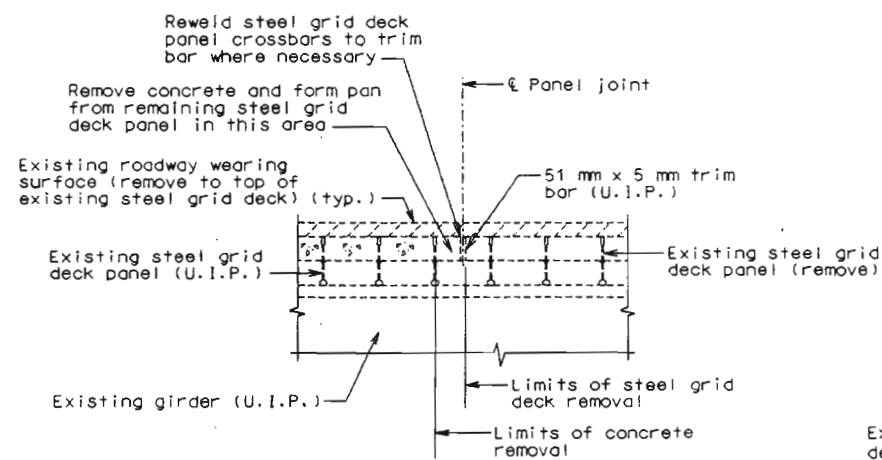

SECTION D-D

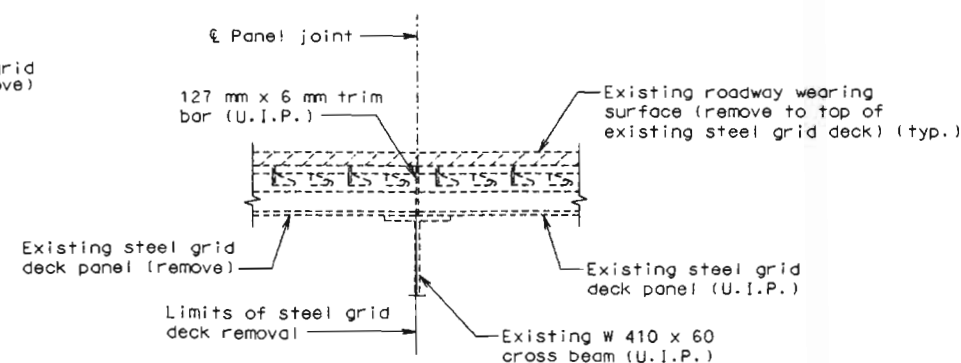


SECTION E-E
DETAILS OF DECK REMOVAL AT BENT NO. 3

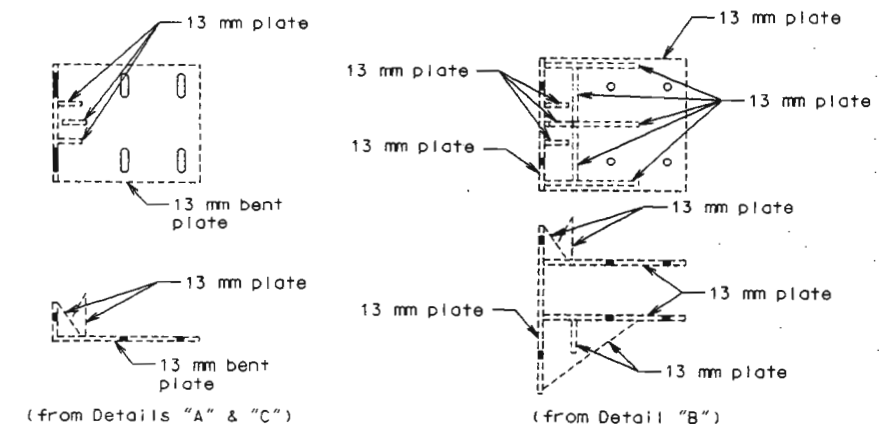

DETAILS OF RAIL POST BRACKETS
(Remove and reuse with new slab)



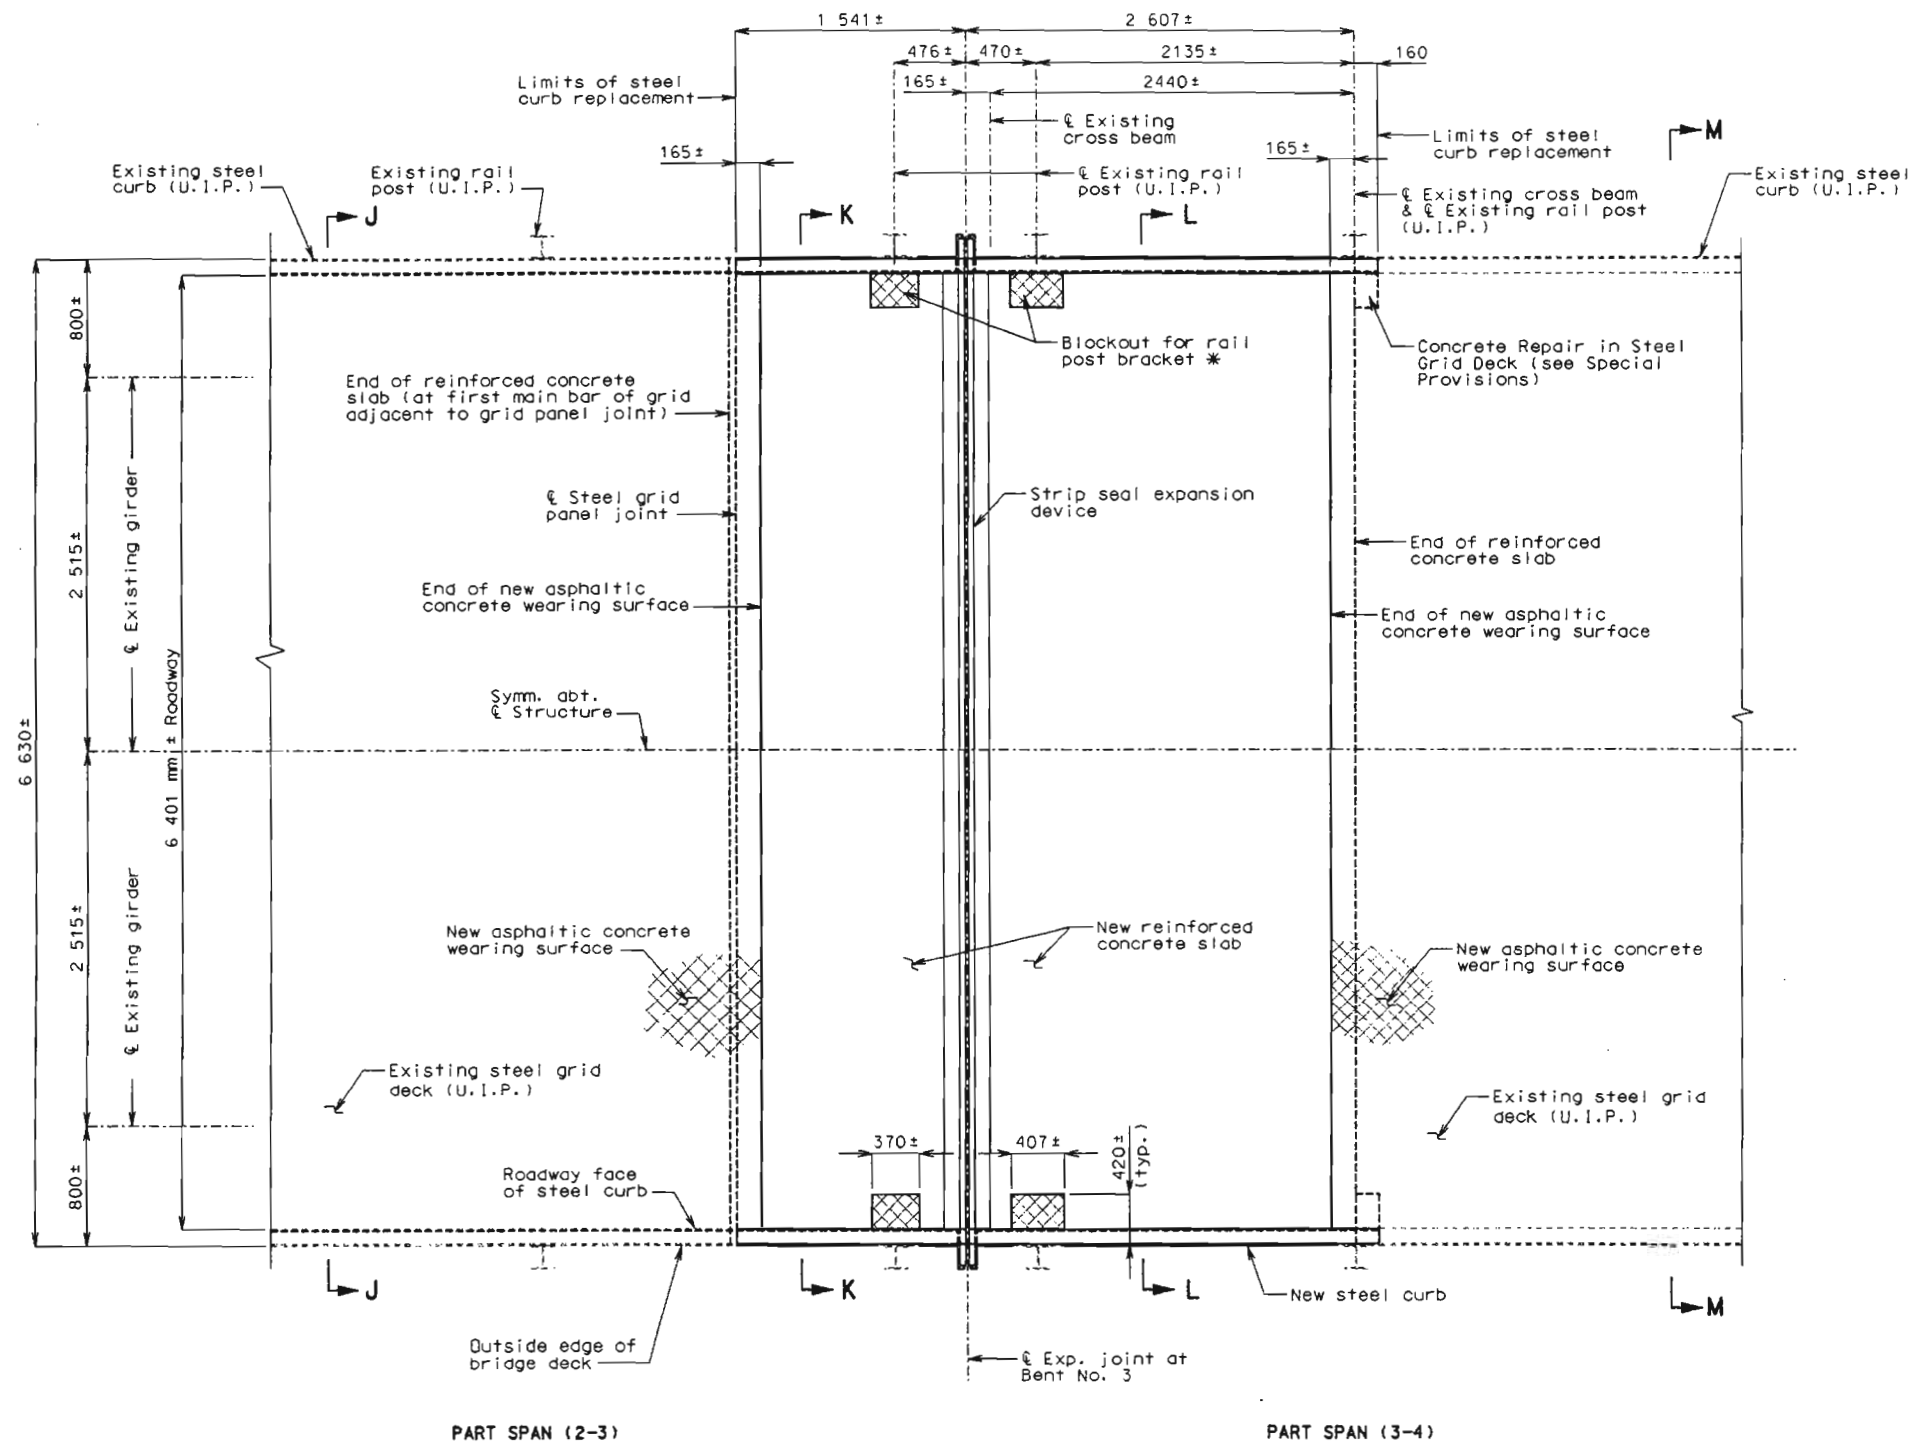

Note: For Sections J-J and M-M, see sheet no. 14.
 For Sections K-K and L-L, see sheet no. 12.
 For longitudinal section thru new reinforced concrete slabs, see sheet no. 11.
 For details of strip seal expansion device, see sheet no. 10.
 For details of new steel curb and rail post attachments, see sheet no. 13.

* Blockout to be filled with asphaltic concrete after installation of rail post bracket.
 Details for steel curb replacement have been developed based on available plans and on using the existing rail posts in their present locations. The contractor shall verify the existing rail post locations before ordering steel curb replacement.

Payment for the reinstatement of the existing rail post brackets and washer plates with new H.S. bolts, hex nuts, and washers shall be included in the contract unit price for Slab on Steel.
 Payment for furnishing and installing new steel curb with anchor bolts, hex nuts, and washers shall be included in the contract unit price for Steel Curb.

PART PLAN

DETAILS OF DECK REPLACEMENT AT BENT NO. 3





DATE 8-20-99

Detailed June 1999
 Checked July 1999


Sheet No. 9 of 46

PLATTE COUNTY

K04563

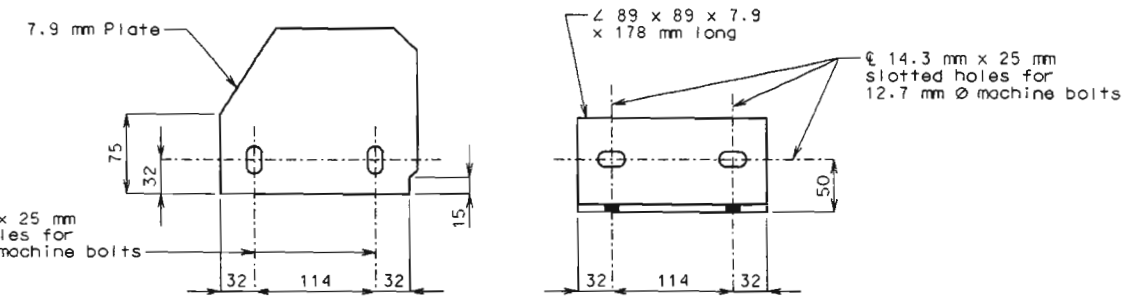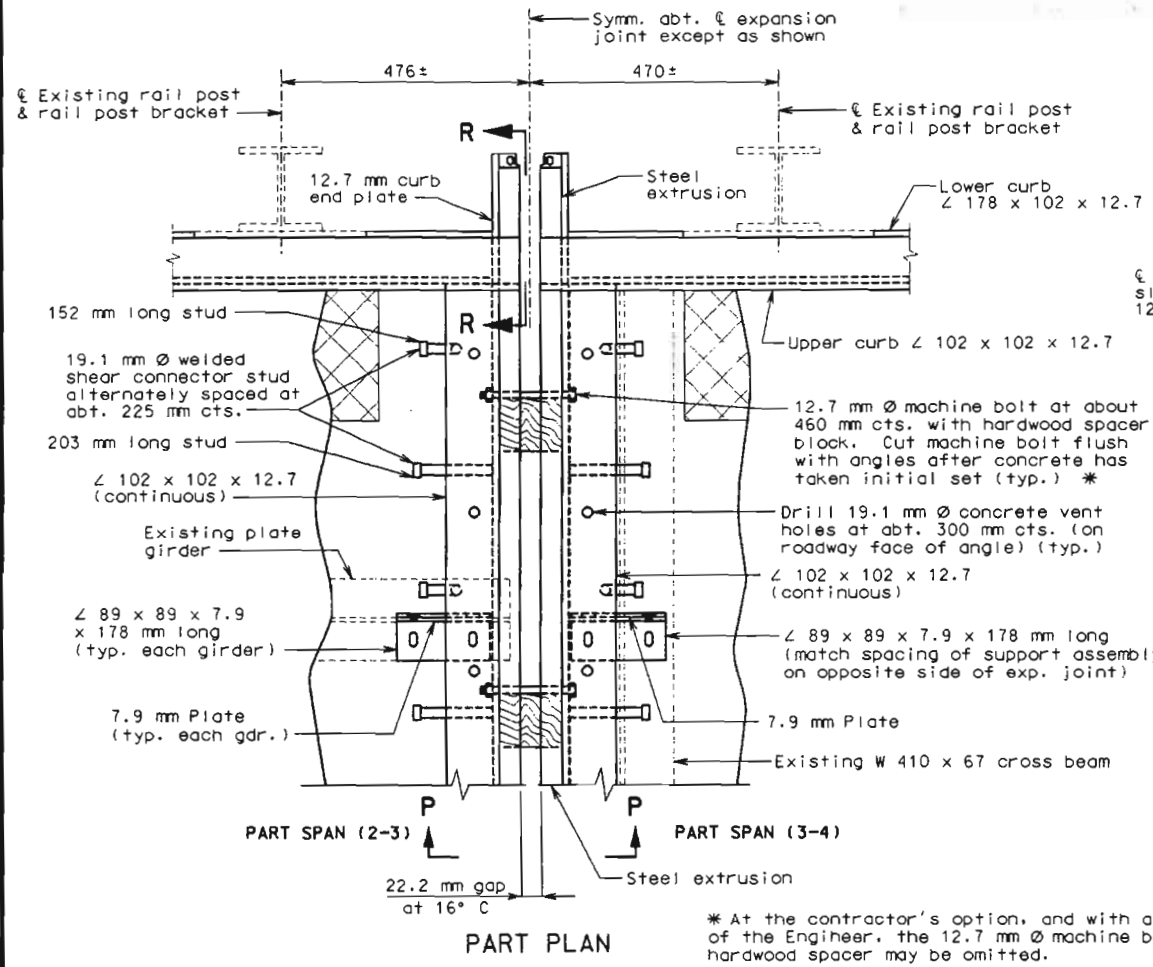

- ① Haunch new slab to bear on existing end diaphragms
- ② Centered on transverse leg of existing bearing stiffener angle
- ③ Centered on existing W 410 x 67 cross beam

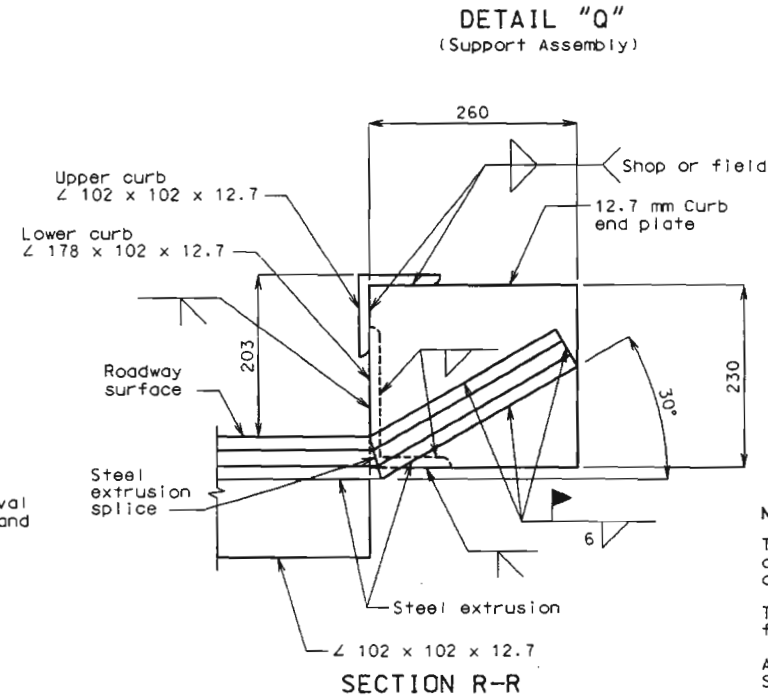

**STRIP SEAL GLAND
MOVEMENT RATING 51 mm**

Note: Strip seal gland shall extend to the end of the steel extrusion.

NOTES FOR STRIP SEAL:

The expansion device shall be fabricated and installed in accordance with the recommendations of the manufacturer, and as set forth in the Special Provisions.

The contractor must verify all dimensions prior to fabrication.

All welds shall conform to Section 712 of the Missouri Standard Specifications (Metric).

Splices of the steel extrusion shall develop full strength.

All steel shall be ASTM A709M Grade 250, except steel extrusions shall be ASTM Grade 345W or Grade 250.

Neoprene strip seal shall meet ASTM D-2628M.

Anchors for the extrusions or armor shall be approved welded studs (C1010 thru C1020).

Payment for steel extrusions and neoprene strip seal shall be made under the contract unit price for Strip Seal Expansion Device.

Structural steel for the expansion device shall be coated with a minimum of two coats of inorganic zinc primer (125 micrometers minimum thickness) or galvanized in accordance with ASTM A123. Anchors need not be protected from overspray.



Payment for furnishing, coating or galvanizing, and placing structural steel plates and angles shall be included in the contract unit price for Strip Seal Expansion Device.

The strip seal expansion device shall be bent to conform to crown and grade of roadway.

Concrete shall be forced under and around angles, studs, and support assemblies. Proper consolidation of the concrete shall be achieved by localized internal vibration.

Plan dimensions are based on installation at 16 degrees Celsius. The expansion gap and other dimensions shall be increased 2.0 mm for each 5 degrees Celsius fall and decreased 2.0 mm for each 5 degrees Celsius rise in temperature at installation.

* At the contractor's option, and with approval of the Engineer, the 12.7 mm Ø machine bolt and hardwood spacer may be omitted.

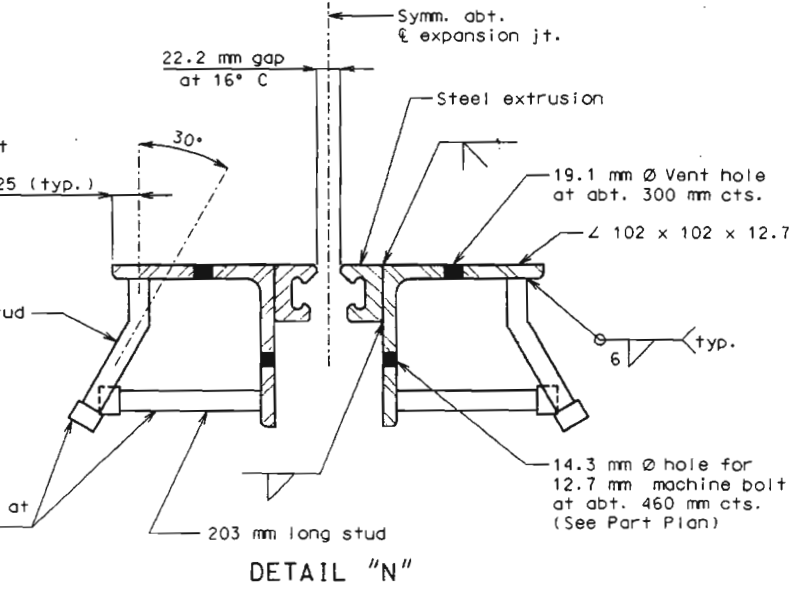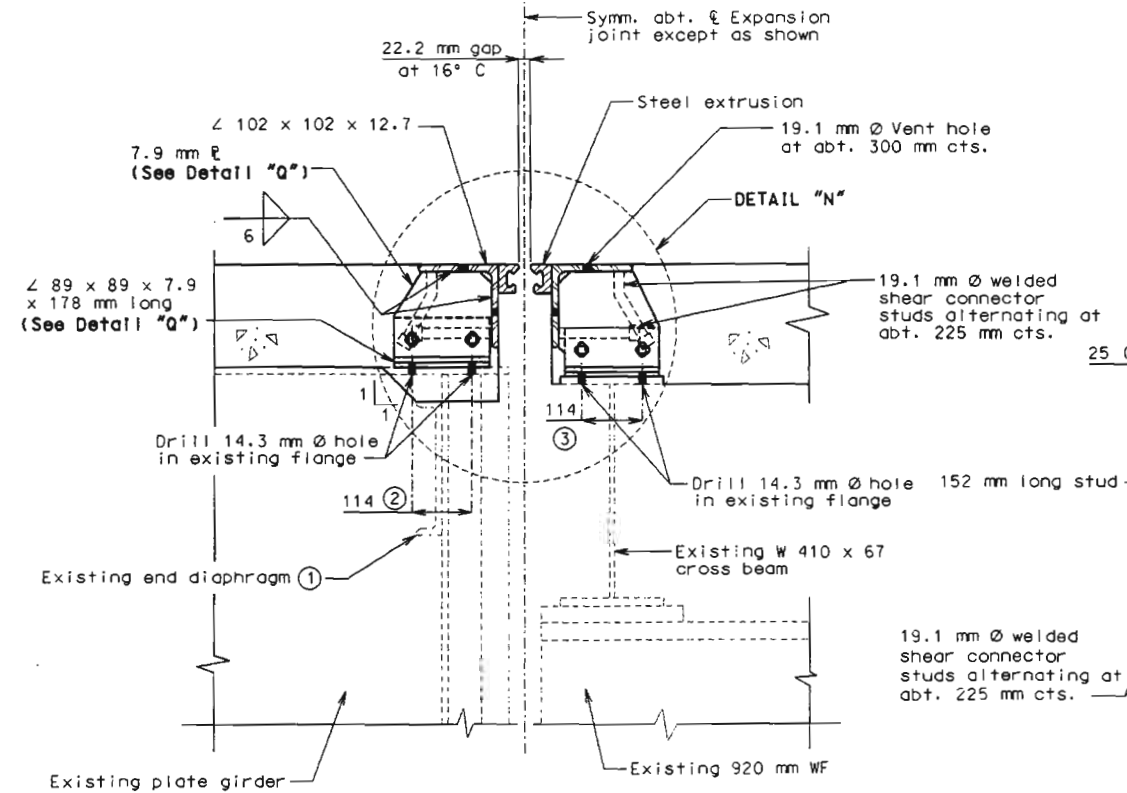


PART SECTION P-P

DETAILS OF STRIP SEAL EXPANSION DEVICE AT BENT NO. 3


Detailed June 1999
Checked July 1999



DATE 8-23-99

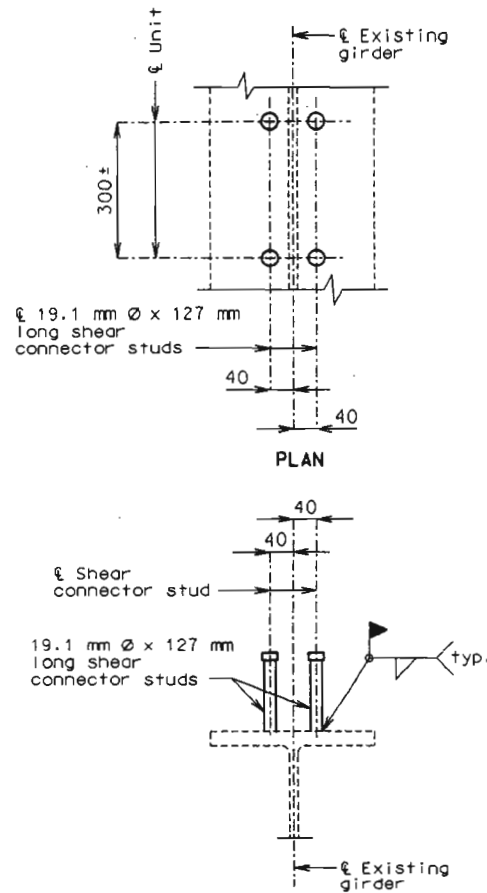


DETAILS OF SHEAR CONNECTOR STUDS
(2 STUDS PER UNIT)
SPAN (2-3) ONLY

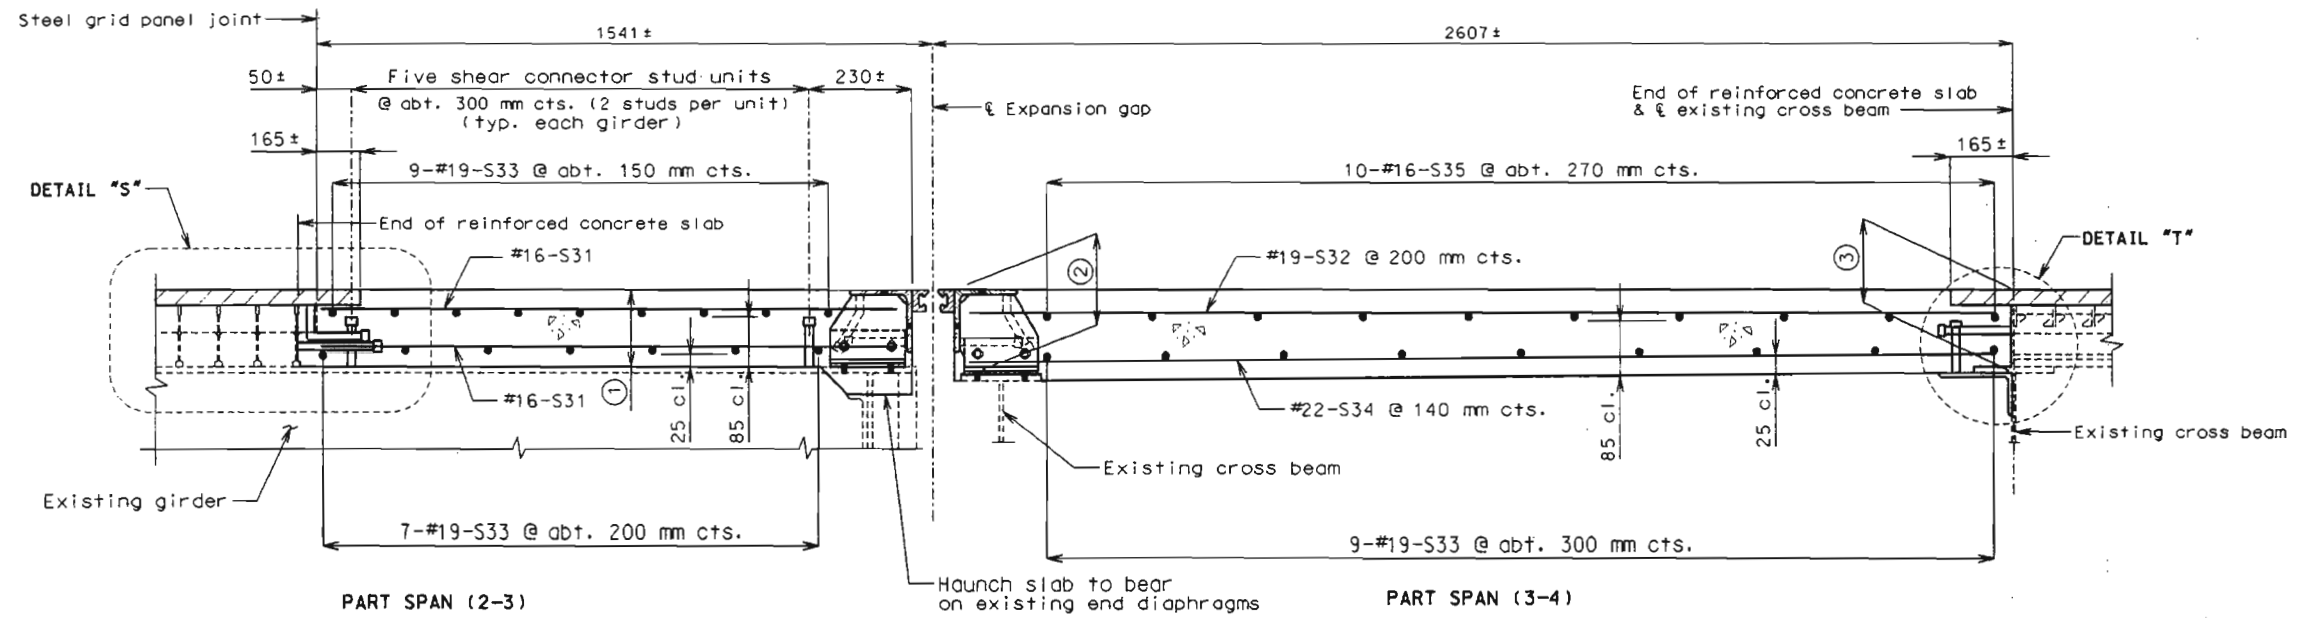

PART SECTION AT BENT NO. 3


Note: For additional slab reinforcement at first rail post in Span (3-4), see sheet no. 13.

	①	②	③
At crown of roadway	195	233	208
At gutter line	170	208	183

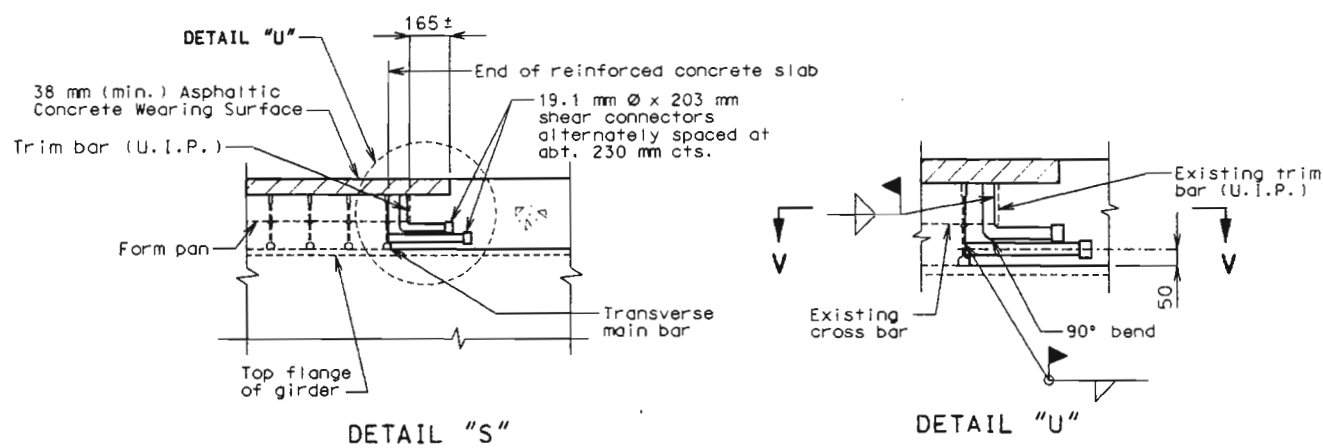


DETAIL "S"

DETAIL "U"

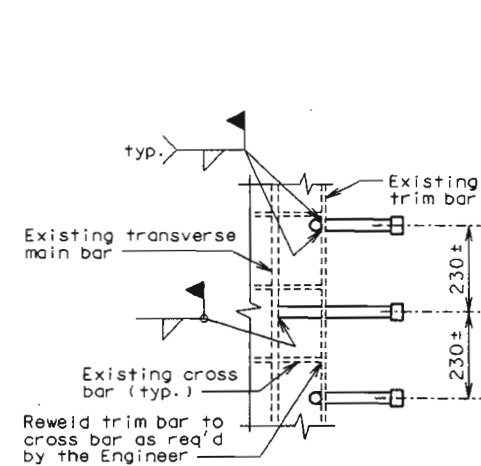

PART SECTION V-V

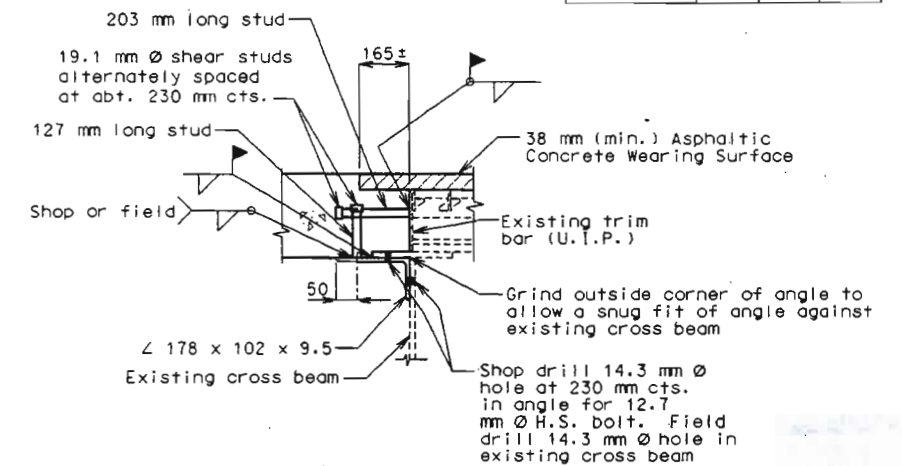

DETAIL "T"

Note: Payment for furnishing and installing shear connector studs (except those for expansion device armor) and L 178 x 102 x 9.5 at cross beam shall be included in the contract unit price for Slab on Steel.



DATE 8-20-99


DETAILS OF DECK REPLACEMENT AT BENT NO. 3

Detailed June 1999
Checked July 1999


Sheet No. 11 of 66

PLATTE COUNTY


K04563

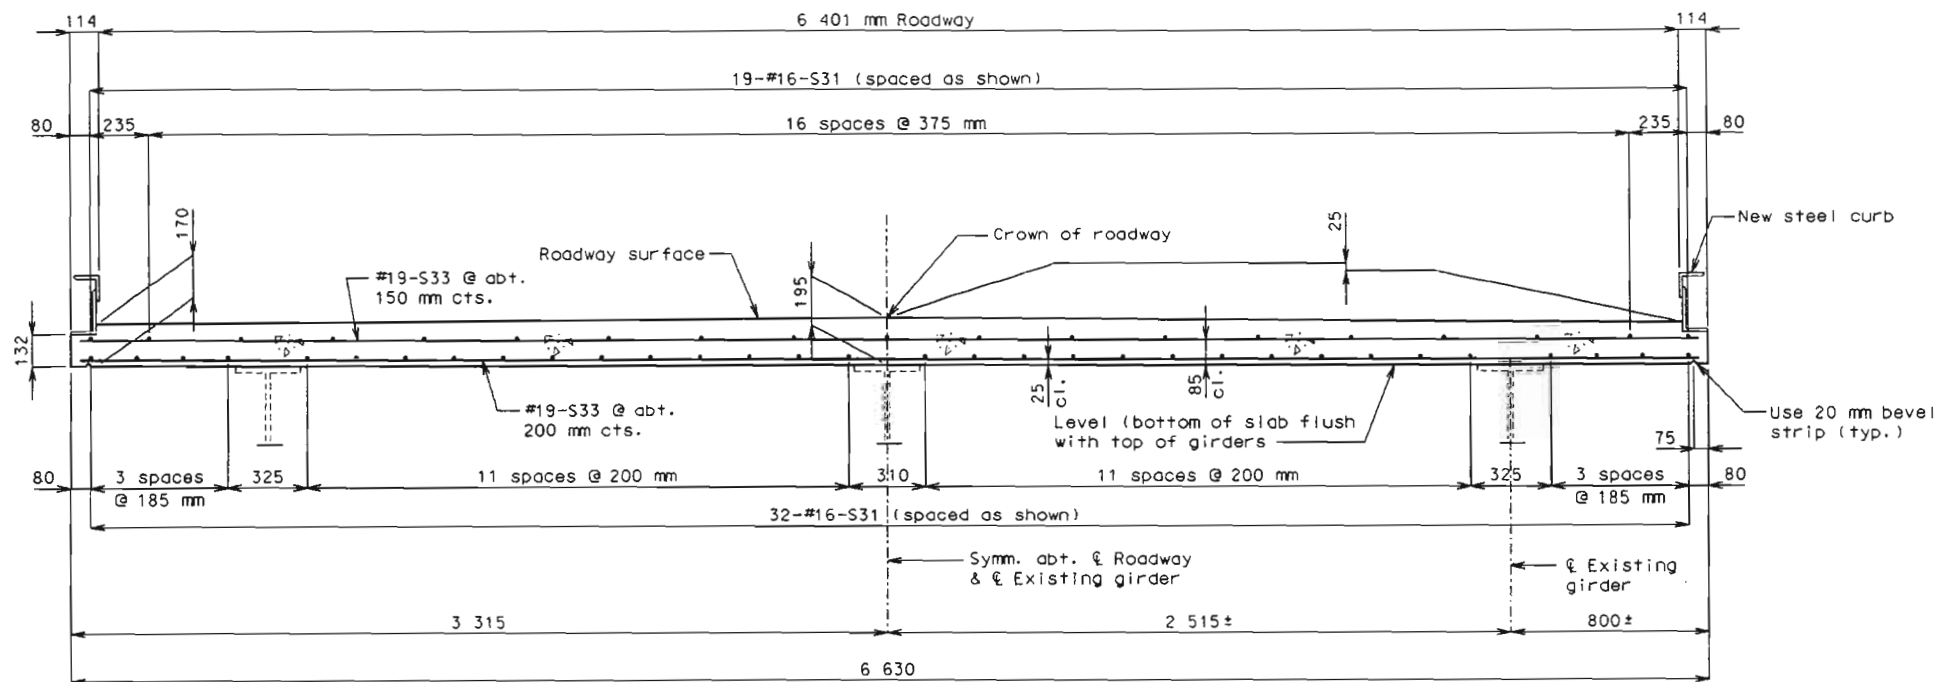

SECTION K-K (SPAN 2-3)

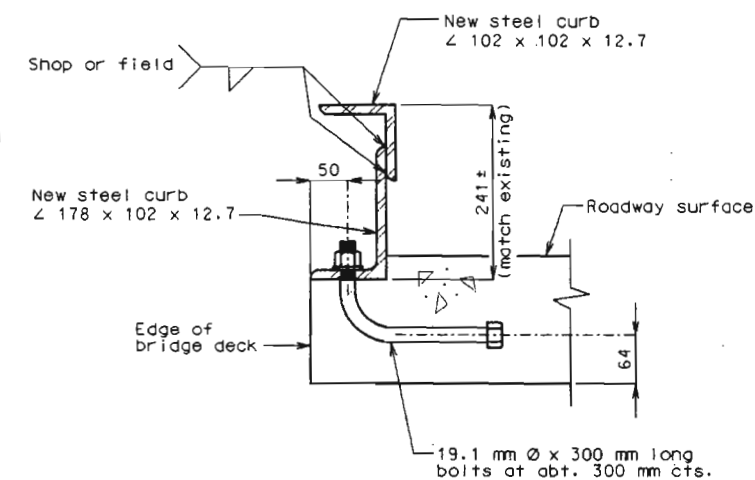

TYPICAL SECTION SHOWING STEEL CURB ATTACHMENT IN AREA OF NEW REINFORCED CONCRETE SLAB

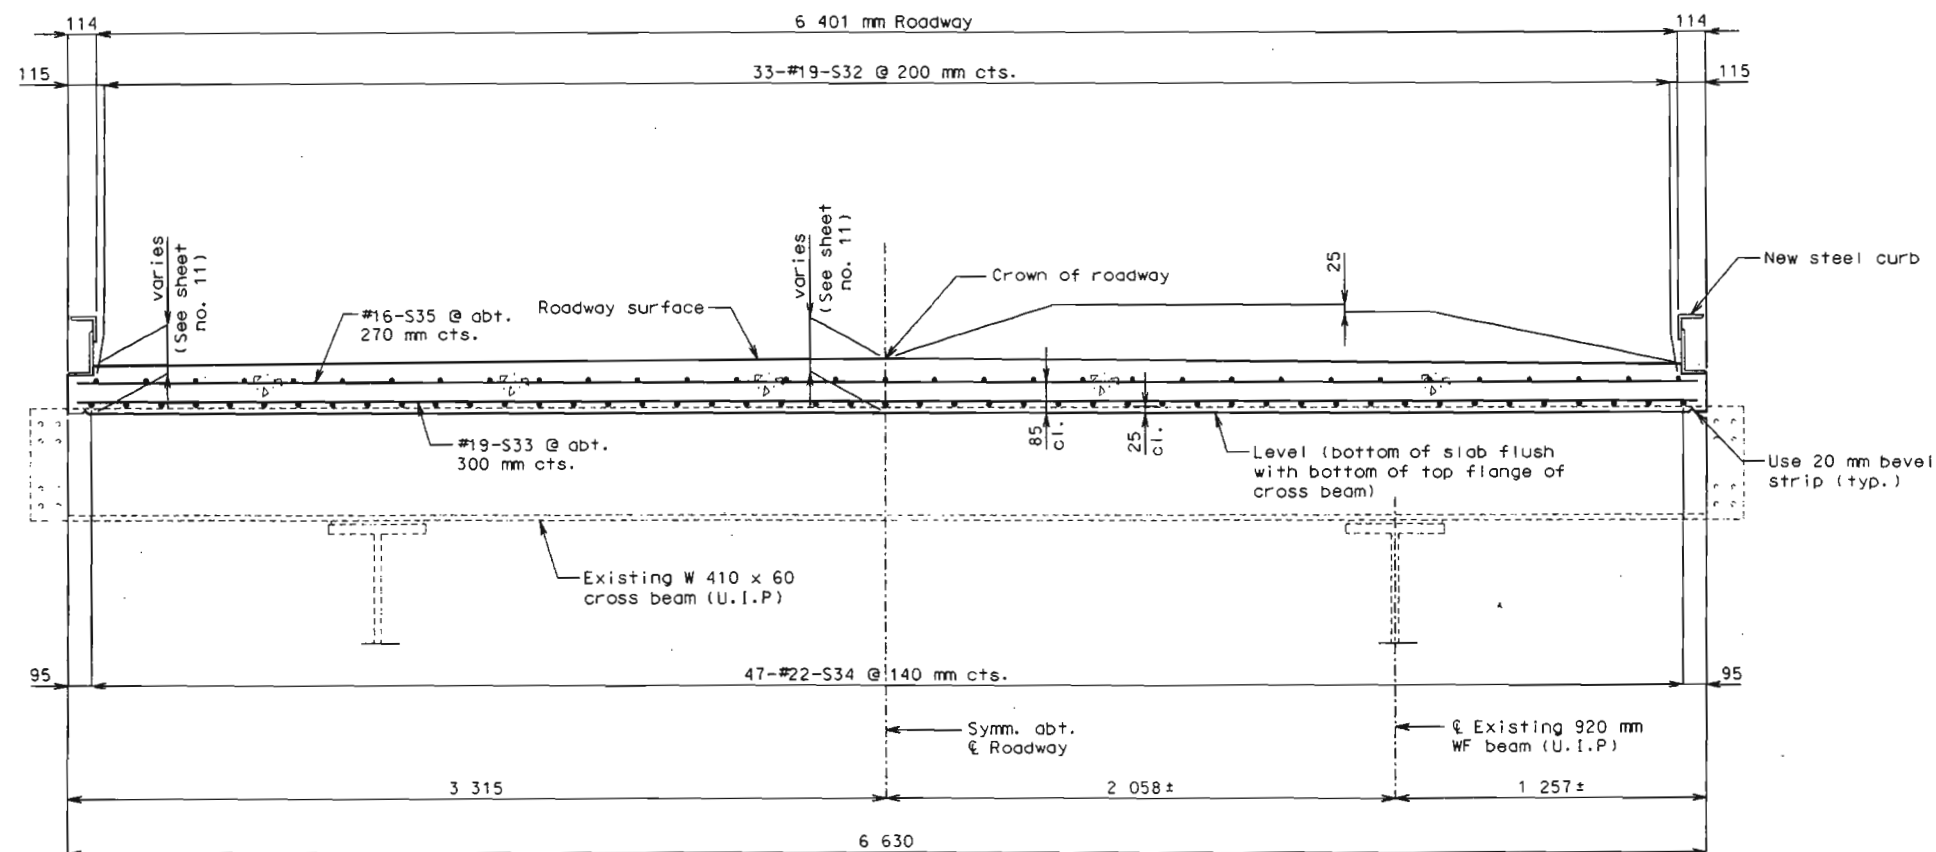

SECTION L-L (SPAN 3-4)

Note: For additional slab reinforcement at first rail post in Span (3-4), see sheet no. 13.

Note: Top of new slab and expansion device shall conform to 25 mm crown of roadway.
 For details of roadway crown, see sheet no. 14.
 For location of Sections K-K and L-L, see sheet no. 9.

Detailed June 1999
 Checked July 1999

DETAILS OF DECK REPLACEMENT AT BENT NO. 3


Sheet No. 12 of 46

PLATTE COUNTY


K04563



State	Proj. No.	Sheet No.
MO		B13








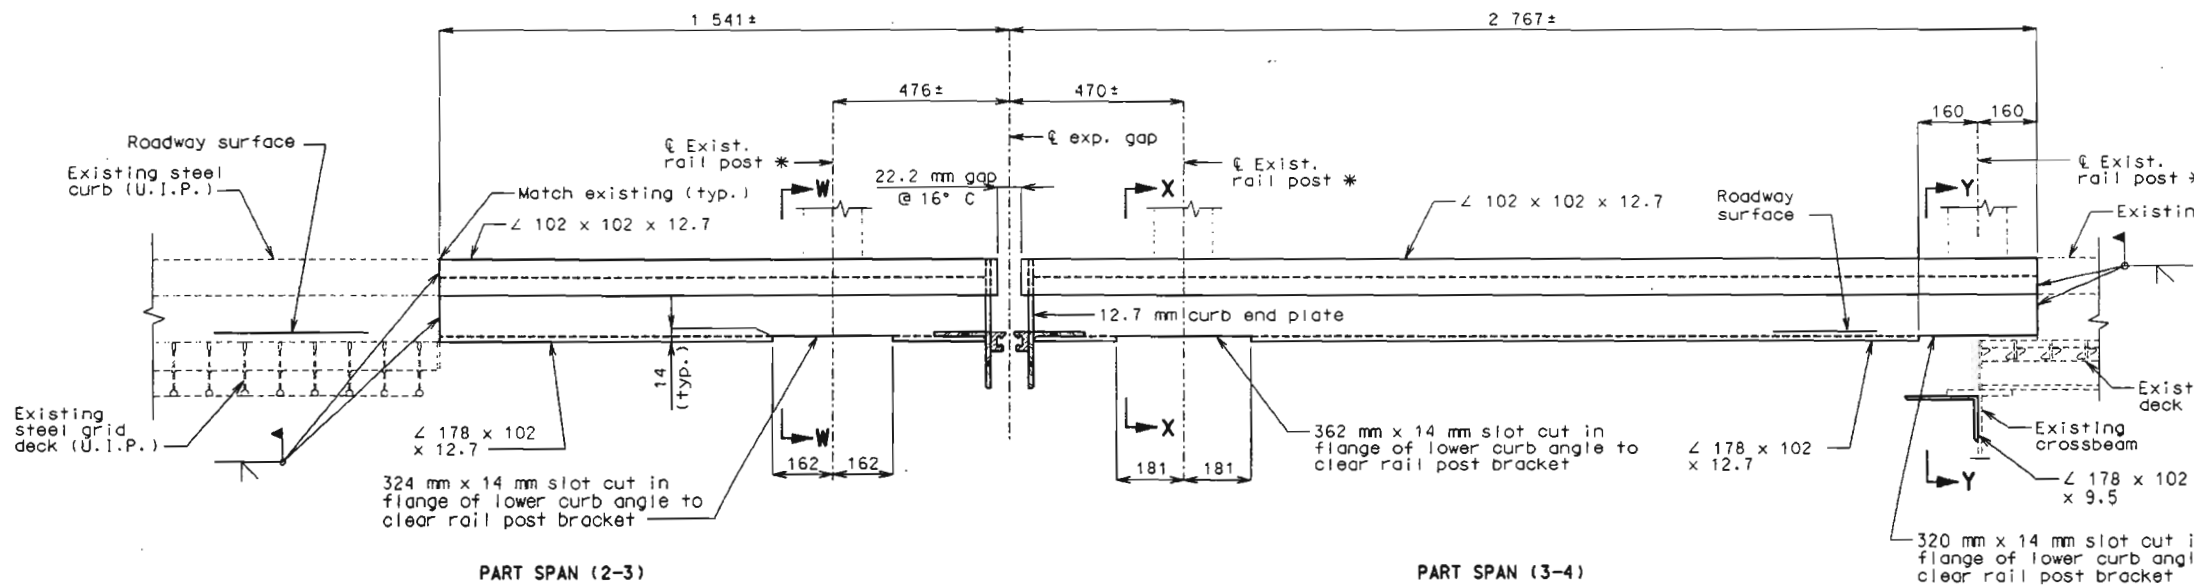


Note: Reuse rail post brackets in their present locations (as shown in plan and elevation views) with the new reinforced concrete slab.

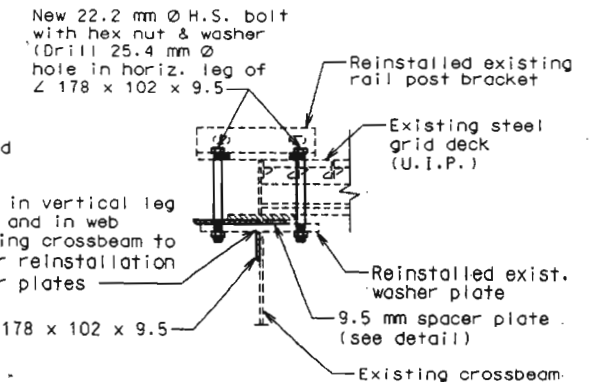

* Reuse existing rail post bracket and washer plates

① Blockout to be filled with asphaltic concrete after installation of rail post brackets.

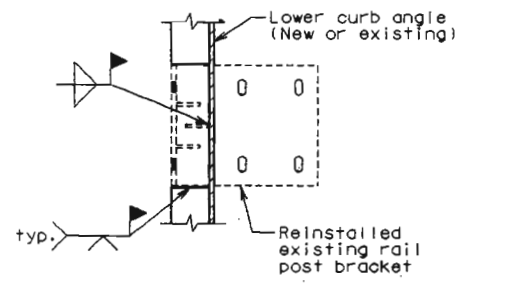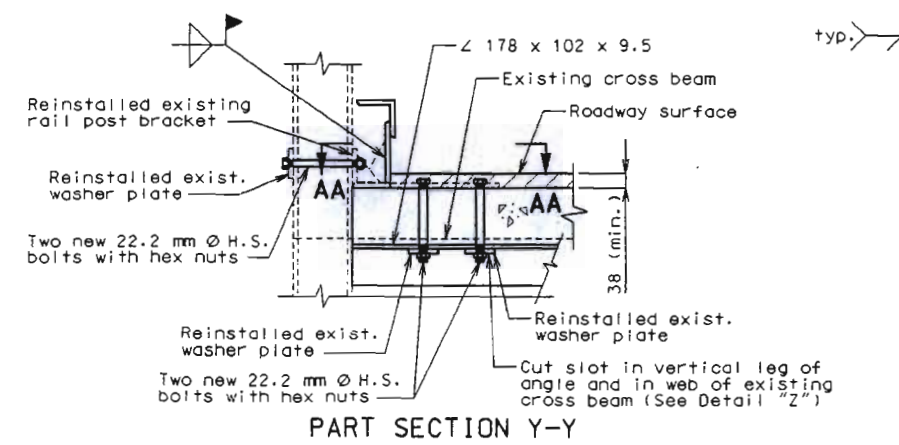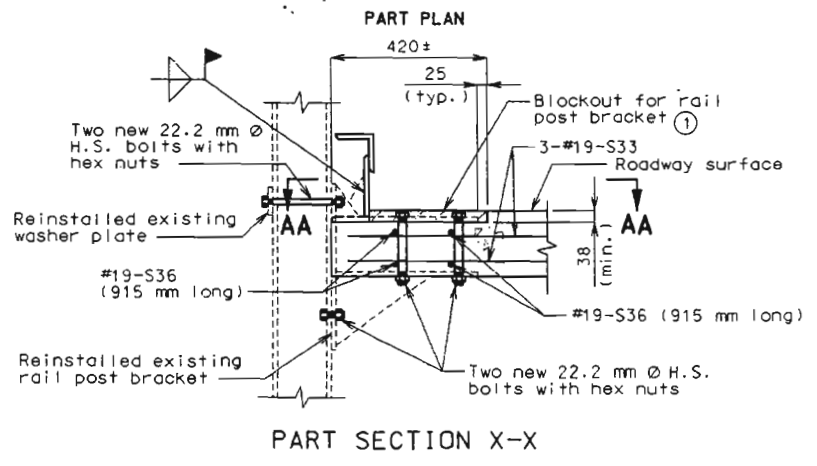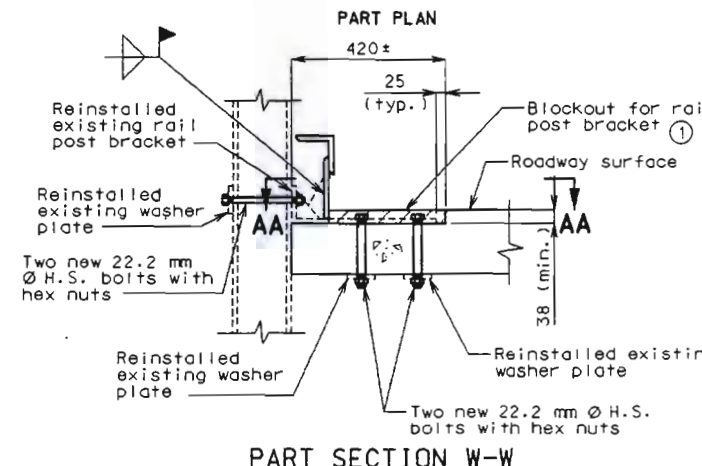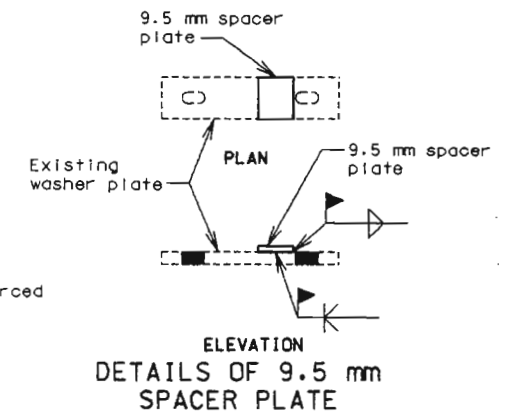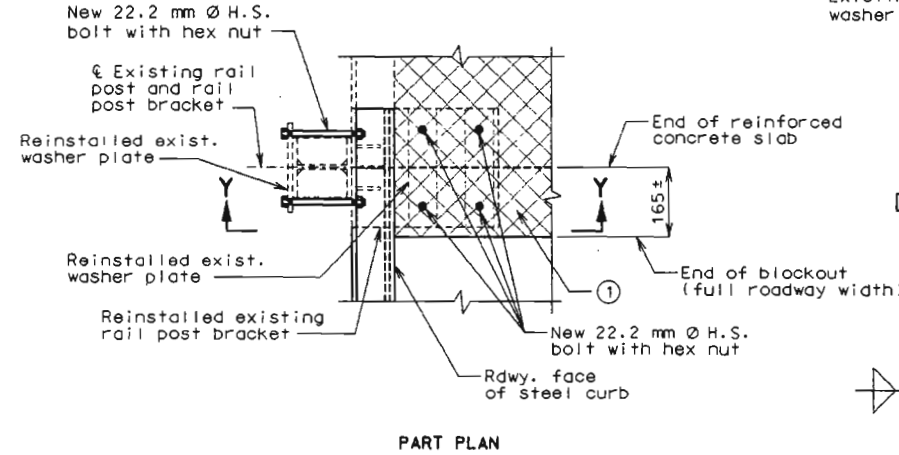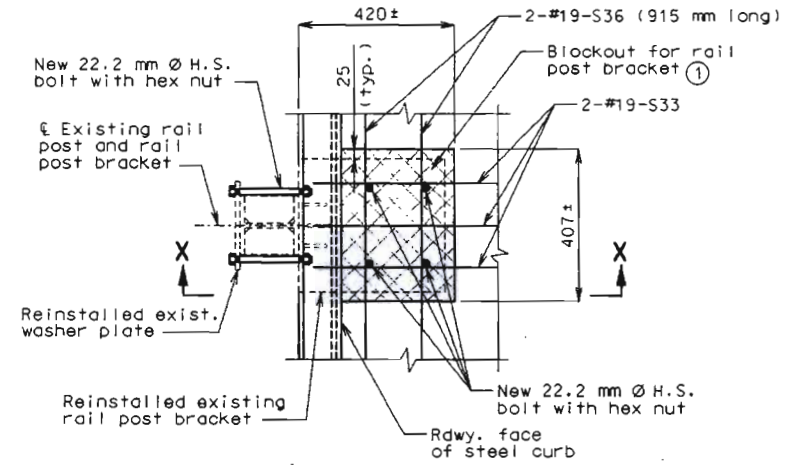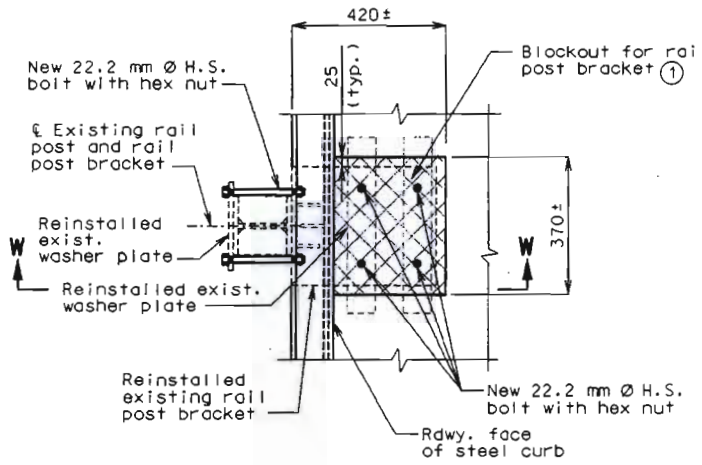

DETAILS OF STEEL CURB & RAIL POST ATTACHMENT AT BENT NO. 3




DATE 8-20-99

Detailed June 1999
Checked July 1999


Sheet No. 13 of 46

PLATTE COUNTY K04563


State	Proj. No.	Sheet No.
MO		B14

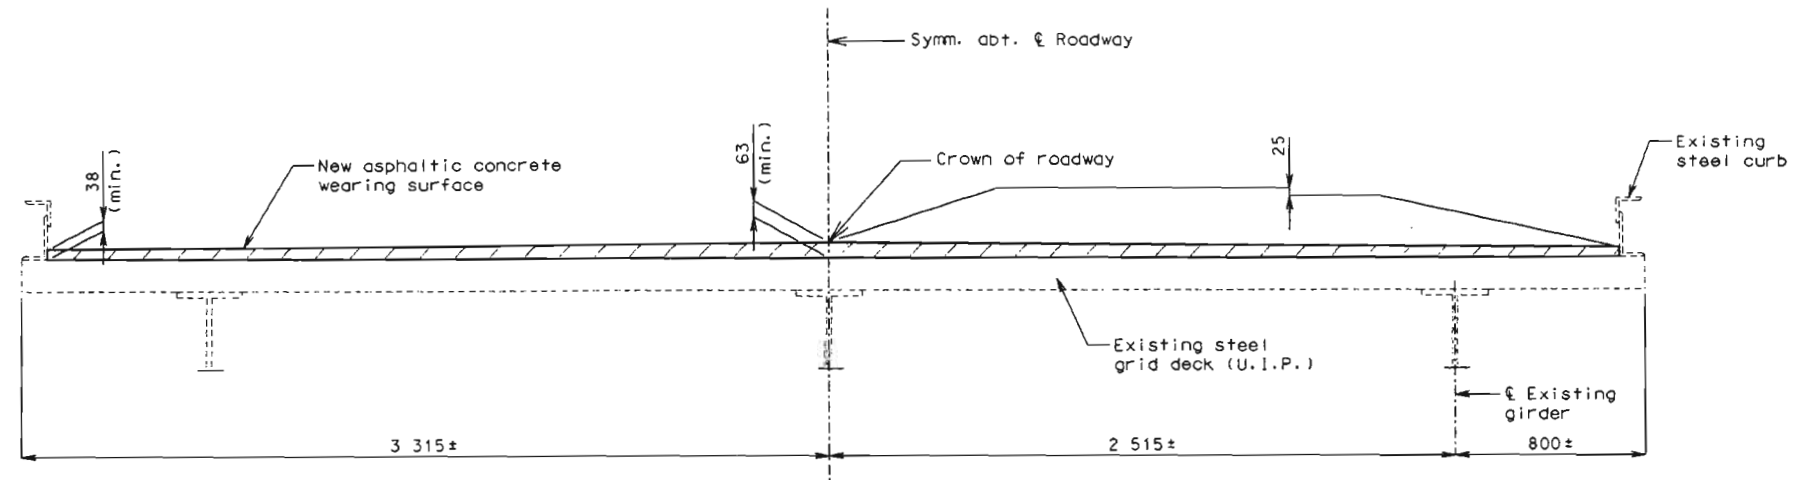

SECTION J-J (SPAN 2-3)

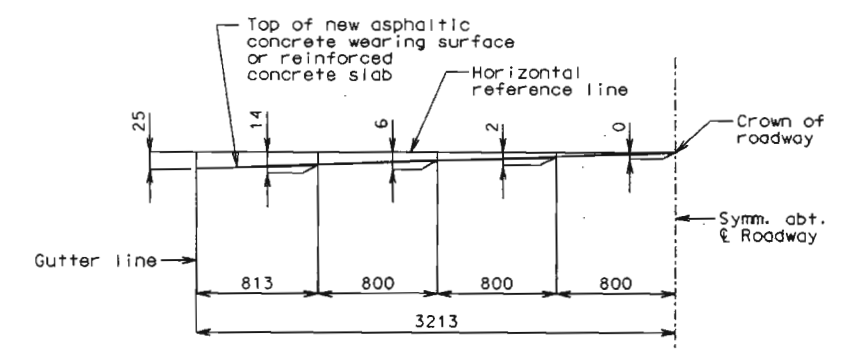

DETAIL OF ROADWAY CROWN

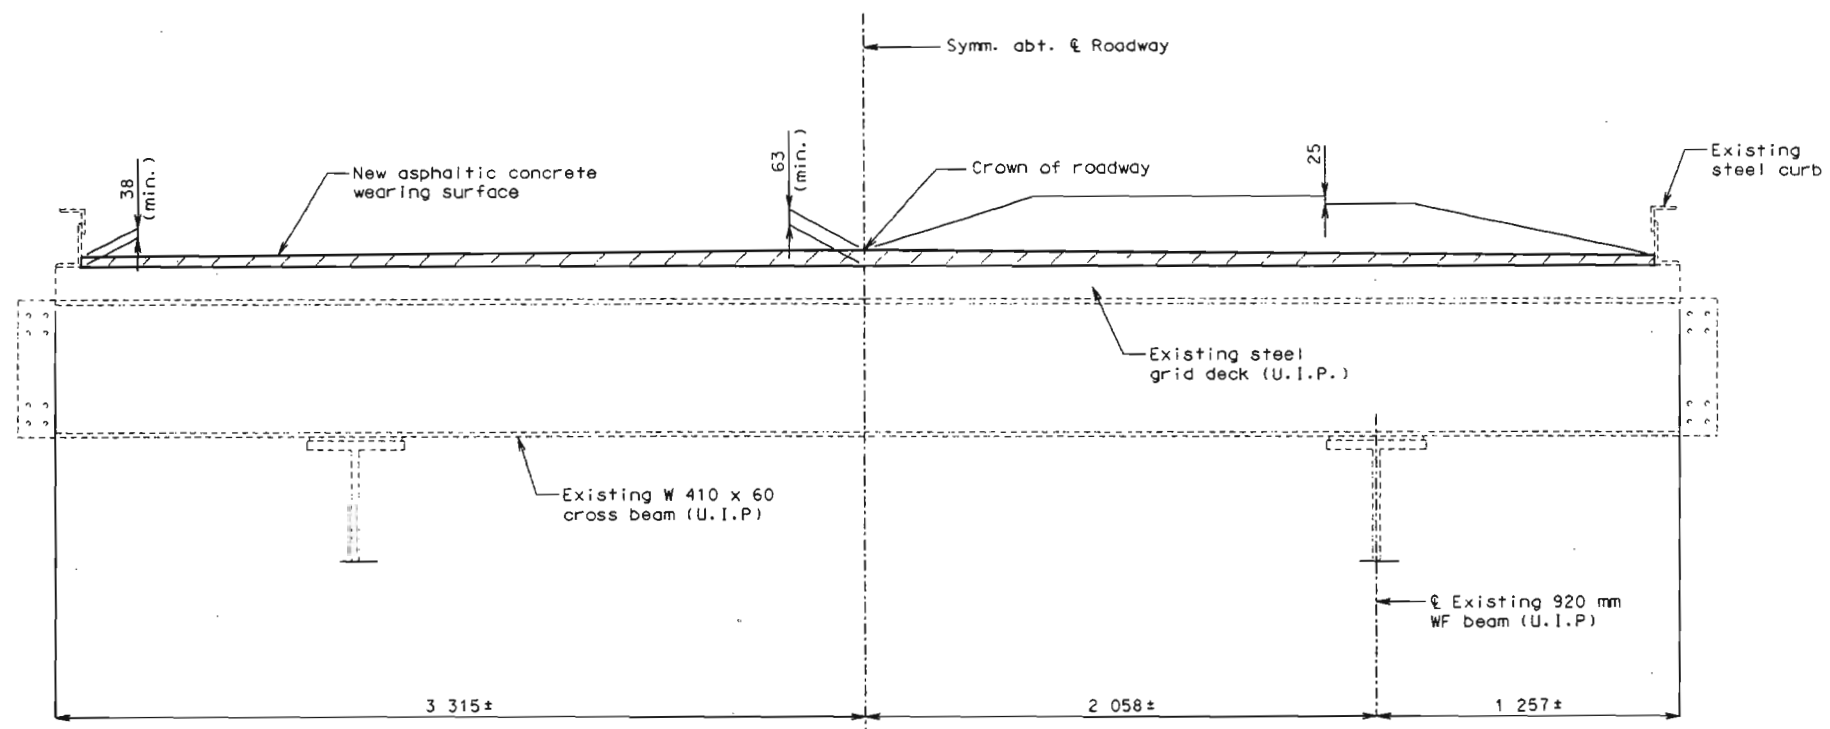

SECTION M-M (SPAN 3-4)

Note: For location of Sections J-J and M-M, see sheet no. 9.


DETAILS OF ASPHALTIC CONCRETE WEARING SURFACE NEAR BENT NO. 3

Detailed June 1999
Checked July 1999

Sheet No. 14 of 46

PLATTE COUNTY K04563



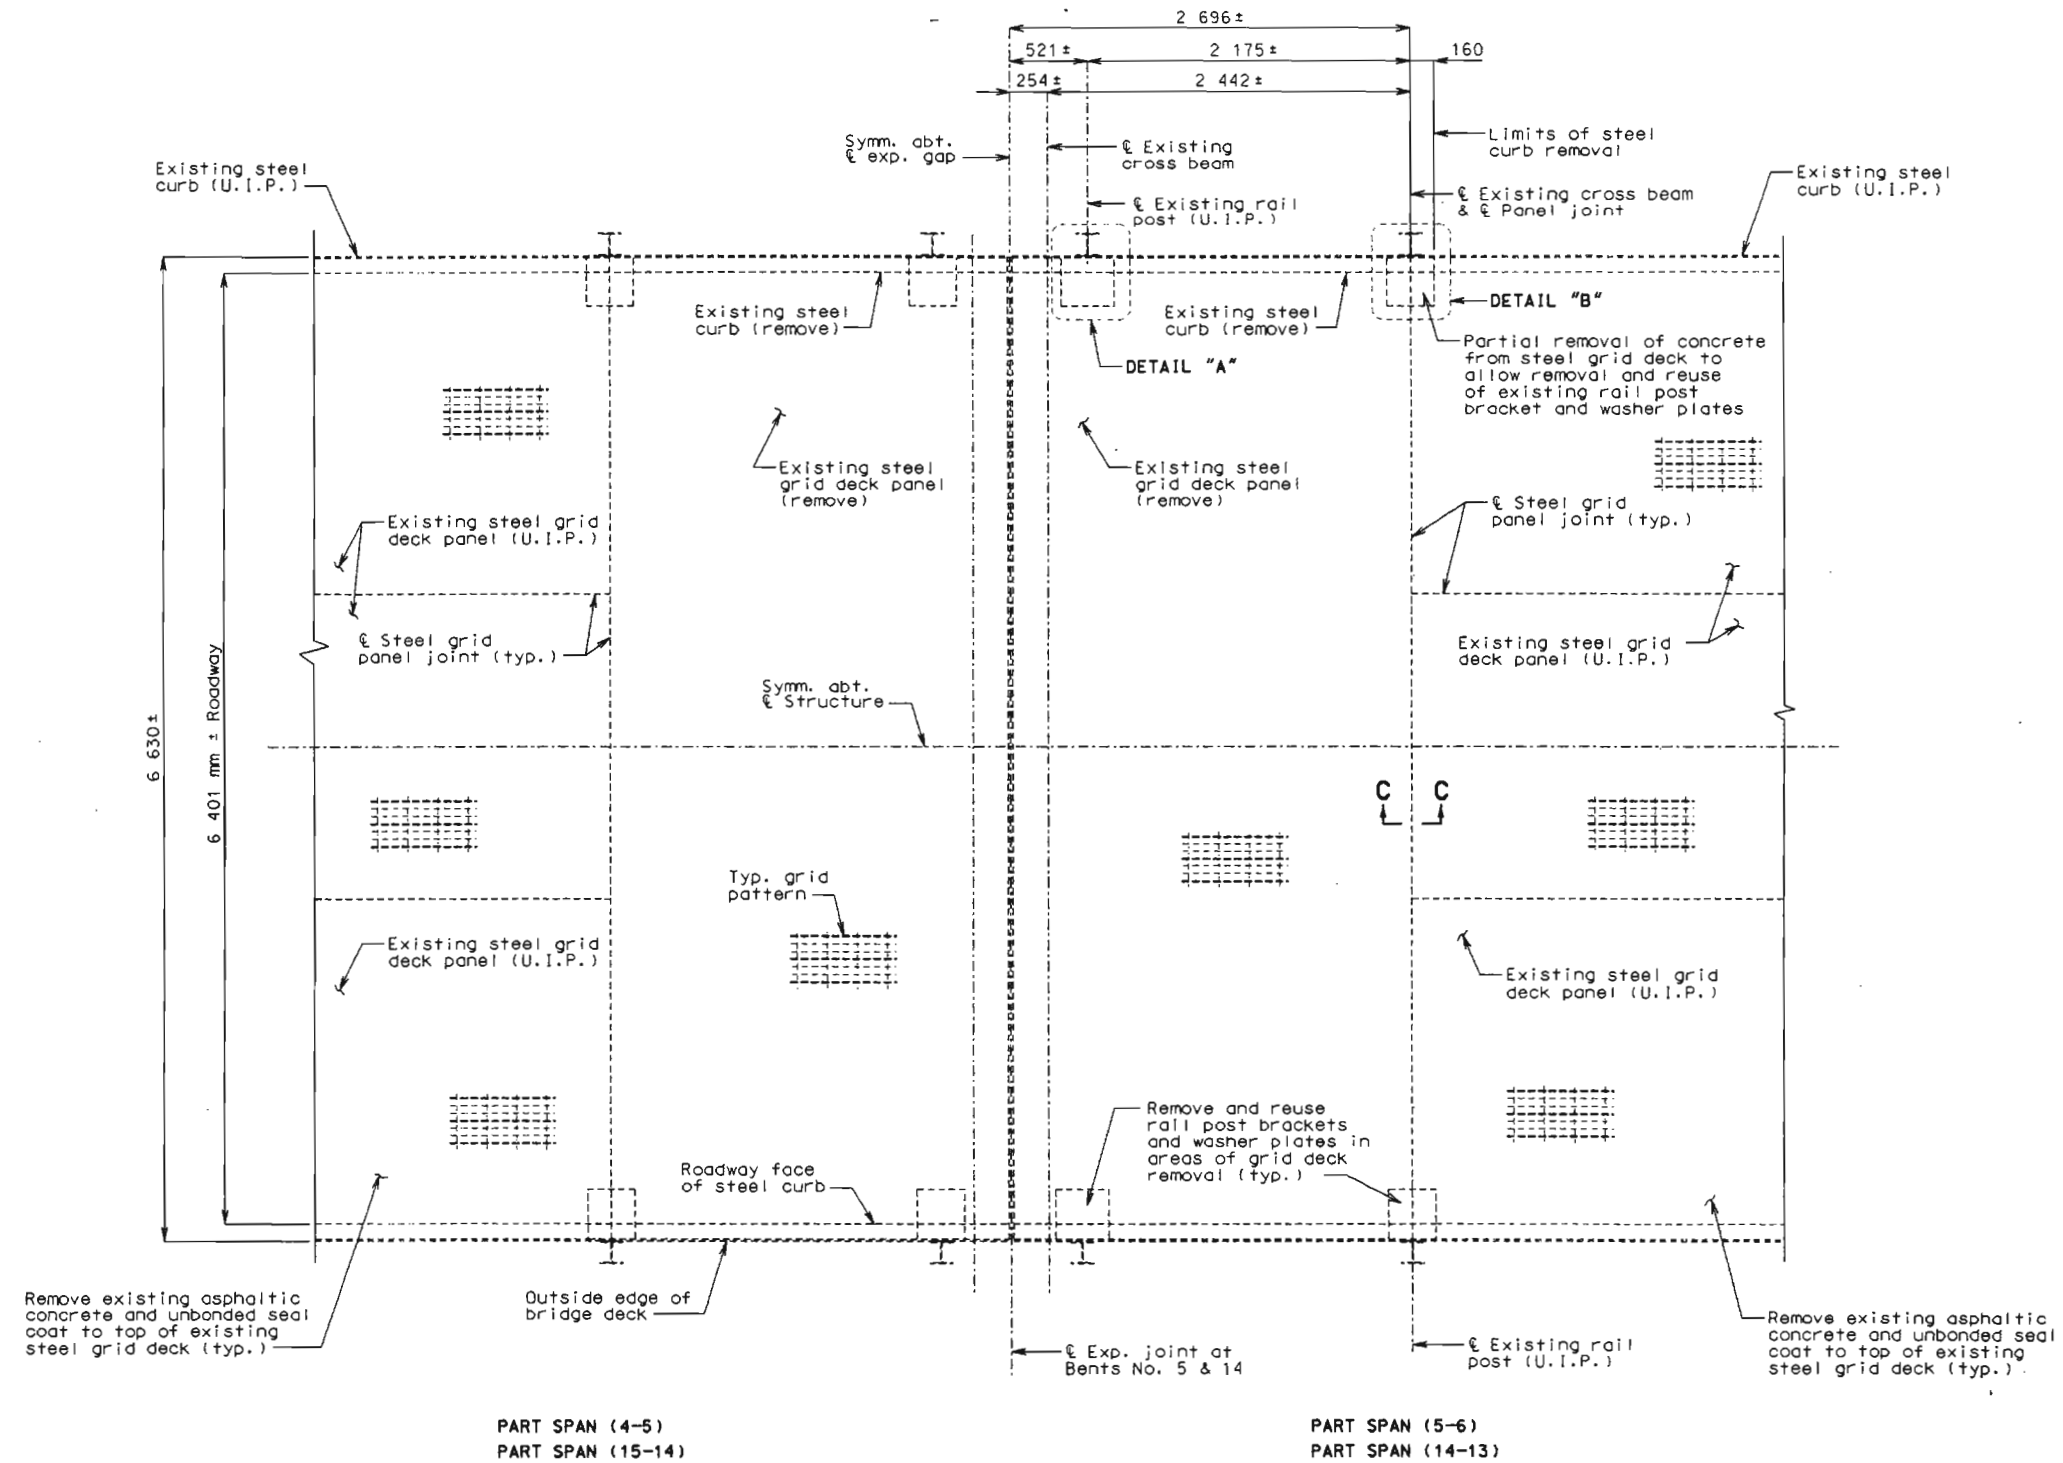

PART PLAN OF EXISTING DECK


Note: Removed rail post brackets and washer plates shall be cleaned and coated with a prime coat of the specified coating system before reinstallation with the new slab.

Payment for the removal of steel curb, rail post brackets and washer plates, as designated on the plans, shall be included in the contract unit price for Partial Removal of Existing Steel Grid Deck.


Note: For Details "A" and "B", and Section C-C, see sheet no. 16.




Detailed June 1999
Checked July 1999

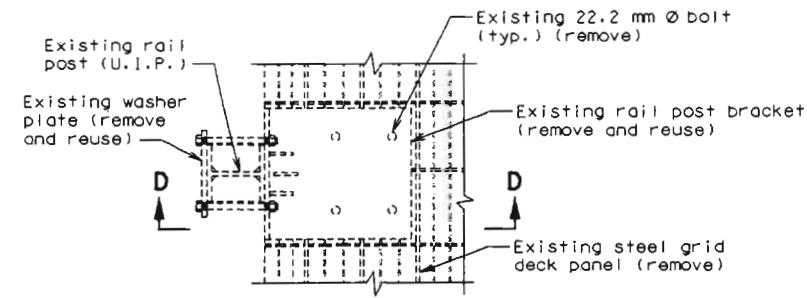


DETAIL "A"
(Rotated 90° counterclockwise)
Note: Steel curb not shown for clarity.

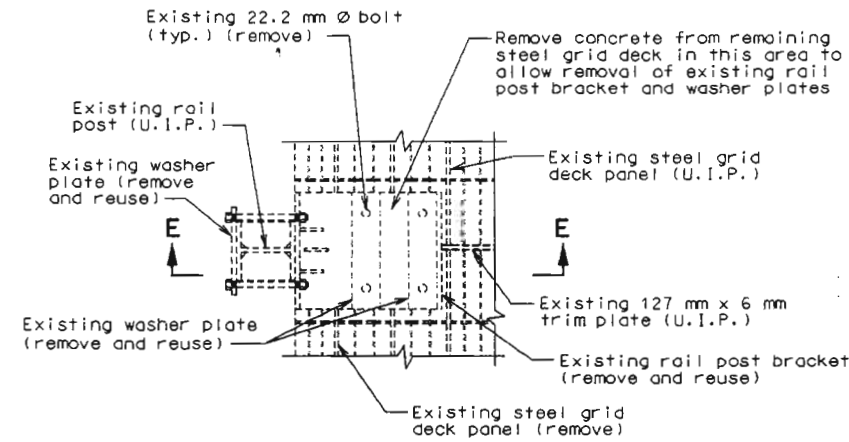

DETAIL "B"
(Rotated 90° counterclockwise)
Note: Steel curb not shown for clarity.

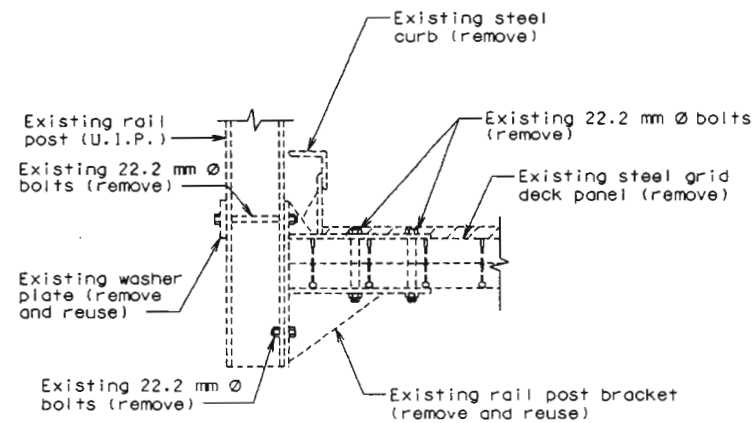


SECTION D-D

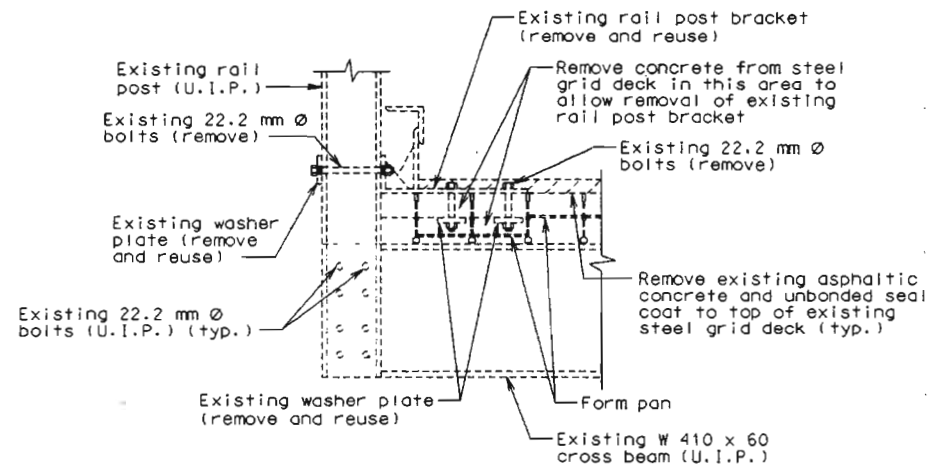


SECTION E-E

Note: For location of Details "A" & "B" and Section C-C, see sheet no. 15.

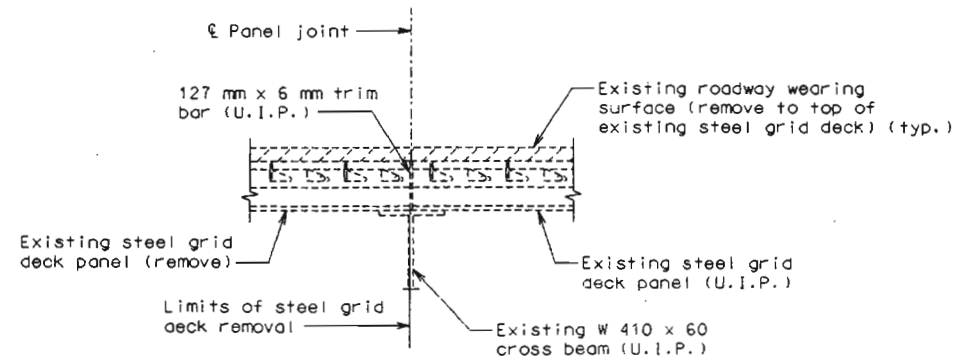

SECTION C-C

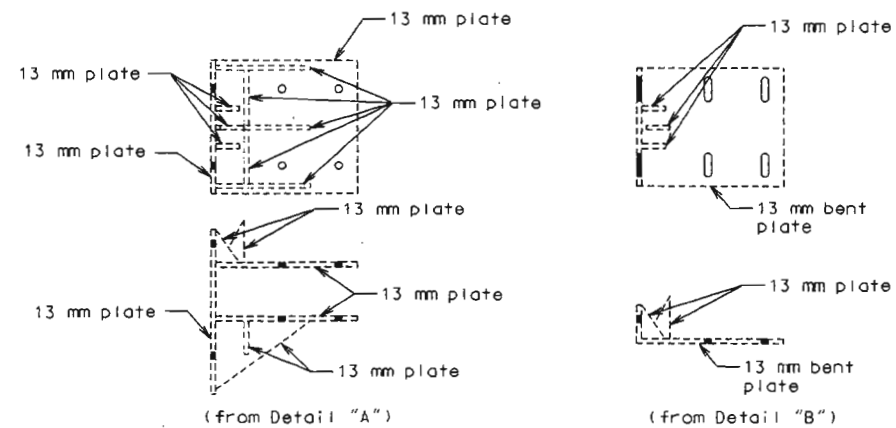


DETAILS OF RAIL POST BRACKETS
(Remove and reuse with new slab)

DETAILS OF DECK REMOVAL AT BENTS NO. 5 & 14



State	Proj. No.	Sheet No.
MO		1317

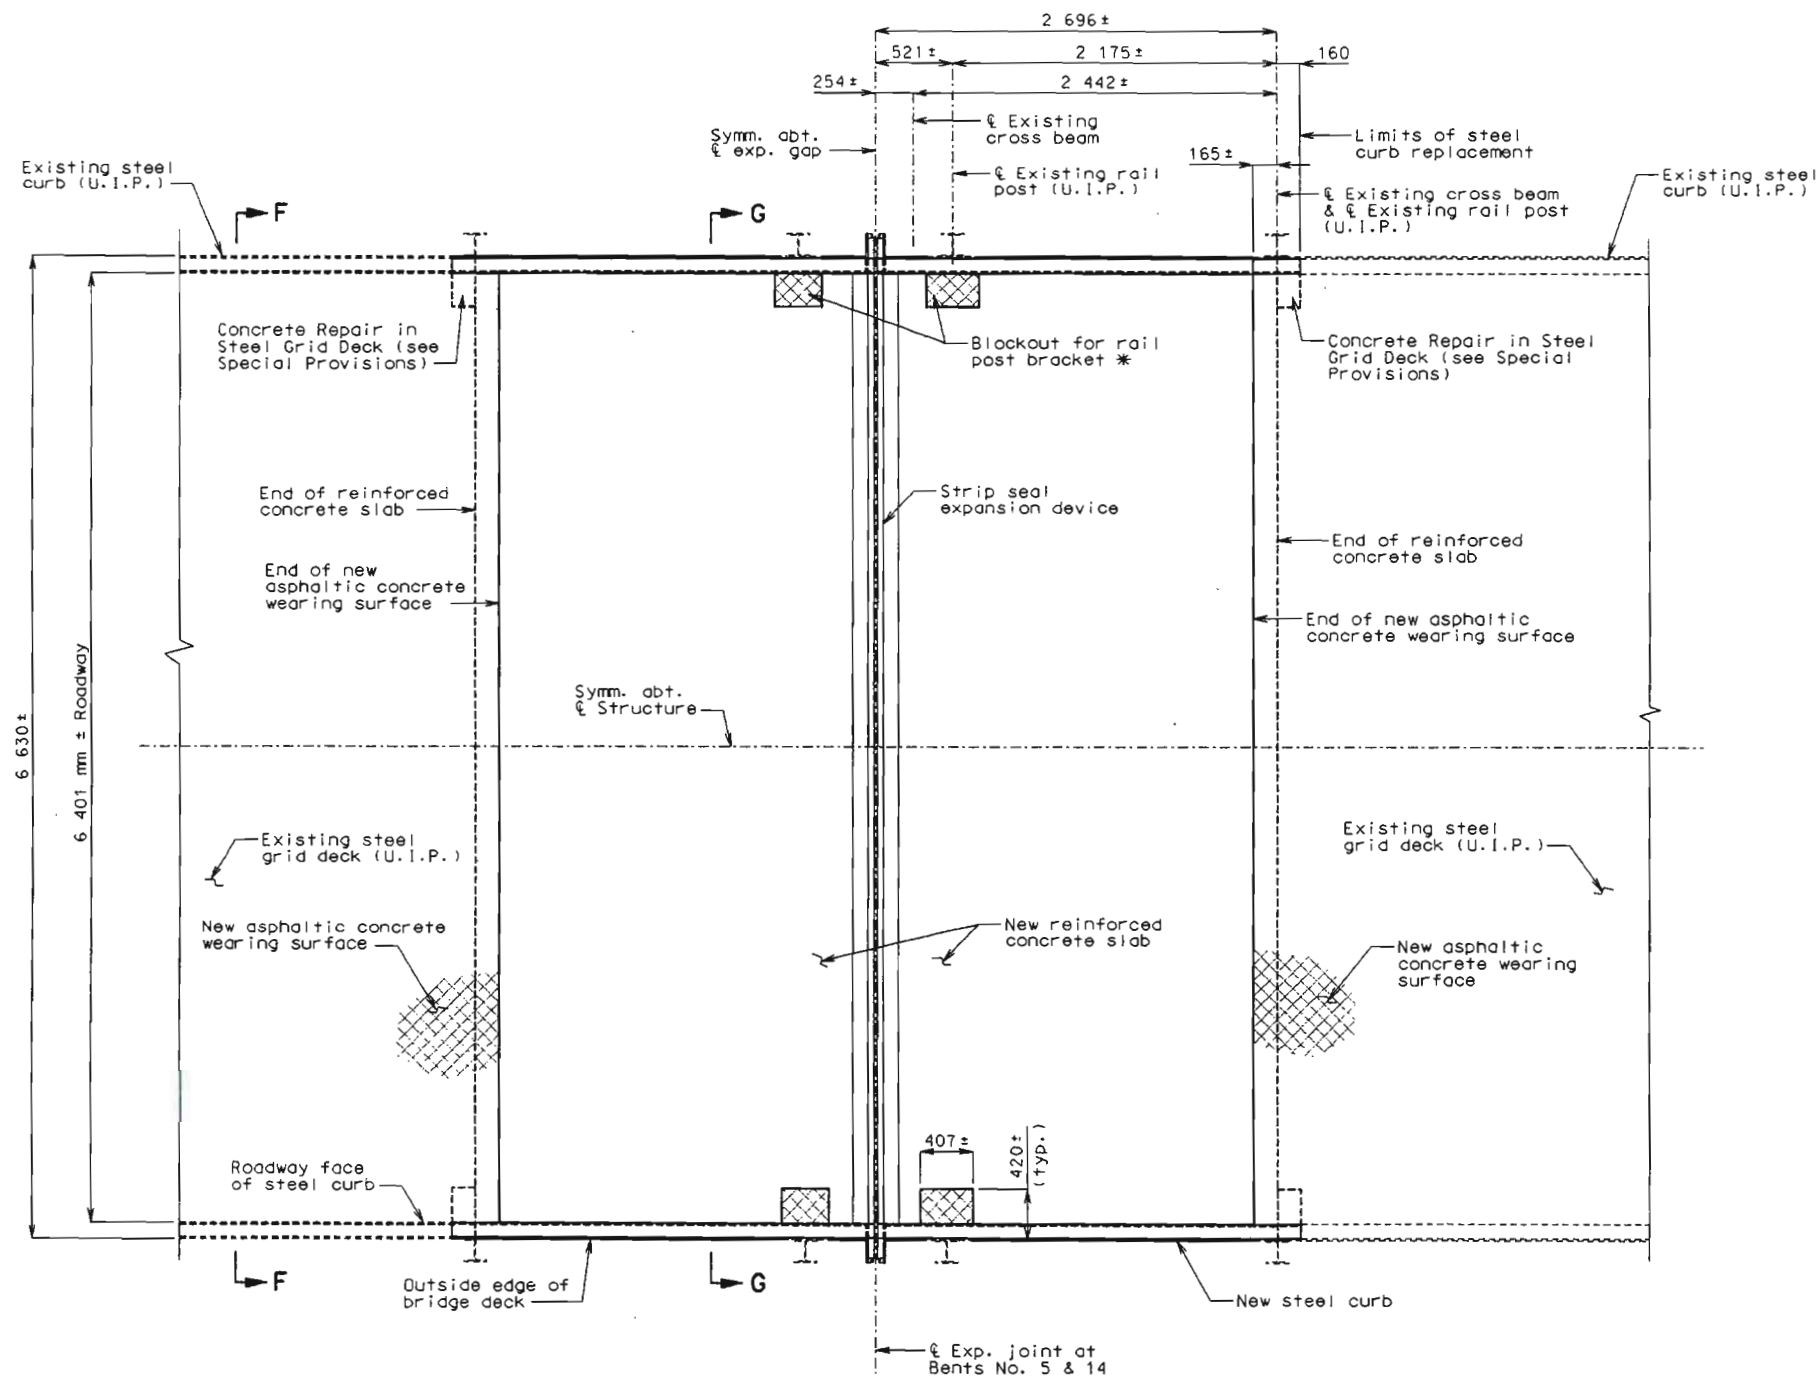

PART SPAN (4-5)
PART SPAN (15-14)

PART SPAN (5-6)
PART SPAN (14-13)

PART PLAN

Note: For Sections F-F and G-G, see sheet no. 20.

For longitudinal section thru new reinforced concrete slabs, see sheet no. 19.

For details of strip seal expansion device, see sheet no. 18.

For details of new steel curb and rail post attachments, see sheet no. 21.

* Blockout to be filled with asphaltic concrete after installation of rail post bracket.

Details for steel curb replacement have been developed based on available plans and on using the existing rail posts in their present locations. The contractor shall verify the existing rail post locations before ordering steel curb replacement.

Payment for the reinstallation of the existing rail post brackets and washer plates with new H.S. bolts, hex nuts, and washers shall be included in the contract unit price for Slab on Steel.

Payment for furnishing and installing new steel curb with anchor bolts, hex nuts, and washers shall be included in the contract unit price for Steel Curb.



Detailed June 1999
Checked July 1999


DETAILS OF DECK REPLACEMENT AT BENTS NO. 5 & 14

Sheet No. 17 of 46

PLATTE COUNTY


K04563

State	Proj. No.	Sheet No.
MO		318

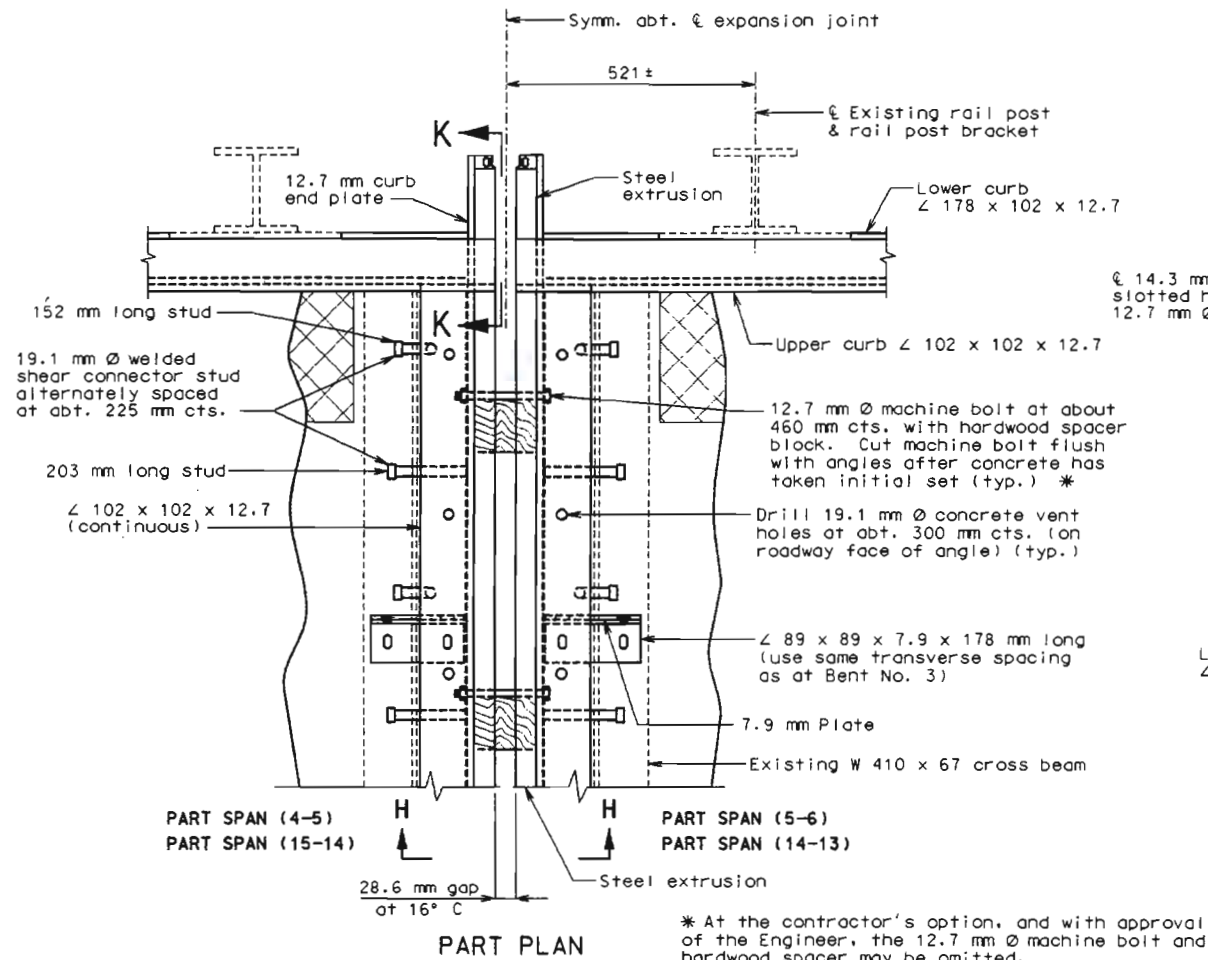


PART PLAN

* At the contractor's option, and with approval of the Engineer, the 12.7 mm \varnothing machine bolt and hardwood spacer may be omitted.

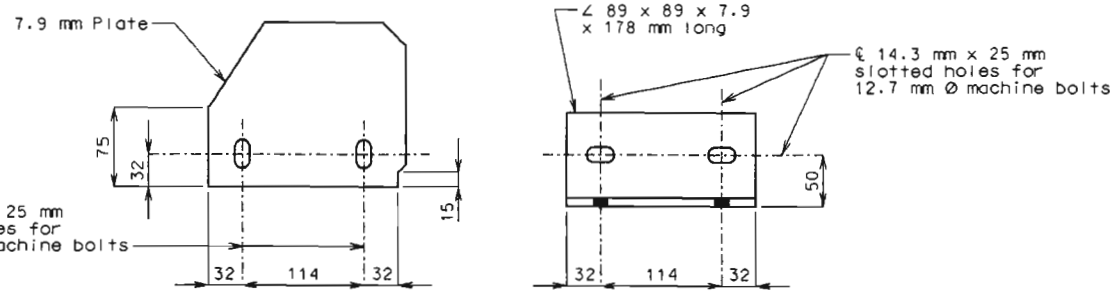

DETAIL "J"
(Support Assembly)

① Centered on existing W 410 x 67 cross beam

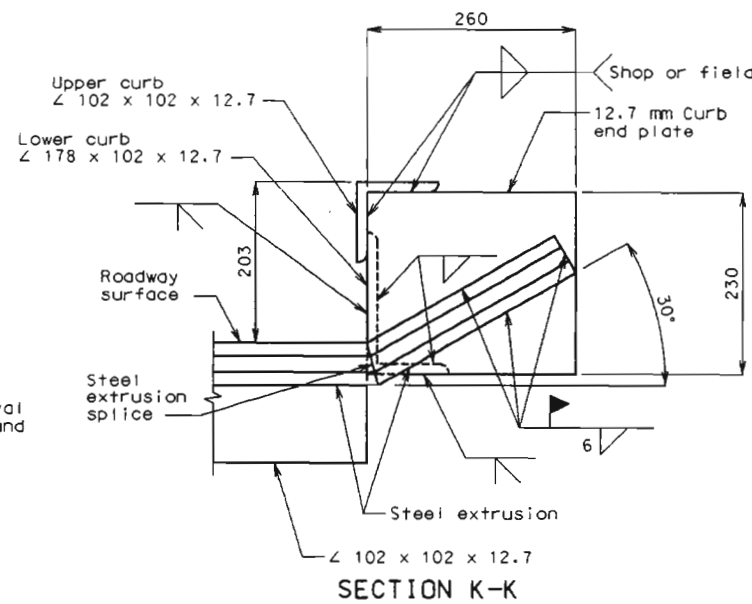

SECTION K-K



STRIP SEAL GLAND
MOVEMENT RATING 51 mm

Note: Strip seal gland shall extend to the end of the steel extrusion.

NOTES FOR STRIP SEAL:

The expansion device shall be fabricated and installed in accordance with the recommendations of the manufacturer, and as set forth in the Special Provisions.

The contractor must verify all dimensions prior to fabrication.

All welds shall conform to Section 712 of the Missouri Standard Specifications (Metric).

Splices of the steel extrusion shall develop full strength.

All steel shall be ASTM A709M Grade 250, except steel extrusions shall be ASTM Grade 345W or Grade 250.

Neoprene strip seal shall meet ASTM D-2628M.

Anchors for the extrusions or armor shall be approved welded studs (C1010 thru C1020).

Payment for steel extrusions and neoprene strip seal shall be made under the contract unit price for Strip Seal Expansion Device.


Structural steel for the expansion device shall be coated with a minimum of two coats of inorganic zinc primer (125 micrometers minimum thickness) or galvanized in accordance with ASTM A123. Anchors need not be protected from overspray.

Payment for furnishing, coating or galvanizing, and placing structural steel plates and angles shall be included in the contract unit price for Strip Seal Expansion Device.

The strip seal expansion device shall be bent to conform to crown and grade of roadway.

Concrete shall be forced under and around angles, studs, and support assemblies. Proper consolidation of the concrete shall be achieved by localized internal vibration.

Plan dimensions are based on installation at 16 degrees Celsius. The expansion gap and other dimensions shall be increased 2.2 mm for each 5 degrees Celsius fall and decreased 2.2 mm for each 5 degrees Celsius rise in temperature at installation.

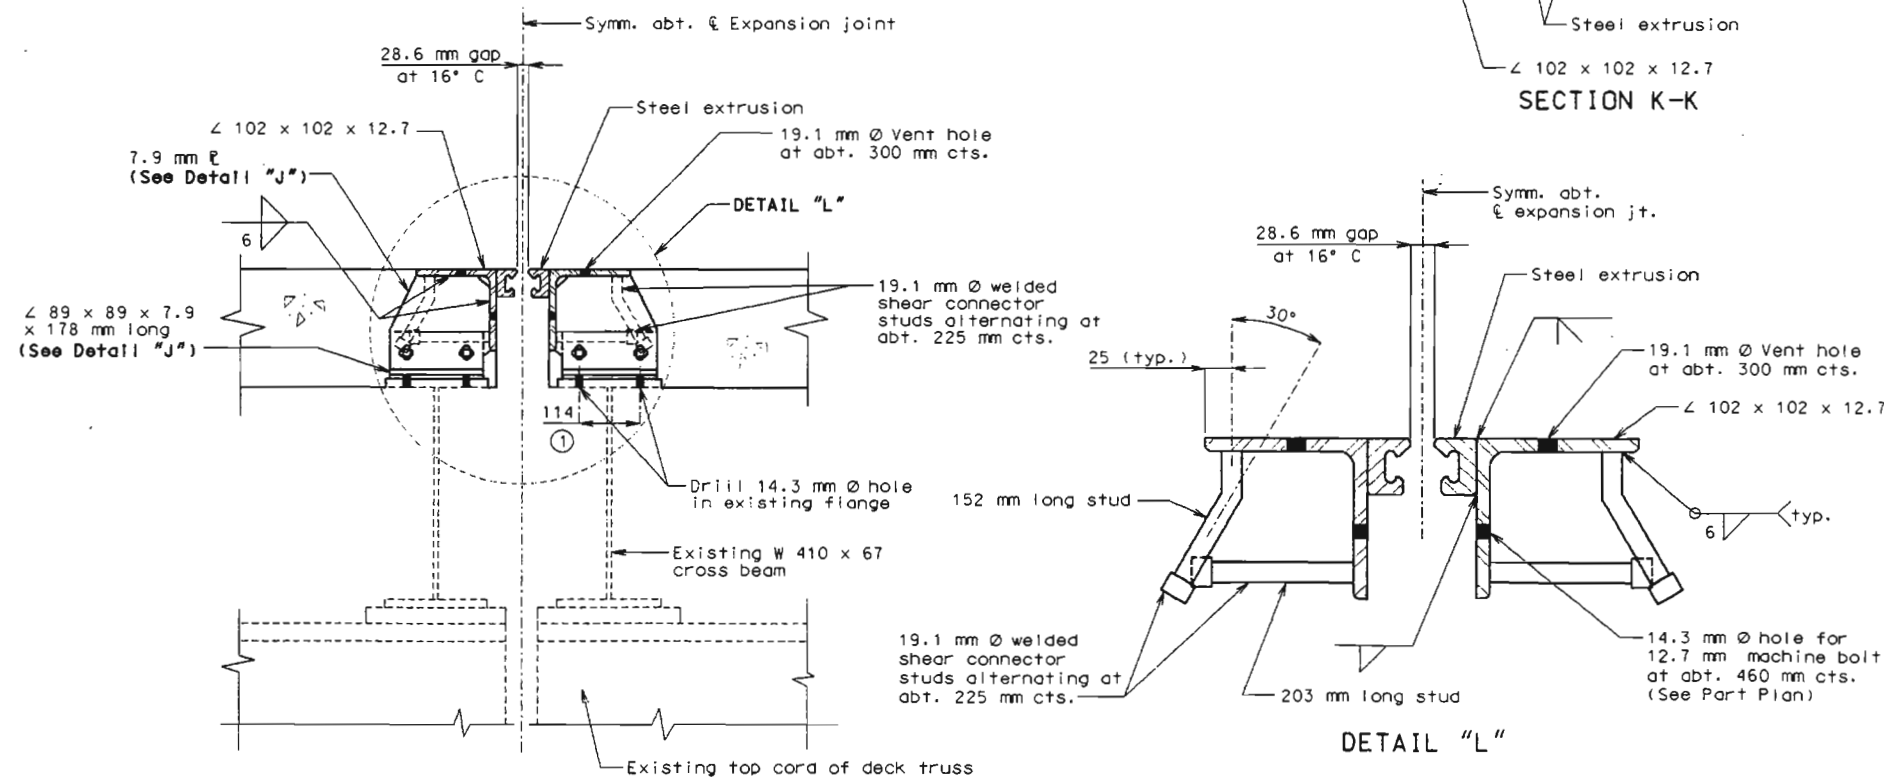

PART SECTION H-H

DETAIL "L"

DETAILS OF STRIP SEAL EXPANSION DEVICE AT BENTS NO. 5 & 14




Detailed June 1999
Checked July 1999

Sheet No. 18 of 46

PLATTE COUNTY

K04563

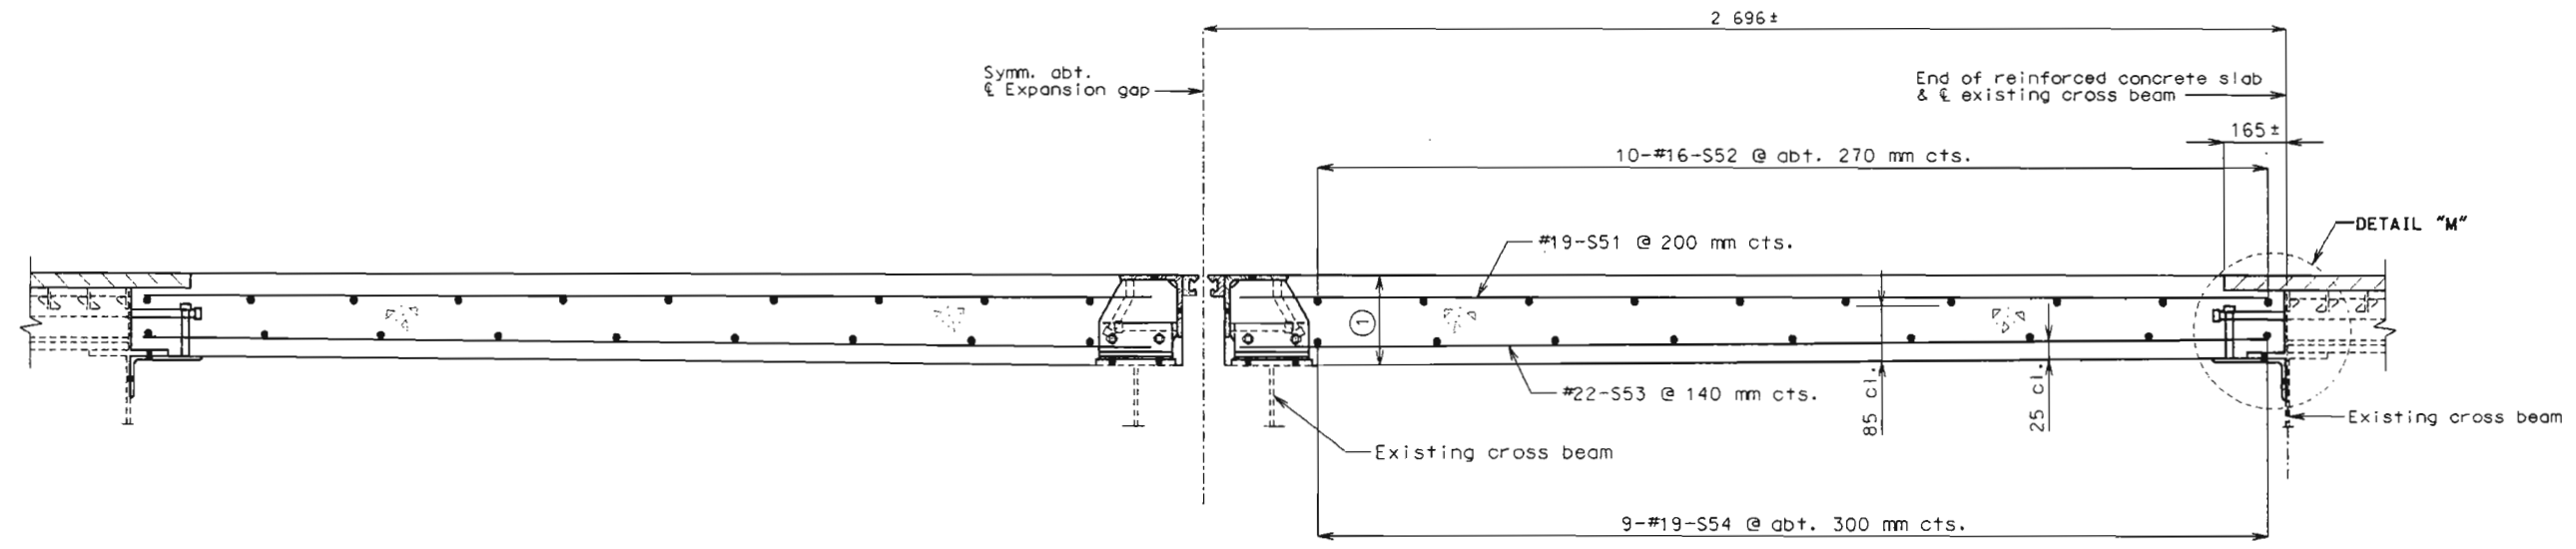

PART SPAN (4-5)
PART SPAN (15-14)


PART SPAN (5-6)
PART SPAN (14-13)

PART SECTION AT BENTS NO. 5 & 14

Note: For additional slab reinforcement at rail posts near expansion joint, see sheet no. 21.

	①
At crown of roadway	208
At gutter line	183

Note: Payment for furnishing and installing shear connector studs (except those for expansion device armor) and \angle 178 x 102 x 9.5 at cross beam shall be included in the contract unit price for Slab on Steel.

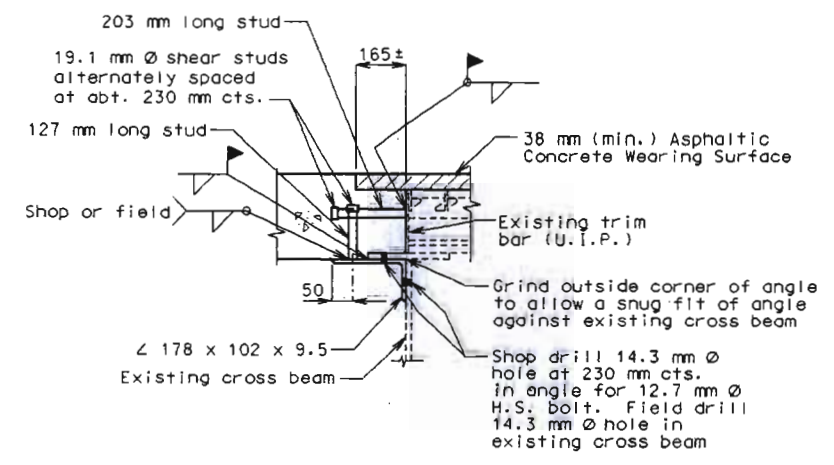

DETAIL "M"



DETAILS OF DECK REPLACEMENT AT BENTS NO. 5 & 14


Detailed June 1999
Checked July 1999

Sheet No. 19 of 46

PLATTE COUNTY


K04563

State	Proj. No.	Sheet No.
MO		B 20

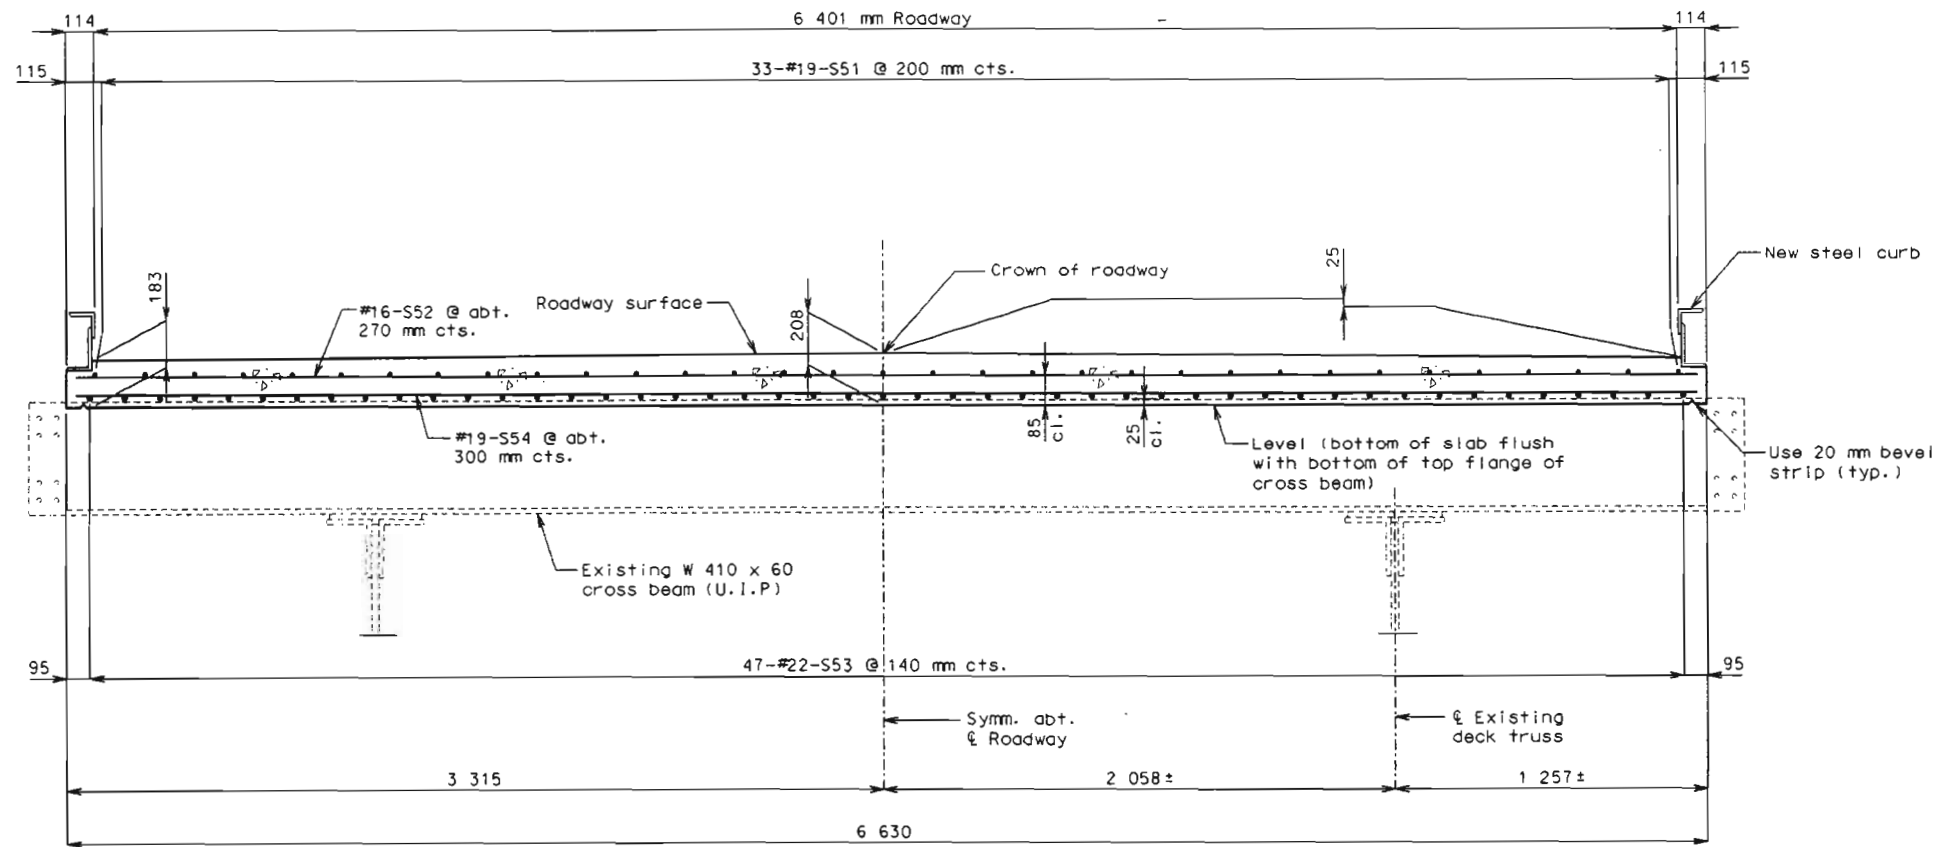

SECTION G-G


Note: For additional slab reinforcement at rail posts near expansion joint, see sheet no. 21.

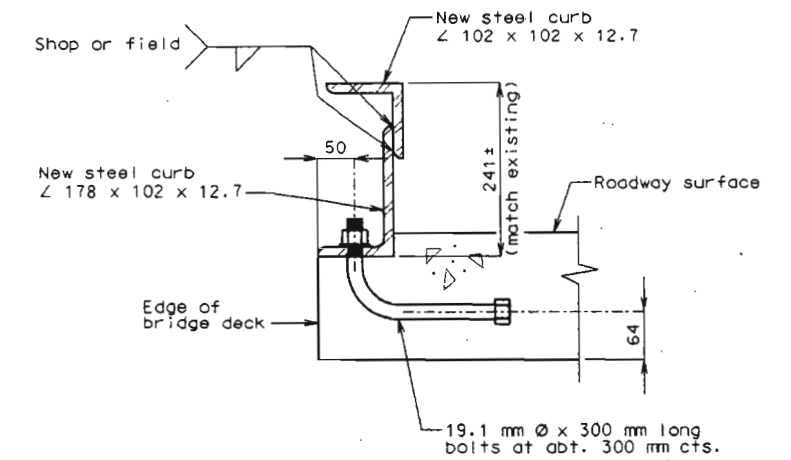


TYPICAL SECTION SHOWING STEEL CURB ATTACHMENT IN AREA OF NEW REINFORCED CONCRETE SLAB

Note: Top of new slab and expansion device shall conform to 25 mm crown of roadway.

For location of Sections F-F and G-G, see sheet no. 17.

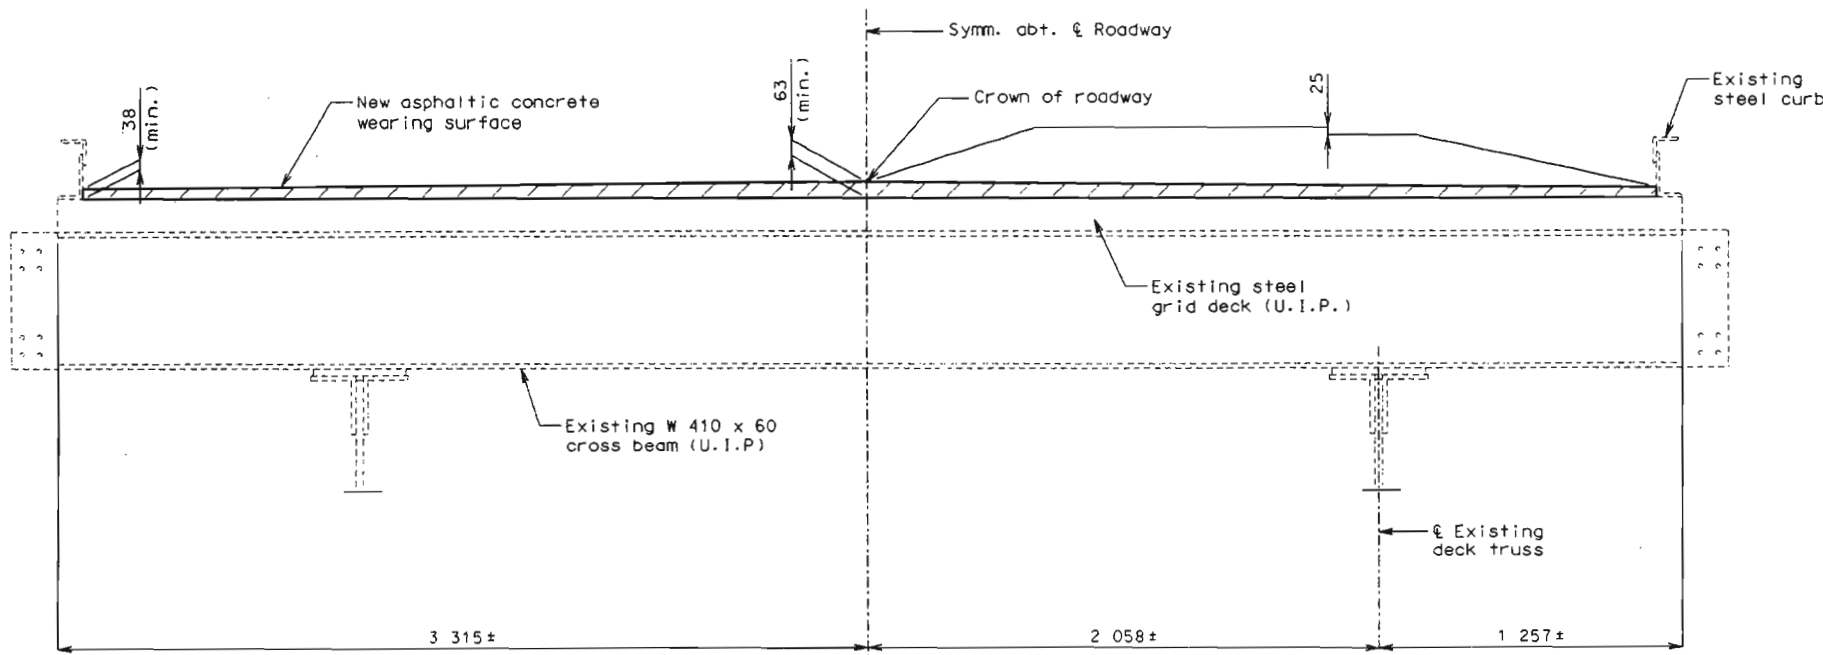

SECTION F-F

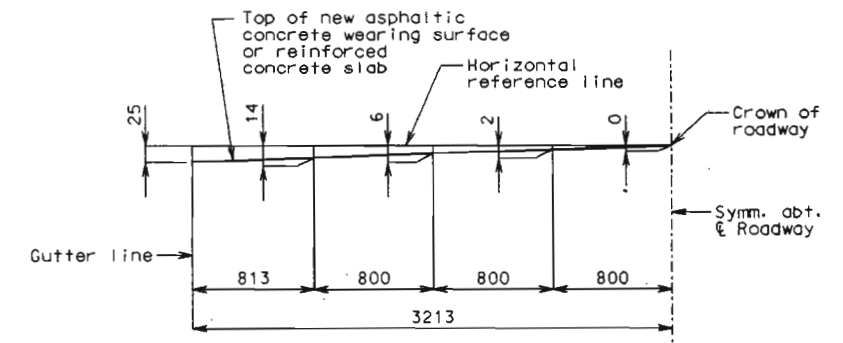

DETAIL OF ROADWAY CROWN

DETAILS OF DECK REPLACEMENT AT BENTS NO. 5 & 14

Detailed June 1999
Checked July 1999

Sheet No. 20 of 46

PLATTE COUNTY


K04563



State	Proj. No.	Sheet No.
MO		321

Note: Reuse rail post brackets in their present locations (as shown in plan and elevation views) with the new reinforced concrete slab.

* Reuse existing rail post bracket and washer plates


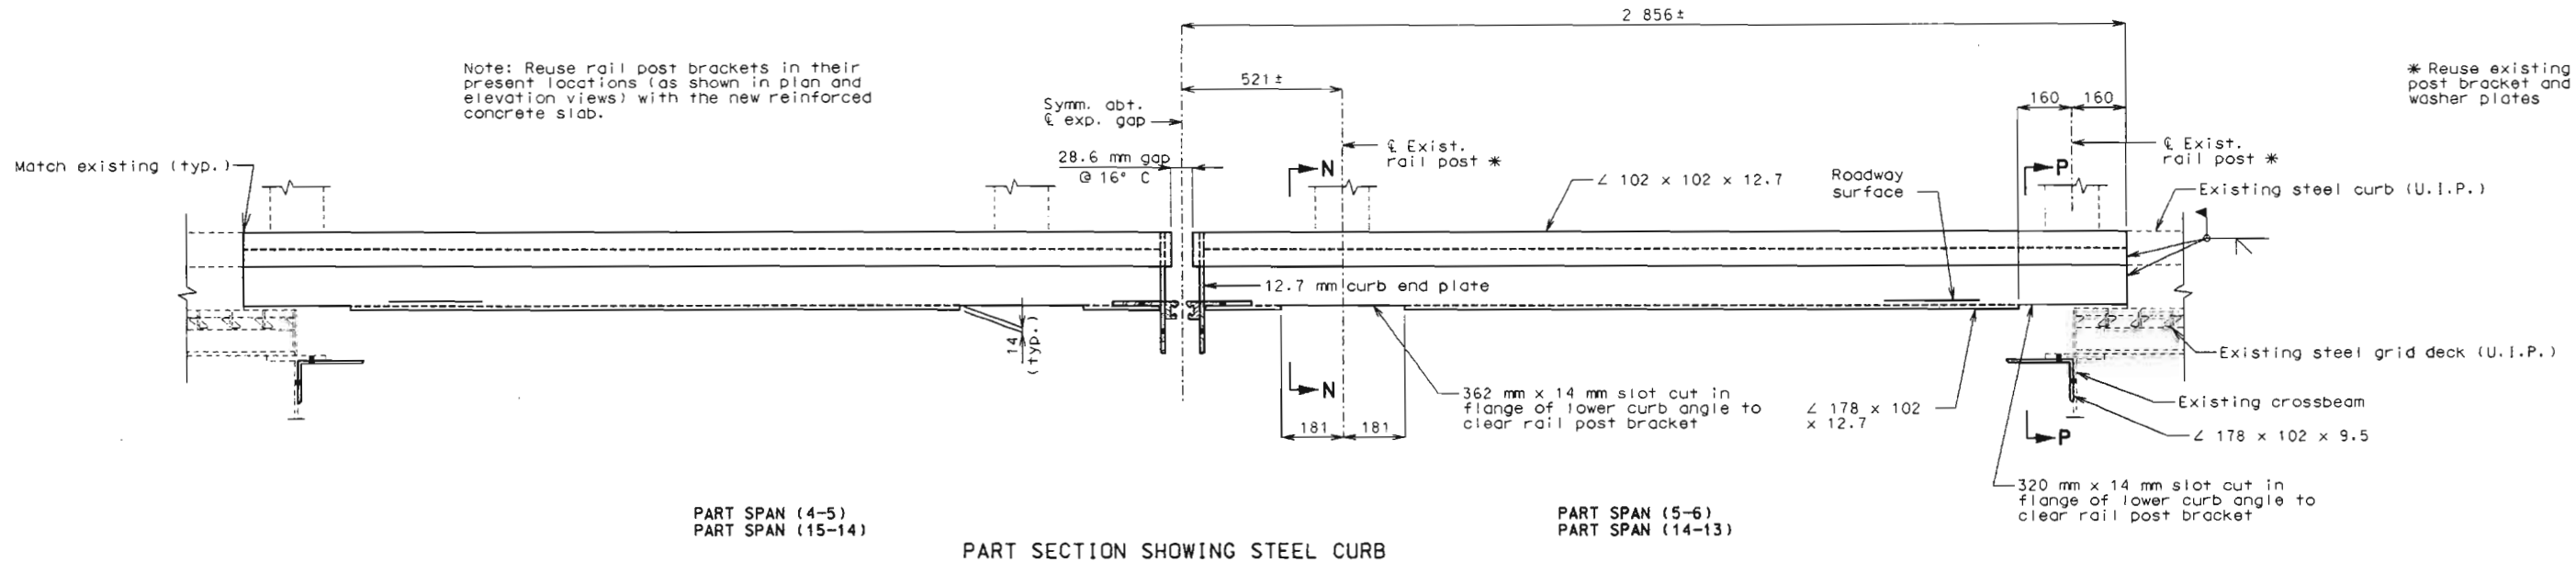


PART SPAN (4-5)
PART SPAN (15-14)


PART SPAN (5-6)
PART SPAN (14-13)

PART SECTION SHOWING STEEL CURB


① Blockout to be filled with asphaltic concrete after installation of rail post brackets.

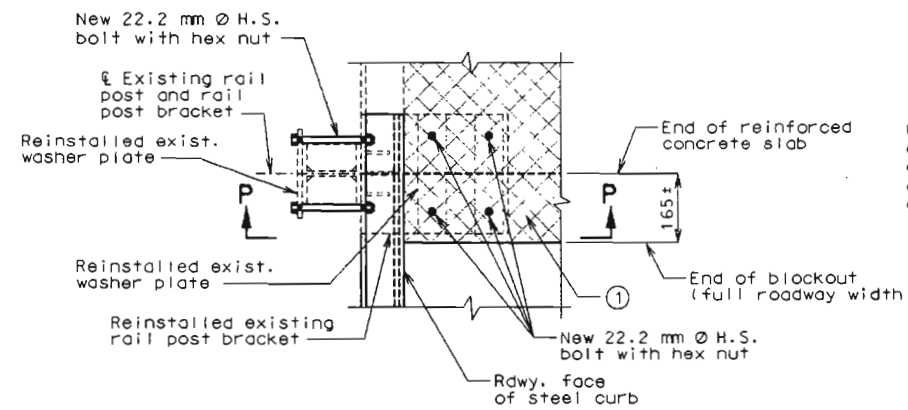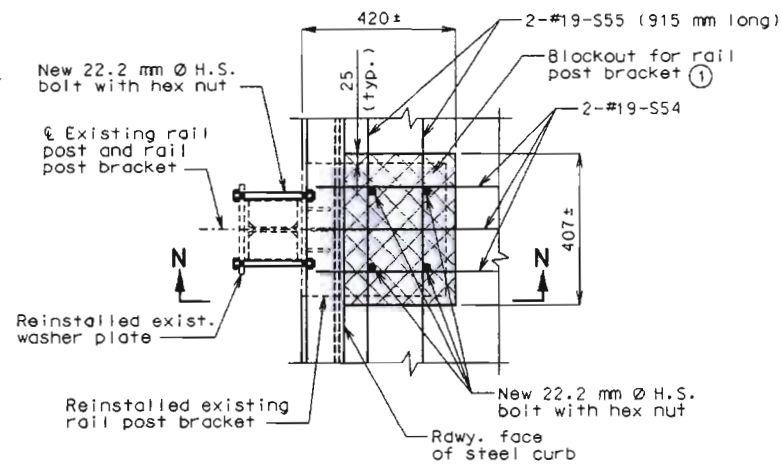


PART PLAN

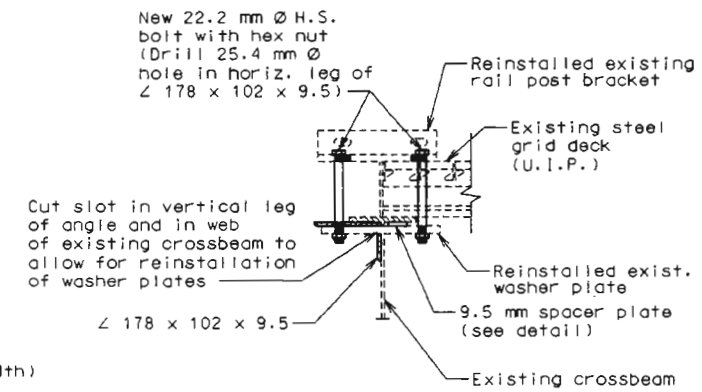


DETAIL "Q"
(Steel curb not shown for clarity)

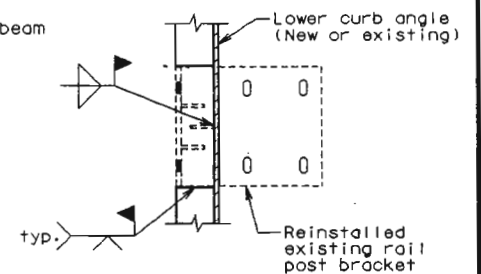


PART SECTION R-R
(Showing field welds)

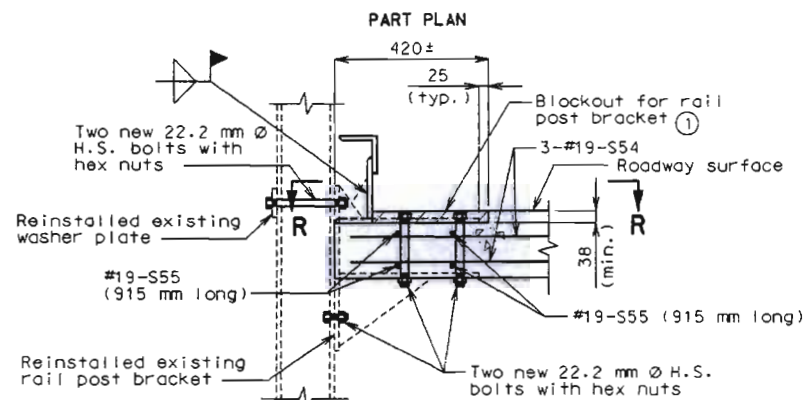

PART SECTION N-N

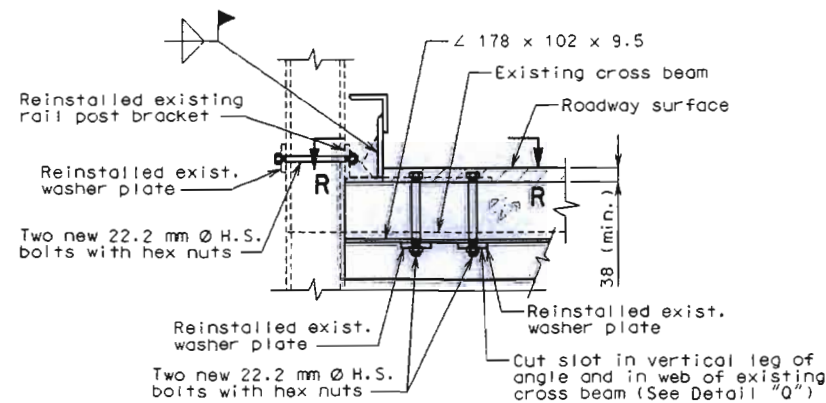

PART SECTION P-P

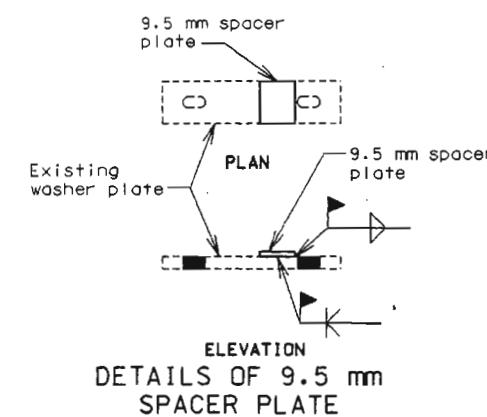

ELEVATION
DETAILS OF 9.5 mm
SPACER PLATE

DETAILS OF STEEL CURB & RAIL POST ATTACHMENT AT BENTS NO. 5 & 14


Detailed June 1999
Checked July 1999

Sheet No. 21 of 46

PLATTE COUNTY

K04563



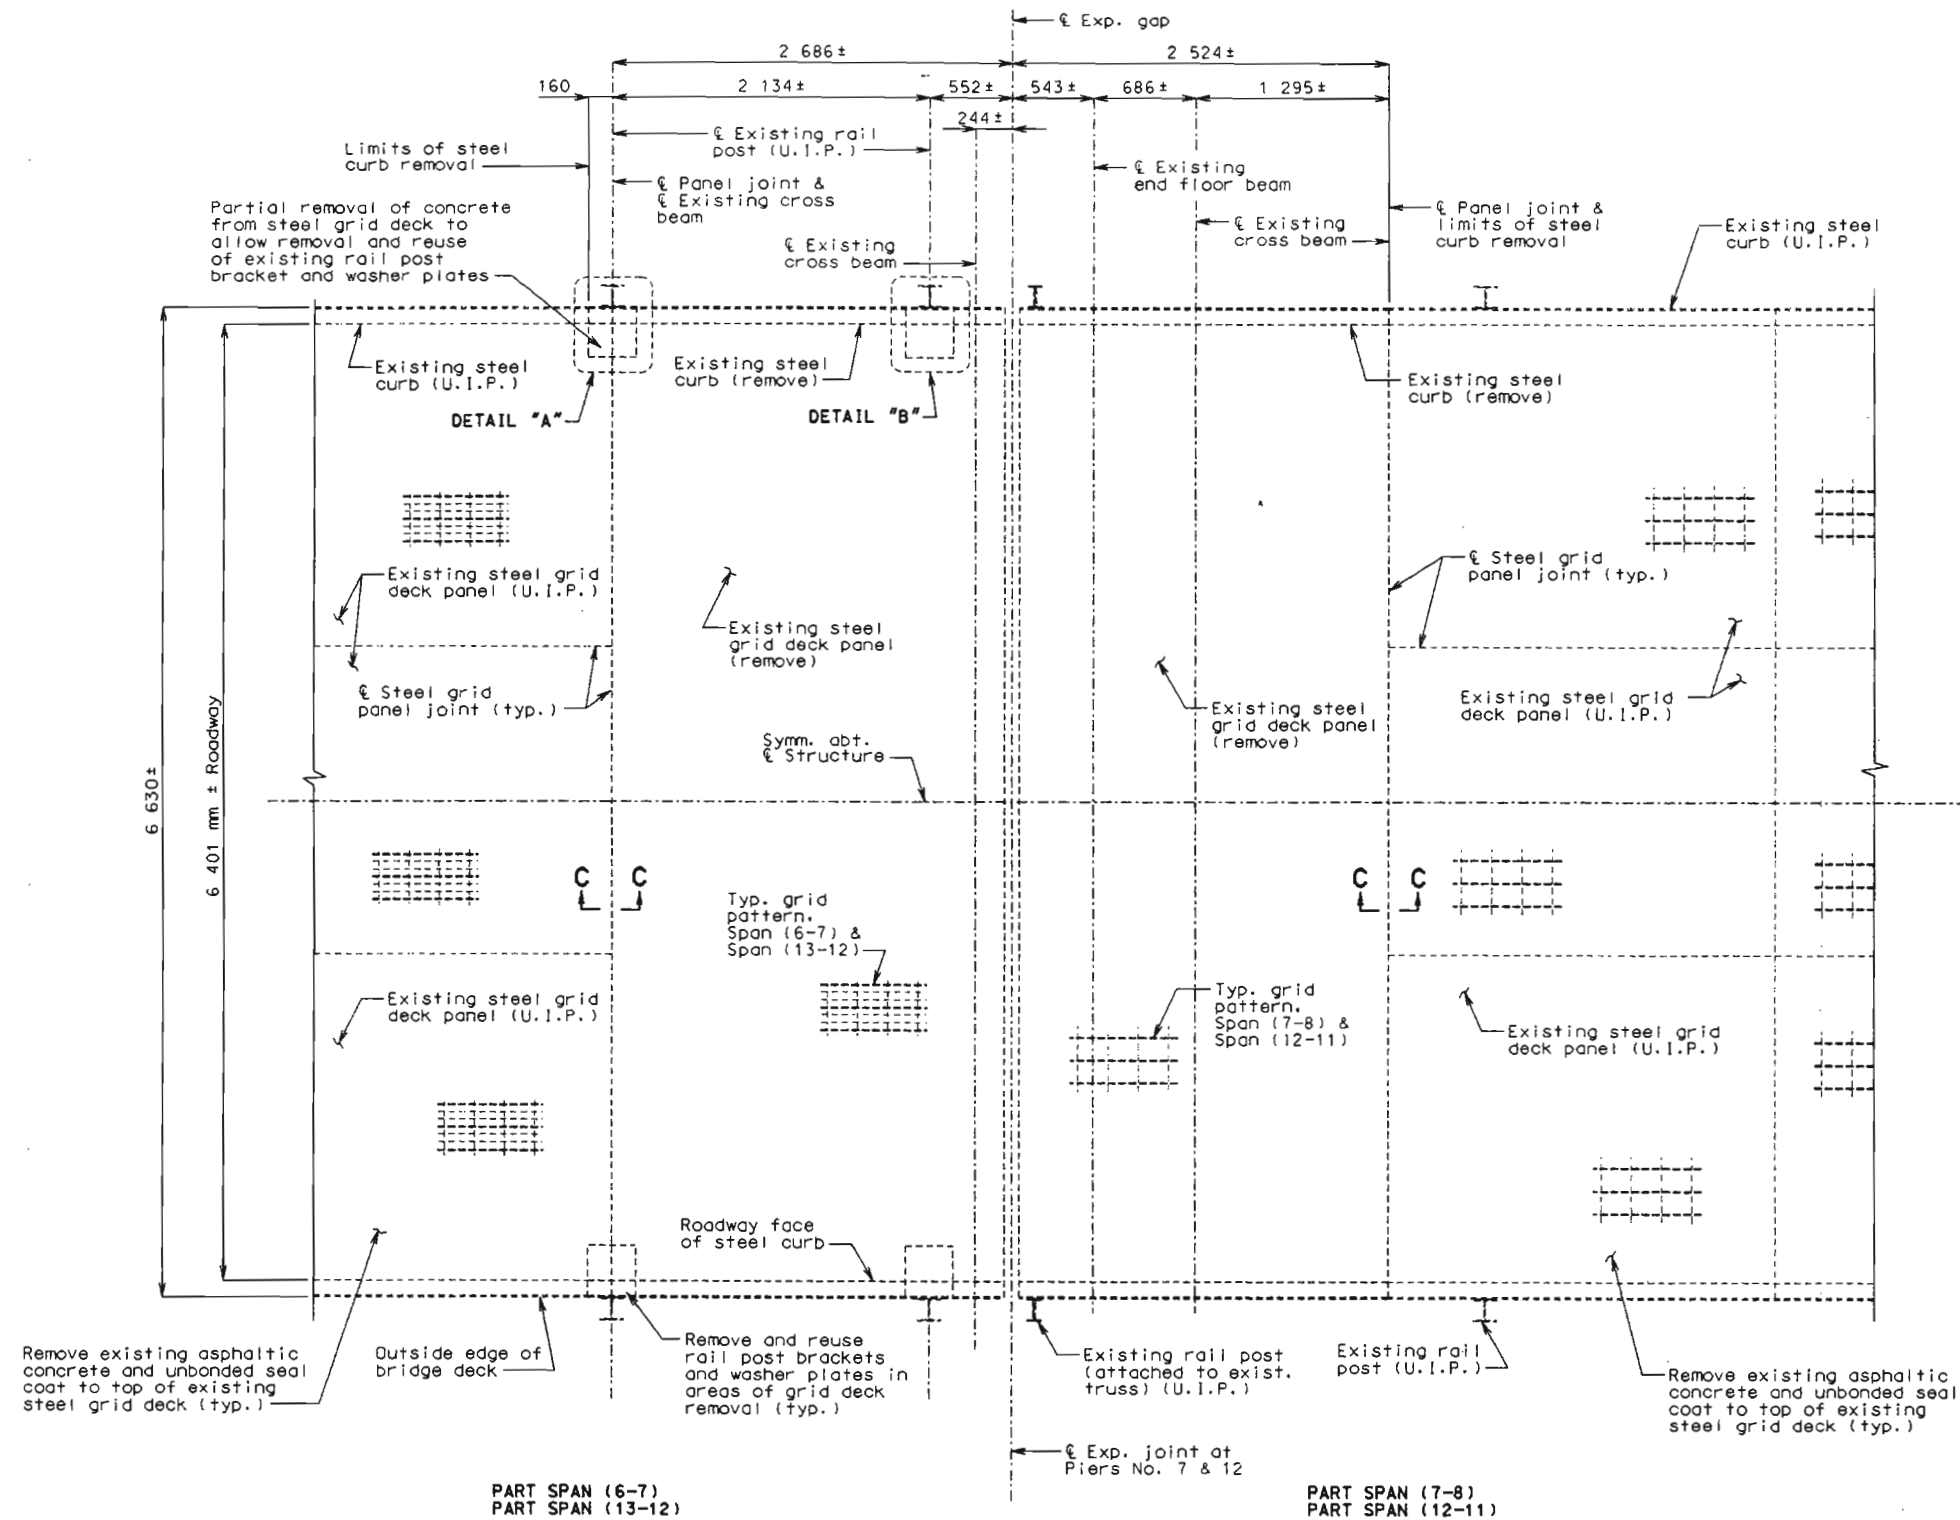

PART PLAN OF EXISTING DECK


Note: Removed rail post brackets and washer plates shall be cleaned and coated with a prime coat of the specified coating system before reinstallation with the new slab.

Payment for the removal of steel curb, rail post brackets and washer plates, as designated on the plans, shall be included in the contract unit price for Partial Removal of Existing Steel Grid Deck.

Note: For Details "A" & "B" and Section C-C, see sheet no. 23.



State	Proj. No.	Sheet No.
MO		B24

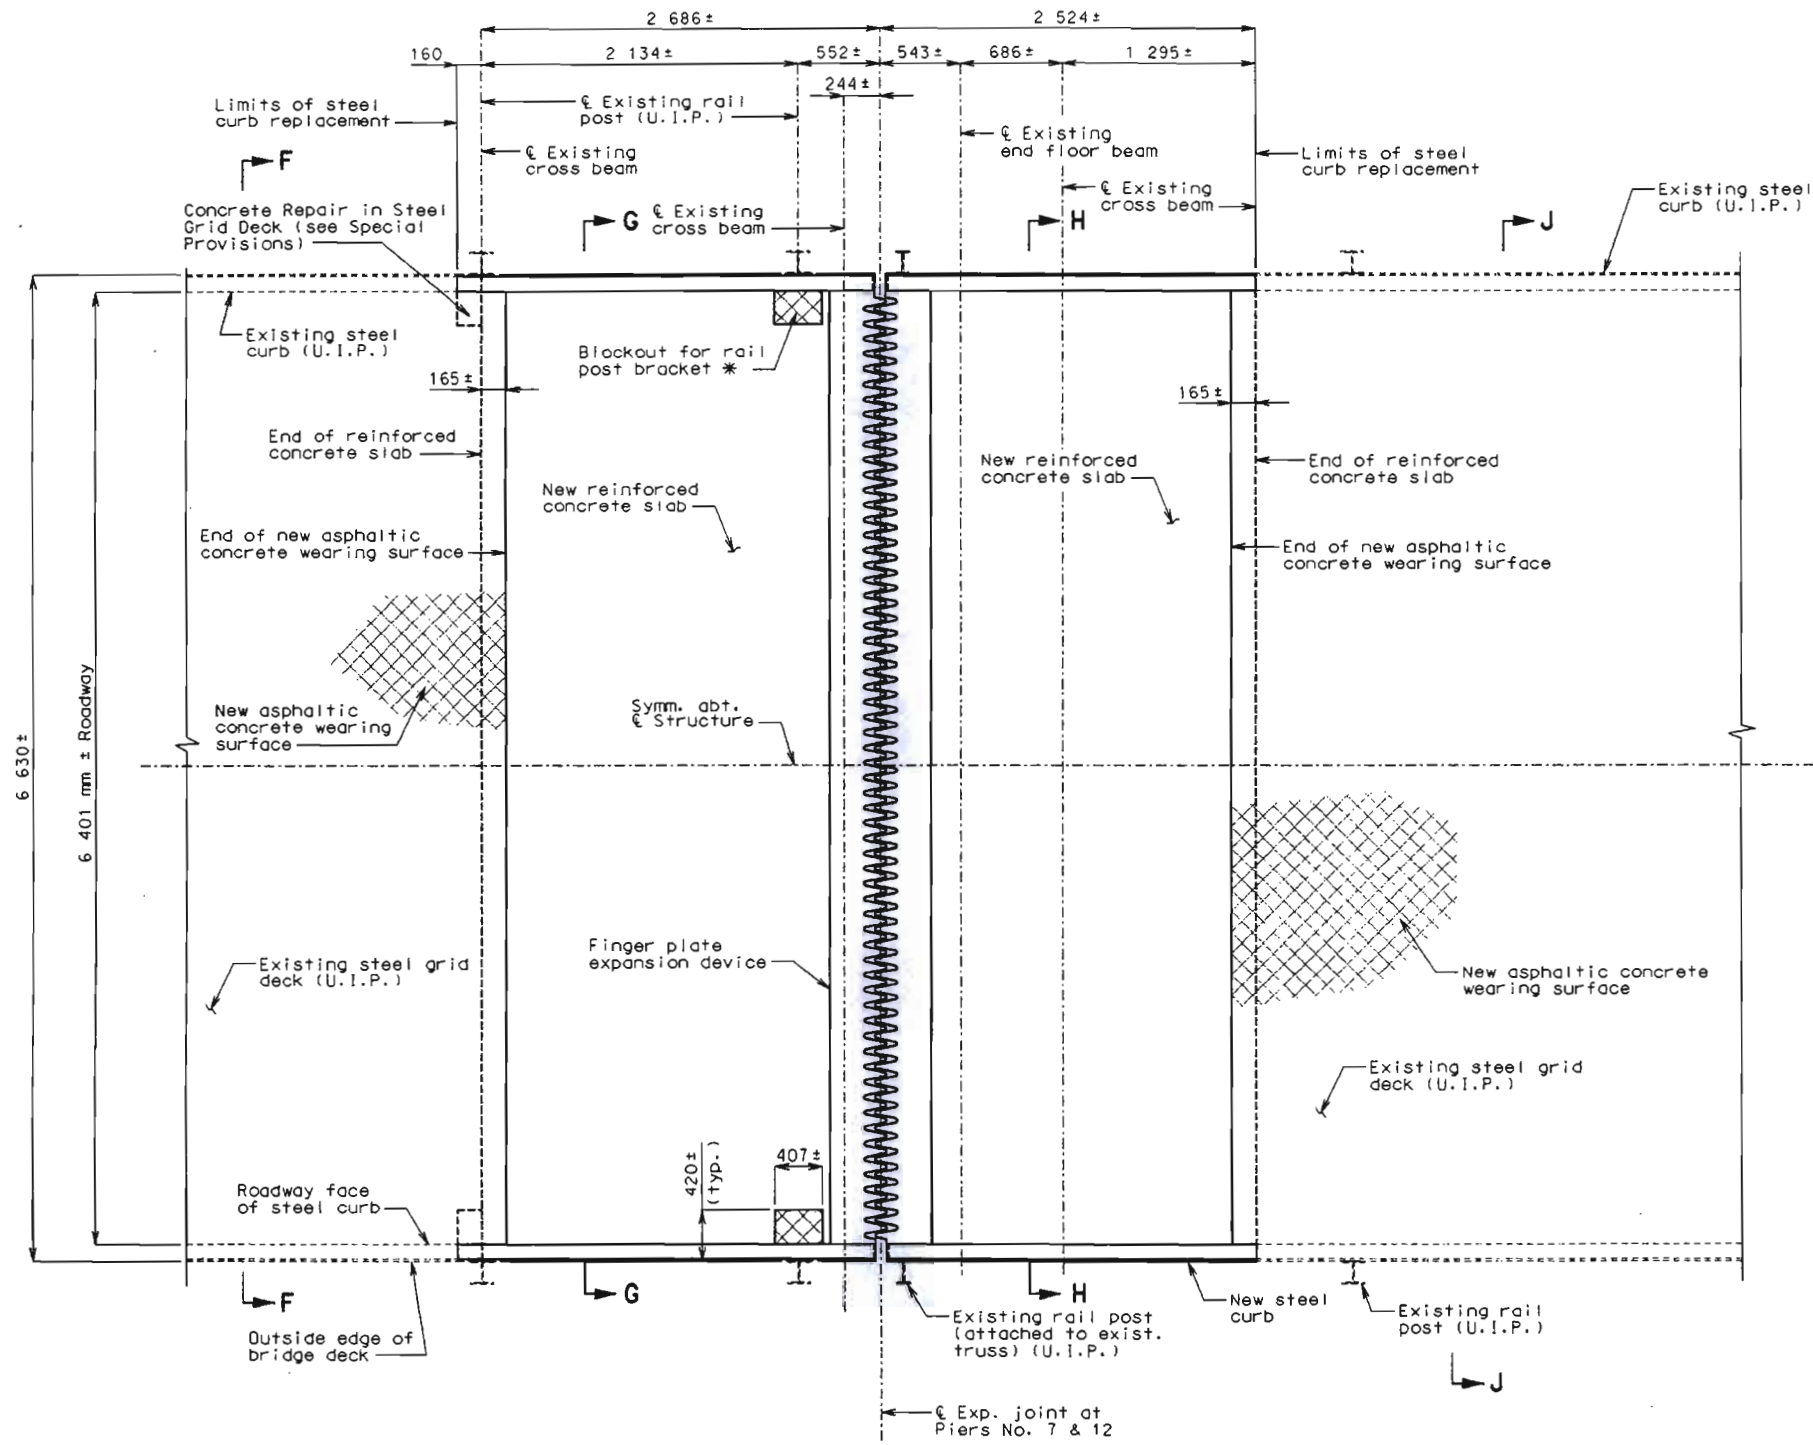

PART SPAN (6-7)
PART SPAN (13-12)

PART SPAN (7-8)
PART SPAN (12-11)

PART PLAN

Note: For Sections F-F and J-J, see sheet no. 29.
For Sections G-G and H-H, see sheet no. 27.
For longitudinal section thru new reinforced concrete slabs, see sheet no. 26.
For details of finger plate expansion device, see sheet no. 25.
For details of new steel curb and rail post attachments, see sheet no. 28.

* Blockout to be filled with asphaltic concrete after installation of rail post bracket.

Details for steel curb replacement have been developed based on available plans and on using the existing rail posts in their present locations. The contractor shall verify the existing rail post locations before ordering steel curb replacement.

Payment for the reinstatement of the existing rail post brackets and washer plates with new H.S. bolts, hex nuts, and washers shall be included in the contract unit price for Slab on Steel.

Payment for furnishing and installing new steel curb with anchor bolts, hex nuts, and washers shall be included in the contract unit price for Steel Curb.



DETAILS OF DECK REPLACEMENT AT PIERS NO. 7 & 12


Detailed June 1999
Checked July 1999

Sheet No. 24 of 46


PLATTE COUNTY

K04563

State	Proj. No.	Sheet No.
MO		B25

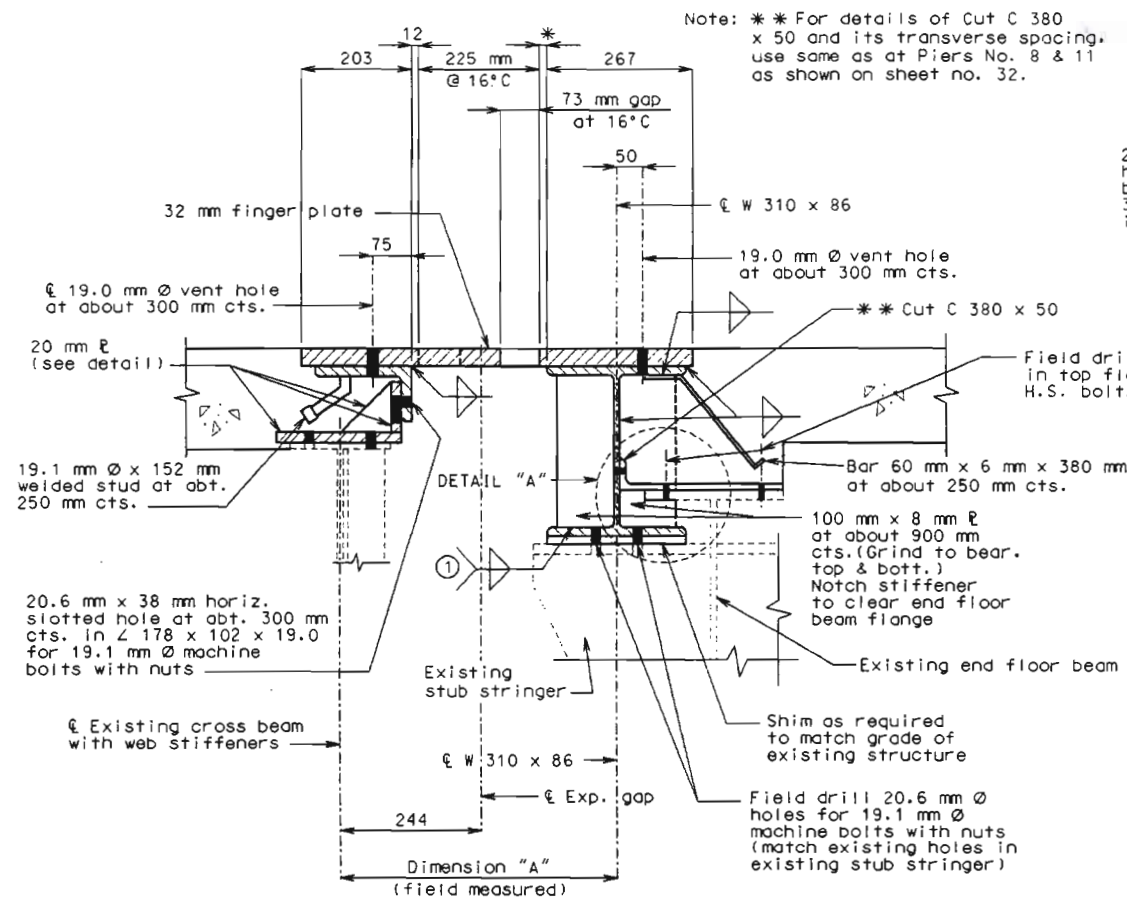

PART SECTION THRU EXPANSION DEVICE

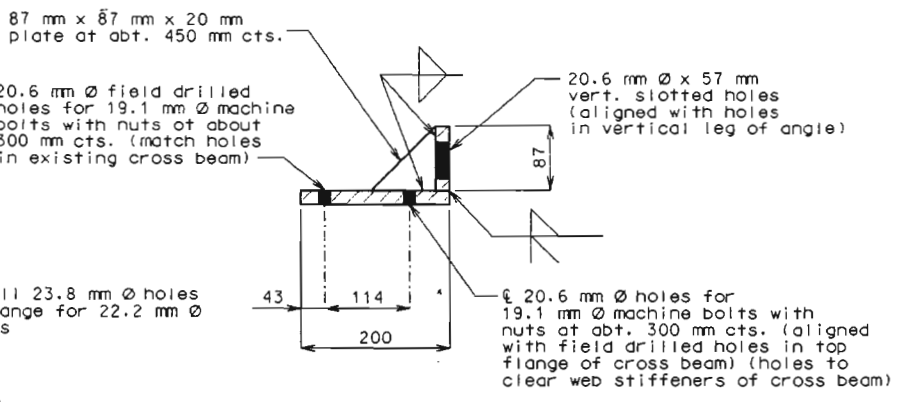

DETAIL OF 20 mm PLATES

① Top & bottom, each side of WF

* Dimension "A" (adjusted to 16°C) minus 484 mm (12 mm min.)
 Note: If dimension "*" exceeds 100 mm, then center the expansion gap on dimension "A" and modify all details affected by the shift of expansion gap.

Note: Concrete shall be forced under and around finger plate supporting hardware and studs. Proper consolidation of the concrete shall be achieved by localized internal vibration.

GENERAL NOTES:

Finger plates shall be cut with a machine guided gas torch from one plate. The plate from which fingers are cut may be spliced before fingers are cut. The surface of cut shall be perpendicular to the surface of the plate. The cut shall not exceed 3 mm in width. The centerline of cut shall not deviate more than 2 mm from the position of centerline of cut shown. No splicing of finger plate or finger plate assembly will be allowed after fingers are cut.

Plan dimensions are based on installation at 16 degree Celsius. The expansion gap and other dimensions shall be increased 5.4 mm for each 5 degree Celsius fall in temperature and decreased 5.4 mm for each 5 degree Celsius rise in temperature at installation.

Structural steel for the expansion device shall be coated with a minimum of two coats of inorganic zinc primer (125 micrometer minimum thickness) or galvanized in accordance with the ASTM A123. Anchors need not be protected from overspray.

Payment for furnishing, coating or galvanizing, and installing structural steel for the expansion device will be made at the contract unit price for Expansion Device (Finger Plate) per meter.


All holes shown for connections to be subpunched 20.6 mm (Shop or field drill) and reamed to 23.8 mm in field.

32 mm Finger Plate, W 310 x 86; and L 178 x 102 x 19.0 shall be bent to conform to crown of roadway.


Longitudinal reinforcing steel shall be placed so that ends shall not be more than 25 mm from 20 mm vertical plate, or web of W 310 x 86, at expansion device.

Material for the expansion device shall be ASTM A709M Grade 250 structural steel. Anchors for the expansion device shall be approved stud welded anchors (C1010 thru C1020).


Removal of existing expansion device and support for steel grid on top of stub stringer is included in the contract unit price for Partial Removal of Existing Steel Grid Deck.

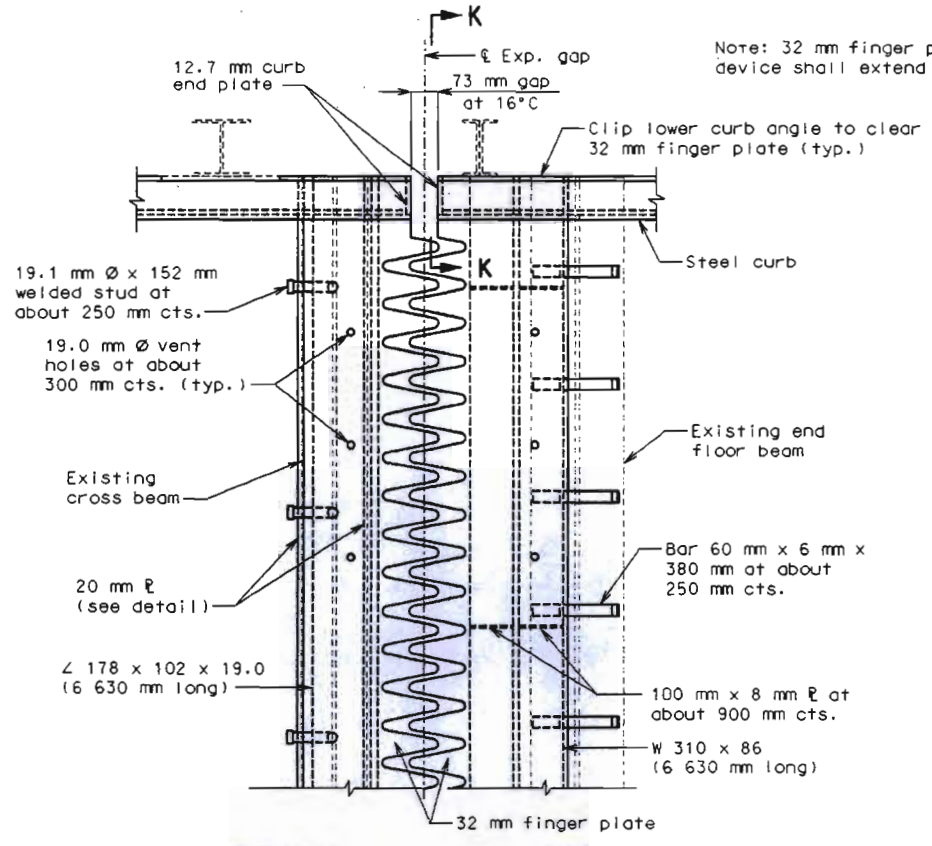


PART PLAN OF EXPANSION DEVICE

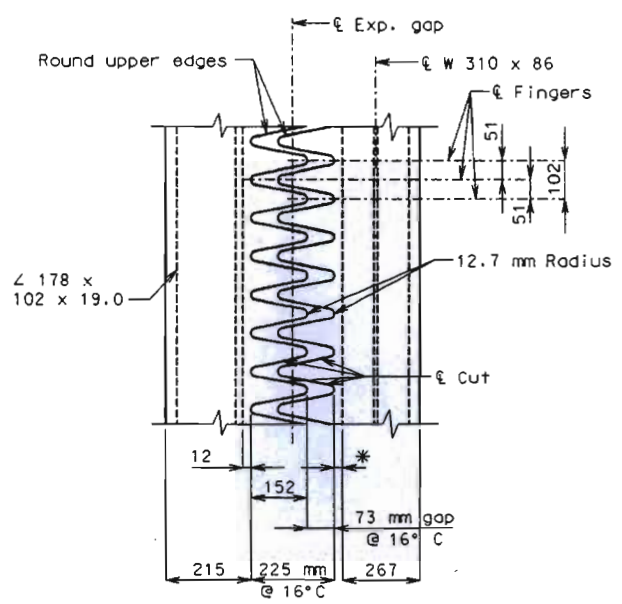

TYPICAL PLAN OF PLATE

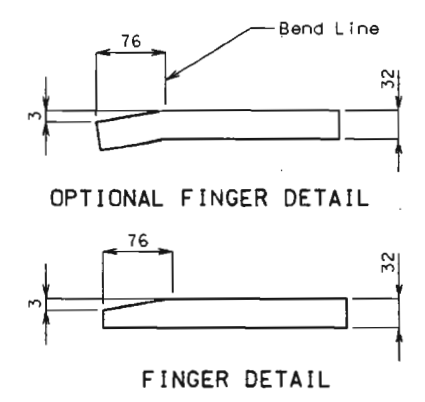


DETAIL "A" SHOWING NOTCH IN STIFFENER AT TOP FLANGE OF END FLOOR BEAM (CUT CHANNEL NOT SHOWN FOR CLARITY)

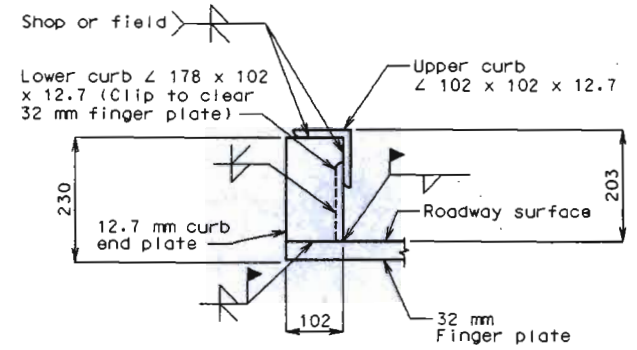

SECTION K-K




Detailed June 1999
 Checked July 1999

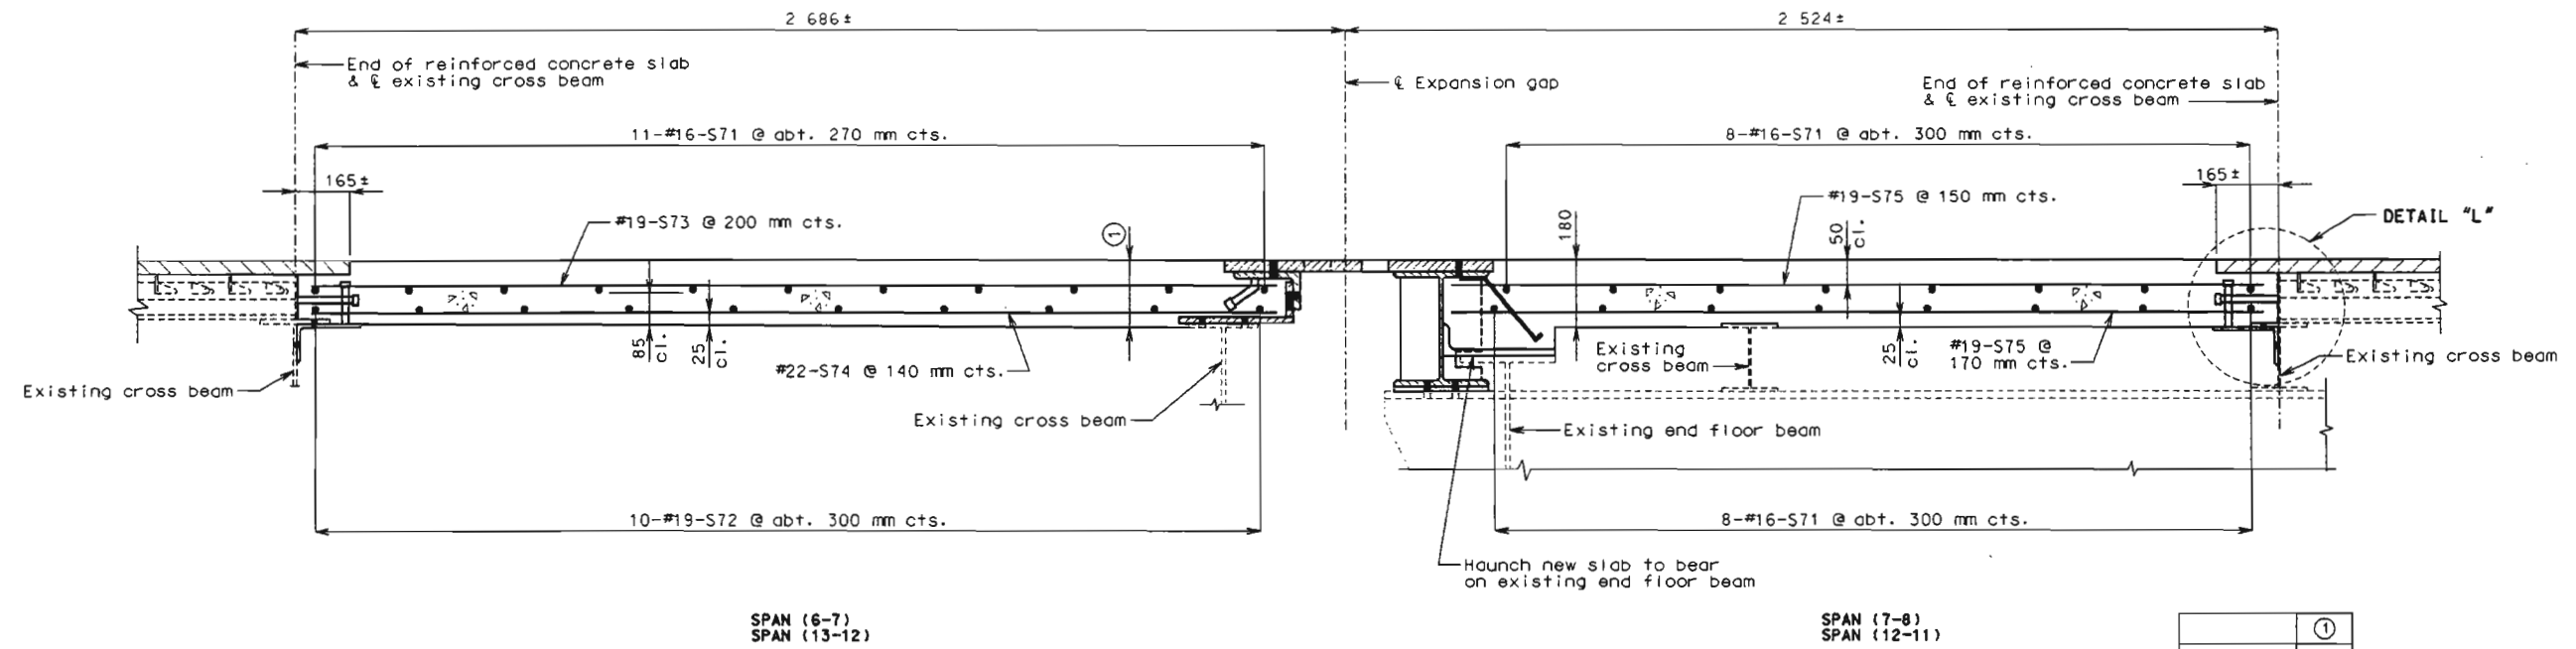

PART SECTION AT PIERS NO. 7 & 12

	①
At crown of roadway	208
At gutter line	183

Note: For additional slab reinforcement at rail posts in deck truss spans near expansion joint, see sheet no. 28.

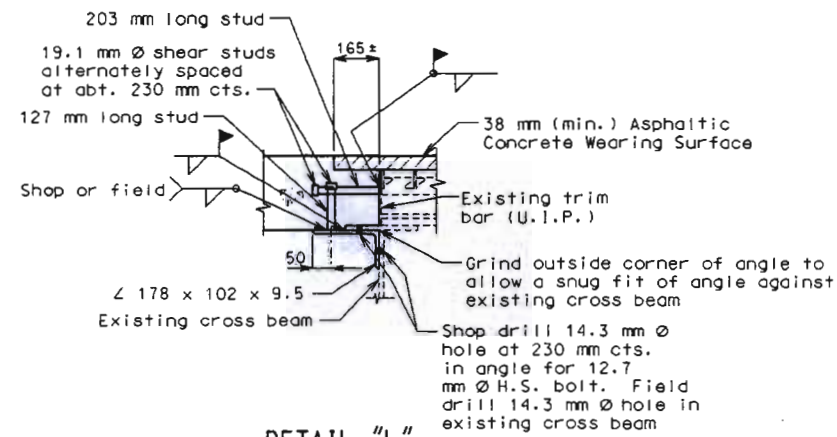


DETAIL "L"
Spans (7-8) & (12-13) shown
Spans (6-7) & (11-12) by opposite hand

Note: Payment for furnishing and installing shear connector studs (except those for expansion device armor) and L 178 x 102 x 9.5 at cross beam shall be included in the contract unit price for Slab on Steel.




DETAILS OF DECK REPLACEMENT AT PIERS NO. 7 & 12

State	Proj. No.	Sheet No.
MO		B 27

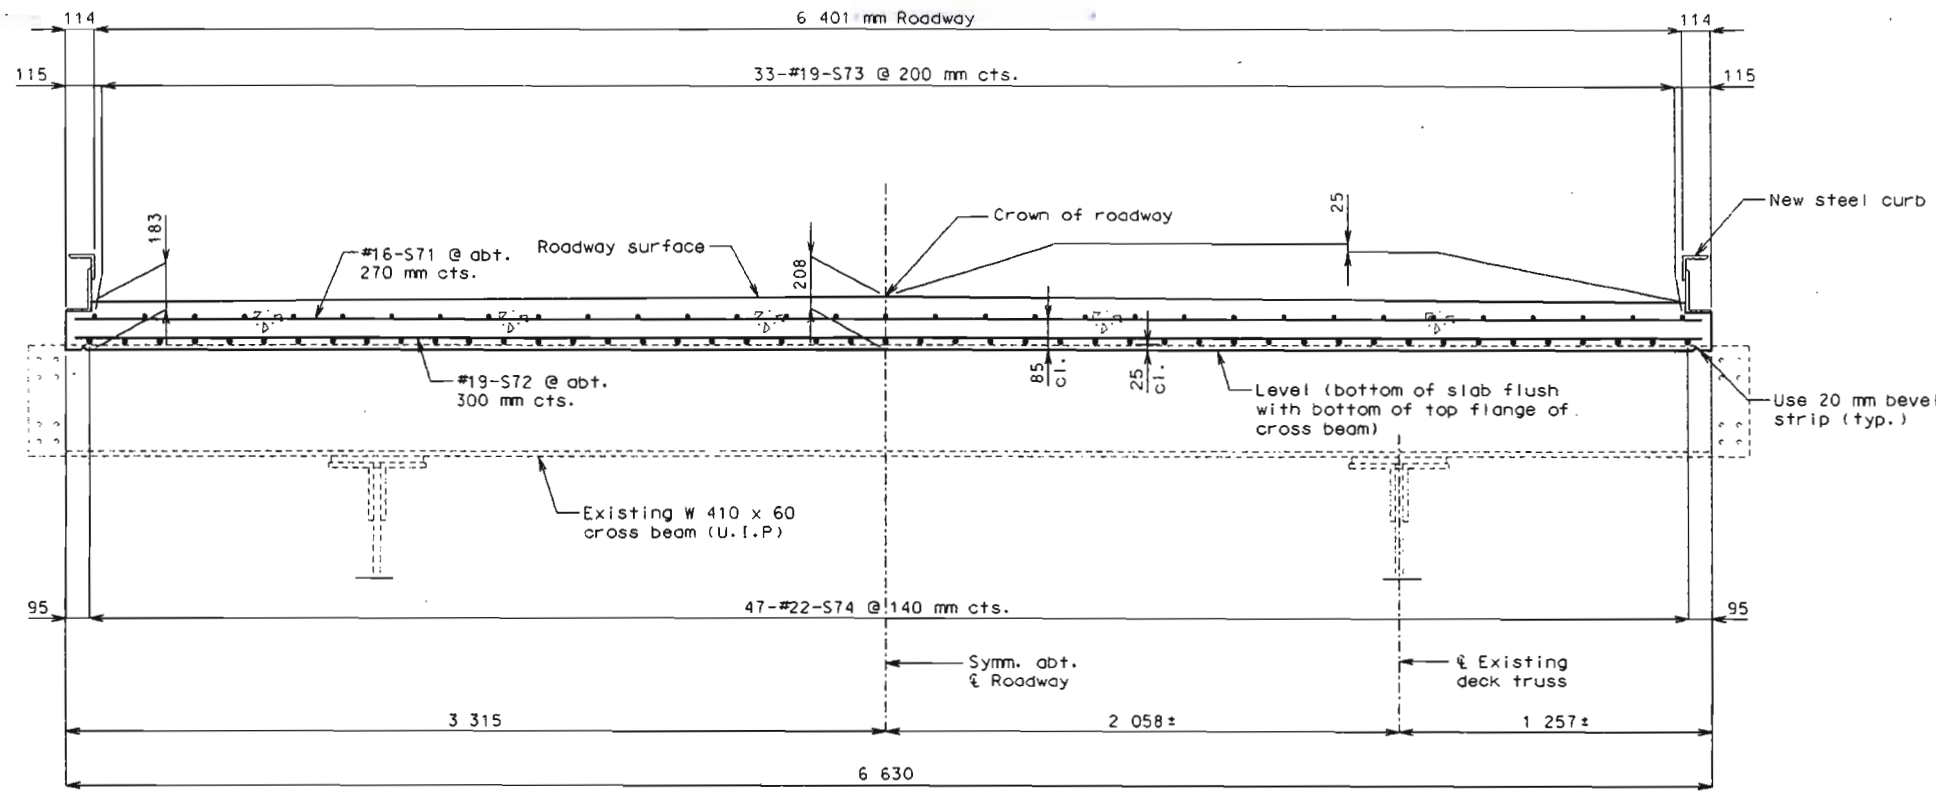

SECTION G-G

Note: For additional slab reinforcement at rail posts in deck truss spans near expansion joint, see sheet no. 28.

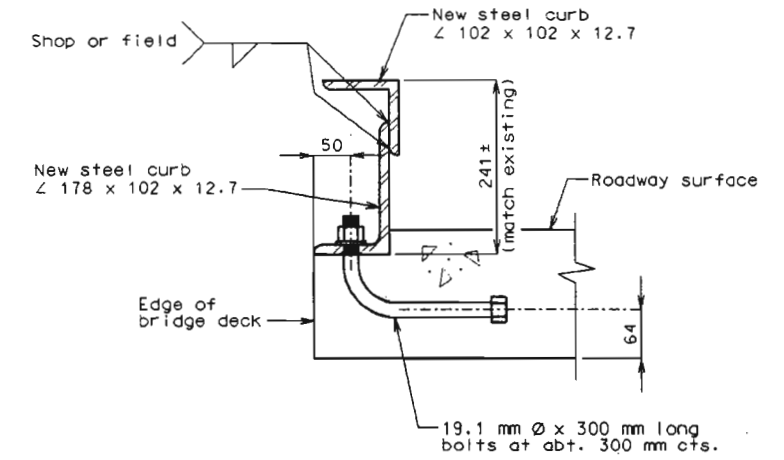


TYPICAL SECTION SHOWING STEEL CURB ATTACHMENT IN AREA OF NEW REINFORCED CONCRETE SLAB

Note: Top of new slab and expansion device shall conform to 25 mm crown of roadway.

For details of roadway crown, see sheet no. 29.

For location of Sections G-G and H-H, see sheet no. 24.

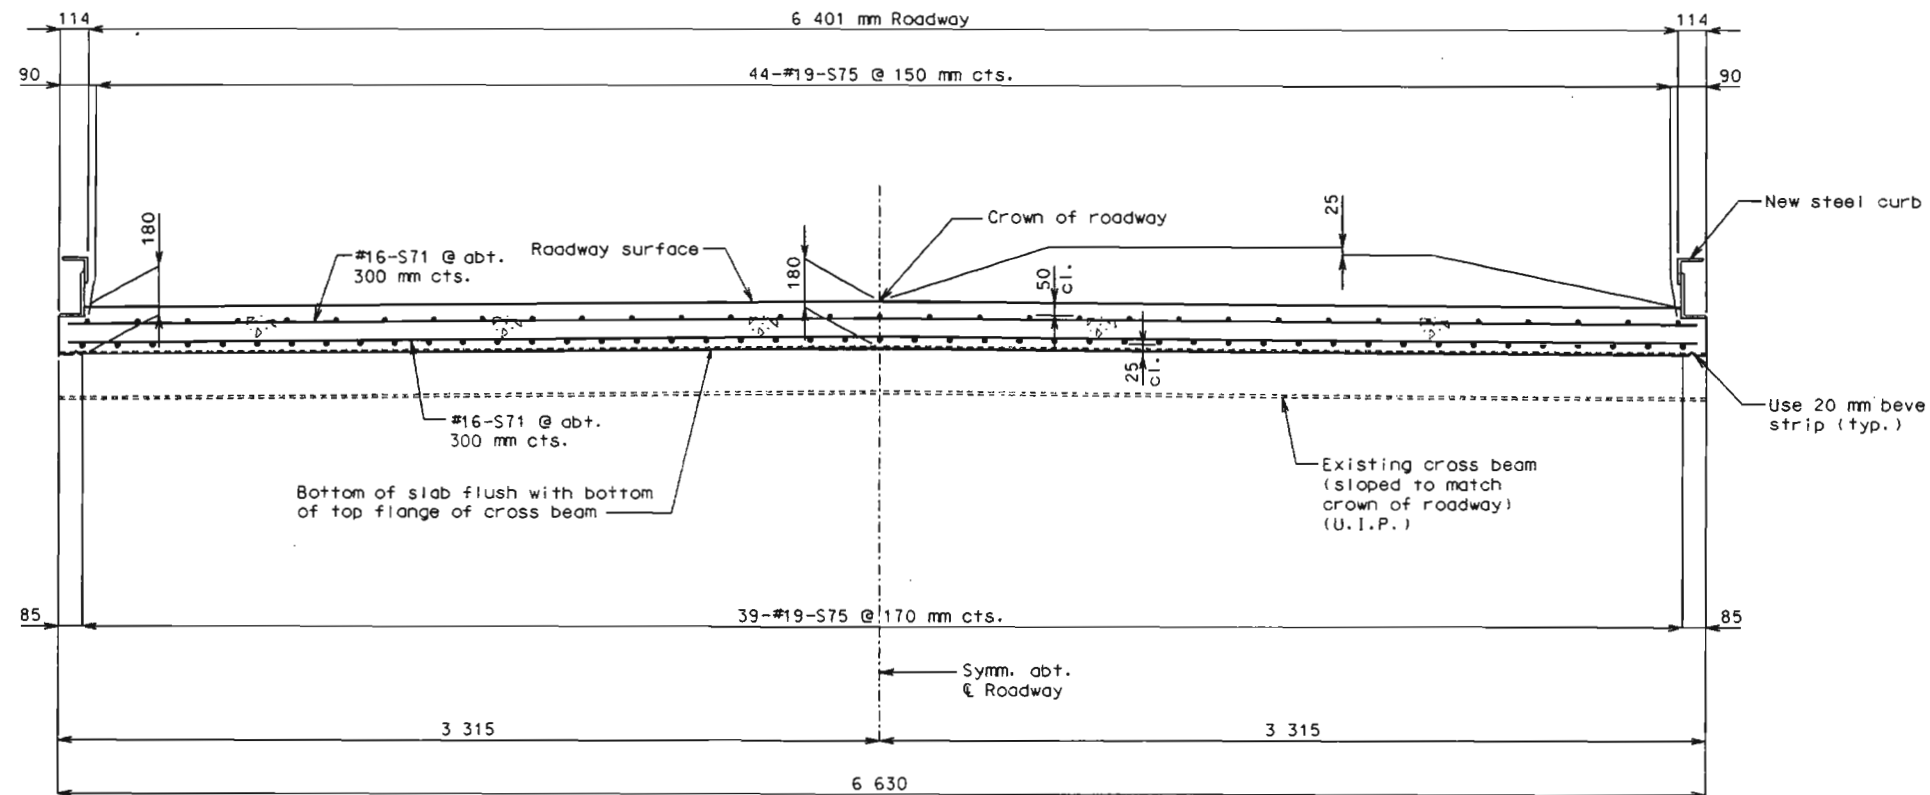

SECTION H-H

DETAILS OF DECK REPLACEMENT AT PIERS NO. 7 & 12




Detailed June 1999
Checked July 1999

Sheet No. 27 of 46

PLATTE COUNTY

K04563


State	Proj. No.	Sheet No.
MO		132P

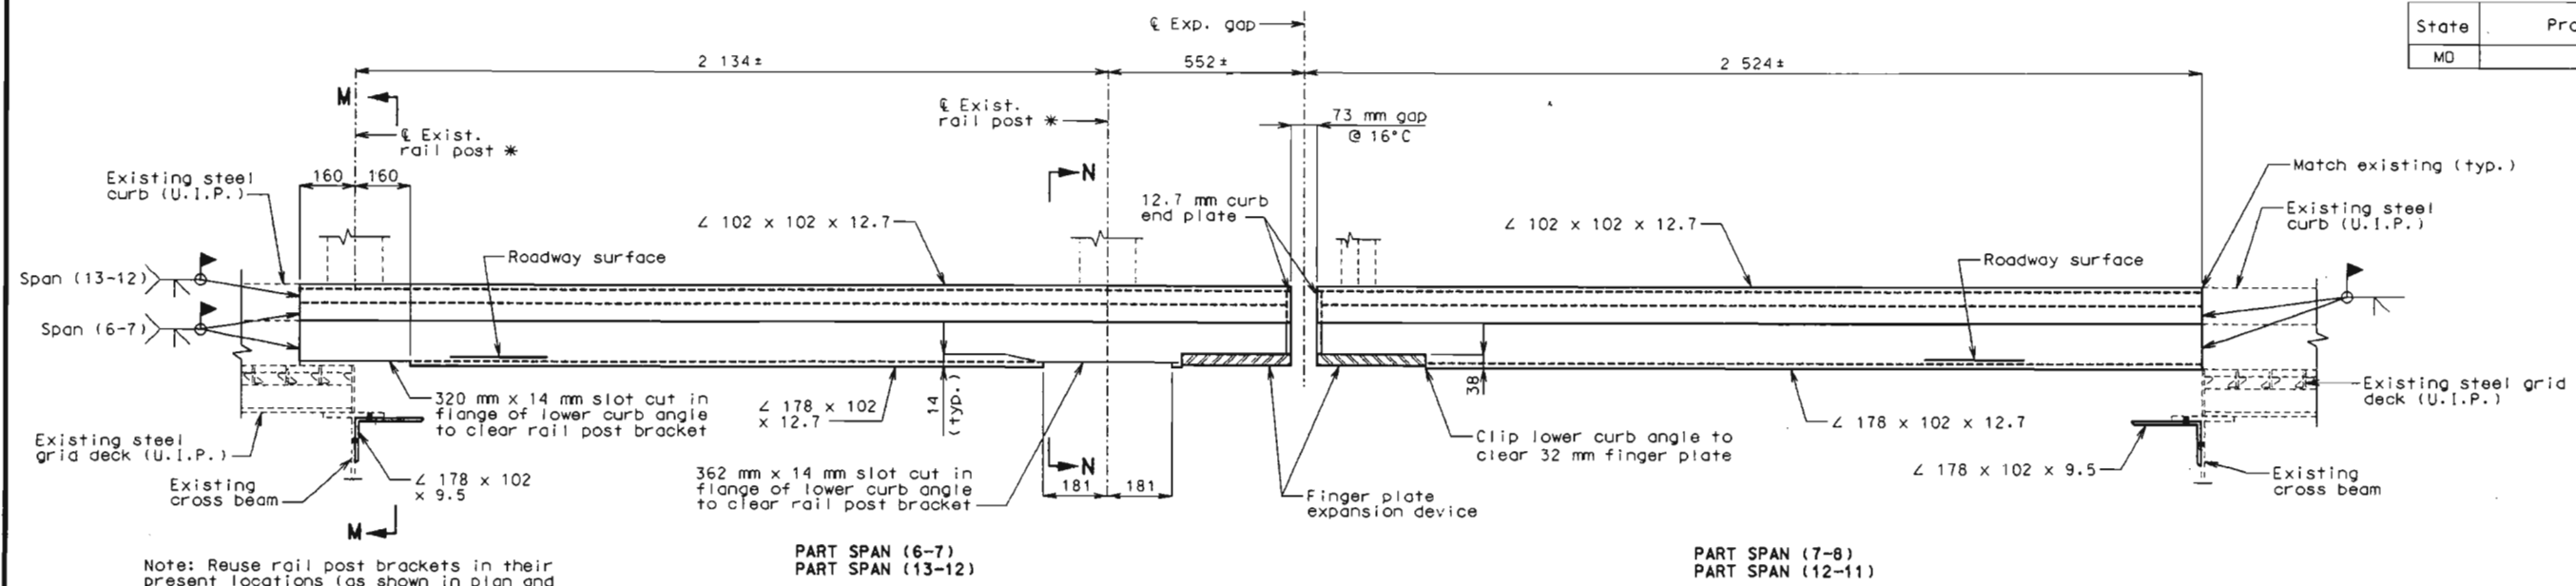


PART SECTION SHOWING STEEL CURB
(LEFT SIDE SHOWN, RIGHT SIDE SIMILAR)

* Reuse existing rail post bracket and washer plates.


① Blockout to be filled with asphaltic concrete after installation of rail post brackets.

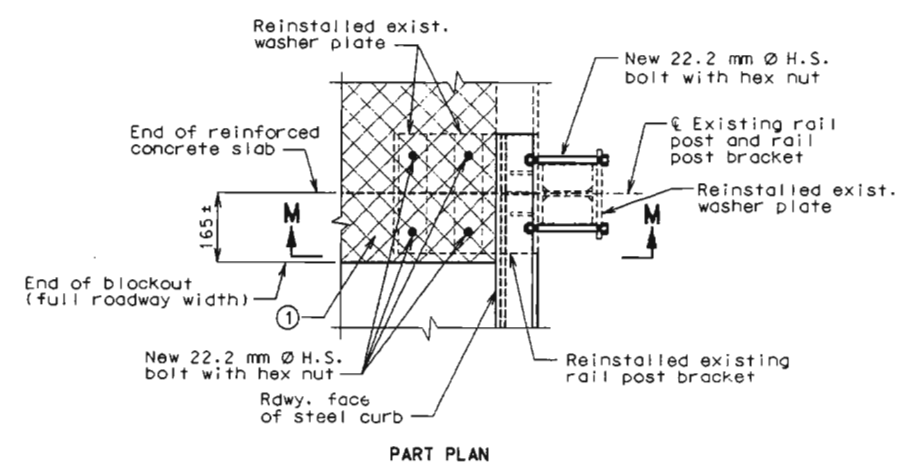


PART PLAN

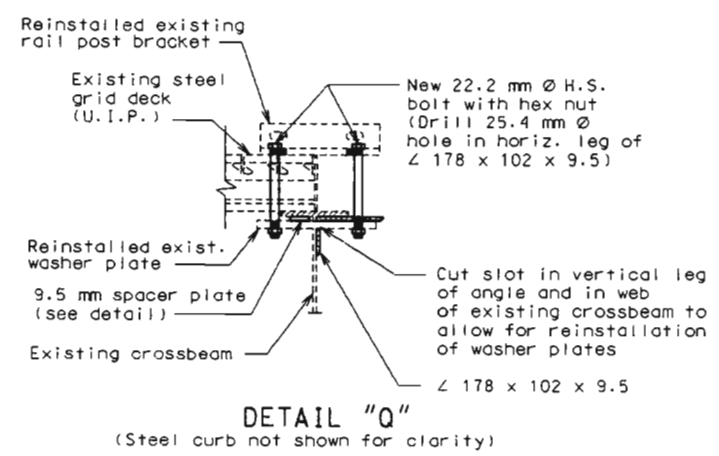

DETAIL "Q"
(Steel curb not shown for clarity)

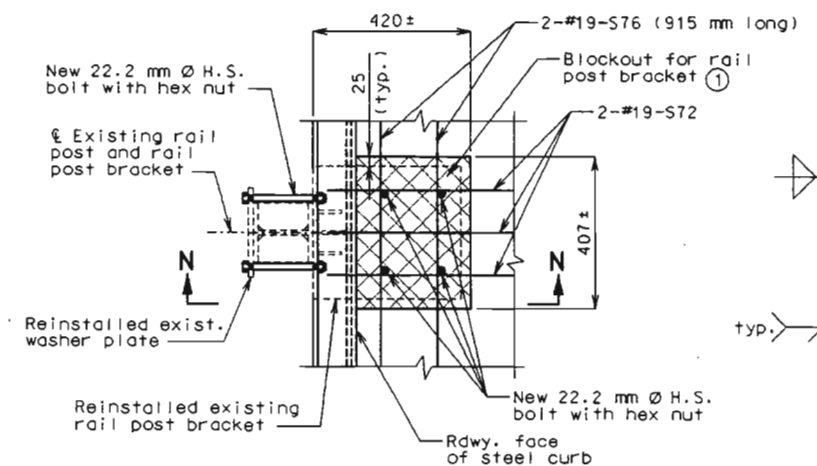


PART PLAN

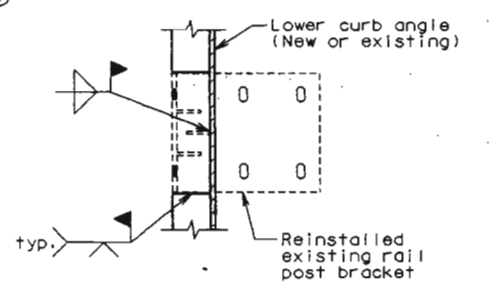


PART SECTION P-P
(Showing field welds)


(As shown for Part Section N-N, Part Section M-M by opposite hand)

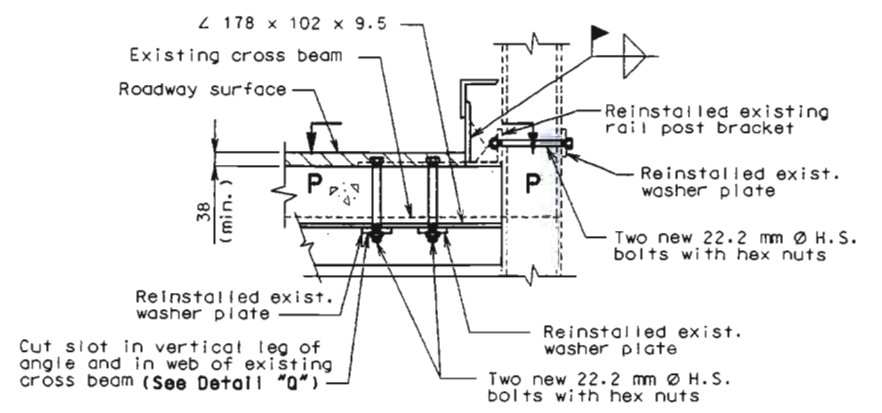

PART SECTION M-M

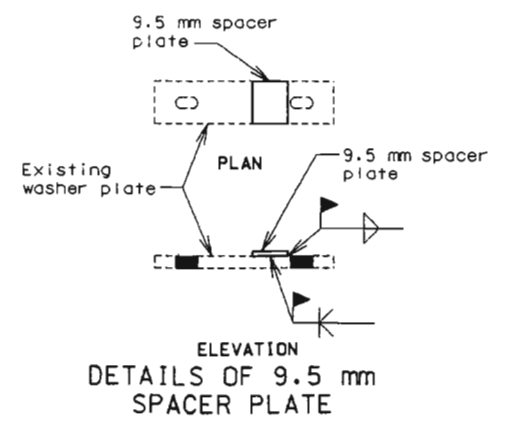

ELEVATION DETAILS OF 9.5 mm SPACER PLATE

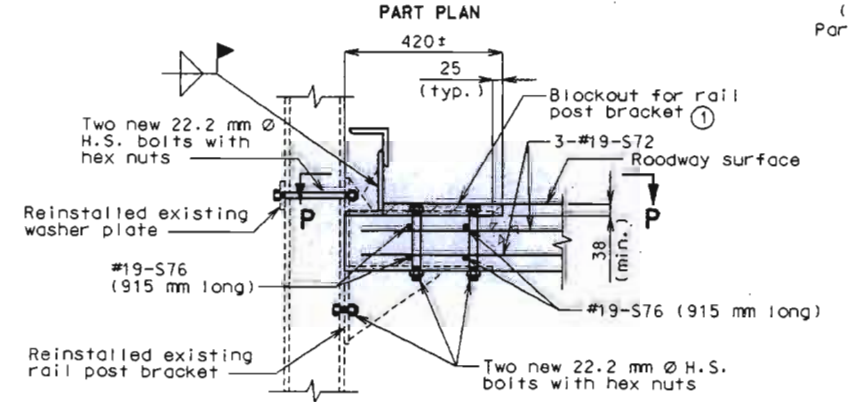


PART SECTION N-N




DETAILS OF STEEL CURB & RAIL POST ATTACHMENT AT PIERS NO. 7 & 12

Detailed June 1999
Checked July 1999

State	Proj. No.	Sheet No.
MO		321

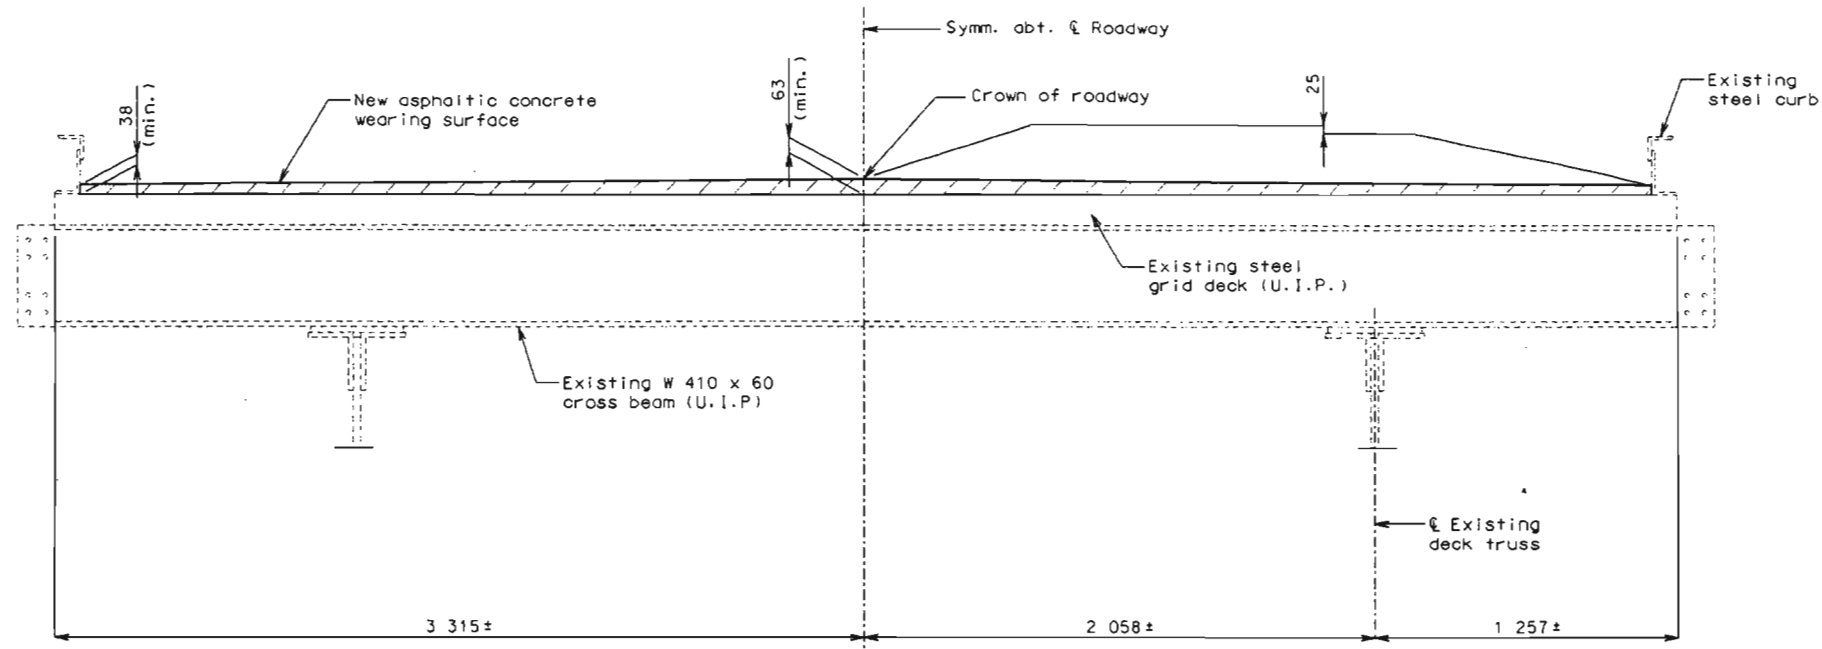


SECTION F-F

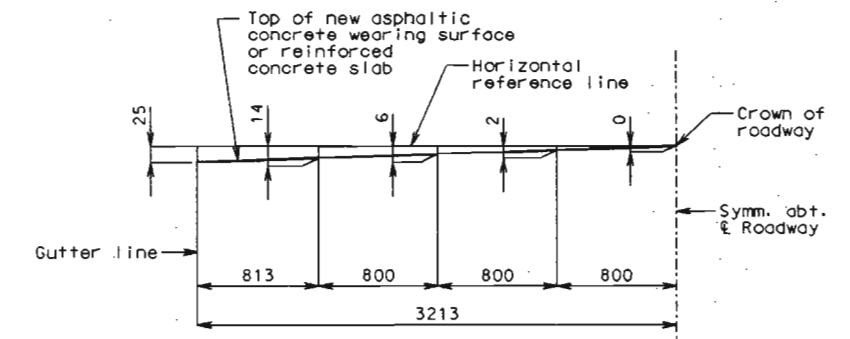

DETAIL OF ROADWAY CROWN

Note: For location of Sections F-F and J-J, see sheet no. 24.

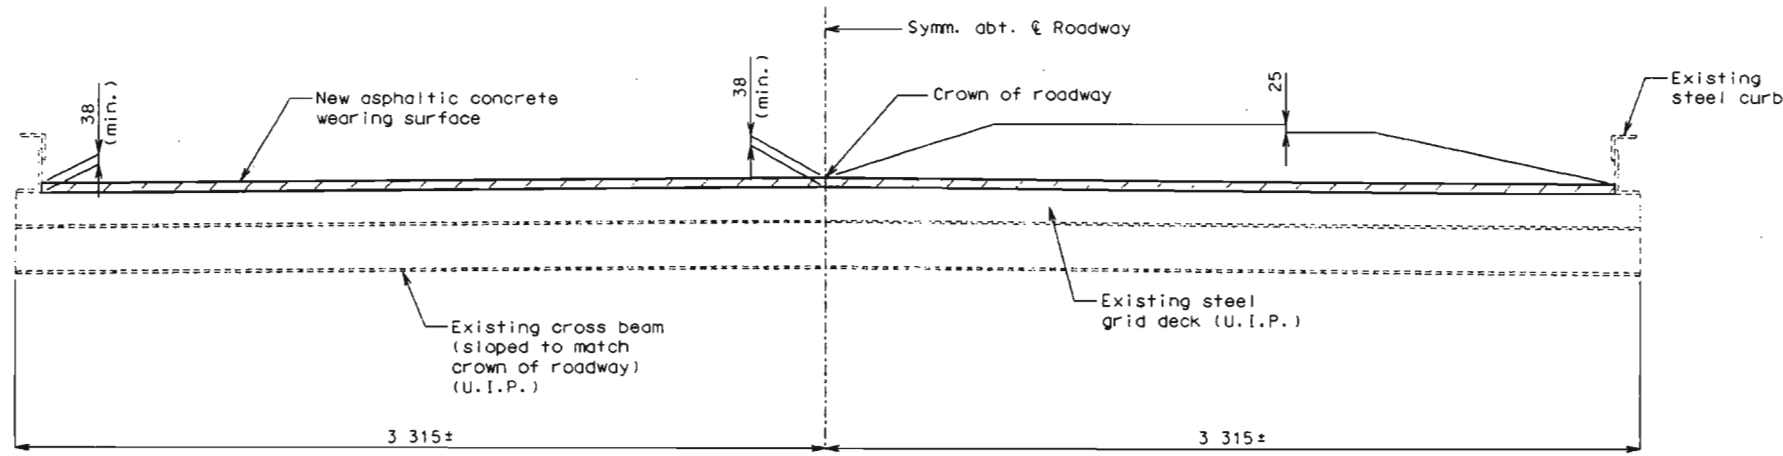

SECTION J-J



DETAILS OF ASPHALTIC CONCRETE WEARING SURFACE AT PIERS NO. 7 & 12

Detailed June 1999
Checked July 1999

Sheet No. 29 of 46

PLATTE COUNTY K04563



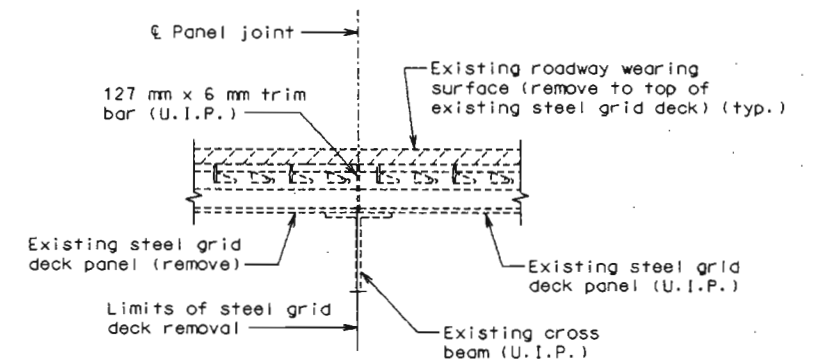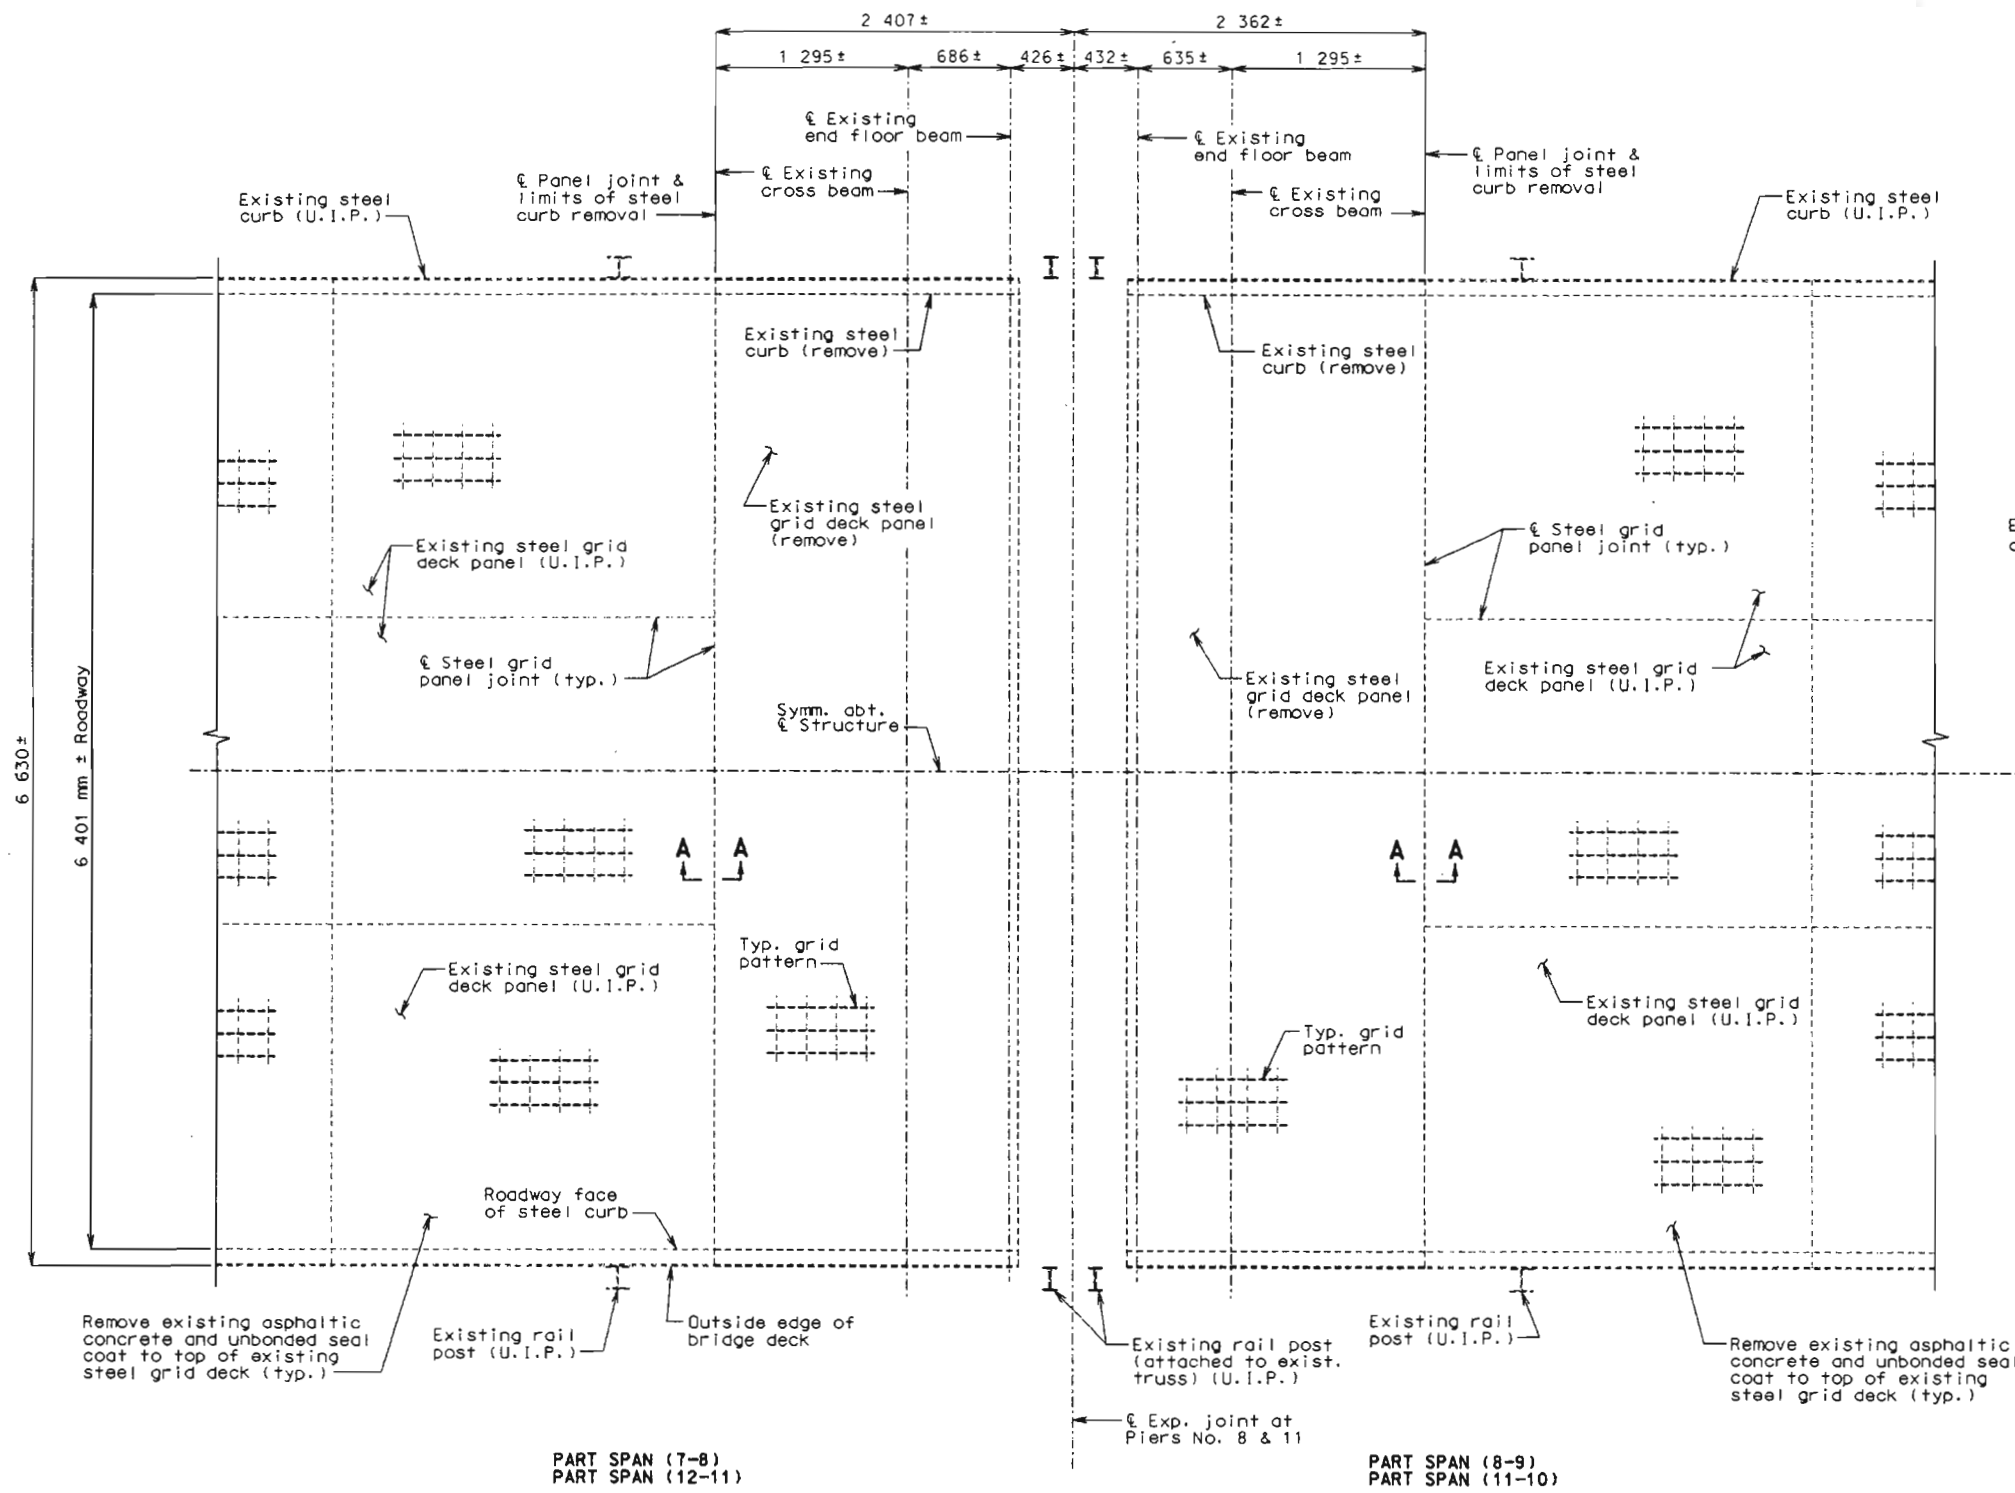

SECTION A-A
Spans (8-9) & (11-12) shown
Spans (7-8) & (10-11) by opposite hand

PART SPAN (7-8)
PART SPAN (12-11)


PART SPAN (8-9)
PART SPAN (11-10)

PART PLAN OF EXISTING DECK

Note: Payment for the removal of steel curb, as designated on the plans, shall be included in the contract unit price for Partial Removal of Existing Steel Grid Deck.



State	Proj. No.	Sheet No.
MO		1331

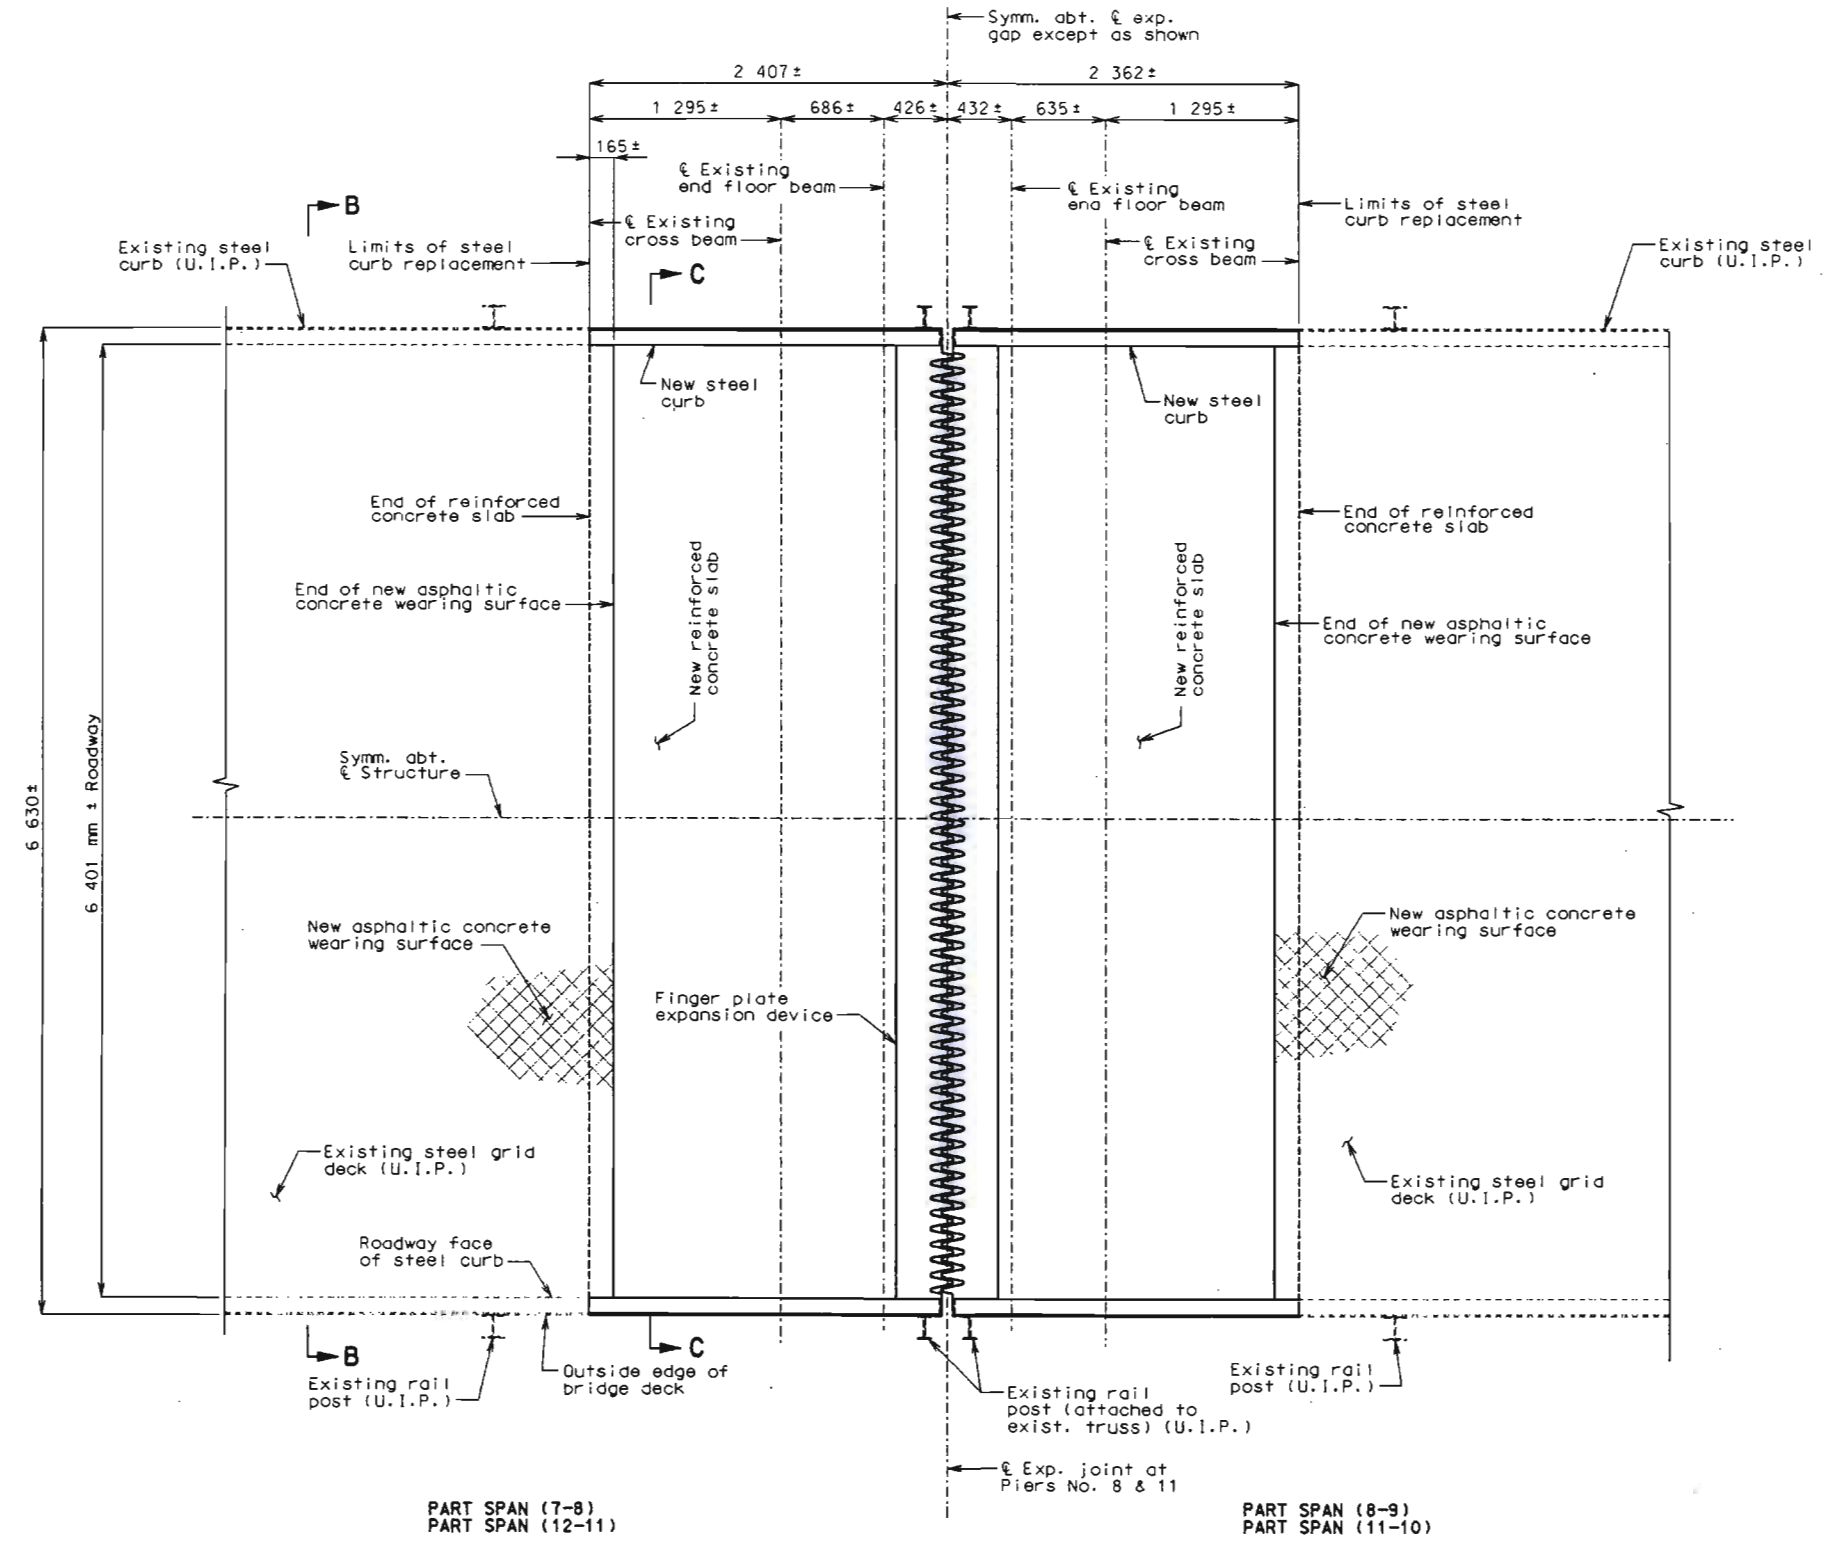

Note: For Sections B-B and C-C, see sheet no. 34.
 For longitudinal section thru new reinforced concrete slabs, see sheet no. 33.
 For details of finger plate expansion device, see sheet no. 32.
 For details of new steel curb, see sheet no. 33.

Details for steel curb replacement have been developed based on available plans and on using the existing rail posts in their present locations. The contractor shall verify the existing rail post locations before ordering steel curb replacement.

Payment for furnishing and installing new steel curb with anchor bolts, hex nuts, and washers shall be included in the contract unit price for Steel Curb.

PART SPAN (7-8)
 PART SPAN (12-11)

PART SPAN (8-9)
 PART SPAN (11-10)


PART PLAN

DETAILS OF DECK REPLACEMENT AT PIERS NO. 8 & 11




DATE 8-20-99

Detailed June 1999
 Checked July 1999

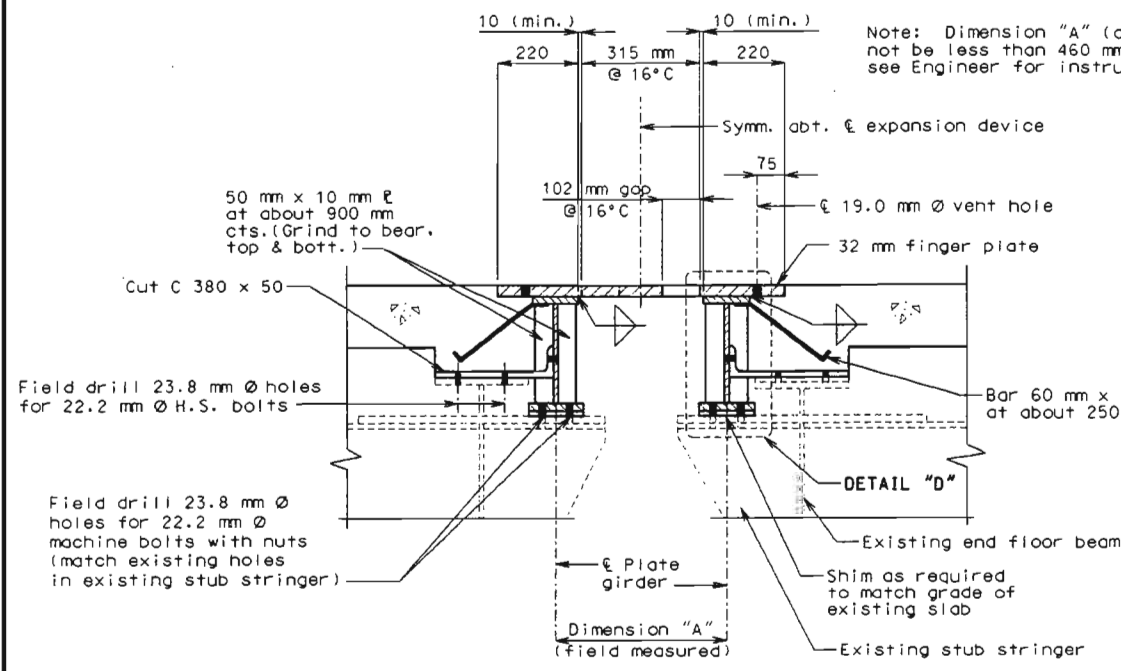

PART SECTION THRU EXPANSION DEVICE


Note: Concrete shall be forced under and around finger plate supporting hardware. Proper consolidation of the concrete shall be achieved by localized internal vibration.

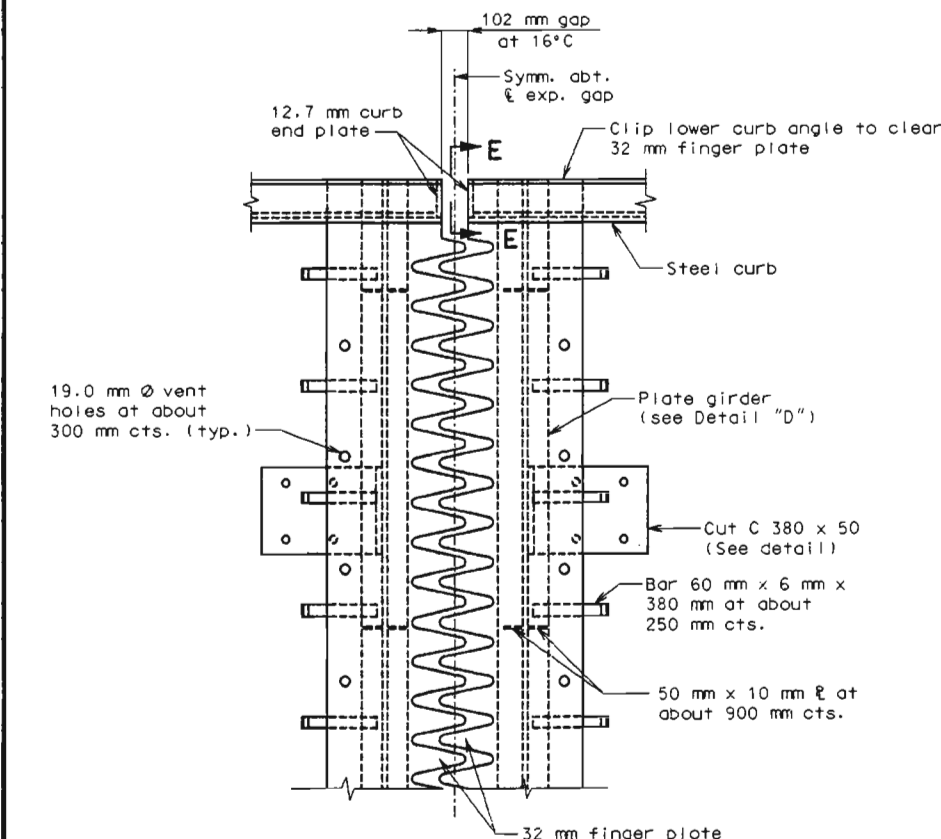


PART PLAN OF EXPANSION DEVICE

Note: 32 mm finger plate expansion device shall extend full width of bridge deck.


Note: Dimension "A" (adjusted to 16°C) shall not be less than 460 mm. If less than 460 mm, see Engineer for instructions.

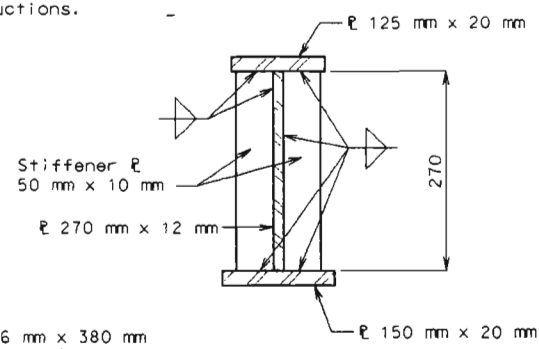


DETAIL "D"

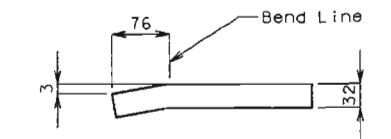


OPTIONAL FINGER DETAIL

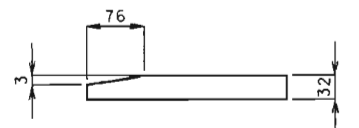


FINGER DETAIL

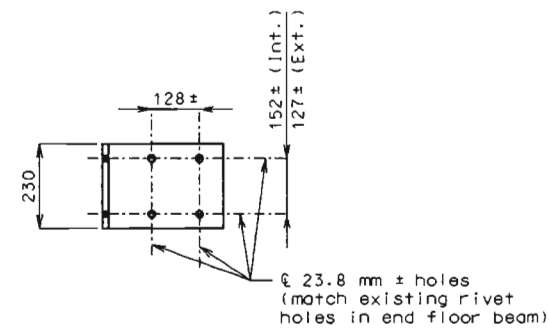


DETAIL OF CUT C 380 x 50

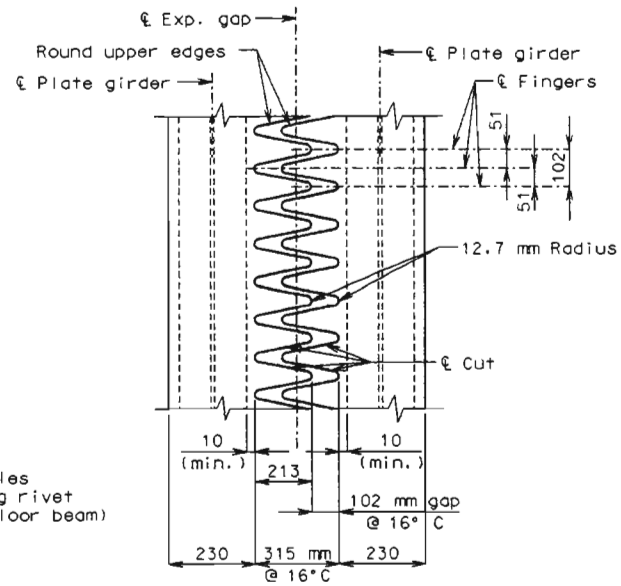

TYPICAL PLAN OF PLATE

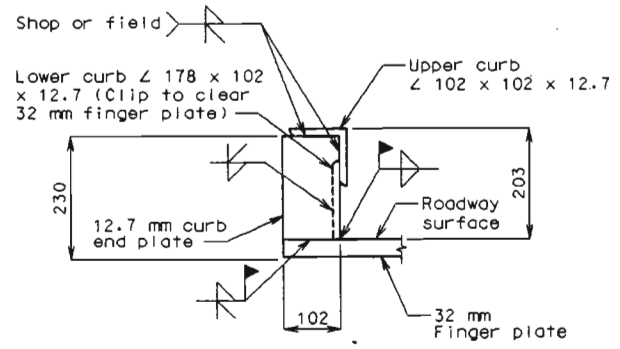

SECTION E-E

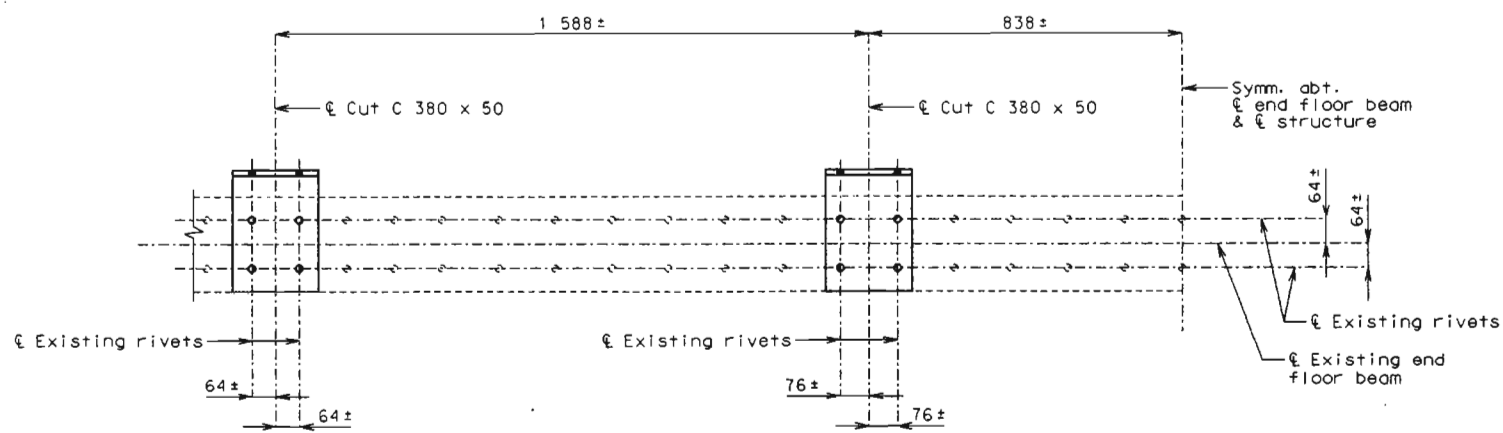

PART PLAN OF EXISTING END FLOOR BEAM (MAIN TRUSS)

(SHOWING LOCATION OF CUT C 380 x 50)

(Use same details for simple span truss)

Note: Remove indicated existing rivets and attach cut C 380 x 50 using 22.2 mm diameter H.S. bolts.

GENERAL NOTES:

Finger plates shall be cut with a machine guided gas torch from one plate. The plate from which fingers are cut may be spliced before fingers are cut. The surface of cut shall be perpendicular to the surface of the plate. The cut shall not exceed 3 mm in width. The centerline of cut shall not deviate more than 2 mm from the position of centerline of cut shown. No splicing of finger plate or finger plate assembly will be allowed after fingers are cut.

Plan dimensions are based on installation at 16 degree Celsius. The expansion gap and other dimensions shall be increased 7.4 mm for each 5 degree Celsius fall in temperature and decreased 7.4 mm for each 5 degree Celsius rise in temperature at installation.

Structural steel for the expansion device shall be coated with a minimum of two coats of inorganic zinc primer (125 micrometer minimum thickness) or galvanized in accordance with the ASTM A123. Anchors need not be protected from overspray.

Payment for furnishing, coating or galvanizing, and installing structural steel for the expansion device will be made at the contract unit price for Expansion Device (Finger Plate) per meter.

All holes shown for connections to be subpunched 20.6 mm diameter (Shop or field drill) and reamed to 23.8 mm diameter in field.

32 mm Finger Plate and plate girders shall be bent to conform to crown of roadway.

Longitudinal reinforcing steel shall be placed so that ends shall not be more than 25 mm from web of plate girder at expansion device.


Material for the expansion device shall be ASTM A709M Grade 250 structural steel. Anchors for the expansion device shall be approved stud welded anchors (C1010 thru C1020).

Removal of existing expansion device and supporting beams on top of stub stringers is included in the contract unit price for Partial Removal of Existing Steel Grid Deck.



DATE 8-20-99

State	Proj. No.	Sheet No.
MO		B33

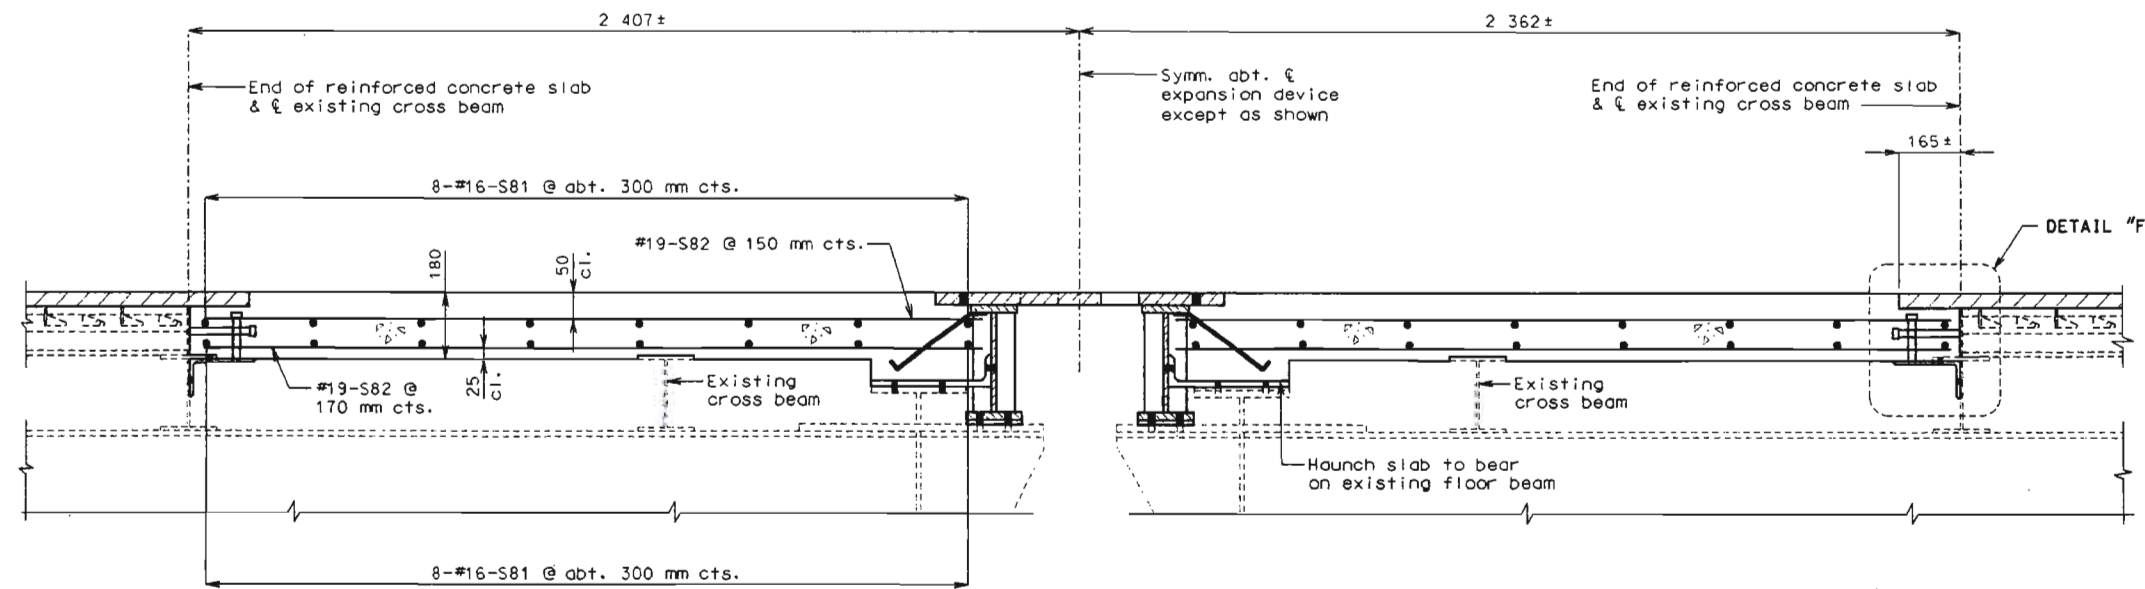


PART SPAN (7-8)
PART SPAN (12-11)

PART SPAN (8-9)
PART SPAN (11-10)


PART SECTION AT PIERS NO. 8 & 11

Note: Payment for furnishing and installing shear connector studs and $\angle 178 \times 102 \times 9.5$ at cross beam shall be included in the contract unit price for Slab on Steel.

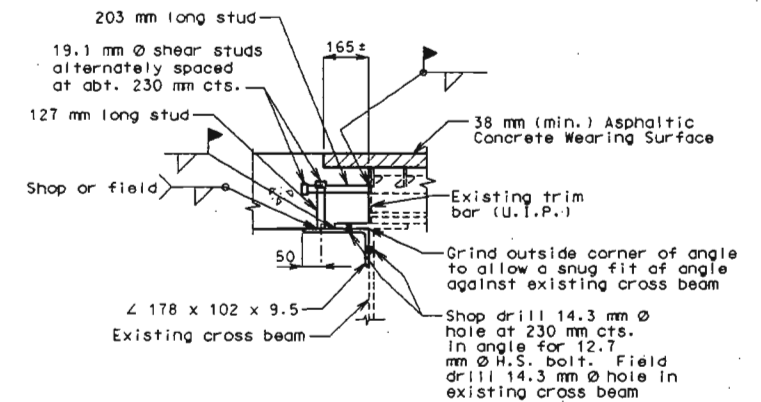

DETAIL "F"

Spans (8-9) & (11-10) shown
Spans (7-8) & (12-11) by opposite hand

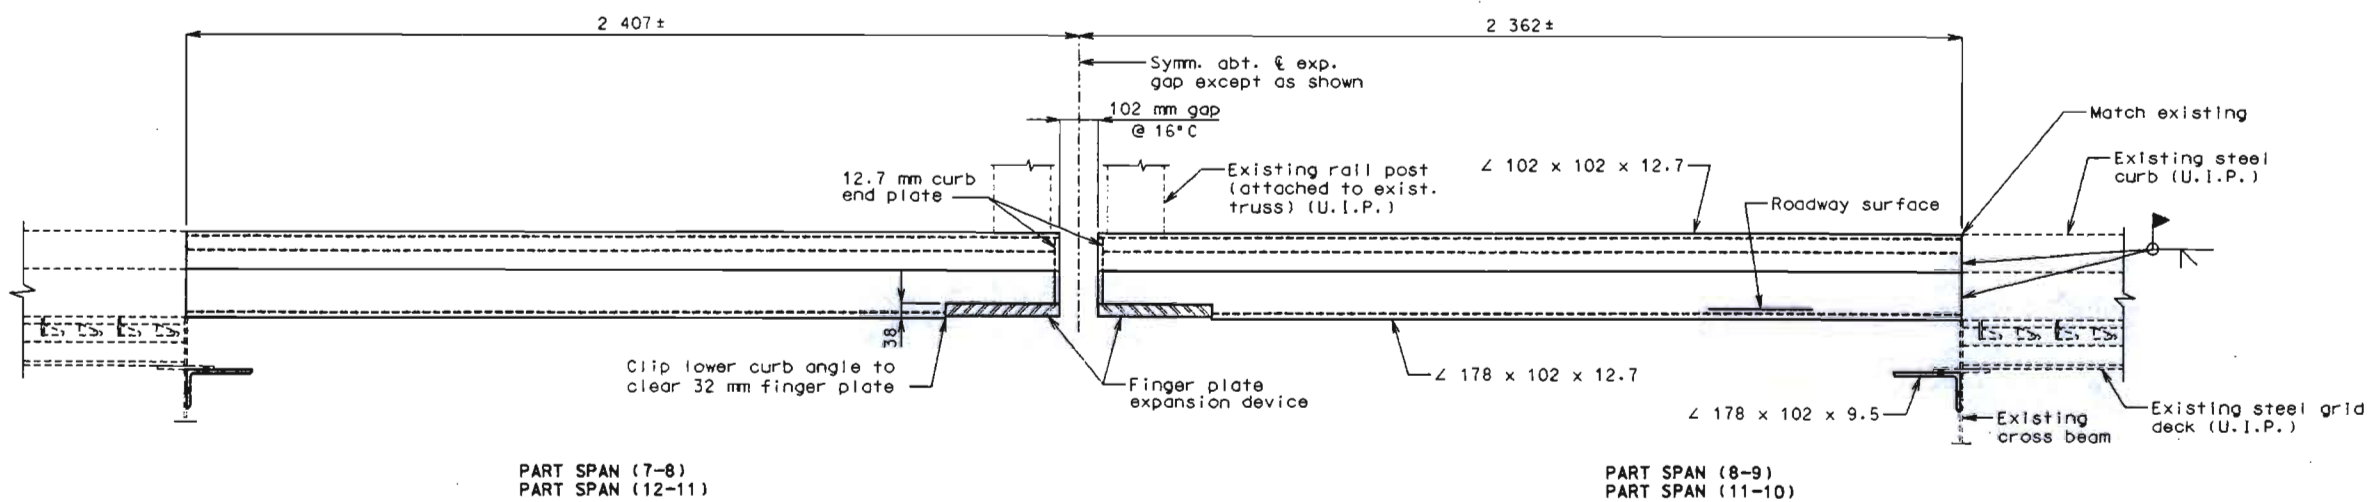

PART SPAN (7-8)
PART SPAN (12-11)

PART SPAN (8-9)
PART SPAN (11-10)

PART SECTION SHOWING STEEL CURB

(Left side shown, right side similar)

DETAILS OF DECK REPLACEMENT AT PIERS NO. 8 & 11




Detailed June 1999
Checked July 1999

Sheet No. 33 of 46


PLATTE COUNTY

K04563

State	Proj. No.	Sheet No.
MO		1334

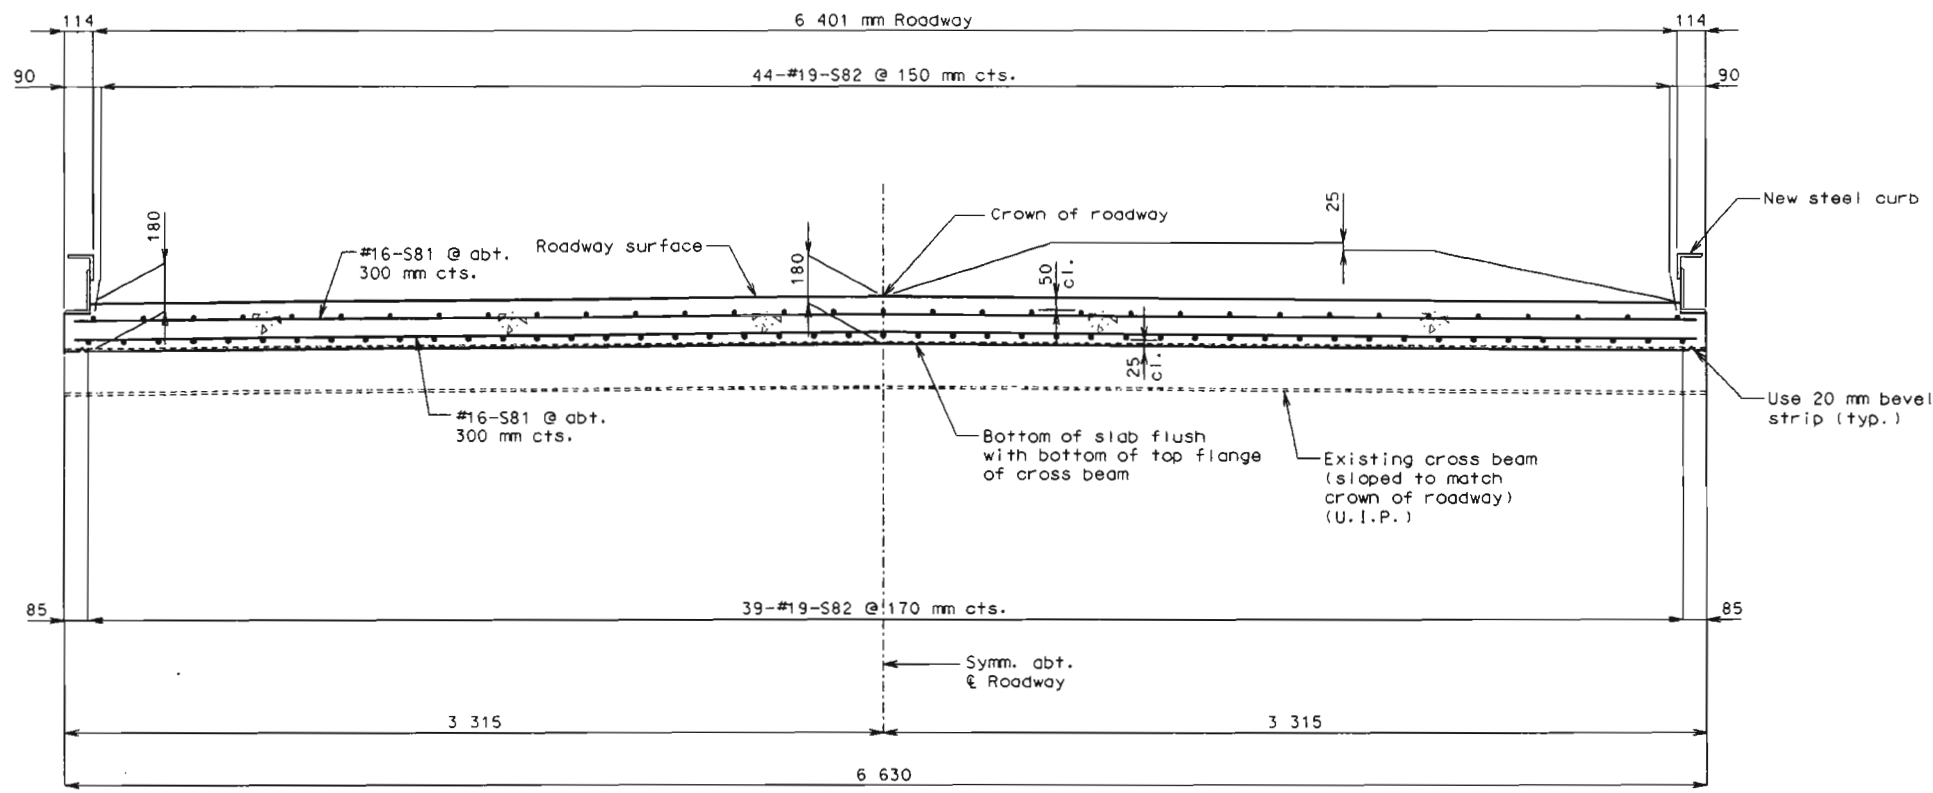


SECTION C-C

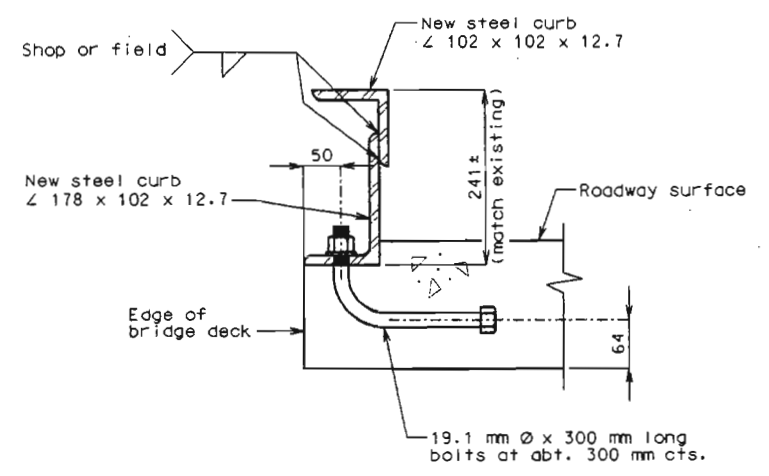


TYPICAL SECTION SHOWING STEEL CURB ATTACHMENT IN AREA OF NEW REINFORCED CONCRETE SLAB

Note: Top of new slab and expansion device shall conform to 25 mm crown of roadway.
For location of Sections B-B and C-C, see sheet no. 31.

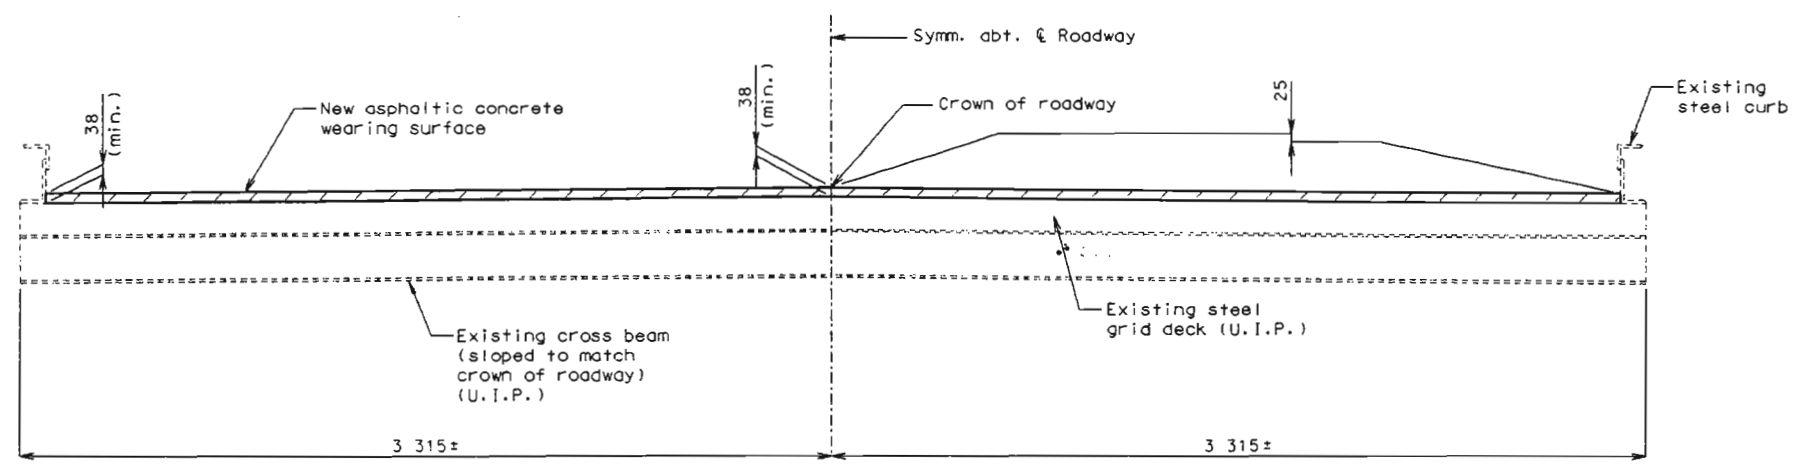

SECTION B-B

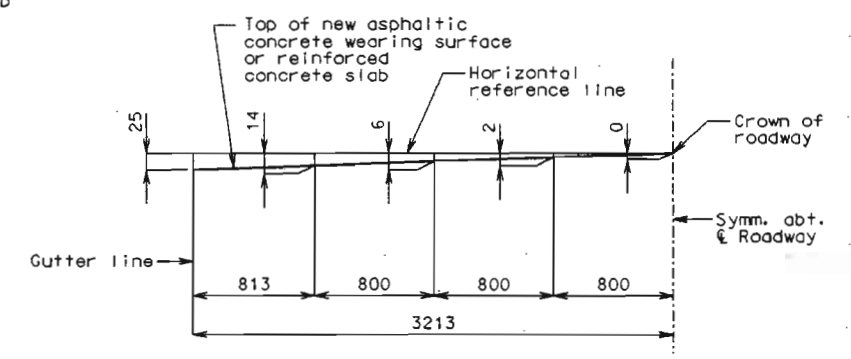

DETAIL OF ROADWAY CROWN





Detailed June 1999
Checked July 1999

DETAILS OF DECK REPLACEMENT AT PIERS NO. 8 & 11


Sheet No. 34 of 46

PLATTE COUNTY


K04563

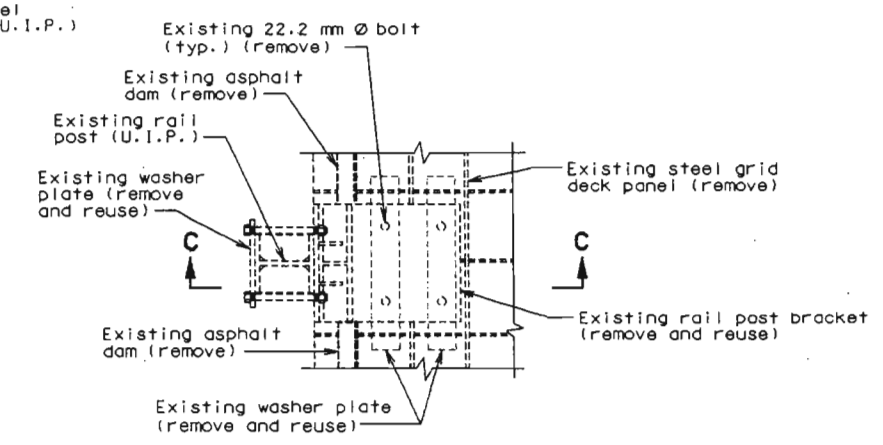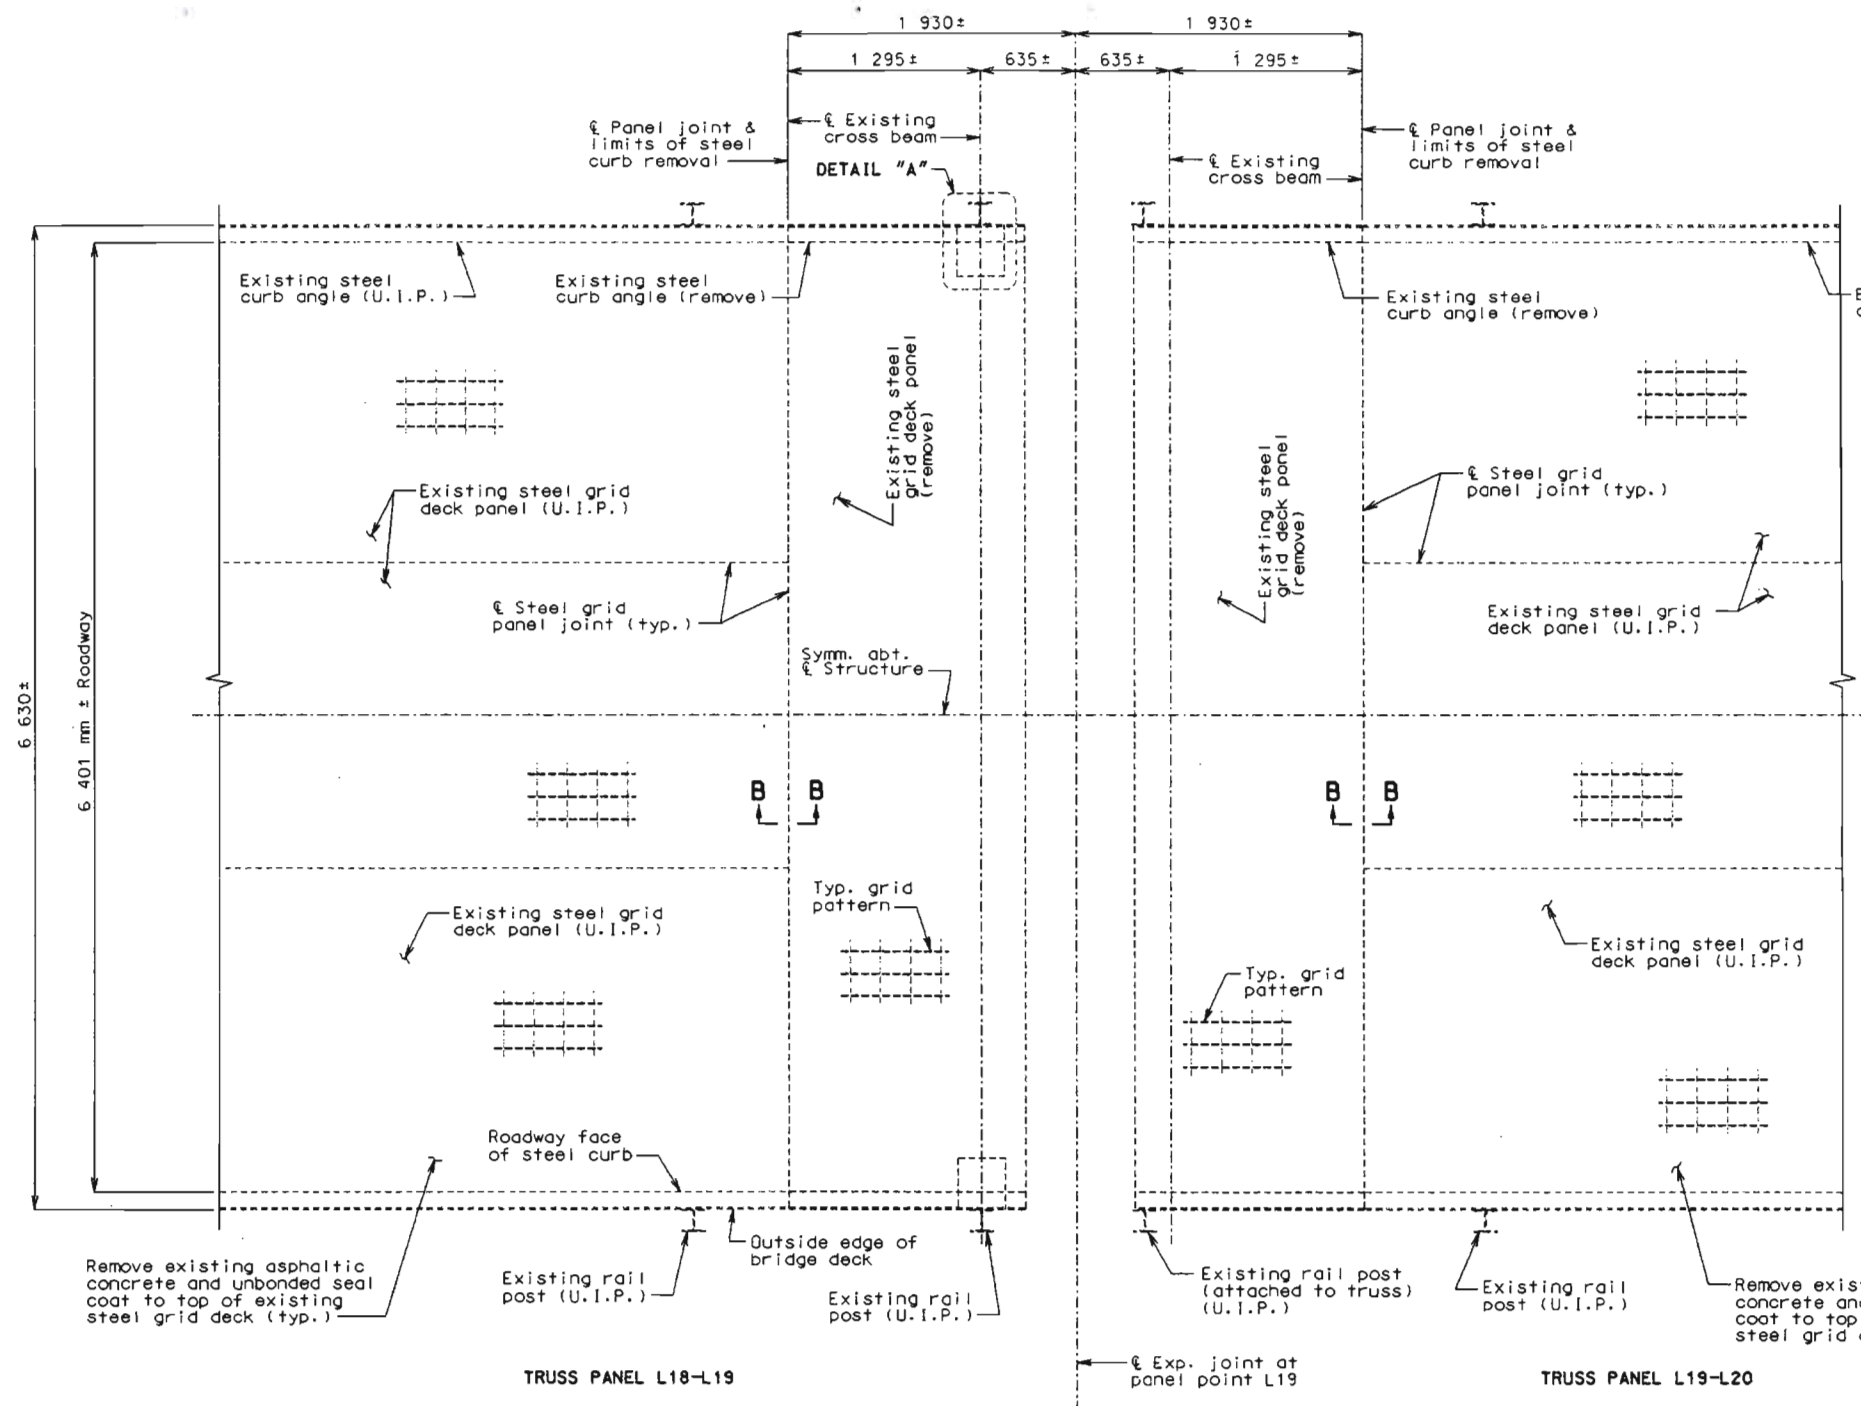


DETAIL "A"
(Rotated 90° counterclockwise)
Note: Steel curb not shown for clarity.

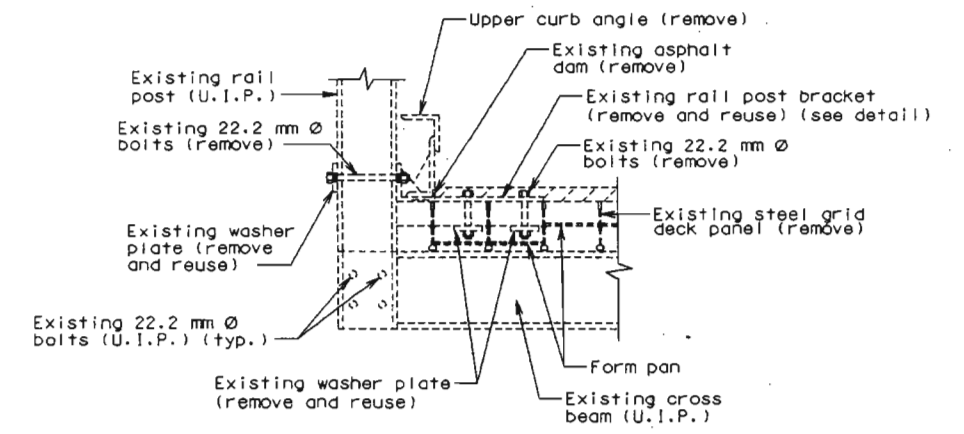

SECTION C-C

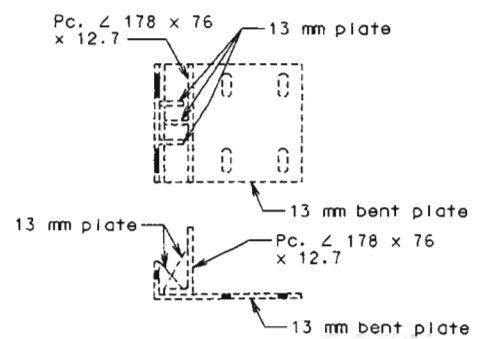

DETAILS OF RAIL POST BRACKETS
(Remove and reuse with new slab)

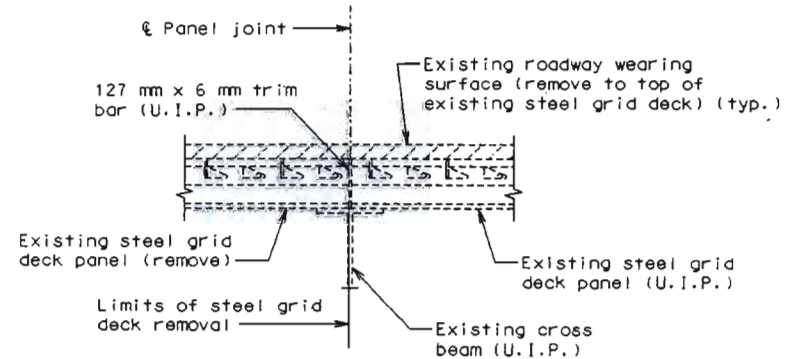


SECTION B-B
(Truss panel L19-L20 shown,
Truss panel L18-L19 by opposite hand)

Note: Removed rail post brackets and washer plates shall be cleaned and coated with a prime coat of the specified paint system before reinstallation with the new slab.
Payment for the removal of steel curb, rail post brackets and washer plates, as designated on the plans, shall be included in the contract unit price for Partial Removal of Existing Steel Grid Deck.

DETAILS OF DECK REMOVAL AT PANEL POINT L19



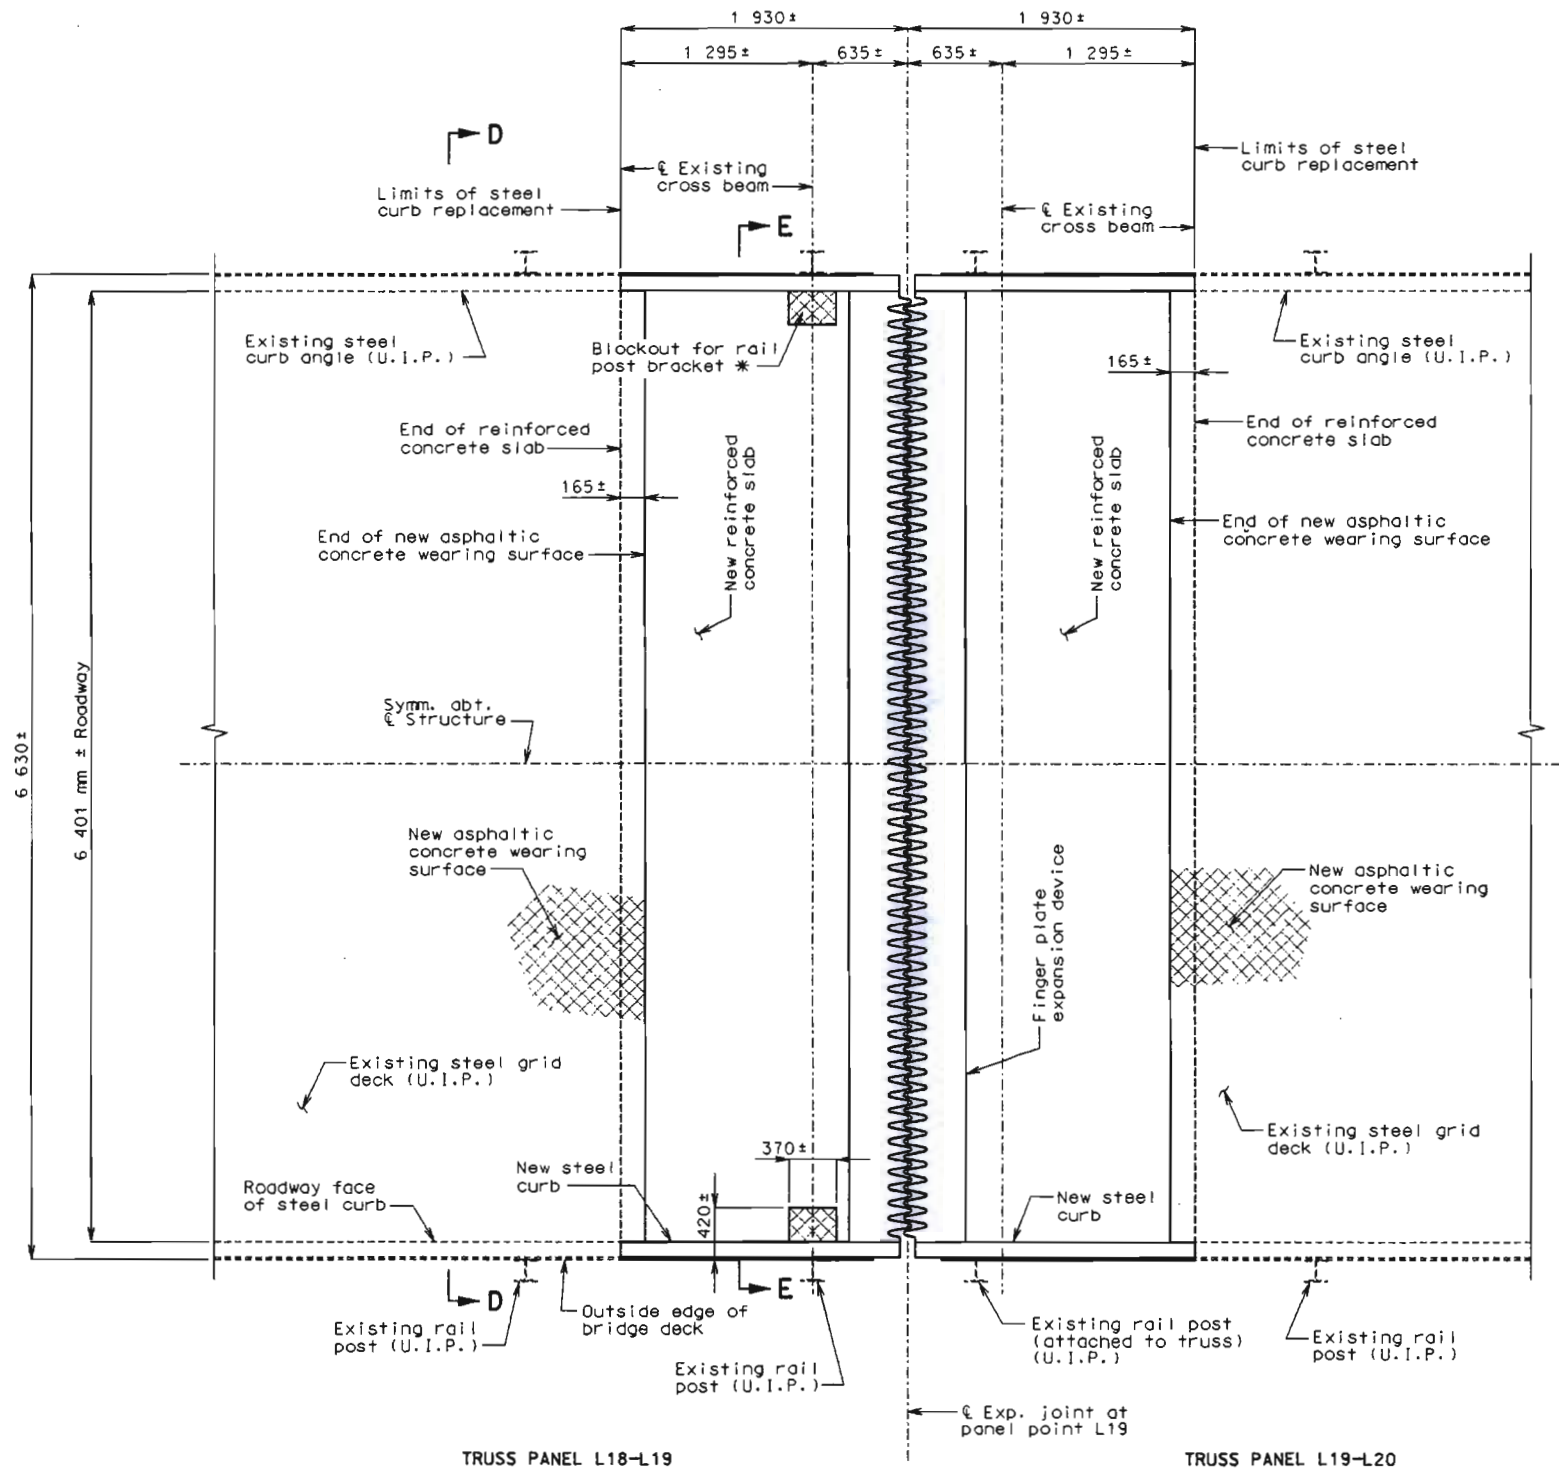

TRUSS PANEL L18-L19

TRUSS PANEL L19-L20

PART PLAN

DETAILS OF DECK REPLACEMENT AT PANEL POINT L19

Note: For Sections D-D and E-E, see sheet no. 39.

For longitudinal section thru new reinforced concrete slabs, see sheet no. 38.

For details of finger plate expansion device, see sheet no. 37.

For details of new steel curb and rail post attachments, see sheet no. 40.

* Blackout to be filled with asphaltic concrete after installation of rail post bracket.

Details for steel curb replacement have been developed based on available plans and on using the existing rail posts in their present locations. The contractor shall verify the existing rail post locations before ordering steel curb replacement.

Payment for the reinstatement of the existing rail post brackets and washer plates with new H.S. bolts, hex nuts, and washers shall be included in the contract unit price for Slab on Steel.

Payment for furnishing and installing new steel curb with anchor bolts, hex nuts, and washers shall be included in the contract unit price for Steel Curb.



DATE 8-25-99

State	Proj. No.	Sheet No.
MO		B37

GENERAL NOTES:

Finger plates shall be cut with a machine guided gas torch from one plate. The plate from which fingers are cut may be spliced before fingers are cut. The surface of cut shall be perpendicular to the surface of the plate. The cut shall not exceed 3 mm in width. The centerline of cut shall not deviate more than 2 mm from the position of centerline of cut shown. No splicing of finger plate or finger plate assembly will be allowed after fingers are cut.

Plan dimensions are based on installation at 16 degree Celsius. The expansion gap and other dimensions shall be increased 8.5 mm for each 5 degree Celsius fall in temperature and decreased 8.5 mm for each 5 degree Celsius rise in temperature at installation.

Structural steel for the expansion device shall be coated with a minimum of two coats of inorganic zinc primer (125 micrometer minimum thickness) or galvanized in accordance with the ASTM A123. Anchors need not be protected from overspray.

Payment for furnishing, coating or galvanizing, and installing structural steel for the expansion device will be made at the contract unit price for Expansion Device (Finger Plate) per meter.

All holes shown for connections to be subpunched 20.6 mm Ø (Shop or field drill) and reamed to 23.8 mm Ø in field.


32 mm Finger Plate and plate girders shall be bent to conform to crown of roadway.

Longitudinal reinforcing steel shall be placed so that ends shall not be more than 25 mm from web of plate girder at expansion device.

Material for the expansion device shall be ASTM A709M Grade 250 structural steel. Anchors for the expansion device shall be approved stud welded anchors (C1010 thru C1020).


Removal of existing expansion device and supporting beams on top of stringers is included in the contract unit price for Partial Removal of Existing Steel Grid Deck.

Note: Concrete shall be forced under and around finger plate supporting hardware and studs. Proper consolidation of the concrete shall be achieved by localized internal vibration.

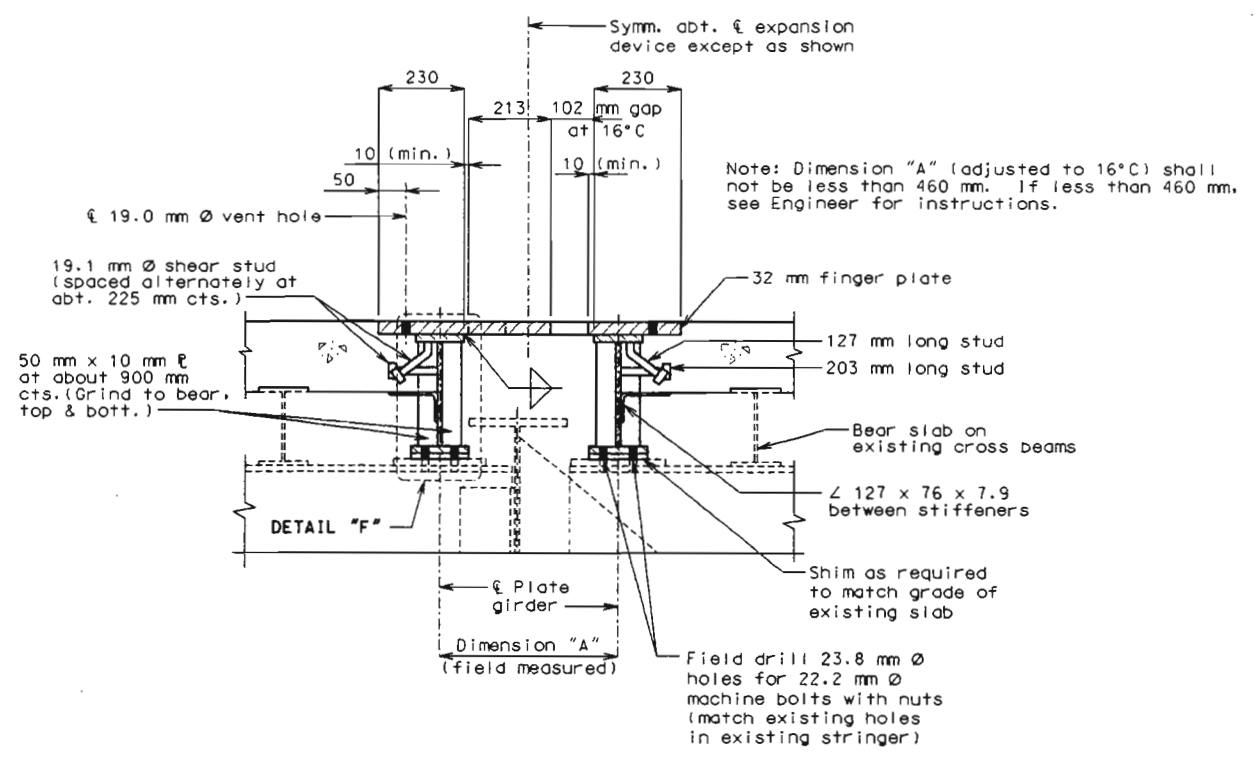


TRUSS PANEL L18-L19 TRUSS PANEL L19-L20


PART SECTION THRU EXPANSION DEVICE

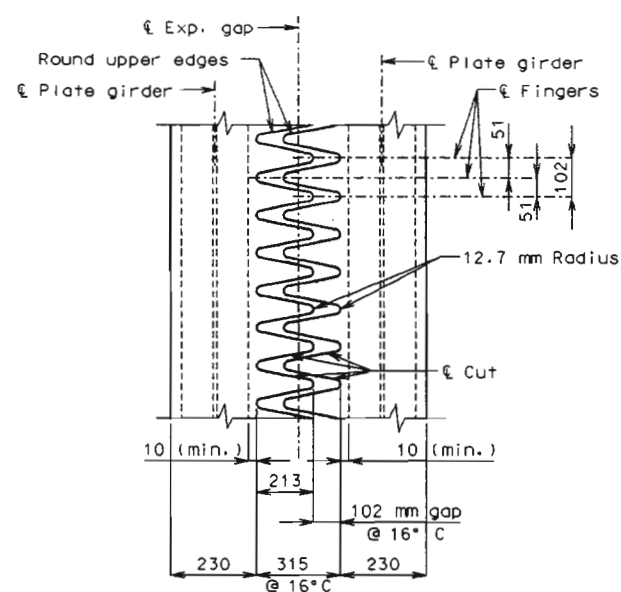


TYPICAL PLAN OF PLATE

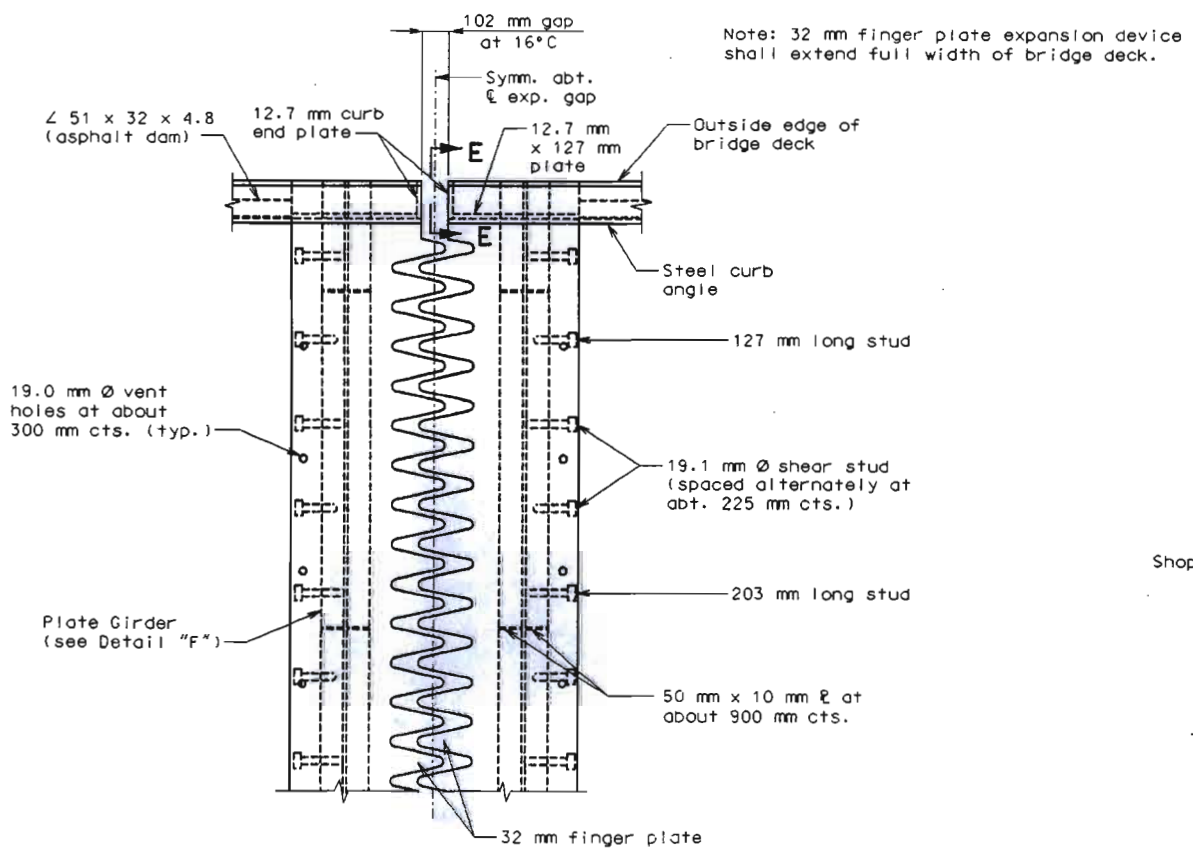


PART PLAN OF EXPANSION DEVICE

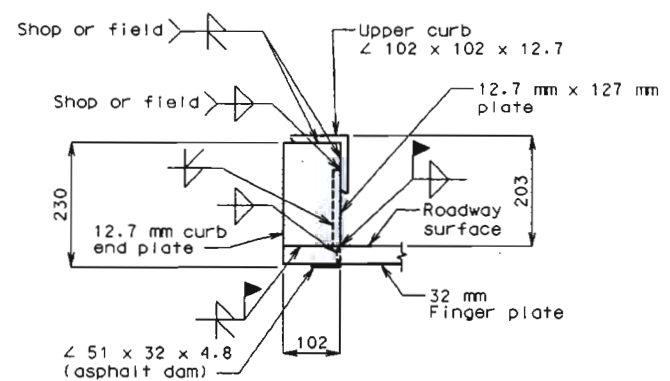


SECTION E-E

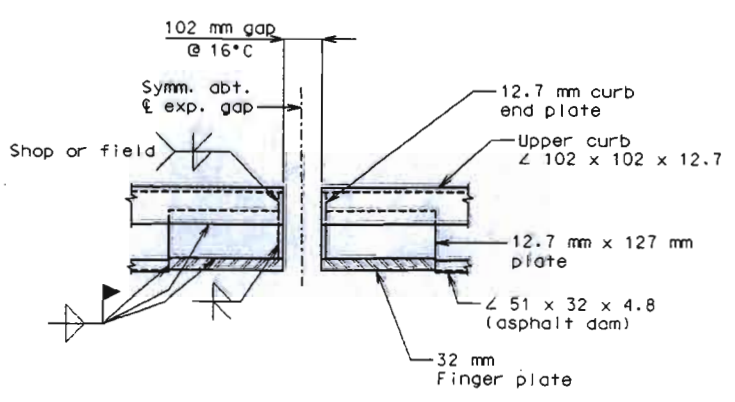


PART SECTION NEAR CURB

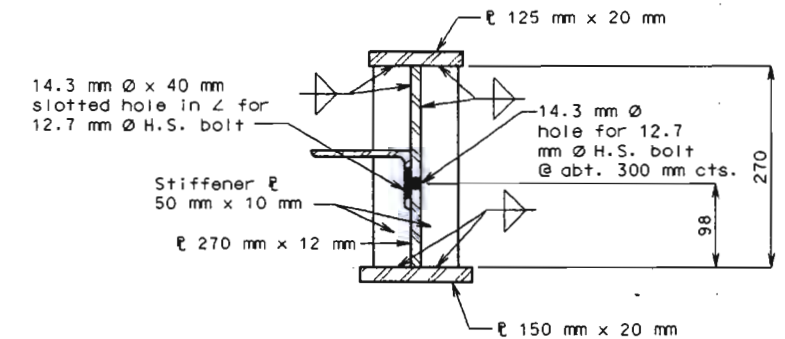

DETAIL "F"

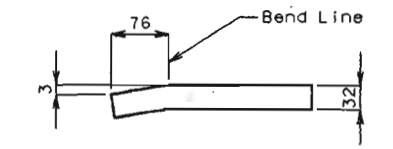

OPTIONAL FINGER DETAIL

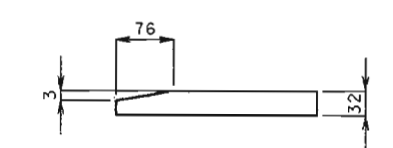


FINGER DETAIL




DETAILS OF FINGER PLATE EXPANSION DEVICE AT PANEL POINT L19

Detailed June 1999
Checked July 1999

State	Proj. No.	Sheet No.
MO		B 3P

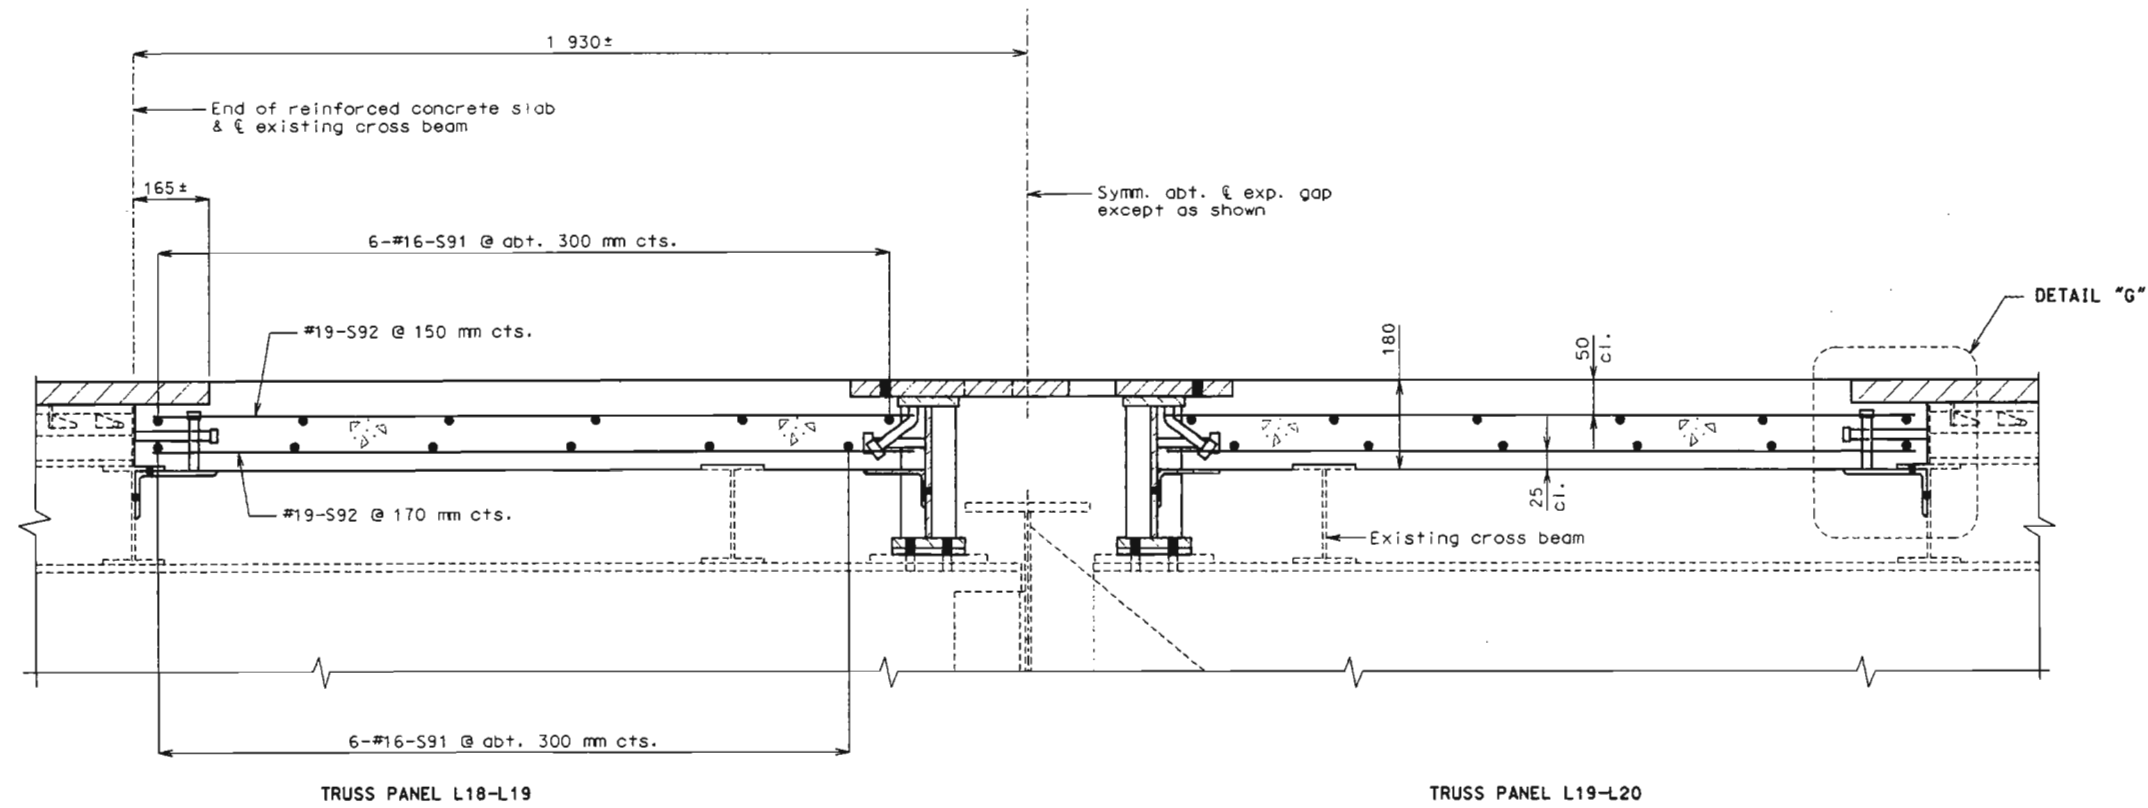

PART SECTION AT PANEL POINT L19

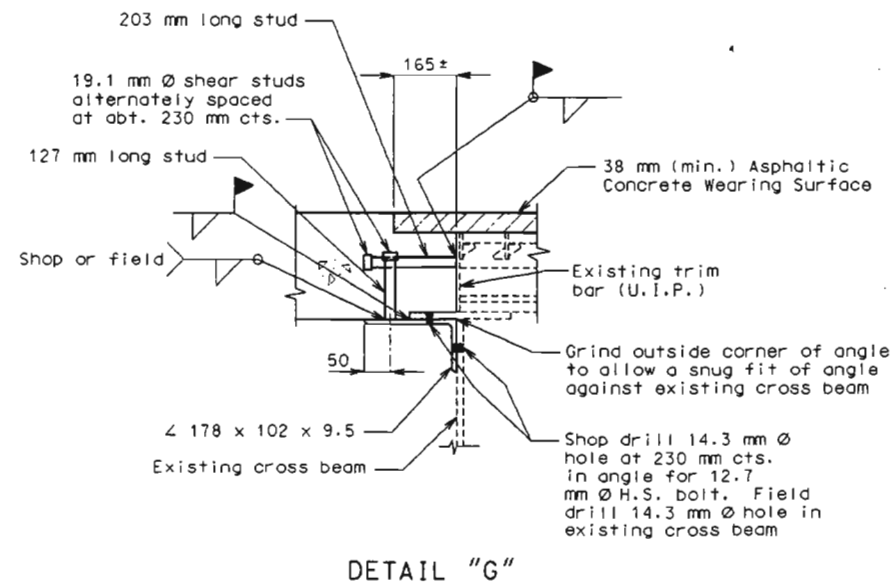

Note: Payment for furnishing and installing shear connector studs and L 178 x 102 x 9.5 at cross beam shall be included in the contract unit price for Slab on Steel.



DATE 8-20-99

DETAILS OF DECK REPLACEMENT AT PANEL POINT L19



Detailed June 1999
Checked July 1999

Sheet No. 38 of 46

PLATTE COUNTY



K04563

State	Proj. No.	Sheet No.
MD		339

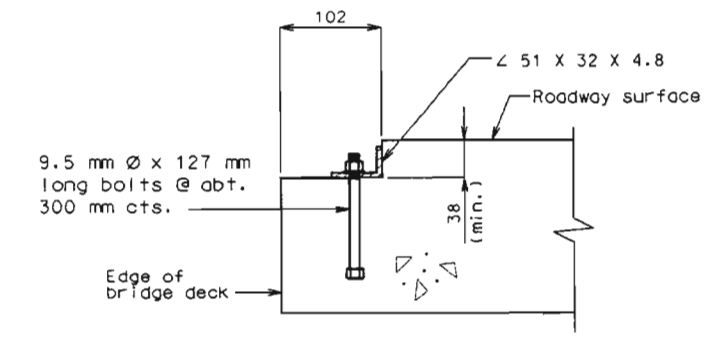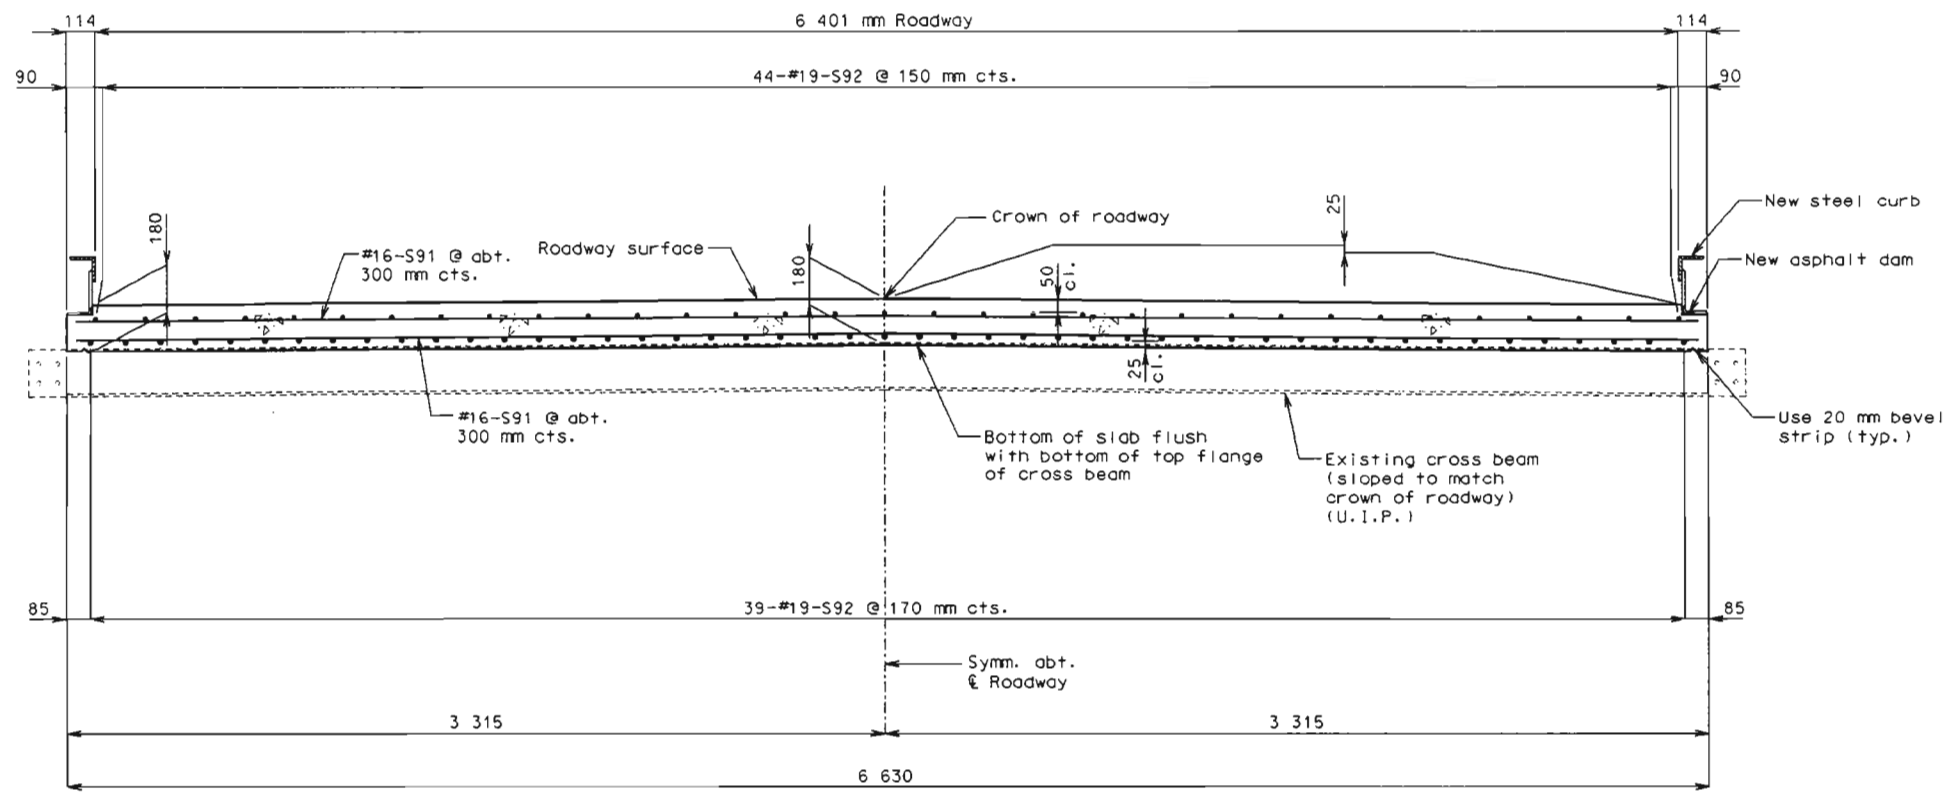

Note: Top of new slab and expansion device shall conform to 25 mm crown of roadway.
 For location of Sections D-D and E-E, see sheet no. 36.

Payment for furnishing and installing new steel dam angles with anchor bolts, hex nuts, and washers shall be included in the contract unit price for Remove and Replace Dam Angle @ Open Curb Areas per meter.

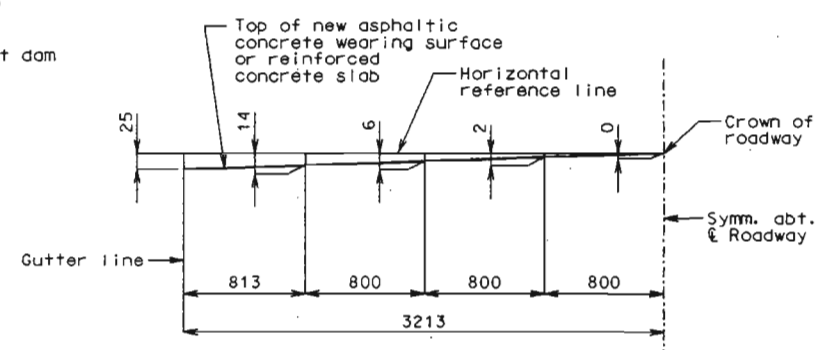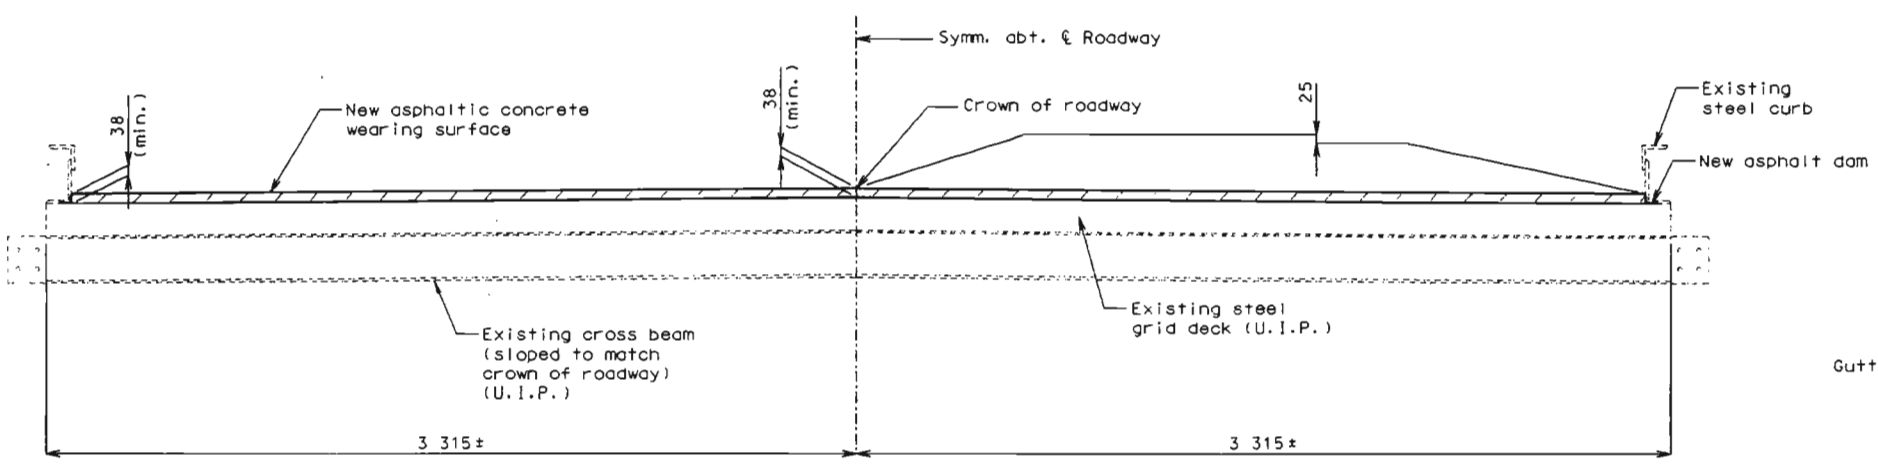

DETAILS OF DECK REPLACEMENT AT PANEL POINT L19


Detailed June 1999
 Checked July 1999

Sheet No. 39 of 46


PLATTE COUNTY

K04563




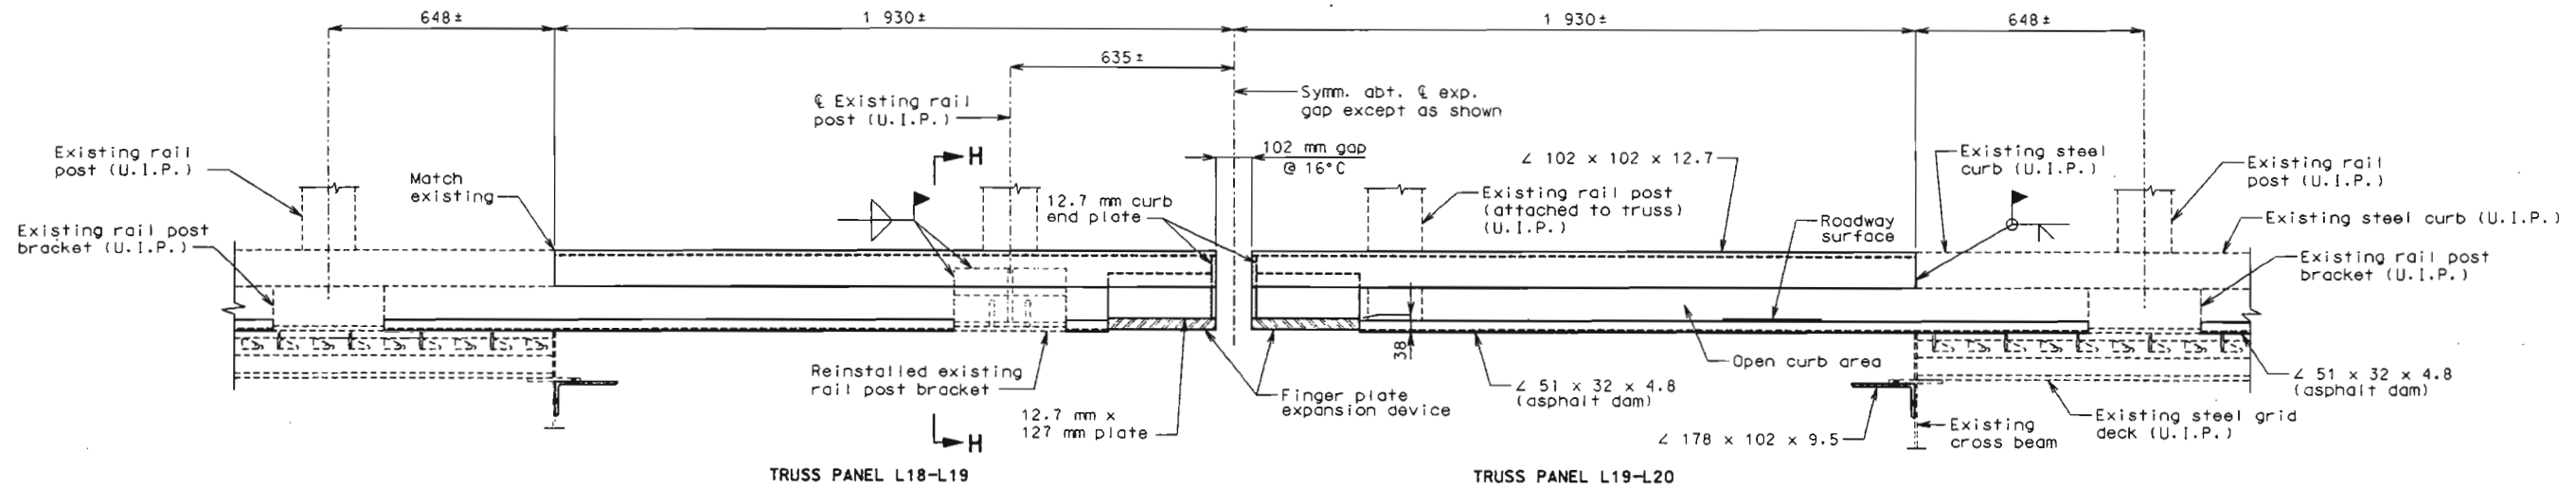


PART SECTION SHOWING STEEL CURB
(Left side shown, right side similar)

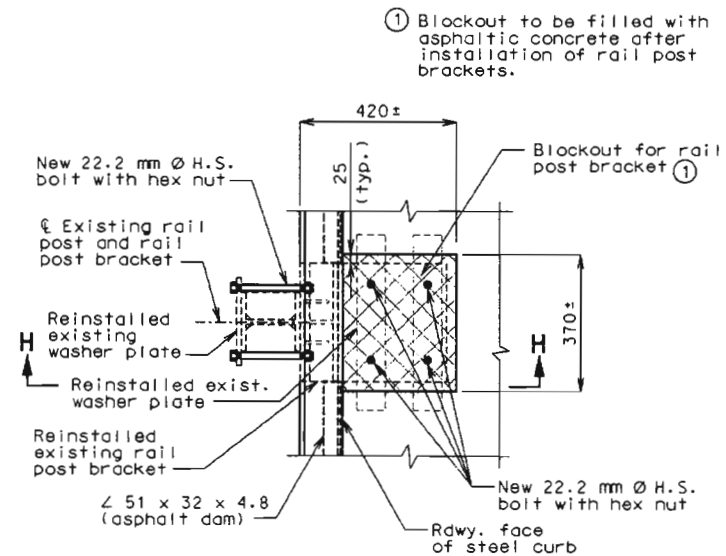


PART PLAN

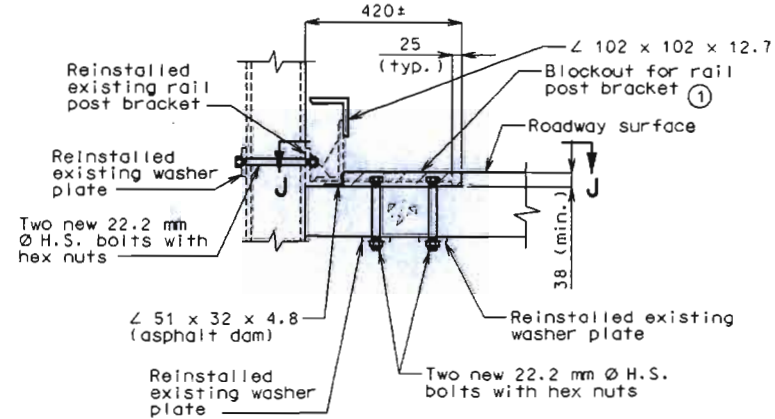

PART SECTION H-H

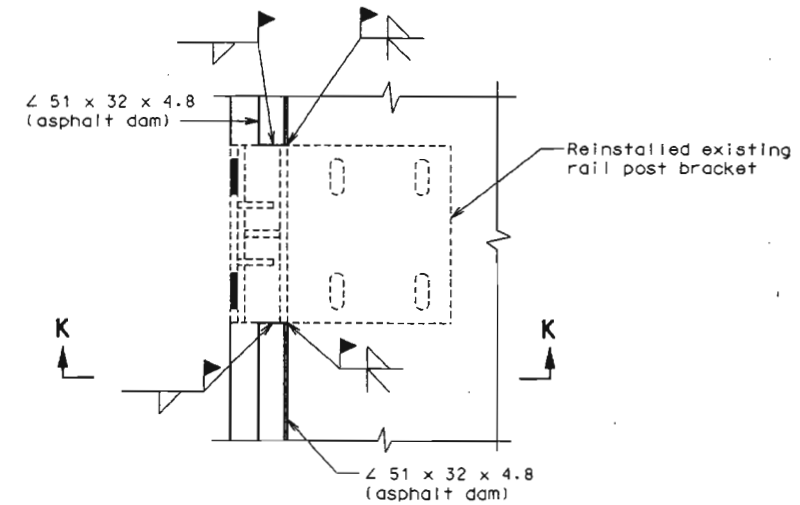


SECTION J-J
(Upper curb angle not shown for clarity)
(Typ. for all rail post bracket locations)

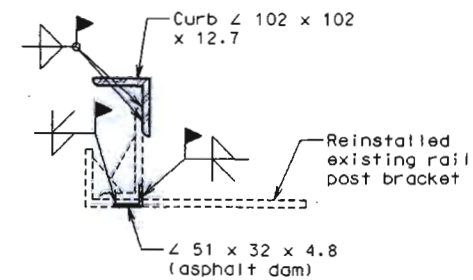

SECTION K-K

DETAILS OF STEEL CURB & RAIL POST ATTACHMENT AT PANEL POINT L19



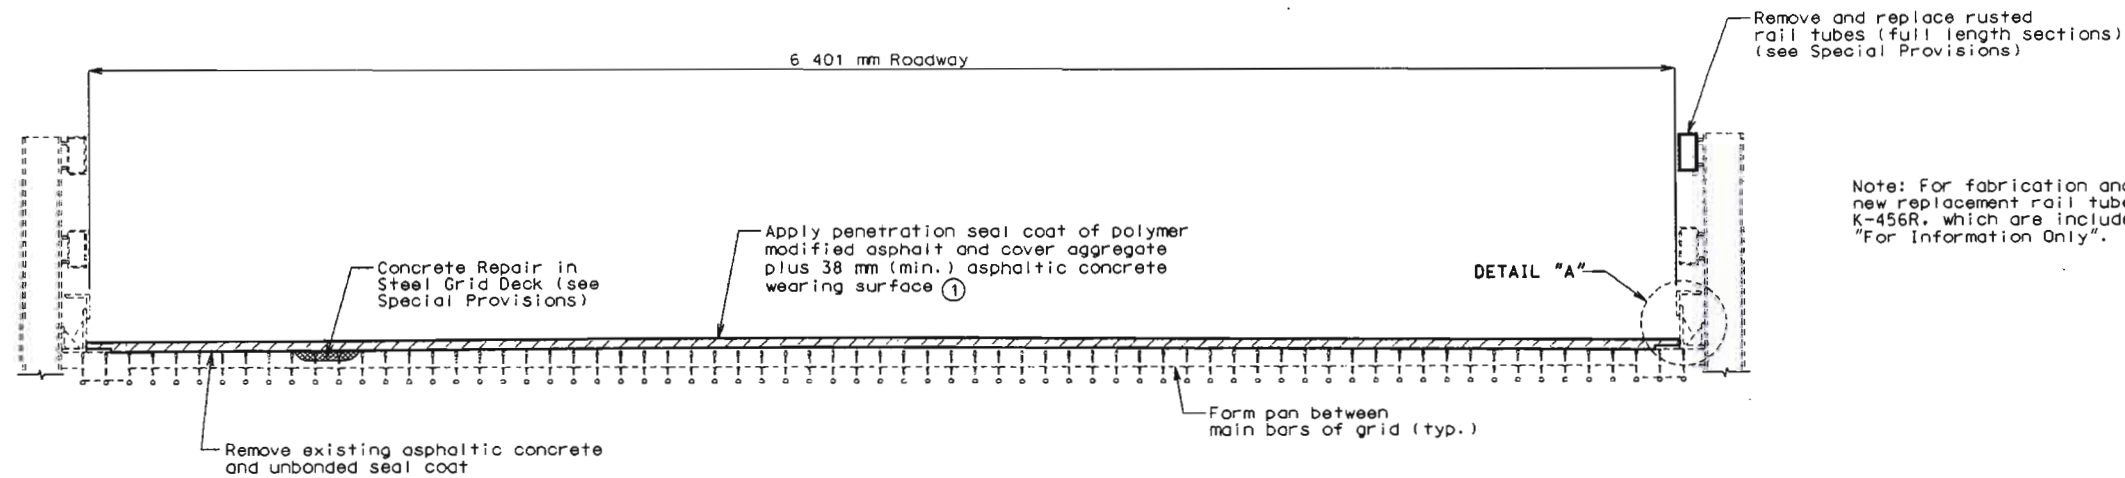


SECTION THRU REHABILITATED SLAB

Note: Main bars of steel grid deck run parallel to roadway everywhere except for spans (1-2) and (2-3).


① 25 mm crown to be constructed of additional asphalt except in the overhead truss spans and areas of deck replacement.

Note: For fabrication and installation information for new replacement rail tubes, see applicable sheets from K-456R, which are included in the contract plans and marked "For Information Only".

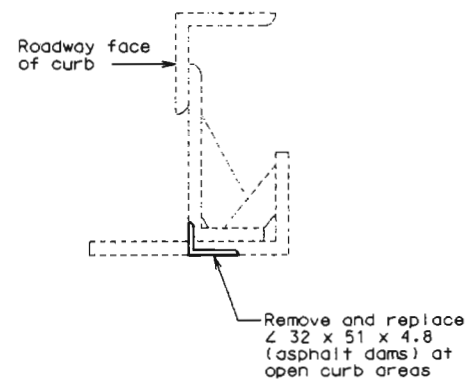

DETAIL "A"
(at open curb)

Note: Weld new $\angle 51 \times 32 \times 4.8$ (asphalt dam) to existing steel grid deck at all points of contact. Weld ends of asphalt dam to edge of rail post brackets at all points of contact.

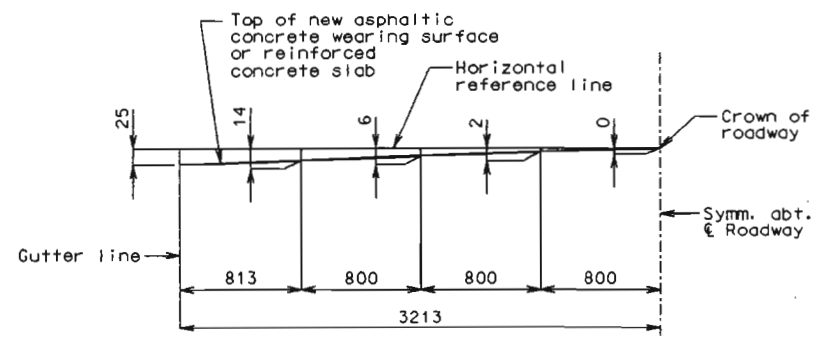


DETAIL OF ROADWAY CROWN

DETAILS OF SLAB REHABILITATION




DATE 8-20-99

State	Proj. No.	Sheet No.
MD		B42

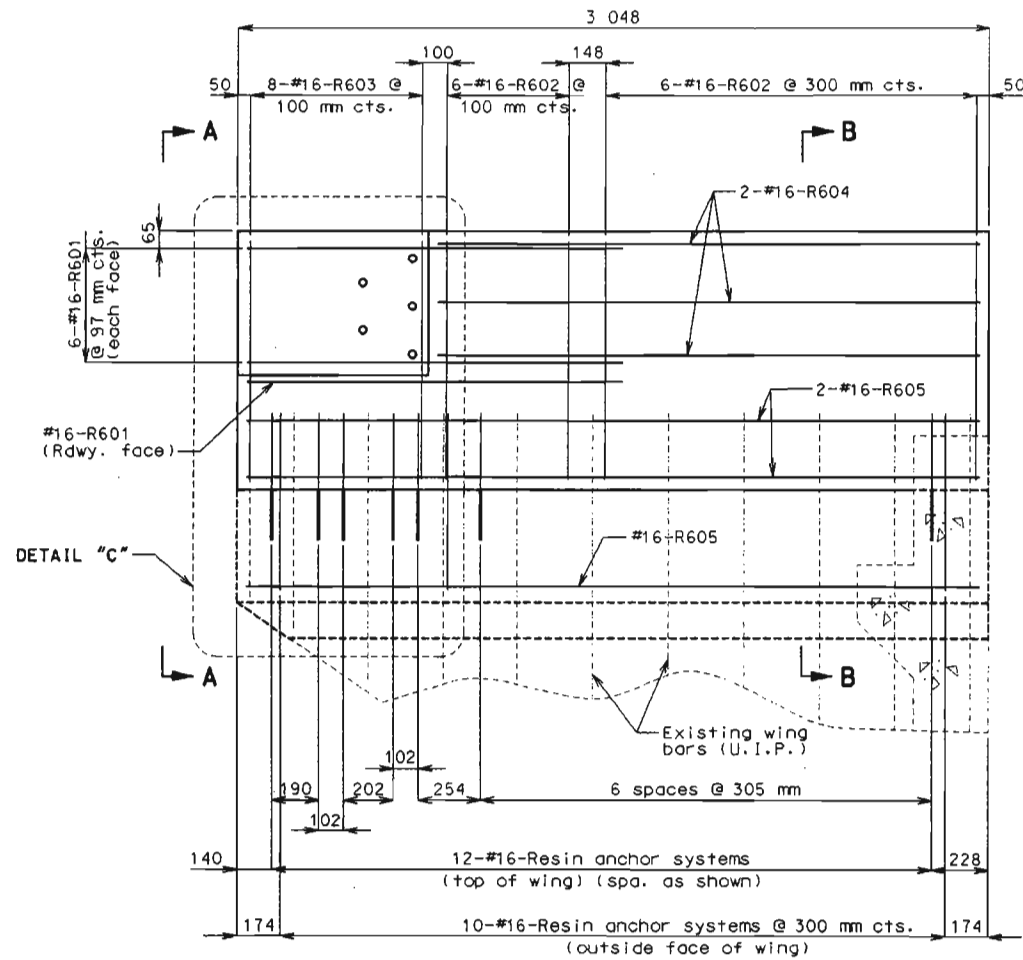


TYPICAL ELEVATION OF END POST

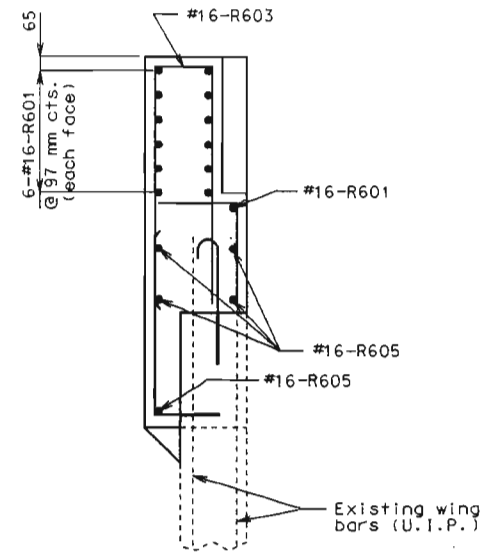


ELEVATION A-A

* Slope 6 mm toward roadway

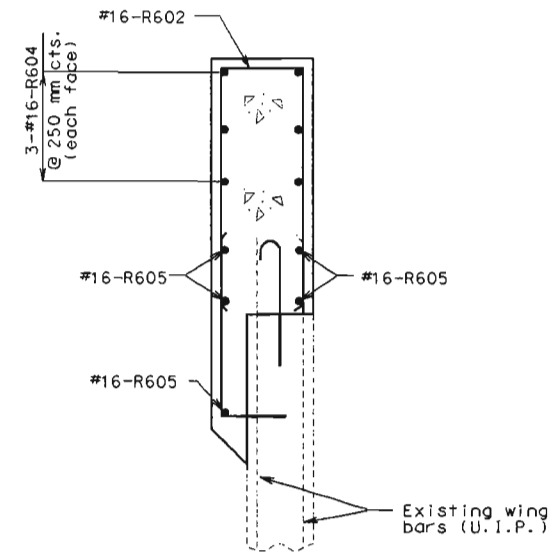


SECTION B-B

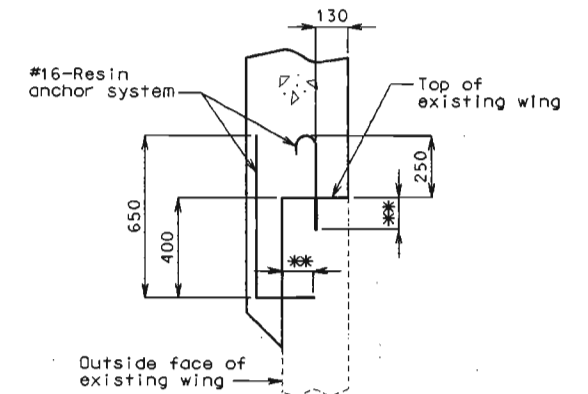


PART SECTION SHOWING RESIN ANCHOR SYSTEMS

** Manufacturer's recommended embedment depth (see Special Provisions)

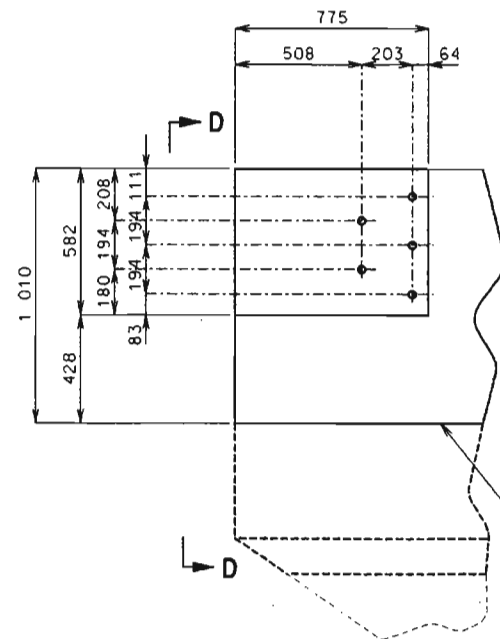

DETAIL "C"

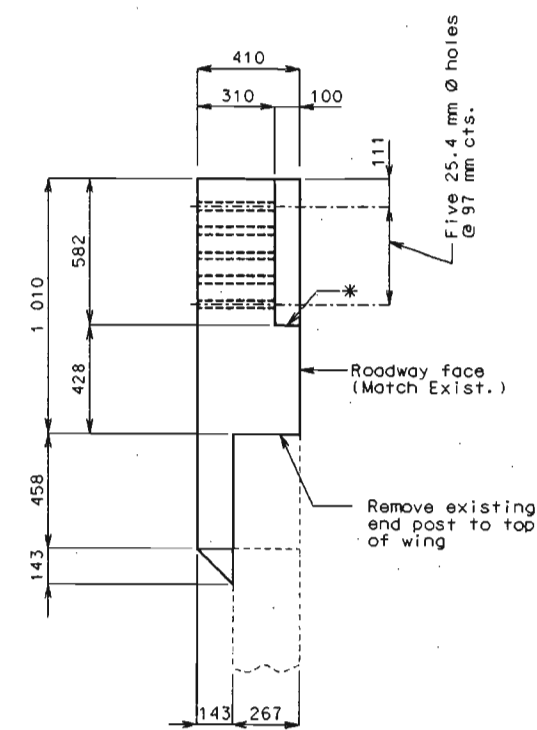

ELEVATION D-D

Note: Remove existing end posts at Bent No. 16 to construction joint at top of wing and replace with new end posts as shown.

All exposed edges of end post shall have either a 15 mm radius or a 10 mm bevel, unless otherwise noted.

Concrete in the end post shall be Class B1 with $f'c = 28$ MPa.

The contractor shall use one of the resin anchor systems listed in the job special provisions. These anchor systems shall be installed according to the manufacturer's specifications, except as modified by the job special provisions.

Cost of furnishing and installing the anchor system complete in place shall be included in the price bid for Remove and Replace End Posts per each.

The 15.9 mm diameter resin anchor systems shall have a minimum ultimate pullout strength of 68.9 kN in concrete with $f'c = 28$ MPa, see special provisions.

An epoxy coated #16 Grade 420 reinforcing bar as shown here shall be substituted for the 15.9 mm threaded rod stud.

The cost for removing existing end posts and the reconstruction of new end posts shall be included in the price bid for Remove and Replace End Posts per each.

DETAILS OF END POST AT BENT NO. 16

Detailed Sept 1998
Checked July 1999


Sheet No. 42 of 46

PLATTE COUNTY

K04563



State	Proj. No.	Sheet No.
MO		B43

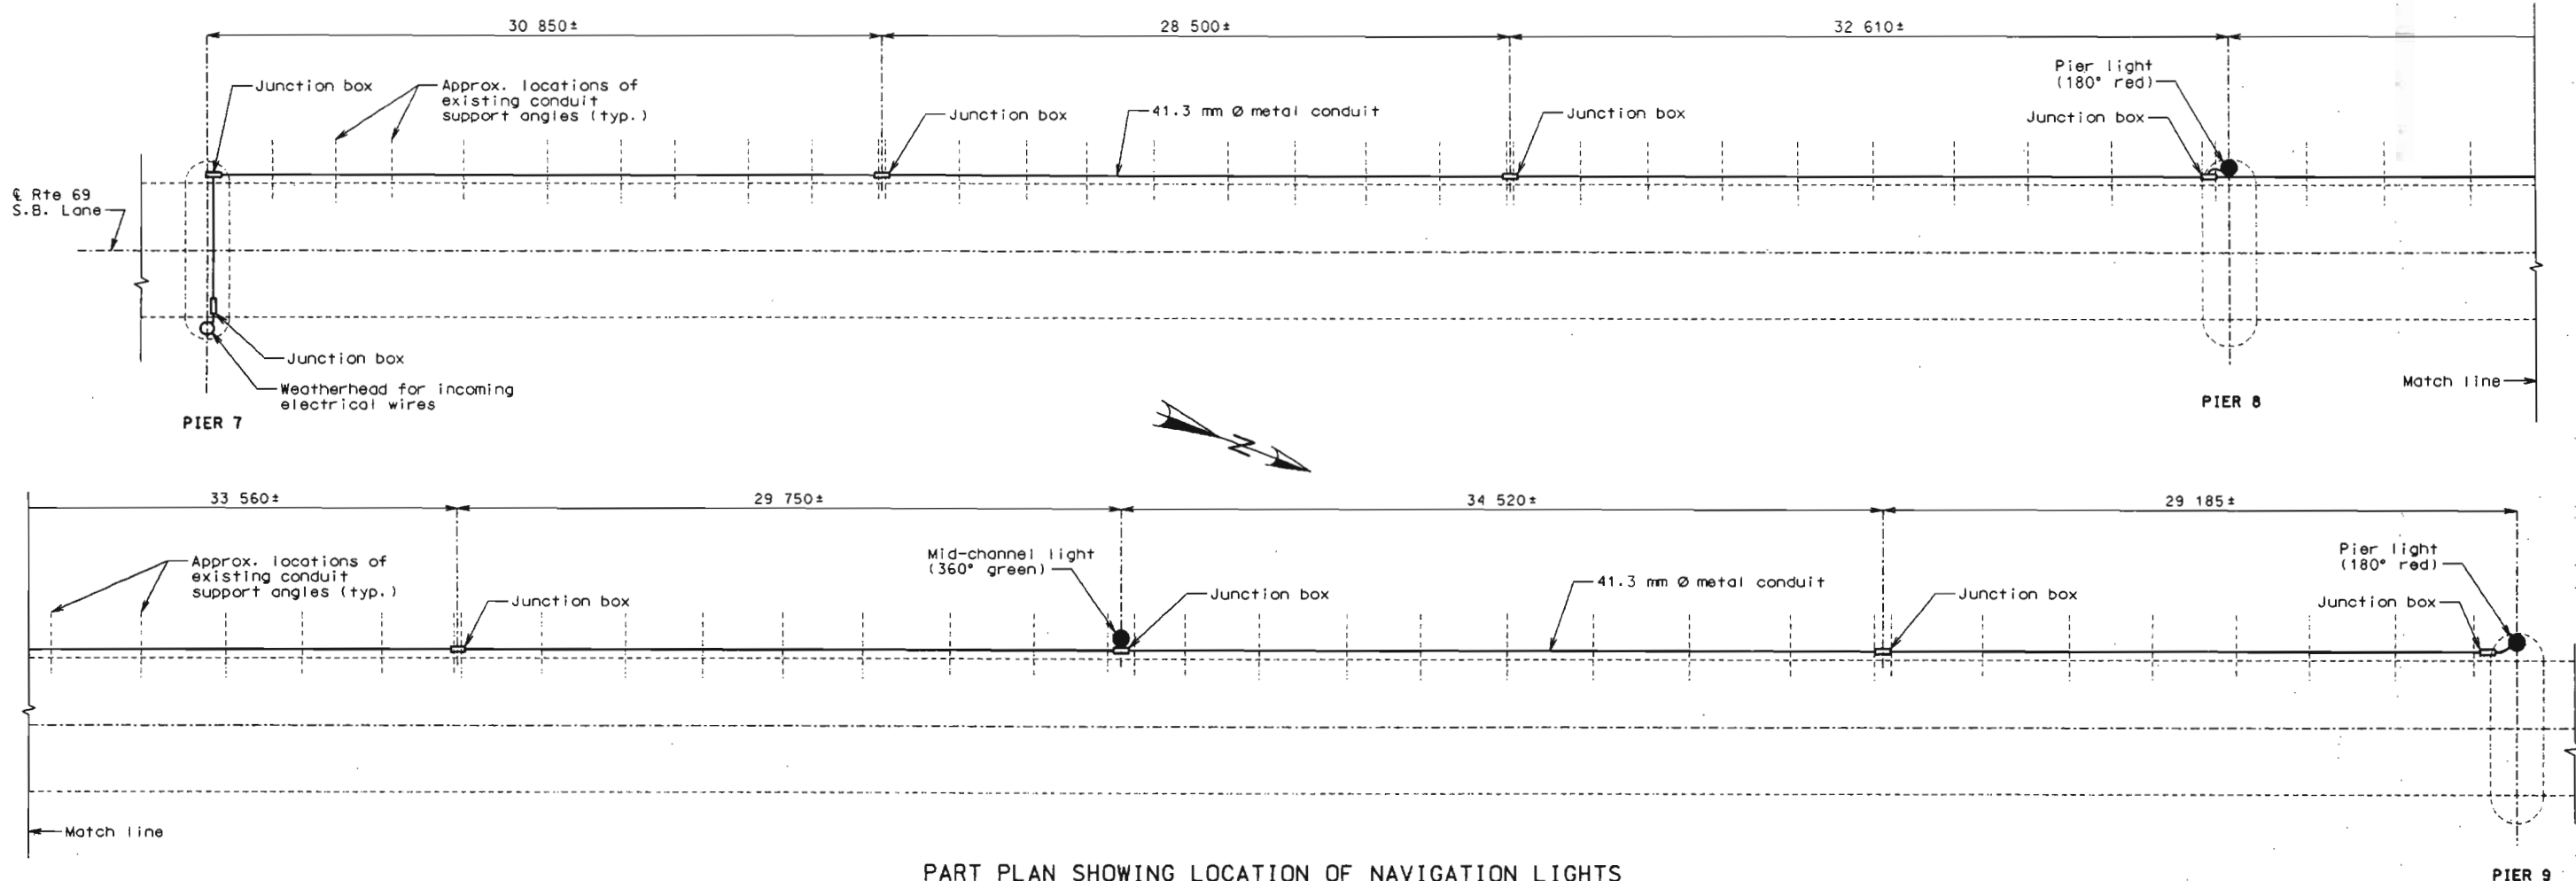

PART PLAN SHOWING LOCATION OF NAVIGATION LIGHTS

GENERAL NOTES FOR NAVIGATION LIGHTING:

Conduit shall be galvanized rigid steel. Each section of conduit shall bear the Underwriters Laboratories, Inc. (UL) label (Sec. 1060).

All conduit from the 41.3 mm Ø main conduit to the light fixtures shall be 25.4 mm Ø flexible metallic conduit.

Weepholes shall be provided at appropriate locations to drain any moisture in the conduit lines.

All junction boxes shall be 305 mm x 305 mm x 102 mm (min.) cast aluminum or stainless steel, drilled for mounting, and meet other requirements of Sec. 1062 except for the requirement to be flanged. See other sheets for mounting details.

The terminations shall be permanent or separable.

The terminations and covers shall be of watertight construction.

Navigation lighting shall meet the requirements of the U.S. Coast Guard.

Existing navigation lighting shall be kept in operation during construction. After installing the new system, the existing system and any other older system shall be removed and disposed of as approved by the engineer and shall be included in the pay item for Navigation Lighting System per lump sum.

Expansion fittings shall be installed in conduit lines between all junction boxes as approved by the engineer.

Expansion fittings shall be installed on conduit lines at each slab expansion device.

Expansion fittings shall provide a minimum movement in either direction of 75 mm at expansion device at Pier No. 8 and 25 mm at all other locations between junction boxes.

Light fixtures shall be bridge lamps as manufactured by the Tideland Signal Corporation of Houston, Texas.

The fixtures shall be furnished complete with lamp-out relays, mountings, and all incidentals.

All bolts, nuts, and washers shall be galvanized, except as noted.

Any field-drilled holes required for attachment of above items shall be considered as part of the navigation lighting system.


Payment for furnishing and installing conduit system for navigation lighting, complete in place, will be paid for at the contract unit price for Navigation Lighting System, lump sum.

Note: Navigation lighting required on west side only.




Detailed Oct. 1998
Checked July 1999


DETAILS OF NAVIGATION LIGHTING

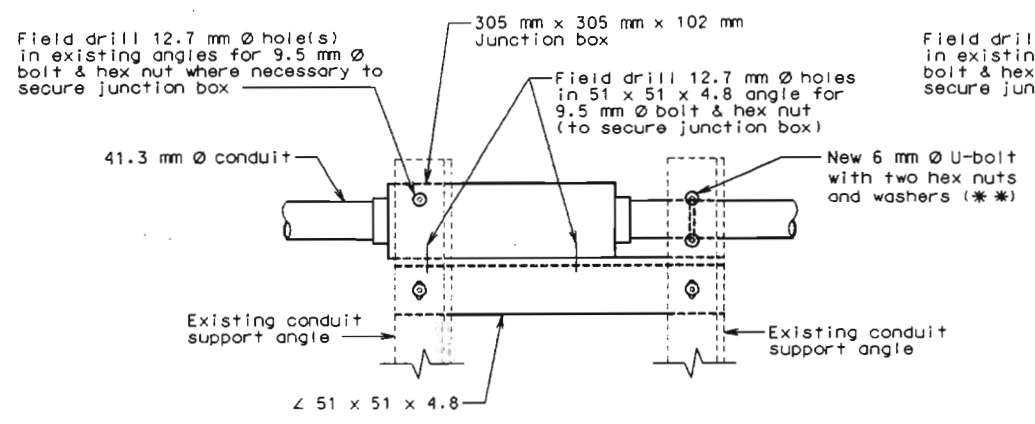

PLAN

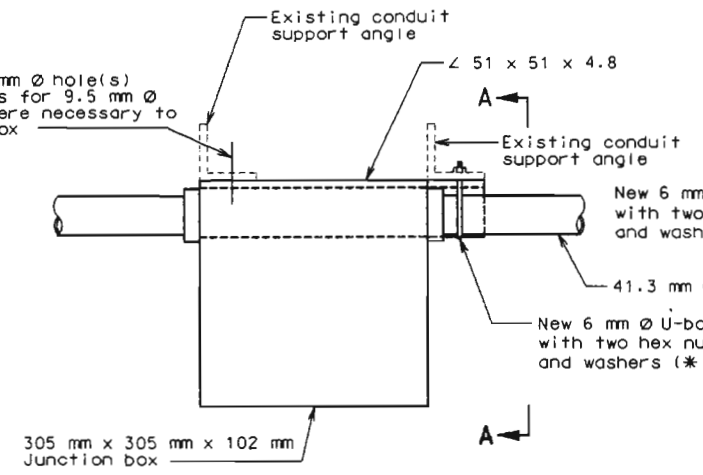


ELEVATION

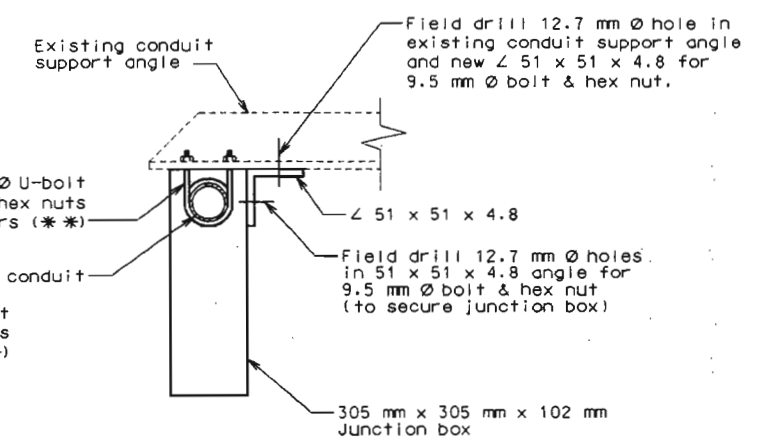

SECTION A-A

ALTERNATE METHOD FOR SECURING JUNCTION BOXES


(WHERE JUNCTION BOX WILL NOT FIT BETWEEN EXISTING CONDUIT SUPPORT ANGLES)

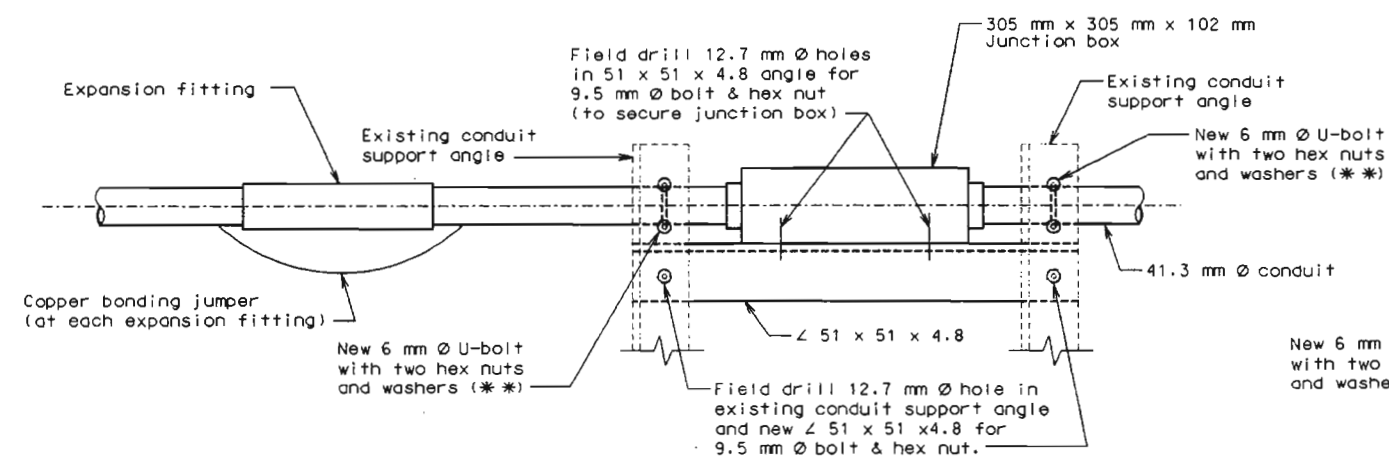


PLAN SHOWING JUNCTION BOX & EXPANSION FITTINGS

* Expansion fittings shall be installed in conduit lines between all junction boxes and at slab expansion joints as approved by the engineer.

** Use existing holes in conduit support angle.

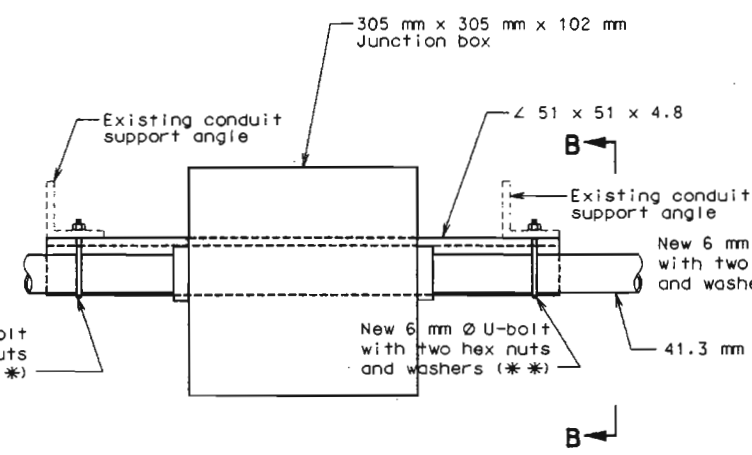

ELEVATION

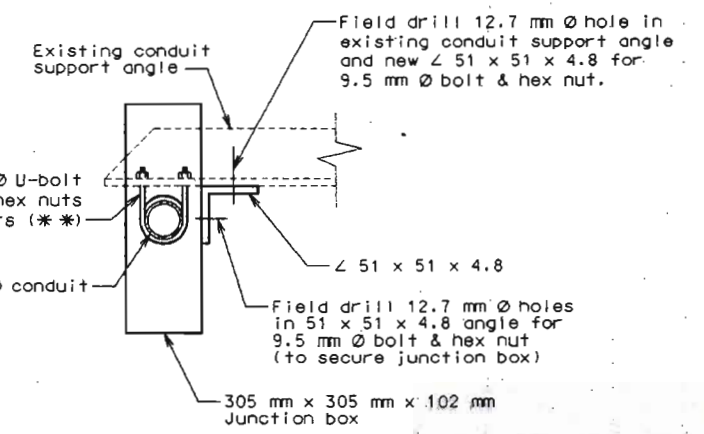

SECTION B-B

JUNCTION BOX ATTACHMENT DETAILS


(WHERE JUNCTION BOX WILL FIT BETWEEN EXISTING CONDUIT SUPPORT ANGLES)




DATE 8-20-99

DETAILS OF NAVIGATION LIGHTING

State	Proj. No.	Sheet No.
MO		B45

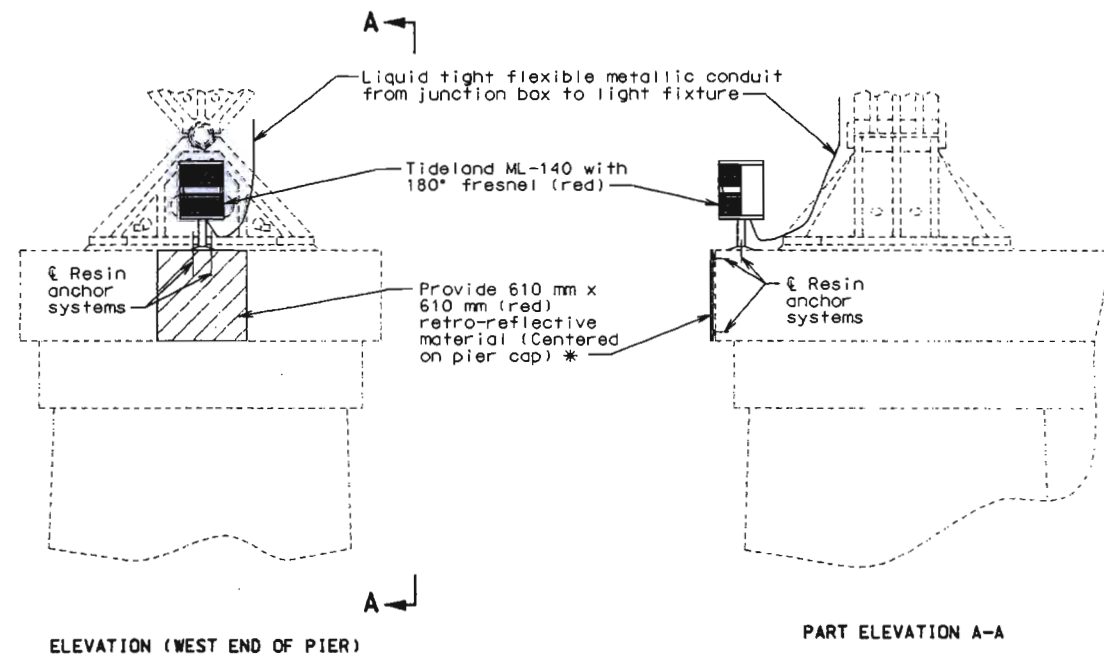

NAVIGATION LIGHTS AT PIERS 8 & 9

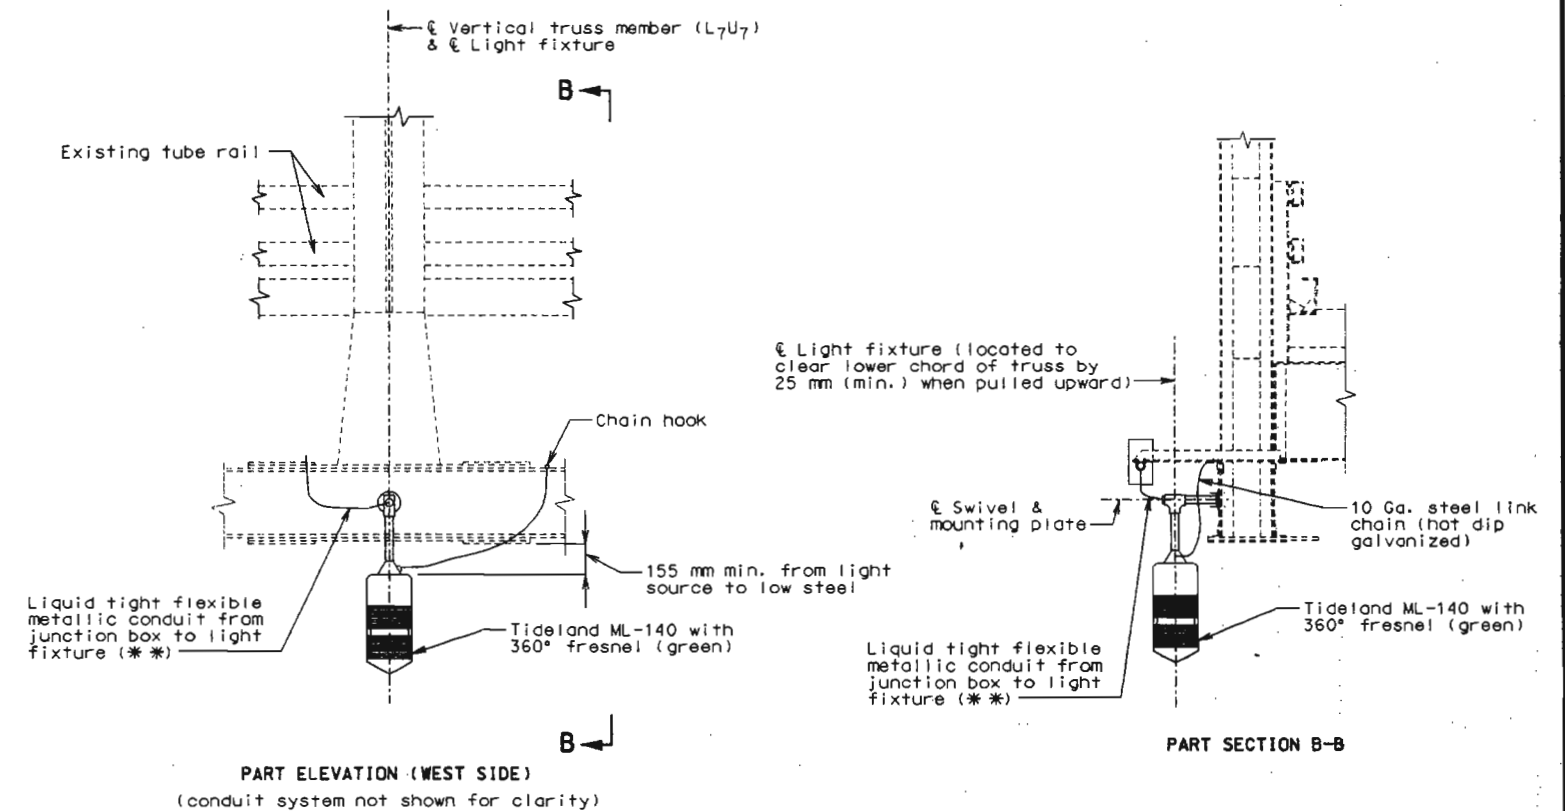

NAVIGATION LIGHT AT MID-CHANNEL (L7) (SPAN 8-9)

* Type 2 reflective sheeting on an aluminum flat sheet in accordance with Section 1042 of the Missouri Standard Specifications. For mounting, use 9.5 mm Ø stainless steel studs, washers, and nuts with resin anchor systems. See Special Provisions. Space aluminum flat plate away from existing concrete with 9.5 mm stainless steel spacer.

** Minimize length of flexible conduit as approved by the engineer.

Utilize existing holes where possible when mounting swivel plate. Use galvanized bolts, size and number as recommended by the manufacturer and approved by the engineer.

Galvanized studs used for the resin anchor systems shall be the same size and number as recommended by the manufacturer and approved by the engineer.



DATE 8-20-99

Detailed Sept 1998
Checked July 1999

DETAILS OF NAVIGATION LIGHTING

Sheet No. 45 of 46

PLATTE COUNTY

K04563



BILL OF REINFORCING STEEL

No. Req'd.	Mark No.	Location	Epoxy (E)	Shape No.	Stirrup (S)	Substr. (X)	Varies (V)	Dimensions							Nominal Length	Actual Length	Mass
								B	C	D	E	F	H	K			
Size	Mark							mm	mm	mm	mm	mm	mm	mm	mm	kg	
SUB-STRUCTURE																	
BENT NO. 14																	
11	22	H400	BEAM	E 20	X			6020						6020	6020	201	
6	19	H401	BEAM	E 20	X			6020						6020	6020	81	
8	19	H402	BEAM	E 10	S	X			560	955				2075	1980	35	
9	22	H403	BEAM	E 18	X			6020						6520	6520	179	
18	13	P400	COLUMN	E 13	S	X		605	835	605	835			3110	3030	54	
32	16	U400	BEAM	E 13	S	X		655	835	655	835			3260	3160	157	
8	16	U401	BEAM	E 10	S	X			835	655				2325	2260	28	
18	25	V400	COLUMN	E 17	X			2860						3135	3135	224	
8	W5	N400	BEAM	E 22	X			381	230					7010	7010	14	
SUPER-STRUCTURE																	
@ BENT 3																	
51	16	S31	SLAB	E 20				1405						1405	1405	111	
33	19	S32	SLAB	E 20				2470						2470	2470	182	
31	19	S33	SLAB	E 20				6550						6550	6550	454	
47	22	S34	SLAB	E 20				2470						2470	2470	353	
10	16	S35	SLAB	E 20				6550						6550	6550	102	
8	19	S36	SLAB	E 20				915						915	915	16	
@ BT 5 & 14																	
132	19	S51	SLAB	E 20				2560						2560	2560	755	
40	16	S52	SLAB	E 20				6550						6550	6550	407	
188	22	S53	SLAB	E 20				2560						2560	2560	1464	
60	19	S54	SLAB	E 20				6550						6550	6550	878	
32	19	S55	SLAB	E 20				915						915	915	65	
@ BT 7 & 12																	
54	16	S71	SLAB	E 20				6550						6550	6550	549	
32	19	S72	SLAB	E 20				6550						6550	6550	468	
66	19	S73	SLAB	E 20				2450						2450	2450	361	
94	22	S74	SLAB	E 20				2450						2450	2450	701	
166	19	S75	SLAB	E 20				2105						2105	2105	781	
16	19	S76	SLAB	E 20				915						915	915	33	
@ BT 8 & 12																	
64	16	S81	SLAB	E 20				6550						6550	6550	651	
332	19	S82	SLAB	E 20				2050						2050	2050	1521	
@ L19																	
24	16	S91	SLAB	E 20				6550						6550	6550	244	
166	19	S92	SLAB	E 20				1620						1620	1620	601	


BILL OF REINFORCING STEEL

No. Req'd.	Mark No.	Location	Epoxy (E)	Shape No.	Stirrup (S)	Substr. (X)	Varies (V)	Dimensions							Nominal Length	Actual Length	Mass
								B	C	D	E	F	H	K			
Size	Mark							mm	mm	mm	mm	mm	mm	mm	mm	kg	
END POST @ BENT 16																	
26	16	R601	END POST	E 20										1600		65	
24	16	R602	END POST	E 10	S				930	330				2190	2125	79	
16	16	R603	END POST	E 10	S				930	230				2090	2025	50	
12	16	R604	END POST	E 20										2190	2190	41	
12	16	R605	END POST	E 20										2965	2965	55	

State	Proj. No.	Sheet No.
MO		1346

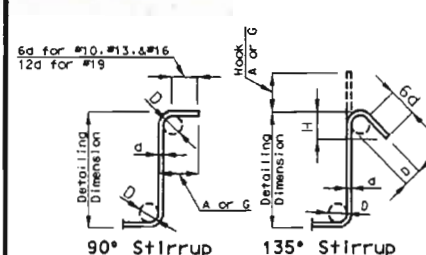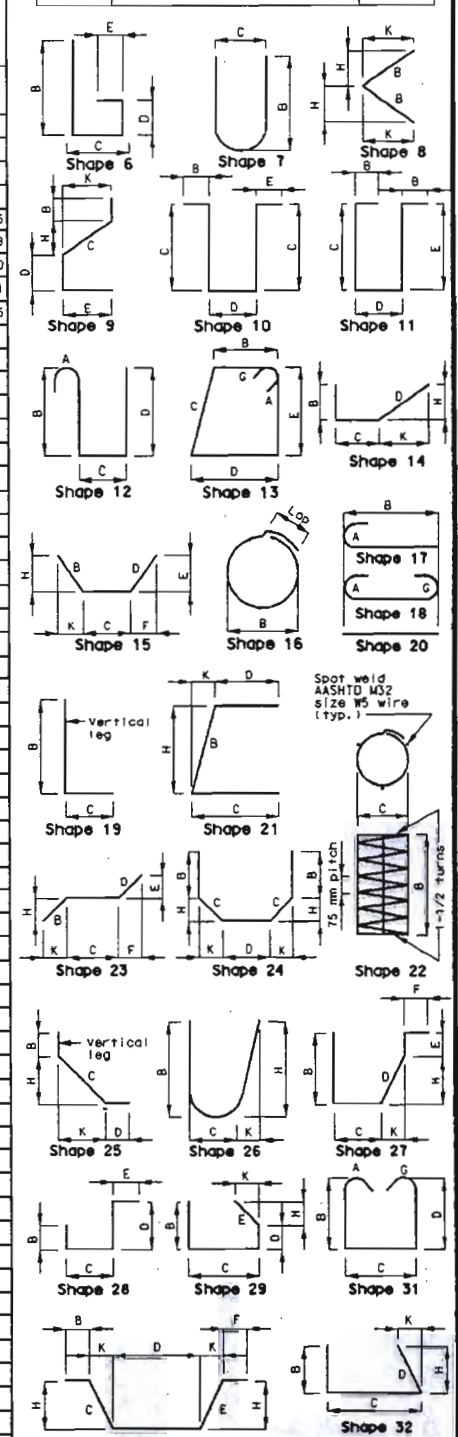


Bar Size	D	90° Hook		135° Hook	
		A or G	B or H	A or G	B or H
#10	60	125	80	150	100
#13	50	115	115	80	80
#16	65	155	140	95	95
#19	115	305	205	115	115

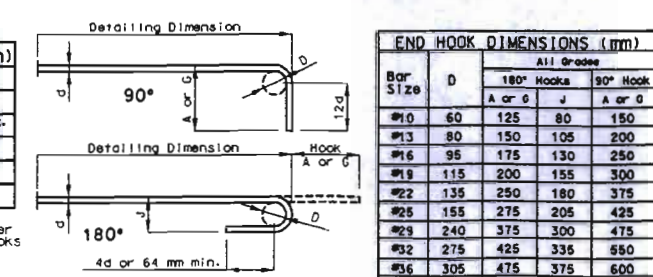

Bar Size	D	180° Hook		90° Hook	
		A or G	J	A or G	J
#10	60	125	80	150	100
#13	50	115	115	80	80
#16	65	155	140	95	95
#19	115	305	205	115	115
#22	135	250	180	375	275
#25	155	275	205	425	325
#29	240	375	300	475	375
#32	275	425	335	530	430
#36	305	475	375	600	500
#43	465	675	550	775	675

Note:
 All standard hooks and bends other than 180 degree to be bent with the same procedure as for 90 degree standard hooks.
 Hooks and bends shall be in accordance with the procedures as shown on this sheet.
 E = epoxy coated reinforcement
 S = stirrup
 X = bar is included in substructure quantities
 V = bar dimensions vary in equal increments between dimensions shown on this line and the following line.
 No. Ea. = number of bars of each length
 Nominal lengths are based on out to out dimensions shown in bending diagrams and are listed for fabricator's use (nearest 5 mm).
 Actual lengths are measured along centerline bar to the nearest 5 mm.
 Payweights are based on actual lengths.
 Four angle or channel spacers are required for each column spiral. Spacers are to be placed on inside of spirals. Length and mass of column spirals do not include splices or spacers.
 Reinforcing steel (Grade 420) = Fy 420 MPa

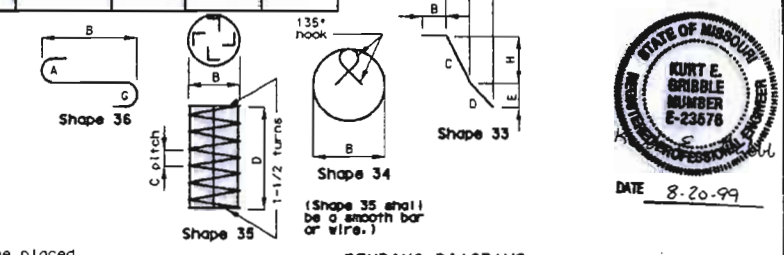

Detailed July 1999
 Checked July 1999