

# NEW FAIRFAX BRIDGE PROJECT

NEAR

## KANSAS CITY, KANSAS

FOR

## PLATTE COUNTY, MISSOURI

1955

CONTRACT I--SUBSTRUCTURE NEW FAIRFAX BRIDGE

### INDEX OF DRAWINGS

1. GENERAL PLAN AND ELEVATION
2. SUBSTRUCTURE GENERAL NOTES AND QUANTITIES
3. ABUTMENT 1 & BENT 14
4. ABUTMENT 16
5. BENTS 2, 3, 5, 6, 13, & 15
6. BENT 4
7. PIERS 7 & 12 AND RELOCATION OF COLLECTOR PIPE AT PIER 7
8. PIERS 8 & 11
9. PIERS 9 & 10
10. ANCHOR BOLT PLAN AND LOG OF BORINGS
11. TYPICAL BAR TYPES AND HOOK DIMENSIONS
12. SUBSTRUCTURE BAR LIST--SPECIAL BENDING DETAILS AND CUTTING DIAGRAMS
13. SUBSTRUCTURE BAR LIST--SPECIAL BENDING DETAILS AND CUTTING DIAGRAMS

### APPROVED

COUNTY COURT OF PLATTE COUNTY MISSOURI

----- PRESIDING JUDGE ----- DATE -----

MISSOURI STATE HIGHWAY COMMISSION

----- CHIEF ENGINEER ----- DATE -----

STATE HIGHWAY COMMISSION OF KANSAS

----- CHIEF ENGINEER ----- DATE -----




SVERDRUP AND PARCEL, INC.  
CONSULTING ENGINEERS  
ST. LOUIS, MO.

SUBMITTED BY

REGISTERED PROFESSIONAL ENGINEER  
MISSOURI NO. E-640

RT. 69

A-450

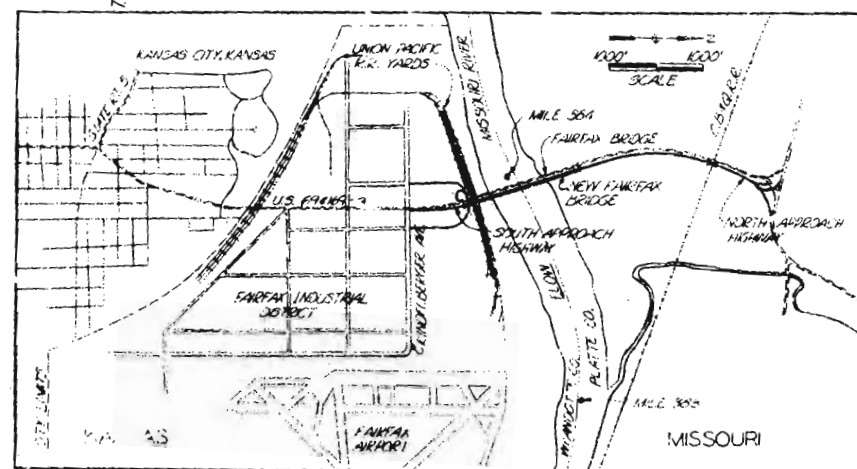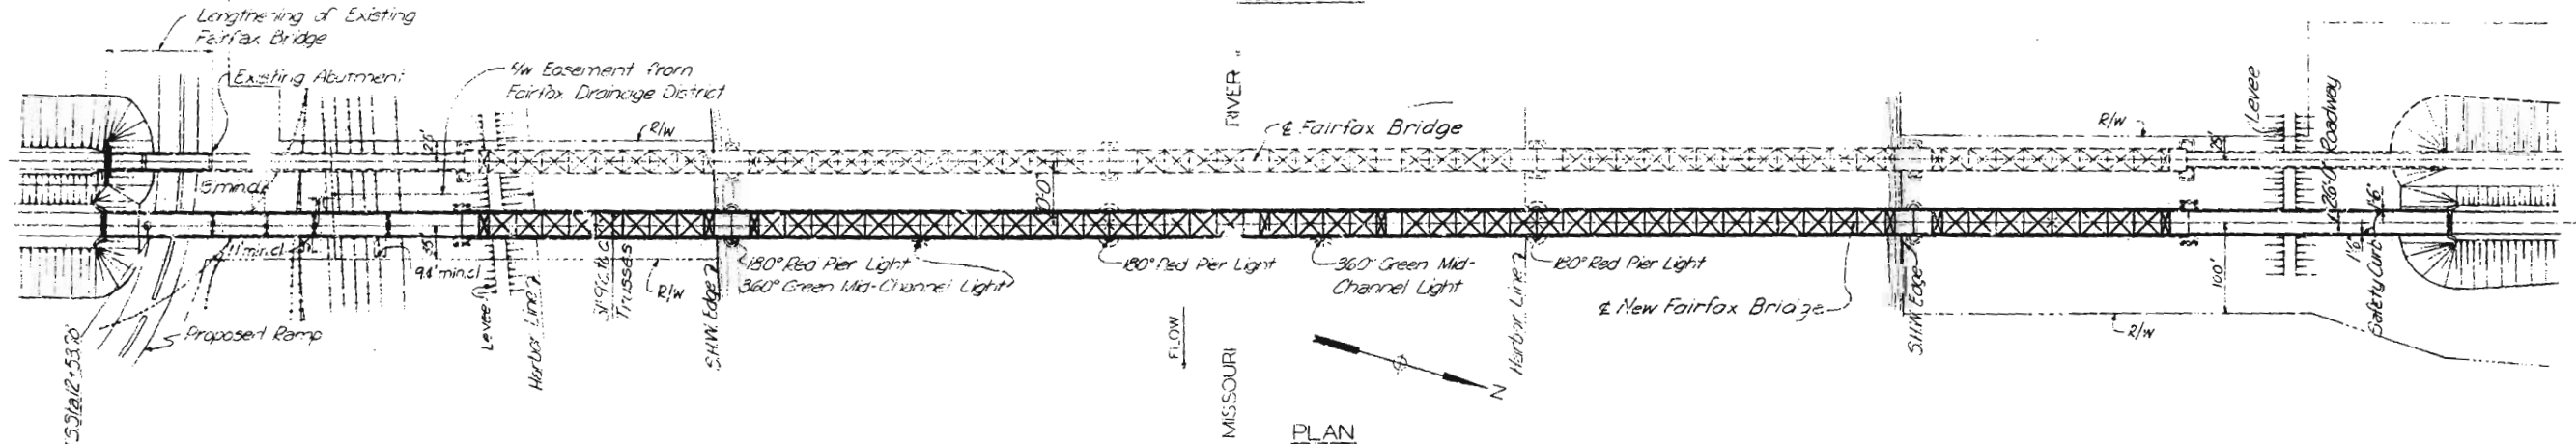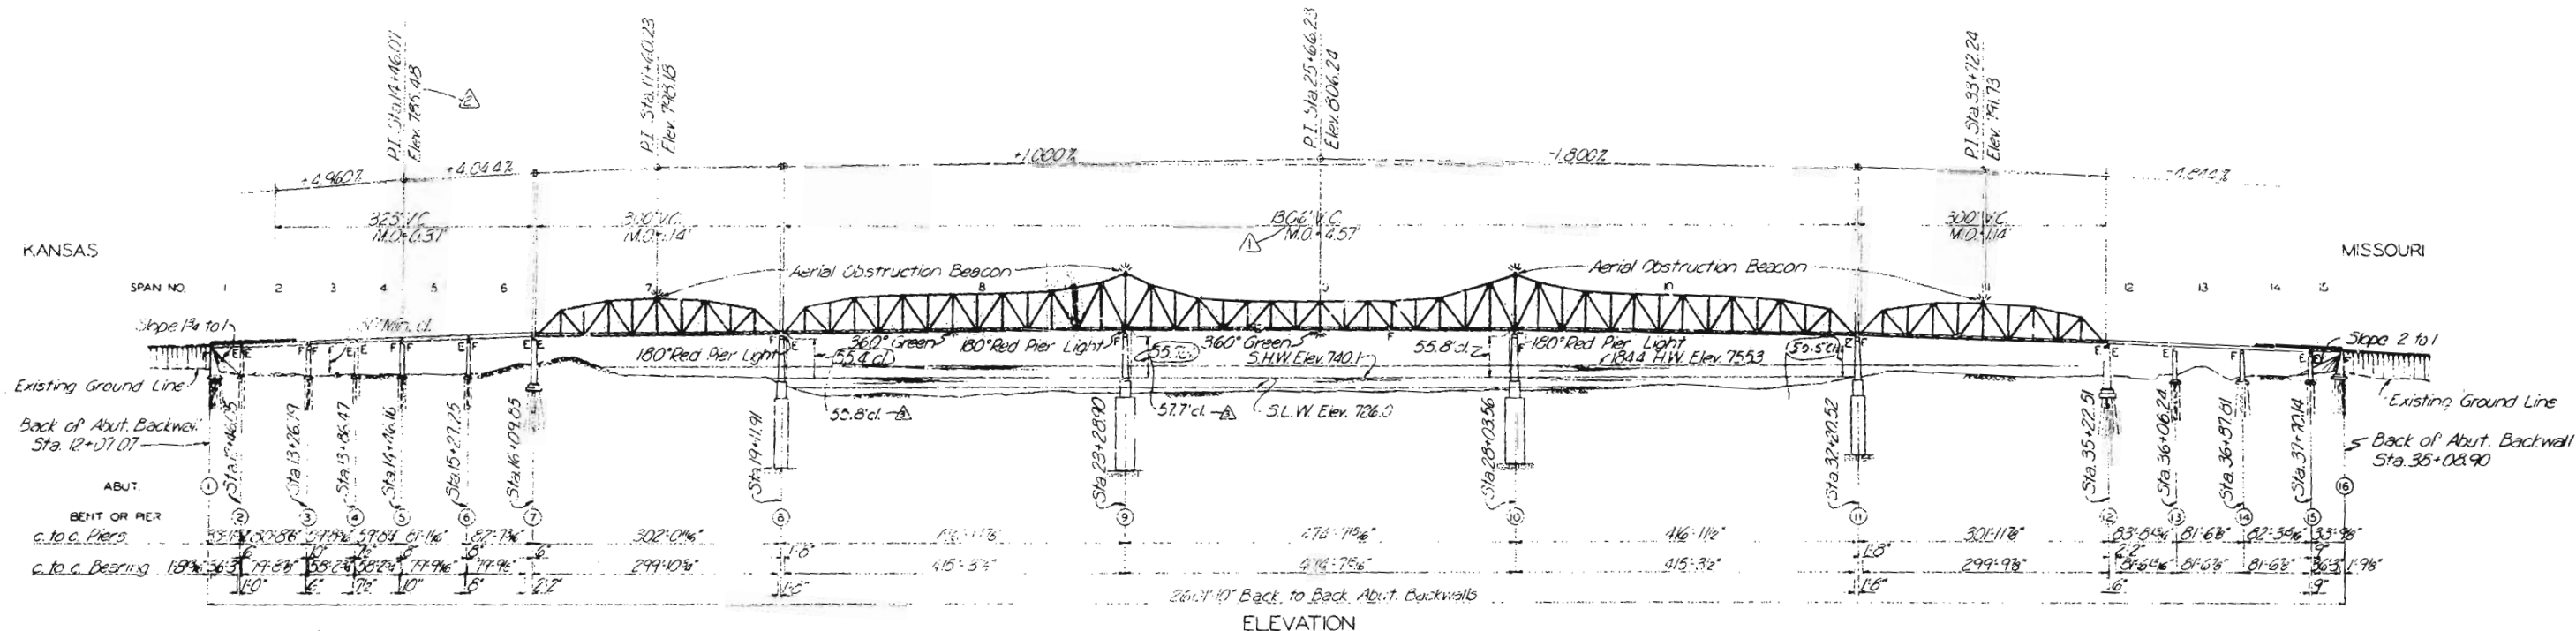

NEW FAIRFAX BRIDGE  
OVER MISSOURI RIVER  
NEAR KANSAS CITY, KANSAS  
FOR  
PLATTE COUNTY, MISSOURI

GENERAL PLAN AND ELEVATION

SVERDRUP AND PARCEL, INC.  
CONSULTING ENGINEERS  
ST. LOUIS, MO.

SHEET 1 OF 13

AS BUILT DRAWING

FINAL DESIGN DRAWING

A-450  
Platte Co  
RF 62

Revision 1 Cl on Piers 3 & 9, 1-20-59 By R.E.B. Mtd. J.E.C.  
Revision 2 Elevation of P.I. 5-31-56 by H.T.S. Chd. J.L.  
Revision 3 Length of Vert. Curve, 5-9-56 By H.T.S. Chd. D.K.

Note: Do not scale this drawing. Follow dimensions.

Drawn by: H.T. Sanders, Mar. 1956  
Checked by: D. Kotakis, Apr. 1956

## SUBSTRUCTURE GENERAL NOTES

SPECIFICATIONS: Standard Specifications of the Missouri State Highway Commission, 1955 Edition, supplemented by General and Special Provisions.

DESIGN LOADING: In accordance with Division III of the A.A.S.H.O. Standard Specifications for Highway Bridges, 1953 Edition, with the following exceptions and interpretations:

Live Load: H20-S16-44, except that the concentrated load used in combination with a lane load is taken as 26,000 pounds for both shear and moment calculations for the truss spans only.

Safety Curb Live Load: None

Dead Load: Provision is made for a future wearing surface of 15 pounds per square foot of roadway surface. Provision is made for future utilities of 630 pounds per foot of bridge in addition to the weight of the structure. Haydite Concrete is assumed to weigh 105 pounds per cubic foot.

Wind Load: Provision is made for transverse, longitudinal, quartering and vertical wind forces. Transverse wind force for the design of superstructure is assumed to be 50 pounds per square foot or a combination of 30 pounds per square foot on the structure plus 200 pounds per lineal foot on the live load. For substructure design the transverse wind is assumed to be 50 pounds per square foot or combination of 15 pounds per square foot on the substructure and superstructure and 100 pounds per lineal foot on the live load.

Longitudinal wind force on the superstructure spans is as specified in the A.A.S.H.O.

For quartering wind (45° to bridge centerline), the simultaneous lateral and longitudinal forces applied to the superstructure are as follows:

For truss spans:

Lateral .707 times total transverse wind.

Longitudinal .354 times total transverse wind.

For girder spans:

Lateral .707 times total transverse wind.

Longitudinal .177 times total transverse wind.

Wind area of substructure units is actual projection.

A vertical wind force acting on the truss spans only is assumed in design of shoes and substructure. The assumed force is an upward force applied at the windward quarter point of plan width.

For combination with dead load plus 50 pounds transverse wind, the force is 20 pounds per square foot of deck plan area. For combination with dead load, live load and transverse wind, the force is 6 pounds per square foot of deck plan area.

Impact: No impact for substructure units.

## FOUNDATION DESIGN LOADS:

Rock Bearing Pressure: The normal maximum design load pressure for vertical loads is 12 Tons per square foot with increases for combinations of loads as specified in A.A.S.H.O. Art. 3.4.1.

Timber Piles: The normal maximum design load for vertical loads is 20 Tons per pile with increases for combinations of loads as specified in A.A.S.H.O. Art. 3.4.1.

## DESIGN UNIT STRESSES IN CONCRETE:

Concrete in flexure 1,200 pounds per square inch.

Reinforcing Steel 20,000 pounds per square inch.

TIMBER PILES: All timber piles shall be driven to sustain a load of 27 Tons.

They shall have a minimum penetration of 35 feet except at Piers 7 and 12 the minimum penetration shall be 40 feet below bottom of seal course.

BEARING AREAS: Raised bearing areas on piers shall be poured monolithically with pier cap. All bearing areas to receive superstructure shall be finished perfectly smooth and level at the elevations shown on plans. See Standard Specifications.

REINFORCEMENT: All dimensions to reinforcing steel on detail drawings are to  $\frac{1}{4}$  of bar, except where the clear dimensions are noted from face of concrete. All reinforcing steel shall be lapped a minimum of 30 diameters unless otherwise shown or noted.

CONCRETE: Class B (air-entrained) concrete shall be used for all substructure concrete including bases of Piers 8, 9, 10 and 11.

BEVELED EDGES: All exposed edges of concrete shall be beveled  $\frac{3}{4}$  unless otherwise shown or noted.

CONSTRUCTION JOINTS: Construction joints shall be made only at locations shown on the plans, except that the Engineer will approve the use of such additional construction joints in the caissons and ice breakers as may be necessary or desirable for a satisfactory handling of this work. Provide keys at all construction joints.

ANCHOR BOLT WELLS: Care shall be exercised in locating anchor bolt wells to the dimensions shown on the detail drawings. All anchor bolts shall be set in wells, except at the Contractor's option anchor bolts for Spans 1 and 15 may be cast in place.

COPPER FLASHING: Payment for furnishing and placing Copper Flashing shall be included in unit contract price for concrete.

## TABLE OF ESTIMATED QUANTITIES

Item	Unit	Quantity
Class 1 Excavation for Structures	Cu. Yds.	2420
Class 2 Excavation for Structures	Cu. Yds.	420
Class B Concrete	Cu. Yds.	3283
Class B Concrete in Seal Courses	Cu. Yds.	245
Class B Concrete (Bases of Piers 8 & 11)	Cu. Yds.	4620
Class B Concrete (Bases of Piers 9 & 10)	Cu. Yds.	6108
Plain Timber Piles in place	Lin. Ft.	11,400
Treated Timber Piles in place	Lin. Ft.	10,080
Reinforcing Steel	Lbs.	764,880
Relocation of Collector Pipe and Filter at Pier 7	See Change Order No. 1	

Note:

Excavation for bridge made above Elevation 727.0 shall be paid for as Class 1 Excavation for Structures, except for Piers 8, 9, 10 & 11.

Excavation for bridge made below Elevation 727.0 shall be paid for as Class 2 Excavation for Structures, except for Piers 8, 9, 10 & 11.

The cost of excavation necessary for the construction of Piers 8, 9, 10 & 11 shall be included in the price bid for Class B Concrete (Base of Pier).

The volumes of Class B Concrete (Base of Piers 8, 9, 10 & 11) are the gross volumes of the base as shown on the plans with no deductions for the wells.

## TABLE OF FINAL QUANTITIES

Item	Unit	Quantity
Class 1 Excavation for Structures	Cu. Yds.	2,040.5
Class 2 Excavation for Structures	Cu. Yds.	495.5
Class B Concrete	Cu. Yds.	4,090.8
Class B Concrete in Seal Course	Cu. Yds.	153.6
Class B Concrete (Bases of Piers 8 & 11)	Cu. Yds.	4,548.7
Class B Concrete (Bases of Piers 9 & 10)	Cu. Yds.	5,928.9
Plain Timber Piles in Place	Lin. Ft.	5,508
Treated Timber Piles in Place	Lin. Ft.	14,910
Reinforcing Steel	Lbs.	765,050
Relocation of Collector Pipe & Filter @ Pier 7	One	Lump Sum
Adjustment for Additional Costs	One	Lump Sum

NEW FAIRFAX BRIDGE  
OVER MISSOURI RIVER  
NEAR KANSAS CITY, KANSAS

FOR  
PLATTE COUNTY, MISSOURI

SUBSTRUCTURE GENERAL NOTES  
AND QUANTITIES

SVERDRUP AND PARCEL, INC.  
CONSULTING ENGINEERS  
ST. LOUIS, MO.

FINISHED

SHEET 2 OF 13

A-630

AS BUILT DRAWING




FINAL DESIGN DRAWING

Platte Co.  
RE 69














Revision  $\Delta$  Final Quantities, 1-20-59 By R.E.B. Chkd. JEC

Drawn by: W.J. Ballard, Apr. 1956

Checked by: E. Lemcoe, Apr. 1956

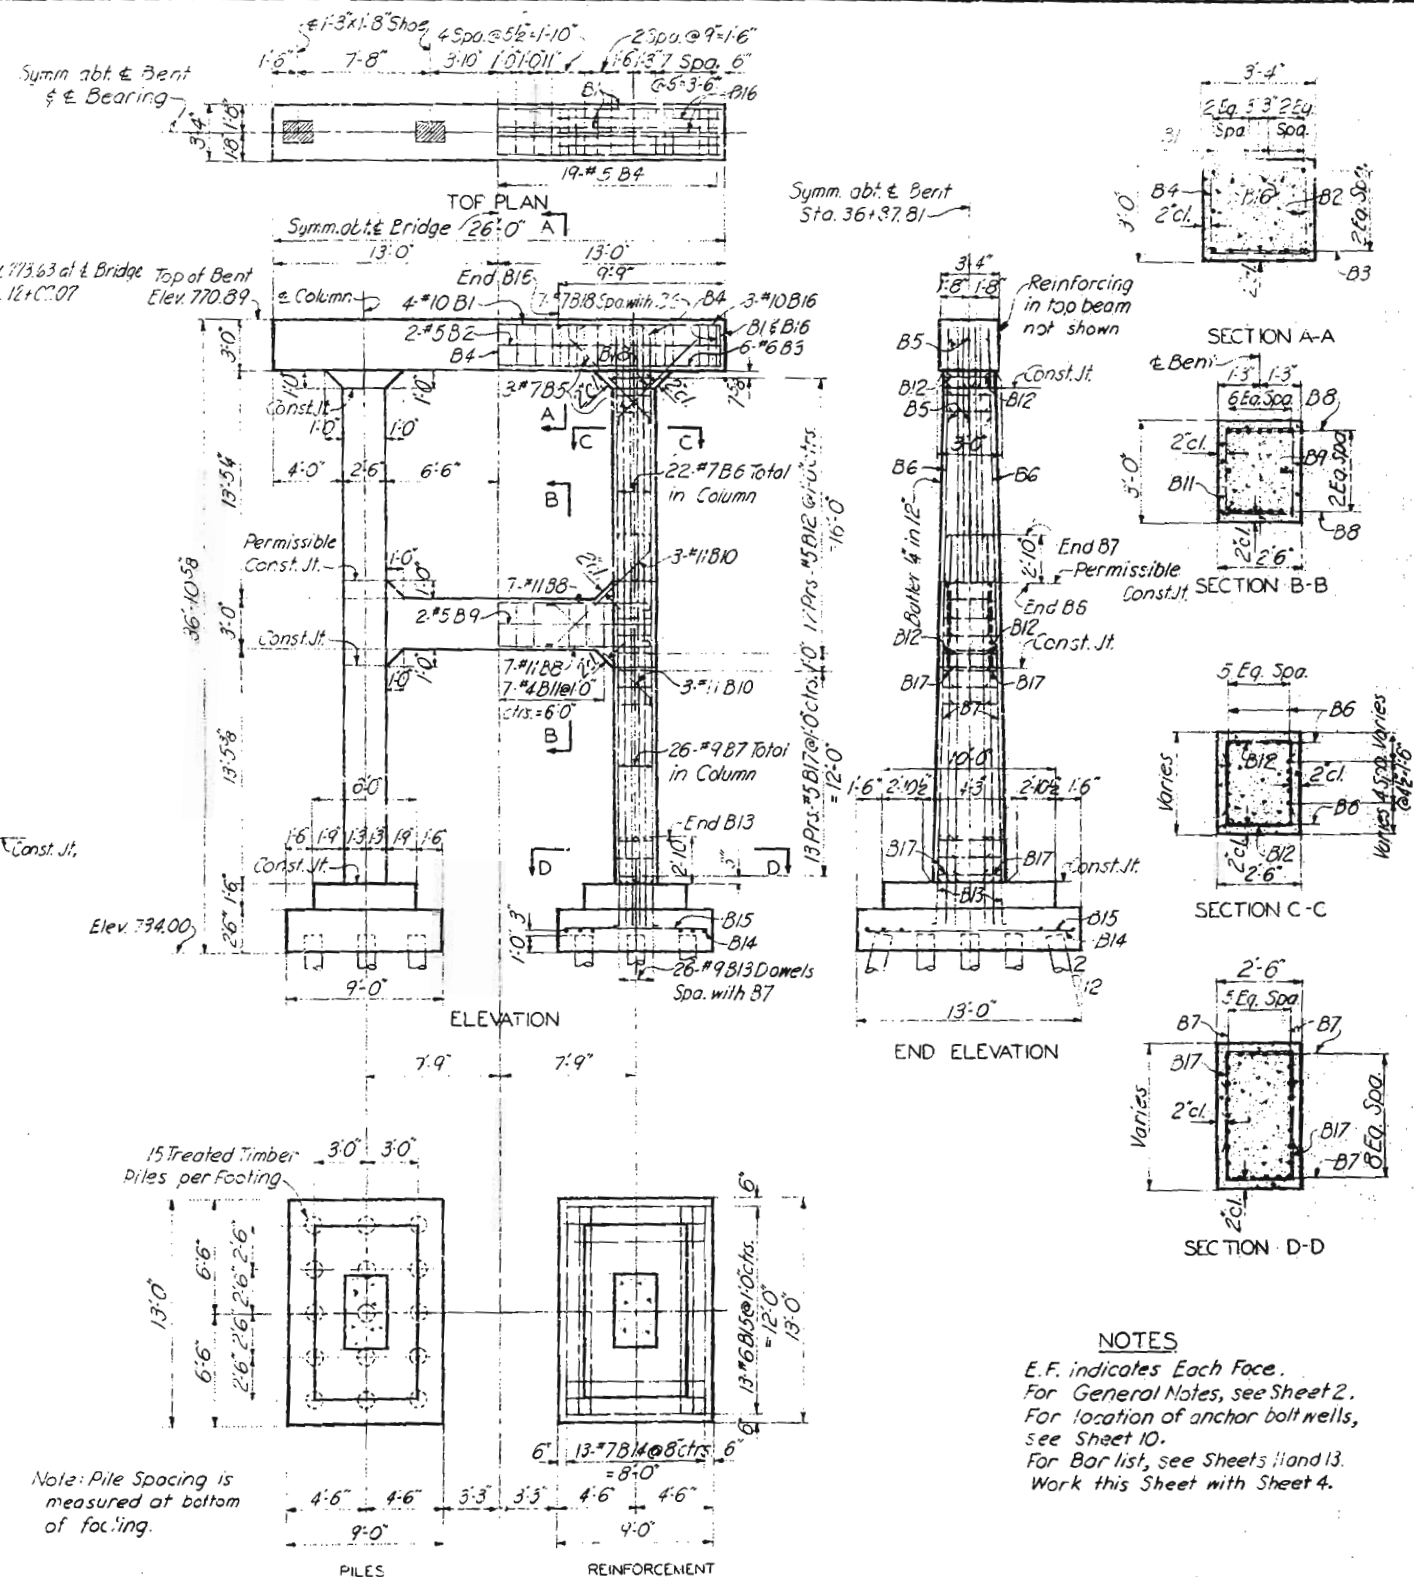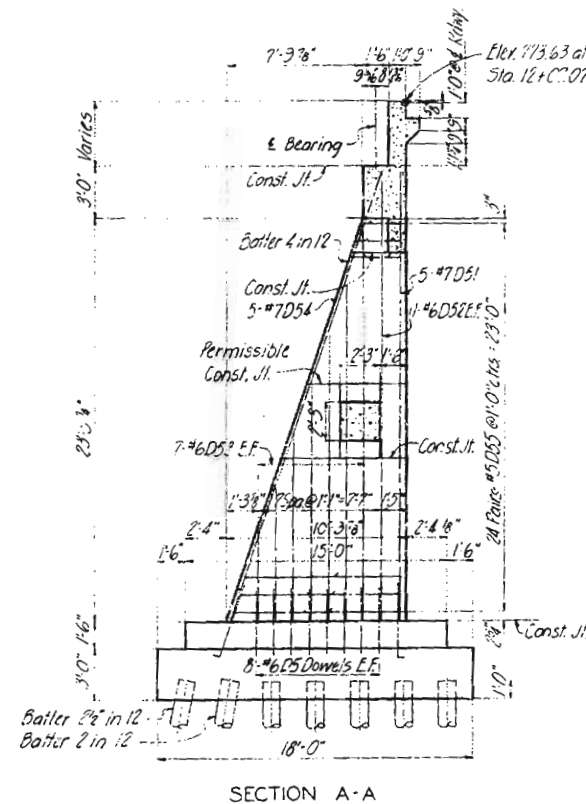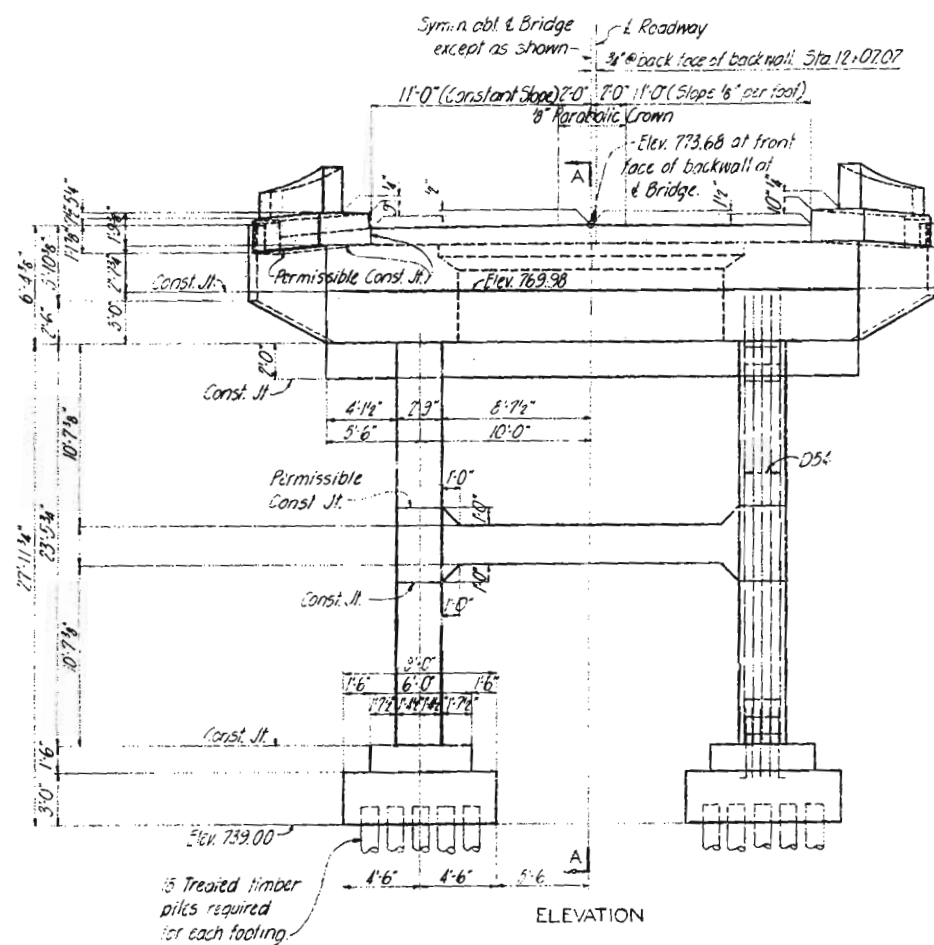



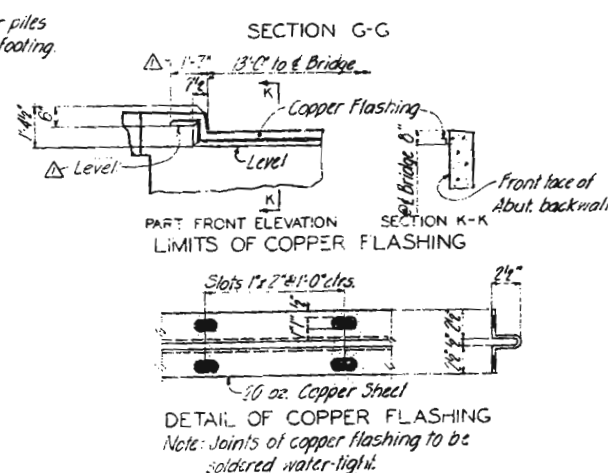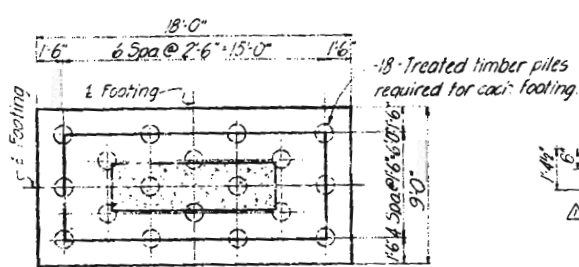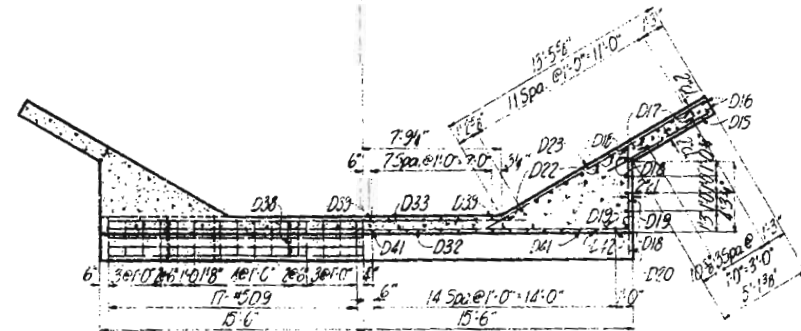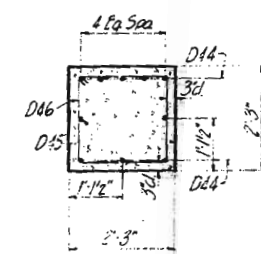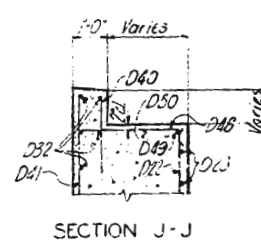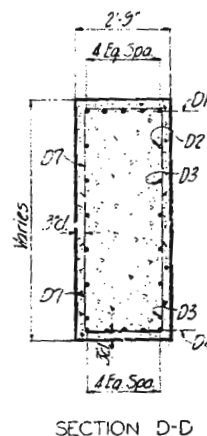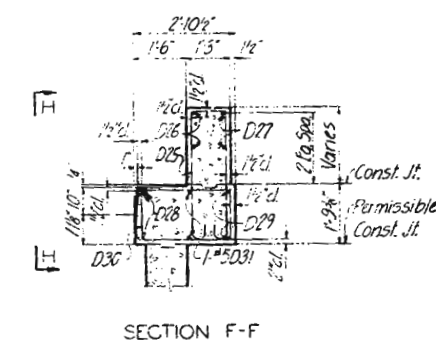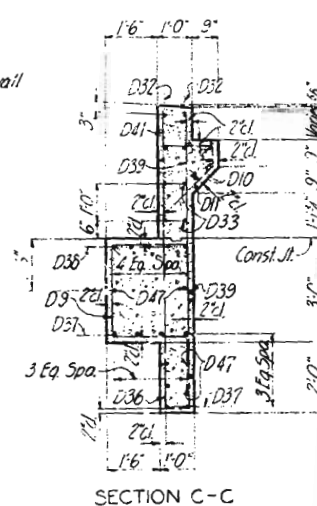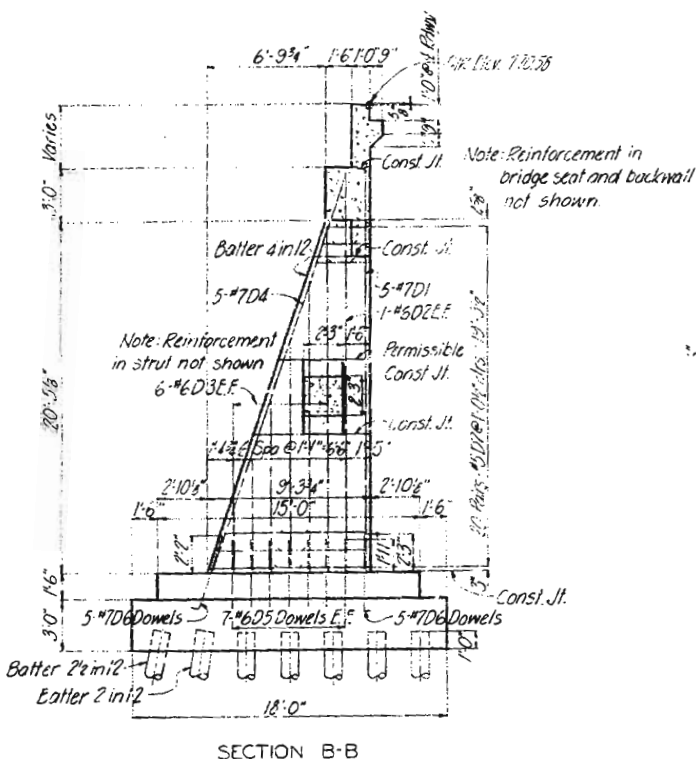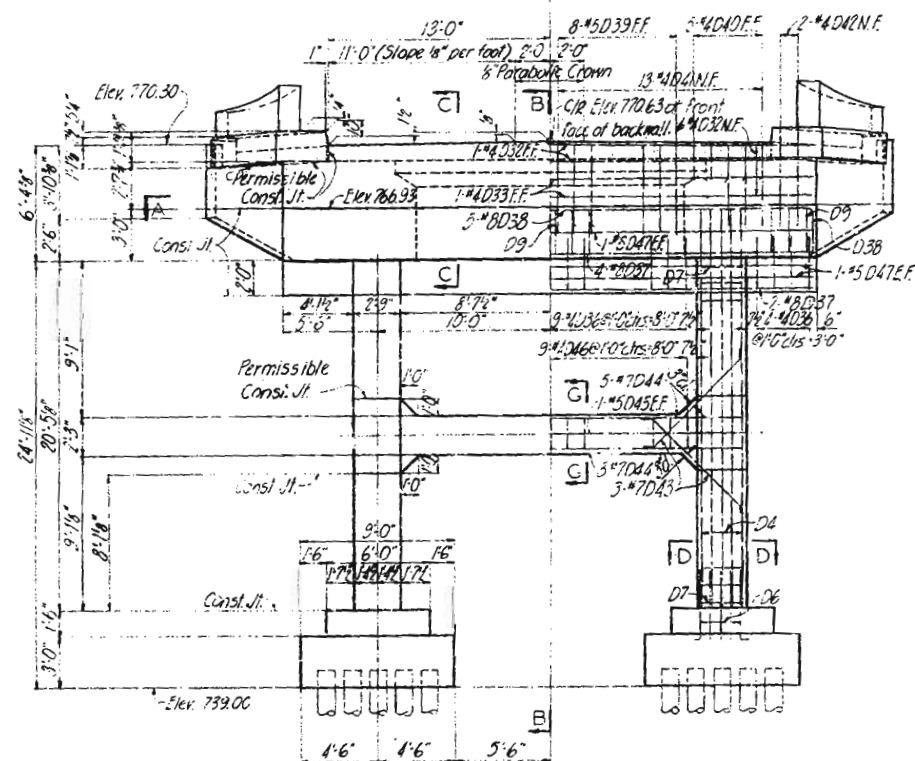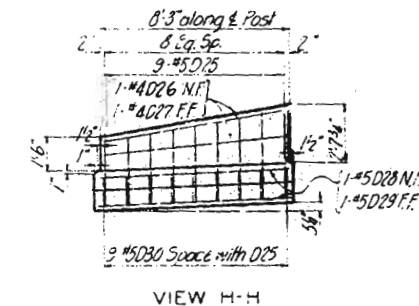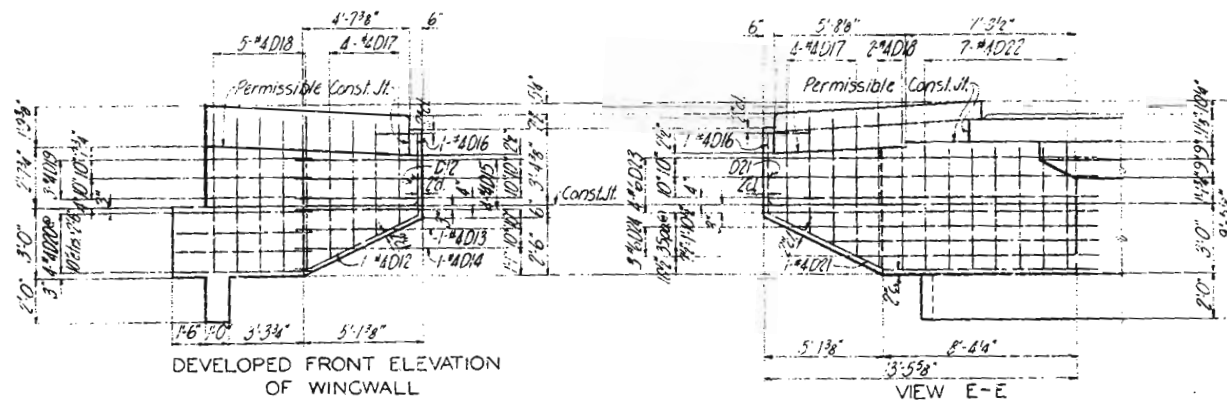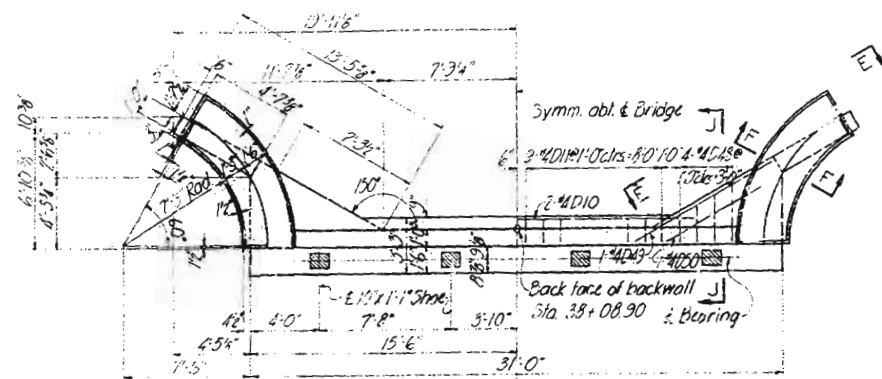

**NOTES**

N.F. indicates near face; F.F. indicates far face; and E.F. indicates each face.

For General Notes, see Sheet 2.

For location of anchor bolt wells, see Sheet 10.

For Bar List, see Sheets 11 and 15.

Revision Δ Copper Flashing 6-11-56 By G.L.D. C.F.K. E.L.

**NEW FAIRFAX BRIDGE  
OVER MISSOURI RIVER  
NEAR KANSAS CITY, KANSAS**

FOR  
**PLATTE COUNTY, MISSOURI**

ABUTMENT 16

SVERDRUP AND PARCEL, INC.  
CONSULTING ENGINEERS  
ST. LOUIS, MO.

SHEET 4 OF 13


**A-450**  
Platte Co.  
Pl. 69

AS BUILT DRAWING

FINAL DESIGN DRAWING

Note: Do not scale this drawing. Follow dimensions.

Drawn by: R.E. Skubitz, Jan. 1956  
Checked by: G.L. Dystin, Apr. 1956

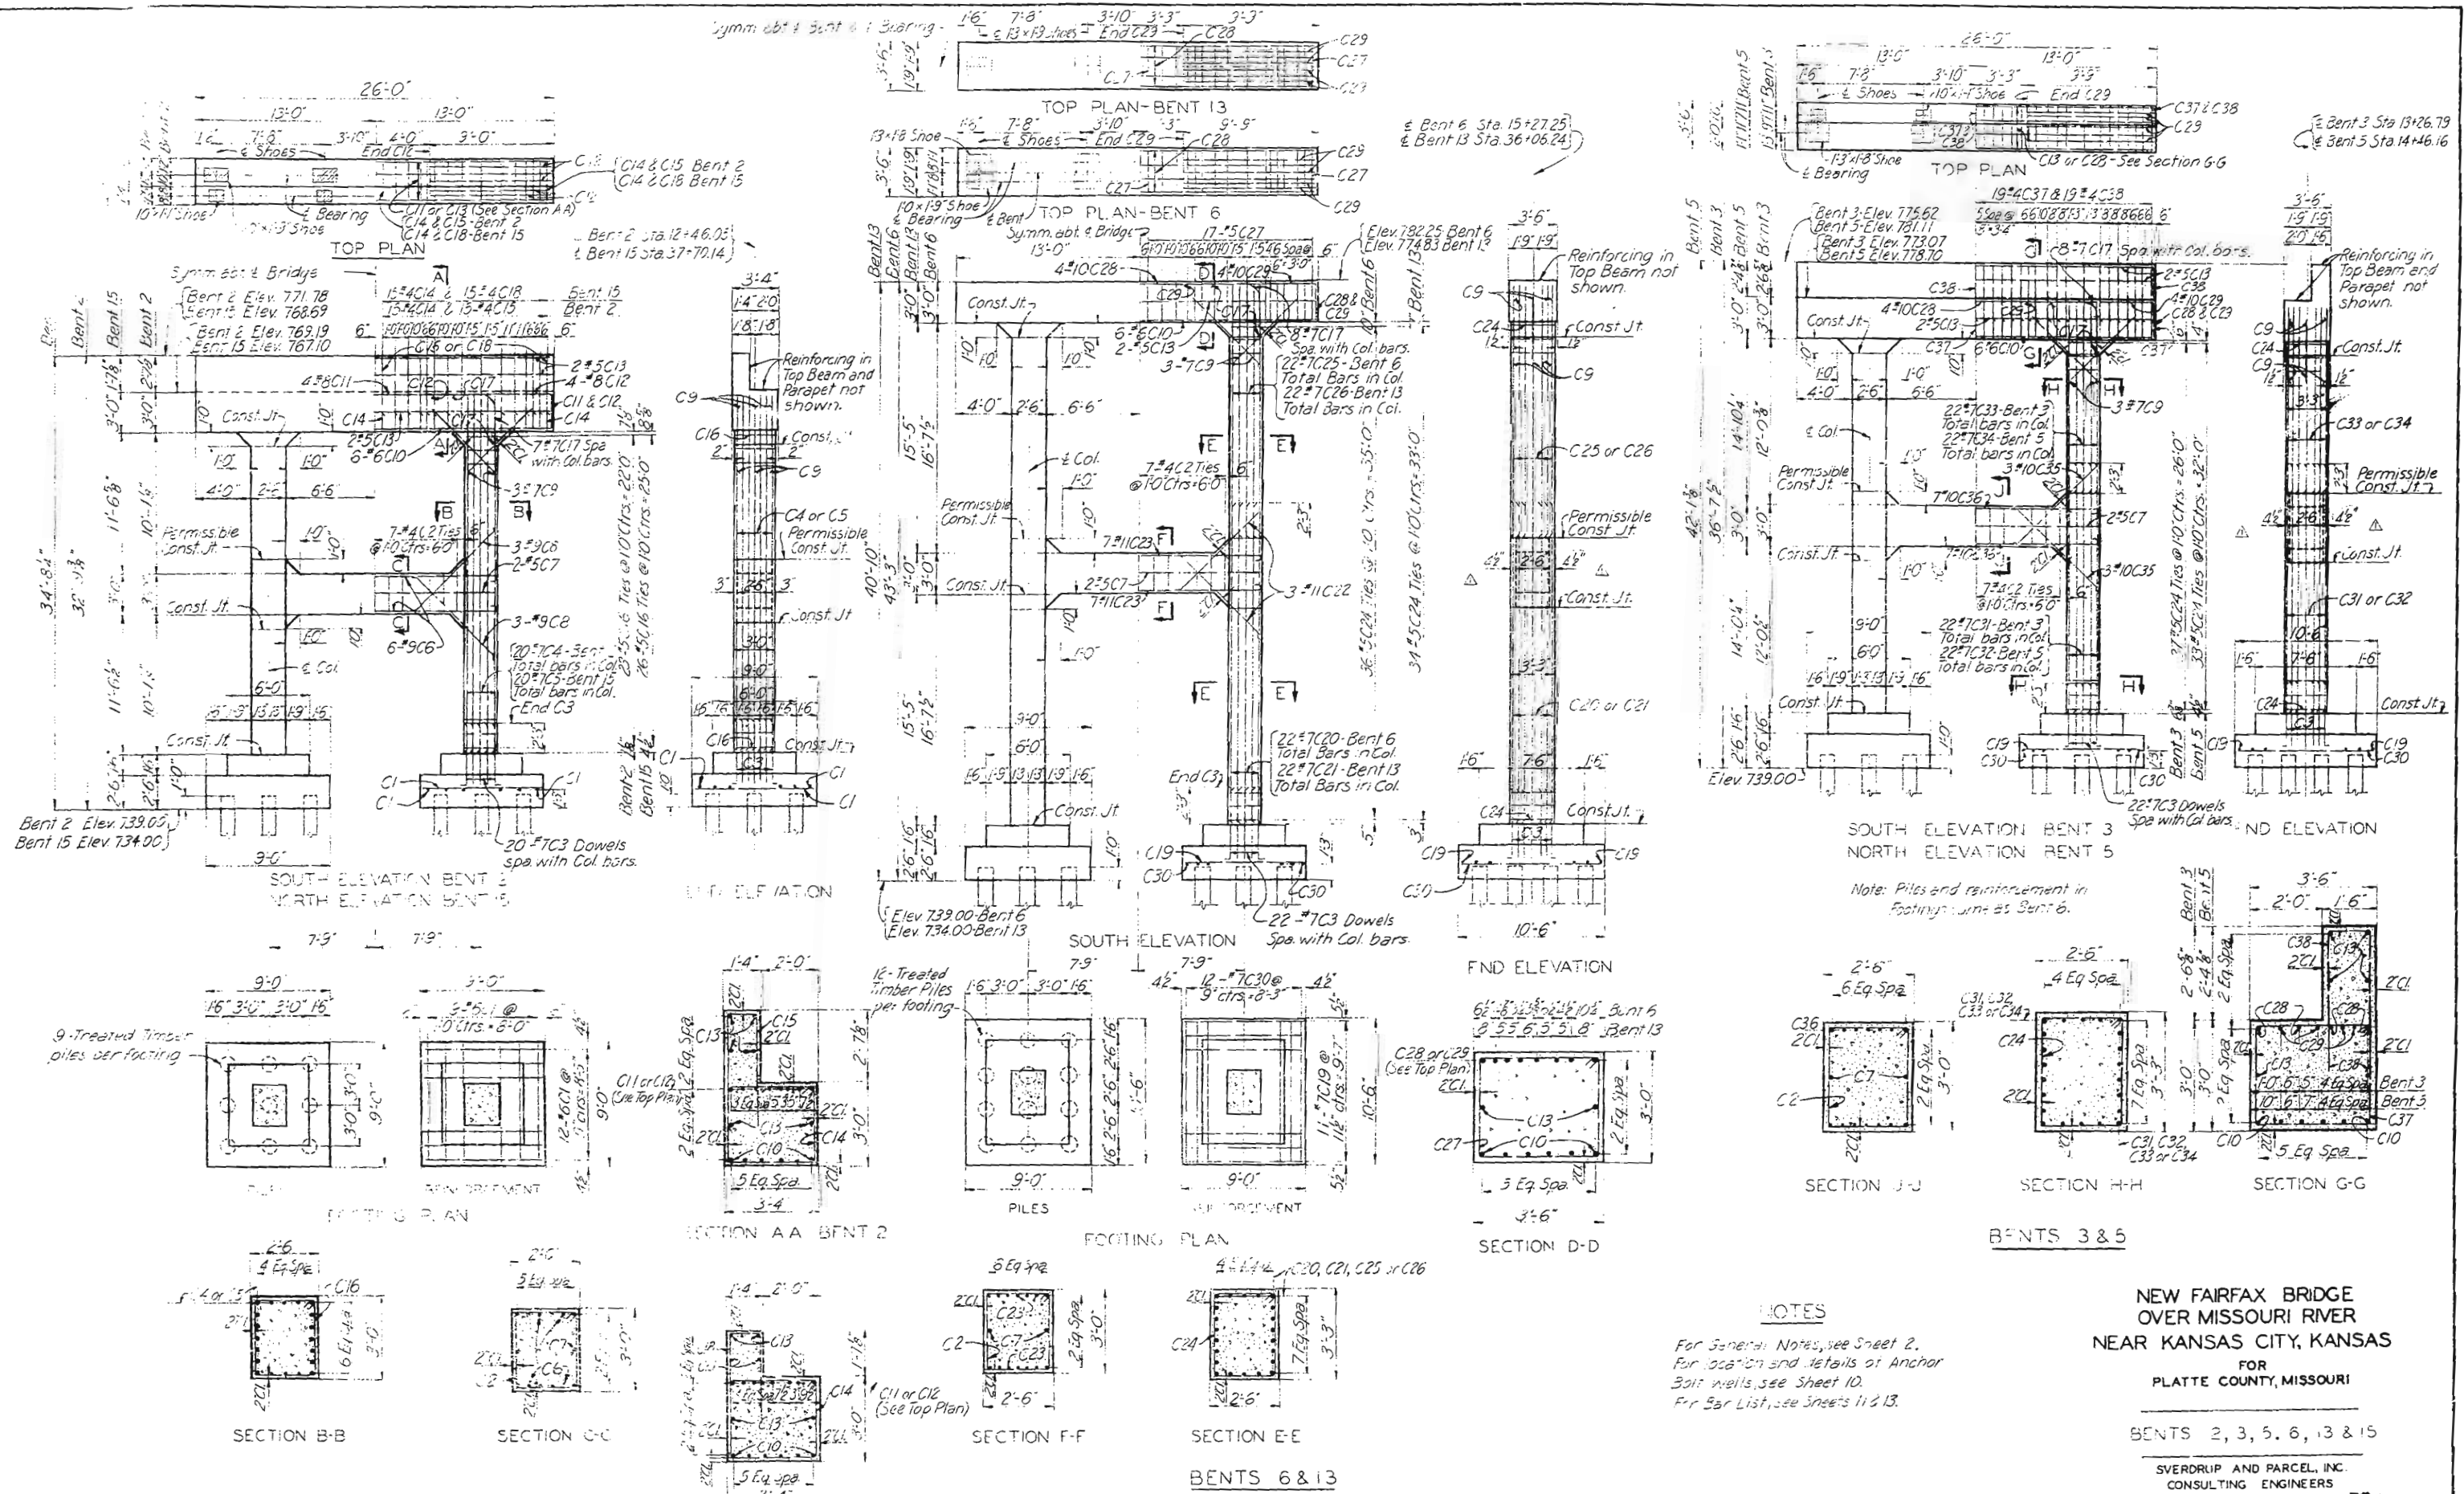

**NOTES**

For General Notes, see Sheet 2.  
 For location and details of Anchor Bolt wells, see Sheet 10.  
 For Bar List, see Sheets 11 & 13.

**NEW FAIRFAX BRIDGE  
 OVER MISSOURI RIVER  
 NEAR KANSAS CITY, KANSAS**

FOR  
**PLATTE COUNTY, MISSOURI**






**BENTS 2, 3, 5, 6, 13 & 15**

**SVERDRUP AND PARCEL, INC.  
 CONSULTING ENGINEERS  
 ST. LOUIS, MO**

Drawn by: W. Miller, April 1956  
 Checked by: J. Wilson, April 1956

Do not scale this drawing. Follow dimensions.

Revision 1, Bent Dimensions 5-1-56 By E.L. Chkd. G.L.D. SHEET 5 OF 13

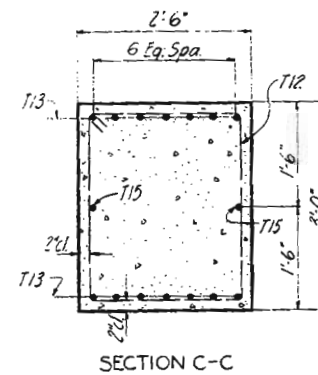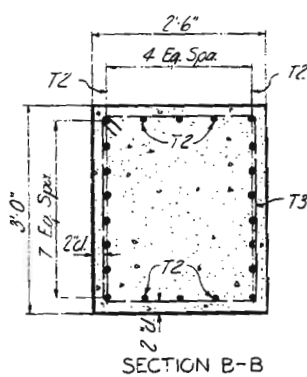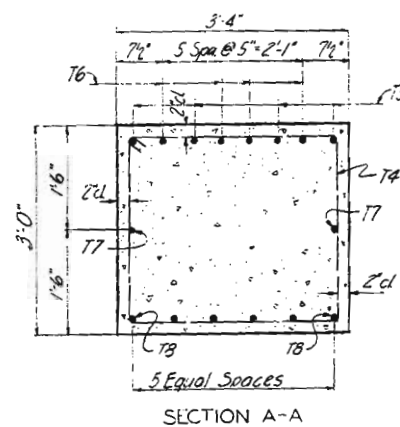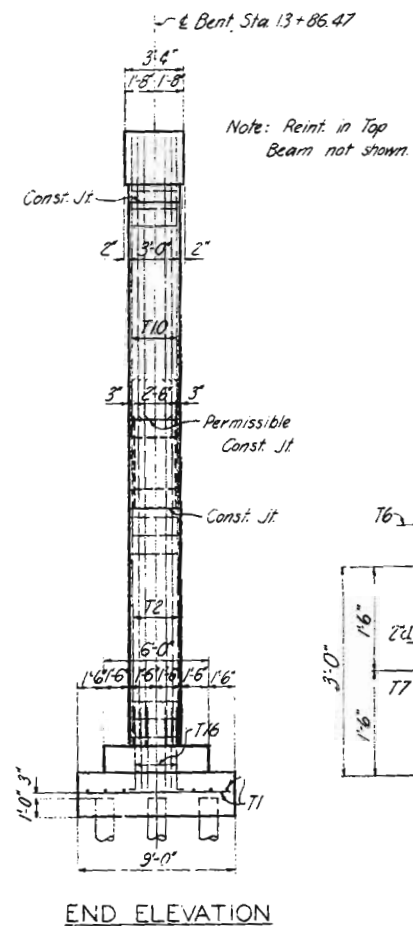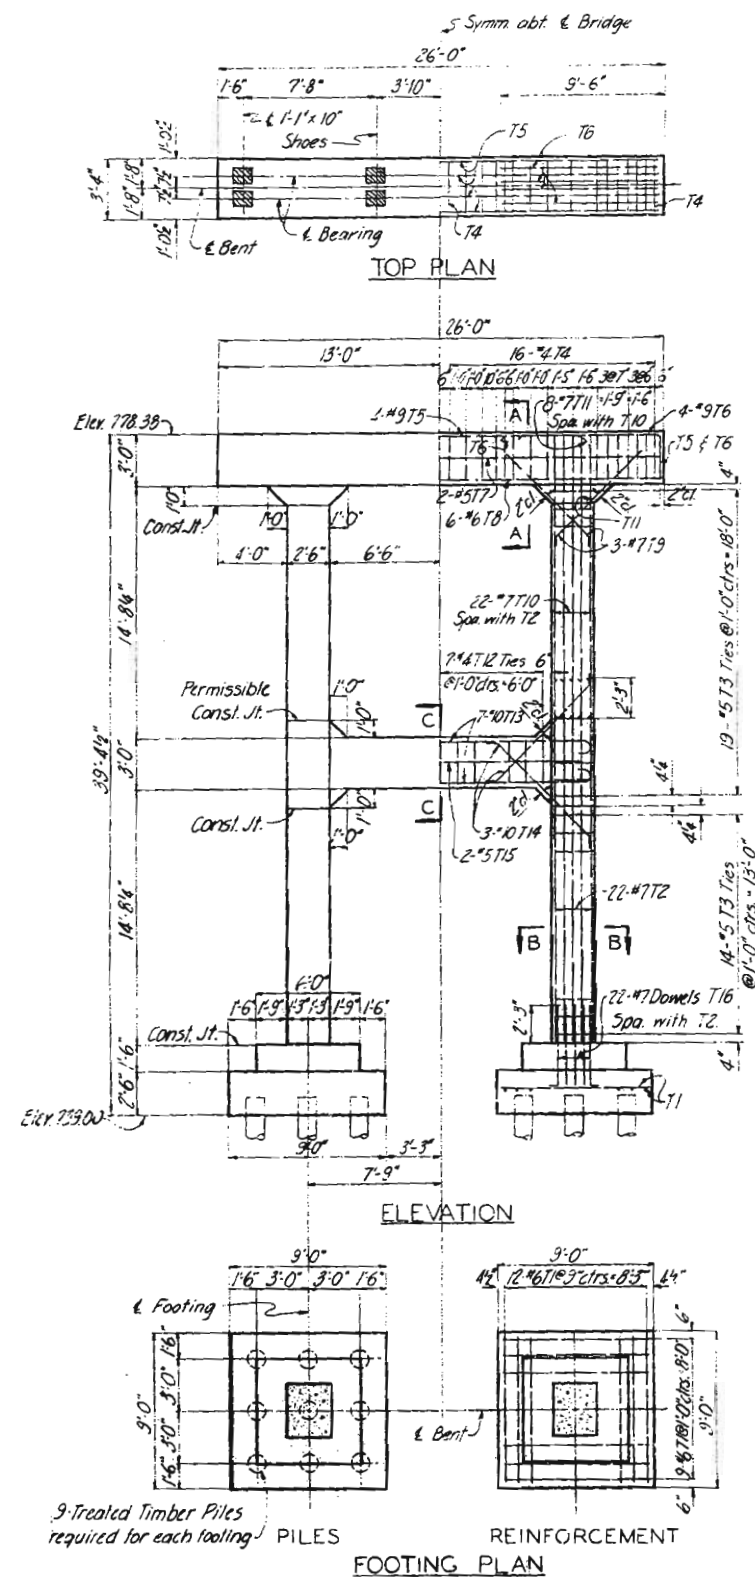

NOTES

For General Notes, see Sheet 2.  
For location of anchor bolt wells,  
see Sheet 10.  
For Bar List, see Sheets 11 and 13.

NEW FAIRFAX BRIDGE  
OVER MISSOURI RIVER  
NEAR KANSAS CITY, KANSAS  
FOR  
PLATTE COUNTY, MISSOURI

BENT 4

SVERDRUP AND PARCEL, INC.  
CONSULTING ENGINEERS  
ST. LOUIS, MO.

519 NE

SHEET 6 OF 13

A-45  
Platte  
Rf. 69







AS BUILT DRAWING

FINAL DESIGN DRAWING

Note: Do not scale this drawing. Follow dimensions.

1159	Drawn by: R.E. Skubiz, Apr. 1956
56573	Checked by: G.L. Dyslin, Apr. 1956



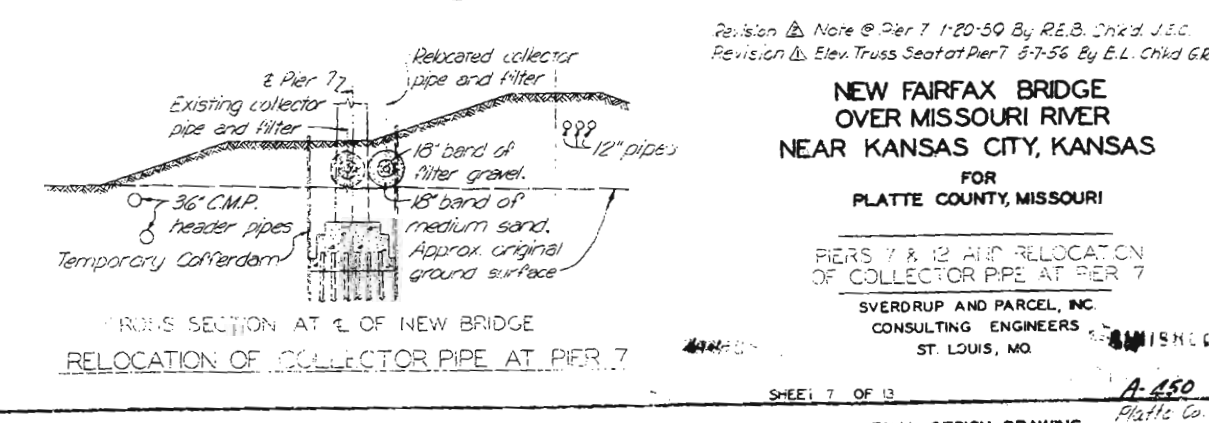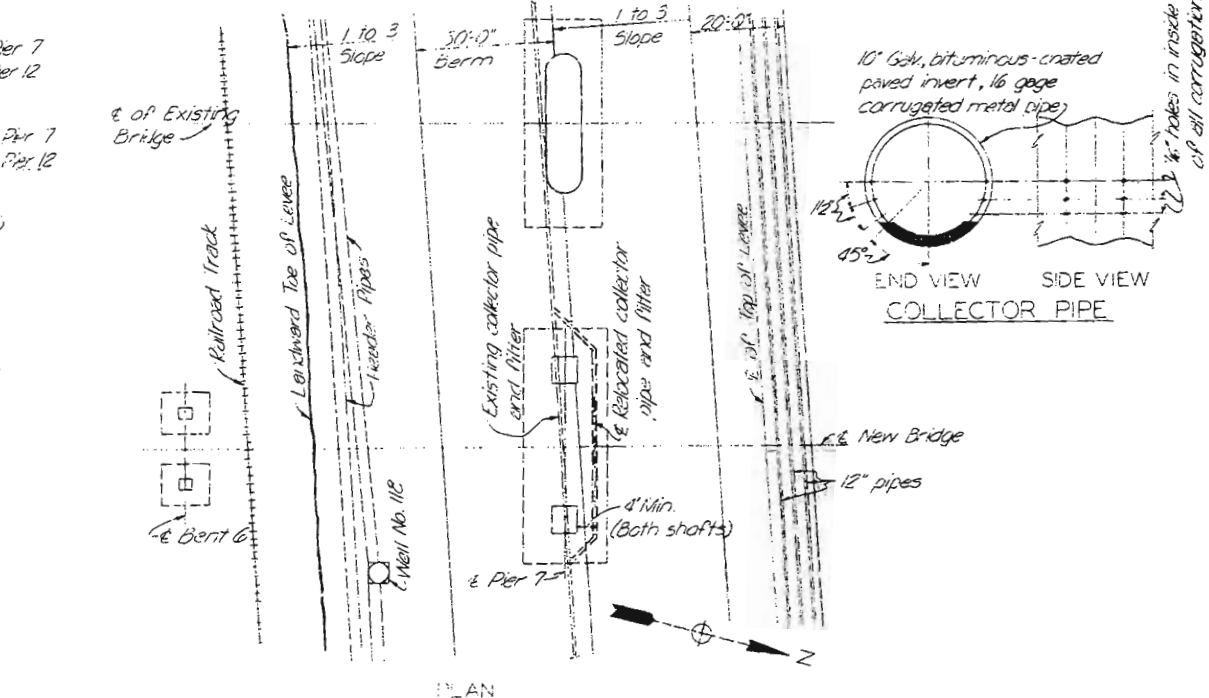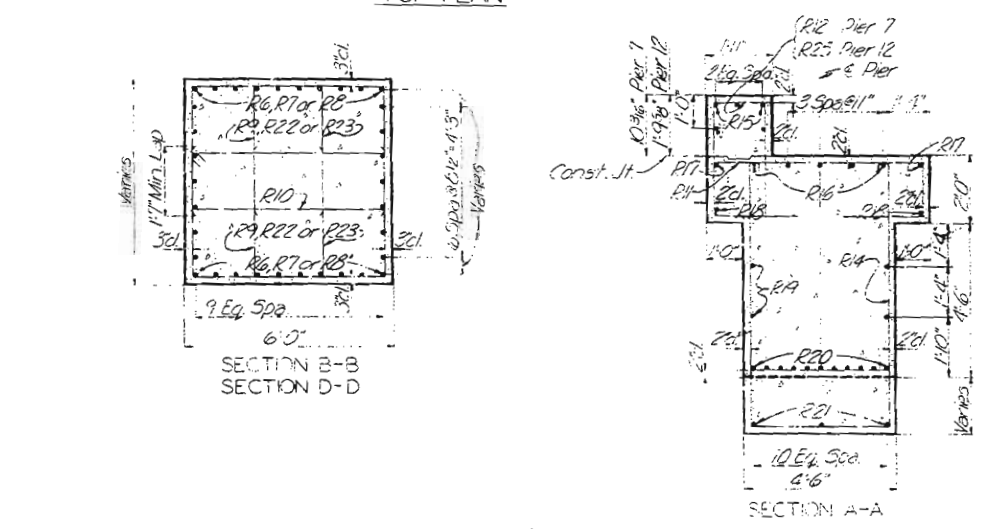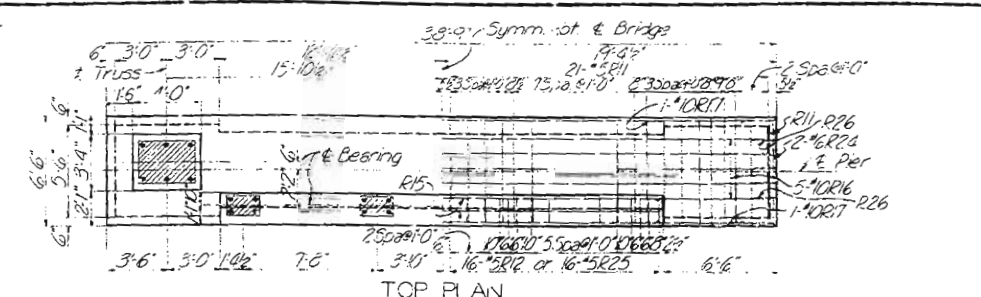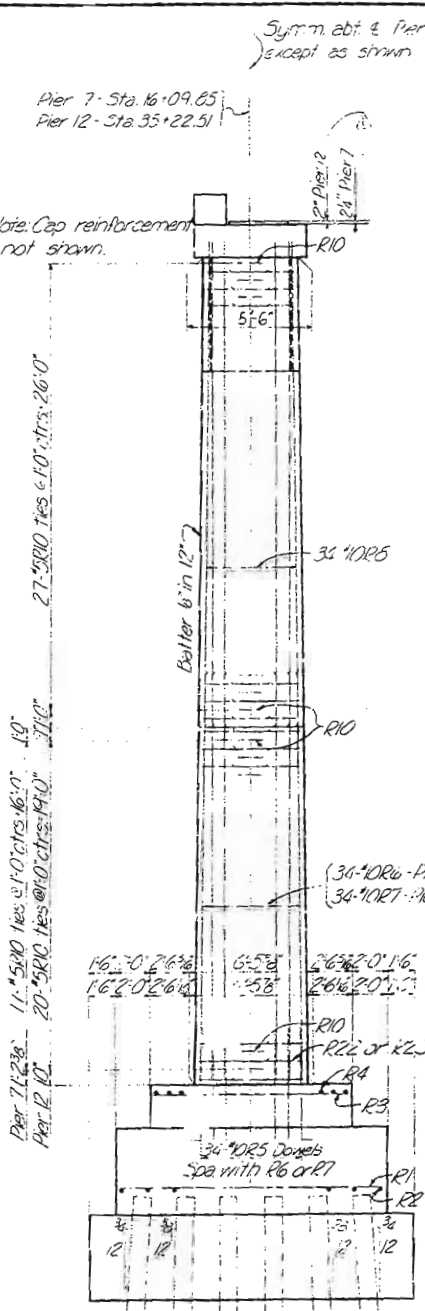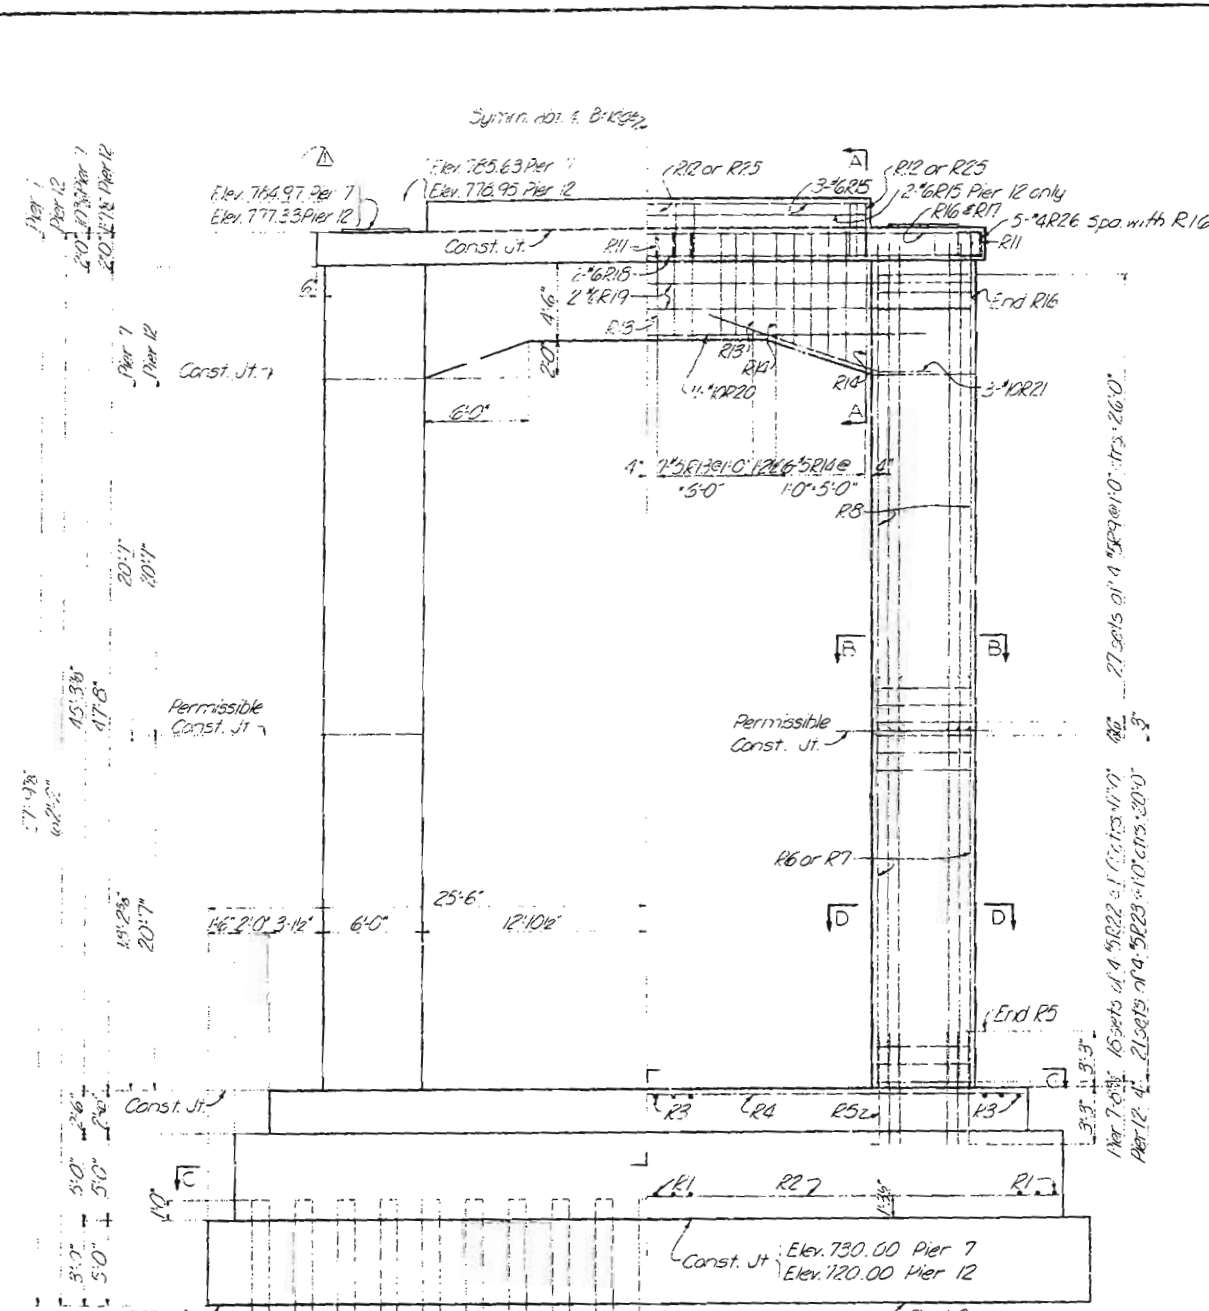

NOTES  
For General Notes, see Sheet 2.  
For location and size of anchor bolt wells, see Sheet 10.  
For Bar List, see Sheets 11 and 13.

Revision A Note @ Pier 7 1-20-59 By R.E.B. Chkd. J.S.C.  
Revision B Elev. Truss Seat at Pier 7 5-7-56 By E.L. Chkd. G.R.P.

**NEW FAIRFAX BRIDGE  
OVER MISSOURI RIVER  
NEAR KANSAS CITY, KANSAS**

FOR  
PLATTE COUNTY, MISSOURI

PIERS 7 & 12 AND RELOCATION  
OF COLLECTOR PIPE AT PIER 7

SVERDRUP AND PARCEL, INC.  
CONSULTING ENGINEERS  
ST. LOUIS, MO


SHEET 7 OF 13

A-450  
Platte Co.  
9-69


Drawn by: H.T. Sanders, Mar. 1956  
Checked by: D. Kotakis, Apr. 1956

Note: Do not scale this drawing. Follow dimensions.


AS BUILT DRAWING  
FINAL DESIGN DRAWING

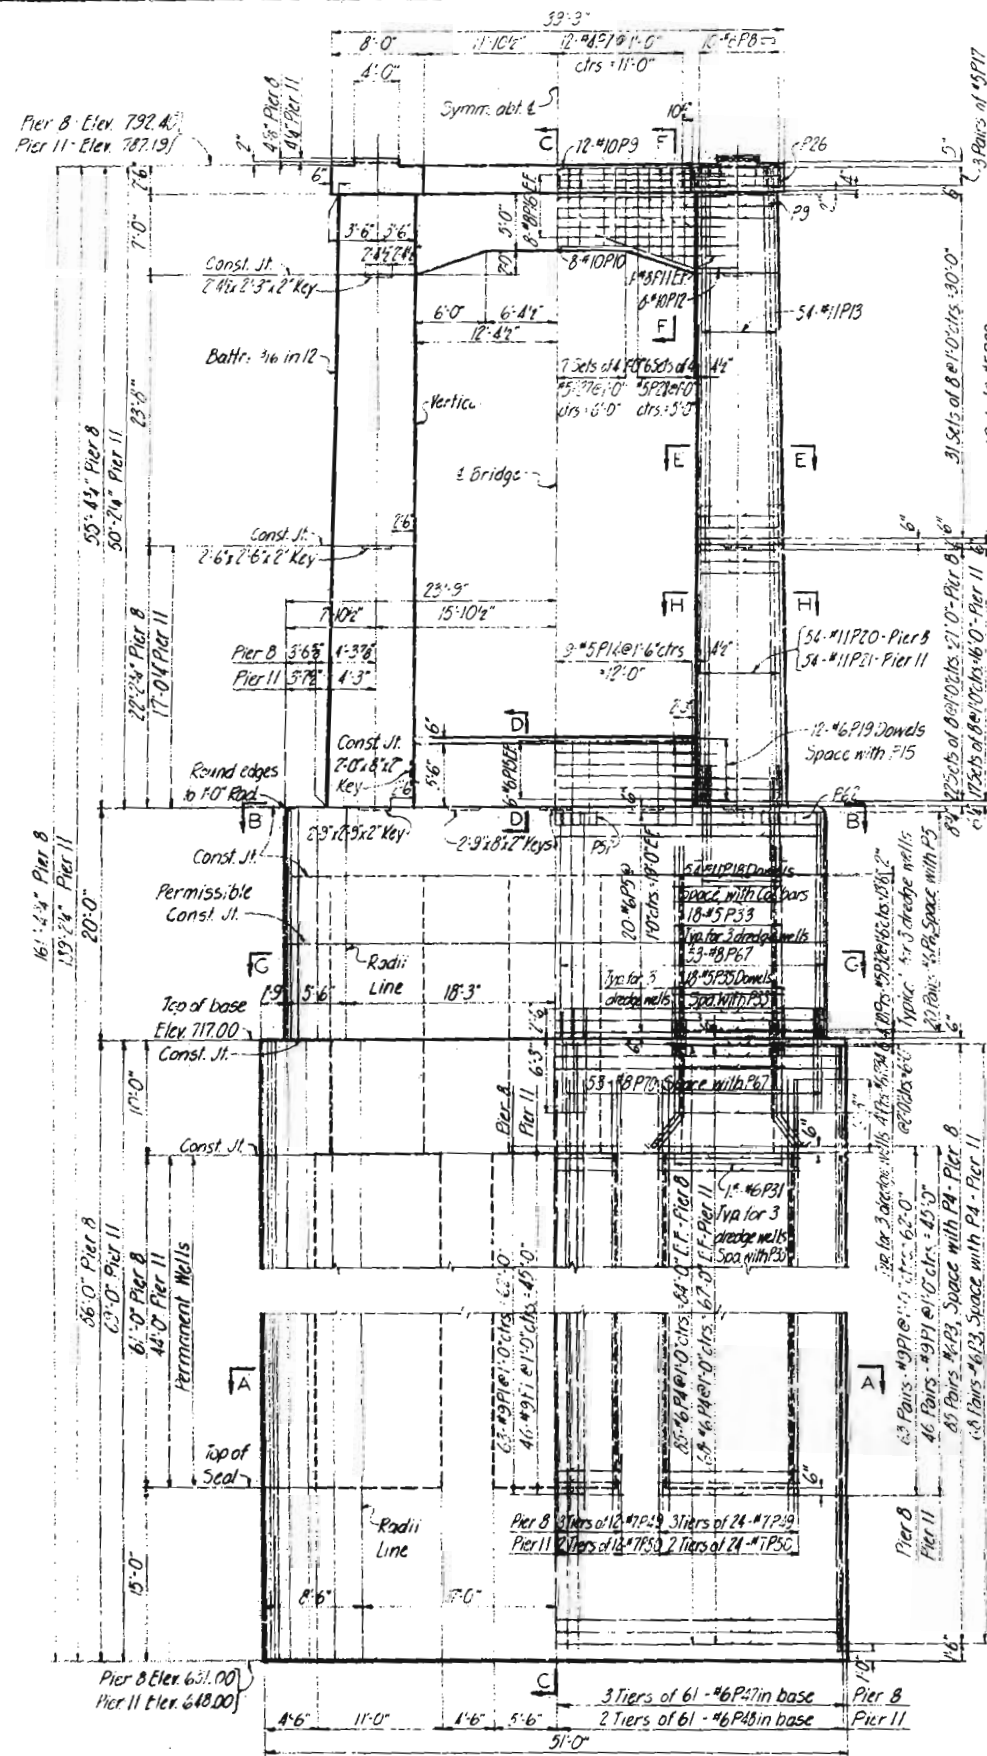


SOUTH ELEVATION - PIER 8  
NORTH ELEVATION - PIER 11

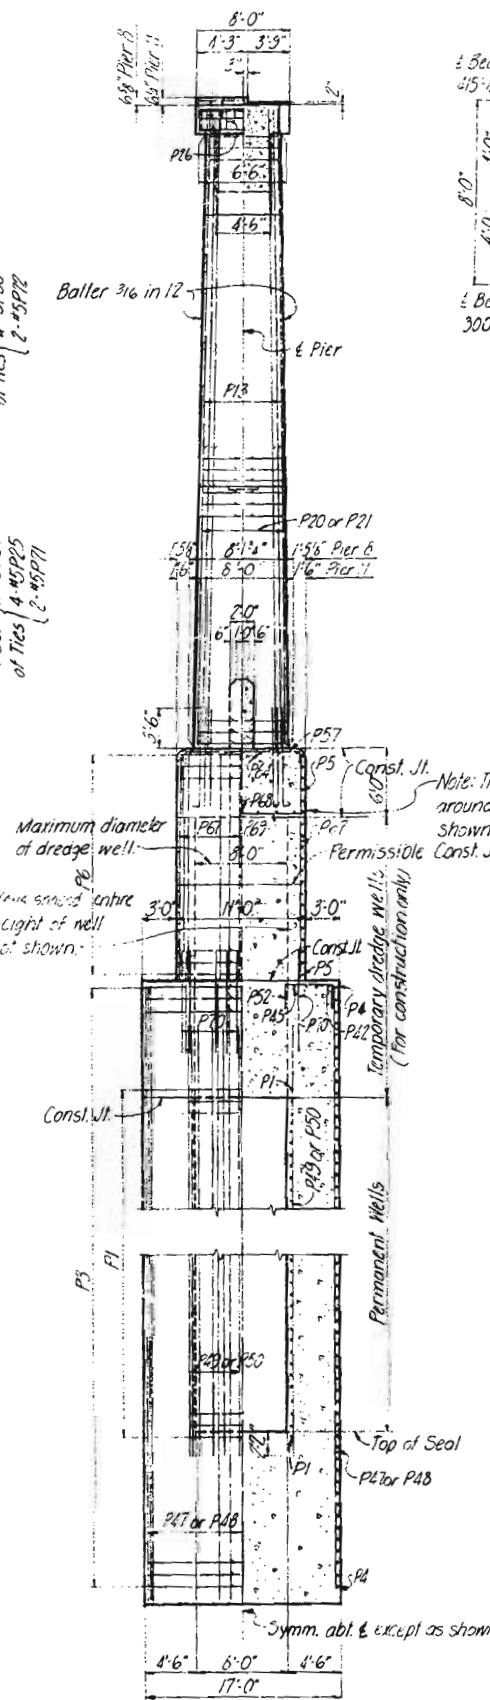


HALF  
END ELEVATION  
HALF  
SECTION C-C

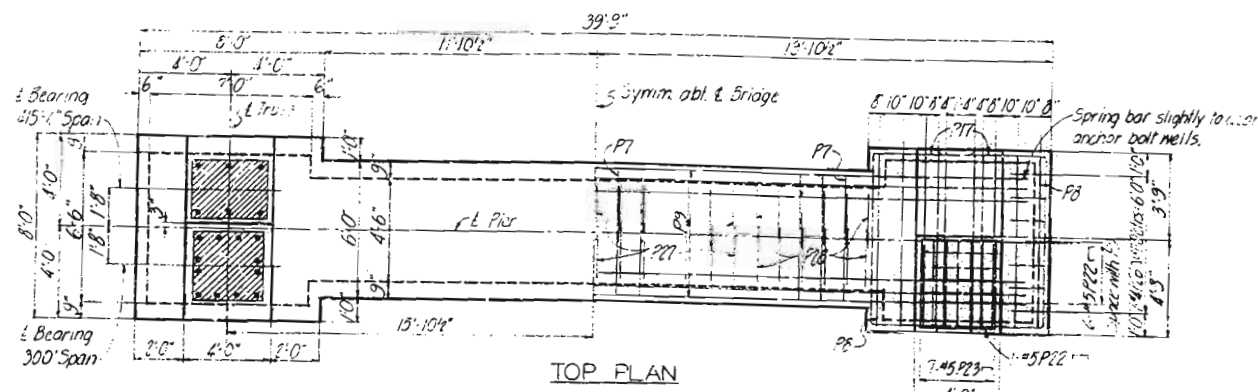


TOP PLAN

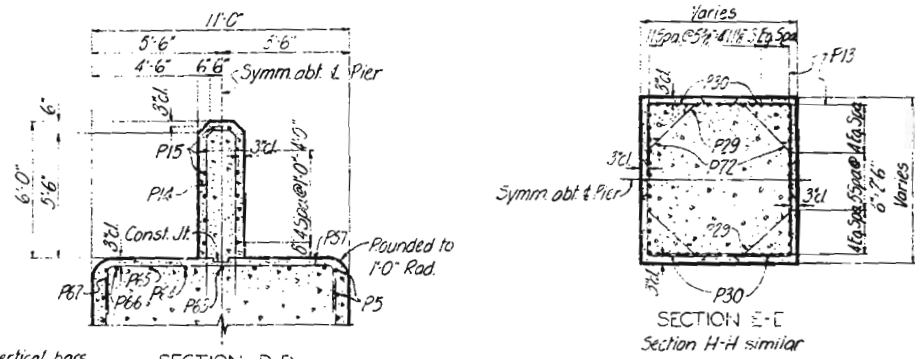

SECTION D-D  
SECTION E-E

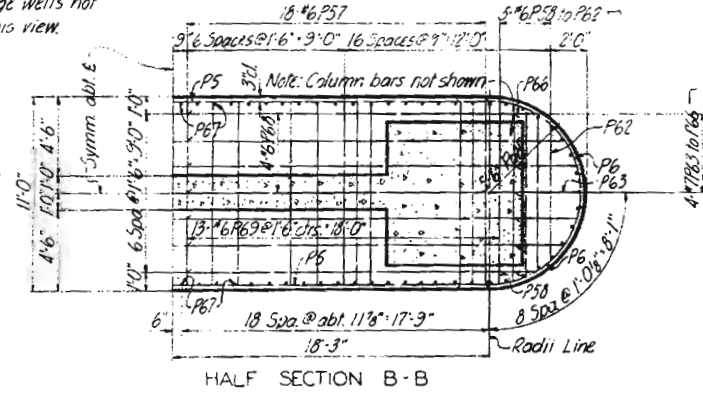

HALF SECTION B-B

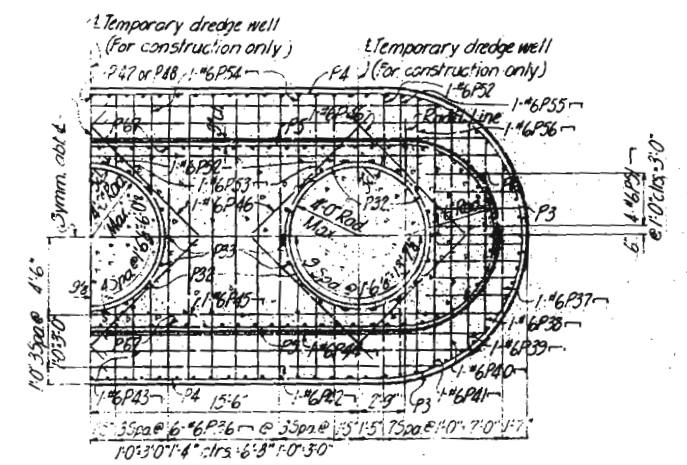

HALF SECTION G-G

**NOTES**  
For General Notes see Sheet 2  
For location and size of Anchor Bolt Wells see Sheet 10.  
For Bar List see Sheets 11 and 12.  
As built for Piers 8, 9, 10 and 11 are in Central Files on 8 1/2 x 11" Sheets.

**NEW FAIRFAX BRIDGE  
OVER MISSOURI RIVER  
NEAR KANSAS CITY, KANSAS**

FOR  
PLATTE COUNTY, MISSOURI

PIERS 8 & 11

SVERDRUP AND PARCEL, INC.  
CONSULTING ENGINEERS  
ST. LOUIS, MO.

Drawn by: R.E. Skubitz, Jan. 1956  
Checked by: W. K. Kiefer, March 1956

Note: Do not scale this drawing. Follow dimensions.

Revision A General Notes 1-20-59 By R.E. Skubitz, J.E.C.



SHEET 3 OF 13

AS BUILT DRAWING


FINAL DESIGN DRAWING

A-450  
Platte Co.  
R-69

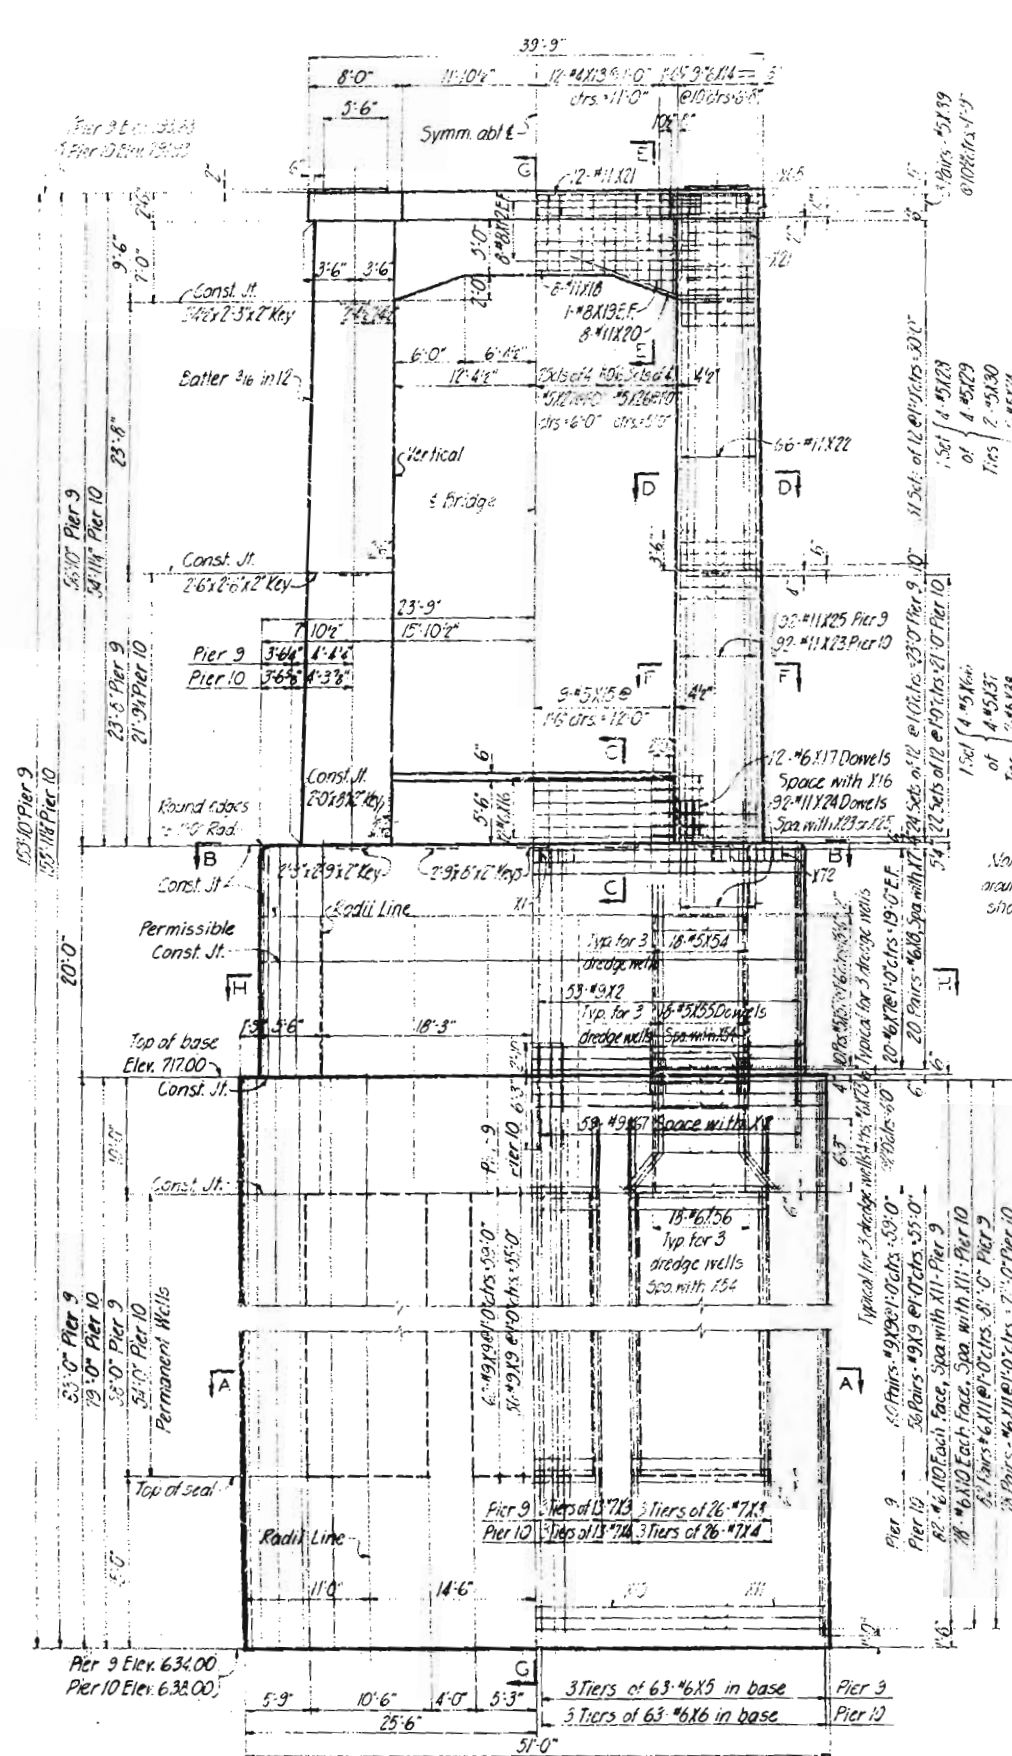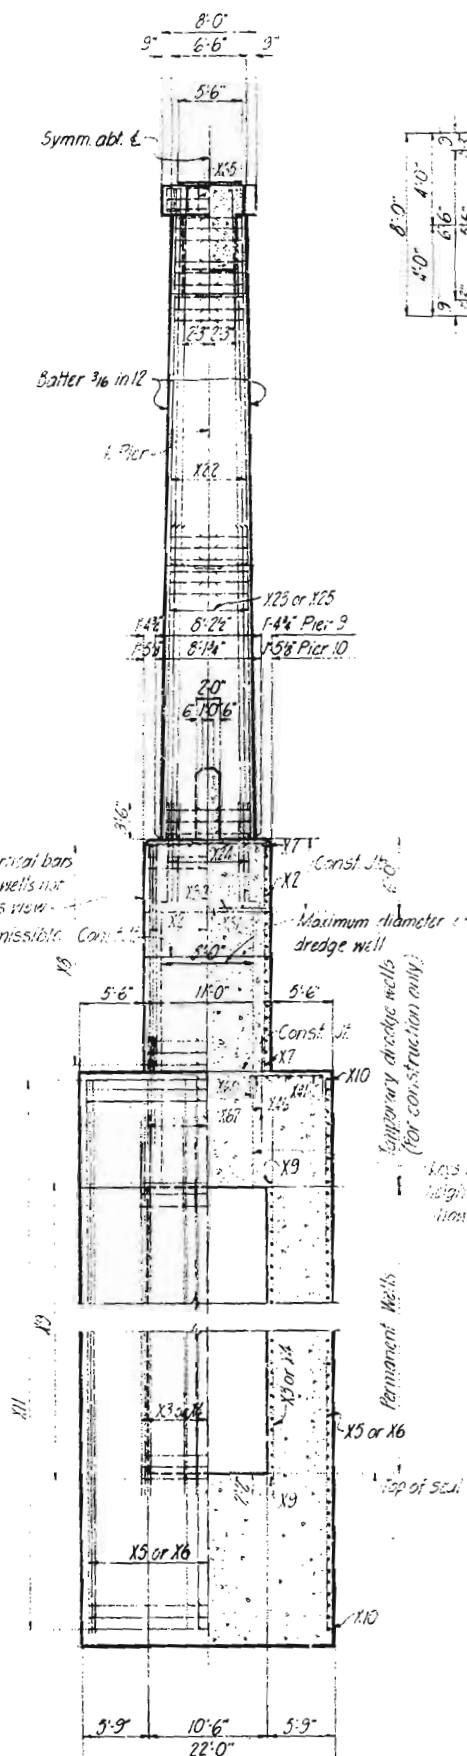

ELEVATION

HALF                      HALF  
END ELEVATION      SECTION C-C

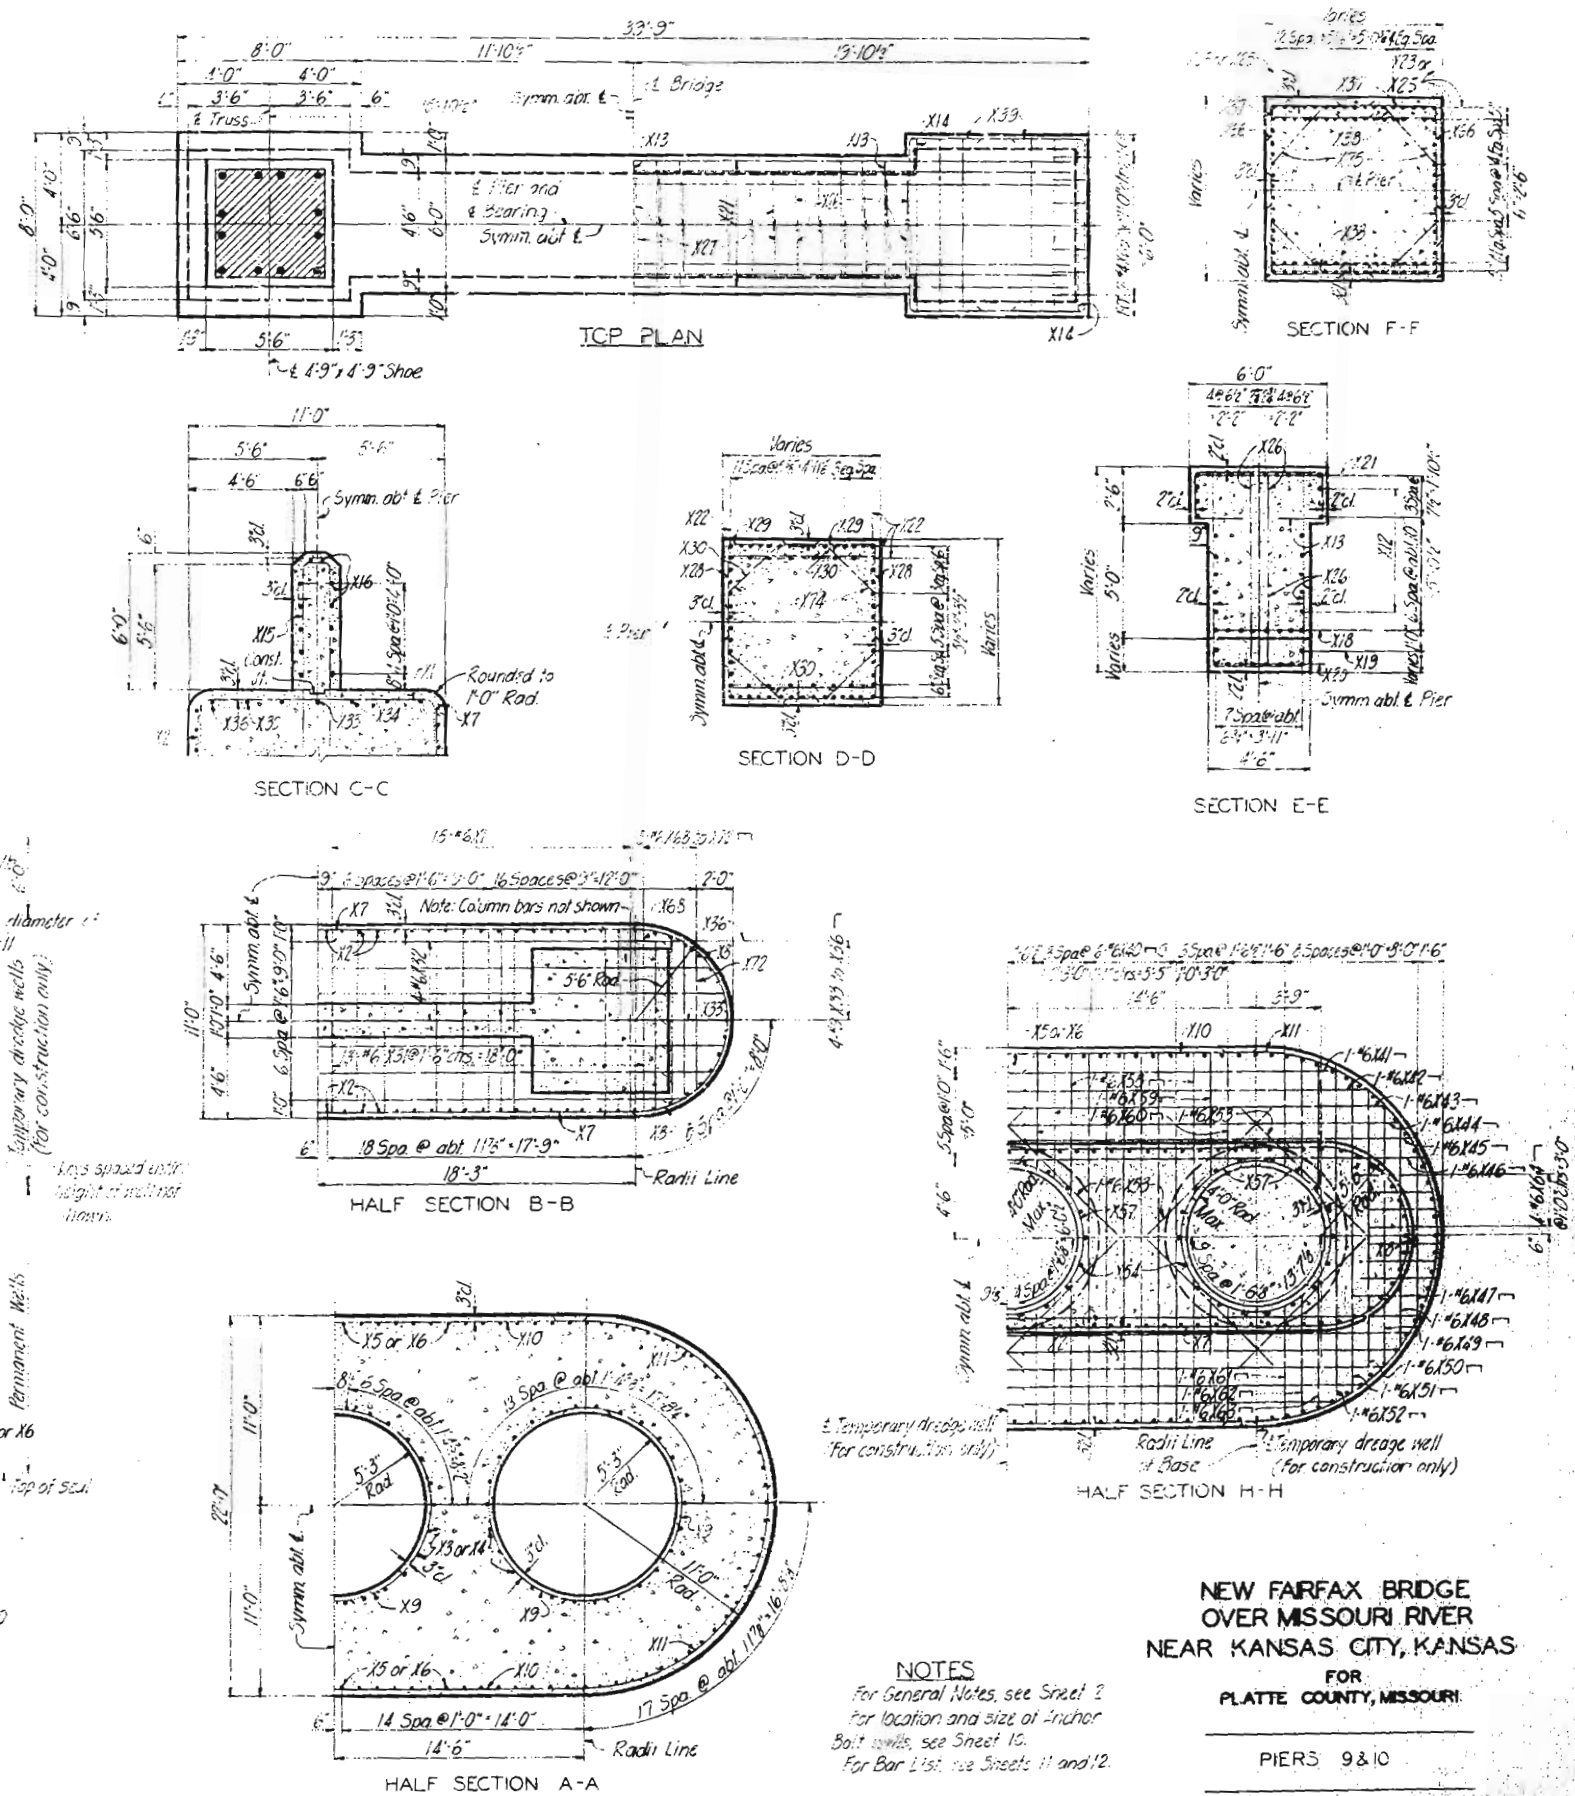

TCP PLAN

SECTION F-F

SECTION C-C

SECTION D-D

SECTION E-E

HALF SECTION B-E

HALF SECTION A-A

HALF SECTION H-H

**NOTES**  
For General Notes, see Sheet 2  
For location and size of Anchor  
Bolt walls, see Sheet 15.  
For Bar List, see Sheets 11 and 12.

NEW FARFAX BRIDGE  
OVER MISSOURI RIVER  
NEAR KANSAS CITY, KANSAS  
FOR  
PLATTE COUNTY, MISSOURI

PIERS 9 &amp; 10

SVERDRUP AND PARCEL, INC.  
CONSULTING ENGINEERS  
ST. LOUIS, MO.


SHEET 9 OF 13

A-450



AS BUILT DRAWING

FINAL DESIGN DRAWING


Note: Do not scale this drawing. Follow dimensions

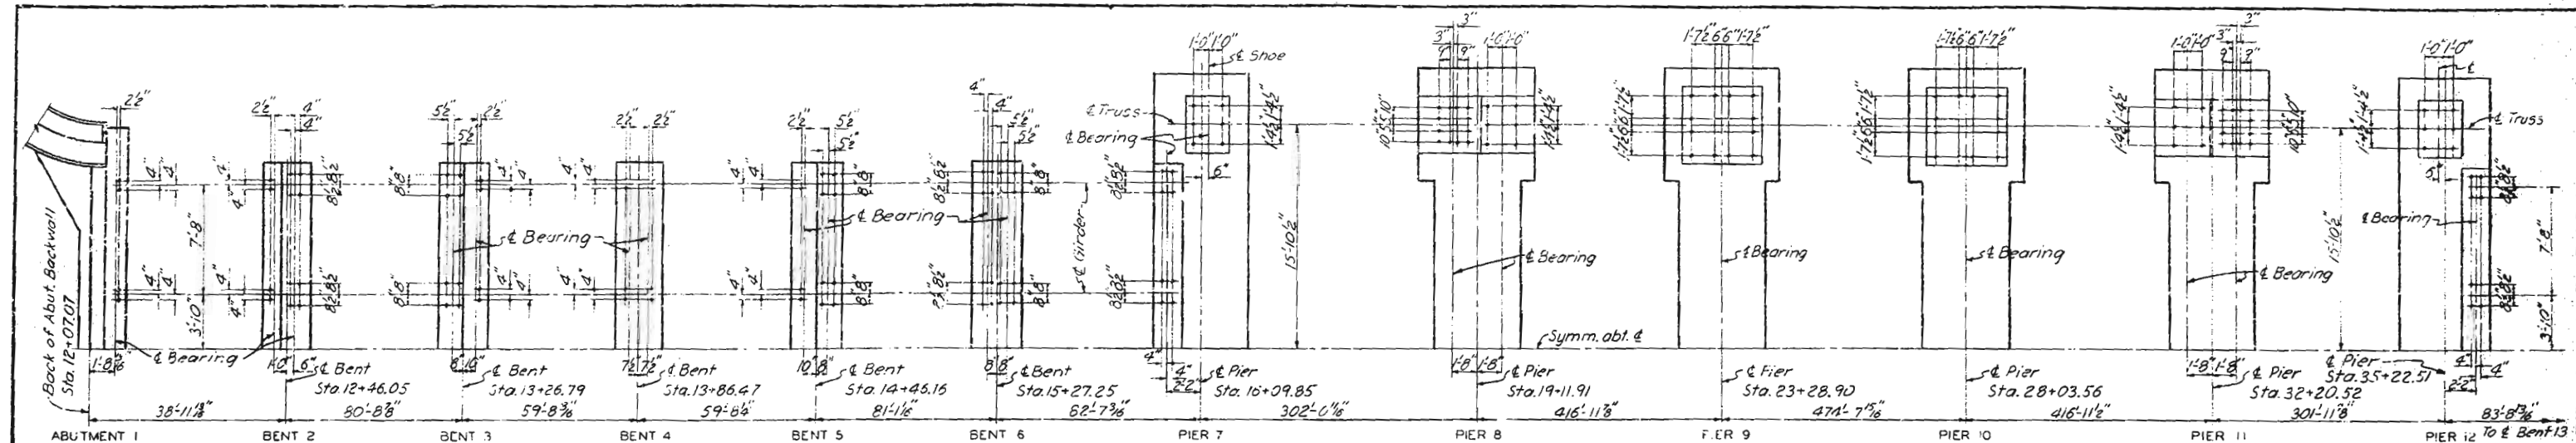

HALF ANCHOR BOLT PLAN

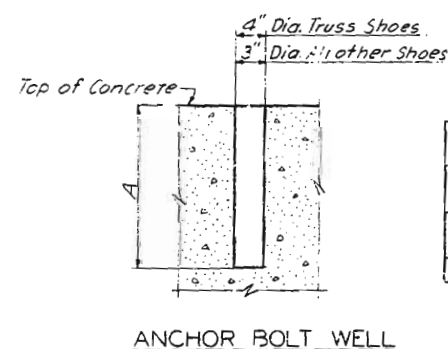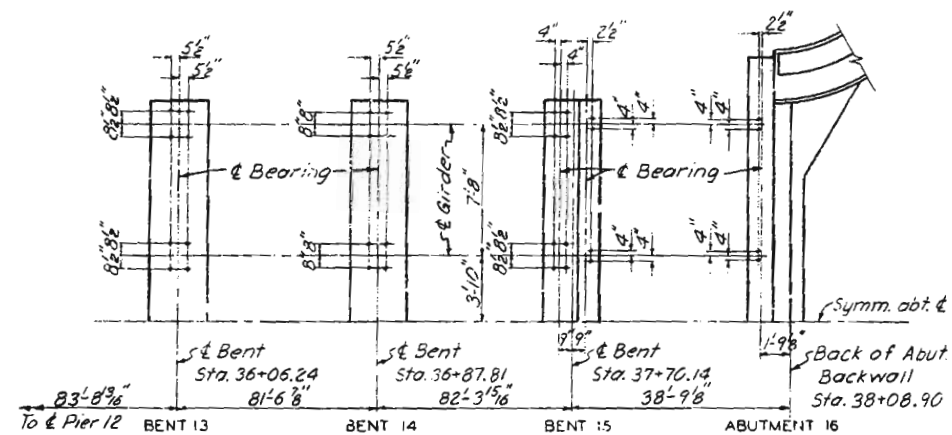

Location	Dim.
Piers 8 & 11 (Fixed Shoes)	2' 8"
Piers 7 & 12 (Truss Shoes)	2' 8"
Piers 8 & 11 (Expansion Shoes)	2' 7"
Piers 9 & 10	1' 6"
All Others	1' 6"

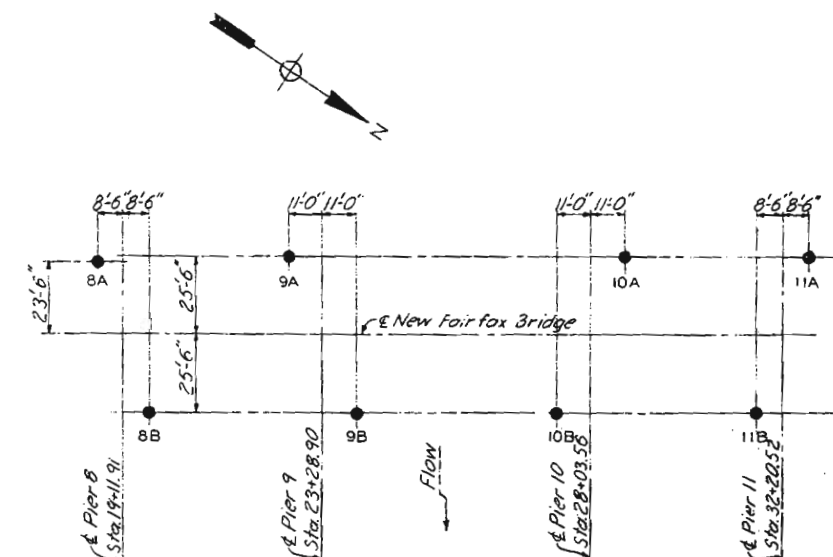

PLAN OF BORINGS

LOG OF BORINGS

ELEV.	HOLE 8A Sta. 19+03.41 23.5' Lt. of & Bridge	HOLE 8B Sta. 19+20.41 25.5' Rt. of & Bridge	HOLE 9A Sta. 23+17.90 25.5' Lt. of & Bridge	HOLE 9B Sta. 23+39.90 25.5' Rt. of & Bridge	HOLE 10B Sta. 27+92.56 25.5' Rt. of & Bridge	HOLE 10A Sta. 28+14.56 25.5' Lt. of & Bridge	HOLE 11B Sta. 32+12.02 25.5' Rt. of & Bridge	HOLE 11A Sta. 32+29.02 25.5' Lt. of & Bridge	ELEV.
740							739.8	744.9	740
730	734.7			730.7			731.8		730
720	725.0	726.5	727.7	723.7	724.7	724.5	730.3		720
710		725.5	724.7						710
700	704.7			703.7	714.1		719.6	719.9	700
690	692.7	691.5	687.7	695.7	694.7	694.3		699.9	690
680		684.5	687.7	680.7	688.7			689.9	680
670	678.7	676.5	672.7	672.7	679.7	674.3	674.8	675.9	670
660			662.7	665.7	659.1	666.3		663.9	660
650	656.7			655.7	654.1	650.3	651.3	651.9	650
640			638.4	642.2	646.1	644.3	648.3	640.2	640
630	631.5	638.1	634.9	635.2	640.4	631.6	638.3		630
620	621.5	628.1	628.4		634.0				620

NOTES

Anchor Bolts for Spans 1 and 15 may be cast in place. All others are to be grouted in wells.

Anchor bolt wells shall be formed in substructure units by placing and setting with a template.

Wells shall be completely filled with grout containing Iron Oxide Cement (Embec) or an approved equivalent, after steel has been erected and adjusted.

NEW FAIRFAX BRIDGE  
OVER MISSOURI RIVER  
NEAR KANSAS CITY, KANSAS  
FOR  
PLATTE COUNTY, MISSOURI

ANCHOR BOLT PLAN  
AND LOG OF BORINGS

SVERDRUP AND PARCEL, INC.  
CONSULTING ENGINEERS

ST. LOUIS, MO.

SHEET 10 OF 13



AS BUILT DRAWING

FINAL DESIGN DRAWING

A-450  
Platte Co.  
AT 69



Drawn by: W.J. Ballard, Apr. 1956  
Checked by: D. Korakis, Apr. 1956

# TYPICAL BAR TYPES

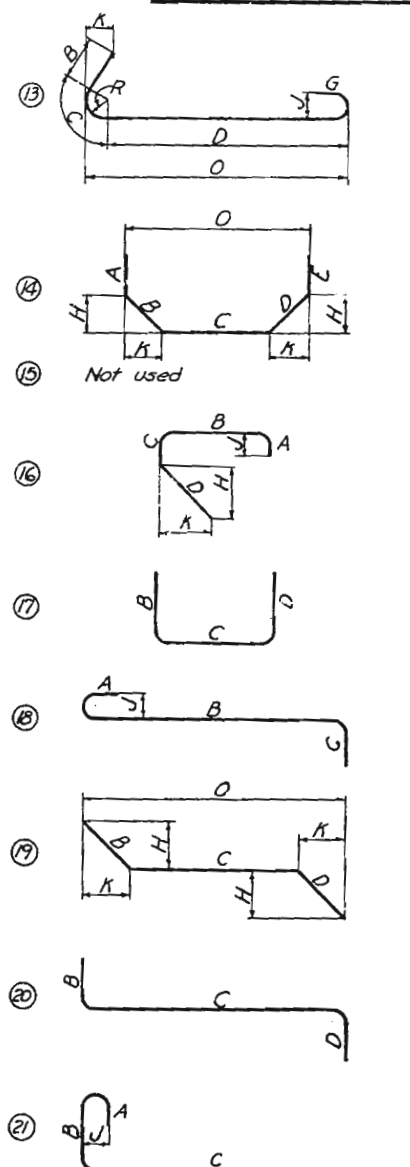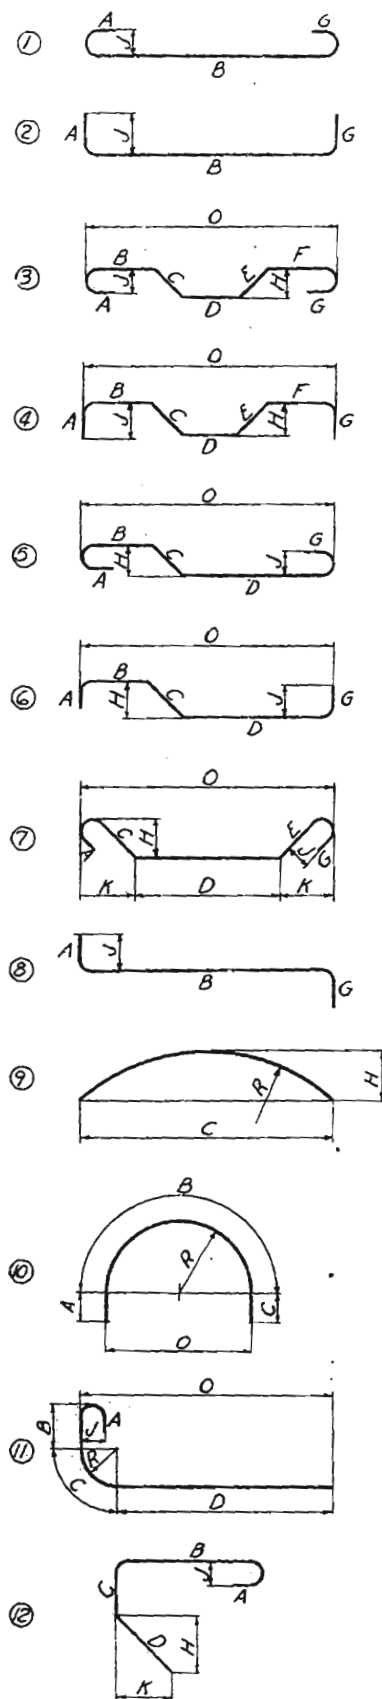

Where slope differs from 45°, dimensions "H" and "K" must be shown.

## ENLARGED VIEW SHOWING BAR BENDING DETAILS

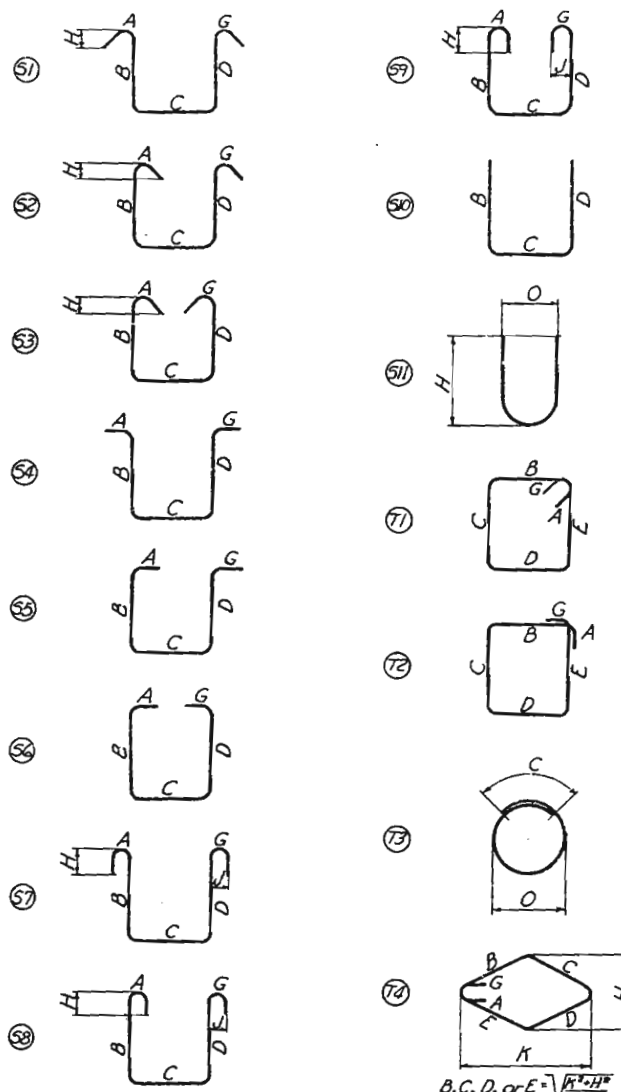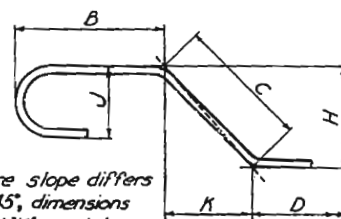


$$B, C, D, \text{ or } E = \sqrt{H^2 + H^2}$$


## NOTES

- All dimensions are out to out, except "R" which is to inside of bend.
- "J" Dimension on 180° hooks to be shown in Bar List only where necessary to restrict hook size, otherwise standard hooks are to be used.
- Where "J" is not shown, "J" will be kept equal to or less than "H". Where "J" can exceed "H", it should be shown in Bar List.
- "H" Dimension on stirrups to be shown on Bar List where necessary to restrict hooks.
- Corrections in length, due to bending around a mandrel, will be made only when the radius "R" (as in types 11 and 13) exceeds the standard radii indicated in standard hook dimensions. However, the dimensions "A" or "G" shown for standard hooks have been corrected for curvature.
- All bends shown are bent around a standard mandrel, except where radius "R" is indicated.
- Figures in circles show bar types.
- Where "R" is shown on bar types 9, 10, 11 and 13, the length of bend shall be measured along outside of bend. The length of bar type T3 shall also be measured along outside of bar.


## STANDARD HOOK DIMENSIONS

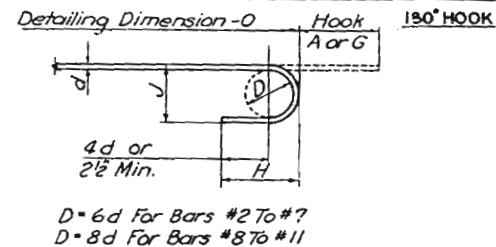

Bar Size	Hook A or G	Approx. H
#2	4"	3 1/2"
#3	5"	4"
#4	6"	4 1/2"
#5	7"	5"
#6	8"	6"
#7	10"	7"
#8	1 1/4"	10"
#9	1 3/4"	10 1/2"
#10	1 5/8"	11 1/2"
#11	1 7/8"	12 1/2"

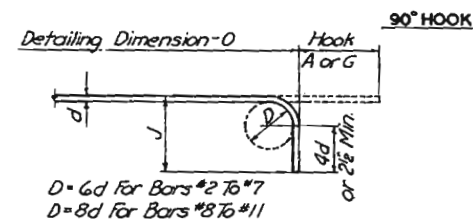

Bar Size	Hook A or G	Approx. H
#2	3"	3 1/2"
#3	3"	4"
#4	3"	4 1/2"
#5	4"	5"
#6	4"	6"
#7	5"	7"
#8	6"	9"
#9	7"	10"
#10	8"	11 1/2"
#11	9"	12 1/2"

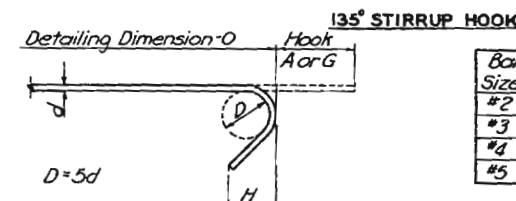

Bar Size	Hook A or G	H
#2	3 1/2"	2"
#3	4"	2 1/2"
#4	4 1/2"	2 3/4"
#5	5"	2 3/4"

## BAR SIZE EQUIVALENTS

#2	6"	#7	7 1/8"
#3	5 1/2"	#8	1"
#4	1 1/2"	#9	1"
#5	5 3/8"	#10	1 1/8"
#6	3 3/4"	#11	1 1/4"

NEW FAIRFAX BRIDGE  
OVER MISSOURI RIVER  
NEAR KANSAS CITY, KANSAS

FOR  
PLATTE COUNTY, MISSOURI

## TYPICAL BAR TYPES AND HOOK DIMENSIONS

SVERDRUP AND PARCEL, INC.  
CONSULTING ENGINEERS  
ST. LOUIS, MO.

FINISH  
A-450  
Platte Co.  
RI-69  
A-450

SHEET 11 OF 13

AS BUILT DRAWING

FINAL DESIGN DRAWING STANDARD B1




12-59 Drawn by: A. Avila, Dec. 1951  
5/5/1959 Traced by: L. Glaser, Dec. 1951  
Checked by: W. Littlefield, Jan. 1952  
Revised: Feb., 1953



### SPECIAL BENDING DETAILS AND CUTTING DIAGRAMS

Hand-drawn diagrams for a reinforced concrete column. The left diagram shows a cross-section of a column with dimensions: width 2'-7 1/4", height 4'-5 1/4" @ 2' 10", and reinforcement 6-X26 @ P28. The right diagram shows a detail of a bent-up bar with dimensions: 25'-0" total length, 11'-7 1/4" and 13'-3 3/4" segments, and a 4" bend angle. A separate diagram shows a bent-up bar with a 90-degree bend and a radius R.

Mark	A	S	R
X8	2:0"	9:3"	5:24"
X11	2:0"	17:10 <sup>5</sup> / <sub>8</sub>	10:8 <sup>1</sup> / <sub>4</sub>
P3	2:0"	13:11 <sup>1</sup> / <sub>2</sub>	8:2 <sup>1</sup> / <sub>4</sub>
P6	2:0"	9:3"	5:24"

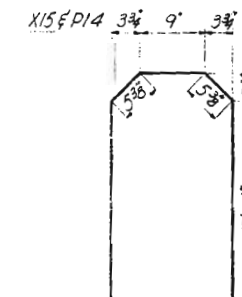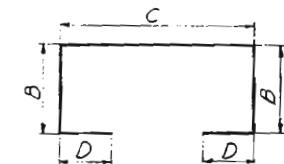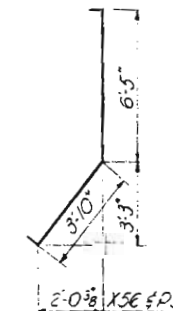

Mark	B	C	D
X13	2:2"	5:8"	2:1"
X14	2:2"	7:8"	2:10"
P7	2:2"	5:8"	2:1"
P8	2:2"	7:8"	2:10"

Dimensioning, bending and hooks for Special Bending Details shall conform to the standards as noted or shown on Sheet 11.

A dash is used in the appropriate dimension column to indicate that a hook, bend or portion of the standard bar type is to be omitted.

See Sheet 11 for Typical Bar Types and Hook Dimensions.

NEW FAIRFAX BRIDGE  
OVER MISSOURI RIVER  
NEAR KANSAS CITY, KANSAS

FOR  
PLATTE COUNTY, MISSOURI

SUBSTRUCTURE BAR LIST-SPECIAL  
BENDING DETAILS & CUTTING DIAGRAMS

SVERDRUP AND PARCEL, INC.  
CONSULTING ENGINEERS  
ST. LOUIS, MO.

**FINISHED**

A-450  
Platte Co.  
Rt. 69

Revision  $\Delta$  X13, X27, X33 to X36, P7, P27 5-3-56 By: J.S.A. Chkd: J.A.W.

SHEET 12 OF 13

AS BUILT DRAWING

FINAL DESIGN DRAWING





# NEW FAIRFAX BRIDGE PROJECT

NEAR

## KANSAS CITY, KANSAS

FOR

## PLATTE COUNTY, MISSOURI

1955

### INDEX OF DRAWINGS

- 1 GENERAL PLAN & ELEVATION
- 2 SUPERSTRUCTURE GENERAL NOTES & AND QUANTITIES
- 3 ANCHOR BOLT PLAN
- 4 BEAM SPANS 1,3,4 & 15 - GIRDER SPANS 2,3 & 6
- 5 BEAM SPANS 12,13 & 14
- 6 BEAM AND GIRDER SPANS-SHOES
- 7 ROADWAY EXPANSION DEVICES AT BENTS 2,4,6 & 15
- 8 SIMPLE TRUSS SPAN-L0 TO L3
- 9 SIMPLE TRUSS SPAN-L4 TO L5 AND STRESS SHEET
- 10 TRUSS SPANS NOTES AND MISC. DETAILS
- 11 CANTILEVER TRUSS SPANS-STRESS SHEET
- 12 CANTILEVER TRUSS SPANS-L0 TO L2 & PORTAL AT U1
- 13 CANTILEVER TRUSS SPANS-L3 TO L6
- 14 CANTILEVER TRUSS SPANS-L7 TO L10
- 15 CANTILEVER TRUSS SPANS-L11 TO L14
- 16 CANTILEVER TRUSS SPANS-L15 TO L18
- 17 CANTILEVER TRUSS SPANS-L19 TO L22
- 18 TRUSS SPANS-FLOOR SYSTEM
- 19 TRUSS SPANS-SWAY FRAMES
- 20 CANTILEVER TRUSS SPANS-PORTALS
- 21 SWAY FRAME AT U14 AND AERIAL BEACON ACCESS
- 22 SIMPLE TRUSS SPAN-AERIAL BEACON ACCESS AT L5
- 23 TRUSS SPANS-SHOES
- 24 ROADWAY EXPANSION DEVICES AT PIERS 7,8,11 & 12
- 25 ROADWAY EXPANSION DEVICE AT L19 & WIND TRANSFER DEVICE
- 26 STRUCTURAL STEEL HANDRAIL & ROADWAY DRAIN LOCATION
- 27 SLABS-SPANS 1 TO 6
- 28 SLABS-SPANS 7 TO 11
- 29 SLABS-SPANS 12 TO 15 & ROADWAY DRAINS
- 30 NAVIGATION LIGHTING DETAILS
- 31 NAVIGATION LIGHTING DETAILS

### CONTRACT II-SUPERSTRUCTURE NEW FAIRFAX BRIDGE

## APPROVED

COUNTY COURT OF PLATTE COUNTY MISSOURI

-----PRESIDING JUDGE-----DATE-----

MISSOURI STATE HIGHWAY COMMISSION

-----CHIEF ENGINEER-----DATE-----




STATE HIGHWAY COMMISSION OF KANSAS

-----CHIEF ENGINEER-----DATE-----

SVERDRUP AND PARCEL, INC.  
CONSULTING ENGINEERS  
ST. LOUIS, MO.

SUBMITTED BY:

REGISTERED PROFESSIONAL ENGINEER  
MISSOURI NO. E-640

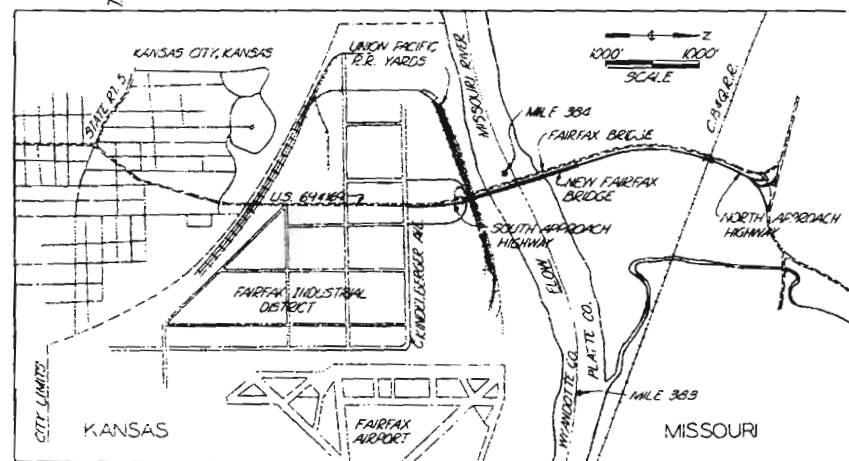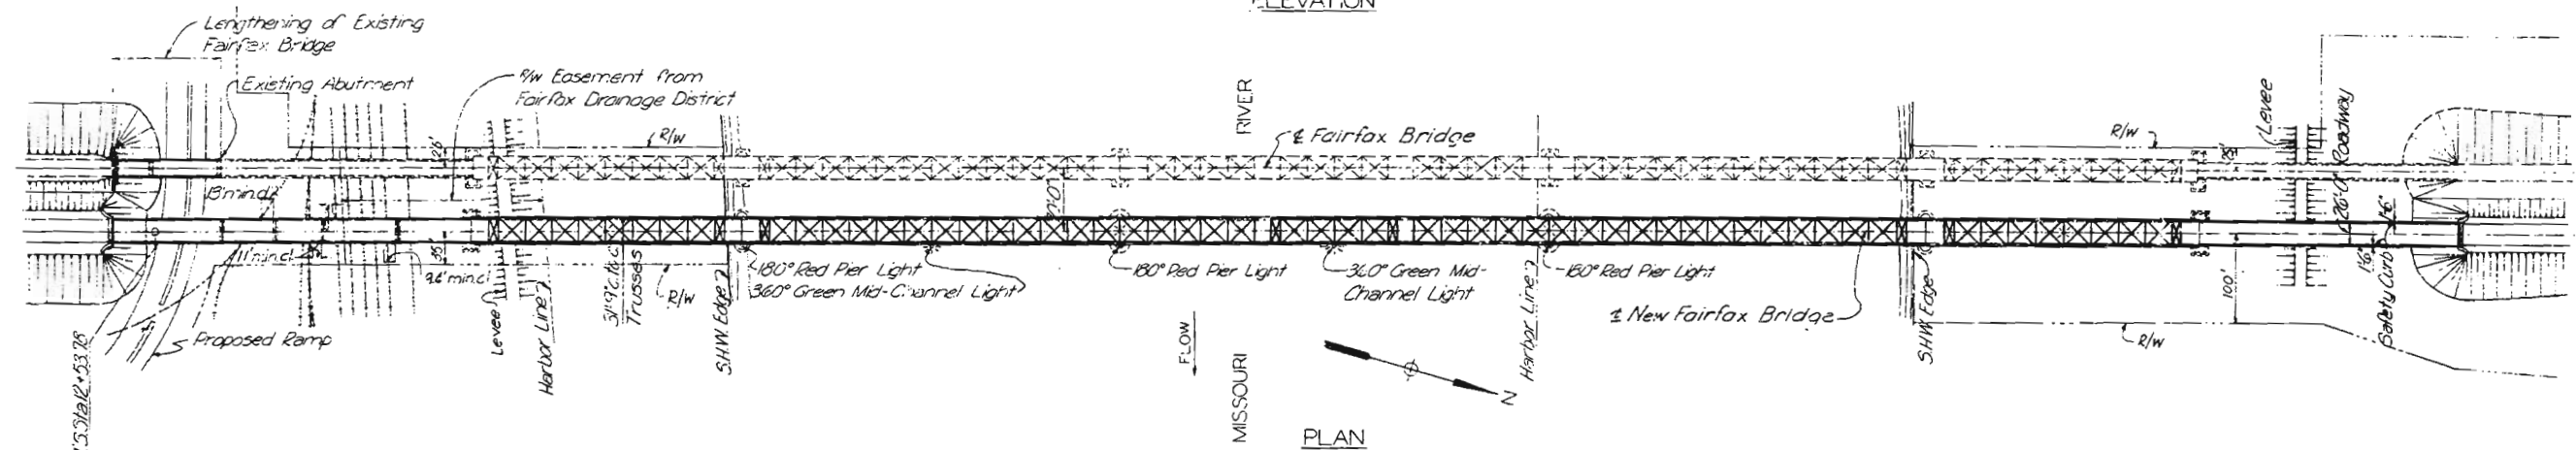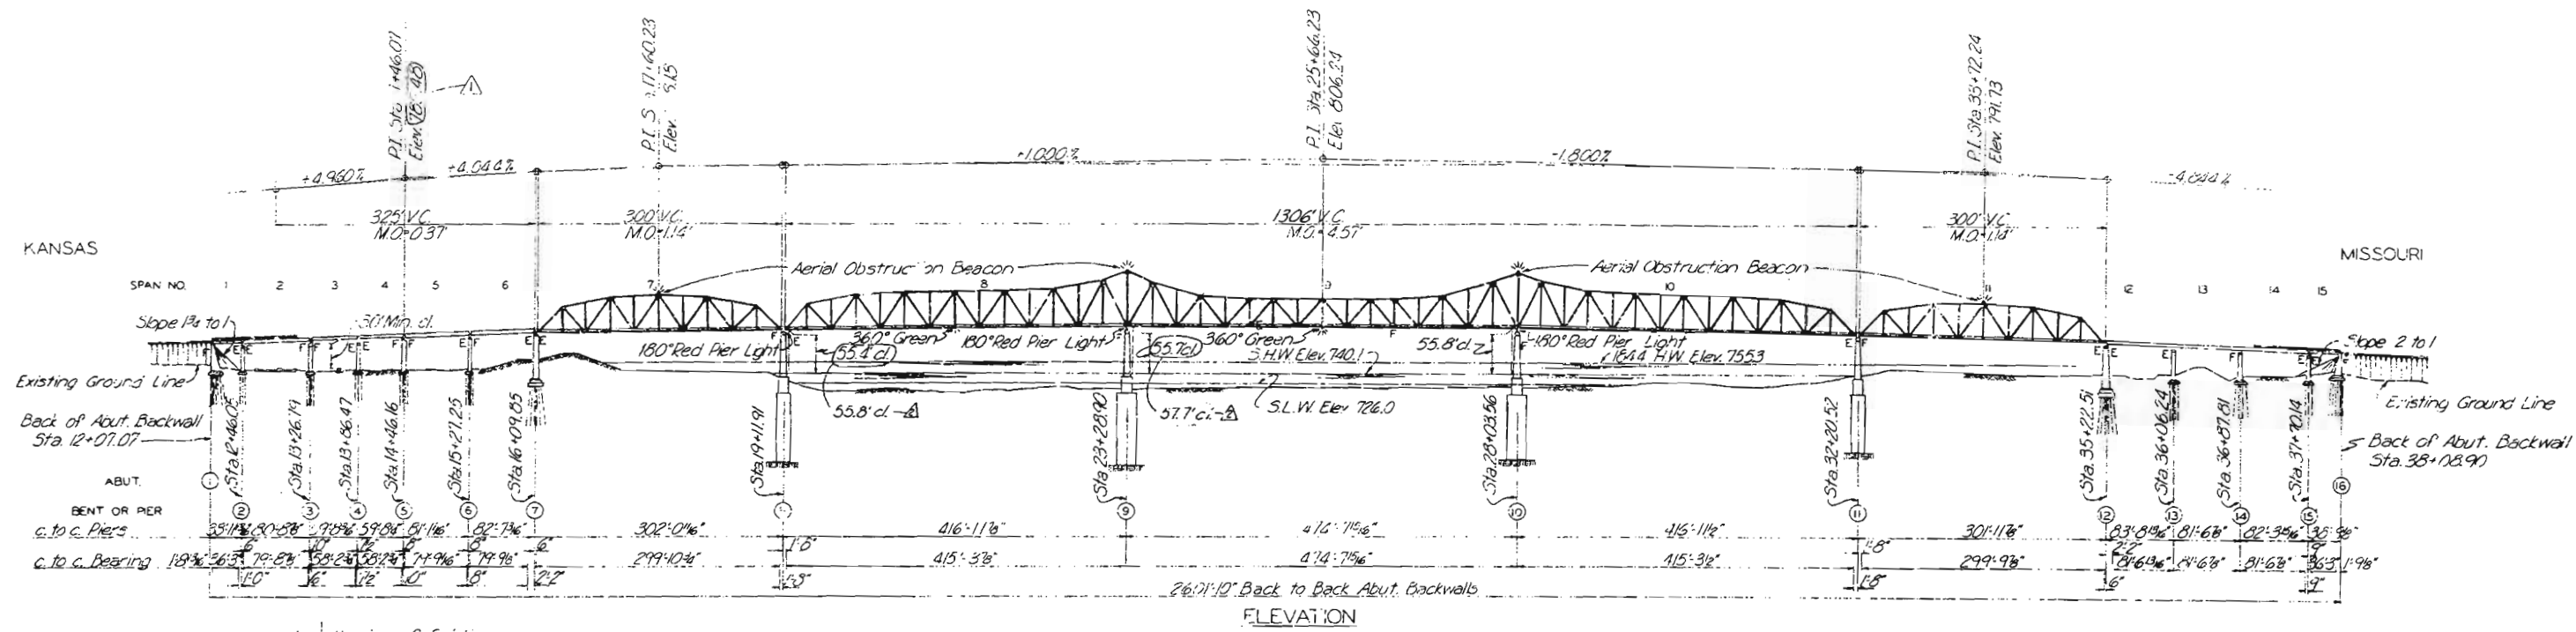

**NEW FAIRFAX BRIDGE  
OVER MISSOURI RIVER  
NEAR KANSAS CITY, KANSAS  
FOR  
PLATTE COUNTY, MISSOURI**

GENERAL PLAN AND ELEVATION

SVERDRUP AND PARCEL, INC.  
CONSULTING ENGINEERS  
ST. LOUIS, MO.

SHEET 1 OF 31

A-450

AS BUILT DRAWING

FINAL DESIGN DRAWING

Drawn by: H.T. Sanders, Mar. 1956  
Checked by: D. Kotakis, Apr. 1956

Note: Do not scale this drawing. Full size dimensions.

Revision 1 Piers 8 & 9 1-20-59 By R.E.B. Chkd. J.E.C.  
Revision 2 Elevation of P.I. 5-31-56 By H.T.S. Chkd. E.L.

# GENERAL NOTES

SPECIFICATIONS: Standard Specifications of the Missouri State Highway Commission, 1955 Edition, supplemented by General and Special Provisions.

DESIGN LOADING: In accordance with Division III of the A.A.S.H.O. "Standard Specifications for Highway Bridges", 1953 Edition, with the following exceptions and interpretations:

Live Load: H20-S16-44, except that the concentrated load used in combination with a lane load is taken as 26,000 pounds for both shear and moment calculations for the truss spans only.

Safety Curb Live Load: None

Dead Load: Provision is made for a future wearing surface of 15 pounds per square foot of roadway surface. Provision is made for future utilities of 630 pounds per foot of bridge in addition to the weight of the structure. Haydite concrete is assumed to weigh 105 pounds per cubic foot.

Wind Load: Provision is made for transverse, longitudinal, quartering and vertical wind forces. Transverse wind force for the design of superstructure is assumed to be 30 pounds per square foot or a combination of 30 pounds per square foot on the structure plus 200 pounds per lineal foot on the live load. For substructure design the transverse wind is assumed to be 50 pounds per square foot or combination of 15 pounds per square foot on the substructure and superstructure and 100 pounds per lineal foot on the live load. Longitudinal wind force on the superstructure spans is as specified in the A.A.S.H.O.

For quartering wind (45° to bridge centerline), the simultaneous lateral and longitudinal forces applied to the superstructure are as follows:

For Truss Spans:  
Lateral .707 times total transverse wind.  
Longitudinal .354 times total transverse wind.

For Girder Spans:  
Lateral .707 times total transverse wind.  
Longitudinal .177 times total transverse wind.

Wind area of substructure units is actual projection.

A vertical wind force acting on the truss spans only is assumed in design of shoes and substructure. The assumed force is an upward force applied at the windward quarter point of plan width. For combination with dead load plus 30 pounds transverse wind, the force is 20 pounds per square foot of deck plan area. For combination with dead load, live load and transverse wind, the force is 6 pounds per square foot of deck plan area.

Impact: No impact for substructure units.

DESIGN UNIT STRESSES IN CONCRETE:

Concrete in flexure — — — 1000 pounds per square inch.  
Reinforcing steel — — — 20,000 pounds per square inch.

ROADWAY WEARING SURFACE: The roadway slab as detailed includes a 6" wearing surface poured monolithically with slab.

REINFORCEMENT: All dimensions to reinforcing steel on detail drawings are to centerline of bar, except where the clear dimensions are noted from face of concrete. All reinforcing steel shall be lapped a minimum of 30 diameters unless otherwise shown or noted.

CONCRETE: Lightweight (Haydite air-entrained) concrete shall be used for all superstructure concrete. See Special Provisions.

BEVELED EDGES: All exposed edges of concrete shall be beveled 3/4" unless otherwise shown or noted.

CONSTRUCTION JOINTS: Construction joints shall be made only at locations shown on the plans. Keys shall be provided at all construction joints.

JOINT FILLER: Where joint filler is specified on the plans it shall conform to the requirements for "Gray Rubber Compound Joints" as given in Section 59-22B of the Standard Specifications. Payment for furnishing and placing joint filler shall be included in unit contract prices for items in which it is placed.

JOINT SEAL: Where joint seal is specified it shall conform to the requirements as given in the Standard Specifications. Payment for furnishing and placing joint seal shall be included in contract prices for other items of work.

COPPER FLASHING: Payment for furnishing and placing Copper Flashing shall be included in unit contract price for concrete.

SHOES: All finished surfaces shall be coated with white lead and talcum before leaving the shop. All pilot and driving nuts shall be furnished by the Contractor at his own expense.

LABREKA PADS: See Special Provisions.

STRUCTURAL CARBON STEEL: Structural Carbon Steel shall conform to A.S.T.M. Specification A7.

STRUCTURAL LOW-ALLOY STEEL: Structural Low-Alloy Steel shall conform to A.S.T.M. Specification A242 and supplemental requirements of the Special Provisions.

RIVET STEEL: Rivet Steel shall conform to A.S.T.M. Specification A141.

FABRICATION: Fabrication shall be in accordance with the requirements of the Standard Specifications except as noted in the Special Provisions.

WELDING: All welding shall be in accordance with the current "Specifications for Welded Highway and Railway Bridges" of the American Welding Society.

HIGH TENSILE BOLTS: High tensile bolts shall conform with the requirements of the Standard Specifications.

TURNED BOLTS: The bolt diameter billed on drawings shall be the shank diameter. The threaded portion shall be 1/8" smaller in diameter than the shank, except as noted on the drawings. In all cases the hole shall be the same diameter as the shank.

PAINT: Shop Coat - Red Lead, first field coat - Aluminum, second field coat - Aluminum. The first field coat of Aluminum shall be tinted with Prussian Blue in order to differentiate it from the second field coat. The second field coat shall be Al. minimum paint, untinted. Payment for cleaning and painting shall be included in the price bid for respective metalwork payment items.

## TABLE OF ESTIMATED QUANTITIES

Item	Unit	Quantity
Lightweight Concrete	Cu. Yds.	16.72
Fabricated Structural Carbon Steel (Beam & Gdr. Spans)	Lbs.	765,000 *
Fabricated Structural Carbon Steel (Truss Spans)	Lbs.	3,178,000 *
Fabricated Structural Low-Alloy Steel (Truss Spans)	Lbs.	1,684,000 *
Fabricated Structural Carbon Steel (Handrail)	Lbs.	221,500
Steel Castings	Lbs.	70,800
Reinforcing Steel	Lbs.	375,210
Roadway Drain Castings	Lbs.	7,400
Navigation Lighting System	One	Lump Sum

\* Quantity not refigured from final plans. Figure above is same as indicated on Bidding Plans.

## TABLE OF FINAL QUANTITIES

Item	Unit	Quantity
Lightweight Concrete	Cu. Yds.	16.837
Fabricated Structural Carbon Steel (Beam & Gdr. Spans)	Lbs.	784,480
Fabricated Structural Carbon Steel (Truss Spans)	Lbs.	3,365,050
Fabricated Structural Low-Alloy Steel (Truss Spans)	Lbs.	1,558,160
Fabricated Structural Carbon Steel (Handrail)	Lbs.	222,660
Steel Castings	Lbs.	74,350
Reinforcing Steel	Lbs.	375,210
Roadway Drain Castings	Lbs.	7,400
Navigation Lighting System	One	Lump Sum
Additional Insurance	One	Lump Sum

NEW FAIRFAX BRIDGE  
OVER MISSOURI RIVER  
NEAR KANSAS CITY, KANSAS  
FOR  
PLATTE COUNTY, MISSOURI

SUPERSTRUCTURE GENERAL NOTES  
AND QUANTITIES

SVERDRUP AND PARCEL, INC.  
CONSULTING ENGINEERS  
ST. LOUIS, MO.

21N15424

Revision A Quantities added 1-20-59 By R.E.B. Chkd. J.E.C.  
Revision B Revise reinforcing steel quantity 12-10-56 by G.R.P. Chkd. W.H.B.  
Revision C Quantities added. 6-25-56 by W.M. Chkd. E.L.

SHEET 2 OF 31


A-450

AS BUILT DRAWING



FINAL DESIGN DRAWING

Platte Co.  
Pt. 69

1259  
35337  
Drawn by: W. Miller, May 1956  
Checked by: E. Lemcoe, May 1956

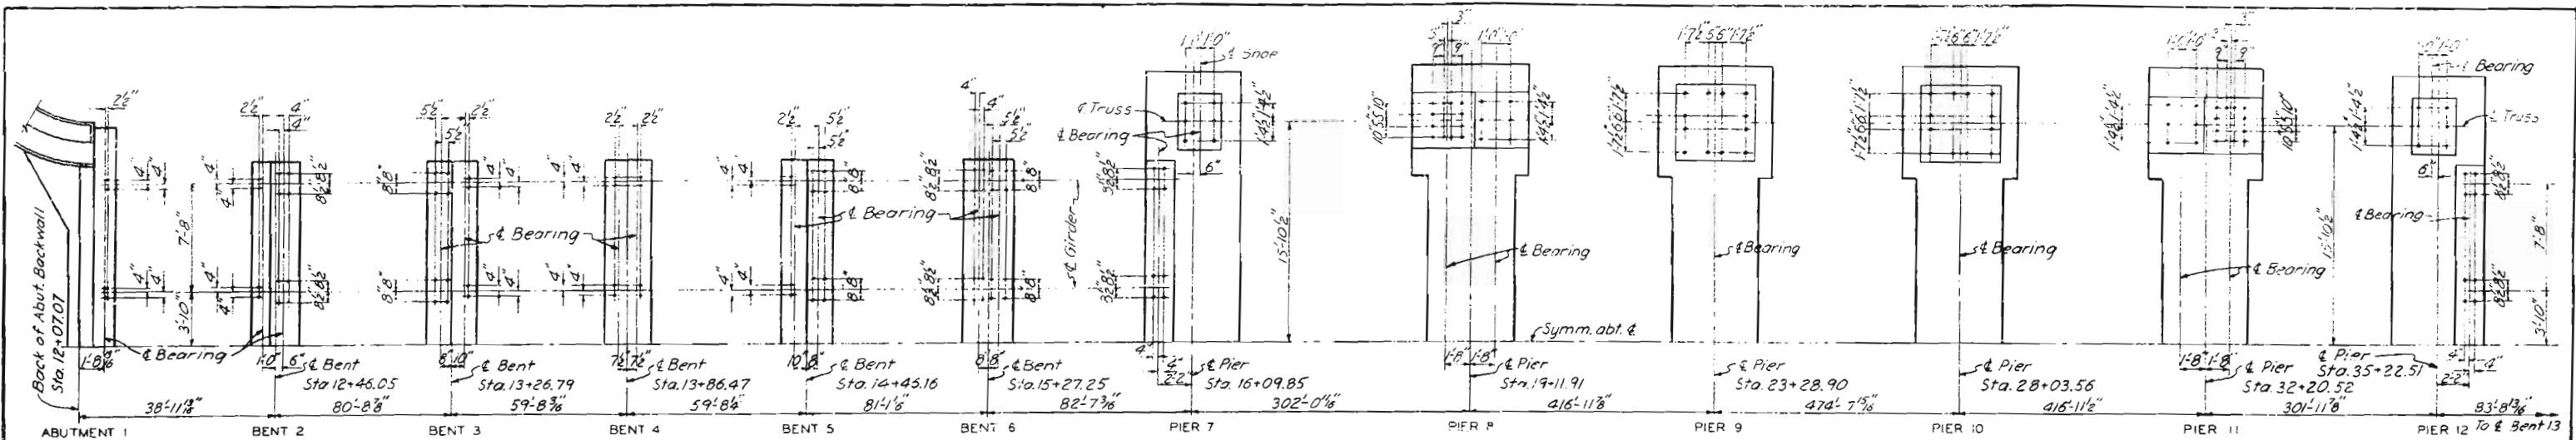

HALF ANCHOR BOLT PLAN

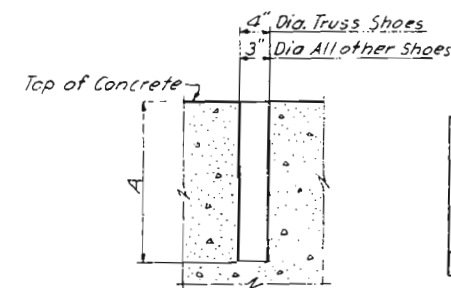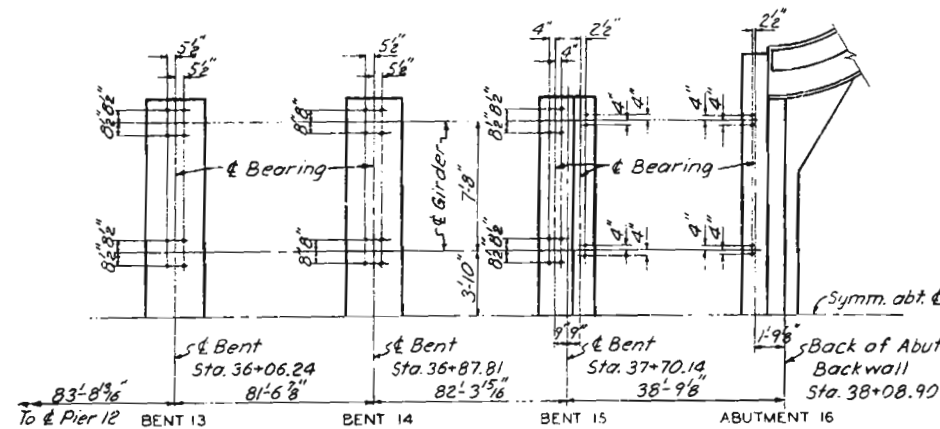

ANCHOR BOLT WELL

Location	Dim. A
Piers 8 & 11 (Fixed Shoes)	2'-2"
Piers 7 & 12 (Truss Shoes)	2'-2"
Piers 8 & 11 (Expansion Shoes)	2'-7"
Piers 9 & 10	2'-7"
All Others	1'-6"

#### NOTES

Anchor Bolts for Spans 1 and 15 may be cast in place. All others are to be grouted in wells.

Anchor bolt wells shall be formed in substructure units by placing and setting with a template.

Wells shall be completely filled with grout containing Iron Oxide Cement (Embeco) or an approved equivalent, after steel has been erected and adjusted.

NEW FAIRFAX BRIDGE  
OVER MISSOURI RIVER  
NEAR KANSAS CITY, KANSAS  
FOR  
PLATTE COUNTY, MISSOURI

#### ANCHOR BOLT PLAN

SVERDRUP AND PARCEL, INC.  
CONSULTING ENGINEERS  
ST. LOUIS, MO






Drawn by: W.J. Ballard Apr. 1956  
Checked by: D. Korakis Apr. 1956

SHEET 3 OF 31

A-450

AS BUILT DRAWING

FINAL DESIGN DRAWING

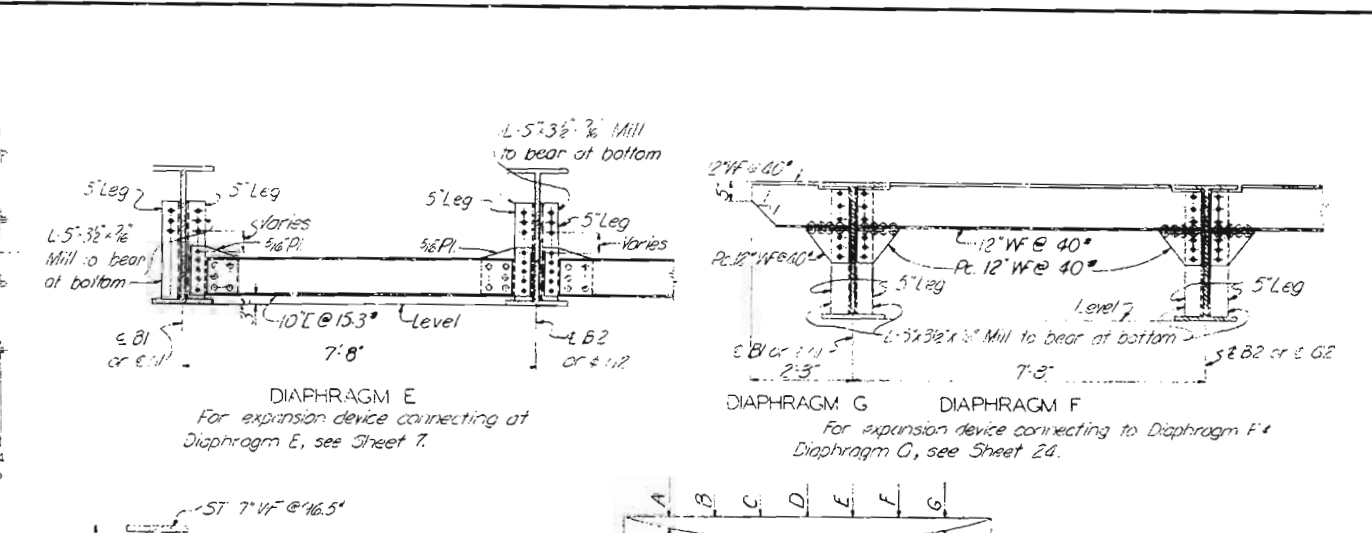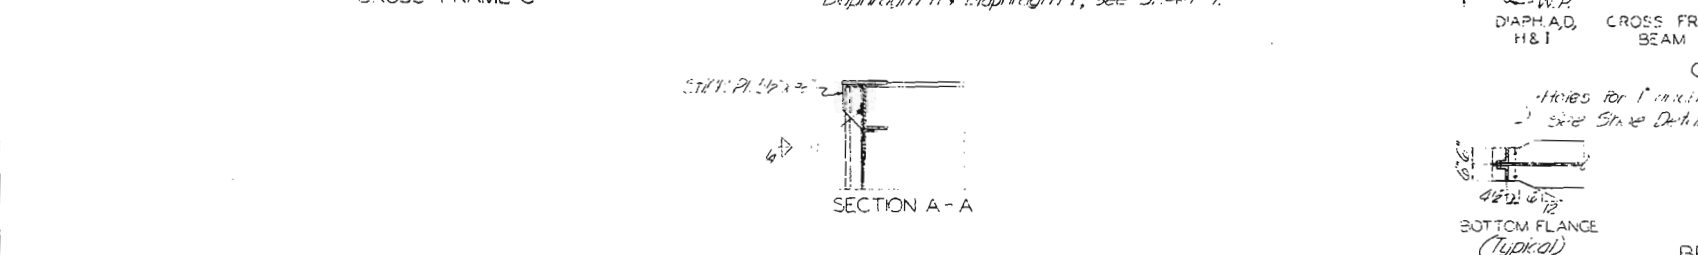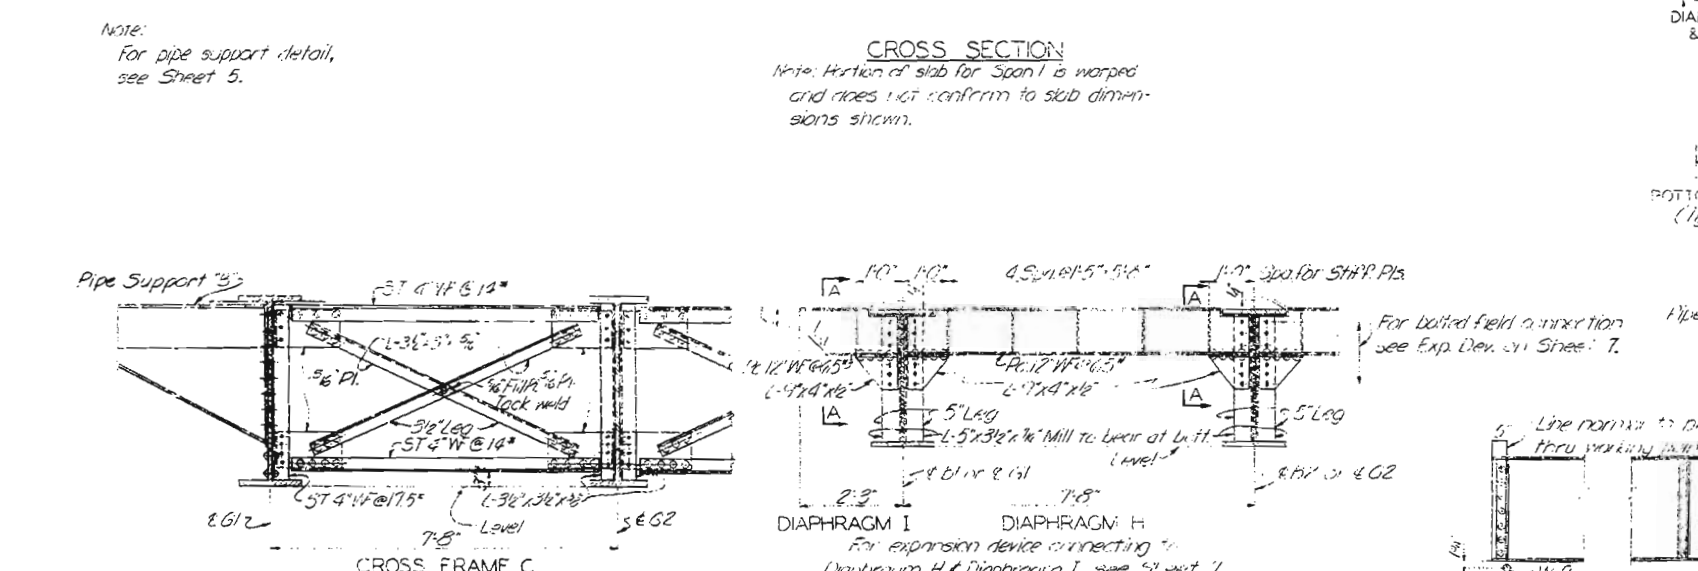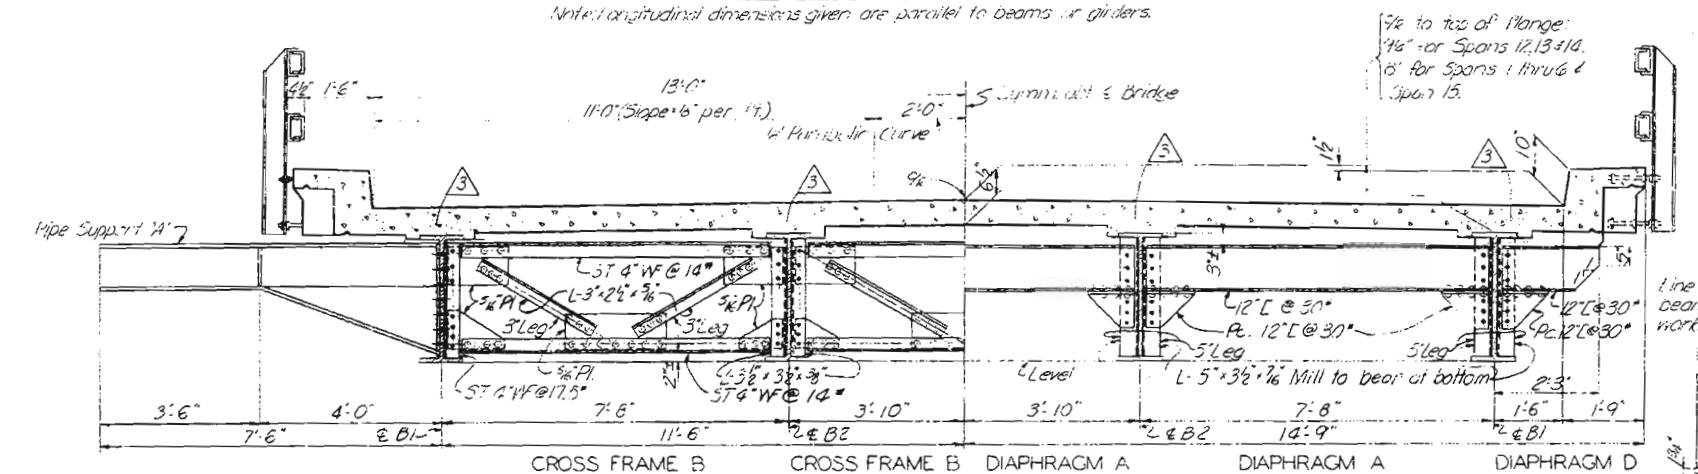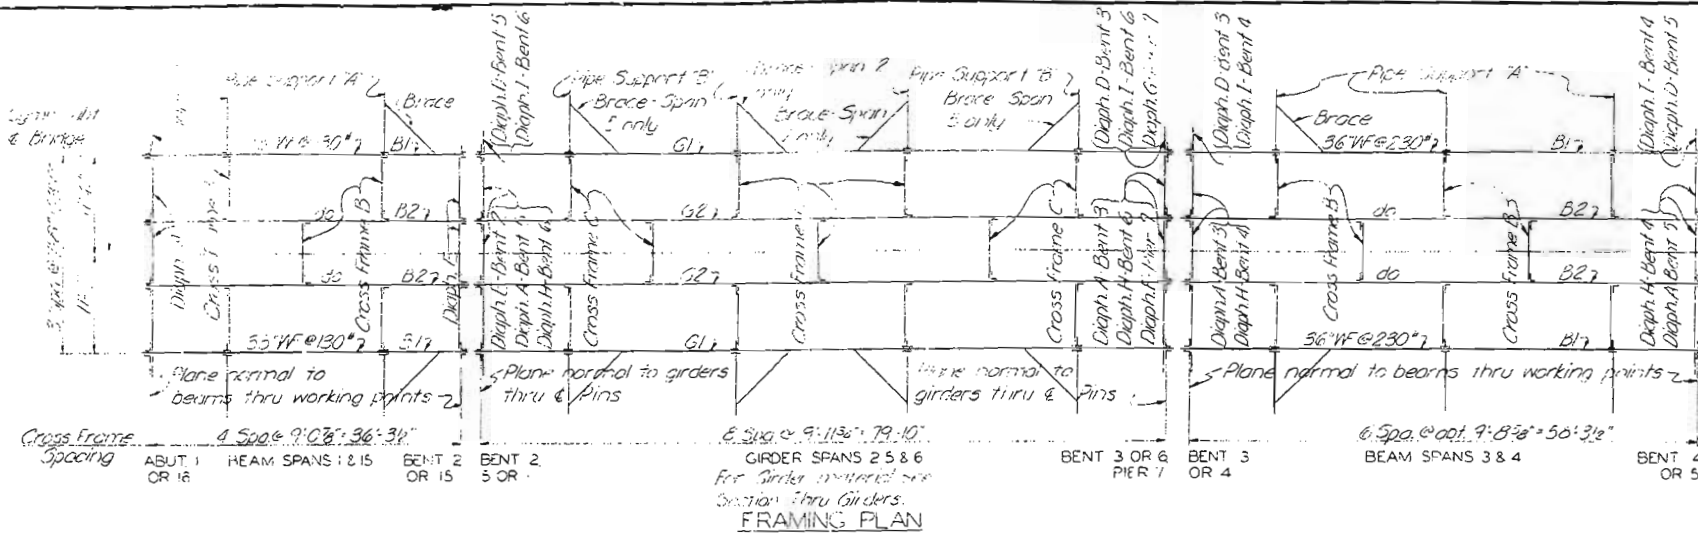

**SECTION THRU GIRDERS G1 & G2**



Continuous Butt Weld  
Grind flush at connections.

8 Equal Spaces - Span Length



Span	Beam	A	B	C	D	E	F	G	P	Q
18 15	B1, E1	-	6	-	3	-	6	-	20%	20%
3 & 4	B1, G2	3	6	2	3	2	6	3	25%	15%
2, 5 & 6	G1, G2	3	6	4	3	3	6	3	30%	15%

Note: Column P shows the percentage of total dead load deflection due to dead load in steel only. Column Q shows the percentage of total dead load deflection due to dead load of future utilities. Beams are not to be cambered.

**TOTAL DEAD LOAD DEFLECTION ORDINATES**

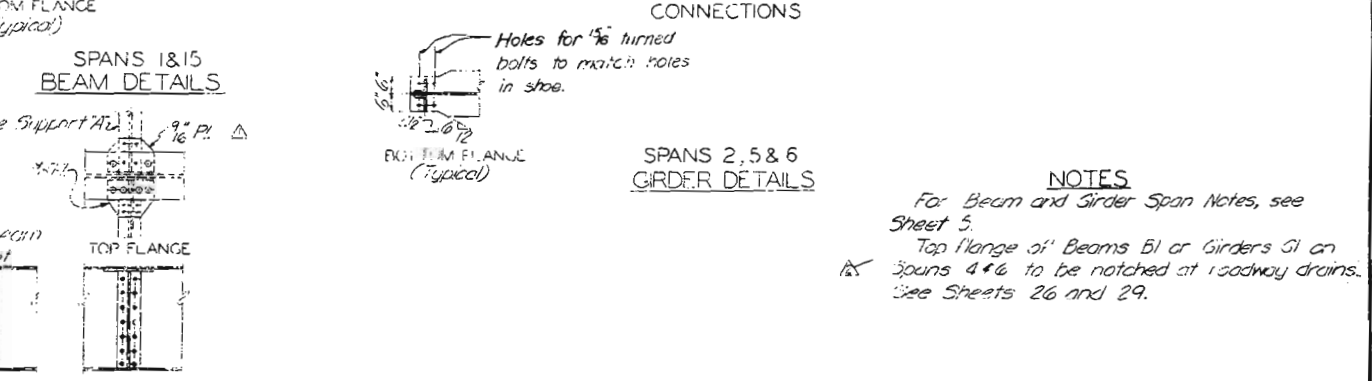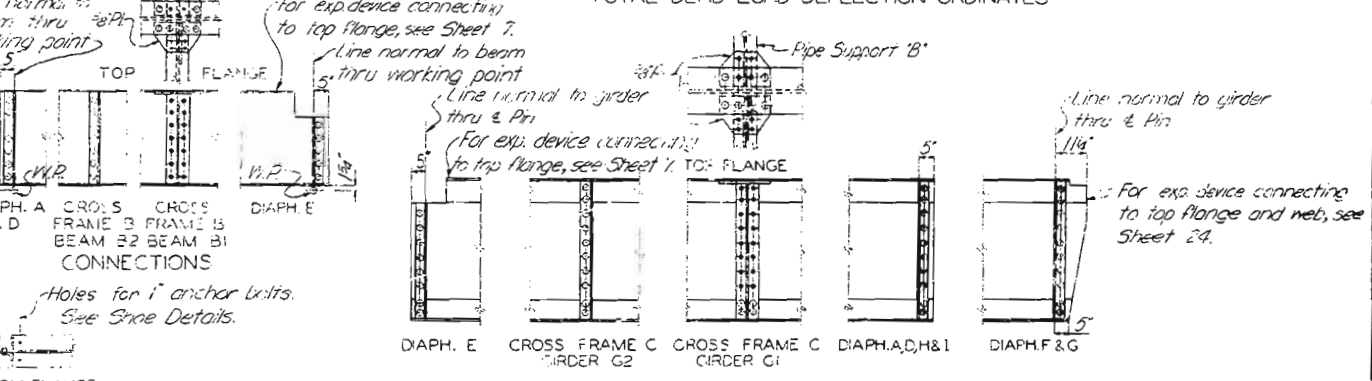



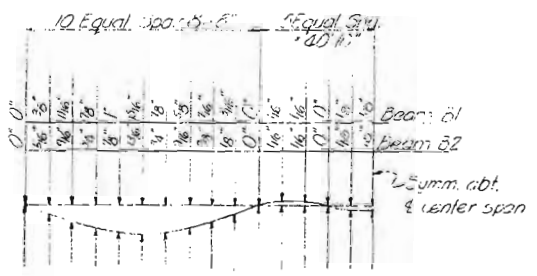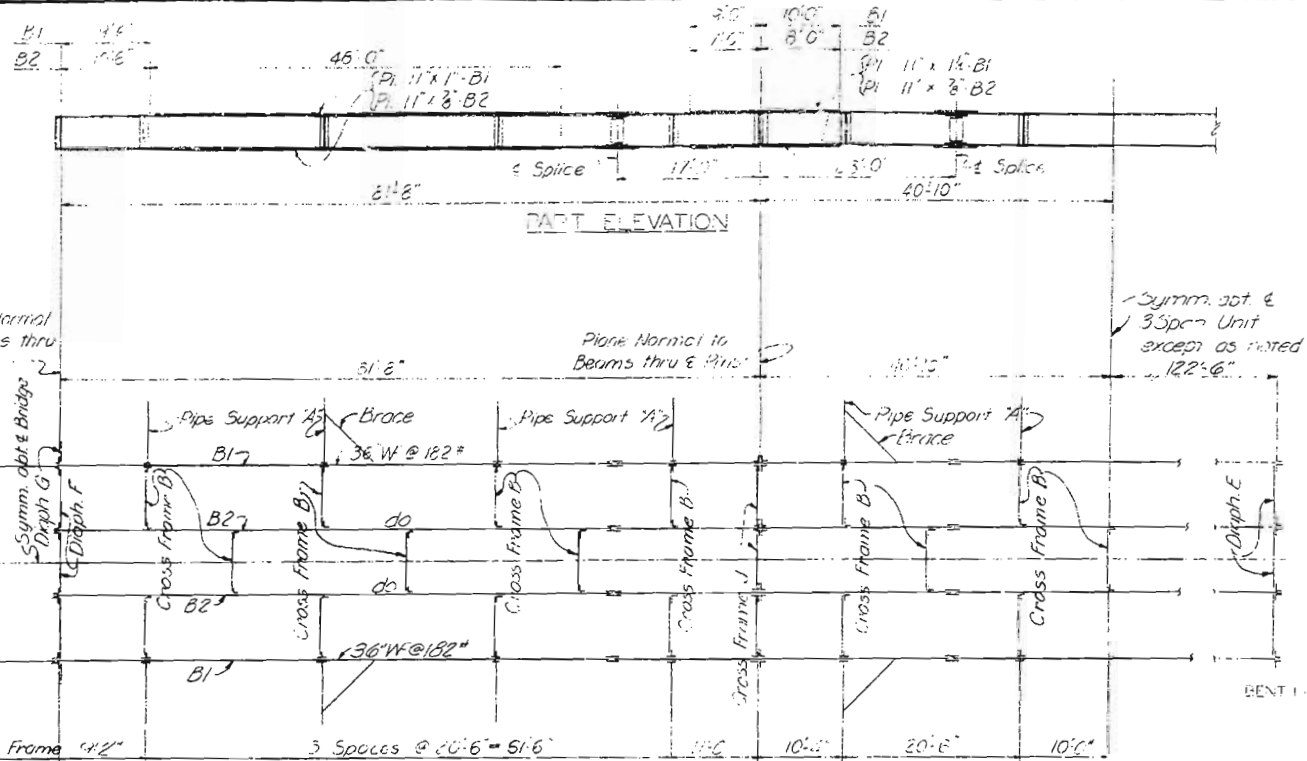

**DEAD LOAD DEFLECTION ORDINATES**  
 Note: Deflections are not to be cambered. The deflection for dead load of steel only is shown. The deflection for dead load of future wearing surface and other loads is shown in parentheses.


**TABLE 1. MAXIMUM MOMENT AND REACTIONS**

	Loading	Span			
		A	B	C	D
Beam B1	D.L.	48.7	78.7	103.3	135.4
	L.L.	33.4	51.8	46.5	49.5
	I.	8.1	12.5	1.3	12.0
	Total	90.2	143.0	151.1	196.9
Beam B2	D.L.	26.2	42.3	55.5	72.8
	L.L.	17.7	14.1	6.45	5.8.7
	I.	1.6	1.79	1.56	1.66
	Total	45.5	58.3	63.5	80.1

Note: Reactions are given in kips. Moments are given in ft. kips.


**PART FRAMING PLAN**

Note: Welding and end details for all cover plates are same as shown here.  
 Note: Longitudinal dimensions given are parallel to grade.  
 Note: Cross Frame J is same as Cross Frame B except beam stiff. & shall be as shown in beam elevation.

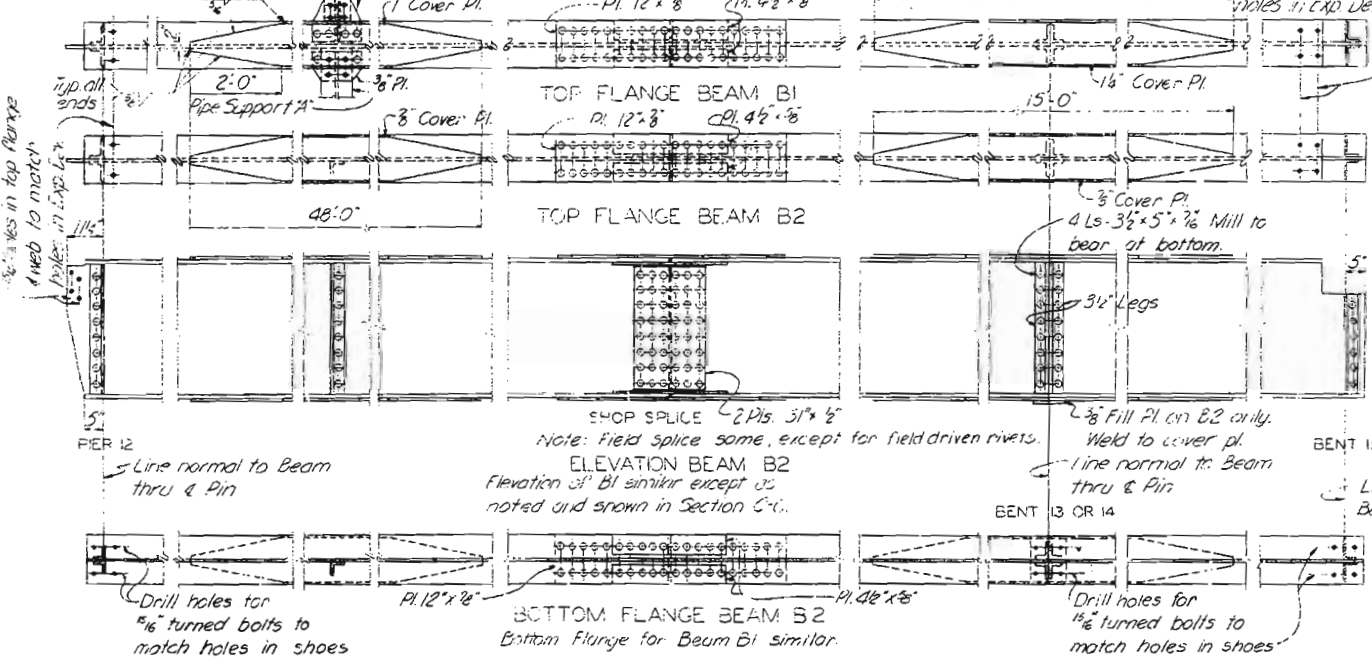

**TYPICAL BEAM DETAILS**


**NOTES**  
 For Cross Section and Diaphragms see Sheet 4.

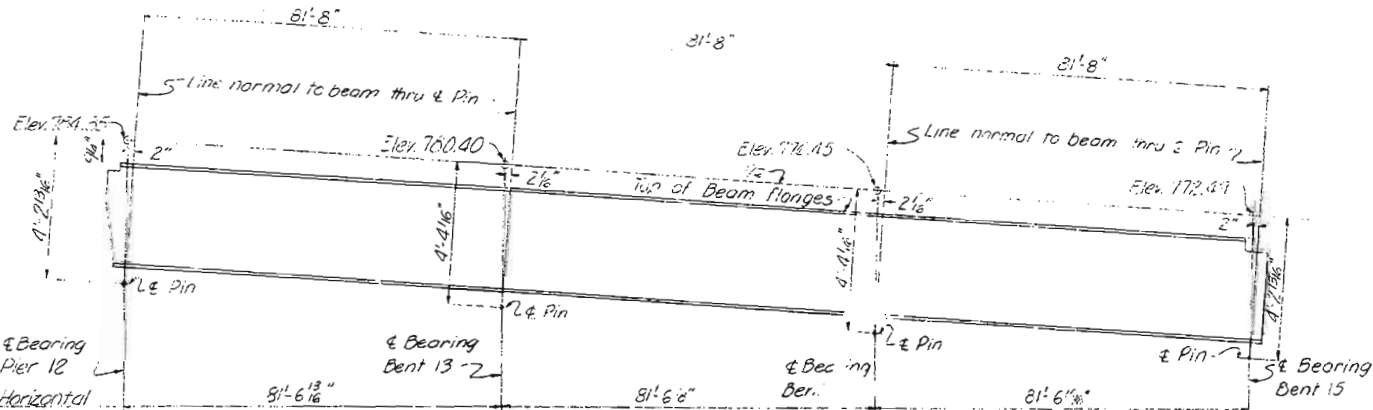


**BEAM LAYOUT**

**BEAM AND GIRDER SPAN NOTES**


All field connections shall be riveted unless otherwise noted. Where desired for convenience in erection, shop and field rivets may be interchanged. All rivets in beams and girders shall be 3/4". All others shall be 3/8". Splices may be either field or shop and shall be positioned substantially as shown but may be shifted slightly in either direction if desired by the Contractor. All cover plates and all flange splice plates shall be universal mill plates. Re-entrant cuts shall be filleted to not less than 1/2" radius. Pipe supports shall be braced at points indicated in Framing Plan.

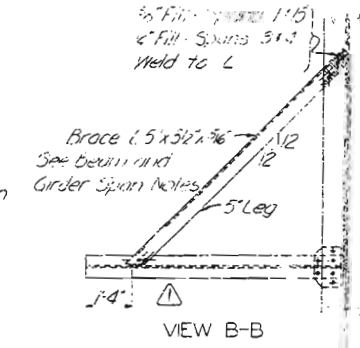

**VIEW B-B**

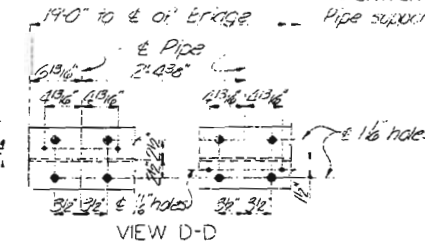

**VIEW D-D**

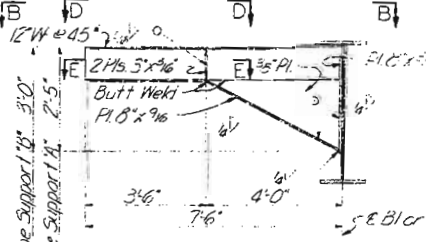

**PIPE SUPPORT DETAIL**

Note: Do not scale this drawing. Follow dimensions.

Revision 1 Holes for Pipe Conns. 8-2-56 By L.G. Chkd. EL.  
 Revision 2 Pipe Support Brace 8-27-56 By EL. Chkd. G.R.P.

**NEW FAIRFAX BRIDGE  
 OVER MISSOURI RIVER  
 NEAR KANSAS CITY, KANSAS  
 FOR  
 PLATTE COUNTY, MISSOURI**

BEAM SPANS 12,13,14

SVERDRUP AND PARCEL INC.  
 CONSULTING ENGINEERS  
 ST. LOUIS, MO.


SHEET 5 OF 31

AS BUILT DRAWING

FINAL DESIGN DRAWING

Platte Co  
 PL 64

Drawn by: S.A. Hussaini Jan. 1956  
 Checked by: S.A. Hussaini May 1956

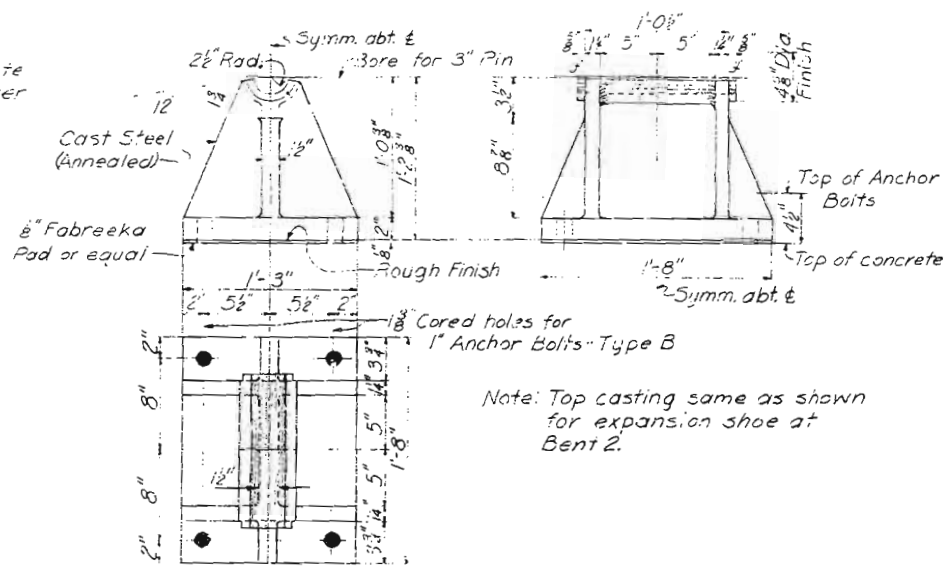

FIXED SHOE AT BENTS 3, 5, 6, & 14


Spans 2, 5, 6, 13 & 14  
(16 - Required)

Spans 2, 5, 6, 13 & 14  
(16 - Required)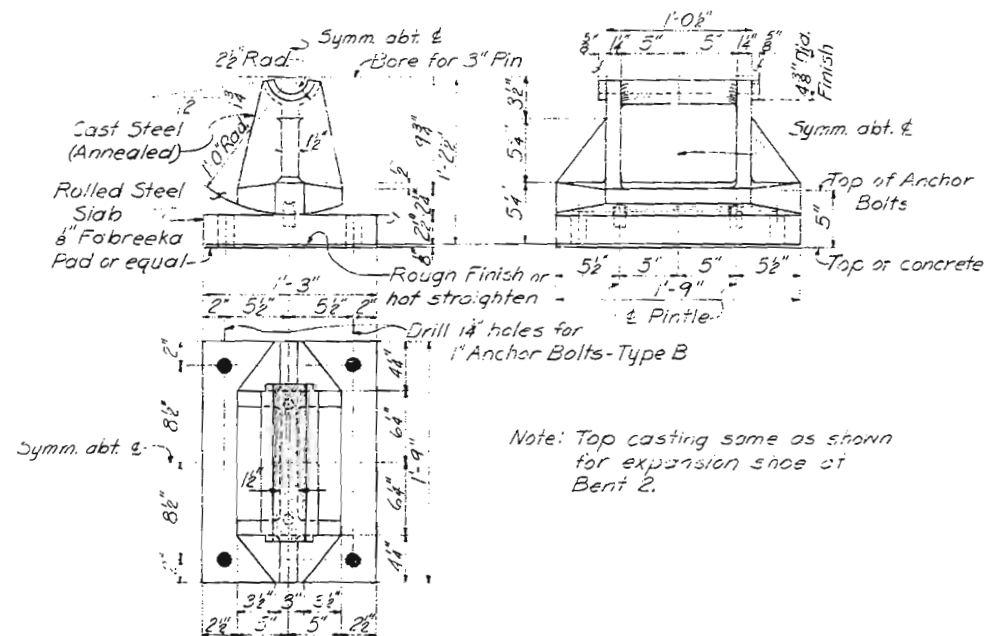

EXPANSION SHOE AT BENT 13

Spons 2, 5, 6, 12, & 14  
(20 Required)

(4 Required)

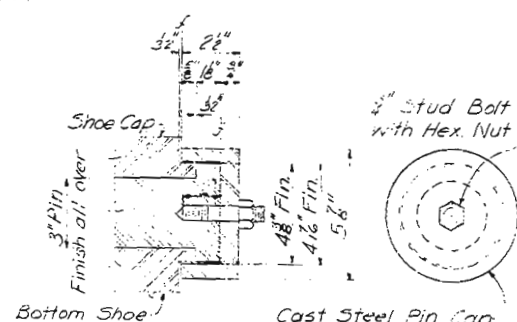

ANCHOR BOLTS  
(64-Type A Required)  
(160-Type E Required)

Cast Steel Pin  
(Annealed)  
PIN ENDS AND PIN CAPS  
(40- Pins Required)  
(80- Pin Caps Required)

Technical drawing of a Pintle. The drawing shows a cross-section of a cylindrical part with a central hole. Dimensions are given as follows:

- Top diameter: 1 3/8" Dia.
- Inner hole diameter: 7/8" Dia.
- Bottom diameter: 1 1/4" Dia.
- Length of the central hole: 2 1/2"
- Length of the bottom section: 1"

Notes:

- Threaded on Driving Fit
- PIN TLE
- (43 Required)
- Finish all over

Note: Do not scale this drawing. Follow dimensions.

NOTES

All fillets on castings to be 2".  
All castings shall conform to A.S.T.M.  
Designation A27, Grade 65-35; full  
annealed.  
Cost of furnishing and placing Fybreeka  
Pads, or equal shall be included in price  
bid for other items.

NEW FAIRFAX BRIDGE  
OVER MISSOURI RIVER  
NEAR KANSAS CITY, KANSAS  
FOR  
PLATTE COUNTY, MISSOURI

BEAM AND GIRDER SPANS-SHOES

SVERDRUP AND PARCEL, INC.  
CONSULTING ENGINEERS  
ST. LOUIS, MO. FINISHED


SHEET 6 OF 31

AS BUILT DRAWING


FINAL DESIGN DRAWING

A-450  
Plastic C  
of 69


A-450  
Plastic C  
of 69

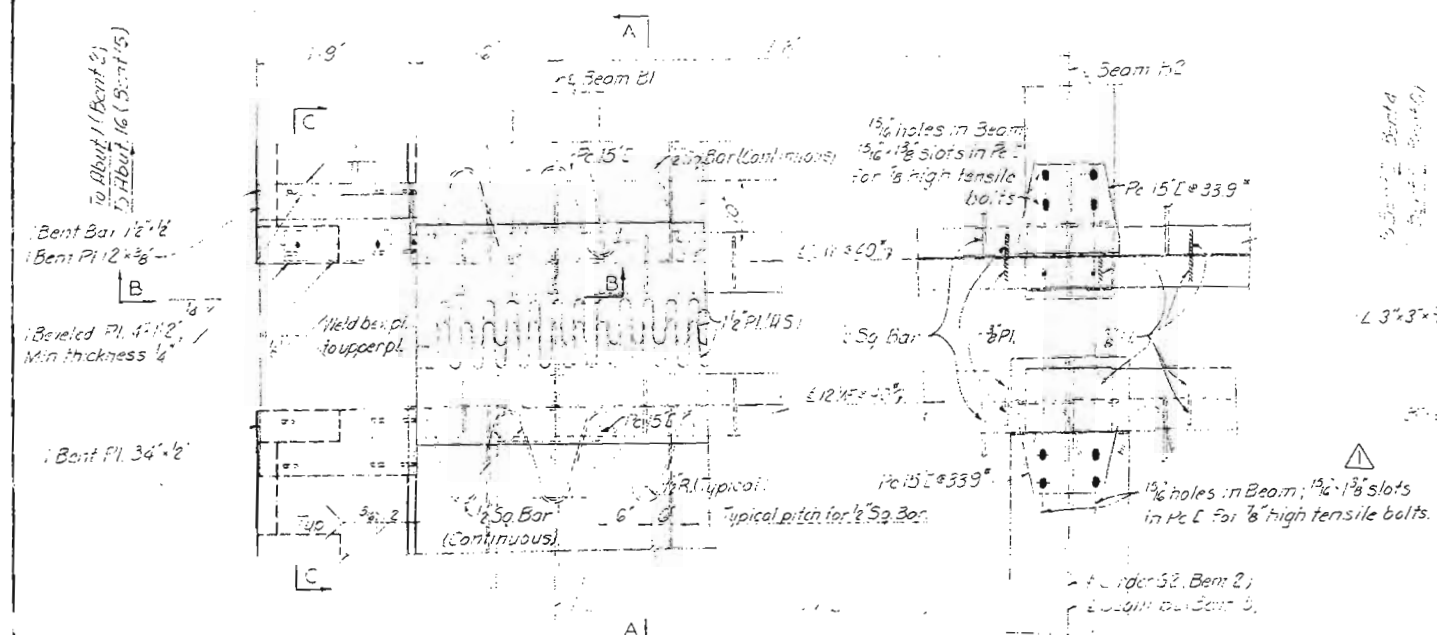


PART PLAN OF EXPANSION DEVICE AT BENTS 2 & 15

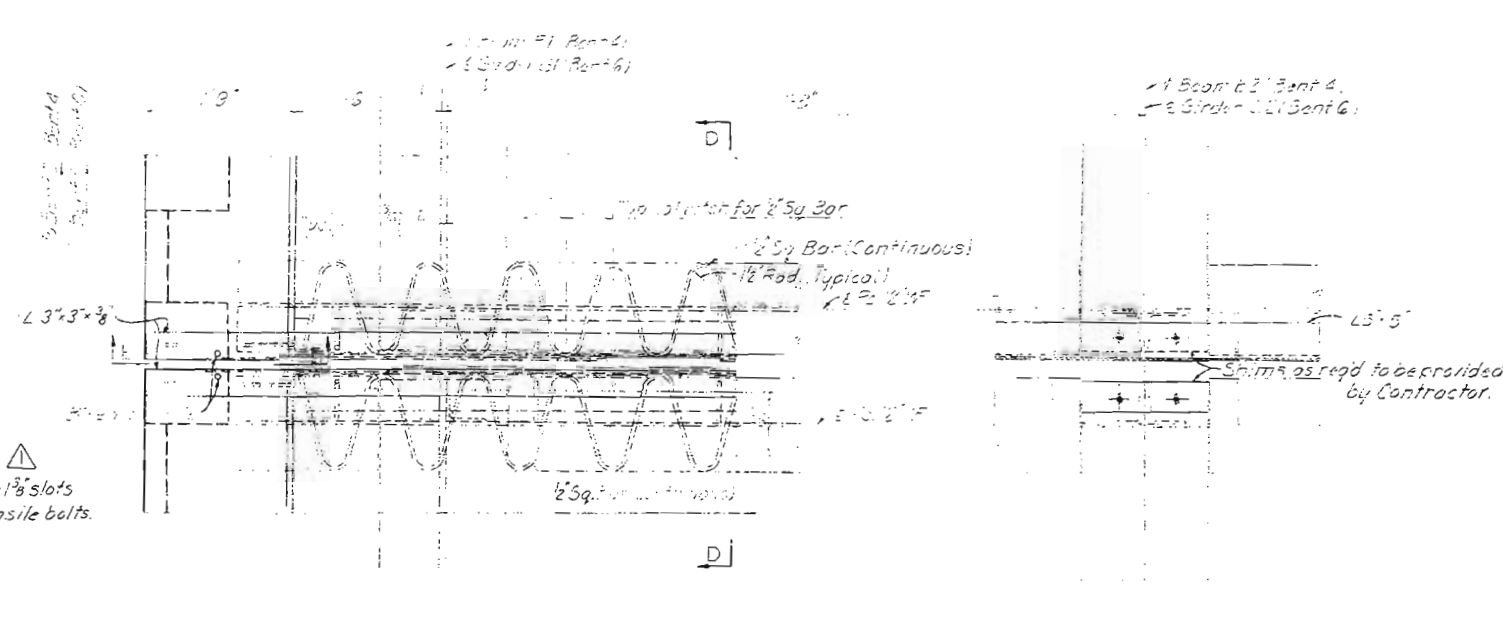


PART PLAN OF EXPANSION DEVICE AT BENTS 4 & 15

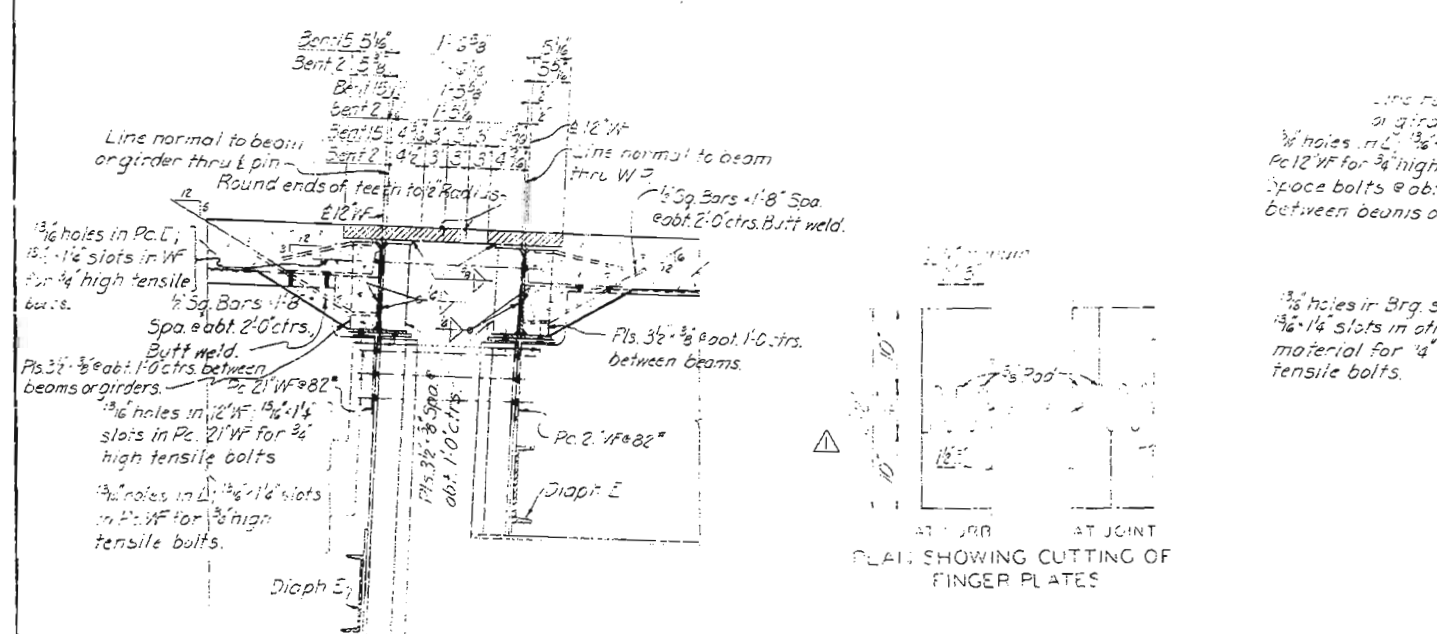


SECTION A-A

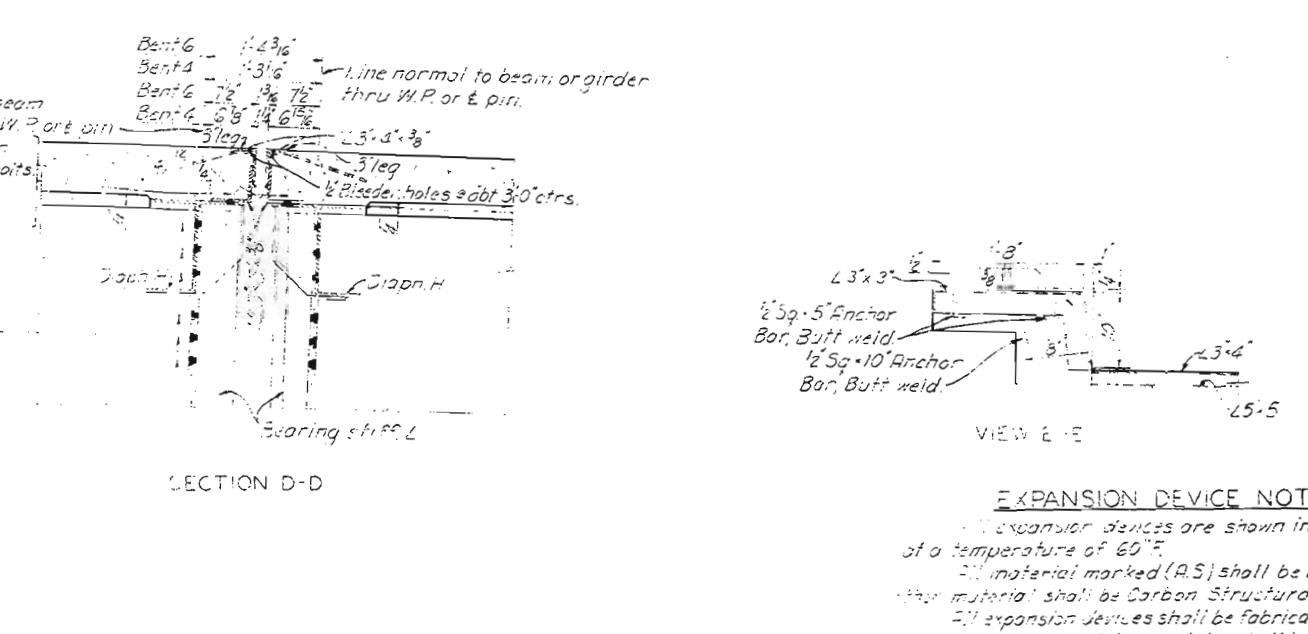

SECTION D-D

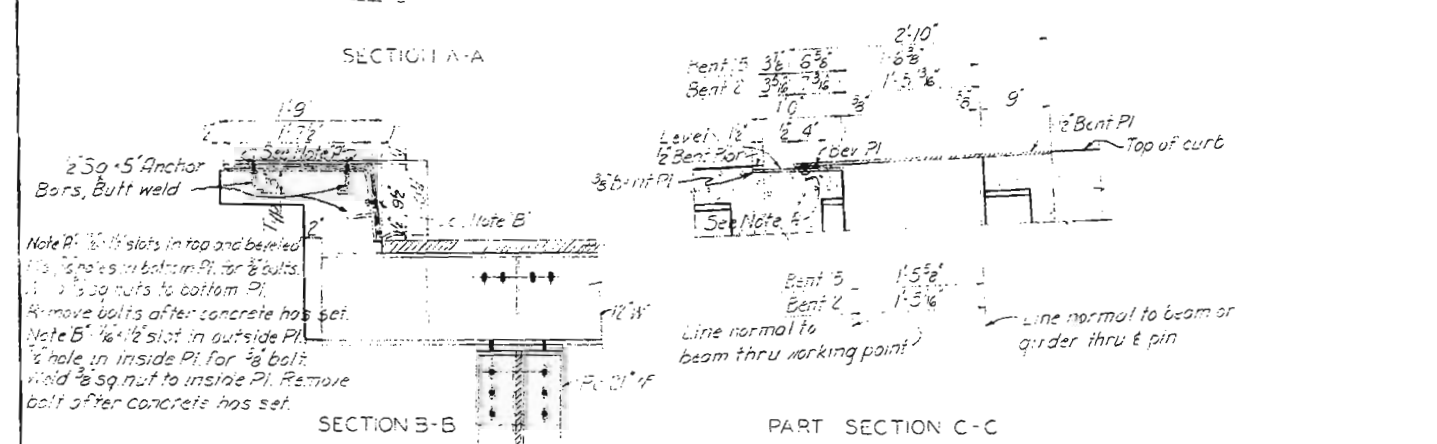

SECTION B-B

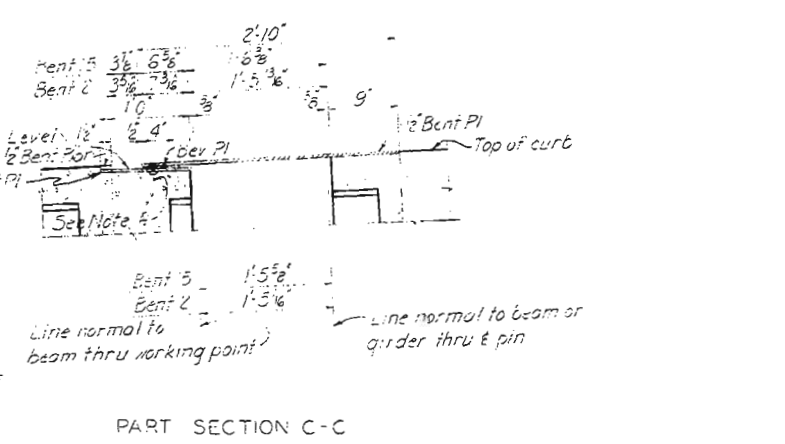

PART SECTION C-C

### EXPANSION DEVICE NOTES

- Expansion devices are shown in normal position of a temperature of 60°F.
- Material marked (A.S.) shall be Low Alloy Steel. All other material shall be Carbon Structural Steel.
- Expansion devices shall be fabricated to fit roadway.
- Flame cutting of finger plates shall be as narrow as practicable and shall not exceed 1/2" in width. A mechanical guide shall be used to guide the cutting torch. All burrs shall be ground smooth.

NEW FAIRFAX BRIDGE  
OVER MISSOURI RIVER  
NEAR KANSAS CITY, KANSAS  
FOR  
PLATTE COUNTY, MISSOURI

ROADWAY EXPANSION DEVICES  
AT BENTS 2, 4, 6 & 15  
SVERDRUP AND PARCEL, INC.  
CONSULTING ENGINEERS  
ST. LOUIS, MO.

FINISHED

Drawn by: J.A. Wise, Jr. April 1956  
Checked by: G.R. Pennington May 1956

Note: Do not scale this drawing. Follow dimensions.

Revision: Δ Revise Expansion Device at Bents 2 & 15. 12-10-56 By J.A.H. Chkd. G.R.P.

SHEET 1 OF 3

AS BUILT DRAWING

FINAL DESIGN DRAWING

A-450  
Platte Co  
Rt. 69

# TRUSS DETAIL NOTES

Material and members marked (A.S.) shall be Low-Alloy Steel. All other material to be Carbon Steel unless otherwise noted.

All rivets to be 7/8" diameter unless otherwise noted. In tension members (6) indicates the number of holes cut to maintain net section. Where "M.N.S." is given, sufficient pitch shall be provided to maintain net section in a staggered chain of holes on the face indicated.

Perforated cover plates shall extend into the joint the minimum number of rivet spaces as shown in joint details.





Provide 8"x16" access holes at about 3'6" centers in both cover plates of lower chord, diagonal members, and in bottom cover plate of end post and upper chord. Holes in vertical members as noted on members.

In members in which both cover plates are perforated, the perforations shall be opposite in the two cover plates of the same member except where otherwise shown near joints.


For diaphragms in truss members between joints, see Sheet 10.

For pipe bracket connection at truss joints, see Sheet 18.

For typical details of ends of cover plates for vertical truss members, see Sheets 18 and 19.

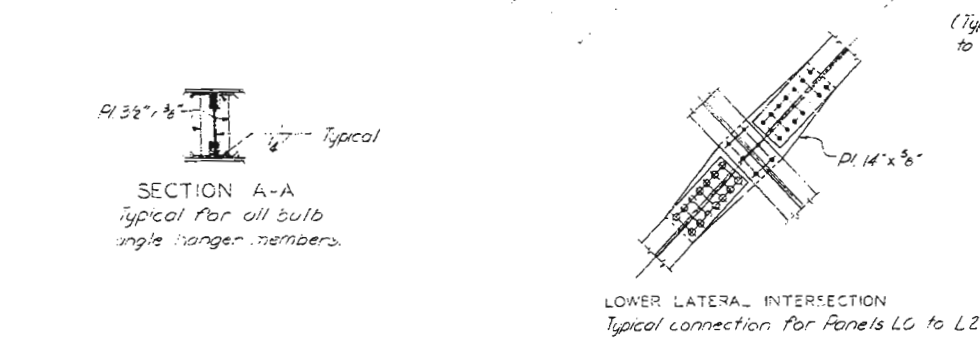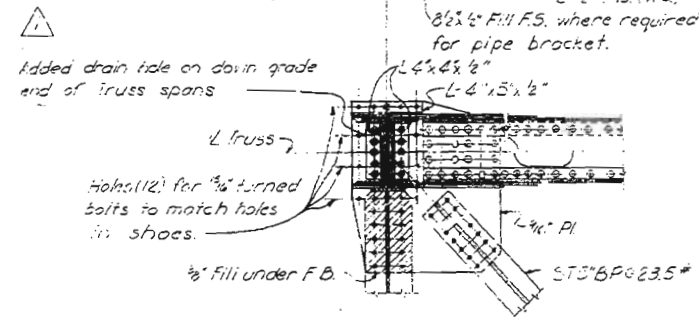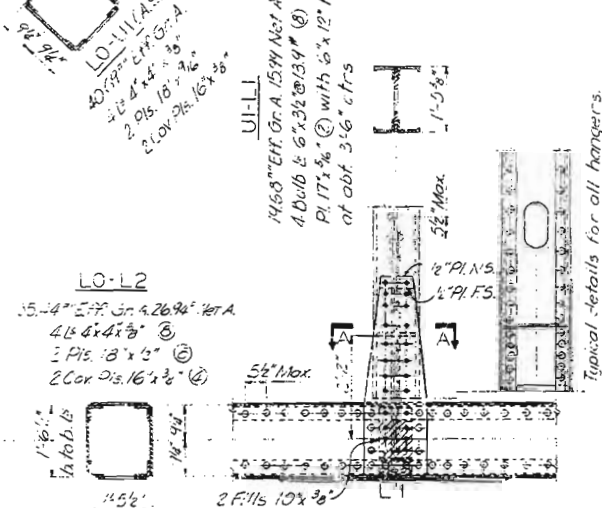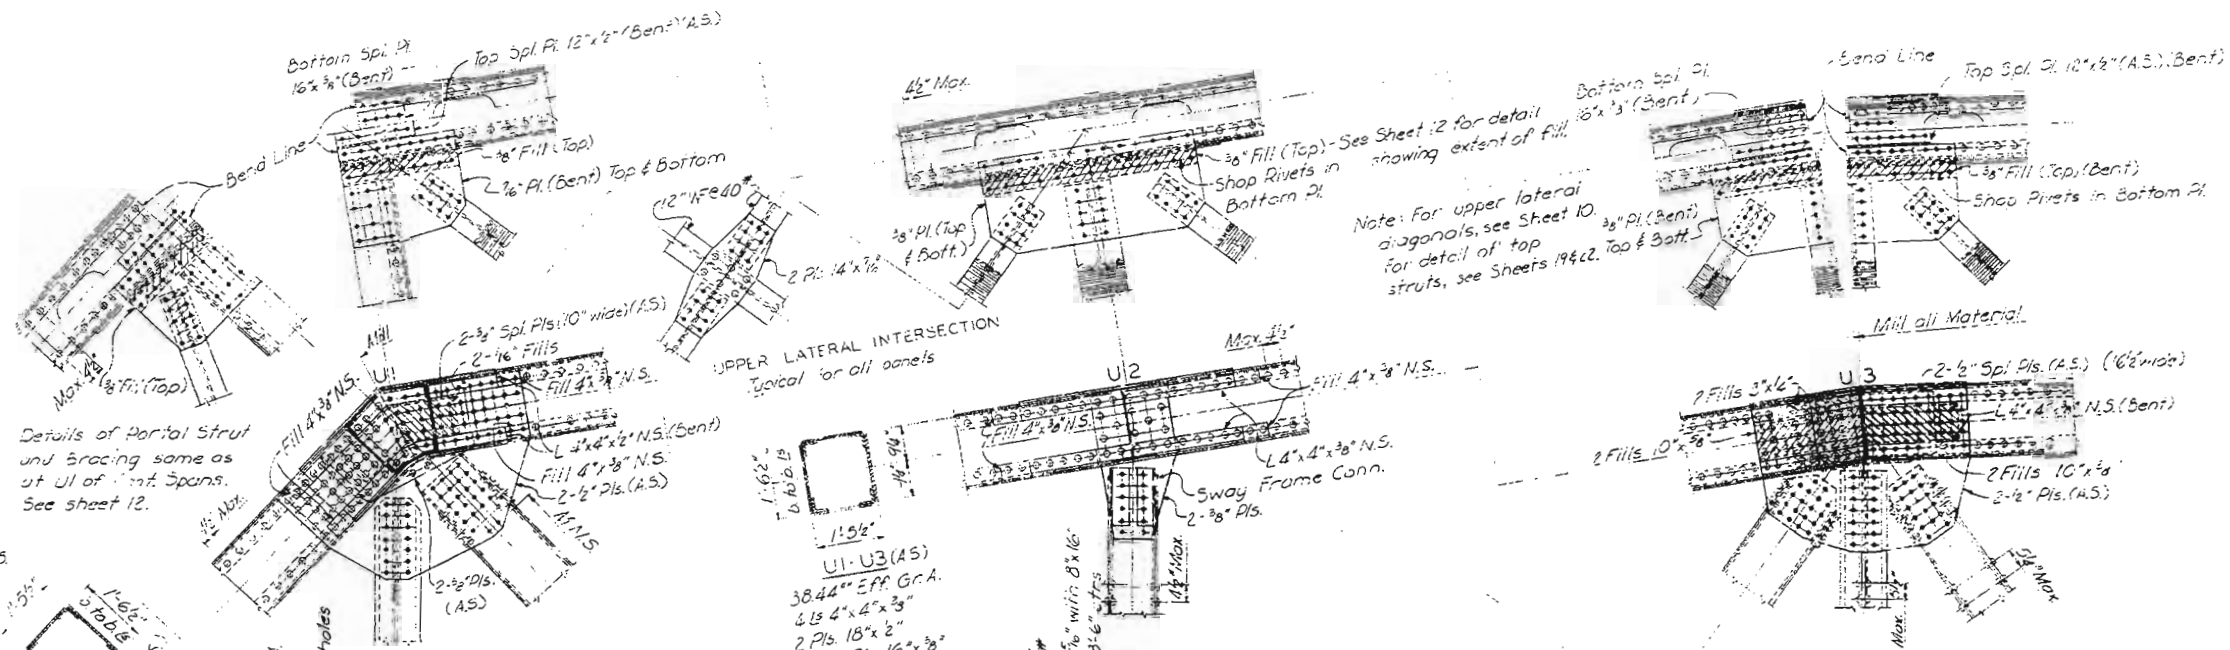

Note: End Floorbeam details to be similar to intermediate floorbeam. Stringer connection and expansion device details not shown. See Sheet 24. Mill gusset plates and diaphragm to bear over shoe cap. Mill jacking stiffeners to bear on floorbeam flanges.

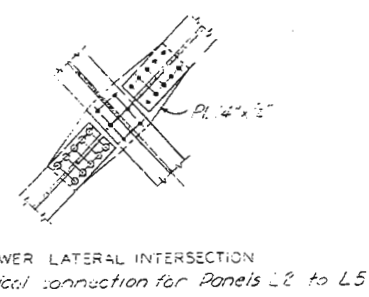

NEW FAIRFAX BRIDGE  
OVER MISSOURI RIVER  
NEAR KANSAS CITY, KANSAS

FOR  
PLATTE COUNTY, MISSOURI

SIMPLE TRUSS SPAN-L0 TO L3

SVERDRUP AND PARCEL, INC.  
CONSULTING ENGINEERS  
ST. LOUIS, MO.

Drawn by: K.L. Fogg, Mar. 1956  
Traced by: R.C. Hunt, April 1956  
Checked by: E. Lemcoe, June 1956

Note: Do not scale this drawing. Follow dimensions.

Revision 1 Joint detail L0 1-21-59 By R.E.B. Check J.E.C.

AS BUILT DRAWING

SHEET 3 OF 11


FINAL DESIGN DRAWING

A-450  
Platte Co.  
Fl. 69



Member	D.L.	L.L.	I.	Trans. Wind 30° Wind			D.L. L.		Arrow in Sails		1/2	Material	
				on Structure	on Structure	on Structure	30° W.	30° W.	Elf. Gr.	Net			
L0-L2	326T	114T	17T	125T	125T	118T	457T	575T	451T	35.44	26.94	—	4L3 4" 4" 3/8"; 2 PIs. 18" 3/4"; 2 Cox. PIs. 16" 3/8"
L2-L4	578T	201T	30T	125T	125T	203T	807T	1012T	786T	39.44	30.44	—	4L3 4" 4" 3/8"; 2 PIs. 18" 3/4"; 2 Cox. PIs. 16" 3/8" A.S.
L4-L6	643T	223T	33T	136T	227T	220T	849T	1191T	870T	48.00	36.50	—	4L3 4" 4" 3/8"; 2 PIs. 18" 3/4"; 2 Cox. PIs. 16" 3/8" A.S.
L0-U1	477C	166C	25C	18C	29C	29C	668C	697C	505C	40.69	—	73	4L3 4" 4" 3/8"; 2 PIs. 18" 3/4"; 2 Cox. PIs. 16" 3/8" A.S.
U1-U3	510C	176C	27C	—	—	—	73C	—	—	38.44	—	50	4L3 4" 4" 3/8"; 2 PIs. 18" 3/4"; 2 Cox. PIs. 16" 3/8" A.S.
U3-U5	640C	222C	33C	—	—	—	895C	—	—	47.44	—	52	4L3 4" 4" 3/8"; 2 PIs. 18" 3/4"; 2 Cox. PIs. 16" 3/8" A.S.
U1-L2	255T	101T	15T	—	—	—	371T	—	—	25.42	20.07	—	2-15 1/8 @ 33.9"; 2 Cox. PIs. 17" 3/8"
L2-U3	133C	66C	10C	—	—	—	209C	—	—	25.42	—	101	2-15 1/8 @ 33.9"; 2 Cox. PIs. 17" 3/8"
U3-L4	104T	61T	10T	—	—	—	175T	—	—	17.68	13.31	—	2-12 3/4 @ 20.7"; 2 Cox. PIs. 17" 3/8"
L4-U5	7C	49C	7C	—	—	—	81C	—	—	25.42	18.47	105	2-15 1/8 @ 33.9"; 2 Cox. PIs. 17" 3/8"
U1-L1	16C	36T	5T	—	—	—	53T	—	—	—	—	—	—
U1-L2	62T	58T	18T	—	—	—	138T	—	—	19.68	15.99	—	4 Bulb Ls 6" 3/8" @ 13.9"; 1 Pl. 17" 3/8"
U3-L3	62T	58T	18T	—	—	—	138T	—	—	19.68	15.99	—	4 Bulb Ls 6" 3/8" @ 13.9"; 1 Pl. 17" 3/8"
U5-L5	62T	58T	18T	—	—	—	138T	—	—	19.68	15.99	—	4 Bulb Ls 6" 3/8" @ 13.9"; 1 Pl. 17" 3/8"
U2-L2	16C	—	—	—	—	—	16C	—	—	17.68	—	86	2-12 3/4 @ 20.7"; 2 Cox. PIs. 17" 3/8"
U4-L4	16C	—	—	—	—	—	16C	—	—	17.68	—	101	2-12 3/4 @ 20.7"; 2 Cox. PIs. 17" 3/8"
Ro	359	134	20	20	34	29	543	572	423	—	—	—	—

Note: All material marked A.S. shall be structural low-alloy steel. All other material to be carbon steel.

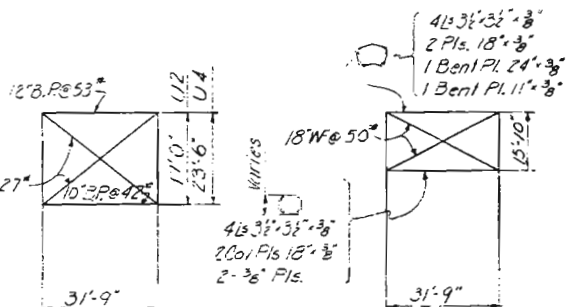


SWAY FRAMES  
U2 & U4

PORTAL LO-UI


Diagram of a Warren truss with vertical dimensions and angles. The truss has a lower chord with nodes L0, L1, L2, L3, L4, and L5. The upper chord has nodes U1, U2, U3, U4, and U5. The vertical height of the truss is 45'-0". The vertical dimensions of the panels are 32'-0" (L0-L1), 42'-0" (L2-L3), and 45'-0" (L4-L5). The angles at the lower chord nodes are 63° (L1), 63° (L2), and 1'-16" (L4). The truss is labeled "Symm. abt. C" (Symmetric about C). The lower chord is labeled "Line thru L0 and L5".

### ELEVATION OF TRUSS

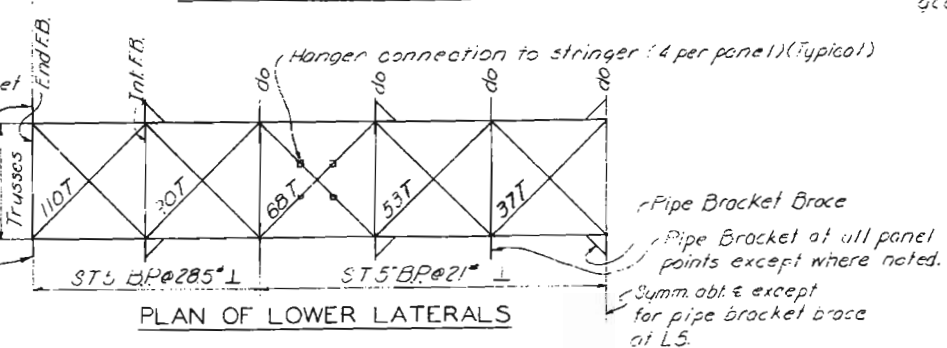

### PLAN OF LOWER LATERALS

✓ Pipe Bracket Brace  
✓ Pipe Bracket at all panel  
points except where noted.  
✓ Summ. obl. & except  
for pipe bracket brace  
at L5.

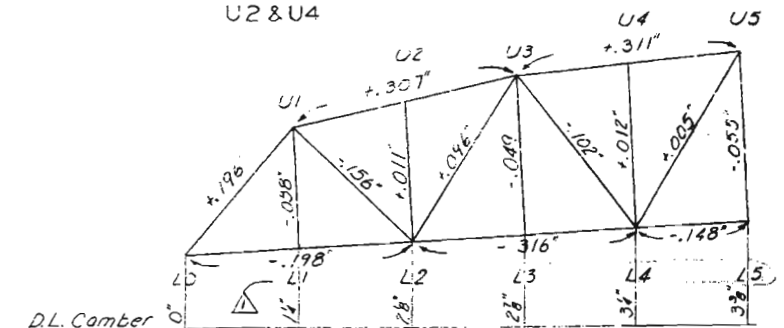

DEAD LOAD DEFLECTION DIAGRAM.

Note: Lengths of members to be computed from geometric shape of truss and the connections indicated are to be applied to these lengths. + indicates lengthening, - indicates shortening. The blocking dimensions given are the position of the lower chord joints above the geometric shape to provide for dead load deflection.

NEW FAIRFAX BRIDGE  
OVER MISSOURI RIVER  
NEAR KANSAS CITY, KANSAS  
FOR  
PLATTE COUNTY, MISSOURI

SIMPLE TRUSS SPAN - L4 TO L5  
& STRESS SHEET

SVERDRUP AND PARCEL, INC.  
CONSULTING ENGINEERS  
ST. LOUIS, MO.

**FINISHED**

A-450  
Plate Co.  
Rt. 69

Note: Do not scale this drawing. Follow dimensions.


Revision  $\Delta$  Panel Point designations. 3-2-56 by: T.V.D., Chkd. E.L. SHEET 9 OF 31

AS BOLT DRAWING


FINAL DESIGN DRAWING

RT-69

Top Lateral Connections  
similar to joint U2.

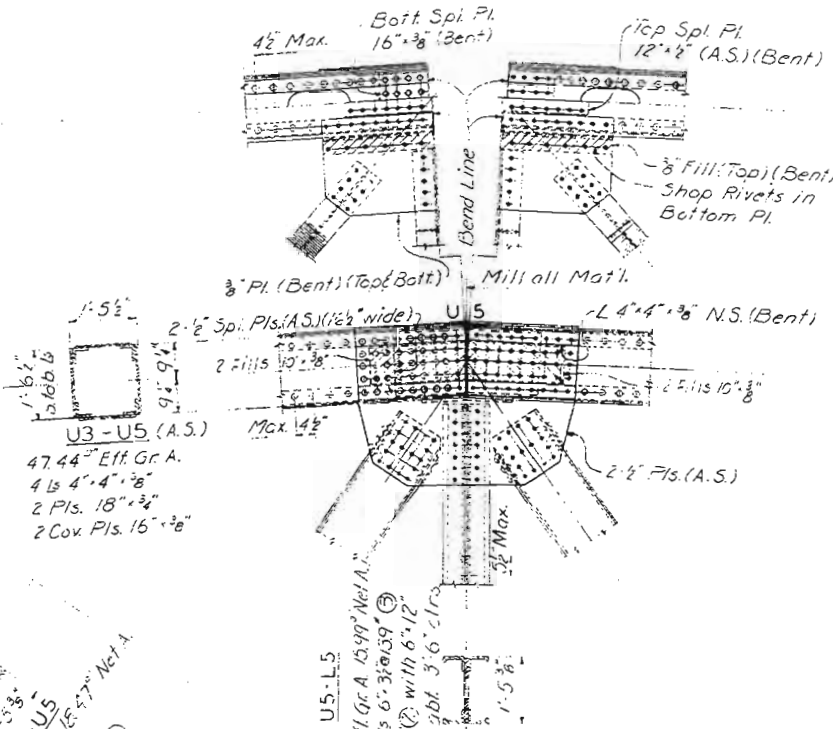


U4  
Joint details similar  
to Joint U2.

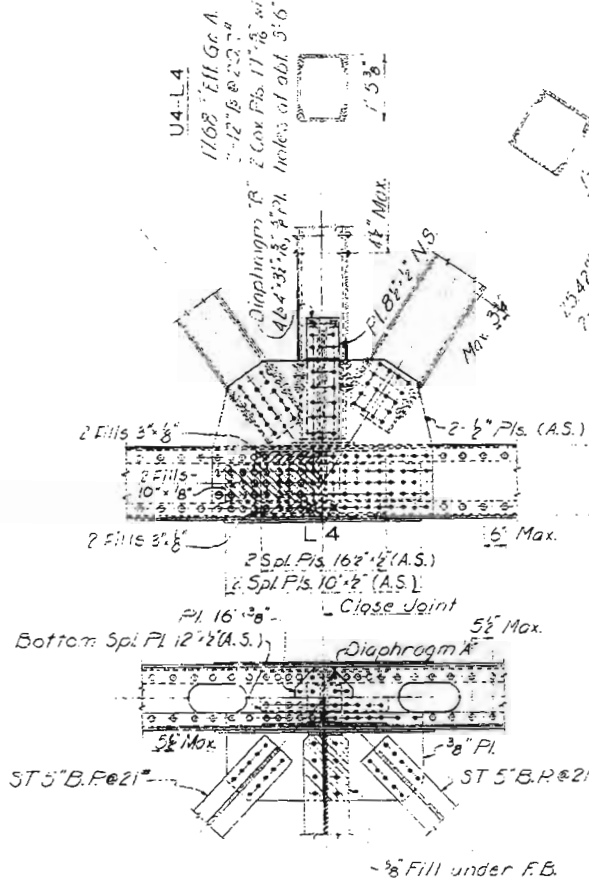

joint details same as L1  
except provide 2" fills  
for chord diaphragm.

Bottom Lateral Connections  
same as at L3

$3\frac{1}{2}"$  - Under D.L. of Steel Only  
 $0"$  - Under Full D.L.  
 $1\frac{1}{2}"$  - Under No Appreciable D.L.  
 & Base slab - 5¢ Pin

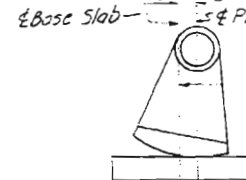

## SHOE SETTINGS

Set shoes as shown at median temperature of 60°F. For temperatures above and below median temperature, increase or decrease the offsets shown above by using coefficient of expansion  $\alpha = 0.000065$ .

Omit Pipe Bracket  
at Piers 8 & 11  
only. --

299'-10 $\frac{3}{4}$ " Span I } to a fixed shoe  
299'-9 $\frac{3}{8}$ " Span II }

Set shoes as shown at median temperature of 60°F. For temperatures above and below median temperature, increase or decrease the offsets shown above by using coefficient of expansion  $\alpha = 0.000065$ .

Drawn by: K.L. Fogg, Mar. 1956  
Traced by: R. Hammer Jr., Apr. 1956  
Checked by: F.L. & T.V.D. June 1956

Note: Do not scale this drawing. Follow dimensions.

Revision  $\Delta$  Panel Point designations. 3-2-56 by: T.V.D., Chkd. E.L. SHEET 9 OF 31

AS BOLT DRAWING

FINAL DESIGN DRAWING

RT-69



# CANTILEVER TRUSS SPANS AND SIMPLE TRUSS SPAN NOTES

DESIGN: In accordance with Division III of the A.A.S.H.O. "Standard Specifications for Highway Bridges," 1953 edition, with the following exceptions and interpretations.

DESIGN LOADING: Roadway Live Loading H20-S16-44 except that the concentrated load to be used in combination with a lane load shall be taken as 26,000 pounds for both shear and moment calculations.

Safety Curb Live Load: None  
Impact: Stringers, Floorbeams, and Hangers: 1-30%

Main members and shoes of Anchor Span: 1-10%

Main members of suspended span: 1-20%

Main members of cantilever arm: 1-15%

Main members of simple span: 1-15%

Dead Load: Provision is made for a future wearing surface of 15 pounds per square foot of roadway surface. Provision is made for future utilities of 630 pounds per foot of bridge in addition to the weight of the structure. Haydite concrete is assumed to weigh 105 pounds per cubic foot.

Wind Load: See General Notes, Sheet 2.

UNIT STRESSES: The normal unit stresses used are as given in the A.A.S.H.O. Standard Specifications.

MATERIALS: All members and materials marked (A.S.) shall be structural low alloy steel; all other material shall be structural carbon steel unless otherwise noted on the detail drawings.


DETAILS: All field connections shall be riveted unless otherwise noted. Where desired for convenience in erection, shop and field rivets may be interchanged. All web plates and cover plates for truss members shall be universal mill plates. All gusset plates shall be cut back not more than 1/4" from the back of chord angles or channels, except as otherwise noted on the detail drawings. Access holes may be flame-cut provided exposed edges are ground smooth.

RIVETS: All rivets shall be of the sizes noted on the detail drawings.

FABRICATION: See Special Provisions.


CAMBER: Trusses shall be cambered for the design dead load including future wearing surface and future utility loads.

ERECTION: Before ordering material, the Contractor shall submit to the Engineer for approval, complete plans showing the method of erection he proposes to use and showing erection stresses in all truss members. Erection stresses shall be composed of the dead load stress of the structure and erection equipment plus the stress from a 30 pound wind on the structure as defined in the A.A.S.H.O. Standard Specifications, and on erection equipment. Erection stresses shall not exceed the normal unit stresses by more than 33 1/3%. No payment will be made for any extra material required due to erection conditions.

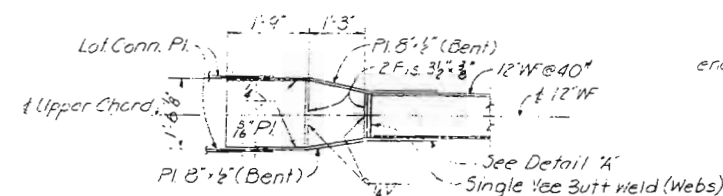


UPPER LATERAL DIAGONALS FOR  
SIMPLE SPANS AND CANTILEVER  
TRUSS SPANS FROM U1 TO U19

For upper laterals on Suspended  
Span, See Sheet 17.

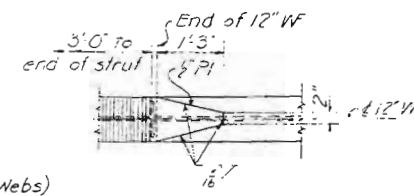

DETAIL "A"

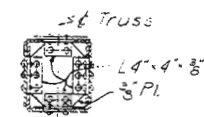

DIAPHRAGM FOR  
COMPRESSION MEMBERS

Typical chord diaphragm shown. Diaphragms for other members similar. Provide two diaphragms per panel at approximate third points in chord members as follows:

Cantilever Truss Spans: Lower chord from L8 to L18

Upper chord from U1 to U11 and from U20 to U22

Simple Truss Spans: Upper chord from U1 to U5

Provide noted number of diaphragms approximately equally spaced in the following members:

Cantilever Truss Spans: L10-U1, L18-U19, L19-U20, and L21-U22 --- 2 req'd. at 3 points

L2-U3, L4-U5, U5-L6, U7-L8, U9-L10,


U11-L12, and L16-U17 --- 3 req'd.

U13-L14, U14-L14 and L14-U15 --- 4 req'd.





Simple Truss Spans: L10-U1 --- 2 req'd. (at 3 points)

L2-U3 and L4-U5 --- 3 req'd.

In members in which the net section is limited, rivets connecting diaphragm to segments are to be arranged to maintain the net section.

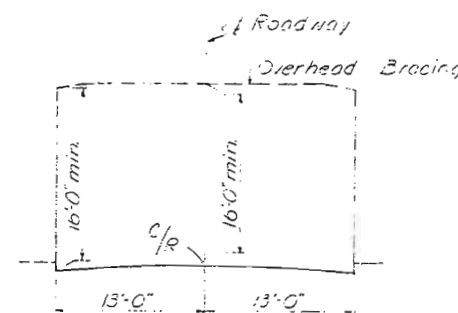

CLEARANCE DIAGRAM

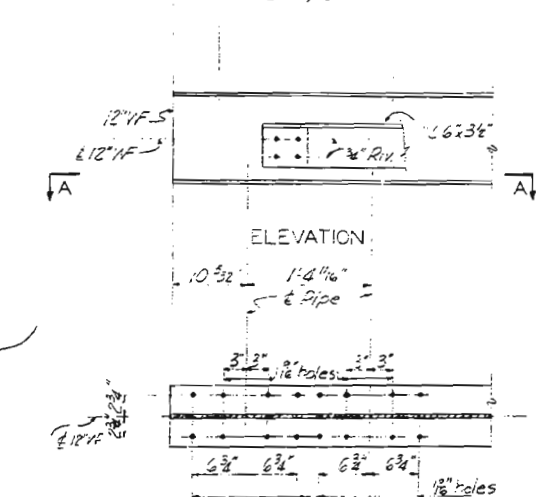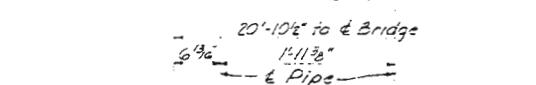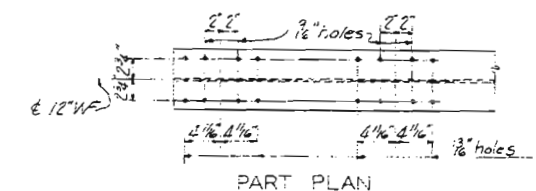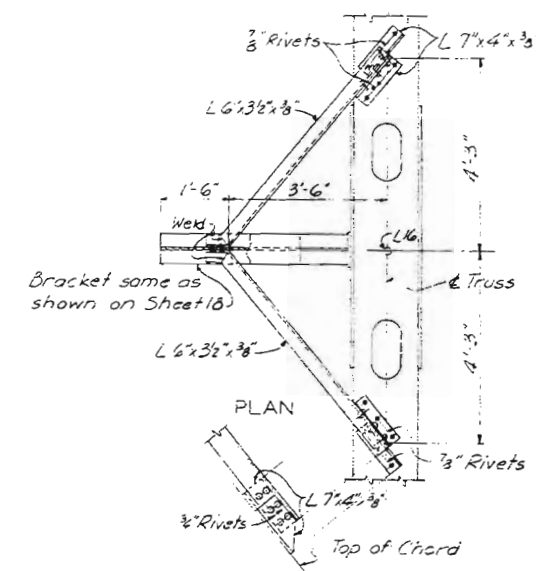

SECTION A-A

PIPE ANCHOR BRACKET AT L16

Holes in flanges of 12\"/>

NEW FAIRFAX BRIDGE  
OVER MISSOURI RIVER  
NEAR KANSAS CITY, KANSAS

FOR  
PLATTE COUNTY, MISSOURI

TRUSS SPAN NOTES &  
MISC. DETAILS

SVERDRUP AND PARCEL, INC.  
CONSULTING ENGINEERS  
ST. LOUIS, MO.

FINISHED

Note: Do not scale this drawing. Follow dimensions.

Revision & Add Pipe Anchor Bracket. B-2-56 By: E.L. Chkd. T.D. SHEET 10 OF 31

A-450


AS BUILT DRAWING

FINAL DESIGN DRAWING



Platte Co.  
Rt. 69

Drawn by R. Hamner Jr., May 1956



Checked by E. Lemcoe, June 1956

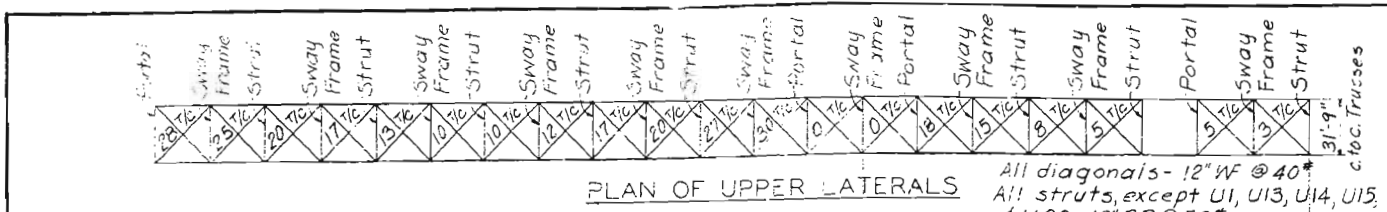

Note: Dimensions of Truss shown are for the geometric shape after calculated deflection has occurred. All posts and hangers are to be on radial lines, except U19-L19 & U19-L14 which shall be truly vertical in the normal position. Chord members to be straight between splice points. All floorbeams to be normal to grade.

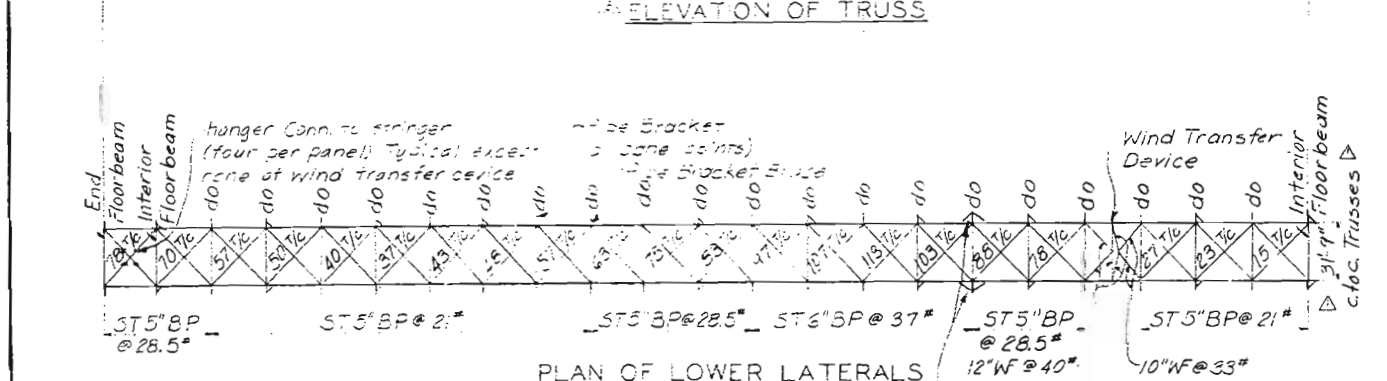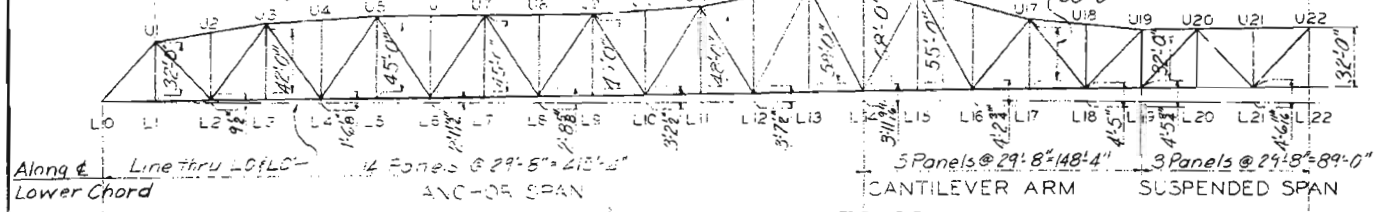

Note: Lengths of members to be computed for geometric shape of truss and the corrections indicated are to be applied to these lengths. + indicates lengthening, - indicates shortening. The blocking dimensions given are the positions of lower chord (L0-L22) above the geometric shape to provide for dead load deflection.

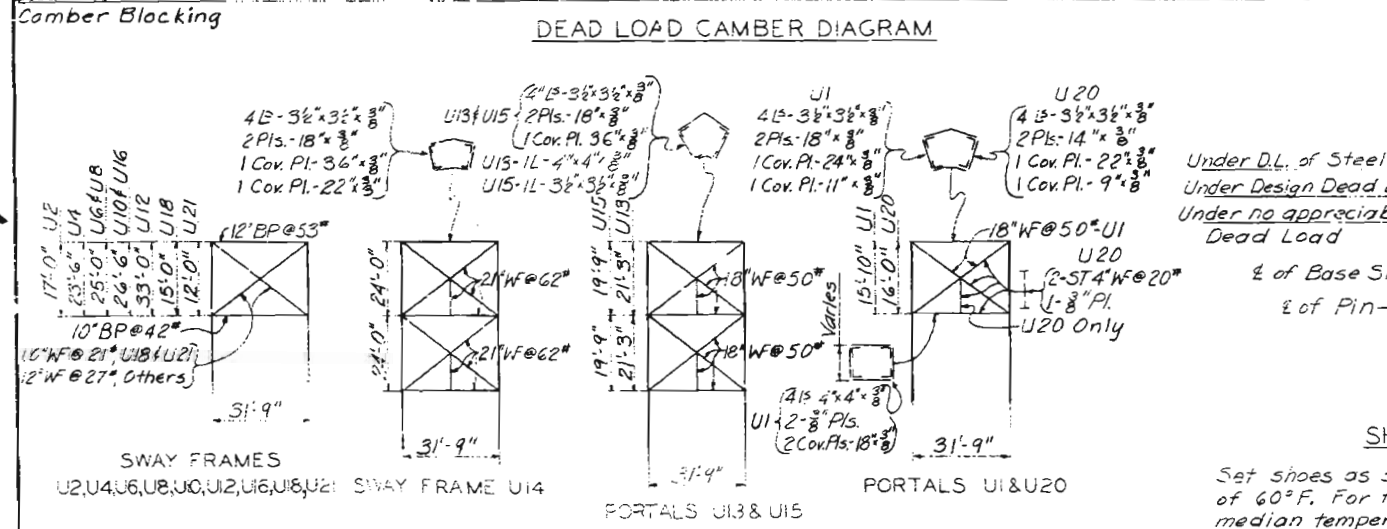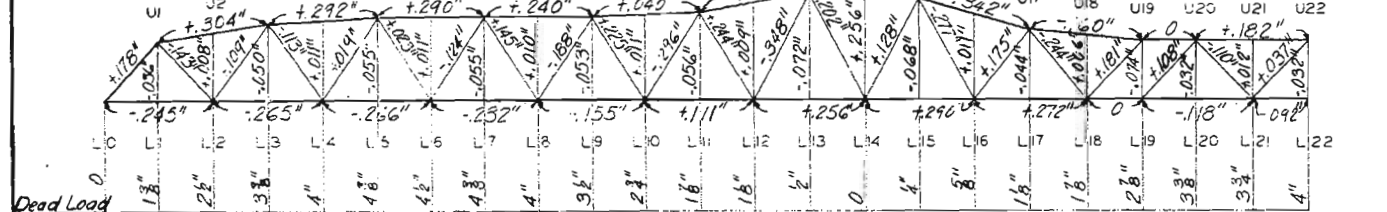

Note: Do not scale this drawing. Follow dimensions.

TABLE OF TRUSS MEMBERS AND STRESSES														
Member	D.L.	L.L.	I.	Trans. Wind on Struct.	30° Wind on Struct.	30° Wind on Struct.	D.L.+I.	D.L.+I.	D.L.+I.	D.L.+I.	Area in sq. in.	furnished	furnished	Material
L0-L2	343T	149T	15T	111T	185T	174T	507T	681T	528T	29.10	22.10	—	—	A.S. 4L3-4"x4"x3/8", 2Pls. 18"x3/8", 2Cov. Pls. 16"x3/8"
L2-L4	620T	289T	29T	183T	305T	307T	938T	1245T	925T	51.44	38.94	—	—	A.S. 4L3-4"x4"x3/8", 2Pls. 18"x3/8", 2Cov. Pls. 16"x3/8"
L4-L6	706T	324T	37T	234T	390T	391T	1127T	1503T	1096T	58.94	44.94	—	—	A.S. 4L3-4"x4"x3/8", 2Pls. 18"x3/8", 2Cov. Pls. 16"x3/8"
L6-L8	617T	402T	40T	246T	410T	412T	1059T	1471T	1027T	58.94	44.94	—	—	A.S. 4L3-4"x4"x3/8", 2Pls. 18"x3/8", 2Cov. Pls. 16"x3/8"
L8-L10	311T	369T	37T	237T	393T	394T	743T	1111T	704T	43.90	33.00	—	—	A.S. 4L3-4"x4"x3/8", 2Pls. 18"x3/8", 2Cov. Pls. 16"x3/8"
L10-L12	175C	346C	35C	256C	426C	426C	628C	950C	621C	37.69	28.69	—	—	A.S. 4L3-4"x4"x3/8", 2Pls. 18"x3/8", 2Cov. Pls. 16"x3/8"
L12-L14	735C	339C	34C	295C	491C	434C	1108C	1542C	1226C	63.94	—	—	—	A.S. 4L3-4"x4"x3/8", 2Pls. 18"x3/8", 2Cov. Pls. 16"x3/8"
L14-L16	830C	286C	43C	244C	440C	395C	1159C	1554C	1270C	63.94	—	—	—	A.S. 4L3-4"x4"x3/8", 2Pls. 18"x3/8", 2Cov. Pls. 16"x3/8"
L16-L18	479C	174C	22C	118C	497C	170C	728C	843C	676C	37.69	—	—	—	A.S. 4L3-4"x4"x3/8", 2Pls. 18"x3/8", 2Cov. Pls. 16"x3/8"
L18-L20	505C	221C	22C	26C	43C	44C	748C	792C	543C	27.44	—	—	—	A.S. 4L3-4"x4"x3/8", 2Pls. 18"x3/8", 2Cov. Pls. 16"x3/8"
L20-L22	539C	243C	24C	—	—	—	806C	—	—	40.69	—	—	—	A.S. 4L3-4"x4"x3/8", 2Pls. 18"x3/8", 2Cov. Pls. 16"x3/8"
U1-U3	693C	340C	24C	—	—	—	1067C	—	—	54.44	—	—	—	A.S. 4L3-4"x4"x3/8", 2Pls. 18"x3/8", 2Cov. Pls. 16"x3/8"
U3-U5	689C	393C	39C	—	—	—	1121C	—	—	54.44	—	—	—	A.S. 4L3-4"x4"x3/8", 2Pls. 18"x3/8", 2Cov. Pls. 16"x3/8"
U5-U7	491C	393C	39C	—	—	—	923C	—	—	46.50	—	—	—	A.S. 4L3-4"x4"x3/8", 2Pls. 18"x3/8", 2Cov. Pls. 16"x3/8"
U7-U9	76C	318C	32C	—	—	—	573C	—	—	42.94	—	—	—	A.S. 4L3-4"x4"x3/8", 2Pls. 18"x3/8", 2Cov. Pls. 16"x3/8"
U9-U11	688C	329T	33T	—	—	—	441T	—	—	40.69	—	—	—	A.S. 4L3-4"x4"x3/8", 2Pls. 18"x3/8", 2Cov. Pls. 16"x3/8"
U11-U13	472T	348T	35T	—	—	—	655T	—	—	40.69	—	—	—	A.S. 4L3-4"x4"x3/8", 2Pls. 18"x3/8", 2Cov. Pls. 16"x3/8"
U13-U15	983T	329T	33T	—	—	—	1345T	—	—	64.44	—	—	—	A.S. 4L3-4"x4"x3/8", 2Pls. 18"x3/8", 2Cov. Pls. 16"x3/8"
U15-U17	1017T	340T	51T	—	—	—	1408T	—	—	64.44	—	—	—	A.S. 4L3-4"x4"x3/8", 2Pls. 18"x3/8", 2Cov. Pls. 16"x3/8"
U17-U19	687T	243T	36T	—	—	—	328T	—	—	36.00	—	—	—	A.S. 4L3-4"x4"x3/8", 2Pls. 18"x3/8", 2Cov. Pls. 16"x3/8"
U19-U21	229T	86T	13T	—	—	—	430T	—	—	30.58	—	—	—	A.S. 4L3-4"x4"x3/8", 2Pls. 18"x3/8", 2Cov. Pls. 16"x3/8"
U21-U23	277T	139T	14T	—	—	—	272C	—	—	25.44	—	—	—	A.S. 4L3-4"x4"x3/8", 2Pls. 18"x3/8", 2Cov. Pls. 16"x3/8"
L2-U3	153C	108C	11C	—	—	—	243C	—	—	18.81	—	—	—	A.S. 4L3-4"x4"x3/8", 2Pls. 18"x3/8", 2Cov. Pls. 16"x3/8"
U3-L4	25C	88C	9C	—	—	—	153C	—	—	25.42	—	—	—	A.S. 4L3-4"x4"x3/8", 2Pls. 18"x3/8", 2Cov. Pls. 16"x3/8"
L4-U5	23C	77T	8T	—	—	—	93T	—	—	25.42	—	—	—	A.S. 4L3-4"x4"x3/8", 2Pls. 18"x3/8", 2Cov. Pls. 16"x3/8"
U5-L6	31C	88C	9C	—	—	—	154C	—	—	25.42	—	—	—	A.S. 4L3-4"x4"x3/8", 2Pls. 18"x3/8", 2Cov. Pls. 16"x3/8"
L6-U7	28C	76T	8T	—	—	—	84T	—	—	25.42	—	—	—	A.S. 4L3-4"x4"x3/8", 2Pls. 18"x3/8", 2Cov. Pls. 16"x3/8"
U7-L8	131T	106T	11T	—	—	—	248T	—	—	8.81	—	—	—	A.S. 4L3-4"x4"x3/8", 2Pls. 18"x3/8", 2Cov. Pls. 16"x3/8"
L8-U9	229C	116C	12C	—	—	—	357C	—	—	30.15	—	—	—	A.S. 4L3-4"x4"x3/8", 2Pls. 18"x3/8", 2Cov. Pls. 16"x3/8"
U9-L10	327T	132T	13T	—	—	—	472T	—	—	30.15	—	—	—	A.S. 4L3-4"x4"x3/8", 2Pls. 18"x3/8", 2Cov. Pls. 16"x3/8"
L10-U11	428C	149C	15C	—	—	—	592C	—	—	37.69	—	—	—	A.S. 4L3-4"x4"x3/8", 2Pls. 18"x3/8", 2Cov. Pls. 16"x3/8"
U11-L12	514T	168T	17T	—	—	—	701T	—	—	37.69	—	—	—	A.S. 4L3-4"x4"x3/8", 2Pls. 18"x3/8", 2Cov. Pls. 16"x3/8"
L12-U13	535C	168C	17C	—	—	—	700C	—	—	43.50	—	—	—	A.S. 4L3-4"x4"x3/8", 2Pls. 18"x3/8", 2Cov. Pls. 16"x3/8"
U13-L14	431C	182C	18C	—	—	—	795T	—	—	37.69	—	—	—	A.S. 4L3-4"x4"x3/8", 2Pls. 18"x3/8", 2Cov. Pls. 16"x3/8"
L14-U15	214C	179C	18C	—	—	—	631C	—	—	37.69	—	—	—	A.S. 4L3-4"x4"x3/8", 2Pls. 18"x3/8", 2Cov. Pls. 16"x3/8"
U15-L16	358T	128T	19T	—	—	—	505T	—	—	37.69	—	—	—	A.S. 4L3-4"x4"x3/8", 2Pls. 18"x3/8", 2Cov. Pls. 16"x3/8"
L16-U17	294C	110C	17C	—	—	—	421C	—	—	24.02	—	—	—	A.S. 4L3-4"x4"x3/8", 2Pls. 18"x3/8", 2Cov. Pls. 16"x3/8"
U17-L18	409T	144T	22T	—	—	—	575T	—	—	24.02	—	—	—	A.S. 4L3-4"x4"x3/8", 2Pls. 18"x3/8", 2Cov. Pls. 16"x3/8"
L18-U19	336C	126C	19C	—	—	—	481C	—	—	24.02	—	—	—	A.S. 4L3-4"x4"x3/8", 2Pls. 18"x3/8", 2Cov. Pls. 16"x3/8"
U19-L20	60T	58T	17T	—	—	—	135T	—	—	19.68	—	—	—	A.S. 4L3-4"x4"x3/8", 2Pls. 18"x3/8", 2Cov. Pls. 16"x3/8"
L20-U21	11C	11C	—	—	—	—	11C	—	—	17.68	—	—	—	A.S. 4L3-4"x4"x3/8", 2Pls. 18"x3/8", 2Cov. Pls. 16"x3/8"
U21-L22	63T	58T	17T	—	—	—	135T	—	—	17.68	—	—	—	A.S. 4L3-4"x4"x3/8", 2Pls. 18"x3/8", 2Cov. Pls. 16"x3/8"
L22-U23	13C	13C	—	—	—	—	13C	—	—	17.68	—	—	—	A.S. 4L3-4"x4"x3/8", 2Pls. 18"x3/8", 2Cov. Pls. 16"x3/8"
U23-L24	64T	58T	17T	—	—	—	139T	—	—	17.68	—	—	—	A.S. 4L3-4"x4"x3/8", 2Pls. 18"x3/8", 2Cov. Pls. 16"x3/8"
L24-U25	13C	13C	—	—	—	—	13C	—	—	17.68	—	—	—	A.S. 4L3-4"x4"x3/8", 2Pls. 18"x3/8", 2Cov. Pls. 16"x3/8"
U25-L26	64T	58T	17T	—	—	—	139T	—	—	17.68	—	—	—	A.S. 4L3-4"x4"x3/8", 2Pls. 18"x3/8", 2Cov. Pls. 16"x3/8"
L26-U27	12C	12C	—	—	—	—	12C	—	—	17.68	—	—	—	A.S. 4L3-4"x4"x3/8", 2Pls. 18"x3/8", 2Cov. Pls. 16"x3/8"
U27-L28	62T	58T	17T	—	—	—	137T	—	—	17.68	—	—	—	A.S. 4L3-4"x4"x3/8", 2Pls. 18"x3/8", 2Cov. Pls. 16"x3/8"
L28-U29	12C	12C	—	—	—	—	12C	—	—	17.68	—	—	—	A.S. 4L3-4"x4"x3/8", 2Pls. 18"x3/8", 2Cov. Pls. 16"x3/8"
U37-L38	256T	91T	30T	—	—	—	377T	—	—	40.34	—	—	—	A.S. 4L3-4"x4"x3/8", 2Pls. 18"x3/8", 2Cov. Pls. 16"x3/8"
L38-U39	169T	70T	14T	—	—	—	253T	—	—	30.58	—	—	—	A.S. 4L3-4"x4"x3/8", 2Pls. 18"x3/8", 2Cov. Pls. 16"x3/8"
L39-U40	304T	126T	25T	—	—	—	455T	—	—	38.17	—	—	—	A.S. 4L3-4"x4"x3/8", 2Pls. 18"x3/8", 2Cov. Pls. 16"x3/8"
U40-L41	243C	103C	21C	—	—	—	372C	—	—	36.03	—	—	—	A.S. 4L3-4"x4"x3/8", 2Pls. 18"x3/8", 2Cov. Pls. 16"x3/8"
L41-U42	270C	112C	23C	—	—	—	405C	—	—	33.16	—	—	—	A.S. 4L3-4"x4"x3/8", 2Pls. 18"x3/8", 2Cov. Pls. 16"x3/8"
U42-L43	149T	73T	15T	—	—	—	237T	—	—	20.24	—	—	—	A.S. 4L3-4"x4"x3/8", 2Pls. 18"x3/8", 2Cov. Pls. 16"x3/8"
L43-U44	50C	48C	10C	—	—	—	108C	—	—	19.68	—	—	—	A.S. 4L3-4"x4"x3/8", 2Pls. 18"x3/8", 2Cov. Pls. 16"x3/8"
U44-L45	53T	58T	17T	—	—	—	128T	—	—	17.68	—	—	—	A.S. 4L3-4"x4"x3/8", 2Pls. 18"x3/8", 2Cov. Pls. 16"x3/8"
L45-U46	11C	11C	—	—	—	—	11C	—	—	17.68	—	—	—	A.S. 4L3-4"x4"x3/8", 2Pls. 18"x3/8", 2Cov. Pls. 16"x3/8"
U46-L47	53T	58T	17T	—	—	—	128T	—	—	17.68	—	—	—	A.S. 4L3-4"x4"x3/8", 2Pls. 18"x3/8", 2Cov. Pls. 16"x3/8"
L47-U48	409	174	30	50	42	600	642	459	—	—	—	—	—	—
U48-L49	1415	391	39	127	212	17	945	2000	1627	—	—	—	—	—

Stresses are given in kips. + = tension and - = compression. All members marked A.S. shall be structural low alloy steel. All others to be structural carbon steel.

Under D.L. of Steel only  
Under Design Dead Load  
Under no appreciable Dead Load

45° 38" to & Fixed Shoe - Span 8.  
45° 38" to & Fixed Shoe - Span 10.


SHOE SETTINGS

Set shoes as shown at median temperature of 60°F. For temperature above and below median temperature, increase or decrease the offsets given above, using coefficient of expansion,  $\alpha = 0.000065$ .














SHOE REACTIONS  
(D.L. + 50° Trans. Wind + 20° Vertical Wind)

	L0 or L0'	L14 or L14'
Dead Load	413	1426
50° Trans. Wind	± 59	± 232
20° Vert. Wind	-103	-249
Reaction	Max. 472	1658
	Min. 251	945

Revisions:  
Revision A Anchor Span Dimension 8-22-56 by E.L. Chkd. M.C.W.  
Revision B Pipe Anchor Brkt. at L16 8-2-56 by T.S. Chkd. E.L.  
Revision C Pipe Support Brace at L22 6-22-56 by G

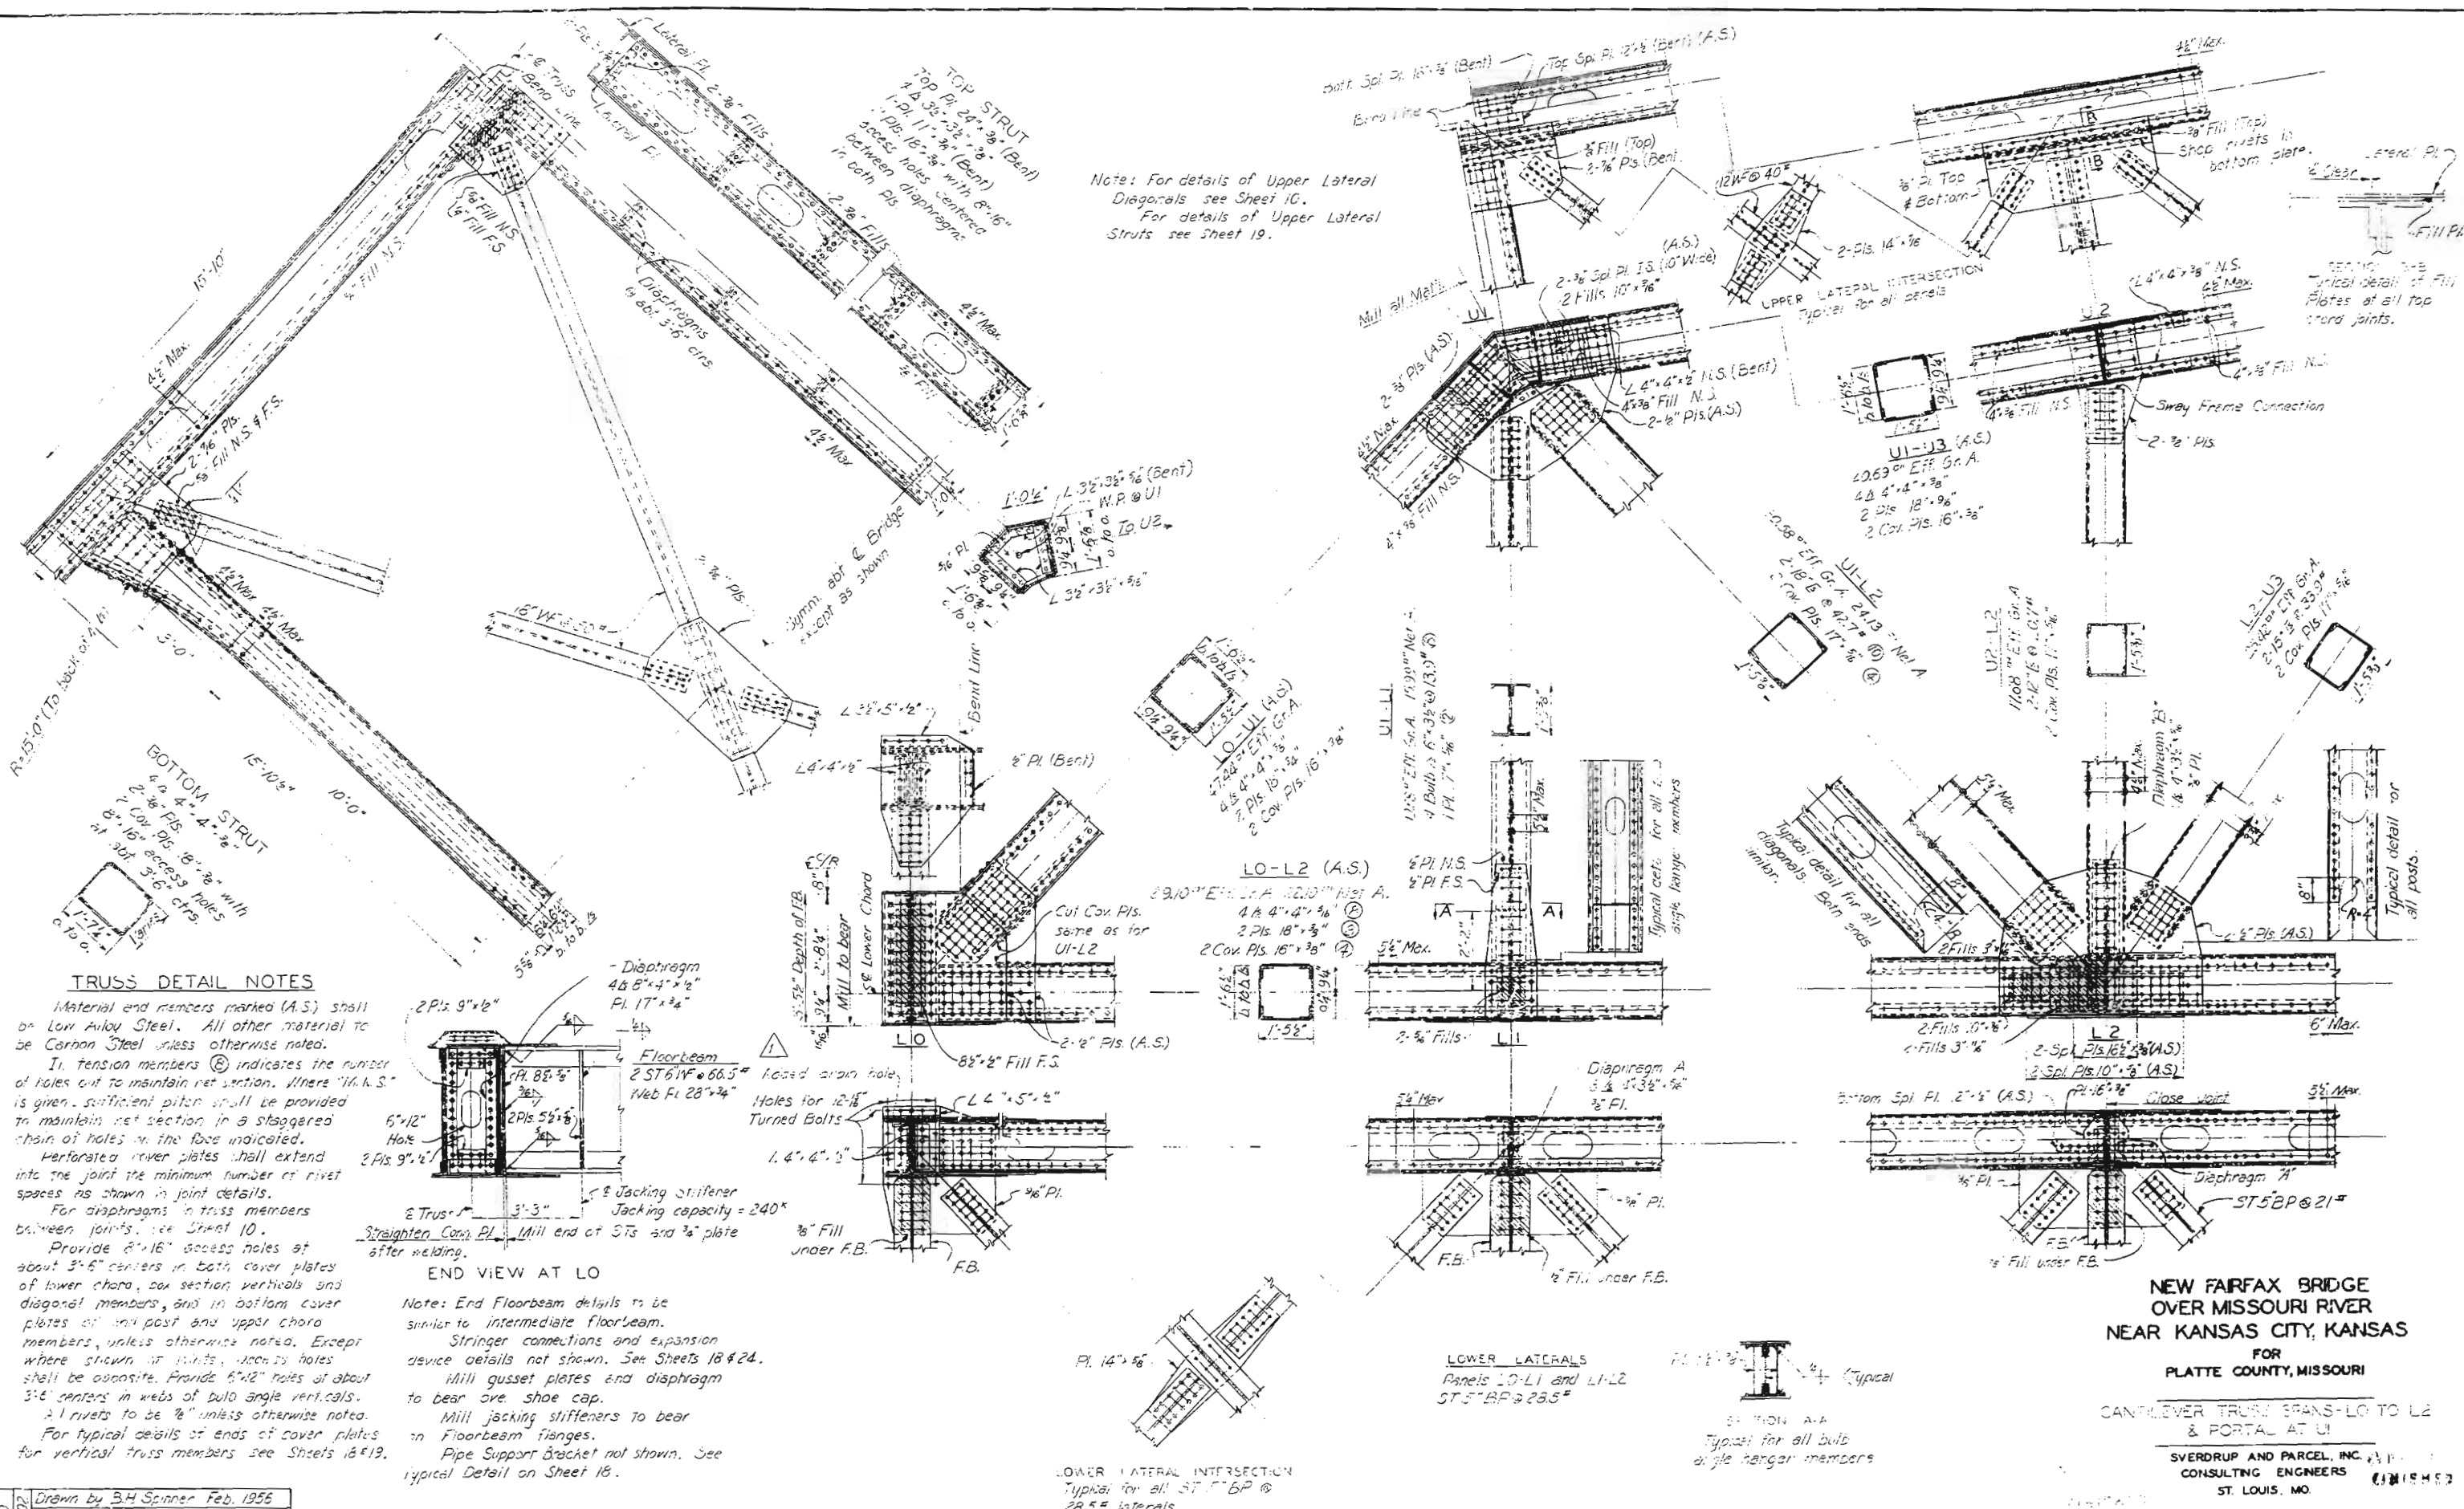




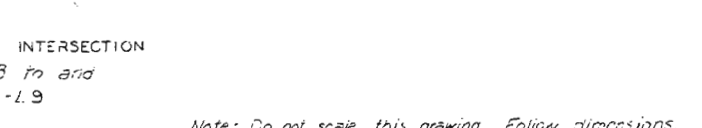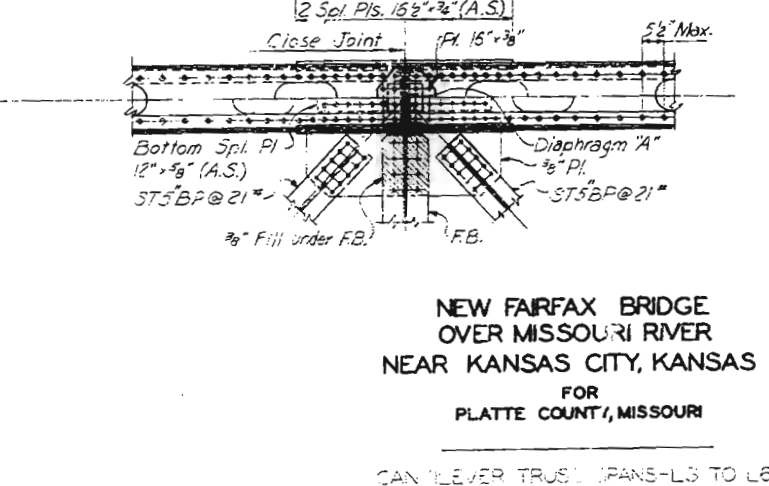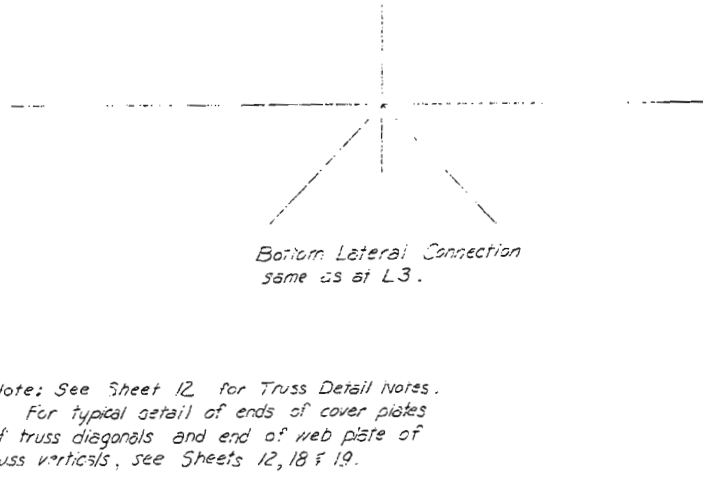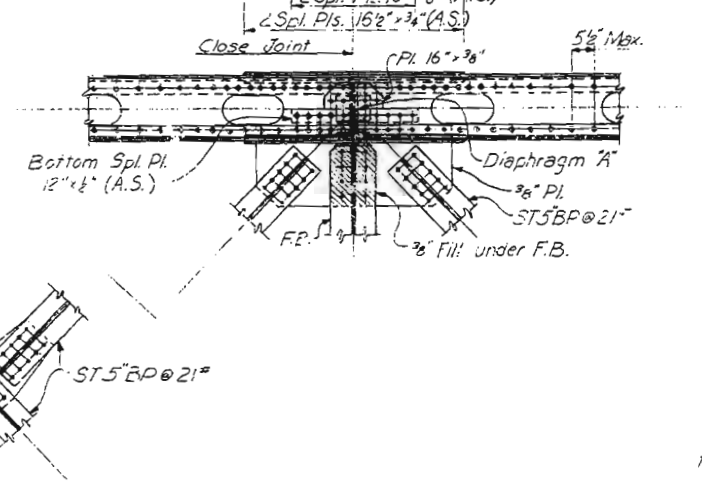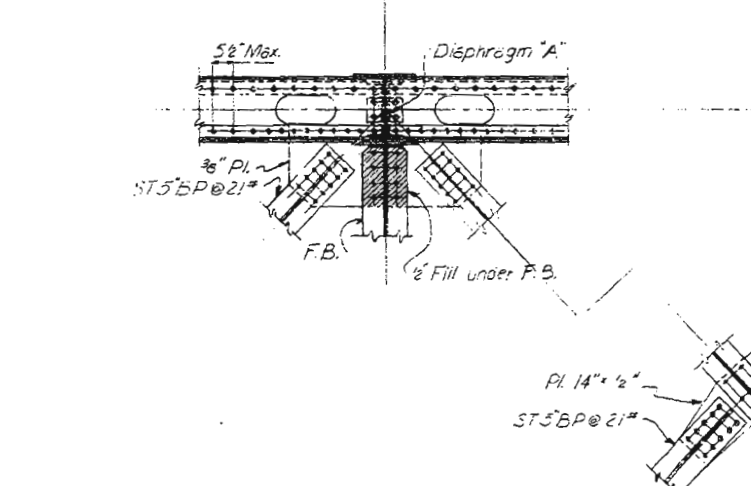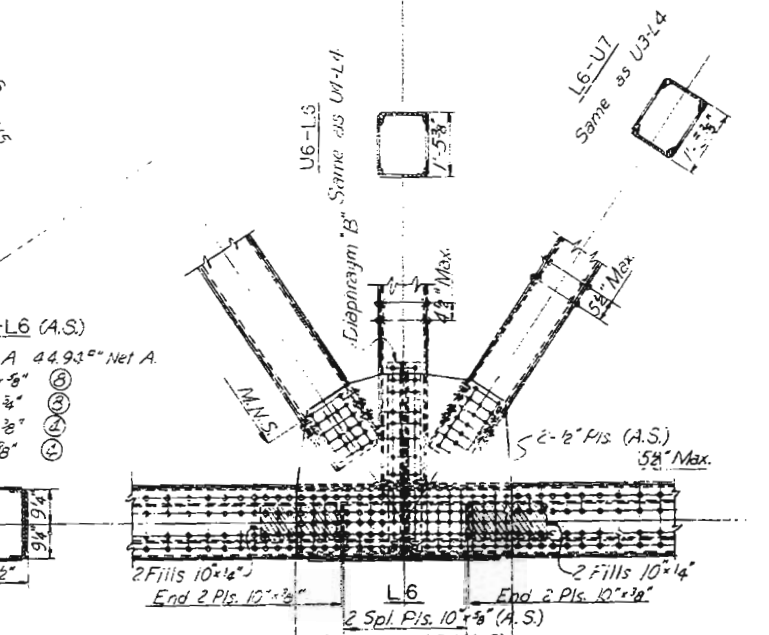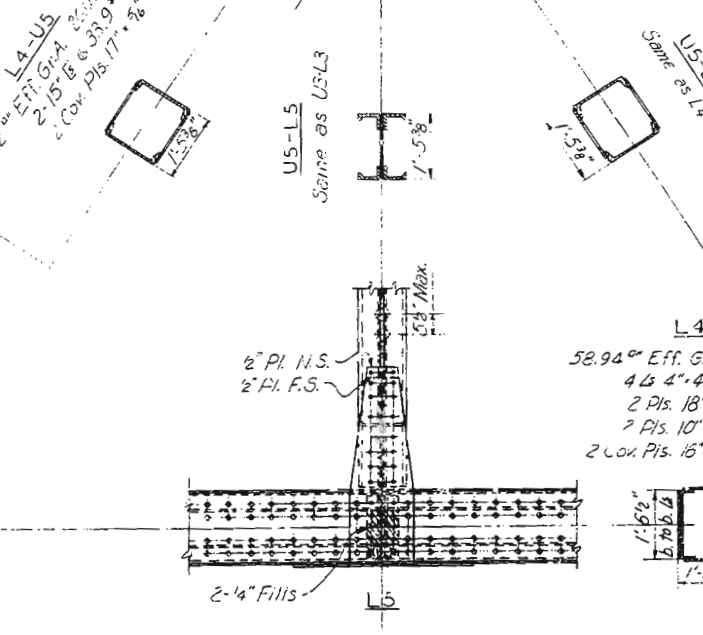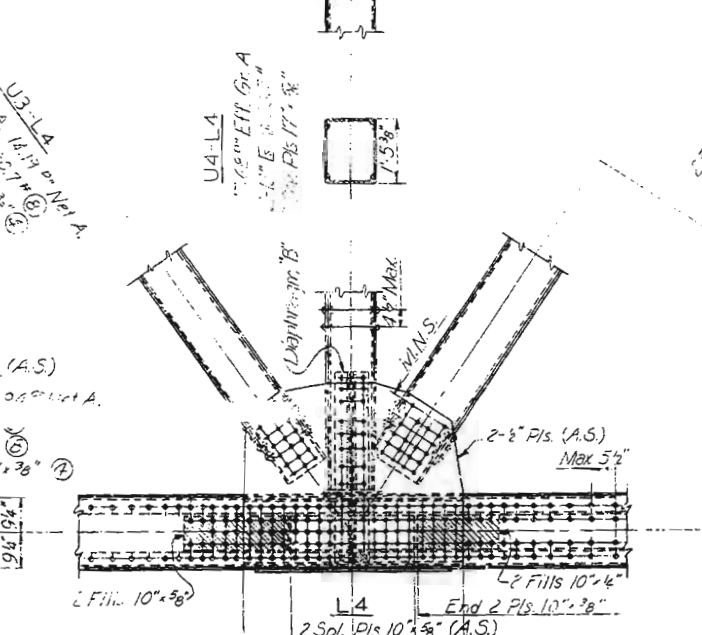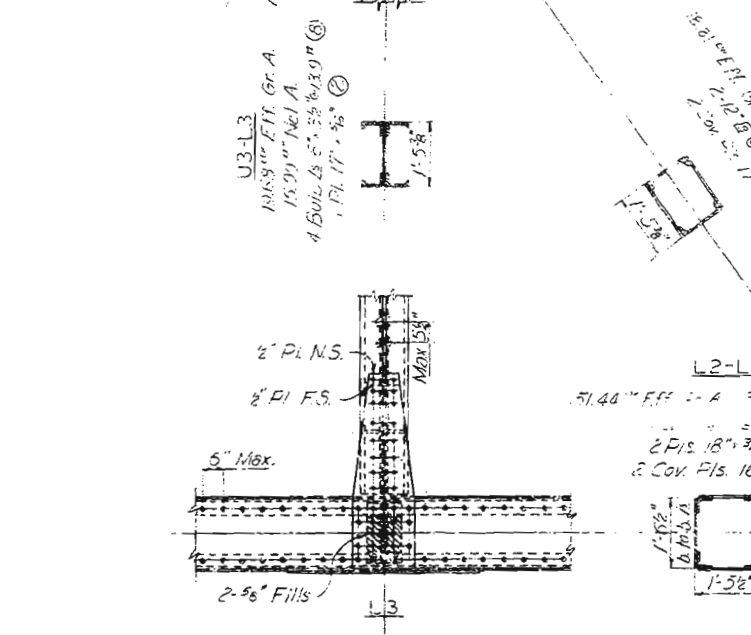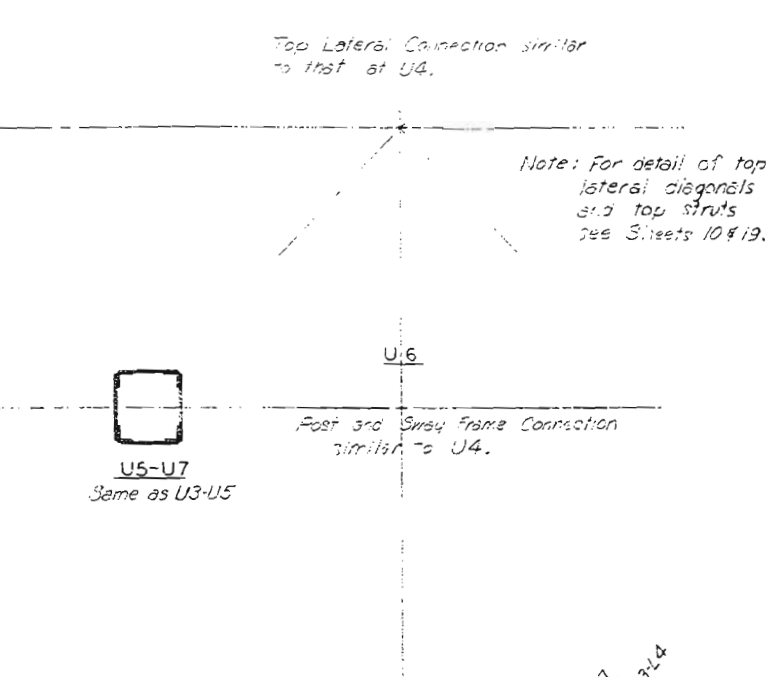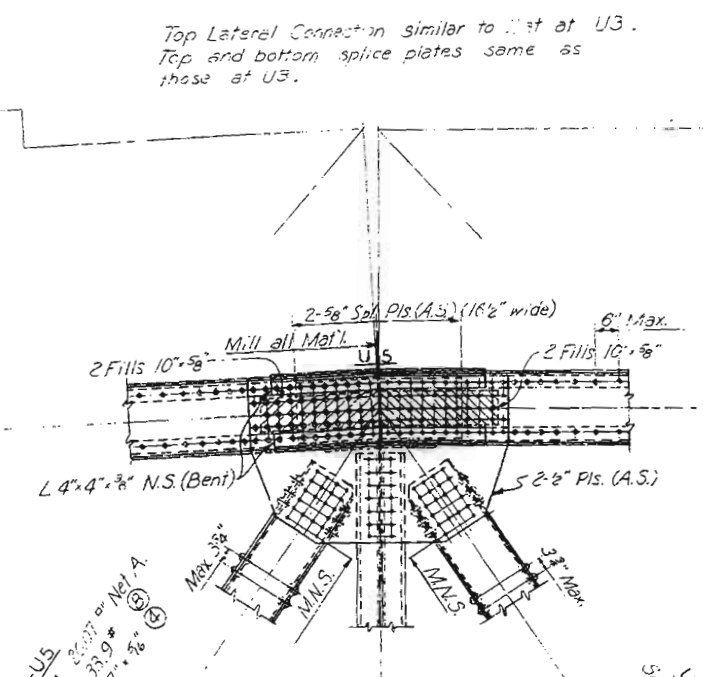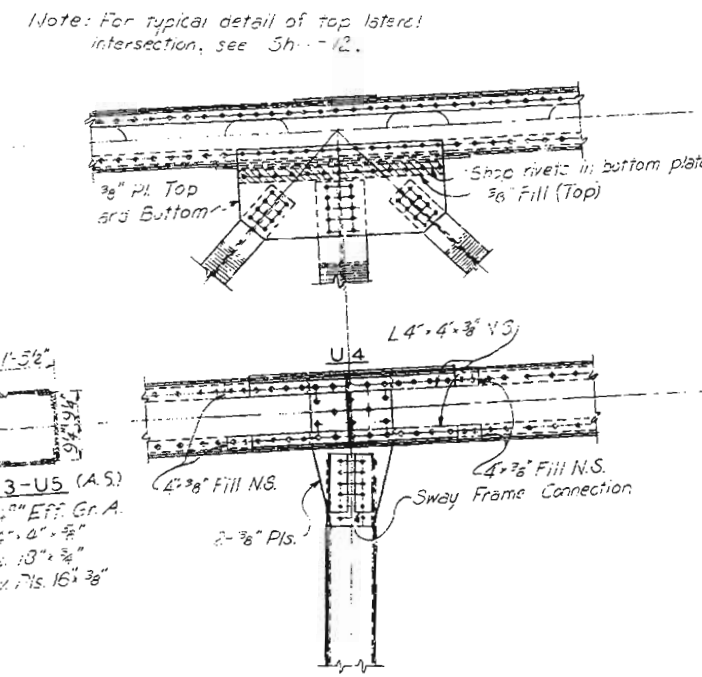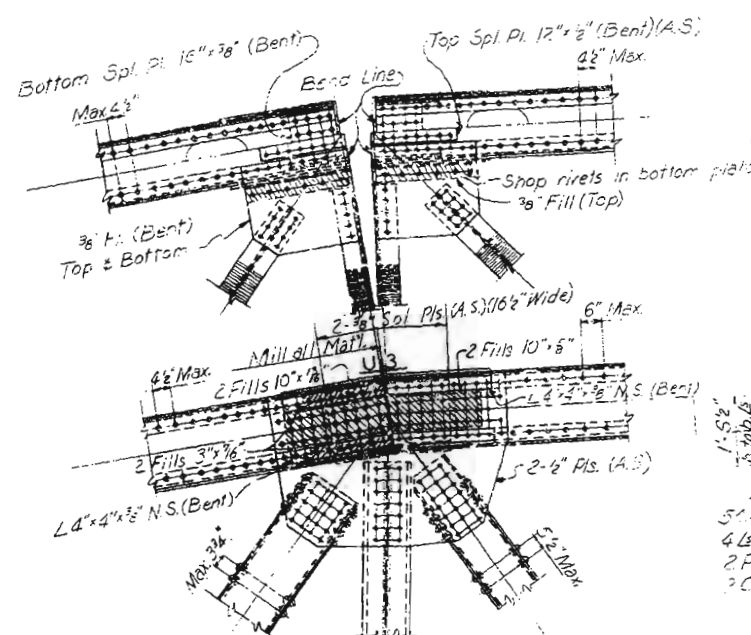






Note: For typical detail of top lateral intersection, see Sheet 12.

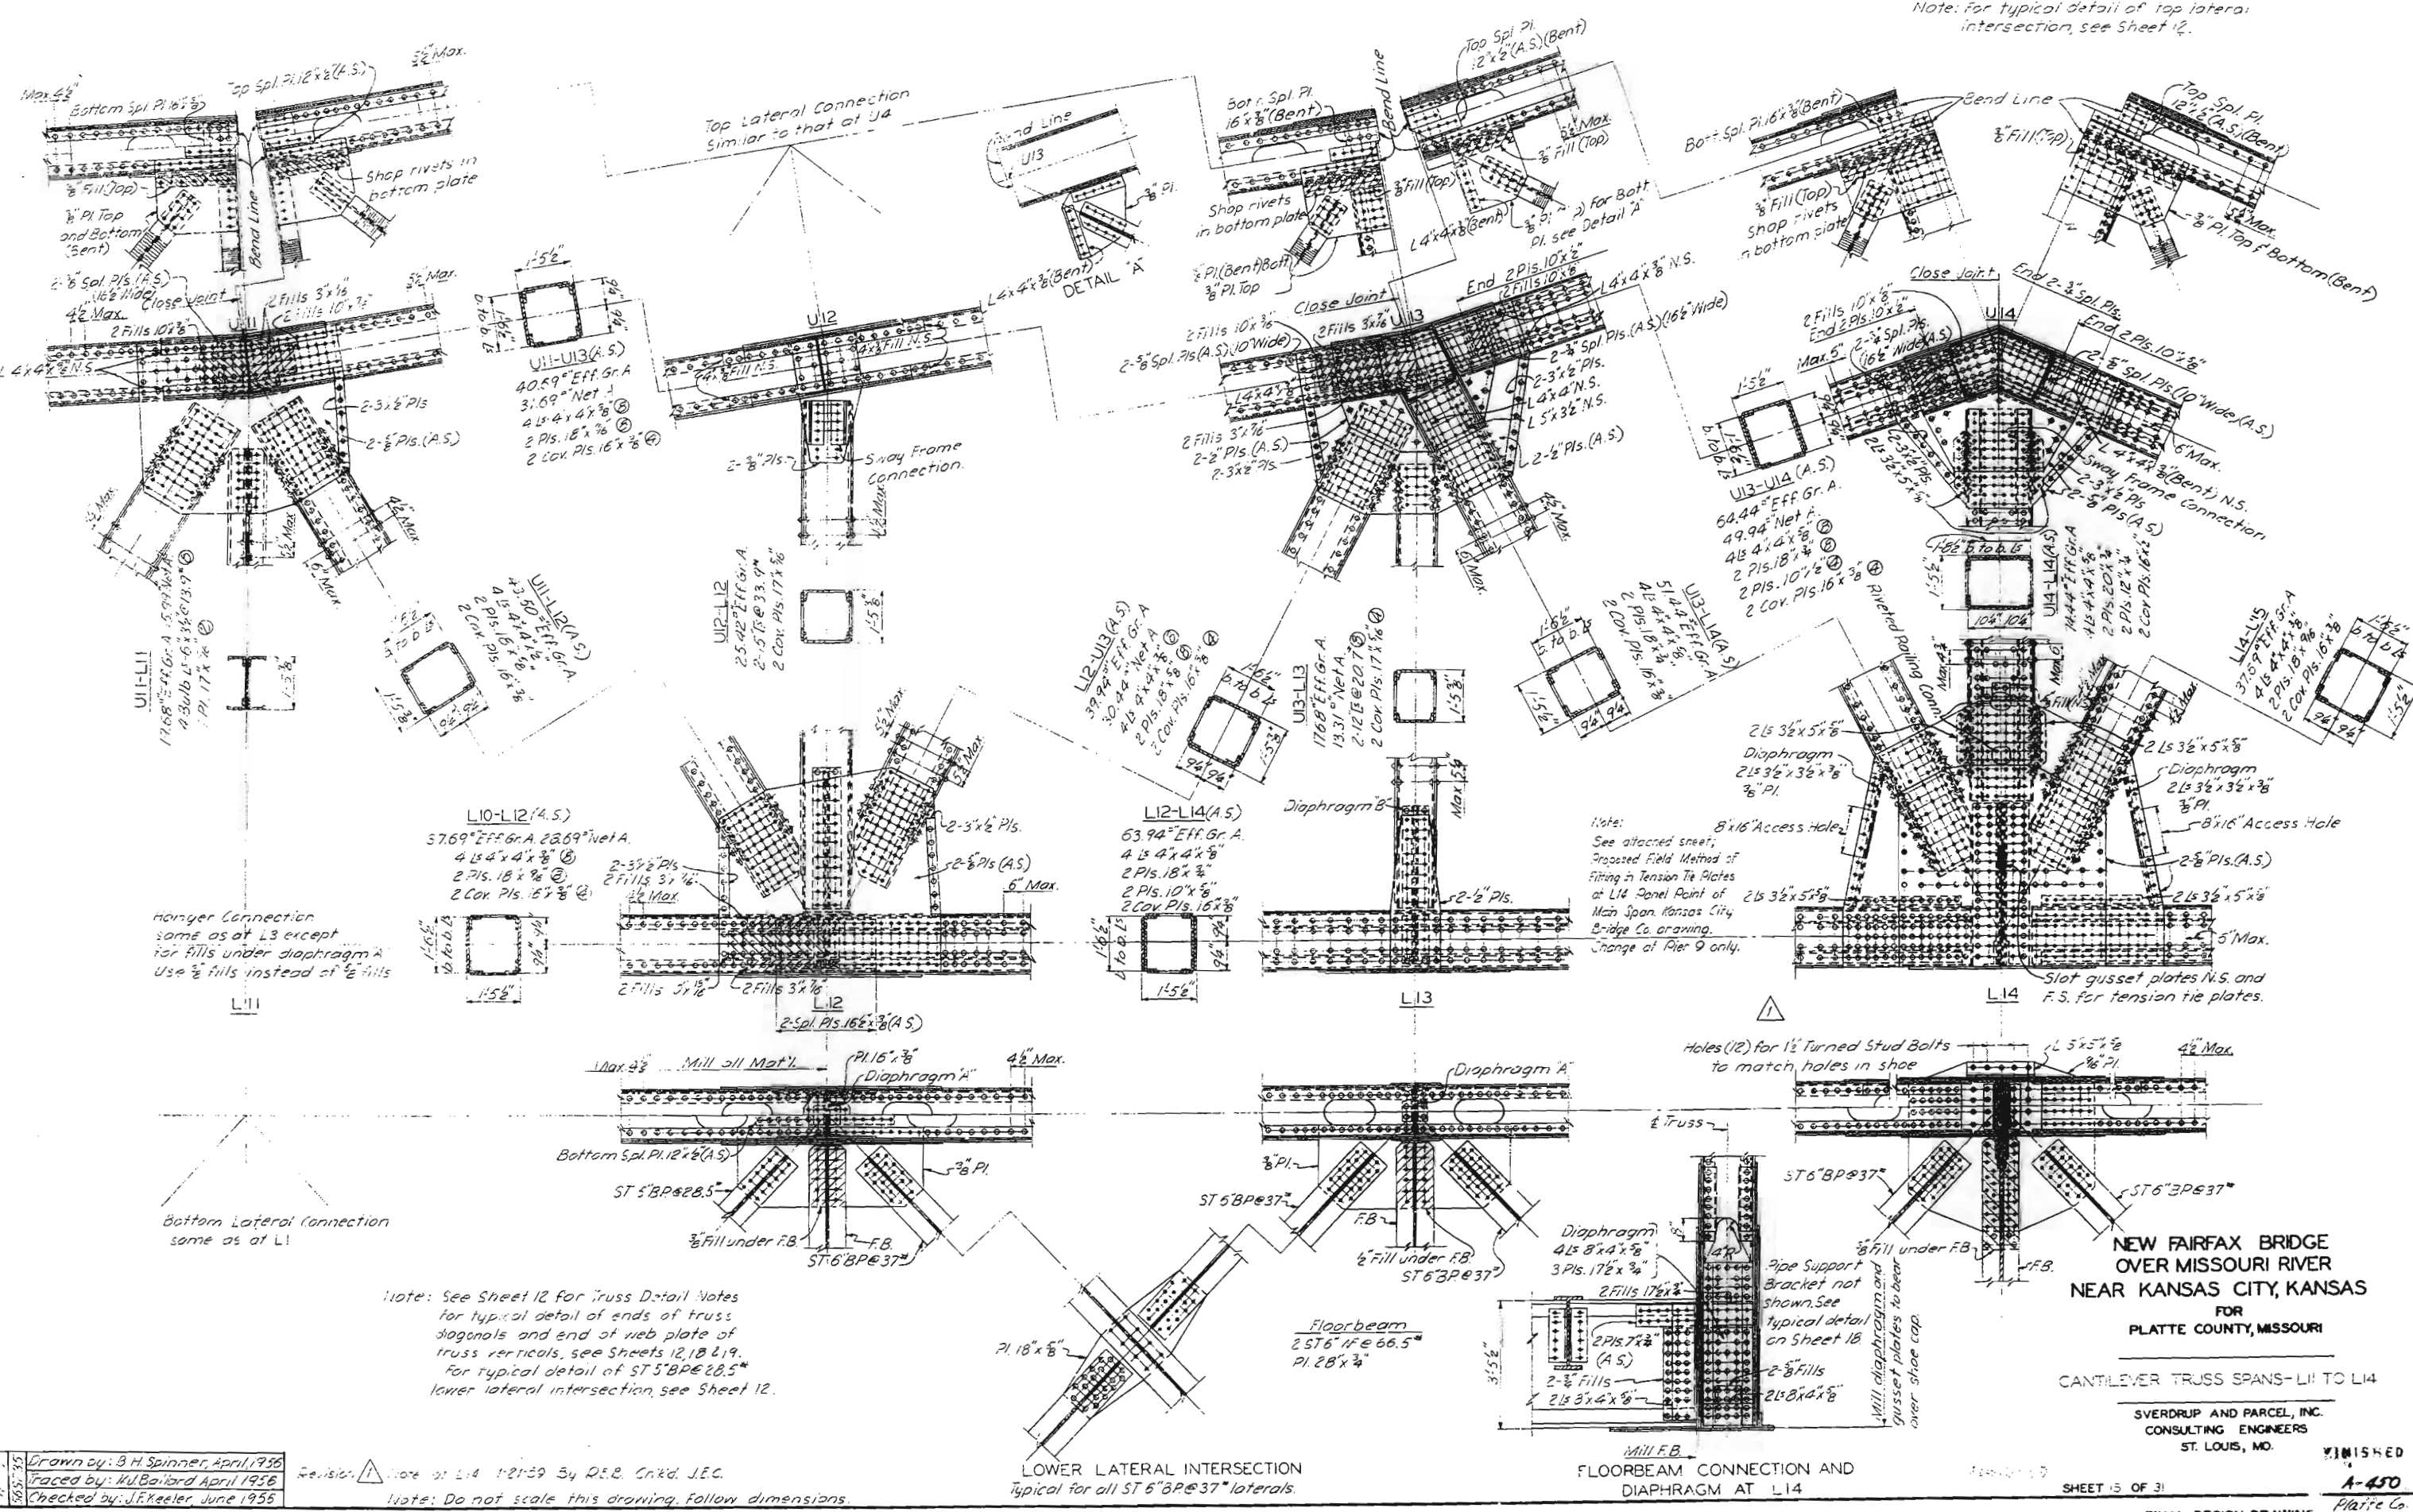

690 12 TO 1


3007

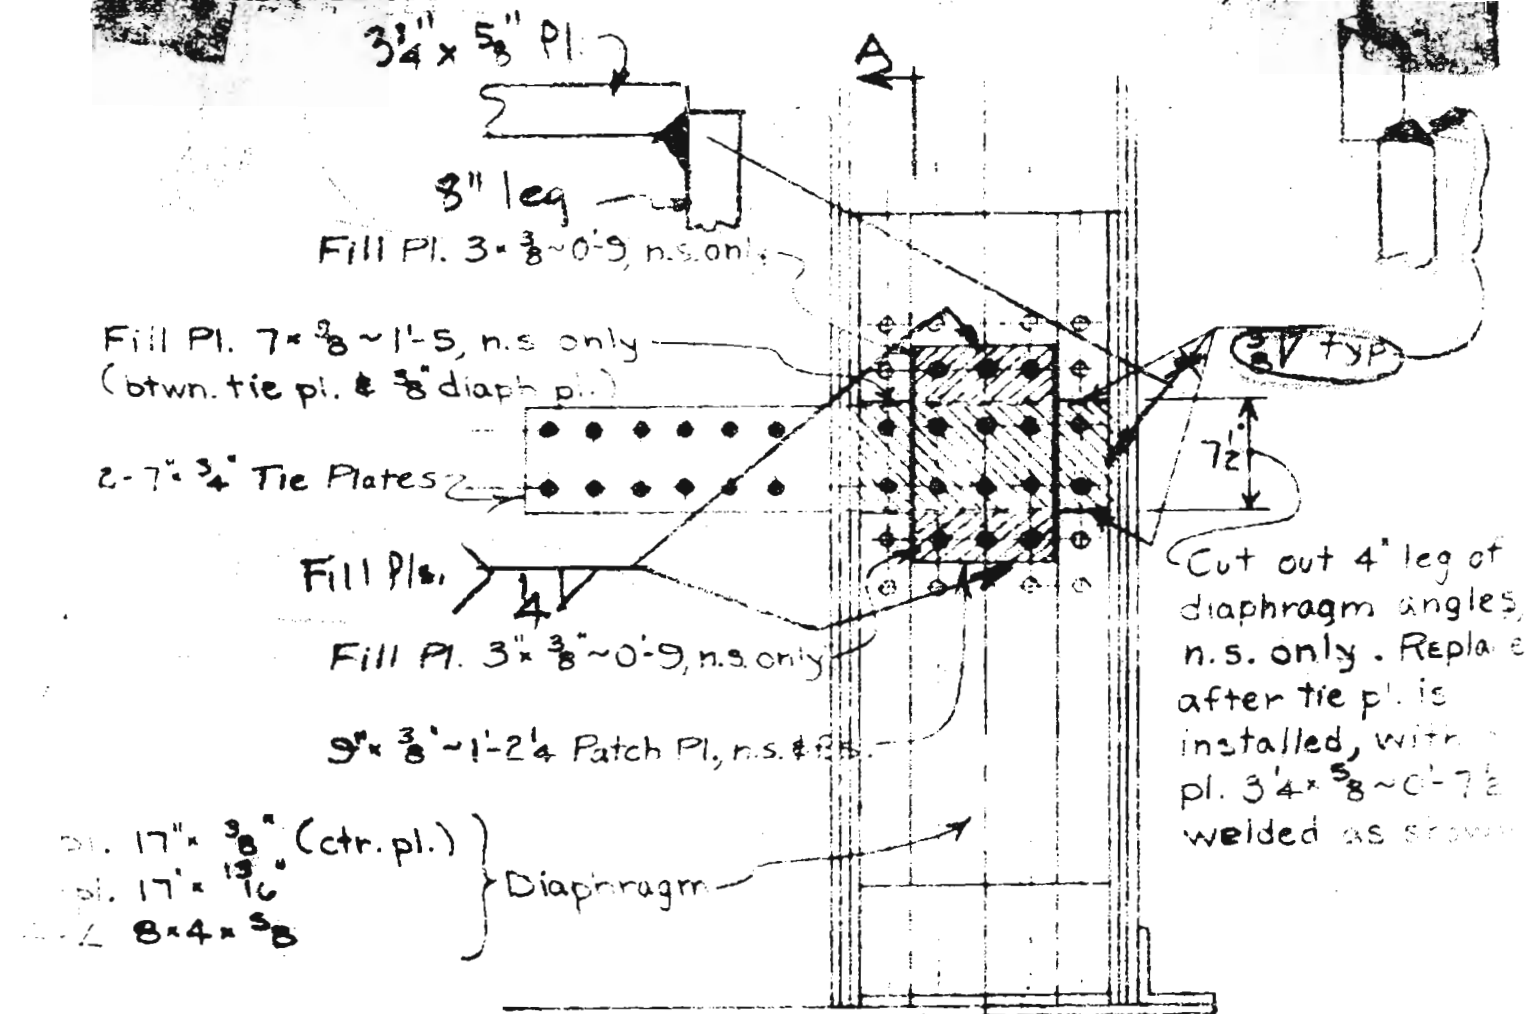

APPROVED  
as noted  
SEP 23 1957


SYNDERUP & PARCEL INC.  
J. F. Keck

Scale:  $1'' = 1'-0$   
 drawn by: JHH  
 Sept. 21, 1957

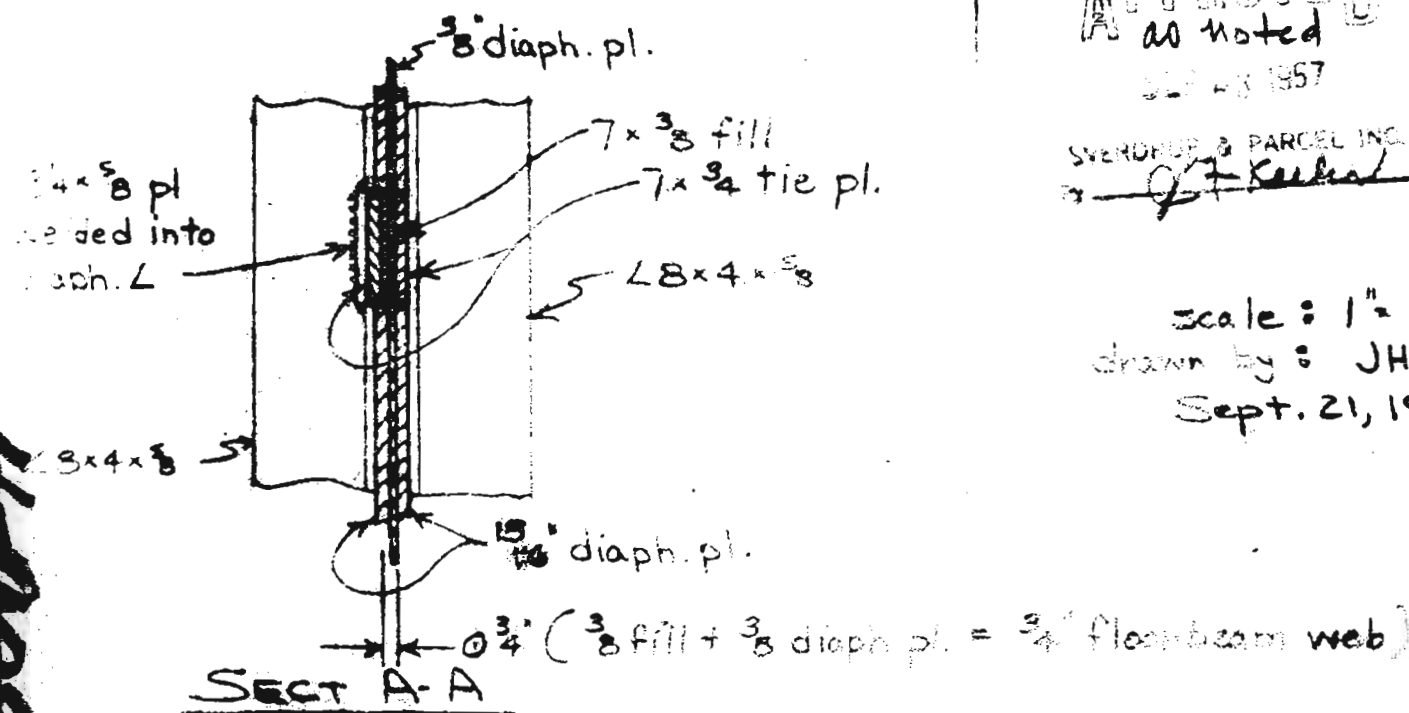

PROPOSED FIELD METHOD OF FITTING IN TENSION  
 TIE PLATES AT LK PANEL POINT OF MAIN SPAN  
 Kansas City Bridge Co.  
 CASE 8877

*Note: For typical result of top lateral intervention, see Sheet 12.*

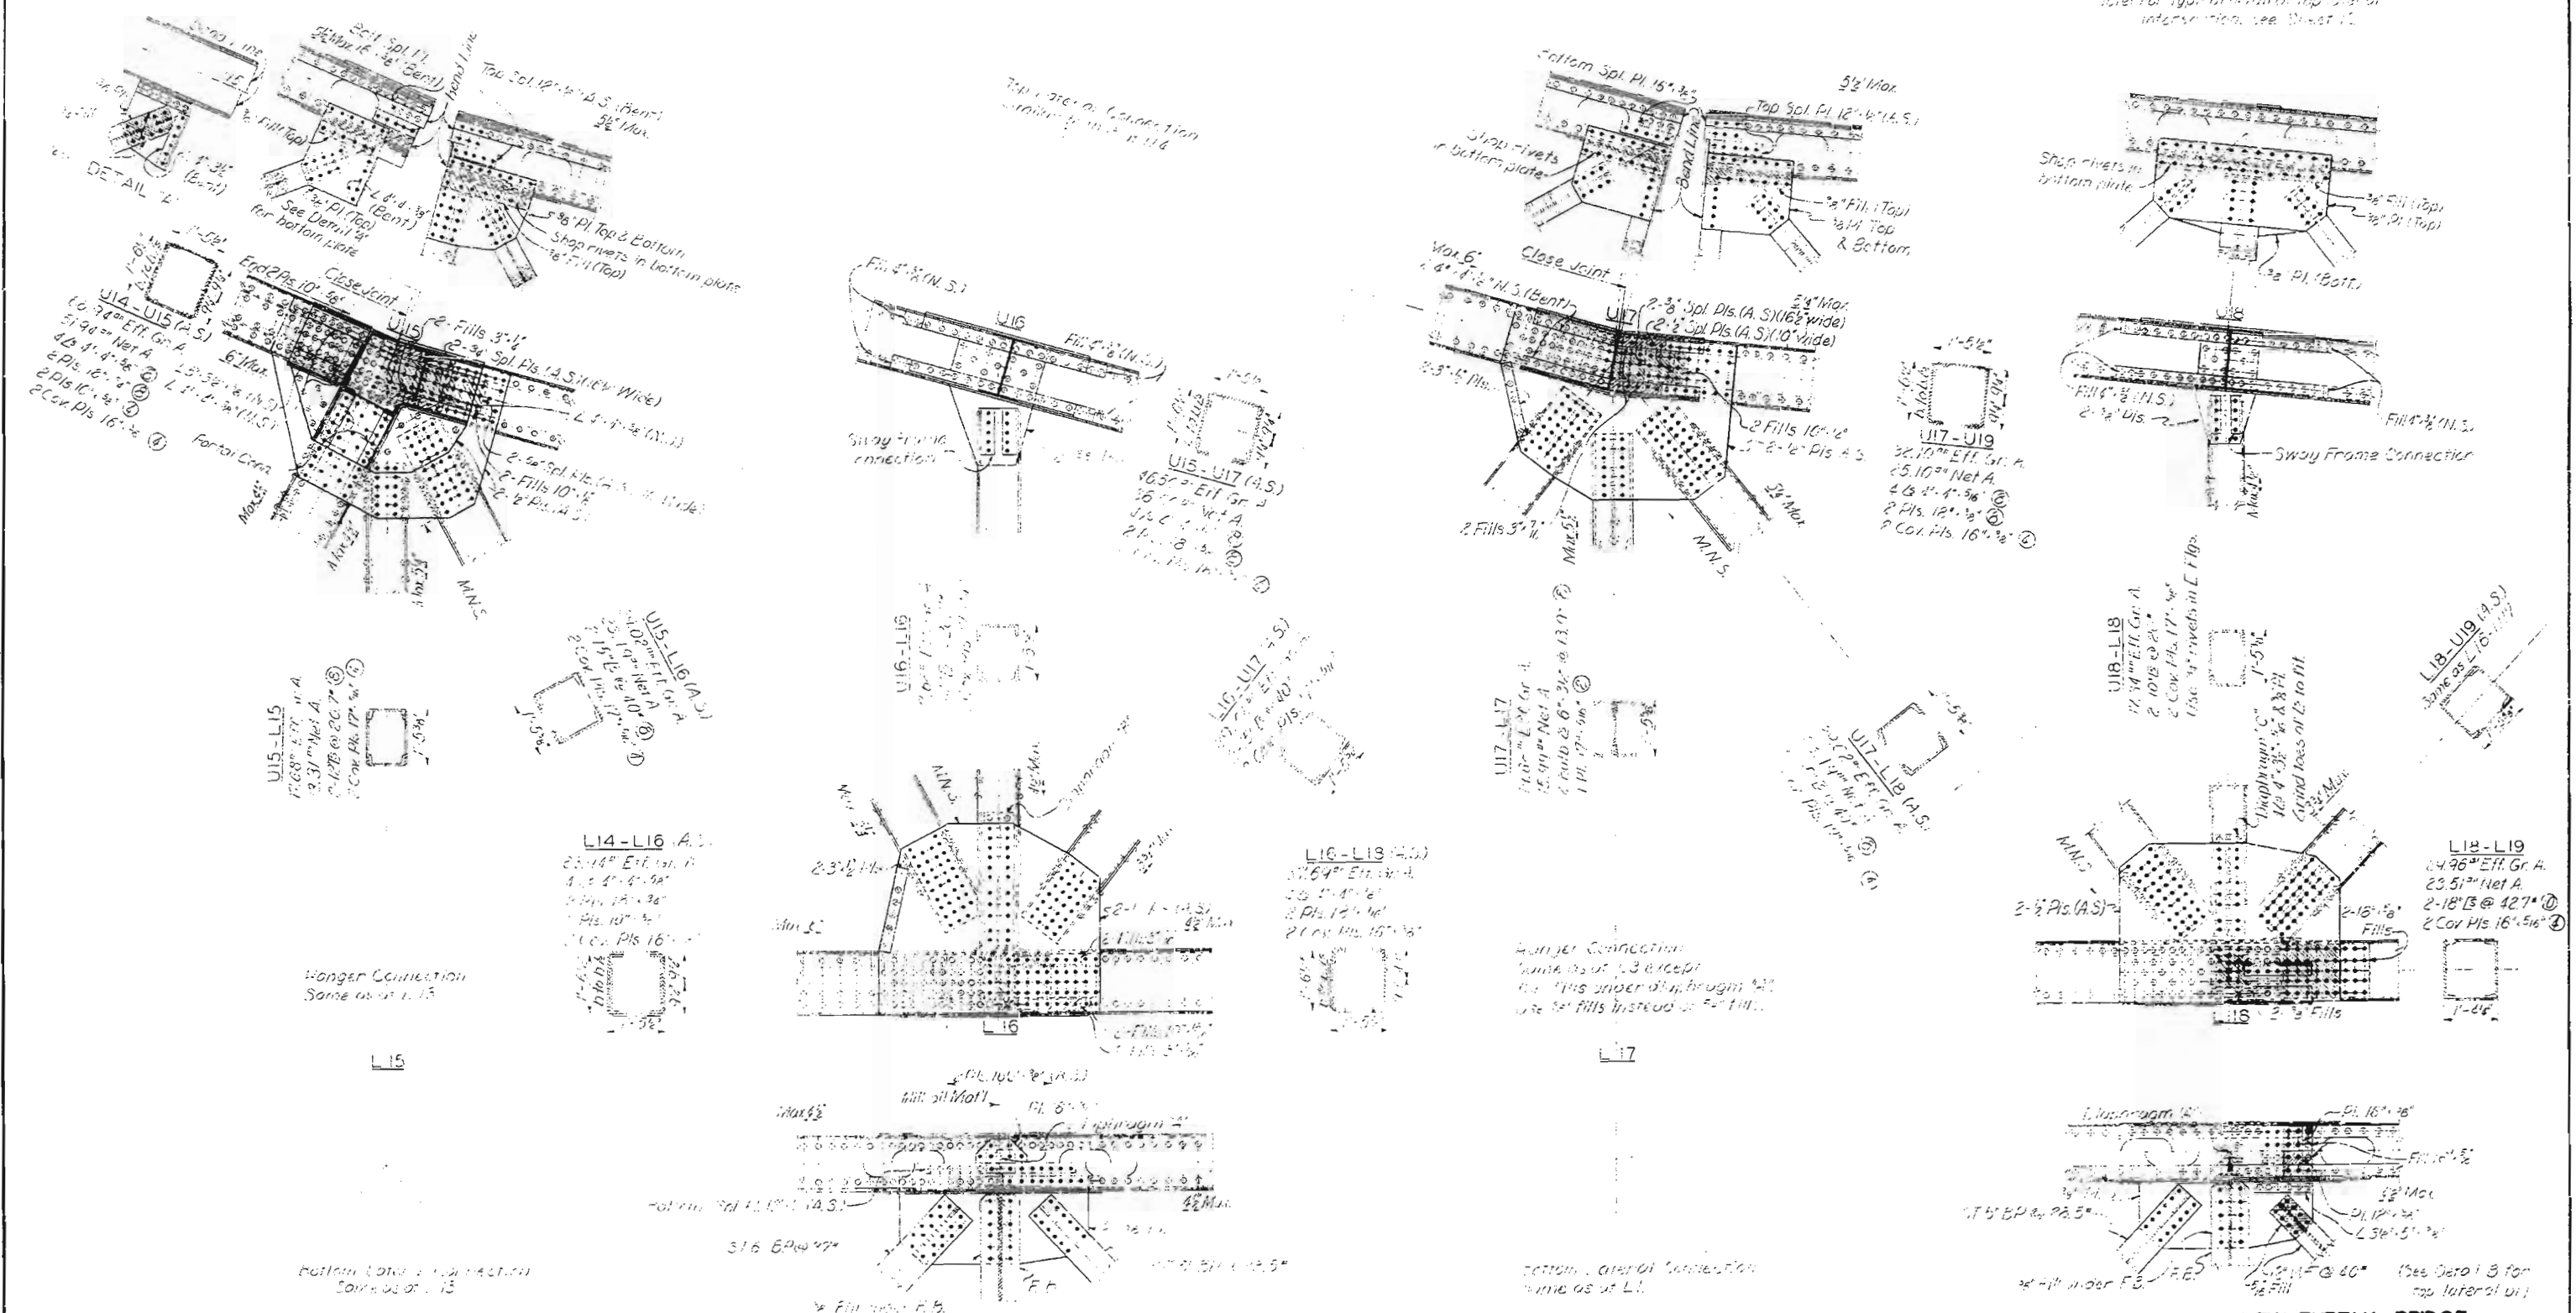

117a See sheet 12 for Trans. and Notes.  
for typical detail section of Trans.  
dipgrads and and 1:1000 p. 1 of  
100 is north (see sheets 12, 13 & 14)  
For typical detail of ST 6-88 @ 37°  
lower lat. trans. intersection see sheet 15.  
For typical section of ST 50 @ 28.5°  
upper lat. trans. section see sheet 12.

note: Don't write too many, focus on details.

C-1	Grown by: S. H. Spinner, Apr. 1956
	Traced by: R. R. Neg., May 1956
	Checked by: J. F. Keeler, June 1956

NEW FAIRFAX BRIDGE  
OVER MISSOURI RIVER  
NEAR KANSAS CITY, KANSAS  
FOR  
PLATTE COUNTY, MISSOURI

CANTILEVER TRUSS 2445-L5 TO JO

SVERDRUP AND PARCEL, INC.  
CONSULTING ENGINEERS  
ST LOUIS, MO


SHEET 5 OF 5

AS BUILT DRAWING


FINAL DESIGN DRAWING

WISNEL  
A-450  
9/27/68  
137.68




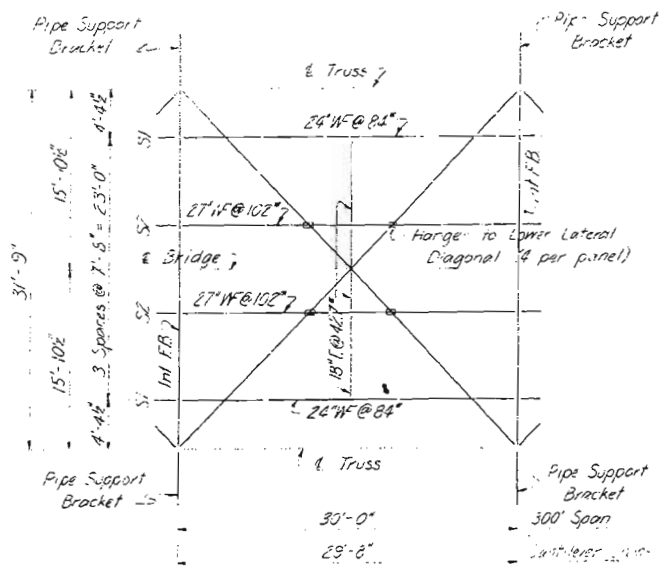


TYPICAL FLOOR FRAMING PANEL

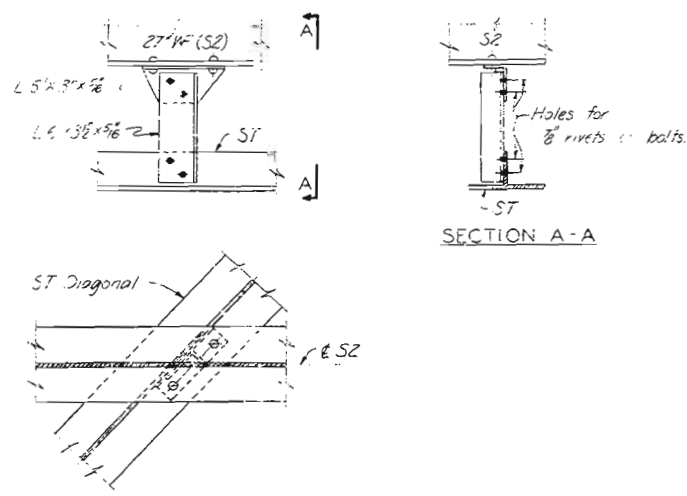

HANGER CONNECTION TO LOWER LATERAL DIAGONALS

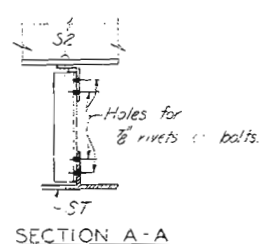


SECTION A-A

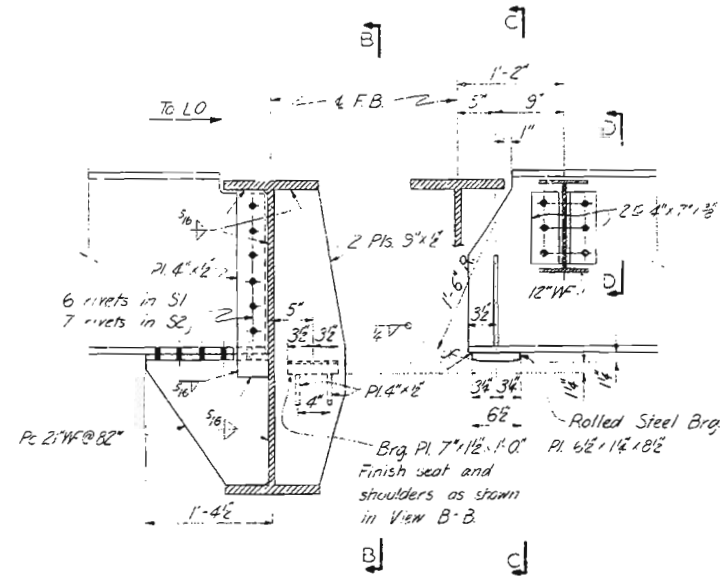


DETAIL OF STRINGER EXPANSION DEVICE

Stringer Expansion Devices as shown at L4, L8, L12, L16, and L22 of Spans 8 and 9, and at L5 of Spans 7 and 11. Expansion end of stringer towards LO' at L19, L16, L12, L8, and L4 of Spans 9 and 10.

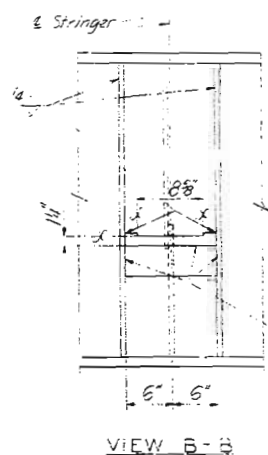


VIEW B-B

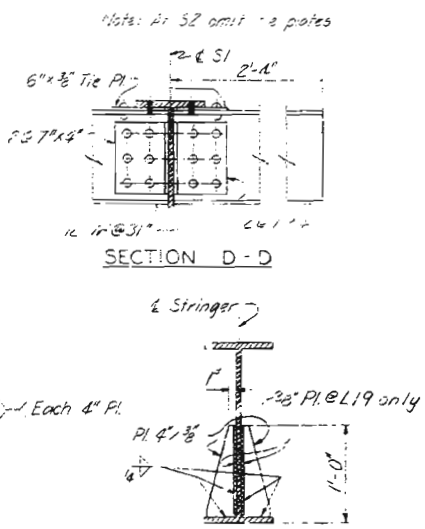


SECTION C-C


2

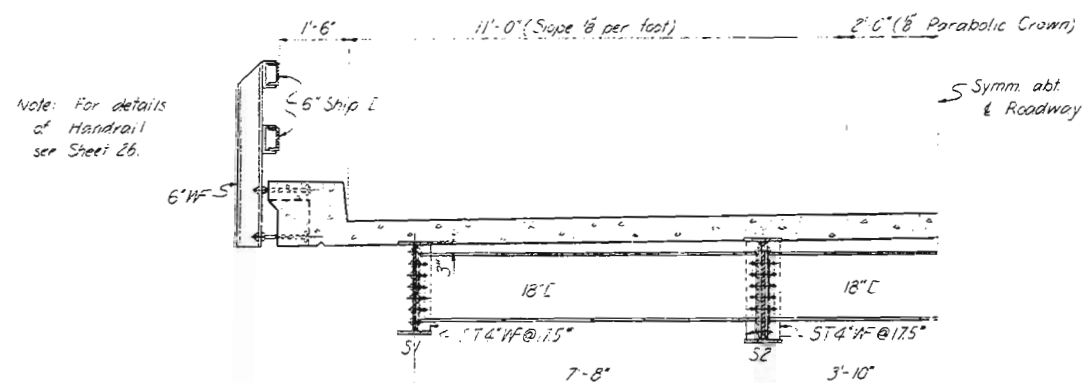

TYPICAL HALF CROSS SECTION BETWEEN PANEL POINTS

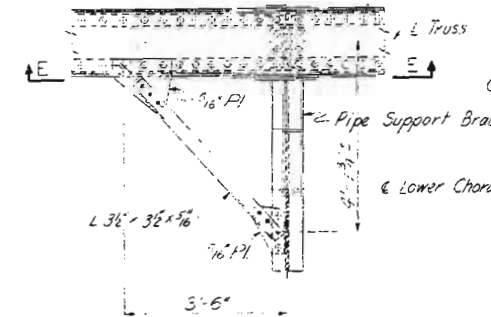


PLAN OF PIPE SUPPORT BRACKET

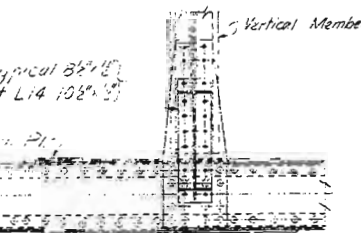

SECTION E-E


Typical for brackets at truss hanger members. At other panel points connection of bracket is similar.

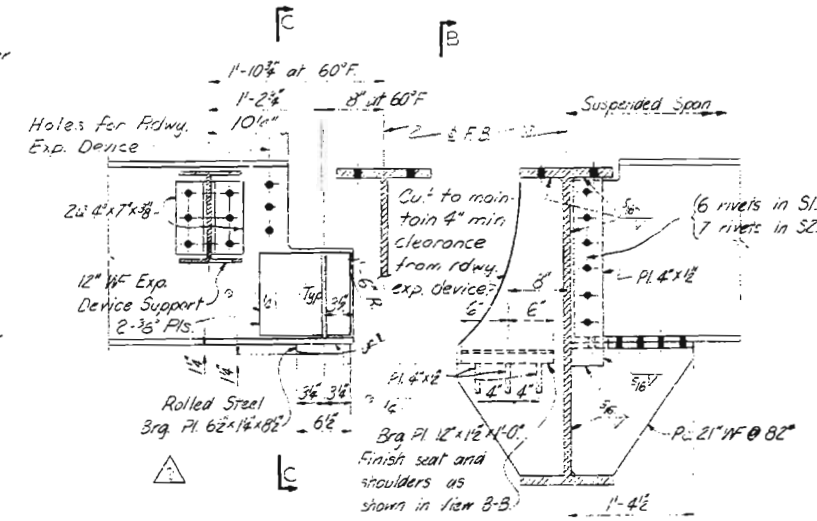


DETAIL OF STRINGER EXPANSION DEVICE AT L19

For details of roadway expansion device see sheet 25.

Notes: For detail of pipe anchor bracket at L16, see Sheet 10.

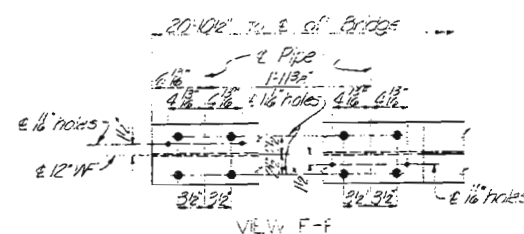


VIEW F-F

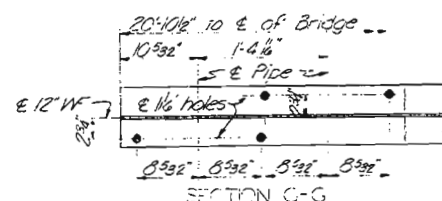

SECTION C-G

STRINGER CONNECTION TO FLOORBEAM AT S2

Stringer connection at S1 similar except as noted

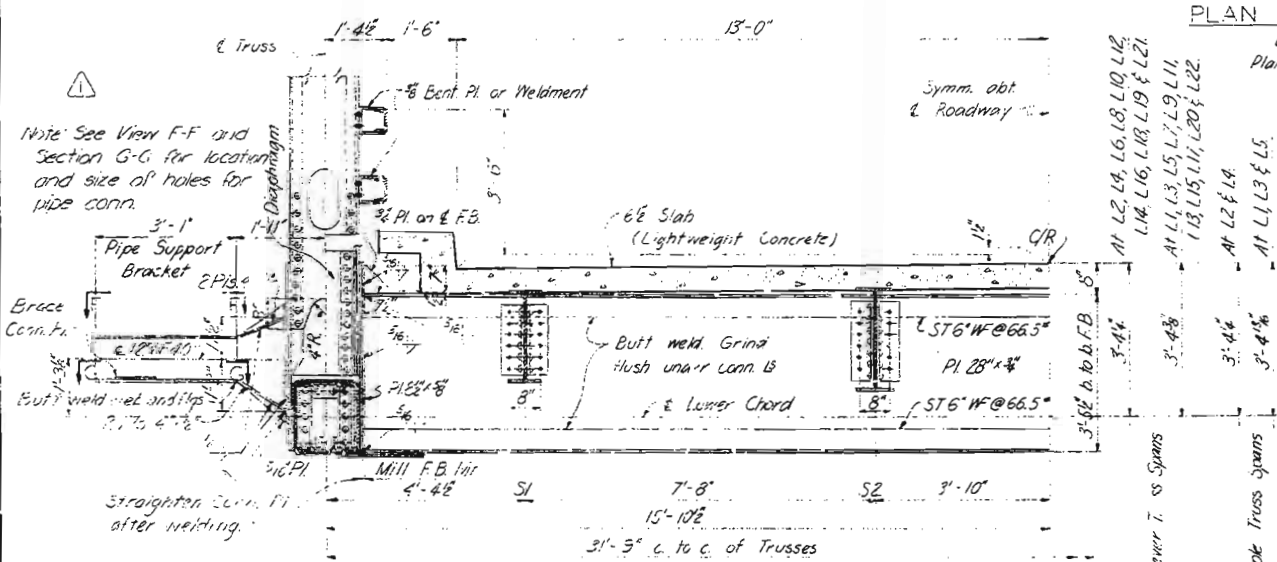

HALF CROSS SECTION AT INTERIOR FLOORBEAM

Drawn by: J. M. Hanson, Mar 1956  
Checked by: J. F. Reeler, May 1956

Note: Do not scale this drawing. Follow dimensions


Revision 1 Stringer exp. device at L19, 12-16-56, By VLS, Chkd. G.R.P.  
Revision 2 Holes for pipe conn. 5-3-56 By VLS, Chkd. E.L.

NEW FARFAX BRIDGE  
OVER MISSOURI RIVER  
NEAR KANSAS CITY, KANSAS  
FOR  
PLATTE COUNTY MISSOURI  
TRUSS SPANS - FLOOR SYSTEM

SVERDRUP AND PARCEL, INC.  
CONSULTING ENGINEERS  
ST. LOUIS, MO  
FINISHED  
A-450  
Platte Co.  
Pl. 69


AS BUILT DRAWING

FINAL DESIGN DRAWING

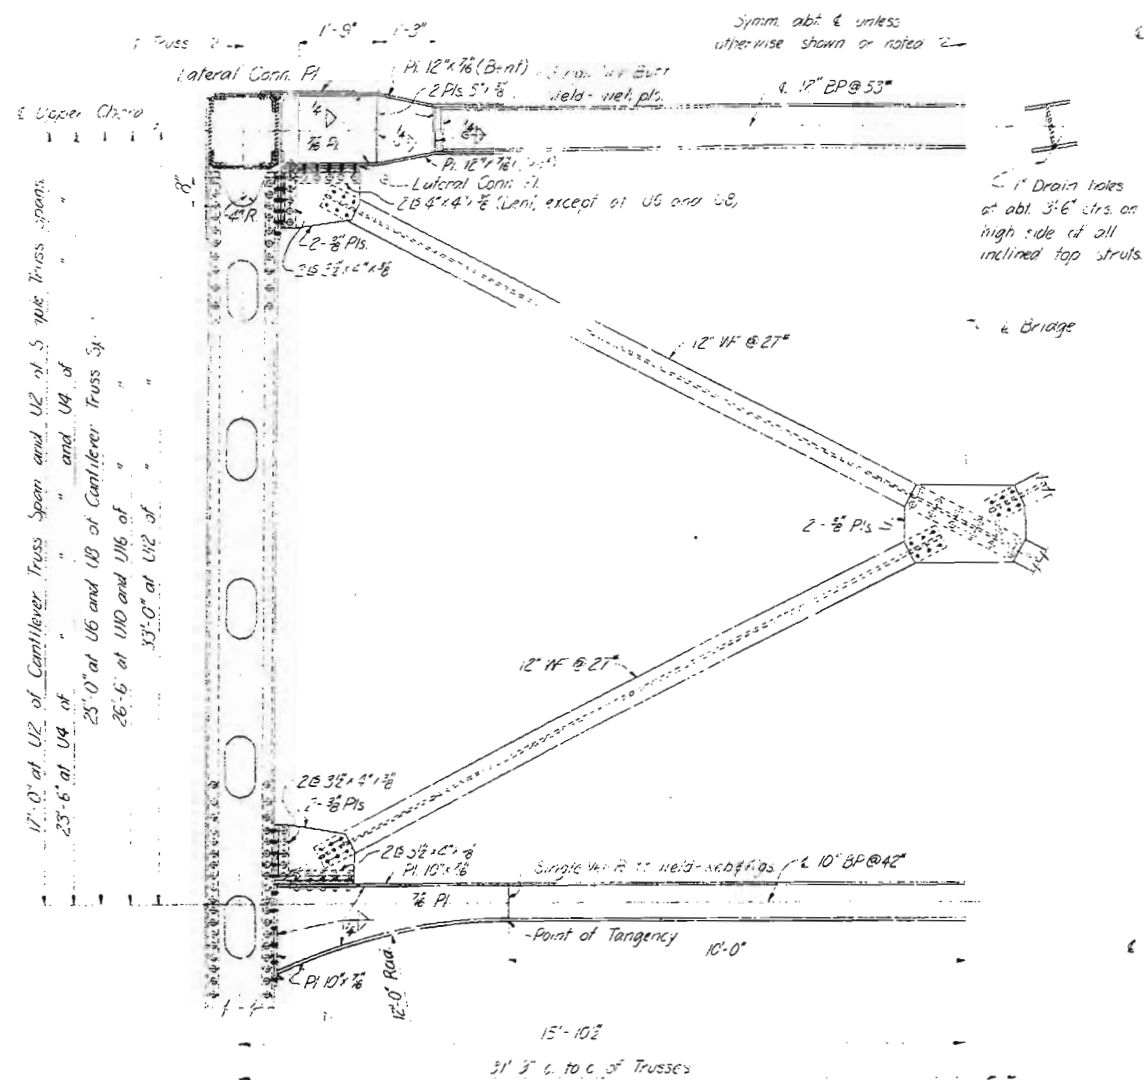


SWAY FRAME AT U2  
OF CANTILEVER TRUSS SPAN

Sway Frames at U4, U6, U8, U10, U12, and U16 of Cantilever Truss Span similar. Sway Frames at U2 and U14 of Simple Truss Spans also similar. Top struts at U3, U5, U7, U9, U11, U17, and U19 of Cantilever Truss Span, and U3 and U5 of Simple Truss Span, similar to that shown for U2.

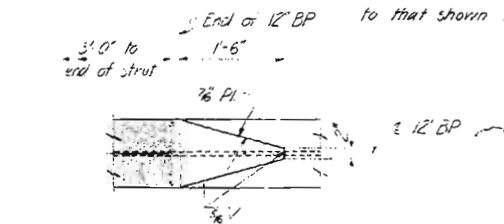


DETAIL OF WELDING  
FOR TOP STRUT FLANGE SPLICE

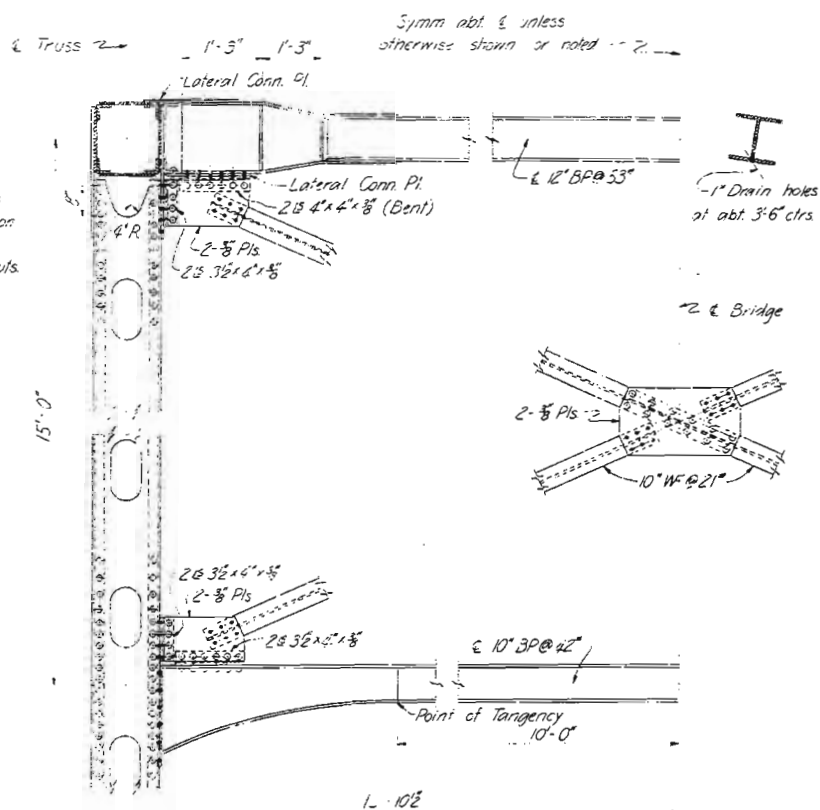

SWAY FRAME AT U18

Top strut and bottom strut similar to that shown at U2.

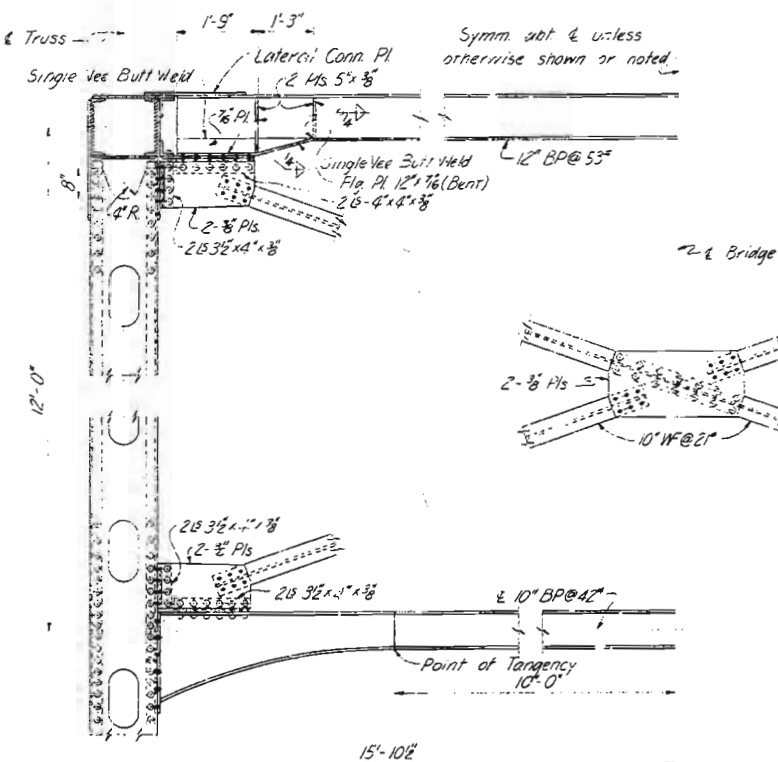

SWAY FRAME AT U21

Bottom strut similar to that shown at U2. Top strut at U22 similar to that shown for U21.

NOTES  
All rivets to be 5/8" diam. except 3/4" diam. in Hangers at 15' C's.

NEW FAIRFAX BRIDGE  
OVER MISSOURI RIVER  
NEAR KANSAS CITY, KANSAS  
FOR  
PLATTE COUNTY, MISSOURI

TRUSS SPANS - SWAY FRAMES

SVERDRUP AND PARCEL, INC.  
CONSULTING ENGINEERS  
ST. LOUIS, MO

SHEET 3 OF 3


A-450  
Platte Co.  
Rt. 69

AS BUILT DRAWING


FINAL DESIGN DRAWING

Note: Do not scale this drawing. Follow dimensions

Drawn by: J. M. Hansur, Mar. 1956  
Checked by: J. F. Keeler, May 1956

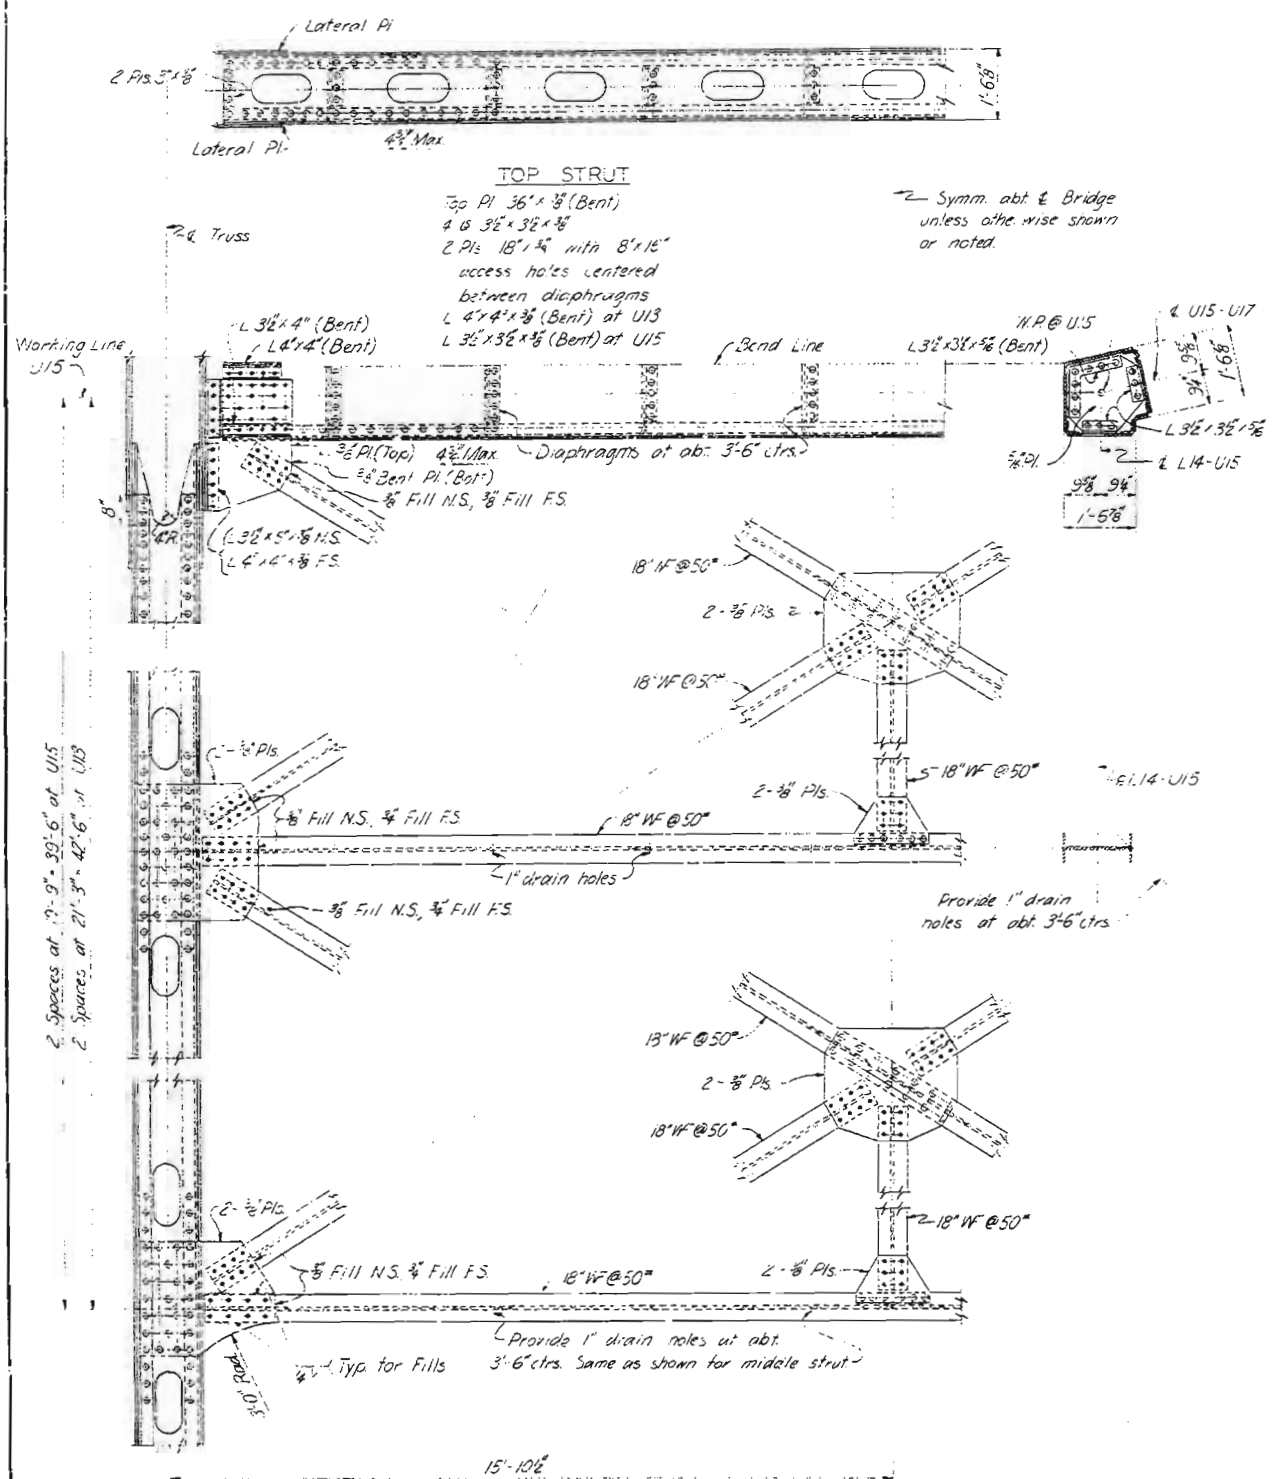

**PORTAL AT U15**  
Portal at U13 similar, with dimensions as shown.

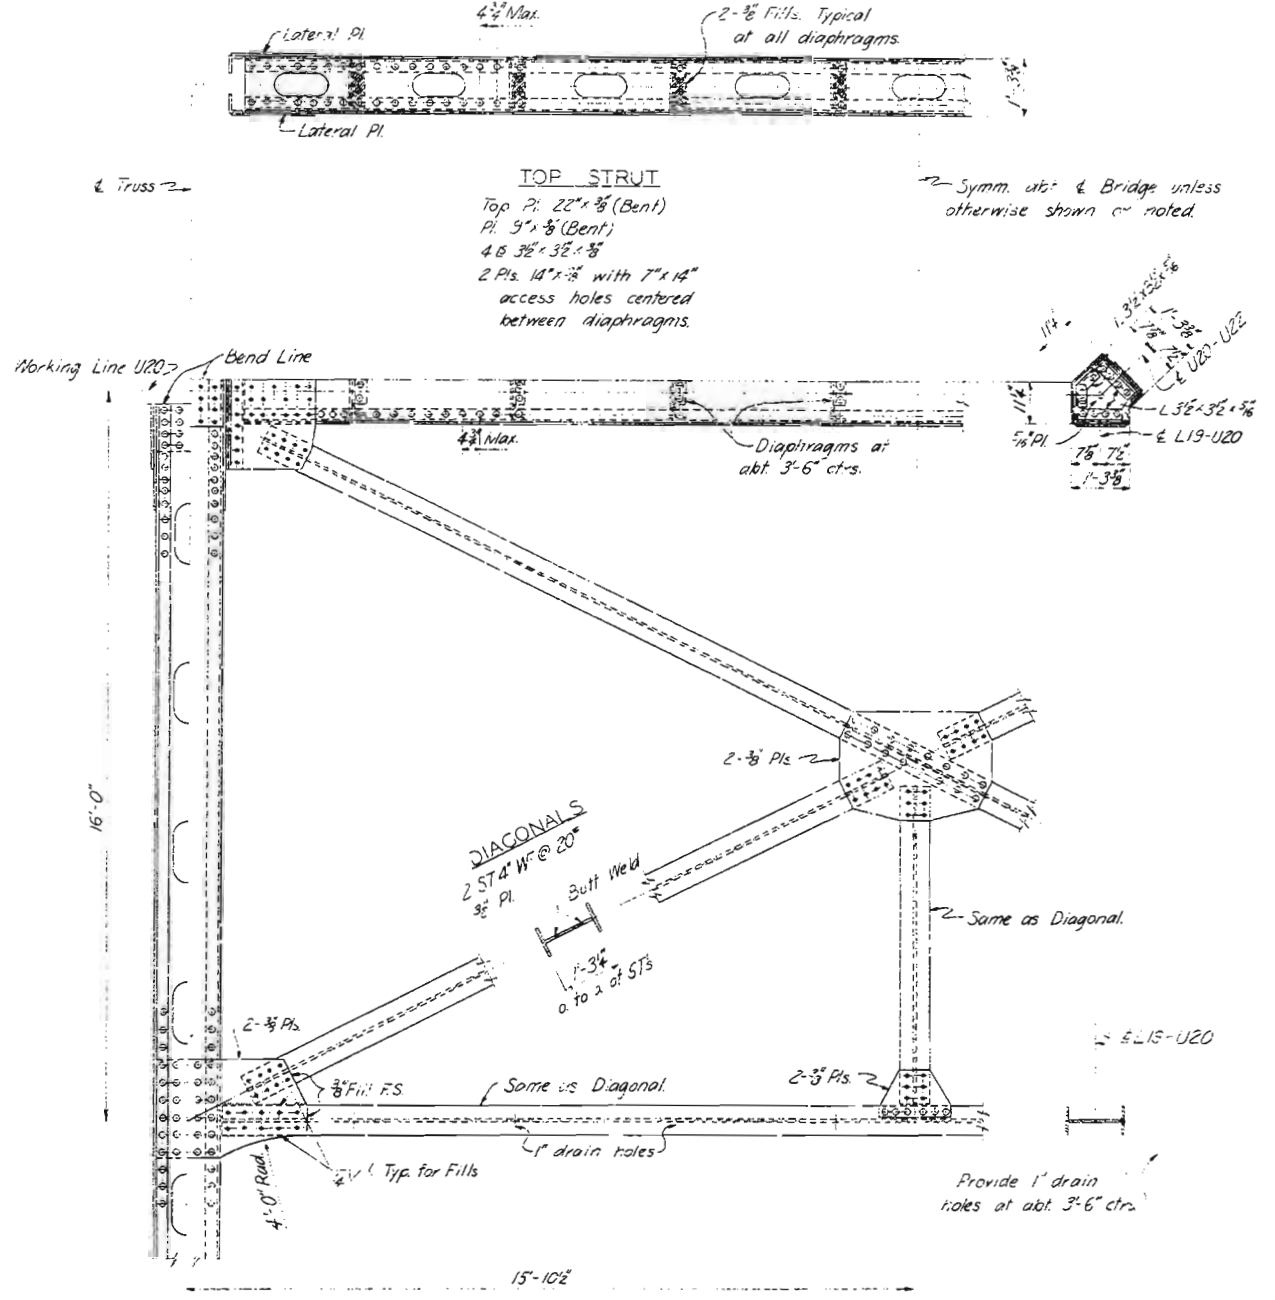

**PORTAL AT U20**

**NOTES**  
All rivets to be 7/8" diam.

**NEW FAIRFAX BRIDGE  
OVER MISSOURI RIVER  
NEAR KANSAS CITY, KANSAS  
FOR  
PLATTE COUNTY, MISSOURI**

**CANTILEVER TRUSS SPANS - PORTALS**

SVERDRUP AND PARCEL, INC.  
CONSULTING ENGINEERS  
ST. LOUIS, MO

DESIGNED BY  
CHECKED BY






SHEET 20 OF 31

A-450  
Platte Co.  
Rt. 69



AS BUILT DRAWING

FINAL DESIGN DRAWING

Drawn by: J. M. Hanson, Mar. 1956  
Checked by: J. F. Keeler, May, 1956

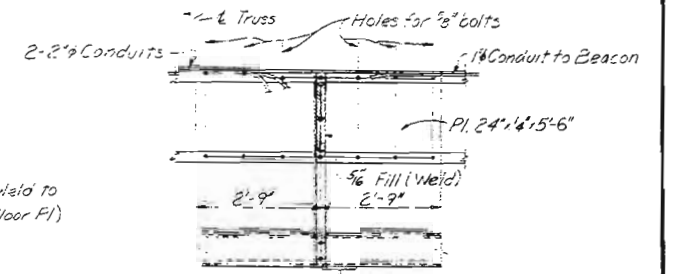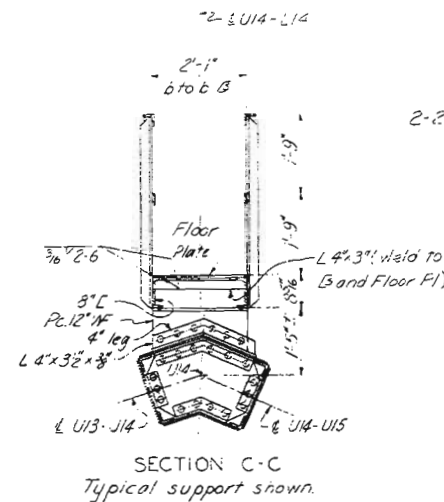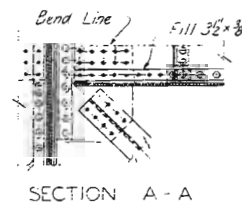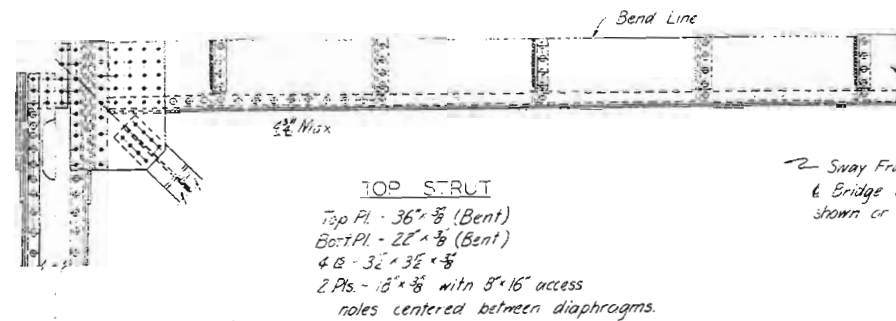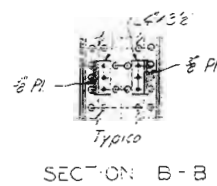

Mount transformer, 2 Photoelectric Controls, and 2 load contactors on  $\frac{1}{4}$  inch plate on outside of platform. Orient Photoelectric Controls to North. Also mount master disconnect switch, and 2 circuit breakers on  $\frac{1}{4}$  inch plate on inside of platform.

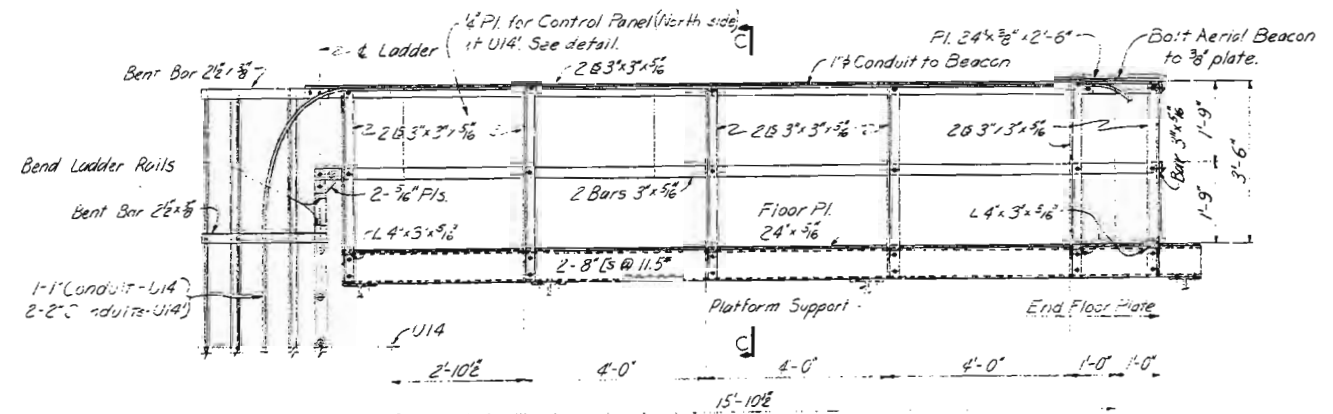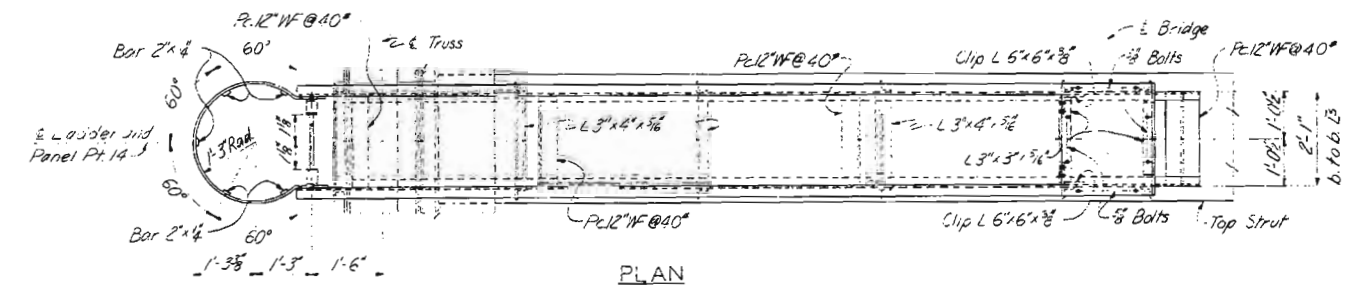

Rivets in platform and railings to be  $\frac{3}{4}$  inch

#### NOTES

All rivets to be  $\frac{3}{4}$  inch diam. unless otherwise noted.  
Sway Frame and Aerial Beacon Access at U14 same as at U14 except as noted in detail of Control Panel at U14.  
For Ladder Detail and Ladder Splice, see Sheet 22.  
All floor plates to be raised pattern plates.  
Ladder and cage to be shop welded in convenient lengths with at least two supports per section.  
See Sheets 30 & 31 for electrical details.  
Fillet welds to be  $\frac{1}{8}$  inch minimum.  
All conduit to be rigid galvanized conduit.

NEW FAIRFAX BRIDGE  
OVER MISSOURI RIVER  
NEAR KANSAS CITY, KANSAS  
FOR  
PLATTE COUNTY, MISSOURI

SWAY FRAME AT U14  
& AERIAL BEACON ACCESS  
SVERDRUP AND PARCEL, INC.  
CONSULTING ENGINEERS  
ST. LOUIS, MO.

SHEET 21 OF 31

AS BUILT DRAWING

FINAL DESIGN DRAWING

See Elevation of Upper Landing Platform.

Upper Chord

1-1 inch Conduit U14  
2-2 inch Conduit U14  
(Support at 8'-0 inch ctrs on  $\frac{3}{8}$  inch bars)

Bent Bars  $2 \frac{1}{2} \times \frac{3}{8}$   
at abt. 4'-0 inch ctrs

24'-0"

4 Bars

Typical Ladder Support Spacing not to exceed 8'-0"

24 3/2 inch x 4 inch x 3/8 inch & 2 inch Pls

24'-0"

11'-0" to Lower Landing Platform

Note: See Sheet 31 for details of ladder and cage of Lower Ladder Platform

2x Downstream Truss

Note: Ladder and platform to be on downstream side of bridge only.


15'-10 1/2"

Note: Do not scale this drawing. Follow dimensions.


Drawn by: J. M. Hanson, May 1956  
Checked by: E. Lemcoe, June 1956






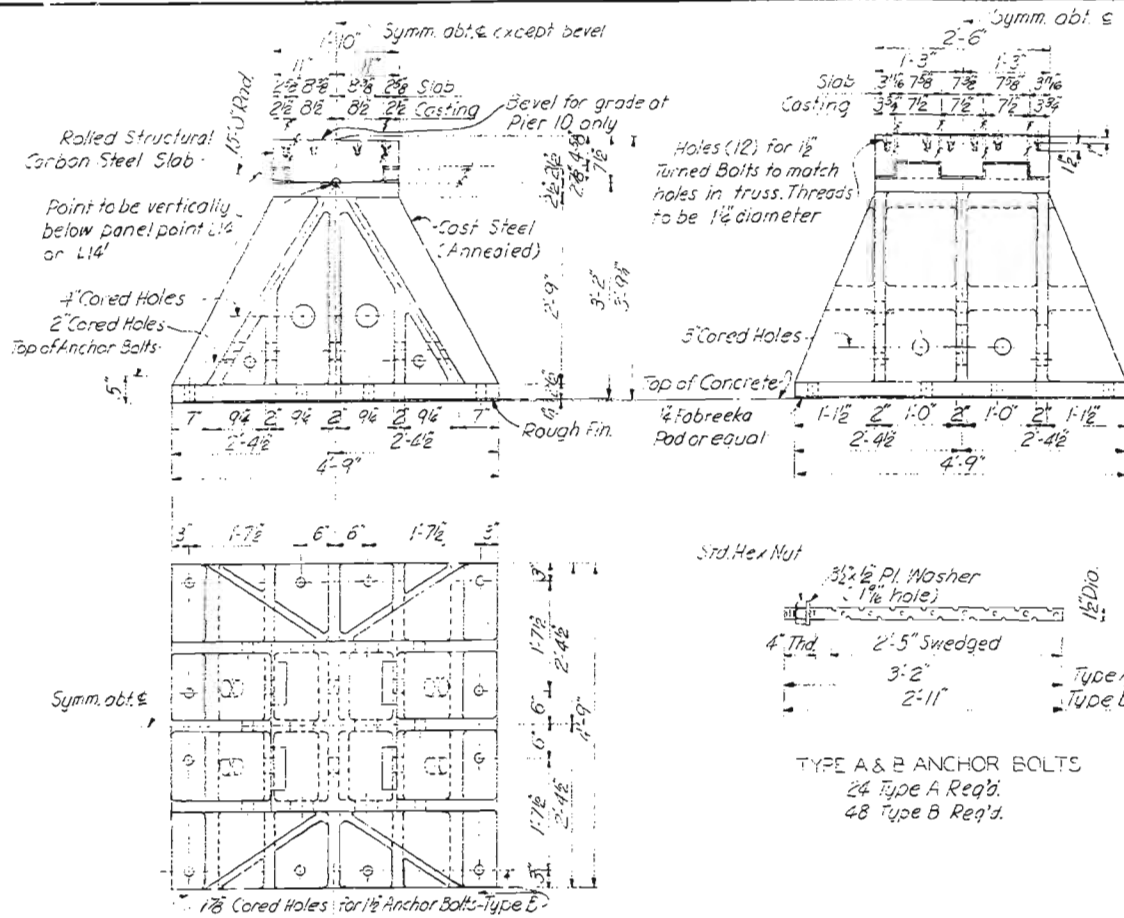

CANT. TRUSS SPANS-FIXED SHOE AT PIERS 9 & 10  
(4 Required)

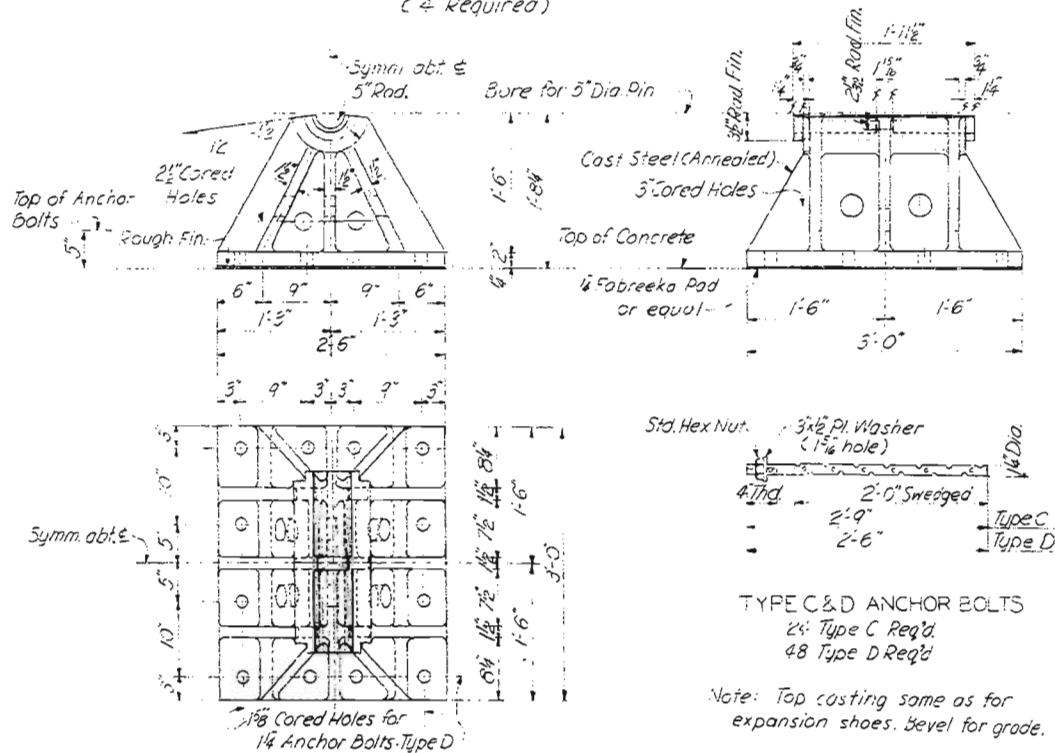


SIMPLE TRUSS SPANS-FIXED SHOE AT PIERS 8 & 11  
(4 Required)

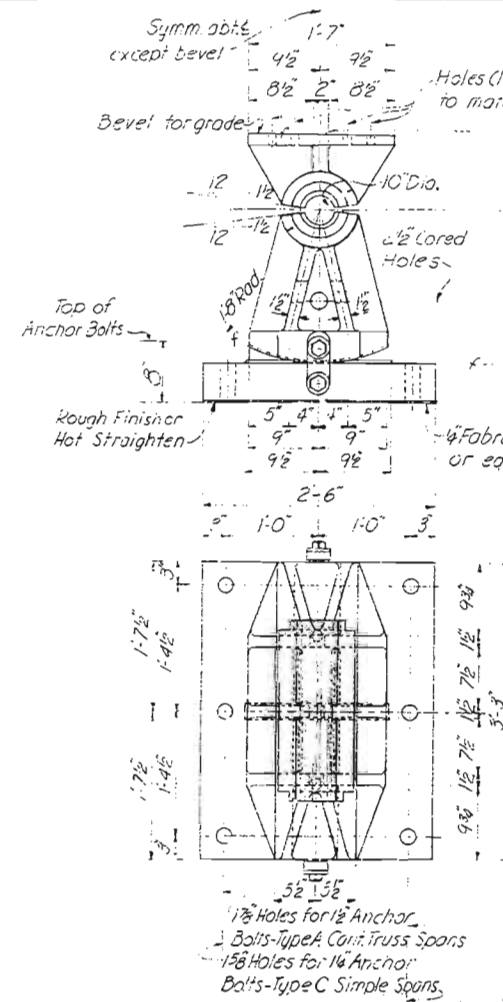

EXPANSION SHOE  
PIERS 8 & 11-CANT. TRUSS SPANS (4 Required)  
PIERS 7 & 12-SIMPLE TRUSS SPANS (4 Required)

#### NOTES

For Anchor Bolt Plan See Sheet 3.  
All fillets on castings to be  $\frac{3}{4}$  radius.  
All castings shall conform to A.S.T.M. Designation A27, Grade 65-35, full annealed.  
The tongues in base slabs of the expansion shoes shall be machined from the parent rolled slabs.  
Bronze washers shall conform to A.S.T.M. Designation B100, Alloy No. 2.

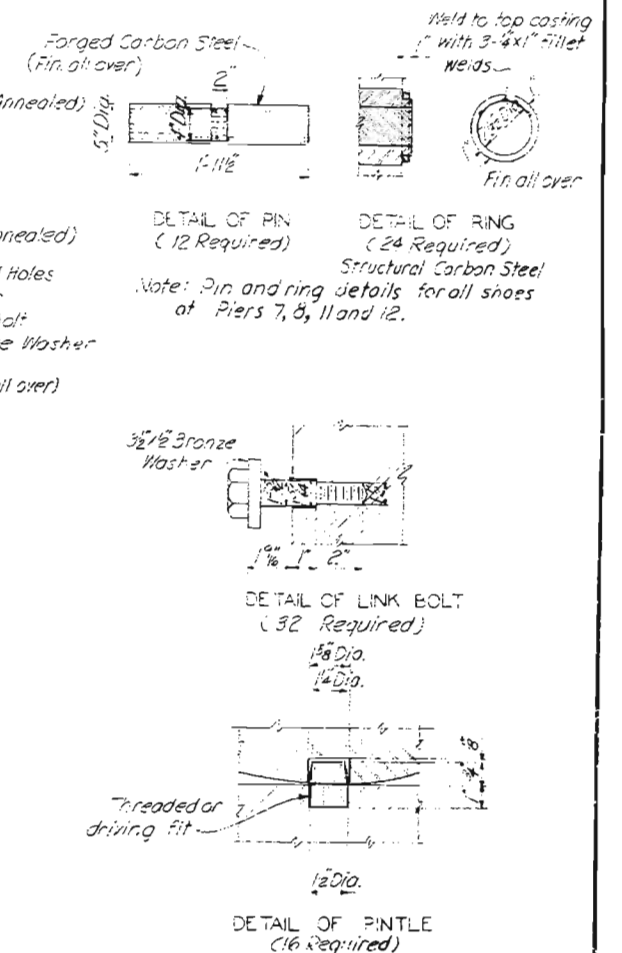

NEW FAIRFAX BRIDGE  
OVER MISSOURI RIVER  
NEAR KANSAS CITY, KANSAS

FOR  
PLATTE COUNTY, MISSOURI

TRUSS SPANS-SHOES

SVERDRUP AND PARCEL, INC.  
CONSULTING ENGINEERS  
ST. LOUIS, MO.





SHEET 23 OF 31

AS BUILT DRAWING

FINAL DESIGN DRAWING

A 450  
Platte Co.  
Rt. 69

Drawn by: J.S. Alagia April, 1956  
Checked by: E. Lemce June, 1956

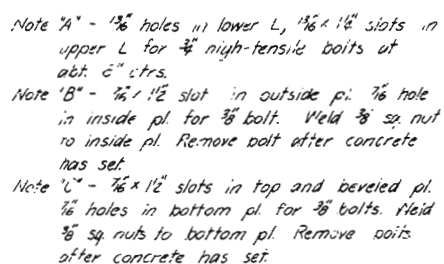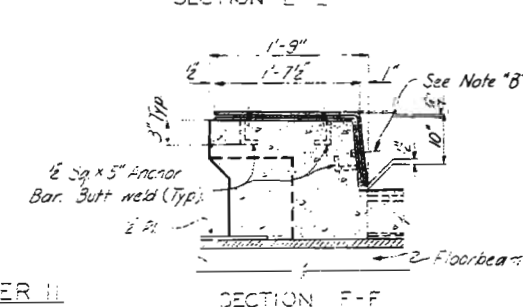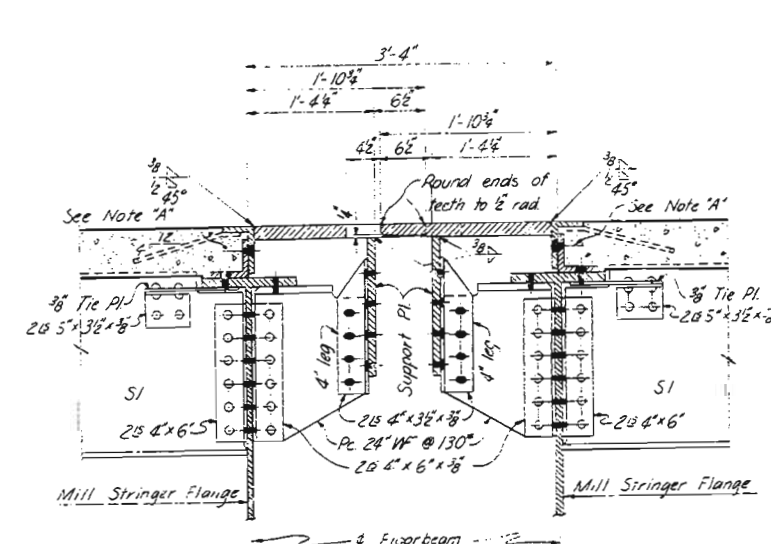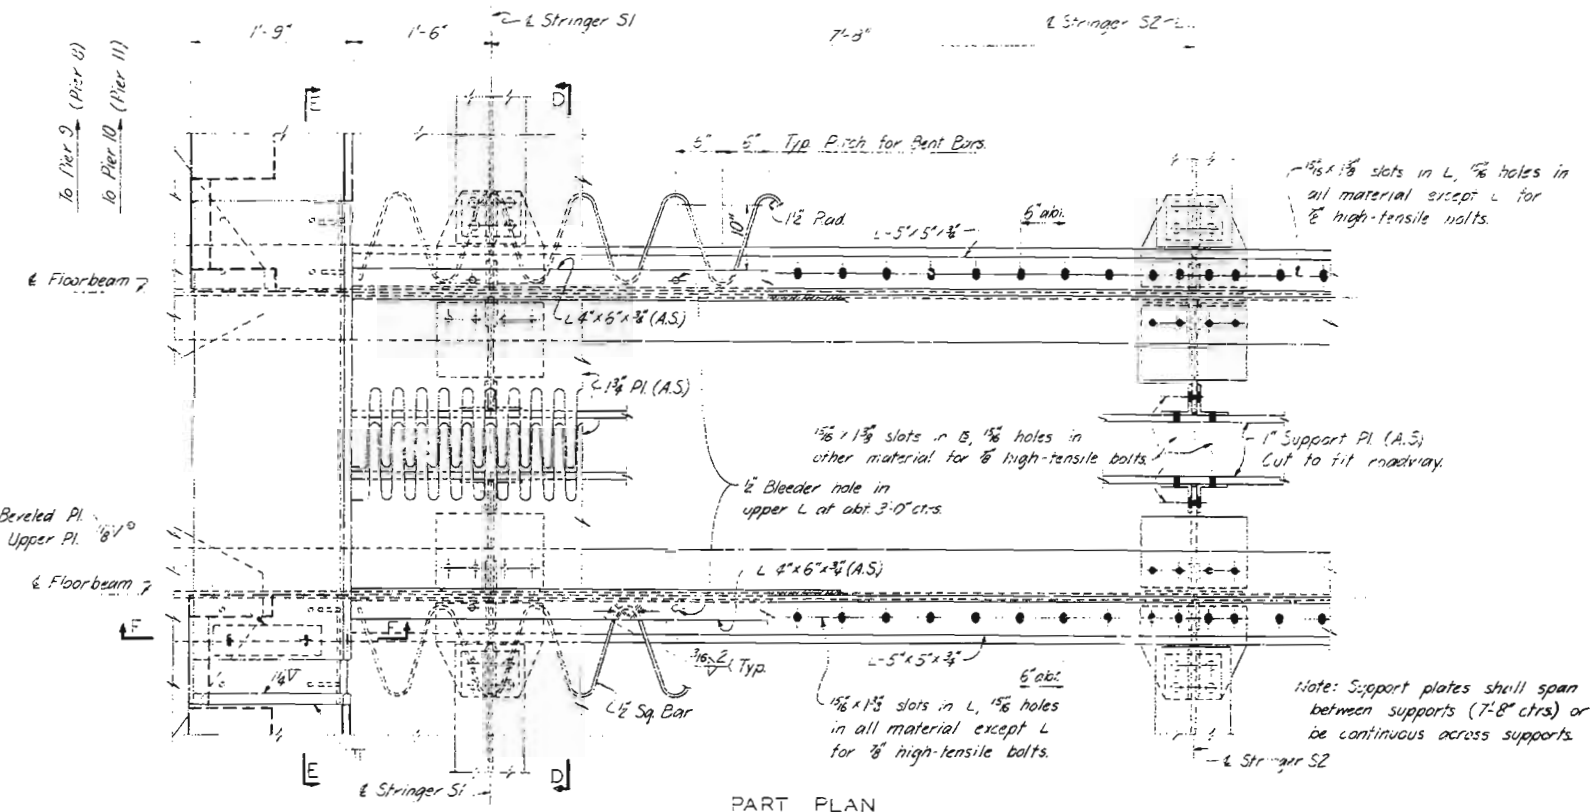

For Expansion Device Notes, see Sheet 25.  
All rivets  $\frac{3}{8}$ " dia unless noted otherwise.

SVERDRUP AND PARCEL, INC.  
CONSULTING ENGINEERS  
ST. LOUIS, MO.





A 450  
Platte Co  
Rt. 69

FINAL DESIGN DRAWING

Note: Do not scale this drawing. Follow dimensions.





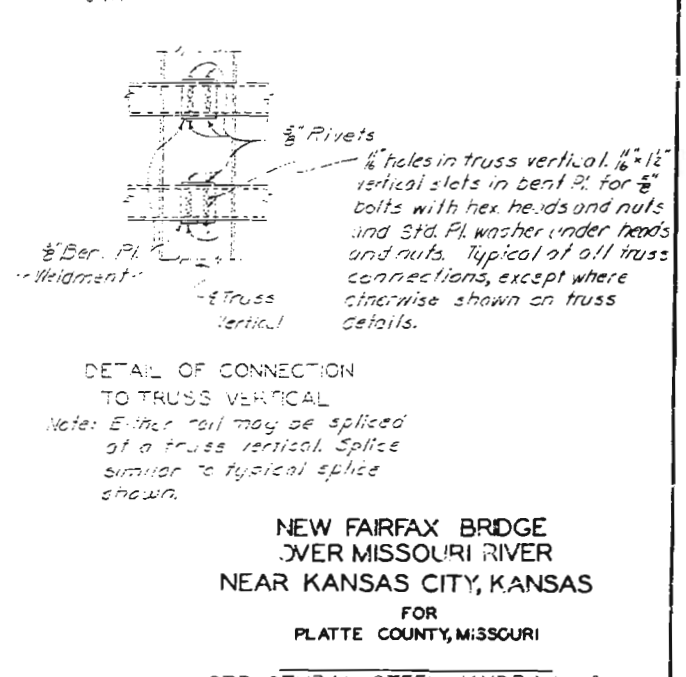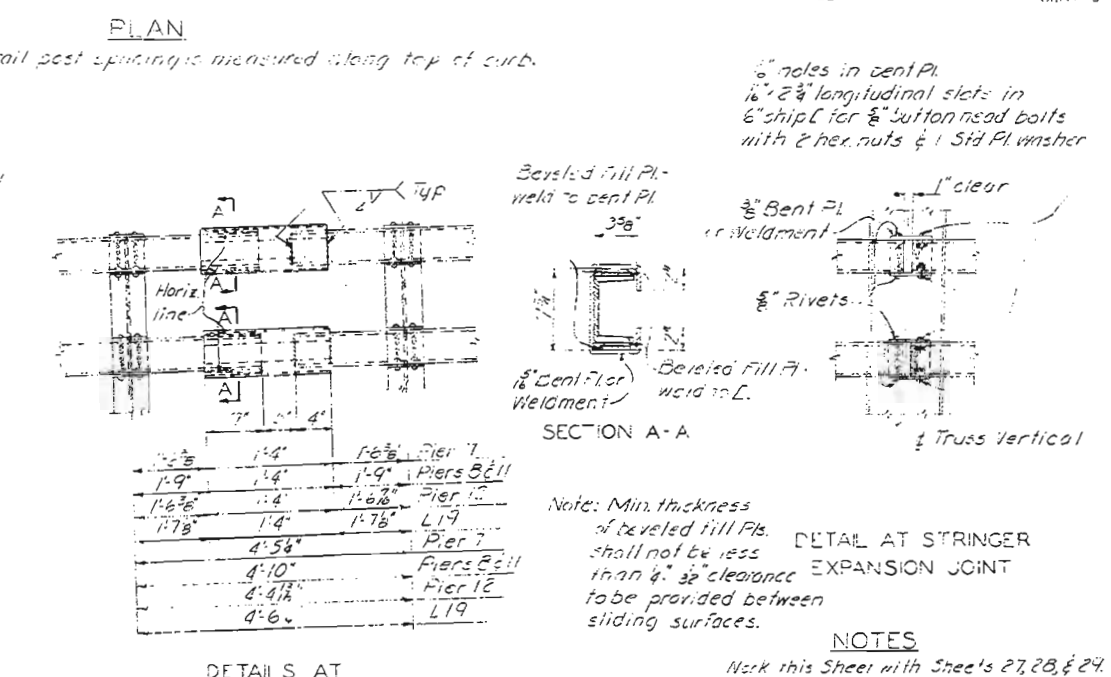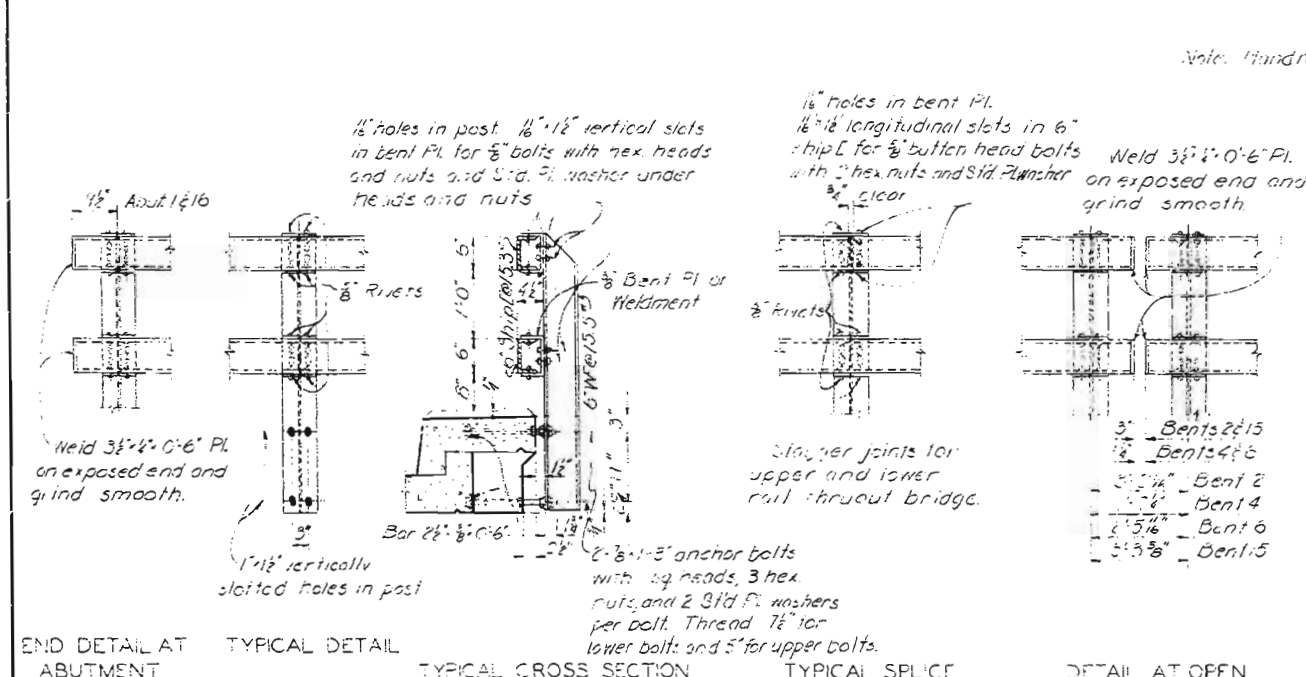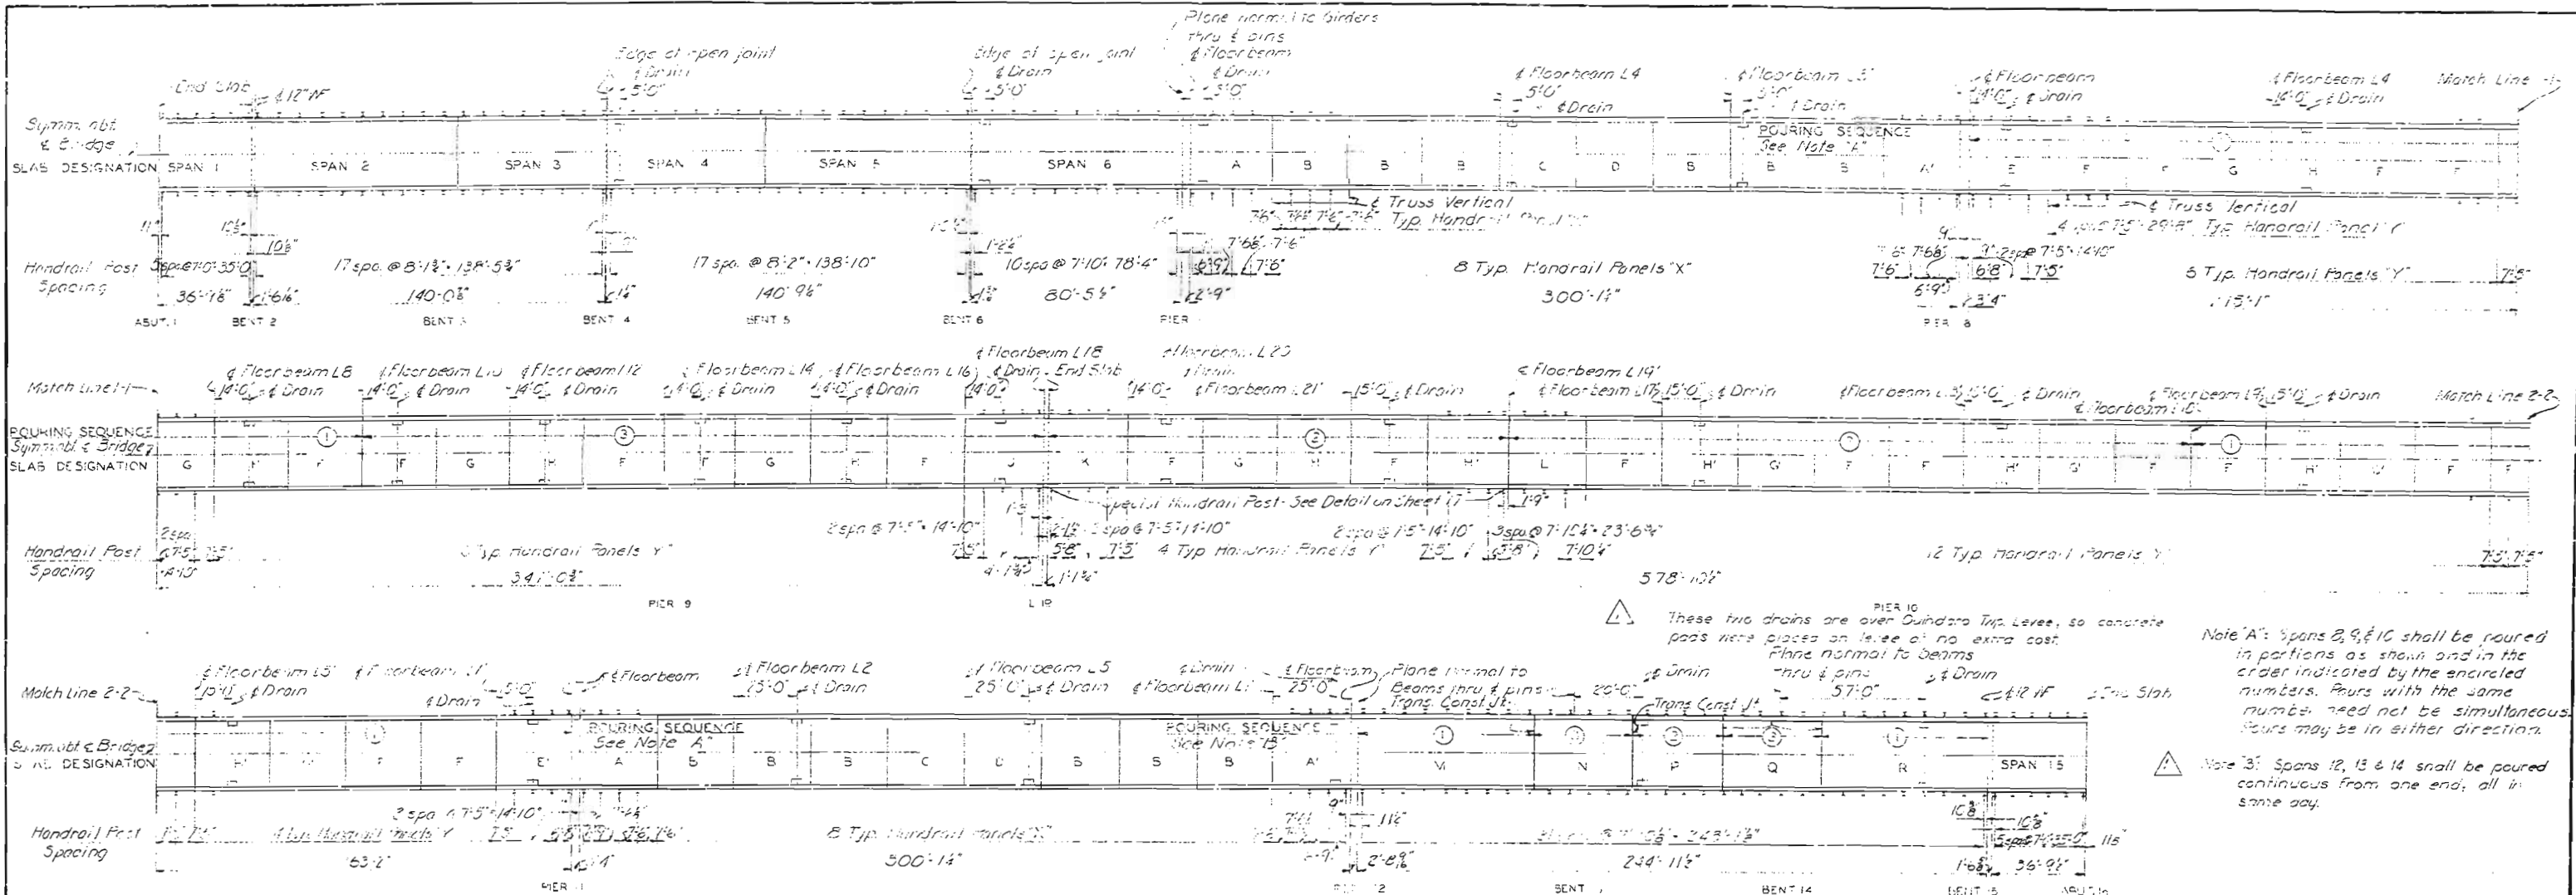

Drawn by: R. Hammer Jr., May 1956  
 Checked by: G. Pennington, May 1956

STRUCTURAL STEEL HANDRAIL  
 Note: Handrail posts to be set normal to grade.  
 Note: Do not scale this drawing. Follow dimensions.

Revision 1 Note B & Plan 1-21-59 By R.E.B. Chkd J.E.C.

NEW FAIRFAX BRIDGE  
 OVER MISSOURI RIVER  
 NEAR KANSAS CITY, KANSAS  
 FOR  
 PLATTE COUNTY, MISSOURI  
 STRUCTURAL STEEL HANDRAIL 2.  
 ROADWAY DRAIN LOCATION  
 SVERDRUP AND PARCEL, INC.  
 CONSULTING ENGINEERS  
 ST. LOUIS, MO.  
 SHEET 28 OF 31  
 A-450  
 Platte Co  
 R.E.B.



14'-9"  
11'-0" (Slope 8" per ft.)  
2'-0" (8" Parabolic Crown)  
Symm. abt. & Bridge  
Note: Spacing for Reinforcing Steel same as for Typical Half Cross Section detailed on Sheet 27.  
End S4  
End S3  
Level of Wrip  
S1  
S2  
S3  
S660

**DETAIL OF COPPER FLASHING**

Slots 1" x 2" @ 1'-0" ctrs.  
10#2-20 gals.  
Sheet Copper  
Opening to fit joint  
2"  
Joint Seal  
L.B. 3" x 3" Continous between curbs and fabricated to fit roadway.  
2" Bleeder holes @ abt. 6' 0" ctrs.  
2" sq. Bar (continuous) same as shown for Exp. Device @ Bents 4 & 6. See Sheet 7.

**SECTION AT STRINGER EXPANSION DEVICES**

See Detail B-1 Filled Joint  
Copper Flashing  
Joint Seal  
S29 or S30  
S29 or S30  
S27 or S28  
S27 or S28  
S2  
S1  
S2  
S2  
S1  
5" Floorbeam

**SECTION AT TYPICAL INTERIOR FLOORBEAM**

5" Floorbeam and 5" Filled Joint  
Joint Seal  
S1  
S1  
Edges to be neatly rounded with 3/4" ad edging tool.  
S2  
S2  
Copper Flashing

**LIMITS OF FLASHING & JOINT FILLER**

Hatched area indicates extent of joint filler.

2" Bevel  
Copper Flashing  
Joint Seal  
2"

pouring sequence, see Sheet 26.  
Work this sheet with Sheets 26, 27 & 29.  
See Sheet 30 for inserts cast in concrete for Lighting Cable Supports.

**NEW FAIRFAX BRIDGE OVER MISSOURI RIVER NEAR KANSAS CITY, KANSAS**

FOR PLATTE COUNTY, MISSOURI

SLABS - SPANS 7 TO 11

SVERDRUP AND PARCEL, INC. CONSULTING ENGINEERS ST. LOUIS, MO. FINISHED

Drawn by: R. Hammer Jr., May 1936

For location of slab panels and  
pouring sequence, see Sheet 26.  
Work this sheet with Sheets 26, 27, & 29.  
See Sheet 30 for inserts cast in  
concrete for Lighting Cable Supports.

SLABS - SPANS 7 TO 11

SVERDRUP AND PARCEL, INC.

CONSULTING ENGINEERS  
ST. LOUIS, MO.

FINISHED

25 OF 31

FINAL DESIGN DRAWING

A-450  
Platts Co  
Rt. 69


Revision  $\Delta$  Add armour angles & stringer expansion devices 12-10-56, By N.H.B. Chrs. G.R.P.  
Revision  $\Delta$  Revise exp. device & L19 (Section 4-A) 12-10-56, By N.H.B. Chkd. G.R.P.

AS BUILT DRAWING

FINAL DESIGN DRAWING


SUPERSTRUCTURE BAR LIST					
No.	Size	Length	Mark	Type	Location
2551	*5	28'-4"	S1	Spcl.	Slab
5246	*5	27'-6"	S2	Str.	do
5246	*4	4'-11"	S3	Spcl.	Curb
5246	*4	2'-8"	S4	Spcl.	do
67	*4	36'-7"	S5	Str.	Slab/Curb
134	*4	40'-10"	S6	Str.	do
134	*4	30'-3"	S7	Str.	do
134	*4	30'-3"	S8	Str.	do
134	*4	40'-11"	S9	Str.	do
134	*4	40'-9"	S10	Str.	do
			S11	Not Used	
			S12	Not Used	
			S13	Not Used	
			S14	Not Used	
1160	*4	2'-0"	S15	Str.	Bracket
1160	*4	5'-7"	S16	Spcl.	do
36	*4	5'-0"	S17	Str.	Haunch
126	*4	3'-2"	S18	Spcl.	do
			S19	Not Used	
			S20	Not Used	
			S21	Not Used	
			S22	Not Used	
268	*4	29'-8"	S23	Str.	Slab/Curb
134	*4	29'-6"	S24	Str.	do
804	*4	29'-10"	S25	Str.	do
1340	*4	29'-6"	S26	Str.	do
134	*4	29'-3"	S27	Str.	do
670	*4	28'-11"	S28	Str.	do
134	*4	30'-4"	S29	Str.	do
670	*4	30'-0"	S30	Str.	do
67	*4	27'-11"	S31	Str.	do
67	*4	29'-10"	S32	Str.	do
67	*4	36'-7"	S33	Str.	do
134	*4	33'-8"	S34	Str.	do
134	*4	54'-4"	S35	Str.	do
84	*4	20'-0"	S36	Str.	do
67	*4	38'-10"	S37	Str.	do
134	*4	33'-8"	S38	Str.	do
80	*4	6'-0"	S39	Str.	Slab

Drawn by: R. Hamner Jr., May 1956  
 Checked by: G.R. Pennington, June 1956

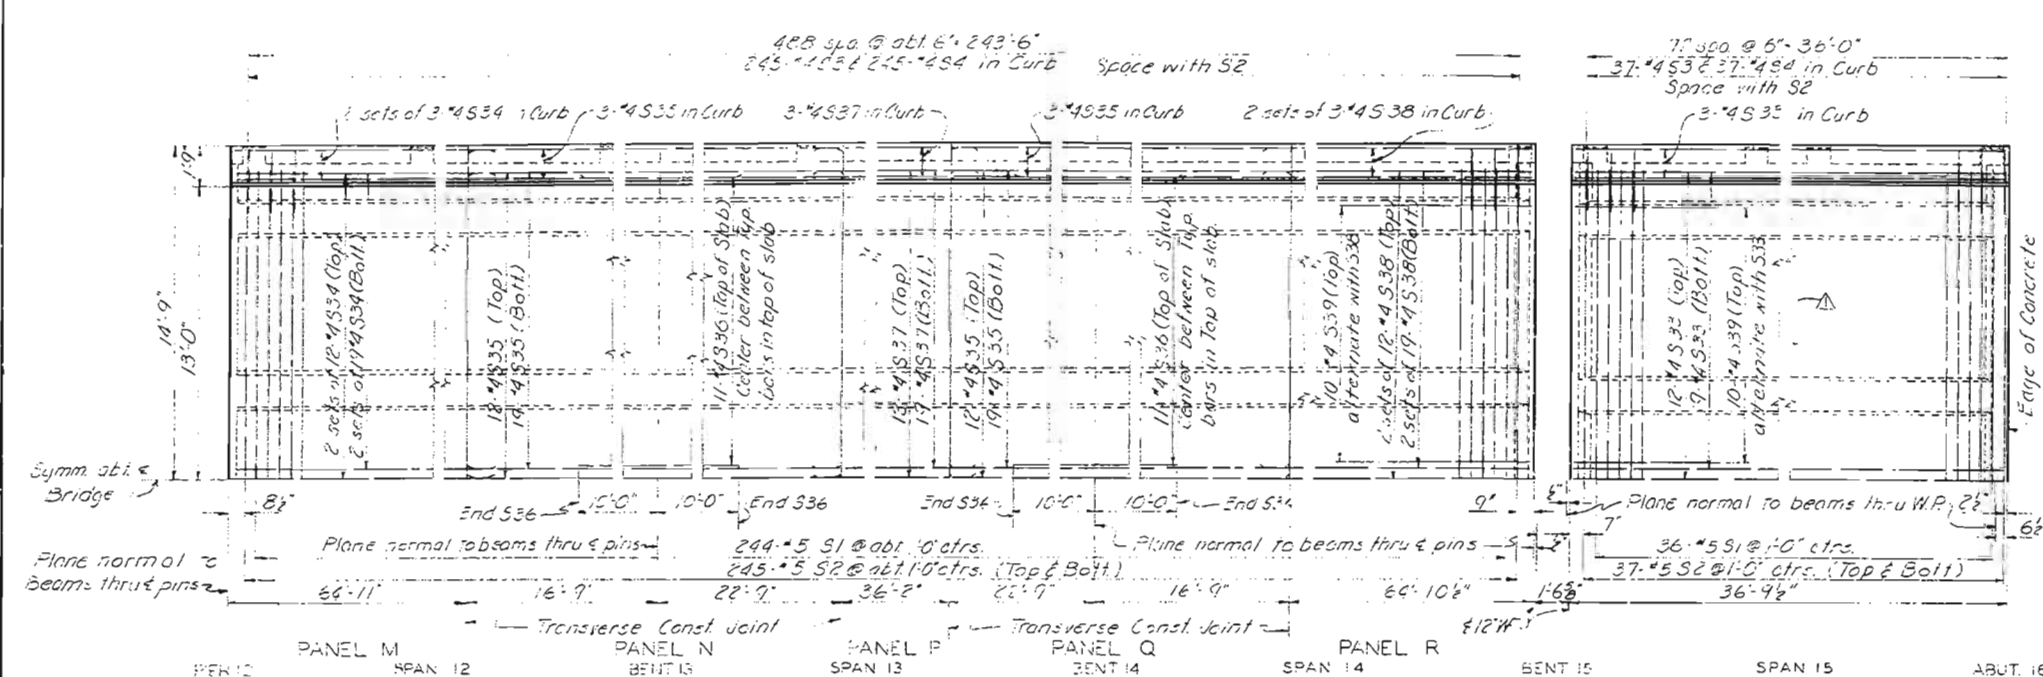

PLAN

Note: For Typical Cross Section see Sheet 27.  
 For sections at Bent 15 and Abut. 16 see Sheet 27.  
 For slab pouring sequence see Sheet 26.

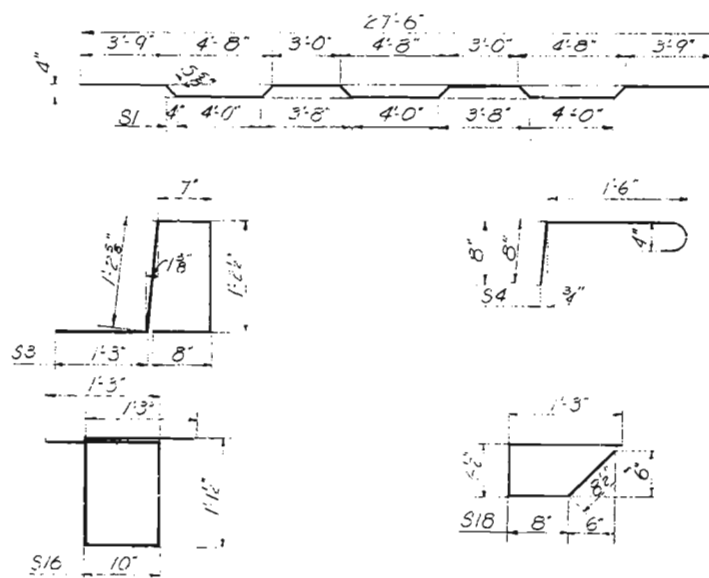


SPECIAL BENDING DETAILS

Note: All bar dimensions are out to out.  
 Bar size numbers indicate diameter of bar in 8 inches.

TABLE OF HAUNCH HEIGHTS - "Y"			
Point	0	1	2
Span 12	1.0	1.0	1.0
Span 13	1.0	1.0	1.0
Span 14	1.0	1.0	1.0
Span 15	1.0	1.0	1.0


Haunch heights are given in inches.  
 For location of dimension "Y", see Typ. Half Cross Section on Sheet 27.  
 Y's measured to top of beam flange, not top of cover plate.  
 Haunch heights include dead load deflections shown on Sheet 5.

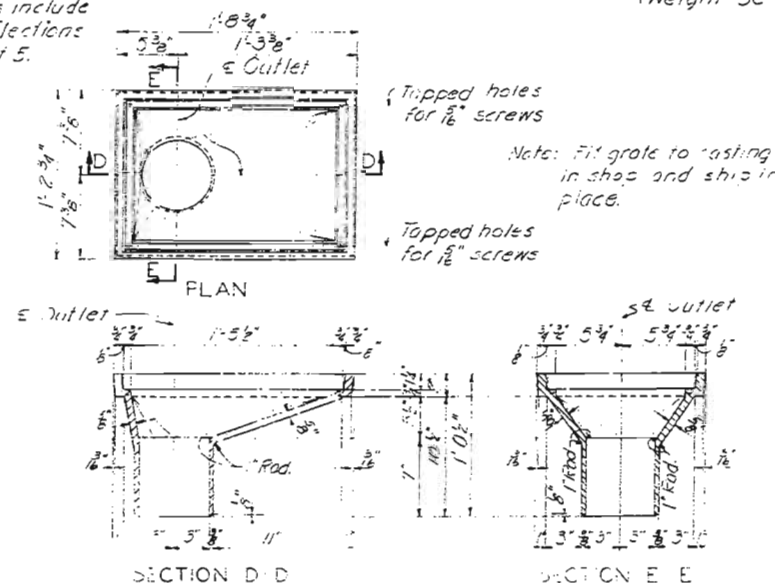

DETAIL OF CASTING

Casting to be made of Gray Iron (Weight 98" 50 Required)


Revision A Add bar S39 12-10-56 B, H.H.B. Chkd G.R.P.

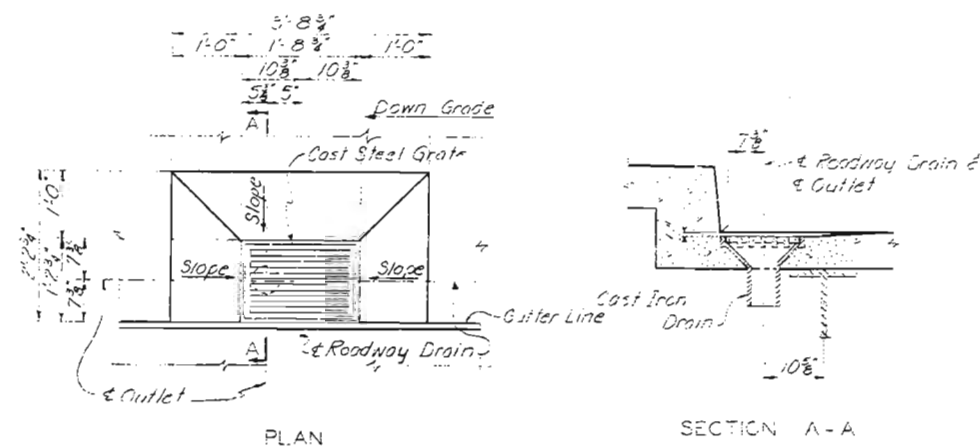

ROADWAY DRAIN

SECTION A-A

Note: For Spans 4 and 6, notch top flange of beam or girder sufficiently to clear drain casting.

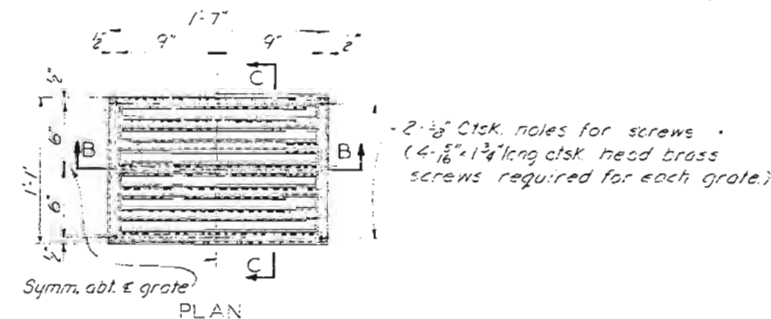

SECTION B-B

SECTION C-C

DETAILS OF GRATE

Grate to be made of Cast Steel.  
 (Weight 50" 50 Required)

NOTES

Work this Sheet with Sheets 26, 27 & 28.  
 See Sheet 30 for inserts cast in concrete for Lighting Cable Supports.

NEW FAIRFAX BRIDGE  
 OVER MISSOURI RIVER  
 NEAR KANSAS CITY, KANSAS  
 FOR  
 PLATTE COUNTY, MISSOURI

SLABS - SPANS 12 TO 15 &

ROADWAY DRAINS

SVERDRUP AND PARCEL, INC.  
 CONSULTING ENGINEERS  
 ST. LOUIS, MO

SHEET 23 OF 31

4-450

AS BUILT DRAWING

FINAL DESIGN DRAWING

Platte Co.  
 R. 64


Note: Do not scale this drawing. Follow dimensions.



Handrail shall be shop fabricated with members welded together with minimum of 1/4" fillet welds.

hinged latch bar to support light during servicing. Extend E to prevent channel light from swinging past vert position.


SECTION B-B

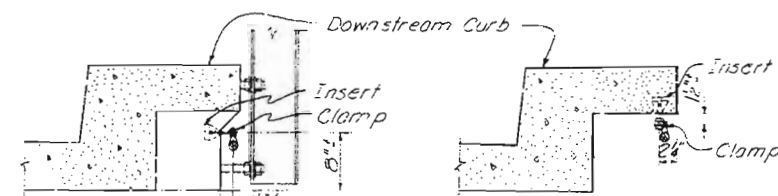


CABLE SUPPORT - TYPE I  
Note: Use at handrail brackets.

Inserts to be Hohmann and Barnard Threaded Insert "HD" or equal with 1/2" galv threaded rod and 2 galv hex nuts. Clamps to be Hubbard Cable Suspension Clamps "B901" or equal.

CABLE SUPPORT - TYPE II  
Note: Use near panel points on truss spans (where there are no handrail brackets) and at other points between handrail brackets where support for the cable may be necessary.

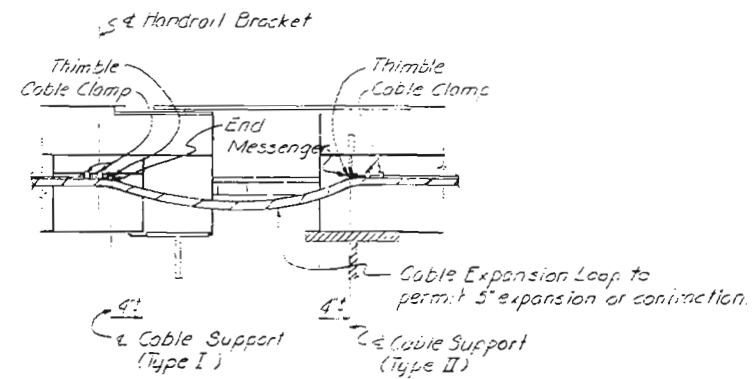


CABLE EXPANSION LOOP AT ROADWAY EXPANSION DEVICES  
Note: Drawn for L19. Similar detail at Piers 8, 11, 12 and Bent 15.

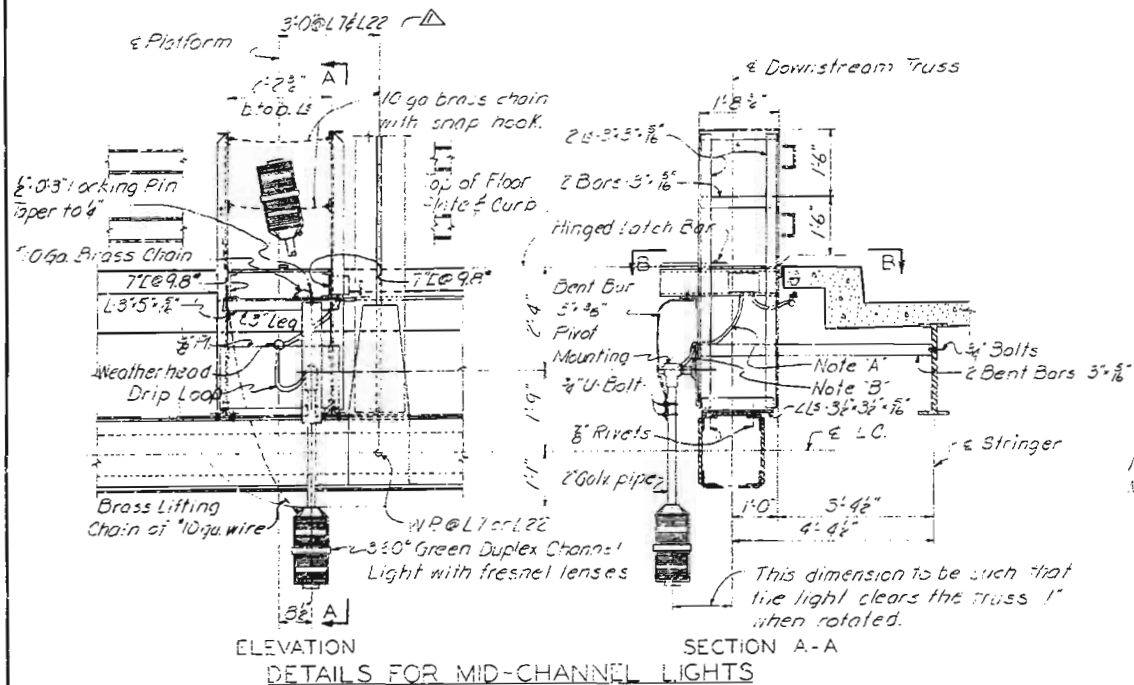

DETAILS FOR MID-CHANNEL LIGHTS

Note: Drawn for L7; L22 is similar. Pipe support bracket not shown.


Note "A" Rigid galv. conduit to weatherhead. Note "B" Extra-flexible rubber insulated neoprene jacketed 1/2" 12 AWG cable.

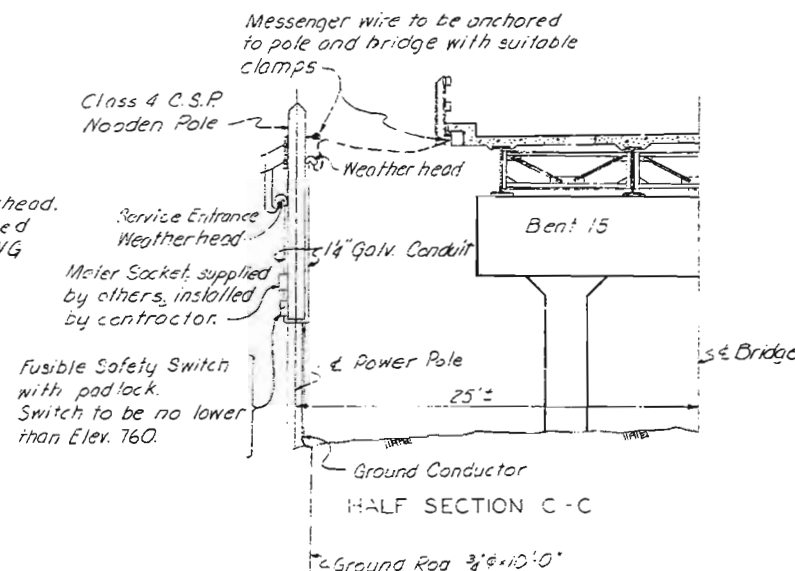


HALF SECTION C-C

NOTES

Work this Sheet with Sheets 21 & 31. Cable running longitudinally along bridge from point of entrance on Span 15 to Panel Point L5 on Span 7 shall be supported by Cable Supports, Type I or Type II, at all handrail brackets, panel points and other points as required by expansion loops or junction boxes.

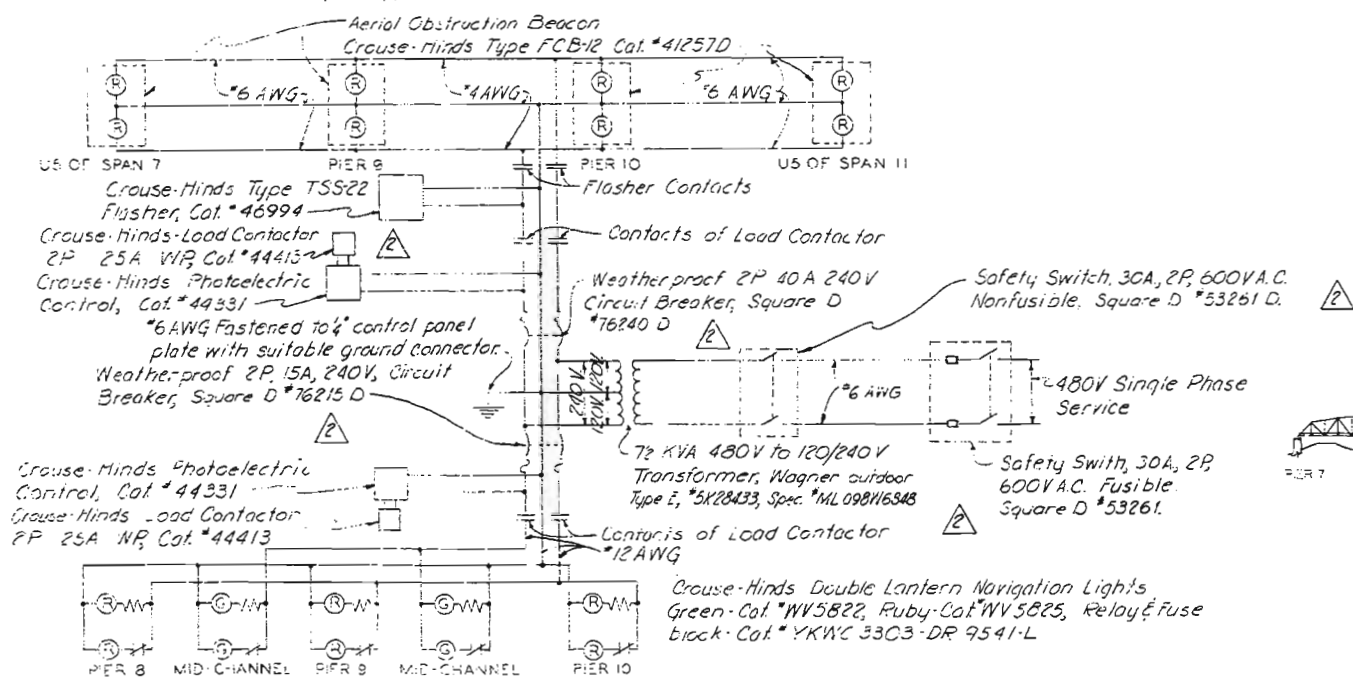

SCHEMATIC WIRING DIAGRAM  
Transformer and Photoelectric Control to be located at Pier 10 (U14)

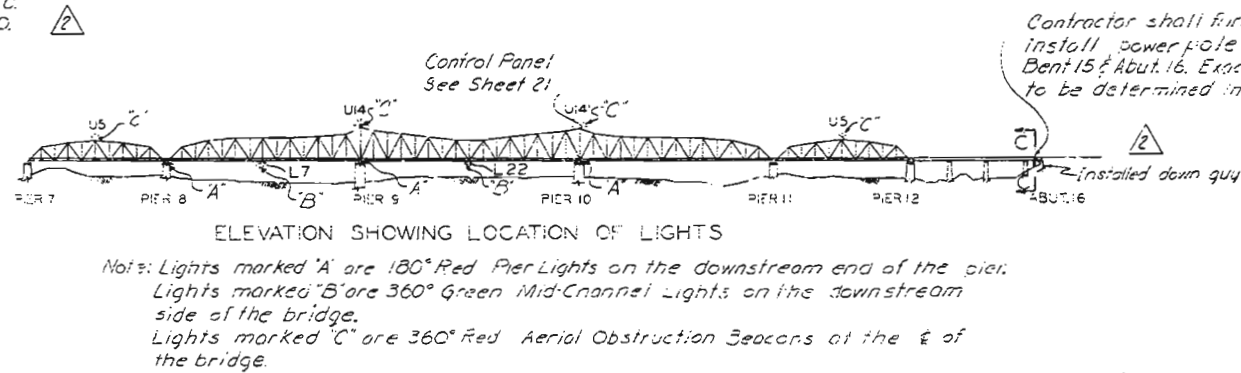

Notes: Lights marked "A" are 180° Red Pier Lights on the downstream end of the pier. Lights marked "B" are 360° Green Mid-Channel Lights on the downstream side of the bridge. Lights marked "C" are 360° Red Aerial Obstruction Beacons at the E of the bridge.

Contractor shall furnish and install power pole between Bent 15 & Abut. 16. Exact location to be determined in field.

NEW FAIRFAX BRIDGE  
OVER MISSOURI RIVER  
NEAR KANSAS CITY, KANSAS  
FOR  
PLATTE COUNTY, MISSOURI

NAVIGATION LIGHTING DETAILS

SVERDRUP AND PARCEL, INC.  
CONSULTING ENGINEERS  
ST. LOUIS, MO.

Note: Do not scale this drawing. Follow dimensions.


Revision A Wiring Diagram, Notes & Elevation 1-21-59 By R.E.B. Chkd. J.E.C.  
Revision B Mid Channel Light Location Dimension, 11-20-56 By R.H.H., Cld. G.R.R. SHEET 30 OF 31

AS BUILT DRAWING

FINAL DESIGN DRAWING

Platte Co.  
Rt. 69

Drawn by: R.H.H., May 1956  
Checked by: G.P. Pennington, June 1956

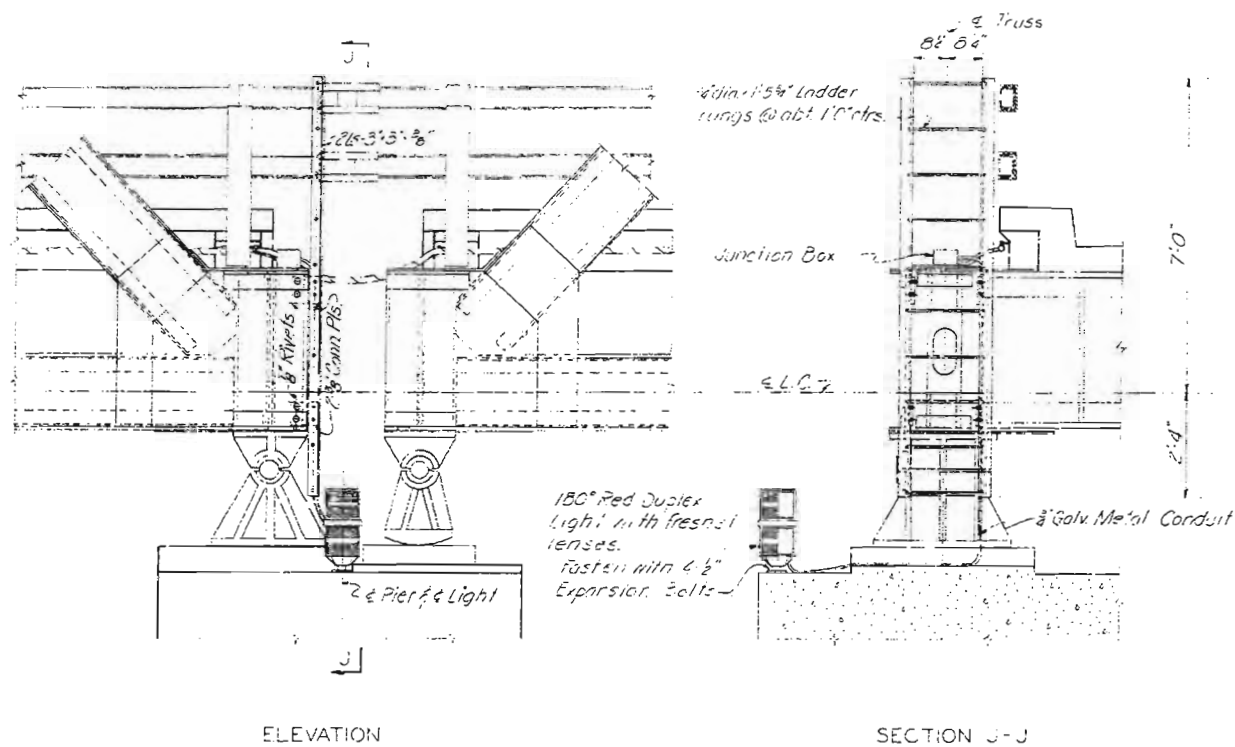


#### DETAIL OF LIGHT AND LADDER AT PIER 8

Note: Roadway expansion device and pipe support bracket not shown.

#### NOTES


Work this Sheet with Sheets 21 & 30.  
All rivets are 3/4" unless otherwise noted.

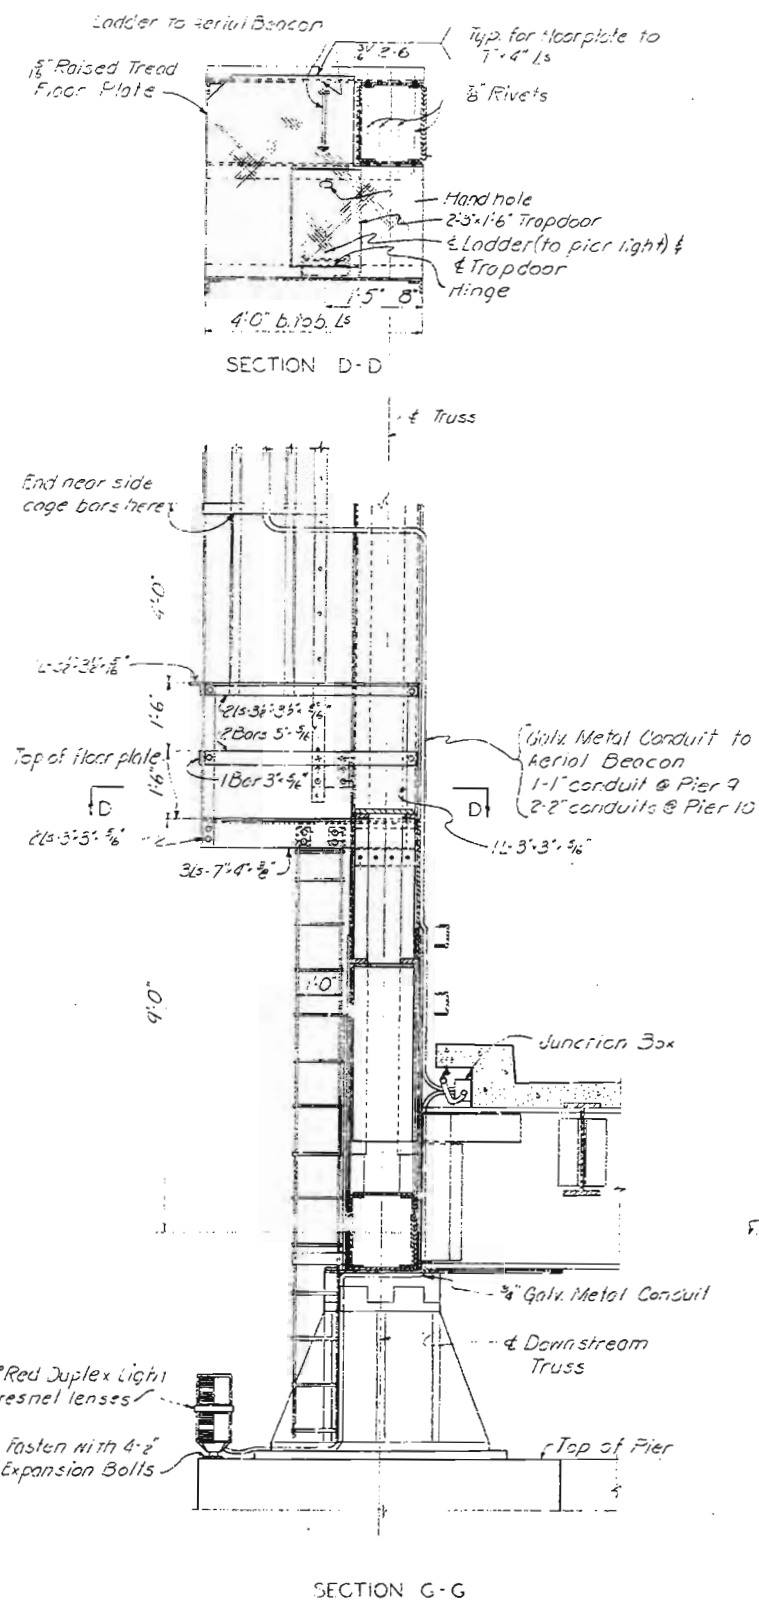

#### DETAIL OF LIGHT AND LADDER AT PIER 9

Details at Pier 10 opposite hand.

Note: Pipe support & part of truss details not shown.  
See Sheet 21 for details of Aerial Beacon Access.

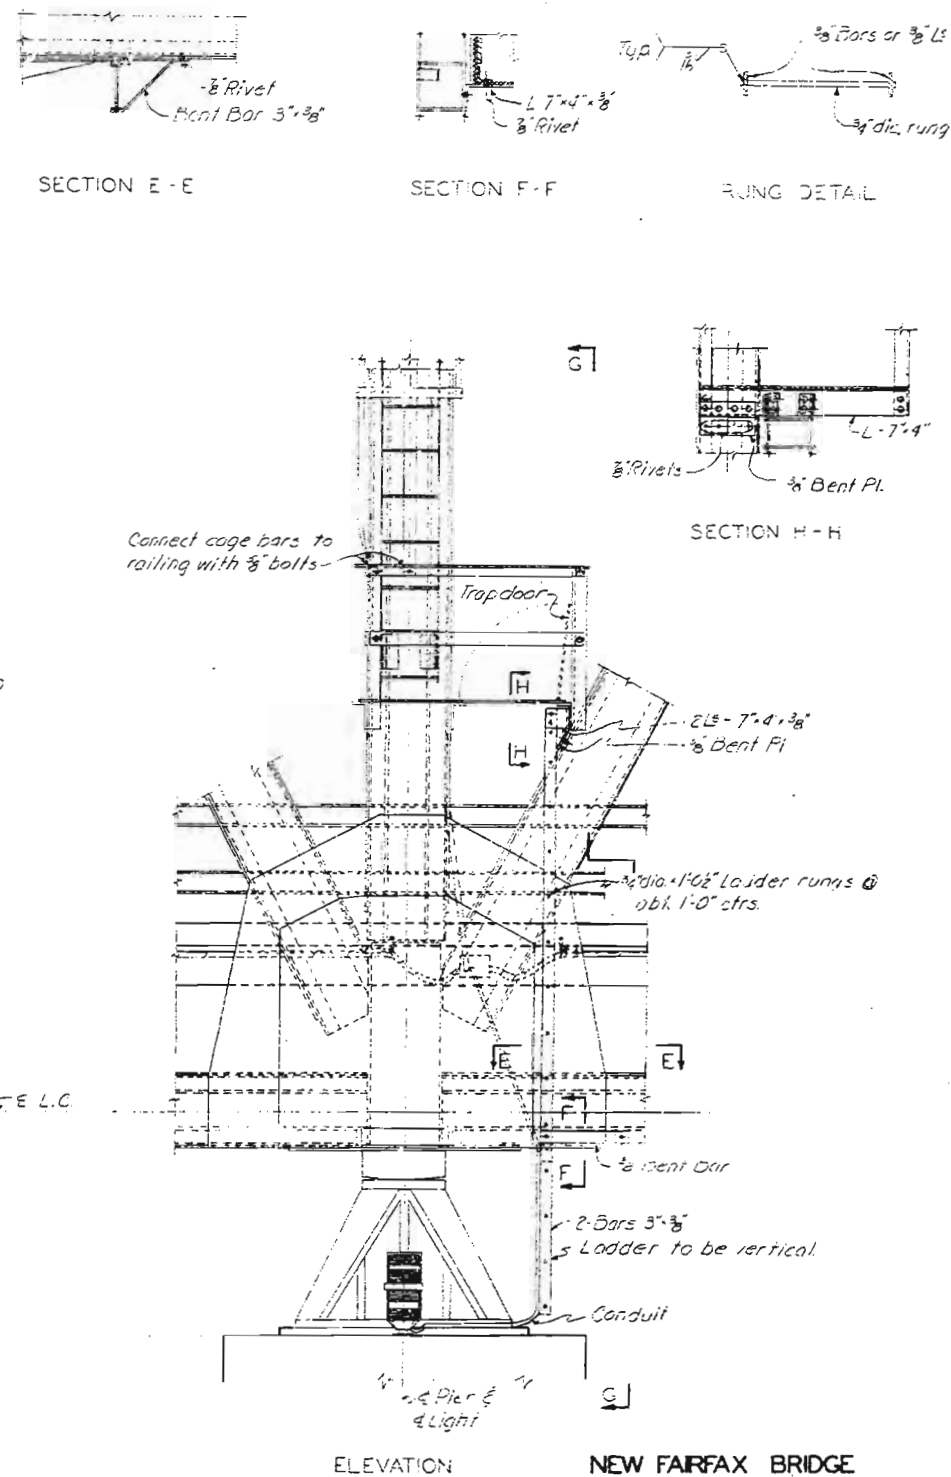

NEW FAIRFAX BRIDGE  
OVER MISSOURI RIVER  
NEAR KANSAS CITY, KANSAS  
FOR  
PLATTE COUNTY, MISSOURI

NAVIGATION LIGHTING DETAILS

SVERDRUP AND PARCEL, INC.  
CONSULTING ENGINEERS  
ST. LOUIS, MO.

SHEET 3 OF 31

AS BUILT DRAWING

FINAL DESIGN DRAWING

A-450  
Platte Co.  
Pl. 69

Drawn by: R. Hammer Jr., June 1936  
Checked by: G. R. Pennington, June 1936

Note: Do not scale this drawing. Follow dimensions.

511

# PLATTE PURCHASE BRIDGE

BUILT BY  
PLATTE COUNTY, MISSOURI  
WITH THE COOPERATION OF  
MISSOURI STATE HIGHWAY COMMISSION  
AND  
STATE HIGHWAY COMMISSION OF KANSAS

A.D. 1957  
COMMEMORATING THE PLATTE PURCHASE, BEING THAT TERRITORY  
NOW COMPRISING PLATTE, BUCHANAN, ANDREW, HOLT, ATCHISON AND  
MCDRAW COUNTY, FROM THE IOWA, SAC AND FOX INDIANS  
SEPTEMBER 17, 1805

COUNTY COURT OF PLATTE COUNTY  
WM. ANDERSON - PRESIDING JUDGE 1956  
HOLT COFFEY - PRESIDING JUDGE  
O. WAYNE THOMPSON - JUDGE WESTERN DISTRICT  
HOMER E. NASH - JUDGE EASTERN DISTRICT

SVERDRUP & PARCEL, INC. - CONSULTING ENGINEERS  
KANSAS CITY BRIDGE CO. - BRIDGE CONTRACTOR  
J. A. TOBIN CONSTRUCTION CO. - APPROACH CONTRACTOR

NAME PLATE  
(2 Required)

Note: Do not scale this drawing. Follow dimensions.


## NOTES

Name plates shall be located on simple truss spans on member La-U downstream, south end of bridge and member La-U upstream, north end of bridge.


Supports for name plates to be paid for as fabricated structural steel.

Name plates to be made of bronze, 1/4" thick with 1/8" raised, polished surface letters and border, with a pebbled finished background.

Bolts for attaching name plates to be 1/2" bronze bolts with hexagonal heads and nuts. Nuts to be brazed to bolts after assembly.

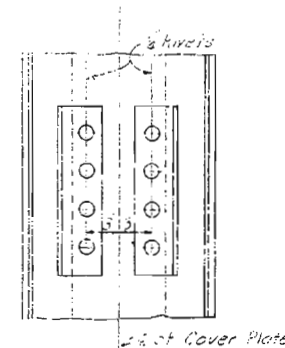

SECTION A-A

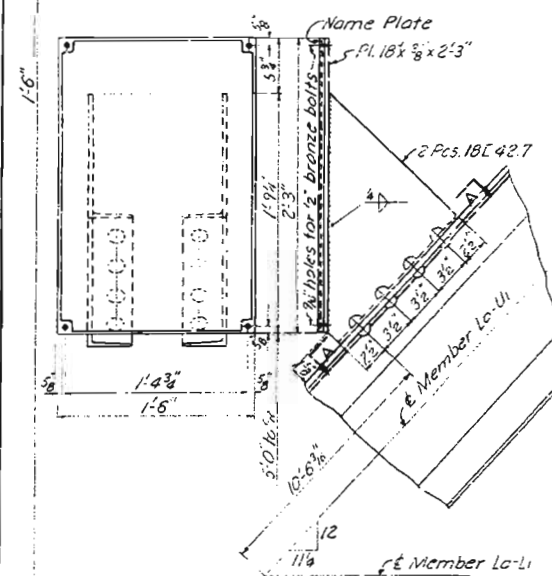

SUPPORT FOR NAME PLATE  
(2 Required)

NEW FAIRFAX BRIDGE  
OVER MISSOURI RIVER  
NEAR KANSAS CITY, KANSAS  
FOR  
PLATTE COUNTY, MISSOURI

## NAME PLATES & SUPPORTS






SVERDRUP AND PARCEL, INC.  
CONSULTING ENGINEERS  
ST. LOUIS, MO.

SHEET 31A

AT BUILT DRAWING

A-450  
Platte Co.  
Pl. 69

FED. ROAD DIST. NO.	STATE	FED. AID PROJ. NO.	FISCAL YEAR	SHEET NO.	TOTAL SHEETS
5	MO.		21	3	

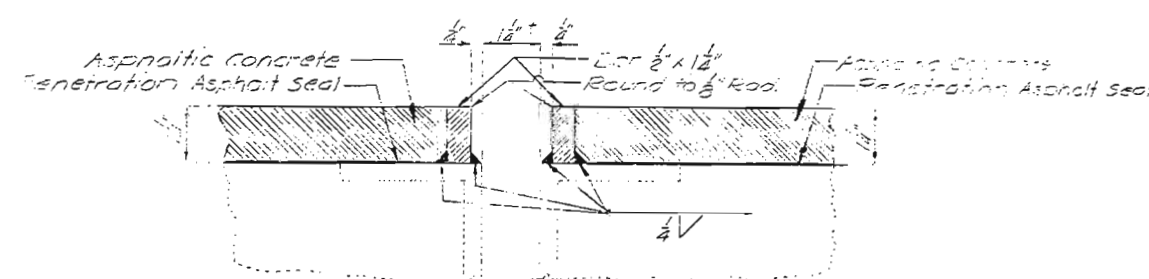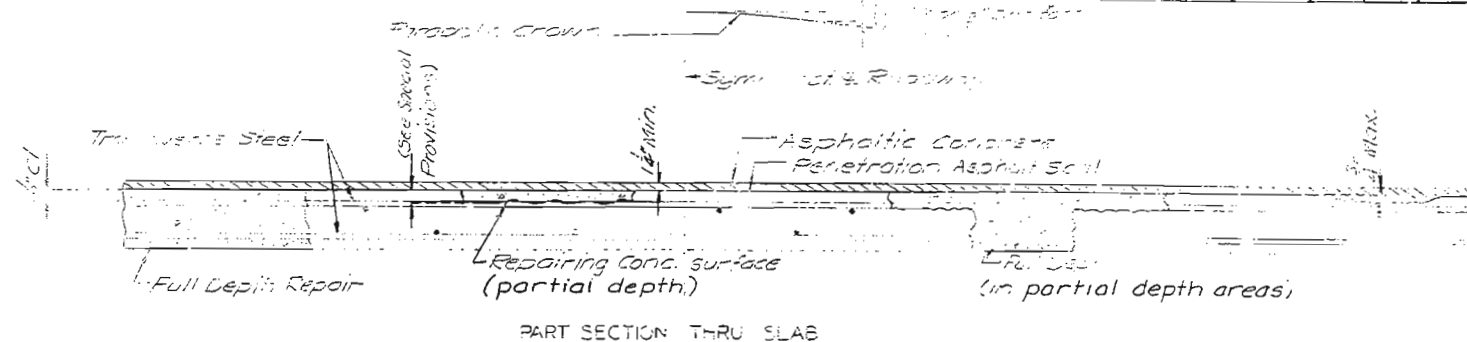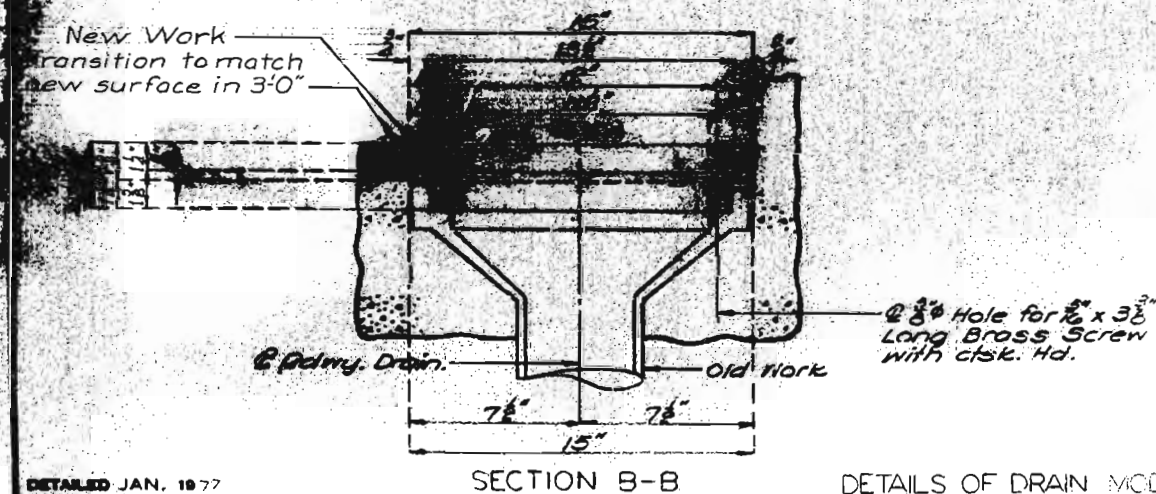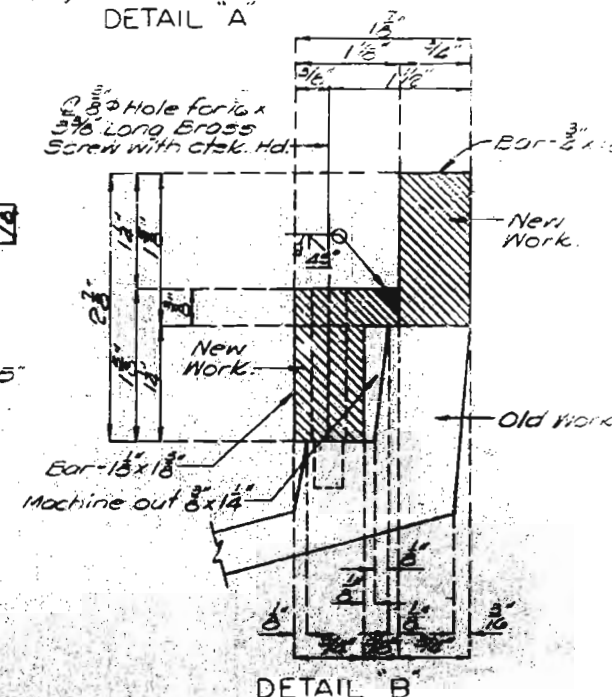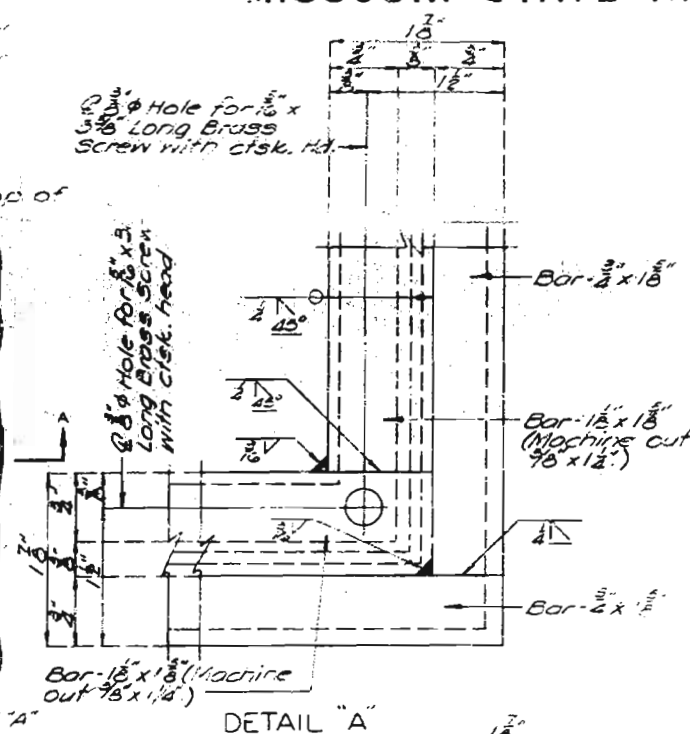

For space "X" in 5td. 712.40, match existing expansion openings.

ESTIMATED QUANTITIES	
ITEM	TOTAL
Asphalt Cement & Asphalt Concrete	700 22
Mineral Aggregate (Asphalt Concrete) (1 1/2" Max)	700 42
Grainious Material (Sand) (1/4")	500 127
Cover concrete (1-1 1/2" x 1")	700 54
Reinforcing Concrete Deck (partial depth)	50.75 9000
Full Depth Repair	30.75 900
Drill Rods/Tools	500 50
Steel Tie Bars	500 50
Special Work	Lump Sum 1

Interpretation shall verify oil chargeable in field before the oil can be sold.

PLATTE COUNTY, MISSOURI  
WYANDOTTE COUNTY, KANSAS

STA. 12+07.07  
RTE. 69

STD 12	0
A 450	0


DETAILS OF DRAIN MODIFICATIONS

1000




FED. ROAD DIST. NO.	STATE	FED. AID PROG. NO.	FISCAL YEAR	SHEET NO.	TOTAL SHEETS
5	MO.		19	3	


PLAN OF DRAIN

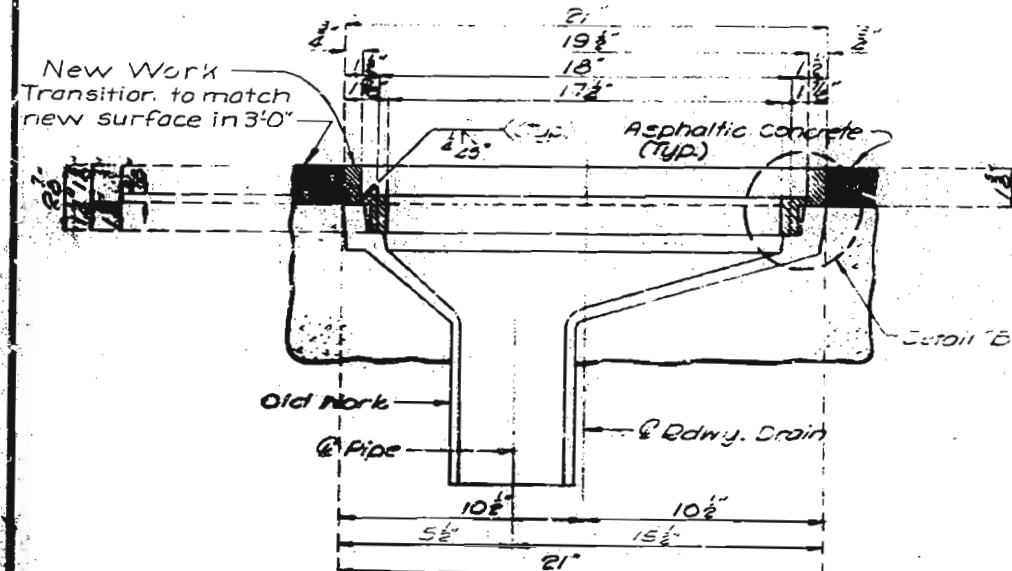

SECTION A-A

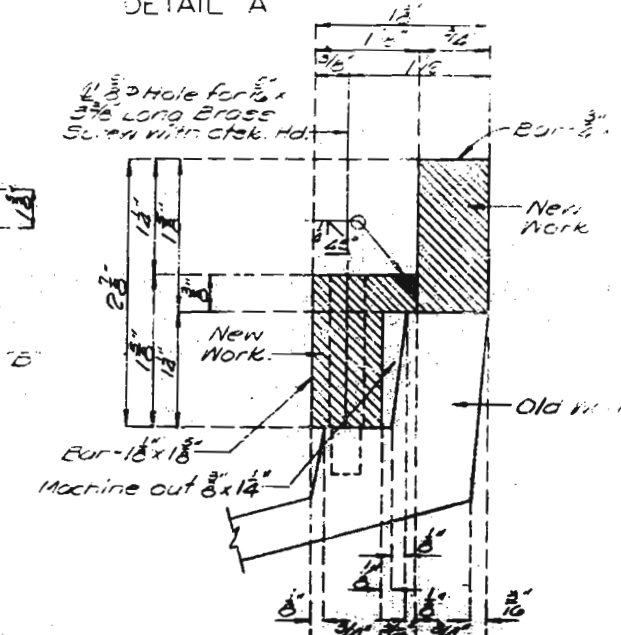


DETAIL "B"

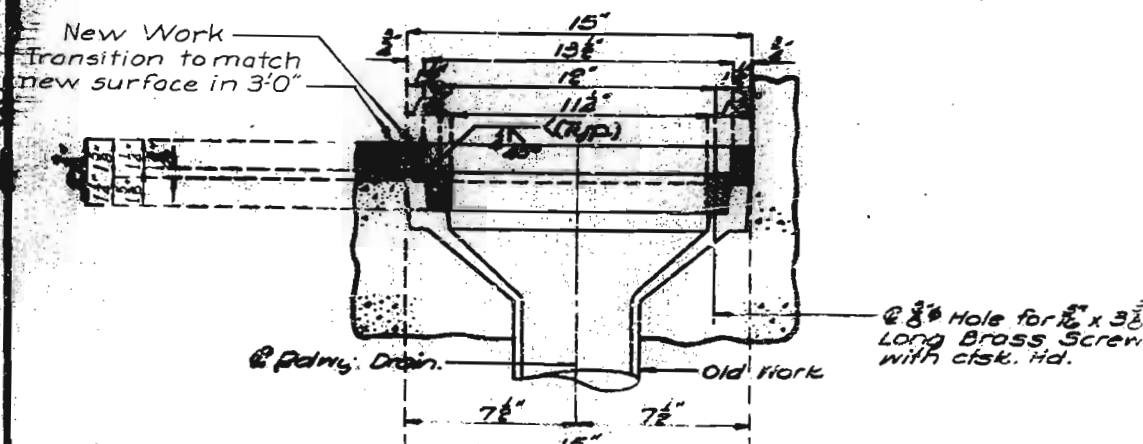


SECTION B-B

### DETAILS OF DRAIN MODIFICATIONS

Note: This drawing is not to scale. Follow dimensions.

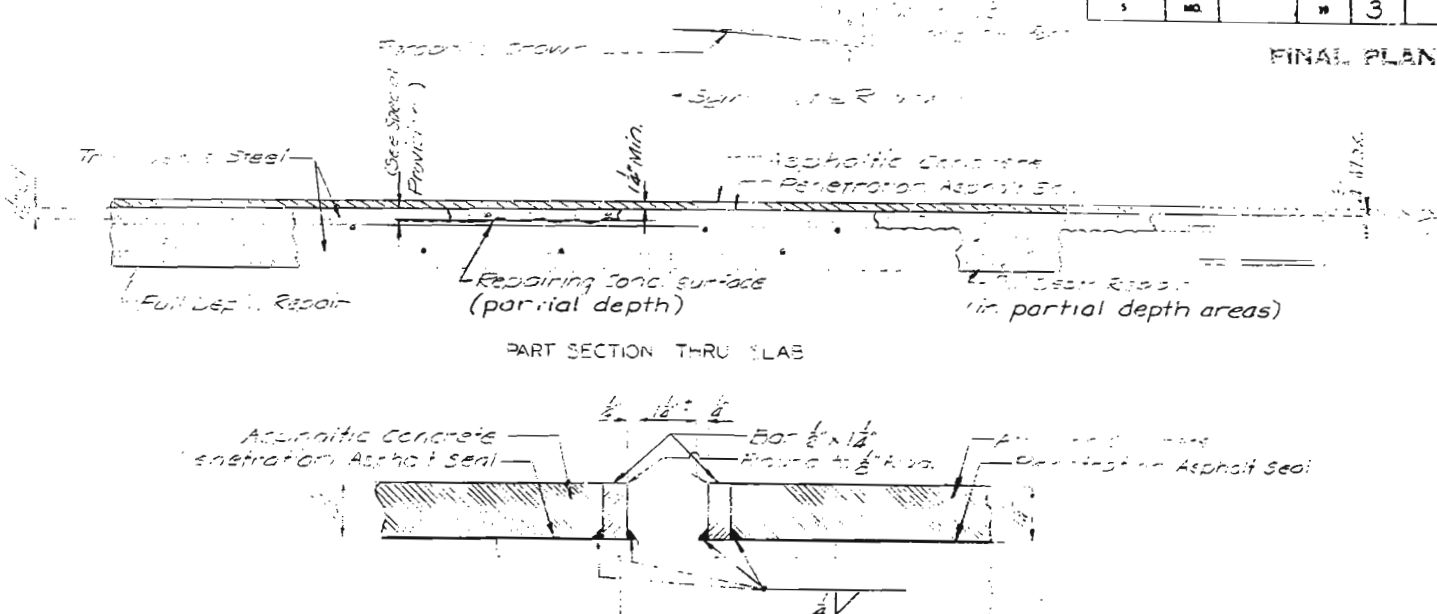

PART SECTION THRU SLAB

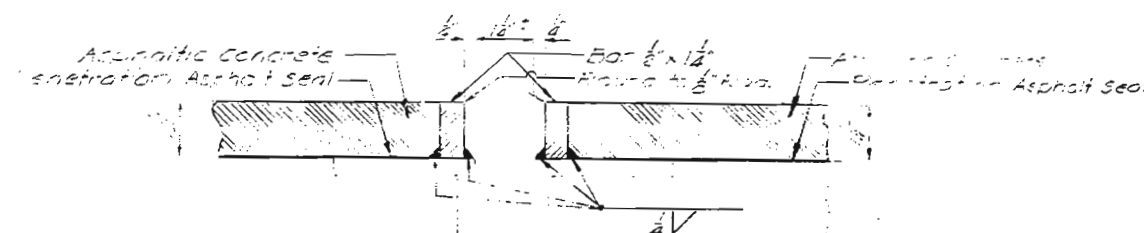

PART SECTION THRU "X" JOINT AT BENTS NO. 4 &amp; NO. 6

Note: For details of standards for other  
examination points, see General Notes for  
Examination, see Std. 712.40

For space "A", in Std. 712.40, match existing expansion openings.

FINAL QUANTITIES		
ITEM		TOTAL
Asphalt Cement (Asphaltic Concrete)	Ton	24.6
Mineral Aggregate (Asphaltic Concrete) (Special Mix)	Ton	487
Bituminous Material (Seal Coat)	Gal.	2360
Cover Aggregate (Grade 3)	Ton	94
Repairing Concrete Deck (partial depth)	Sq. Ft.	9000
Full Depth Repair	Sq. Ft.	900
Drain Modifications	Each	50
Steel Bar Dams	Each	9
Special Work	Lump Sum	1

Note: All new steel for drain modifications is A-36 and was galvanized after fabrication. Contractor verified dimensions in field before ordering new steel.

REPAIRS TO  
BRIDGE OVER MISSOURI RIVER

STATE ROAD: ROUTE 69

AT RIVERSIDE MISSOURI

PROJECT NO. 4-U-69-255

STA. 12+07.07


PLATTE COUNTY, MISSOURI  
WYANDOTTE COUNTY, KANSAS

STD. 712.40

A-450 R


MISSOURI HIGHWAY AND TRANSPORTATION COMMISSION  
REPLACE EXISTING DECK & USE-IN-PLACE  
2601.83' WIDE FLANGE/GIRDER/TRUSS SPANS

STATE	PROJ. NO.	SHEET NO.
MO.	ACSTP-ACBRS-3312(415)	12
SEC./SUR.	8 TWP. 50N RGE. 33W	

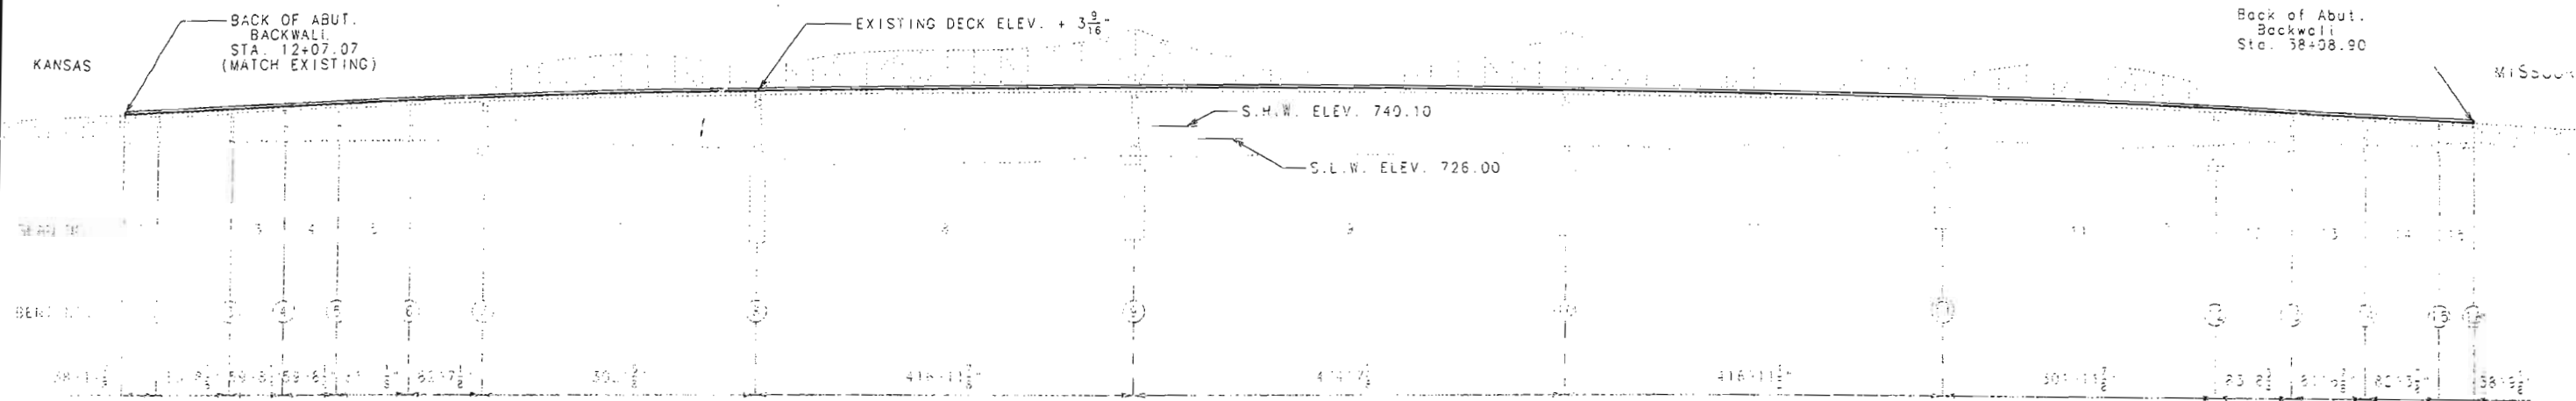

NOTE: LONGITUDINAL DIMENSIONS ARE TAKEN FROM ORIGINAL CONSTRUCTION PLANS AND ARE MEASURED ALONG PROFILE GRADE. (MATCH EXISTING)  
DASHED LINES INDICATE EXISTING STRUCTURE.  
SOLID LINES INDICATE NEW WORK.

ELEVATION

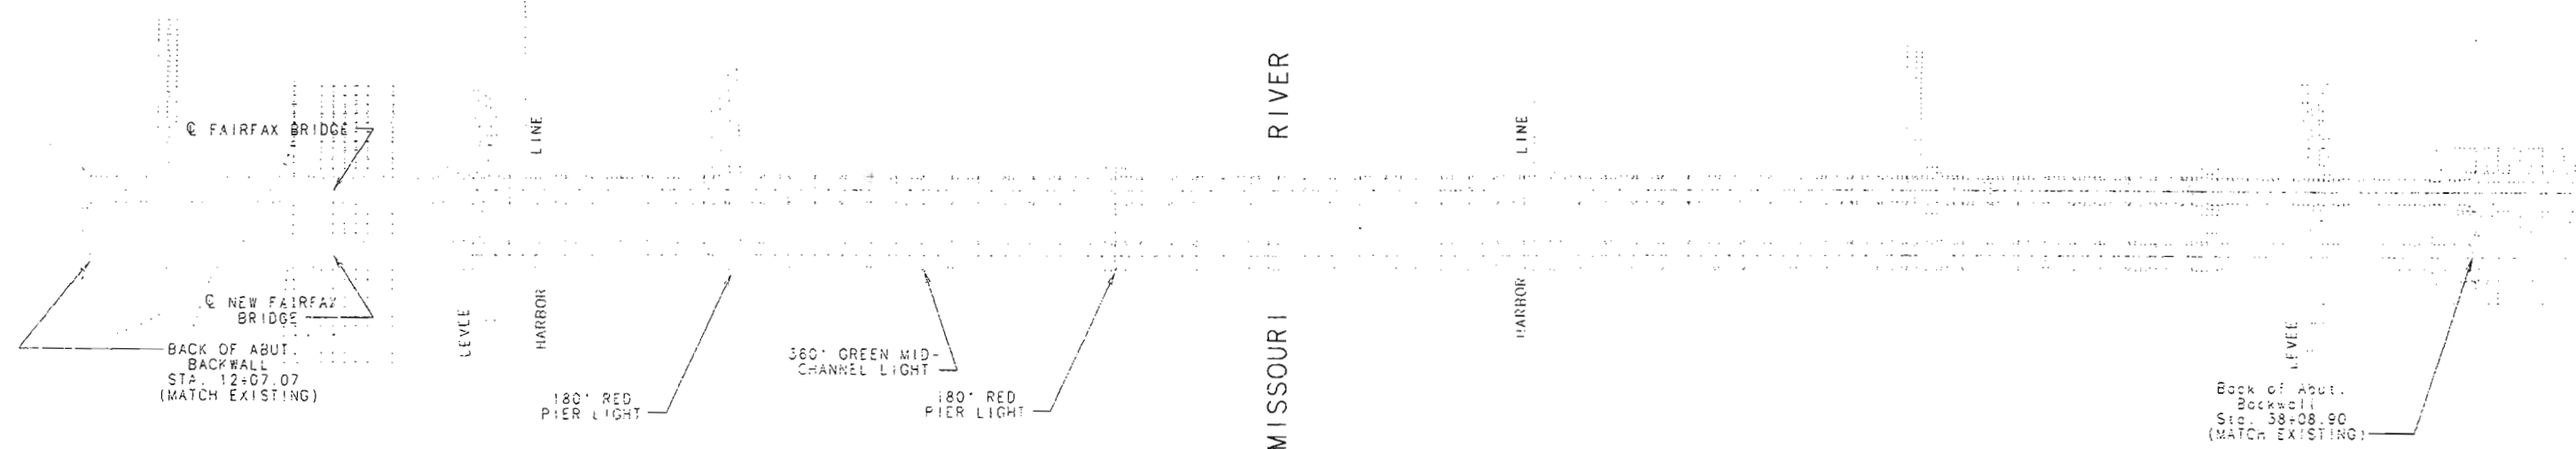

PLAN

**NOTICE AND DISCLAIMER REGARDING BORING LOG DATA**  
The boring data as well as any other boring logs or other factual records of subsurface data and investigations performed by the department for the design of the project, should be obtained from the commission upon written request as outlined in the project special provisions. The commission does not represent or warrant that any such boring data accurately depicts the conditions to be encountered in constructing this project. A contractor assumes all risks it may encounter in basing its bid prices, time or schedule of performance on the boring data or those available from the district, or on any other documentation not expressly warranted, which the contractor may obtain from the commission.



STATE OF MISSOURI  
I HEREBY CERTIFY THAT THIS DRAWING ACCURATELY REPRESENTS THE CONFIGURATION AND LOCATION OF THE ROADWAY AND APPURTENANCES AS DESIGNED FOR CONSTRUCTION ON THIS PROJECT.

REPAIRS TO: NEW FAIRFAX  
BRIDGE OVER MISSOURI RIVER  
BRIDGE OVER MISSOURI RIVER BETWEEN  
THE STATES OF KANSAS & MISSOURI  
PROJECT NO. STA. 12+07.07  
JOB NO. J4U0852 (MATCH EXISTING)  
PLATTE COUNTY  
DATE 12/2/96

STD.	504.00
STD.	605.10
STD.	606.22
STD.	609.0C
STD.	706.35
STD.	902.15
A450R1	

DESIGNED JAN. 1996  
DETAILED JAN. 1996  
CHECKED JUNE 1996

NOTE: THIS DRAWING IS NOT TO SCALE. FOLLOW DIMENSIONS.

SHEET NO. 11 OF 50

FINAL QUANTITIES			
ITEM	SUBSTR.	SUPERSTR.	TOTAL
Remove abandoned Utility Bracket	Each		6
Partial Removal of Substructure Concrete	Lump Sum		1
Removal and Storage of Existing Bridge Rail	Lin. Ft.	5,204	5,204
Removal of Existing Bridge Deck	Sq. Ft.	76,754	76,754
Bridge Approach Slab (Bridge)	Sq. Yd.	182.0	182.0
Protective Coating-Concrete Bents(Deleterious Agents)	Each		10
Substructure Repairs (Formed)	Sq. Ft.	1,509	1,509
Substructure Repairs (Unformed)	Sq. Ft.	938	938
Slab on Steel	Sq. Yd.	8,475	8,475
Safety Barrier Curb	Lin. Ft.	5,204	5,204
Preformed Compression Expansion Joint Seal (2.5 in.)	Lin. Ft.	405	405
Preformed Compression Expansion Joint Seal (3.5 in.)	Lin. Ft.	81	81
Navigation Lighting System	Lump Sum		1
Expansion Device (Finger Plate) (Bts.#7 & #12)	Lin. Ft.	54	54
Expansion Device (Finger Plate) (Bts.#8 & #11)	Lin. Ft.	54	54
Expansion Device (Finger Plate) (at L19)	Lin. Ft.	27	27
Expansion Device (Finger Plate) (at L19)	Each	102	102
Surface Preparation for Applying Structural Steel	Lump Sum		1
Field Application of Inorganic Zinc Primer	Lump Sum		1
Field Coat (System G) Gray	Lump Sum		1
Transporting Lead Contaminated Residue to Storage Area	Lump Sum		1
Transporting Lead Contaminated Residue to the Smelter	Lump Sum		1
Disposal of Lead Contaminated Residue	Lump Sum		1
Add Shear Connectors to Stringers (on Truss)	Each	29,184	29,184
End Bent Replacement	Each	2	2
Bridge Deck Grinding	Lump Sum	1	1
Structural Steel Repair	Unit	76,350.53	76,350.53

\* Safety barrier curb shall be cast-in-place option or slip-form option.

# PLATTE COUNTY A450R1 INDEX OF DRAWINGS

- |   |   |
|---|---|
| 1 - PLAN AND ELEVATION OF STRUCTURE                       | 27 - SLAB UNITS J,K,L,S,R, & Q                      |
| 2 - GENERAL NOTES - ESTIMATED QUANTITIES                  | 28 - SLAB UNIT M                                    |
| 3 - SUBSTRUCTURE REPAIR -,PROTECTIVE COATING              | 29 - SLAB UNIT N                                    |
| 4 - DETAILS OF SHEAR CONN. STUDS & HAUNCHING REIN.        | 30 - SLAB UNIT O                                    |
| 5 - HAUNCHING - DEAD LOAD DEFLECTION                      | 31 - SLAB UNIT P                                    |
| 6 - END ABUTMENTS NO.1 AND NO.16                          | 32 - SLAB UNIT W                                    |
| 7 - PREFORMED COMPRESSION JOINT SEAL (BT.#2,3,4,5,6, & 7) | 33 - SLAB UNIT X                                    |
| 8 - PREFORMED COMPRESSION JOINT SEAL (TRUSS SPANS)        | 34 - LOCATION OF SLAB DRAINS                        |
| 9 - FINGER PLATE EXPANSION DEVICE & CURB DETAIL           | 35 - LOCATION OF SLAB DRAINS                        |
| 10 - FINGER PLATE EXPANSION DEVICE AT PIER 7 & 12         | 36 - SAFETY BARRIER CURB UNITS A & B                |
| 11 - FINGER PLATE EXPANSION DEVICE AT PIER 7 & 12         | 37 - SAFETY BARRIER CURB UNITS C,D,& E              |
| 12 - FINGER PLATE EXPANSION DEVICE AT PIER 8 & 11         | 38 - SAFETY BARRIER CURB UNITS F,G,H,U,& V          |
| 13 - FINGER PLATE EXPANSION DEVICE AT PIER 8 & 11         | 39 - SAFETY BARRIER CURB UNITS I,J,K,L,M,Q,R,S,& T  |
| 14 - FINGER PLATE EXPANSION DEVICE AT L19                 | 40 - SAFETY BARRIER CURB UNITS N,O,& P              |
| 15 - FINGER PLATE EXPANSION DEVICE AT L19                 | 41 - SAFETY BARRIER CURB UNITS W & X                |
| 16 - LOCATION OF SLAB UNITS                               | 42 - SAFETY BARRIER CURB AT END ABUTMENTS           |
| 17 - SLAB POURING SEQUENCE - SLAB NOTES                   | 43 - SAFETY BARRIER CURB SLIP-FORM OPTION           |
| 18 - SLAB UNIT A  | 44 - PLAN SHOWING CONDUIT AND NAVIGATIONAL LIGHTING |
| 19 - SLAB UNIT B  | 45 - DETAILS OF CONDUIT SYSTEMS                     |
| 20 - SLAB UNIT C  | 46 - CONDUIT SYSTEMS COUPLINGS                      |
| 21 - SLAB UNIT D  | 47 - NAVIGATIONAL LIGHTING DETAILS                  |
| 22 - SLAB UNIT E  | 48 - BRIDGE APPROACH SLABS                          |
| 23 - SLAB UNIT F  | 49 - DETAILS OF BOLTED RAIL POST                    |
| 24 - SLAB UNITS G & U                                     | 50 - BAR LIST                                       |
| 25 - SLAB UNITS H & V                                     |   |
| 26 - SLAB UNITS I & T                                     |   |

ESTIMATED QUANTITIES FOR ALTERNATE SLABS			
TYPE OF SLAB	REINF. (LBS.)		CONC. (CU. YDS.)
	EPOXY	PLAIN	
CAST-IN-PLACE CONVENTIONAL FORMS	476,500	0	2138.0
STAY-IN PLACE FORMS	476,500	0	2138.0

The table of Estimated Quantities for Alternate Slabs represents the quantities used by the state in preparing the cost estimate for concrete slabs. Variations may be encountered in these estimated quantities but these variations cannot be used for an adjustment in the contract unit price per square yard of Slab on Steel.

See Special Provisions for alternate methods of forming slabs.

## GENERAL NOTES:

## DESIGN SPECIFICATIONS:

A.A.S.H.T.O.-1992 AND INTERIMS THRU 1995  
LOAD FACTOR DESIGN  
A.A.S.H.T.O.-1983 GUIDE SPECIFICATIONS  
FOR SEISMIC DESIGN  
SEISMIC PERFORMANCE CATEGORY A

## DESIGN LOADINGS:

HS20  
EARTH 120#/CU. FT.  
EQUIVALENT FLUID PRESSURE = 45#/CU. FT.  
35#/SQ. FT. FUTURE WEARING SURFACE

## DESIGN UNIT STRESSES:

CLASS B CONCRETE (SUBSTRUCTURE) f'c = 3,000 PSI.

CLASS B' CONCRETE (SAFETY BARRIER CURB) f'c = 4,000 PSI.

CLASS B2 CONCRETE (SUPERSTRUCTURE EXCEPT SAFETY BARRIER CURB) f'c = 4,000 PSI.

REINFORCING STEEL (GRADE 60) fy = 60,000 PSI.

## JOINT FILLER:

ALL JOINT FILLER SHALL MEET THE REQUIREMENTS OF STANDARD SPECIFICATION 1057.2.4, EXCEPT AS NOTED.

## REINFORCING STEEL:

MINIMUM CLEARANCE TO THE REINFORCING STEEL SHALL BE 1-1/2" UNLESS OTHERWISE SHOWN.

ALL REINFORCING STEEL SHALL BE EPOXY COATED.

## PAINTING:

Protective Coating: System G by the contractor in accordance with special provisions.

Prime Coat: The cost of the prime coat shall be included in the contract unit price of the Fabricated Structural Steel. Tint of the prime coat for System G shall be similar to the color of the field coat to be used.

Field Coat: The cost of the intermediate and finish coats shall be included in the contract unit price per Lump Sum of Field Coat (System G) Gray. See Special Provisions.

## MISCELLANEOUS:

Rehabilitation plans have been developed based on available plans. Shop drawings for structural steel and expansion devices were not available. The contractor shall verify all dimensions of the existing structure that affect dimensions of new construction before ordering new steel components for the rehabilitation work. If dimensions of miscellaneous steel parts vary from rehabilitation plans to accommodate actual construction conditions, no additional payment will be allowed.

Contractor shall maintain uninterrupted power to navigational lights. See special provisions.

Contractor shall prevent debris and other material from dropping into the river. See special provisions.

Remove abandoned utilities brackets (west side)- 6 near bt.#1 and 2 near bt.#16. Payment for the removal of these brackets will be per each. See Special Provisions.


Remove and salvage steel rail components (Store at M.H.T.D. Oak Grove maintenance lot).

Close structure to traffic during construction.


Roadway surfacing adjacent to bridge ends to match new slab.

The area exposed by the removal of concrete and not covered with new concrete shall be coated with an approved special mortar.


A minimum vertical clearance of 21'-6" from top of rails and a minimum lateral clearance of 10'-0" from the centerline of track to nearest temporary construction falsework shall be maintained during construction.

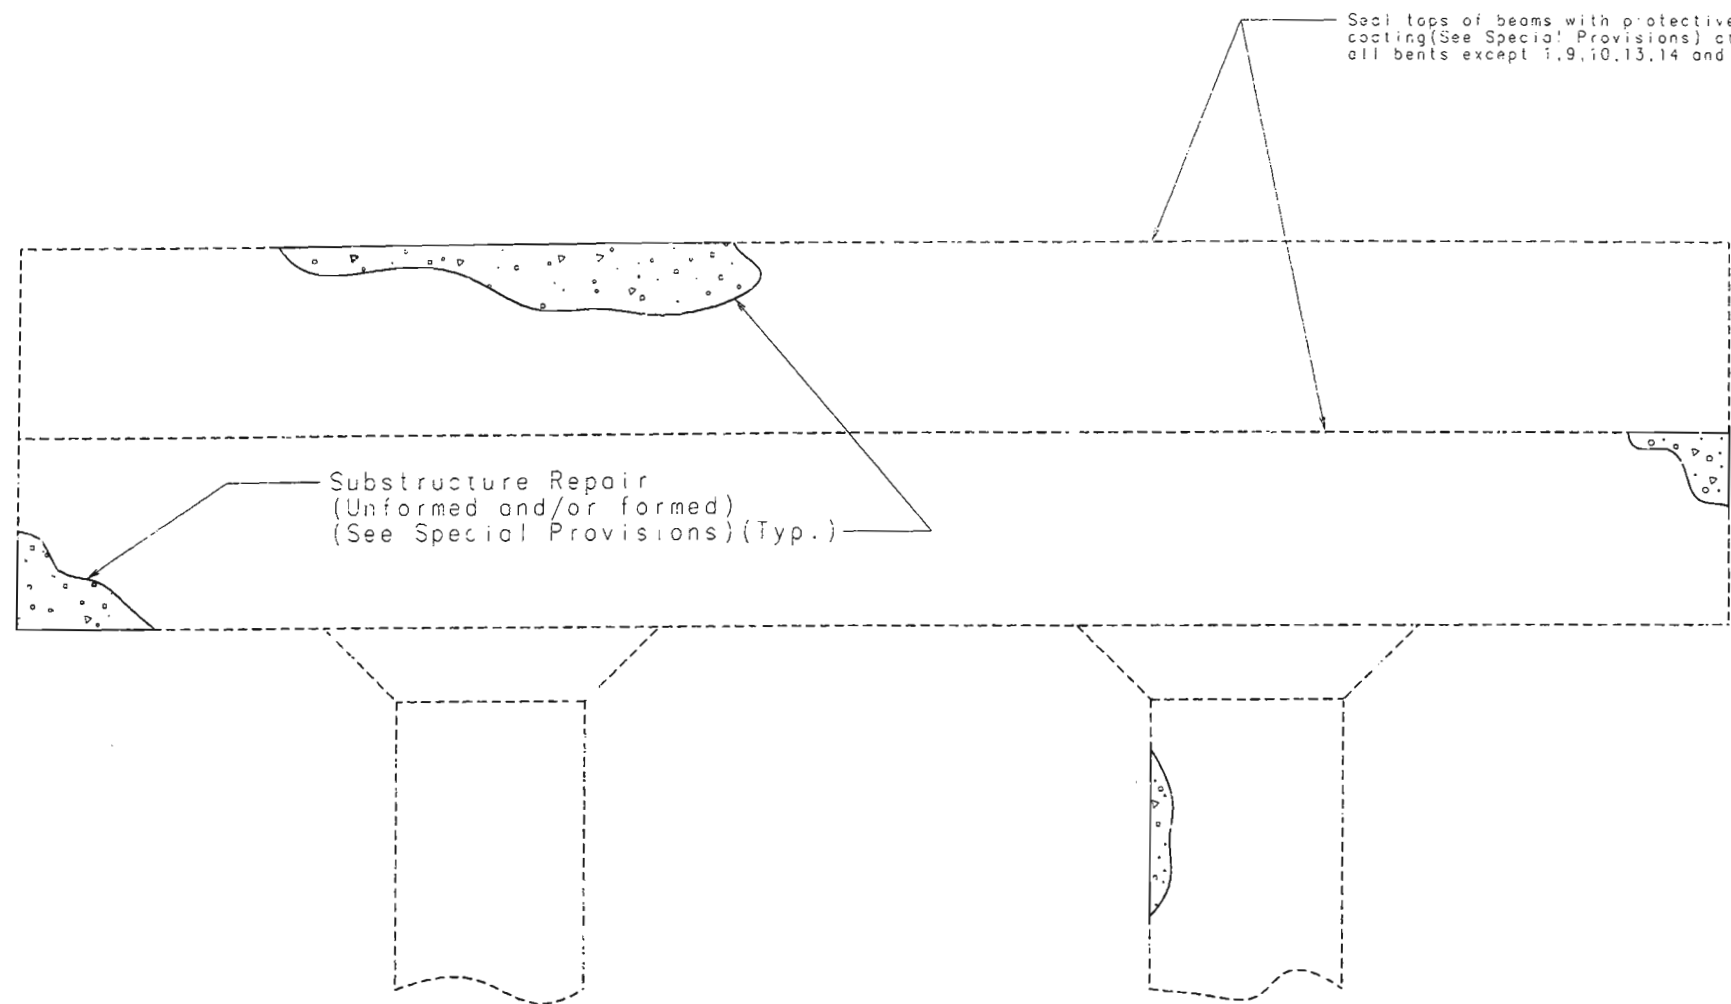

DETAIL SHOWING SUBSTRUCTURE REPAIR AREAS

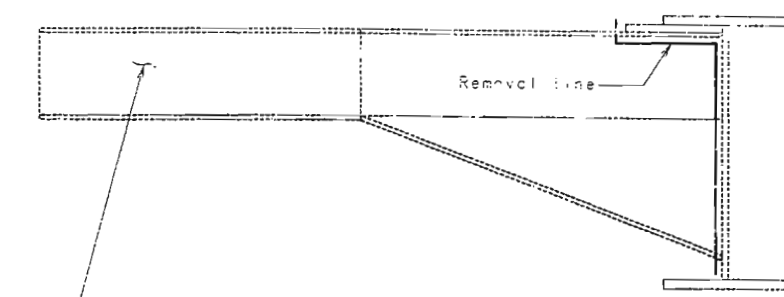

ELEVATION VIEW

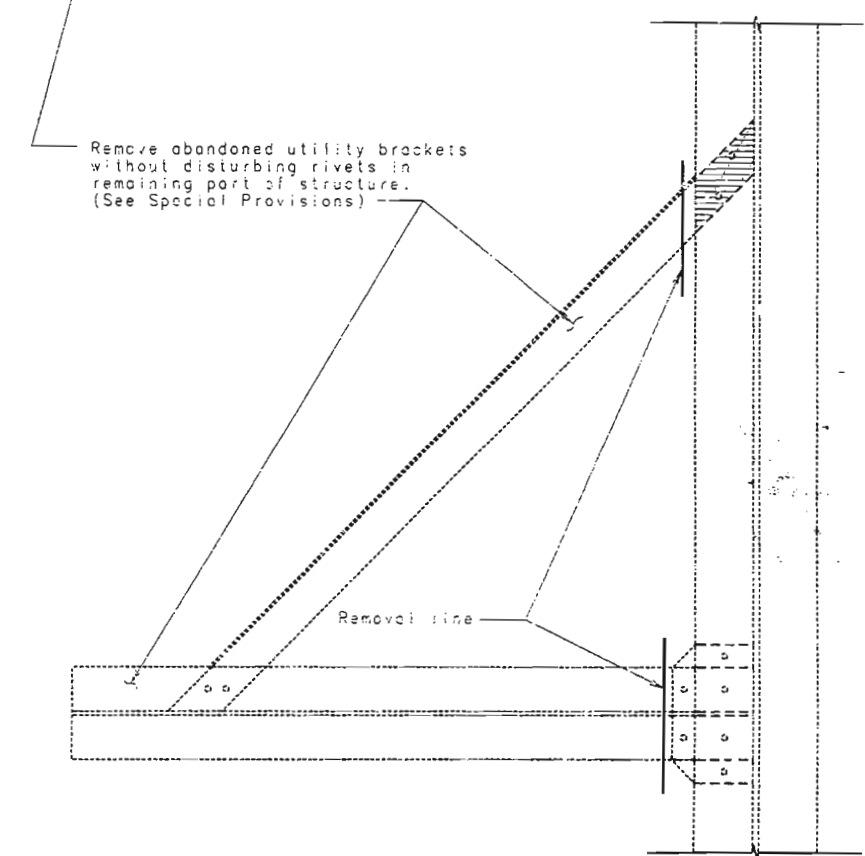

PLAN VIEW

**VERIFICATION**  
 I CERTIFY THAT THIS DESIGN ACCURATELY  
 REFLECTS THE INFORMATION AND DATA  
 FURNISHED BY THE CLIENT AND THE  
 ENGINEER'S FIELD SURVEY.  
 DATE: 4/1/96  
 SIGNATURE: [Signature]

**TYPICAL  
 ABANDONED UTILITY BRACKET  
 REMOVAL DETAILS**

DETAILED JAN. 1996  
 CHECKED JULY 1996


NOTE: THIS DRAWING IS NOT TO SCALE. FOLLOW DIMENSIONS.

SHEET NO. 3 OF 50


PLATTE COUNTY A450R1

333




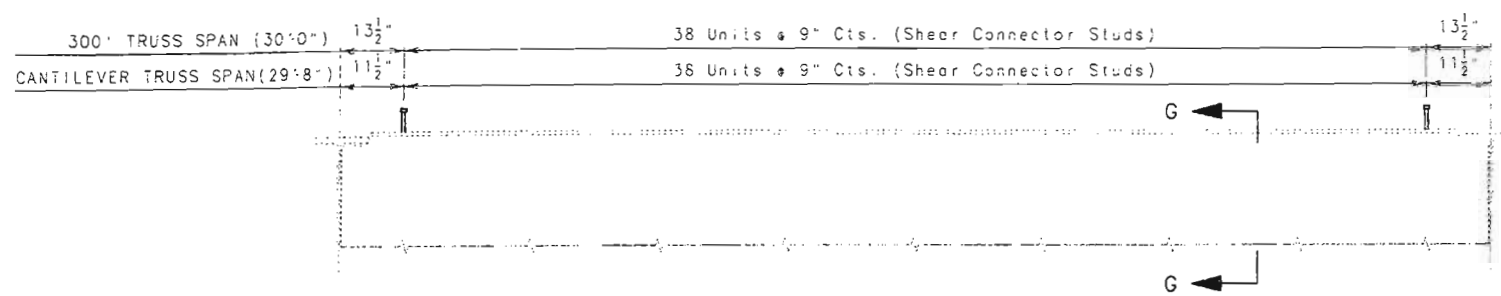


ELEVATION OF STRINGER (300' TRUSS SPAN)  
& CANTILEVER TRUSS SPAN

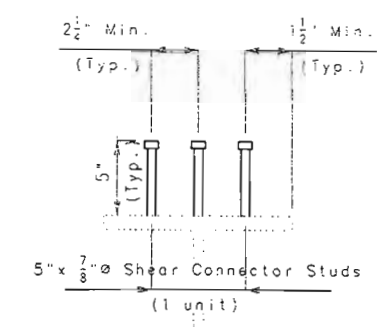








PART SECTION G-G

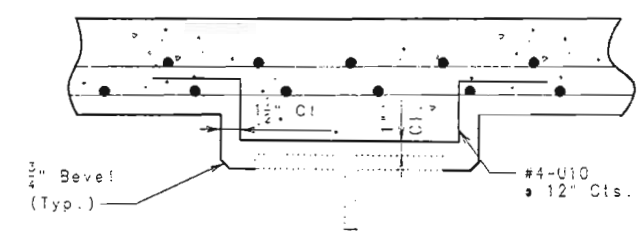


PART SECTION H-H

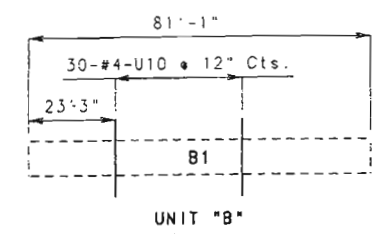


NOTE: FOR LOCATIONS OF SLAB UNITS "A" THRU "X", SEE SHEET NO. 15.  
B1 = EXTERIOR STRINGERS  
B2 = INTERIOR STRINGERS

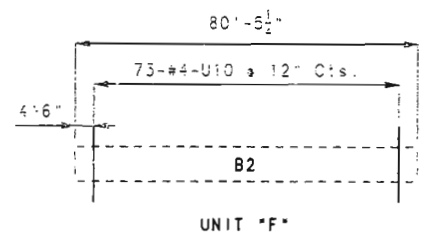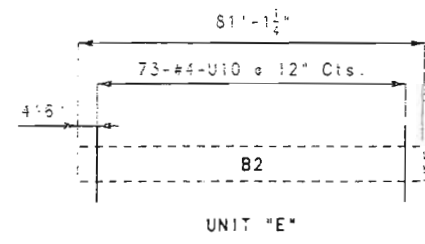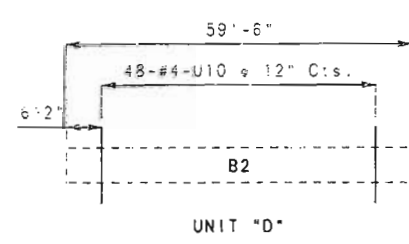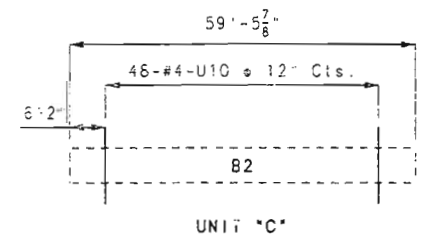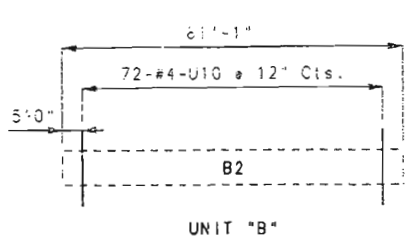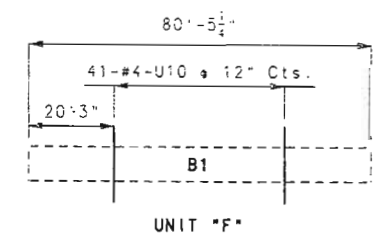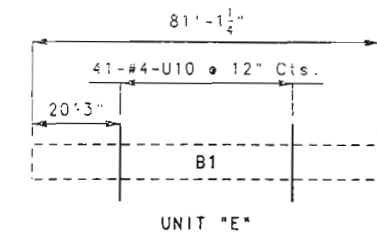


HAUNCH REINFORCEMENT PLAN (UNITS "B", "C", "D", "E" & "F")

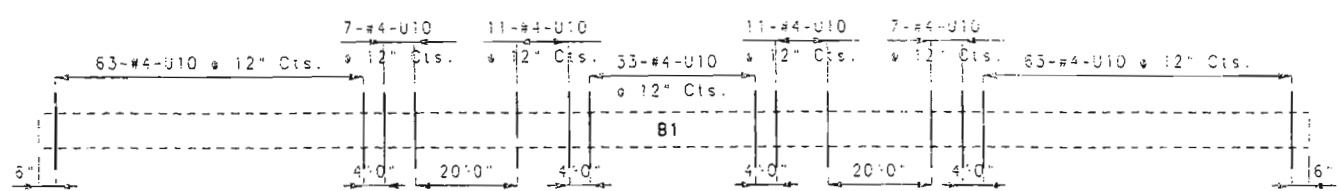

HAUNCH REINFORCEMENT PLAN (UNIT "W")

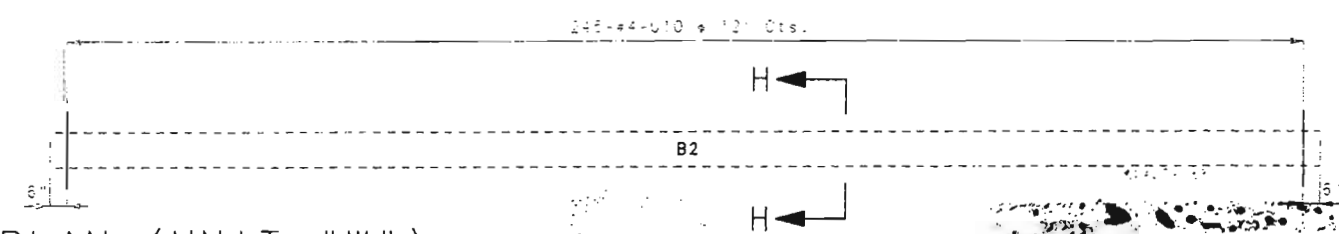


DETAILS OF (TRUSS) SHEAR CONNECTOR STUDS  
& HAUNCHING REINFORCEMENT

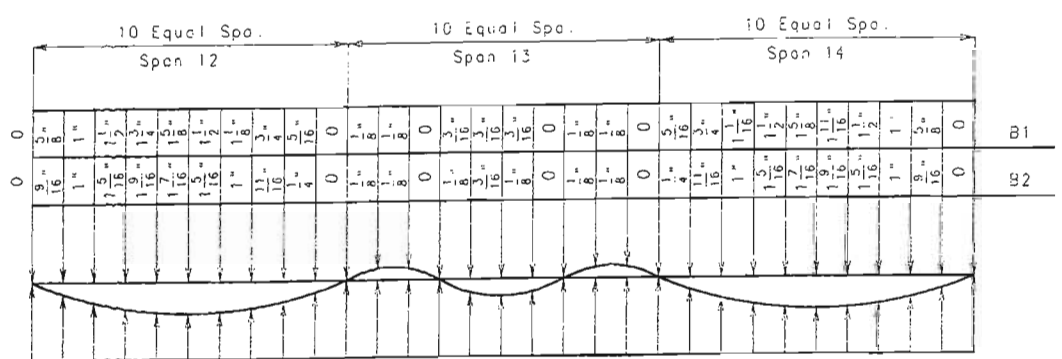

SPANS	BEAMS	P	Q
Spans 12, 13 & 14	B1, B2	21%	10%


DEAD LOAD DEFLECTION ORDINATES

Note: Column P shows the percentage of total dead-load deflection due to dead load of steel only. Column Q shows the percentage of total dead load deflection due to dead load of existing utilities.

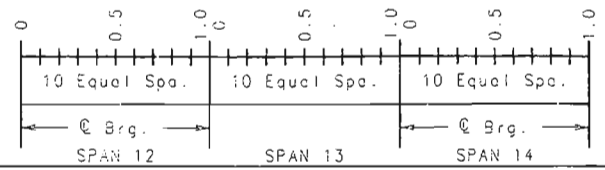


POINT	0	.1	.2	.3	.4	.5	.6	.7	.8	.9	1.0
SPAN 12	B1	3	3 5/8	4 1/8	4 1/2	4 5/8	4 3/4	4 1/2	3 5/8	3 1/8	3
	B2	3 15/16	4 1/2	4 15/16	5 1/4	5 1/2	5 1/8	5 1/4	4 15/16	4 1/2	3 15/16
SPAN 13	B1	3	2 7/8	2 5/8	3	3 3/8	3 1/2	3 3/8	2 5/8	2 7/8	3
	B2	3 15/16	3 13/16	3 11/16	3 15/16	4 1/16	4 1/8	4 1/16	3 13/16	3 11/16	3 15/16
SPAN 14	B1	3	3 5/8	4 1/8	4 1/2	4 5/8	4 3/4	4 1/2	3 5/8	3 1/8	3
	B2	3 15/16	4 1/2	4 15/16	5 1/4	5 1/2	5 1/8	5 1/4	4 15/16	4 1/2	3 15/16

Note: "Y" is measured to top of beam flange, not top of cover plate.

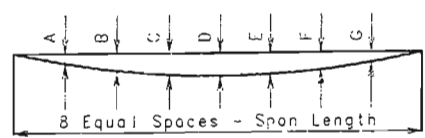


SPAN	BEAM	A	B	C	D	E	F	G	P	Q
1&15	B1, B2	-	3/16	-	5/16	-	3/16	-	14%	14%
3&4	B1, B2	5/16	5/16	13/16	13/16	13/16	13/16	5/16	17%	10%
2, 5&6	G1, G2	1	1 1/16	1 1/2	1 5/16	1	5/8	1	21%	10%


DEAD LOAD DEFLECTION ORDINATES

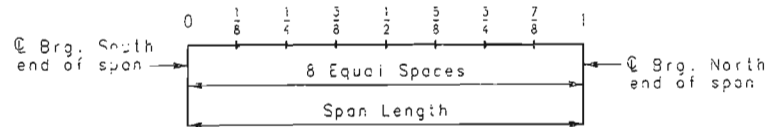

LOCATION	0	1/8	1/4	3/8	1/2	5/8	3/4	7/8	1
SPAN 2	G1	1 1/4	2 1/8	2 1/2	3 1/8	3 1/2	3 3/4	2 15/16	2 1/8
	G2	2 11/16	3 5/16	3 13/16	4 1/8	4 1/2	4 3/8	3 7/8	3 1/8
SPANS 3 & 4	B1	1 1/4	2 1/8	2 1/2	2 11/16	2 13/16	2 11/16	2 1/2	1 3/4
	B2	2 11/16	3 1/8	3 13/16	4 1/8	4 1/2	4 3/8	3 7/8	3 1/8
SPANS 5 & 6	G1	1 1/4	2 1/8	3	3 5/16	3 1/2	3 5/8	3	2 7/8
	G2	2 11/16	3 1/8	3 13/16	4 1/8	4 1/2	4 3/8	3 7/8	3 1/8
POINT	0	1/4	1/2	3/4	1				
SPANS 1&15	B1	1 1/4	1 15/16	2 1/16	1 15/16	1 1/2			
	B2	2 11/16	2 1/8	3	2 7/8	2 11/16			

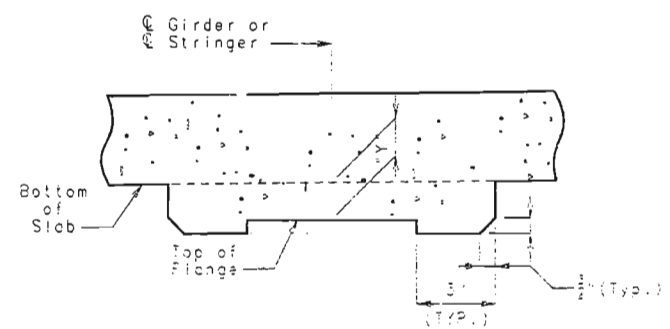


PART SECTION THRU SLAB SHOWING HAUNCH "Y"

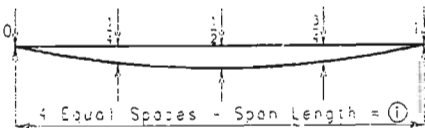

POINTS	0	1/4	1/2	3/4	1	P
TRUSS SPANS 7&11	S1	0	1 5/16	1 1/2	1 1/2	0 10%
	S2	0	1 5/16	1 1/2	1 1/2	0 11%
TRUSS SPANS 8, 9&10	S1	0	1 1/4	1 1/2	1 1/2	0 10%
	S2	0	1 1/4	1 1/2	1 1/2	0 11%


DEAD LOAD DEFLECTION ORDINATES

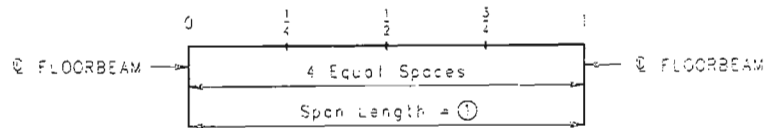

LOCATION	0	1/4	1/2	3/4	1
TRUSS SPANS 7&11	S1	1 1/4	2 1/8	2 1/2	2 1/2
	S2	2 11/16	3 1/8	3 13/16	4 1/8
TRUSS SPANS 8, 9&10	S1	1 1/4	2 1/8	2 1/2	2 1/2
	S2	2 11/16	3 1/8	3 13/16	4 1/8


(1) 30'0" TRUSS SPANS 7&11  
27'6" TRUSS SPANS 8, 9&10

DEAD LOAD DEFLECTION AND HAUNCHING

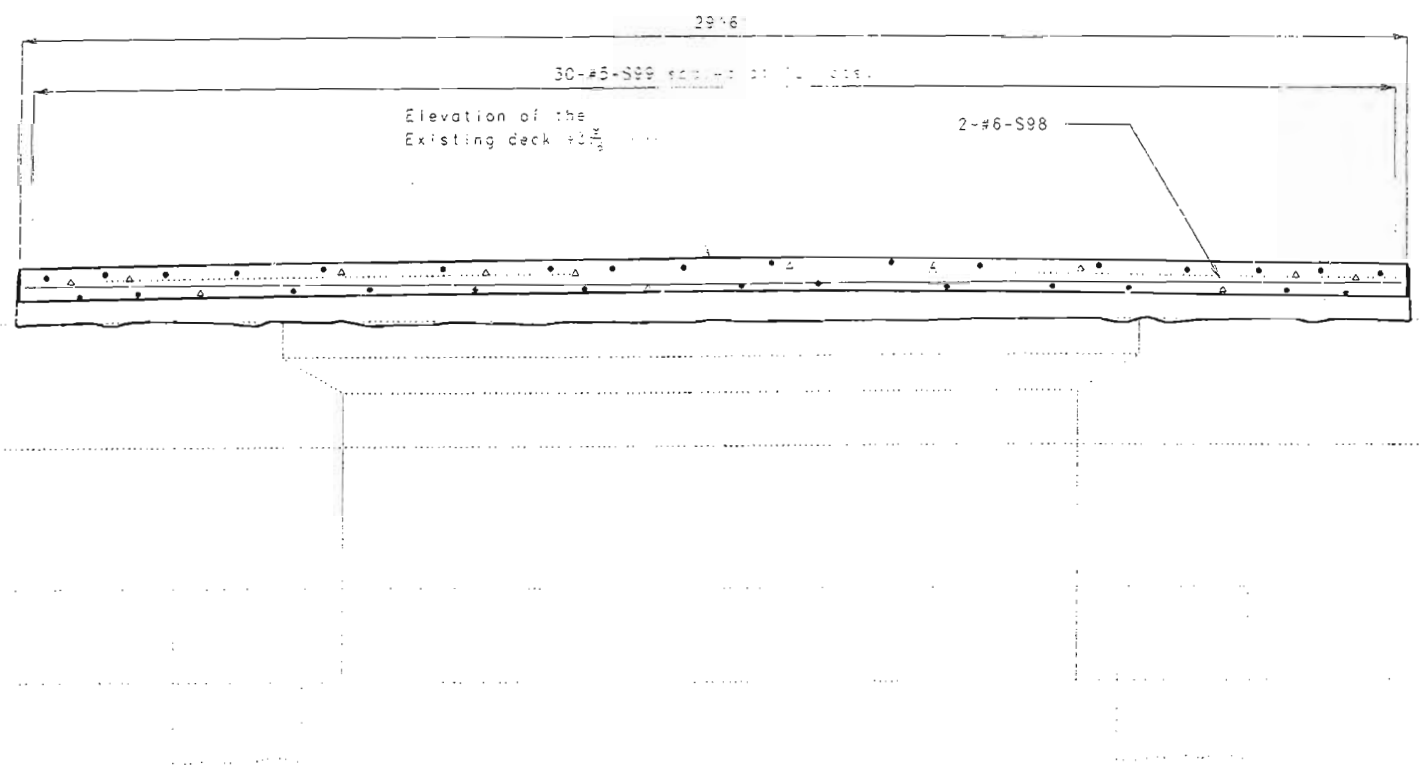


ELEVATION

Note: For location of existing "permissible" const. joint see sheet no. 4 of 13 on plans of existing bridge substructure.

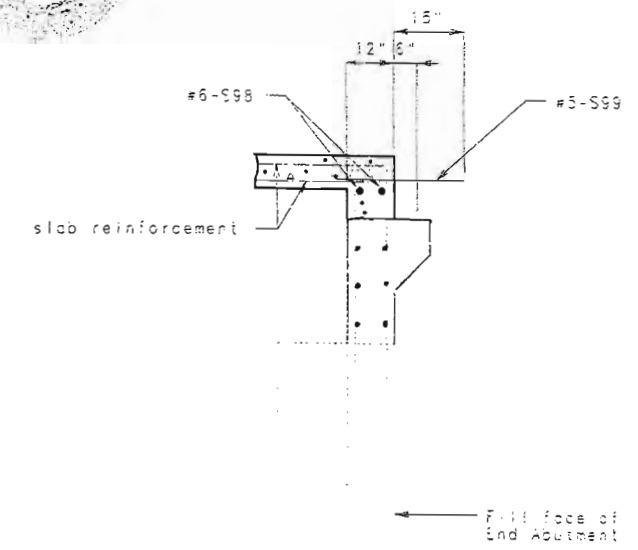


SECTION NEAR C

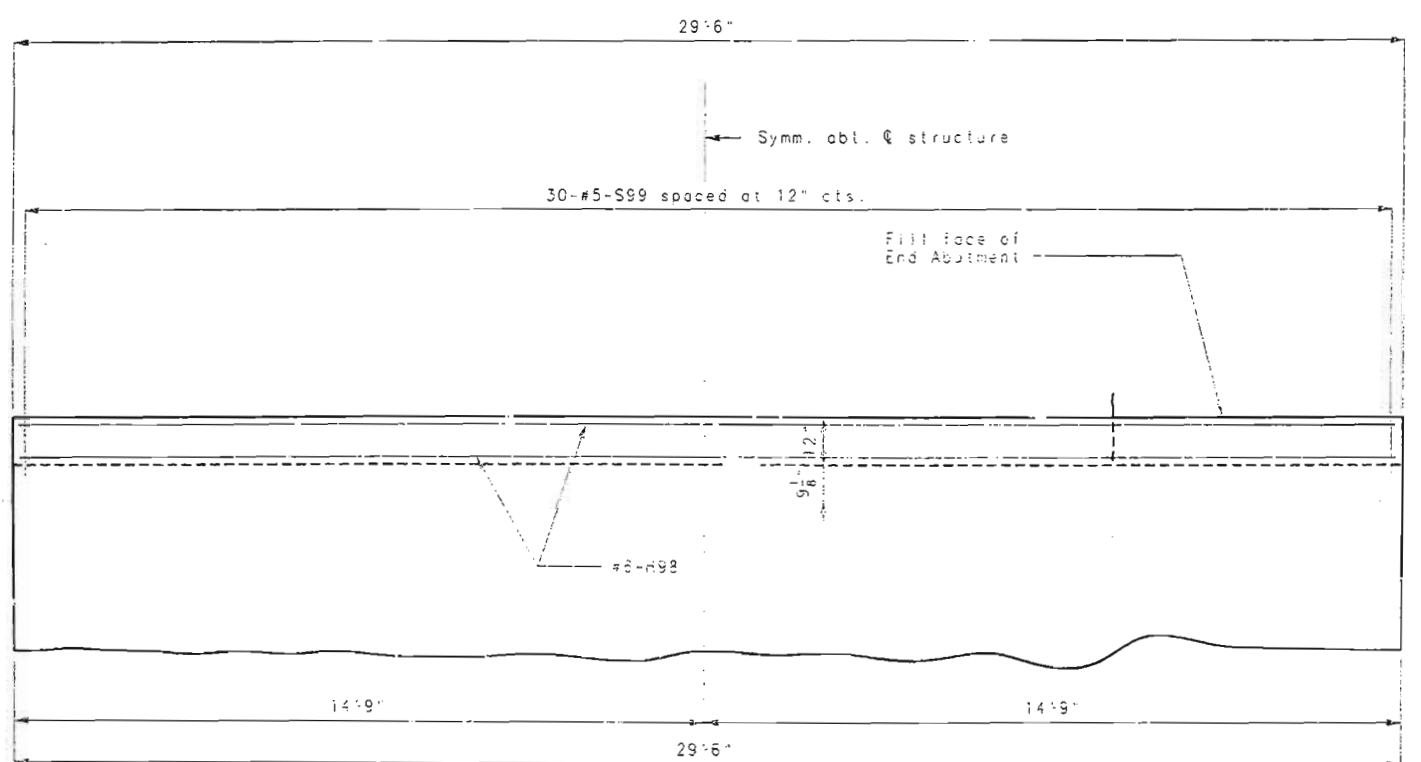

PLAN

DETAILS OF END ABUTMENTS NO.1 AND NO.16

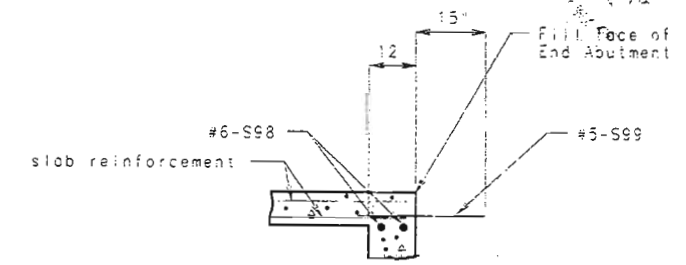

SECTION W-W

Note: Existing vertical reinforcing bars shall be cleanly stripped and reused in place.

For slob reinforcement not shown, see sheets 10.15 and 10.33.

The cost of excavation and concrete for the substructure shall be included in the price bid for Partial Rehabilitation of Substructure Concrete (Lump Sum).

336


DETAILED MAY 1996  
CHECKED JULY 1996

NOTE: THIS DRAWING IS NOT TO SCALE. FOLLOW DIMENSIONS.


SHEET NO. 6 OF 50

PLATTE COUNTY A450R1

- Vertically slotted holes in 5/16" E (Typ.)
- Horizontally slotted holes in vert. leg of angle (Typ.)
- See detail "B" on sheet No. 8.
- Field drill holes in existing top flange to match holes in horizontal leg of angle.
- See sheet No. 5 for bracing heights.

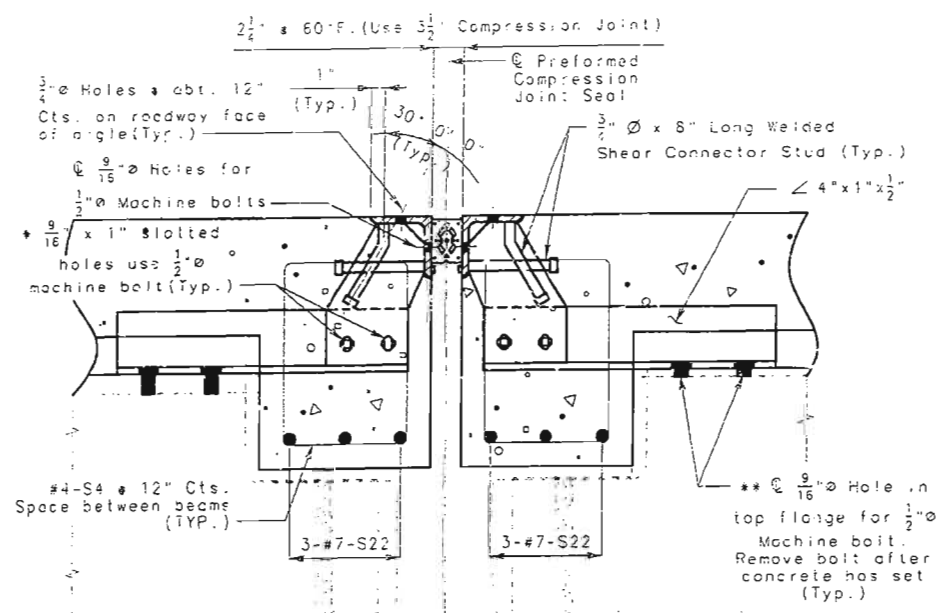


SECTION D-D

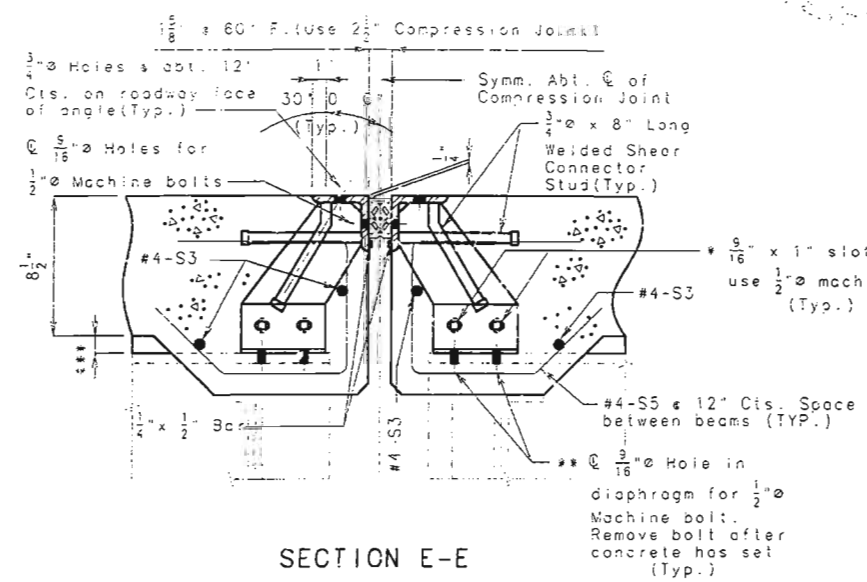


SECTION E-E


Center compression joint between @ bearings.

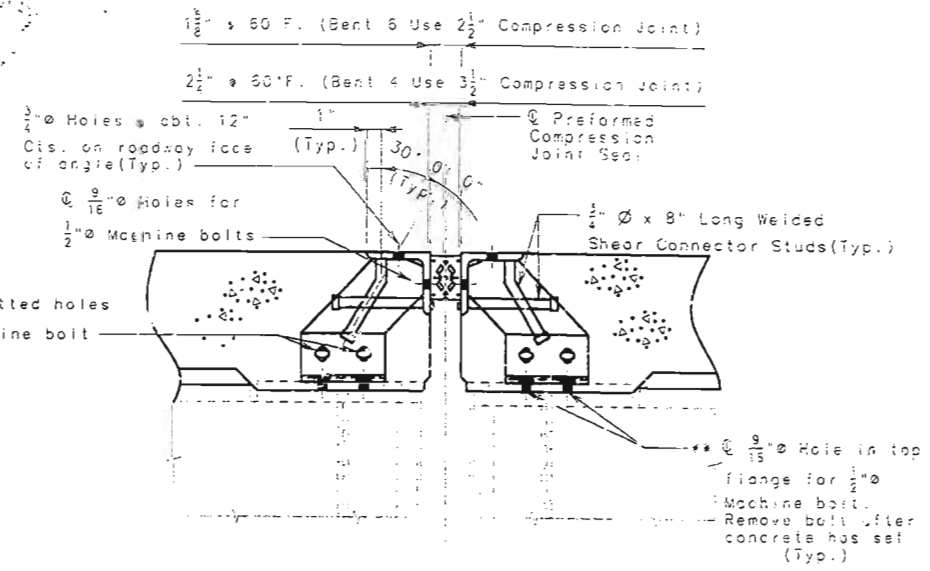


SECTION F-F

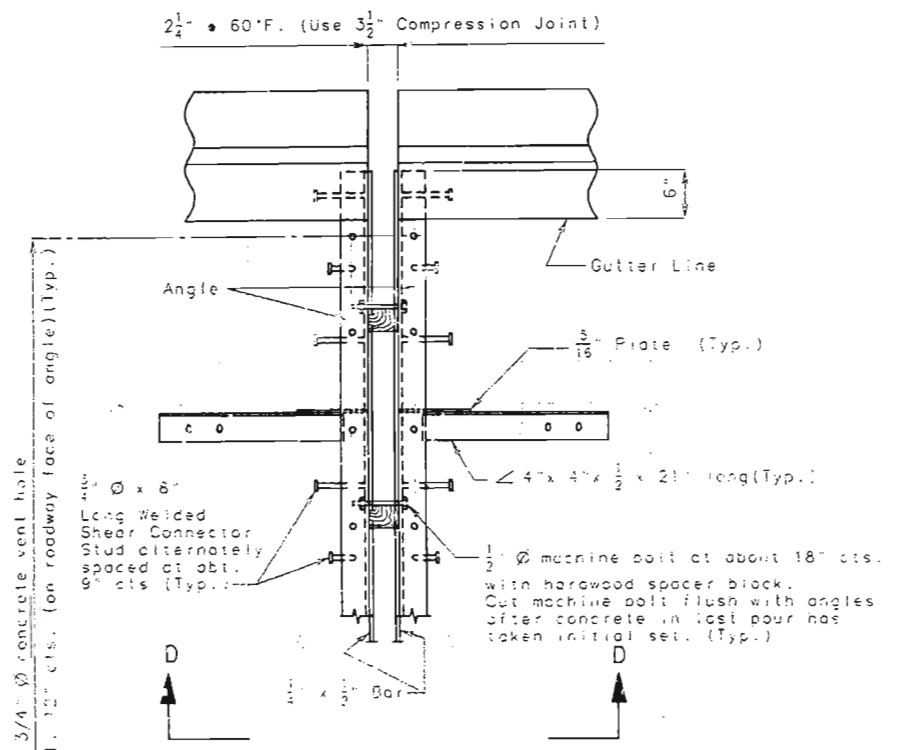

PART PLAN  
(BENTS 2 & 15)

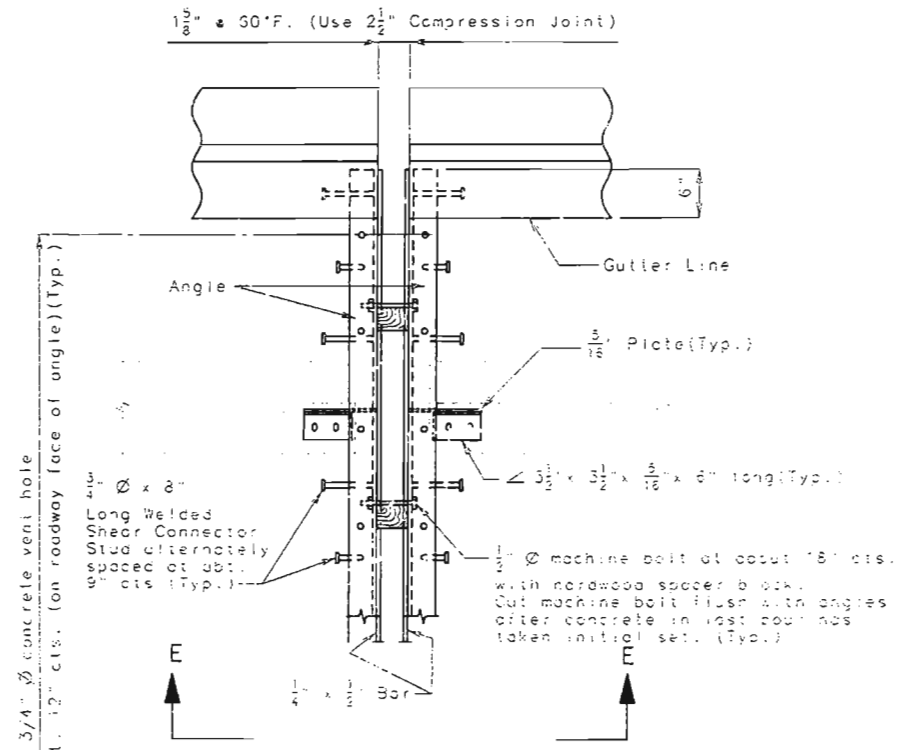

PART PLAN  
(BENTS 3 & 5)

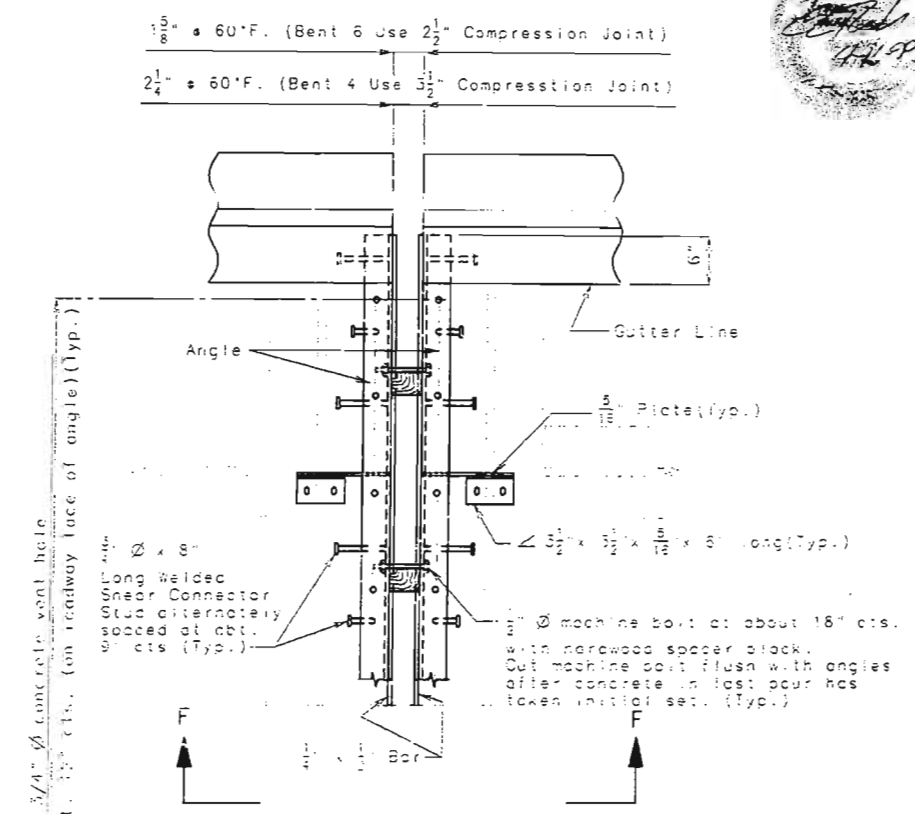

PART PLAN  
(BENTS 4 & 6)

Note: For general notes for preformed compression joints, see sheet No. 8.

# DETAILS OF PREFORMED COMPRESSION JOINT SEALS

DETAILED MAY 1996  
CHECKED JULY 1996

NOTE: THIS DRAWING IS NOT TO SCALE. FOLLOW DIMENSIONS.

SHEET NO. 7 OF 50

PLATTE COUNTY A450R1



**GENERAL NOTES:**

Structural steel for expansion device shall be fabricated in one section, except for stage construction and when the length is over 50', a complete joint penetration groove welded splice is permissible.

The expansion device shall be bent to conform to crown and grade of roadway.

Material for the expansion device shall be (ASTM A709 GRADE 35 STRUCTURAL STEEL).

Plan dimensions are based on installation at 60°F.


Dimension ① shall be increased ③ for each 10° fall in temperature and decreased ③ for each 10° rise in temperature at installation.

See Special Provisions for the requirements of compression joint seal.


Structural steel for the expansion device and curb plate shall be painted with a minimum of two coats of inorganic zinc primer (5 mils minimum) or galvanized in accordance with ASTM A123. Anchors need not be protected from overspray.

Furnishing, coating or galvanizing, and installing the structural steel armored joint shall be included in contract unit price for preformed compression expansion joint seal.

Neoprene extrusions shall meet A.S.T.M. D3542.

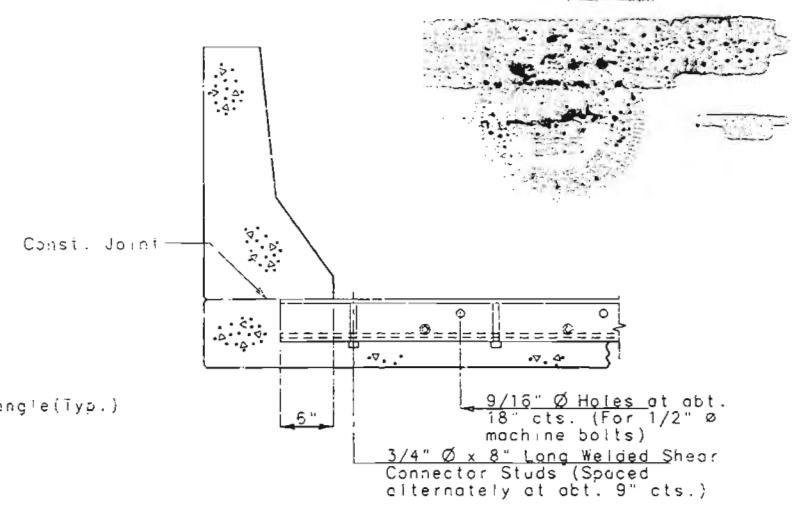


PART SECTION A-A

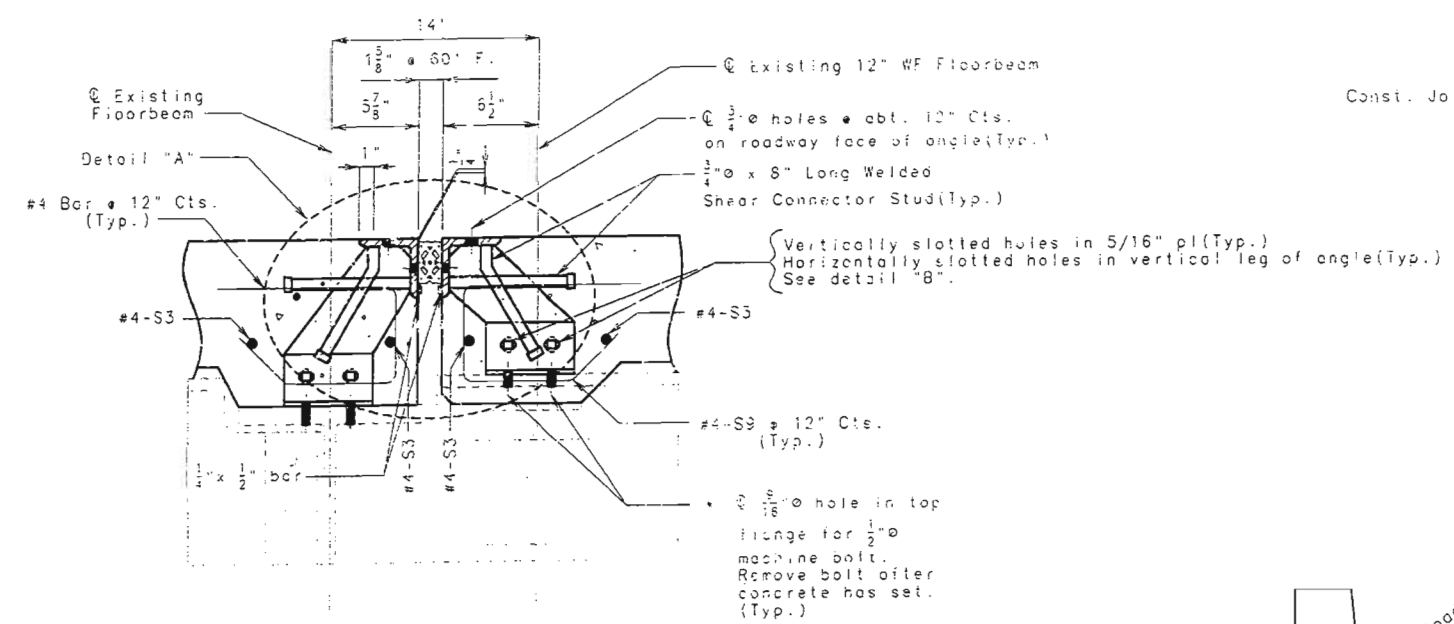


PART SECTION C-C


\* Field drill holes in existing diaphragms to match holes in horizontal leg of angle.

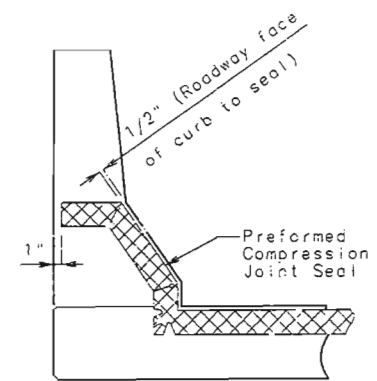

PART SECTION THRU JOINT SEAL

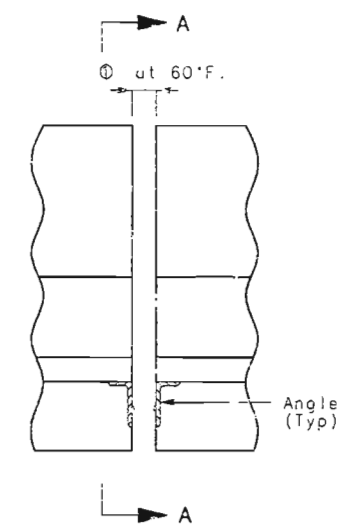


PART ELEVATION OF CURB

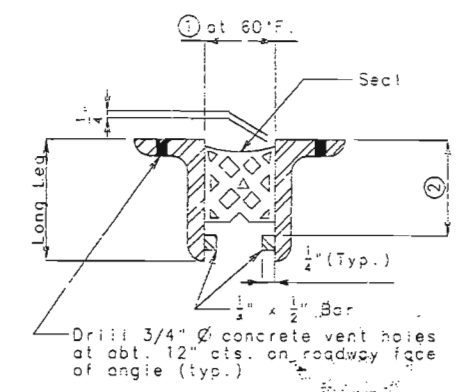

PART CROSS SECTION THRU EXPANSION JOINT


TABLE OF TRANSVERSE BRIDGE SEAL DIMENSIONS			
Seal Width	①	②	Required Movement Range
2.5"	1-5/8"	Manufacturer's Recommended Height	0.9"
3.5"	2-1/4"	Manufacturer's Recommended Height	1.3"

Note: Depth of seal shall not be less than width of seal.  
 ① 1/2" & Panel points L5, 1/2" & all other locations.

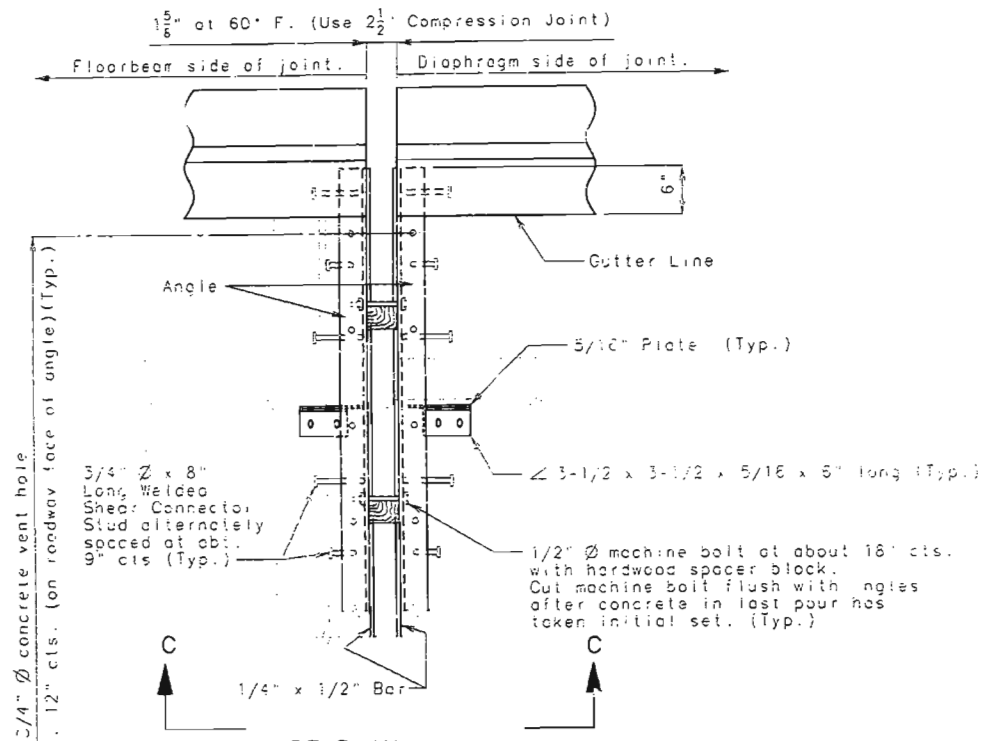


PART PLAN (TRUSS SPAN COMPRESSION JOINTS)

CONT. SPAN TRUSS PANEL POINTS L4, L4', L8, L8', L12, L12', L16, L16', L19' & L22  
 SIMPLE SPANS TRUSS PANEL POINTS L5.

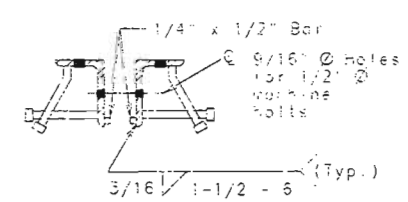

DETAIL "A"

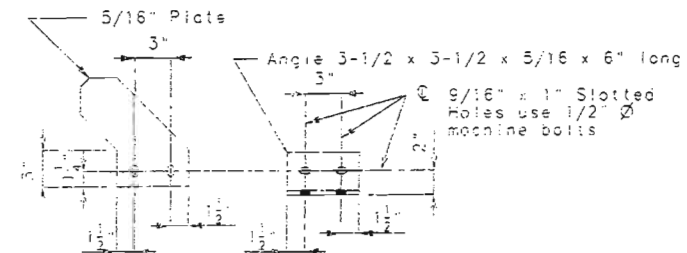

DETAIL "B"

SIZE OF ARMOR JOINT

Vertical leg of angle shall be a minimum of ② + 3/4". Horizontal leg of angle shall be a minimum of 3". Minimum thickness of angle shall be 1/2".

If a seal size larger than that indicated on the plan is used, the movement range, the opening at 60°, and the dimensions for the armor angles shall be shown on the shop drawings.

Concrete shall be forced under armor angle and around studs by trowelling or other approved methods for proper consolidation and anchorage.

# DETAILS OF PREFORMED COMPRESSION JOINT SEALS

NOTE: THIS DRAWING IS NOT TO SCALE. FOLLOW DIMENSIONS.


SHEET NO. 8 OF 50

PLATTE COUNTY A450R1

DETAILED MAY 1996  
 CHECKED JULY 1996


I CERTIFY THAT THIS DRAWING ACCURATELY REFLECTS THE DESIGN, MATERIALS, AND LOCATION OF THE BRIDGE AND ITS COMPONENTS AS CONSTRUCTED ON THIS PROJECT.

SIGNATURE DATE

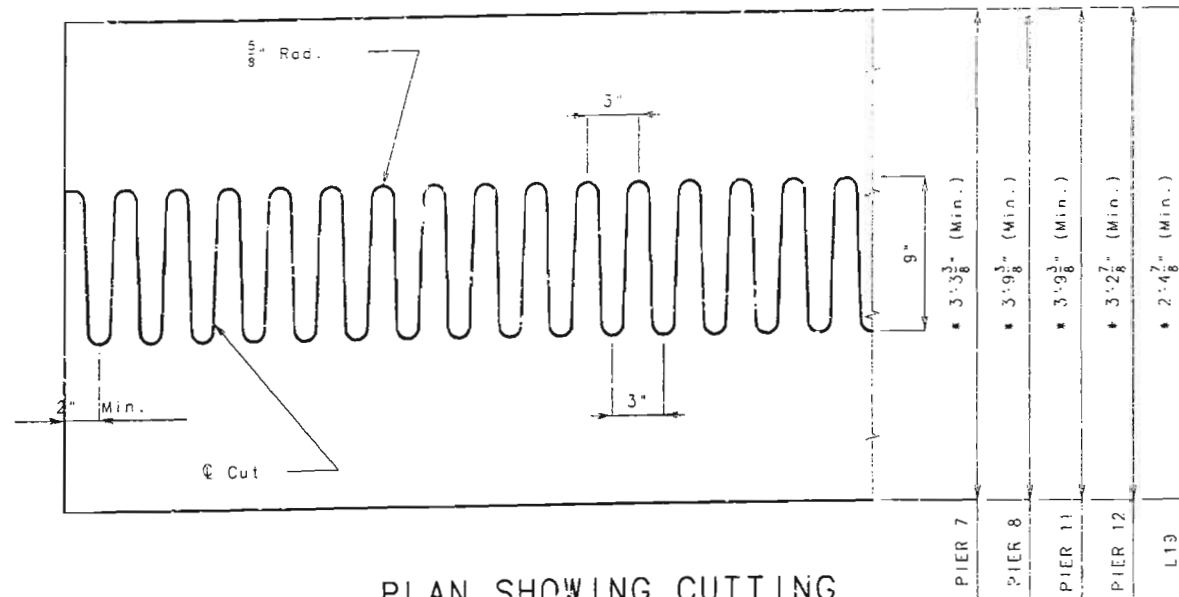


PLAN SHOWING CUTTING OF FINGER PLATE

\* includes allowance for cut width.

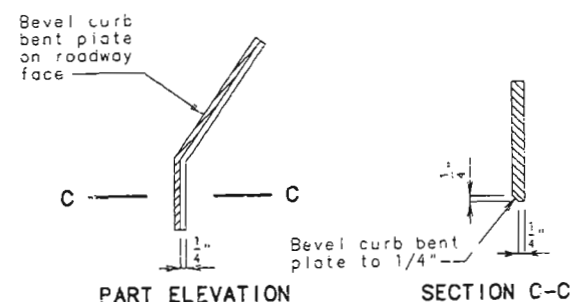


PART ELEVATION AT END OF BEVELED CURB BENT PLATE

SECTION C-C

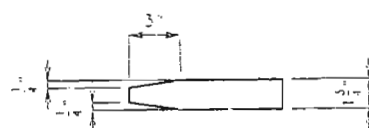

FINGER DETAIL

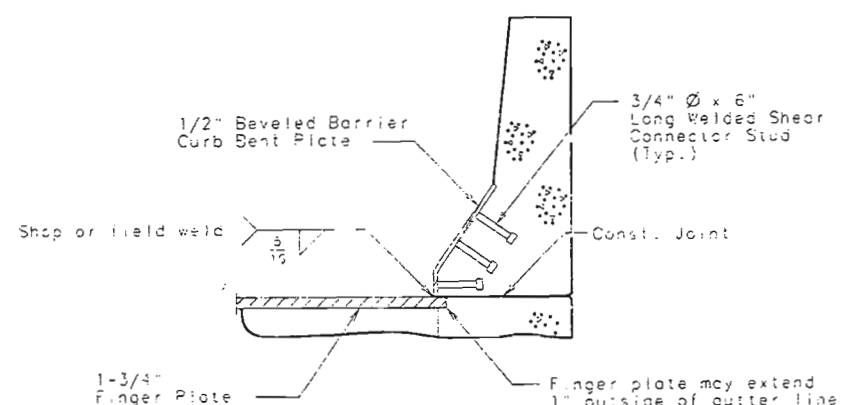

PART SECTION N-N

# DETAILS OF FINGER PLATE EXPANSION DEVICES

## General Notes:

Finger plates shall be cut with a machine guided gas torch from one plate. The plate from which fingers are cut may be spliced before fingers are cut. The surface of cut shall be perpendicular to the surface of the plate. The cut shall not exceed 1/8" in width. The centerline of cut shall not deviate more than 1/16" from the position of centerline of cut shown. No splicing of finger plate or finger plate assembly will be allowed after fingers are cut.

Plan dimensions are based on installation at 60°F. The expansion gap and other dimensions shall be increased 3/8" for each 10°F fall in temperature and increased 3/8" for each 10°F rise in temperature at installation.

Structural steel for the expansion device and curb plate shall be painted with a minimum of two coats of inorganic zinc primer (5 mils minimum) or galvanize in accordance with ASTM A123. Anchors need not be protected from overspray.

Payment for furnishing, coating or galvanizing, and installing structural steel for the expansion device will be made at the contract unit price for expansion device (Finger plate) per lin. ft.


All holes shown for connections to be subpunched 11/16" Ø and reamed to 13/16" Ø in field.

1-1/2" and 1-3/4" Finger Plate and Pc. W14 x 43 shall be bent to conform to crown of roadway.



Longitudinal reinforcing steel shall be placed so that ends shall not be more than 1" from web of Pc. W14 x 43 at expansion device.

Material for the expansion device shall be ASTM A709, GRADE 36 structural steel, except that material for the finger plate & support shall be ASTM A709 GRADE 50 structural steel.




Concrete shall be forced under, and around finger plate supporting hardware, studs, angles and bars by troweling or other approved methods for proper consolidation and anchorage.

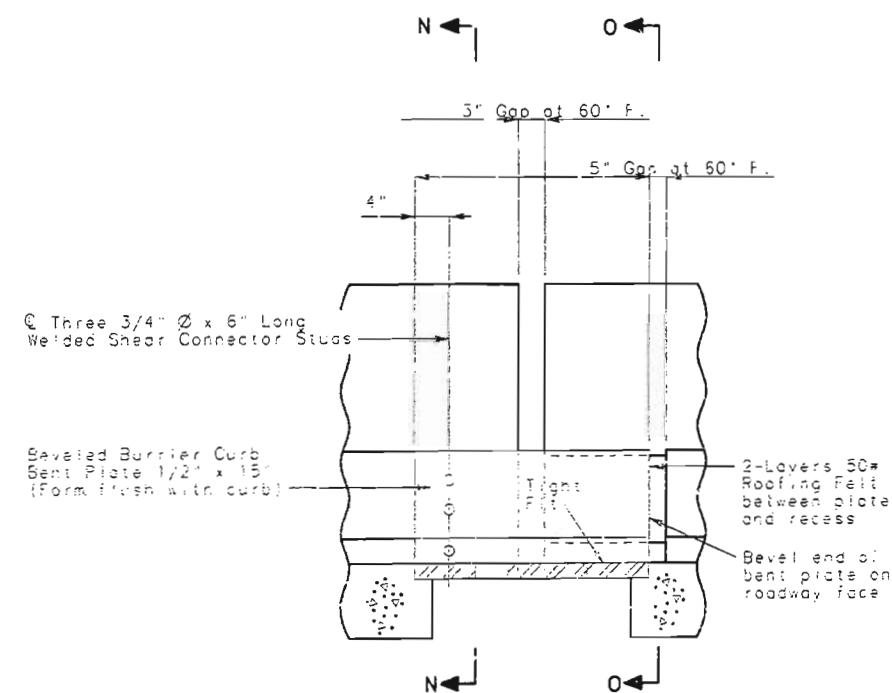

ELEVATION OF BARRIER CURB

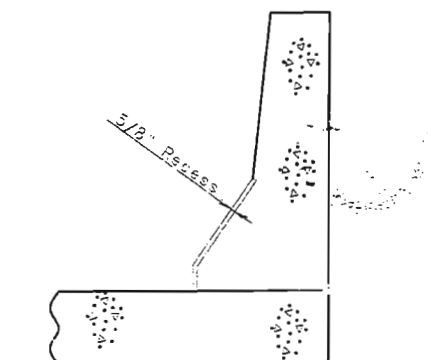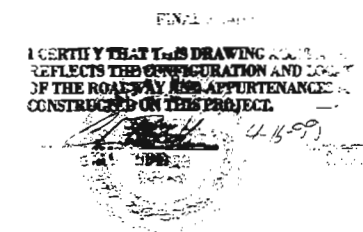

PART SECTION O-O

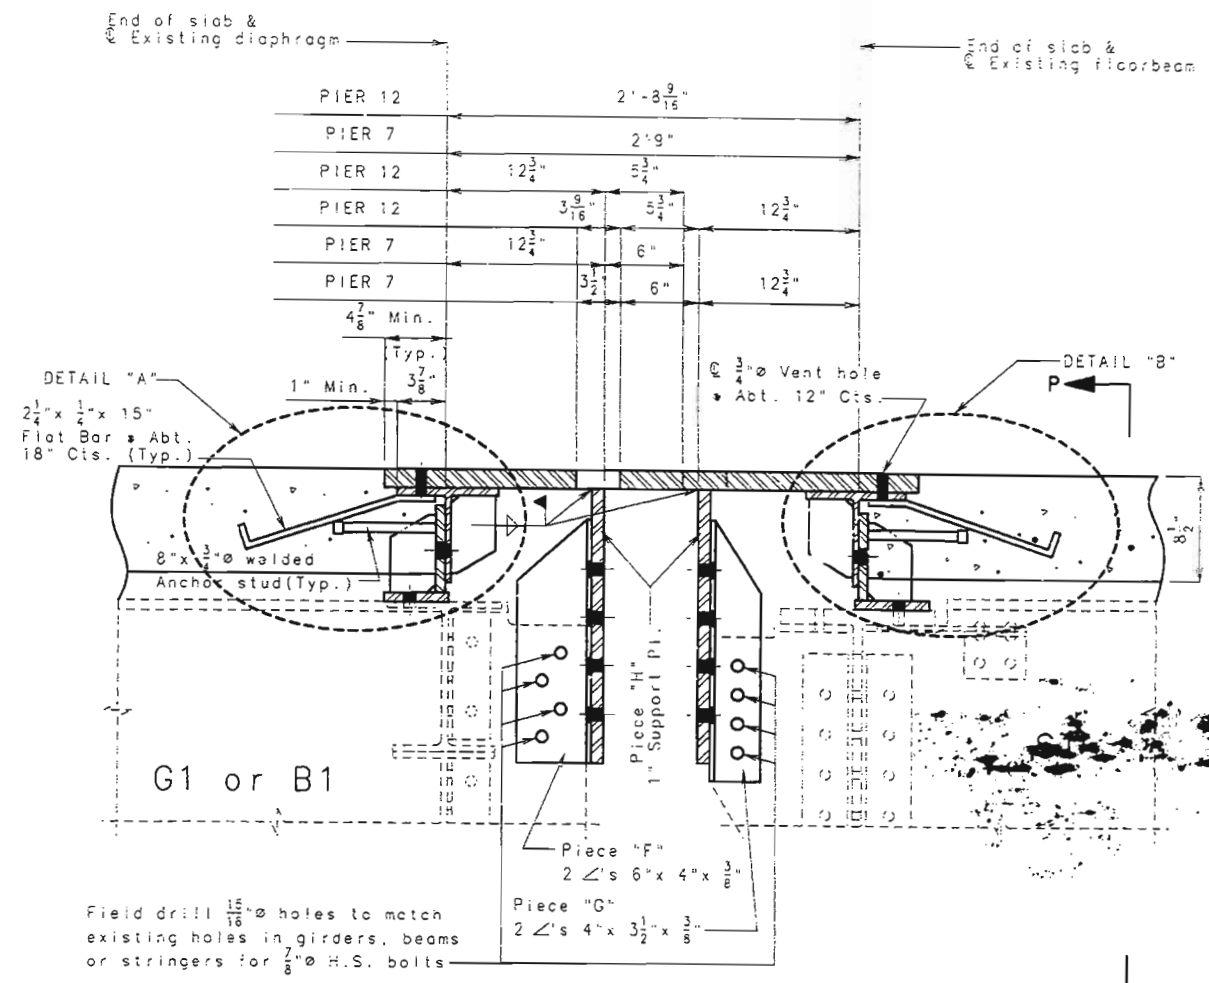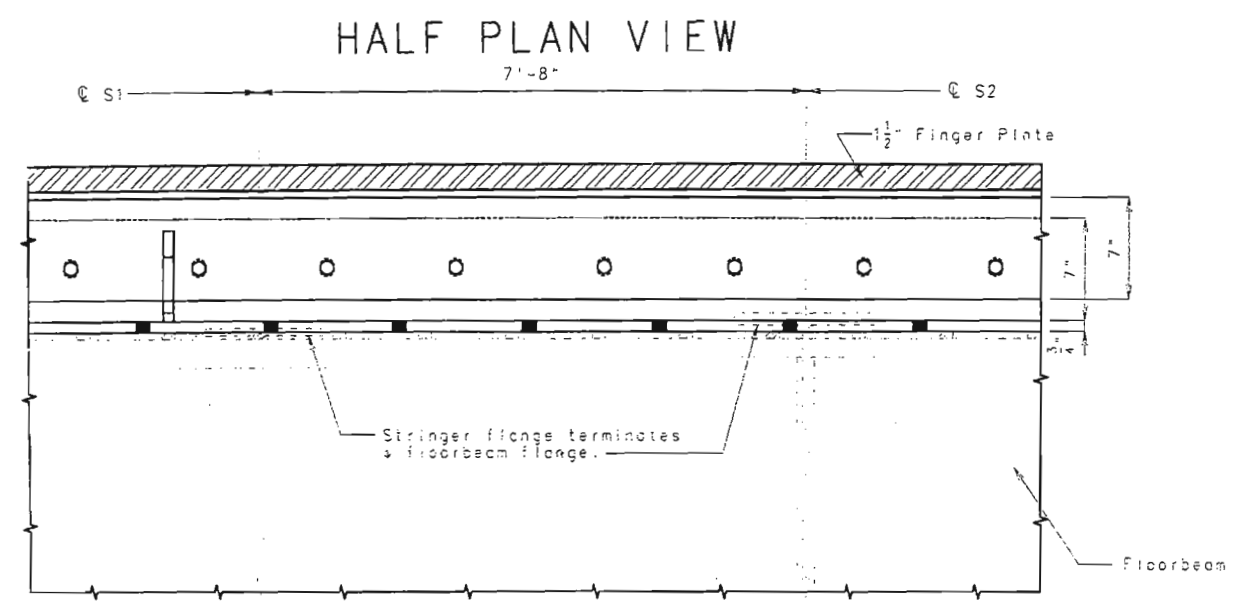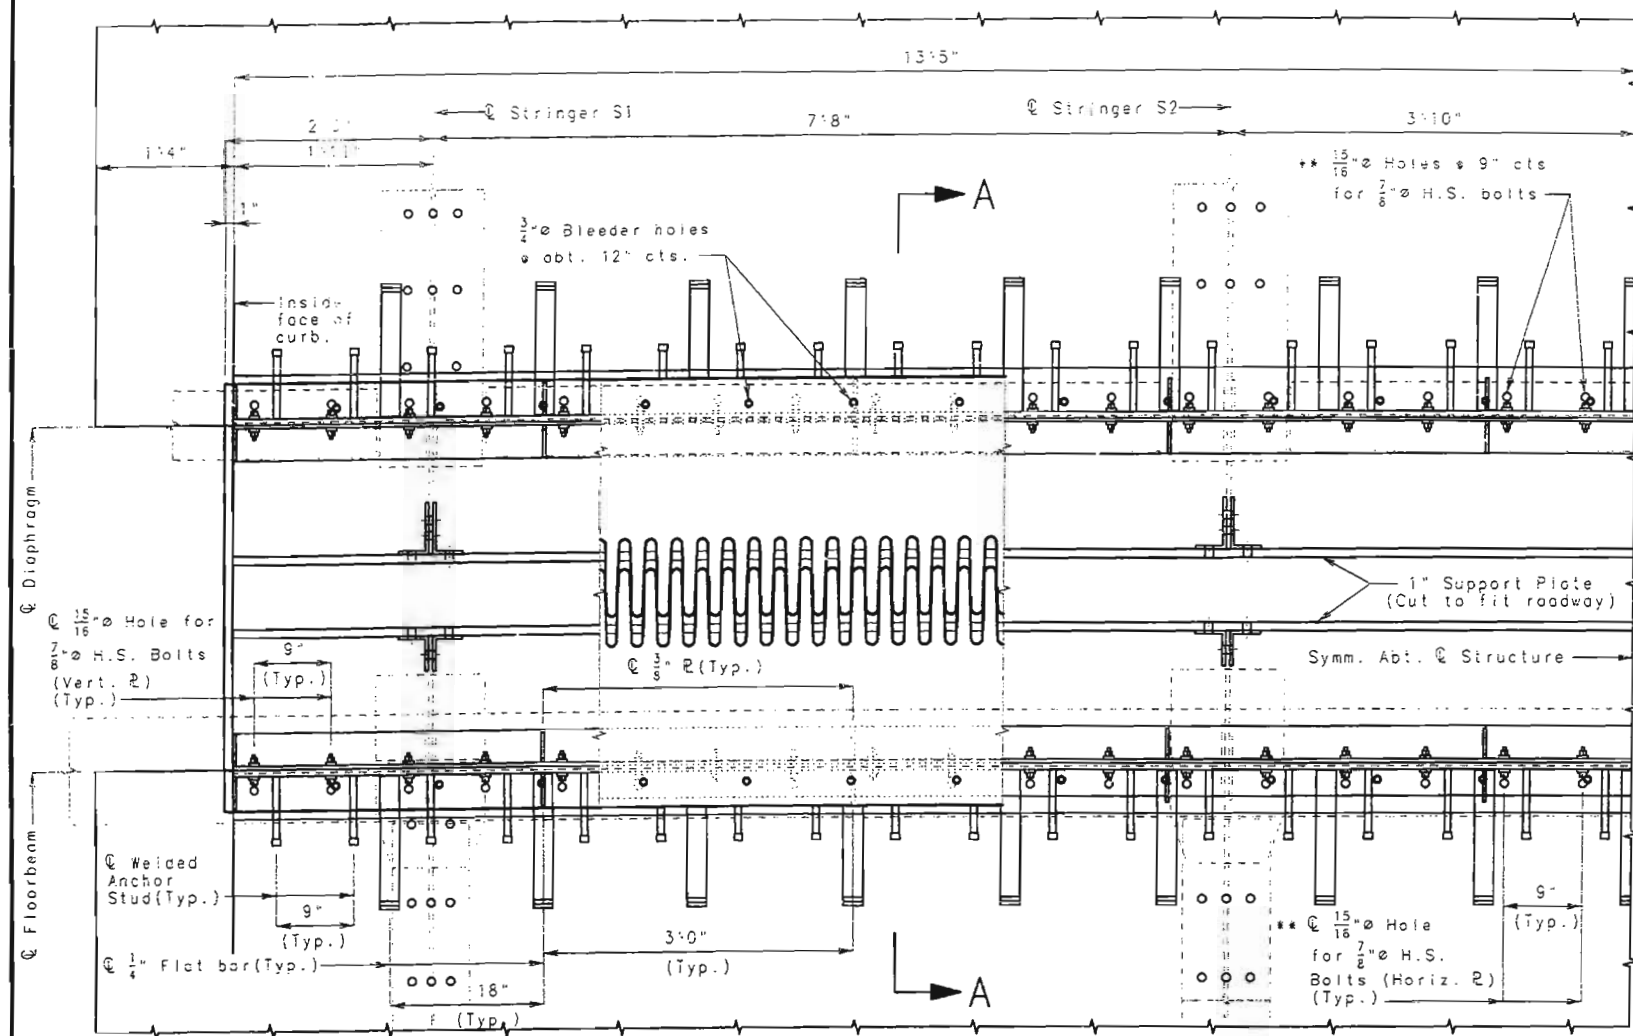

Plan dimensions are based on installation at 60°F. The expansion gap and other dimensions shall be increased 5/16" for each 10°F fall in temperature and increased 5/16" for each 10°F rise in temperature at installation.

1-1/2" Finger Plate and Pl. W14 x 43 shall be bent to conform to crown of roadway.




•• Space between existing holes in diaphragms or floorbeams.

For Details and related pieces, see sheet No. 11.

CERTIFY THAT THIS DRAWING REFLECTS THE CONFIGURATION AND DIMENSIONS OF THE ROADWAY AND APPURTENANCES AS CONSTRUCTED ON THIS PROJECT

4-16-92

# FINGER PLATE EXPANSION DEVICE @ PIERS 7 & 12

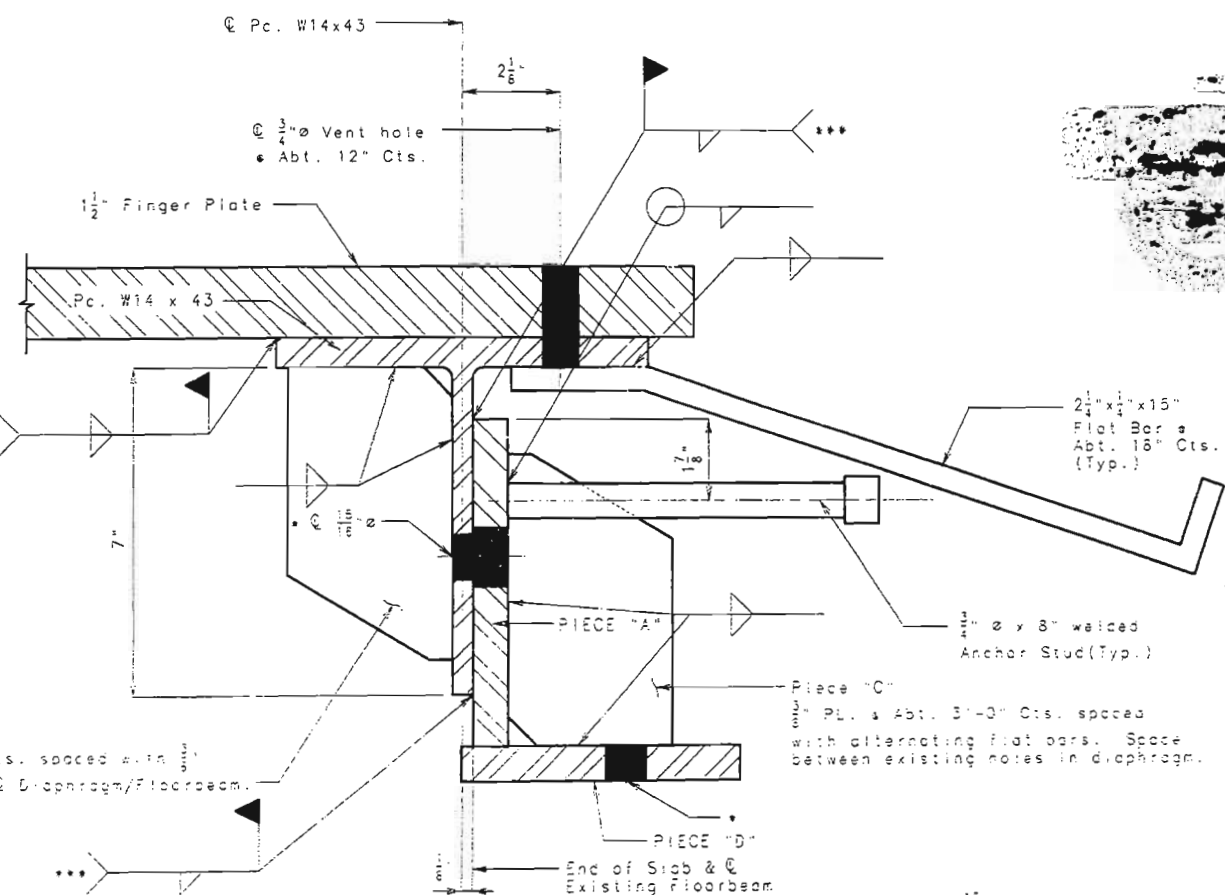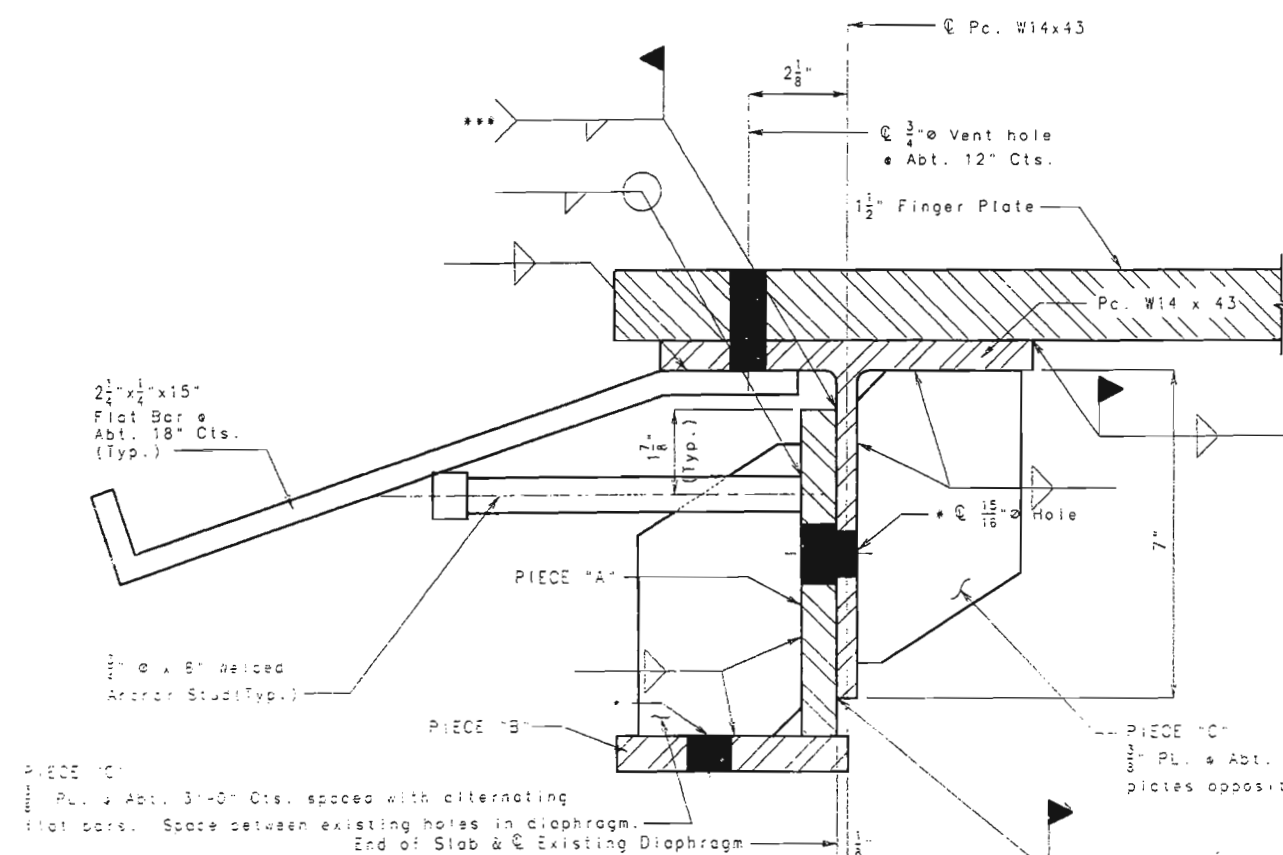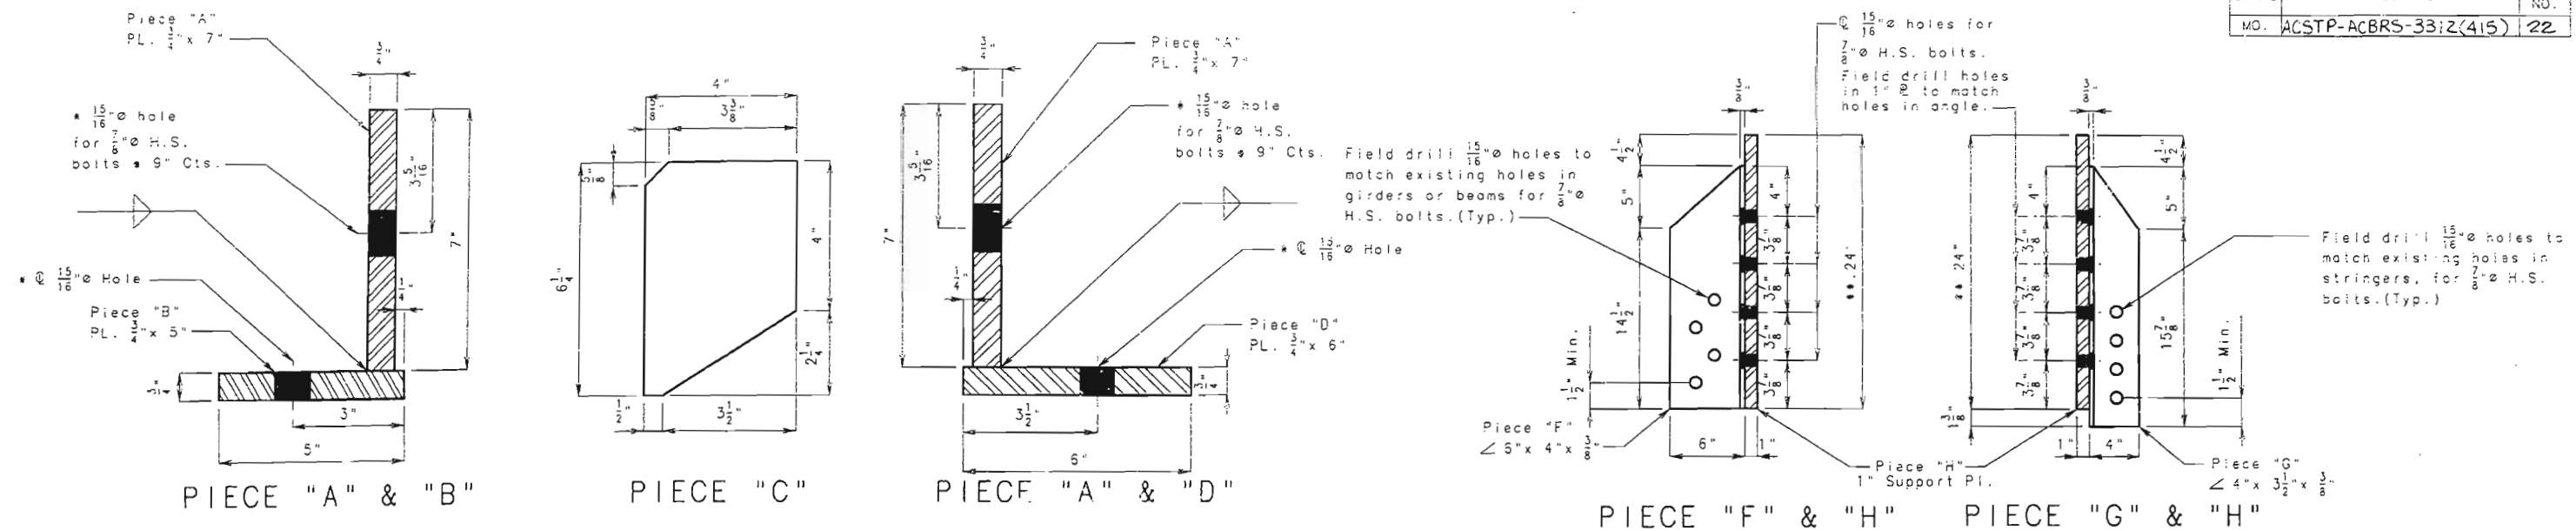

THEY THAT THIS DRAWING ACCUR-  
RELECTS THE CONFIGURATION AND LOC-  
THE ROADWAY AND APPURTENANCES AS  
DUCTS OF THIS PROJECT.

- \* Field Drill  $\frac{15}{16}$ "  $\phi$  hole in Diaphragm/Floorbeam or Pa. W14x43 for  $\frac{7}{8}$ " H.S. bolts + 9" Cts. Space between existing holes or slots in diaphragm or floorbeams.
- \*\* Top of Piece "H" shall be cut to conform to shape of roadway. If bottom of Piece "H" is not cut, it to form to crown of roadway, then this dimension is arbitrary.
- \*\*\* Weld in all accessible areas diagonal! Vertical! adjustments have been made and has been approved by the engineer.

All welding shall be in accordance with STD. SPEC. 712.  
For locations of details & related pieces, See  
Sheet No. 10

DETAILS OF FINGER PLATE @ PIERS 7 & 12.






# FINGER PLATE EXPANSION DEVICE @ PIERS 8 & 11




For details and related pieces, See Sheet No. 13.


LET THIS DRAWING ACC.  
THE CONFIGURATION AND L.  
DWAX AND APPURTENANCE.  
ON THIS PROJECT

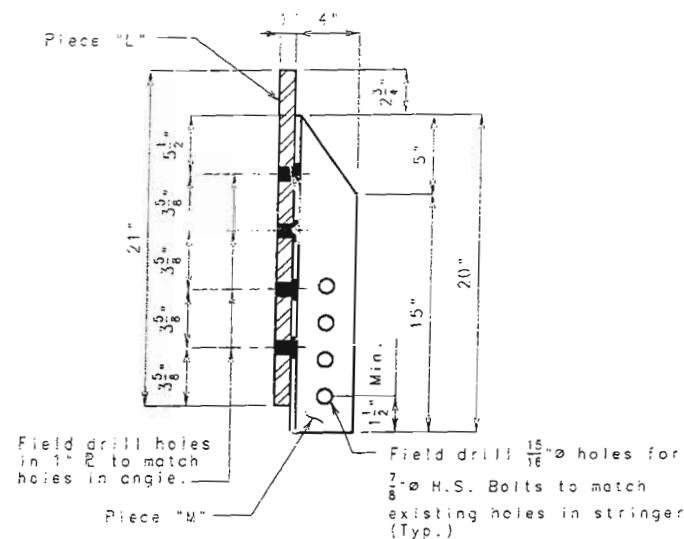


PIECE "L" & "M"

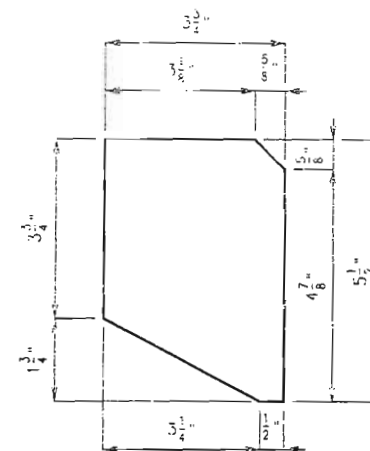

PIECE "K"

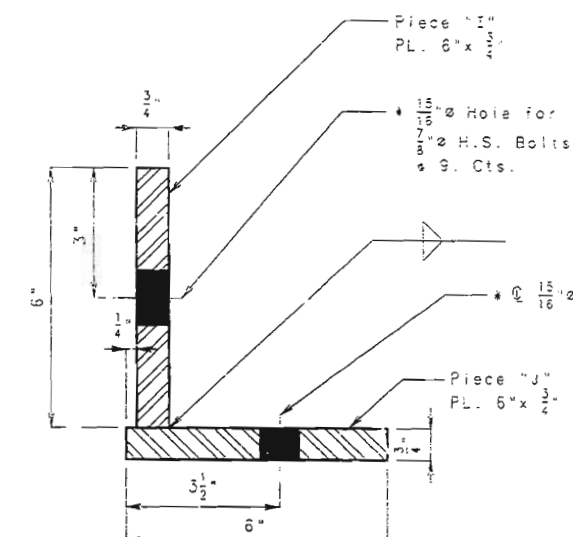


PIECE "I" & "J"

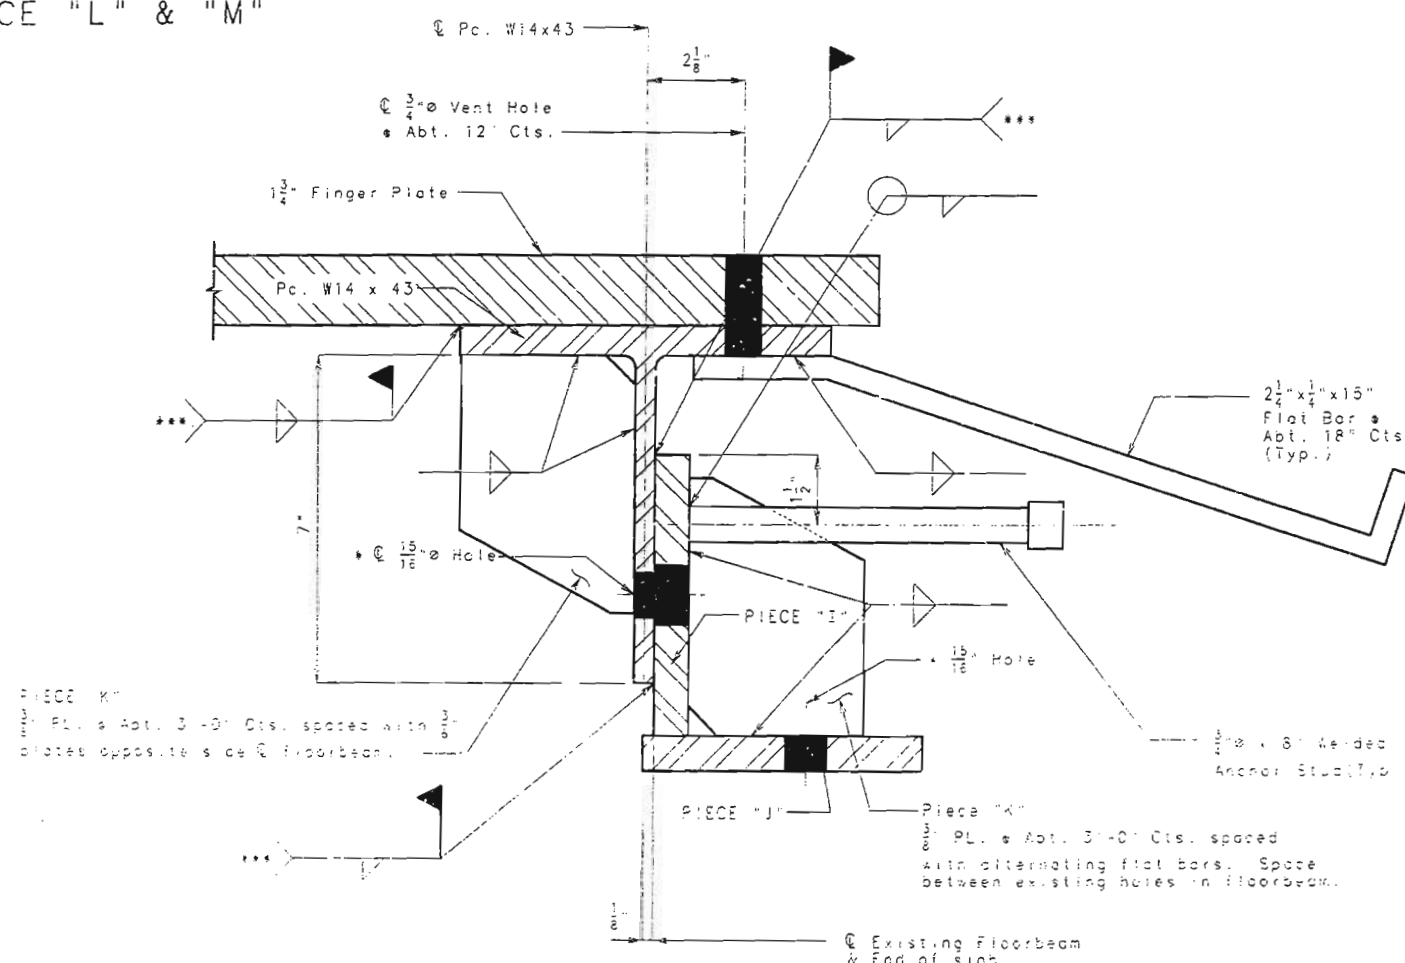

DETAIL "C"

# FINGER PLATE EXPANSION DEVICE @ PIERS 8 & 11






- Field drill 15/16" hole in Pc. W14x43 or existing floorbeam to match holes in piece "I" or "J" for 7/8" H.S. bolts & 9" Cts. Space between existing slots in floorbeam.
- Weld in all accessible areas after final vertical adjustments have been made and has been approved by the engineer.
- All welding shall be in accordance with STD. SP20, 712.
- For locations of details and related pieces, See Sheet No. 12.

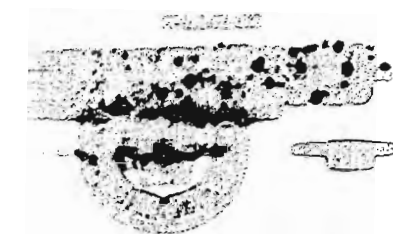







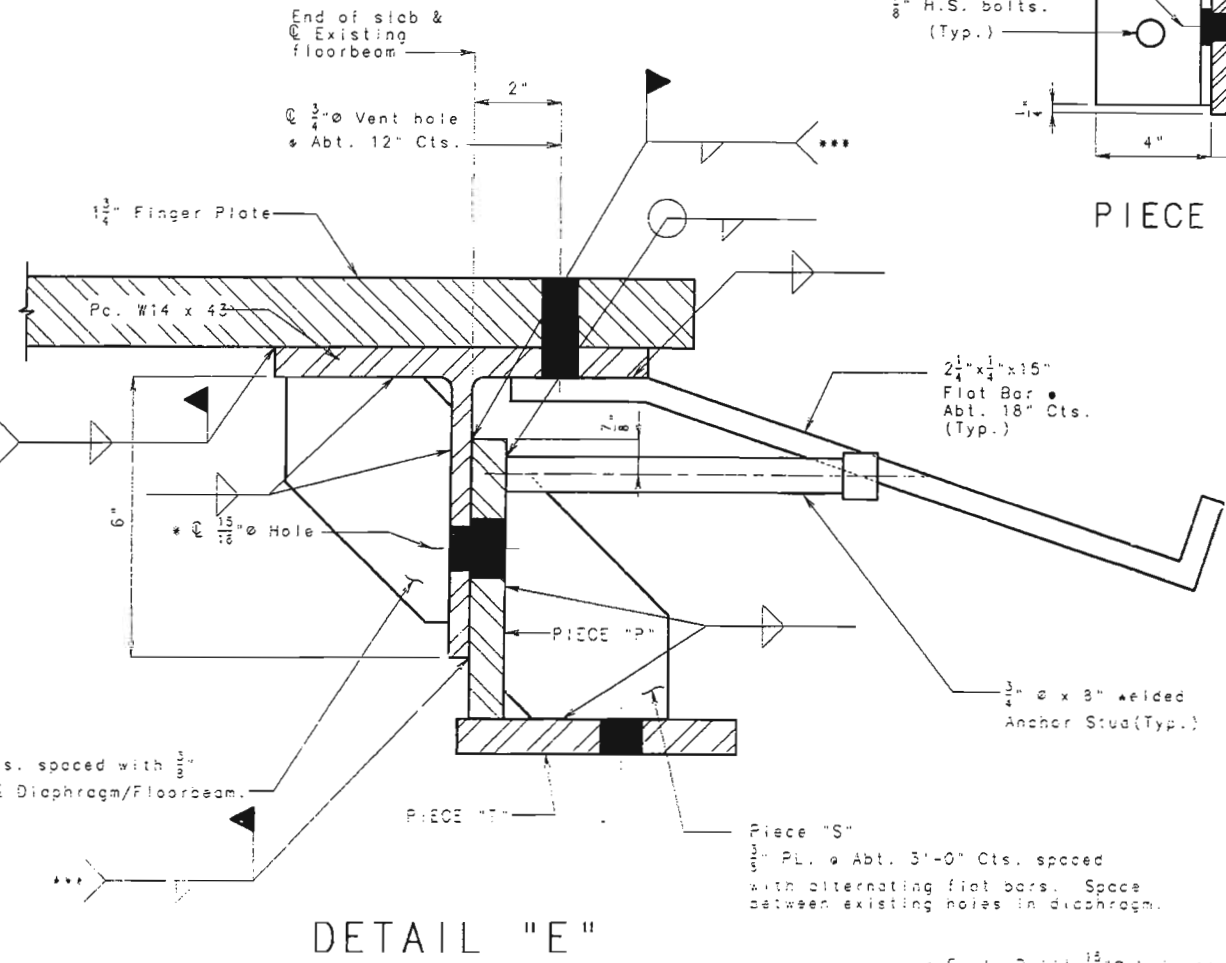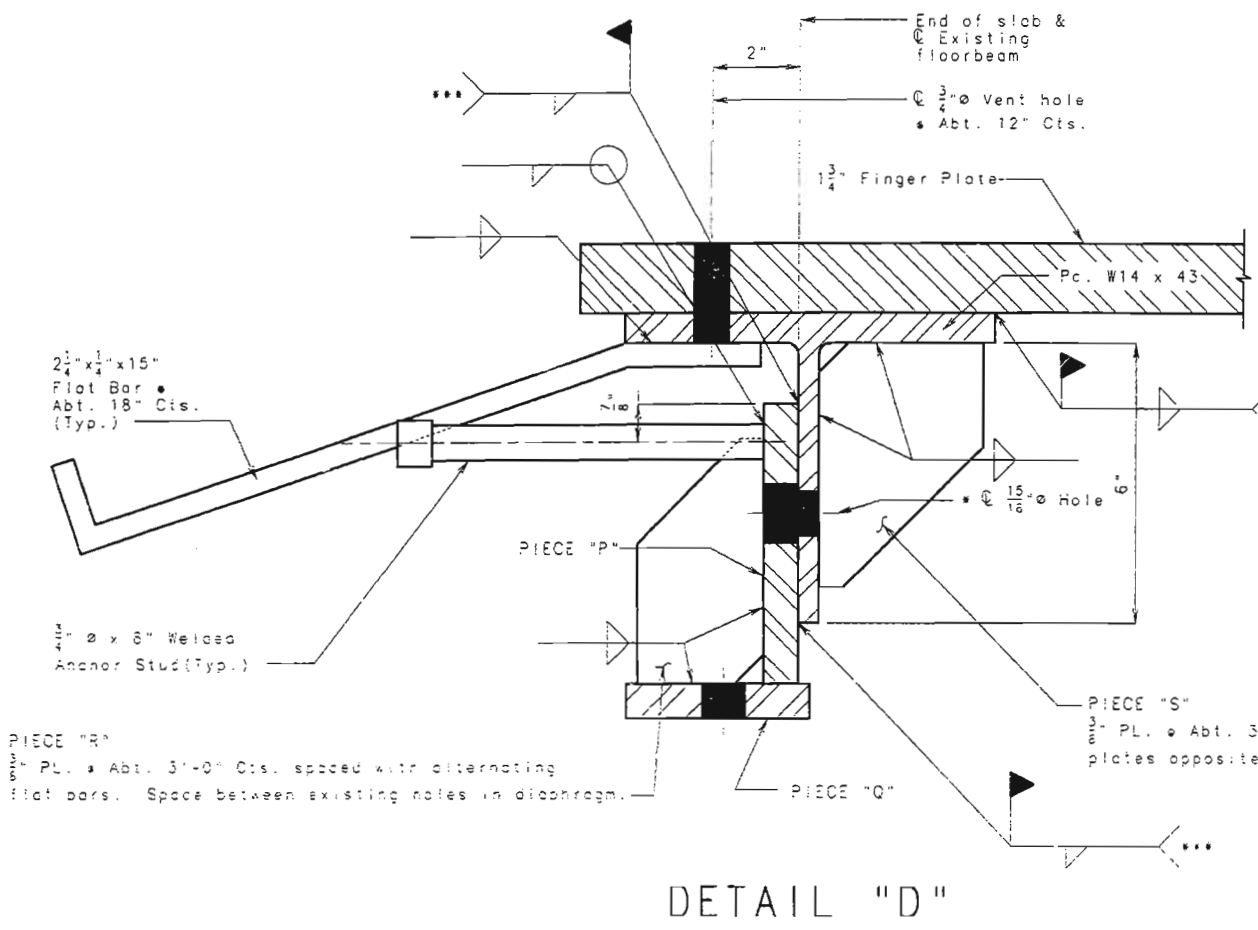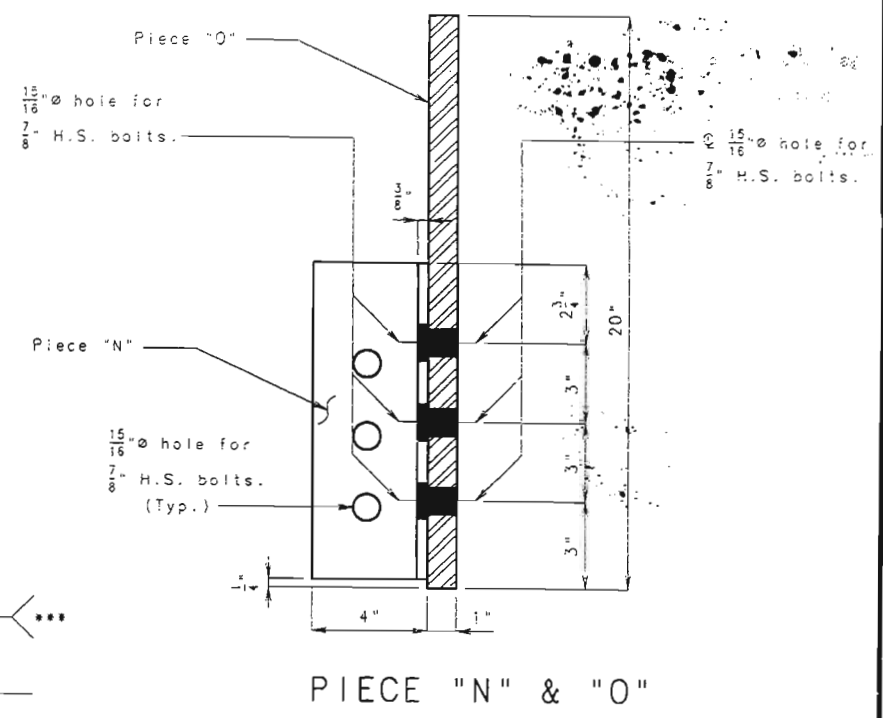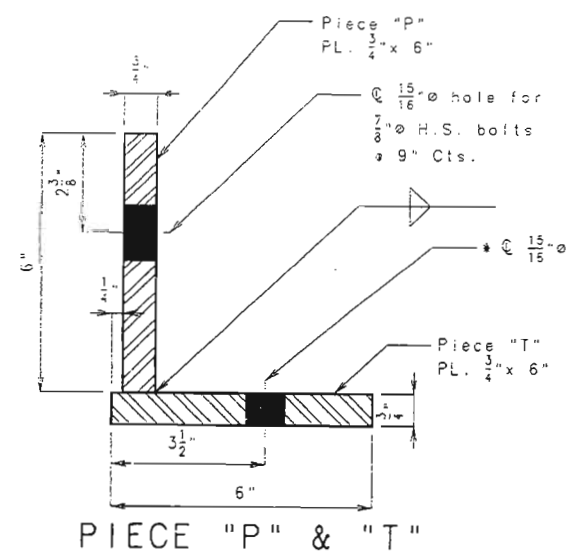
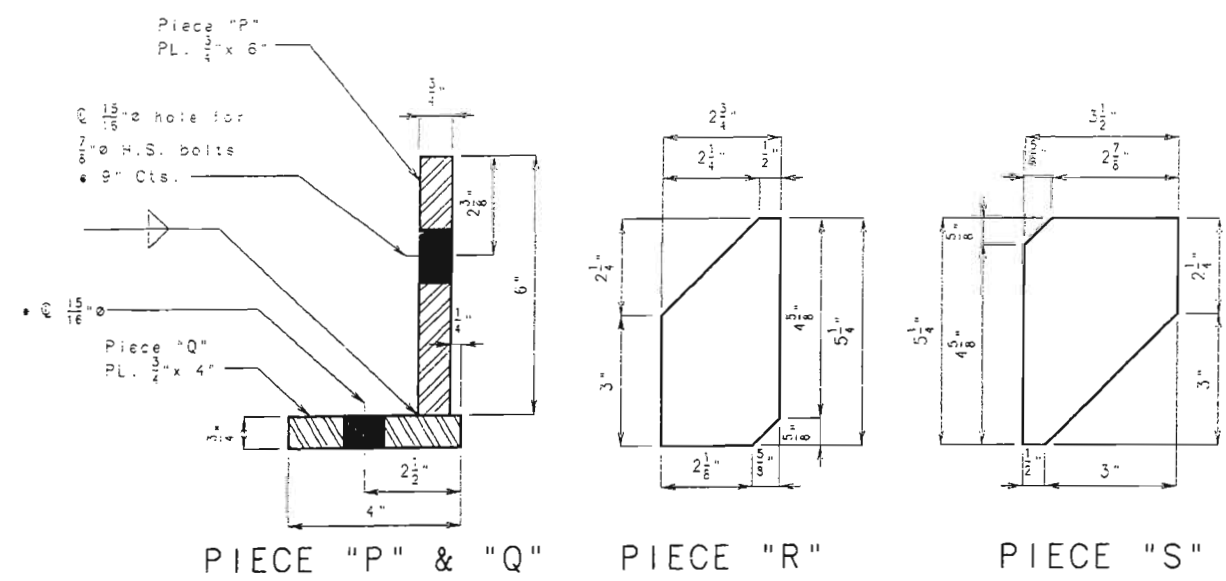


**FINAL PLAN**  
 VERIFY THAT THIS DRAWING SELECTS THE CONFIGURATION AND THE ROADWAY AND APPURTENANCES ON THIS PROJECT.




\* Field Drill 1 1/2\" hole to match existing holes in Diaphragm/Floorbeam for 7/8\" H.S. bolts.  
 \*\* Weld in all accessible areas after final vertical adjustments have been made and has been approved by the engineer.  
 All welding shall be in accordance with STD. SPEC. 712.  
 For locations of details & related pieces. See Sheet No. 14.

# DETAILS OF L19 FINGER PLATE EXPANSION DEVICE

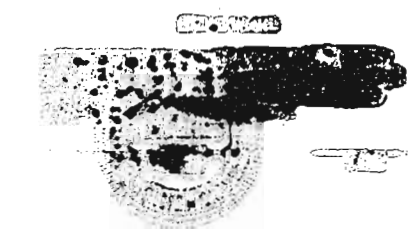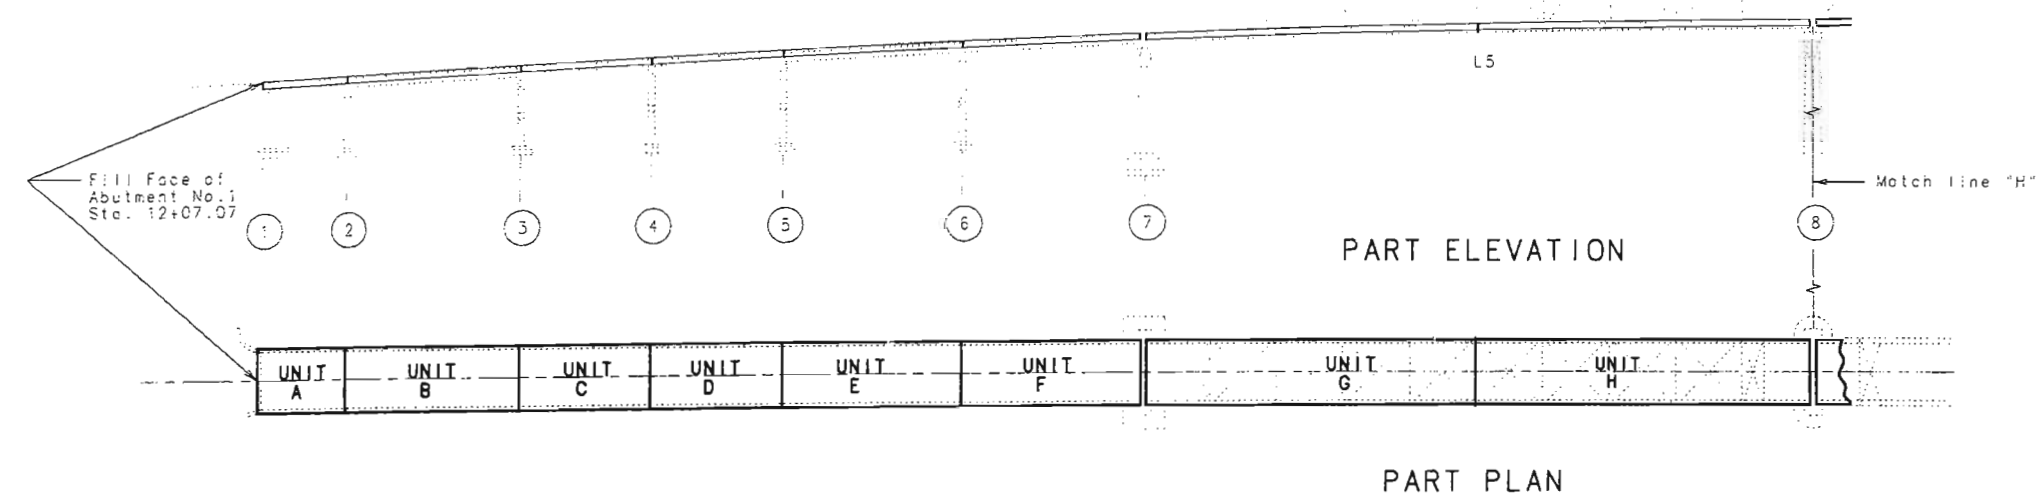

FINAL PLANS


USE THIS DRAWING ACCURATELY  
FOR THE CONFIGURATION AND LOCATION  
OF WAY AND APPURTENANCES AS  
SHOWN ON THIS PROJECT.

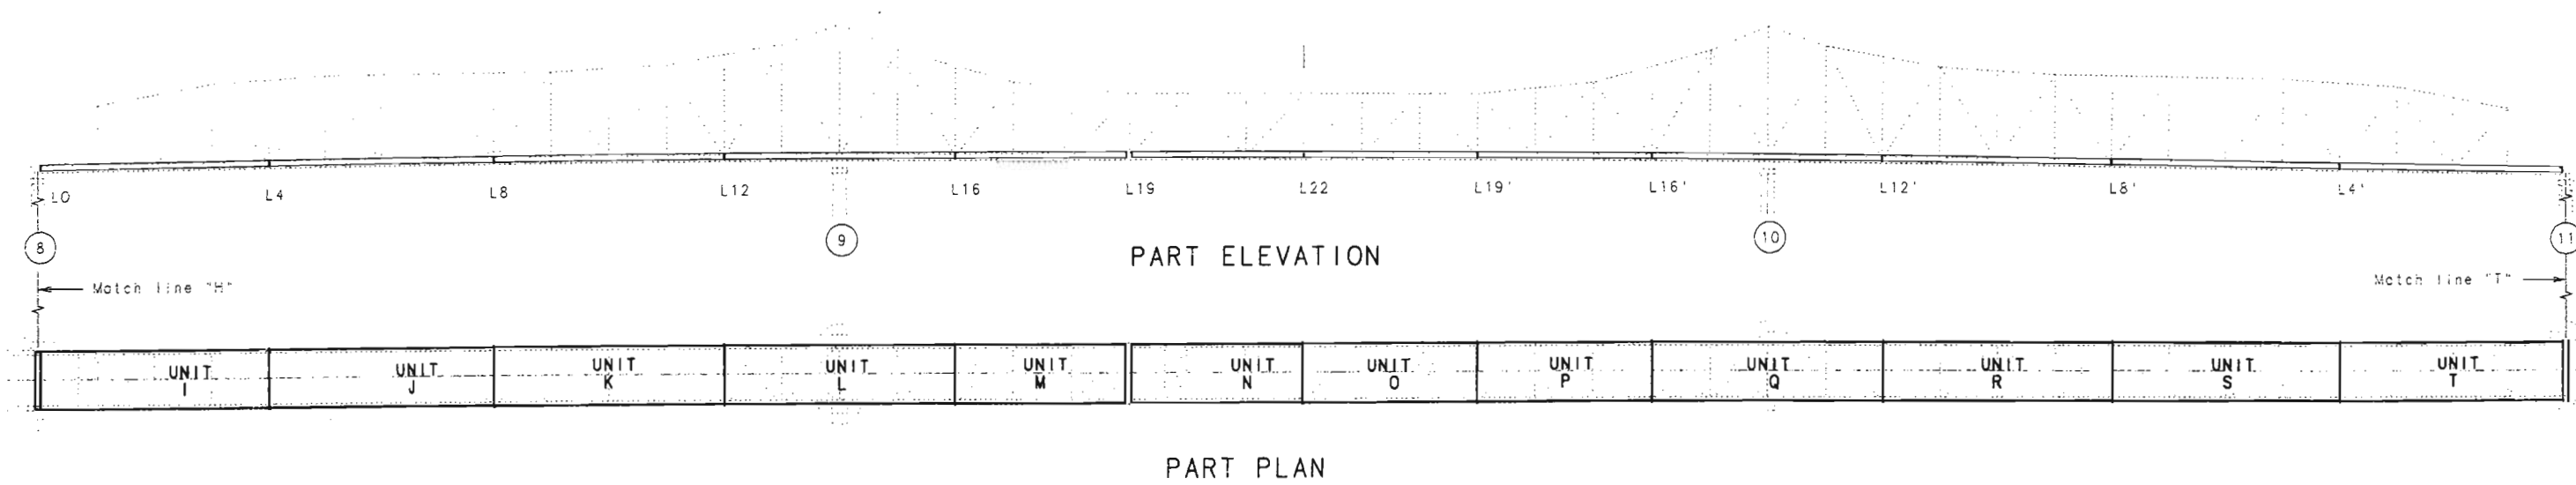


#### GENERAL NOTES FOR SLAB :

- Longitudinal dimensions are taken from original construction plans and are measured along Profile Grade.
- Preformed Compression Joint Seals in slab on Trusses are to be centered on existing filled joint locations.
- Longitudinal reinforcing steel shall be placed so that ends shall not be more than 1 1/2" from vertical armor or expansion device.
- Haunches for the slab replacement were estimated by increasing original deck load deflection by the ratio of new slab weight to the existing slab weight and adding a constant 1-9/16" (3/4" minimum haunch plus 13/16" for the top flange thickness of stringers on trusses).
- The new slab grade is to be 3-9/16" above the existing grade (due to 2" increased slab thickness plus a 1-9/16" grade adjustment on the whole structure mentioned previously). Haunches given are from the top of the steel beams (not top of cover plates) to the bottom of the new slab.
- Concrete in the slab haunches is included in the Estimated Quantities for Slab on Steel.
- For location of slab drains see sheets no. 34 and no. 35.
- For Slab Pouring Sequence see sheet no. 17.


#### LOCATION OF SLAB UNITS AND SLAB POURING SEQUENCE

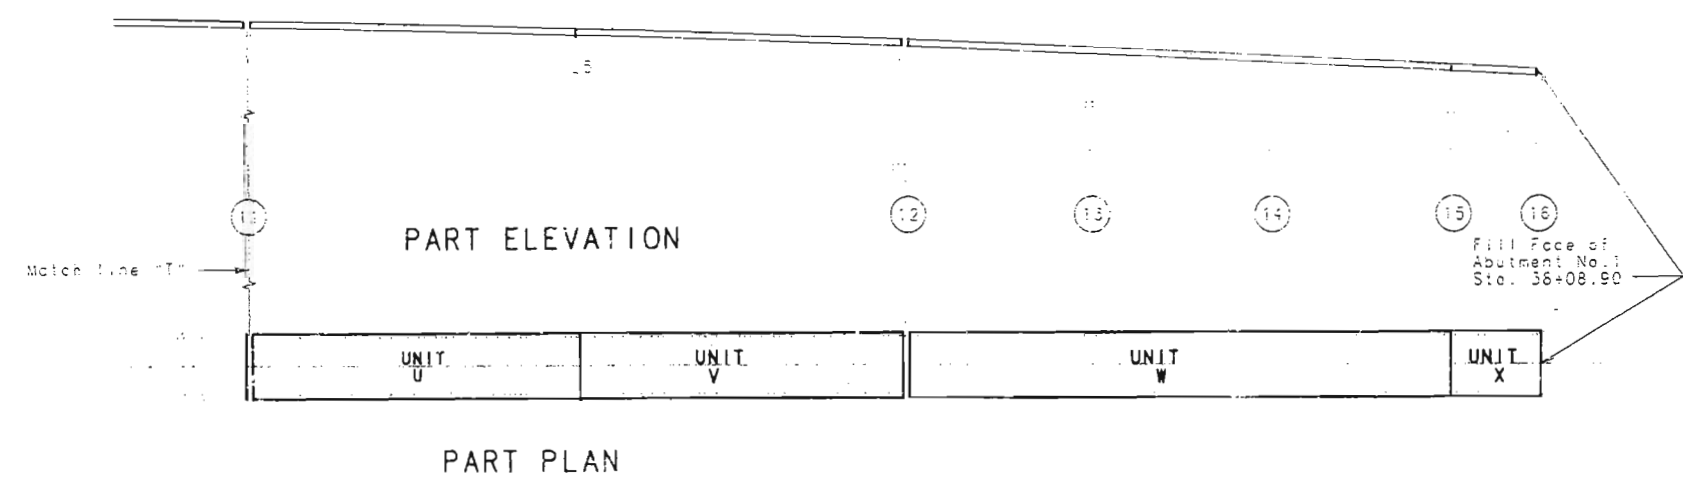


347

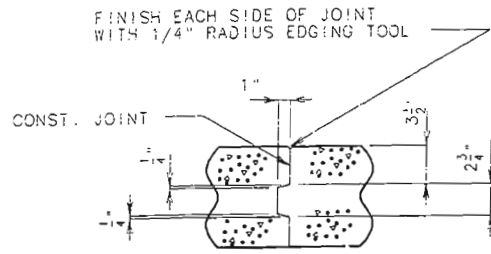

DETAIL OF CONST. JT.  
FOR CAST-IN-PLACE SLAB

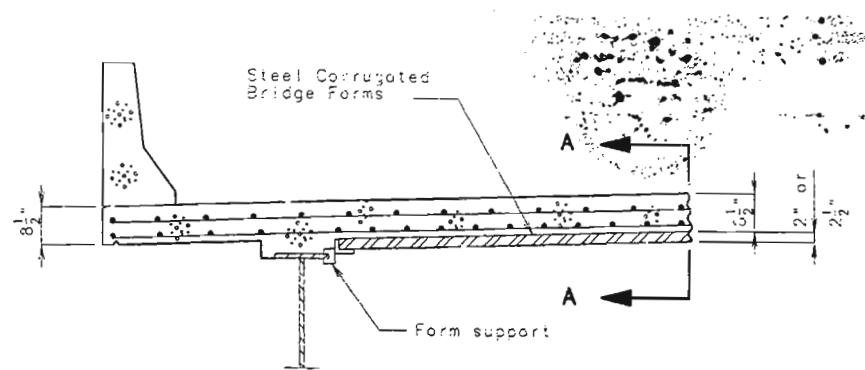


PART SECTION

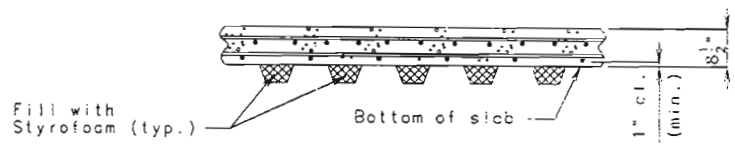

SECTION A-A

DETAILS OF OPTIONAL STAY-IN-PLACE FORMS

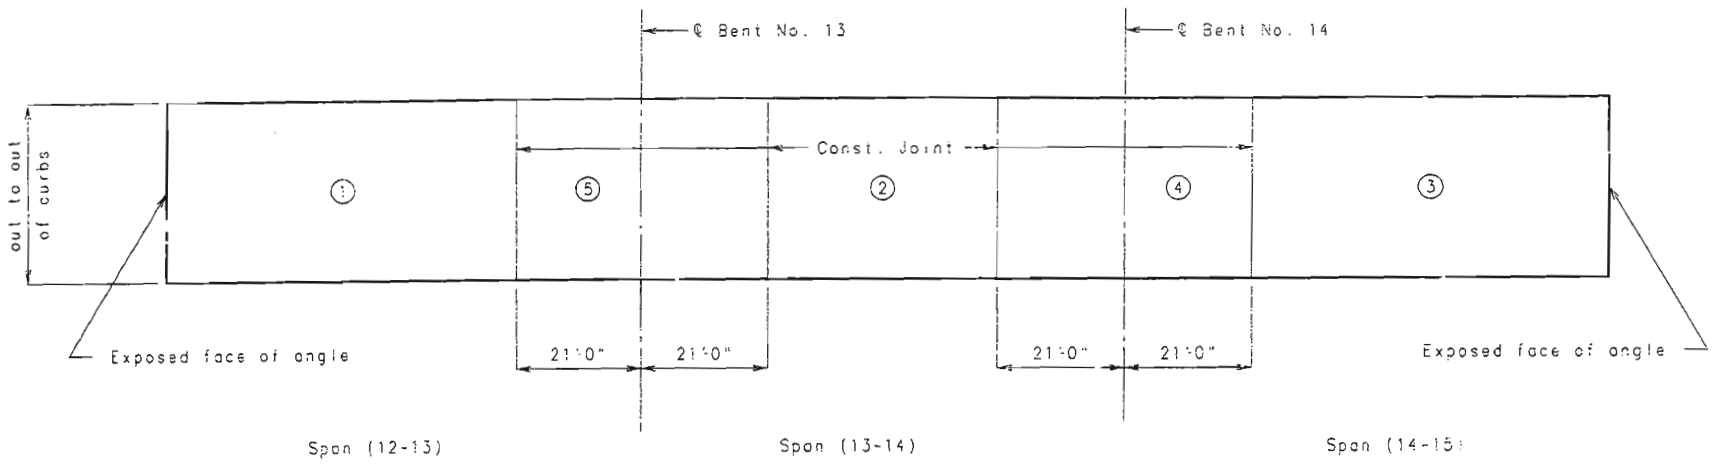

PLAN OF SLAB UNIT W

	SEQUENCE OF POURS					MIN. RATE OF POUR CU. YDS./HR.	
	DIRECTION					WITH RETARDER	NO RETARDER
BASIC SEQUENCE	1	2	3	4	5	25	25
ALTERNATE POURS TO THE BASIC SKIP SEQUENCE ARE SUBJECT TO THE APPROVAL OF THE ENGINEER IN ACCORDANCE WITH SECTION 703.3.12.4 OF MISSOURI STANDARD SPECIFICATIONS.							
ALTERNATE "A" POURS	1	5 + 2	3	4 + 3	2 TO END	32	25
ALTERNATE "B" POURS	1 + 5 + 2	3	4 + 3	2 TO END			
ALTERNATE "C" POURS	1 + 5 + 2 + 4 + 3	2 TO END					
ALTERNATE "D" POURS	1 + 5 + 2 + 4 + 3	END TO END					

SLAB POURING SEQUENCE FOR SPANS (12-13), (13-14)&(14-15)  
SLAB UNIT W

SEQUENCE OF CONSTRUCTION FOR CONTINUOUS TRUSS	
OPTION #1	REMOVE ALL EXISTING SLAB IN THIS ORDER AND REPLACE
	(1) REMOVE : L10 to L19 and L19 to L10
	(2) REMOVE : L19 to L19'
	(3) REMOVE : L0 to L10 and L10' to L0'
	(4) REPLACE: L0 to L8 and L8' to L0'
	(5) REPLACE: L19 to L19'
OPTION #2	OR
	REMOVE AND REPLACE EXISTING SLAB IN THIS ORDER
	(1) REMOVE : L19 to L19'
	(2) REMOVE and REPLACE : L0 to L8 and L8' to L0'
	(3) REPLACE: L19 to L19'
	(4) REMOVE AND REPLACE : L8 to L19 and L19' to L8

SLAB POURING SEQUENCE FOR SPANS (8-9), (9-10)&(10-11)  
Note: Minimum rate of pour shall be 25 cu.yds. per hour

SLAB UNITS I THRU T

SLAB POURING SEQUENCE




















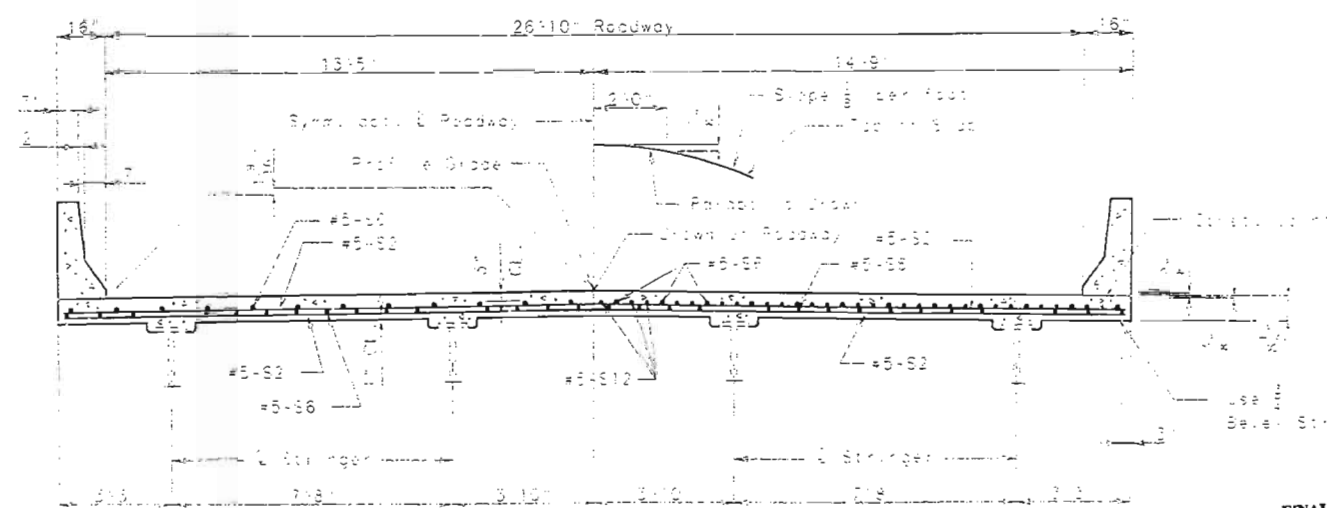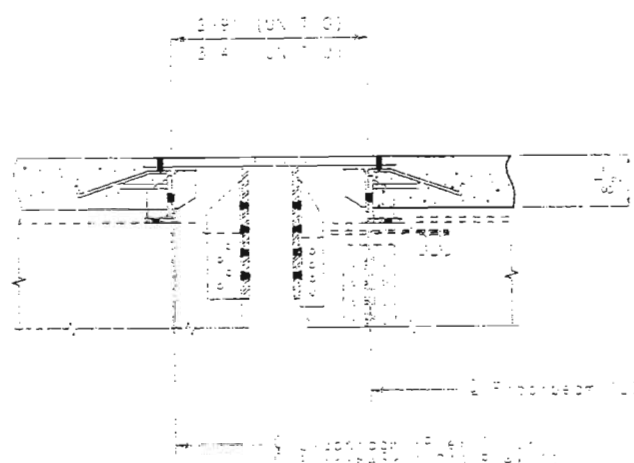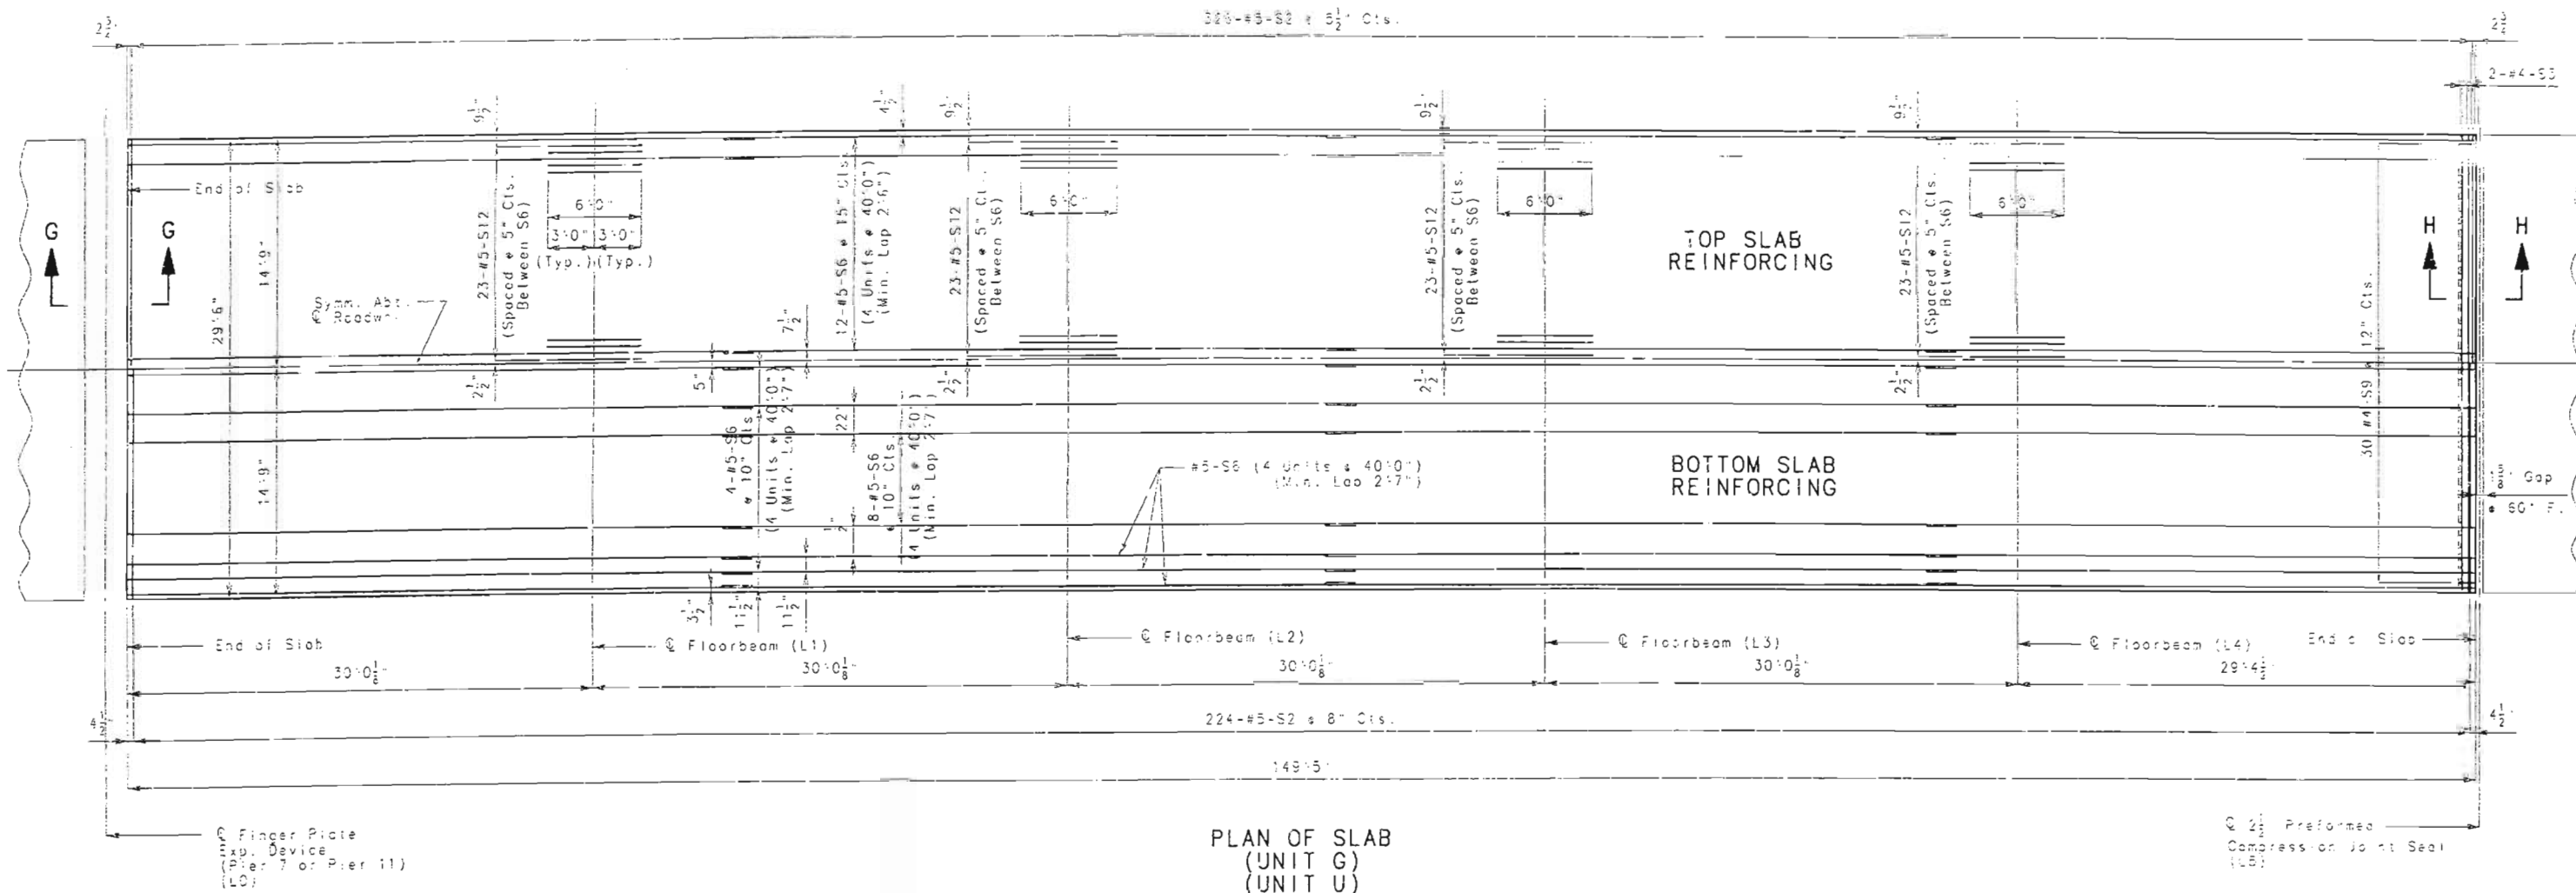






FINAL PLANS

I CERTIFY THAT THIS DRAWING REFLECTS THE CONFIGURATION AND LOCATION OF THE ROADWAY AND APPURTENANCES CONSTRUCTED ON THIS PROJECT.

SIGNATURE


DATE

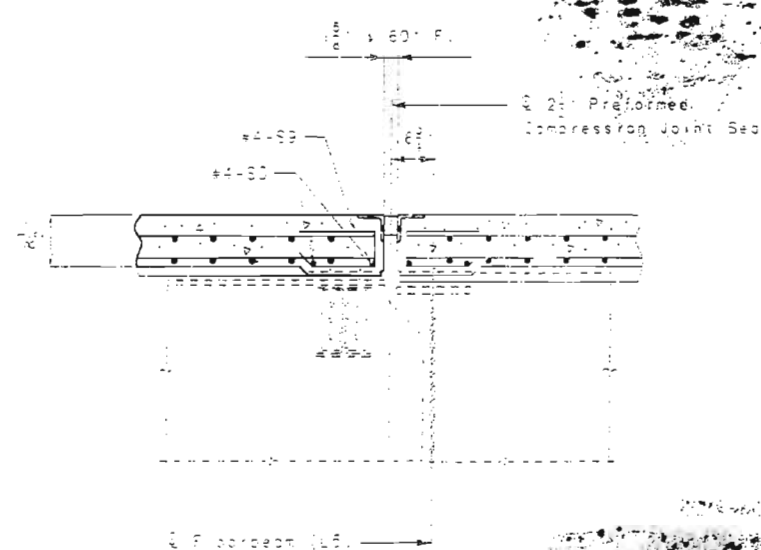

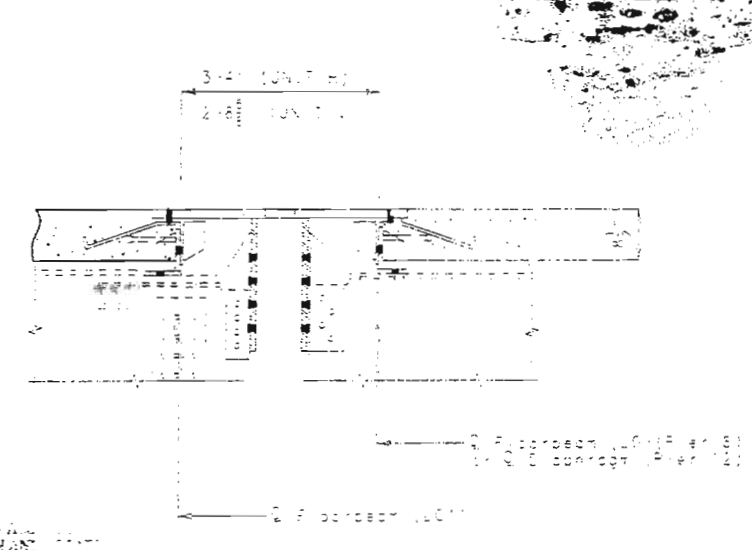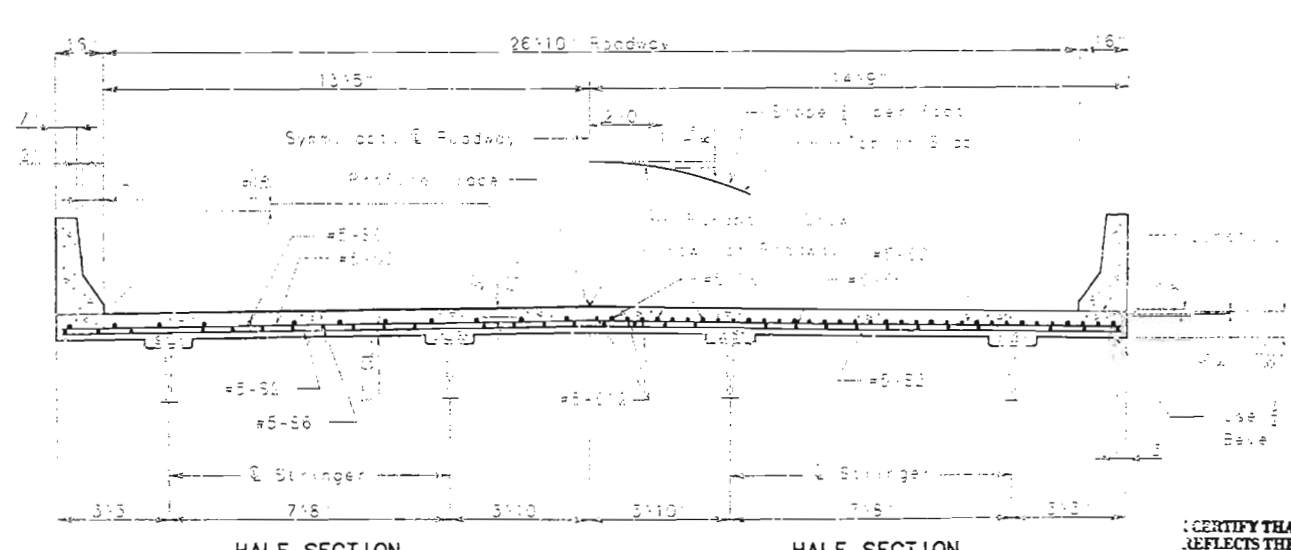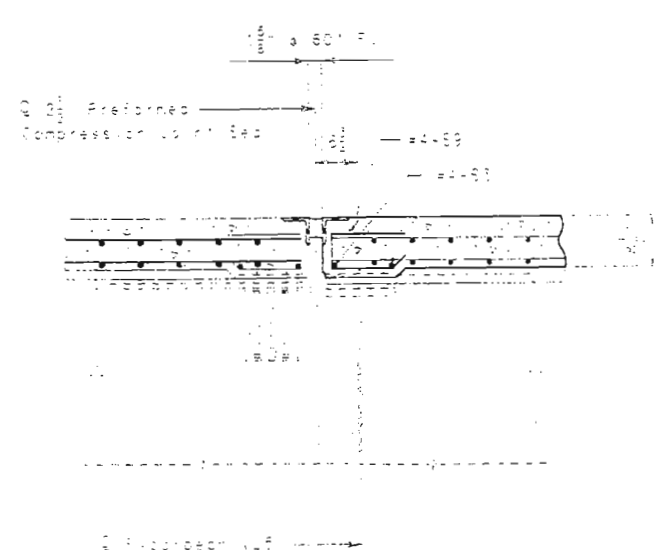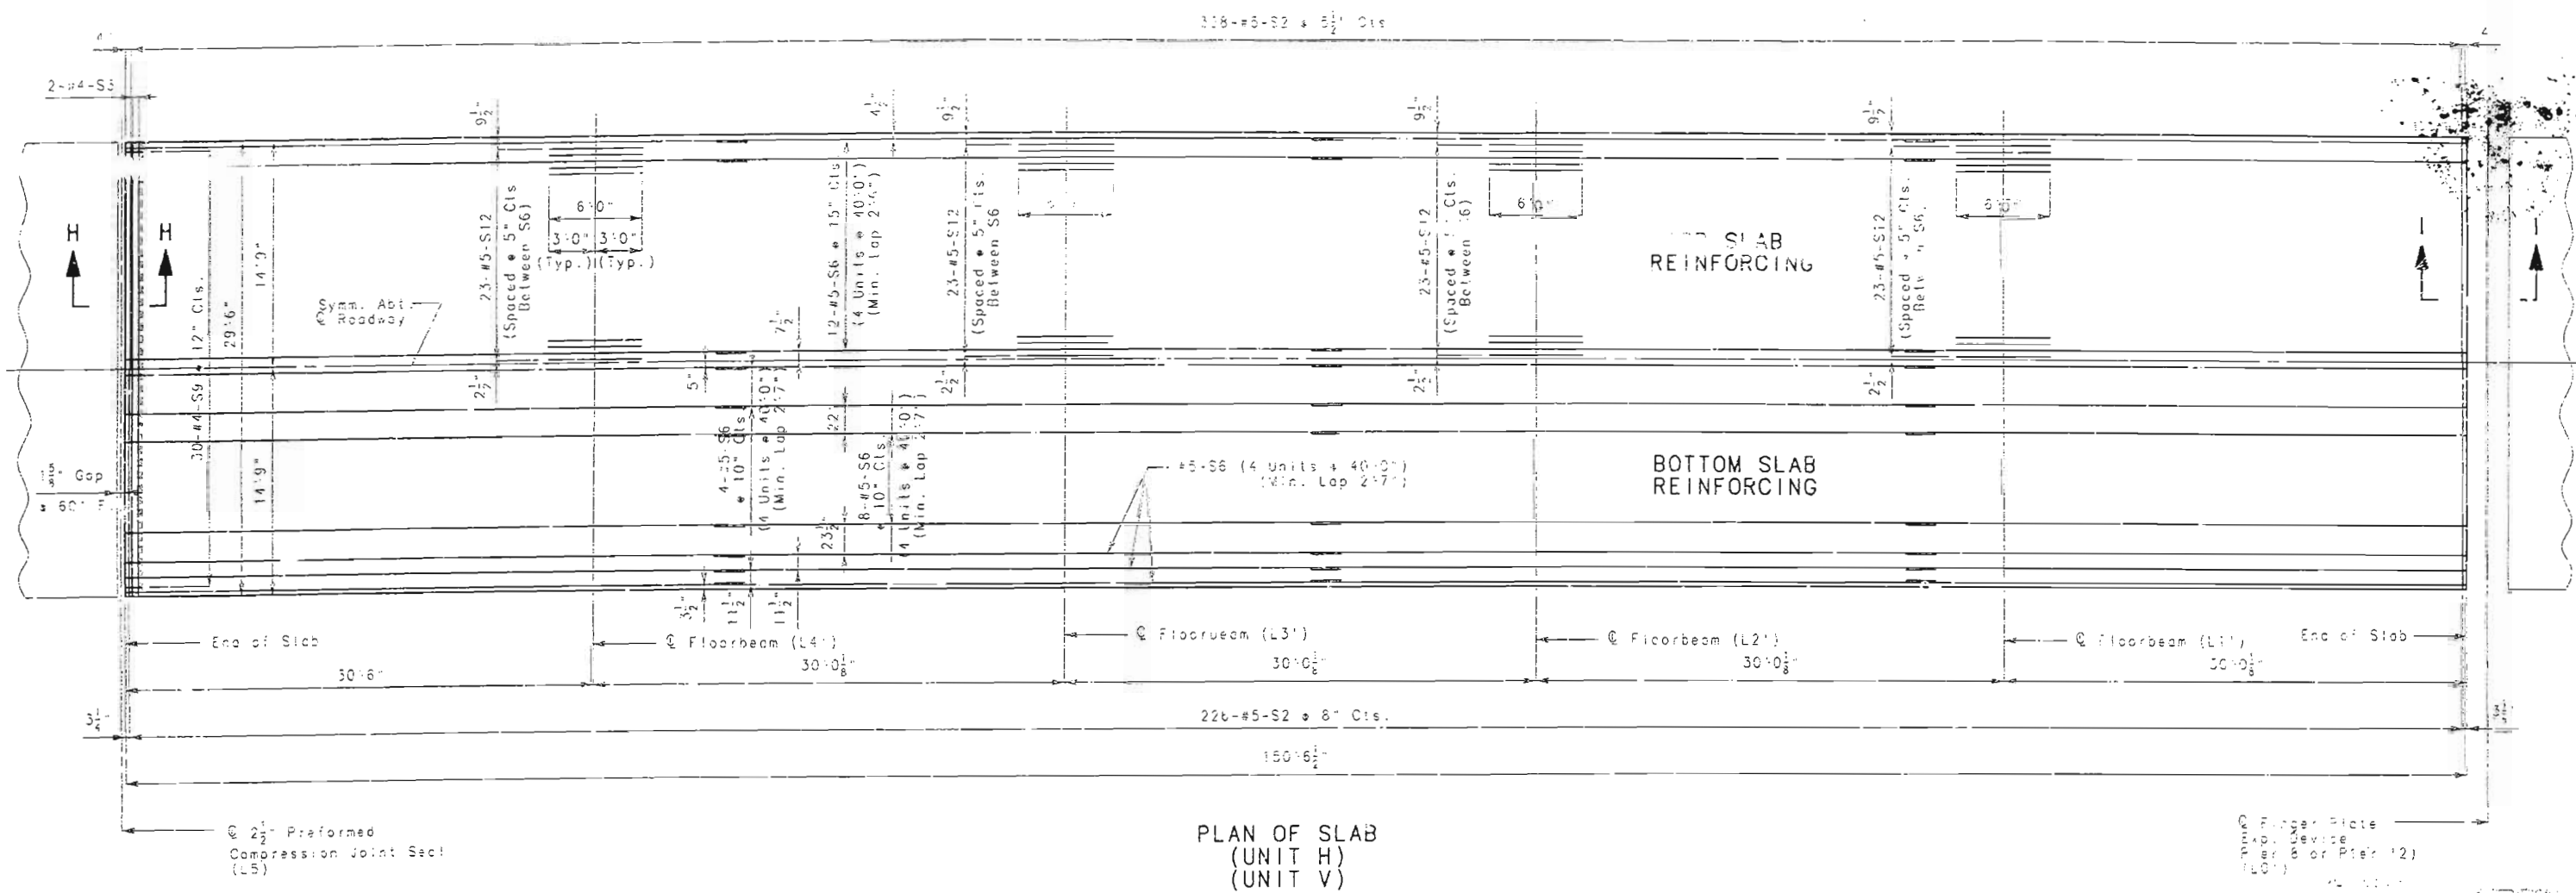


FINAL PLANS  
 I CERTIFY THAT THIS DRAWING  
 REFLECTS THE CONFIGURATION AND  
 OF THE ROADWAY AND APPURTENANCE  
 CONSTRUCTED ON THIS PROJECT.  
 SIGNATURE DATE

356

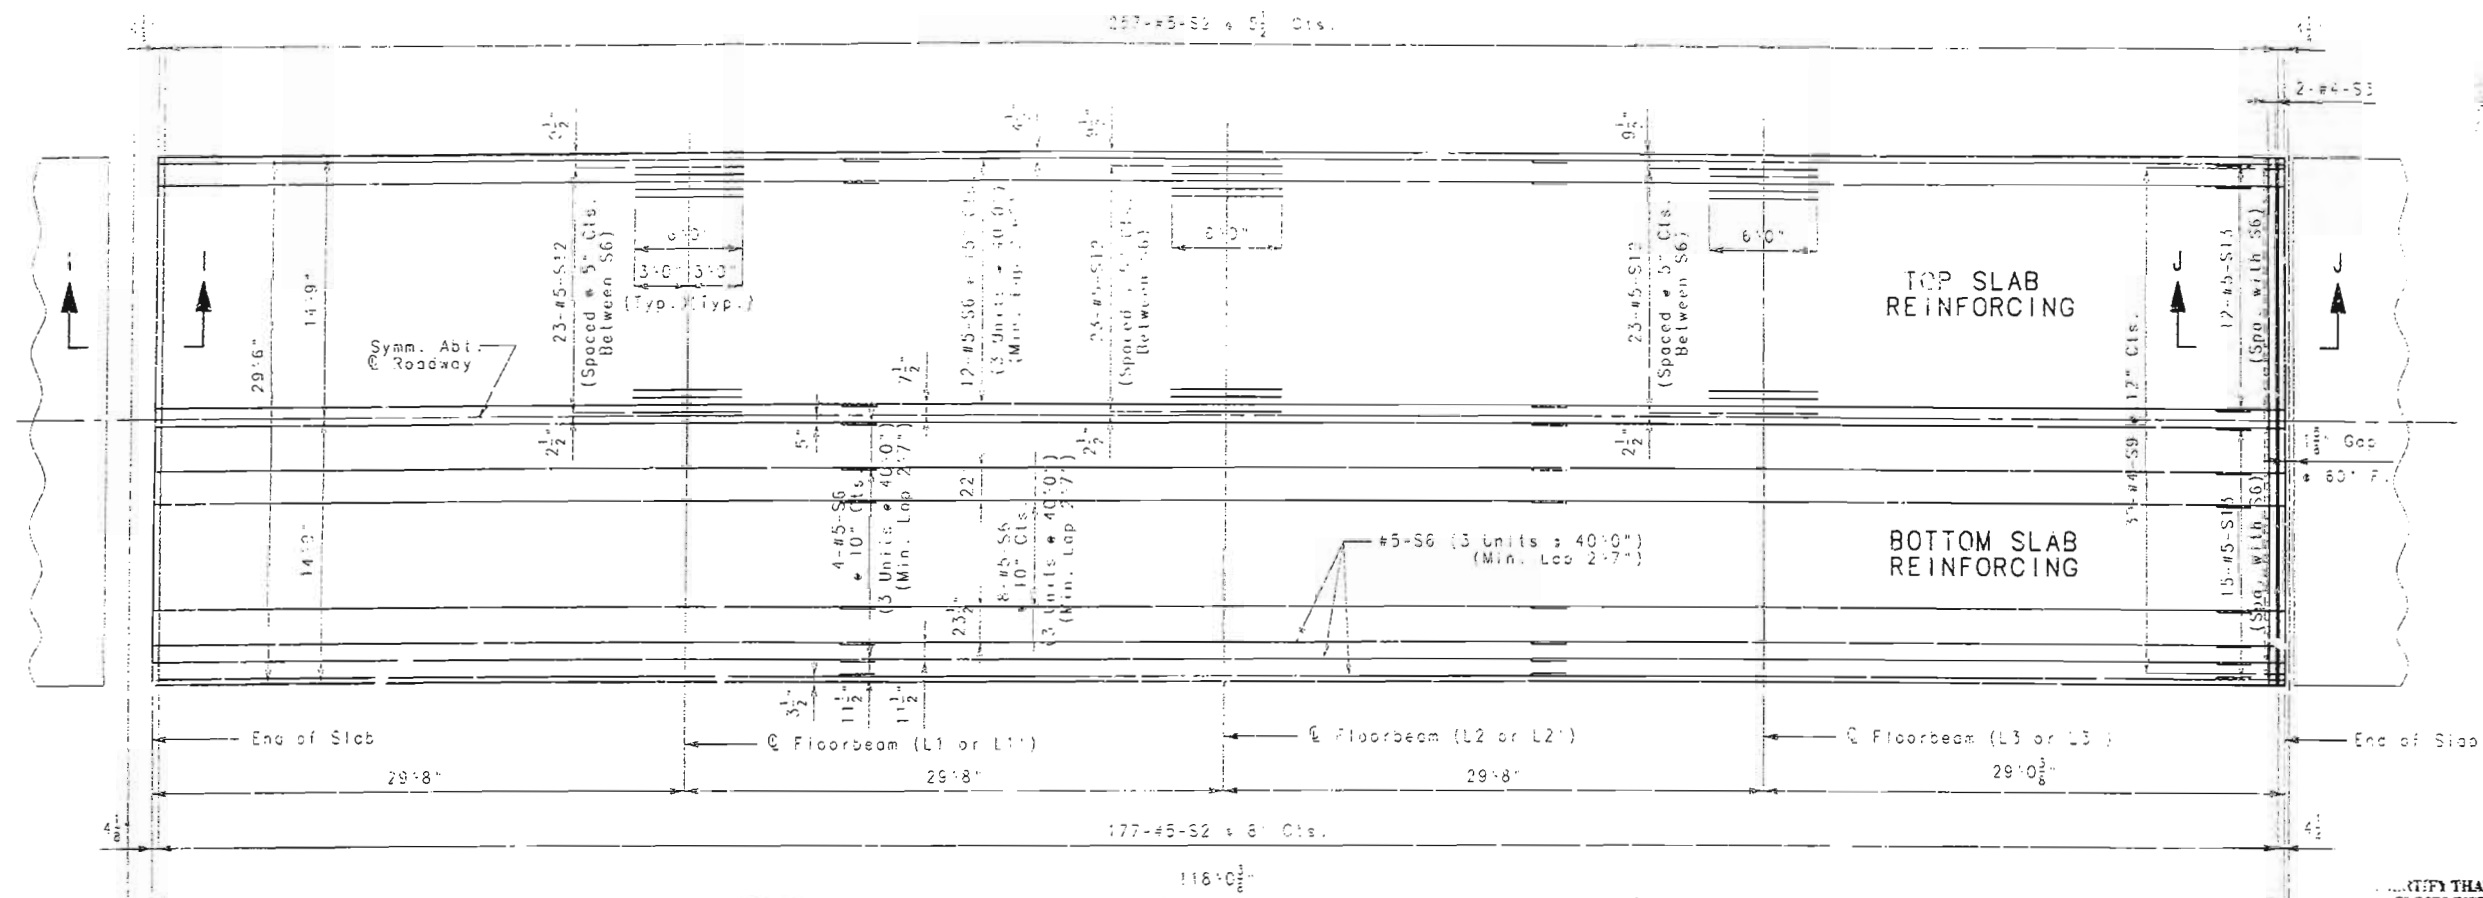


PLAN OF SLAB  
(UNIT I)  
(UNIT T)

FINAL PLAN  
CERTIFY THAT THIS PLAN  
REFLECTS THE CONFIGURATION AND  
THE ROADWAY AND SURFACE  
ON THIS PROJECT  
*[Signature]* 1/1/99

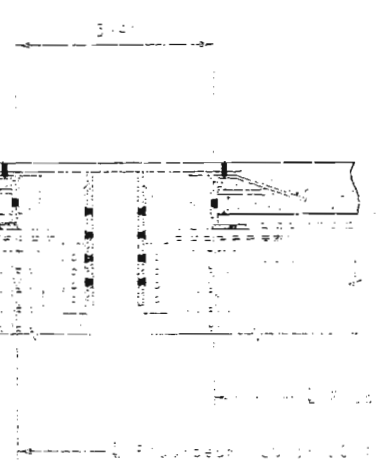


SECTION I-I

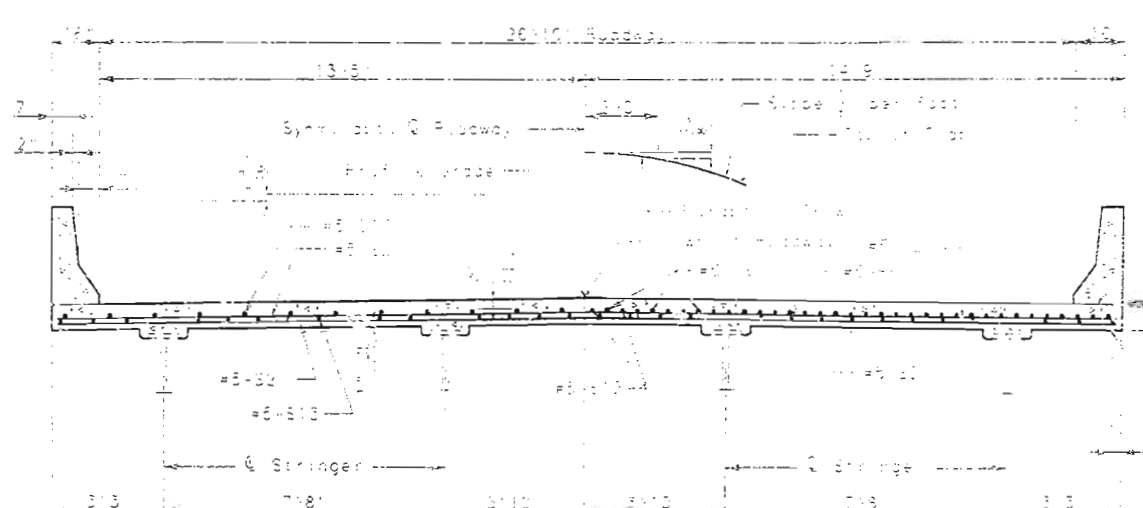


HALF SECTION  
NEAR (L4)


HALF SECTION  
NEAR FLOORBEAM

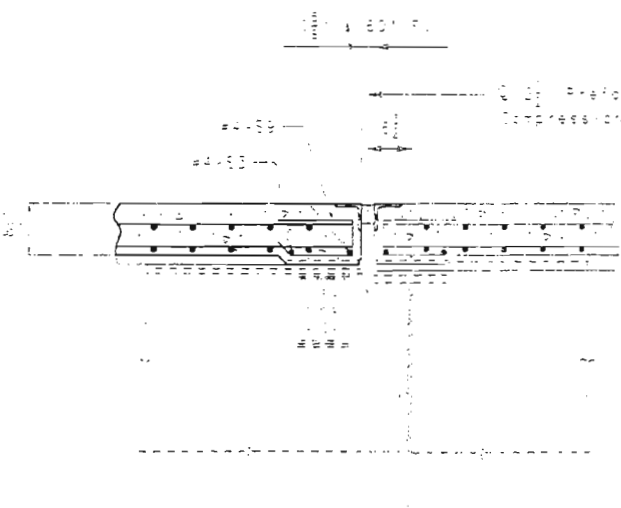

SECTION J-J

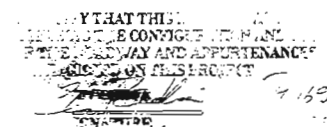

Q 2 1/2" Preformed \_\_\_\_\_  
Compression Joint: Sec  
(L8, L12, L16 or  
L8', L12', L16')




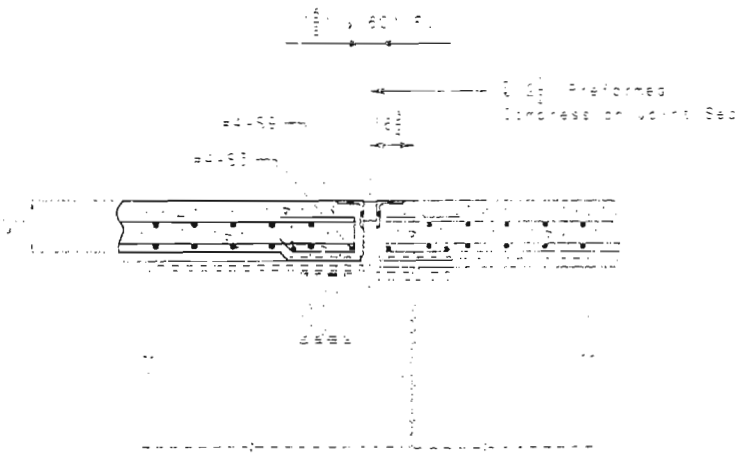


SECTION K-K

[illegible]





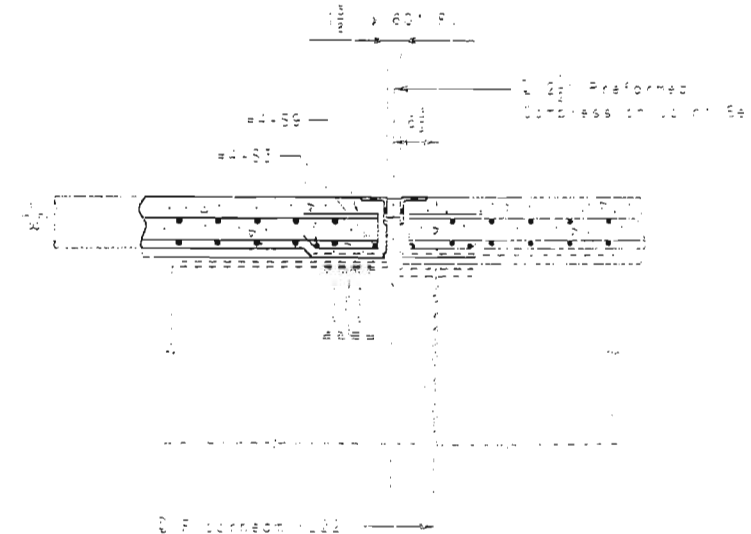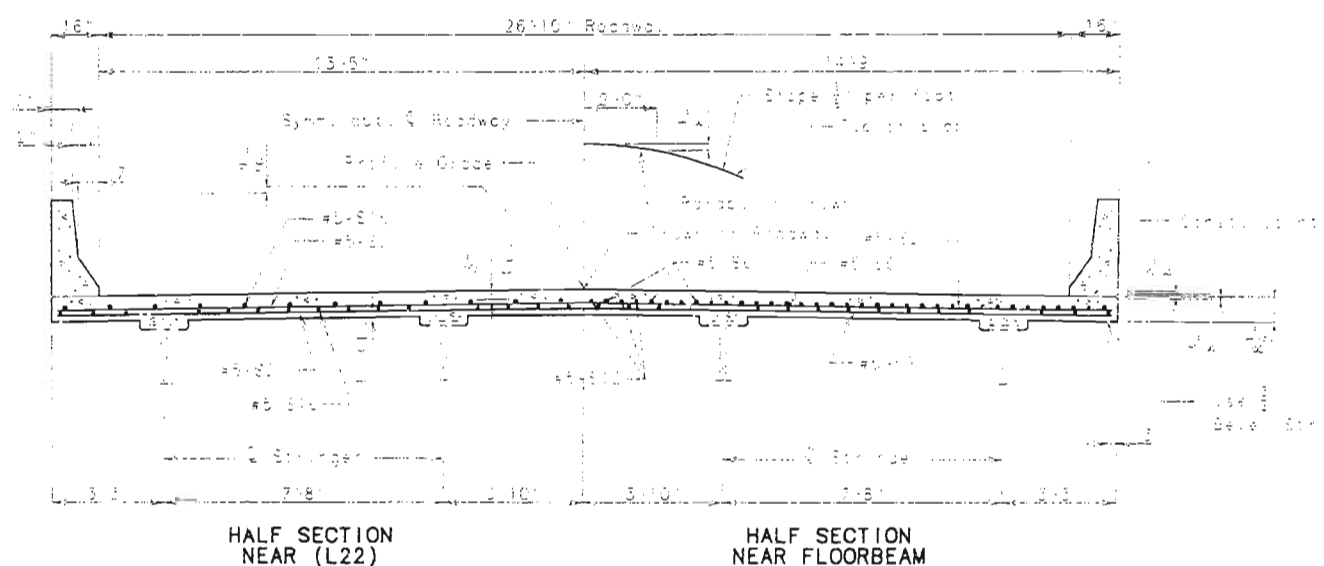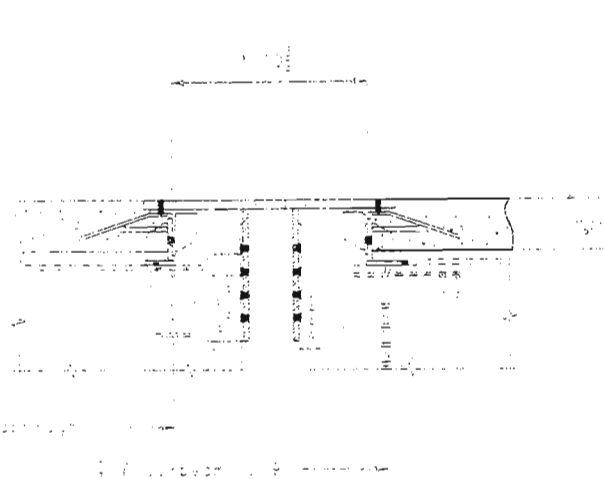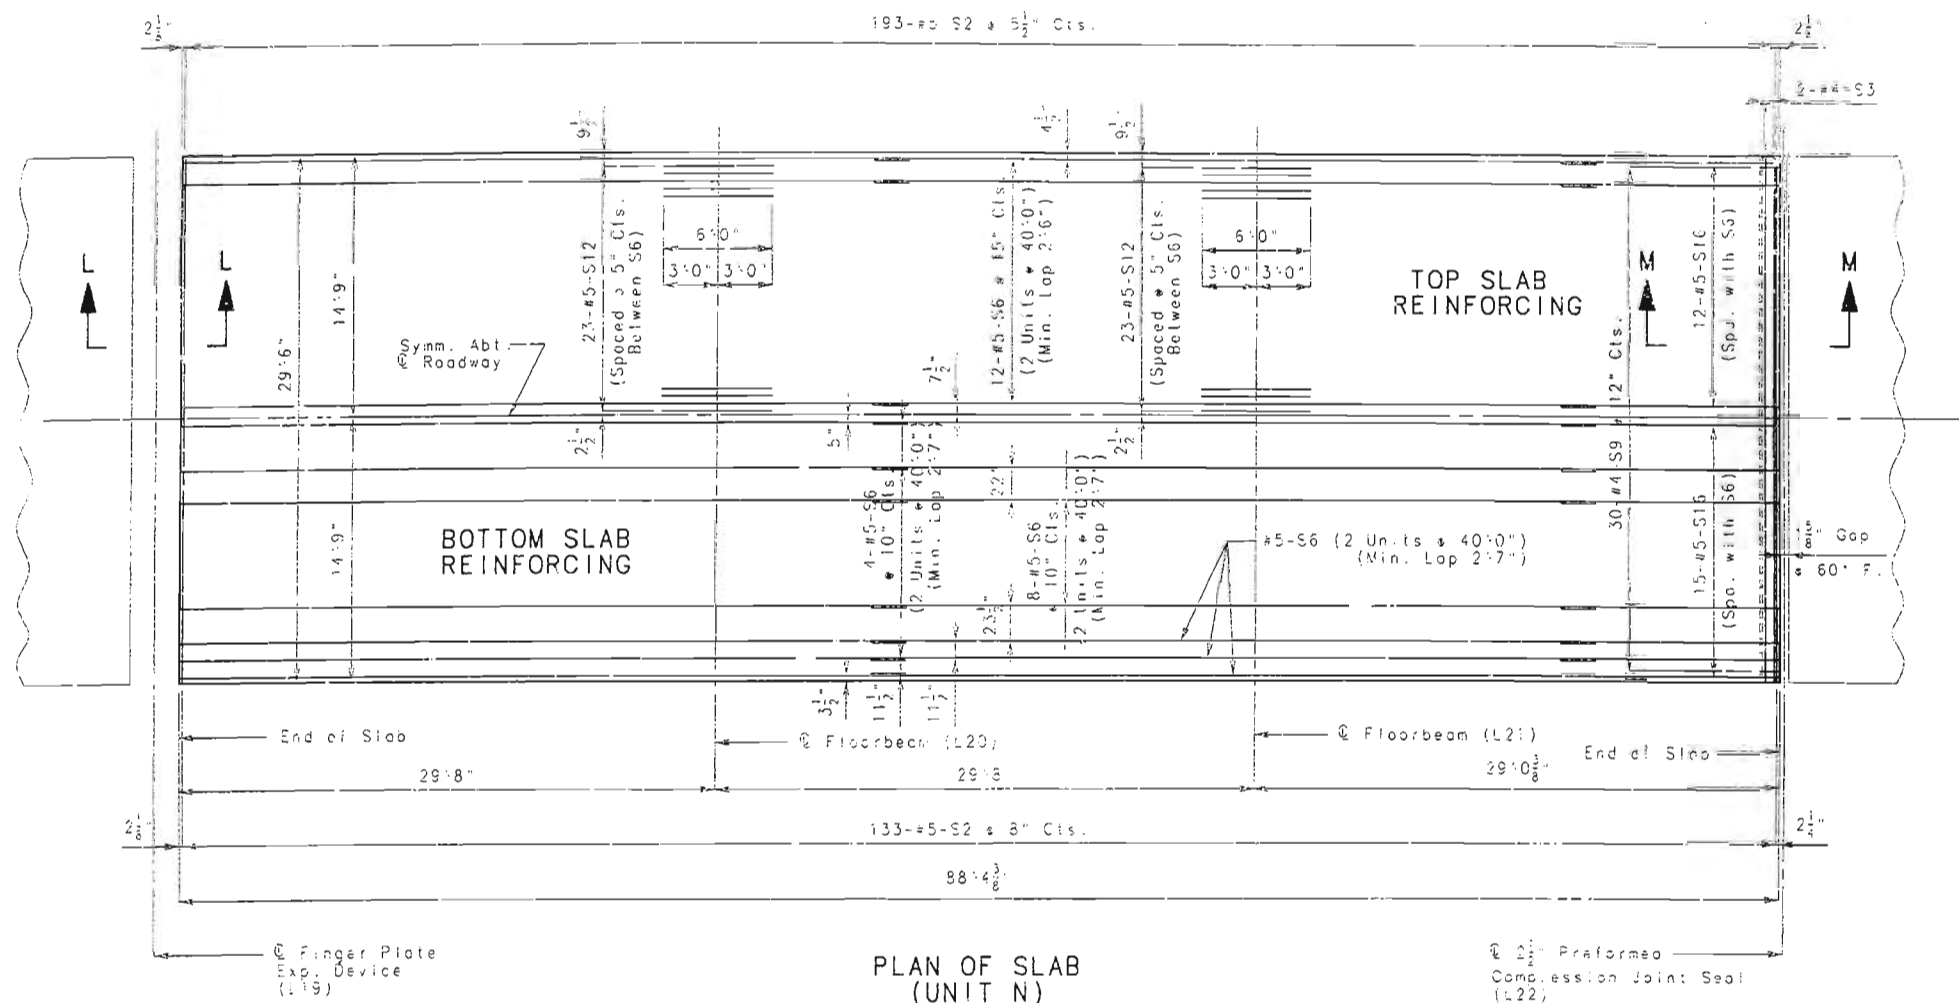

SECTION L-L

Notes: For Details and Reinforcement of Joints, Barrier Curb not shown see sheet no. 40.  
 For anchorage see sheet no. 40.  
 For slab pouring sequence see sheet no. 40.

SECTION M-M

360













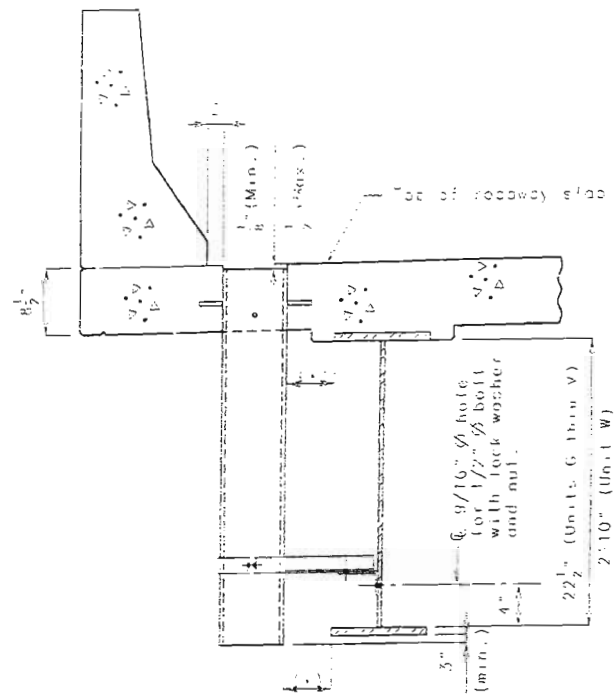


PART SECTION NEAR DRAIN

If a hole is less than 1", drains shall be located parallel to roadway. Other set pipe drains transverse to roadway.

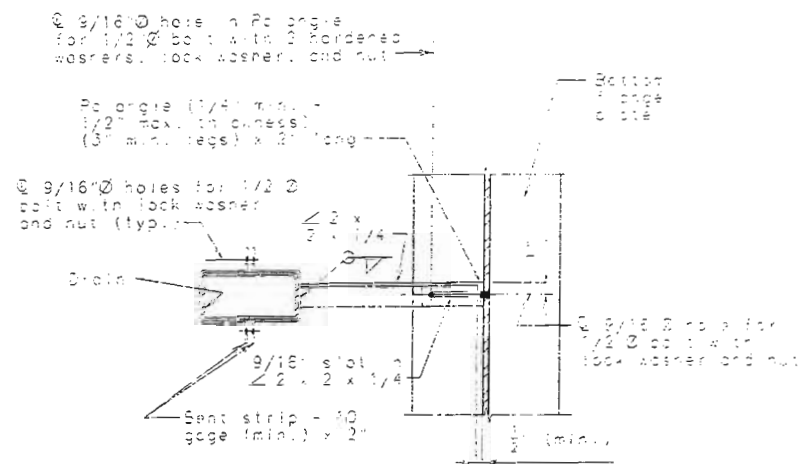


PART SECTION SHOWING BRACKET ASSEMBLY

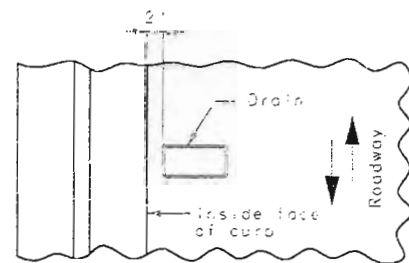


PART PLAN OF SLAB AT DRAIN

DETAILS OF DRAINS TRANSVERSE TO ROADWAY

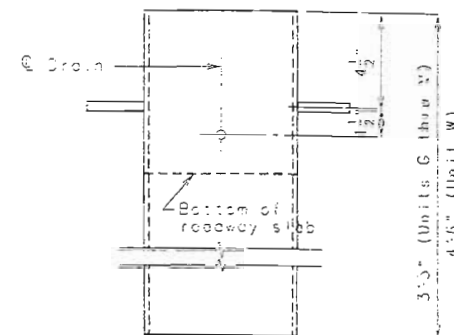


ELEVATION OF DRAIN

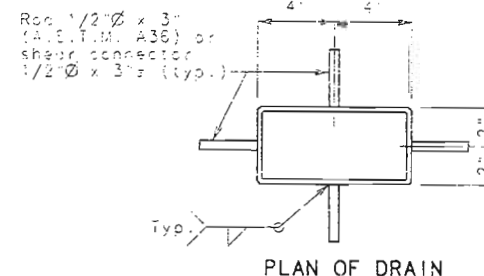

PLAN OF DRAIN

## SLAB DRAIN DETAILS

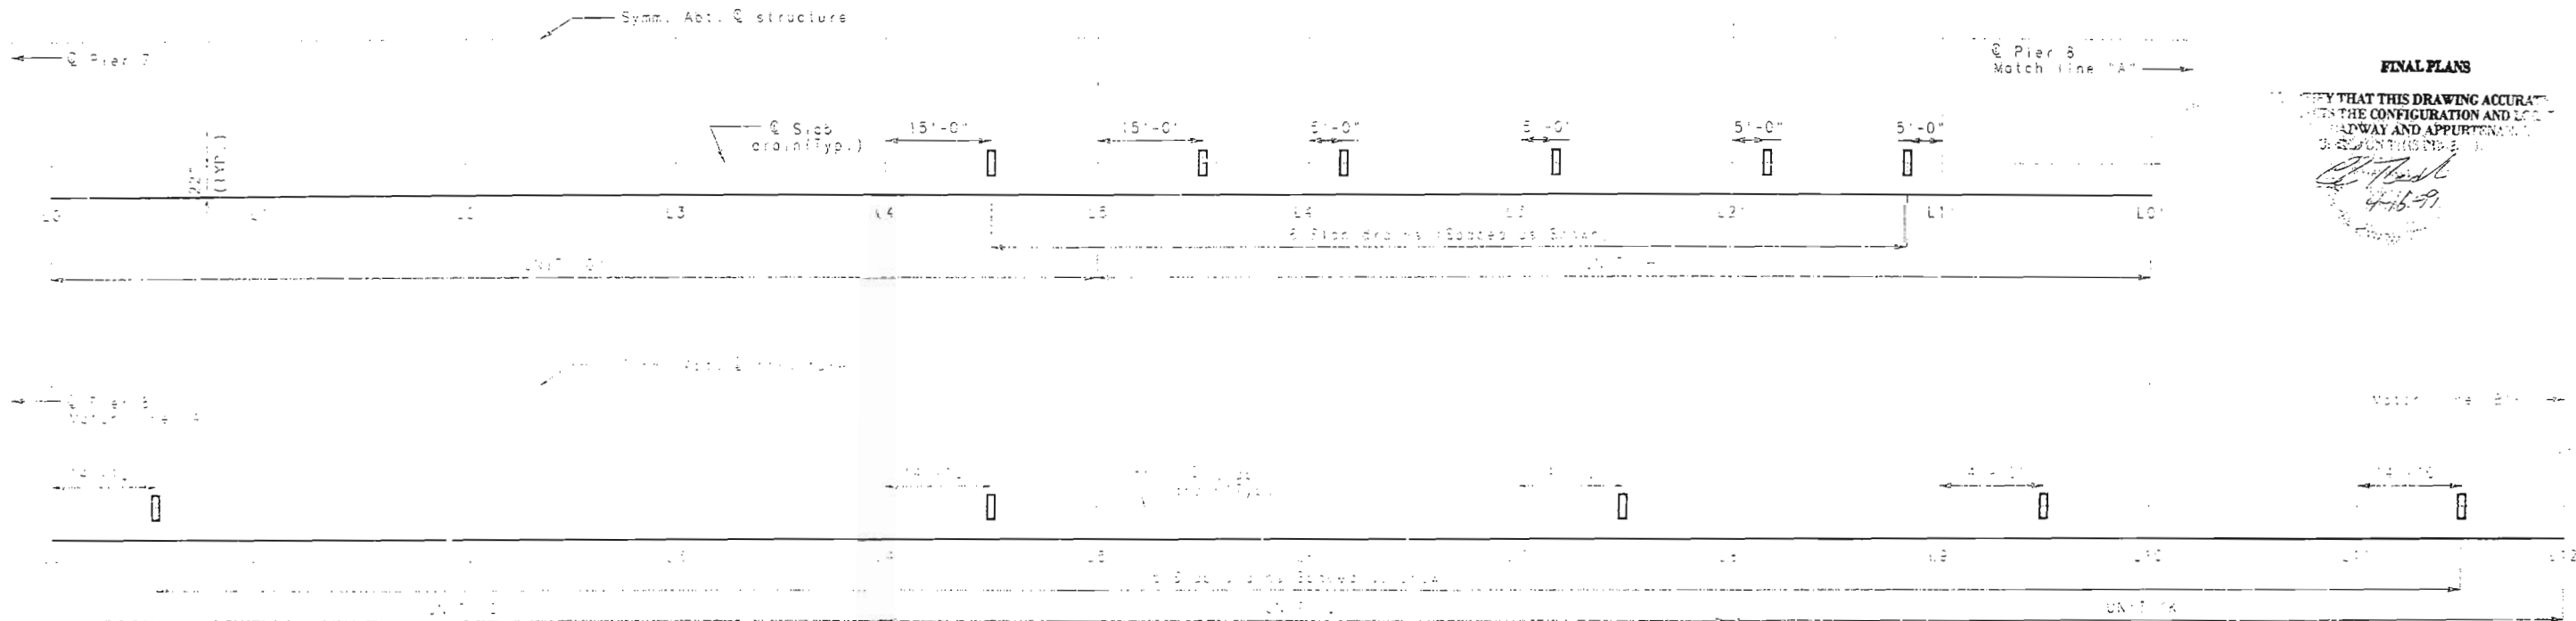

PART PLAN SHOWING SLAB DRAIN LOCATIONS

For match line B alternate detail, see sheet No. 32.  
Refer to slab drain detail on slab sheets.

STATE	PROJ. NO.	SHEET NO.
MO.	ACSTP-ACBRS-3312(415)	45

Slab drains may be fabricated of either 1/4" welded sheets of ASTM A709 Grade 36 structural steel or 1/4" structural steel tubing ASTM A500, Grade B.

Outside dimensions of drains are 8" x 4".

Locate drains in the slab by dimensions shown in the Part Elevation.

Shift reinforcing in field where necessary to clear drains.

The drains and bracket assembly shall be galvanized in accordance with ASTM A123.

All bolts, hardened washers, lock washers and nuts shall be galvanized in accordance with ASTM A153.

The bolt hole for the bracket assembly attachment shall be located on the plate girder shop drawings.

Shop drawings will not be required for slab drains and the bracket assembly.

## FINAL PLANS

VERIFY THAT THIS DRAWING ACCURATELY REPRESENTS THE CONFIGURATION AND LOCATION OF THE ROADWAY AND APPURTENANCES.

*[Signature]*  
4-16-99

## SLAB DRAIN DETAILS & LOCATIONS

PLATTE


COUNTY

A450R1



FINAL PLANS

WHAT THIS DRAWING ACCURATELY  
REPRESENTS THE CONFIGURATION AND  
LOCATION AND APPURTENANCES  
HEREON THIS PROJECT.

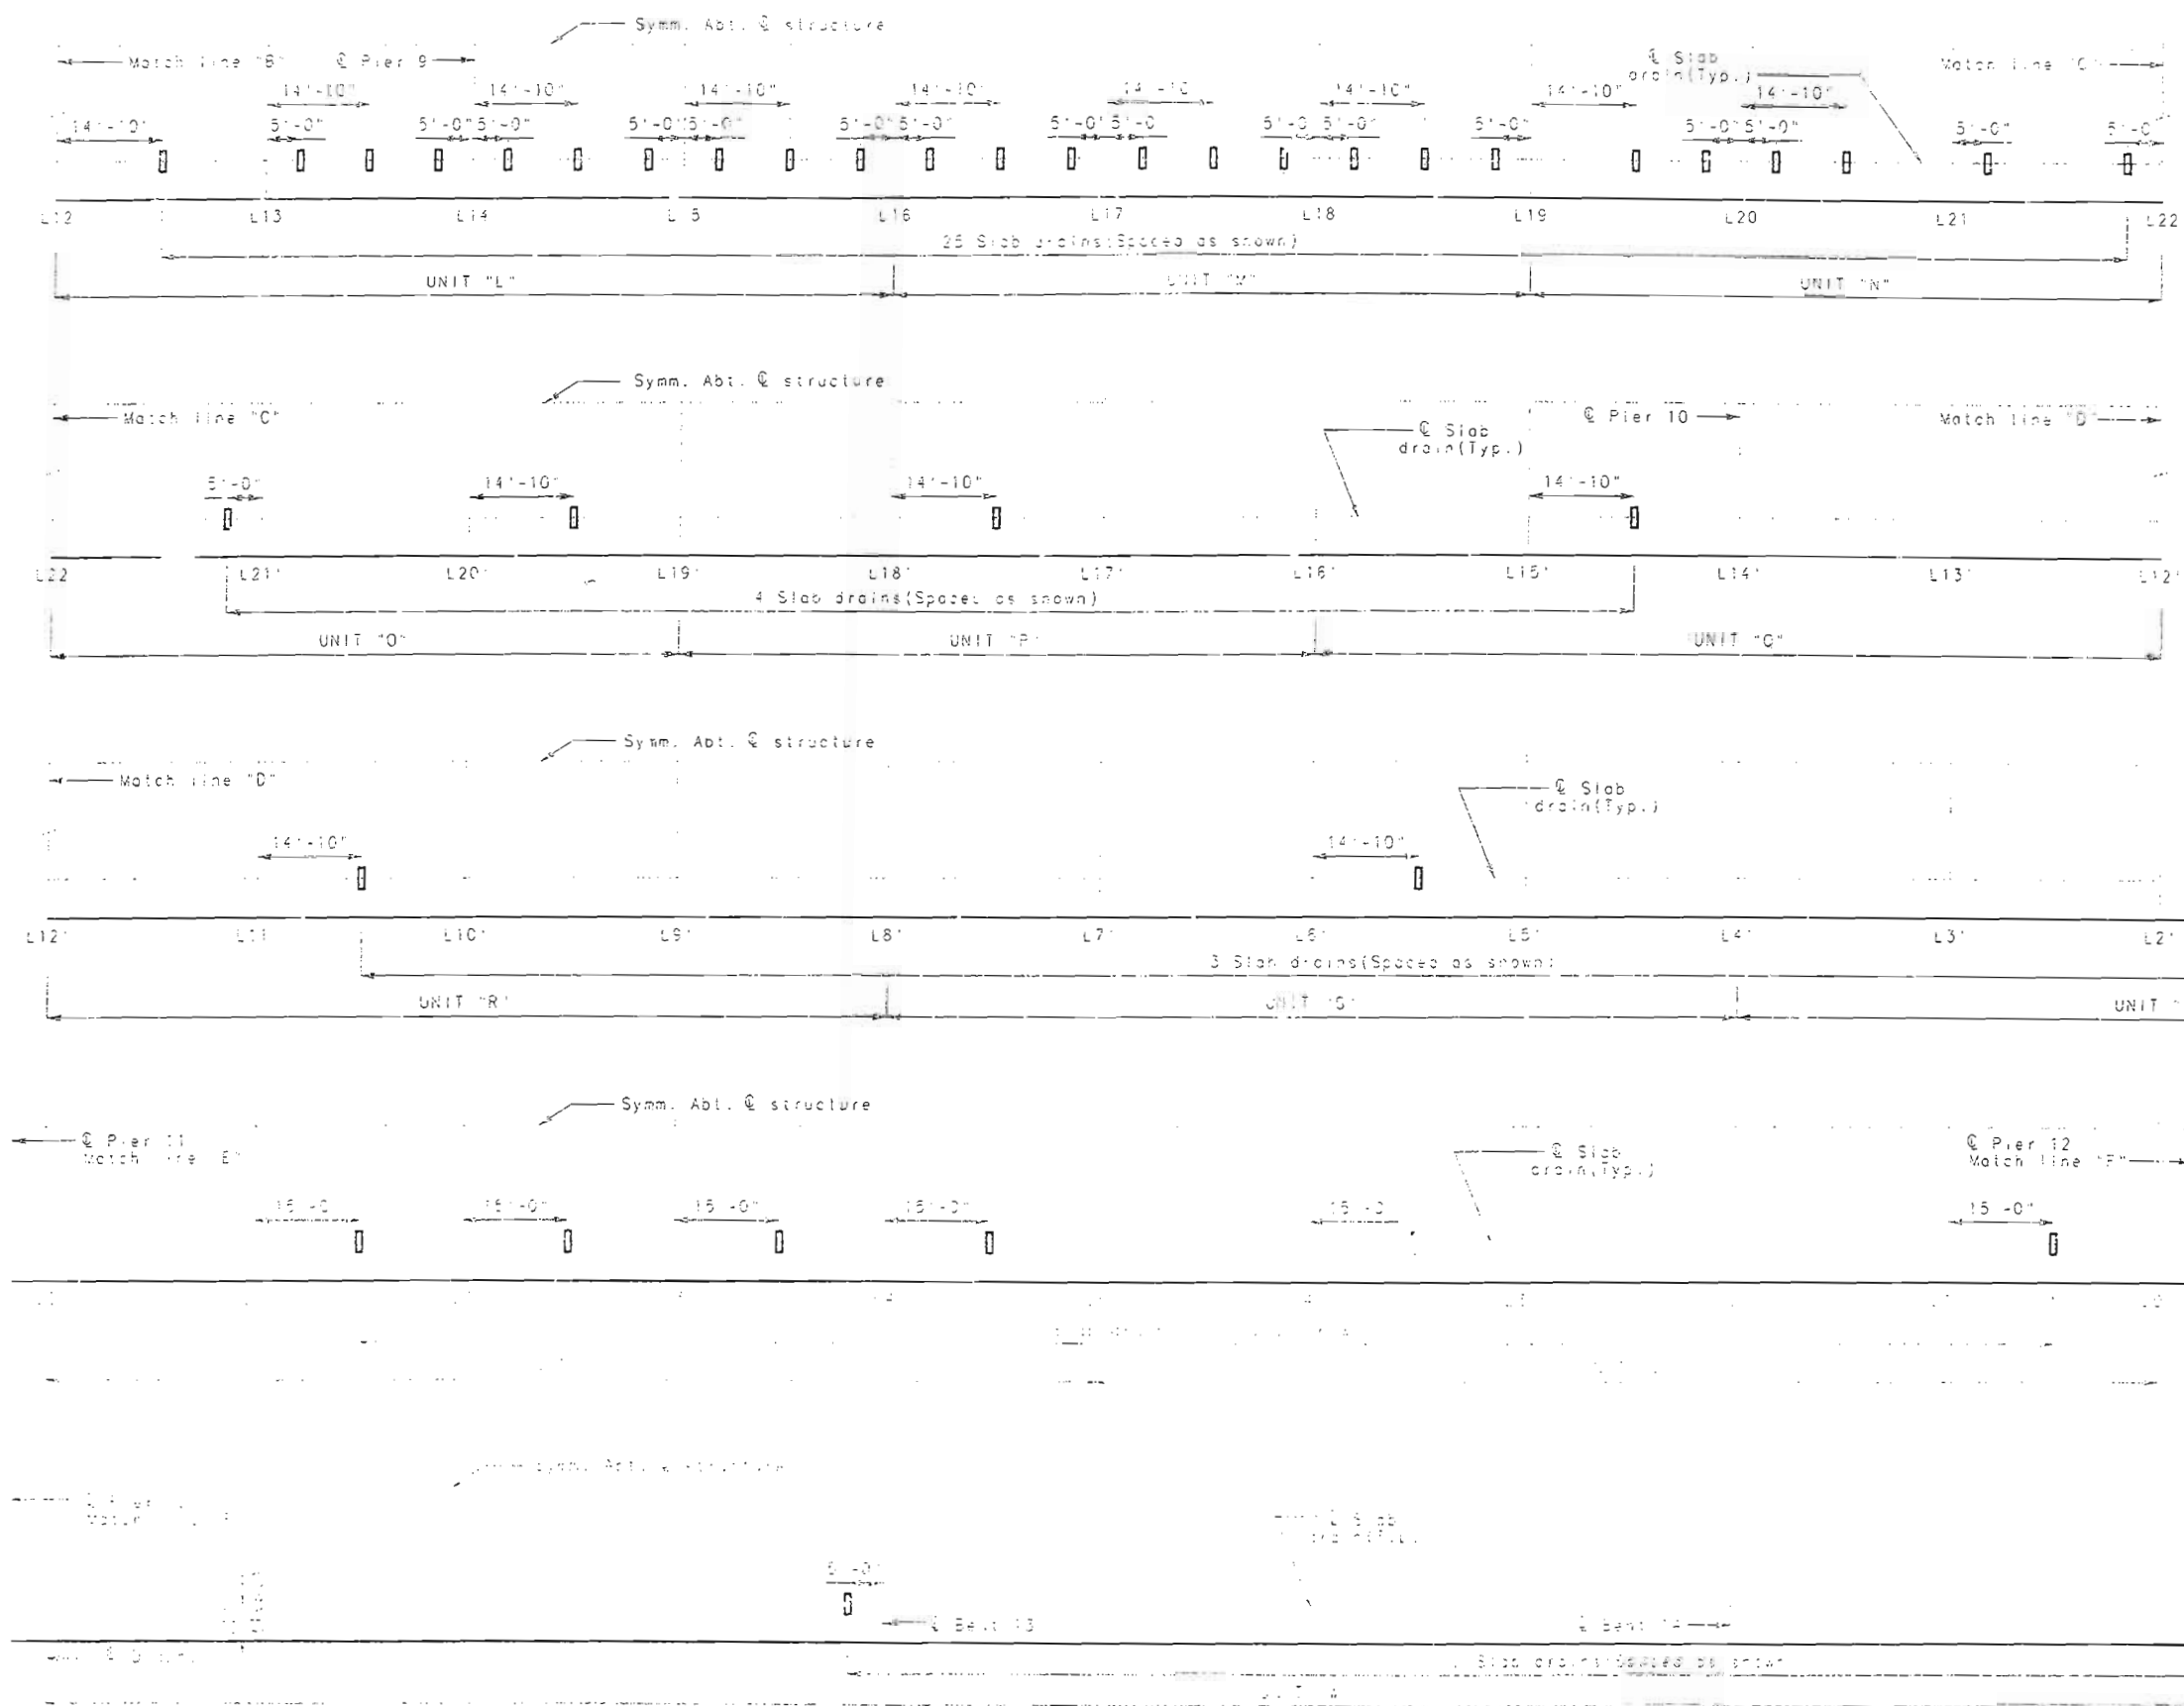

For slab and joint locations  
& match lines, see alternate  
sheet and see sheet No. 45.

PART PLAN SHOWING SLAB DRAIN LOCATIONS

NOTE: THIS DRAWING IS NOT TO SCALE. FOLLOW DIMENSIONS.

SHEET NO. 46 OF 50

PLATTE

COUNTY


A450R1

Steel Guard Rail  
September 1992  
June 1994


DESIGNED: JUNE 1994  
CHECKED: JULY 1994

Note: A movement gauge shall be provided on one side of bridge or abutment safety barrier curb expansion joints and steel shall be galvanized.


Cost of movement gauge complete in place shall be included in contract unit price for safety barrier curb.

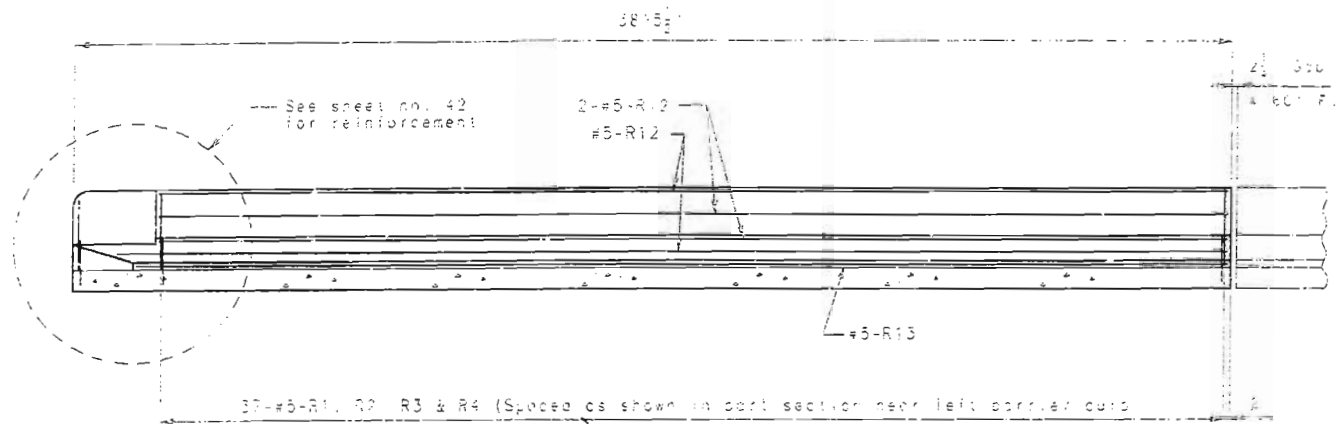

SECTION NEAR LEFT SAFETY BARRIER CURB (UNIT A)

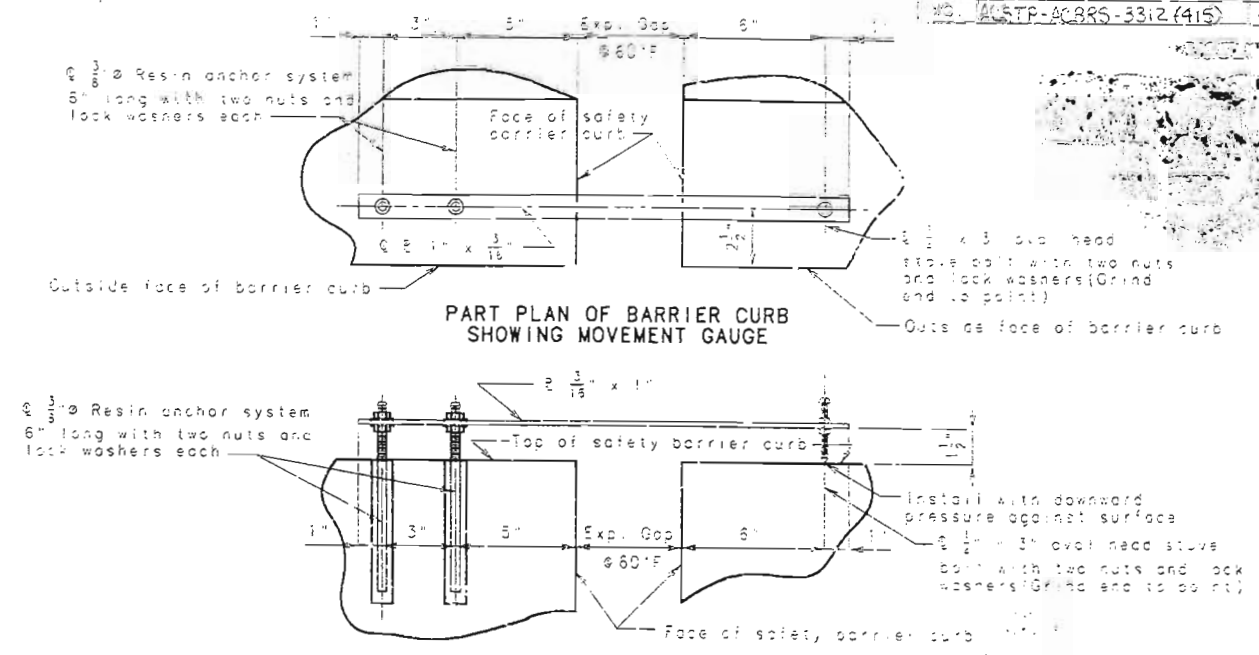

PART ELEVATION OF BARRIER CURB SHOWING MOVEMENT GAUGE

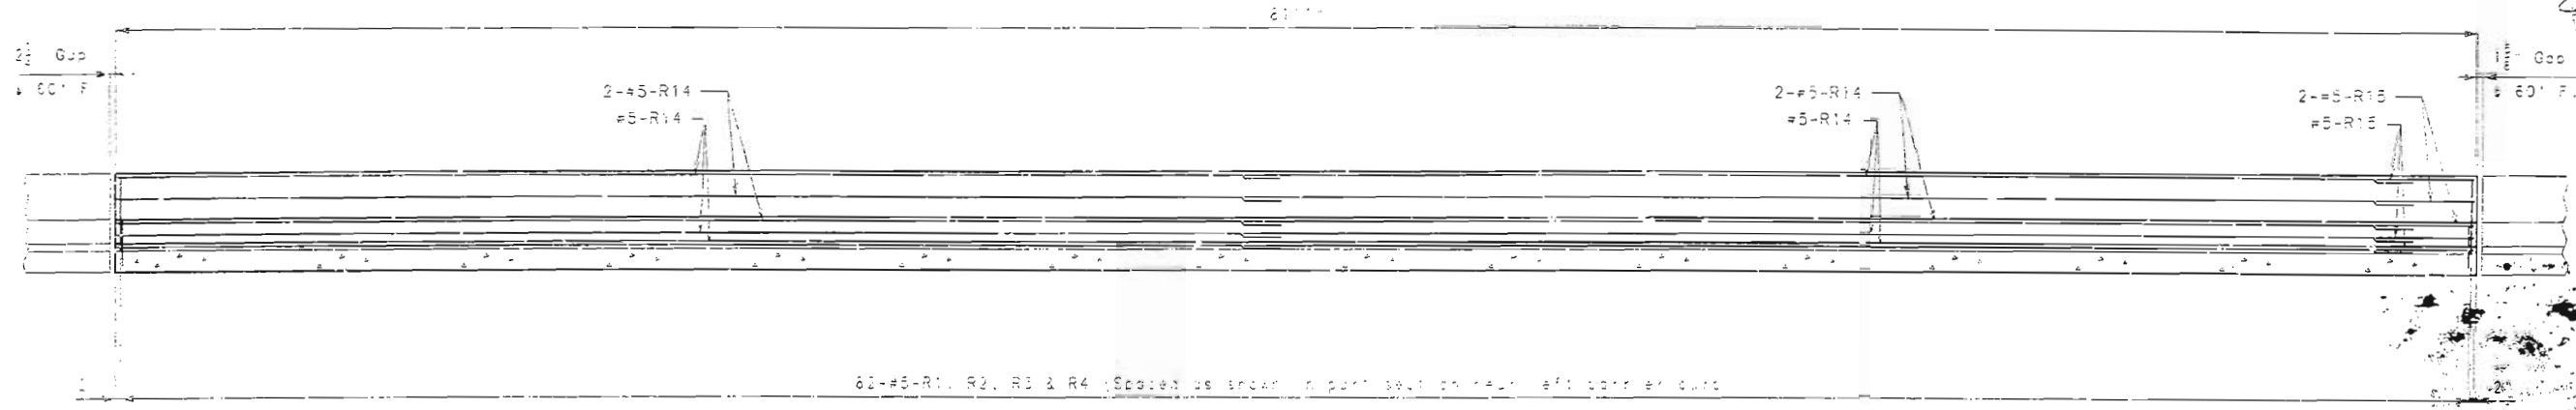

SECTION NEAR LEFT SAFETY BARRIER CURB (UNIT B)


General Notes for Barrier Curb:

- Top of safety barrier curb shall be set to 4' 0" above grade with safety barrier curb to rise 1/2" at each curb face to 4' 1/2" above grade.
- Exposed edges of safety barrier curb shall have a 1/2" x 1/2" x 1/2" chamfer on all 4 sides.
- When the safety barrier curb is placed, the contractor shall place the curb in 1' concrete and the reinforcement, and place the curb.
- Measurement of safety barrier curb is to the nearest 1/8" for each structural member and the curb is to be set from end of work to end of work.
- Longitudinal dimensions are taken from end of construction of curb and are taken along center line.
- Work in this sheet with sheet no. 42.
- See details of concrete & steel in notes on sheet no. 44, 45 and 46.




DETAILS OF PLASTIC WATERSTOP

FILLED JOINT DETAIL

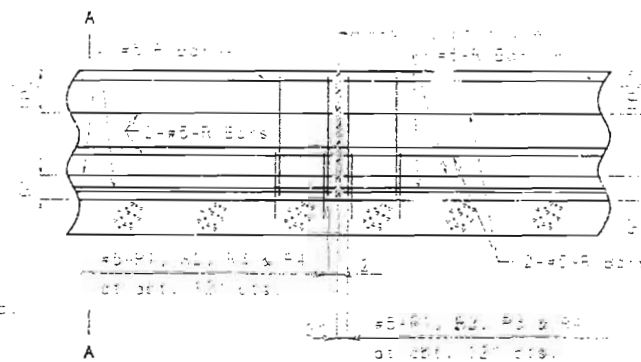

PART SECTION NEAR LEFT SAFETY BARRIER CURB (CAST-IN-PLACE CONVENTIONAL FORMING OPTION)

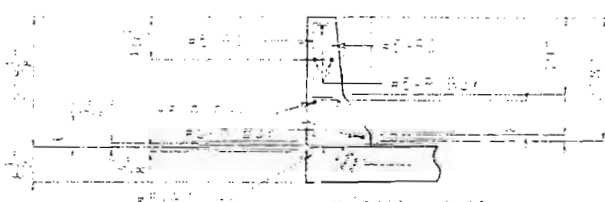

PART SECTION A-A

Note: Use minimum 1/2" x 1/2" x 1/2" chamfer on all 4 sides of safety barrier curb.

367  
MAR. 1995  
AUSTIN-ACBRS-3312(415)








SECTION NEAR LEFT SAFETY BARRIER CURB  
(UNIT F)




A450R1

ARCHIVE: CARR U.E.V.A.T.I.O.N {REVISED:  
JAN. 1990 MAR. 1995


DETAILED JUNE 1996  
CHECKED JUNE 1996

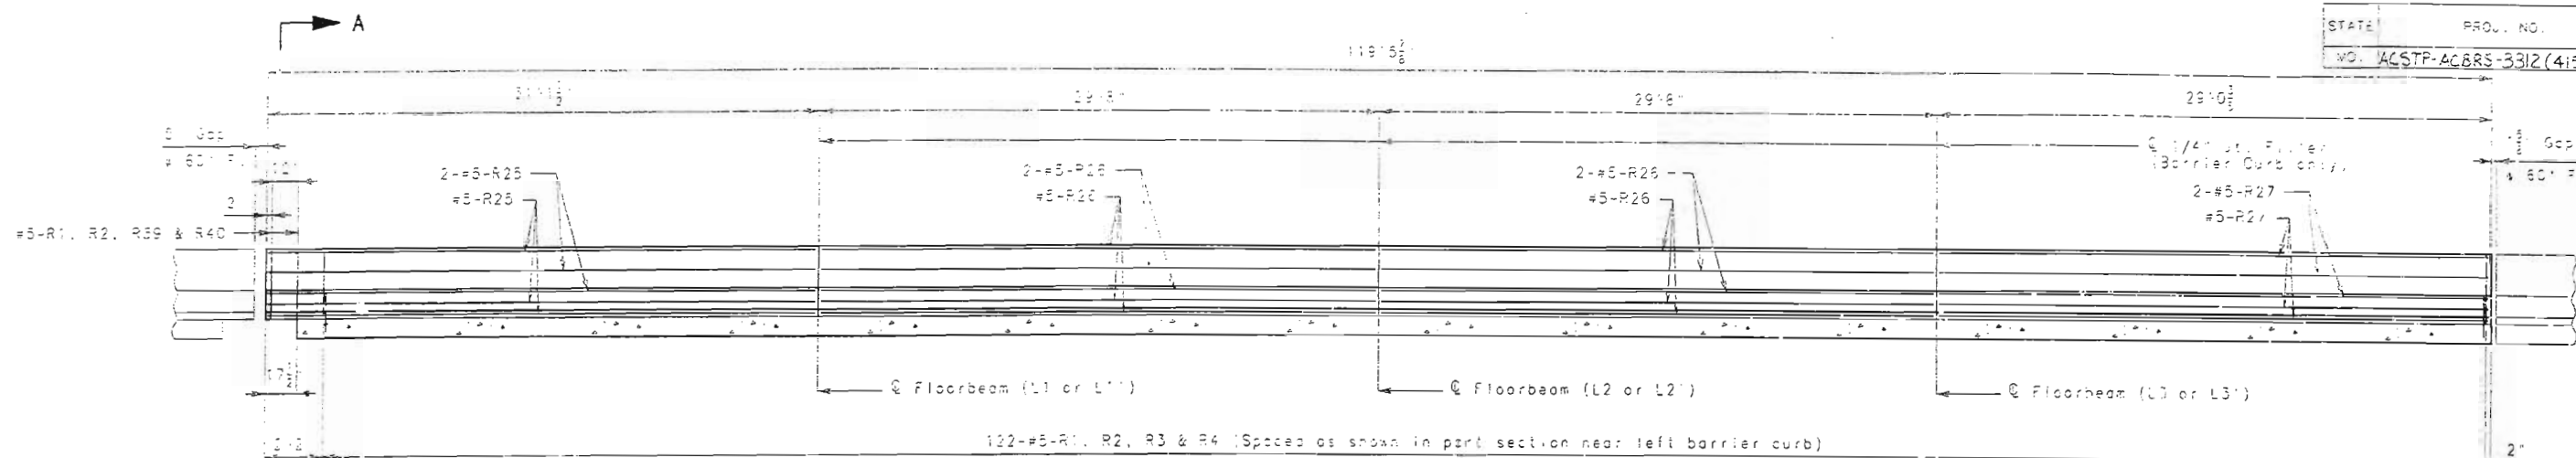

SECTION NEAR LEFT SAFETY BARRIER CURB  
 (UNIT I) (UNIT T)  
 For detail of section A-A, see sheet no. 38.

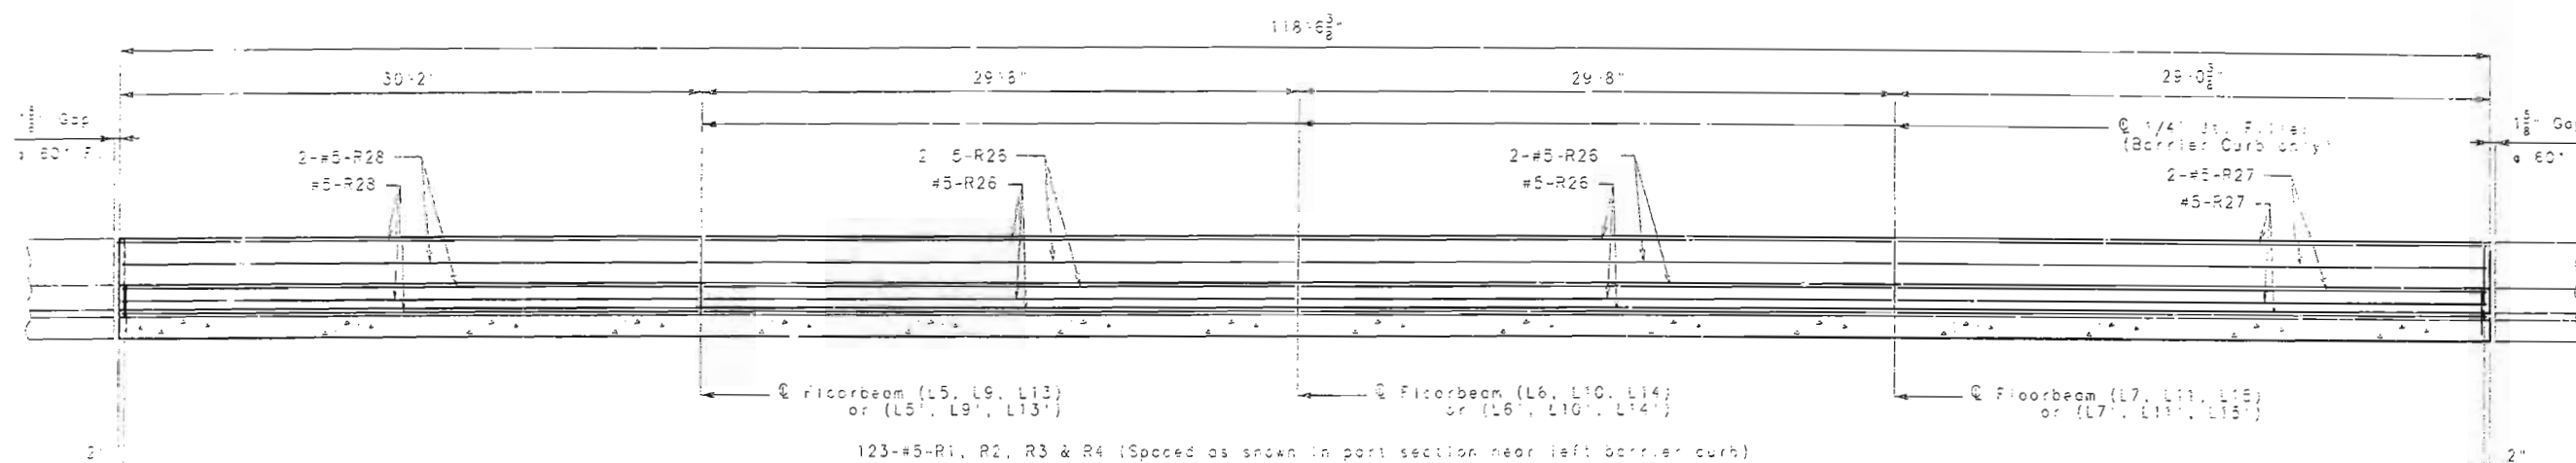

SECTION NEAR LEFT SAFETY BARRIER CURB  
 (UNIT J) (UNIT S)  
 (UNIT K) (UNIT R)  
 (UNIT L) (UNIT Q)

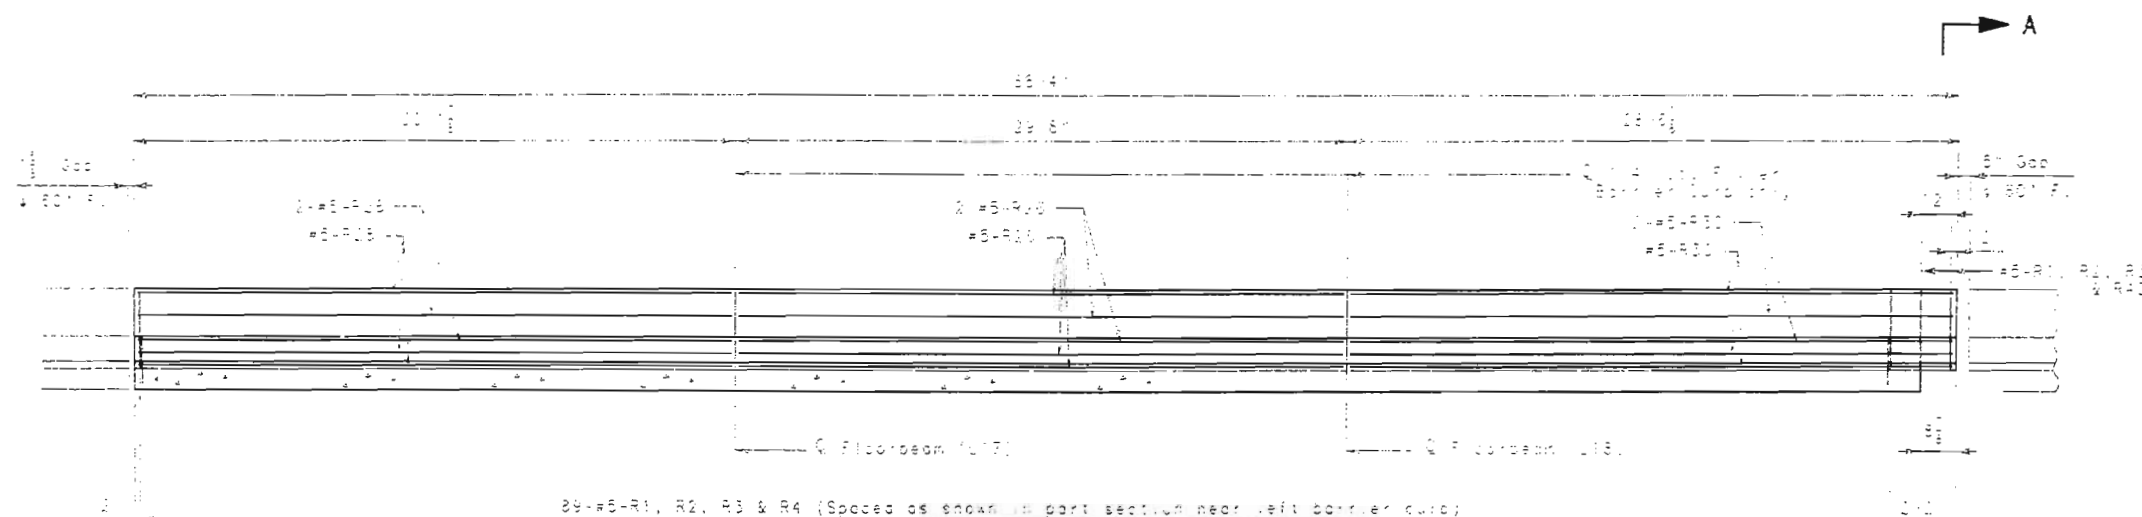


SECTION NEAR LEFT SAFETY BARRIER CURB  
 (UNIT M)  
 For detail of section A-A, see sheet no. 38.

WHAT THIS DRAWING  
 THE CONFIGURATION AND  
 THE CONSTRUCTION AND  
 THE APPURTENANCES  
 OF THIS PROJECT.




370

REVISIONS  
 DATE  
 BY  
 DESCRIPTION  
 1. MAR. 1995  
 2. MAR. 1995  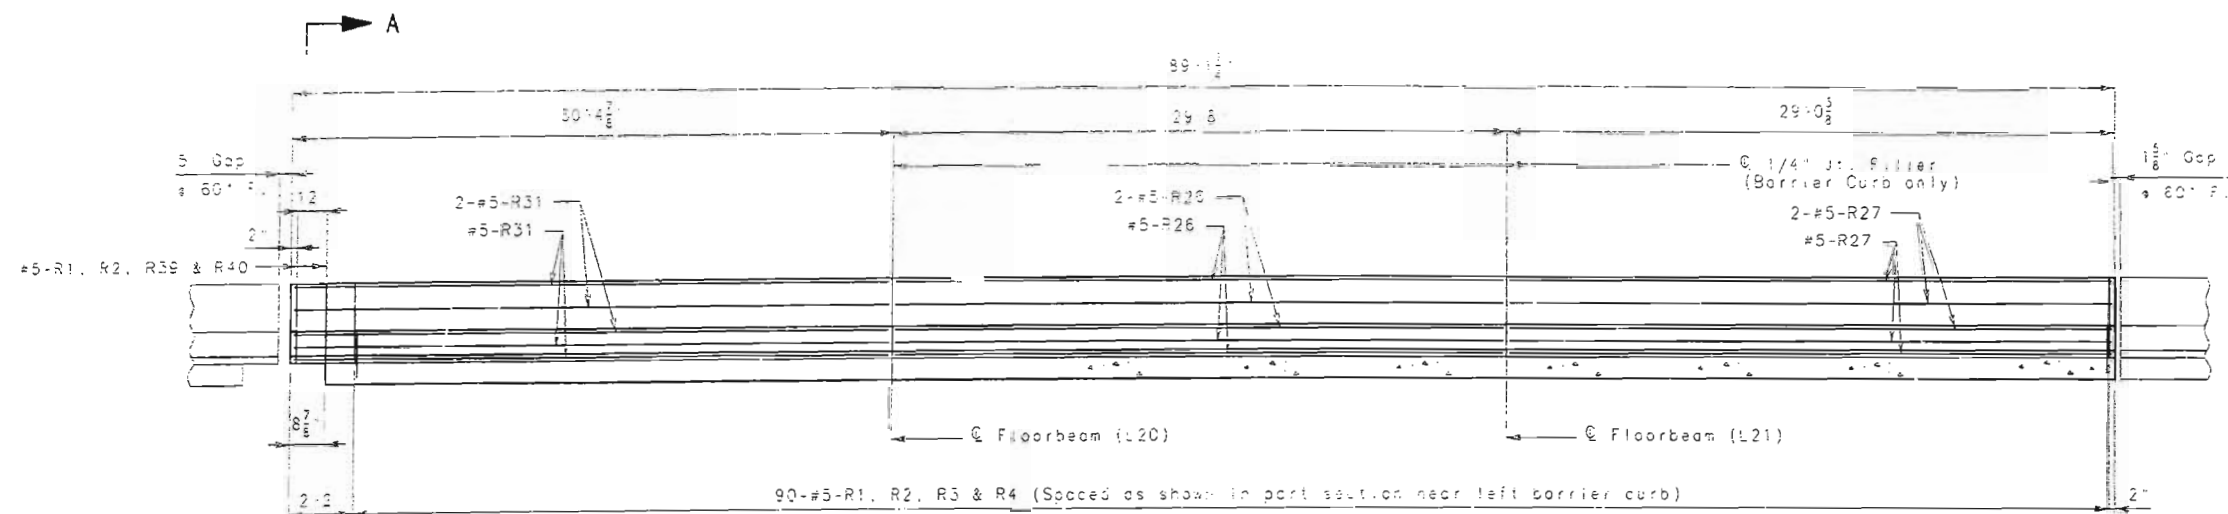
SECTION NEAR LEFT SAFETY BARRIER CURB  
(UNIT N)

For detail of section A-A, see sheet no. 38.

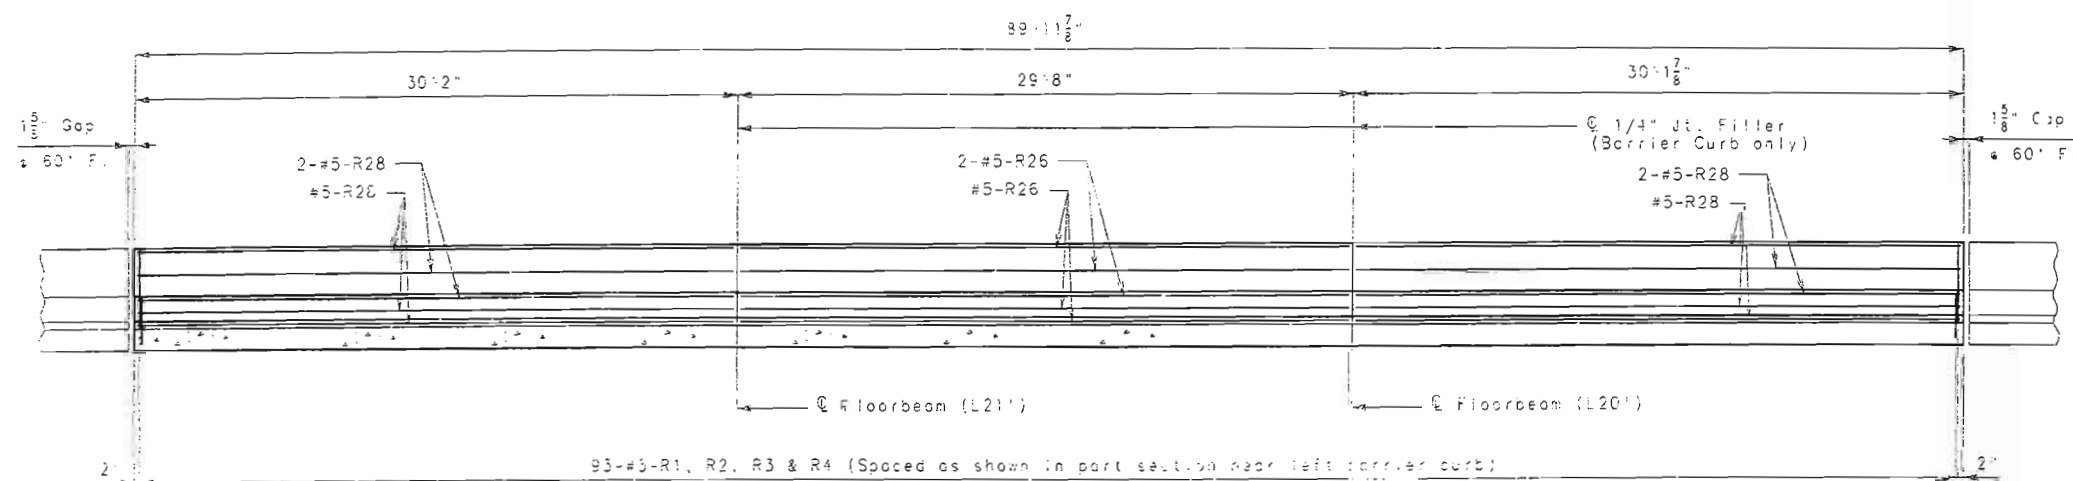

SECTION NEAR LEFT SAFETY BARRIER CURB  
(UNIT 0)

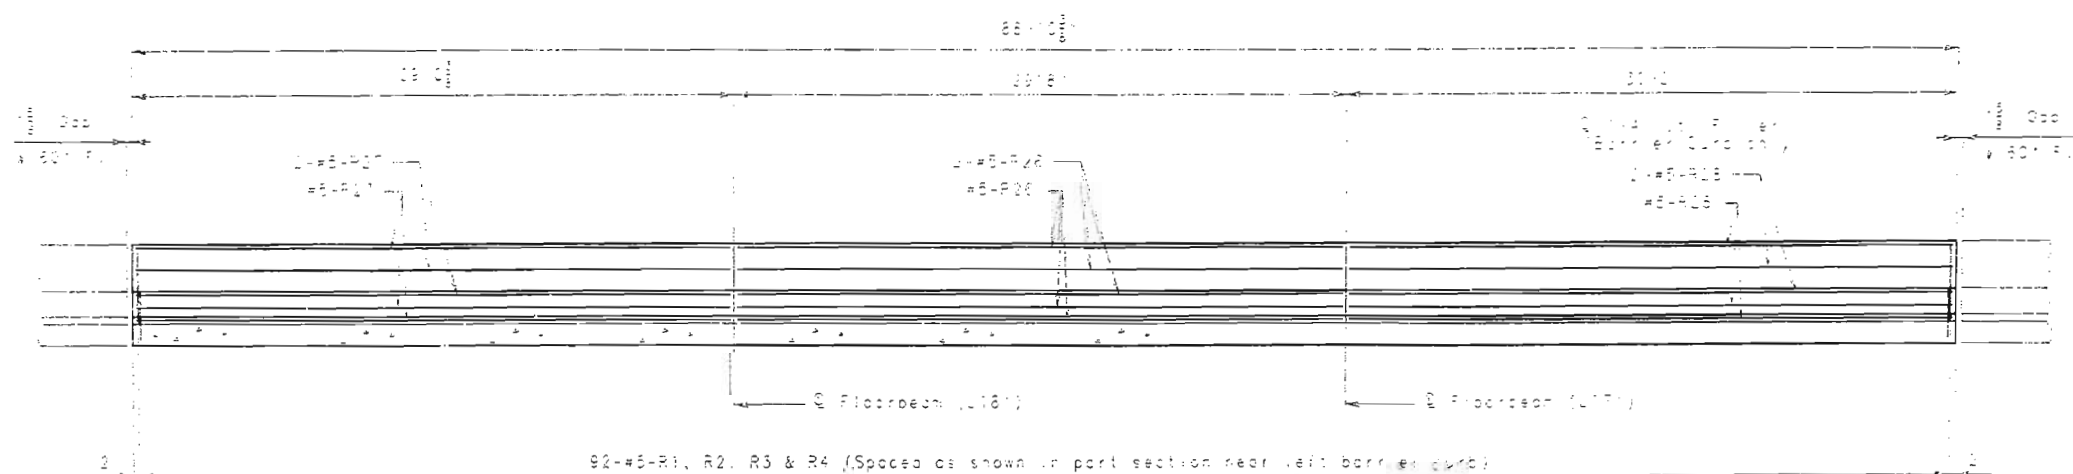

SECTION NEAR LEFT SAFETY BARRIER CURB  
(UNIT P)


FINAL PLANS

~~I CERTIFY THAT THIS DRAWING~~ ACCURATELY  
REFLECTS THE CONFIGURATION AND LOCATION  
OF THE ROADWAY AND APPURTENANCES AS  
CONSTRUCTED ON THIS PROJECT.

SIGNATURE

4 699




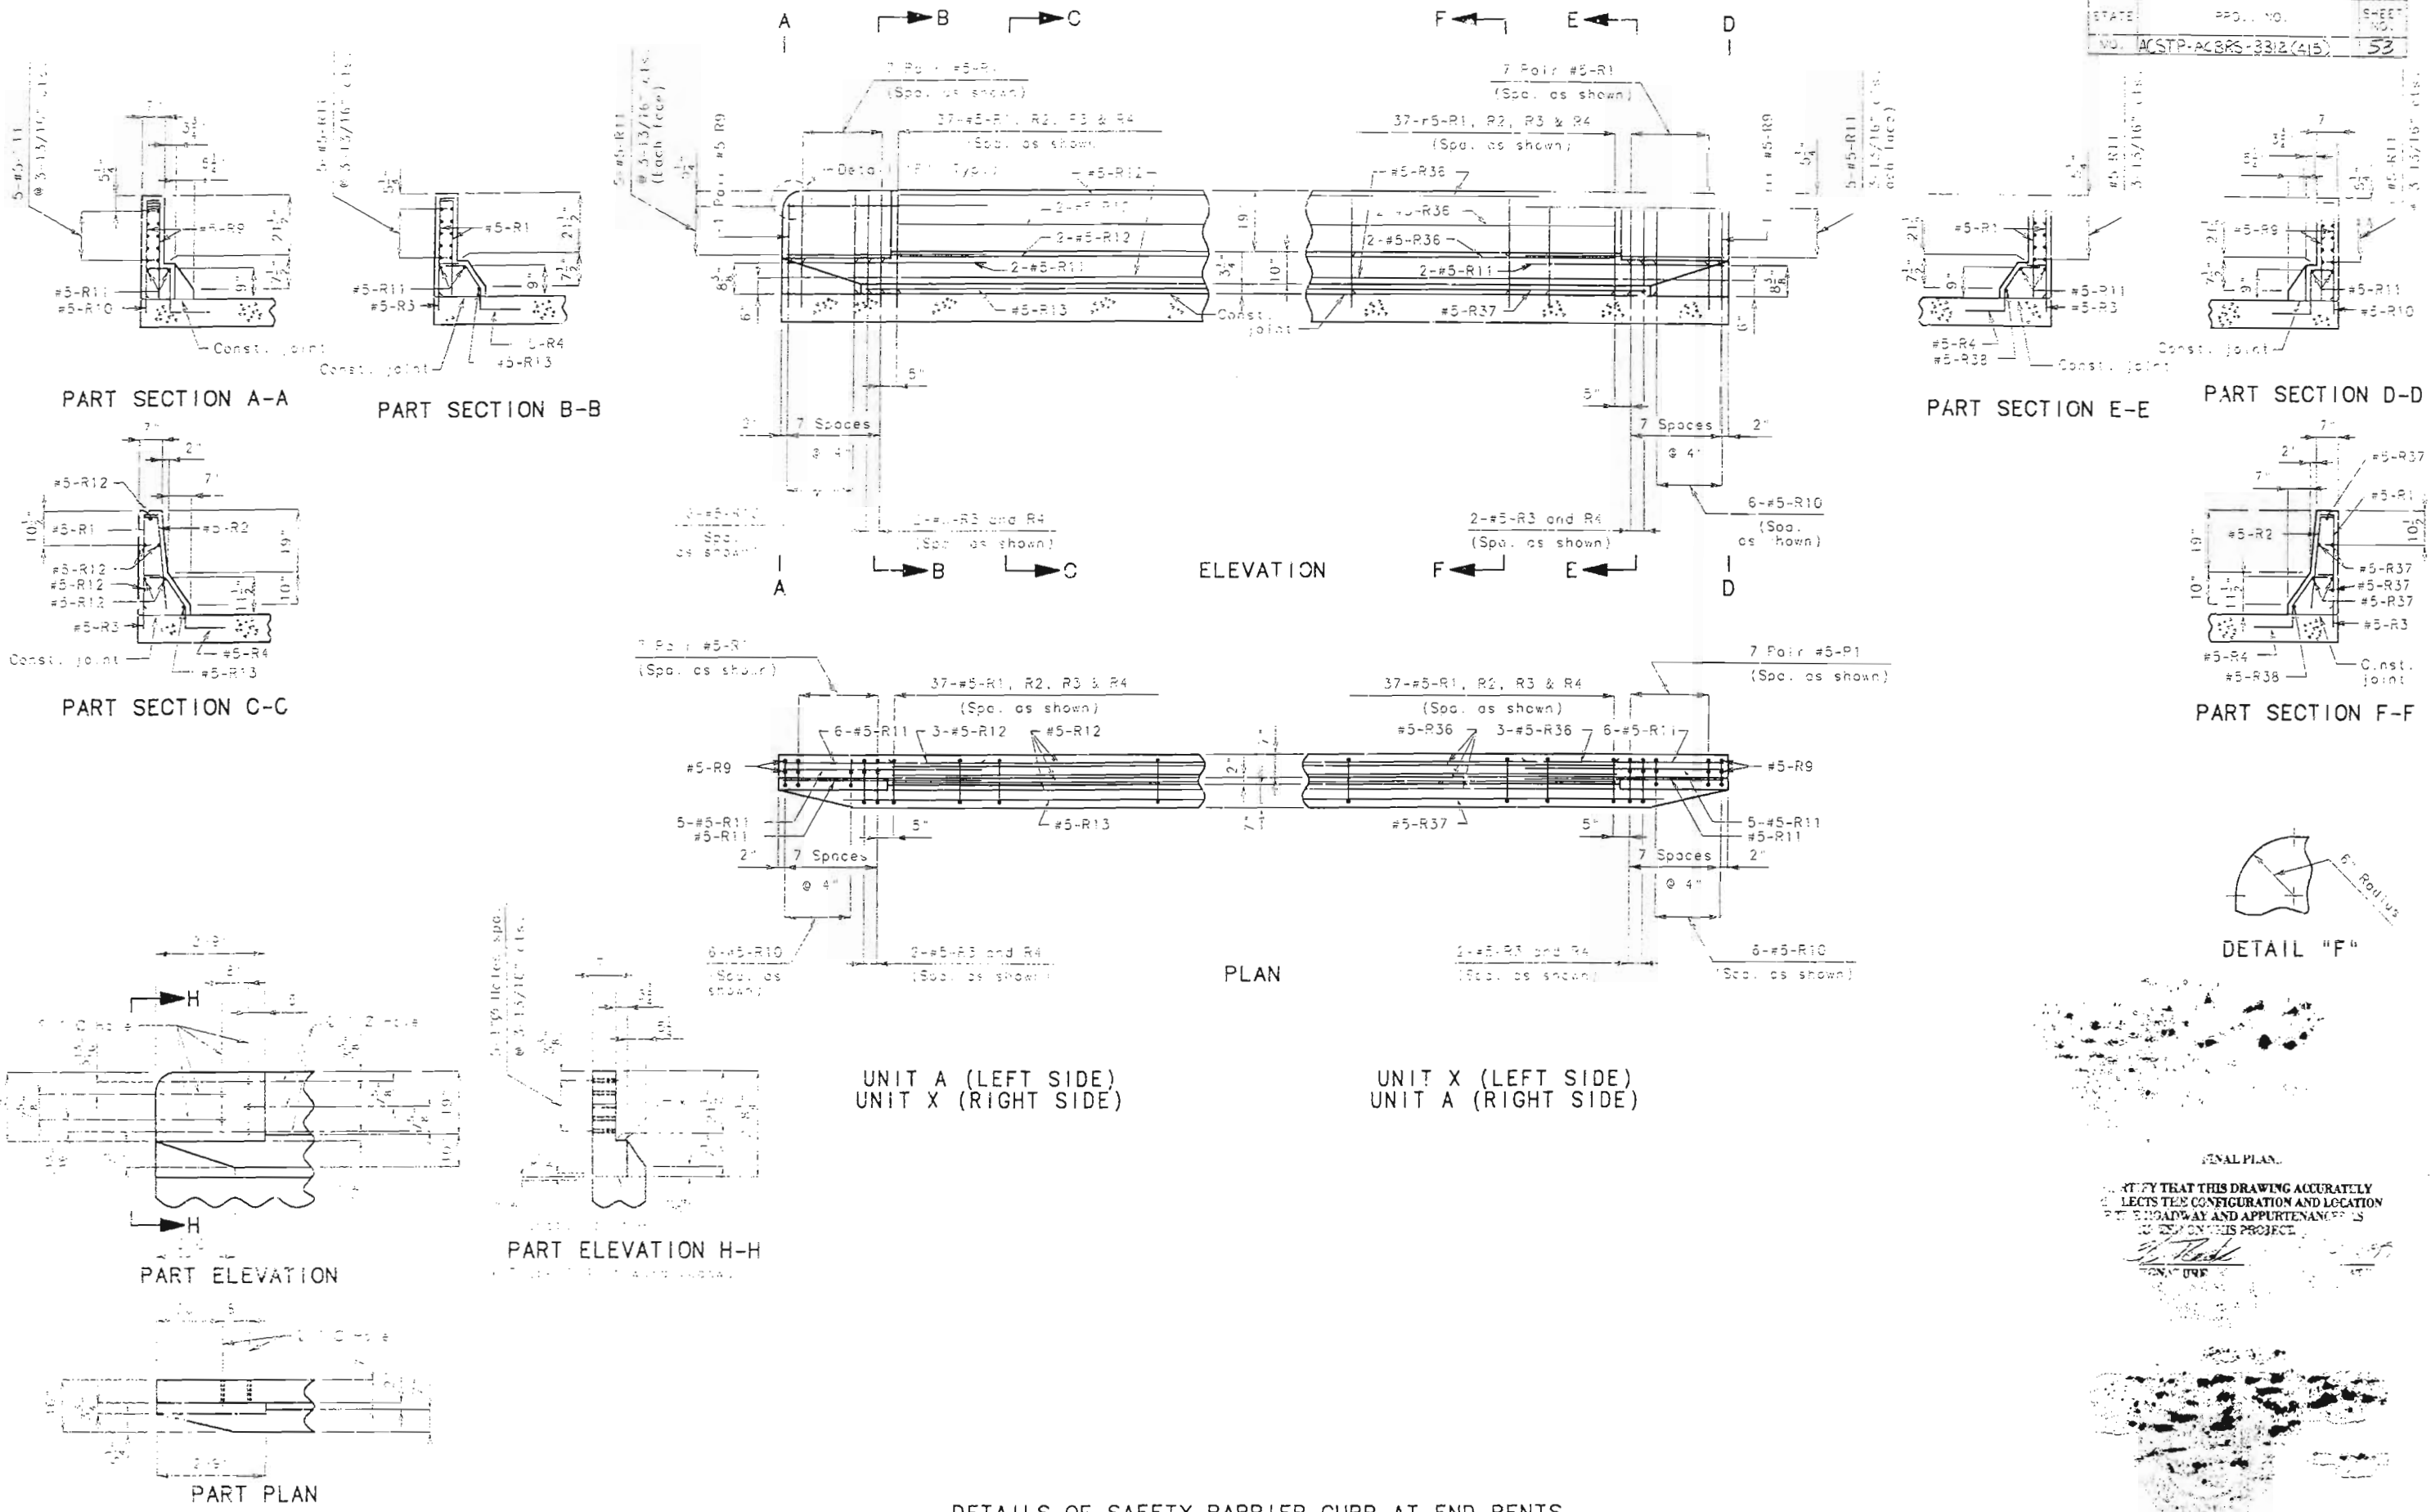


FINAL PLAN.  
I CERTIFY THAT THIS DRAWING ACCURATELY  
REPRESENTS THE CONFIGURATION AND LOCATION  
OF THE ROADWAY AND APPURTENANCES AS  
CONSTRUCTED ON THIS PROJECT.  
*[Signature]*  
ENGINEER

REVISED: SEPT. 1995  
BY: [illegible]




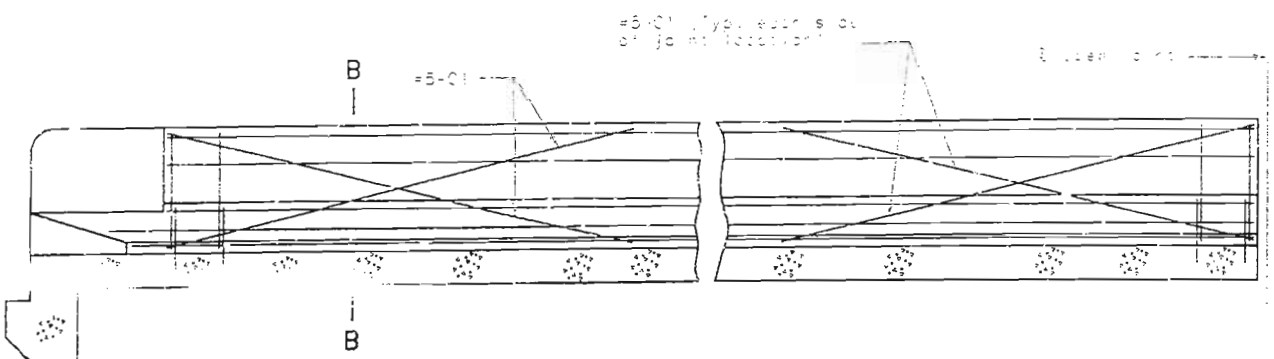


TYPICAL SECTION NEAR LEFT SAFETY BARRIER CURB AT SUPPORT LOCATIONS  
(OPTIONAL SLIP-FORM BRIDGE SAFETY BARRIER CURB)  
(UNIT A) (UNIT X SIMILAR BY 180° ROTATION)

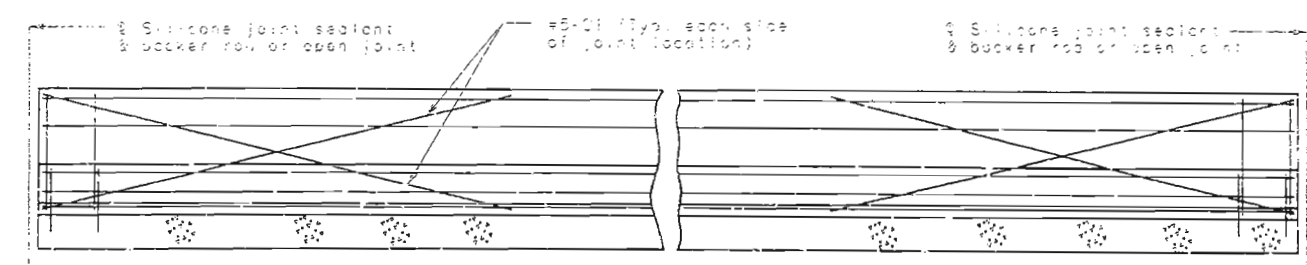


TYPICAL SECTION NEAR LEFT SAFETY BARRIER CURB AT SUPPORT LOCATIONS  
(OPTIONAL SLIP-FORM BRIDGE SAFETY BARRIER CURB)  
(UNIT B THRU UNIT V)

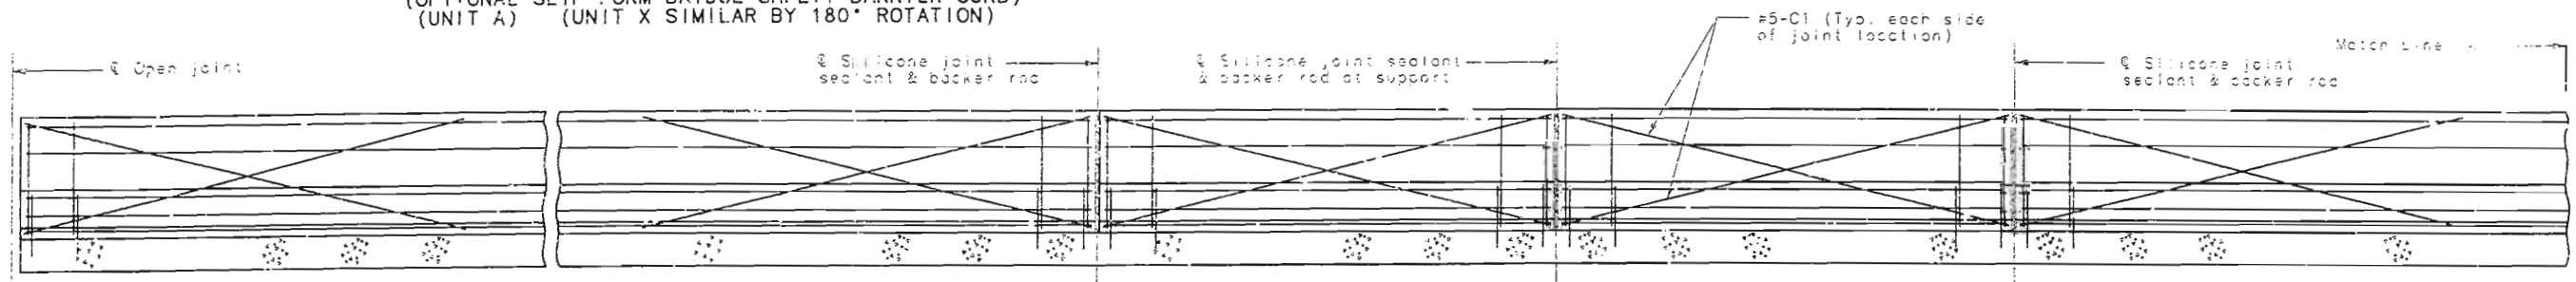


TYPICAL SECTION NEAR LEFT SAFETY BARRIER CURB AT SUPPORT LOCATIONS  
(OPTIONAL SLIP-FORM BRIDGE SAFETY BARRIER CURB)  
(UNIT W)

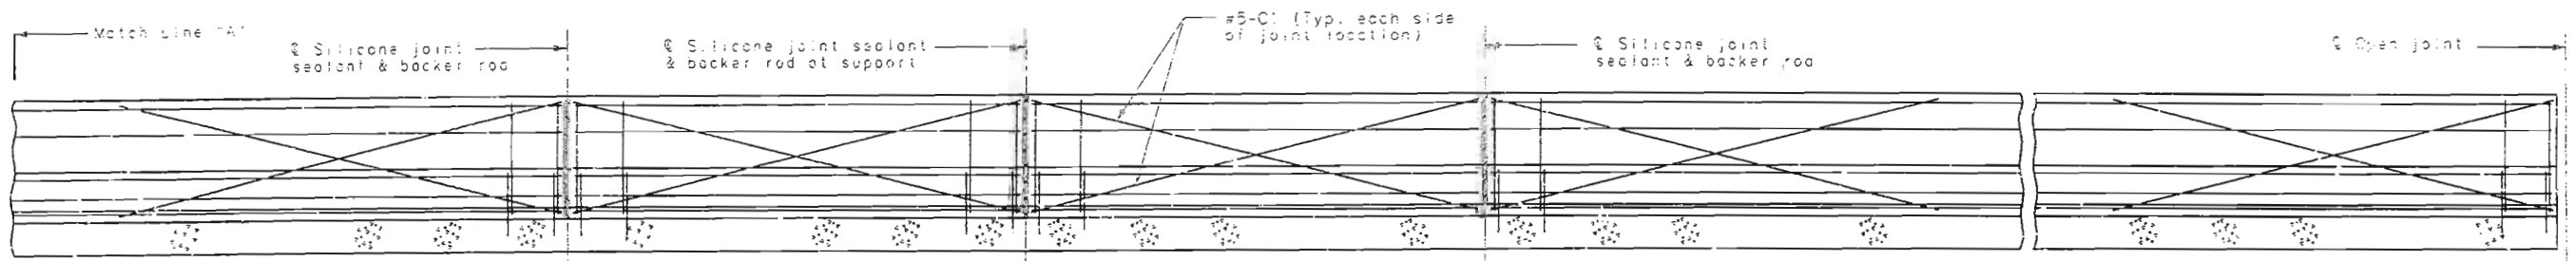


TYPICAL SECTION NEAR LEFT SAFETY BARRIER CURB AT SUPPORT LOCATIONS  
(OPTIONAL SLIP-FORM BRIDGE SAFETY BARRIER CURB)  
(UNIT W)

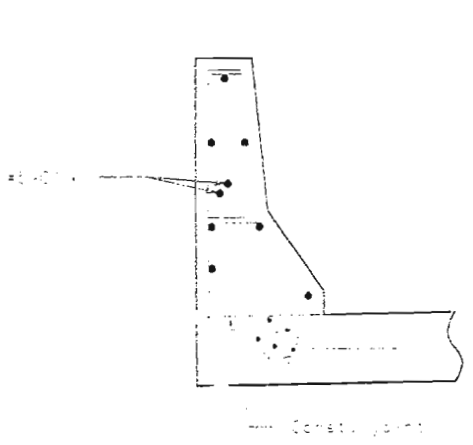

PART SECTION B-B

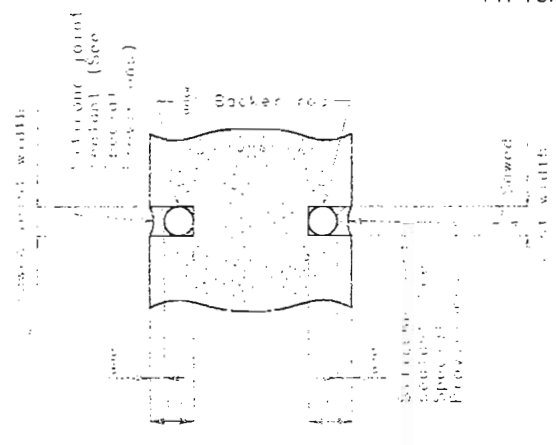

SECTION A-A

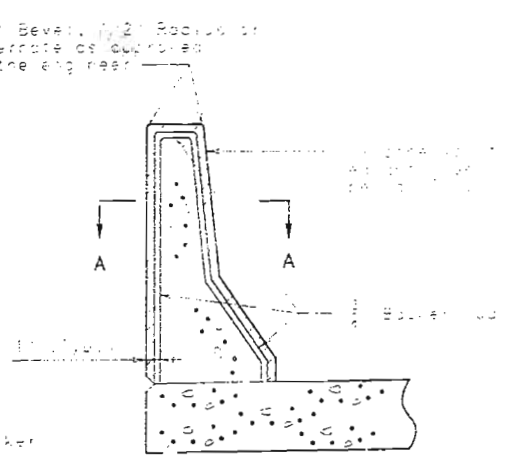

SECTION THRU JOINT

Note: Cost of silicone joint sealant and backer rod complete in place to be included on the contract unit price for safety barrier curb.

Note:

1. Top of safety barrier curb and curb base to be placed with safety barrier curb in place and extend at least 2'-0" into bridge deck.
2. Area under safety barrier curb and curb base to be placed with concrete and extend at least 2'-0" into bridge deck.
3. Measurement of safety barrier curb and curb base to be taken from face of curb to face of curb and not from face of curb to face of curb.
4. Joint sealant and backer rods shall be used on all slip-form bridge safety barrier curbs installed on bridge.
5. Plastic waterstop shall not be used on slip-form bridge safety barrier curbs.
6. C Bars (Slip-form option only) shall be used in addition to cast-in-place conventional forming reinforcement for bridge safety barrier curb.

RECAL PLAN  
THIS DRAWING ACCURATELY  
REPRESENTS THE CONFIGURATION AND LOCATION  
OF THE ROADWAY AND APPURTENANCES  
AS SHOWN ON THIS PROJECT.


OPTIONAL SLIP-FORM BRIDGE SAFETY BARRIER CURB

374

DATE: 09/01/95  
DRAWN BY: J. M. W.  
CHECKED BY: J. M. W.  
SEPT. 1995

KANSAS

MISSOURI

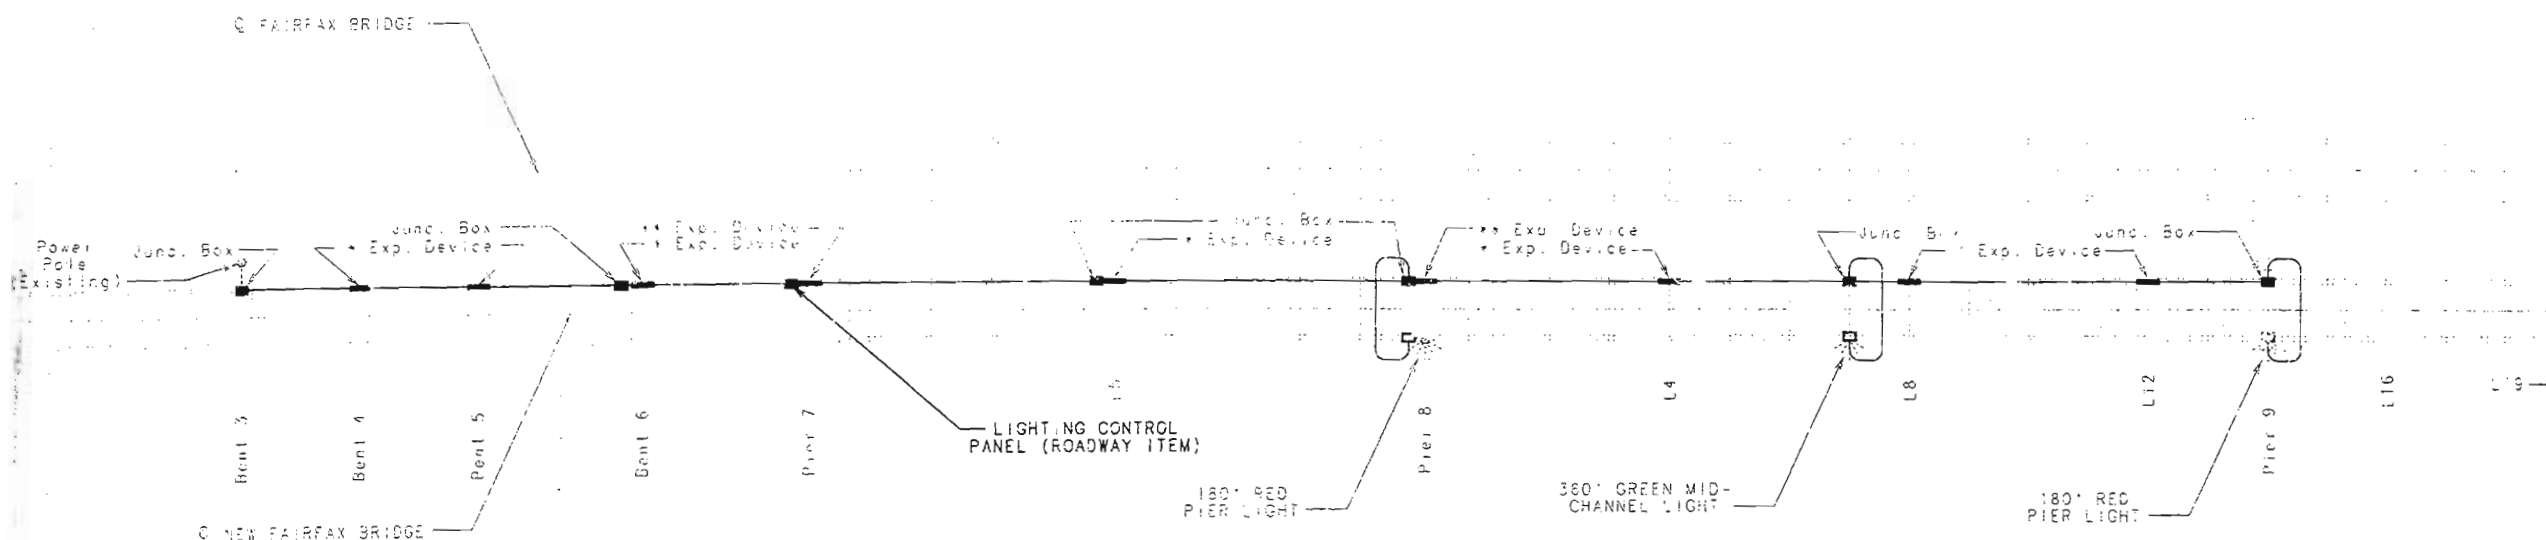

NOTES:

Navigation lighting system shall include light fixtures, lamps, reflective markers, and all incidentals required to complete the work.

The lighting control cabinet and wiring shall be paid for as a roadway item.

Concrete anchors shall be resin anchors and installed according to the manufacturer's specifications. The hole shall be pre-drilled with a conventional carbide masonry bit.

All bolts, nuts and washers shall be galvanized.

Any field drilled holes required for attachment of above items shall be considered as part of the navigation lighting system.

Each section of conduit shall bear the Underwriters Laboratories, Inc. (UL) label. (Sec. 1060)

The location and direction of conduit may be shifted to meet field conditions as directed by the engineer.

Navigation lighting shall meet the requirements of the U.S. COAST GUARD.

All navigation light fixtures shall be Type III, Model 140 with TR-360 lens, 100,000 candlepower, manufactured by MODULAR SIGNAL CORPORATION, 13701 RED OAK ROAD, HOUSTON, TEXAS.

Existing navigation lighting and cable vent in operation during construction. After installing the new system, the existing system and cable vent shall be removed and disposed of as directed by the engineer and shall be included in the application for navigation lighting system completion.


\* Denotes expansion coupling with 2" W.M. movement capability.

\*\* Denotes expansion coupling with 6" W.M. movement capability.


20' approximately one foot of wire in each junction box.

PLAN SHOWING CONDUIT & NAVIGATIONAL LIGHTING


REMARKS  
THAT THIS DRAWING ACCURATELY  
SHOWS THE CONFIGURATION AND LOCATION  
OF ROADWAY AND APPURTENANCES AS  
REQUIRED ON THIS PROJECT

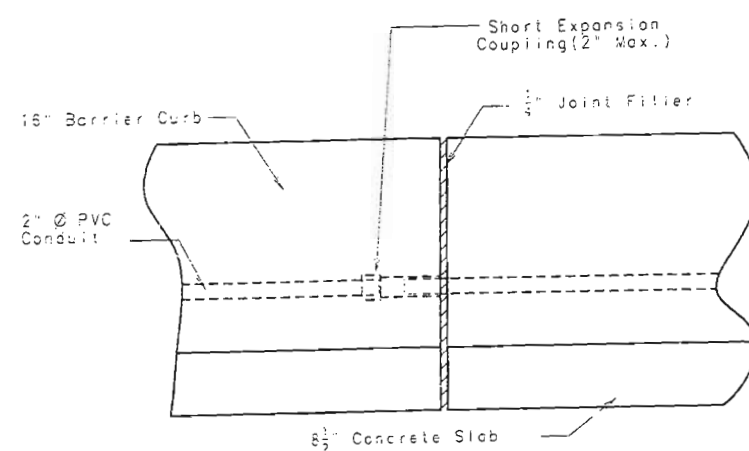

PART  
ELEVATION OF 16" BARRIER  
CURB SHOWING SHORT EXPANSION  
COUPLING • FILLED JOINTS.

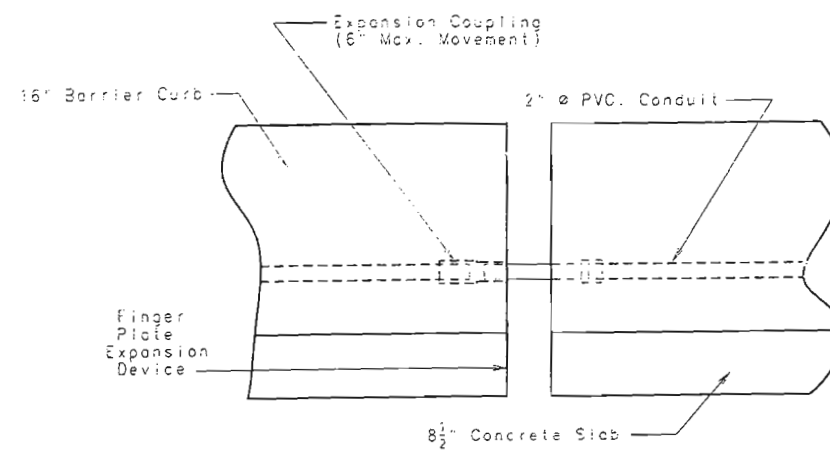

PART  
ELEVATION OF BARRIER CURB  
SHOWING EXPANSION COUPLING  
(Typ. • Piers 7 & 8 of  
Continuous Truss Span).

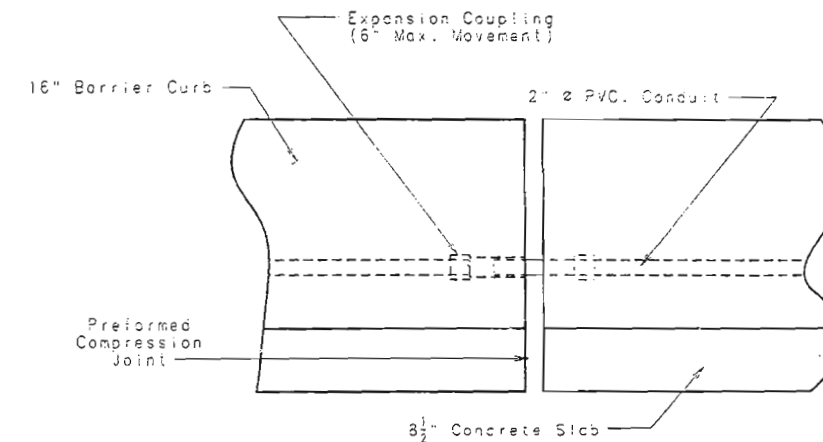



PART  
ELEVATION OF BARRIER CURB SHOWING  
EXPANSION COUPLING (TYP. • Bents 4  
5, 6 & L4, L8, L12 OF CONTINUOUS TRUSS  
SPAN & L5 OF SIMPLE TRUSS SPAN (7-8)).

For locations of expansion couplings, see sheet No. 44.  
For notes on expansion couplings, see sheet No. 45.

## DETAILS OF CONDUIT SYSTEM COUPLINGS


THIS DRAWING IS A PART OF THE  
CONFIGURATION AND LOCATION OF  
ROADWAY AND APPURTENANCES  
SELECTED ON THIS PROJECT.

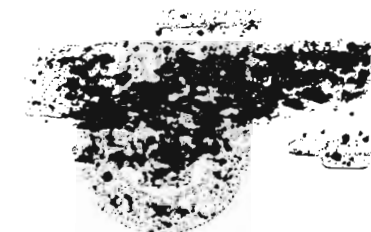

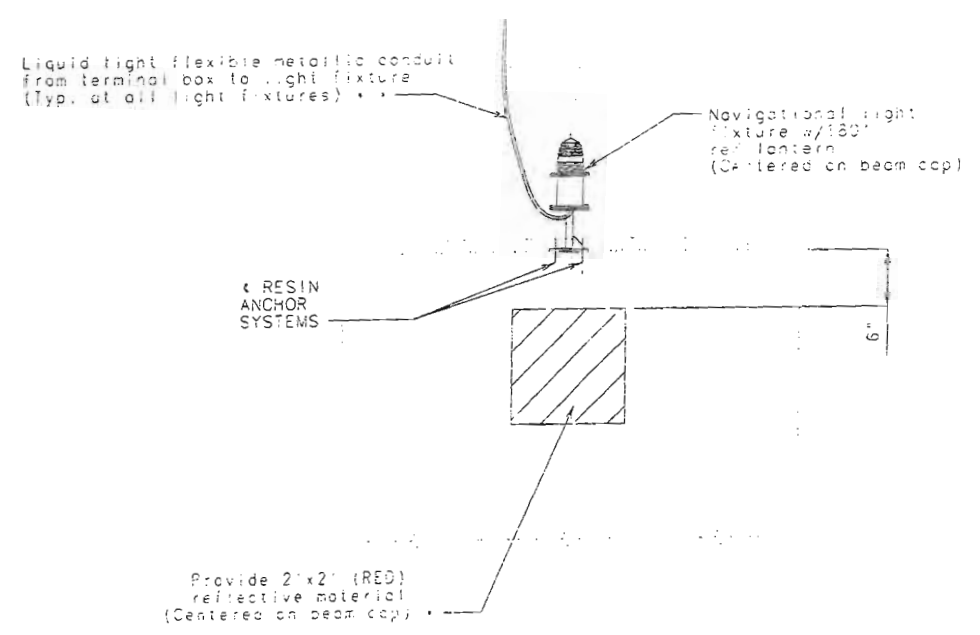


NAVIGATIONAL LIGHTING  
 AT TOP OF PIER 9

NOTE: Galvanized studs used for the resin anchor systems shall be the same size and number as recommended by the manufacturer and approved by the engineer.

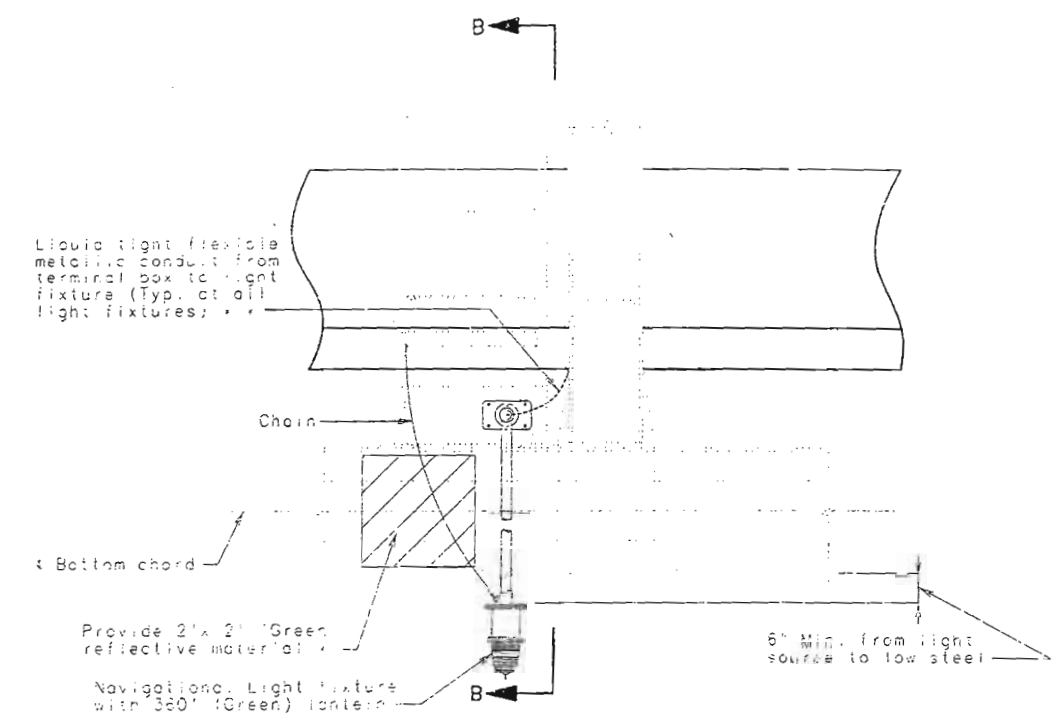


NAVIGATION LIGHT DETAIL AT  
 MID-CHANNEL (SPAN 8-9)

Drawn for L7 pipe support bracket not shown.

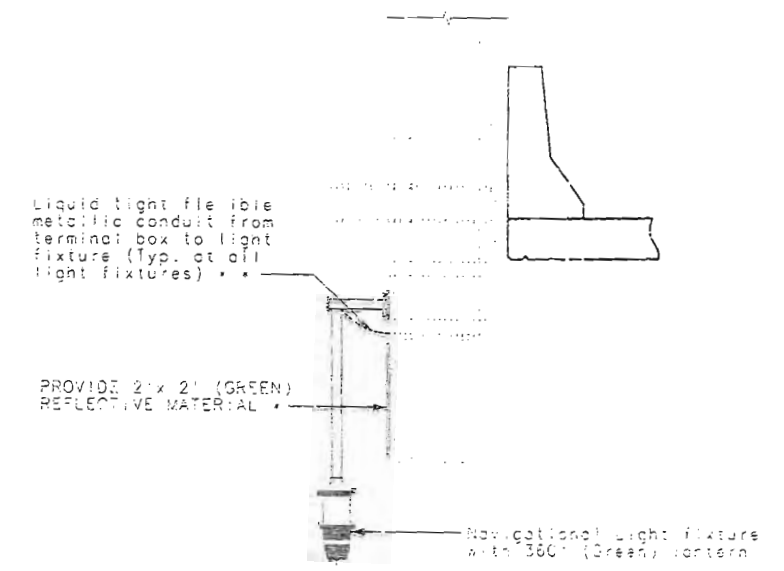

SECTION B-B

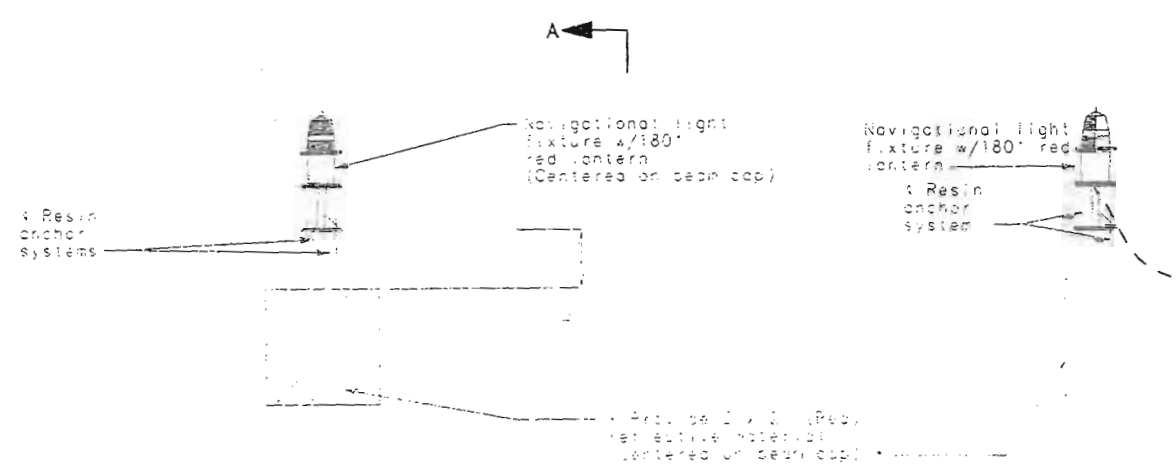

SECTION A-A


NAVIGATIONAL LIGHTING  
 AT TOP OF PIER 8

NOTE:

- Type 2 reflective sheeting on on a minimum flat steel in accordance with sec. 1042. For mounting use 3/8" stainless steel studs, washers and nuts with resin anchor systems. See Special provisions, space about flat plate away from existing concrete or steel with 3/8" stainless steel spacer.
- Width of beam cap of flexible conduit as approved by the engineer.
- For more detail and information refer to ASTM A140, TYPE 316.
- For details on mounting on a plate and mounting details, see galvanized steel size and number as recommended by the manufacturer and approved by the engineer.

NAVIGATION LIGHTING DETAILS

CONFIGURATION  
 WAY AND APPURTENANCE  
 ON THIS PROJECT.

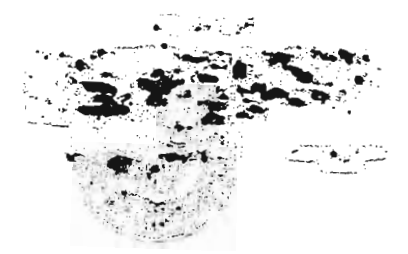

**GENERAL NOTES:**

All concrete for the bridge approach slab and sleeper slab shall be in accordance with Section 503 (f.c. = 4,000 psi).

All joint filler shall meet the requirements of Section 507.2.5, except as noted.

The reinforcing steel in the bridge approach slab and the sleeper slab shall be epoxy coated. Grade 60 with  $F_y = 60,000$  psi.

Minimum clearance to reinforcing steel shall be 1-1/2", unless otherwise shown.

The reinforcing steel in the bridge approach slab and the sleeper slab shall be continuous. The transverse reinforcing steel may be made continuous by lap splicing the #4 & #6 bars 27" and 40" respectively.

Mechanical bar splices will be permitted and shall develop at least 125 percent of the specified yield strength of the reinforcing bars being spliced. The contractor shall furnish the Engineer the manufacturer's certification that this requirement is met and is required to follow the manufacturer's recommendation for installation.

Mechanical bar splices shall be epoxy coated in accordance with Mo. Std. Spec. 710.

See Missouri Standard Plans for details of Reinforced Concrete Structures, Stirrups and Dimensions.

Place Class A underdrain at face of sleeper slab under bridge approach slab and slope to lowest grade of ground line, also missing the bottom of the sleeper slab by 1-1/2".

The contractor shall pour and satisfactorily finish the bridge slab before pouring the bridge approach slabs.

Longitudinal construction joints in approach slab and sleeper slab shall be aligned with longitudinal construction joints in bridge slab.

Payment for furnishing all material, labor and excavation necessary to construct the approach slab, including the timber header, sleeper slab, underdrain, and base and all other appurtenances and incidental work as shown on this sheet, complete in place, shall be considered as completely covered under the contract unit price for "Bridge Approach Slab (Bridge)" per sq. yd.

At the contractor's option, Grade 40 reinforcement may be substituted for the Grade 60 #5 dowel bars connecting the bridge approach slab to the bridge abutment. No additional payment will be made for this substitution.


See Missouri Standard Plans Drawing 504.00 for details of Concrete Approach Pavement.

Underdrains shall be placed under bridge approach slab. See Missouri Standard Plans Drawing 605.10 for details of Class A Underdrain.


See Missouri Standard Plans Drawing 609.00 or 606.00 for details of Type A Barrier Curb.

When a lap splice is required for the use of a mechanical bar splice, the minimum lap length shall be 40" for transverse approach slab bar splices.

When Grade 40 reinforcement is substituted for the Grade 60 #5 dowel bars connecting the bridge approach slab to the bridge abutment, the reinforcement shall be bent up to 90 degrees with 12" lap splices. The lap splices shall be located at least 12" from the bottom of the slab and shall be required according to Mo. Std. Spec. 710.3.2.

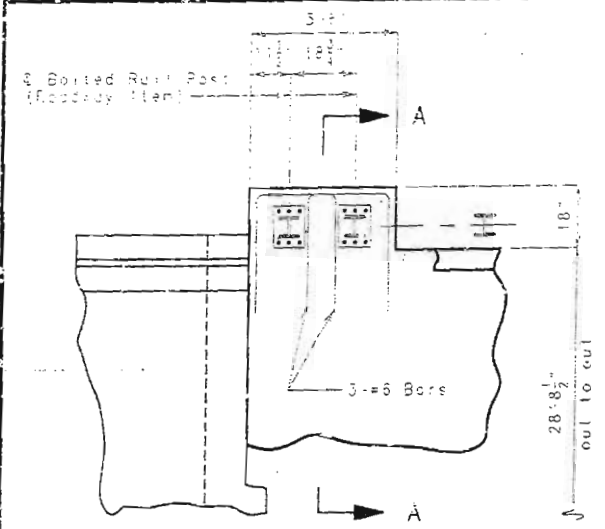


DETAIL A

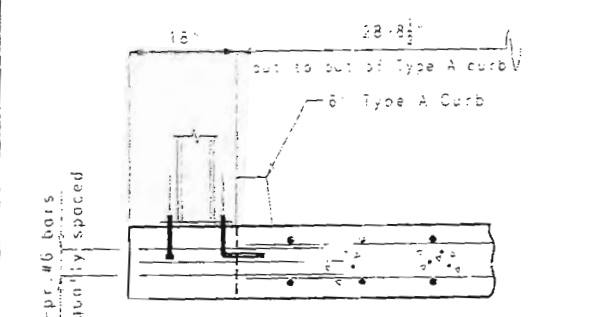


PART SECTION A-A

Note: For Details of Bolted Rail Post (Rdwy. Item) see sheet no. 49.  
Cost of installing Anchors for Bolted Rail Post, placed in Bridge Approach slab shall be included in cost bid for other items.  
\* Type A curb on right side of end bent #16 to be terminated 15' from the front face of end bent as approved by the engineer.

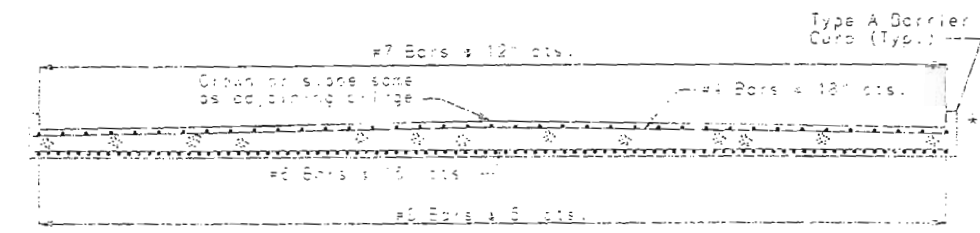


SECTION B-B


Note: With the approval of the Engineer, the contractor may, at the bottom of the approach slab, install the bottom of the roadway surface.

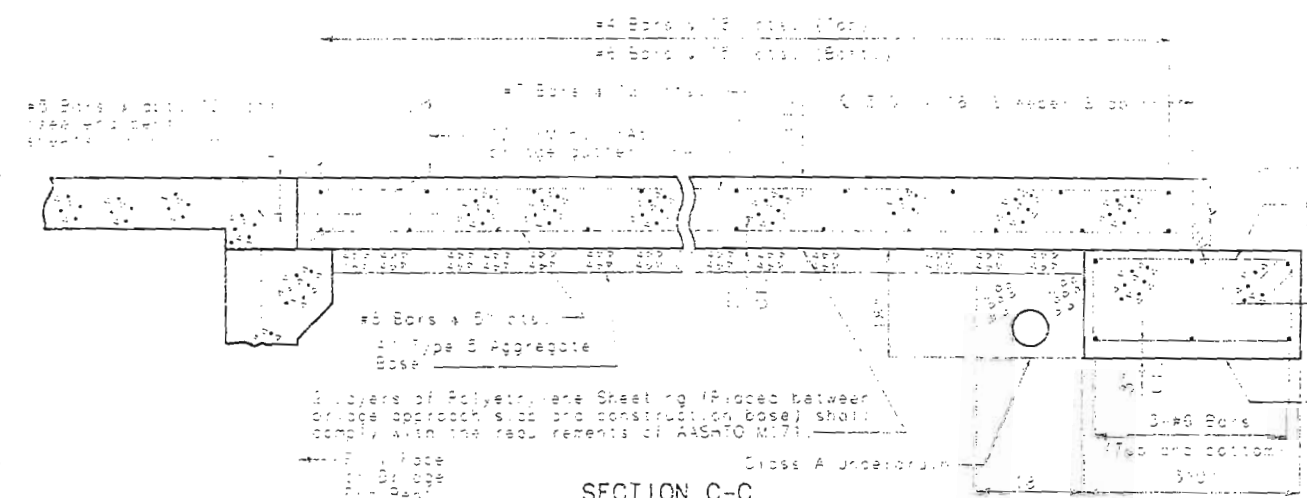

SECTION C-C

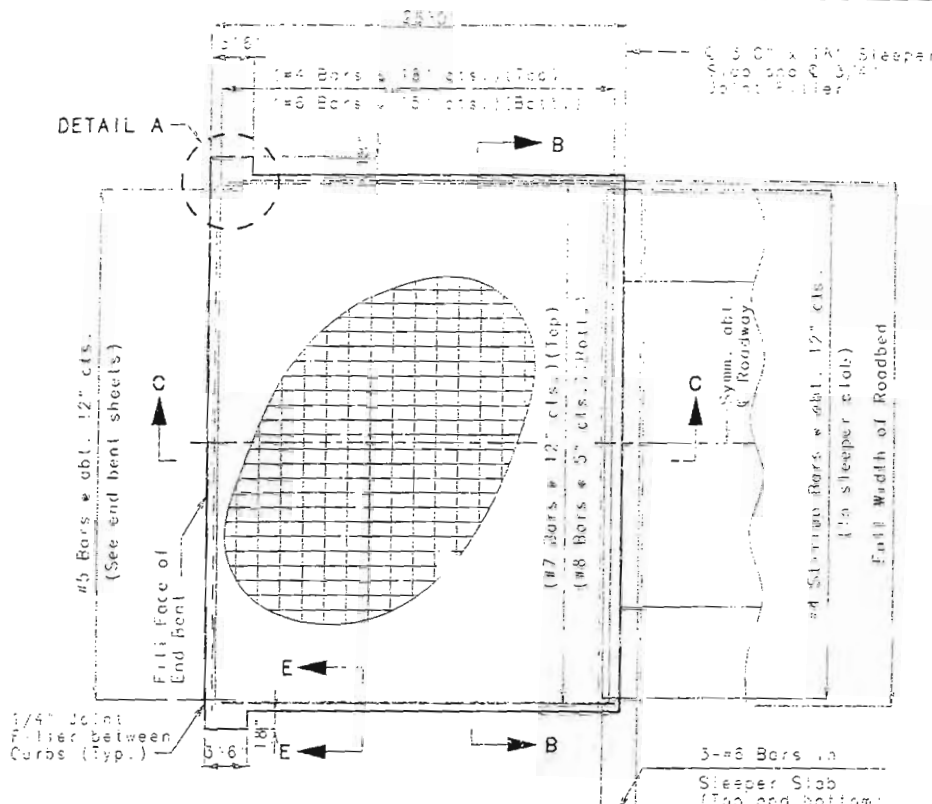


PART PLAN SHOWING REINFORCEMENT

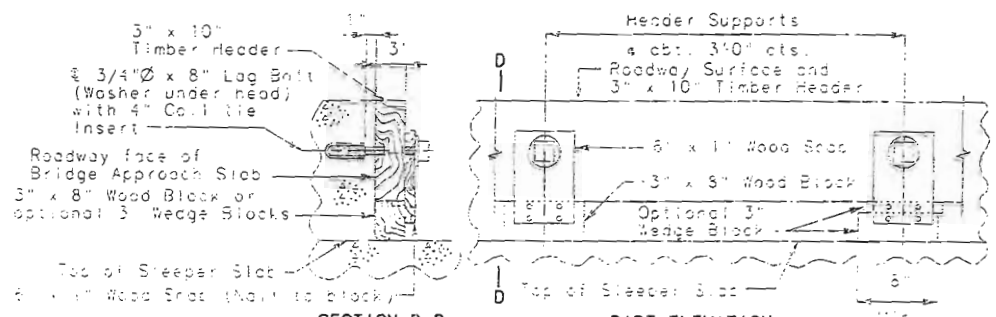


SECTION D-D  
PART ELEVATION  
DETAILS OF TIMBER HEADER

Note: Remove timber header when concrete pavement is placed.

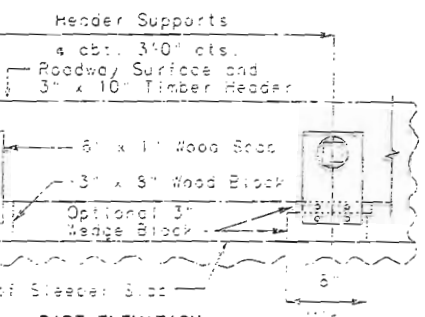


PART ELEVATION




Note: Remove timber header when concrete pavement is placed.

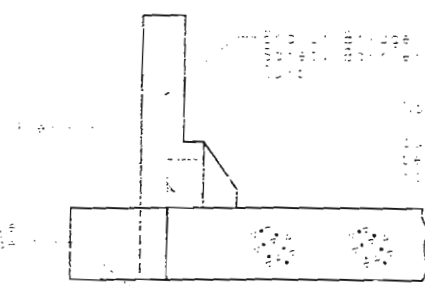

SECTION E-E  
(Between Curbs)

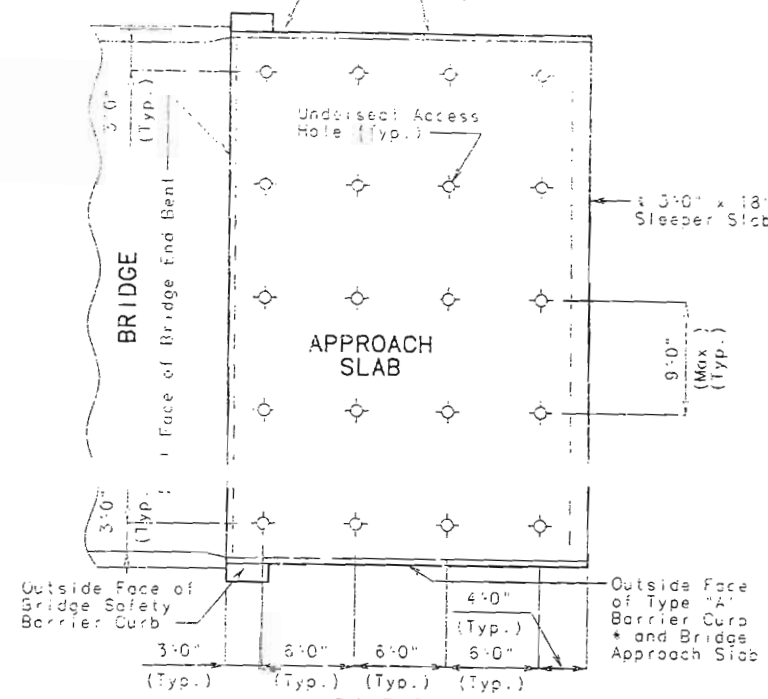


PART PLAN  
(Showing typical underseal access hole locations)

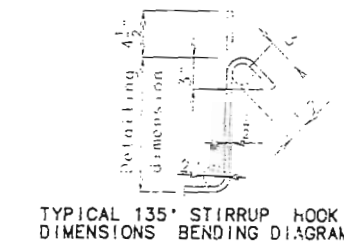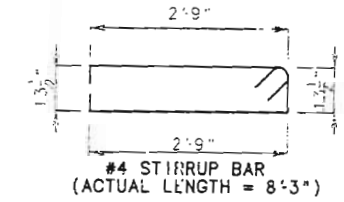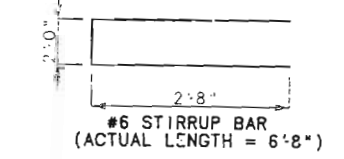


TYPICAL 135° STIRRUP HOOK  
DIMENSIONS BENDING DIAGRAM

Note: When a lap splice is required for the use of a mechanical bar splice, the minimum lap length shall be 40" for transverse approach slab bar splices.

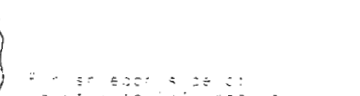


CONST. JOINT DETAIL  
(if required)

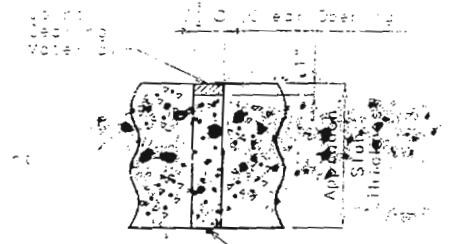


TYPICAL UNDERSEAL  
ACCESS HOLE DETAIL




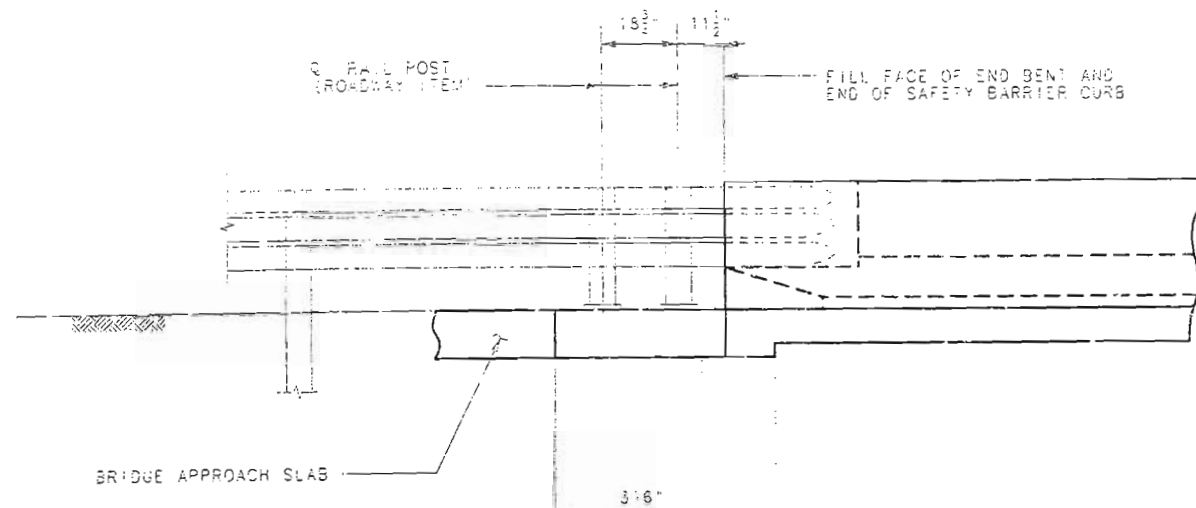

PART ELEVATION NEAR END BENT SHOWING BOLTED RAIL POSTS ON APPROACH SLAB

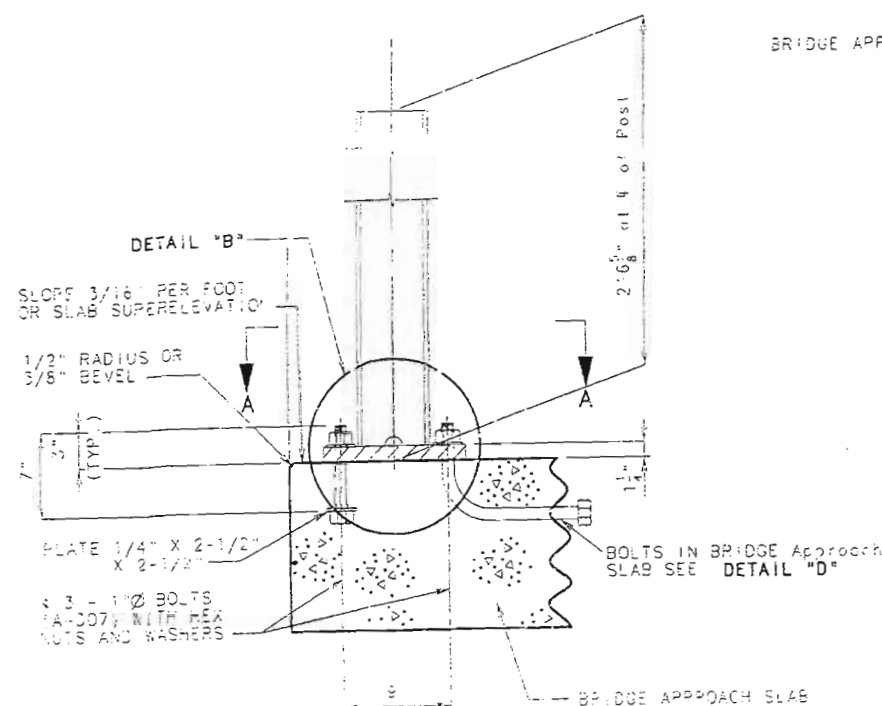


PART SECTION AT BOLTED RAIL POST

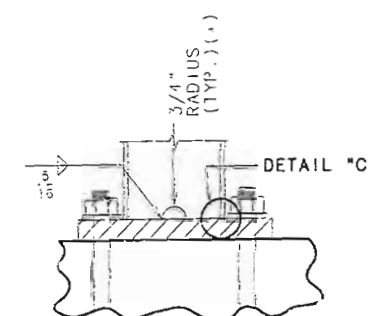


DETAIL "B"



DETAIL "C"

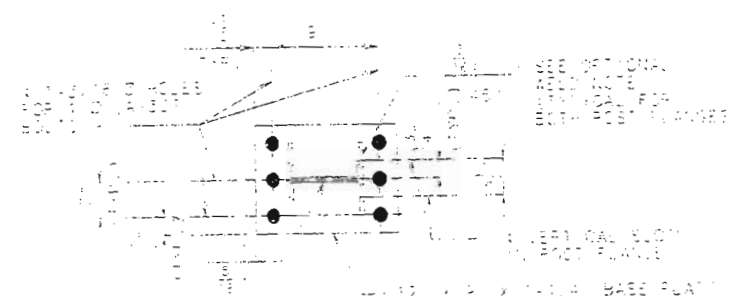

SECTION A-A

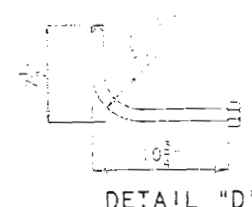

DETAIL "D"

# GENERAL NOTES:

ALL BOLTS, NUTS, WASHERS, PLATES AND ELASTOMERIC MATERIALS ARE CONSIDERED AS PARTS OF THE BRIDGE ANCHOR SECTION (ROADWAY ITEM).

RAIL POSTS SHALL BE SET PERPENDICULAR TO ROADWAY PROFILE GRADE AND VERTICALLY IN CROSS SECTION, AND ALIGNED ACCORDING TO SECTION 713 OF THE MISSOURI STANDARD SPECIFICATIONS. EXCEPT THAT THE RAIL POSTS SHALL BE ALIGNED BY THE USE OF SHIMS SO THAT IN THE FINAL ADJUSTMENT NO PART SHALL DEVIATE MORE THAN ONE INCH FROM TRUE HORIZONTAL ALIGNMENT. THE SHIMS SHALL BE 3" X 1-3/4" AND PLACED BETWEEN THE POST AND THE THREE BEAM RAIL. THE THICKNESS OF THE SHIMS SHALL BE DETERMINED BY THE CONTRACTOR AND VERIFIED BY THE ENGINEER BEFORE ORDERING MATERIAL FOR THIS WORK.

RAIL POSTS SHALL BE SEATED ON ELASTOMERIC PADS HAVING THE SAME DIMENSIONS AS THE POST BASE PLATE AND 1-1/8" THICK. SUCH PADS MAY BE ANY ELASTOMERIC MATERIAL, PLAIN OR FIBERED, HAVING A HARDNESS (DUROMETER) OF 50 OR ABOVE, AS CERTIFIED BY THE MANUFACTURER. ADDITIONAL PADS OR HALF PADS MAY BE USED IN SHIMMING FOR ALIGNMENT. POST HEIGHTS SHOWN WILL BE DECREASED BY THE THICKNESS OF THE PAD.

POSTS AND BASE PLATES SHALL BE FABRICATED FROM ASTM A709 GRADE 50 STEEL AND GALVANIZED.

THREE-BEAM ANCHOR SECTION WITH 2 HEX NUTS AND WASHERS MAY BE SUBSTITUTED FOR THE A-111 ANCHOR BOLTS.

EACH OF THE THREE (3) SHORTER ANCHOR BOLTS SHALL BE FURNISHED WITH A 1/4" X 2-1/2" X 2-1/2" PLATE (ASTM A709 GRADE 50) TACK WELDED TO THE HEAD OF THE BOLT; OR, AT THE CONTRACTOR'S OPTION, ONE PLATE 1/4" X 2-1/2" X 12" CONTINUOUS FOR ALL THREE BOLTS MAY BE USED.

FABRICATION OF STRUCTURAL STEEL SHALL BE IN ACCORDANCE WITH SECTION 7.2 OF THE MISSOURI STANDARD SPECIFICATIONS.

NOTE: FOR DETAILS OF THREE BEAM ANCHOR SECTION SEE MISSOURI STANDARD PLANS NO. 808.22 EXCEPT AS SHOWN ON THIS SHEET.

FOR GUARD RAIL POSTS THAT ARE WITHIN LIMITS OF EXISTING CONCRETE DRAINS, REMOVE CONCRETE TO DRIVE GUARD RAIL POSTS AND GROUT POST IN PLACE AFTER DRYING.

PAYMENT FOR ALL INCIDENTAL WORK RELATED TO GUARD RAIL INSTALLATION IS INCLUDED IN THE UNIT PRICE BID FOR BRIDGE ANCHOR SECTION (ROADWAY ITEM).

CERTIFY THAT THIS DRAWING ACCURATELY REFLECTS THE CONFIGURATION AND LOCATION OF THE ROADWAY AND APPURTENANCES AS CONSTRUCTED ON THIS PROJECT.

SIGNATURE

DATE

## DETAILS OF BOLTED RAIL POST

# BILL OF REINFORCING STEEL

NO. REQ'D.	MARK NO.	LOCATION	EPOXY (E)	SHAPE NO.	STIRRUP (S)	SUBSTR. (X)	VARIES (V)	NO. EACH	DIMENSIONS							NOMINAL LENGTH	ACTUAL LENGTH	WEIGHT
									B	C	D	E	F	H	K			
									FT.	IN.	FT.	IN.	FT.	IN.	FT.	IN.	FT.	LBS.
		SHOULDER																
		MAIN SLAB																
9516	5 S2	SLAB	E 20					28	3.000							28 3	28 3	413
58	5 S3	HAUNCH	E 20					29	3.000							29 3	29 3	440
120	4 S4	HAUNCH	E 13	S				9.000	12.500	9.000	12.500					4 4	4 1	357
120	4 S5	HAUNCH	E 29	S				2 0.000	5.000	10.000	8.500			6.000	6.000	4 3	4 0	321
3348	5 S6	SLAB	E 20					40 0.000								40 0	40 0	139679
54	5 S7	SLAB	E 20					6 0.000								6 0	6 0	338
106	5 S8	SLAB	E 20					21 10.000								21 10	21 10	2459
720	4 S9	HAUNCH	E 26	S				2 0.000	6.000	9.000	4.250			3.000	3.000	3 7	3 5	1843
54	5 S10	SLAB	E 20					5 1.000								5 1	5 1	343
54	5 S11	SLAB	E 20					5 5.000								5 5	5 5	305
2205	5 S12	SLAB	E 20					5 0.000								5 0	5 0	13818
108	5 S13	SLAB	E 20					4 7.000								4 7	4 7	629
324	5 S14	SLAB	E 20					6 1.000								6 1	6 1	2056
54	5 S15	SLAB	E 20					12 8.000								12 8	12 8	730
54	5 S16	SLAB	E 20					13 4.000								13 4	13 4	751
54	5 S17	SLAB	E 20					14 11.000								14 11	14 11	540
54	5 S18	SLAB	E 20					13 10.000								13 10	13 10	779
54	5 S19	SLAB	E 20					20 11.000								20 11	20 11	1175
54	5 S20	SLAB	E 20					35 3.000								35 3	35 3	2154
92	5 S21	SLAB	E 20					41 0.000								41 0	41 0	5666
14	7 S22	HAUNCH	E 20					29 3.000								29 3	29 3	837
54	5 S23	SLAB	E 20					38 2.000								38 2	38 2	2150
6	5 S24	BACKWALL	E 20					29 3.000								29 3	29 3	254
60	5 S25	SLAB	E 20					2 6.000								2 6	2 6	156
3780	4 U10	HAUNCH	E 10					8.000	6.625	12.000	8.000					3 5	3 0	7575
		BARRIER CURB																
3408	5 R1	BARRIER CURB	E 19	S				3 2.000	3.500							2 10	2 8	15038
5050	5 R2	BARRIER CURB	E 15	S				2 6.125	3.500				2 8.000	3.000		2 10	2 9	15345
5316	5 R3	BARRIER CURB	E 19	S				17.000	6.000							6 23	6 22	10169
5316	5 R4	BARRIER CURB	E 27	S				6.000	11.125	7.000	12.000	9.125	6.375			3 0	2 10	15718
8	5 R9	BARRIER CURB	E 19	S				2 2.000	5.500							2 5	2 4	19
24	5 R10	BARRIER CURB	E 10	S				10.000	7.500	12.000						4 2	3 10	96
48	5 R11	BARRIER CURB	E 20					5 0.000								5 0	5 0	250
12	5 R12	BARRIER CURB	E 20					35 5.000								35 5	35 5	443
2	5 R13	BARRIER CURB	E 20					35 6.000								35 6	35 6	76
12	5 R14	BARRIER CURB	E 20					40 3.000								40 0	40 0	4673
14	5 R15	BARRIER CURB	E 20					6 8.000								6 8	6 8	97
26	5 R16	BARRIER CURB	E 20					22 2.000								22 2	22 2	647
14	5 R18	BARRIER CURB	E 20					6 9.000								6 9	6 9	99
14	5 R19	BARRIER CURB	E 20					7 3.000								7 3	7 3	109
26	5 R20	BARRIER CURB	E 20					10 11.000								10 11	10 11	312
103	5 R21	BARRIER CURB	E 20					29 2.000								29 2	29 2	501
26	5 R22	BARRIER CURB	E 20					10 11.000								10 11	10 11	312
14	5 R23	BARRIER CURB	E 20					10 11.000								10 11	10 11	312
26	5 R24	BARRIER CURB	E 20					10 11.000								10 11	10 11	312
14	5 R25	BARRIER CURB	E 20					10 11.000								10 11	10 11	312
26	5 R26	BARRIER CURB	E 20					10 11.000								10 11	10 11	312
14	5 R27	BARRIER CURB	E 20					10 11.000								10 11	10 11	312
14	5 R28	BARRIER CURB	E 20					10 11.000								10 11	10 11	312


# BILL OF REINFORCING STEEL

NO. REQ'D.	MARK NO.	LOCATION	EPOXY (E)	SHAPE NO.	STIRRUP (S)	SUBSTR. (X)	VARIES (V)	NO. EACH	DIMENSIONS							NOMINAL LENGTH	ACTUAL LENGTH	WEIGHT
									B	C	D	E	F	H	K			
									FT.	IN.	FT.	IN.	FT.	IN.	FT.	IN.	FT.	LBS.
14	5 R30	BARRIER CURB	E 20					28 3.000								28 3	28 3	413
14	5 R31	BARRIER CURB	E 20					30 2.000								30 2	30 2	440
28	5 R32	BARRIER CURB	E 20					37 9.000								37 9	37 9	1102
56	5 R33	BARRIER CURB	E 20					9 9.000								9 9	9 9	525
28	5 R34	BARRIER CURB	E 20					32 2.000								32 2	32 2	539
28	5 R35	BARRIER CURB	E 20					37 8.000								37 8	37 8	1095
12	5 R36	BARRIER CURB	E 20					35 6.000								35 6	35 6	444
2	5 R37	BARRIER CURB	E 20					36 7.000								36 7	36 7	75
40	5 R38	BARRIER CURB	E 19	S				10.000	6.000							0 10	0 15	52
40	5 R40	BARRIER CURB	E 21	S				11.125	13.000	5.000				9.125	6.375	2 8	2 2	90
		SLIP-FORM CURB ONLY																
608	5 C1	SLIP-FORM	E 20					10 0.000								10 0	10 0	6341
		INCLUDES 2 ADDITIONAL #4-S3, #5-S15, #7-S22 & #8-S28 BARS FOR TESTING																

CERTIFY THAT THIS DRAWING REFLECTS THE CONFIGURATION AND LOCATION OF THE ROADWAY AND APERTURANCES AS CONSTRUCTED ON THIS PROJECT.

SIGNATURE

DATE

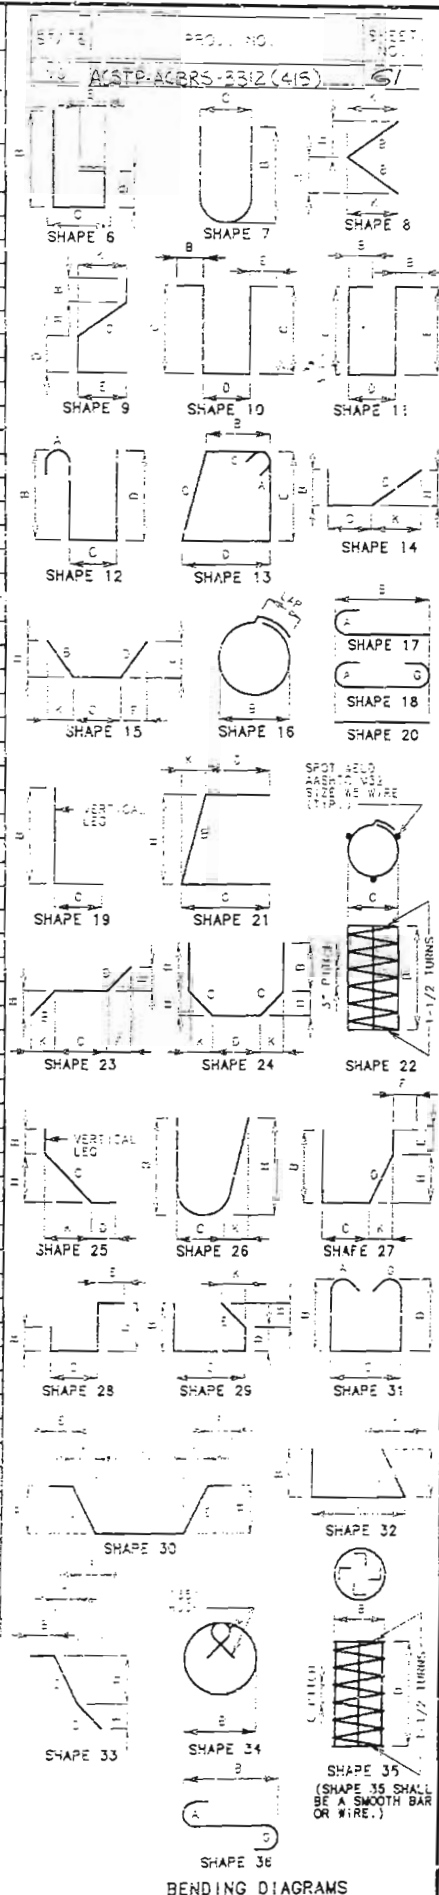


TWO ADDITIONAL #4-S3, #5-S15, #7-S22 & #8-S28 ARE INCLUDED IN THE BAR BILL FOR TESTING.


BAR SIZE	D (IN.)	ALL TAPES	
		180° HOOKS	90° HOOKS
#3	2-1/4"	5"	3"
#4	3"	6"	4"
#5	3-3/4"	7"	5"
#6	4-1/2"	8"	6"
#7	5-1/4"	10"	7"
#8	6"	11"	8"
#9	9-1/2"	15"	11-3/4"
#10	10-3/4"	17"	13-1/4"
#11	12"	19"	14-3/4"
#14	18-1/4"	21-3/4"	21-7"

NOTE: ALL STANDARD BENDS AND BENDS OTHER THAN 150 DEG. TO BE BENT AT THE SAME PROCEDURE AS FOR 150 DEG. BENDS. ALL BENDS SHALL BE IN ACCORDANCE WITH THE PROCEDURES AS SHOWN ON THIS SHEET.

SHAPE 35 SHALL BE A SMOOTH BAR OR WIRE.

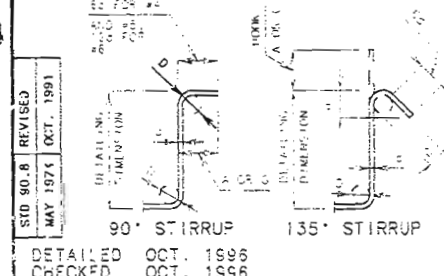

STIRRUP HOOK DIMENSIONS				
GRADES 40 - 50 - 60 KSI				
BAR SIZE	D (IN.)	90° HOOK	135° HOOK	APPROX. H
#4	2"	4-1/2"	4-1/2"	3"
#5	2-1/2"	6"	5-1/2"	3-3/4"
#6	4-1/2"	12"	8"	4-1/2"

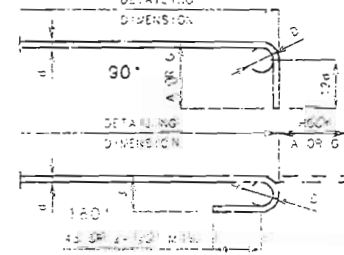

STANDARD 90.8 REVISED MAY 1971 OCT 1991

Detailed OCT. 1996  
Checked OCT. 1996


NOTE: THIS DRAWING IS NOT TO SCALE. FOLLOW DIMENSIONS.

SHEET NO. 50 OF 50.

PLATTE

COUNTY

A450R1

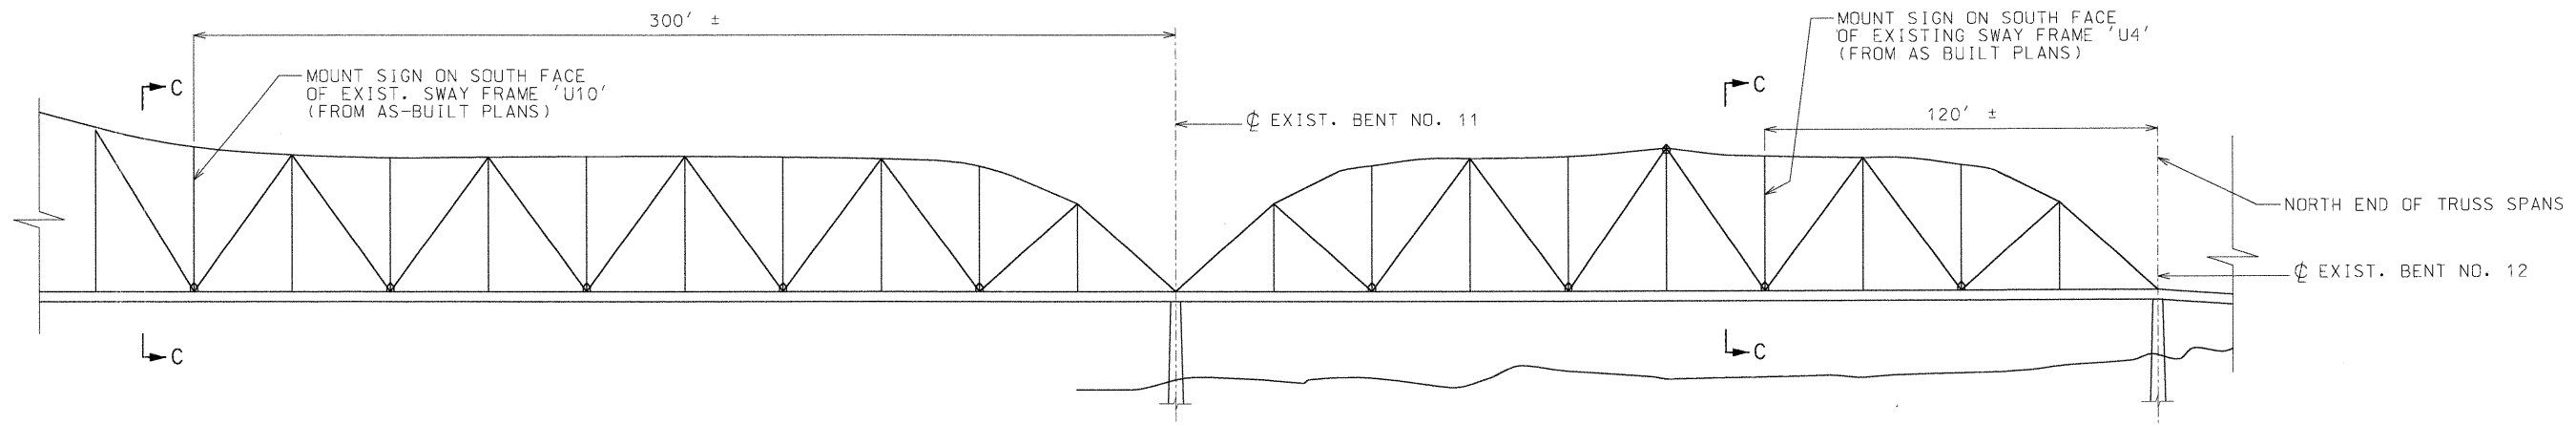

**PARTIAL ELEVATION**  
EXISTING N.B. 69 BRIDGE  
OVER MISSOURI RIVER, BR. NO. A-450


**Note:**  
Bottom of Signs and Supports must be located above Bottom of sway frame low chord

**Notes:**  
Contractor shall field verify existing conditions and dimensions prior to fabricating supports.


Signs shall be bid as Signing Items.

See Job Special Provisions for specifications on required material, fabrication & installation procedures, and incidental work required.


Payment for sign supports on the bridges, completed and accepted work including all materials, equipment, tools, labor, installation and all incidental work necessary shall be made and considered completely covered under the contract unit price for "Sign Supports on Bridges", per each.

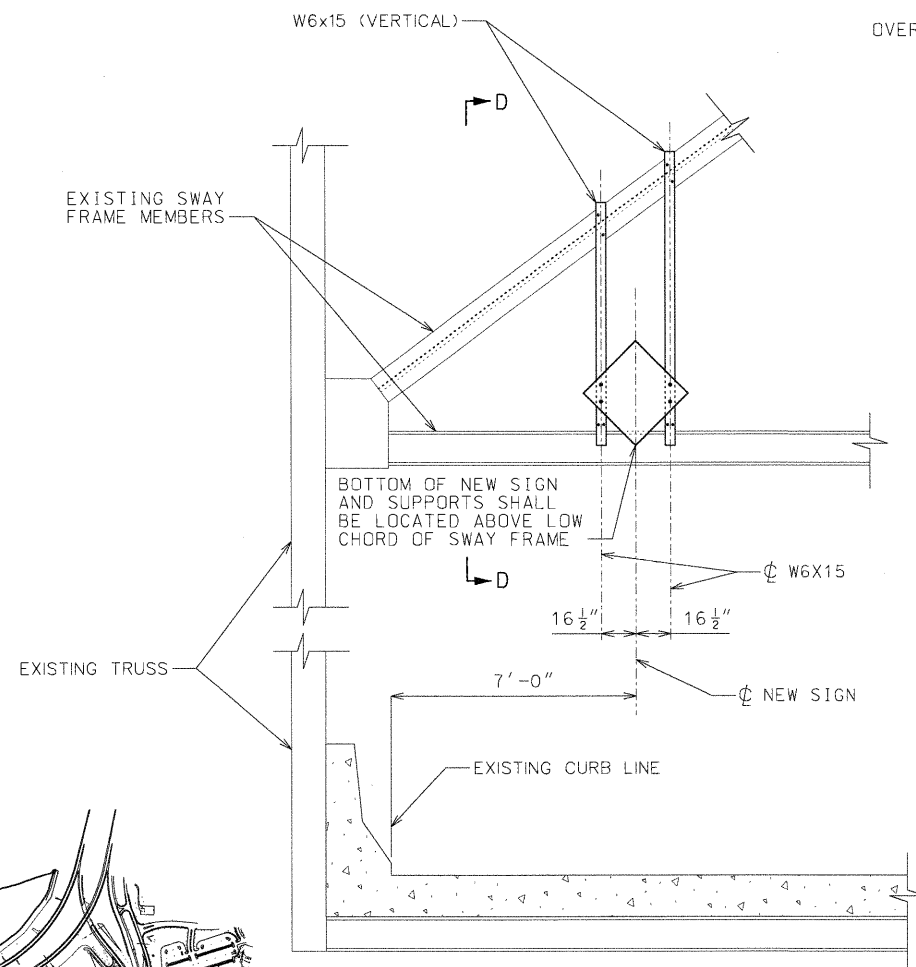

**SECTION C-C**  
(LOOKING NORTH)

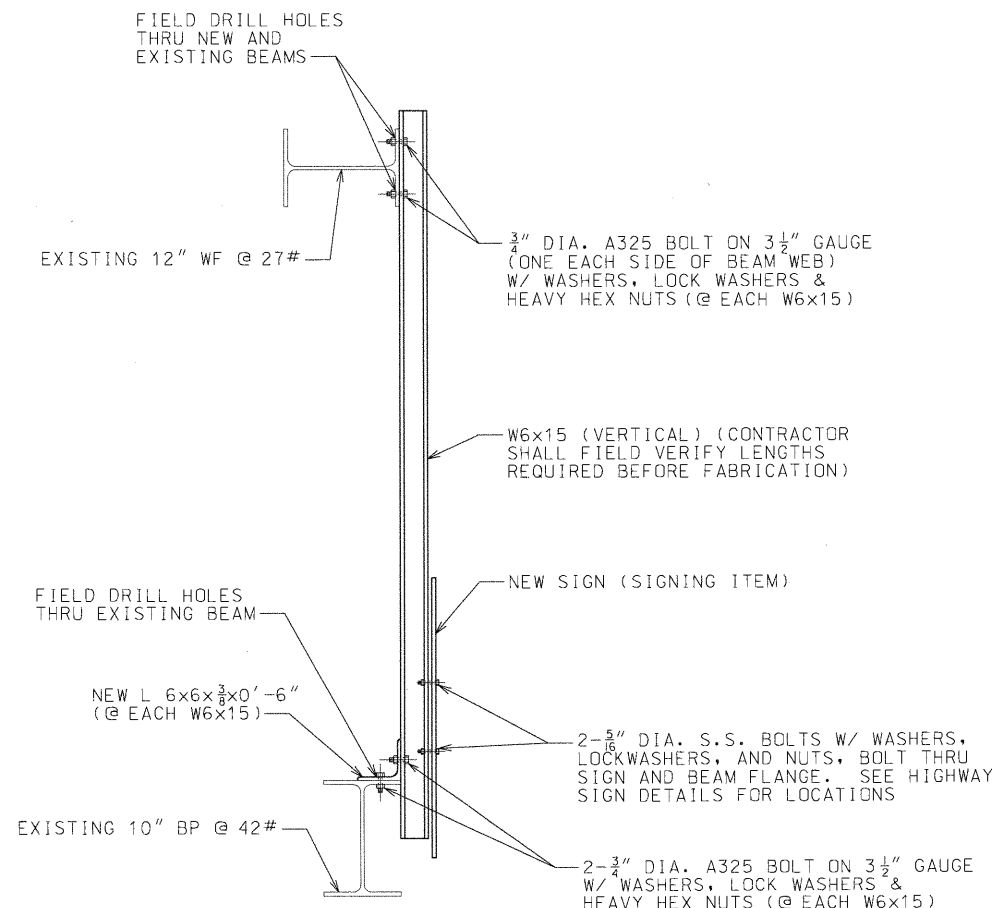

**SECTION D-D**

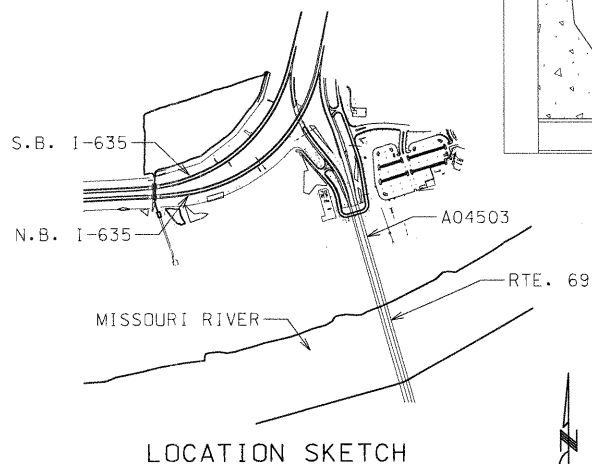

**LOCATION SKETCH**

ESTIMATED QUANTITIES		
ITEM		QUANTITY
SIGN SUPPORTS ON BRIDGES	EACH	2

**BRIDGE: N.B. RTE. 69 OVER THE MISSOURI RIVER**


STATE ROAD FROM MISSOURI RIVER TO RTE. I-635  
ABOUT 0.5 MILES SOUTH OF RTE. I-635

PROJECT NO. J411709  
JOB NO. J411709

STA. RTE. 69


**PLATTE COUNTY**  
DATE: 10/19/05

10-05-2005

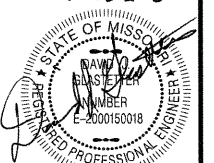


**A04503**

ROUTE	STATE	DISTRICT	SHEET NO.	"THIS MEDIA SHOULD NOT BE CONSIDERED A CERTIFIED DOCUMENT."  DATE _____
69	MO	BR	1	
JOB NO.				
CONTRACT ID.				
PROJECT NO.				
COUNTY PLATTE				

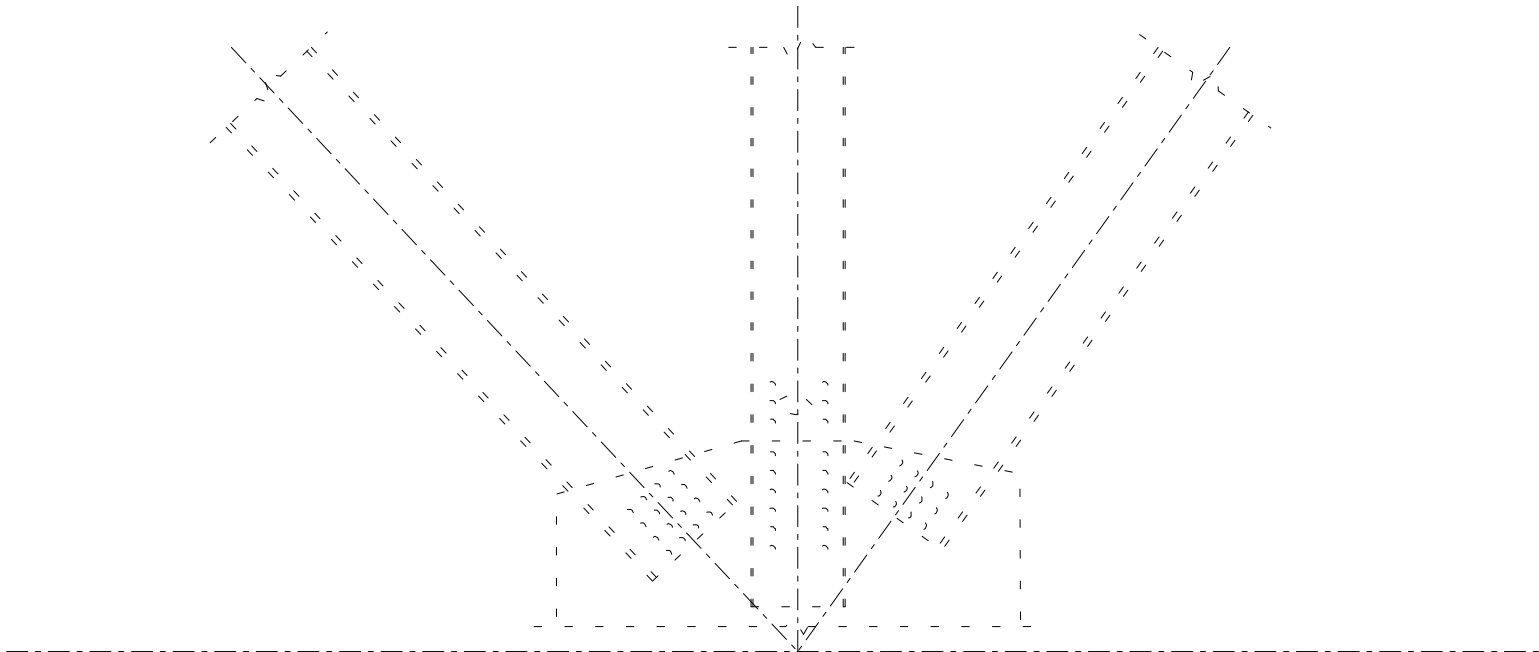


PART ELEVATION SHOWING EXISTING CONDITION

Note:  
Holes are for illustrative purposes. Different configurations exist at different panel points.

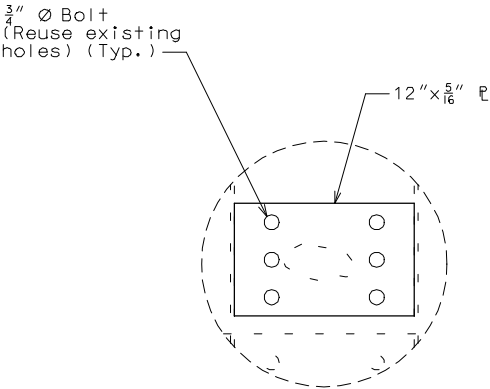


DETAIL "A"

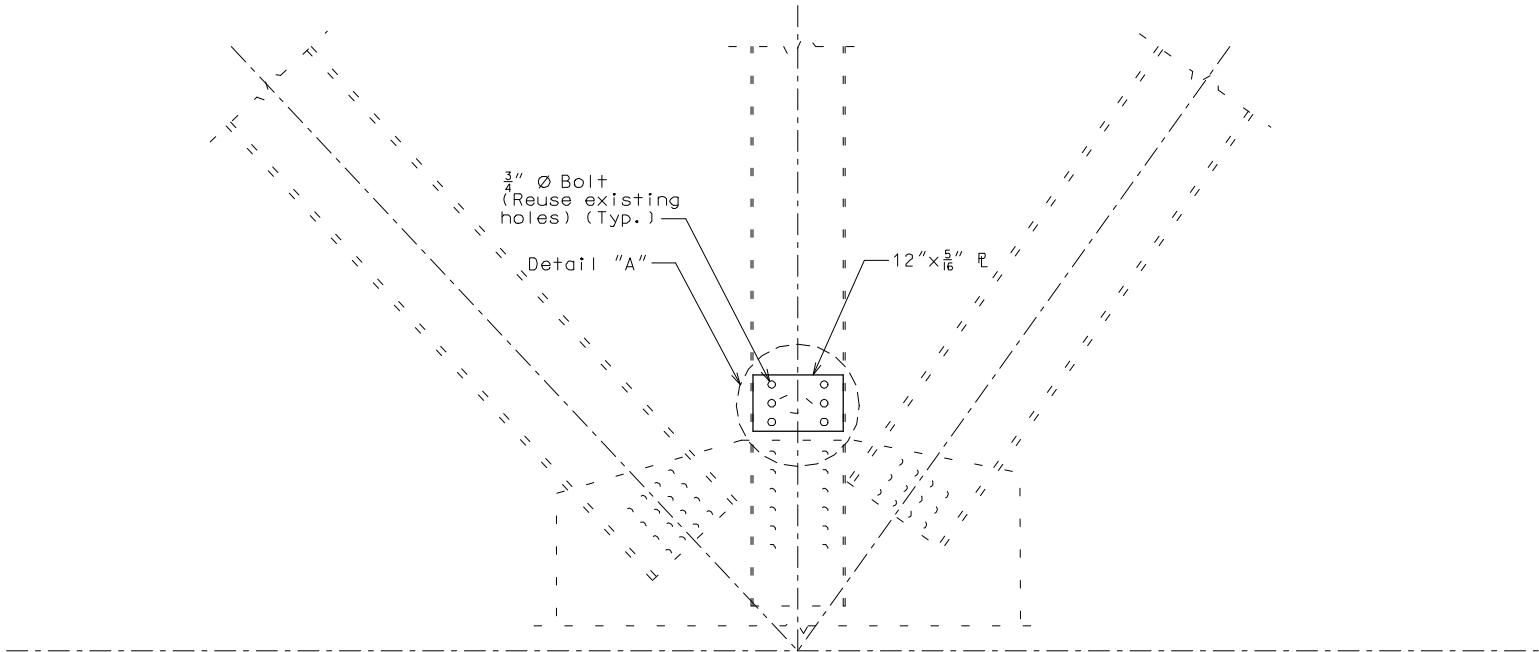

PART ELEVATION SHOWING PROPOSED CONSTRUCTION

Note:  
Holes are for illustrative purposes. Different configurations exist at different panel points.

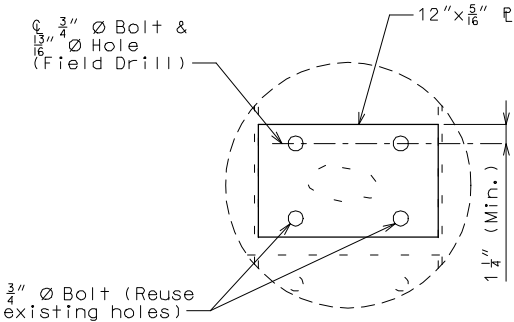


OPTIONAL DETAIL "A"


Notes:  
Field connections shall be made with 3/4" diameter high strength bolts and 13/16" diameter holes, except as noted.  
Fabricated structural steel shall be ASTM A709 Grade 36.  
Outline of old work is indicated by light dashed lines. Heavy lines indicate new work.  
Thicker plates, larger diameter bolts and higher grades of steel may be substituted.

DETAILS OF SPLICE TO REPAIR VERTICAL MEMBERS AT SPAN 7 (L4W & L8W), SPAN 8 (L2, L6W & L10W), SPAN 9 (L16'), SPAN 10 (L4'E, L6', L8' & L2') & SPAN 11 (L2E)


ROUTE	STATE	DISTRICT	SHEET NO.	"THIS MEDIA SHOULD NOT BE CONSIDERED A CERTIFIED DOCUMENT."  DATE _____
69	MO	BR	2	
JOB NO.				
CONTRACT ID.				
PROJECT NO.				
COUNTY PLATTE				

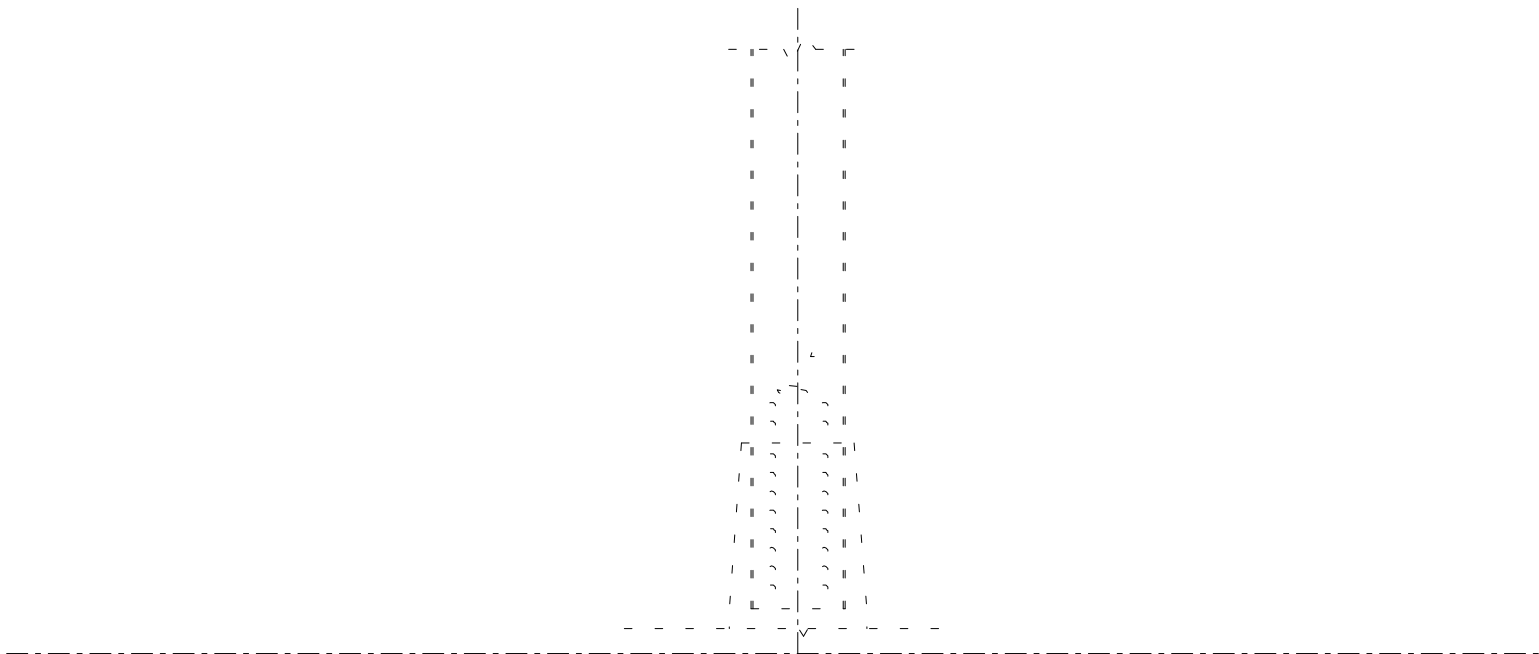

PART ELEVATION SHOWING EXISTING CONDITION

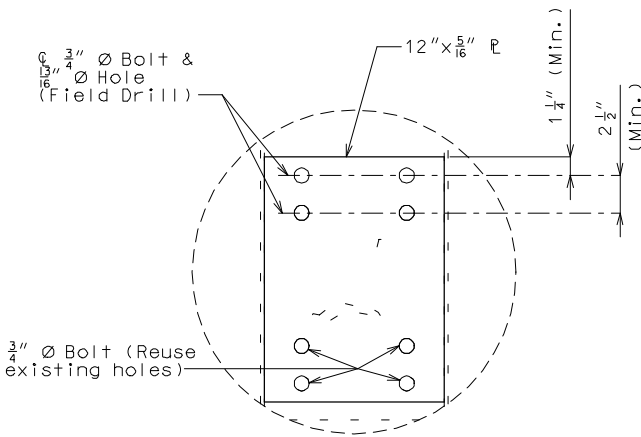

DETAIL "A"

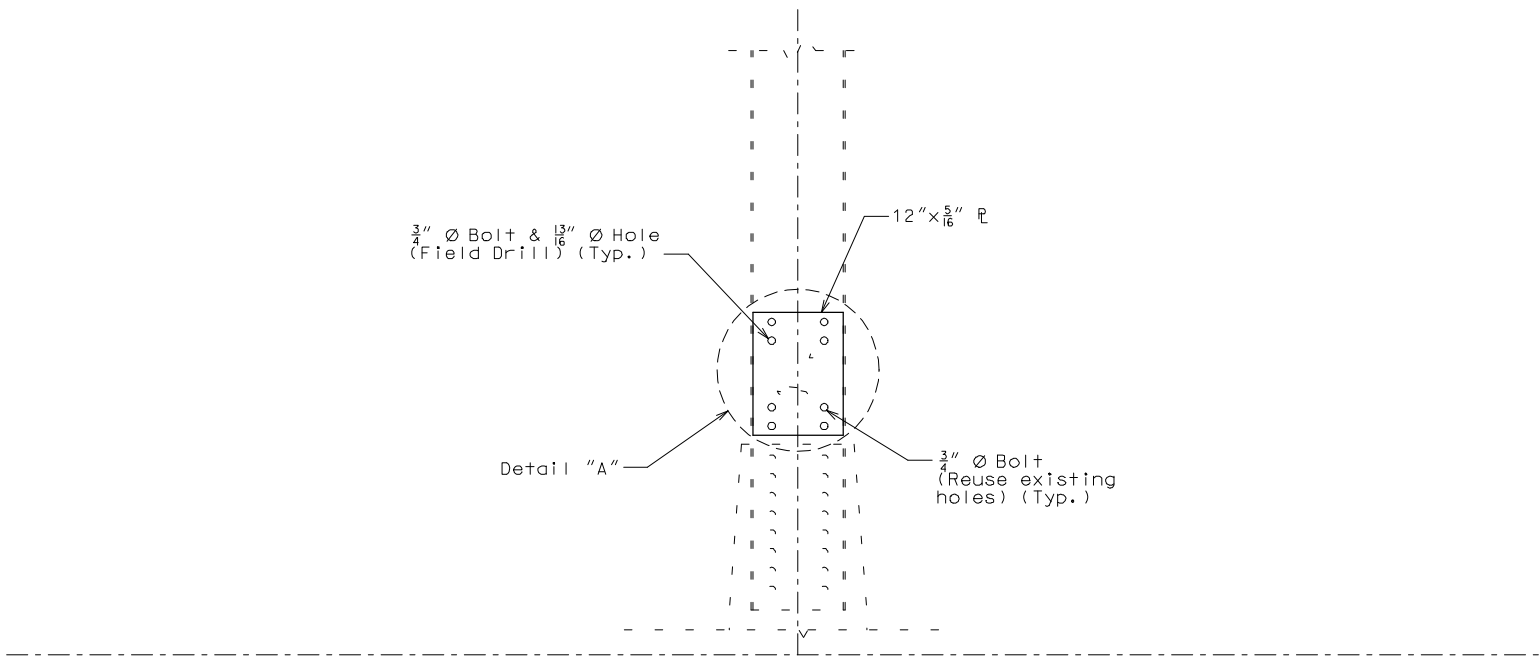

PART ELEVATION SHOWING PROPOSED CONSTRUCTION

Notes:

Field connections shall be made with 3/4" diameter high strength bolts and 13/16" diameter holes, except as noted.

Fabricated structural steel shall be ASTM A709 Grade 36.


Outline of old work is indicated by light dashed lines. Heavy lines indicate new work.

Thicker plates, larger diameter bolts and higher grades of steel may be substituted.

DETAILS OF SPLICE TO REPAIR VERTICAL MEMBER AT SPAN 9 (L15)




ROUTE	STATE	DISTRICT	SHEET NO.	"THIS MEDIA SHOULD NOT BE CONSIDERED A CERTIFIED DOCUMENT."  DATE _____
69	MO	BR	3	
JOB NO.				
CONTRACT ID.				
PROJECT NO.				
COUNTY PLATTE				

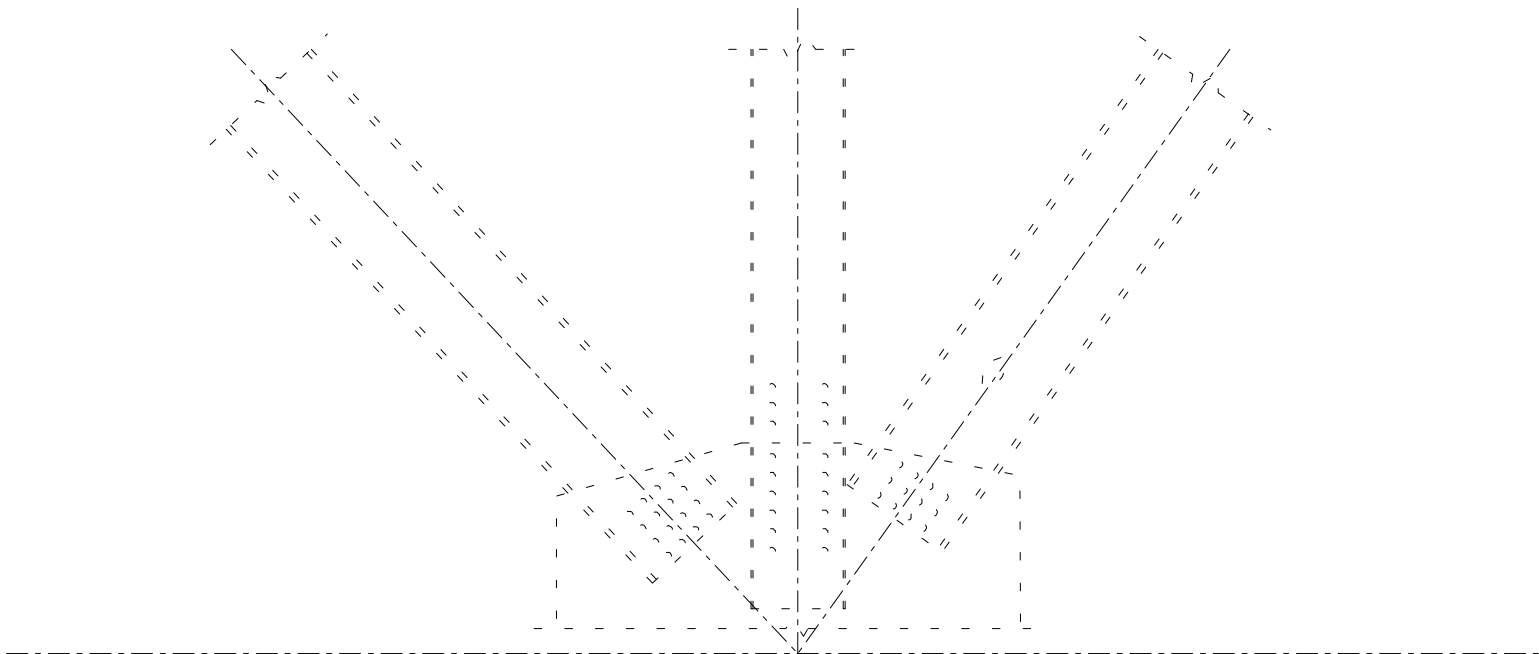


PART ELEVATION SHOWING EXISTING CONDITION

Note:  
Holes are for illustrative purposes. Different configurations exist at different panel points.

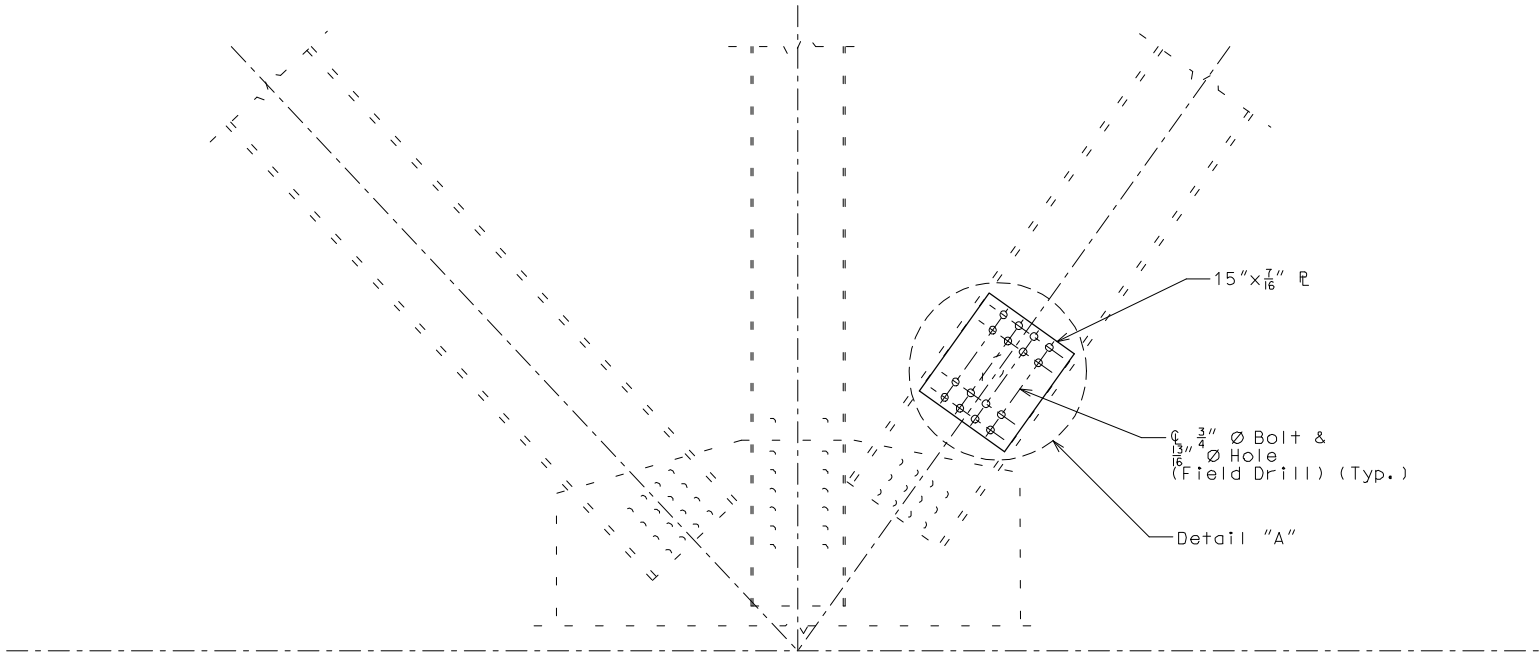

PART ELEVATION SHOWING PROPOSED CONSTRUCTION

Note:  
Holes are for illustrative purposes. Different configurations exist at different panel points.

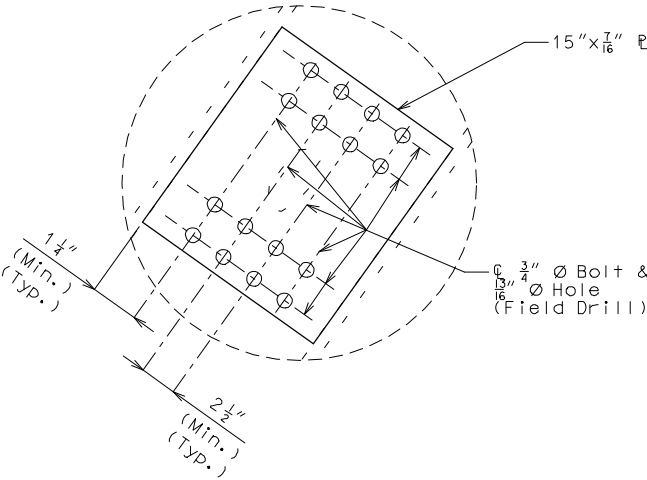

DETAIL "A"

Notes:  
Field connections shall be made with 3/4" diameter high strength bolts and 13/16" diameter holes, except as noted.  
Fabricated structural steel shall be ASTM A709 Grade 36.  
Outline of old work is indicated by light dashed lines. Heavy lines indicate new work.  
Thicker plates, larger diameter bolts and higher grades of steel may be substituted.

DETAILS OF SPLICE TO REPAIR DIAGONAL MEMBER AT L2