

6-0

STATE OF OHIO
DEPARTMENT OF HIGHWAYS

UI-1057(4)

FED. ROAD DIV. NO.	STATE	FEDERAL AID PROJECT NO.	TYPE FUNDS
2	OHIO	UI 1057 (4)	

1
43CUYAHOGA COUNTY
CITY OF CLEVELAND
INNER BELT FREEWAY
CENTRAL VIADUCT
CUY - 42R - 17.50

PART 2

CUY - 42R - 17.50

INNER BELT FREEWAY - CENTRAL VIADUCT

BR. NO. CU - 42R - 175

CUYAHOGA COUNTY

CITY OF CLEVELAND

PART 2 SUBSTRUCTURE

MAR 15 1952
GROUND PHOTO LAB


THIS IMPROVEMENT HAS BEEN DECLARED A LIMITED ACCESS HIGHWAY OR FREEWAY BY ACTION OF THE DIRECTOR OF HIGHWAYS IN ACCORDANCE WITH THE PROVISIONS OF SECTION 5511.02 REVISED CODE OF OHIO.

INDEX OF SHEETS


1	TITLE SHEET	23-28	PIER SHAFT DETAILS
2	QUANTITIES	29	ANCHOR BOLT PLAN AND DETAILS
3	GENERAL NOTES	30-32	REINFORCEMENT SCHEDULES
4,5	GENERAL PLAN AND ELEVATION	33-37	STORM SEWER AND DRAINAGE DETAILS
6-9	GENERAL LAYOUT, TEST HOLE BORINGS, EXISTING CONDITIONS	38,39	DOCK WALL
10,11	RAILROAD TRACK MODIFICATIONS	40-43	CONSTRUCTION IN ERIE RAILROAD YARD
12,13	EXISTING CONDITIONS AT PIER LOCATIONS	10,11,35	R.R. FORCE ACCOUNT WORK
14-22	PIER FOOTINGS	36A	REVISED SHEET no. 36

LINE DATA

BEGIN PROJECT	UI-1057 (4)	STA. 16 + 13.02
END PROJECT	UI-1057 (4)	STA. 43 + 34.72
NET LENGTH	UI-1057 (4) AND WORK	2,721.7 LIN. FT. or 0.515 MILES

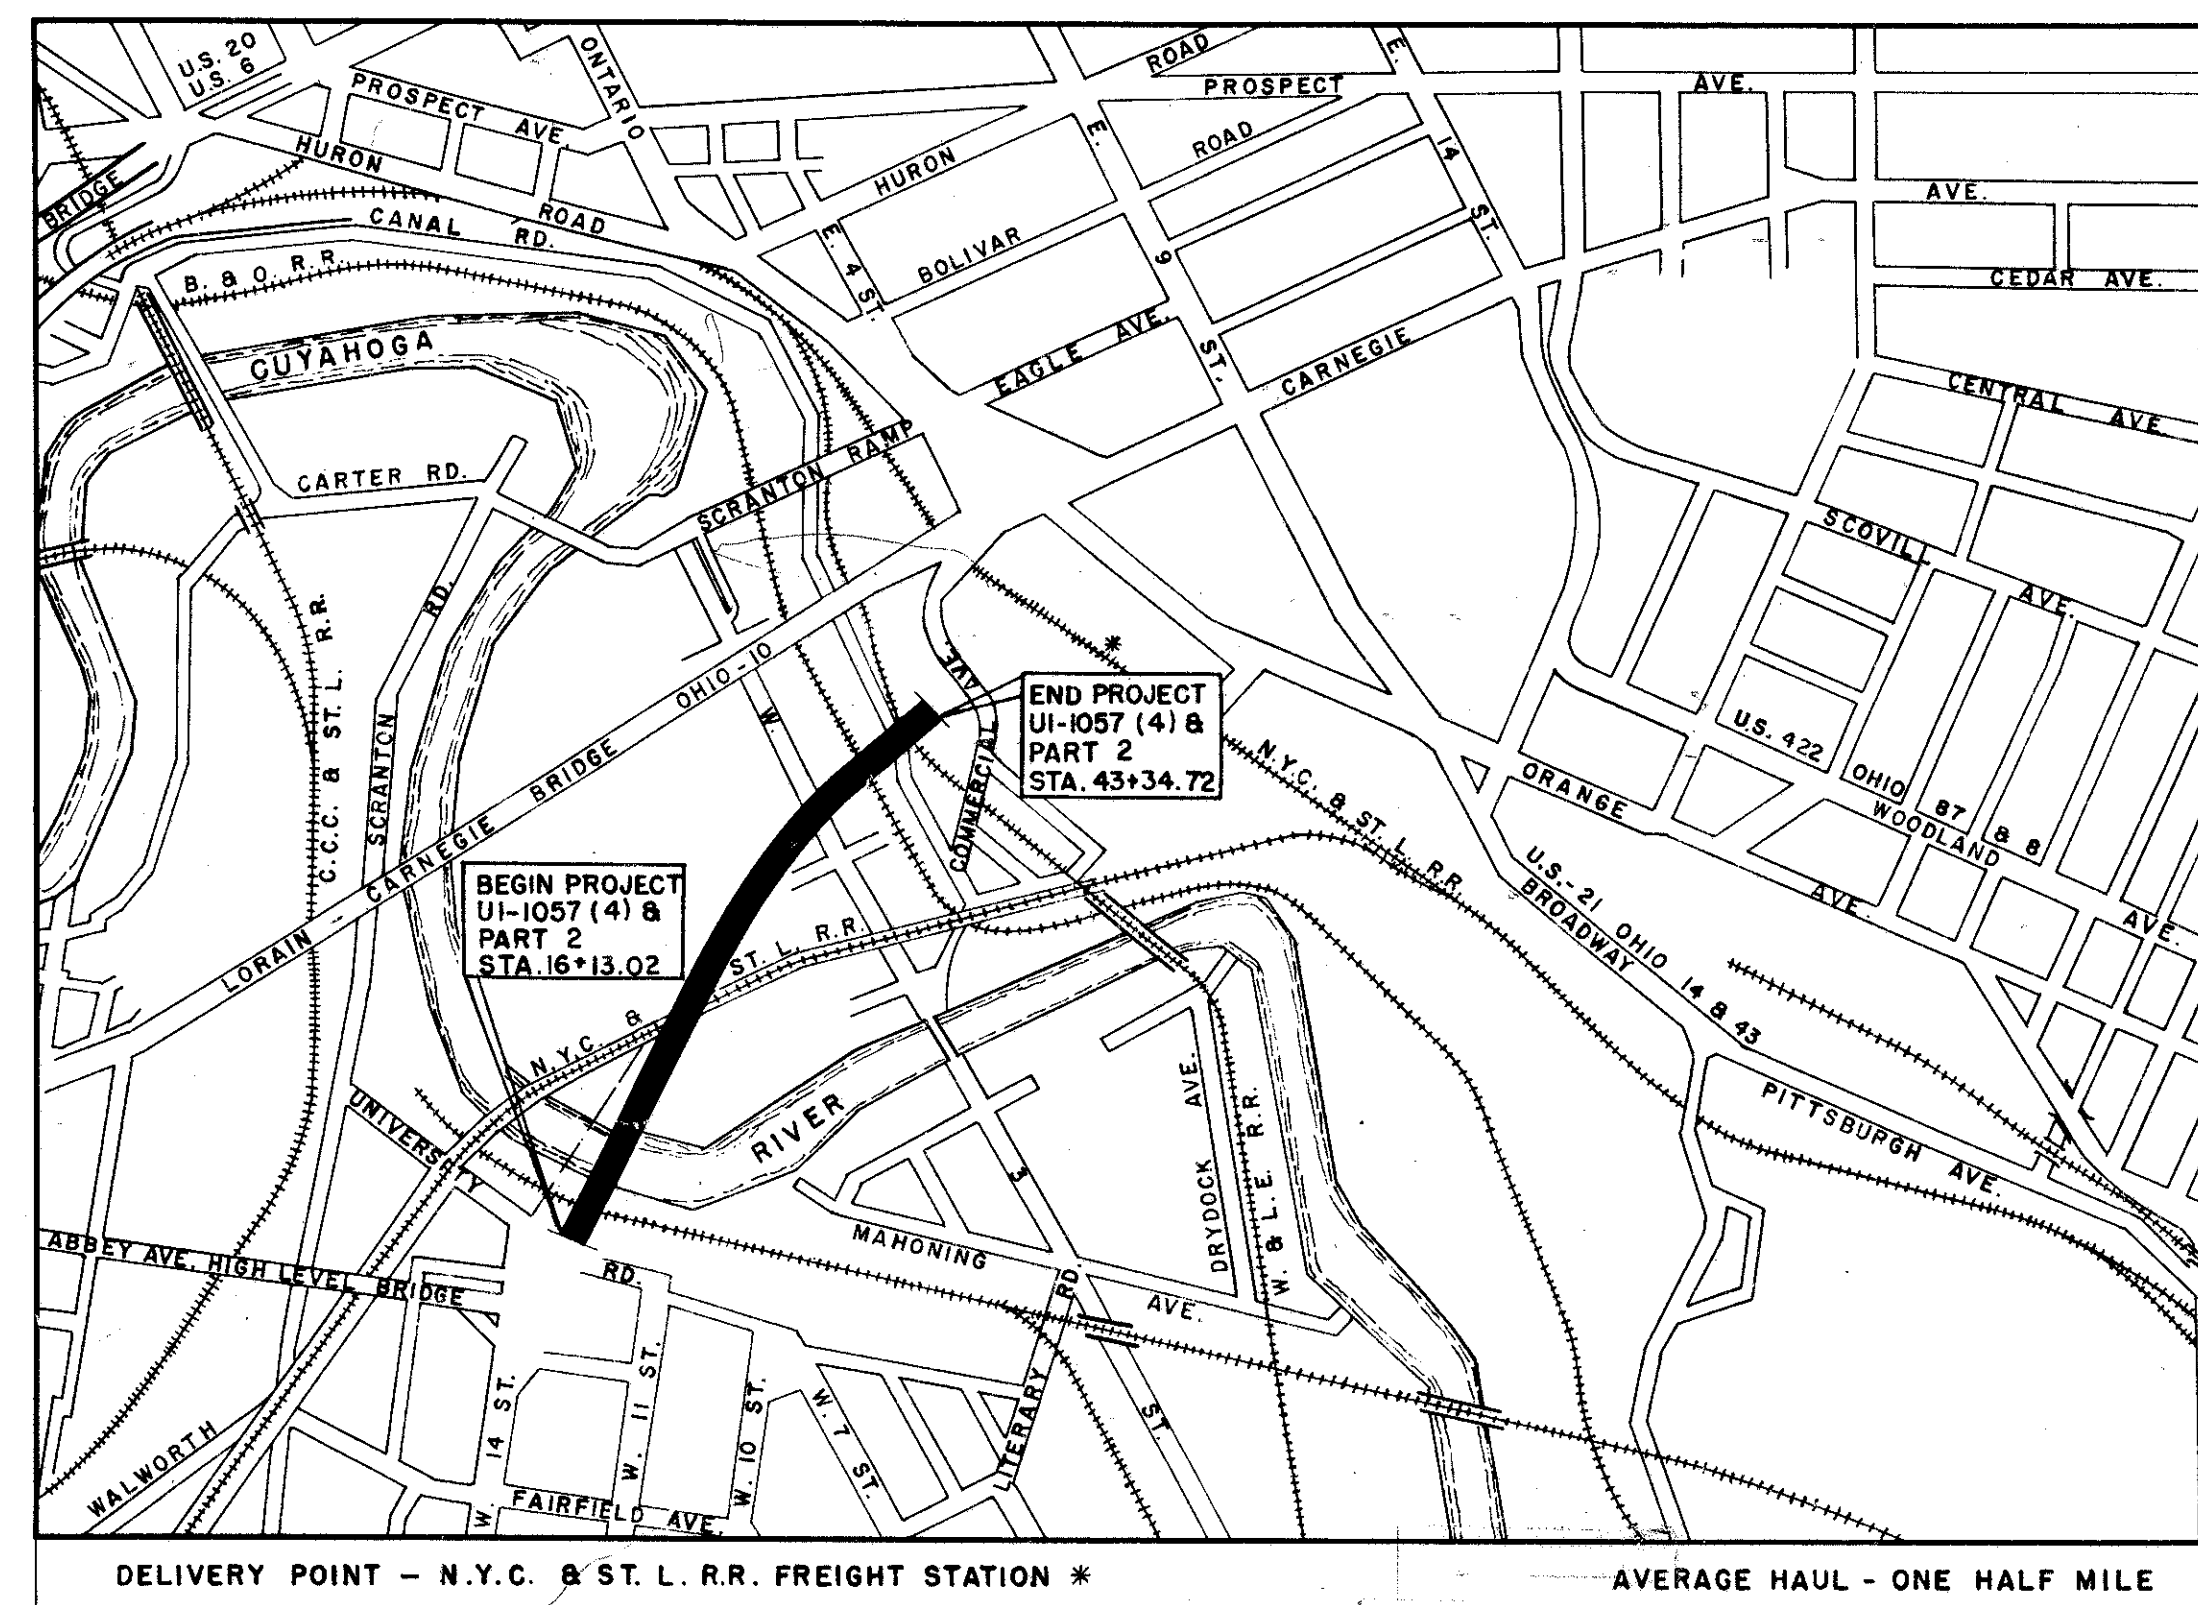

LOCATION PLAN

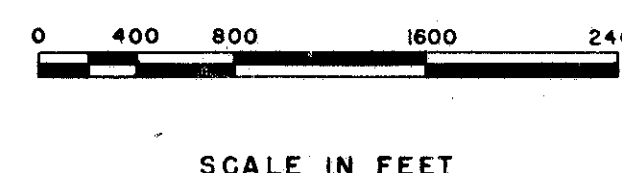

PORTION TO BE IMPROVED

SUPPLEMENTAL SPECIFICATIONS

NUMBER	DATE	NUMBER	DATE
CE-107	5-21-53		
T-171.19	R.3-19-53		
M-101.7	1-24-53		

STANDARD DRAWINGS

NUMBER	DATE	NUMBER	DATE
I-8 MH No. 1	5-1-52		
G-7.07	1-2-53		
I-8 MHIN 1-A	6-1-54		
I-1,2,3,4 & 5	2-20-45		

* Accepted. ** Submitted to B.P.R. for approval.

THE STANDARD SPECIFICATIONS OF THE STATE OF OHIO DEPARTMENT OF HIGHWAYS, INCLUDING CHANGES AND SUPPLEMENTAL SPECIFICATIONS LISTED IN THE PROPOSAL SHALL GOVERN THIS IMPROVEMENT.

I HEREBY APPROVE THESE PLANS AND DECLARE THAT THE MAKING OF THIS IMPROVEMENT WILL NOT REQUIRE THE CLOSING TO TRAFFIC OF THE HIGHWAY AND THAT PROVISIONS FOR THE MAINTENANCE AND SAFETY OF TRAFFIC WILL BE AS SET FORTH IN THE PLANS AND ESTIMATE.

THE RIGHT OF WAY FOR THIS IMPROVEMENT WILL BE PROVIDED BY THE STATE OF OHIO.

APPROVED *Louis R. Drasler*
DATE 9-2-54 DIRECTOR OF PUBLIC SERVICE, CITY OF CLEVELAND

APPROVED *Arthur J. Endrey*
DATE 9-2-54 DIVISION DEPUTY DIRECTOR

APPROVED *John J. Neeseley*
DATE 7/14/54 DEPUTY DIRECTOR OF PLANNING AND PROGRAMMING

APPROVED *Richard Orth*
DATE 9-8-54 ENGINEER OF BRIDGES

APPROVED *W. J. Gould*
DATE 9-10-54 ENGINEER OF LOCATION & DESIGN

APPROVED *W. J. Gould*
DATE 9-10-54 DEPUTY DIRECTOR OF DESIGN & CONSTRUCTION

APPROVED *W. J. Gould*
DATE 9-14-54 FIRST ASSISTANT DIRECTOR

APPROVED *W. J. Gould*
DATE 9-15-54 DIRECTOR OF HIGHWAYS

PRINT APPROVED BY *B. Blowers*
DATE 8-31-54 CHIEF ENGINEER, ERIE RAILROAD

PRINT APPROVED BY *F. H. Simpson*
DATE 8-31-54 CHIEF ENGINEER, NEW YORK CENTRAL SYSTEM

APPROVED *K. J. Wagoner*
DATE 9-2-54 CHIEF ENGINEER, NEW YORK, CHICAGO AND SAINT LOUIS RAILROAD CO.

PRINT APPROVED BY *K. J. Wagoner*
DATE 9-2-54 CHIEF ENGINEER, BALTIMORE AND OHIO RAILROAD

HOWARD NEEDLES TAMMEN & BERGENDOFF
CONSULTING ENGINEERS
KANSAS CITY CLEVELAND NEW YORK

H.G. SOURS
ASSOCIATE
COLUMBUS

FILE NO.	CUYAHOGA COUNTY
SEC	00077
DATE OF LETTING	_____, 195
CONTRACT NO.	

DEPARTMENT OF COMMERCE
BUREAU OF PUBLIC ROADS

APPROVED

DISTRICT ENGINEER

DATE

CUYAHOGA COUNTY
 CITY OF CLEVELAND
 INNER BELT FREEWAY
 CENTRAL VIADUCT
 CUY-42 R-17.50

CONTINUATION OF GENERAL NOTES
 (From Sheet 3)

32. PILING (Continued from Sheet 3)

An effort shall be made to avoid great differences in the penetrated length of the individual piles in a footing. In striving for additional penetration, beyond 65 tons, piles of relatively short penetration shall be driven to a greater rate of blows-per-foot than longer piles.

The Contractor shall submit to the Engineer, at least 15 days before the beginning of pile driving, for approval by the Director, a plan showing the order in which he proposes to drive the piles in a footing. It is intended that the piles nearest the middle of the footing be driven first, to insure as great penetration for them as for the outer piles, after which successive outer piles will be driven.

ESTIMATED QUANTITIES

ITEM	DESCRIPTION	TOTAL	UNIT	PIER 1		PIER 2		PIER 3		PIER 4		PIER 5		PIER 6		PIER 7		PIER 8		WEST END PIER		EAST END PIER		STRUCTURE REMOVAL	SEWER SYSTEM	PROJECT IN GENERAL
				IN	IS	2N	2S	3N	3S	4N	4S	5N	5S	6N	6S	7N	7S	8N	8S	WN	WS	EN	ES			
E-2	Cofferdams, Cribbs and Sheeting	20	Each	1	1	1	1	1	1	1	1	1	1	1	1	1	1	1	1	1	1	1				
E-2	Unclassified Excavation	17,227	Cu. Yds.	1,395	1419	829	816	975	1,035	802	975	829	916	829	829	776	975	1,150	776	543	610	355	393			
S-1	Class "E" Concrete, Footings	6,098	Cu. Yds.	395.6	395.6	308.0	351.3	395.4	395.4	308.0	395.7	308.0	395.7	308.2	308.0	308.0	395.7	307.9	307.9	125.1	125.1	123.0	140.4			
S-1	Class "E" Concrete, above Footings	5,171	Cu. Yds.	177.7	177.7	259.8	259.8	267.6	267.6	275.3	273.6	285.9	285.9	270.2	270.2	265.1	265.1	184.6	184.6	288.5	170.6	370.6	370.6			
S-4	Reinforcing Steel	1,395,556	Lbs.	78,627	78,627	79,962	75,499	83,018	83,018	81,411	85,231	82,639	86,592	80,941	80,941	80,532	84,485	74,470	74,470	26,237	16,910	27,980	31,968			
S-7	Structural Steel	29,148	Lbs.	1,649	1,649	1,575	1,575	1,617	1,617	1,617	1,622	1,608	1,608	1,608	1,617	1,608	1,608	1,449	1,449	842	847	926	1,057			
S-7	Wrought Iron Ladder Rungs	7,027	Lbs.	280	280	399	399	406	406	413	413	427	427	427	427	413	413	280	280	224	119	294	294			
S-8	Field Painting of Structural Steel 2 Coats		Lump Sum																							
S-9	1/2" Sponge Rubber Expansion Joint Material Sec.M-10.02	716	Sq. Ft.	38.5	38.5	38.5	38.5	38.5	38.5	38.5	38.5	38.5	38.5	38.5	38.5	38.5	38.5	38.5	38.5	25.0	25.0	25.0	25.0			
S-17	First Pile Test Load		Lump sum																							Lump Sum
S-17	Subsequent Pile Test Loads	9	Each																							5
S-18	Steel Bearing Piles (12 BP 53)	4,600	Lin. Ft.																	2,400	2,280					
S-18	14" Cast-in-place Reinforced Concrete Piles	125,591	Lin. Ft.	7,740	7,740	7,290	7,200	8,100	8,100	7,290	7,740	6,885	7,310	6,160	6,480	5,670	6,020	4,860	4,860			1,680	1,920			
S-24	Removal of Existing Structure No.1		Lump sum																					/		
S-24	Removal of Existing Structure No.2		Lump sum																					/		
S-24	Removal of Existing Structure No.3		Lump sum																					/		
S-24	Removal of Existing Structure No.4		Lump sum																					/		
S-24	Removing Existing Concrete Pedestals which Interfere with New Construction		Lump sum																							Lump Sum
S-25	Electrical Grounds		Lump sum																							Lump Sum
S-29	8" Wrought Iron Pipe, Including Specials	1,036	Lin.Ft.	33	33	59	59	59	59	61	61	63	63	61	61	60	60	45	45	39	22	45	48			
I-2	8" Pipe for Storm Sewers	6	Lin.Ft.																						6	
I-2	12" Pipe for Storm Sewers	1,333	Lin.Ft.																						1,333	
I-2	12" Pipe for Storm Sewers under Pavement	251	Lin. Ft.																						251	
I-2	15" Pipe for Storm Sewers	335	Lin. Ft.																						335	
I-2	15" Extra Strength Reinforced Concrete Culvert Pipe Sec. M-6.6 (c) for Storm Sewers	288	Lin.Ft.																						288	
I-2	18" Pipe for Storm Sewers under Pavement	80	Lin.Ft.																						80	
I-2	21" Pipe for Storm Sewers	142	Lin.Ft.																						142	
I-2	24" Pipe for Storm Sewers	932	Lin.Ft.																						932	
I-2	24" Extra Strength Reinforced Concrete Pipe Sec. M-6.6 (c) for Storm Sewers	290	Lin.Ft.																						290	
I-2	24" Pipe for Storm Sewers Under Pavement	116	Lin.Ft.																						116	84
I-2	24" Paved Bituminous Coated Corrugated Metal Pipe, Sec. M-6.4 (d) for Storm Sewers	90	Lin. Ft.																						90	
I-2	27" Paved Bituminous Coated Corrugated Metal Pipe, Sec. M-6.4 (d) for Storm Sewers	80	Lin. Ft.																						80	
I-2	36" Extra Strength Reinforced Concrete Culvert Pipe Sec. M-6.6 (c) for Storm Sewers	30	Lin. Ft.																						30	
I-5	Pipe Special, 12" 35° Wye	1	Each																						1	
I-5	Pipe Specials, 8" to 12" Increaser	16	Each																						16	
I-5	Pipe Specials, 8" to 15" Increaser	2	Each																						2	
I-8	Manholes, Standard No.1	16	Each																						16	
Spec.	Outlet Structure "C"		Lump sum																							
I-8	Alteration to Manhole "A"		Lump sum																							
I-8	Alteration to Manhole "B"		Lump sum																							
I-8	Alteration to Manhole "C"		Lump sum																							
I-8	Alteration to Manhole "D"		Lump sum																							
I-8	Alteration to Manhole "F"		Lump sum																							
Spec.	Outlet Structure "A"		Lump sum																							
Spec.	Outlet Structure "B"		Lump sum																							
I-16	Removal of Manhole "E"		Lump sum																							

SUPPORT FOR ERIE RAILROAD TRACKS

ITEM	DESCRIPTION	TOTAL	UNIT	ITEM	DESCRIPTION	TOTAL	UNIT
E-1 & Spec.	Roadway Excavation	5,940	Cu. Yds.	S-7 & Spec.	Steel sheet piling, including reinforcing plate, steel H anchor piles and steel wales, and timber connection angles, for dock wall	843,000	Pounds
E-4 & Spec.	Borrow	3,000	Cu. Yds.	S-7 & Spec.	Steel anchor rods, turnbuckles, pipe sleeves and fastenings for dock walls (including payment for necessary excavation, sheeting and bracing)	43,000	Pounds
S-1	Class "E" concrete, anchor caps	73	Cu. Yds.	S-13	Cresosoted timber fenders for dock wall, including hardware	2.40	M.B.M.
S-4	Reinforcing steel in anchor caps	7,900	Pounds	Special	Temporary timber crib wall	1,965	Sq. Ft.

PENCIL REVISIONS
 SEPT. 20, 1955

Revised As-Built D.L.M. 12/31/57

PART 2

U. S. ROUTE 42 RELOCATION
 INNER BELT FREEWAY - CENTRAL VIADUCT

QUANTITIES

CLEVELAND CUYAHOGA COUNTY OHIO

SCALE None
 MADE G.A. DATE 6-22-54
 TRCD A.H. DATE 6-22-54
 CKD J.G.S. DATE 7-9-54
 HOWARD, NEEDLES, TAMMEN & BERGENDOFF
 CONSULTING ENGINEERS
 KANSAS CITY CLEVELAND NEW YORK
 914-1A SHEET 1.02

CUYAHOGA COUNTY
CITY OF CLEVELAND
INNER BELT FREEWAY
CENTRAL VIADUCT

CUY-42R-17.50

Plans for sheeting and bracing to be used in cofferdams adjacent to railroad tracks and in trenches for sewers placed under railroad tracks shall be submitted to the Director of Highways for approval by the Department of Highways and by the Railroad Company. The contractor must obtain such approval before work is begun.

Cofferdams, cribs and sheeting shall be paid for per unit of cofferdam per pier shaft, with all work to be done according to Item E-2. Any cofferdams, cribs and sheeting associated with the construction reconstruction and removal of parts of the sewer system, and the removal of existing structures, shall be considered as paid for in the prices bid for such construction and removal.

29. SHEET PILE DOCKWALL

The proposed 200 foot dockwall section in the vicinity of Pier 1 requires that structure #1 be removed before construction can be completed. The proposed dockwall shall consist of a front wall and anchor piles connected with tie rods. The front wall is located with the face of the timber fenders at the established dock line.

The existing 3 inch high pressure gas line will be raised or lowered as required by the utility company.

The cost of any excavation, sheeting and bracing incidental to the installation of the dockwall items shall be included in the price bid for the respective items.

The sheet piling shall be U. S. Steel section WZ-38 or Bethlehem section ZP-38 or approved equivalent. Fabricated connections shall be of size and strength to correspond with the rolled members. The fabricated members may be built up by either welding or riveting. Steel for sheet piling shall be in accordance with Sec. M-7.4(c).

The driving of a sheet pile, if directed by the Engineer, shall be stopped before the top of the pile reaches the required elevation, to permit cutting off of metal that is deformed due to driving. Such cutting shall be neatly done to a straight line. Defective piles shall be removed and replaced. A pile shall be considered defective if injured to an extent that would reduce the strength of its section more than 20 percent.

The penetration of the sheet piles shall be such as to reach the elevations shown unless obstructions are encountered. In case obstructions, such as boulders or large stones, prevent the penetration of a sheet pile at least to Elev. 537.0, such obstructions shall be removed.

The vertical steel H anchor piles shall be I2 BP 53 except where otherwise shown on the plans and the battered pile I4 BP 73. The vertical piles shall be driven to a capacity of 40 tons and the battered piles to a capacity of 60 tons. The pile driving shall be governed by Item S-18.

The sheet piling will be paid for at the contract unit price per pound bid. The number of pounds paid for shall be the actual weight of piling in place and accepted, plus an allowance for cut-off. In determining the weight to be paid for, the length of each sheet pile (and special section) shall be considered the length below the specified top of sheeting plus the length of cut-off but not to exceed 6 inches of cut-off. Payment for the quantity determined as described above shall constitute full compensation for furnishing, fabricating, driving, cutting-off and connecting all steel sheet piling and special sections required, and for removal of obstructions.

The steel H piling shall be paid for at the contract unit price per pound bid. The number of pounds paid for shall be the actual weight of the number of feet of piling in place plus the length of cut-off but not to exceed 2 feet of cut-off per pile.

Class "E" concrete shall be paid for at the contract unit price bid per cubic yard for Item "S-1, Class "E" concrete, anchor caps."

Payment for reinforcing steel will be made per contract unit price bid per pound, for Item "S-4, Reinforcing Steel in Anchor Caps."

Payment will be made for dockwall at the contract unit price bid per pound for Item "S-7 and Special, Steel Sheet Piling, Steel H Anchor Piles and Steel Walls, for dockwall."

Payment shall be made for anchor rods, turnbuckles, etc., at the contract unit price bid per pound for Item "S-7 and Special, Steel Anchor Rods, Turnbuckles, Pipe Sleeves and fastenings for dockwall (including payment for necessary excavation, sheeting and bracing)."

Payment shall be made for the timber fenders for the dockwall at the contract unit price bid per MBM for Item "S-13, Cresosoted Timber Fenders for Dockwall including hardware."

30. ERIE RAILROAD TRACK WORK

The Erie Railroad Company shall furnish and place ballast and accomplish all track work upon the completed subgrades constructed by the contractor.

The several phases of work by the contractor and the railroad company will require close cooperation and coordination. The contractor shall notify the railroad company sufficiently in advance of all track moves so that traffic and work schedule interruptions will be held to a minimum.

The contract unit price bid for Item "Special Temporary Timber Crib Wall" per square foot shall be complete compensation for furnishing, installing and maintaining a temporary crib-wall and embankment to the elevations and grades shown on the plans for the period of time necessary and the subsequent removal thereof upon completion of the construction phase of which they are a part. Any track ballast remaining after any track shift and not reclaimed by the railroad shall be considered part of the temporary fill and removed from the site or deposited in permanent fill areas by the contractor. The basis of measurement shall be the number of square feet of surface on the face of the crib wall. The height shall be measured along the battered face of the wall. Any excavation and subsequent backfilling necessary in the course of the track shifts shall be considered as incidental to the performance of this pay item and the contract unit price bid shall include payment therefor.

31. PILING (Continued)

REVISIONS ANNOUNCED OCT. 6, 1954, MADE DEC. 6, 1954

It will be the Contractor's responsibility to provide a shell or casing, for the cast-in-place reinforced concrete piles, of adequate wall thickness, but this thickness shall be not less than No. 7 gauge if the casings are driven without a mandrel.

No "Item S-16, First Test Pile" is provided in the quantities. The first test pile of each type, together with all labor, material, equipment and incidentals therefor, will be paid for per linear foot under the pertinent "S-18" item or per pound under the pertinent "S-7 and Special" item. Continued on Sheet 2.

U. S. ROUTE 42 RELOCATION
INNER BELT FREEWAY - CENTRAL VIADUCT

GENERAL NOTES

CLEVELAND CUYAHOGA COUNTY OHIO

SCALE: MADE G.B. DATE 8-28-54
TRCD J.B. DATE 2-2-54
CKD. C.J.C. DATE 7-8-54

HOWARD, NEEDLES, TAMMEN & BERGENDOFF
CONSULTING ENGINEERS.
KANSAS CITY CLEVELAND NEW YORK

914-1A SHEET: 1.03

REV 9-24-54

1. DESIGN SPECIFICATIONS

"Design Specifications for Highway Structures". State of Ohio Department of Highways dated October, 1951 revised July 15, 1952 and April 1, 1954 (with a load frequency rating of CF 1200-SI) are used in the design of this project.

2. CONSTRUCTION SPECIFICATIONS

"Construction and Material Specification". State of Ohio, Department of Highways, dated January 1, 1953, as modified by notes on the plans and in the proposal, shall govern.

3. SCOPE OF CONTRACT

Work scheduled in this contract consists of the construction of two end piers, piers 1 through 8, the construction of storm sewers, a 200' dockwall section, railroad roadbed grading, the removal of certain fenders and two existing piers from the river, and removal of some of the masonry pedestals of the former Central Viaduct. The steel superstructure of the former Central Viaduct has been removed but the masonry substructure remains in place. All track work will be handled by railroad forces. Railroad grading and cribwall construction in the vicinity of Pier 1 will be done by the contractor.

4. MINIMUM TEMPORARY CONSTRUCTION CLEARANCE FOR RAILROAD TRACKS

The minimum temporary construction clearance for railroad tracks shall be 2' - 0" vertically above top of rail and 8' - 0" horizontally from the centerline of the nearest track.

5. REOPENING OF STREETS

When any street is closed to traffic, and not then permanently closed, work on that particular street shall be prosecuted to the fullest to allow for its reopening as soon as possible. Existing streets adjacent to the project shall remain open as long as possible.

6. FIELD OFFICE

The contractor shall provide a suitable field office in accordance with sec. S-0.0(b) having a minimum of 300 sq. ft. of floor space. The contractor shall have a telephone installed and maintained for the duration of the contract.

7. WORK BY THE CITY - OF CLEVELAND

Within the corporate limits of the city of Cleveland the city will perform any pavement repair due to sewer construction and will seal and fill (by mud jack) the existing sewers that are to be abandoned.

The city will also wreck and remove certain existing buildings within the limits of the easement lines. The city will wreck the buildings to the ground line or tops of foundations near the ground surface, or to the top of the existing cellar foundations and remove all the resulting debris.

8. RAILROAD TRAFFIC

Portions of this project shall be constructed under traffic, and the contractor, to the satisfaction of the engineer, shall plan and conduct his operations so that traffic shall be maintained as herein specified.

At piers 1, 3, 4 and 5 construction operations will interfere with traffic on existing railroad tracks. The tracks will, in some cases, be relocated by the owners, and in other cases will be removed. Temporary trestles may be constructed to span across footing excavations, and the contractor shall coordinate his construction operations so as to interfere the least possible amount with train movements. Flagmen and watchmen shall be supplied as required by the railroads, at the expense of the contractor.

9. BLASTING

Where blasting is necessary, the contractor will be required to take all necessary precautions to protect the work already completed and the adjacent property and he shall be responsible for any and all damage to the work or to adjacent property and injury to persons.

10. BORINGS

The log of each of the test hole borings is shown on these plans.

11. PILING (See also No. 31 on this sheet and No. 32 on Sheet 2.)

The piles in the west end pier shall be I2BP53 steel bearing piles, and in Piers 1 through 8 and in the east end pier I4" cast-in-place reinforced concrete piles.

Preliminary test piles were driven at this site and loaded. A copy of the report on this test pile project may be inspected by bidders in the Division Office of the Department of Highways at Cleveland or in the Bureau of Bridges at Columbus. Copies of this report will be made available to the Contractor for this substructure project and to the engineering personnel, and should be consulted as a guide in the driving of the piles.

A first pile test load shall be applied where directed by the engineer. Subsequent test loads shall be applied if and where directed by the Engineer. The Engineer may direct a subsequent load to be applied on the same pile as a previous load or on another pile in the same footing or in a different footing. The maximum amount of load required shall be equal to 3R unless the "yield point" is reached at a lesser tonnage. The purpose of this test-loading (in addition to that done in the preliminary test pile project) is to calibrate the capacity formula and determine the required number of blows per foot for the actual driving conditions which exist during construction (with respect to the type and size of hammer and the type, section and driven length of the pile) and/or to calibrate the formula for some locations which were not checked in the preliminary test pile project.

The nominal design capacity is 65 tons. The capacity formula shall be adjusted (according to test loading indications) to determine the number of blows per foot required to provide an "R" of 65 tons (that is, a "yield point" of 130 tons). After this rate of blows per foot has been attained, driving shall be continued to cause each pile to penetrate to an average penetration of 15 feet per pile beyond the greatest length of penetration at which the rate of blows per foot for an R of 65 tons has been observed. However, this additional driving (beyond 65 tons) shall be stopped if damage to a pile becomes apparent. The total penetration per pile at the west end pier shall be not less than 60 feet, and at Piers 1 thru 8 and at the east end pier not less than 40 feet.

The hammer used shall have an energy rating of not less than 15,000 ft-lb, and the type and size of hammer used when the required length of penetration to provide an R of 65 tons is being attained shall be the same as used in the driving of the pertinent test-loaded pile.

The average length of the piles is estimated as follows: West End Pier, 60 feet; Pier 1, 90 feet; Pier 2, 90 feet; Pier 3, 90 feet; Pier 4, 90 feet; Pier 5, 65 feet; Pier 6, 80 feet; Pier 7, 70 feet; Pier 8, 60 feet; and East End Pier, 40 feet.

12. DISPOSAL OF SURPLUS EXCAVATION

The contractor shall be responsible for the disposal of any surplus excavation outside the limits of the right-of-way at his own expense.

13. UTILITIES

Except as hereinafter provided any utility facilities encountered at the site of the work which will interfere with the construction of the substructure units included in this contract will be removed or relocated by others. The contractor shall coordinate his operations with the work of the utility owners, or others who may be making the re-

locations, and shall notify the owners of the utilities of his schedule sufficiently in advance to permit them to make the necessary alterations.

14. INTERFERENCES WITH CONSTRUCTION

VICINITY OF WEST END PIER

University Road near the west end pier will be temporarily closed to traffic. No utilities are known to exist which would interfere with pier construction.

VICINITY OF PIER 1

Pier 1 is located in the Erie Railroad yards southwest of the Cuyahoga River. Track relocation will be coordinated by the railroad company and the contractor during sewer, dockwall, roadbed and pier construction. See Note 30.

VICINITY OF PIER 2

The concrete drain trough from the wash stalls of the Goff-Kirby Ready-Mix Plant is to be reconstructed by the owners to clear the pier shafts.

Existing concrete pedestals of the old Central Viaduct which fall within the limits of footing 2N are to be removed by the Contractor before Pier 2N can be built.

VICINITY OF PIER 3

C.C.C. & St. L. Tracks will be relocated by the owners until the pier is completed. Truck wash stalls will be removed by the owner and rebuilt after pier construction is completed. One existing concrete pedestal of the old Central Viaduct must be removed by the contractor before Pier 3 can be built.

VICINITY OF PIER 4

One existing pedestal of the old Central Viaduct must be removed by the Contractor before Pier 4N can be built. One track of the C.C.C. & St. L. will be relocated by the owners prior to the beginning of construction.

VICINITY OF PIER 5

C.C.C. & St. L. tracks will be temporarily relocated by the Railroad Co. prior to the beginning of construction, at the site of Pier 5S. A temporary trestle will be constructed by the Railroad Co. to bridge the C.C.C. & St. L. track over the corner of the excavation for Pier 5N. This work will be done prior to beginning construction at this site. The contractor's operations in excavating and pile driving must be coordinated with train movements on the C.C.C. & St. L. Track. Two existing pedestals of the old Central Viaduct must be removed by the contractor before Pier 5N can be built. The railroad company as shown on Sheet 1.

VICINITY OF PIER 6

One concrete pedestal of the old Central Viaduct must be removed by the contractor prior to beginning construction of Pier 6N. Pier 6S will be built on the site of a two story brick building owned by the United Garage and Service Corporation. The building will be removed by the City to the floor level. There is no basement but has a concrete floor with a lower level on the west side, roughly 15 ft by 40 ft, about 4 ft below the ground level. Two 10,000 gallon tanks and one 2,000 gallon tank are located below the floor and encased in concrete. The amount of encasement is not known. Plans for this structure are available for review by bidders at the Division Office of the Department of Highways at Cleveland, Ohio.

VICINITY OF PIER 7

An existing one story brick and frame building with a concrete floor at the site of Pier 7N will be removed by the City prior to the beginning of construction. Foundations and floor of this building shall be removed by the contractor and payment therefor will be made under Item E-2, Unclassified Excavation. Manhole No. "E" in West 3rd Street and the existing 18" brick sewer shall be removed and rebuilt by the Contractor as shown.

VICINITY OF PIER 8

One and two story brick buildings interfering with the construction of Pier 8 will be removed by the city prior to beginning construction. Foundations are sandstone blocks about 18 inches thick. Basements and stacks are at one level about 8 feet below ground on the 18" side and on the same level as the ground on the south side. Foundations and street side and on the same level as the ground on the south side. Foundations and any other underground constructions connected with the buildings shall be removed by the contractor as Item E-2, Unclassified Excavation. 4-inch and 8-inch gas lines crossing the location of Pier 8S will be removed by the owners when so notified by the contractor.

VICINITY OF EAST END PIER

No attempt will be made to salvage materials of an existing 12" sewer line crossing the location of the north footing. This sewer will be abandoned and a by-pass constructed as described elsewhere. No other utilities are known to interfere with pier construction.

15. REMOVAL OF ABANDONED PIERS AND PEDESTALS OF FORMER CENTRAL VIADUCT

Seven masonry pedestals of the former Central Viaduct interfere with construction of piers 2N, 3N, 4N, 5N and 6N. They shall be removed to at least one foot below the surface of the ground. Payment therefor will be made as a lump sum, Item S-24, Removing Existing Concrete Pedestals which Interfere with New Construction. Removal of that portion of the pedestals below a point one foot below the surface of the ground shall be included in the unit price bid for Item E-2, Unclassified Excavation, for the respective pier footings.

Two piers of the former Central Viaduct in the Cuyahoga River are partially within the limits of the established dock lines. Plans for these piers are shown on Sheet 9. All portions of the pier walls shall be removed down to Elevation 576.0 and all masonry, concrete, timber, steel and piling shall be removed riverward of the established dock lines to Elevation 540.5. Also, piles below this elevation shall be extracted except portions which break off in extracting. Payment for the removal of Structure No. 1 shall be Item S-24, Removal of Existing Structure No. 1 and payment for the removal of Structure No. 2 shall be Item S-24, Removal of Existing Structure No. 2.

16. REMOVAL OF EXISTING FENDERS

Steel pile fenders (Structures Nos. 3 and 4) are to be removed from the Cuyahoga River to Elev. 540.5. Construction plans for these fenders are available. Payment for the removal of these fenders shall be the lump sum bid price for Item S-24, Removal of Existing Structure No. 3, and Item S-24, Removal of Existing Structure No. 4.

17. BRIDGE DRAINAGE AND STORM SEWER SYSTEM

Roadway drainage will be conducted thru pipes and flumes to the tops of the piers by others, in a subsequent contract. The Contractor will place wrought iron pipes within the pier shafts extending to points below the ground surface where horizontal wrought iron pipes extend thru and 1'-0" outside the pier shaft walls. Connection of these drainage pipes is made thru sewer pipe increasers to the storm sewer laterals. At the west end pier, a lateral from the SW End Pier Shaft connects to and the NW End Pier drainage empties through a short section of 8" sewer pipe into new manhole No. 13 near the north shaft. A new sewer extends and connects to existing manhole "A". At Pier 1, laterals will be connected to an existing manhole "B". A 12" Y pipe special will connect both laterals to a single drop pipe. Manholes "A" and "B" are on an existing No. 7 brick sewer running approximately parallel to the bridge center line and emptying into the Cuyahoga River. On this sewer line, about Sta. 18+76, existing manhole "C" shall be removed to elev. 585.0 and the opening covered with a 10" thick concrete slab. Eastward to the Cuyahoga River, the existing 12" cast iron sewer line shall be replaced by a 36" reinforced concrete pipe and outfall structure "C". A new storm sewer nearly parallel to the bridge center line from East bank of the Cuyahoga River to Pier 5, laterals extend from each pier shaft to manholes Nos. 1, 2, 3 and 4 on the new sewer line near Piers 2, 3, 4 and 5 respectively.

Laterals from each shaft of Pier 8 connect into a new manhole No. 6 about Sta. 39+75, on a 15" sewer line from manhole No. 5 in Third Street, about Sta. 36+95. Laterals from the shafts of Pier 7 also connect to manhole No. 5. The existing 18" brick sewer is to be removed and de-auxed around Pier 7 North footing. Existing manhole "E" is to be abandoned. A new storm sewer shall be built on Third Street, from manhole No. 5 Southeast to the Cuyahoga River. A lateral from the north shaft of Pier No. 6 runs to new manhole No. 12 into which the south shaft drainage empties through a short section of 8" sewer pipe. A new 12" sewer connects new manhole No. 12 to new manhole No. 8 in Harrison Street, (about Sta. 35+00). A new 12" sewer shall be built connecting manhole No. 8 with manhole No. 9 on the new Third Street sewer line.

On Third Street, at the north side of Stones Levee, manhole No. 16 shall be built on the new Third Street sewer line, and connection made to the existing catch basin at the N. E. corner of the street intersection, using the existing material. See Sheet 36.

At the east end pier, laterals from the pier shafts connect into new manhole No. 7 at Sta. 43+00. A 12" sewer shall be built from manhole No. 7 to the existing manhole "D" on an existing No. 4 sewer in Commercial Road.

The Contractor shall build manholes No. 14 and No. 15 with the connecting sewer lines, near the east end Pier, to reroute an existing 12 inch sewer around the location of the north pier footing. See Sheet 36.

All wrought iron drainage pipes inside the piers, with couplings and specials, shall be standard weight and conform to Section M-6.10, "Welded Wrought Iron Pipe." ASTM designation A72. Joints may be threaded, welded, or have bolted flanges, or have any combination thereof.

The proposed elevations and locations of catch basins, manholes, and sewer pipes, and the estimated lengths of pipes may be adjusted by the Engineer during construction, as per Section 1-2.03.

Payment for the above drainage and storm sewer system will be made as follows: For the wrought iron pipes from the top of pier shafts to the connection to sewer laterals below ground, a unit price per linear foot for "Item S-29, 8" Wrought Iron Pipe, Including Specials." For the laterals and pipes of the drainage system from the pier shafts to the manholes or outlet structures at the Cuyahoga River, a unit price per linear foot for "Item 1-2, (size) inch pipe for Storm Sewers", (with a separate bid price for each size listed); "Item 1-2 (size) inch Pipe for Storm Sewers under Pavement"; "Item 1-2, (size) inch Extra Strength Reinforced Concrete Culvert Pipe, Sec. M-6.6(c) for Storm Sewers"; "Item 1-2 (size) inch Paved Invert Corrugated Metal Pipe, Sec. M-6.4(d) for Storm Sewers"; "Item 1-8 Each, Standard No. 1 Manholes"; Lump Sum, Alteration to Manhole "A", "B", "D", or "F"; Lump sum, "Outlet Structure "A", "B", or "C"; "Item 1-5 Pipe Specials", (description). The specials shall conform to the same strength class as the adjoining sewer. For payment purposes, each special shall be considered as having a length of 3 feet.

18. EXISTING PIPE AND UTILITIES

The location, size and depth of all existing pipe and utility appurtenances represent the best information obtainable at the time of survey, but the State of Ohio does not guarantee the correctness thereof.

19. CONCRETE

Concrete shall be Class "E".

At least 15 days before concrete form construction is begun, the contractor shall submit to the Engineer for approval by the Director, a plan showing where he proposes to place construction joints and showing the extent and sequence of individual pours. The concrete shall be placed in one continuous operation between the construction joints that have been proposed and approved. Construction joints shall be so located and arranged as to least impair the strength and appearance of the concrete, and to reduce shrinkage stresses to a minimum.

The concrete in shoe seat areas shall be finished 1/8 inch to 1/4 inch high and ground down to the elevations shown.

20. BAR CLEARANCES

The clearance between reinforcing bars and the surface of the concrete shall be 3 inches for the footing bars and 2 inches for the horizontal bars in the pier shafts.

21. REINFORCING BAR SIZE

The first digit in the bar mark if there are three digits, and the first two if there are four, indicates the bar size number.

22. MISCELLANEOUS METAL

Anchor bolts, nuts, washers, anchor bolt frames, doors, door frames, hand hold pipes in door openings and all fasteners for wrought iron pipes within the pier shafts, shall be structural carbon steel, ASTM-A7. Payment will be made by the pound on the computed weight in pounds as bid for Item S-7, Structural Steel.

The ladder rungs shall be wrought iron and will be paid for at the price per pound bid for Item S-7, Wrought Iron Ladder Rungs.

23. WELDING

All welding shall be class "A". - See section S-7.22.

24. DIMENSIONS

Dimensions given are measured horizontally and at 60° F.

25. DATUM PLANE FOR ELEVATIONS (See I.O.C. 11/26/54 H.R. Craig)

All elevations pertaining to the dock walls are shown in feet above mean tide at New York. All other elevations are regional geodetic survey datum. Elevation 570.50 above mean tide at New York City equals elevation 570.07 Cleveland regional geodetic survey datum.

26. MAINTAINING AND SAFEGUARDING TRAFFIC



The contractor shall provide for the maintaining and safeguarding of traffic on all of the streets and drives immediately beyond the ends of this project and within the limits of this project, that are affected by his operations, in accordance with the provisions of Sec. G-7.07 and Sec. G-4.05. Payment therefor will be made in the lump sum price bid for "Maintaining and safeguarding traffic, including lights, signs, barricades and watchmen".

27. ELECTRICAL GROUNDS

A solid No. 6 bare copper wire electrical ground shall be embedded in the concrete of all pier shafts. The wire shall be brazed to a concrete pile casing or a steel H pile at its lower end, and its upper end shall extend sufficiently above the top of the concrete to provide for a suitable splice and extension for connection, by the contractor for the superstructure. Payment therefor will be made at the lump sum price bid for "Item S-25, Electrical Grounds."

28. COFFERDAMS, CRIBS AND SHEETING

CUYAHOGA COUNTY
CITY OF CLEVELAND
INNER BELT FREEWAY
CENTRAL VIADUCT
BR. NO. CU-42R-175

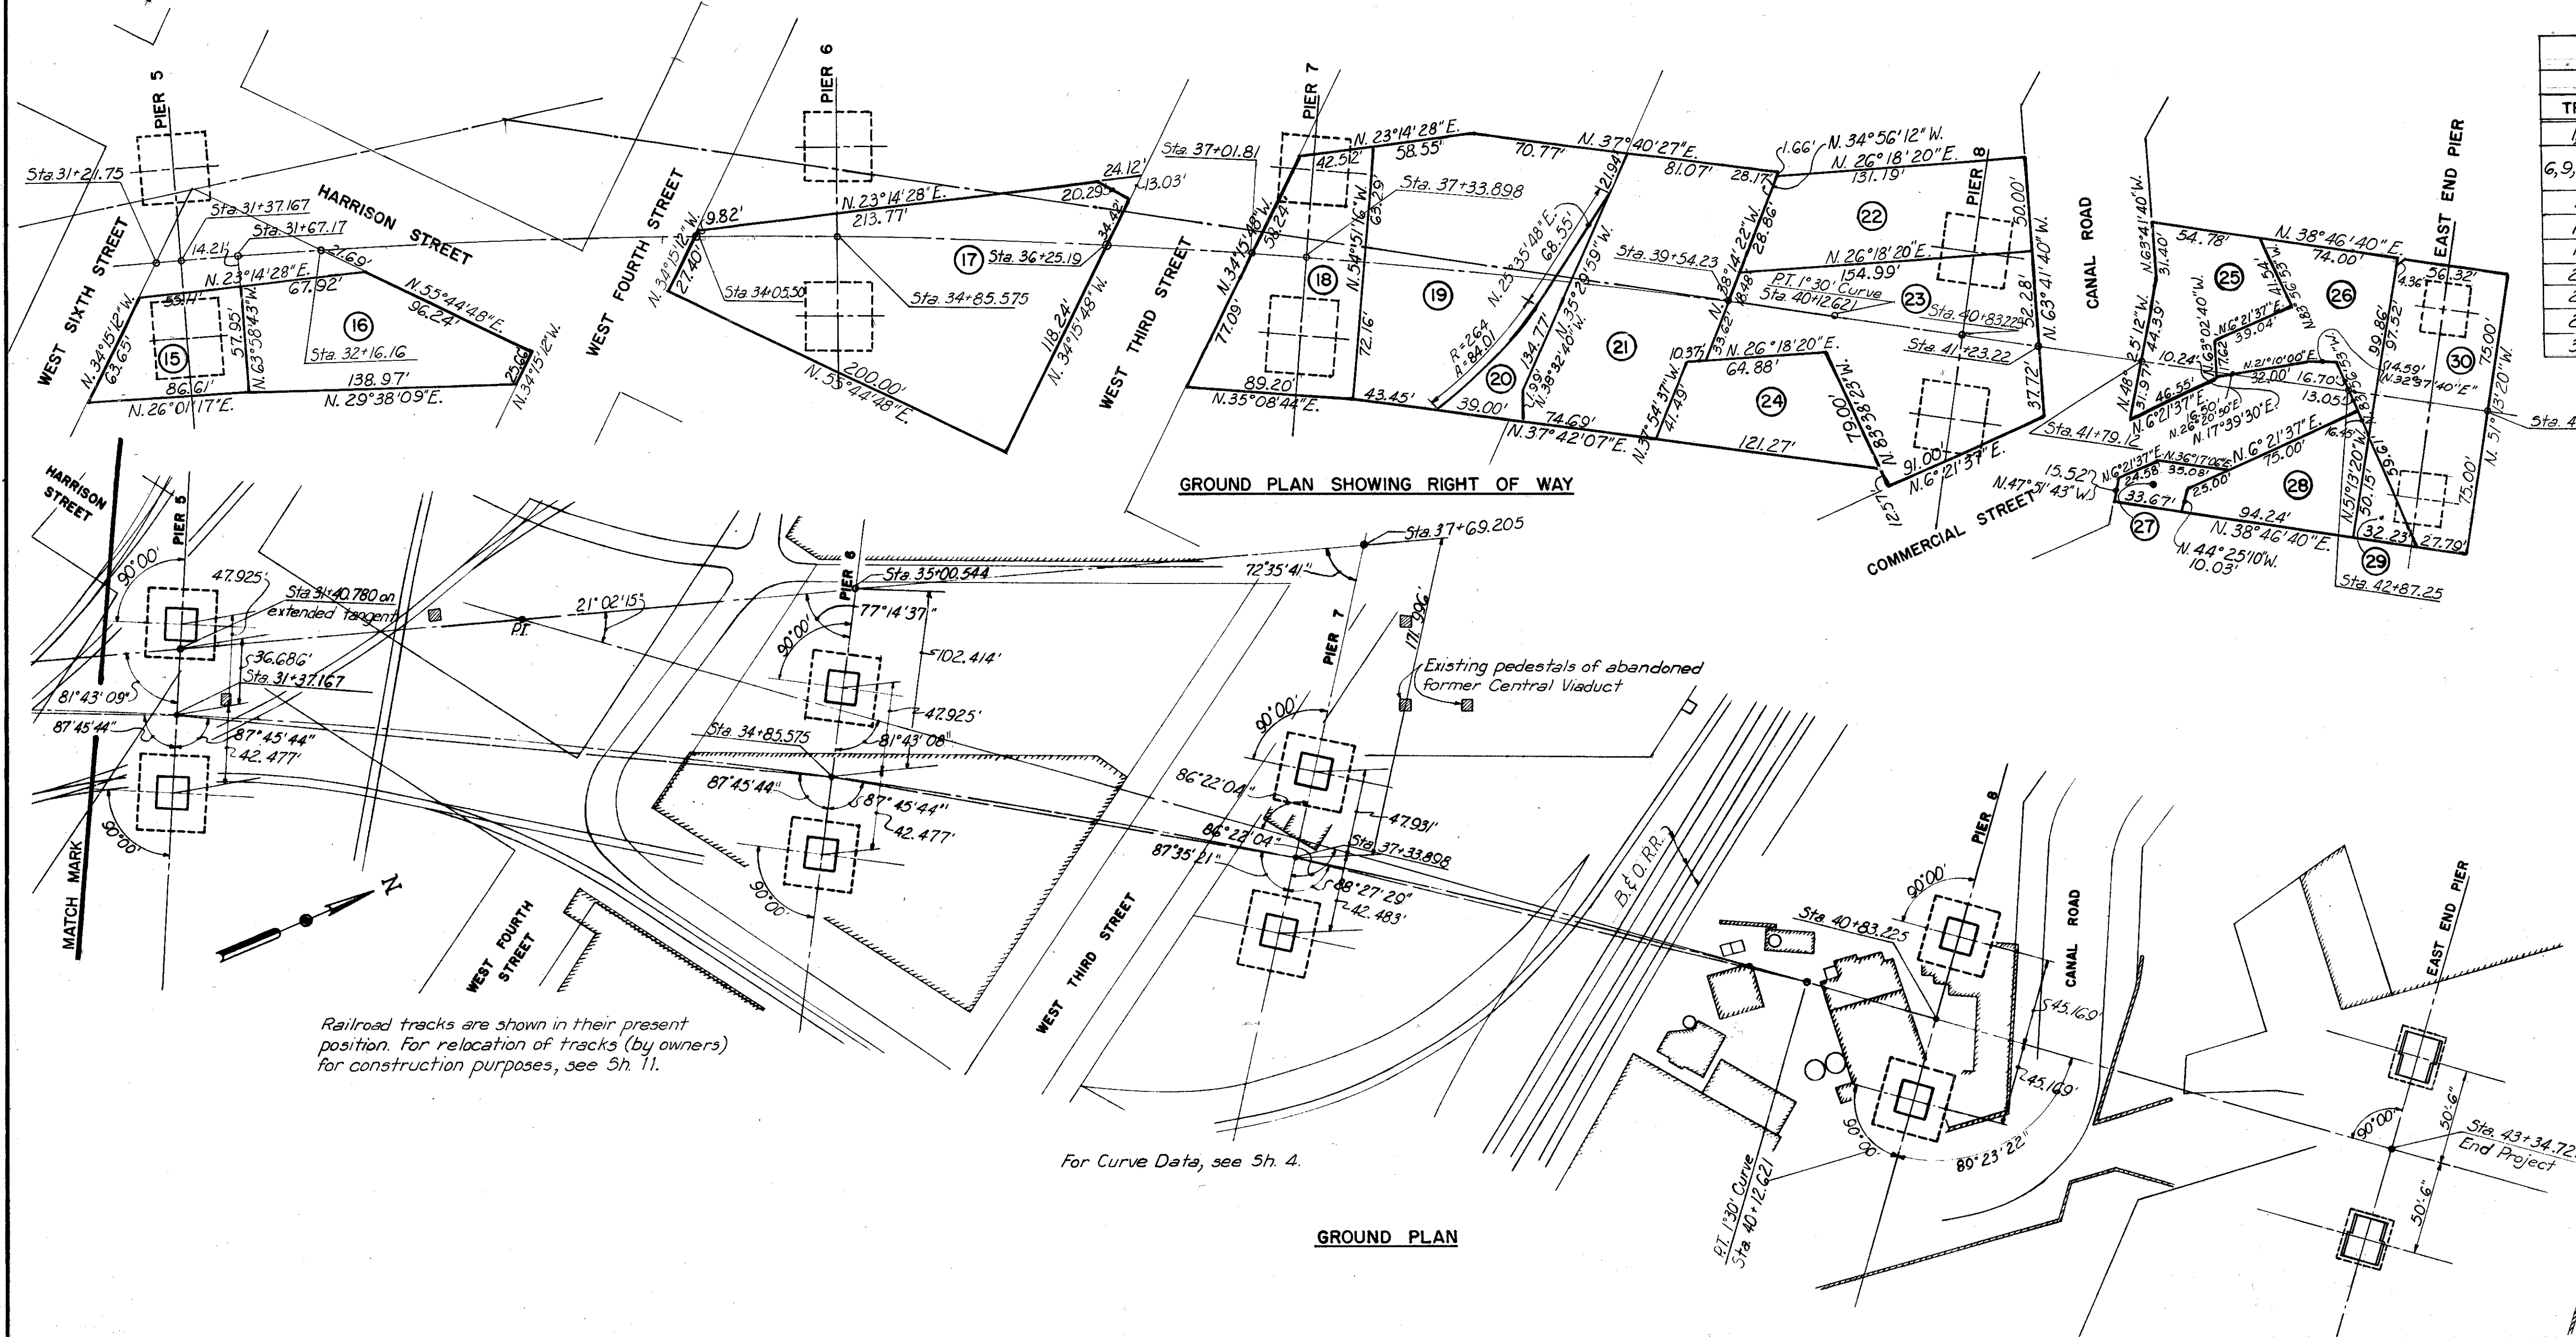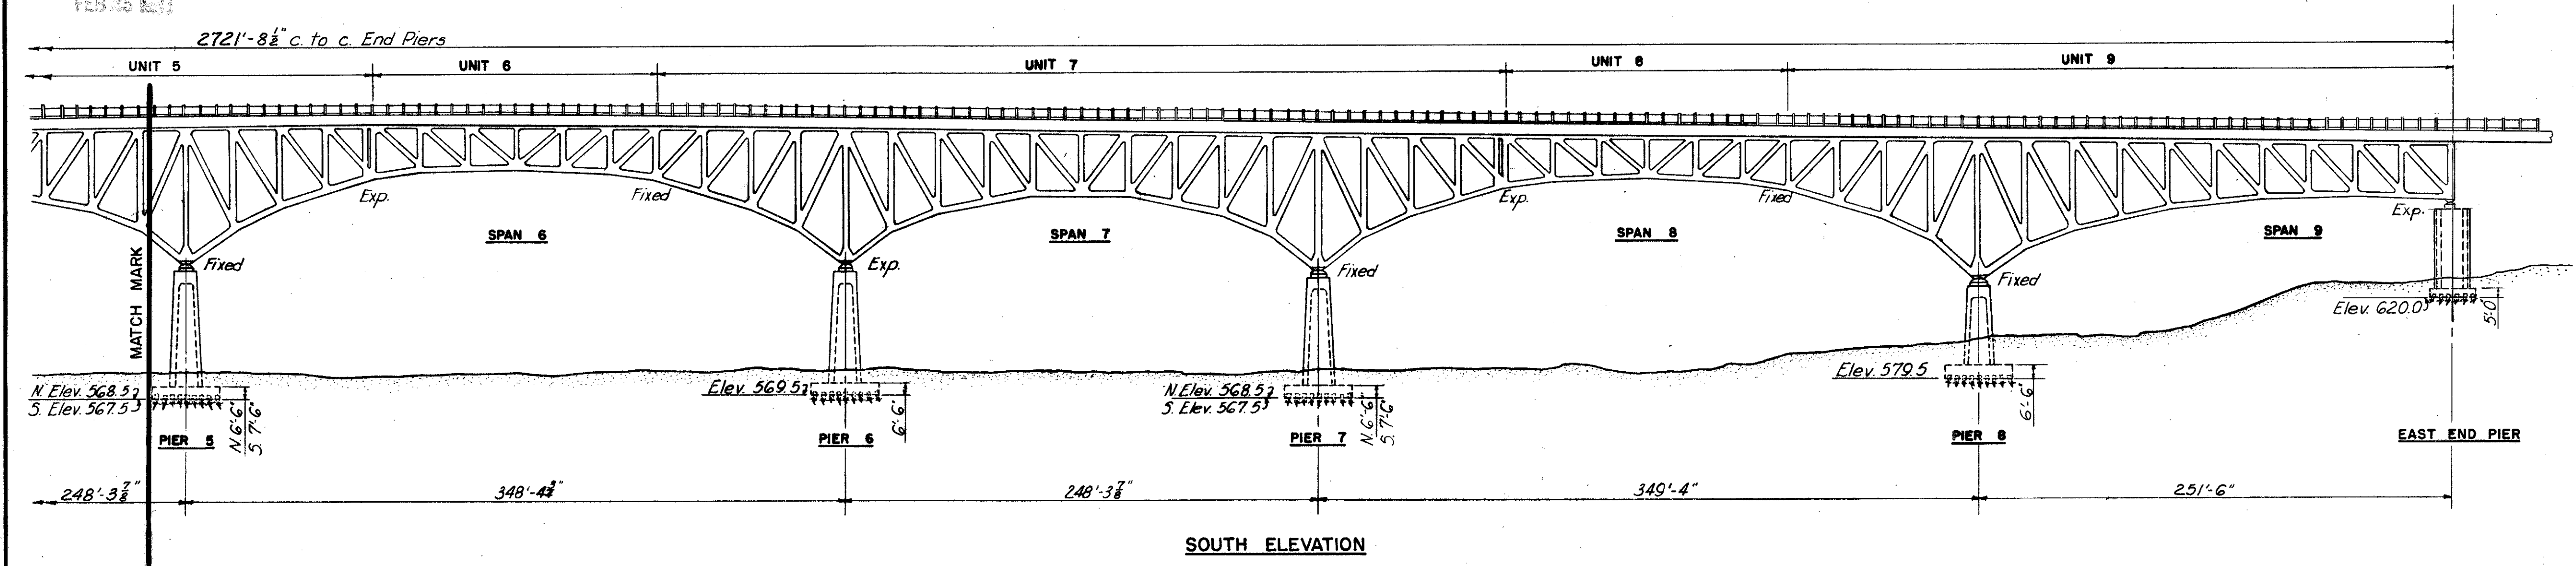

RIGHT OF WAY ACQUISITION REQUIREMENTS			
PERMANENT ACQUISITION		AERIAL RIGHTS ONLY	
TRACT	OWNER	TRACT	OWNER
1, 3	Erie Railroad	2, 4	Erie Railroad
6, 9, 13, 15	C.C.C. & St. L. Railroad	5, 7, 8, 11, 12, 14, 16, 20	C.C.C. & St. L. Railroad
10	C.C.C. & St. L. Railroad	19, 21	B. & O. Railroad
17	United Garage & Service Corp.	24	Sidney C. Brant
18	B. & O. Railroad	25	W. & L. E. Railroad
22	Cleveland Trust Co.	26	Helen C. Lincoln
23	Mildred L. Richards	27	Wilson Terminals, Inc.
29	Louis J. Kaplan	28	Louis J. Kaplan
30	Helen C. Lincoln		

- Work included in this contract:
- Two end piers
 - Piers 1 to 8 inclusive
 - Complete drainage and sewer system
 - Removal of existing structures 1, 2, 3, and 4 from the Cuyahoga River
 - Removal of 7 pedestals of former Central Viaduct
 - Track modifications (force account by railroads)

PART 2

U. S. ROUTE 42 RELOCATION

INNER BELT FREEWAY - CENTRAL VIADUCT

GENERAL PLAN AND ELEVATION

STA. 30+95.00 TO STA. 43+34.725

CLEVELAND CUYAHOGA COUNTY OHIO

SCALE 1"=30'-0"

MADE/DATE 1-10-54

TRCD/DATE 6-12-54

CKD/DATE 7-8-54

HOWARD, NEEDLES, TAMMEN & BERGENDOFF

CONSULTING ENGINEERS

KANSAS CITY CLEVELAND NEW YORK


914-1A SHEET-1.05

RECEIVED
FEB 25 1955

FED. ROAD DIV. NO.	STATE	FEDERAL AID PROJECT NO.	TYPE FUNDS
2	OHIO	UI 1057 (4)	

6
43

CUYAHOGA COUNTY
CITY OF CLEVELAND
INNER BELT FREEWAY
CENTRAL VIADUCT
CUY - 42 R - 17.50

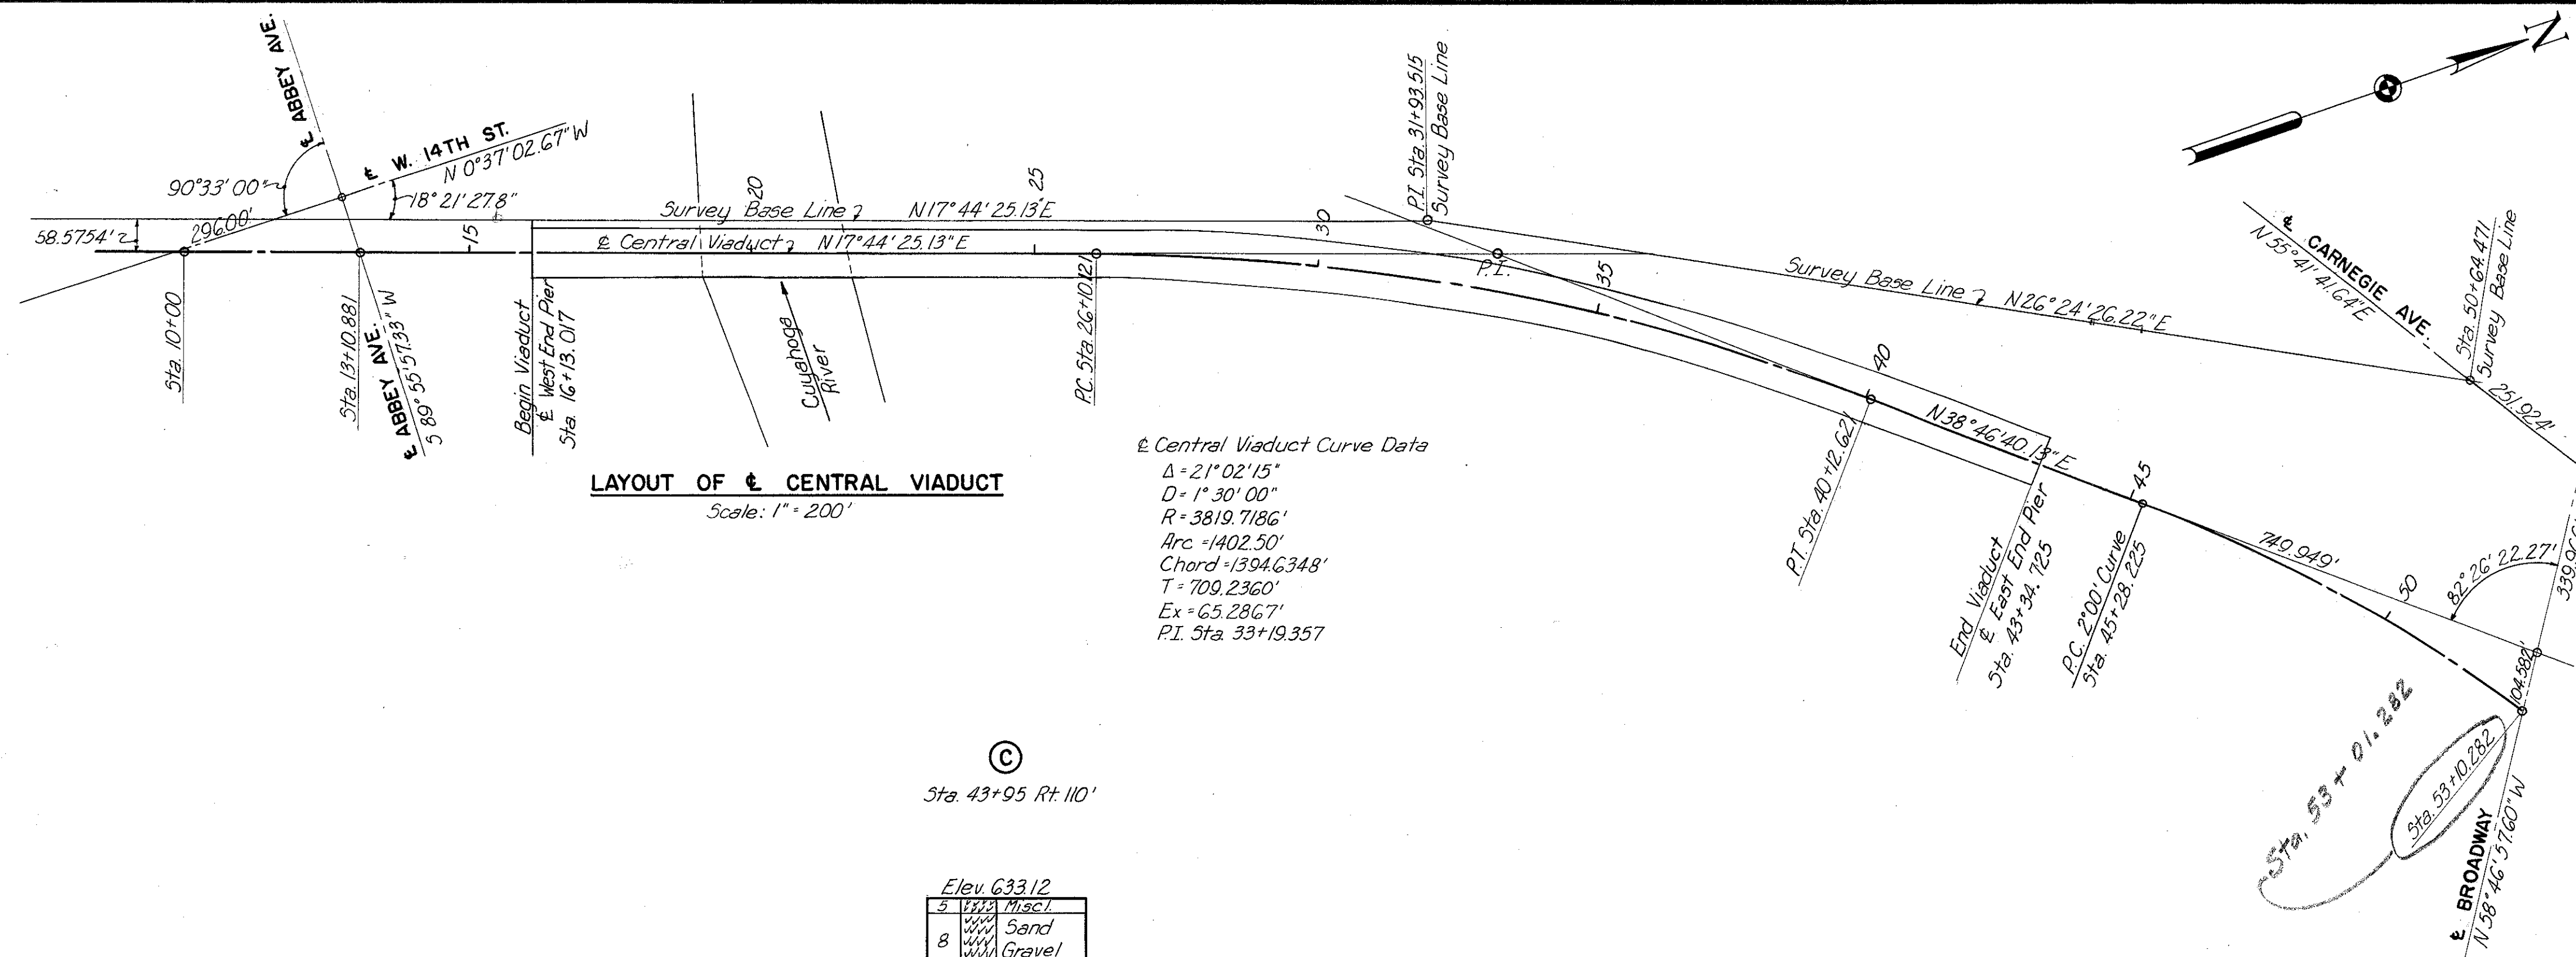


LAYOUT OF CENTRAL VIADUCT

Scale: 1\"/>


Central Viaduct Curve Data

Δ = 21° 02' 15\"/>
D = 1° 30' 00\"/>
R = 3819.7186'
Arc = 1402.50'
Chord = 1394.6348'
T = 709.2360'
Ex = 65.2867'
P.I. Sta. 33+19.357

Sta. 29+53 Rt. 265

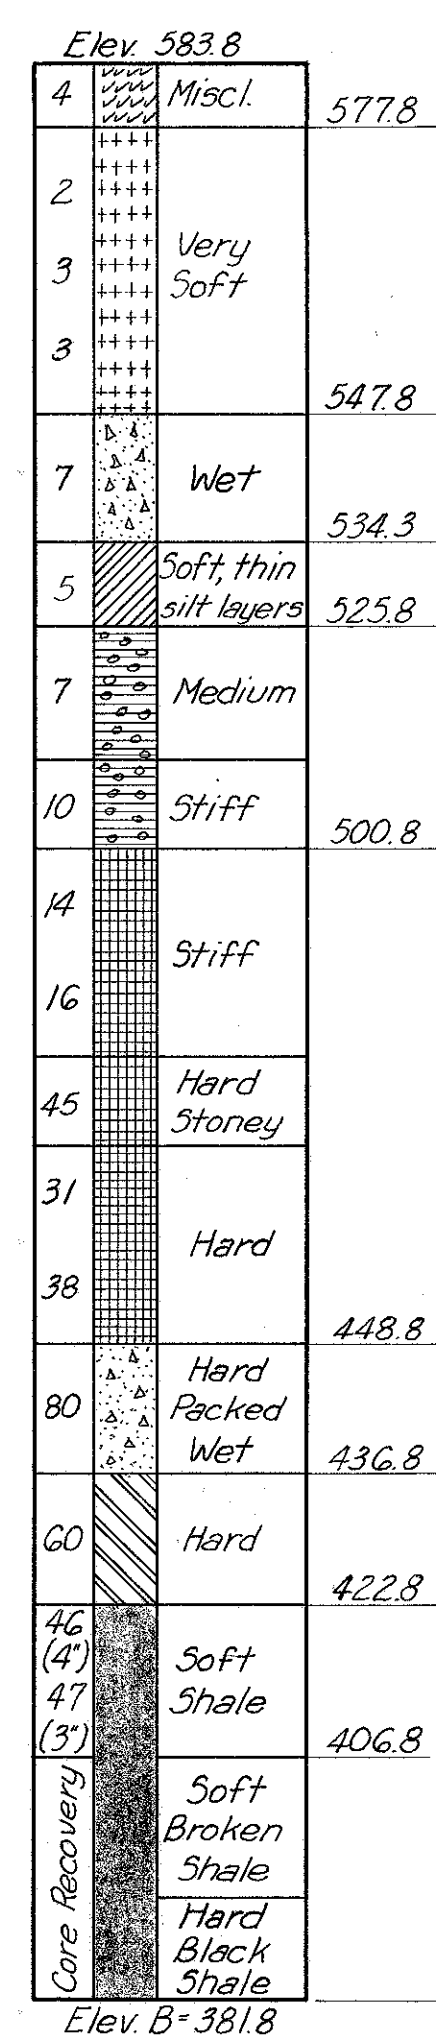


Sta. 37+10 Rt. 205'

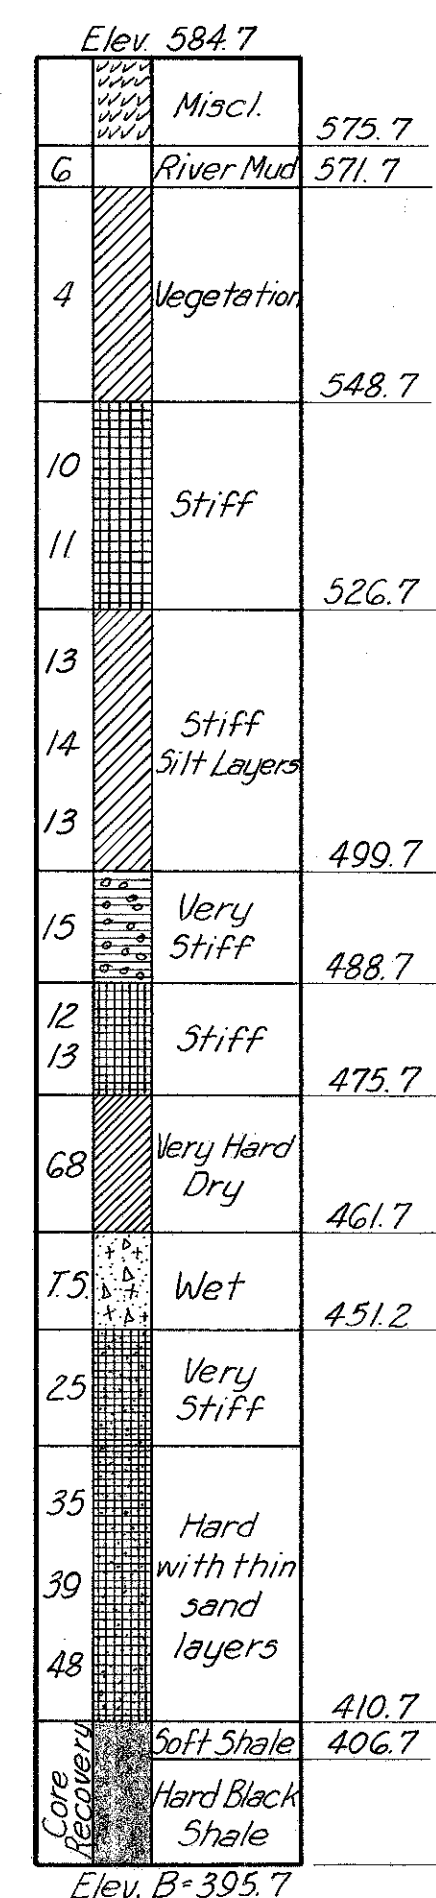

TEST HOLE BORINGS A, B AND C

Sta. 43+95 Rt. 110'

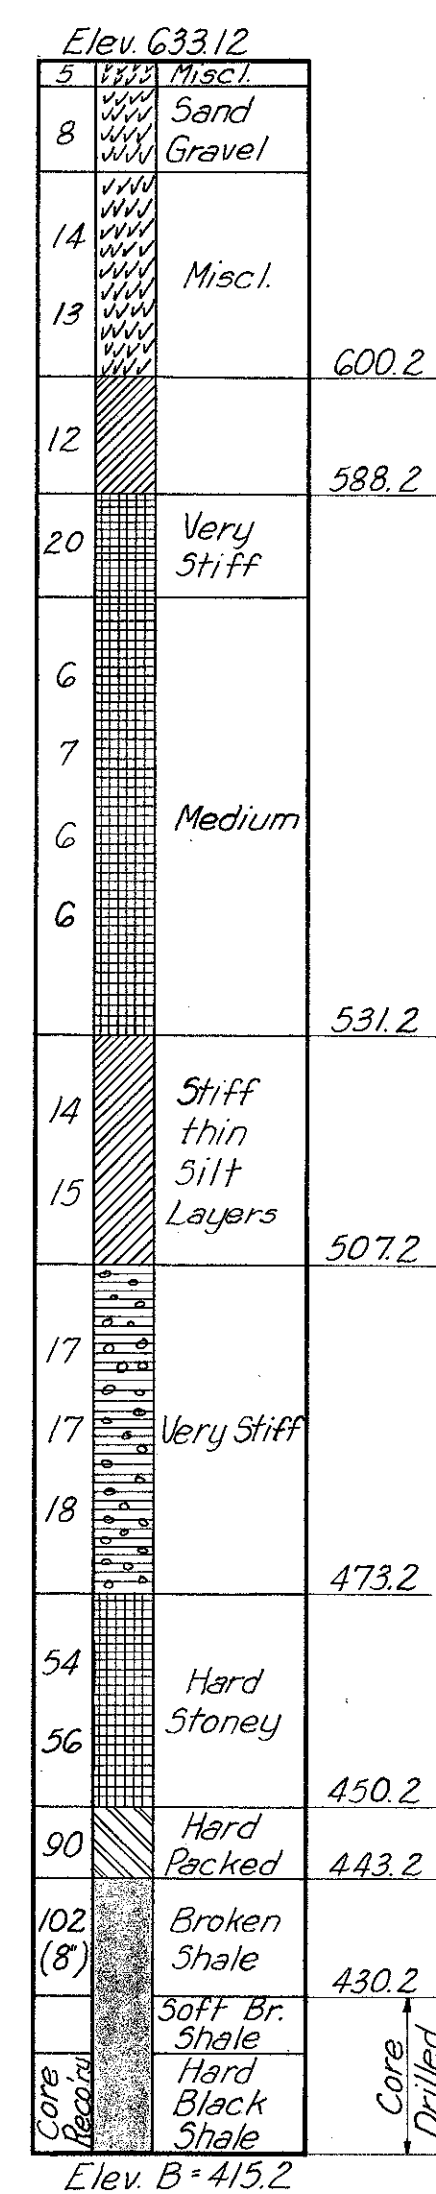

GENERAL NOTES

SOIL LEGEND

Misch.	
Fill	
Clay	
Sand	
Silt	
Silty Sand	
Silty Clay	
Sandy Clay	
Pebbly Clay	
Sand and Gravel	
Silt, Sand and Gravel	
Sand, Clay and Gravel	
Rock	
Ground Water	
Trap Sample	T.S.
Auger Sample	A.S.
Tube Trap	T.T.

BORING LEGEND

(a)	(b)	(c)	(d)
Elev. 100.0			
As	Fill		95.0
3			
2		Soft & Wet	
7.5			
10			
12		Very Stiff	
14			
20			60.0
25		Fine & Wet	
30		Shale	55.0
(6)			
Elev. B = 50.0			

With reference to above example;
1. In column (a) the figures 2, 3, etc. are the hammer blows required to advance the casing one foot unless otherwise noted.
2. Column (b) shows the legend of soil types and ground water elevation.
3. Column (c) shows soil classification. Elev. 100.0 is the ground level and Elev. B = 50.0 is the bottom of the boring.
4. Column (d) shows the intermediate elevations of limits of different soil layers.


Misc. Notes: Vertical scale for boring 1\"/>

Revised 1-26-55

PART 2

U. S. ROUTE 42 RELOCATION INNER BELT FREEWAY - CENTRAL VIADUCT		
GENERAL LAYOUT AND TEST HOLE BORINGS		
CLEVELAND	CUYAHOGA COUNTY	OHIO
SCALE: Vertical: 1\"/>		
MADE: J.G.S. DATE: 1-22-54	HOWARD, NEEDLES, TAMMEN & BERGENDOFF CONSULTING ENGINEERS	
TRCD: H.A.M. DATE: 2-6-54	KANSAS CITY	CLEVELAND NEW YORK
CKD: C.V.G. DATE: 2-25-54	914-1A SHEET 1 OF 06	

CUYAHOGA COUNTY
CITY OF CLEVELAND
INNER BELT FREEWAY
CENTRAL VIADUCT
CUY - 42 R - 17.50

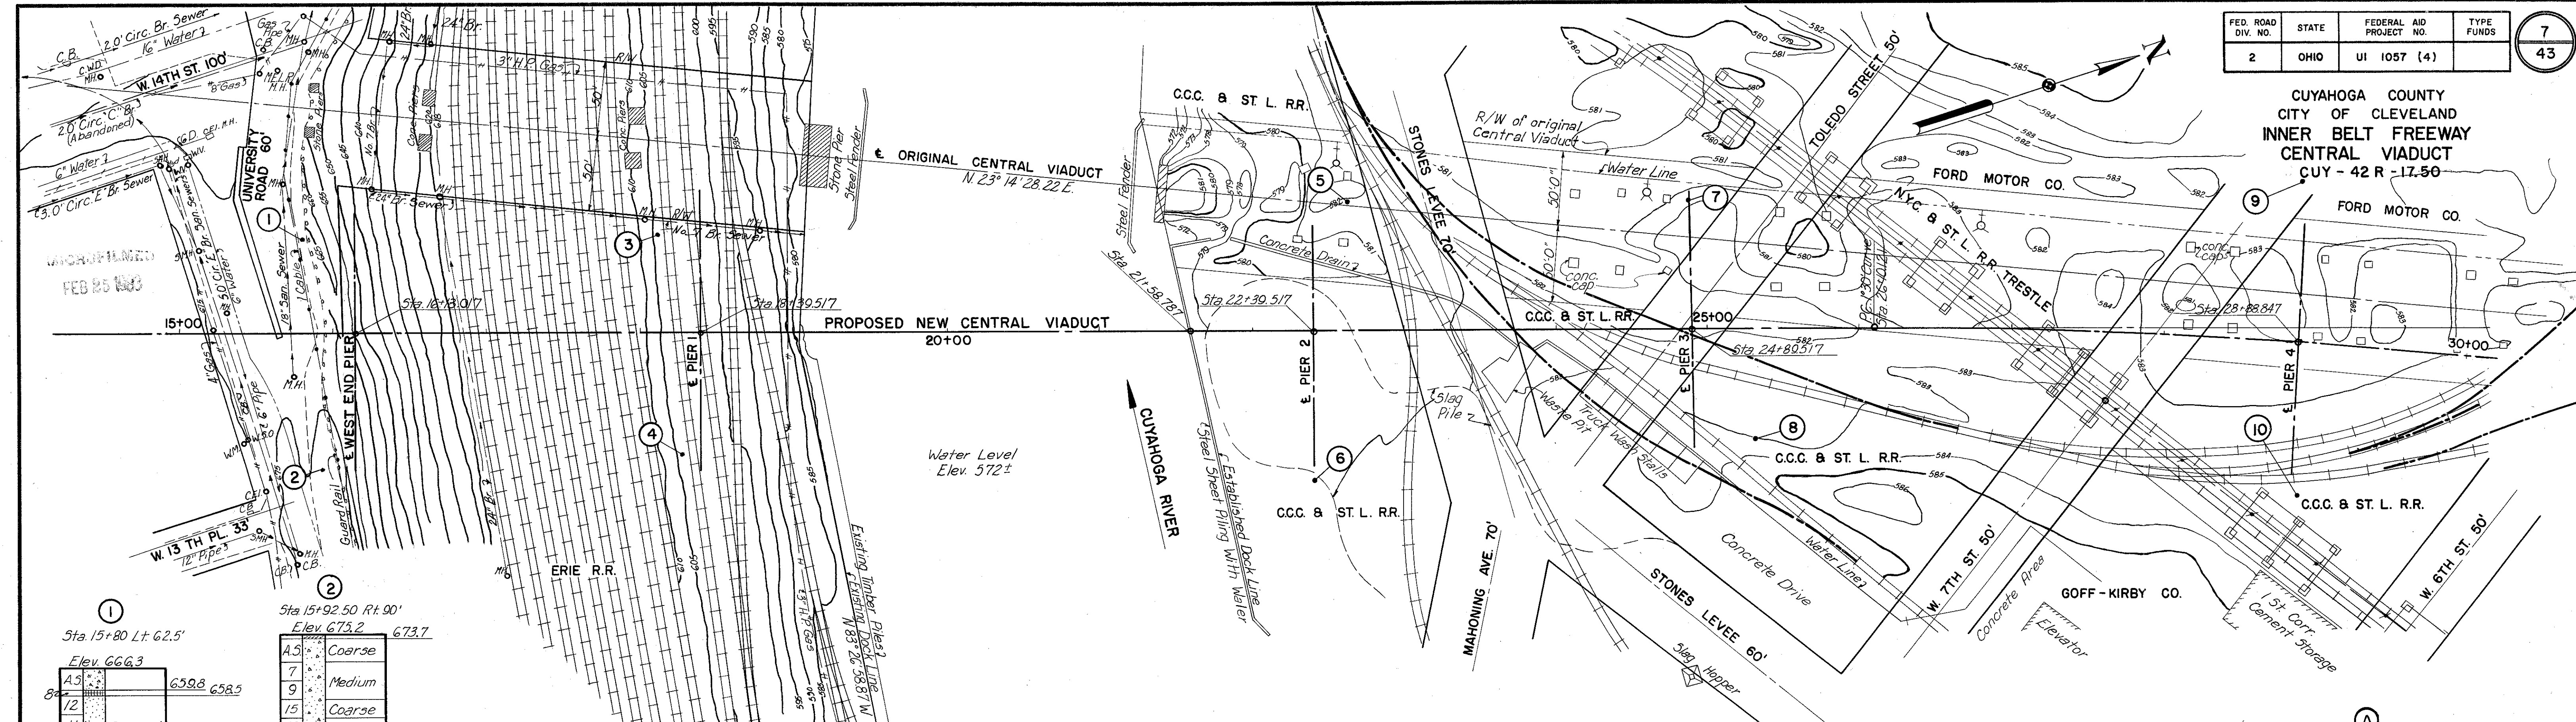

① Sta 15+80 Lt. 62.5'

AS	Elev. 666.3
8	659.8 658.5
12	
11	Compact Med.
14	
16	
18	Compact Med. Wet
TS	Compact Fine, Wet
21	615.0
11	Stiff
6	Medium
16	
18	
15	Very Stiff
15	
20	
	Elev. B = 546.3

② Sta 15+92.50 Rt. 90' Elev. 675.2 673.7

AS	Coarse
7	Medium
9	
15	Coarse
18	Med. Wet
TS	Med. Wet
35	Fine, Wet
TS	Fine, Wet
9	Stiff
15	
14	Very Stiff
9	Medium
16	
19	Very Stiff
	Elev. B = 545.2

③ Sta 18+11.50 Lt. 64' Elev. 604.0

4	Cinder & Slag
7	Fine, Brown
8	578.0
6	573.0
6	Med Grey
14	Very Stiff
9	Stiff
7	Medium
14	
15	Very Stiff
12	
17	Very Stiff & Stony
9	Stiff
7	Medium
TS	Coarse & Wet
	482.5
	Elev. B = 474.0

④ Sta 18+27.50 Rt. 90' Elev. 604.2

5	Cinder
12	Fine, Brown
8	578.0
6	572.2
7	Medium
11	Stiff
17	Very Stiff
11	Stiff
25	Hard Stony
26	
25	Very Stiff
17	Stiff
TS	Coarse, Wet
	475.2
22	Very Stiff with Thin Silt Layers
TS	Wet
	461.7
	Elev. B = 454.2

⑤ Sta 22+62 Lt. 85' Elev. 581.5

3	Misc.
4	574.5
7	Wet
TS	564.0
TS	Med. Wet
TS	Coarse, Wet
9	Stiff
7	Medium
12	Stiff
8	Medium
12	Stiff
15	Very Stiff
9	Stiff
37	Hard
9	Medium
TS	Coarse, Wet
35	Hard
35	Hard
50	Hard
	428.0
	Elev. B = 427.0

⑥ Sta 22+40 Rt. 100.5' Elev. 580.6

AS	Brown
2	575.1
2	Soft
7	Medium
8	Coarse
TS	548.1
9	Stiff
9	
11	Stiff
12	
18	Very Stiff
	Elev. B = 500.6

⑦ Sta 24+89 Lt. 85' Elev. 581.9

3	Sand & Clay
4	573.4
2	Loam, Wet
2	569.9
2	Fine, Wet
2	563.9
2	Fine, Wet
4	559.6
TS	Med. Wet
TS	Wet
12	548.9
12	Stiff with Thin Silt Layers
13	
8	Med with Thin Silt Layers
9	518.9
9	Medium
12	Stiff
12	501.9
12	Stiff

⑧ Sta 25+30 Rt. 75' Elev. 583.0


4	Slag & Clay
4	579.0
6	Loam, Wet
2	574.0
2	Medium
2	568.0
5	Fine, Wet
6	564.0
TS	Wet
TS	544.0
14	Stiff with Thin Silt Layers
13	Stiff with Thin Silt Layers
20	524.0
16	Very Stiff
14	514.0
	Elev. B = 503.0

⑨ Sta 28+85 Lt. 105.5' Elev. 582.0

4	Misc.
4	576.0
3	Soft, Wet
5	Med with Vegetation
2	565.0
2	Soft
2	560.0
2	Soft Little Clay
2	552.0
4	Wet & Gravel Loose
6	533.0
19	Very Stiff
22	
19	
13	Stiff
	Elev. B = 502.0

⑩ Sta 28+94 Rt. 104.5' Elev. 583.3

4	Misc.
4	575.3
6	Brn & Grey
10	Med Veg.
2	566.3
2	Very Soft
2	
2	548.3
6	
TS	531.3
16	
15	Very Stiff
15	503.3
15	Very Stiff











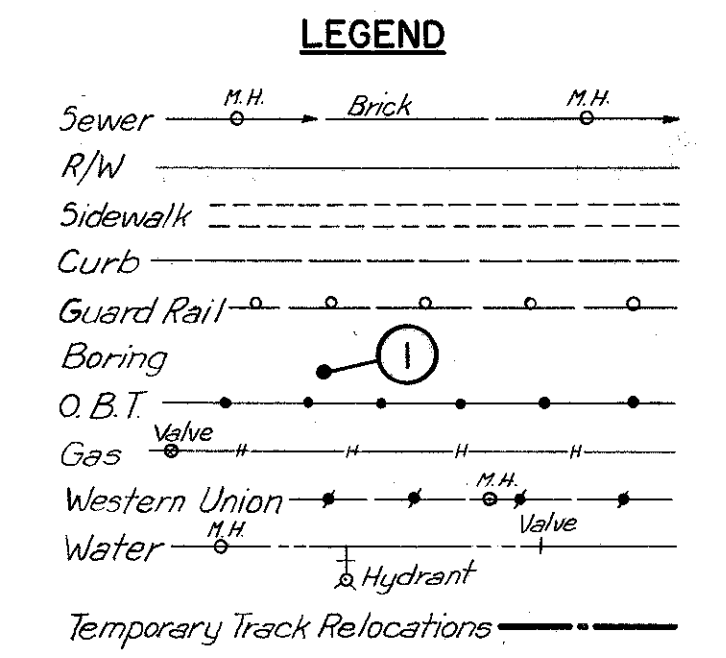


Notes: For general notes on borings and soil and boring legend, see Sheet 6.

PART 2
U. S. ROUTE 42 RELOCATION
INNER BELT FREEWAY - CENTRAL VIADUCT
EXISTING CONDITIONS AND
TEST HOLE BORINGS
CLEVELAND CUYAHOGA COUNTY OHIO
SCALE 1" = 50', 20'
MADE 1/5/54 DATE 1/12/54
TRCD 1/11/54 DATE 2/11/54
CKD CULC DATE 2/25/54
HOWARD, NEEDLES, TAMMEN & BERGENDOFF
CONSULTING ENGINEERS
KANSAS CITY CLEVELAND NEW YORK
914-1A SHEET 1 OF 7

FED. ROAD DIV. NO.	STATE	FEDERAL AID PROJECT NO.	TYPE FUNDS
2	OHIO	UI 1057 (4)	

CUYAHOGA COUNTY
CITY OF CLEVELAND
INNER BELT FREEWAY
CENTRAL VIADUCT
CUY - 42R - 17.50

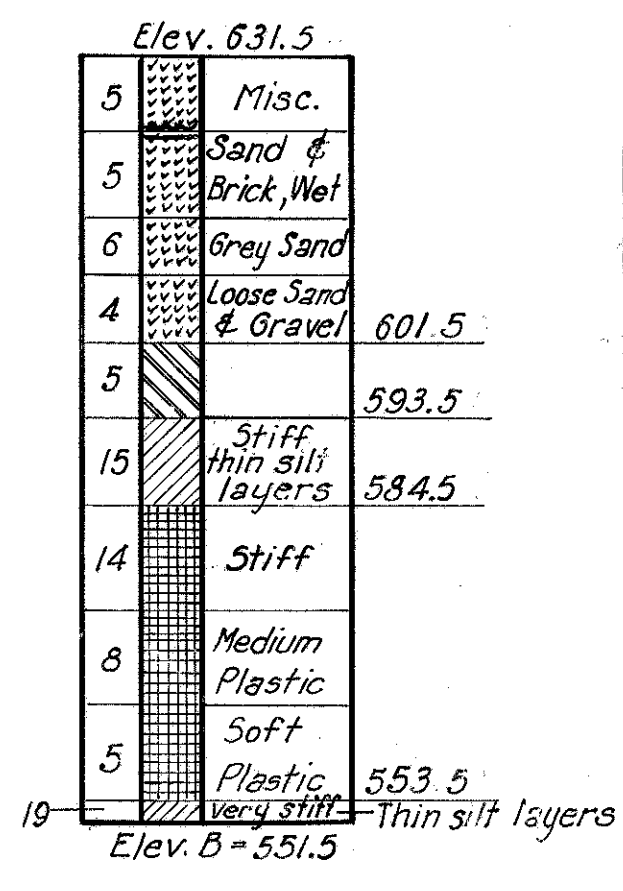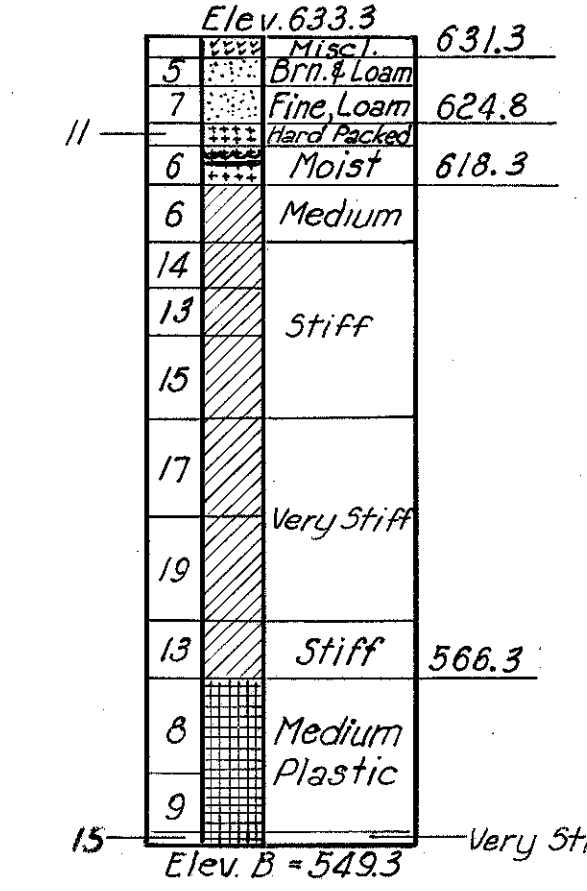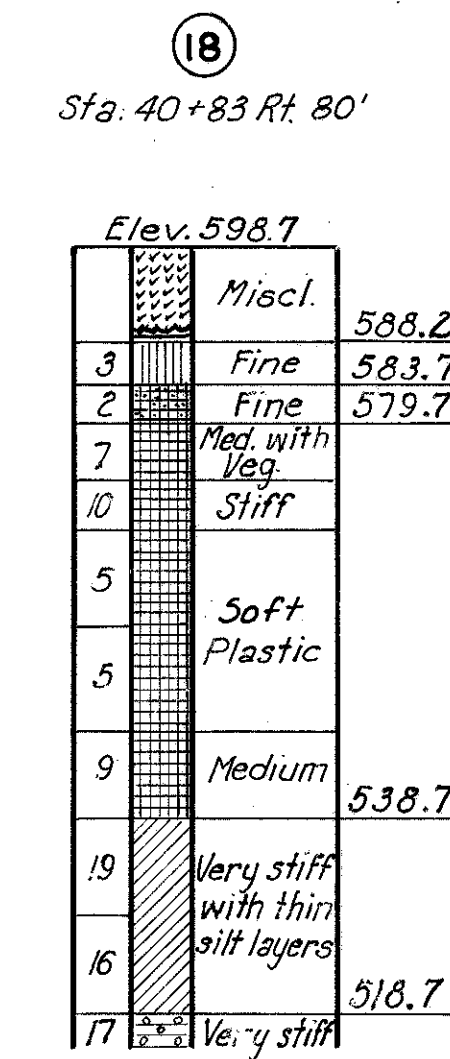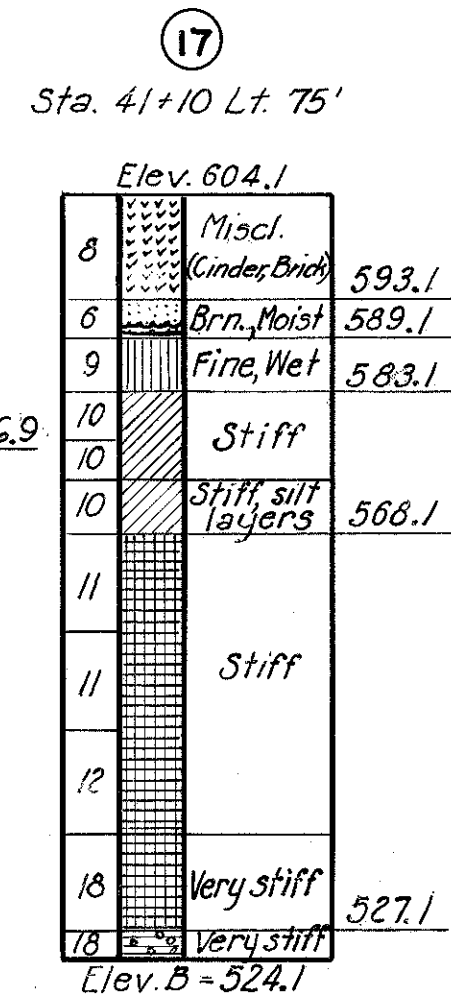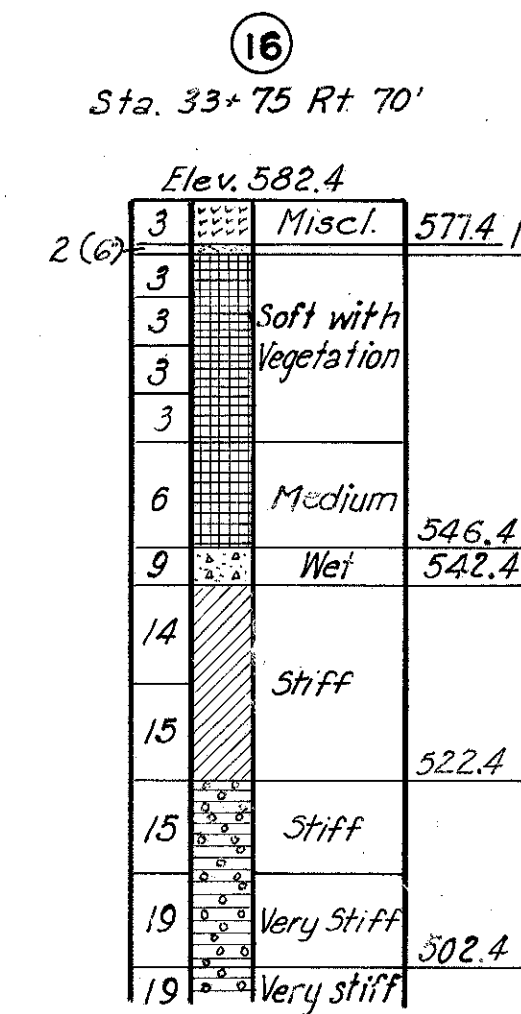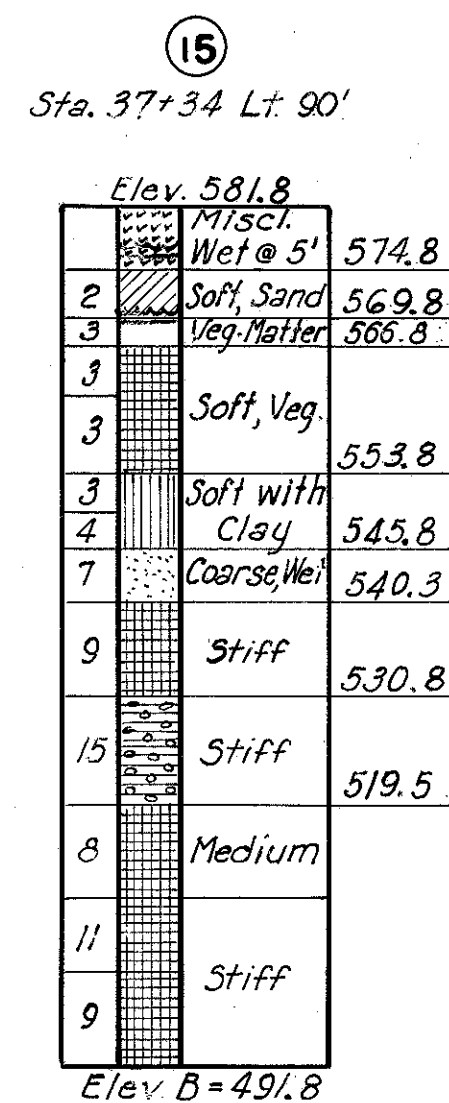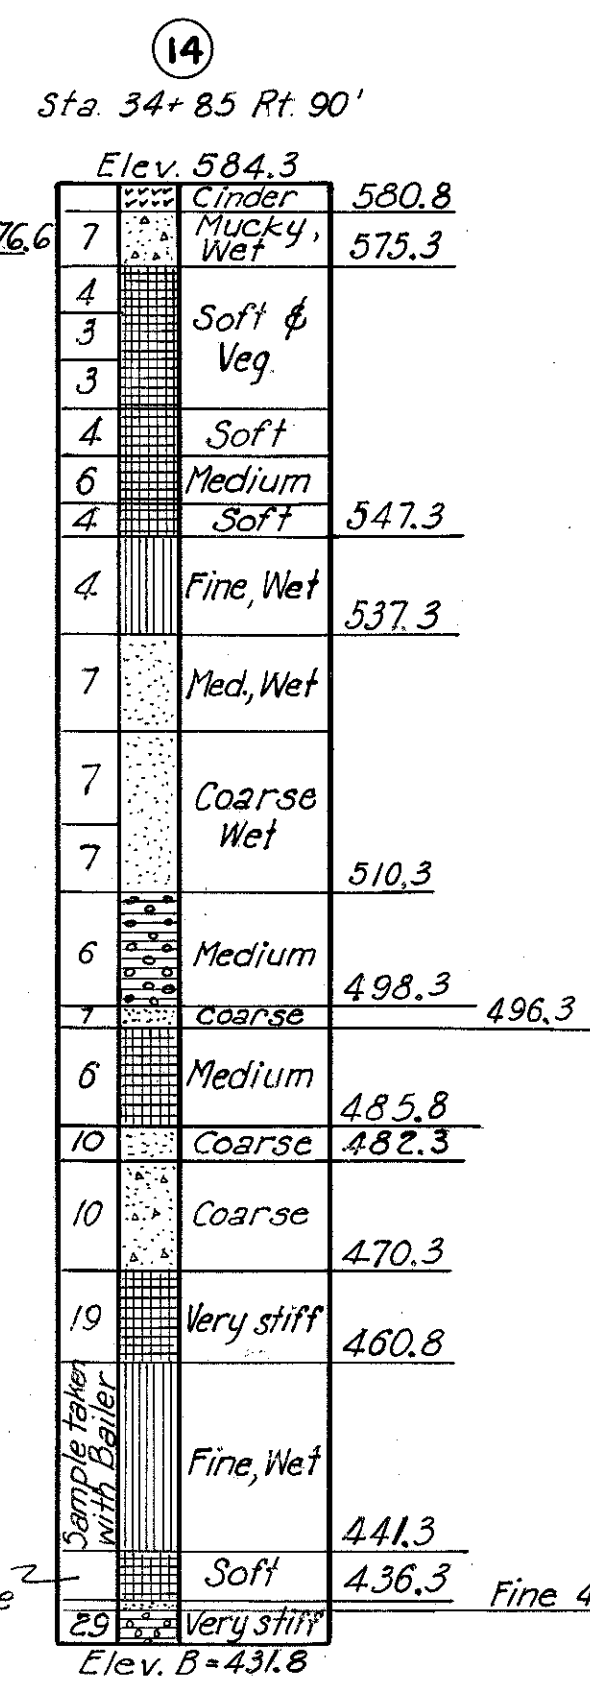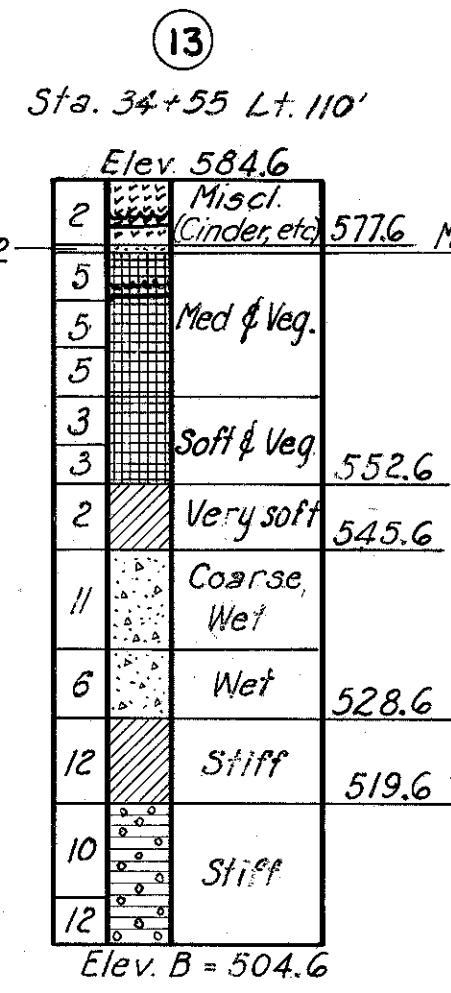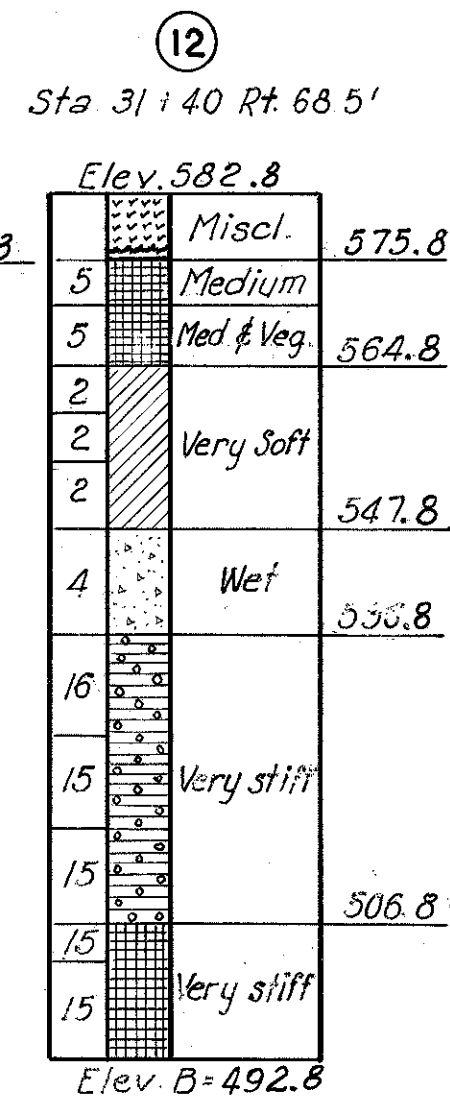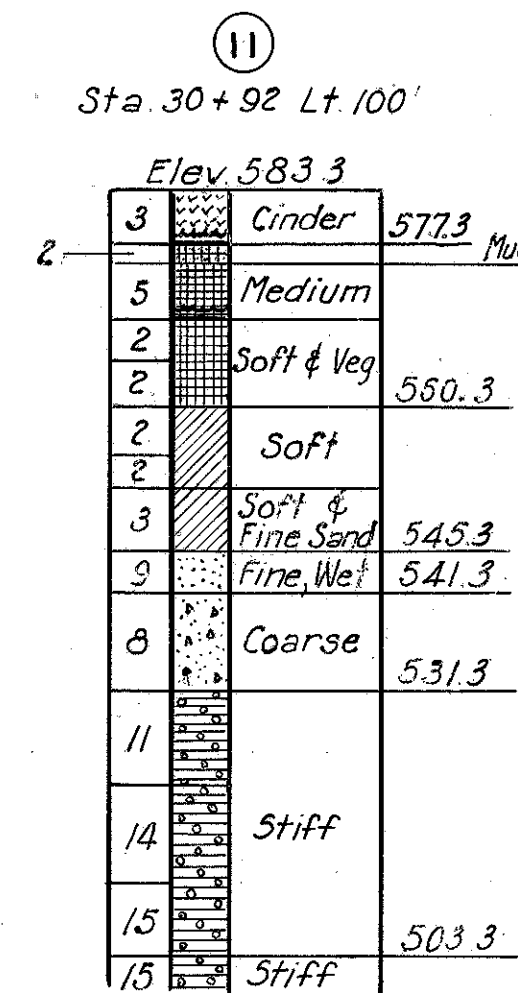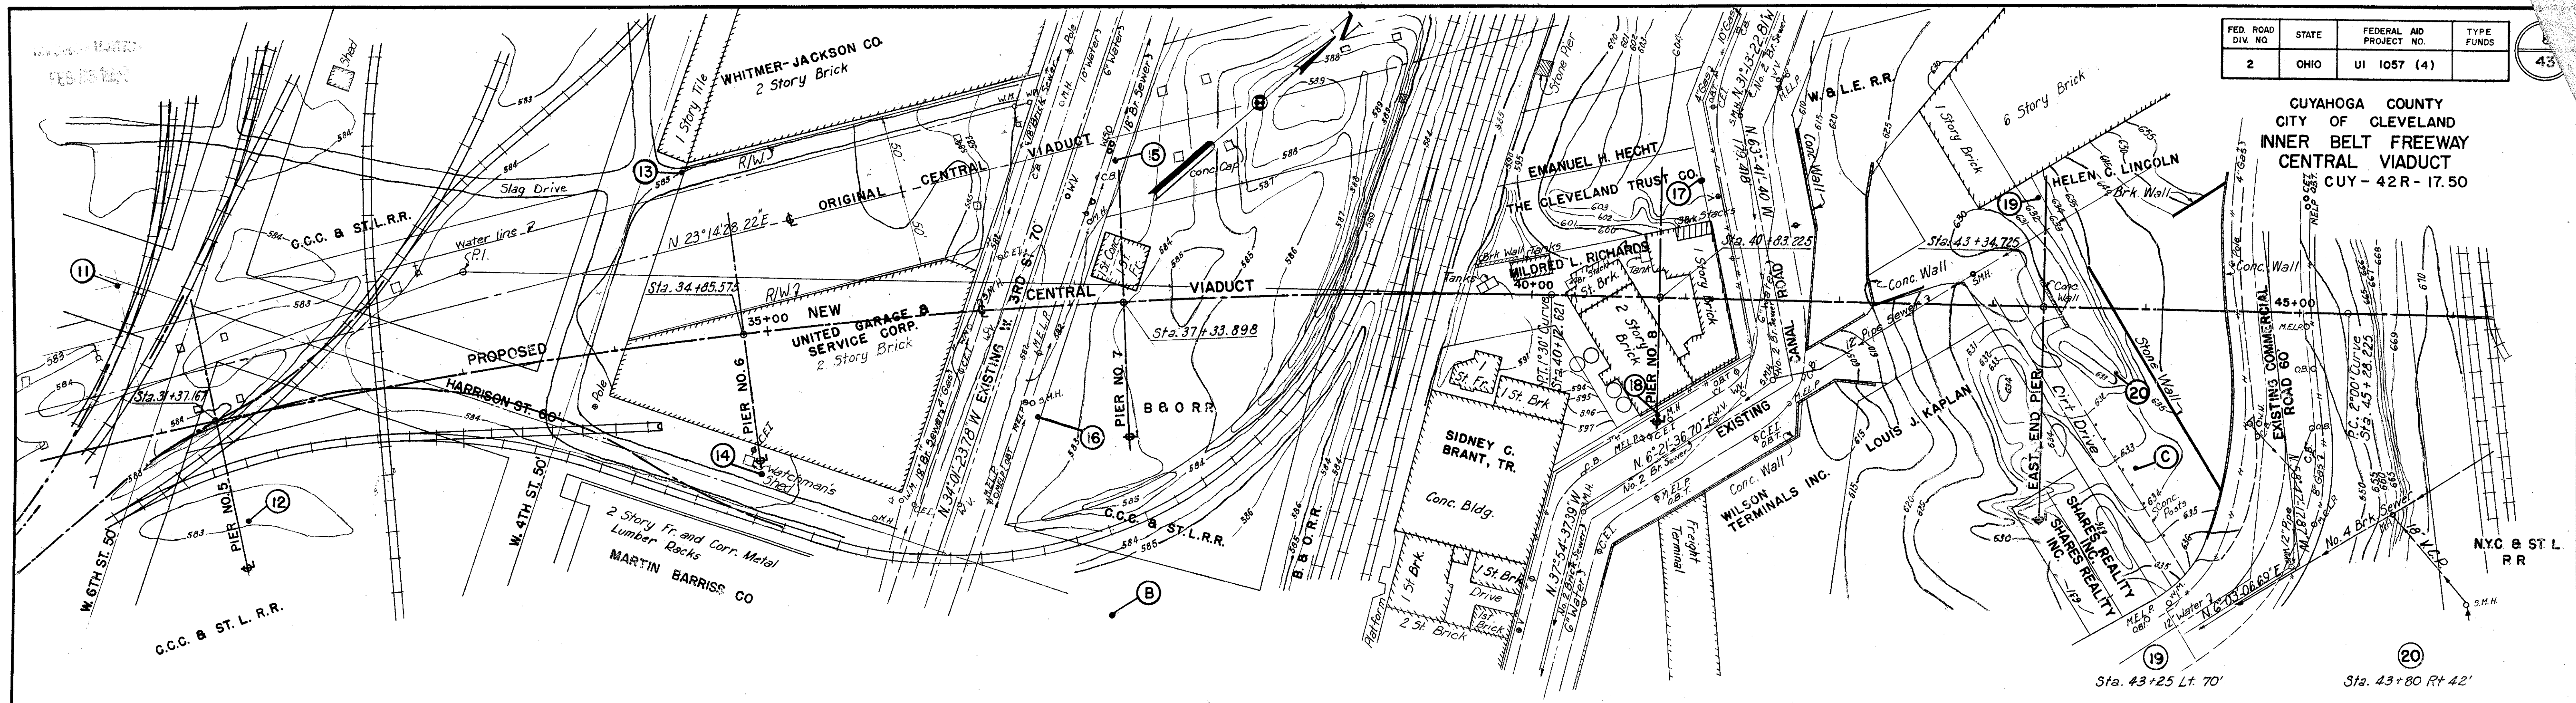

Notes: For general notes on borings and soil and boring legend, see Sheet 6.
Vertical scale for borings: 1" = 20'
For existing conditions legend, see Sheet 7.

PART 2

U. S. ROUTE 42 RELOCATION
INNER BELT FREEWAY - CENTRAL VIADUCT

EXISTING CONDITIONS AND
TEST HOLE BORINGS

CLEVELAND CUYAHOGA COUNTY OHIO

SCALE 1" = 50', 20'
MADE & DATE 1-13-54
TRACED & DATE 1-19-54
CHKD & DATE 2-26-54

HOWARD, NEEDLES, TAMMEN & BERGENDOFF
CONSULTING ENGINEERS
KANSAS CITY CLEVELAND NEW YORK

914-1A SHEET- 1.08




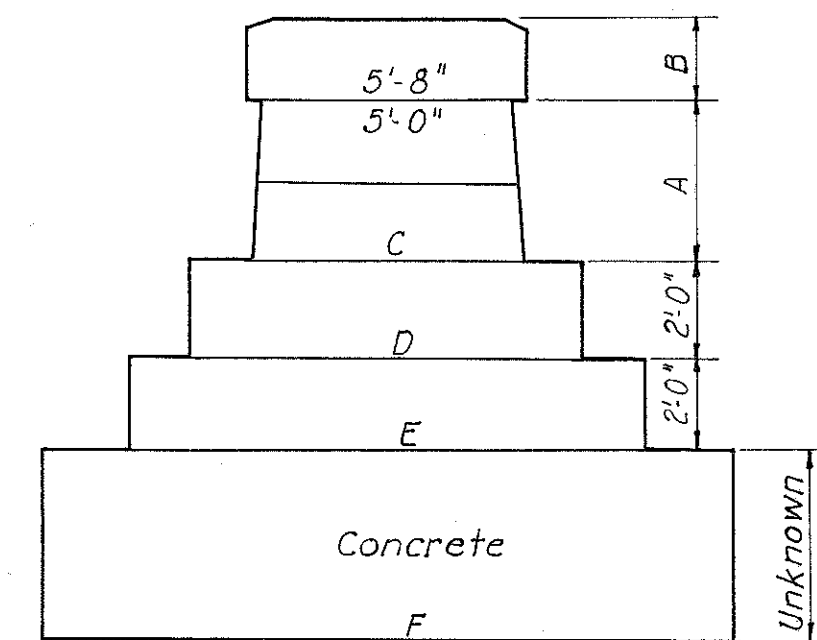


TABLE OF PEDESTAL DIMENSIONS						
Pier	A	B	C	D	E	F
3	3'-0"	1'-6"	5'-6"	7'-0"	9'-0"	11'-0"
4	3'-0"	1'-6"	5'-6"	7'-0"	9'-0"	11'-0"
5	3'-4"	1'-8"	5'-6 1/2"	7'-6"	10'-0"	13'-0"
6	3'-4"	1'-8"	5'-6 1/2"	8'-0"	10'-6"	14'-0"

Existing pedestals of the old Central Viaduct substructure which interfere with new construction shall be removed as necessary to avoid interference with new construction, including pile driving. Payment for pedestal removal to at least one foot below the surface of the ground shall be made by Item S-24, "Removing existing concrete pedestals which interfere with new construction". That portion of the pedestals beneath one foot below the ground shall be removed by the contractor, payment therefor being included in the bid price per cubic yard under pay item E-2, unclassified excavation.

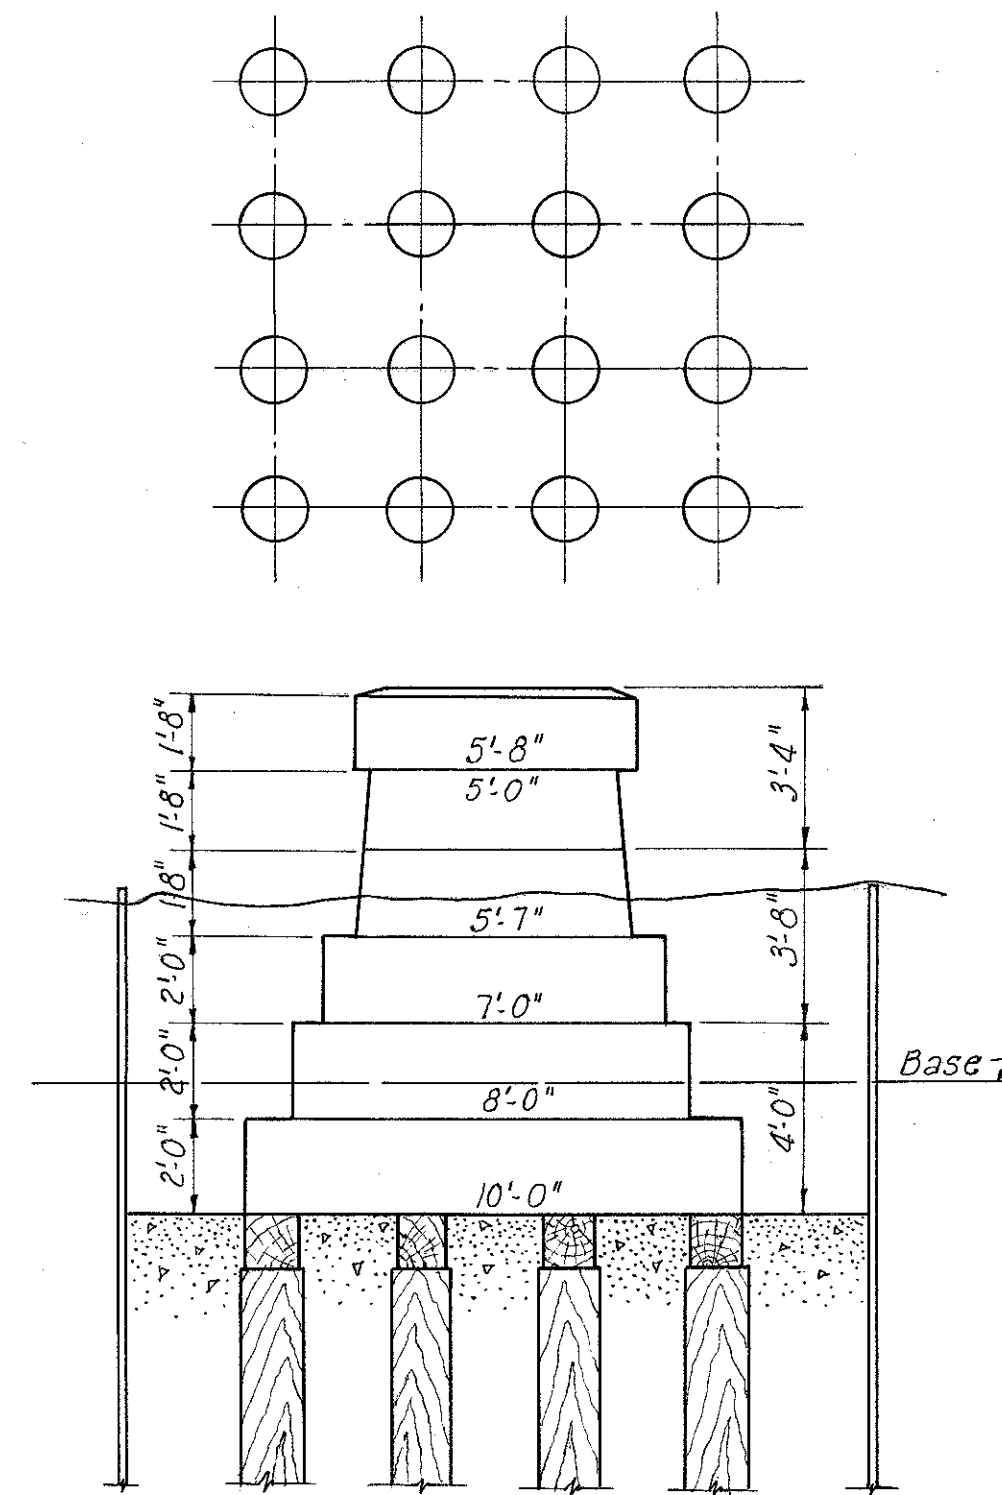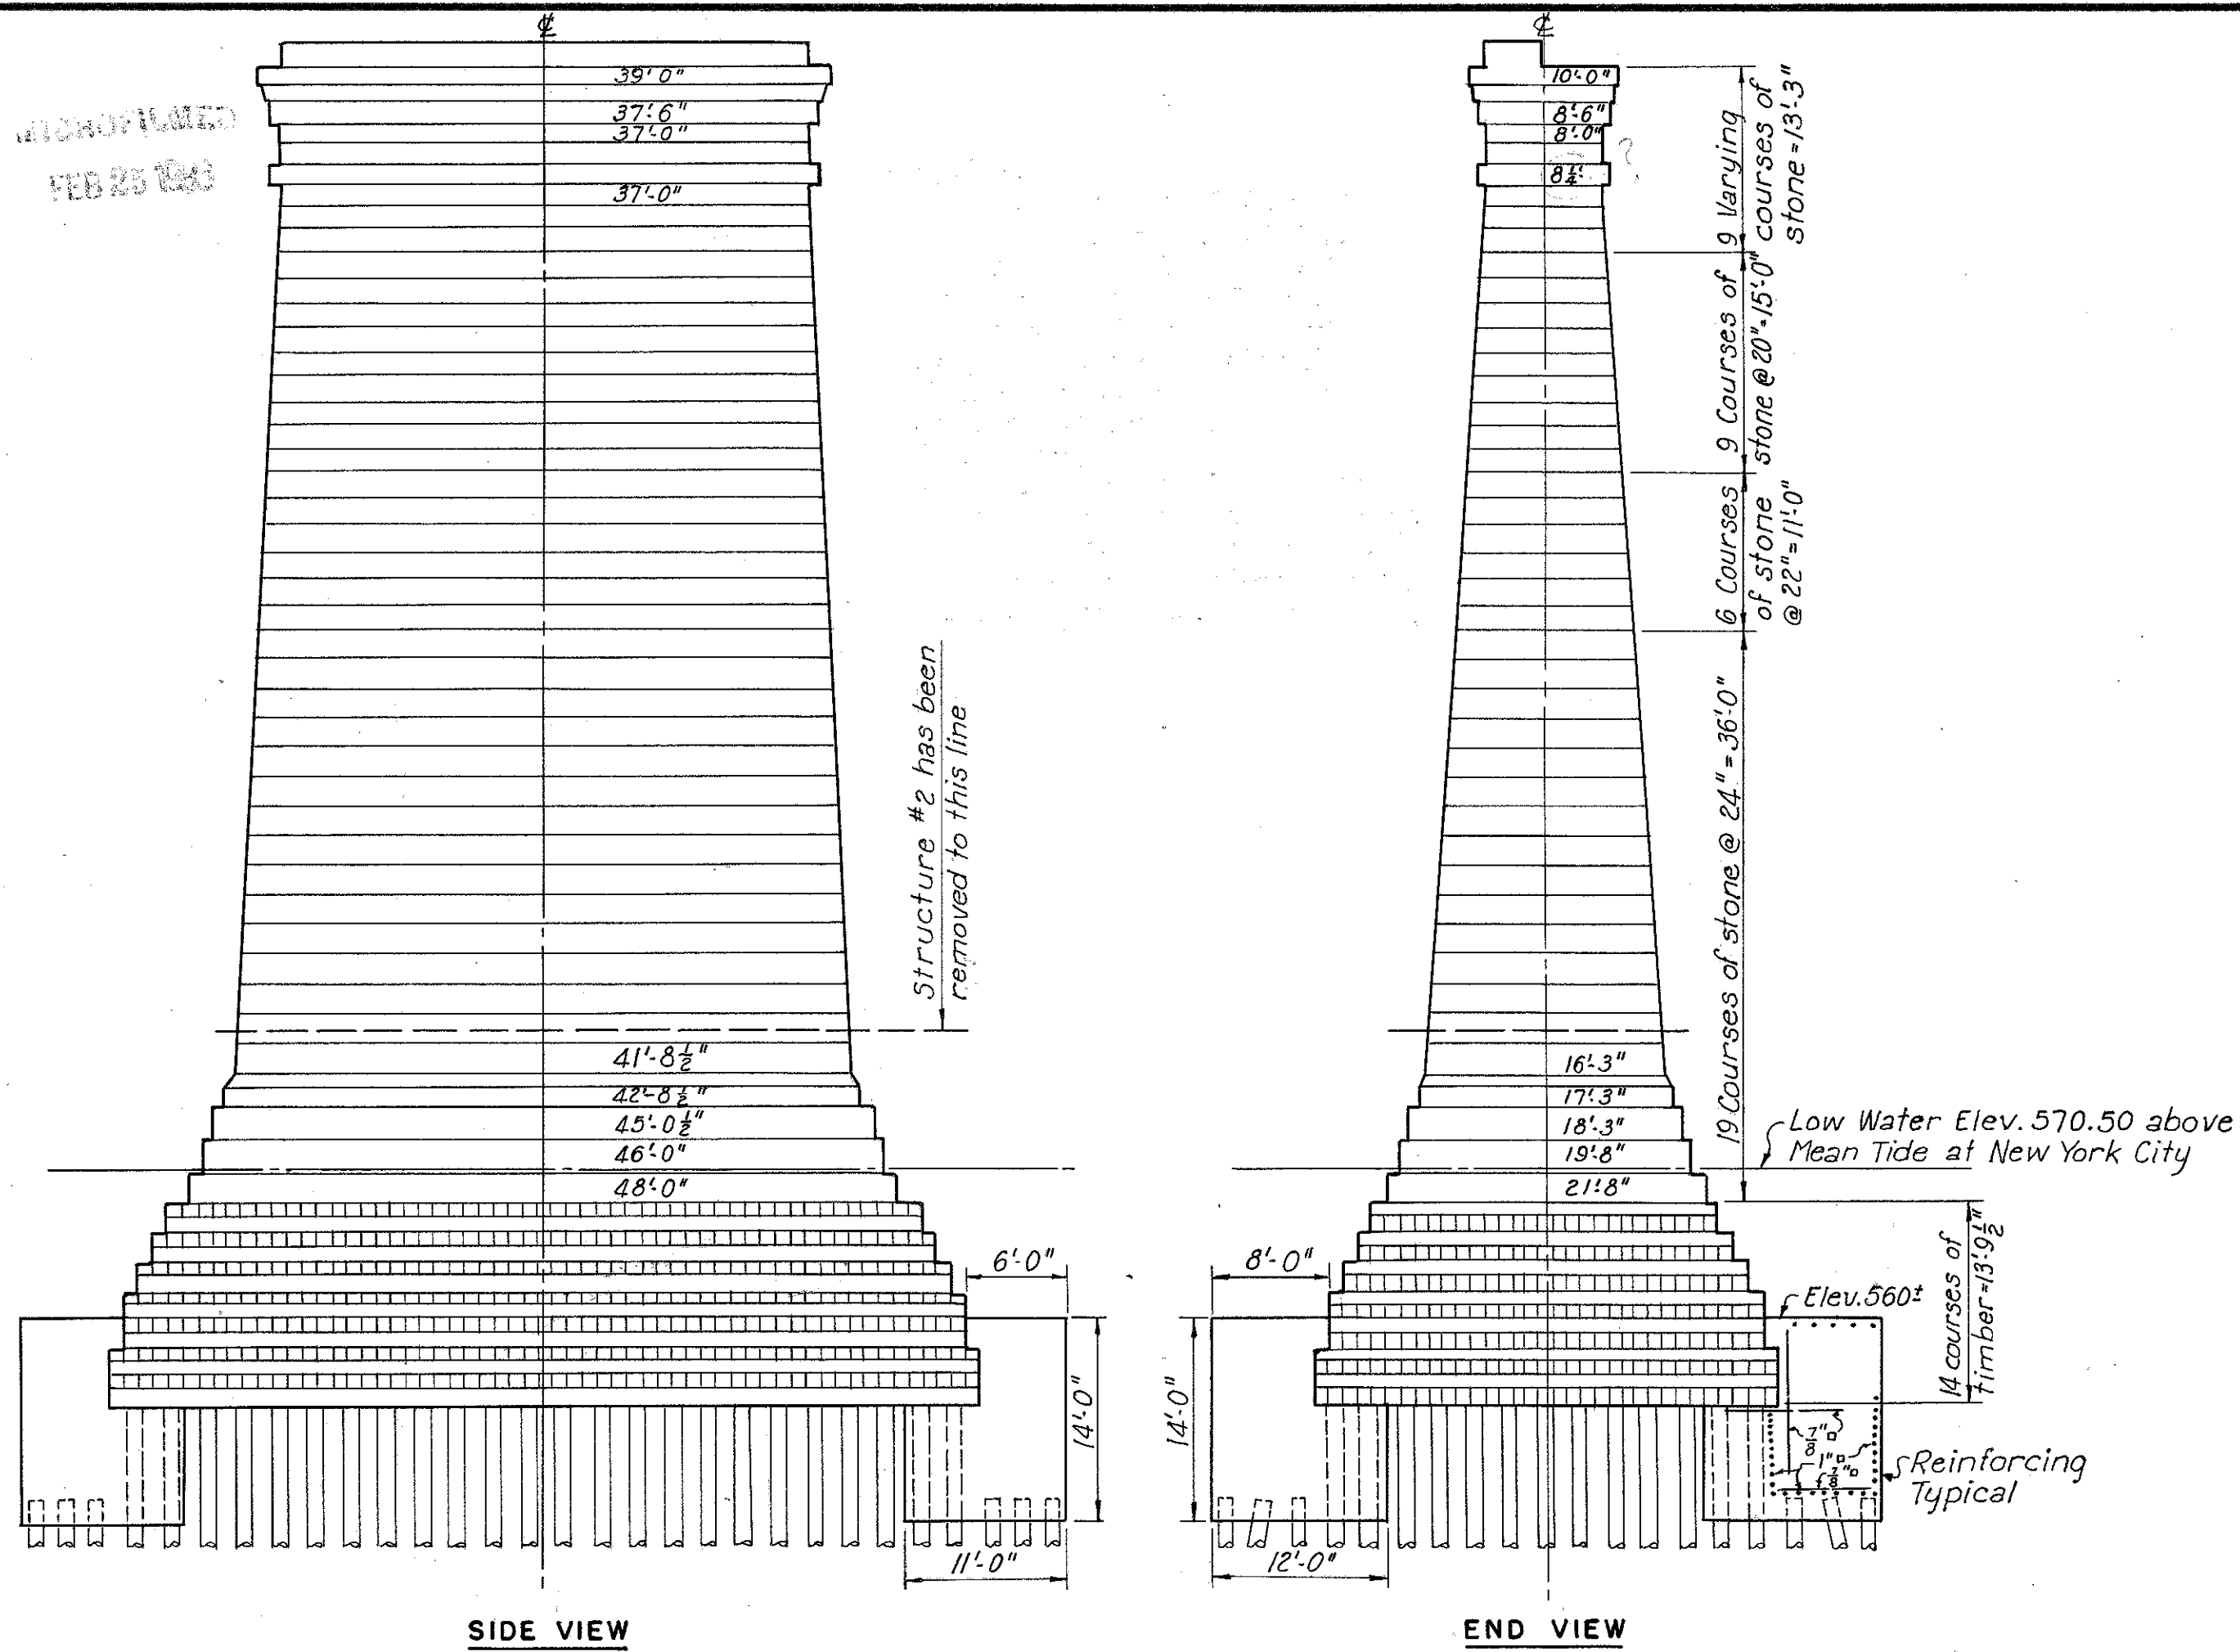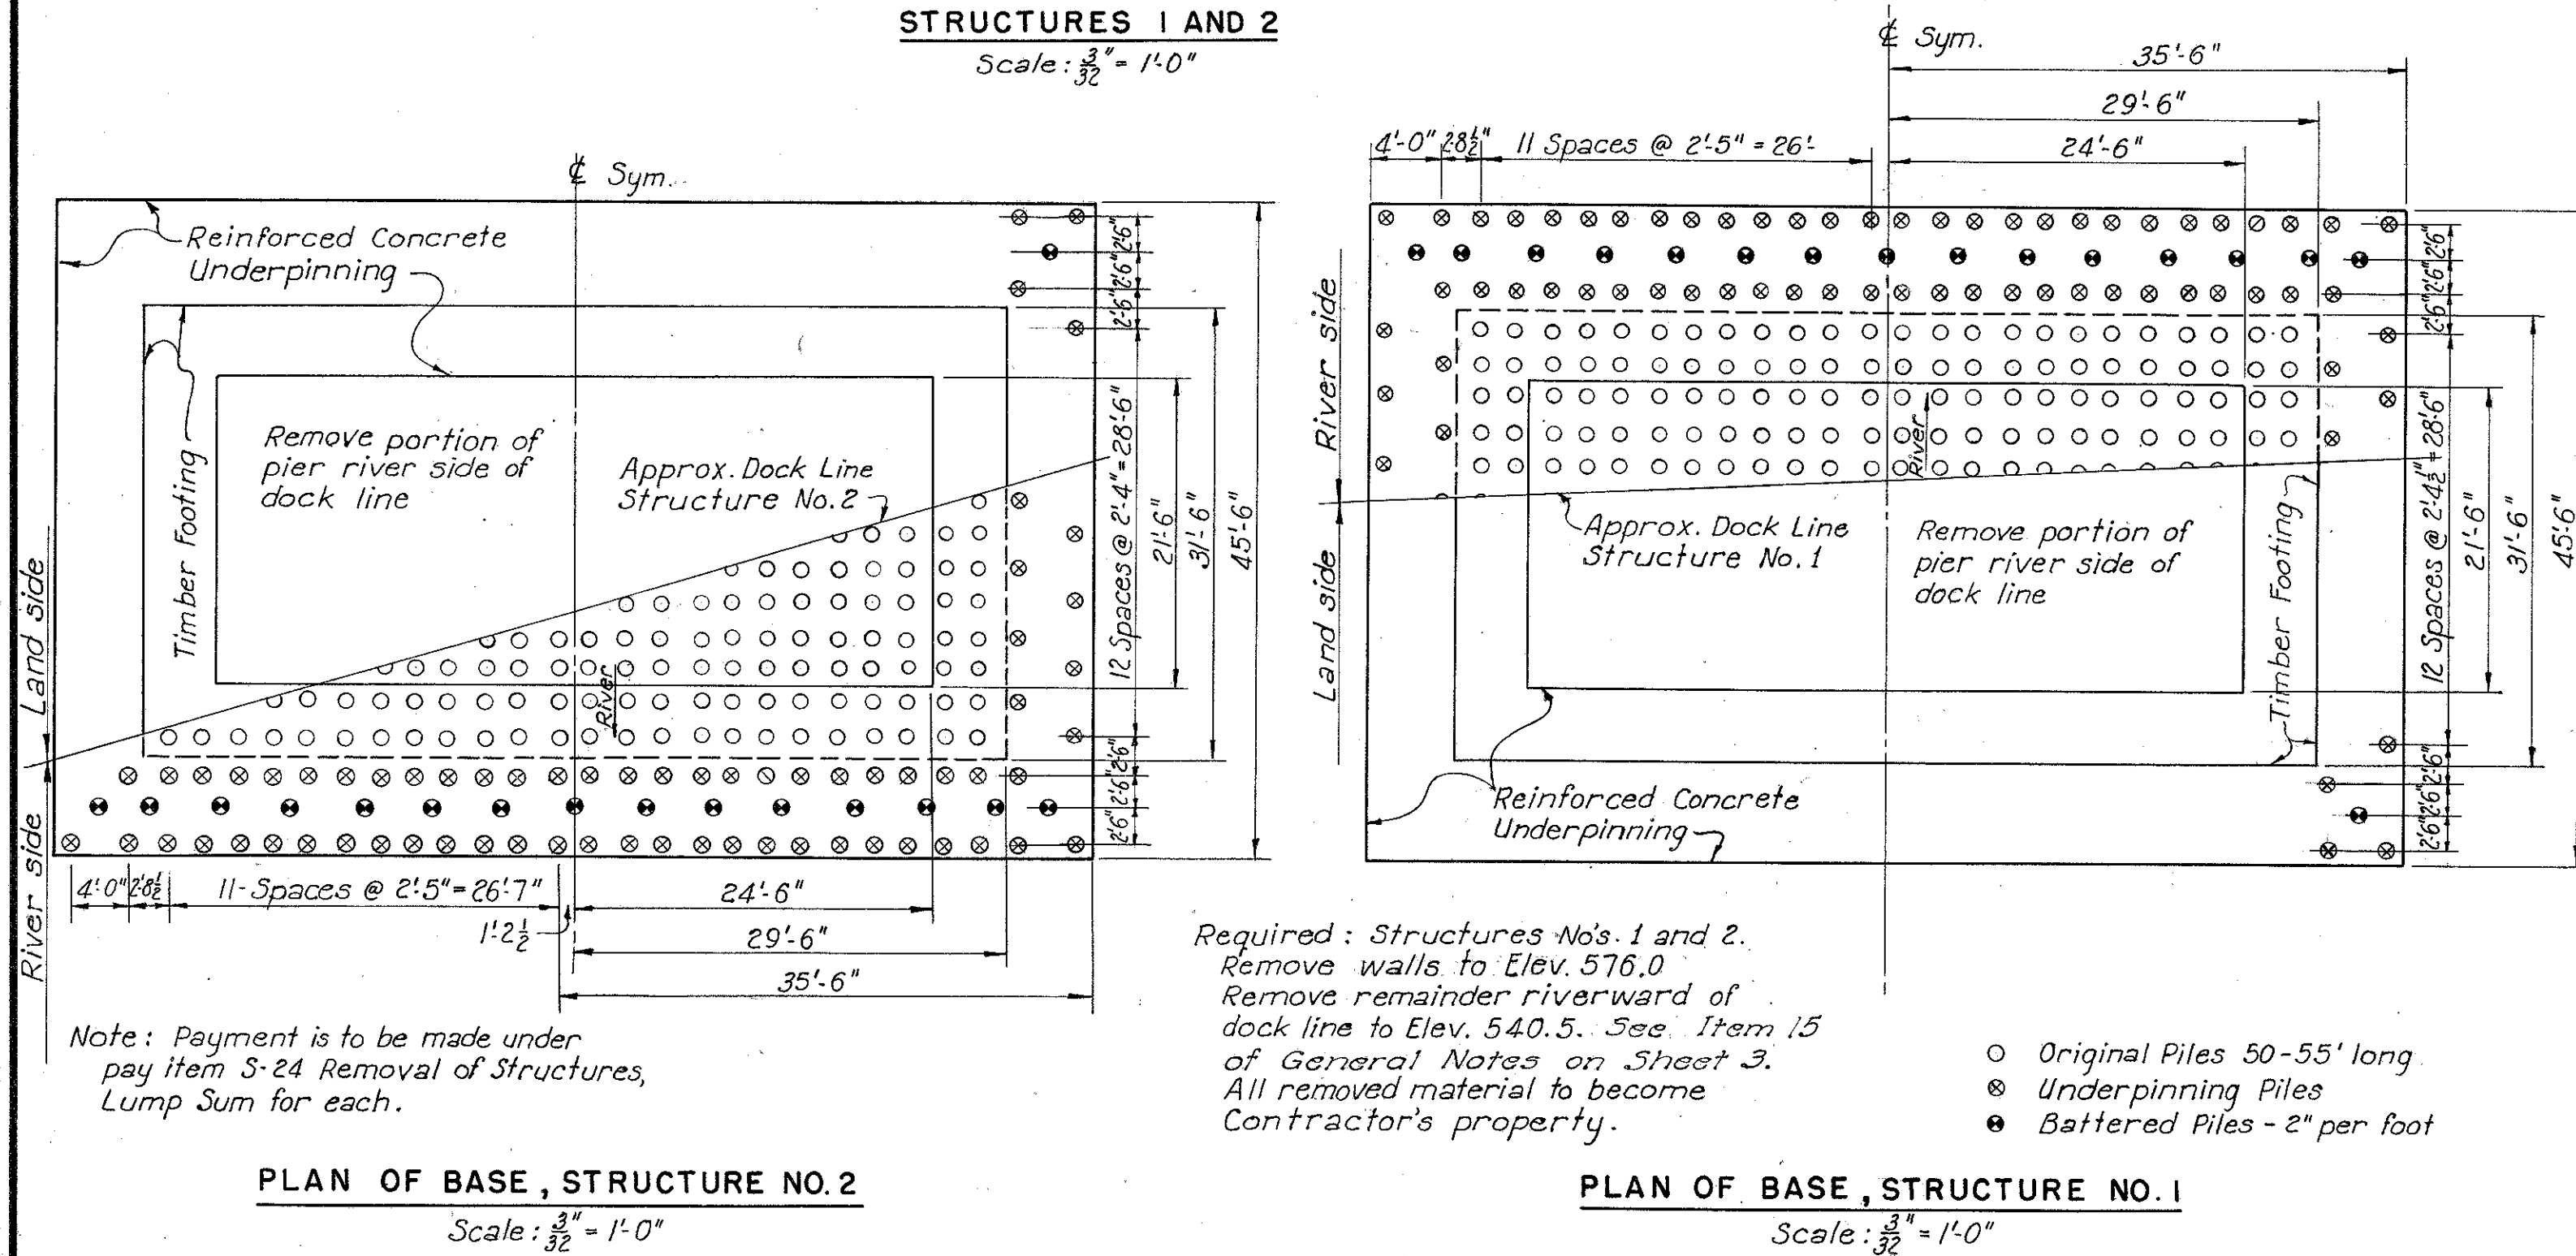

REVISIONS
FEB 25 1955

FED. ROAD DIV. NO.	STATE	FEDERAL AID PROJECT NO.	TYPE FUNDS
2	OHIO	UI 1057 (4)	

10
43

CUYAHOGA COUNTY
CITY OF CLEVELAND
INNER BELT FREEWAY
CENTRAL VIADUCT
CUY - 42 R - 17.50

FORCE ACCOUNT WORK By the Erie Railroad Company	
Engineering and Inspection	Lump Sum
Track Work	Lump Sum
Communication Line Changes	Lump Sum

The labor and the furnishing of materials in connection with the temporary and permanent track work as shown on sheets 40, 41, 42 and 43 and as called for in the estimate will be performed by the Erie Railroad Company by force account.

LEGEND

- Present tracks to be undisturbed.
- Present tracks to be removed.
- Track relocations.

PART 2

U. S. ROUTE 42 RELOCATION
INNER BELT FREEWAY - CENTRAL VIADUCT

ERIE RAILROAD TRACK MODIFICATIONS

CLEVELAND CUYAHOGA COUNTY OHIO

SCALE: 1" = 50'-0"
MADE N.A.M. DATE 4-16-54
TRCD N.A.M. DATE 4-30-54
CKD G.A. DATE 8-30-54
HOWARD, NEEDLES, TAMMEN & BERGENDOFF
CONSULTING ENGINEERS
KANSAS CITY CLEVELAND NEW YORK
914-1A SHEET 110

EXISTING CONDITIONS AND TRACK CHANGES TO BE MADE FOR CONSTRUCTION OPERATIONS FOR PIER 1

CONSTRUCTION CONDITIONS AND PERMANENT TRACK RELOCATIONS

EXISTING CONDITIONS AND TRACK CHANGES TO BE MADE FOR CONSTRUCTING STEEL DOCKWALL

SPECIAL NOTE


Additional information for track location (shown here and in Phase I of Sheet 40) was received from the Erie Railroad Company on its drawings D-194 and D-196, revised Aug. 31, 1954, too late to be incorporated in the cross sections shown on Sheets 41, 42 and 43. However, revised prints of Sheets 41, 42 and 43 will be furnished to the Contractor before he is ready to begin work.

Notes:

- For dockwall construction, see sheets 38 and 39.
- For profiles of grading for tracks, see sheet 40.
- For cross sections parallel to & of proposed Central Viaduct, see sheets 41, 42 and 43.

Information for track location was taken from Erie Railroad Company drawings D-194, D-195, and D-196. Revised Aug. 13, 1954.

CUYAHOGA COUNTY
CITY OF CLEVELAND
INNER BELT FREEWAY
CENTRAL VIADUCT
CUY-42R-17.50

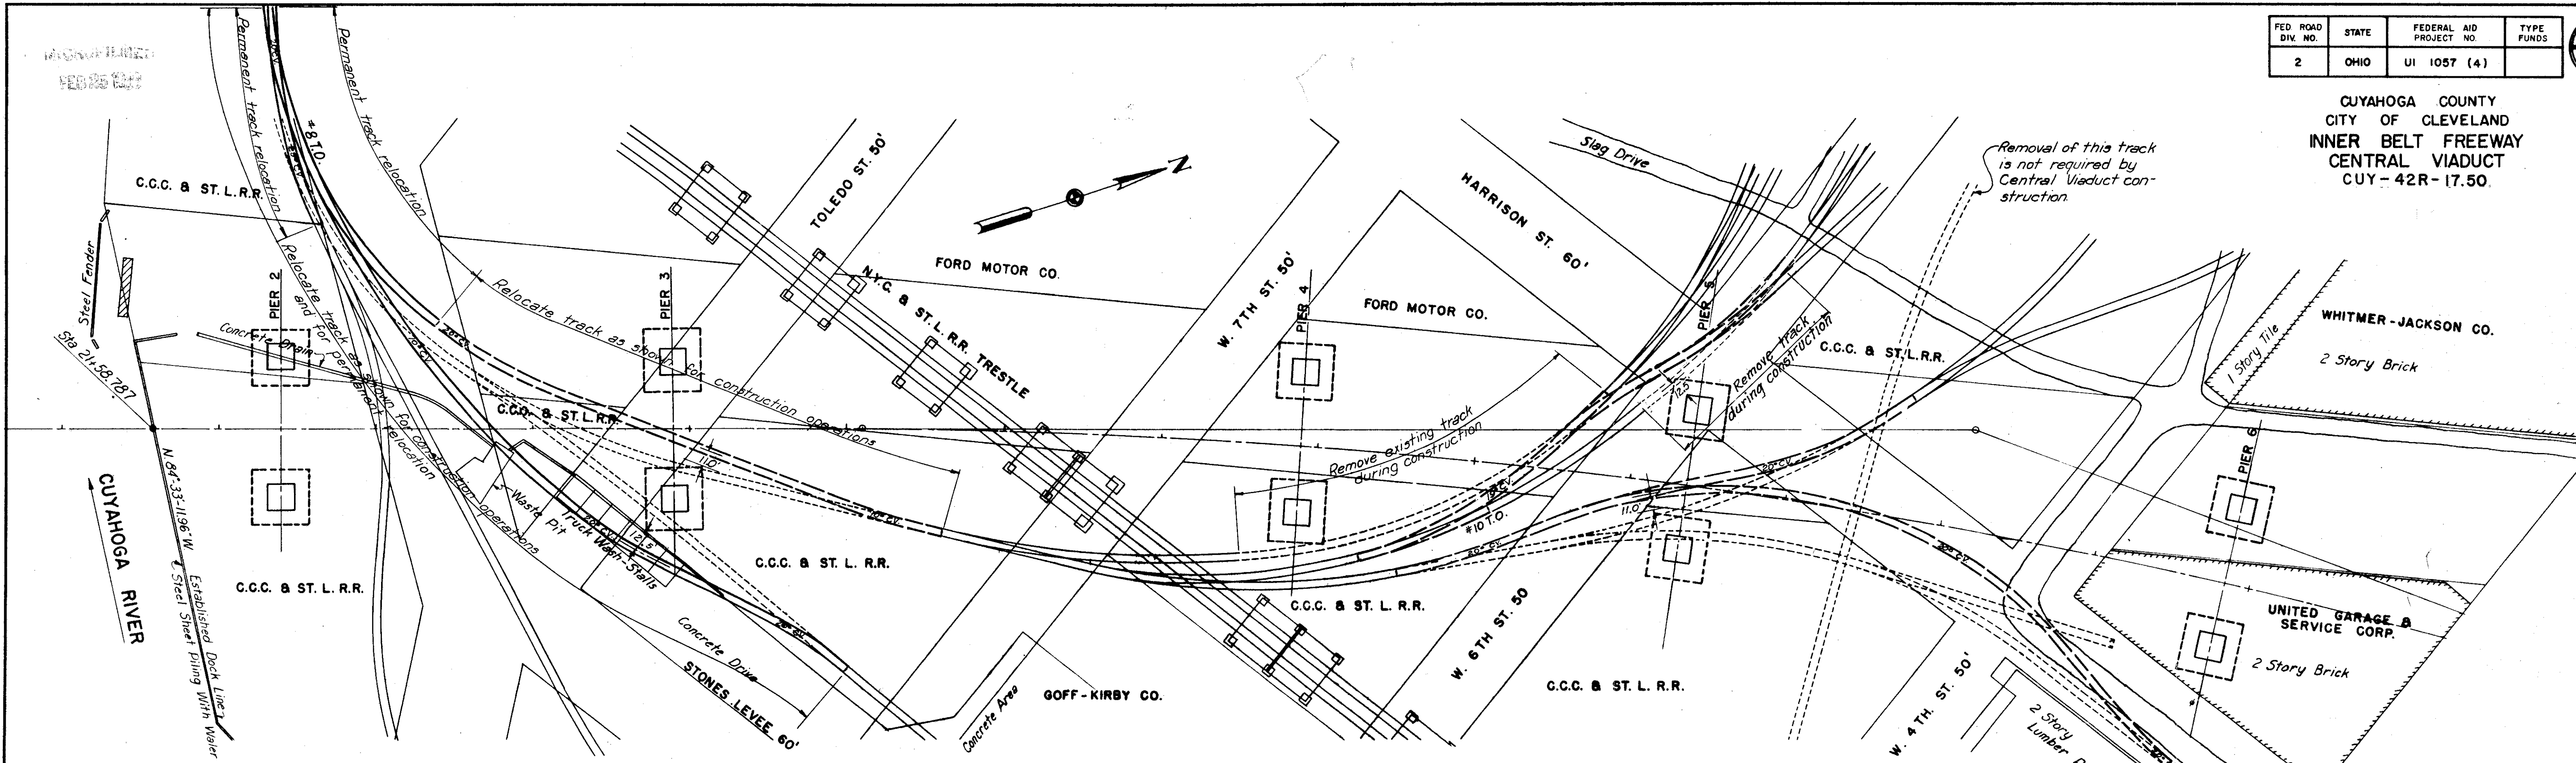


EXISTING CONDITIONS AND TRACK CHANGES
TO BE MADE FOR CONSTRUCTION OPERATIONS

- LEGEND
- Present tracks to be undisturbed.
 - Present tracks to be removed.
 - Track locations for construction conditions.
 - Permanent track locations.

FORCE ACCOUNT WORK by The New York Central System	
North of Harrison Street - B & O Transfer Track	
Preliminary Engineering	Lump sum
Construction Engineering	Lump sum
Accounting	Lump sum
Insurance	Lump sum
South of Harrison Street and East of Cuyahoga River	
Preliminary Engineering	Lump sum
Construction Engineering	Lump sum
Track Work	Lump sum
Protection of Railroad Traffic	Lump sum
Accounting	Lump sum
Insurance	Lump sum

The labor and the furnishing of materials in connection with the temporary and permanent track work as shown on this sheet and as called for in the estimate will be performed by the New York Central System by force account.

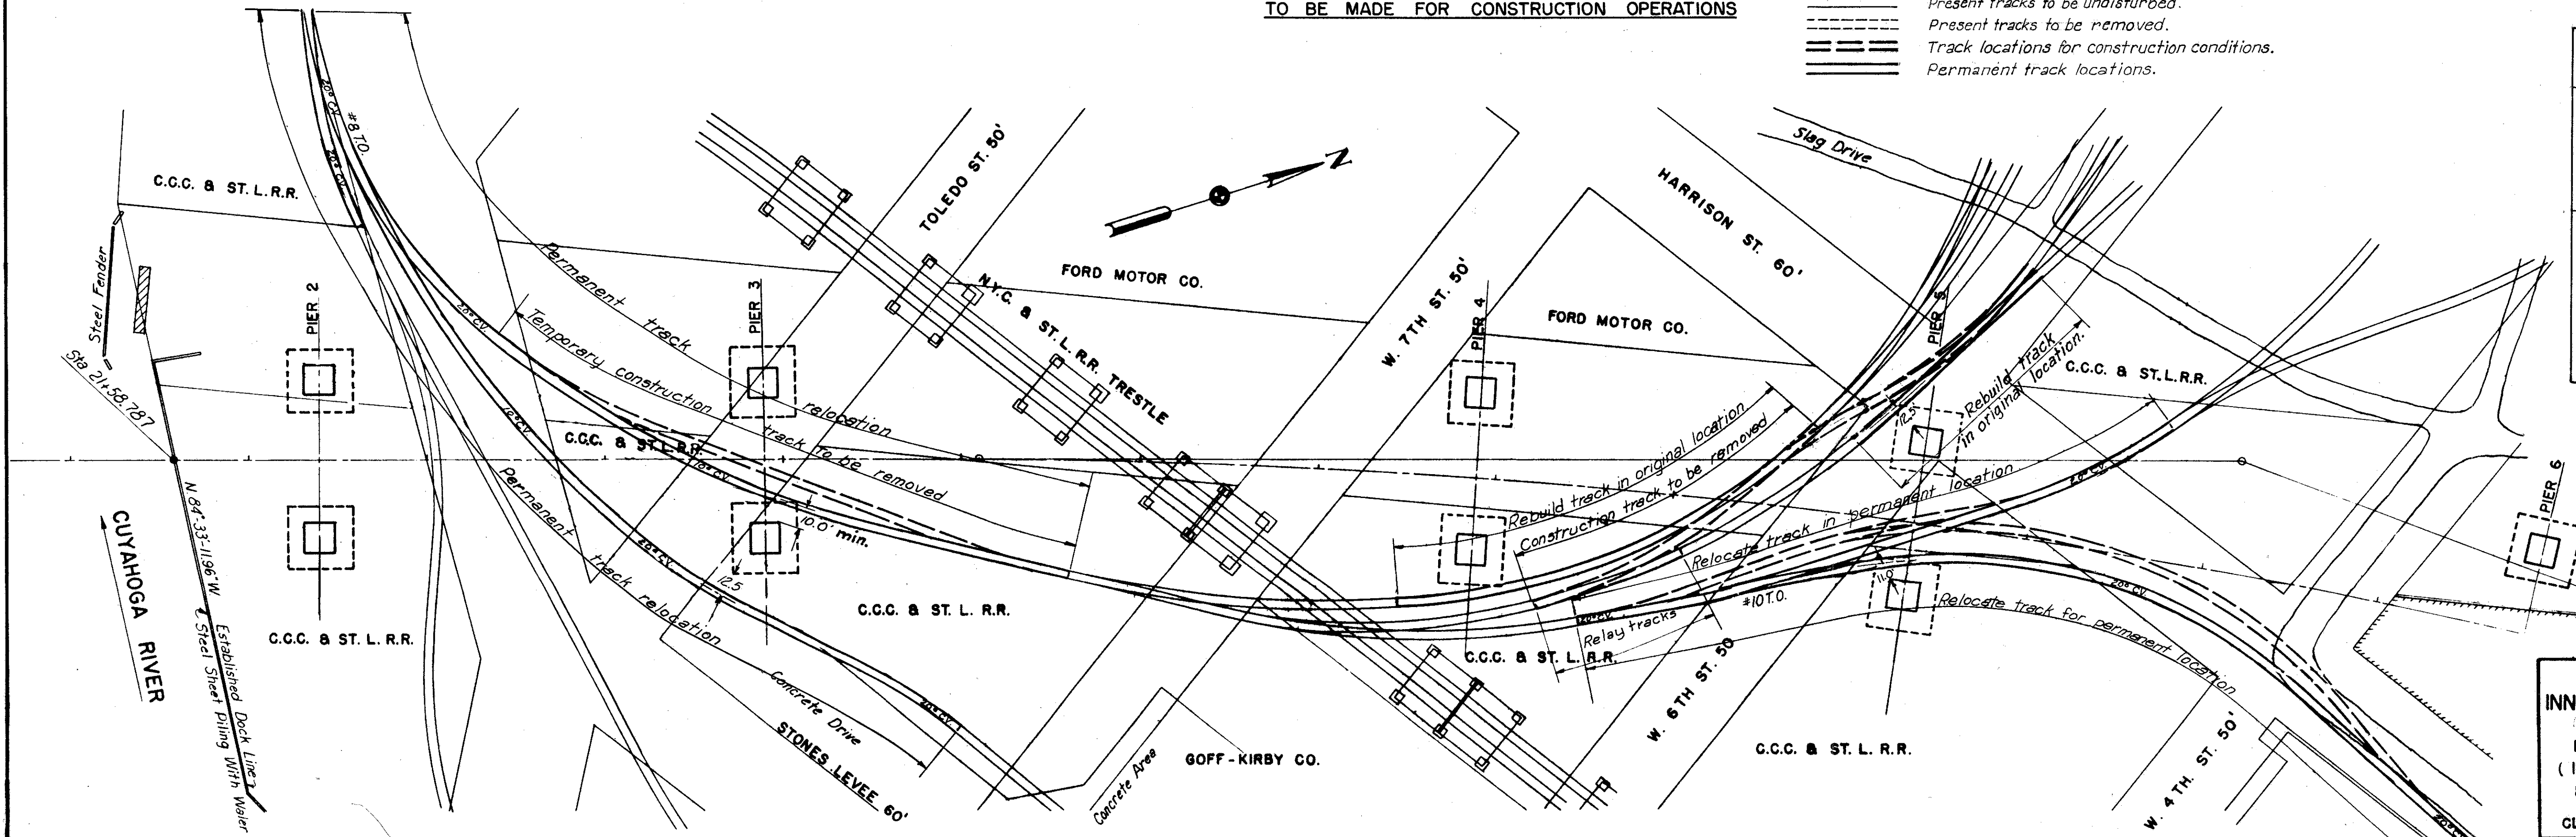

CONSTRUCTION CONDITIONS AND
PERMANENT TRACK RELOCATIONS

PART 2

U. S. ROUTE 42 RELOCATION
INNER BELT FREEWAY - CENTRAL VIADUCT

NEW YORK CENTRAL RAILROAD COMPANY
(lessee of the railway and property of the C.C.C. & ST. L. R.R.) TRACK MODIFICATIONS

CLEVELAND CUYAHOGA COUNTY OHIO

SCALE 1"=50'

MADE N.A.M. DATE 4-12-54
TRCD N.A.M. DATE 4-13-54
CKD G.A. DATE 4-15-54

HOWARD, NEEDLES, TAMMEN & BERGENDOFF
CONSULTING ENGINEERS
KANSAS CITY CLEVELAND NEW YORK






914-1A SHEET-111

UNRECORDED
FEB 25 1954


FED. ROAD DIV. NO.	STATE	FEDERAL AID PROJECT NO.	TYPE FUNDS
2	OHIO	UI 1057 (4)	

13
43

CUYAHOGA COUNTY
CITY OF CLEVELAND
INNER BELT FREEWAY
CENTRAL VIADUCT
CUY - 42 R - 17.50

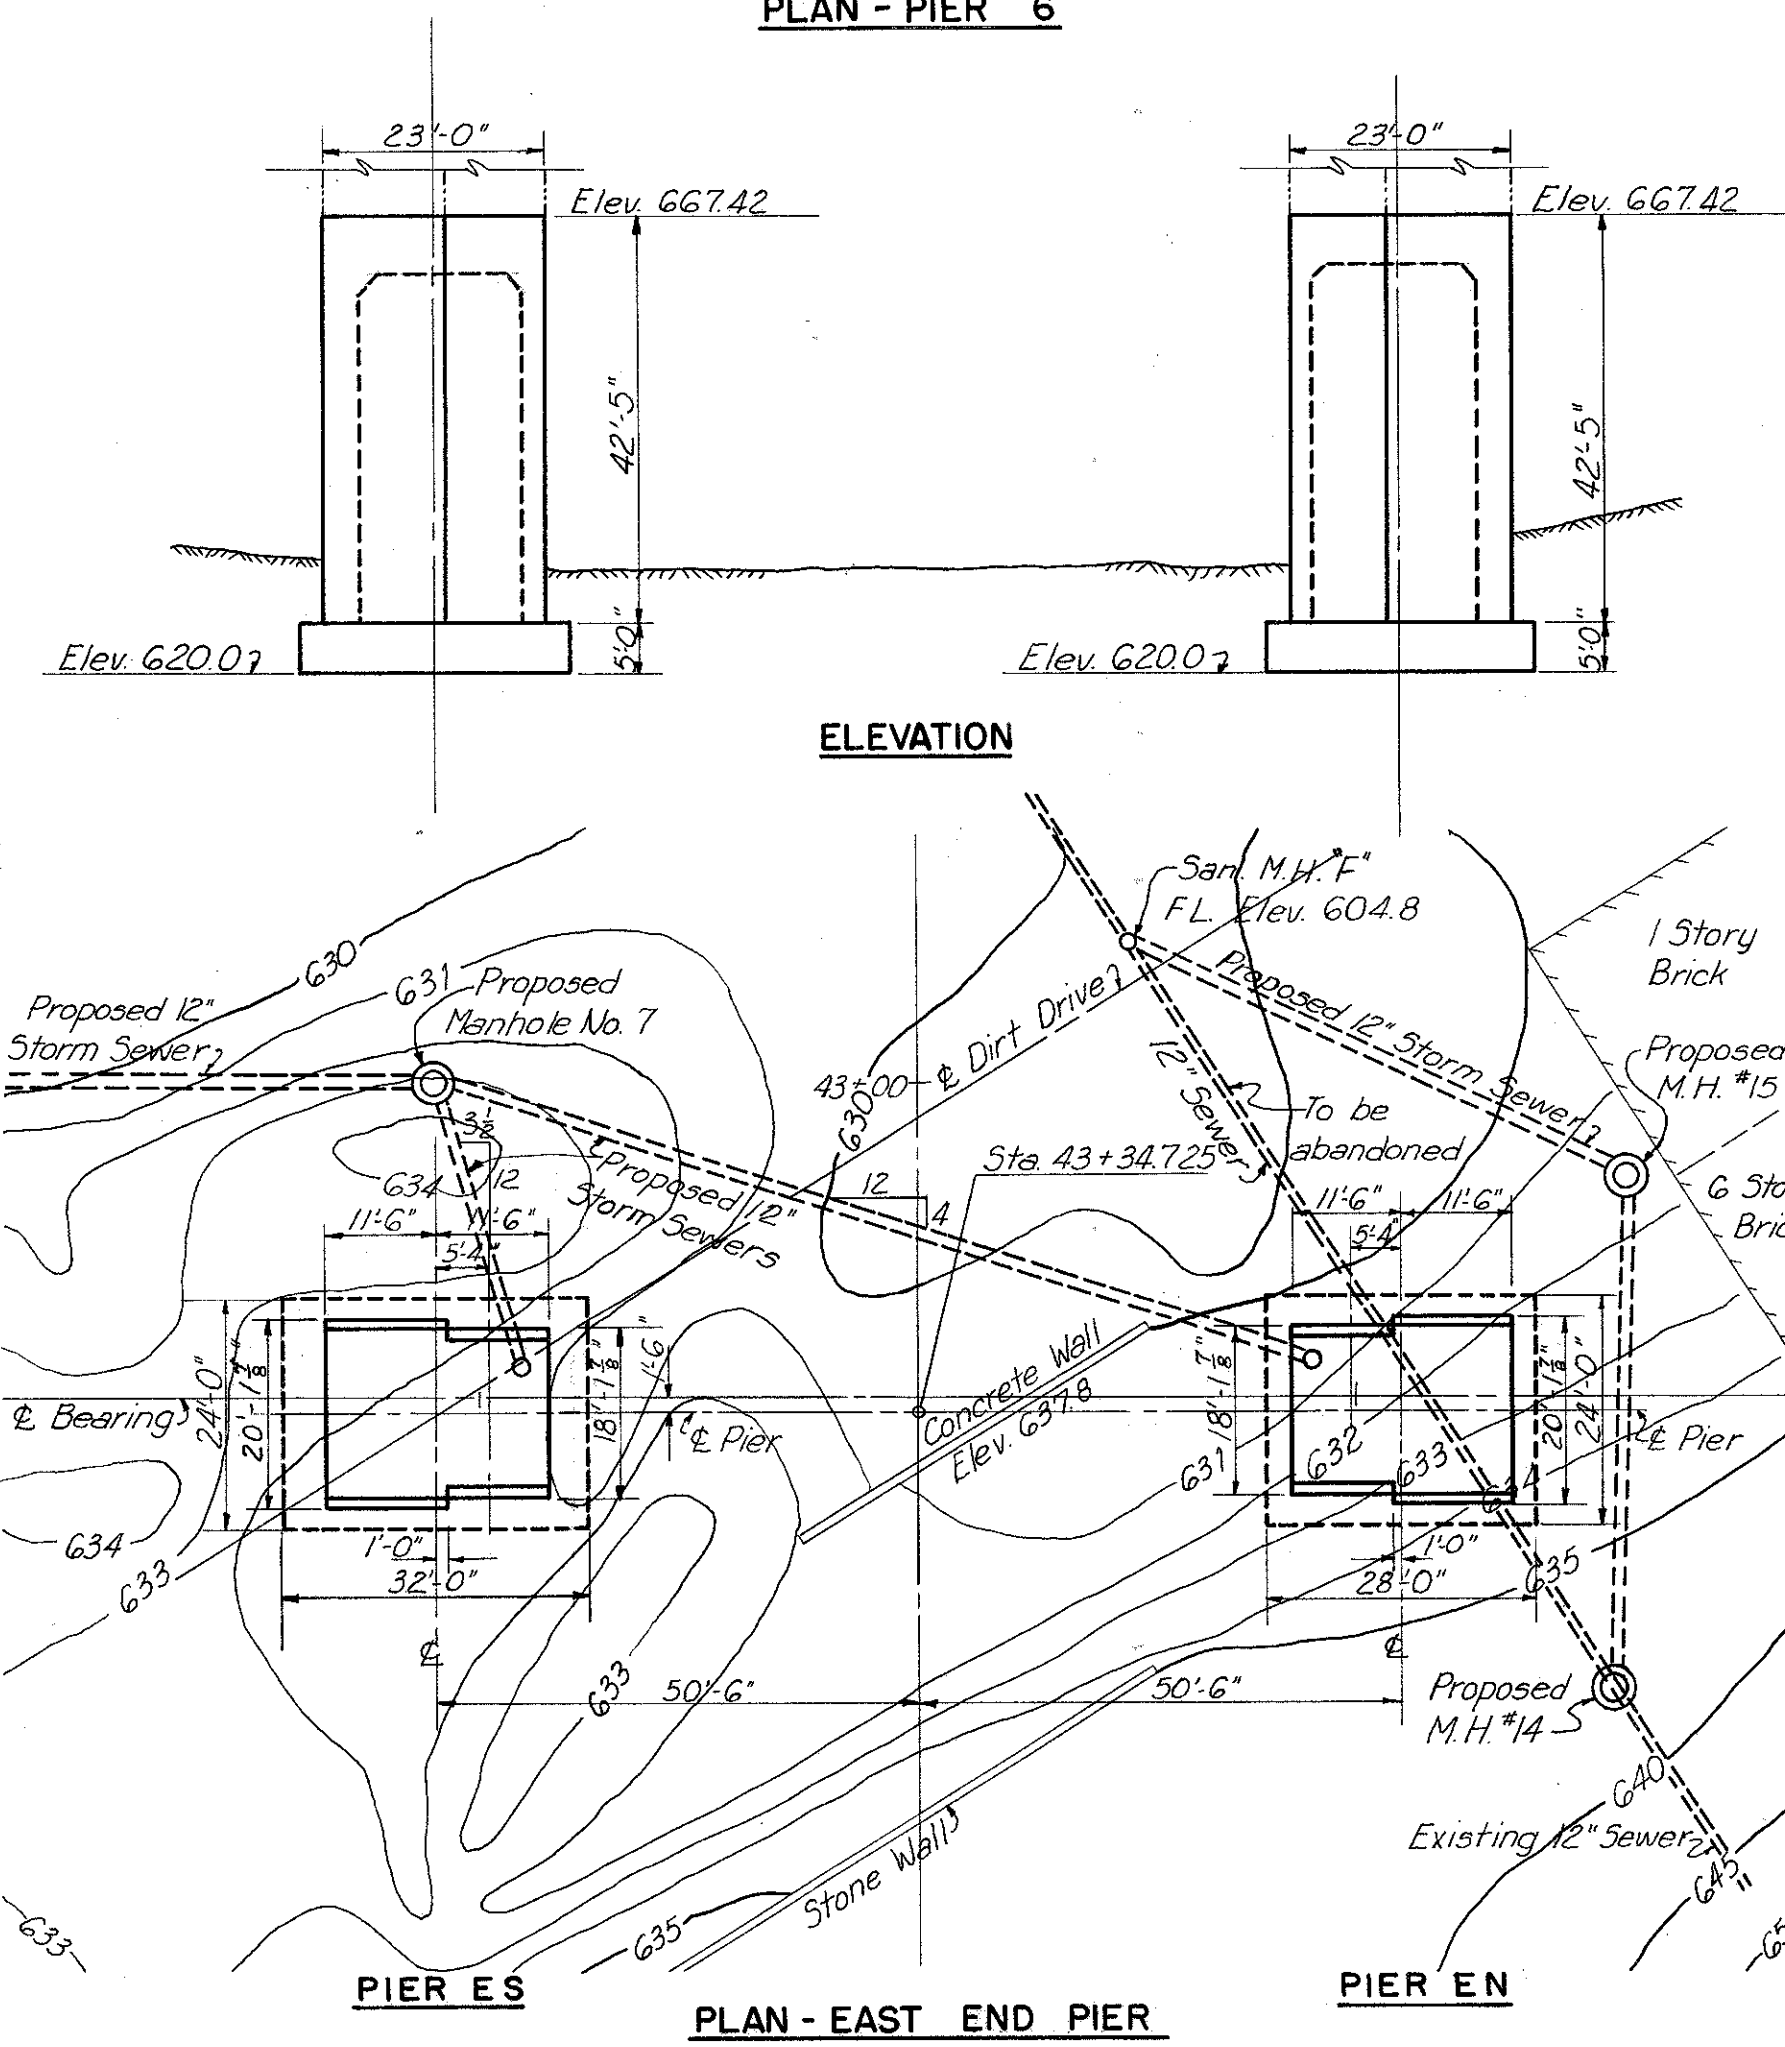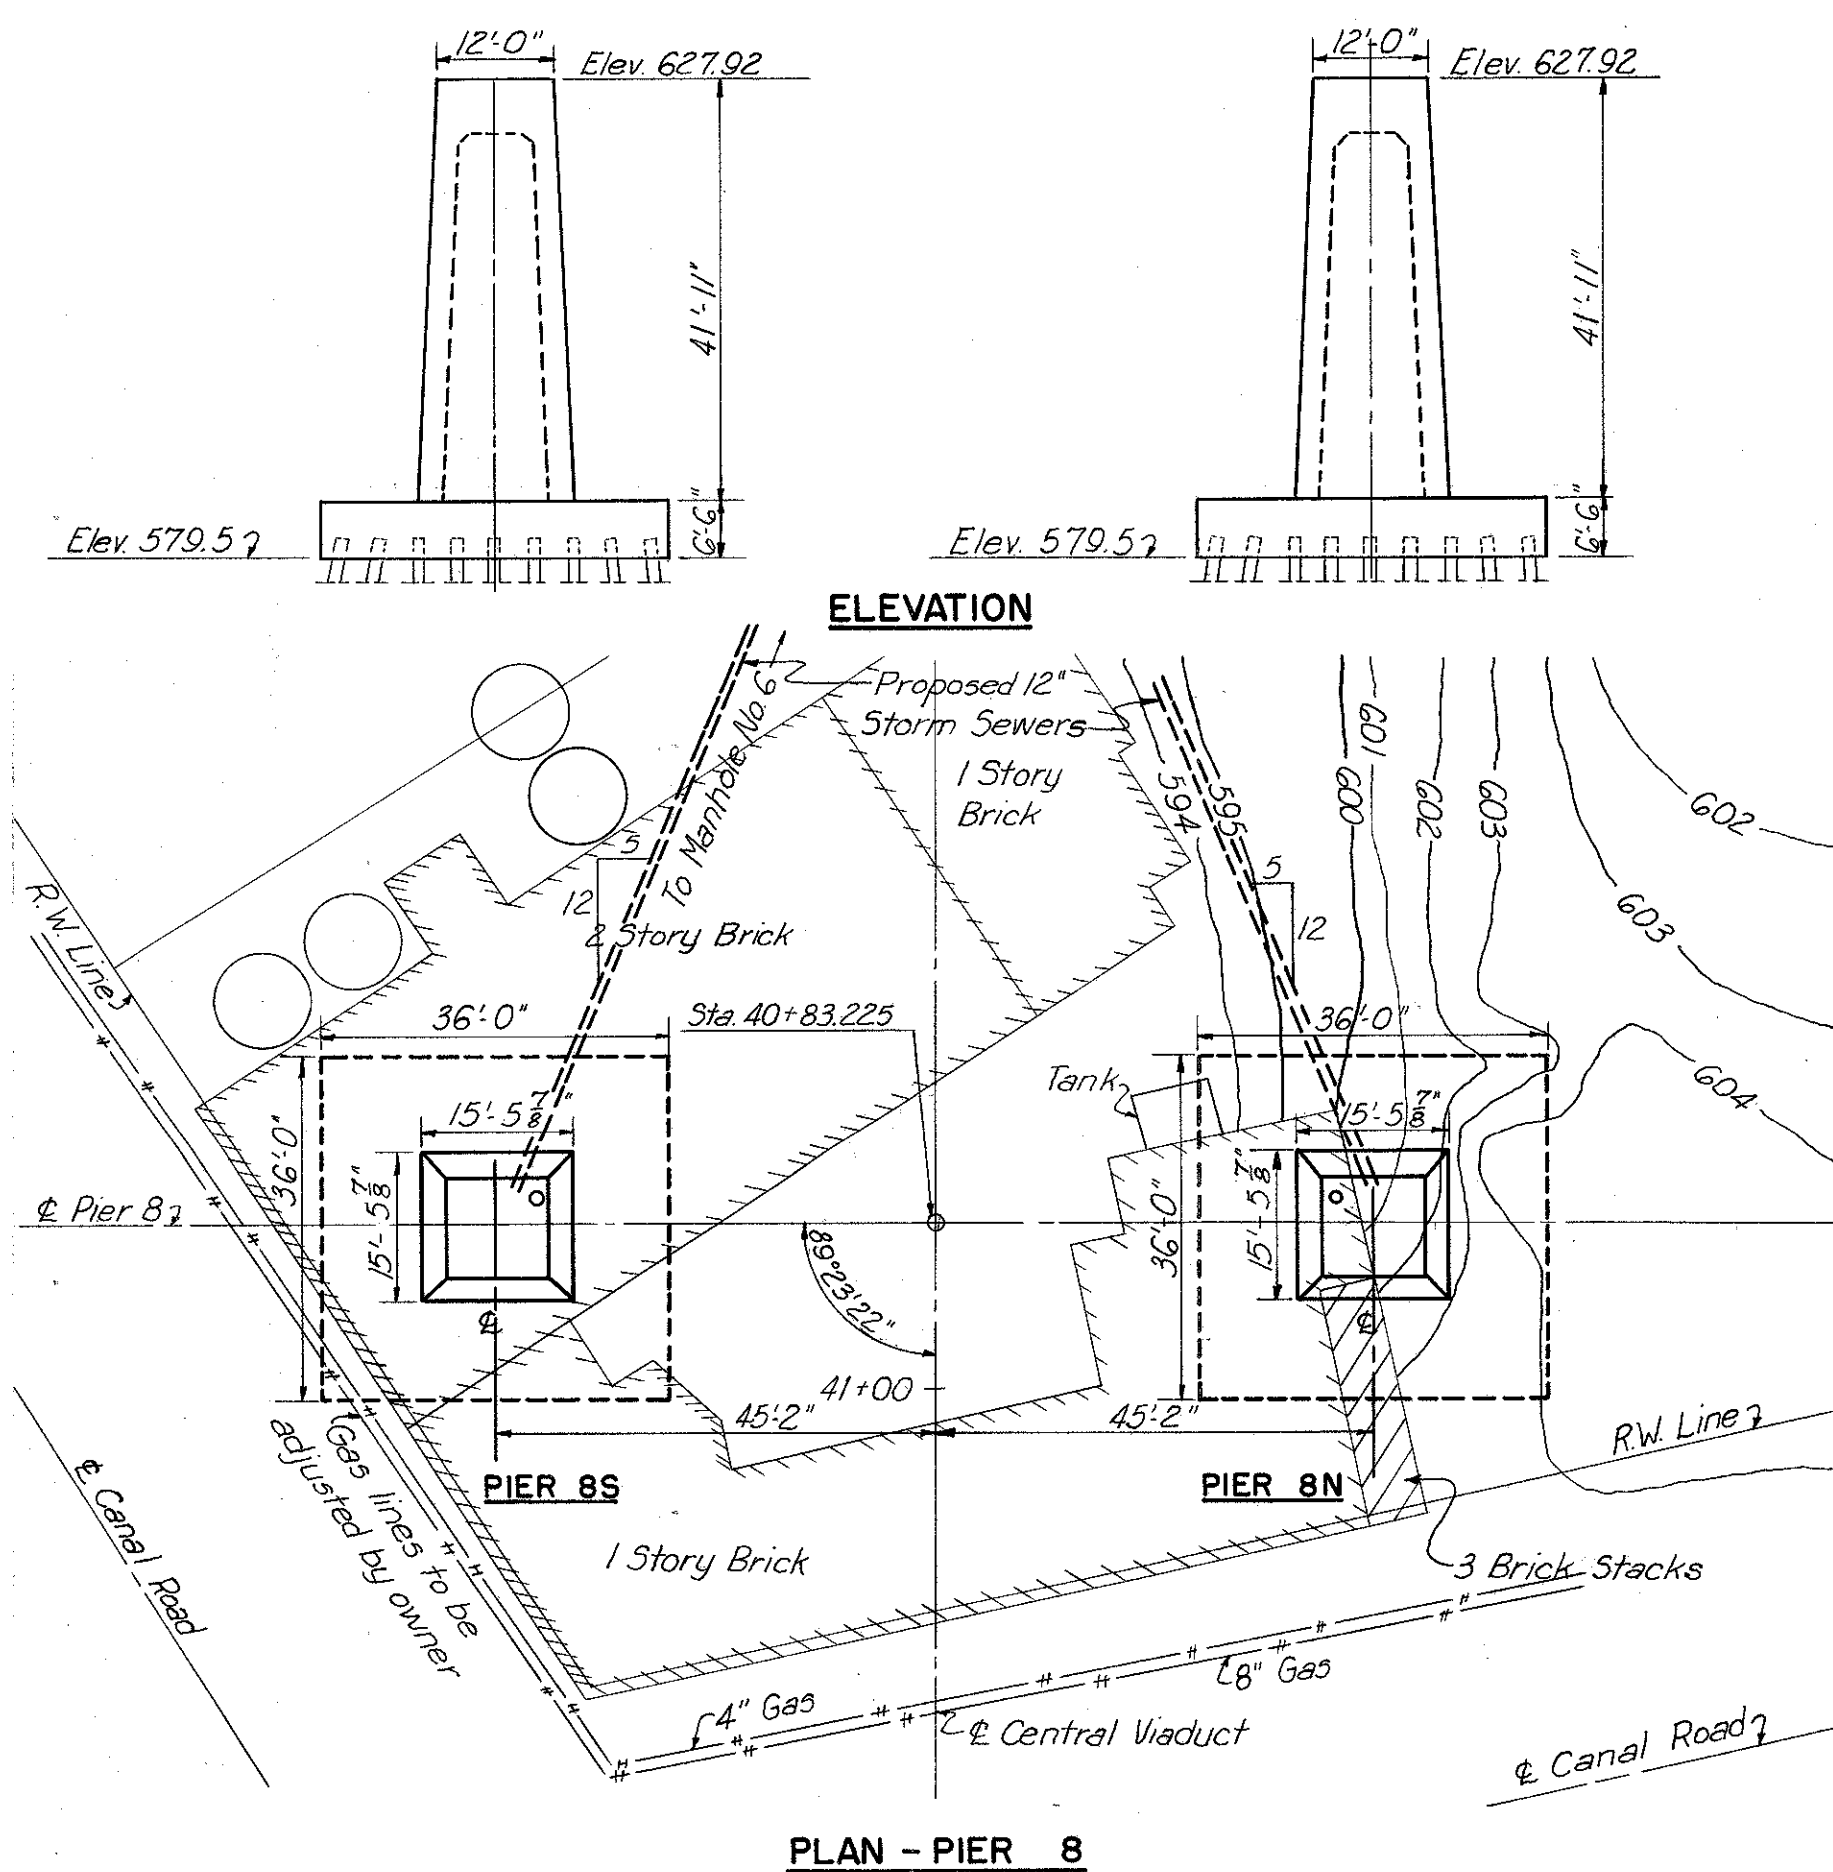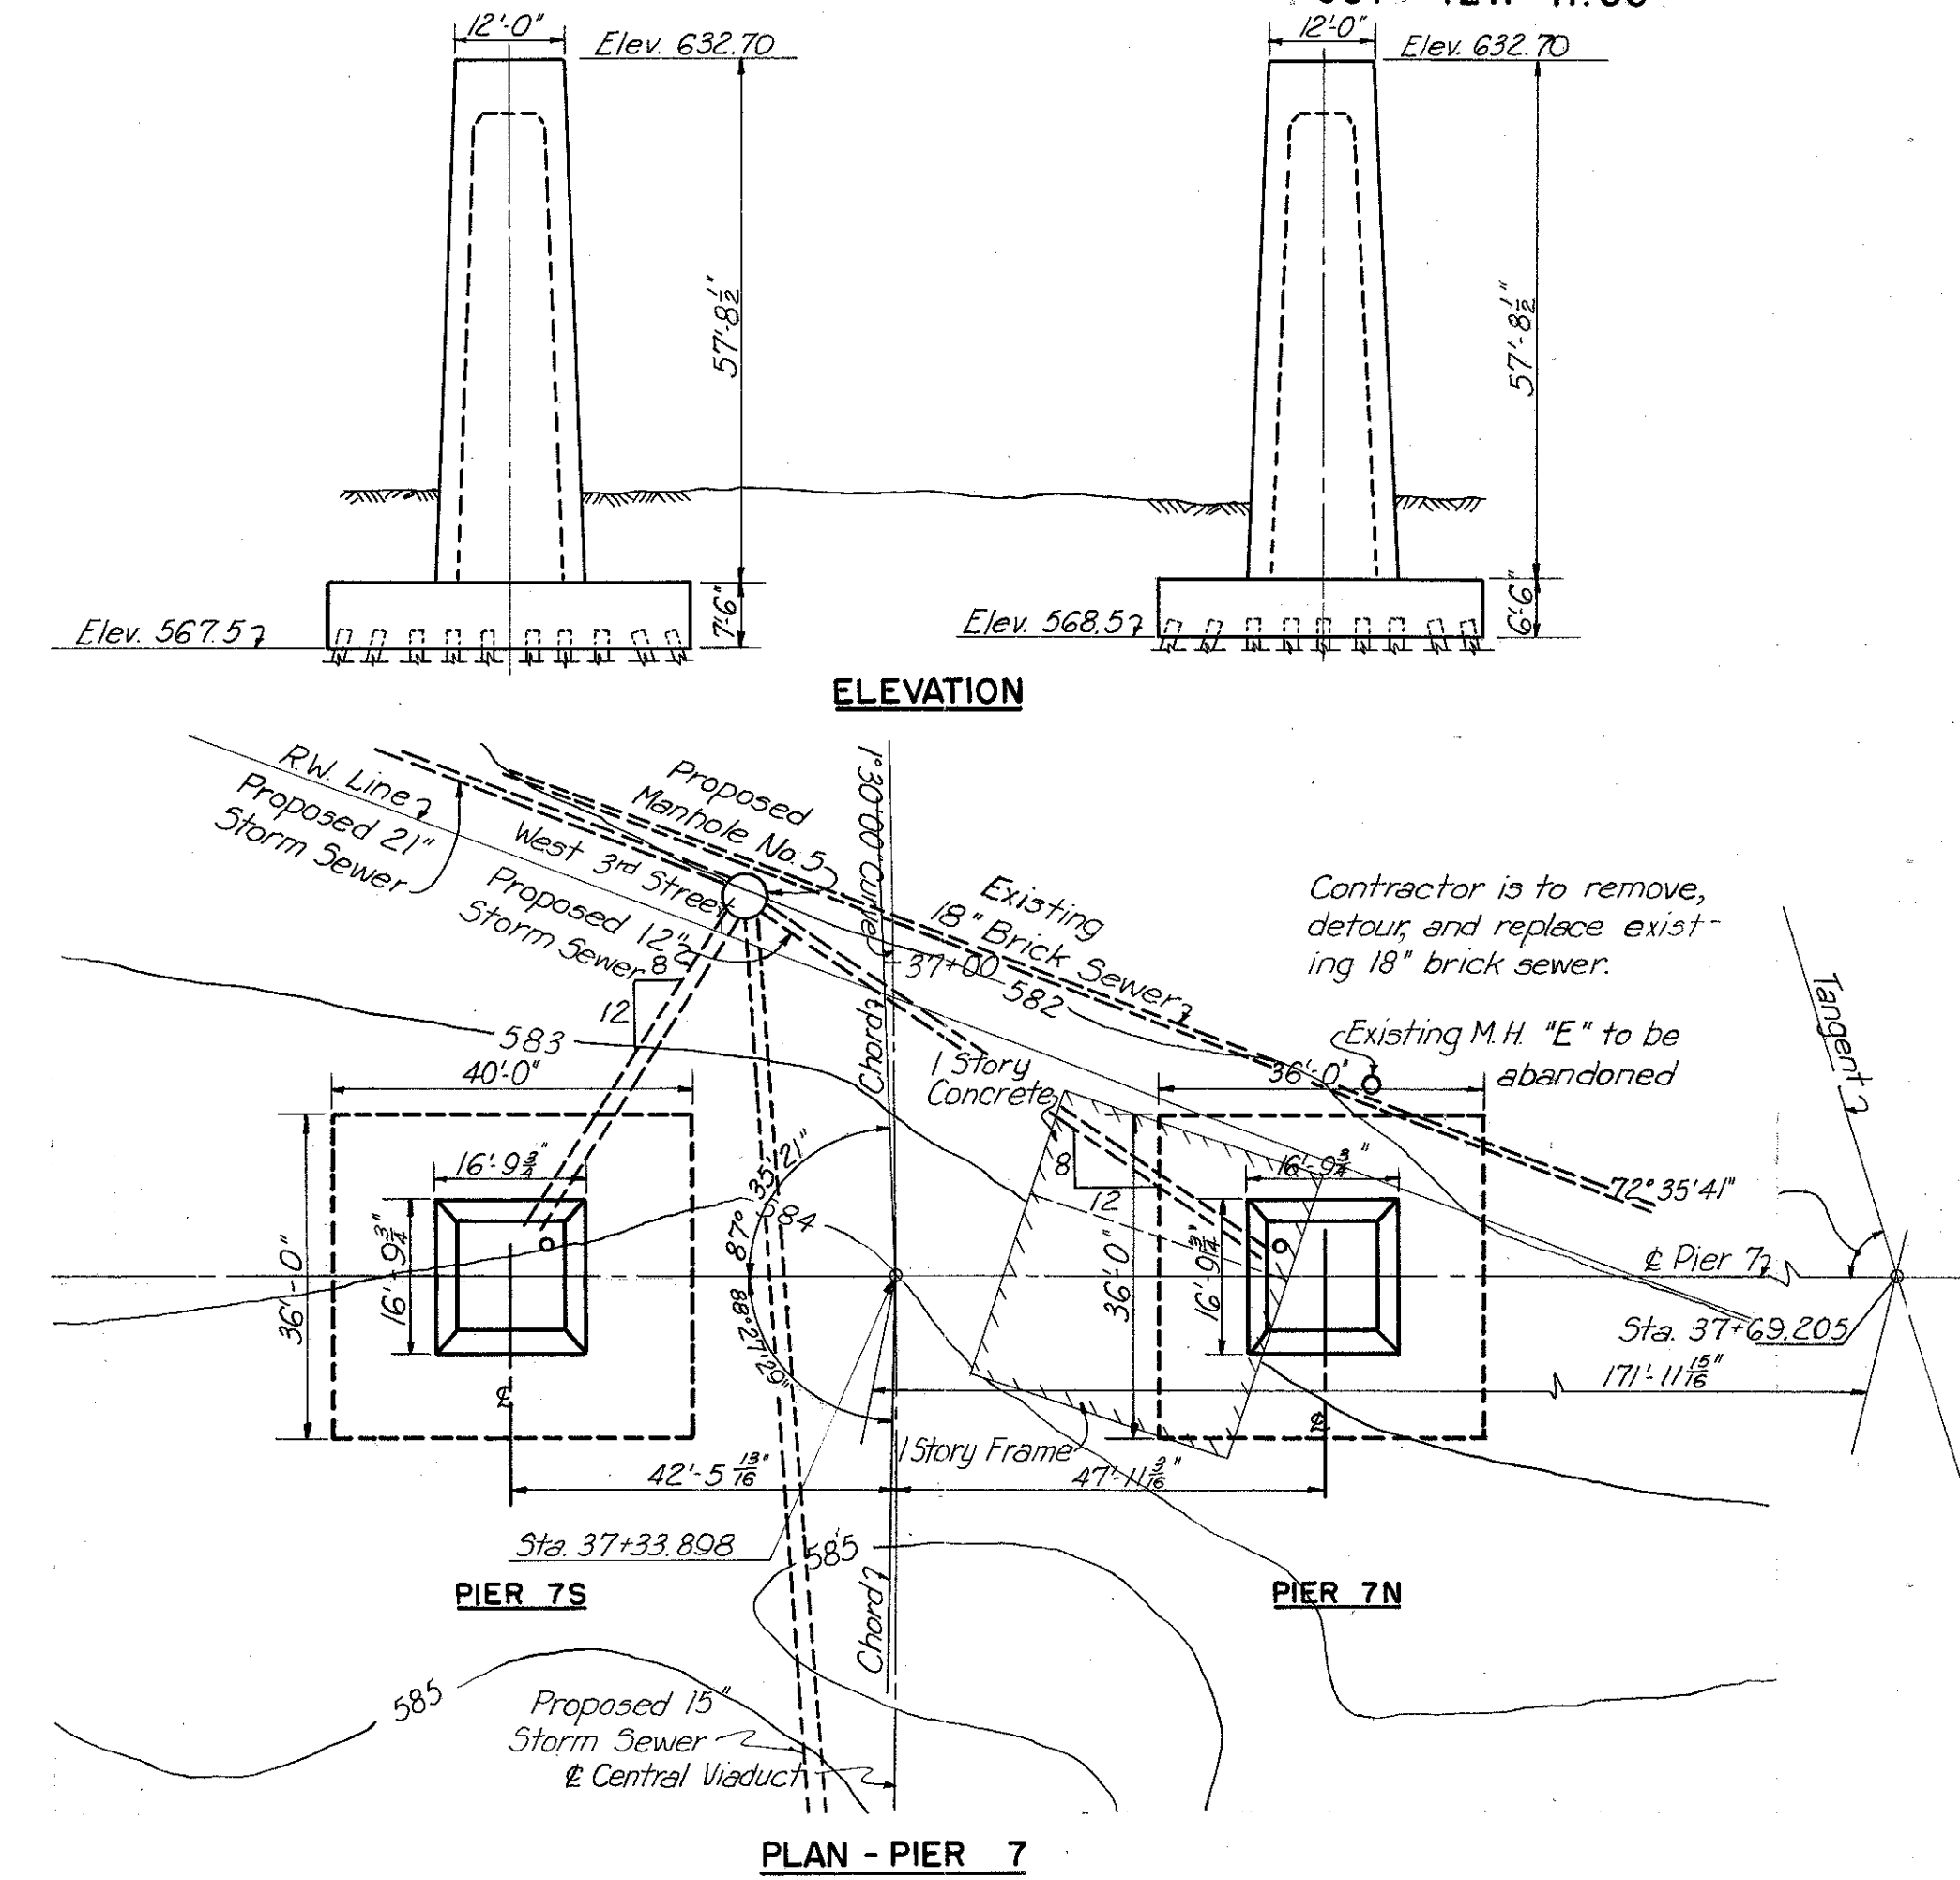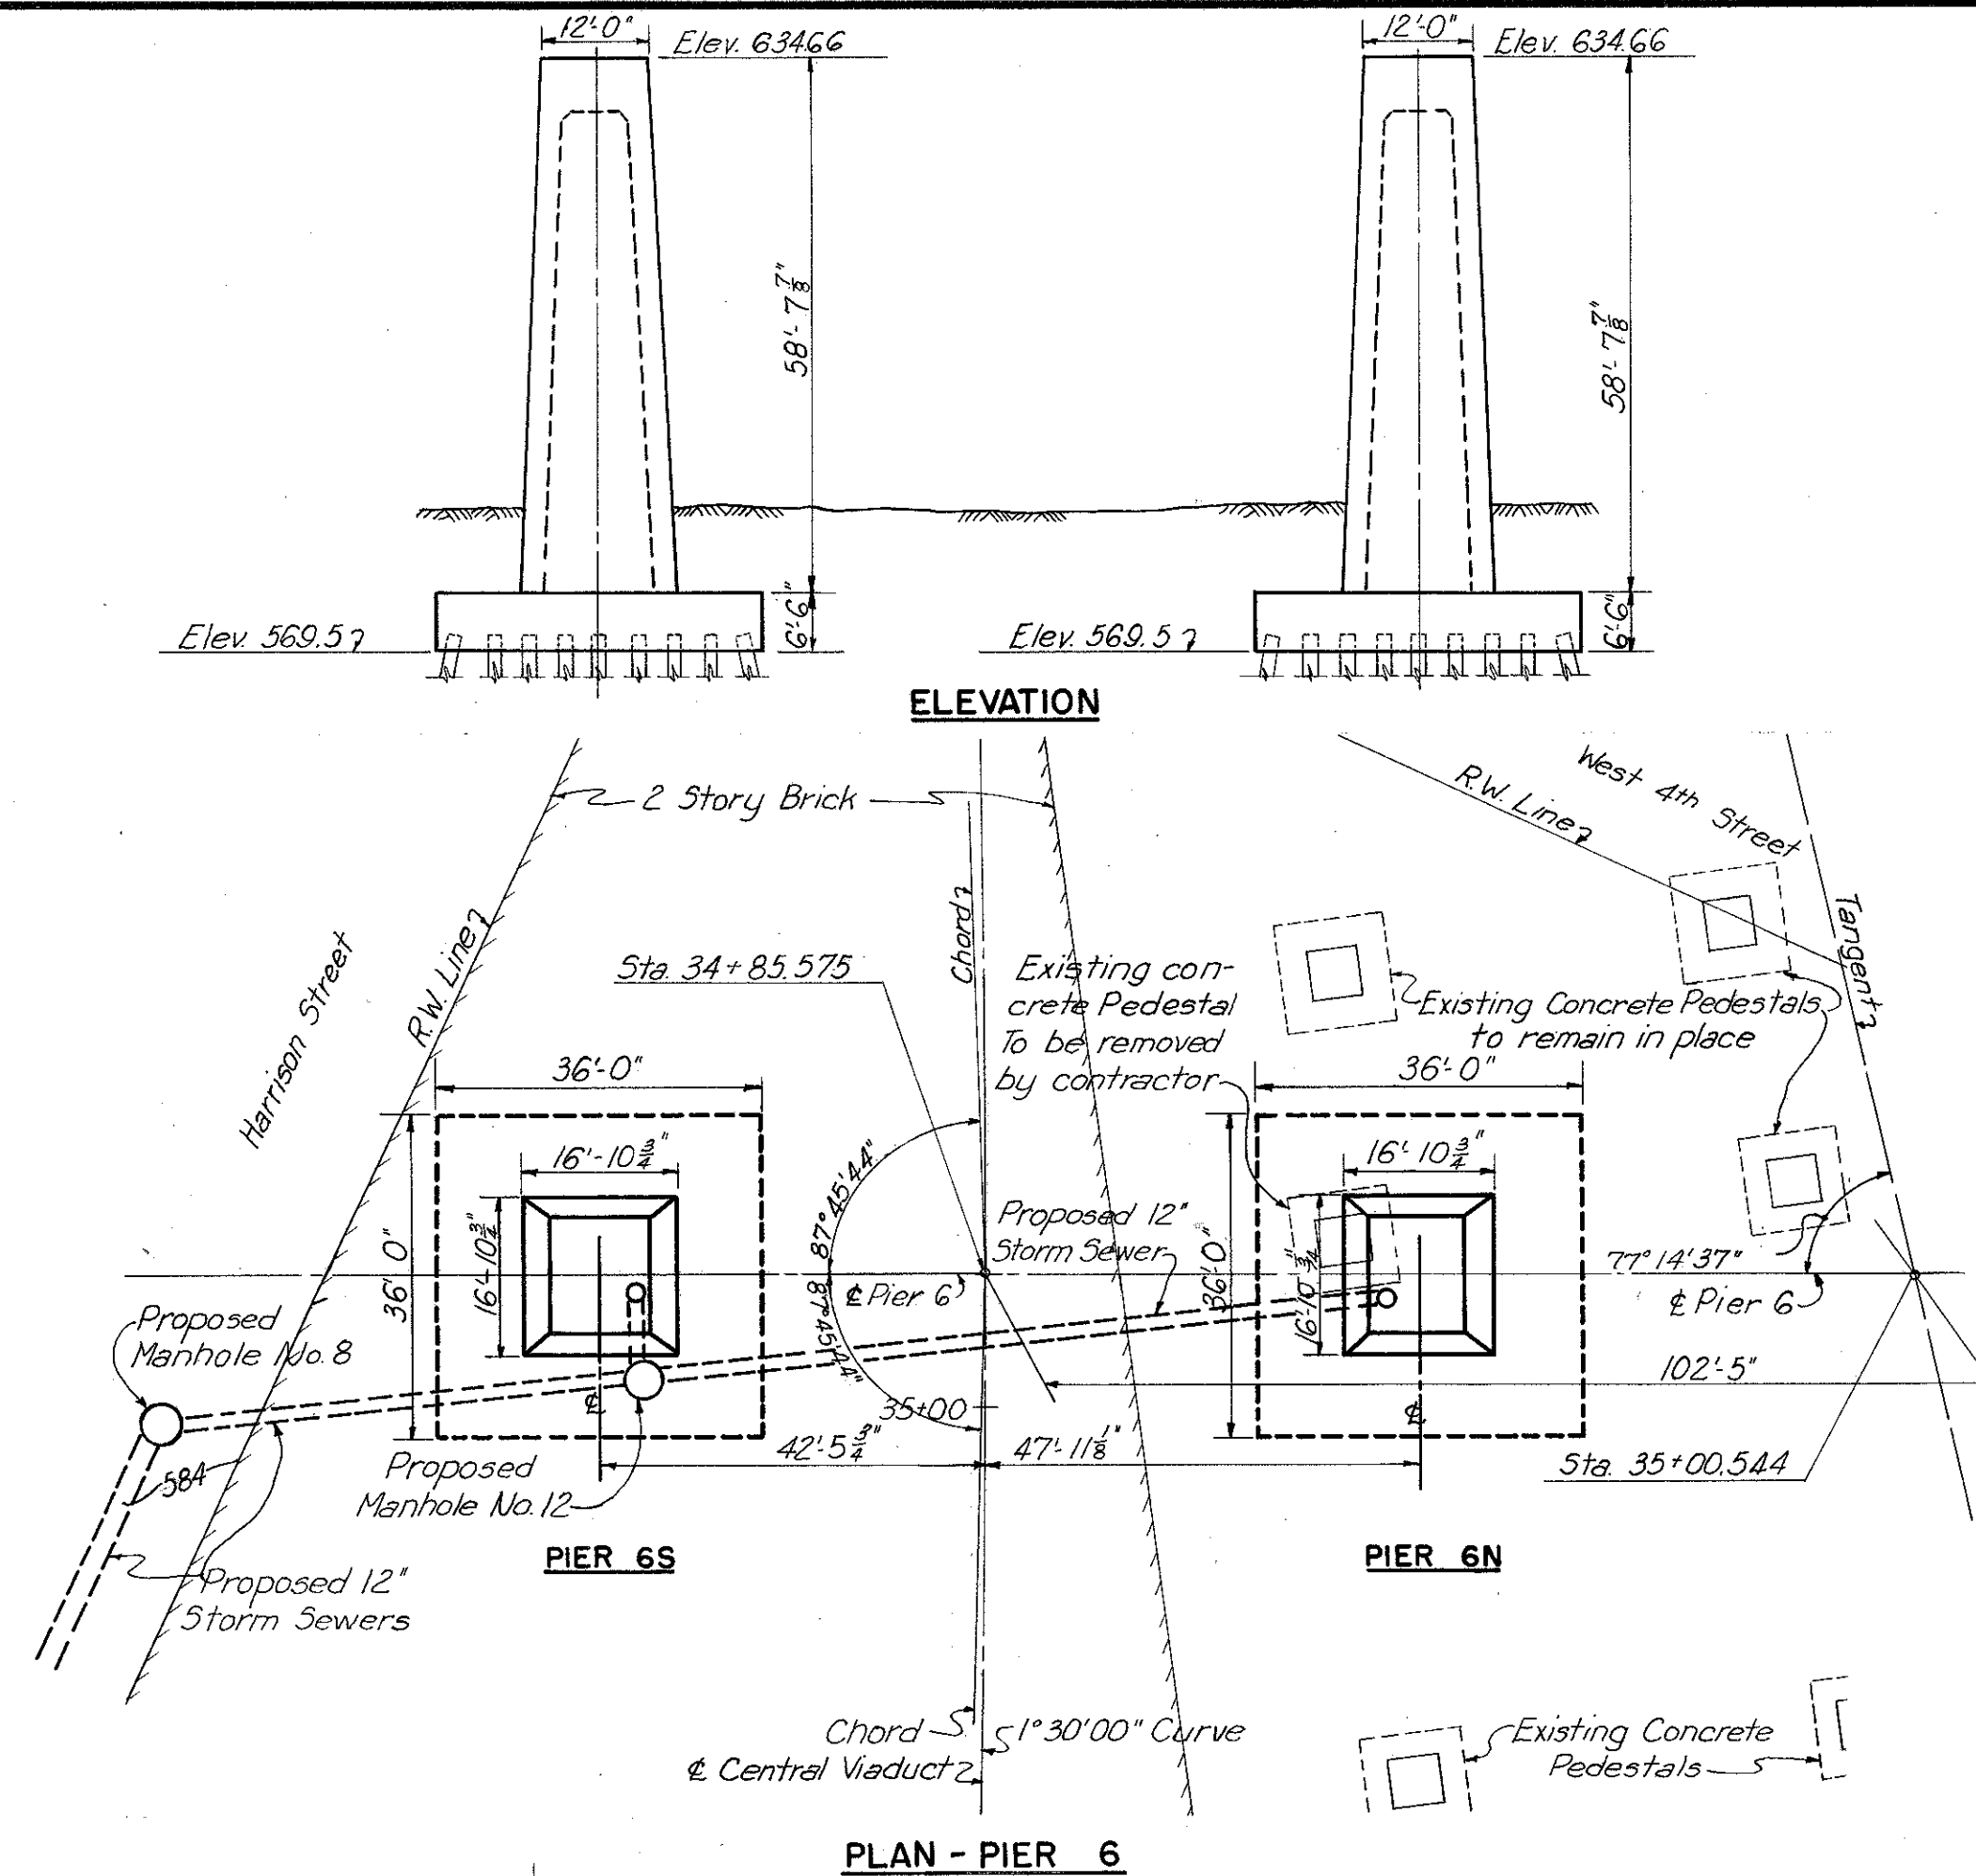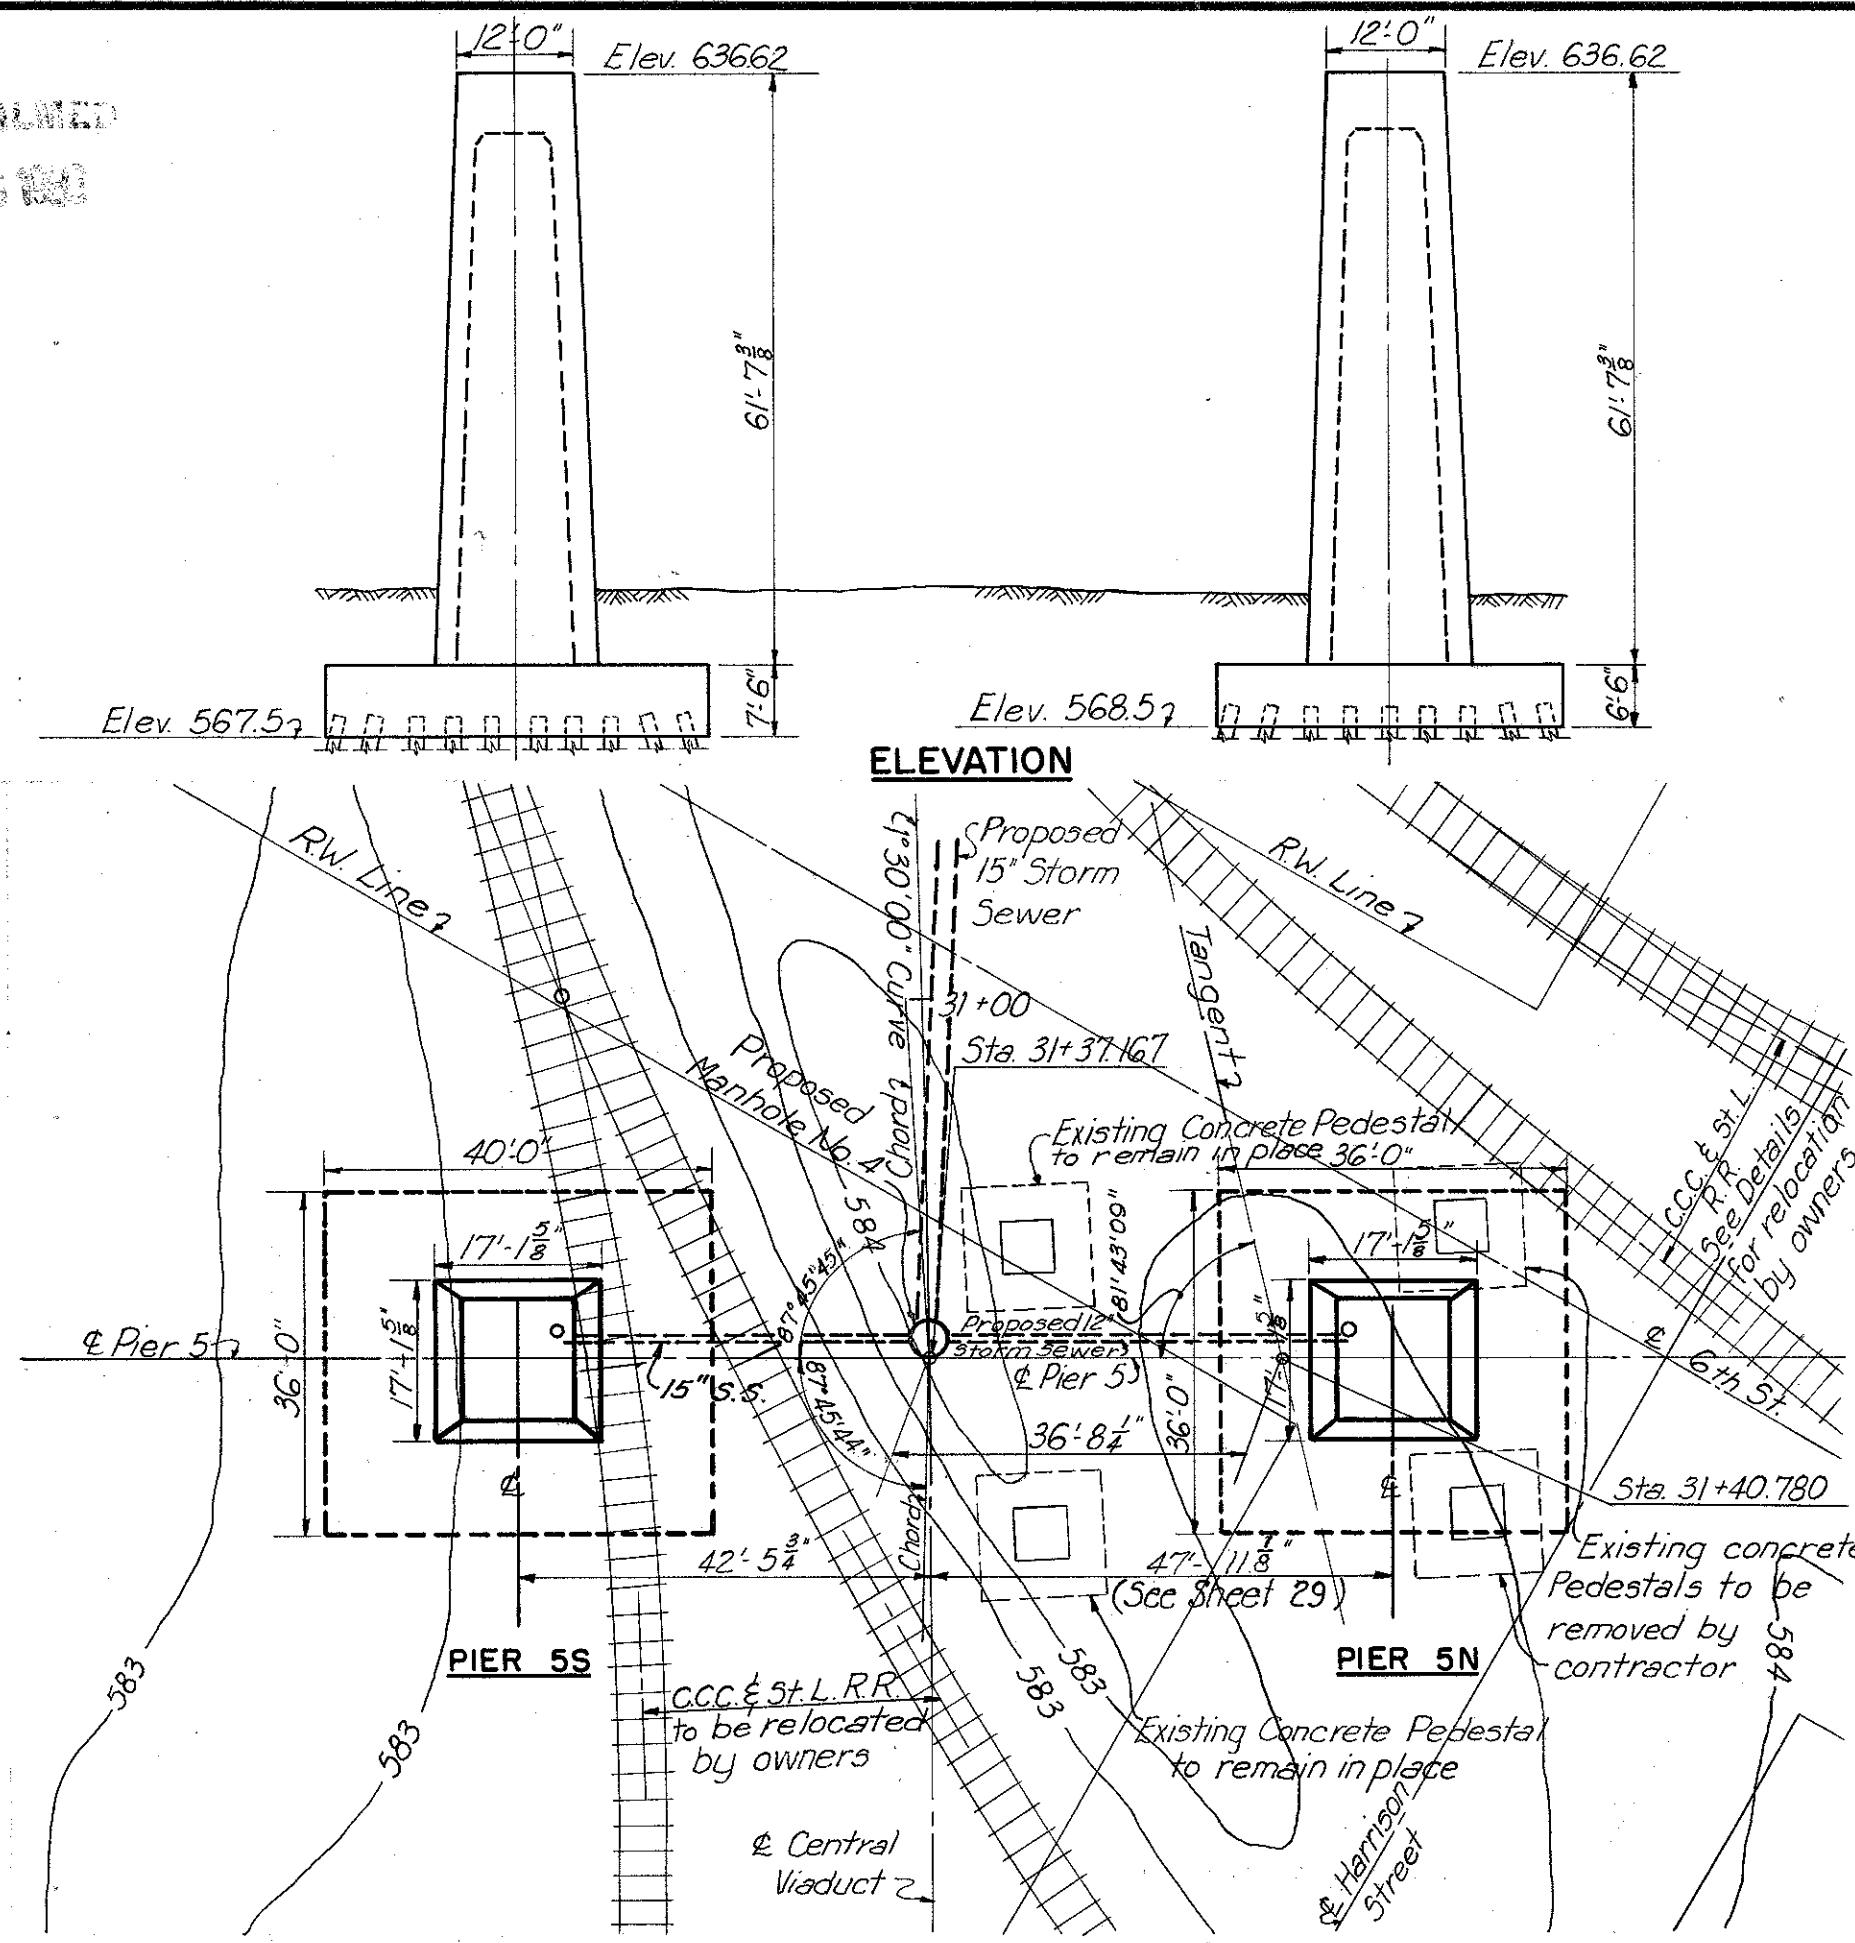

Note: For storm sewer locations, flow lines, and details, see Shs. 33 to 36 inclusive. All railroad tracks are shown in their present locations for track relocation by the owners before the contractor begins construction of pier footings, see Sh. 11.

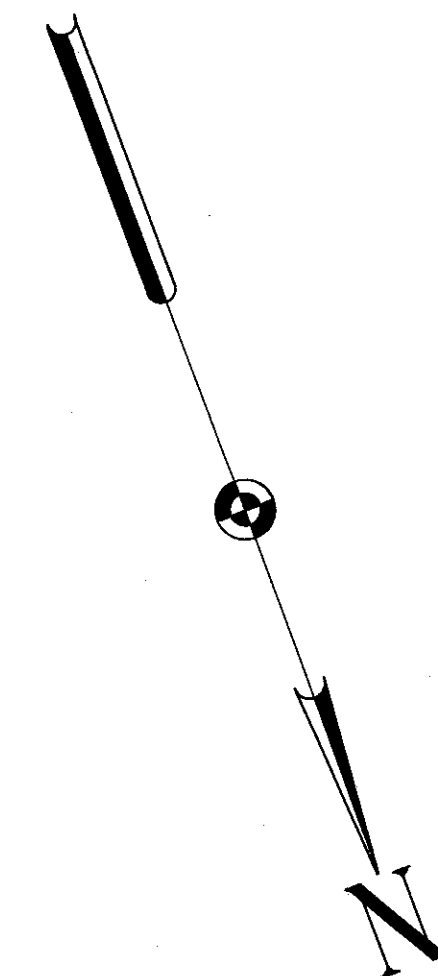

PART 2

U. S. ROUTE 42 RELOCATION
INNER BELT FREEWAY - CENTRAL VIADUCT

EXISTING CONDITIONS AT
PIERS 5 TO 8 INC. AND EAST END PIER

CLEVELAND CUYAHOGA COUNTY OHIO

SCALE: 1" = 20'-0"
MADE R.K. DATE 1-15-54
TRCD N.A.M. DATE 6-15-54
CKD C.J.C. DATE 6-17-54


HOWARD, NEEDLES, TAMMEN & BERGENDOFF
CONSULTING ENGINEERS
KANSAS CITY CLEVELAND NEW YORK

914-1A SHEET 1.13


FED. ROAD DIV. NO.	STATE	FEDERAL AID PROJECT NO.	TYPE FUNDS
2	OHIO	UI 1057 (4)	

14
43


CUYAHOGA COUNTY
CITY OF CLEVELAND
INNER BELT FREEWAY
CENTRAL VIADUCT
CUY - 42R-17.50

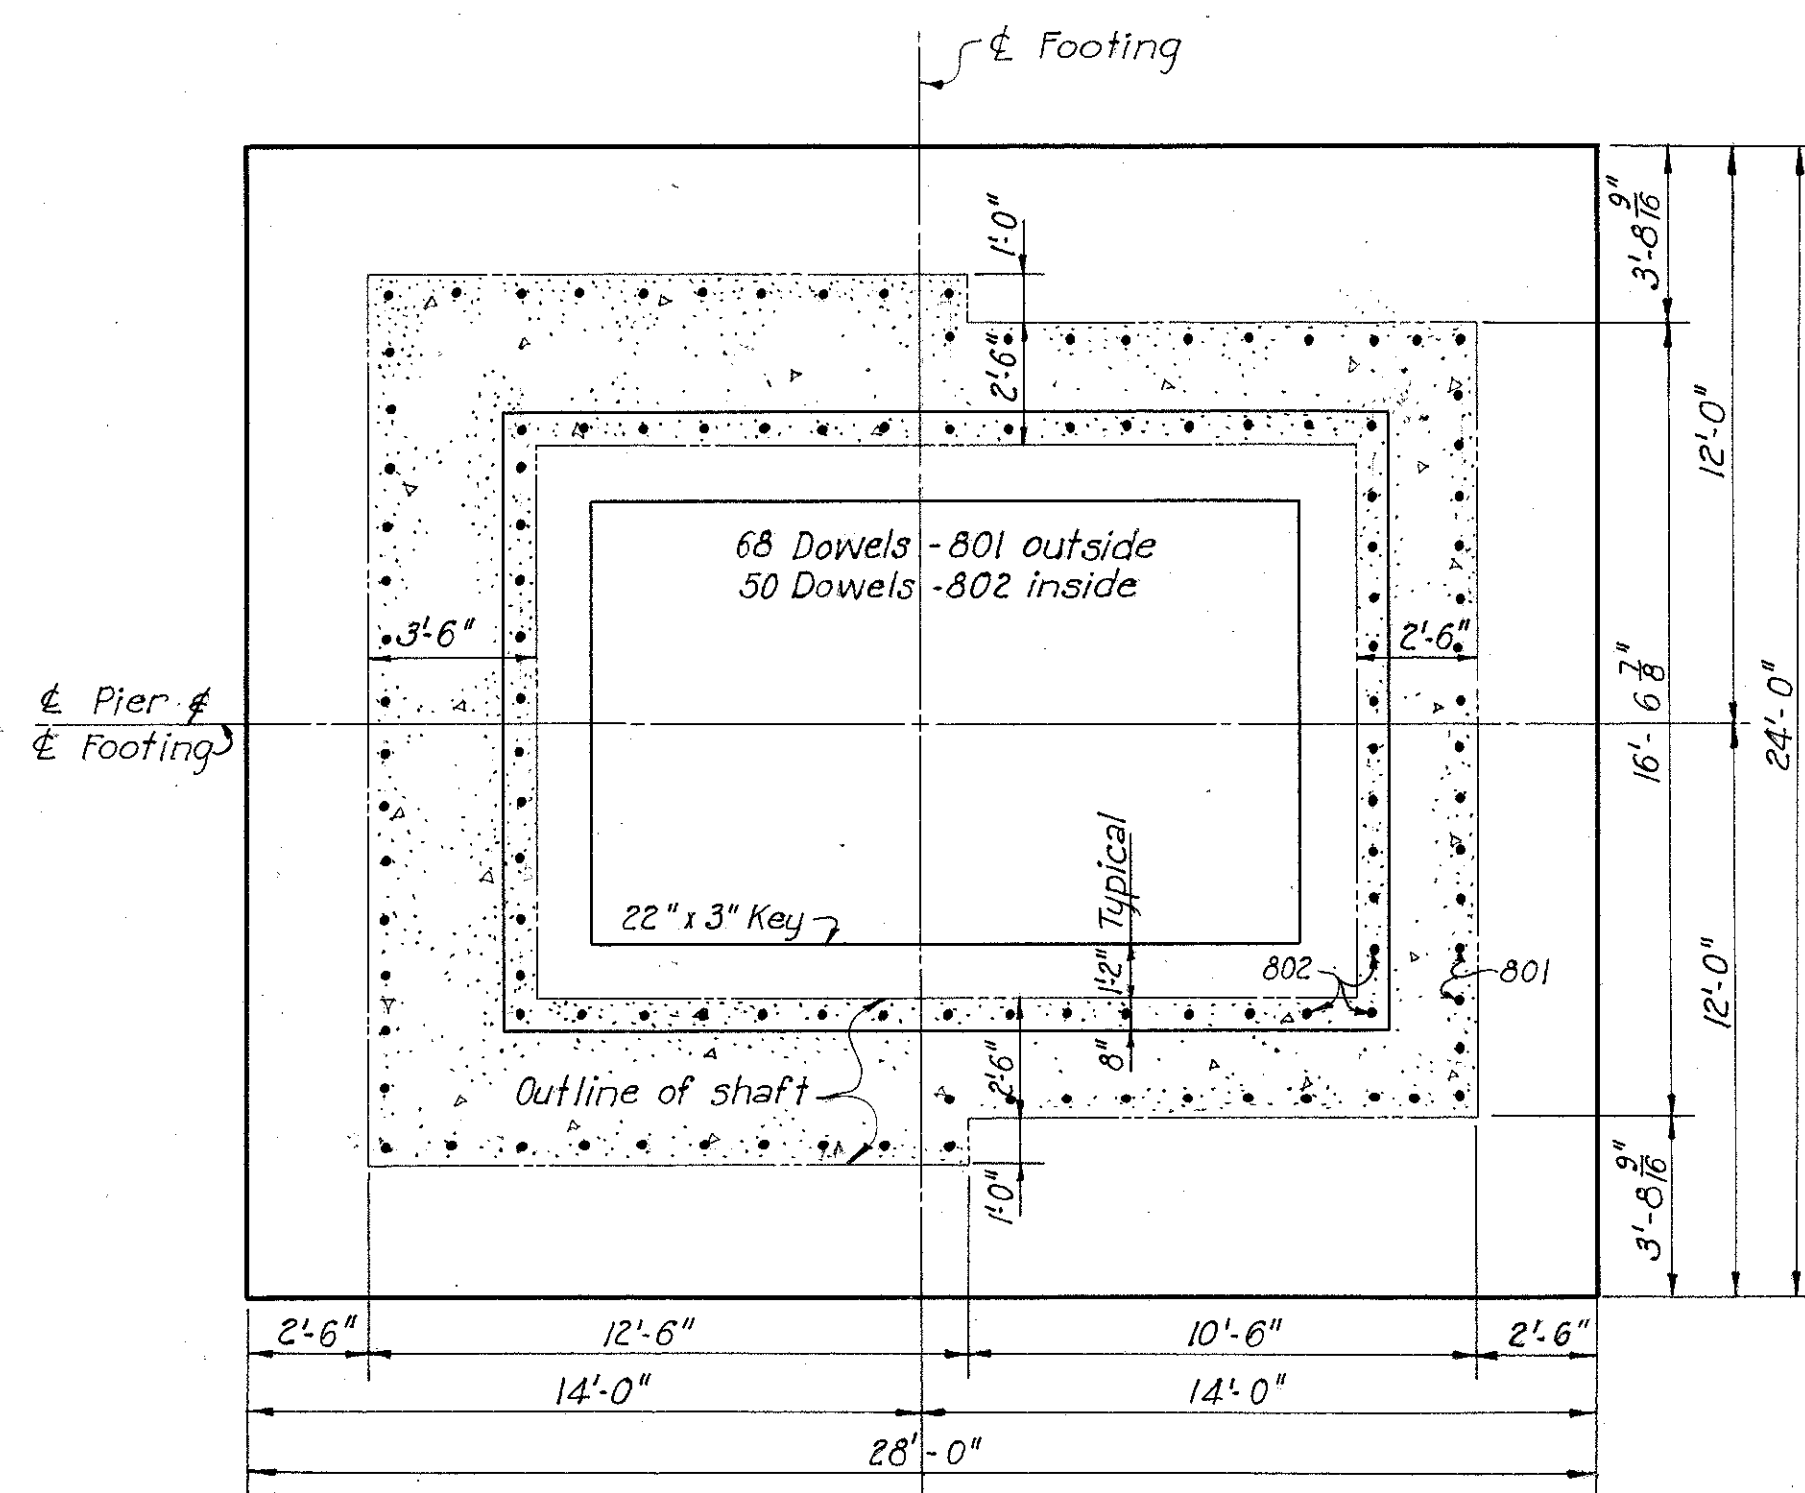


FOOTING PLAN WS

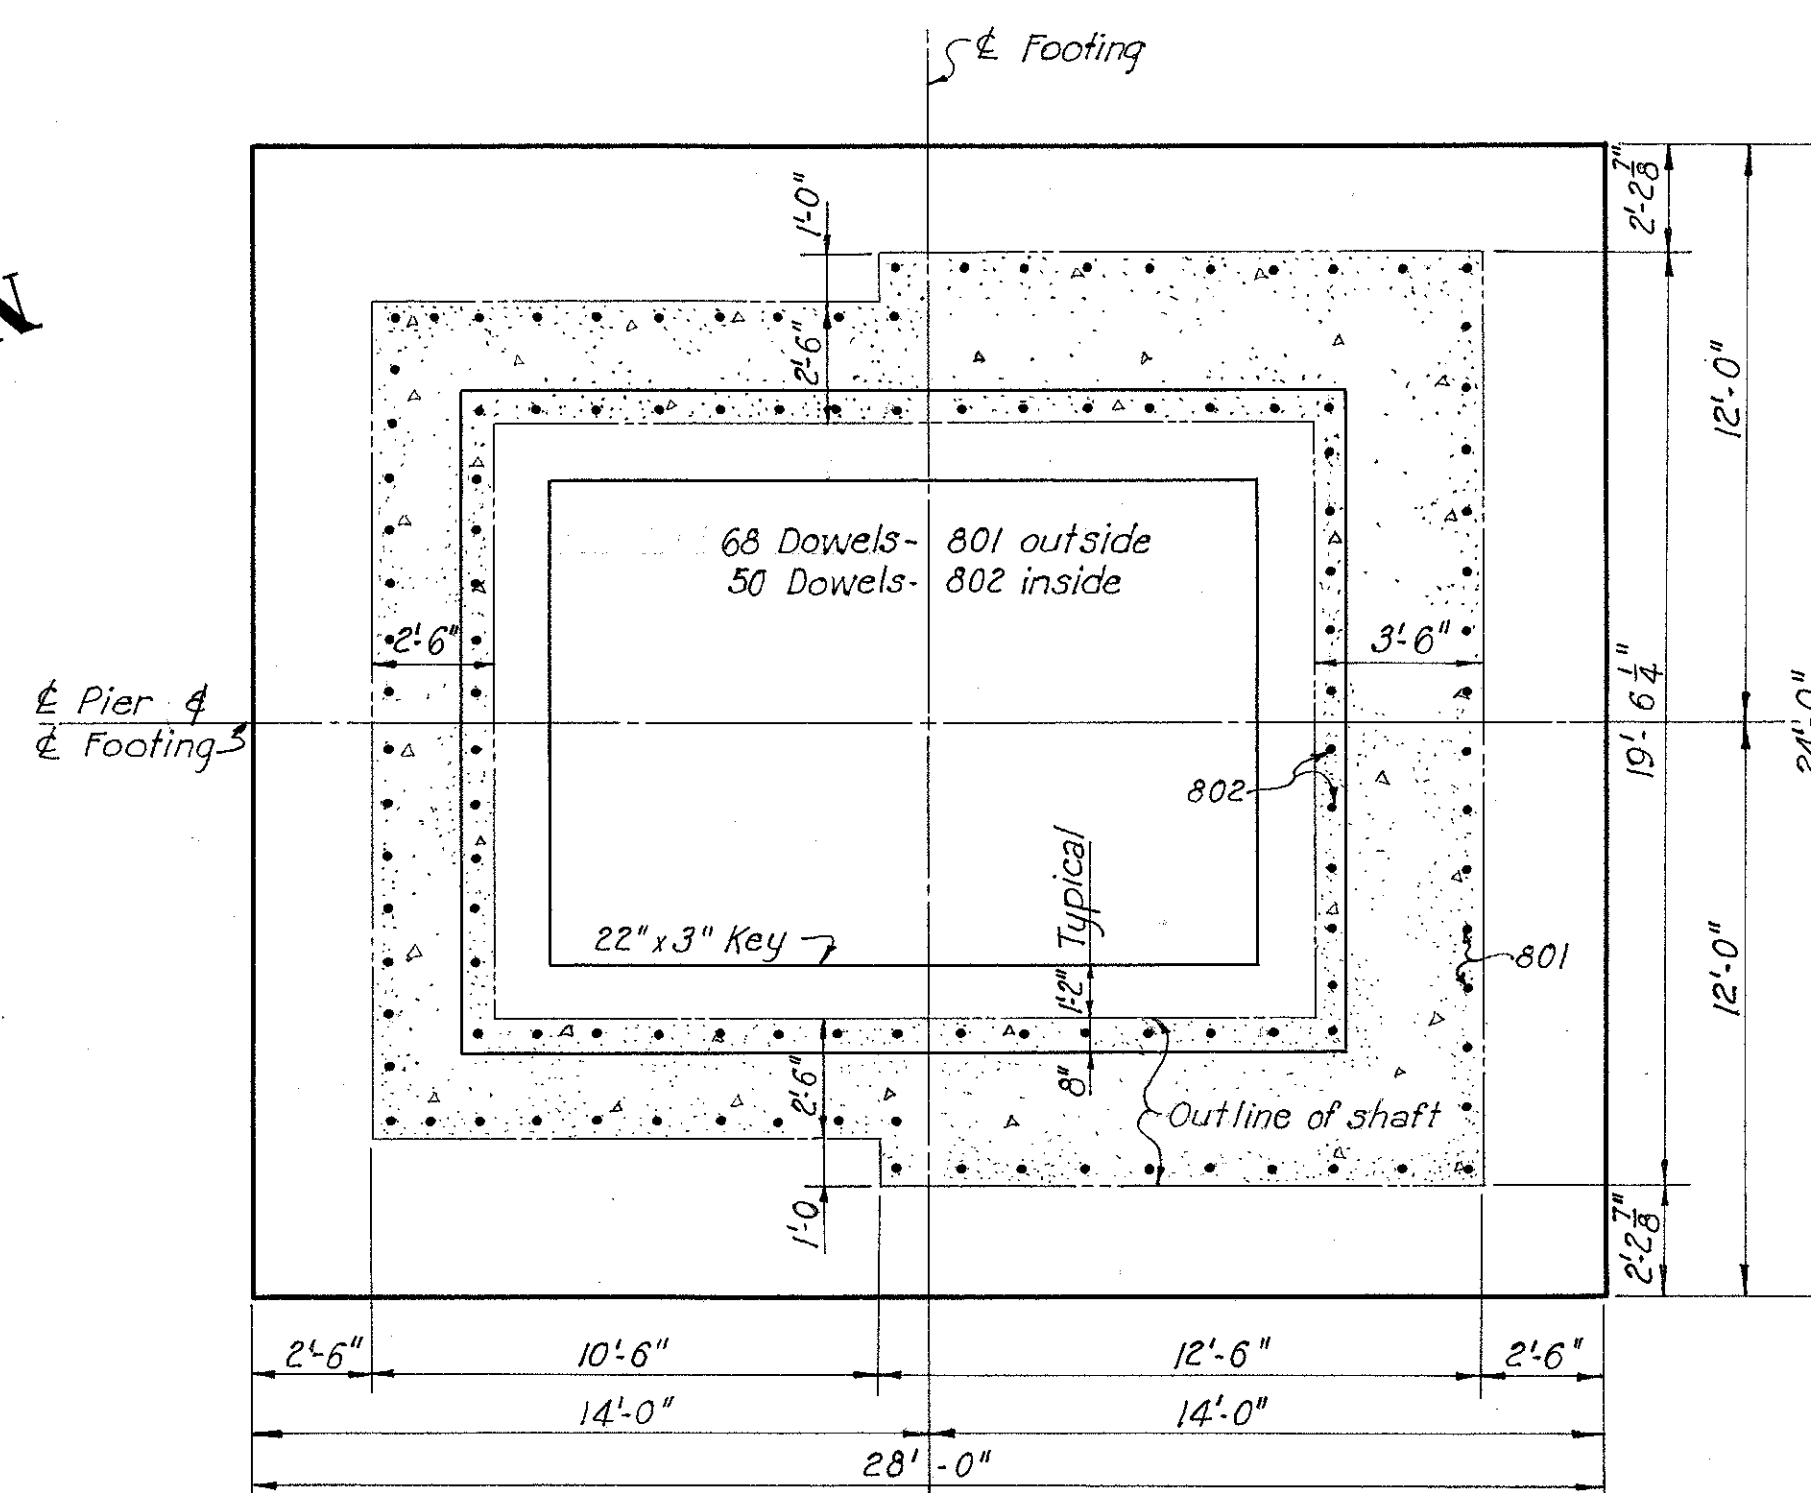

FOOTING PLAN WN

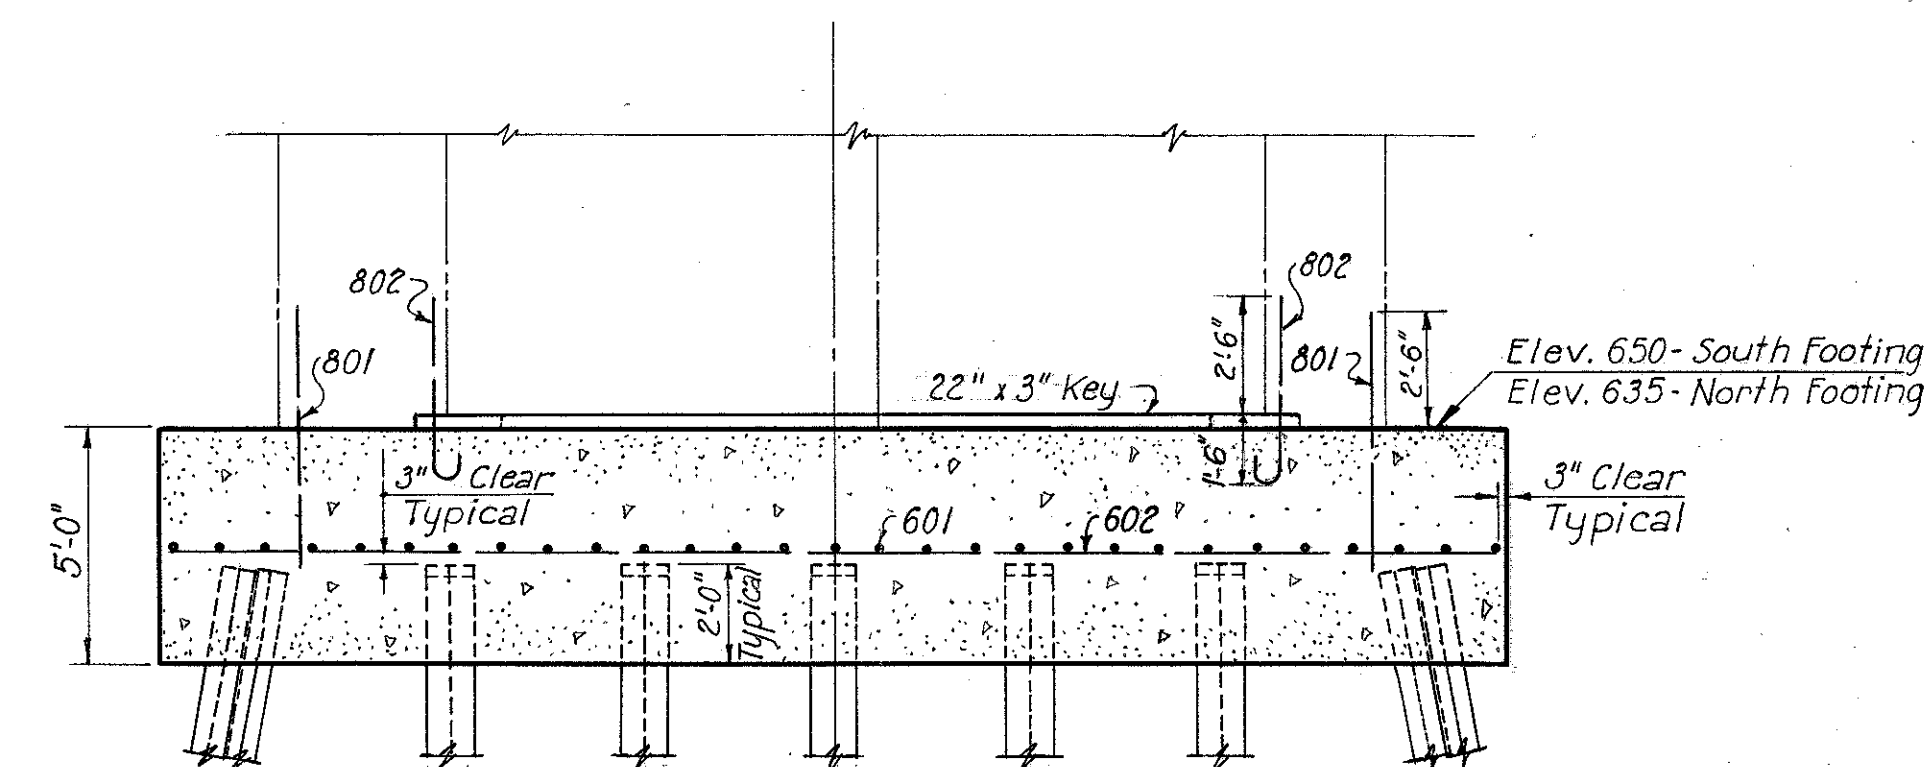


SECTION A-A

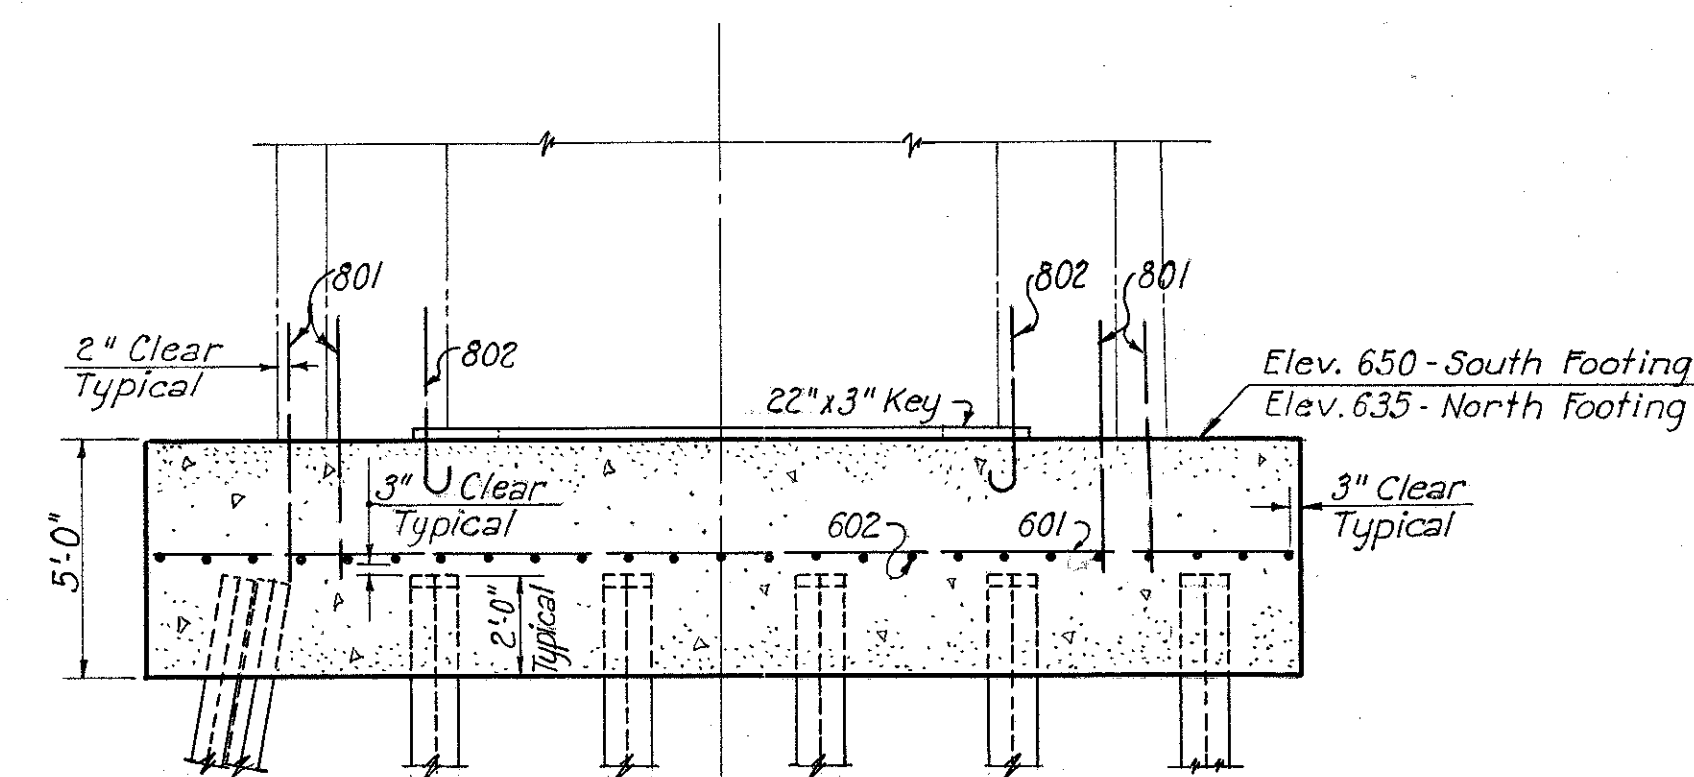


SECTION B-B

Note: 12" B.P. 53 steel piles with a nominal design capacity of 65 tons each.
40 piles, estimated length 60 feet each, for footing WN.
38 piles, estimated length 60 feet each, for footing WS.
Batter 3" per foot and 1 1/2" per foot as shown.
For reinforcing schedule, see Sheet 32.

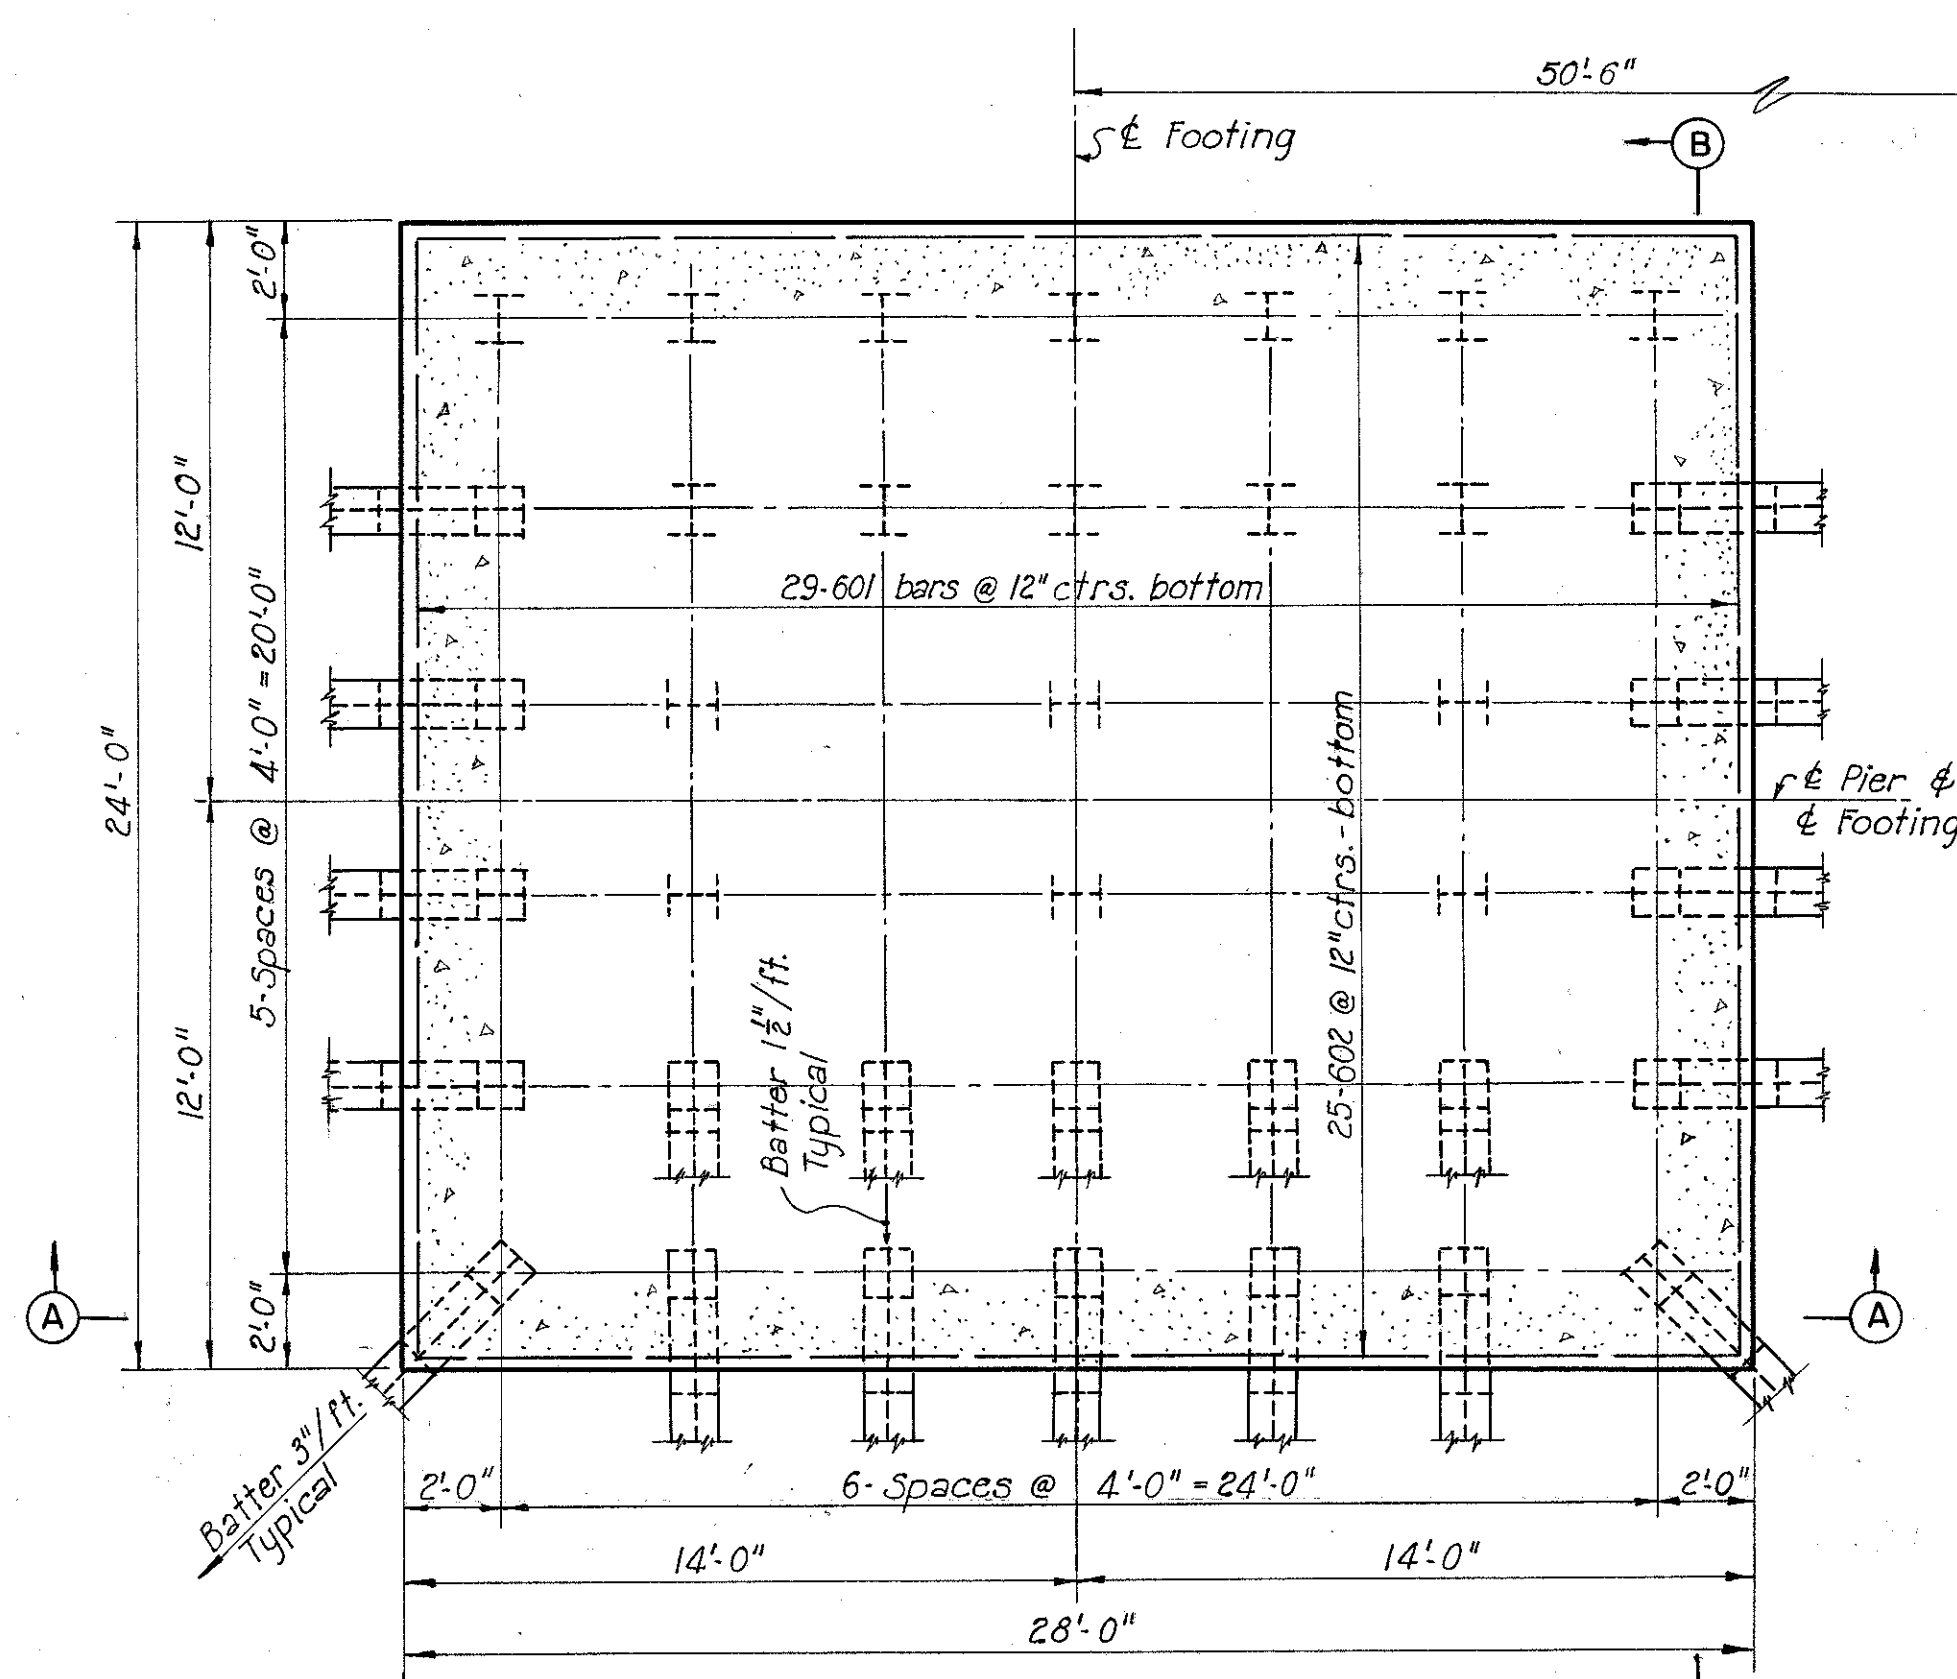

PILE PLAN WS

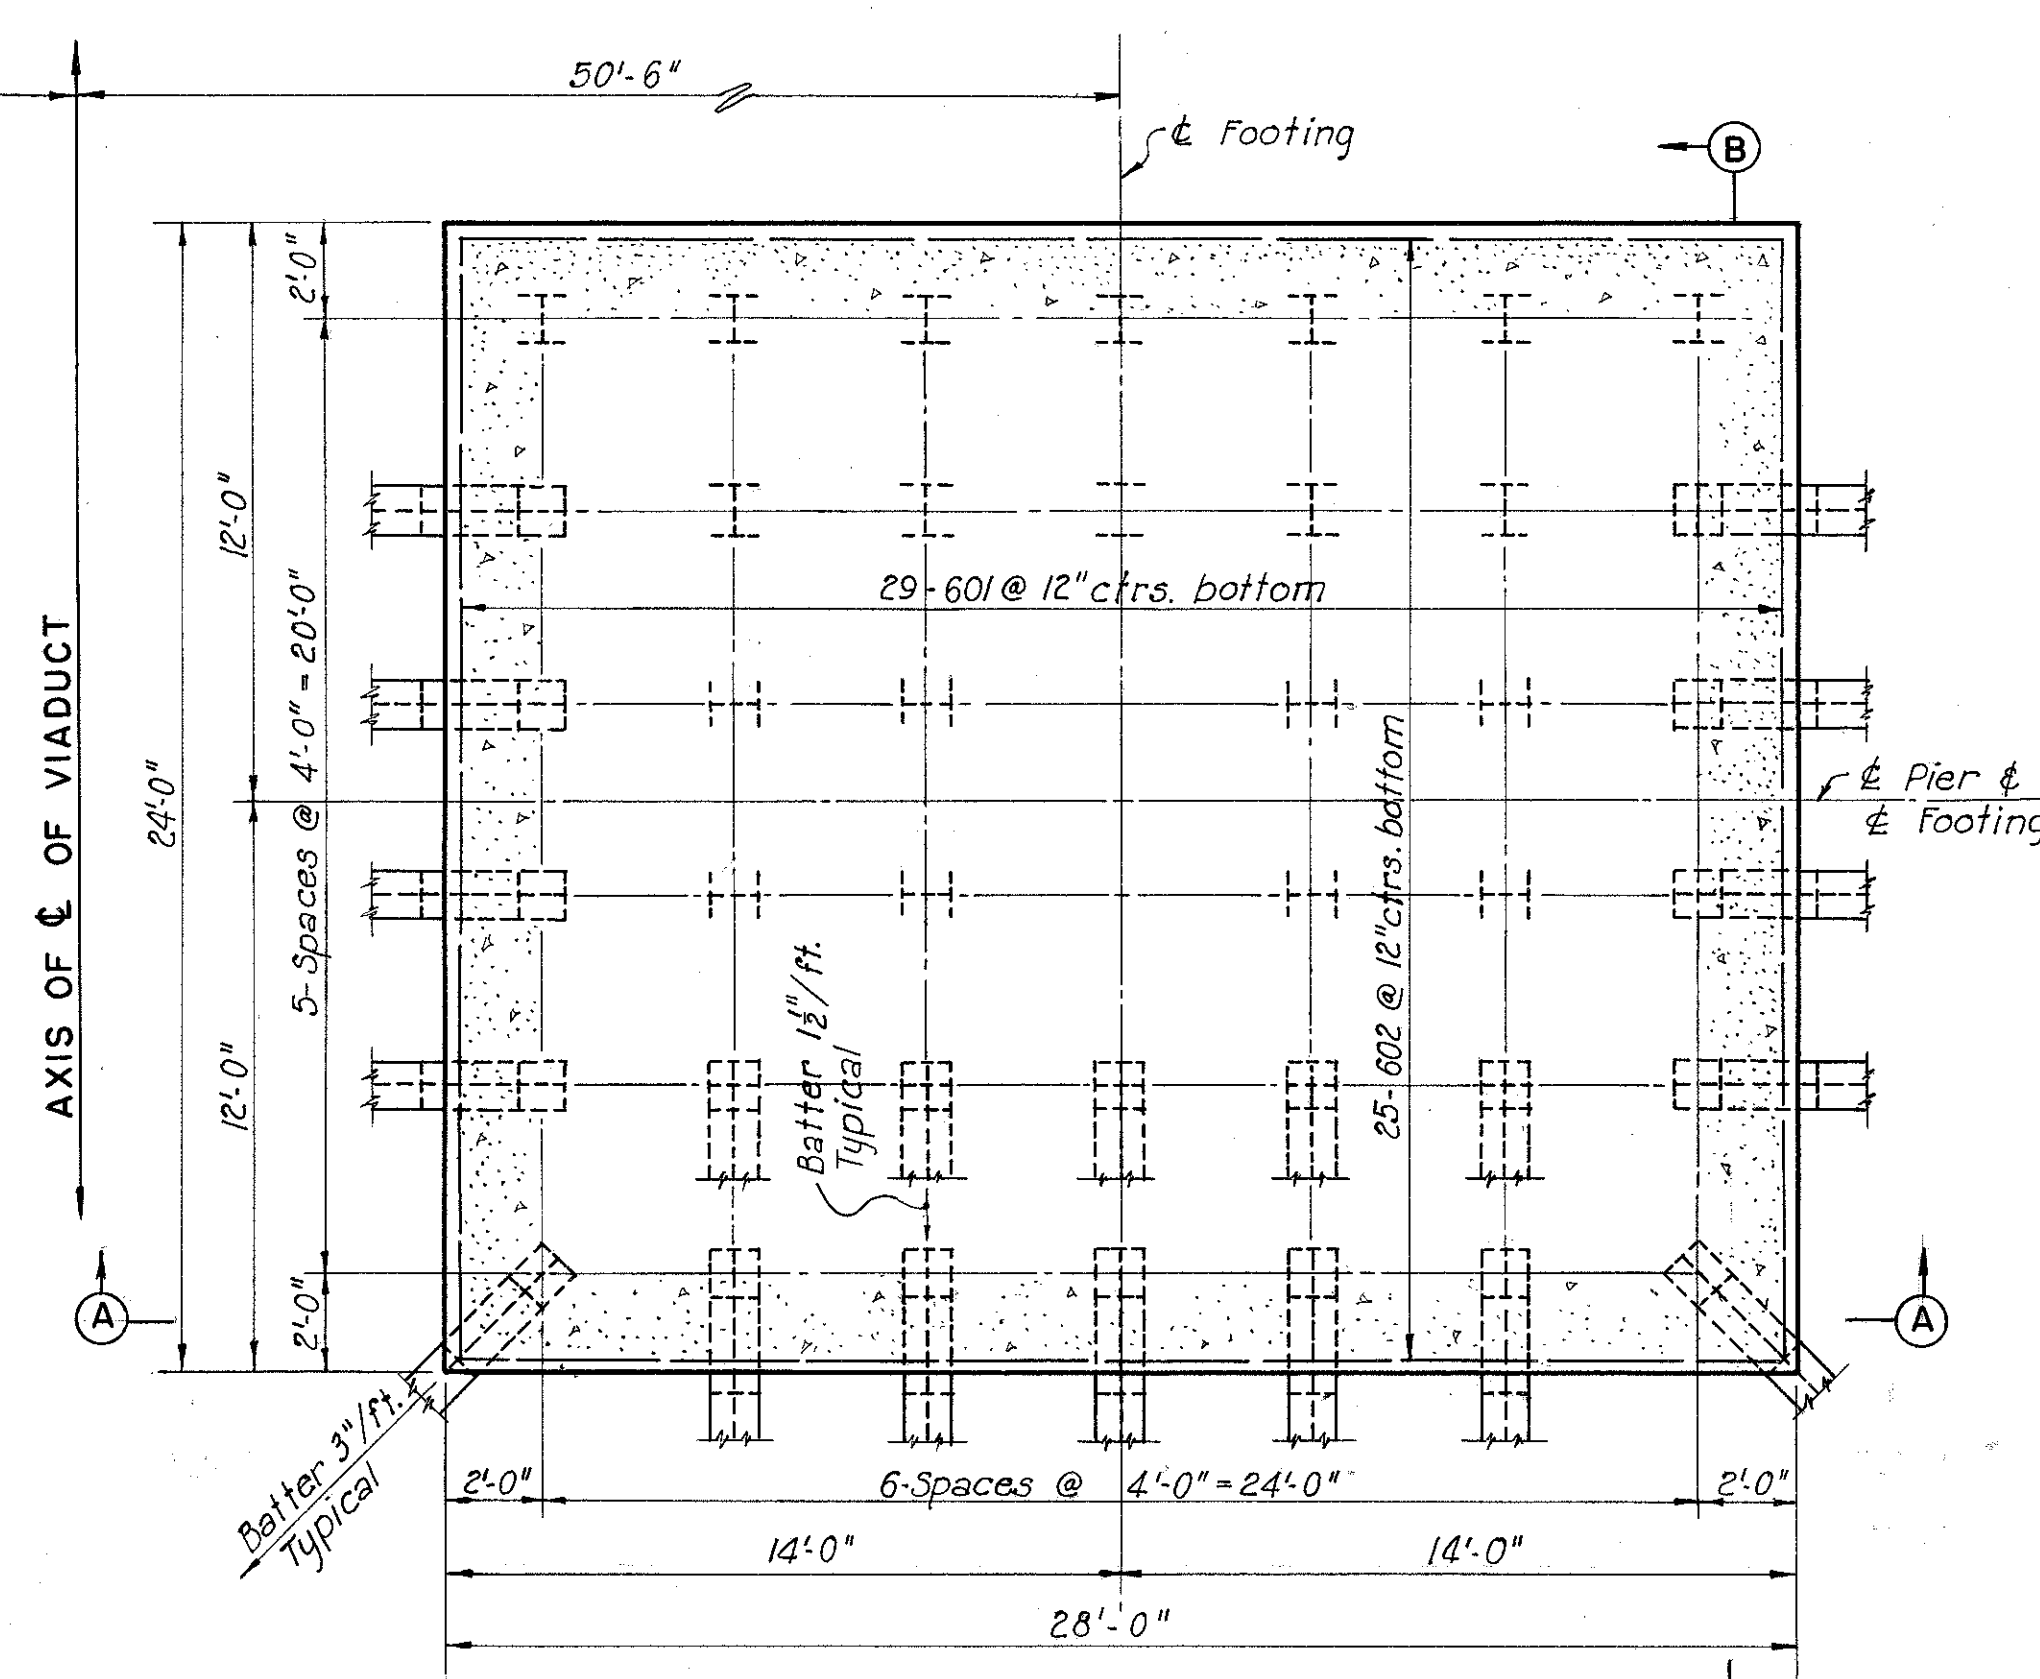

PILE PLAN WN

PART 2


U. S. ROUTE 42 RELOCATION
INNER BELT FREEWAY - CENTRAL VIADUCT

WEST END PIER FOOTINGS, WN AND WS


CLEVELAND CUYAHOGA COUNTY OHIO

SCALE: 1/4" = 1'-0"
MADE F.K.D. DATE 5-25-54
TRCD. A.H. DATE 5-9-54
CKD. C.J.C. DATE 7-1-54
HOWARD, NEEDLES, TAMMEN & BERGENDOFF
CONSULTING ENGINEERS
KANSAS CITY CLEVELAND NEW YORK
914-1A SHEET 1.14


CUYAHOGA COUNTY
CITY OF CLEVELAND
INNER BELT FREEWAY
CENTRAL VIADUCT
CUY - 42 R - 17.50

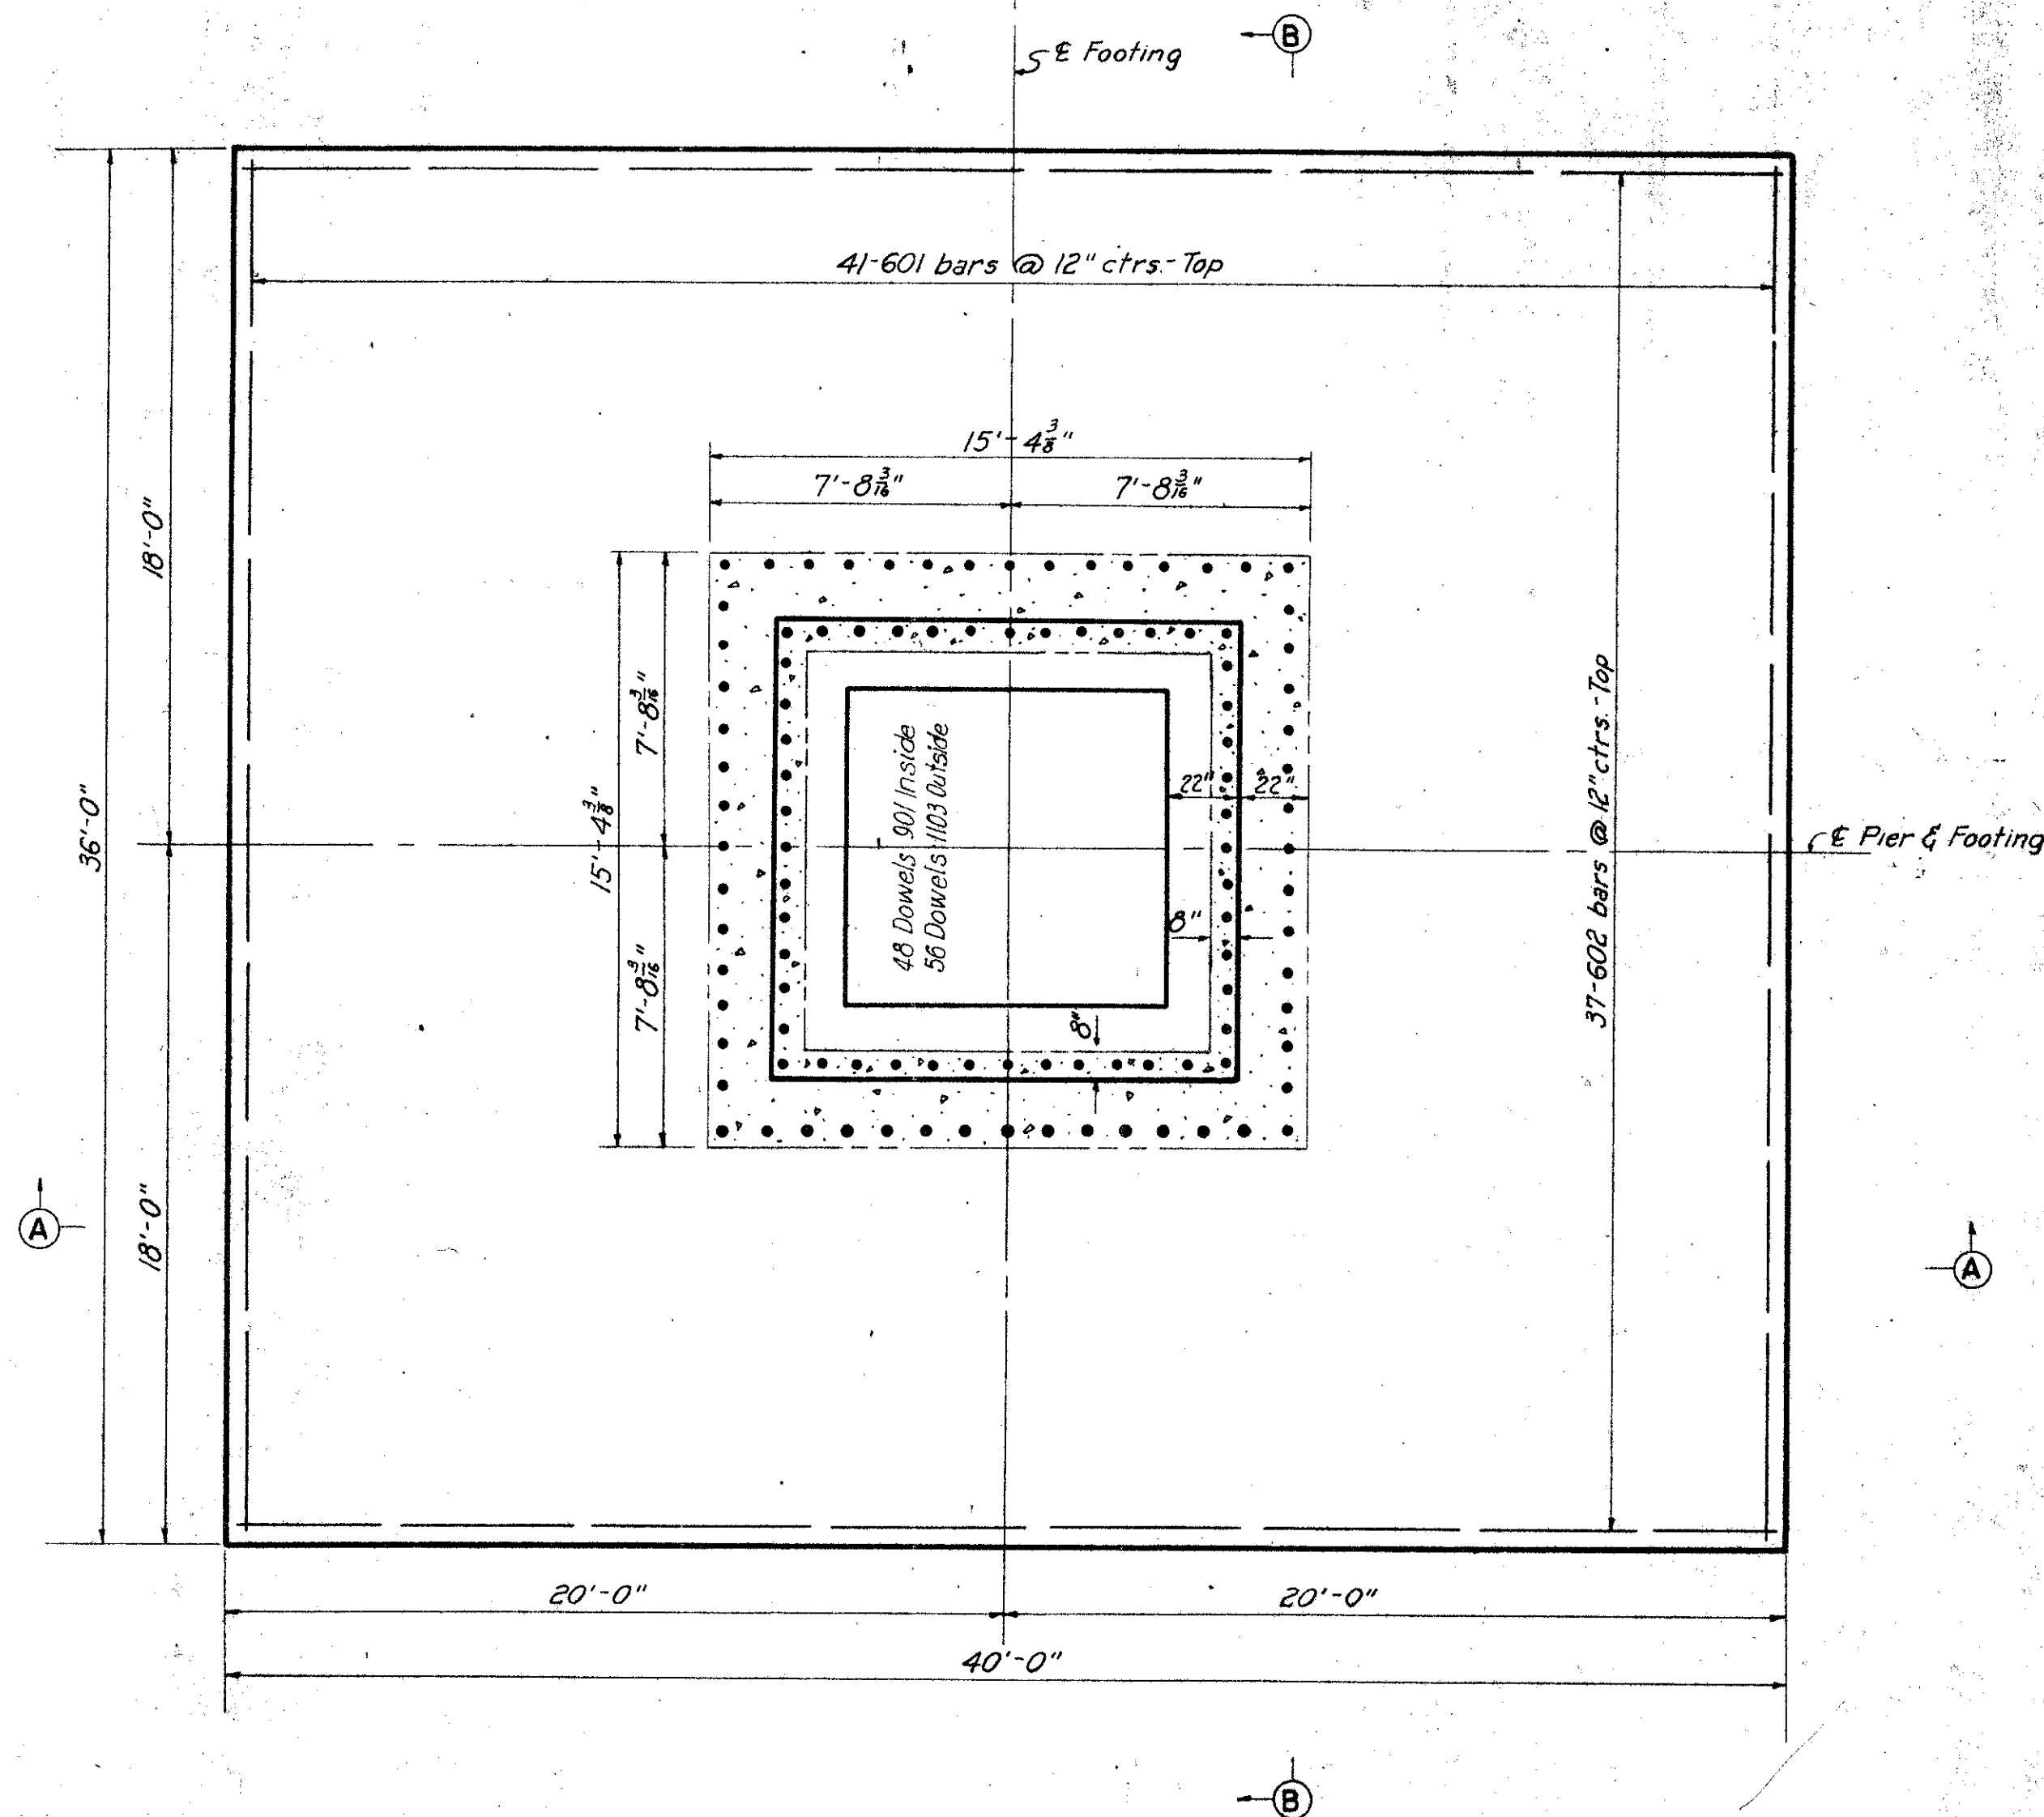


PLAN
Scale: $\frac{1}{4}" = 1'-0"$

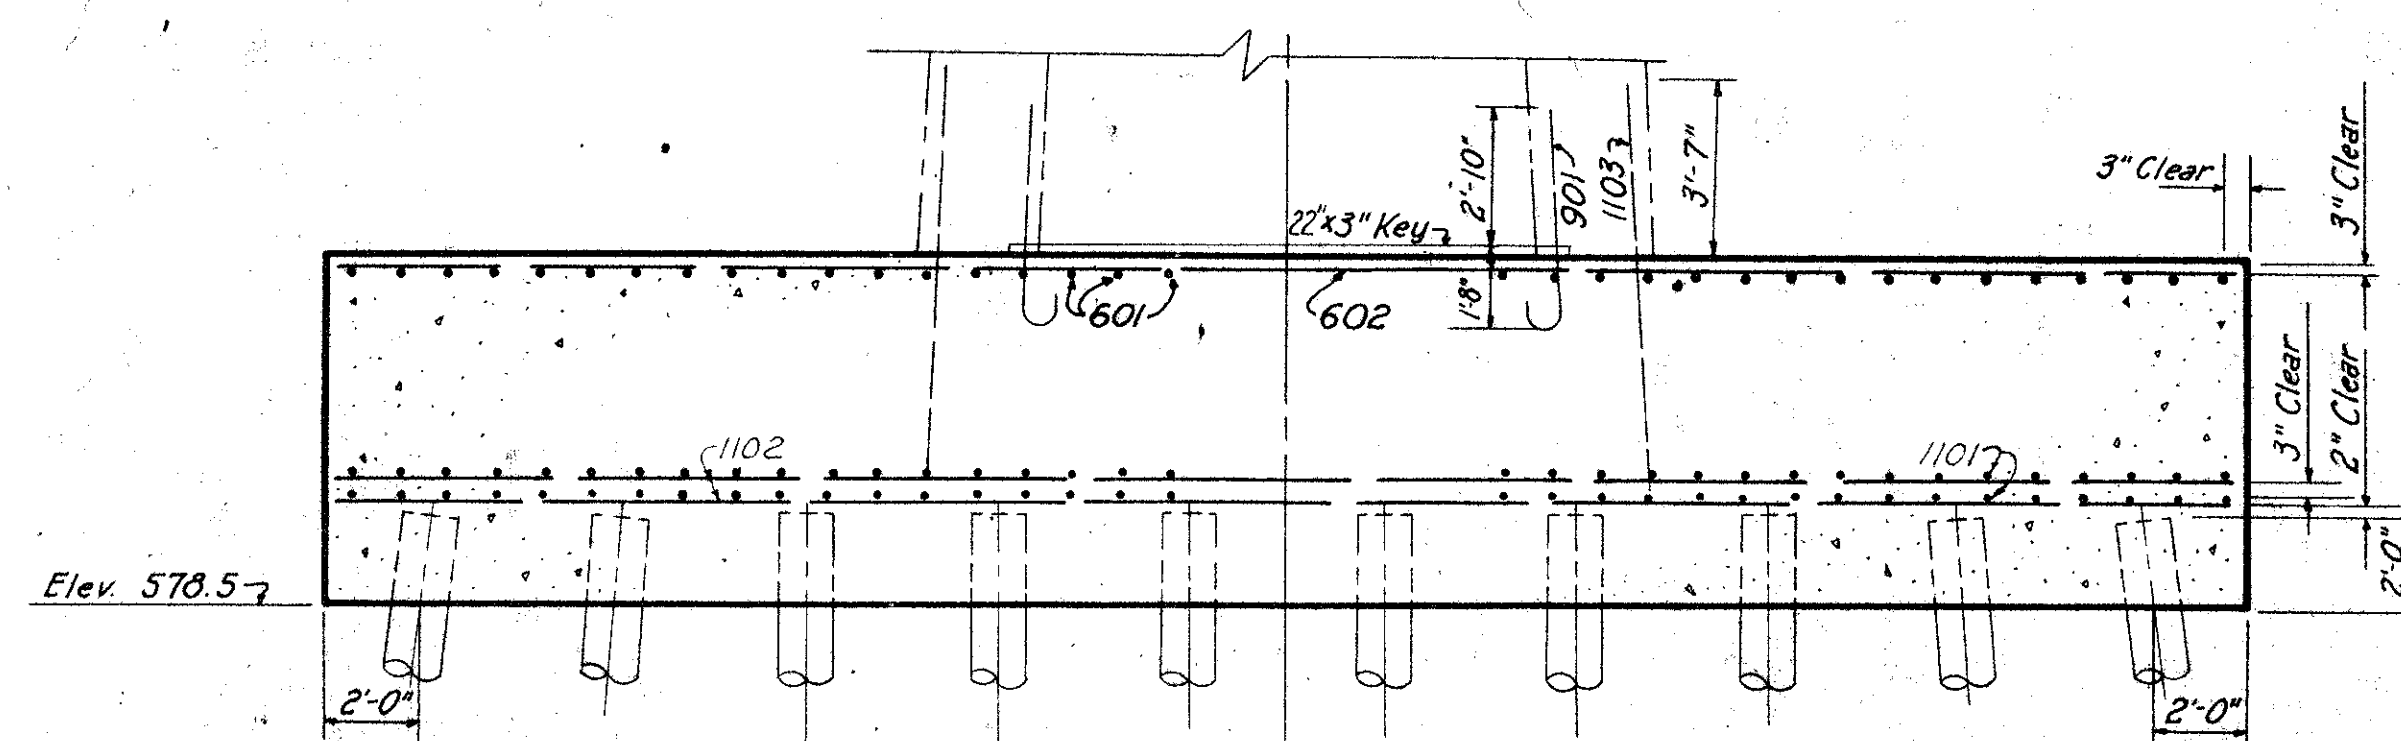

SECTION A-A
Scale: $\frac{1}{4}" = 1'-0"$

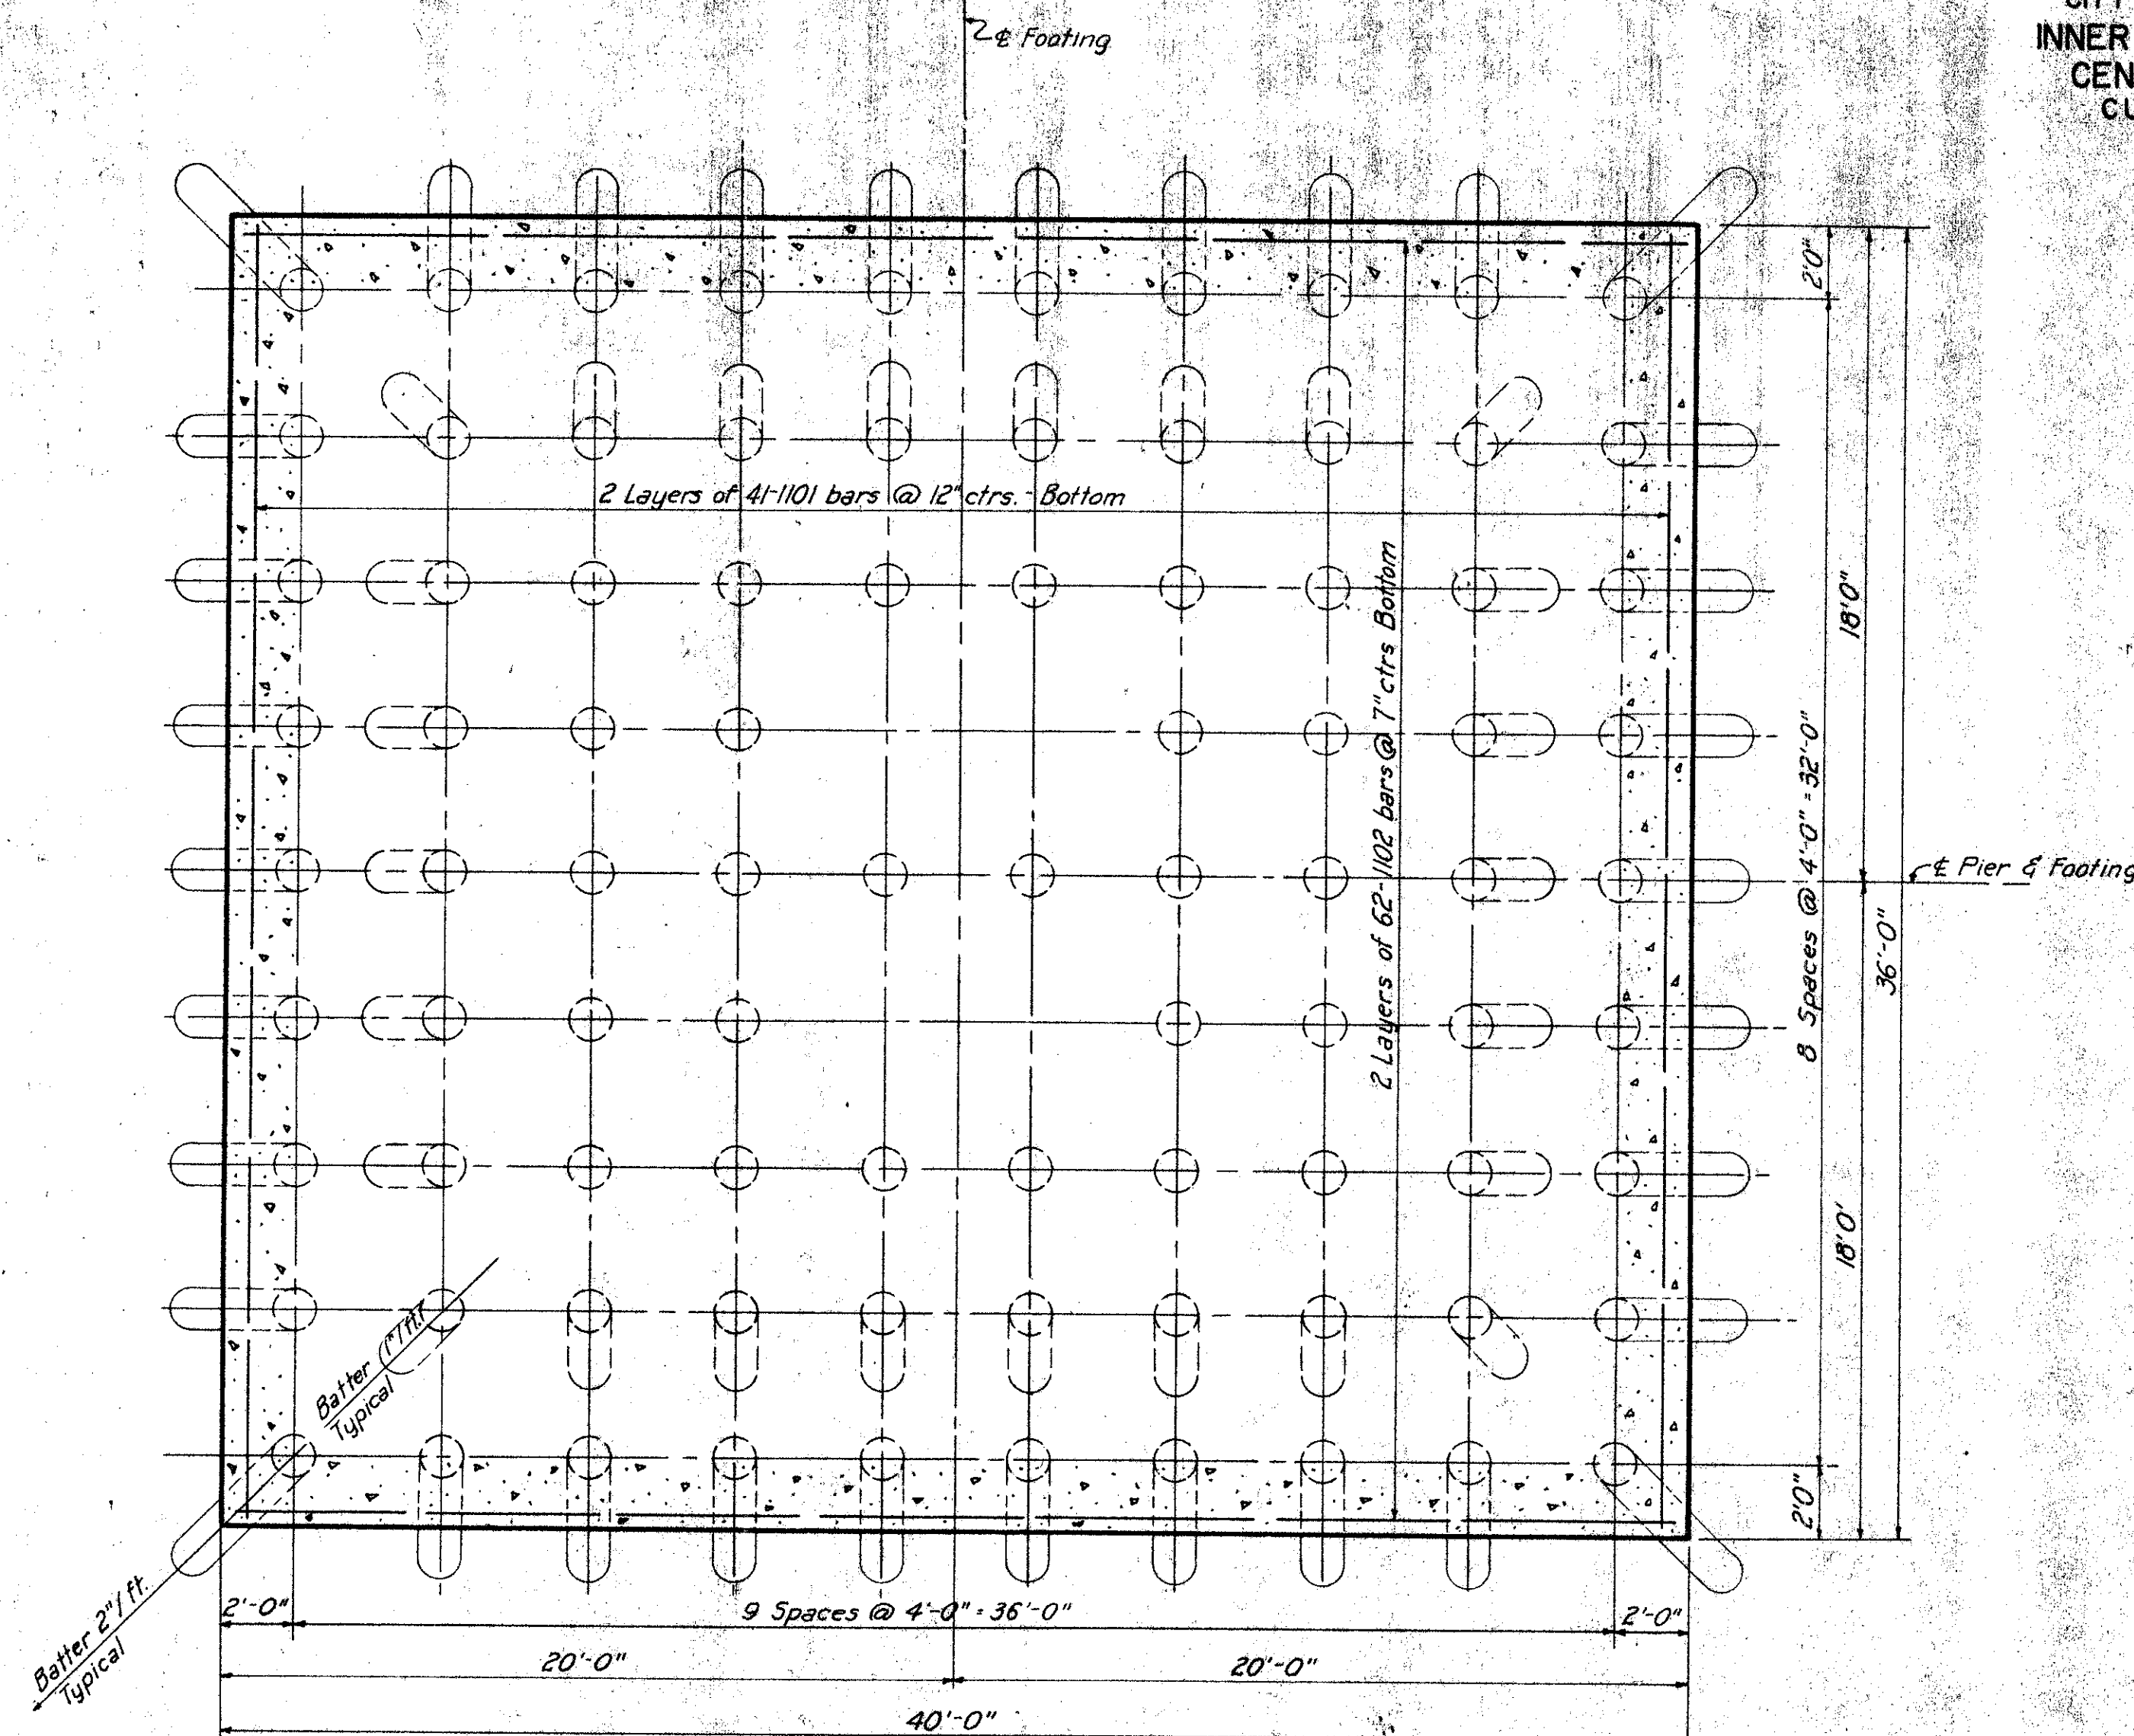

PILE PLAN
Scale: $\frac{1}{4}" = 1'-0"$

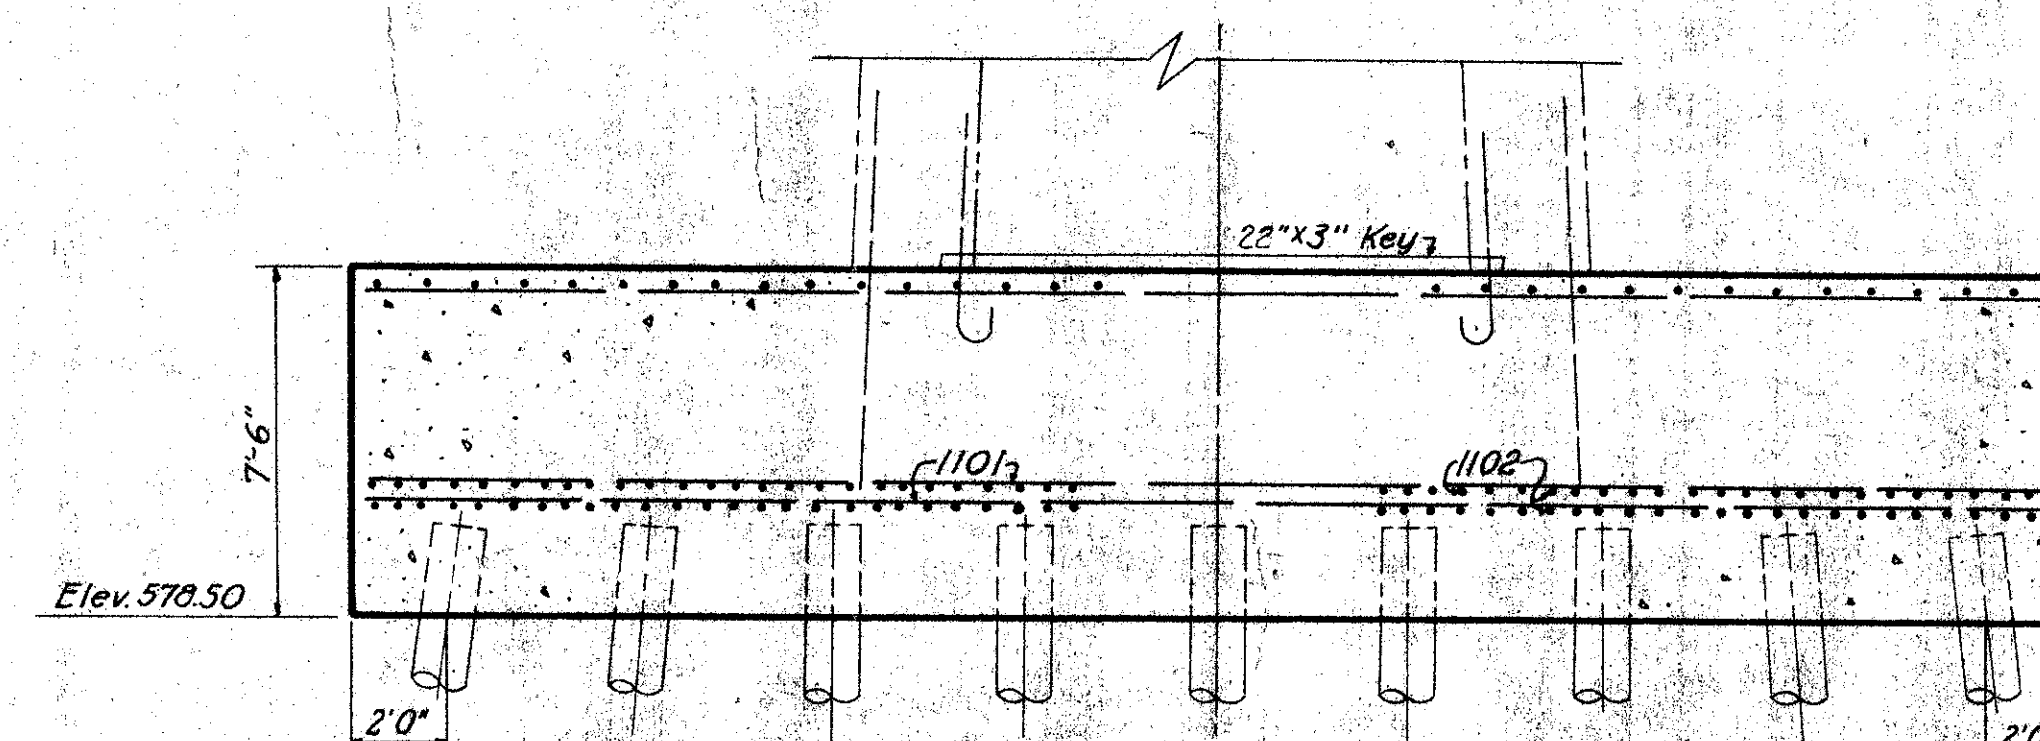

SECTION B-B
Scale: $\frac{1}{4}" = 1'-0"$

Note:
 86-14" ϕ Cast-in-Place Reinforced
 Concrete Piles With a Nominal design capacity
 of 65 Tons. Estimated Length 90 ft. each
 Batter Outside Row of Piles 2" per ft,
 and Batter Second Row of Piles
 1" per ft. for Footing 15 only.
 For Reinforcement Schedule See
 Sheets 30 and 31.
 For Footing 1N, batter outside Row of
 piles 2" per foot on East, South and
 West sides of footing. Batter second
 row of piles 1" per ft. all sides and
 outside row of piles 1" per ft. on North
 side of footing.

PART 2

U. S. ROUTE 42 RELOCATION

INNER BELT FREEWAY - CENTRAL VIADUCT

PIER FOOTINGS IN, AND IS

CLEVELAND CUYAHOGA COUNTY OHIO

SCALE *as shown*
MADE *DER* DATE *2-5-54*
TRCD *EJB* DATE *6-9-54*
CKD *CJC* DATE *2-25-54*

HOWARD, NEEDLES, TAMMEN & BERGENDORF
CONSULTING ENGINEERS
KANSAS CITY CLEVELAND NEW YORK

914-1A SHEET 115

Supersedes Sheet 15
Revised pile batters. GA 2-15-55


UNRECORDED
FEB 25 1954

FED. ROAD DIV. NO.	STATE	FEDERAL AID PROJECT NO.	TYPE FUNDS
2	OHIO	UI 1057 (4)	




17
43

CUYAHOGA COUNTY
CITY OF CLEVELAND
INNER BELT FREEWAY
CENTRAL VIADUCT
CUY - 42 R-17.50

Note: Cut or bend reinforcing steel in the field as required to clear the steel pile dock wall.
The exact location of the existing dock wall anchor is not known. After excavation is completed, it may be necessary to move the corner pile in toward the center of the footing. Maintain an edge distance of 1'-9" from the top center of the pile to the surface of concrete poured directly against the dock wall anchor.

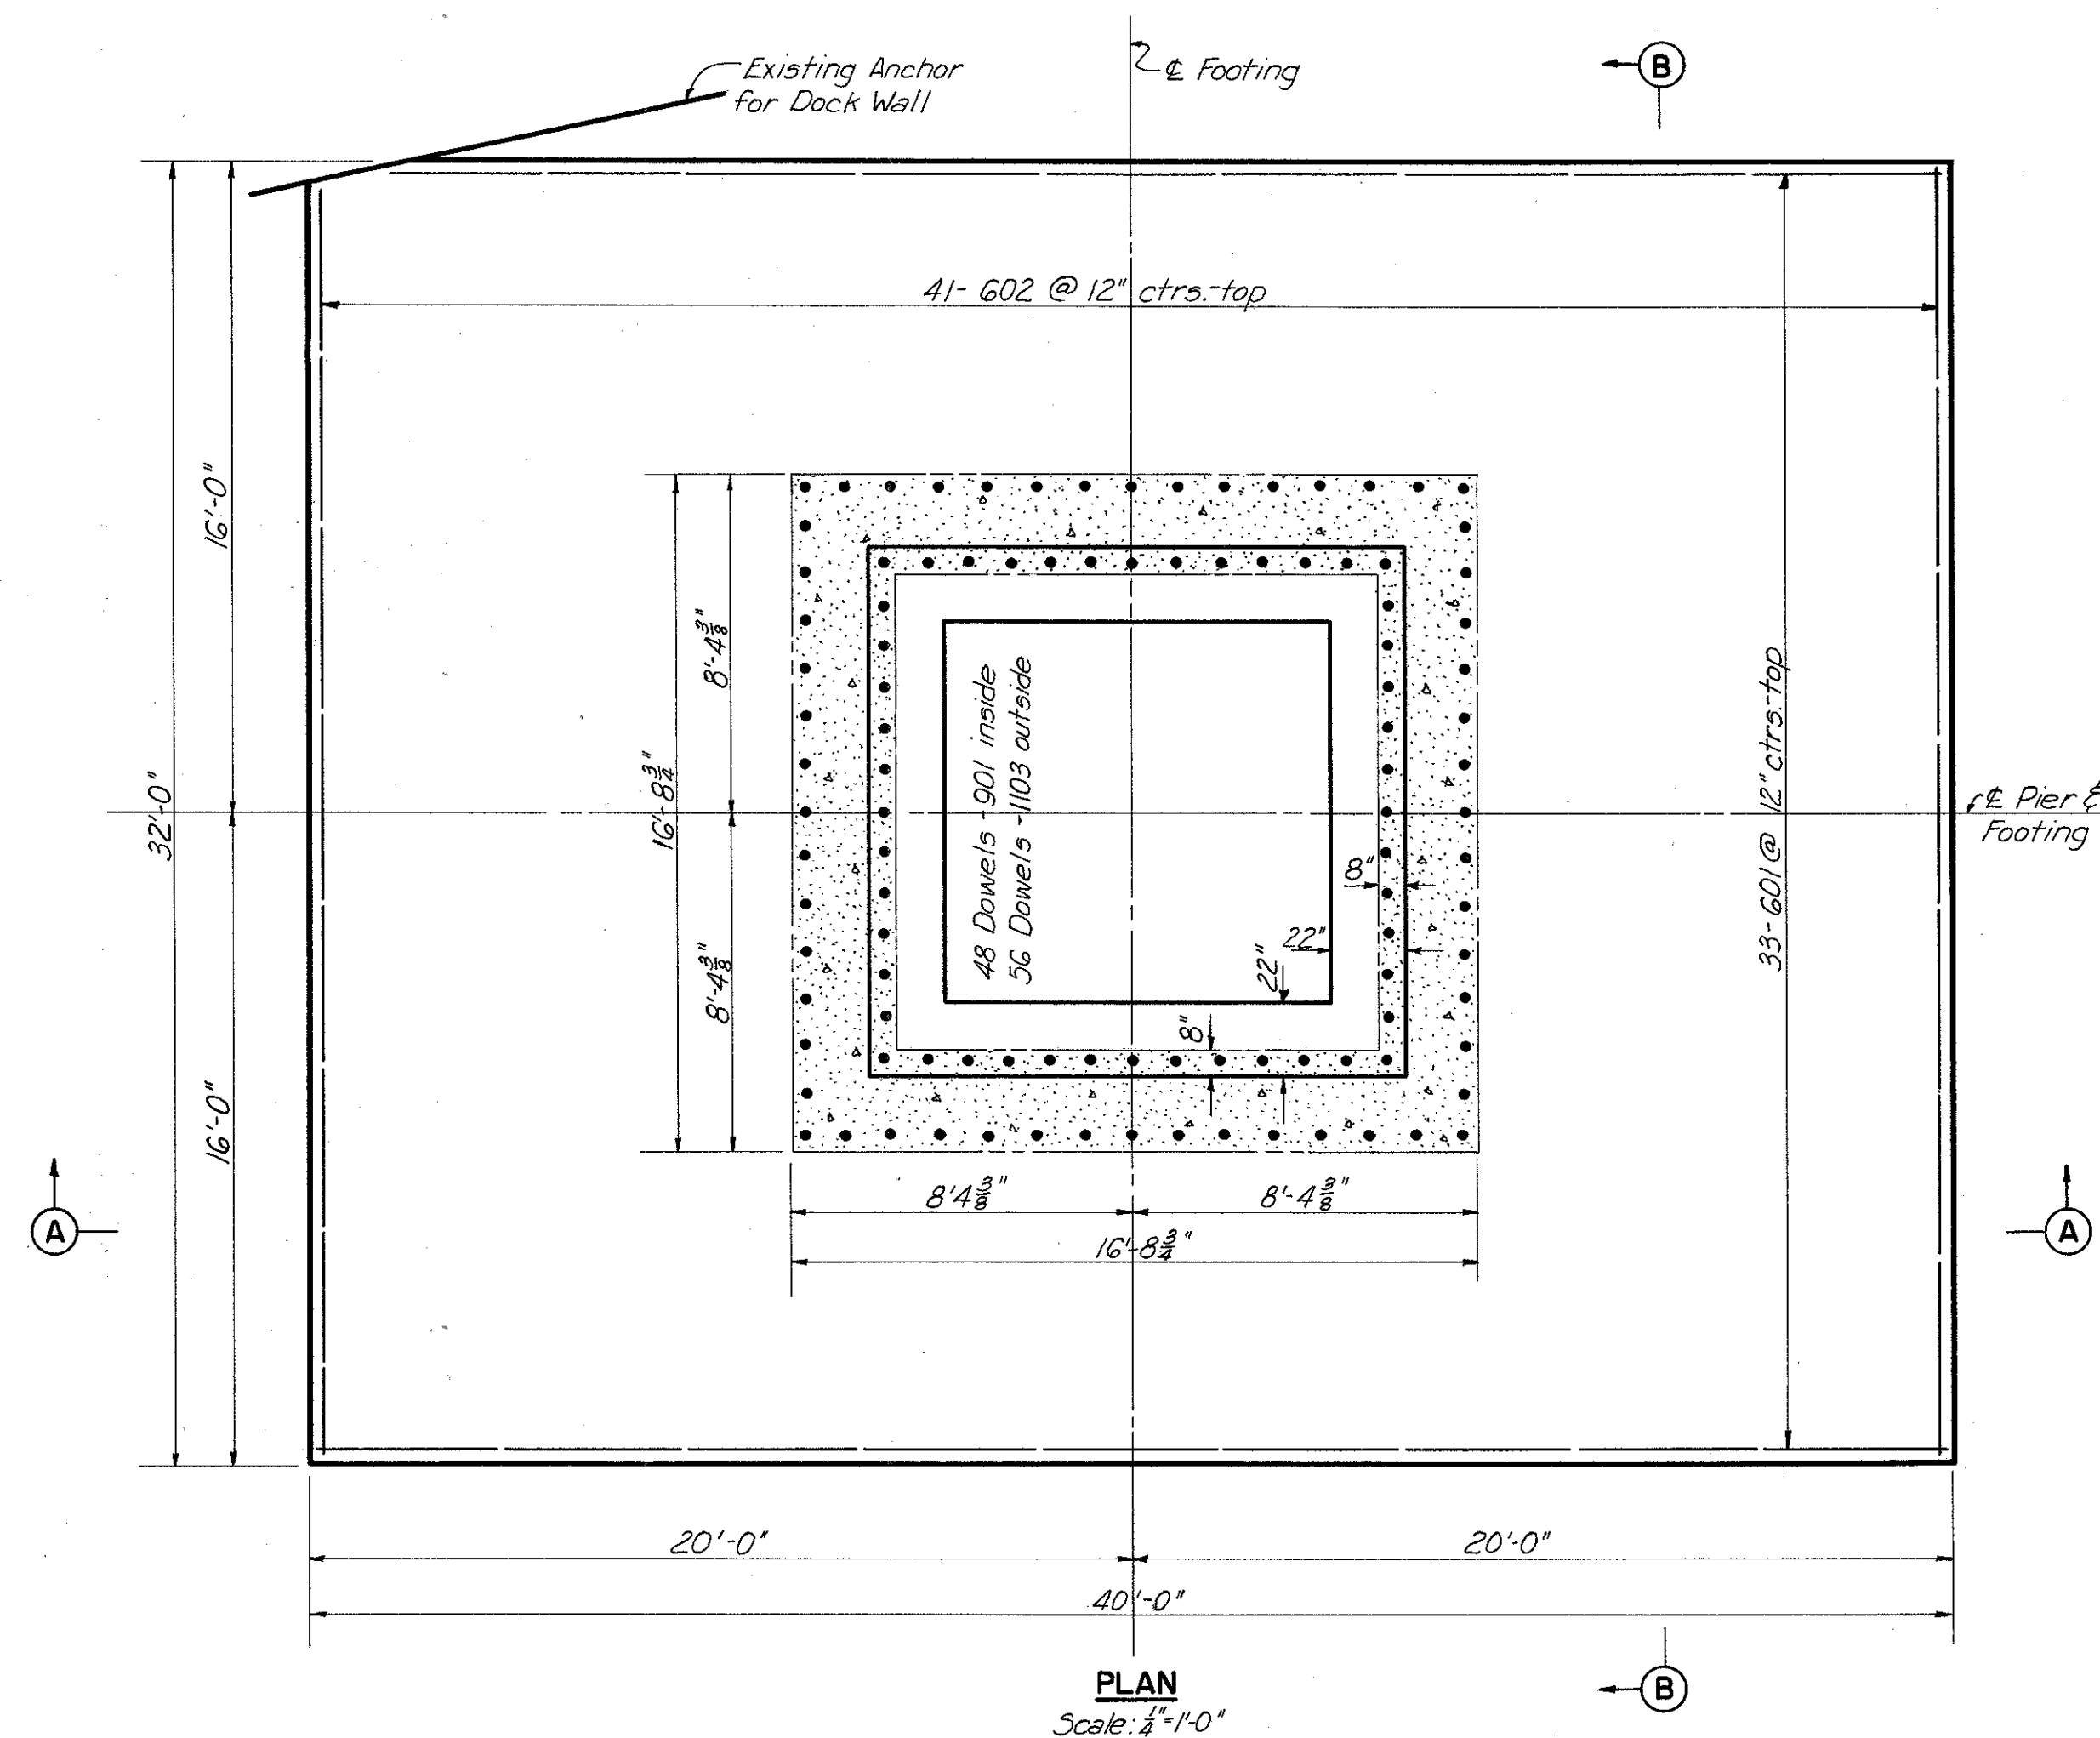

AXIS OF ∇ OF VIADUCT

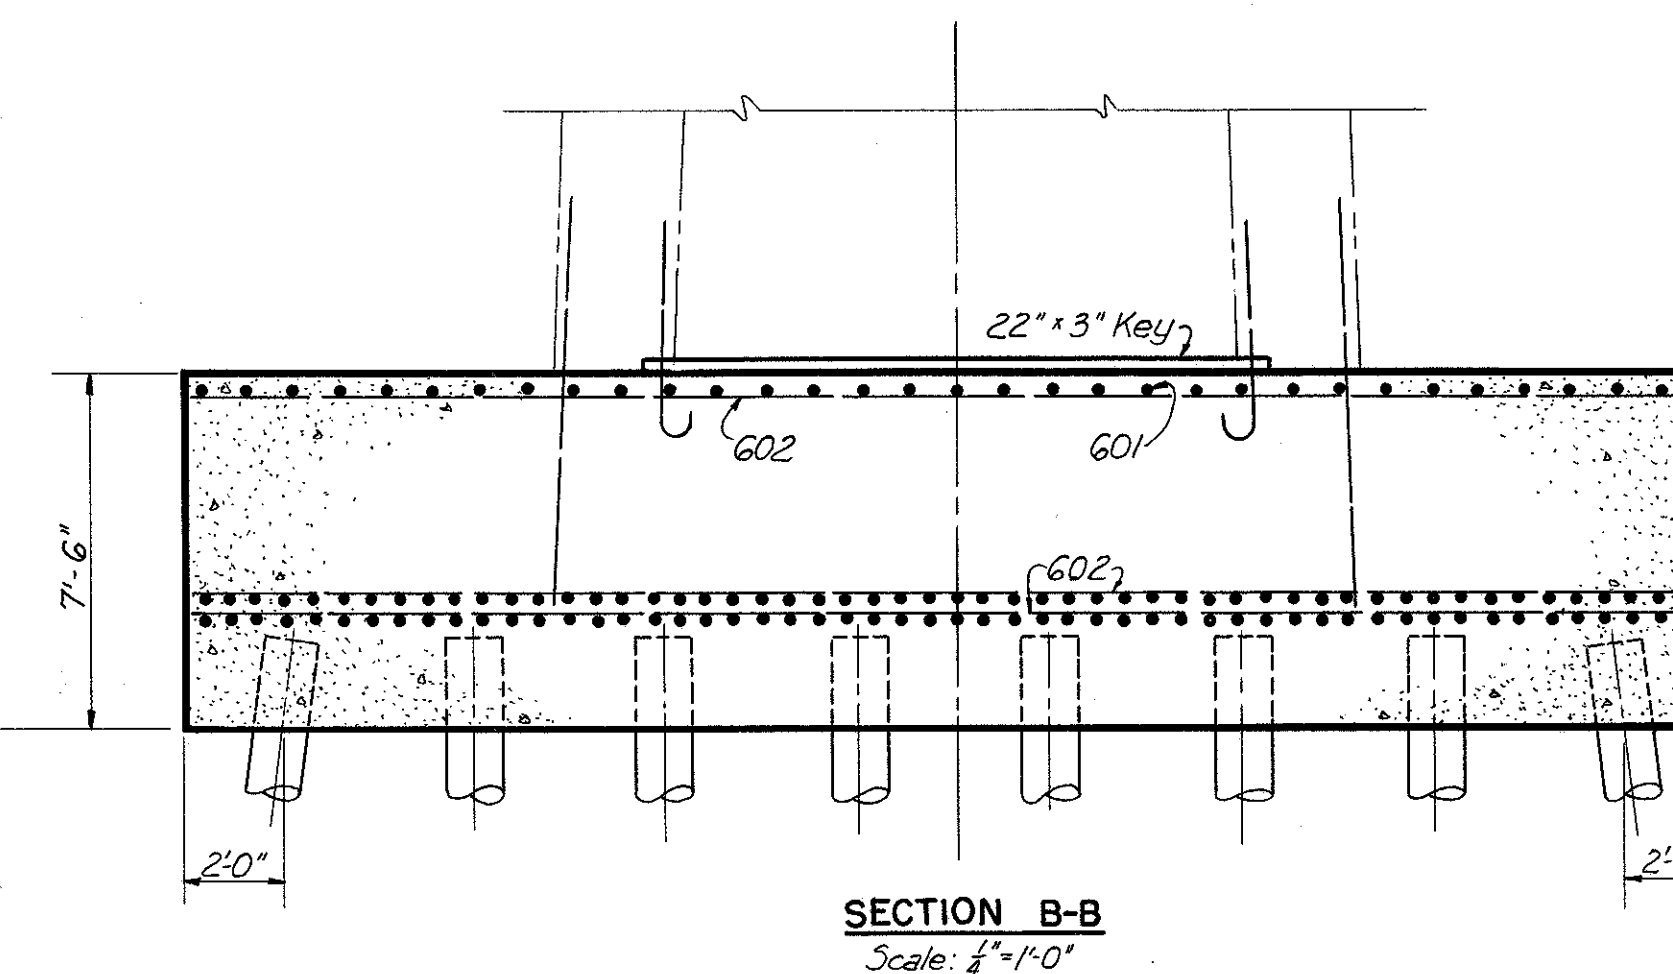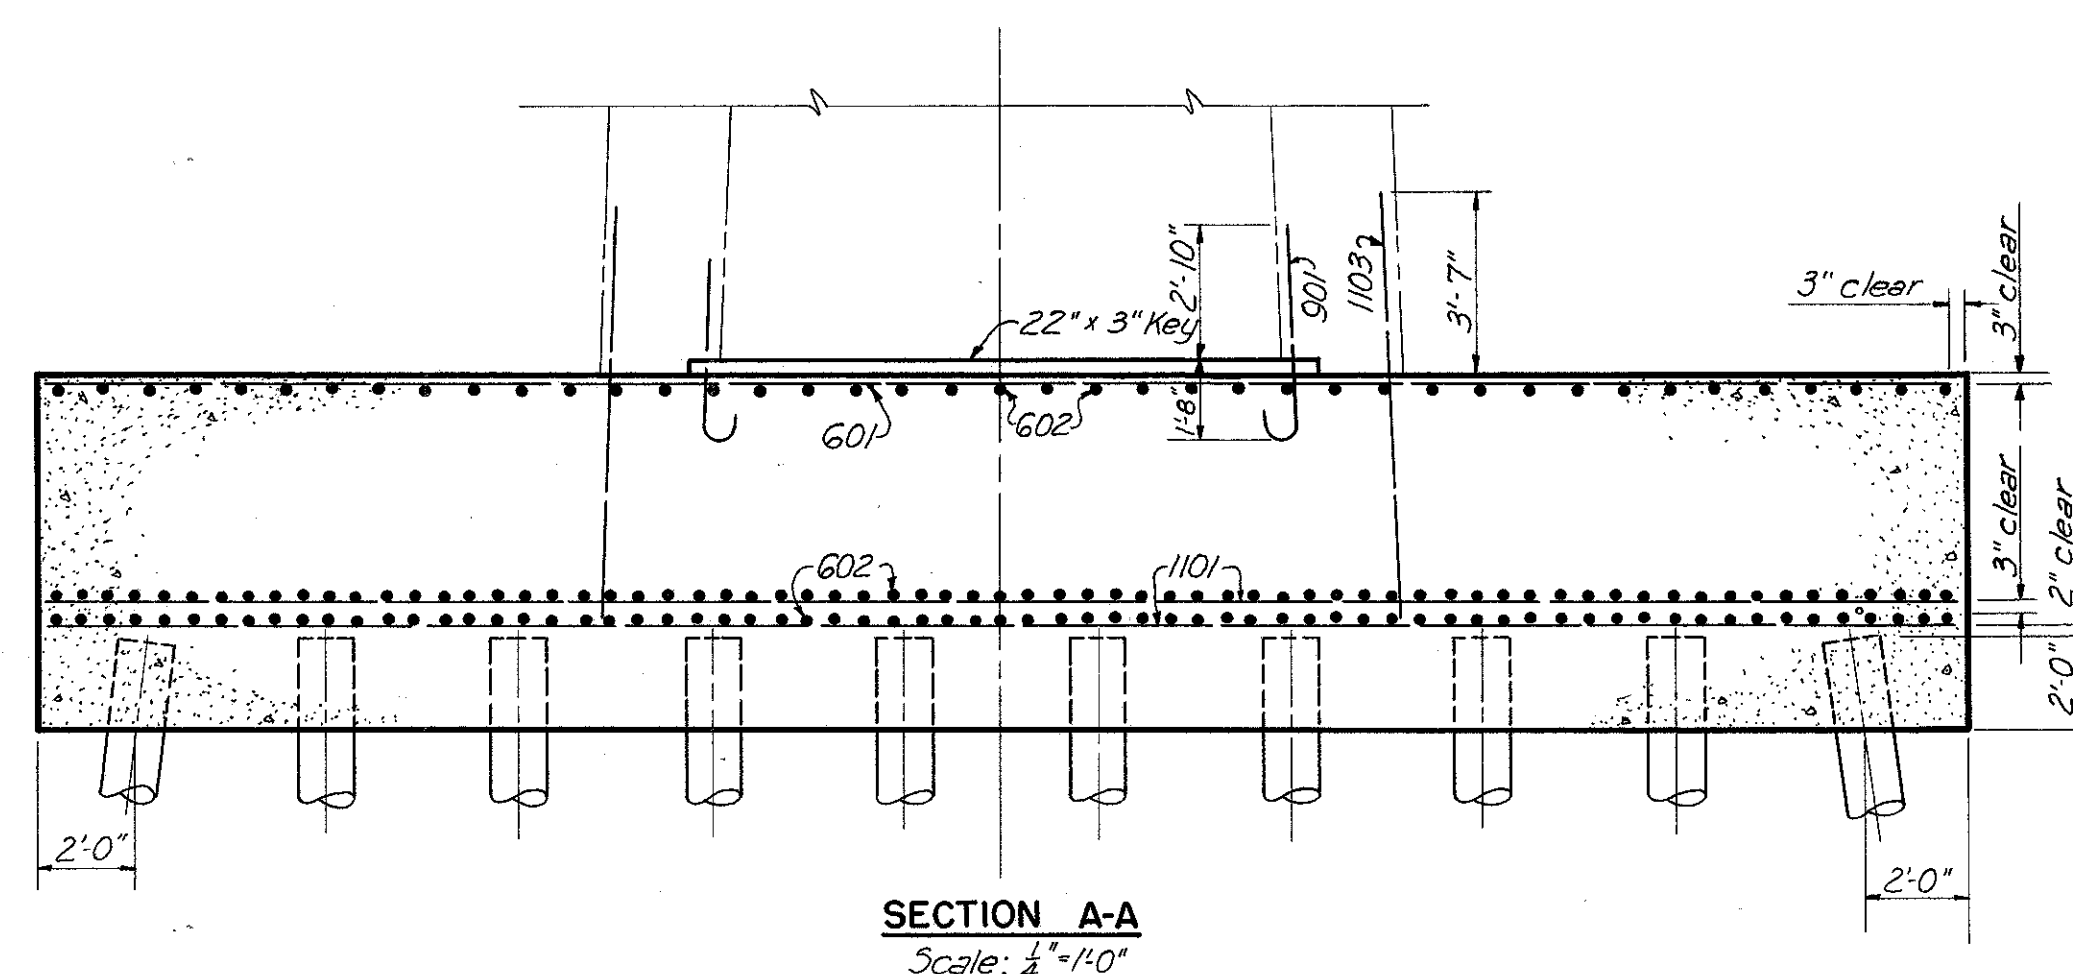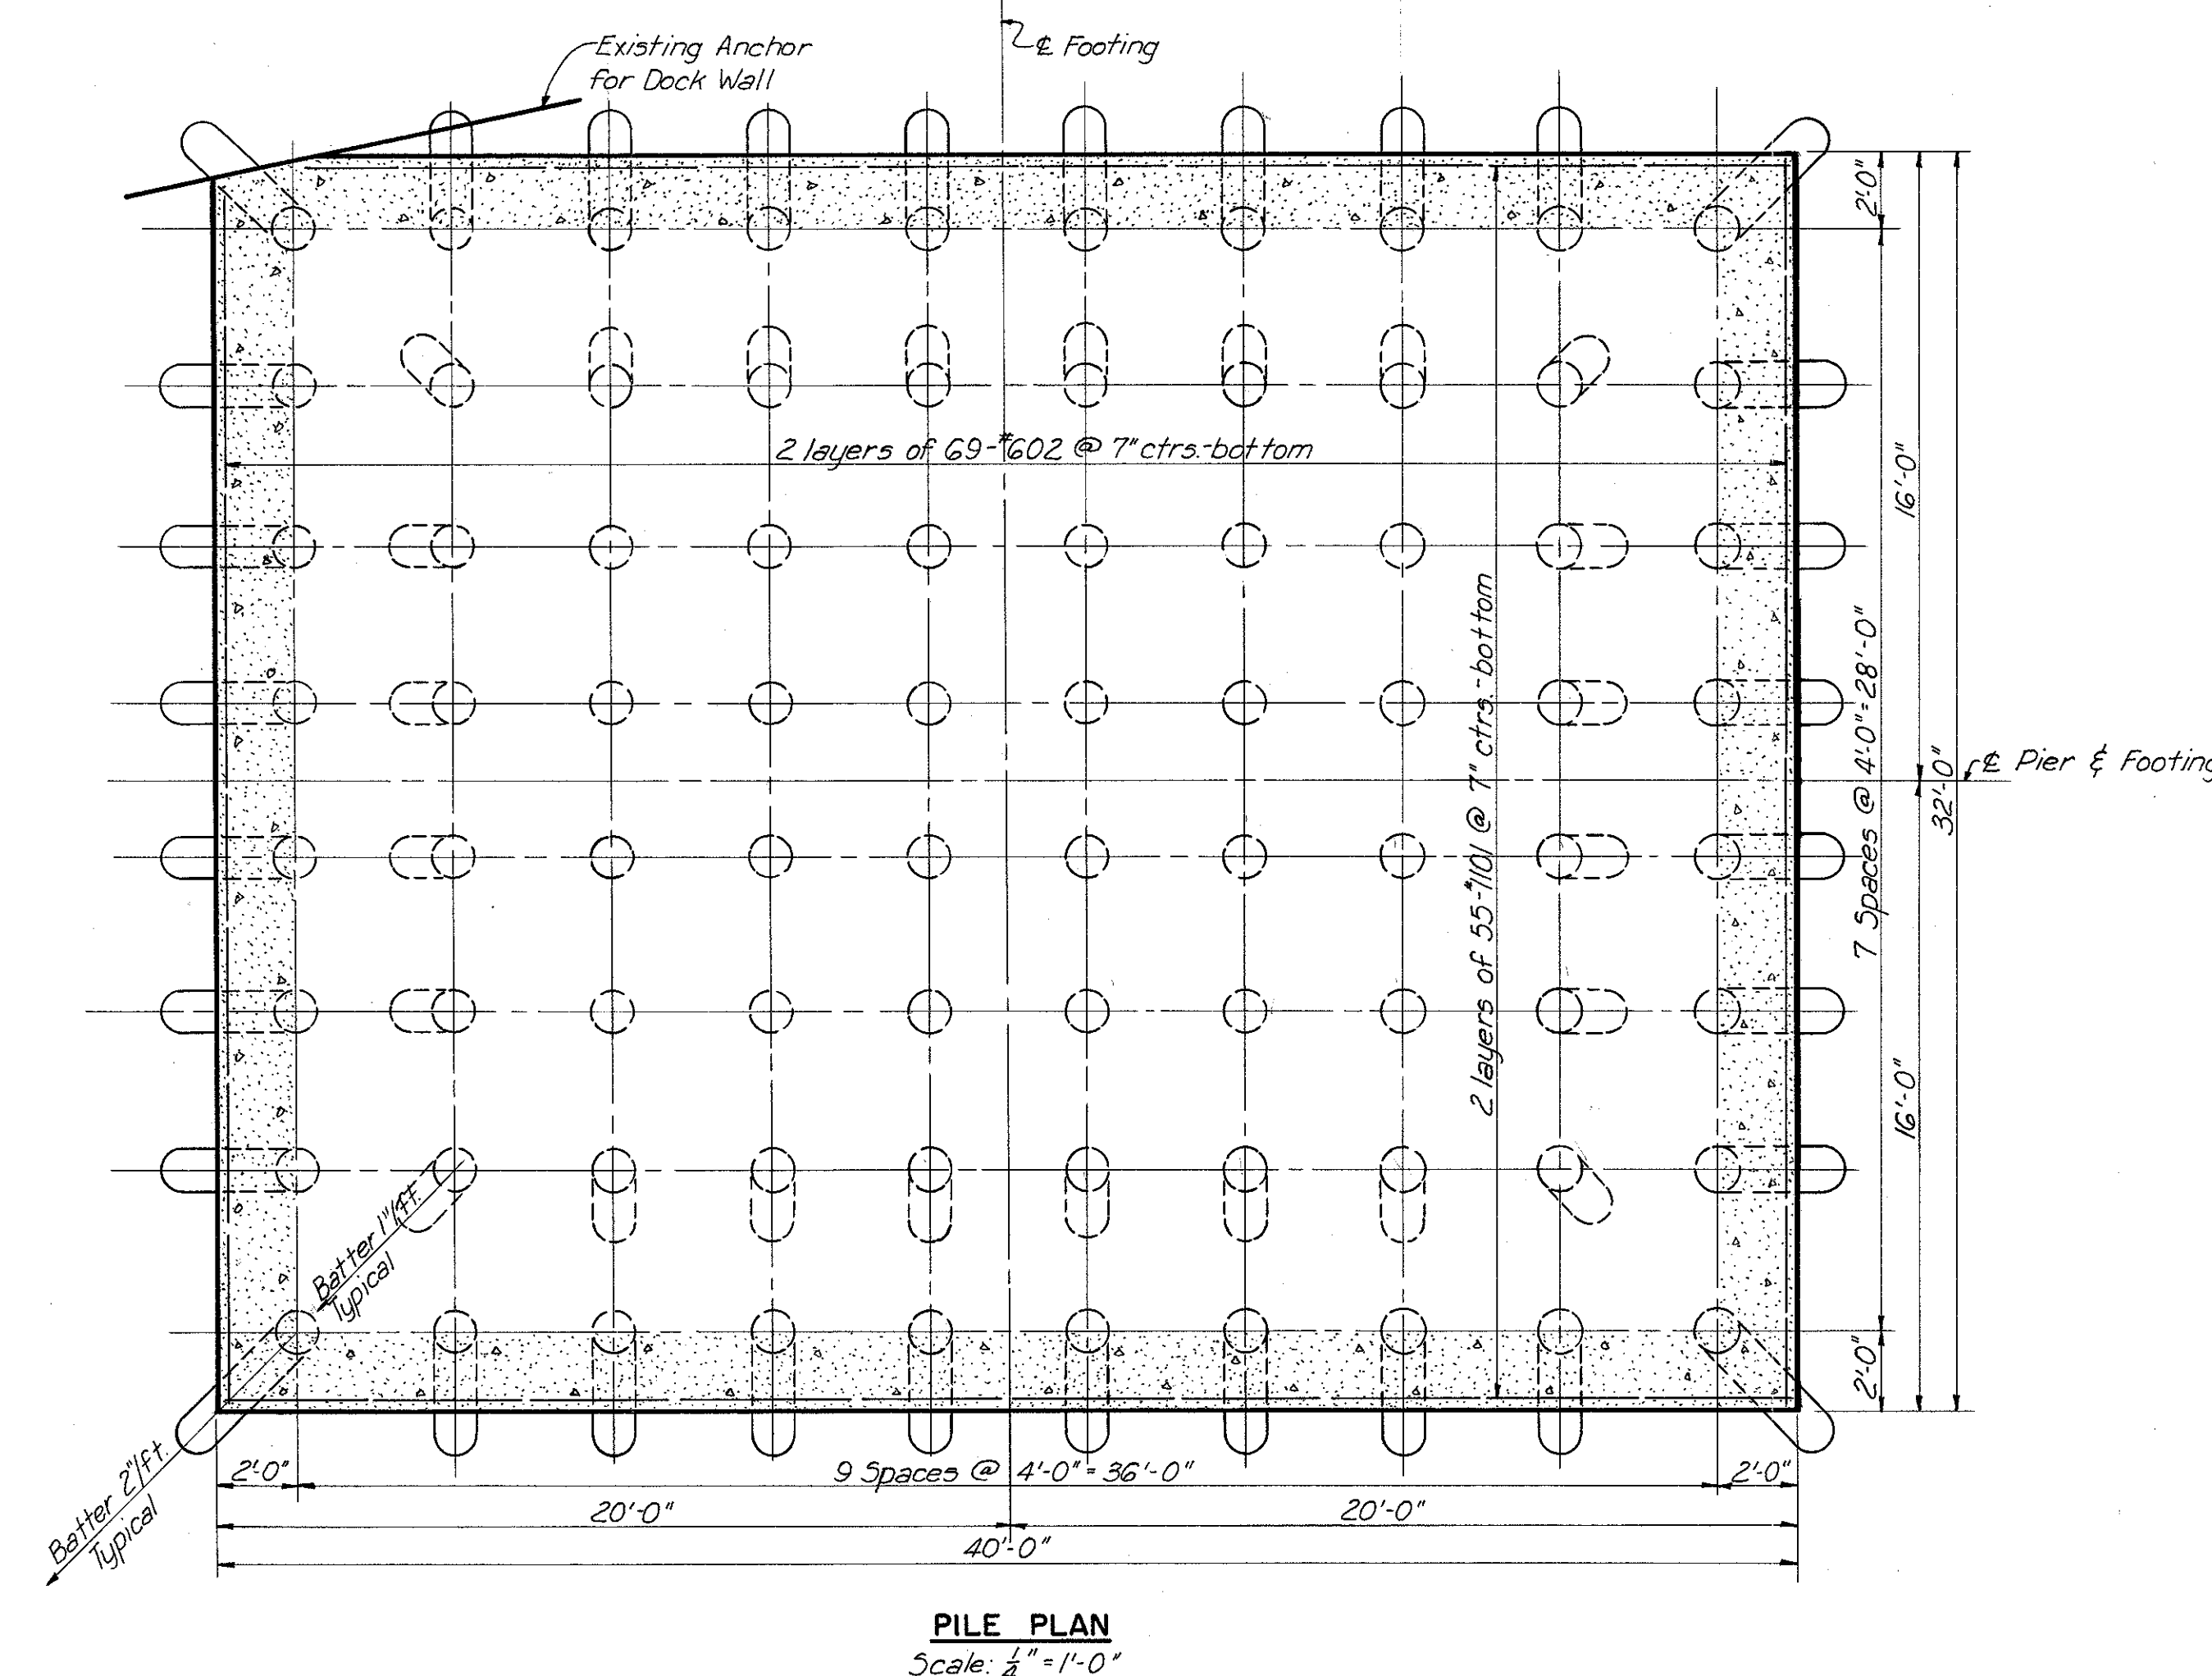

Note: 80-14" cast-in-place reinforced concrete piles with a nominal design capacity of 65 tons each. Estimated length 90 ft. each. Batter outside row of piles 2" per ft., and batter second row of piles 1" per ft. For reinforcing schedule, see Shs. 30 and 31.

PART 2


U. S. ROUTE 42 RELOCATION INNER BELT FREEWAY - CENTRAL VIADUCT		
PIER FOOTING 2S		
CLEVELAND	CUYAHOGA COUNTY	OHIO
SCALE: AS SHOWN MADE D.E.R. DATE 6-9-54 TRCD. A.A.M. DATE 6-25-54 CKD. J.S.S. DATE 6-28-54		
HOWARD, NEEDLES, TAMMEN & BERGENDOFF CONSULTING ENGINEERS KANSAS CITY CLEVELAND NEW YORK 914-1A SHEET 1.17		

MICROFILMED
FEB 28 1973


FED. ROAD DIV. NO.	STATE	FEDERAL AID PROJECT NO.	TYPE FUNDS
2	OHIO	UI 1057 (4)	

18
43

CUYAHOGA COUNTY
CITY OF CLEVELAND
INNER BELT FREEWAY
CENTRAL VIADUCT
CUY - 42 R-17.50

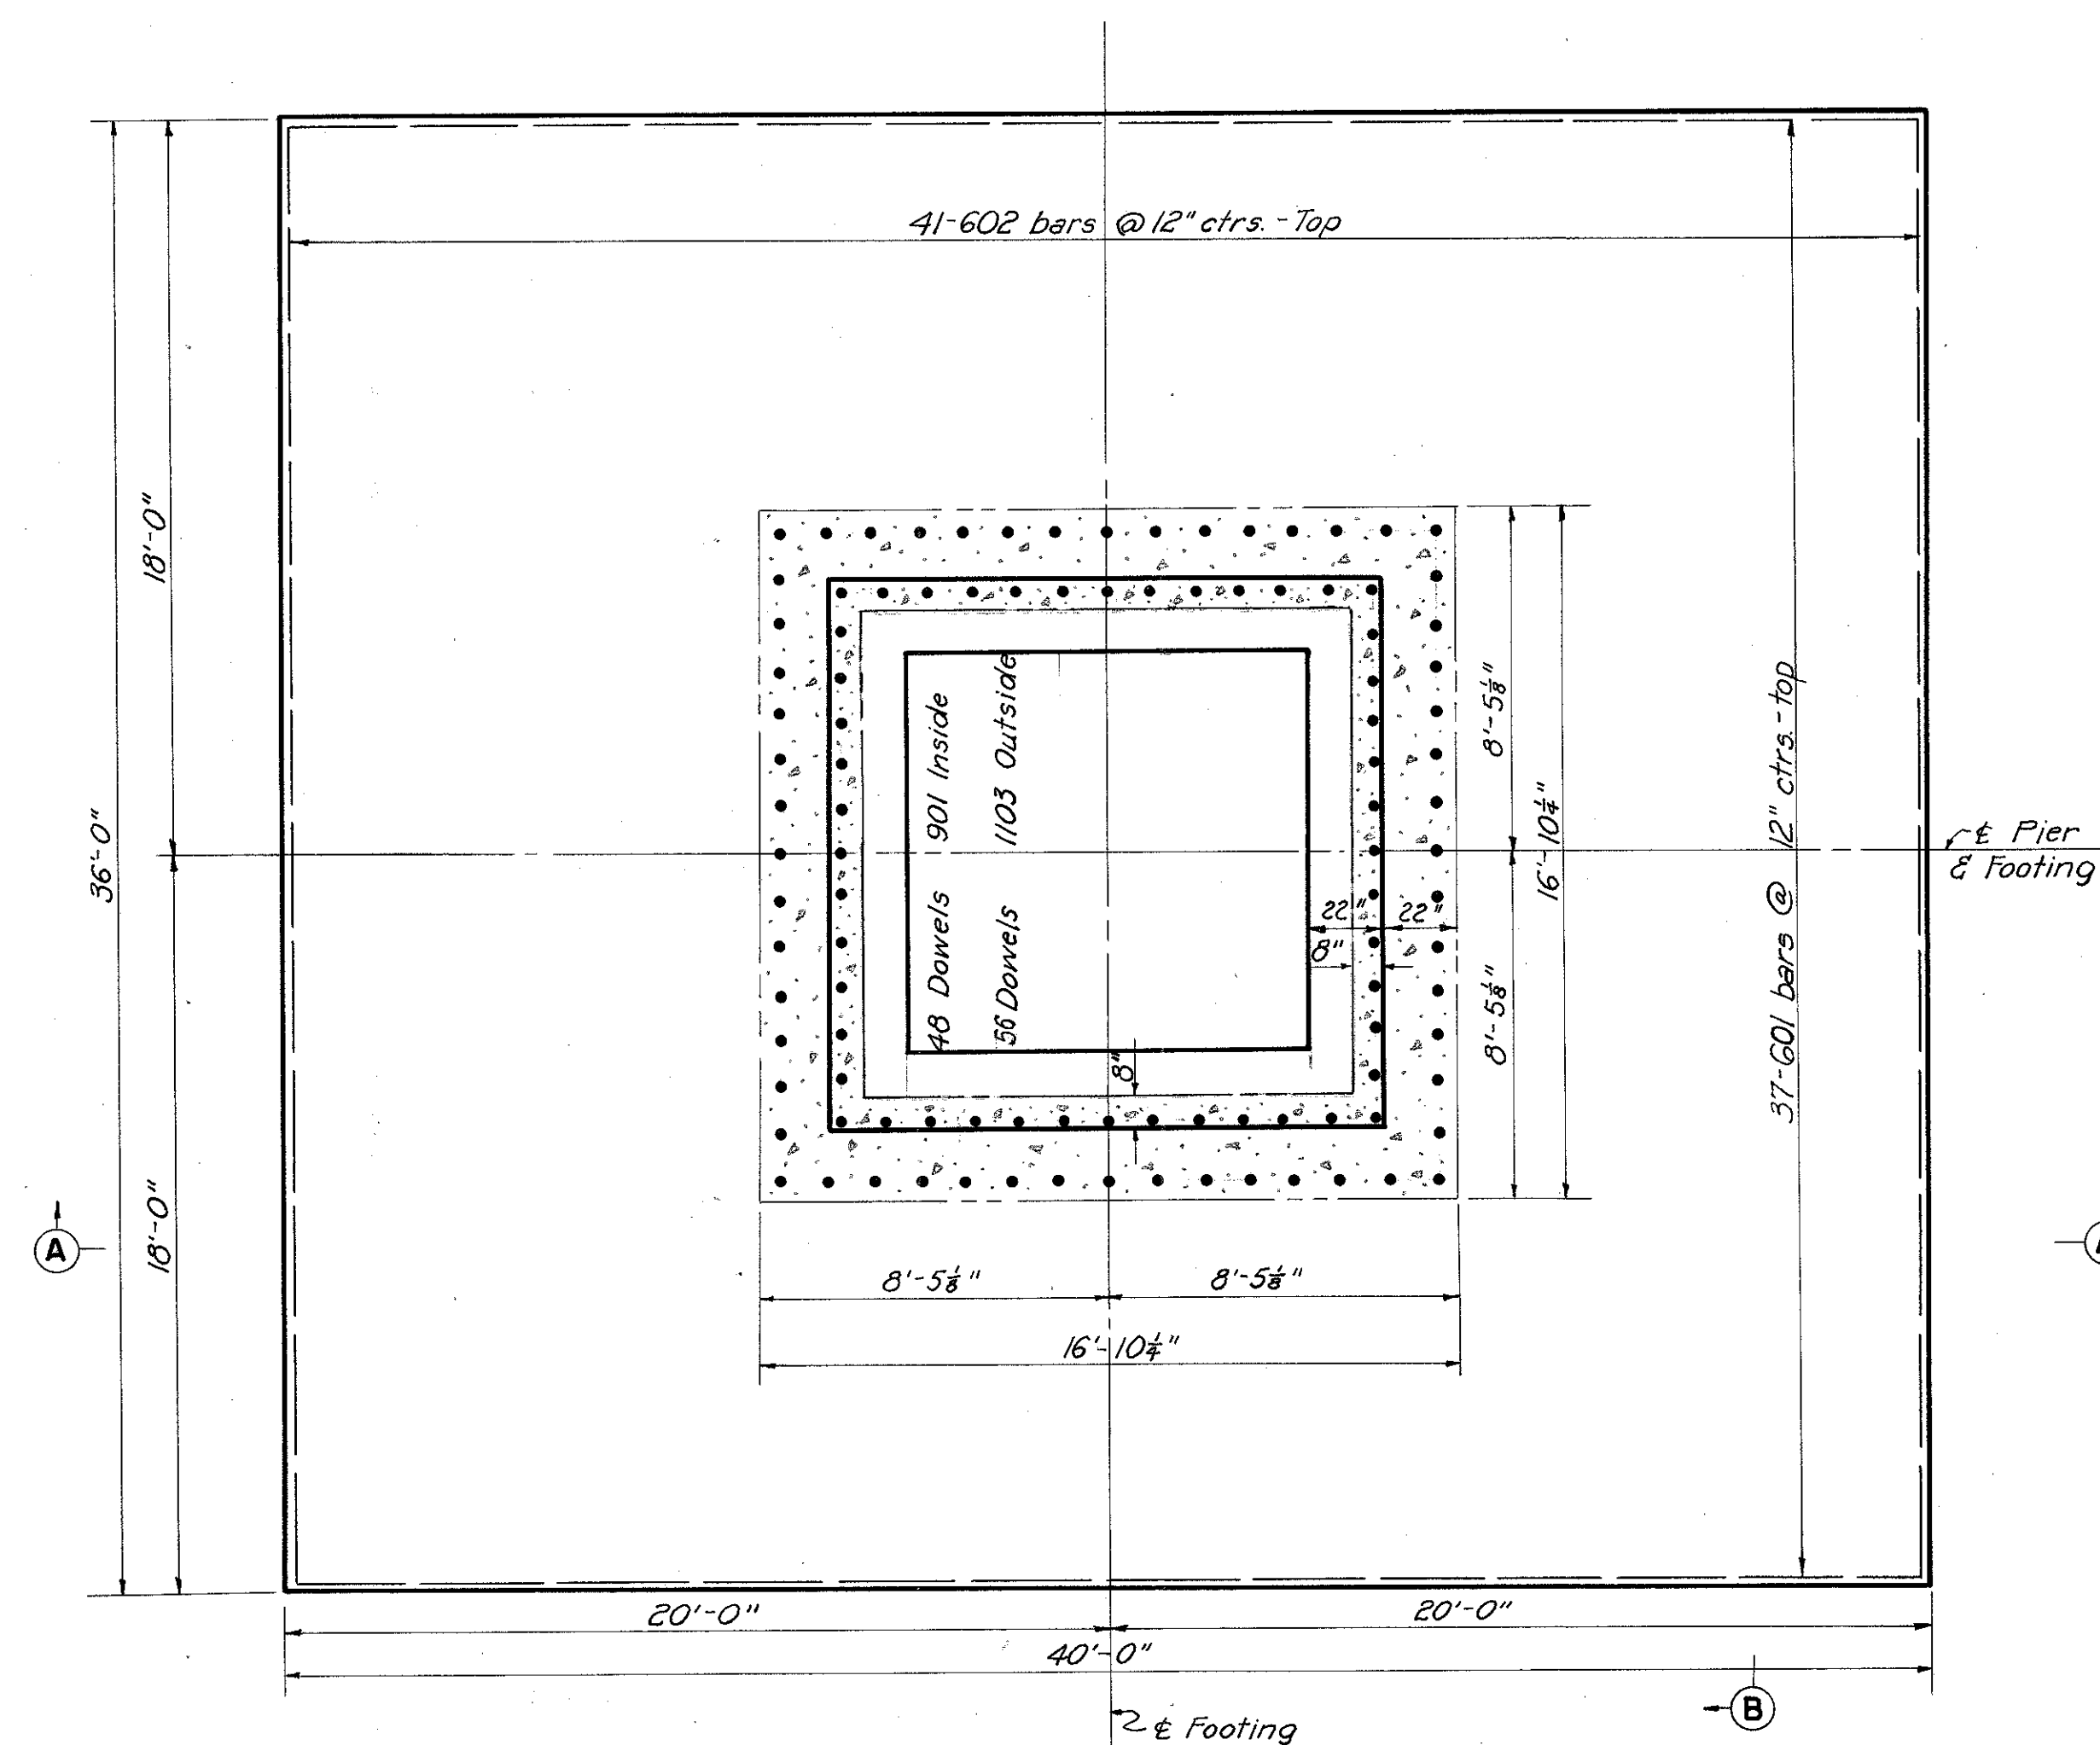


PLAN
Scale: 1/4" = 1'-0"

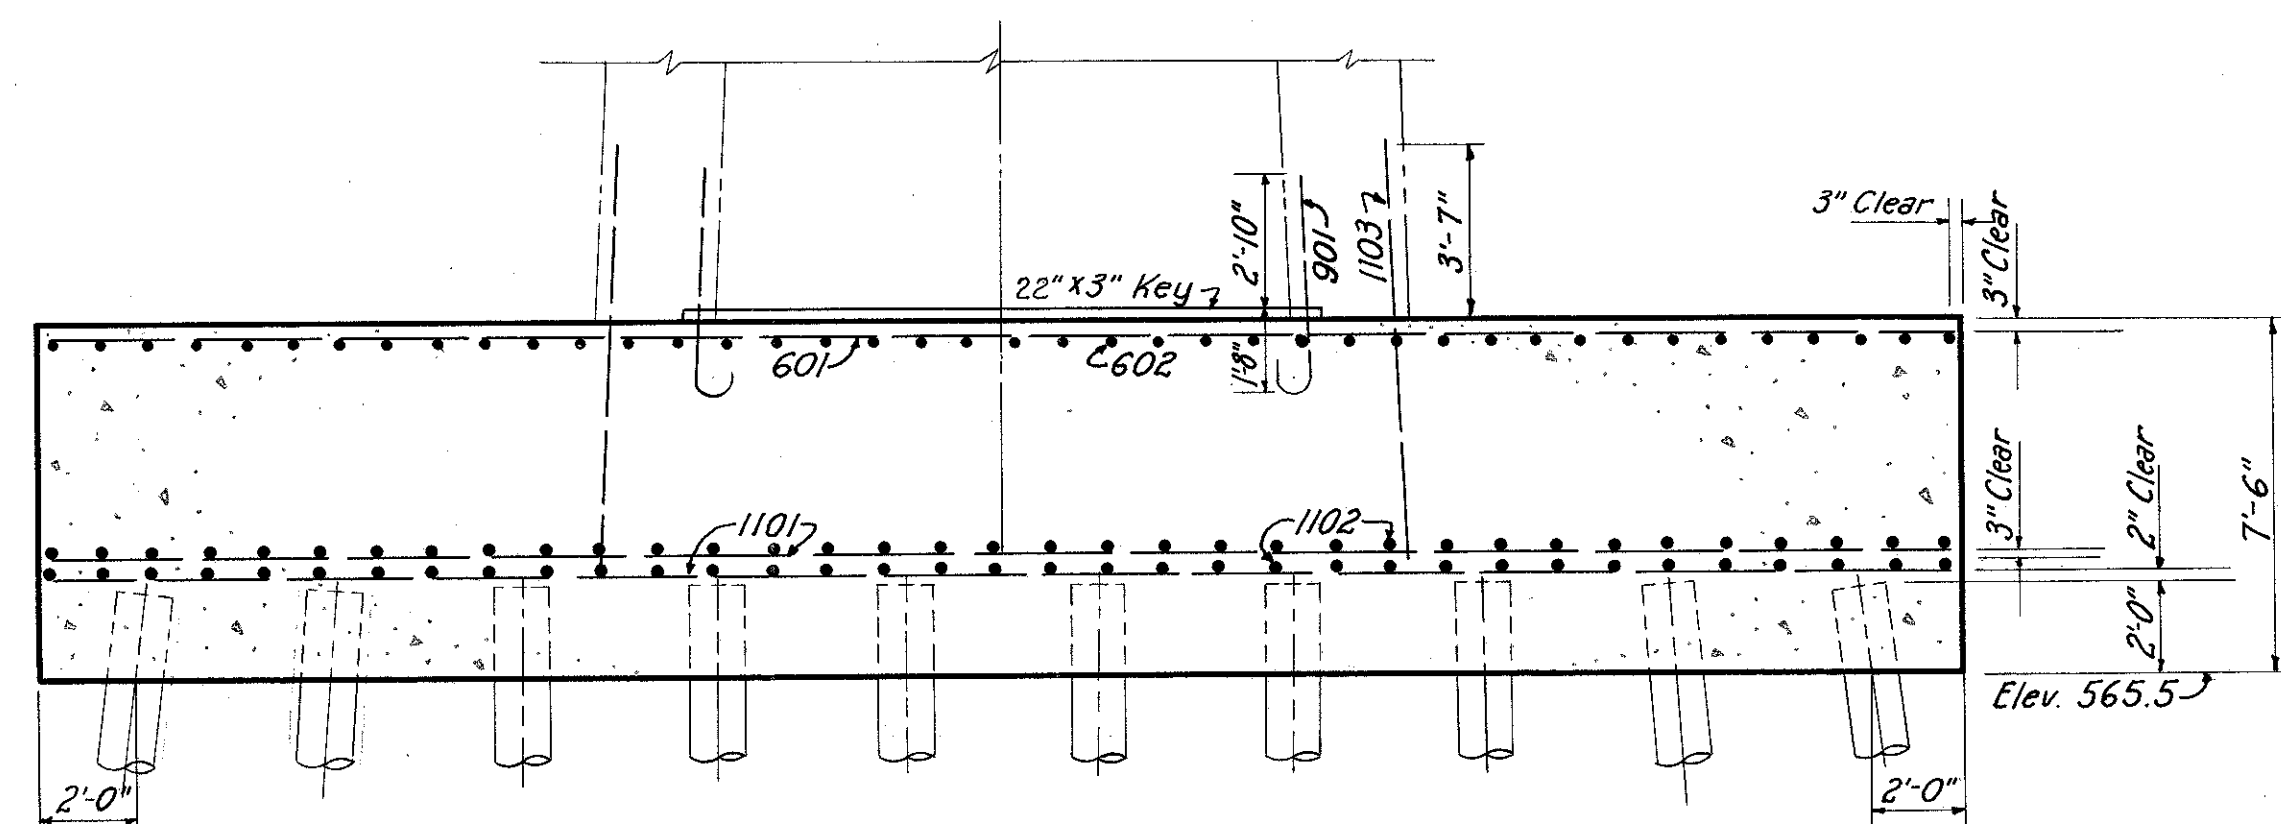


SECTION A-A
Scale: 1/4" = 1'-0"

AXIS OF C. OF VIADUCT

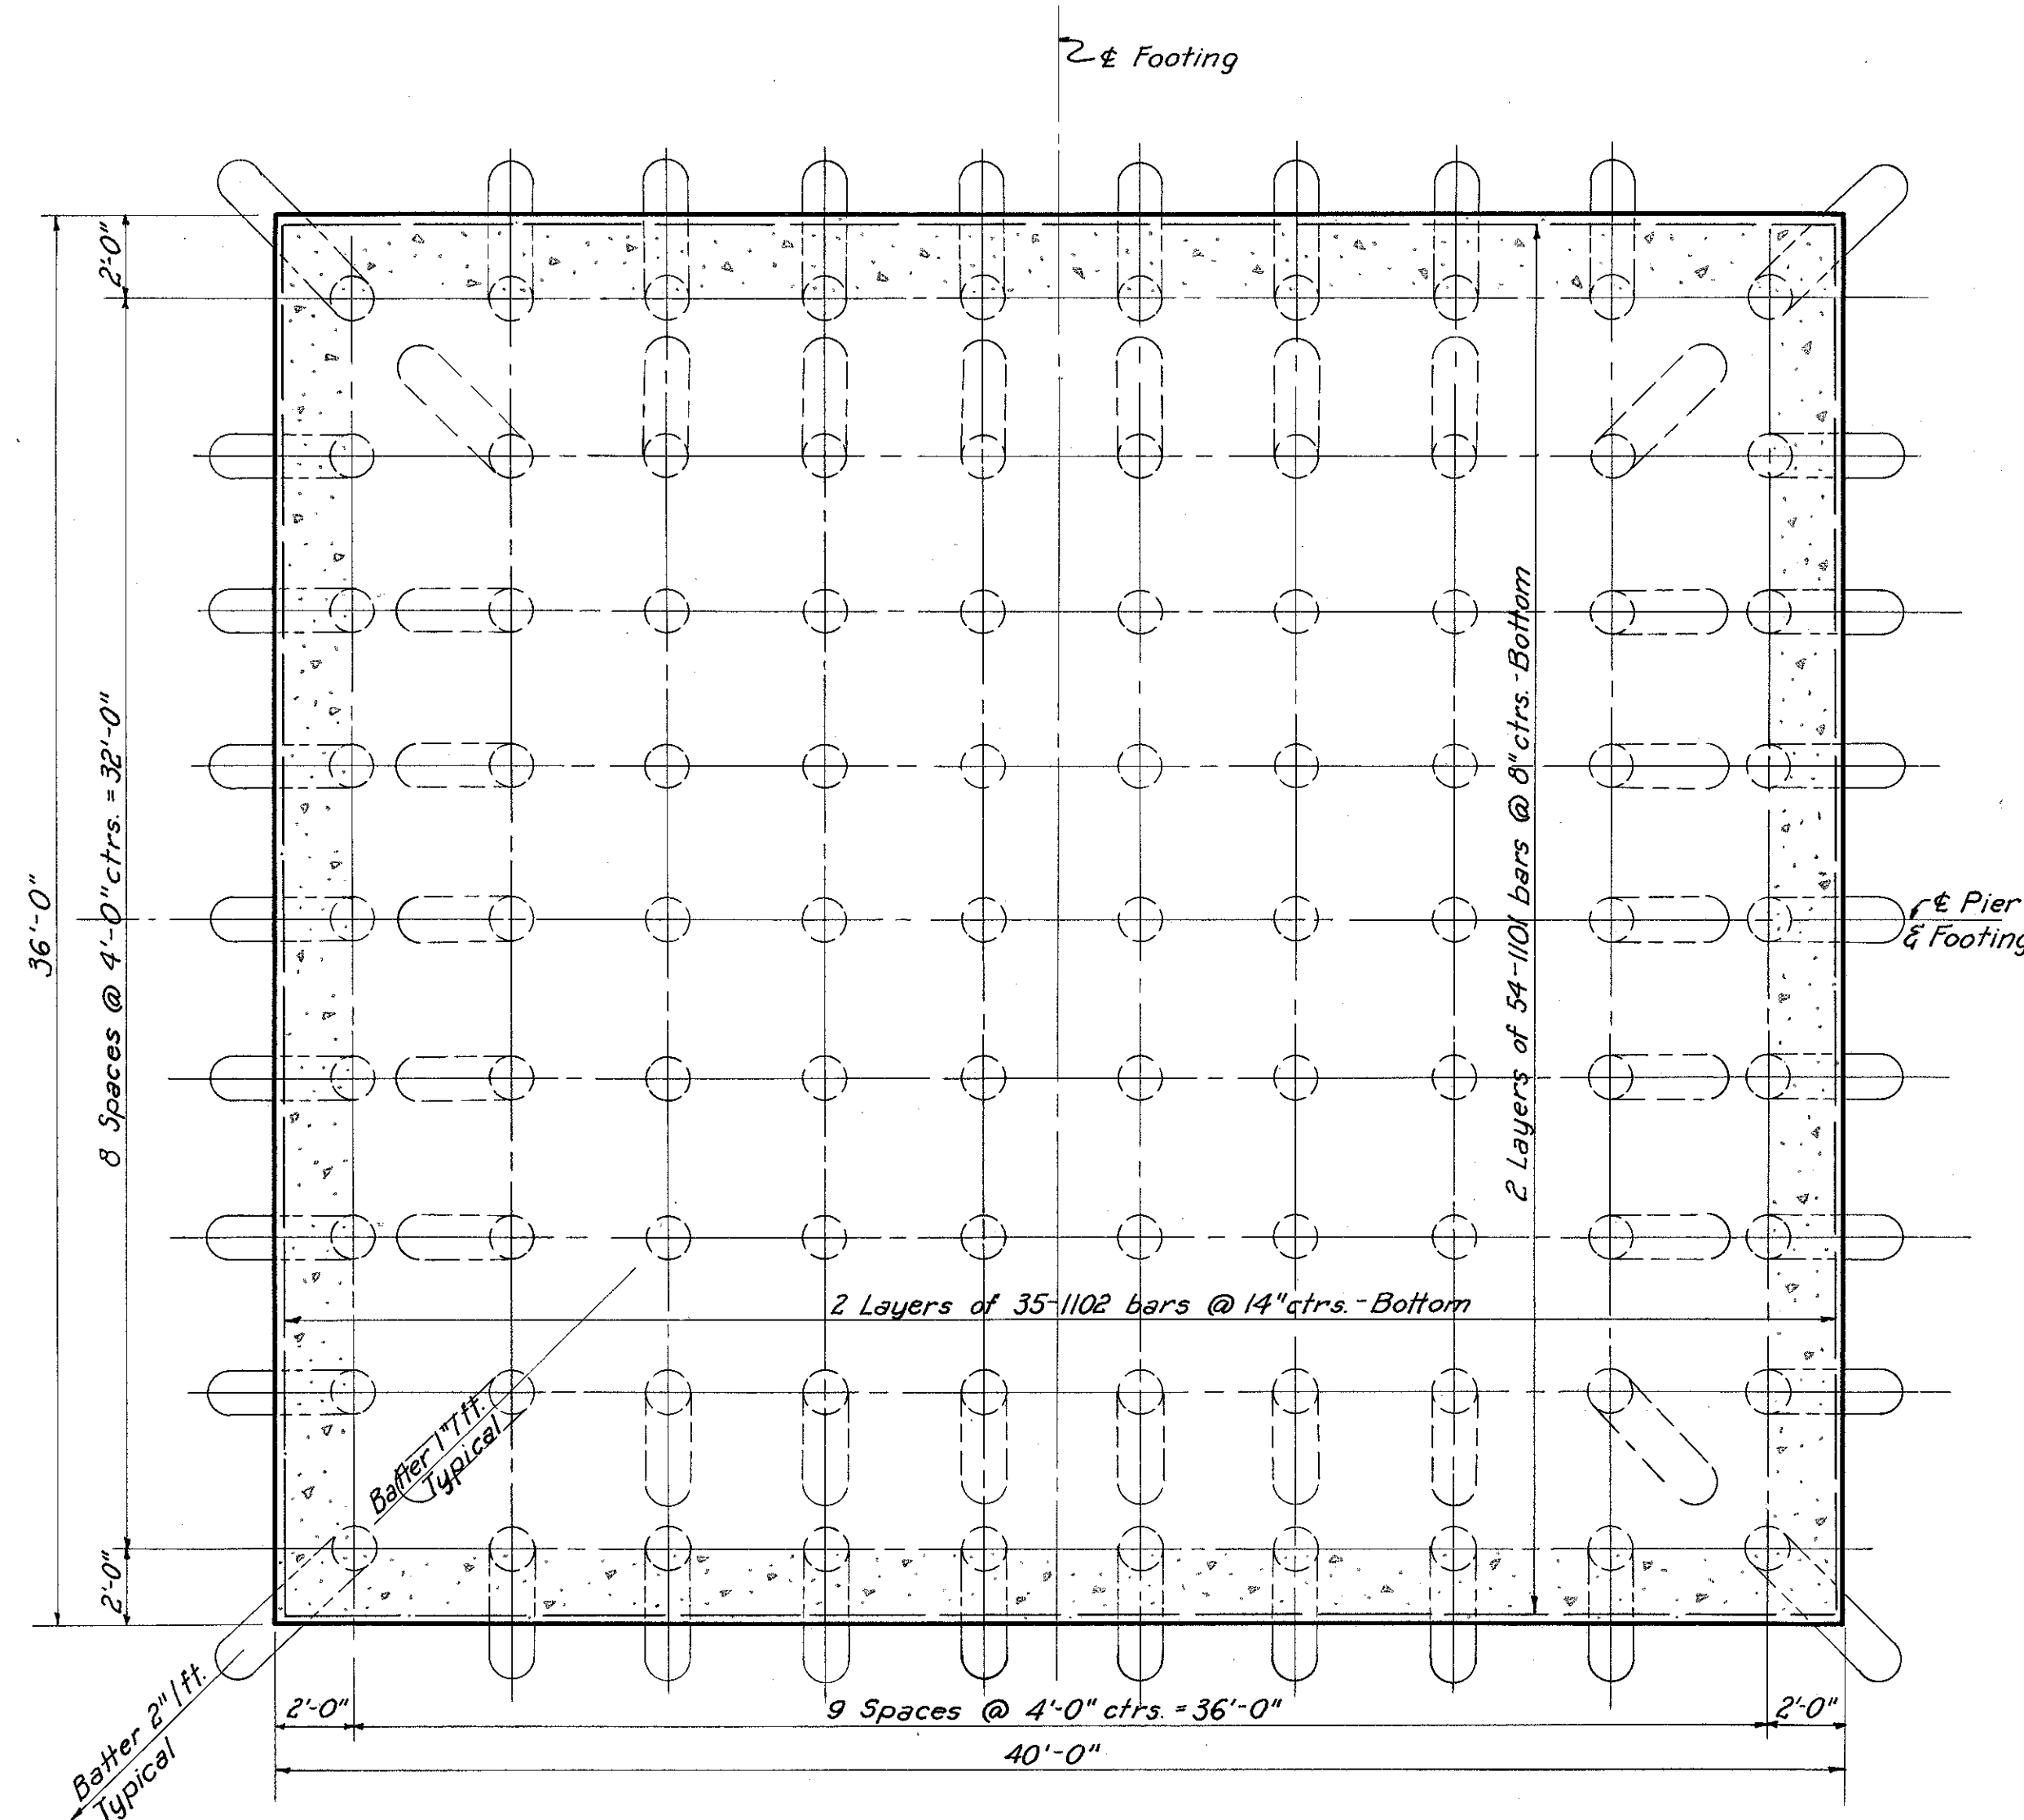

PILE PLAN
Scale: 1/4" = 1'-0"

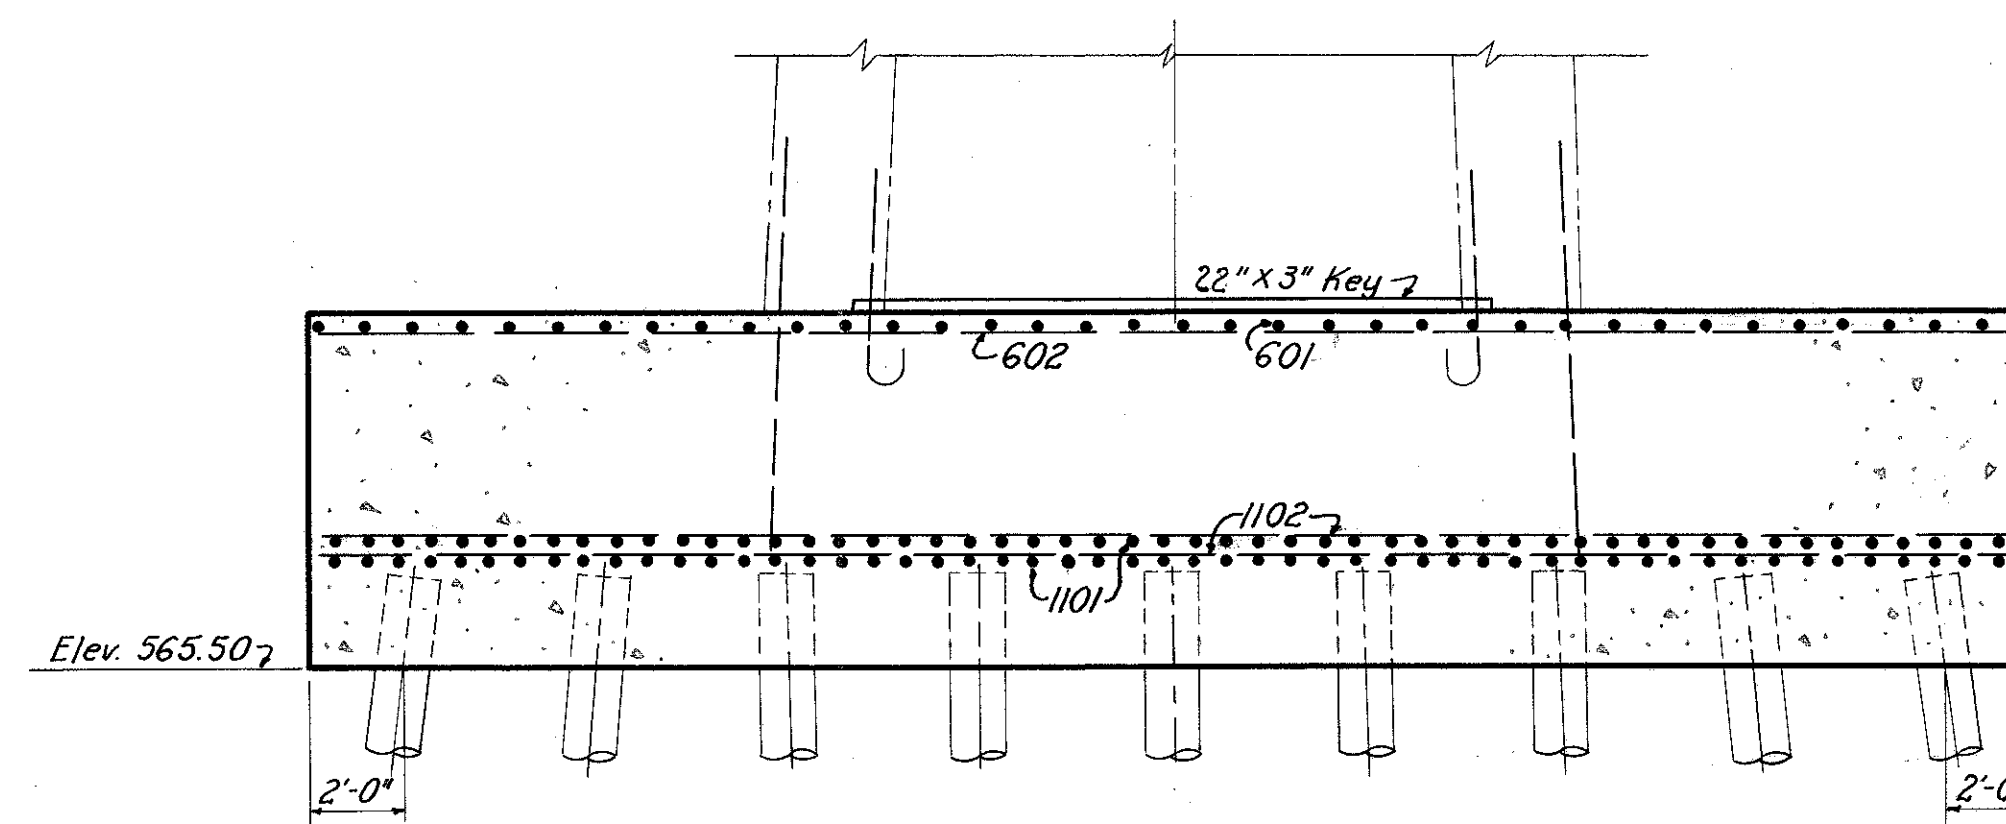

SECTION B-B
Scale: 1/4" = 1'-0"

Note:
90-14" Cast-in-Place Reinforced Concrete Piles With a Nominal Design Capacity of 65 Tons for Each Footing. Estimated Length 90 ft. Each. Batter Outside Row of Piles 2" per ft. and Batter Second Row 1" per ft. For Reinforcement Schedule, see Shs. 30 and 31.

PART 2

U. S. ROUTE 42 RELOCATION
INNER BELT FREEWAY - CENTRAL VIADUCT

PIER FOOTINGS 3N AND 3S


CLEVELAND CUYAHOGA COUNTY OHIO

SCALE: AS SHOWN
MADE BY: E.G. DATE: 2-9-54
TRCD: E.J.B. DATE: 5-7-54
CKD: C.J.C. DATE: 2-25-54
HOWARD, NEEDLES, TAMMEN & BERGENDOFF
CONSULTING ENGINEERS
KANSAS CITY CLEVELAND NEW YORK
914-1A SHEET: 1.18


CUYAHOGA COUNTY
CITY OF CLEVELAND
INNER BELT FREEWAY
CENTRAL VIADUCT
CUY - 42 R - 17.50

Pier Footing	x	y	Estimated pile length
4S	16'-11 1/2"	8'-5 1/2"	90ft.
5S	17'-1 1/8"	8'-6 1/2"	85ft.
7S	16'-9 3/4"	8'-4 3/4"	70ft.

Note:
86-14" ϕ cast-in-place reinforced
concrete piles with a nominal design
capacity of 65 tons for each pile.
Batter outside row 2" per foot, and
batter second row 1" per foot.
For reinforcing schedule see
sheets 30 and 31.

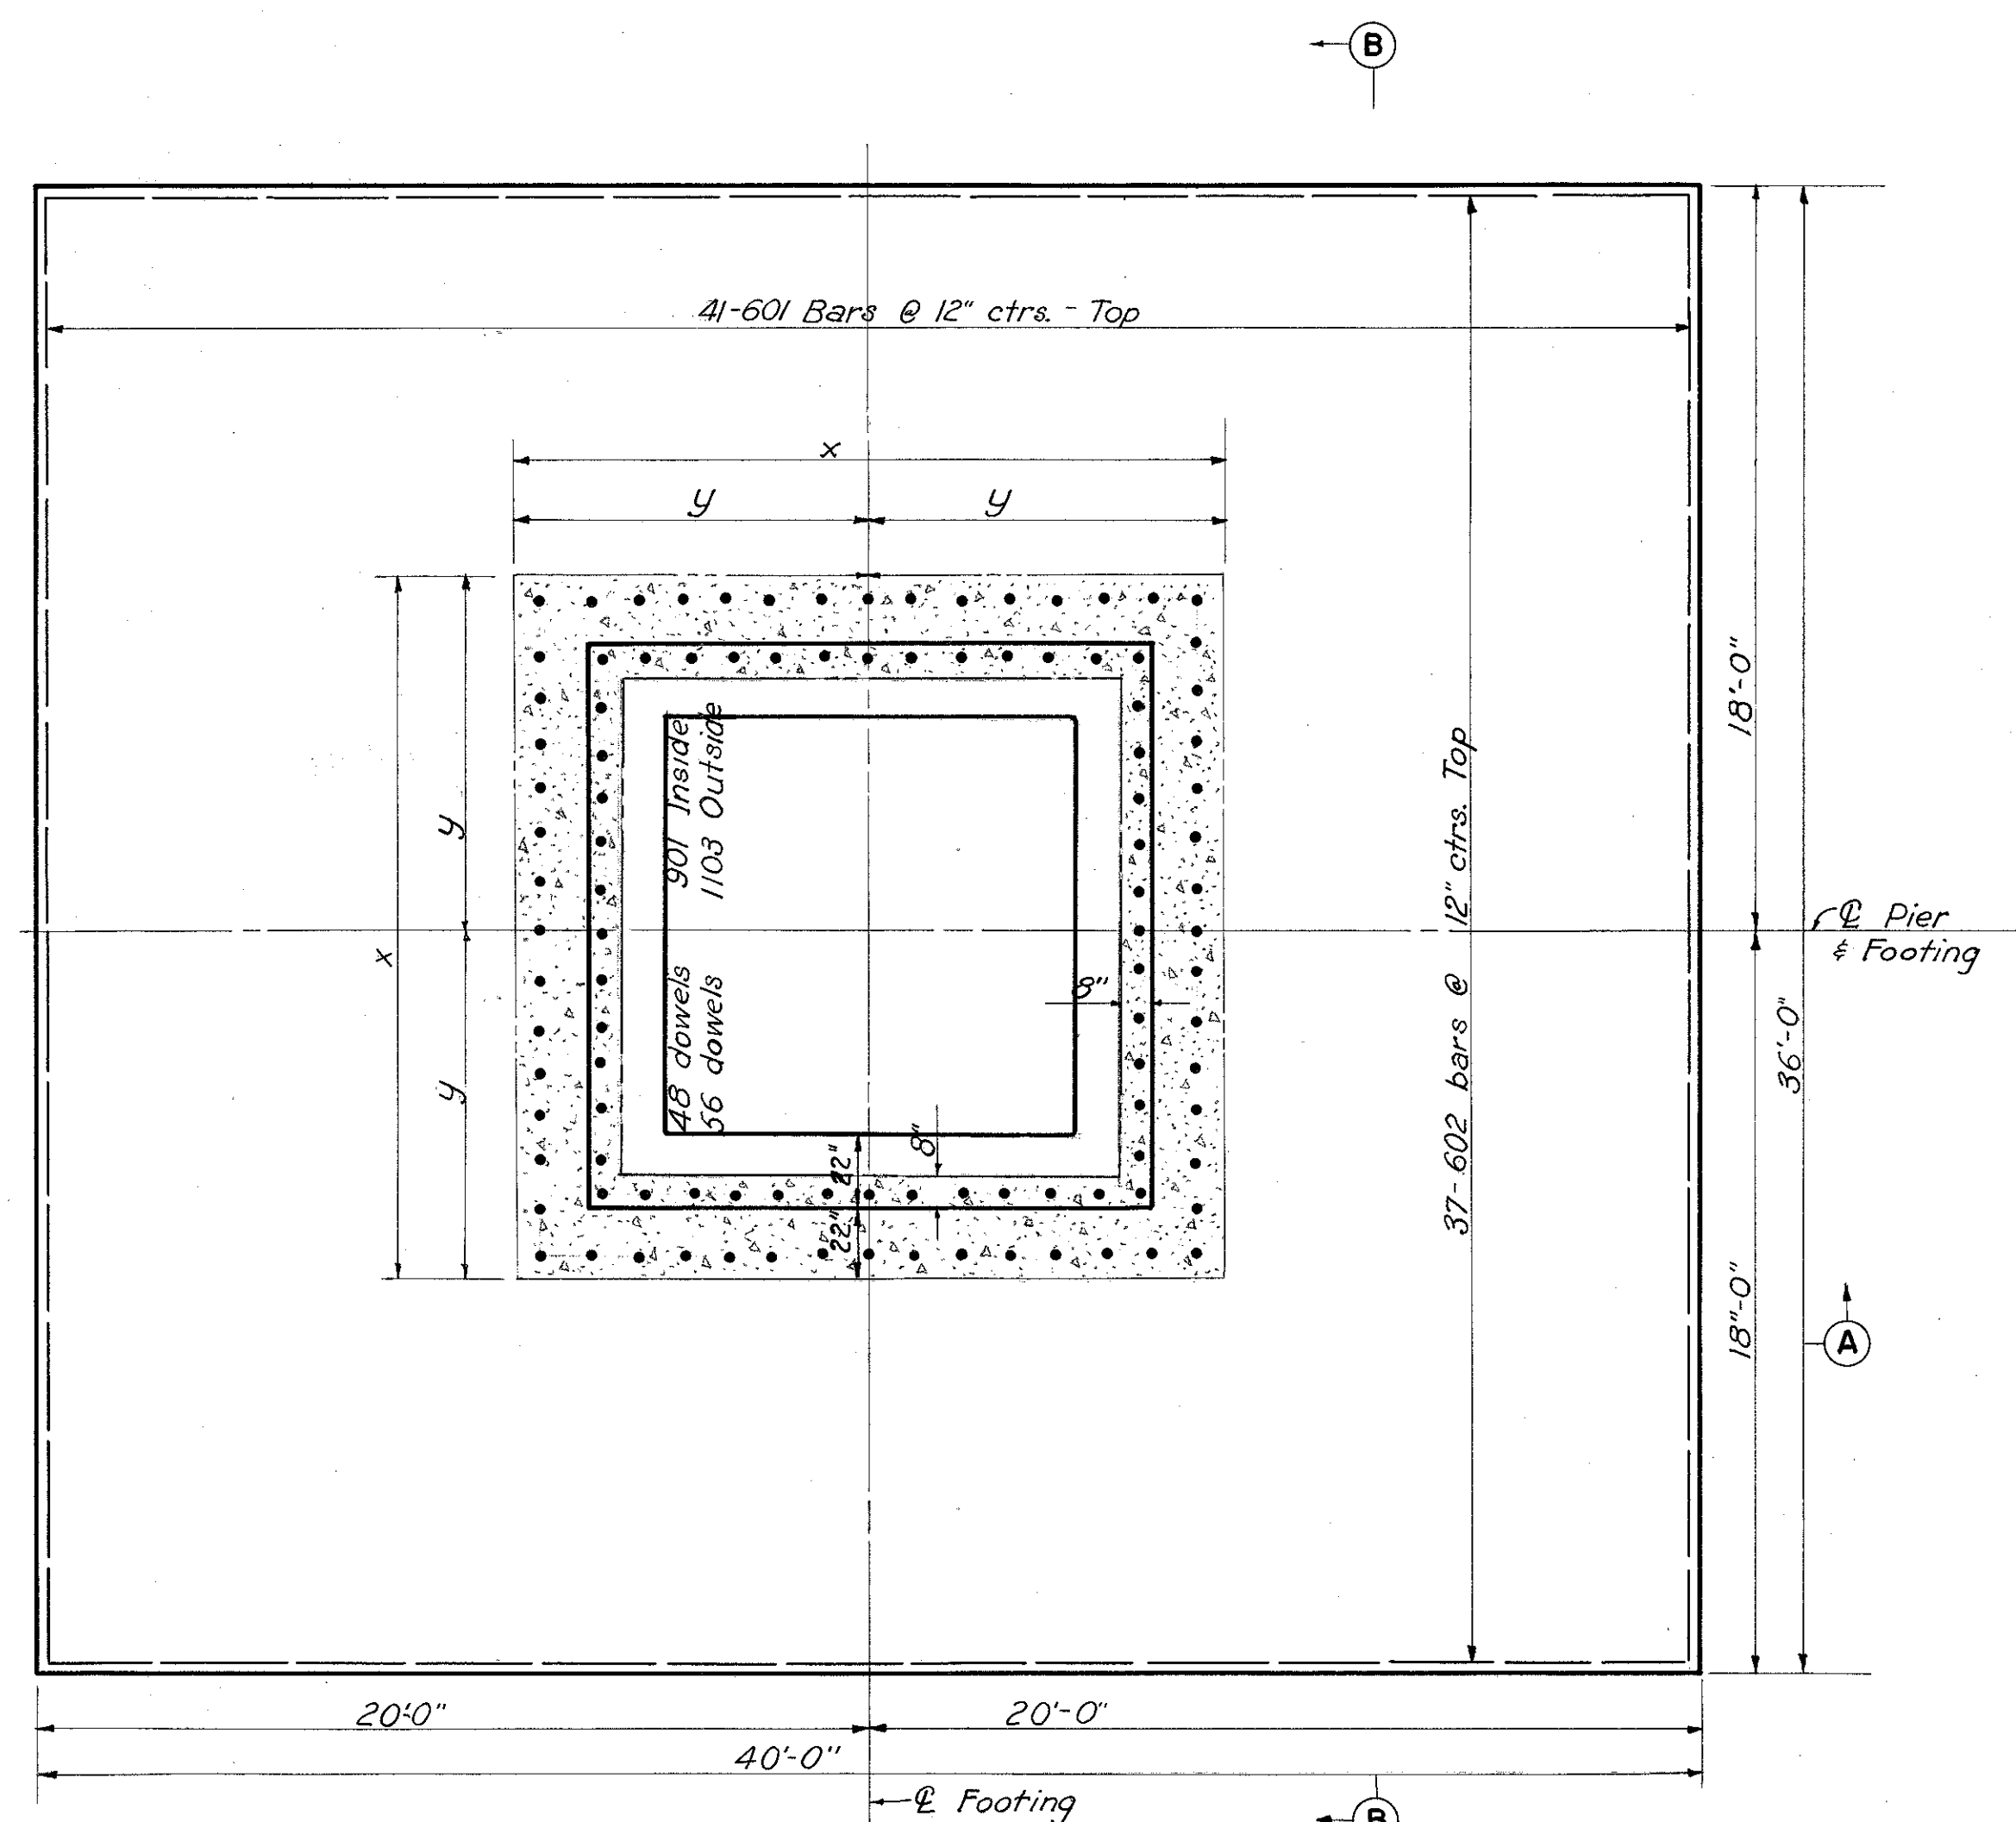


PLAN
Scale: 1/4"=1'-0"

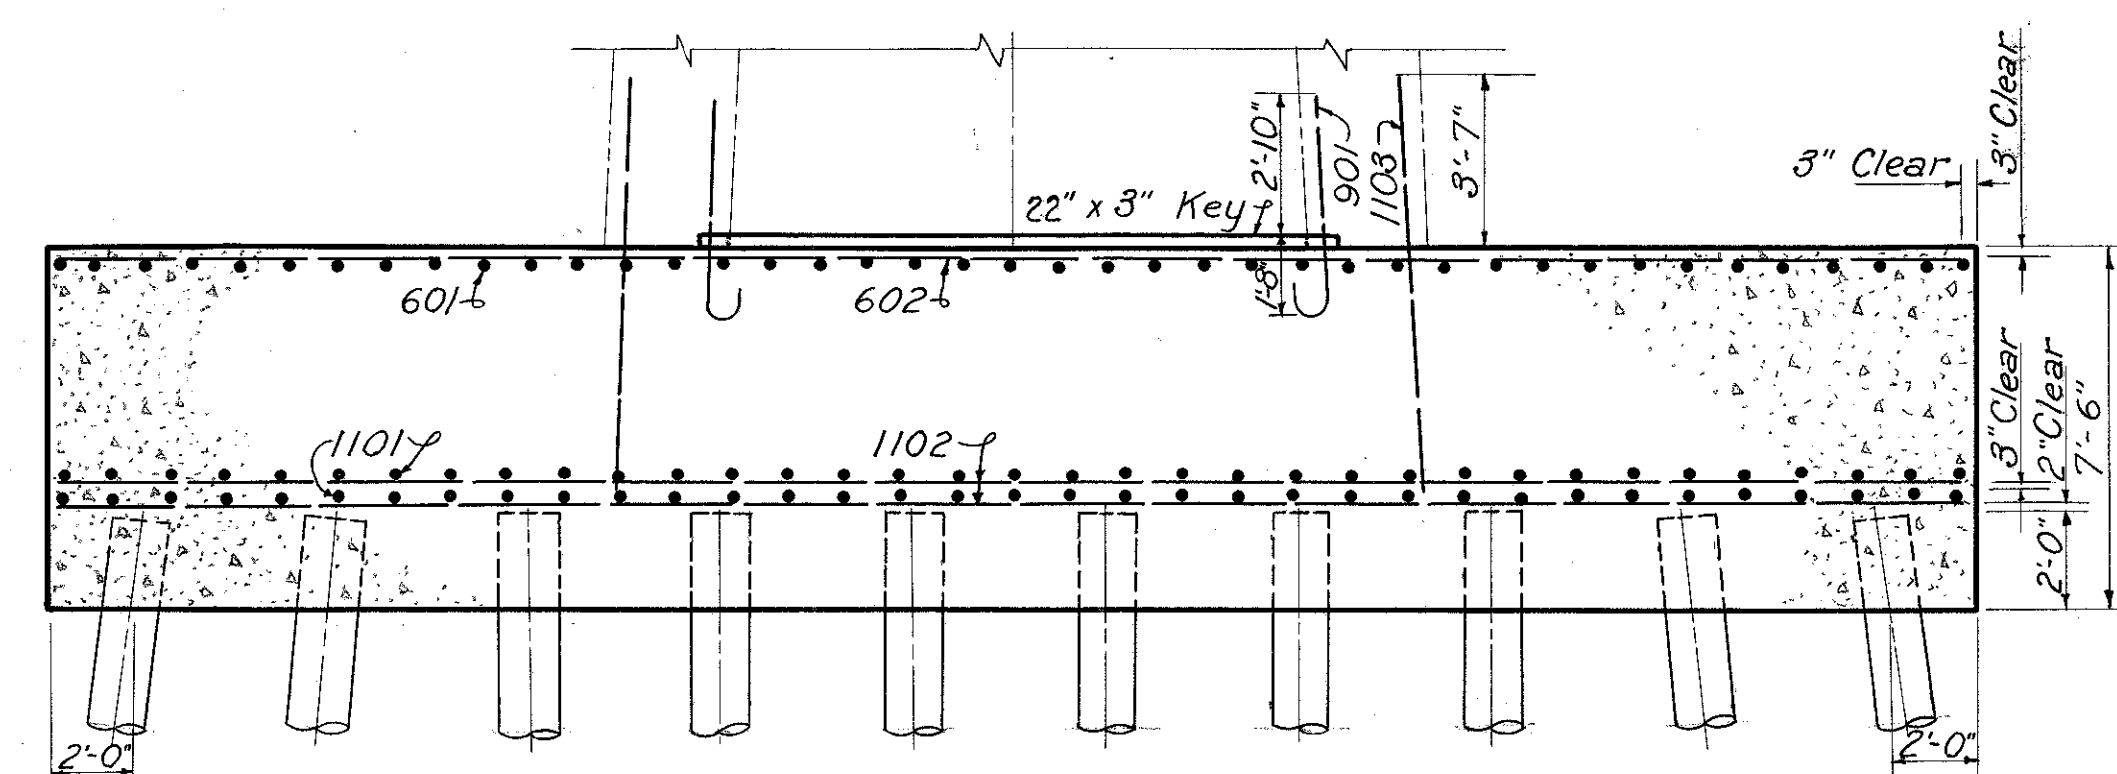


SECTION A-A
Scale: 1/4"=1'-0"

AXIS OF ϕ OF VIADUCT

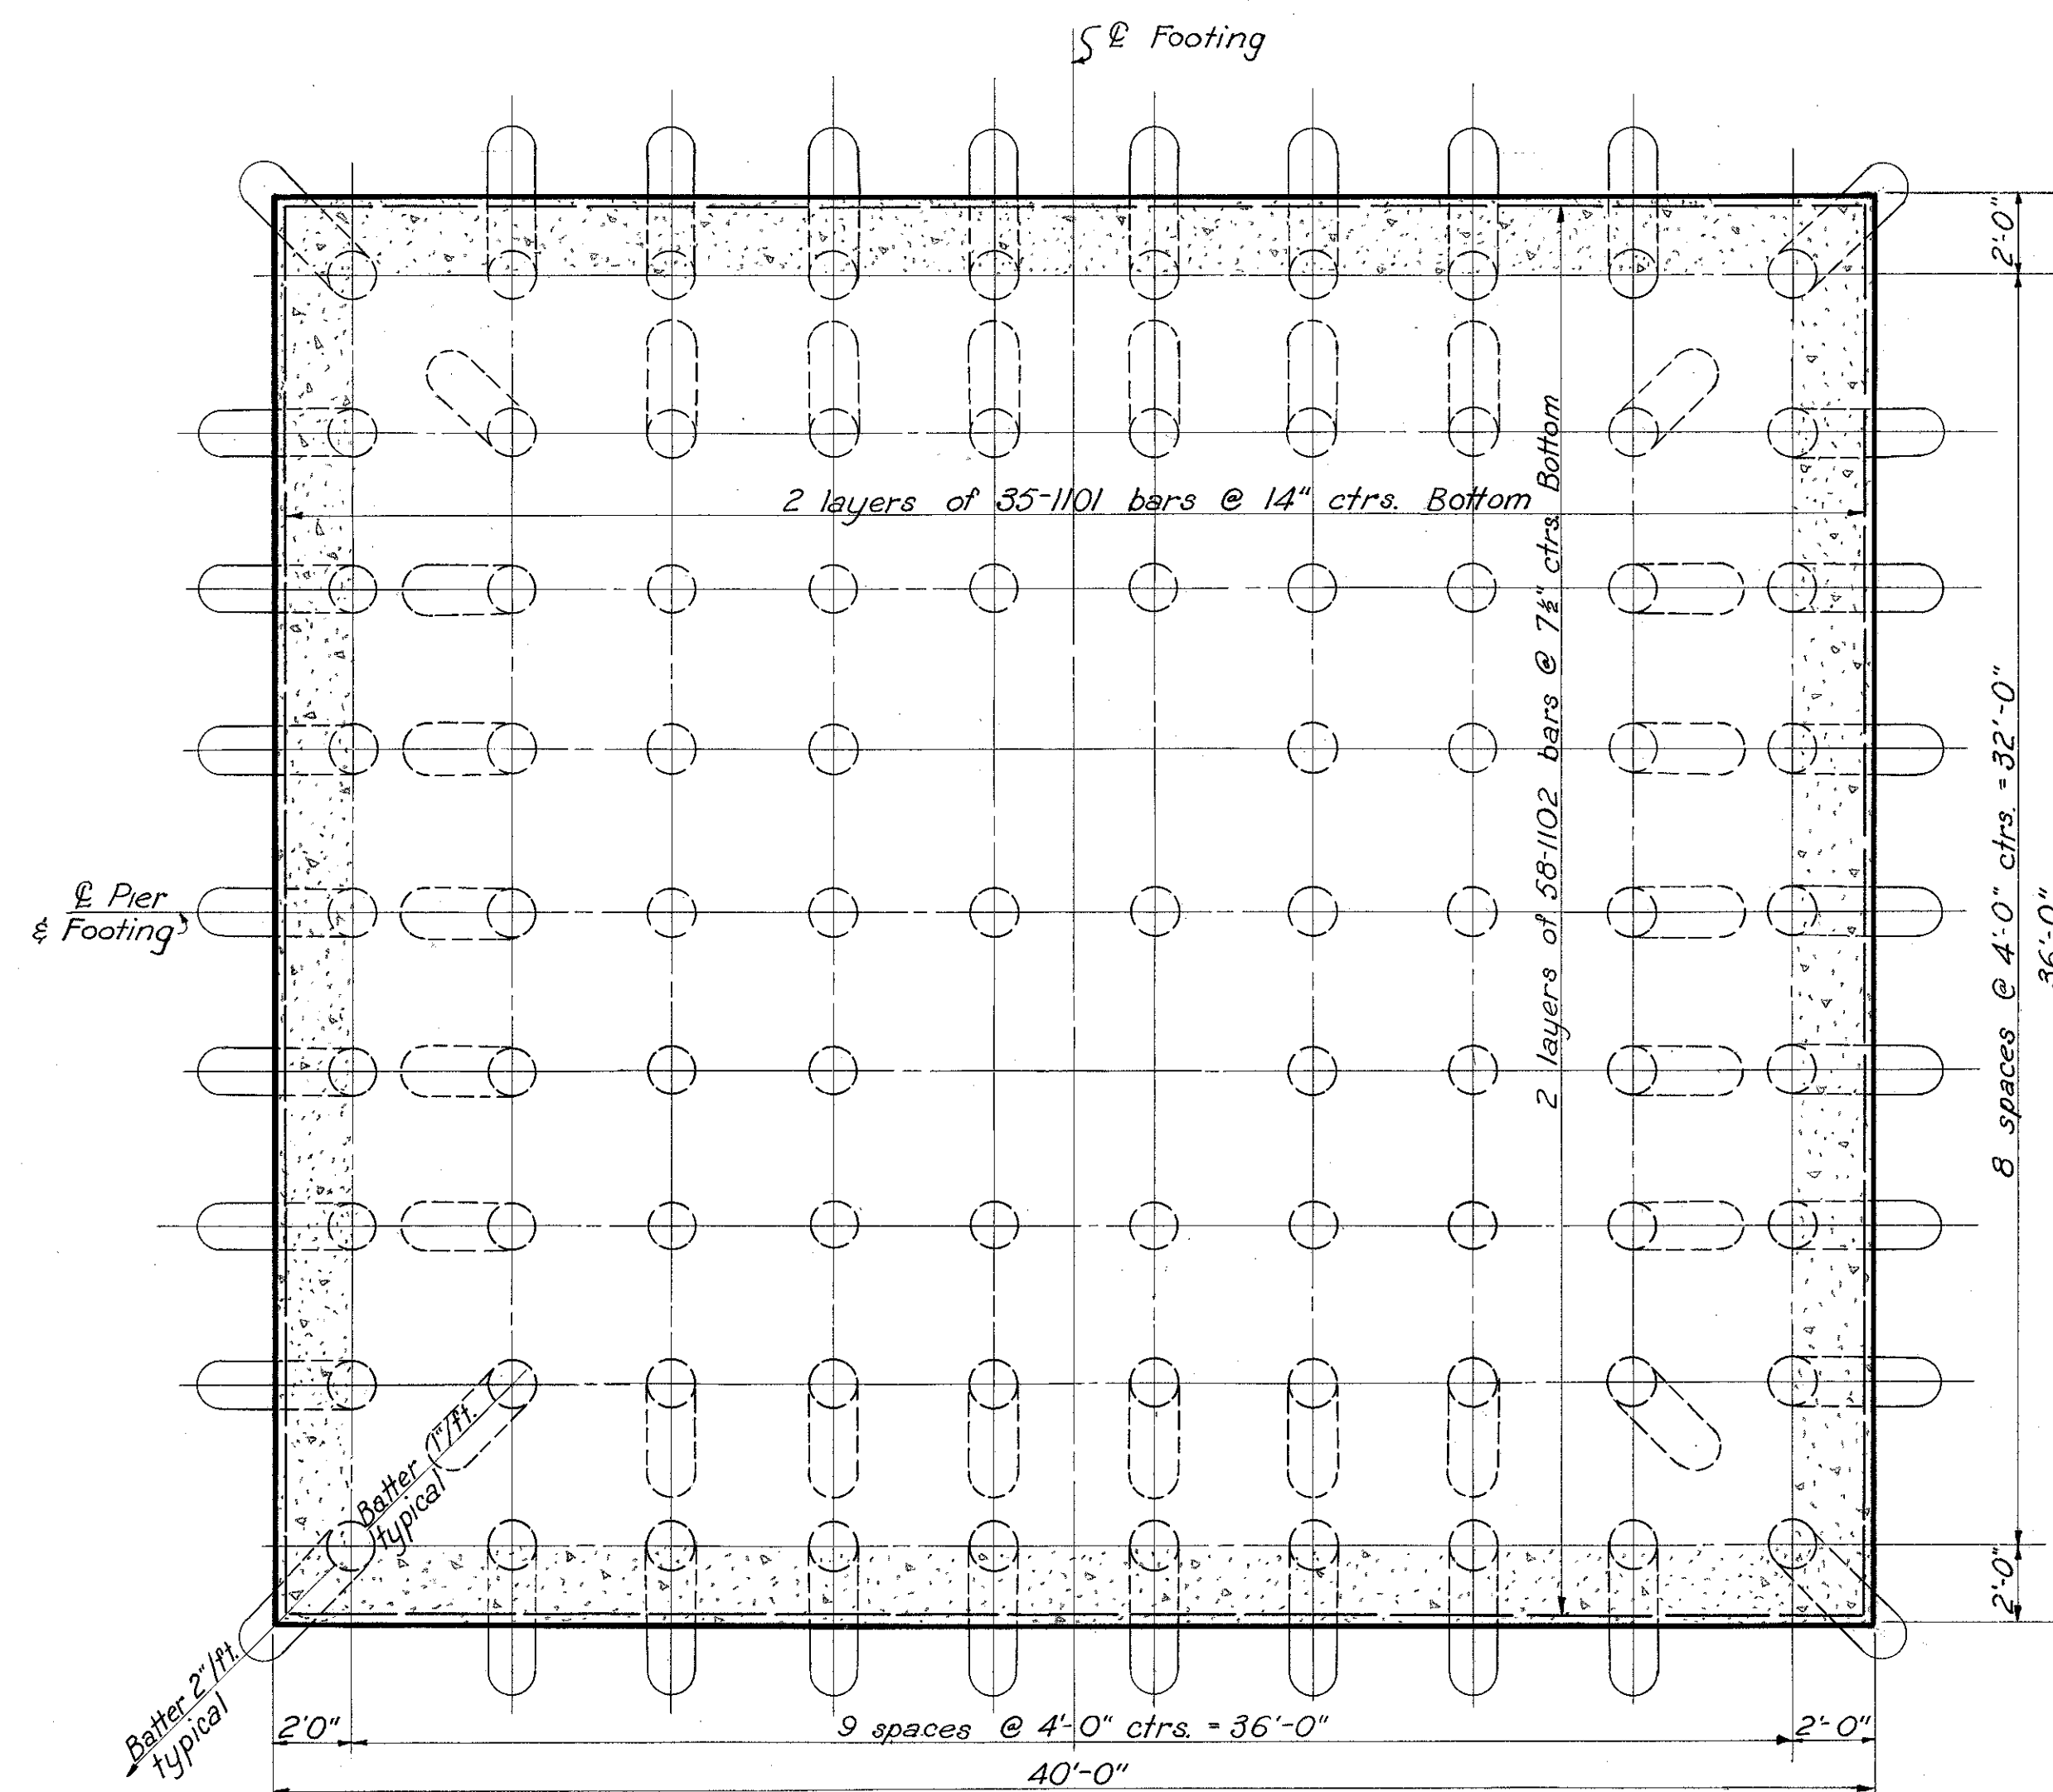

PILE PLAN
Scale: 1/4"=1'-0"

Footing 4S Elev. 566.5
Footings 5S & 7S Elev. 567.5

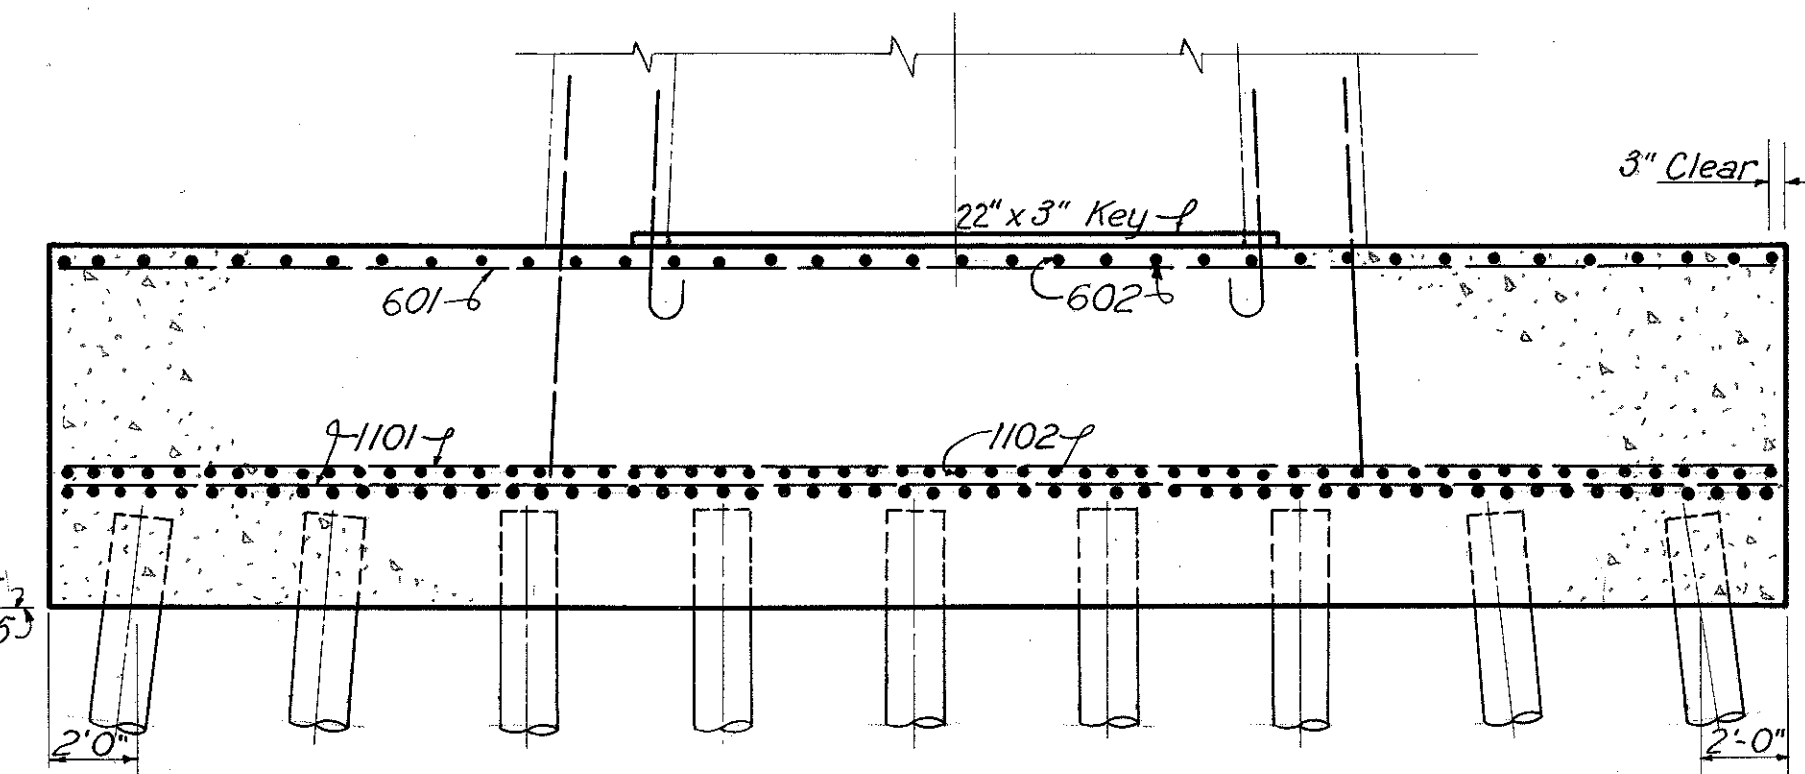

SECTION B-B
Scale: 1/4"=1'-0"

PART 2

U. S. ROUTE 42 RELOCATION
INNER BELT FREEWAY - CENTRAL VIADUCT

PIER FOOTINGS 4S, 5S, AND 7S

CLEVELAND CUYAHOGA COUNTY OHIO

SCALE AS NOTED
MADE E.G. DATE 2-5-54
TRCD CHB DATE 6-9-54
CKD C.I.C. DATE 2-22-54
HOWARD, NEEDLES, TAMMEN & BERGENDOFF
CONSULTING ENGINEERS
KANSAS CITY CLEVELAND NEW YORK
914-1A SHEET 1.19


SCALE as shown
MADE WEG DATE 2-5-54
TRCD JAV DATE 6-9-54
CKD CJC DATE 2-25-54

HOWARD, NEEDLES, TAMMEN & BERGENDORF
CONSULTING ENGINEERS
KANSAS CITY CLEVELAND NEW YORK
914-1A SHEET 120


FED. ROAD DIV. NO.	STATE	FEDERAL AID PROJECT NO.	TYPE FUNDS
2	OHIO	UI 1057 (4)	

21
43


CUYAHOGA COUNTY
CITY OF CLEVELAND
INNER BELT FREEWAY
CENTRAL VIADUCT
CUY - 42 R - 17.50

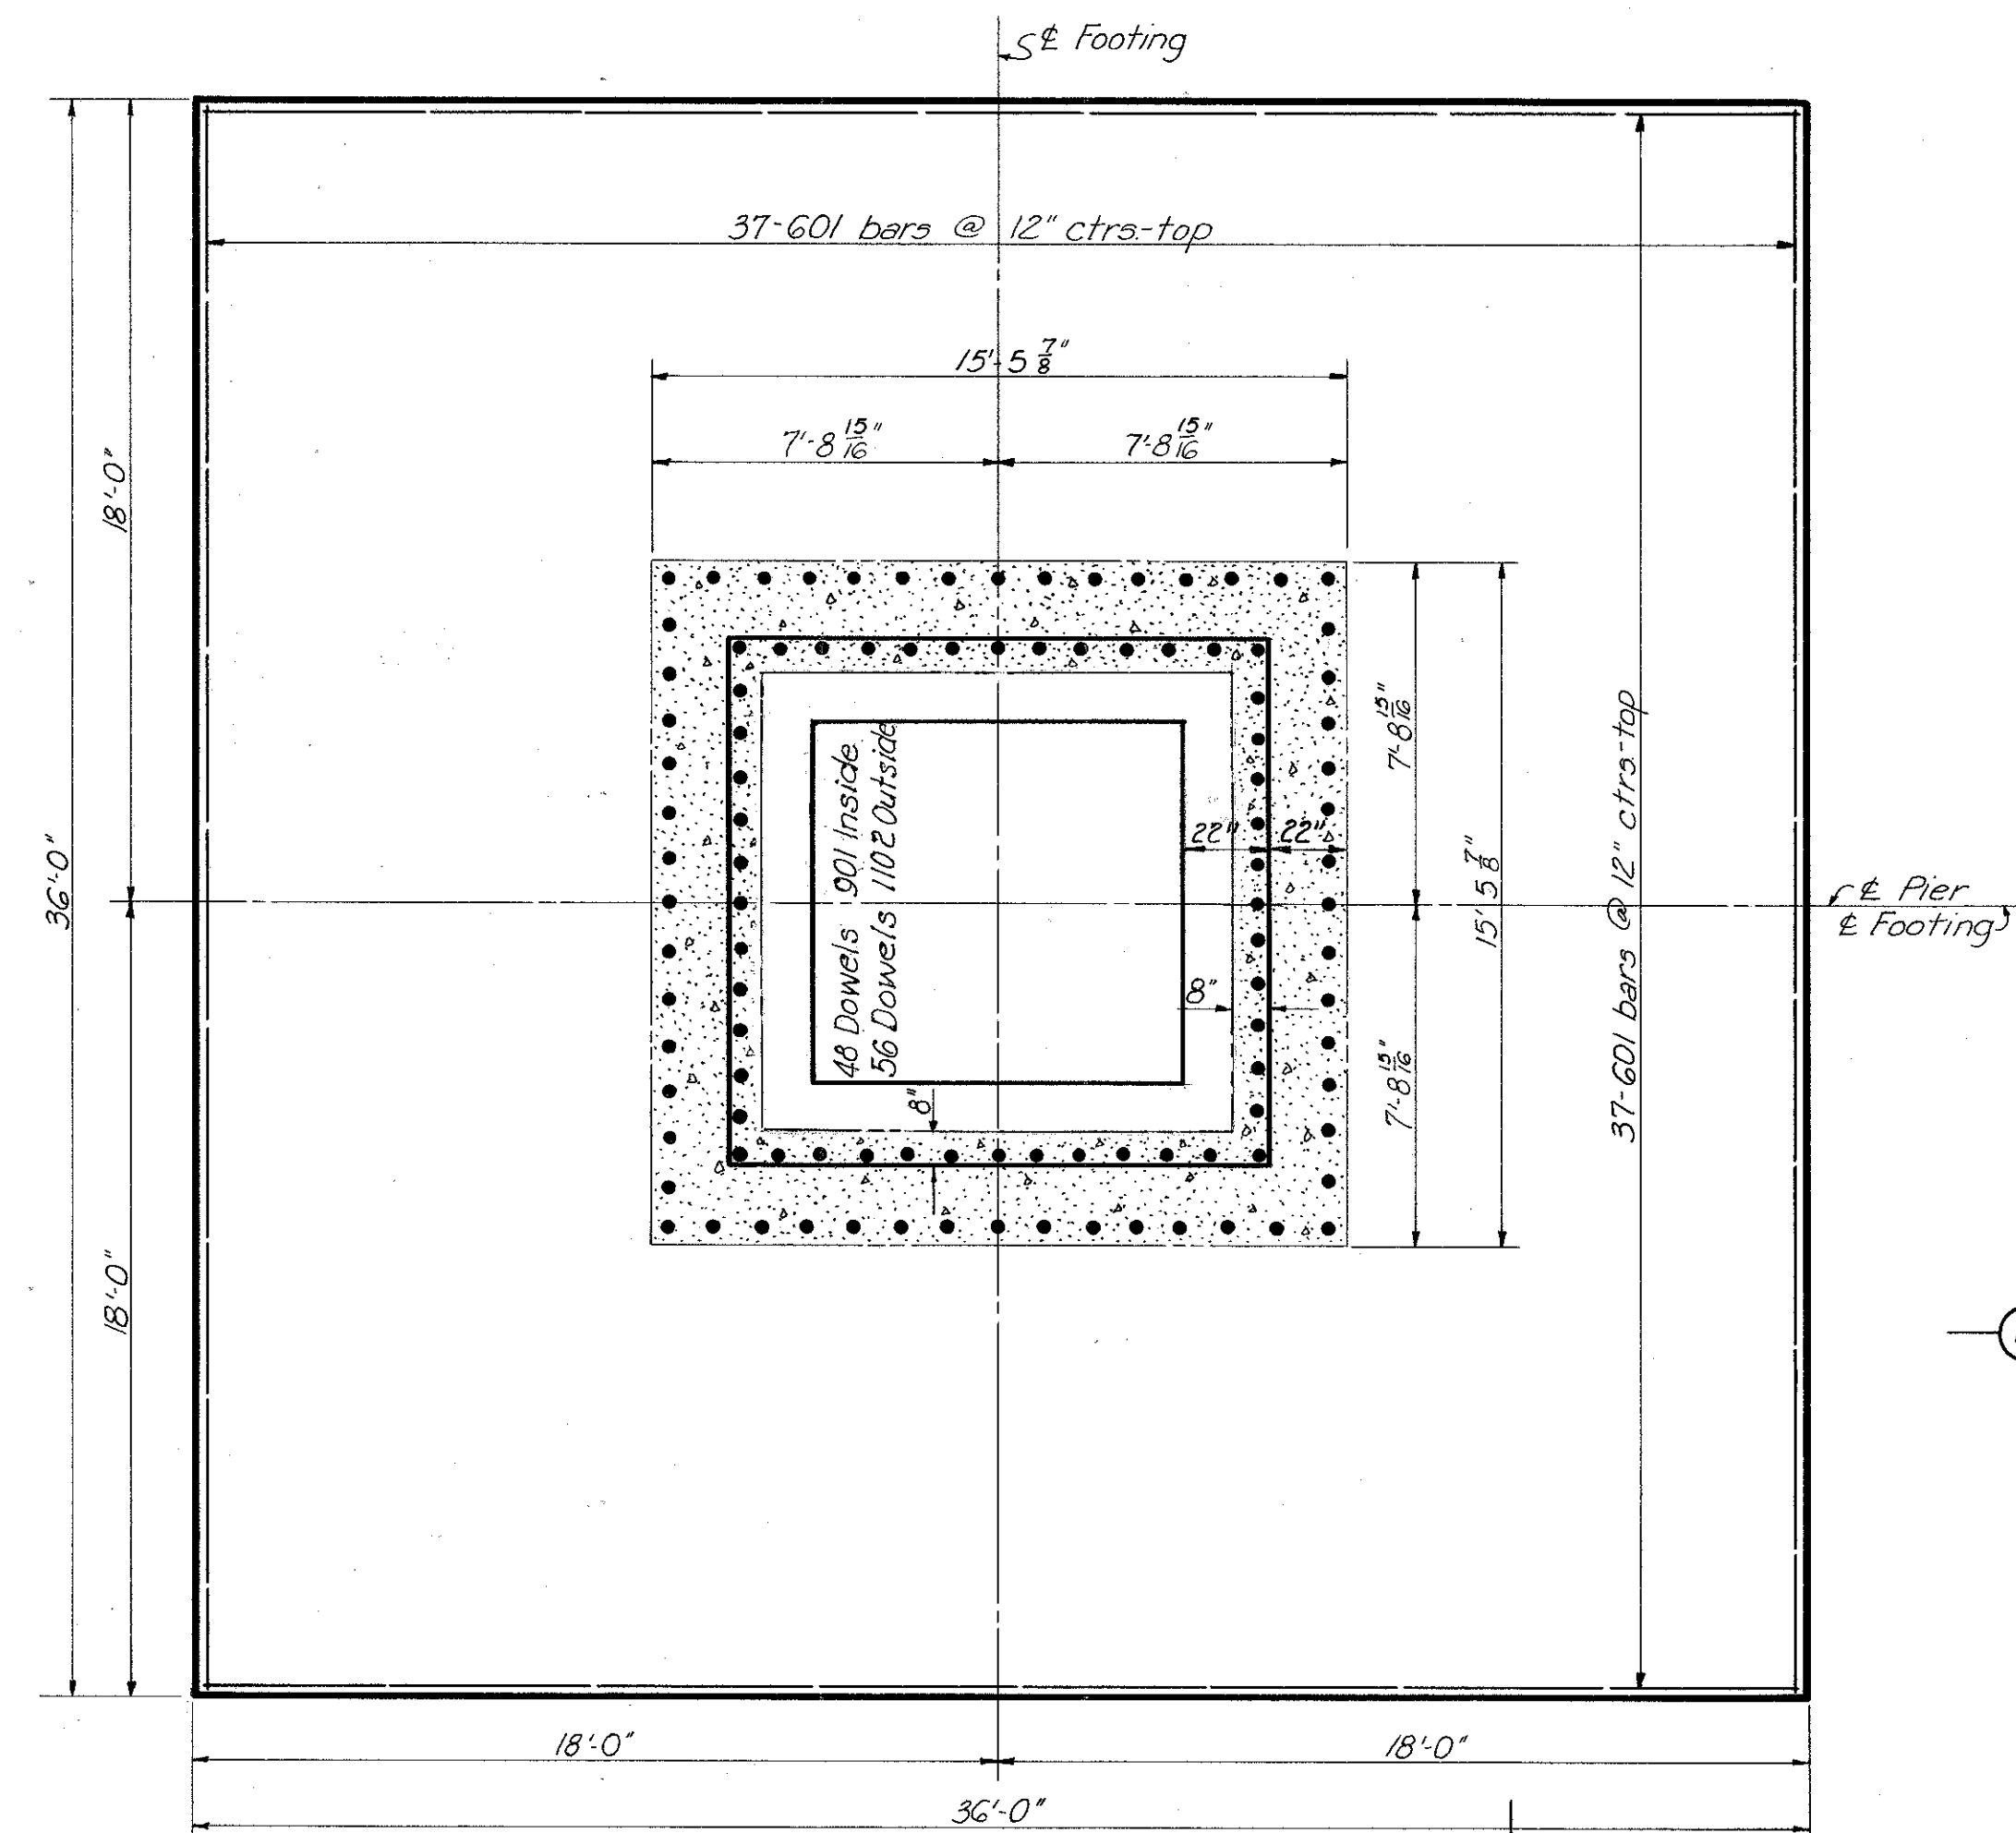


PLAN
Scale: 1/4" = 1'-0"

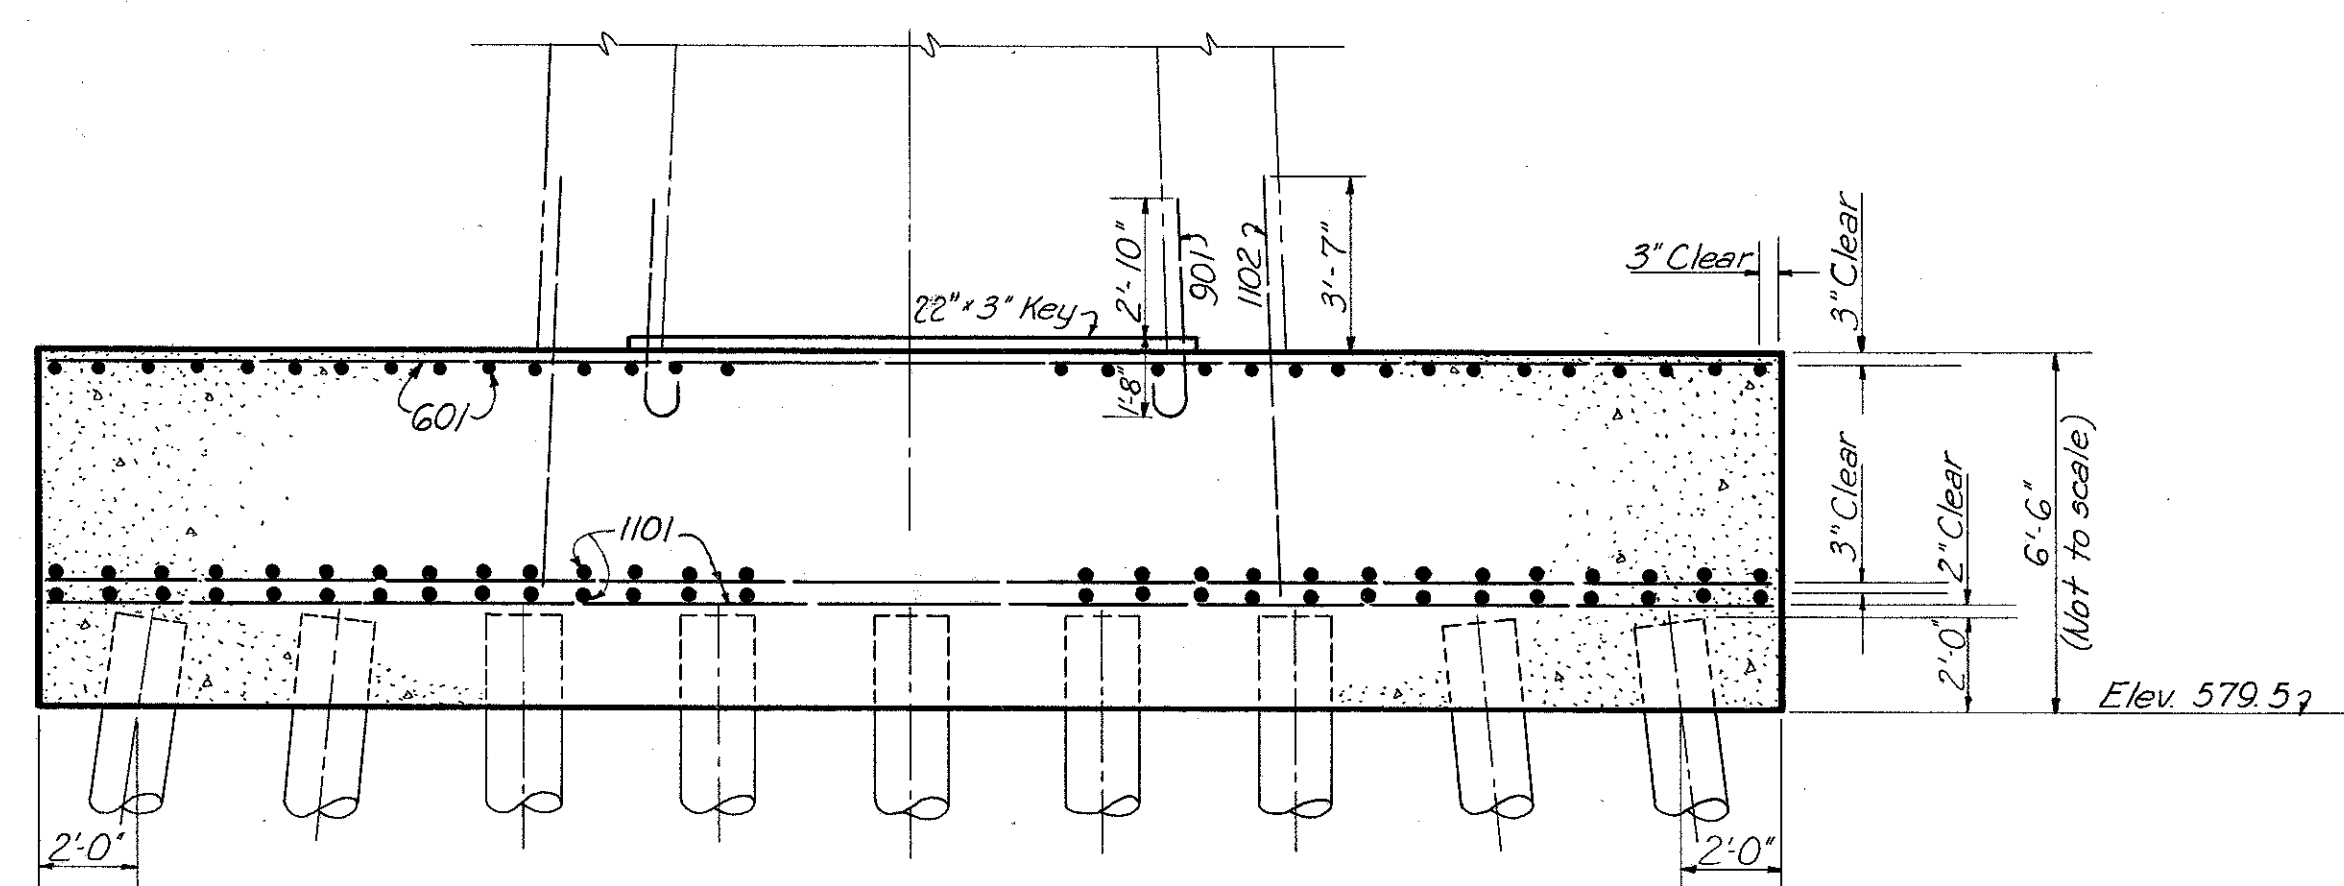

SECTION A-A
Scale: 1/4" = 1'-0"

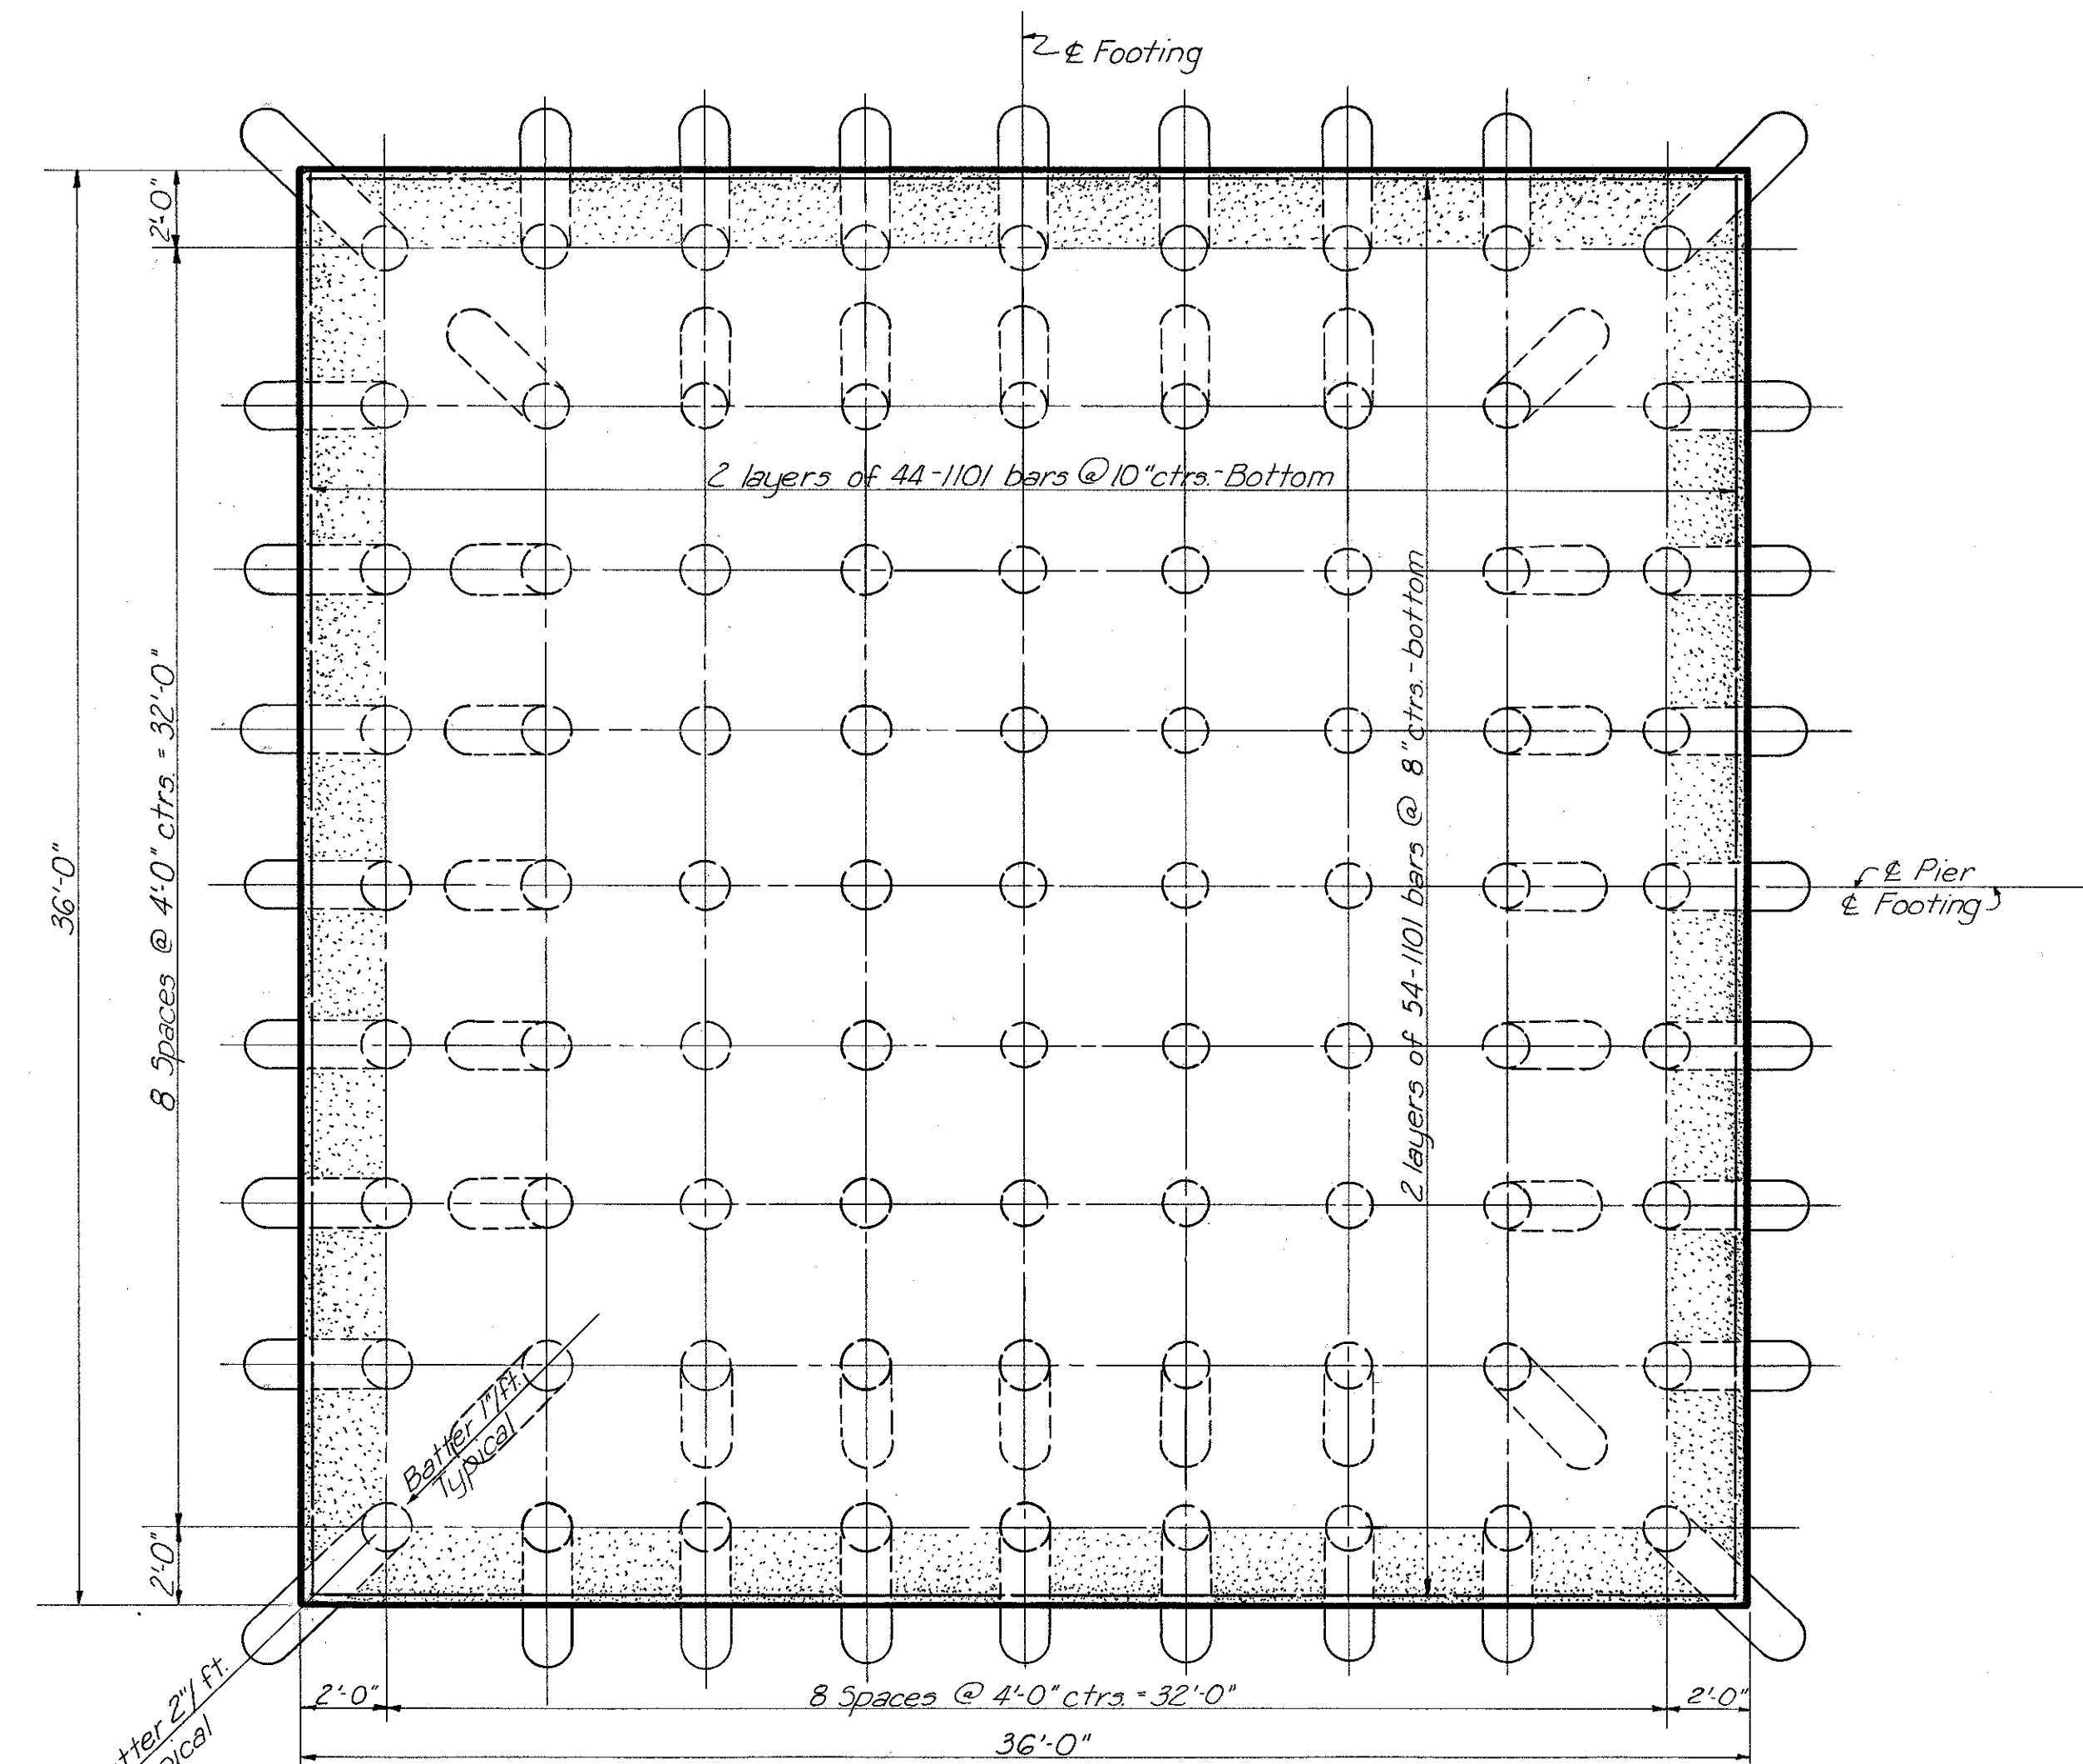

PILE PLAN
Scale: 1/4" = 1'-0"

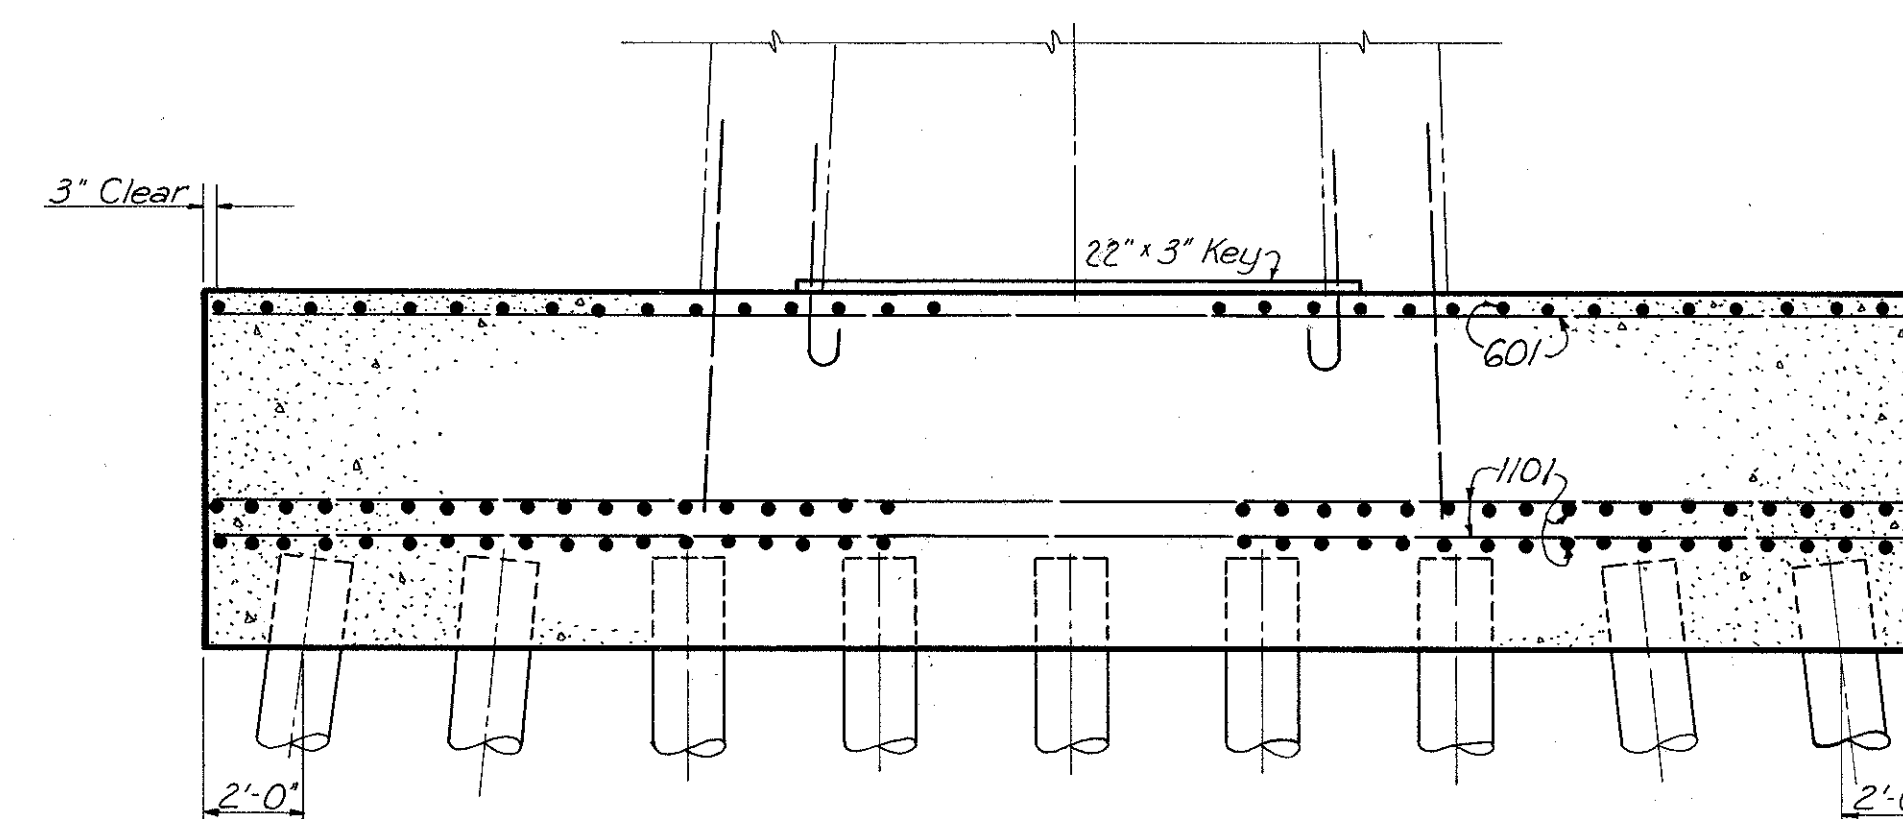

SECTION B-B
Scale: 1/4" = 1'-0"

Note:
8'-14" cast-in-place reinforced concrete
piles required per footing. Nominal design
capacity 65 tons per pile. Estimated length
60 feet each. Batter outside row 2" per
foot, and batter second row 1" per foot.
For Reinforcement Schedule, see 5hs.
30 and 31.

PART 2


U. S. ROUTE 42 RELOCATION
INNER BELT FREEWAY - CENTRAL VIADUCT

PIER FOOTINGS 8N AND 8S


CLEVELAND CUYAHOGA COUNTY OHIO

SCALE: 1/4" = 1'-0"
MADE: N.E.G. DATE: 2-10-54
TRCD: N.A.M. DATE: 6-7-54
CKD: C.J.G. DATE: 2-25-54
HOWARD, NEEDLES, TAMMEN & BERGENDOFF
CONSULTING ENGINEERS
KANSAS CITY CLEVELAND NEW YORK
914-1A SHEET: 121


CUYAHOGA COUNTY
CITY OF CLEVELAND
INNER BELT FREEWAY
CENTRAL VIADUCT
CUY - 42 R - 17.50

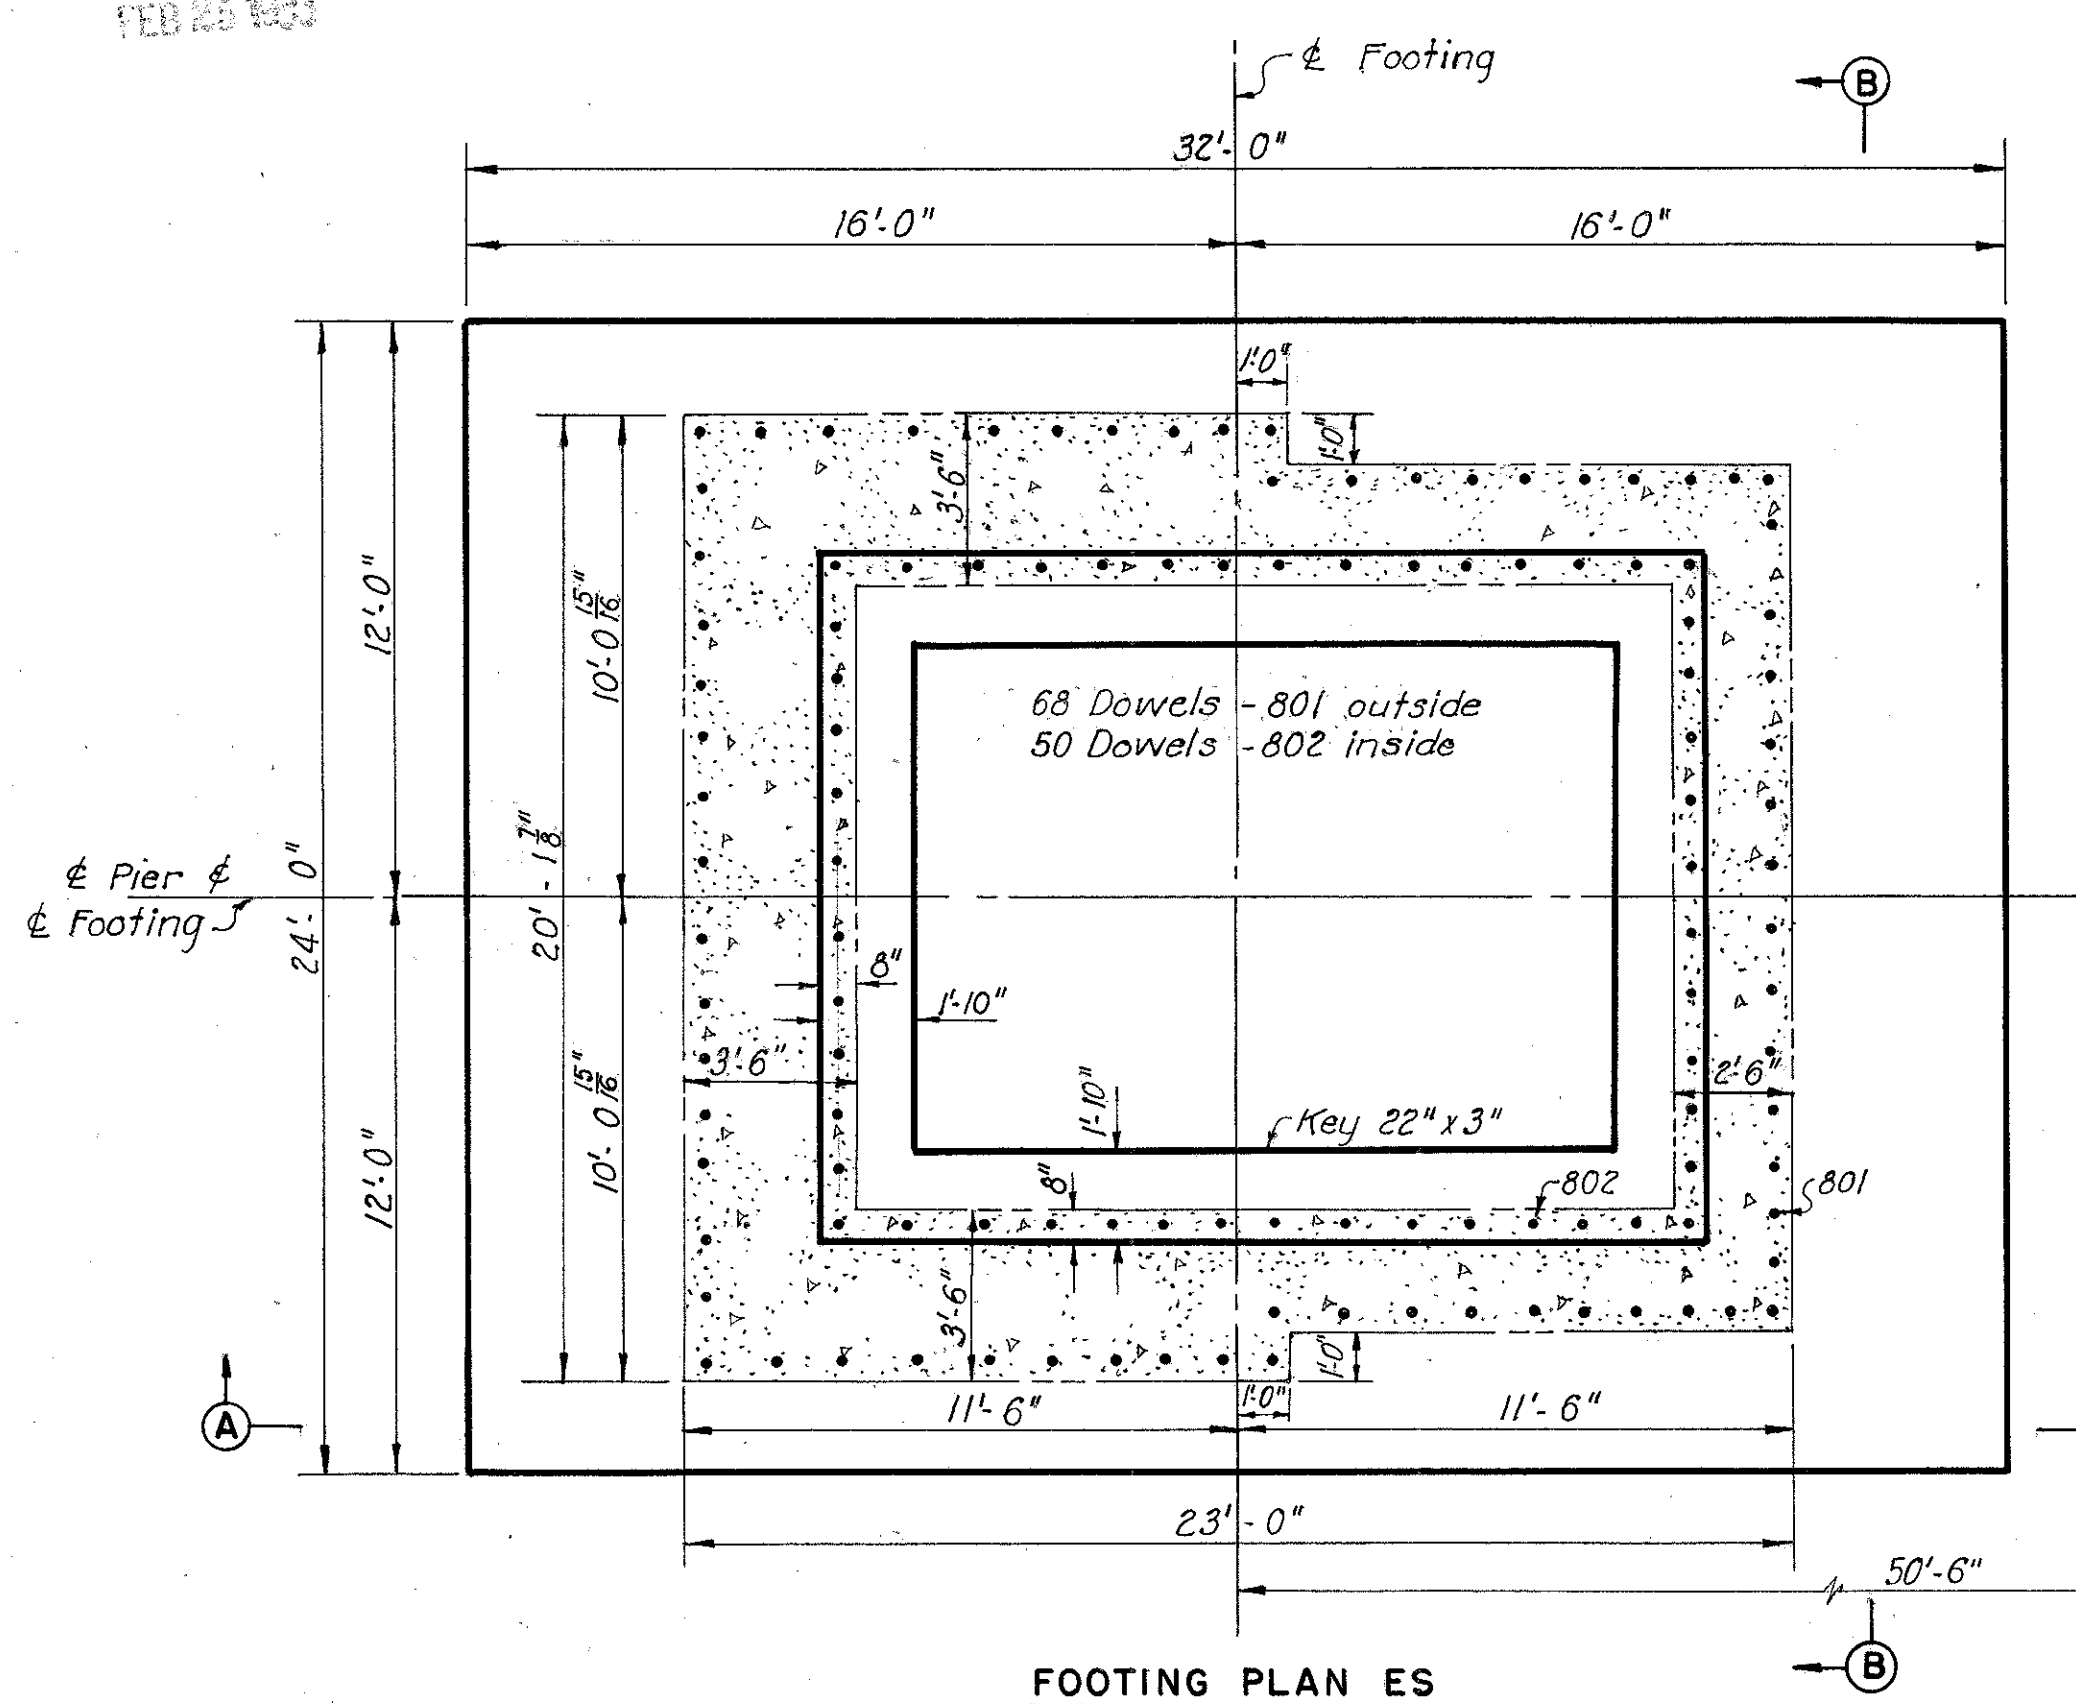


FOOTING PLAN ES

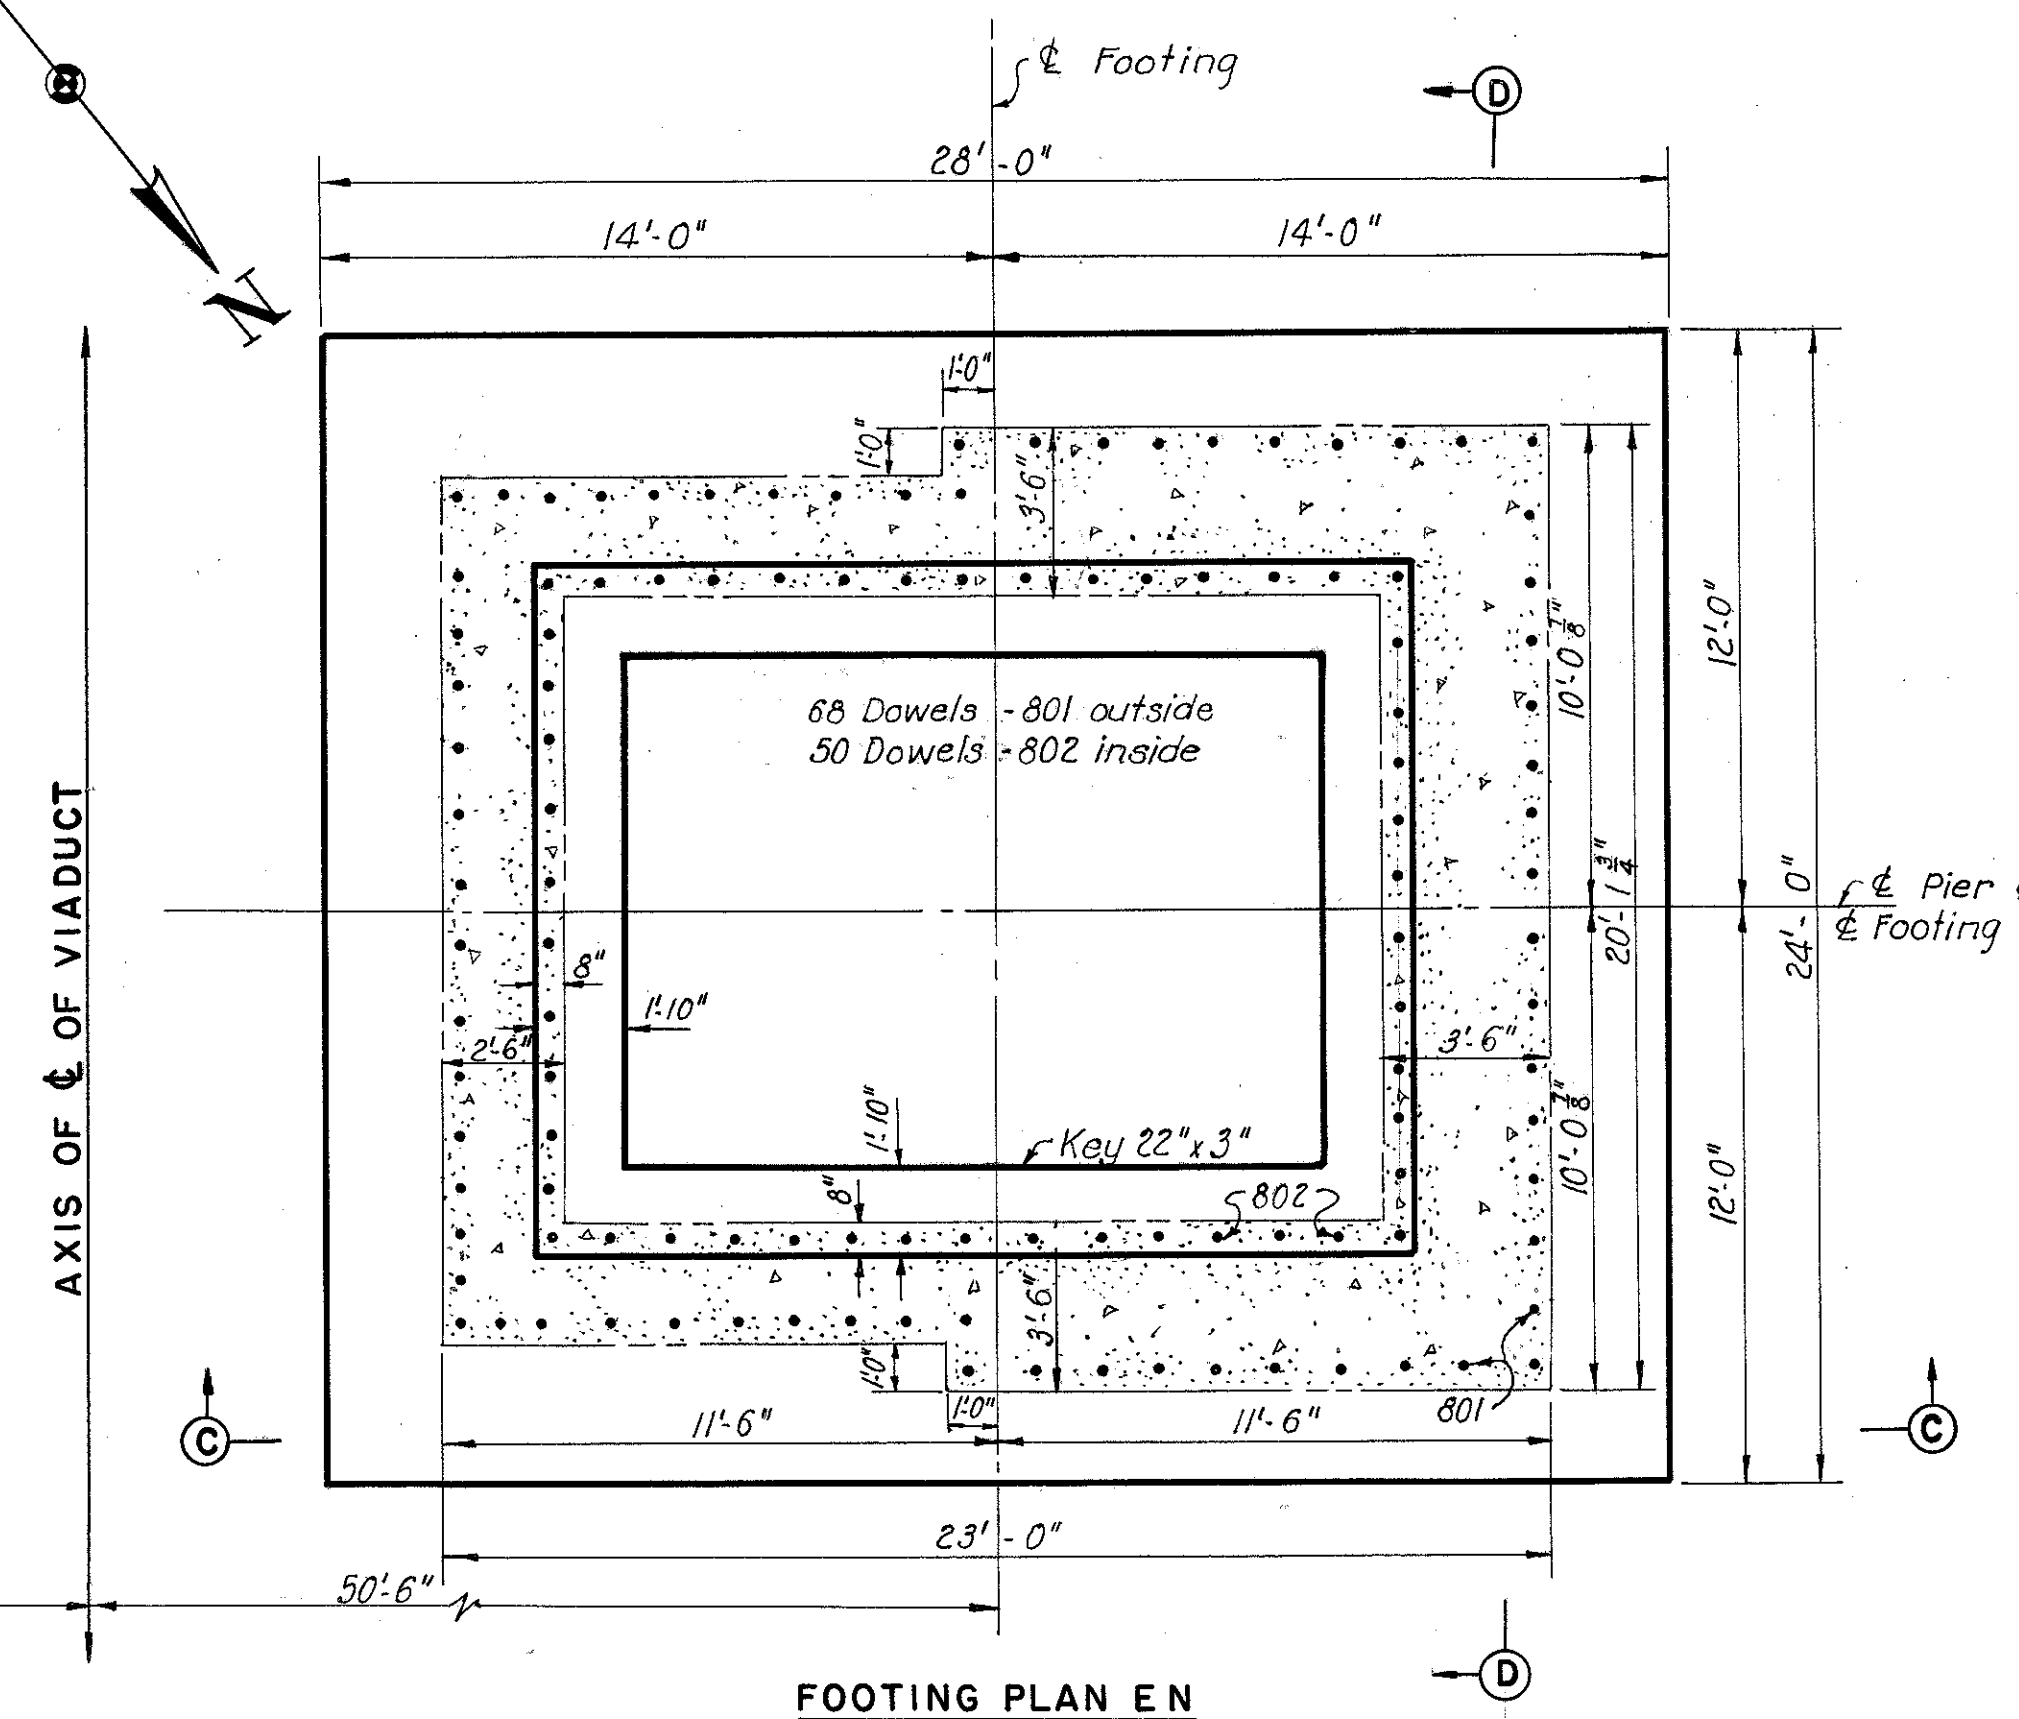


FOOTING PLAN EN

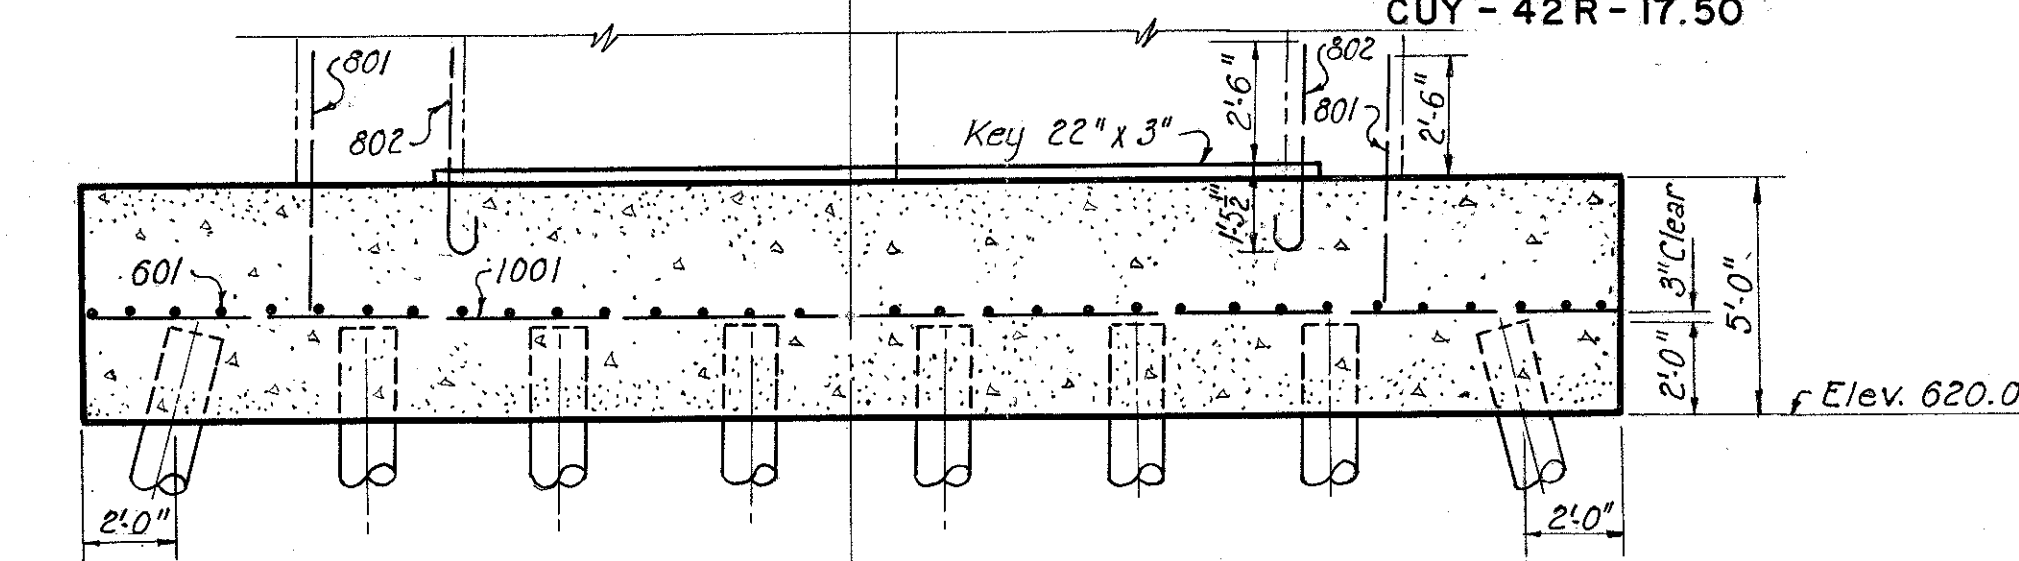


SECTION A - A

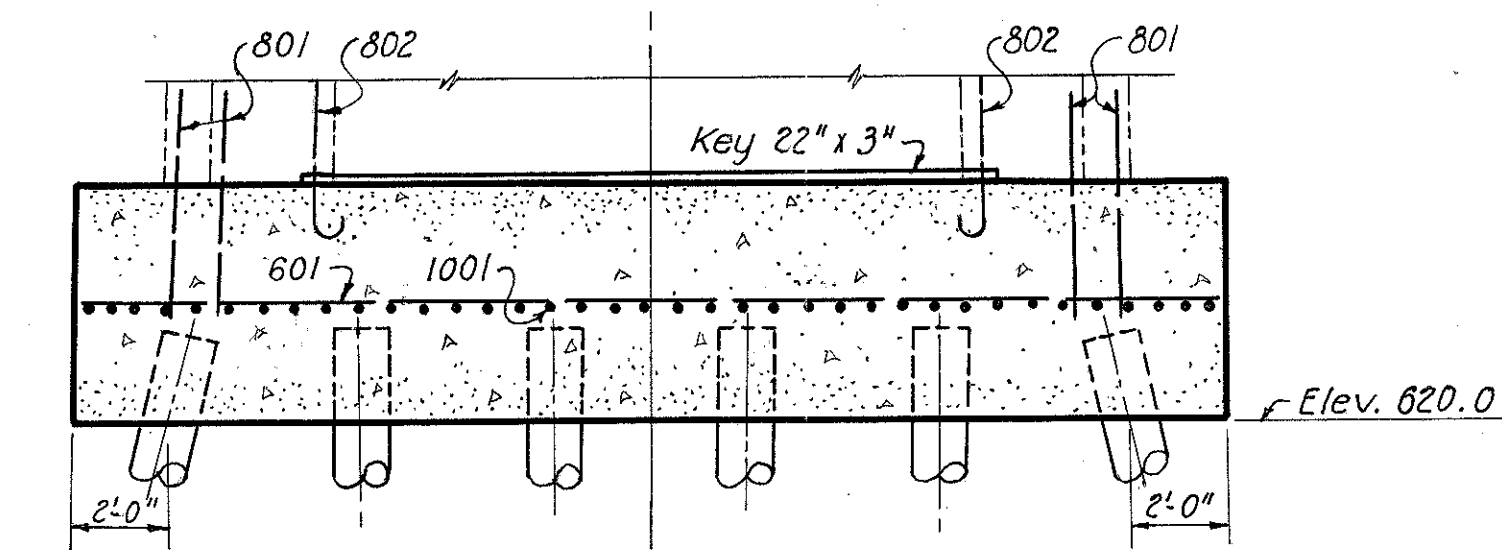


SECTION B-B

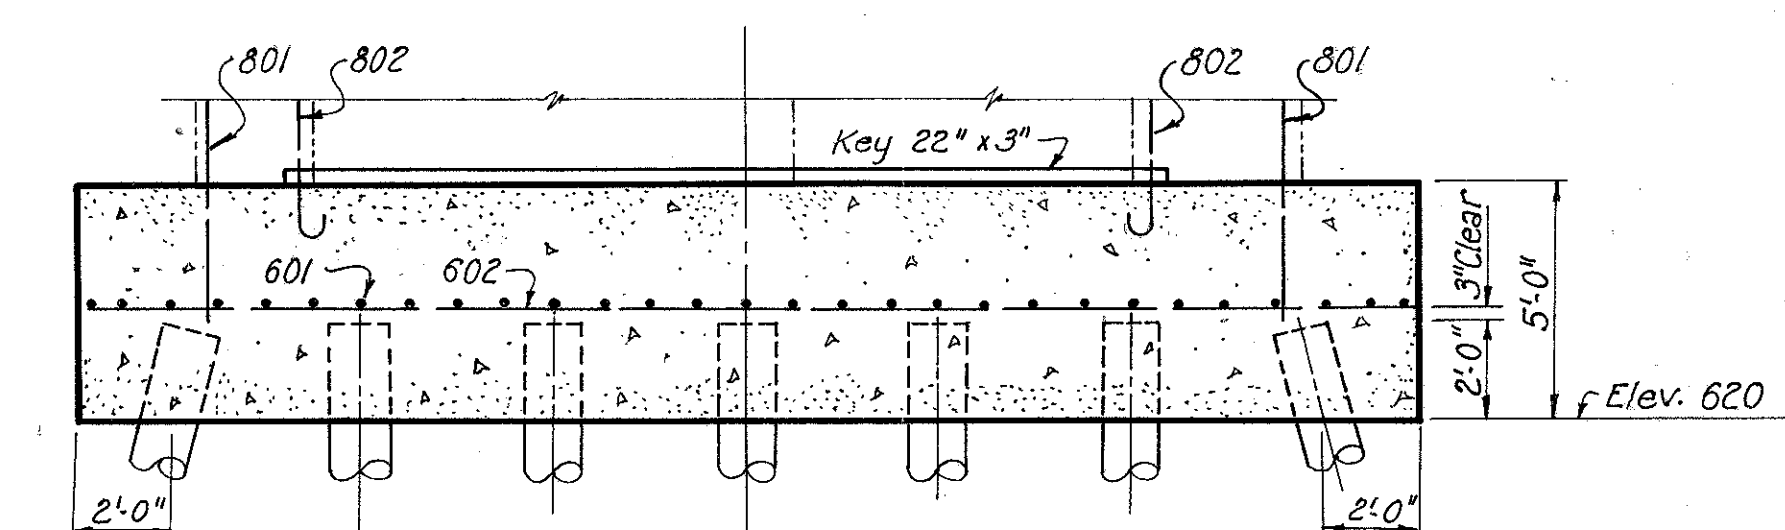


SECTION C-C

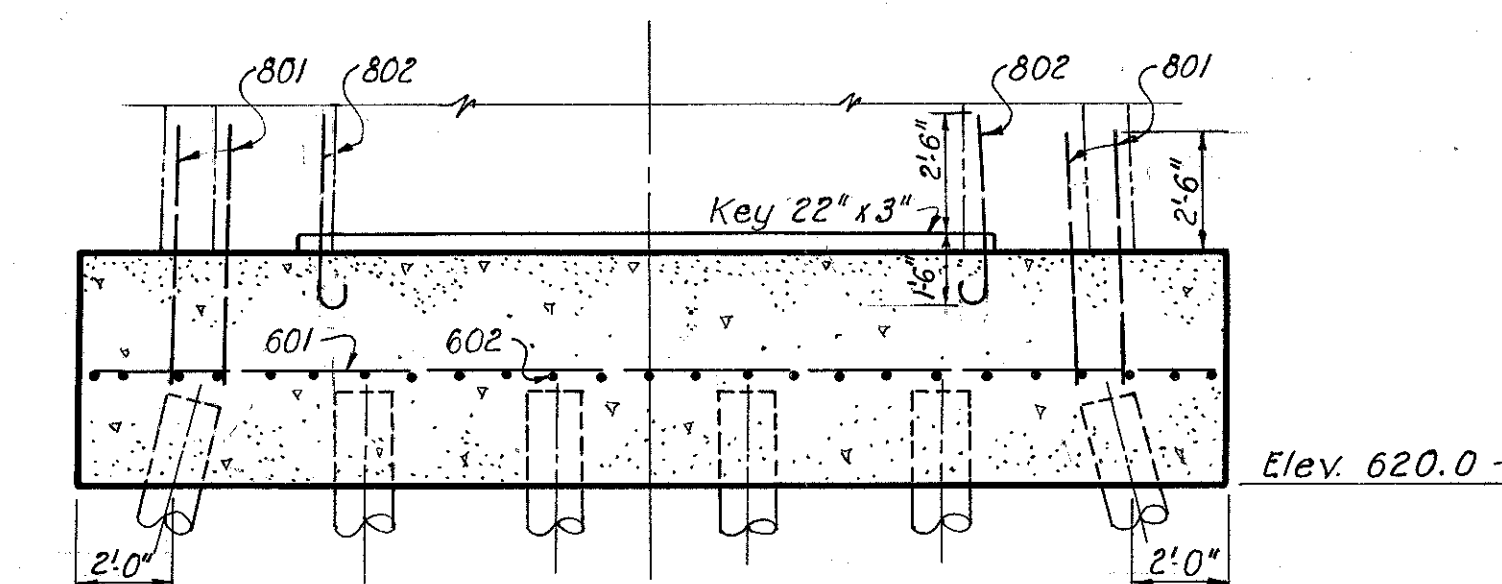

SECTION D-D

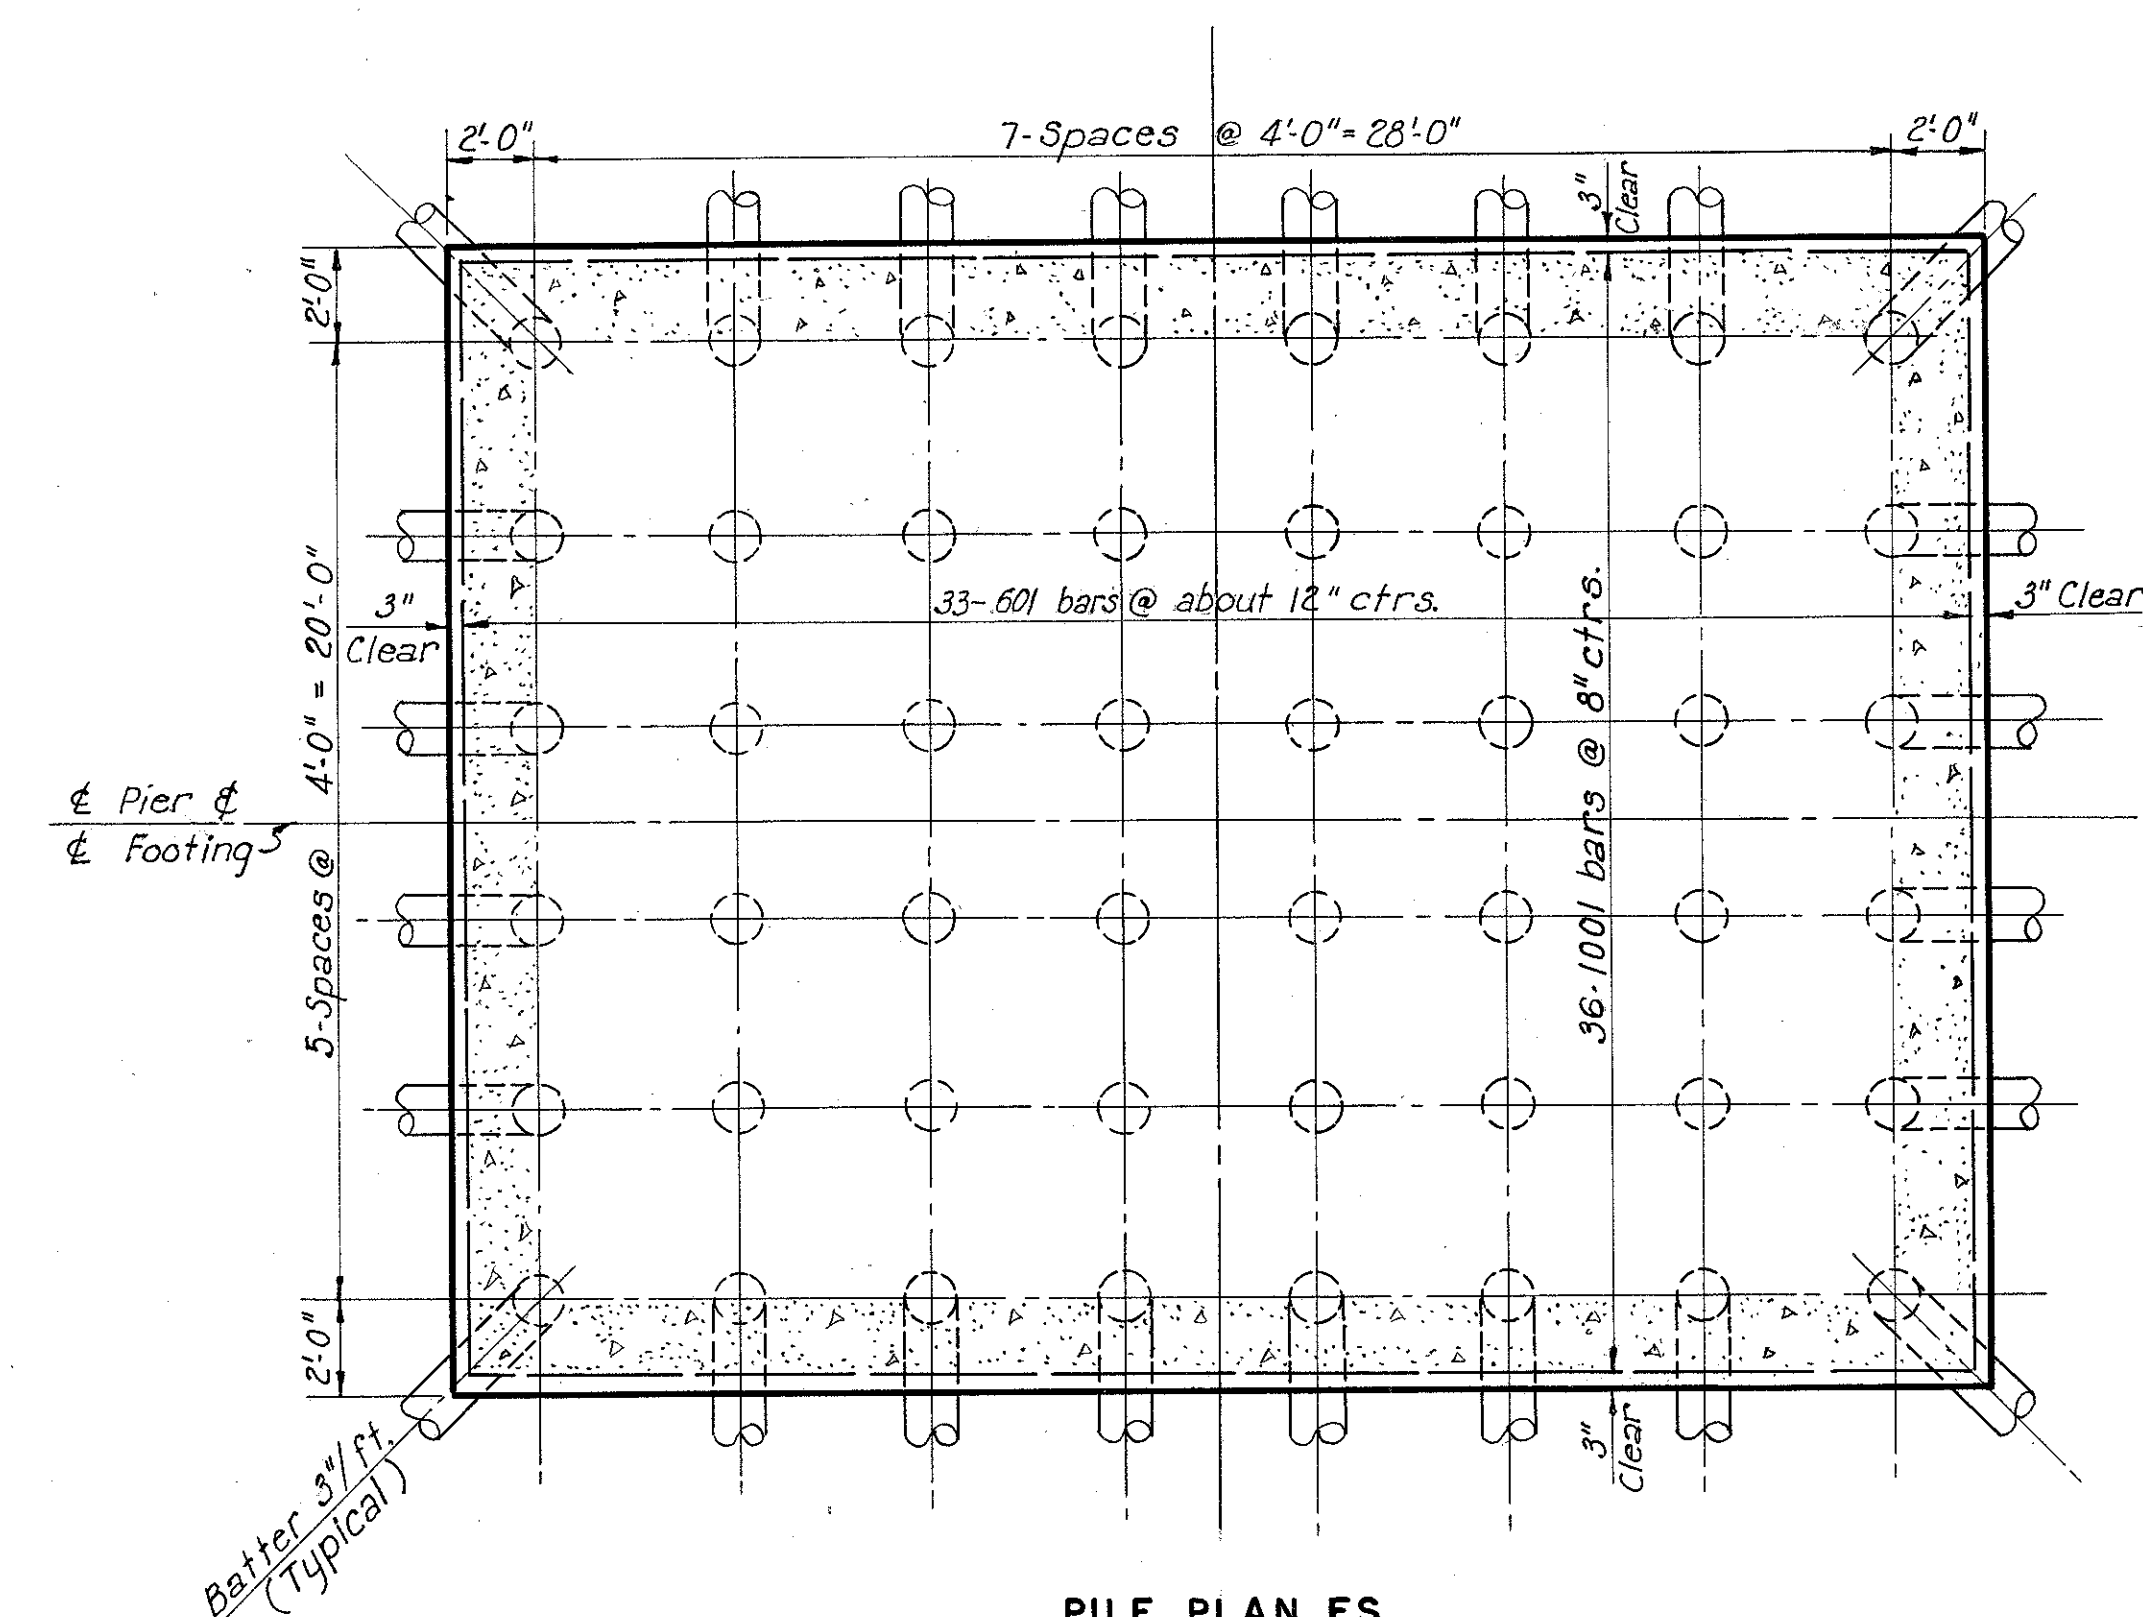

PILE PLAN ES

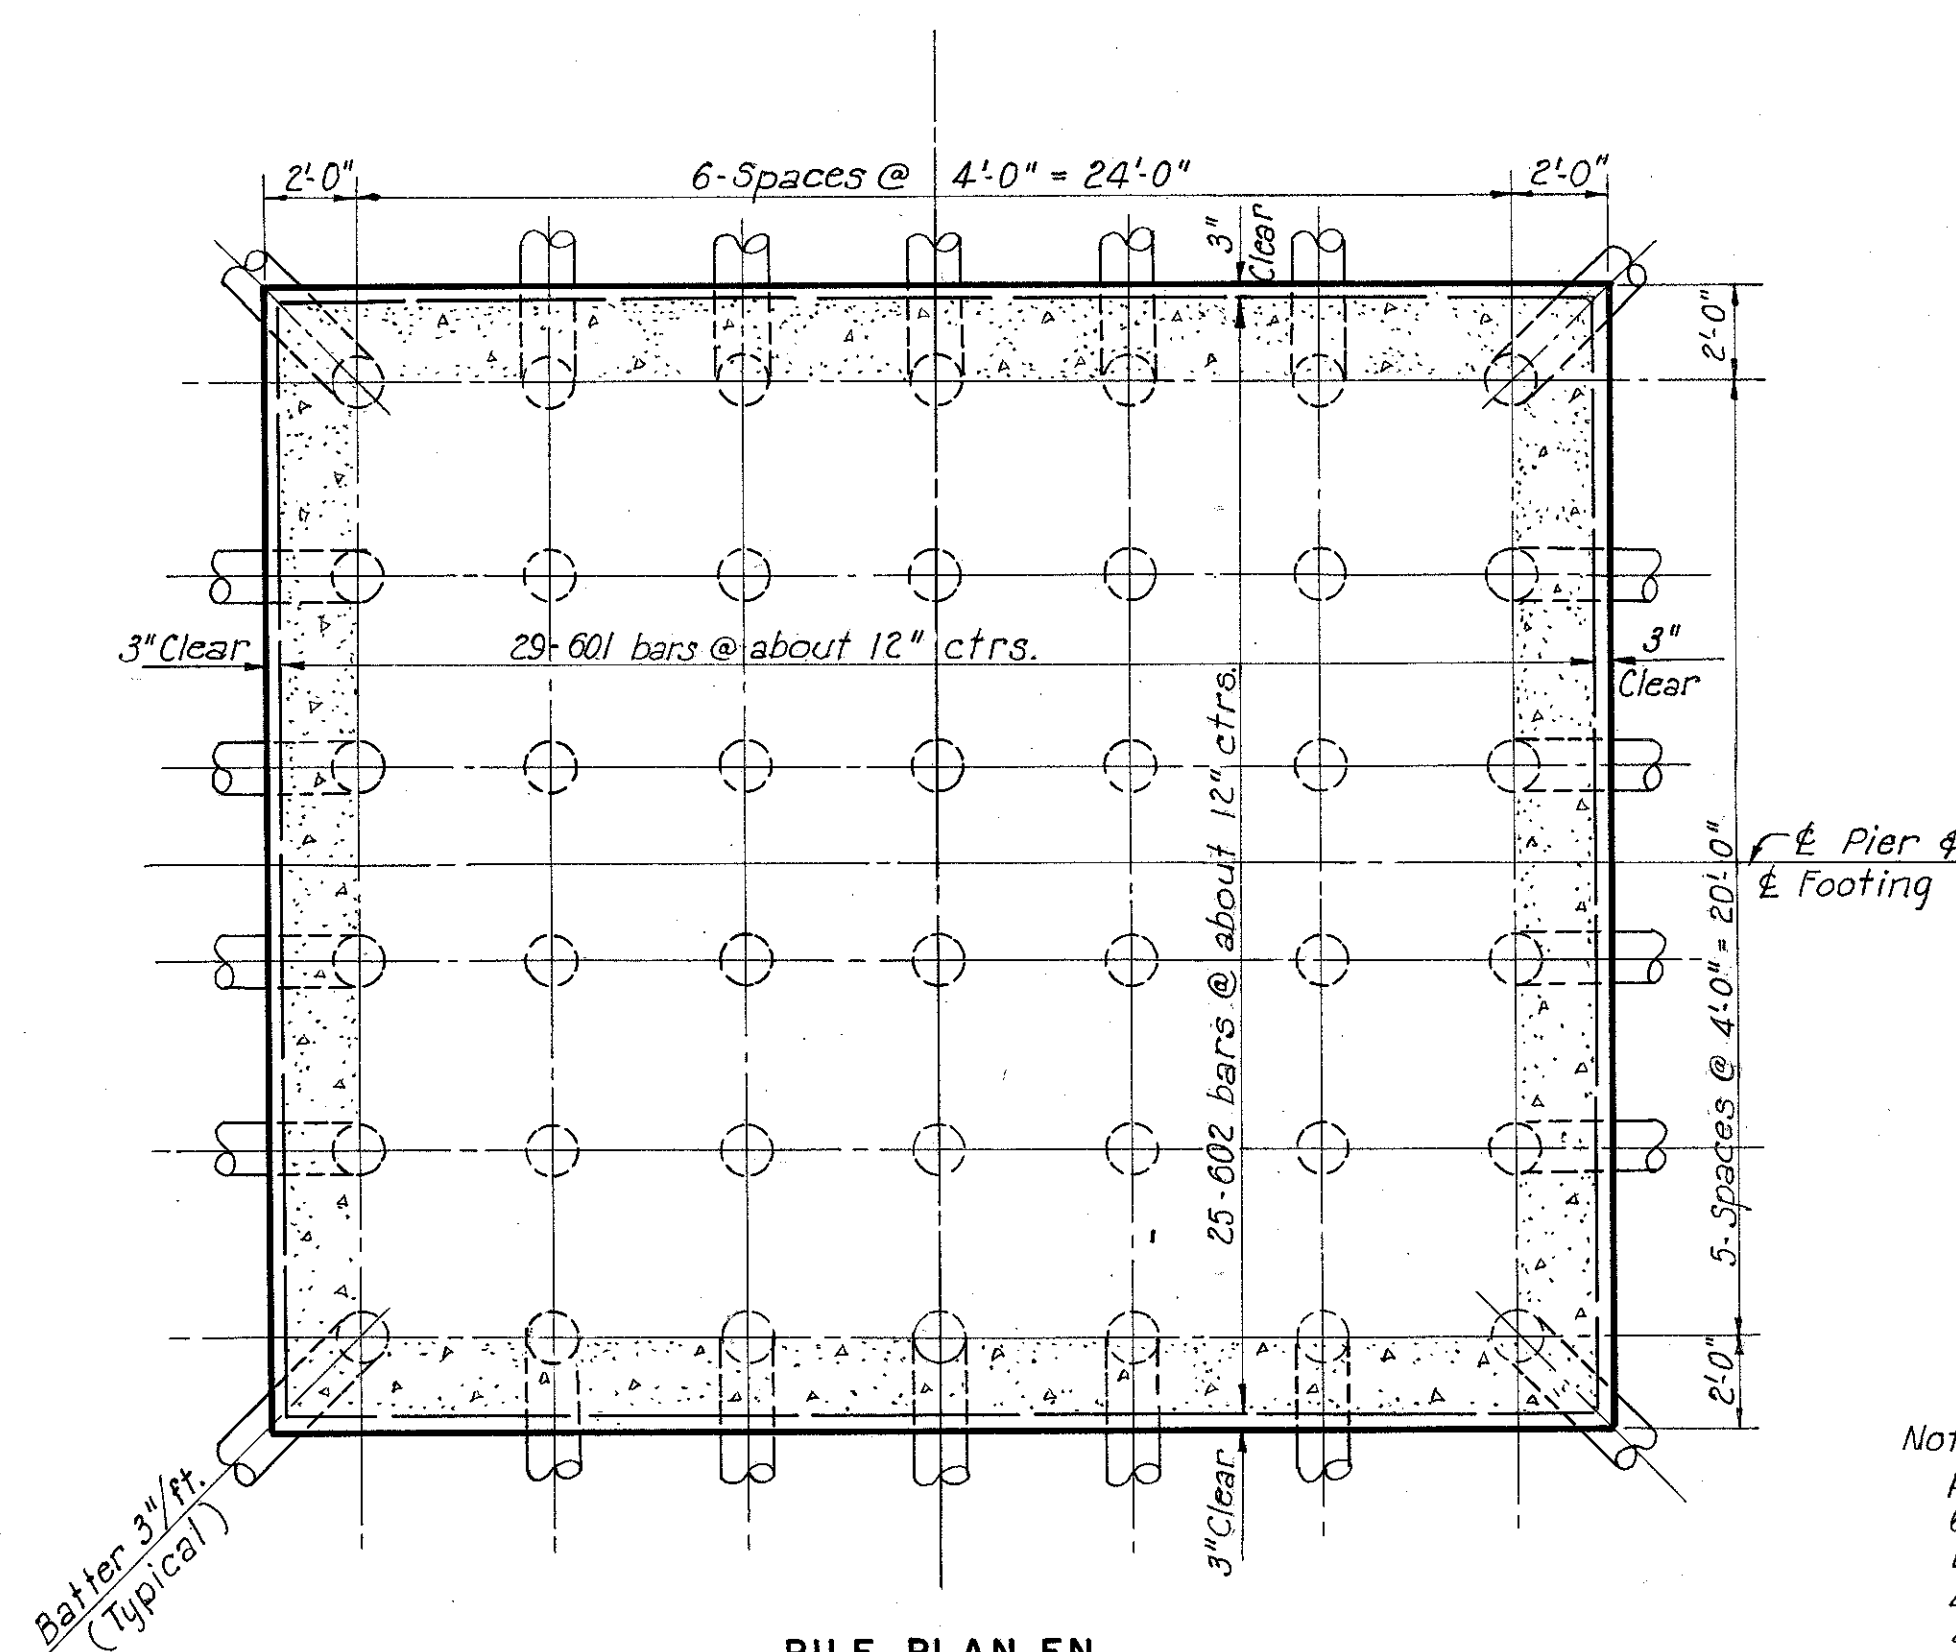

PILE PLAN EN

Note: 14" cast-in-place reinforced concrete
piles with a nominal design capacity of
65 tons each.
Estimated length 40 feet each.
42 piles for footing EN.
48 piles for footing E3.
Batter outside row of piles 3" per foot.
For reinforcing schedule, see sheet 32.

PART 2

U. S. ROUTE 42 RELOCATION
INNER BELT FREEWAY - CENTRAL VIADUCT


EAST END PIER FOOTINGS, EN AND ES

CLEVELAND CUYAHOGA COUNTY OHIO


SCALE $\frac{1}{4}'' = 1'-0''$
MADE DER DATE 6-25-54
TRCD AH DATE 6-28-54
CKD DER DATE 7-6-54

HOWARD, NEEDLES, TAMMEN & BERGENDOFF
CONSULTING ENGINEERS
KANSAS CITY CLEVELAND NEW YORK
914-1A SHEET- 1.22


CUYAHOGA COUNTY
CITY OF CLEVELAND
INNER BELT FREEWAY
CENTRAL VIADUCT
CUY-42R-17.50

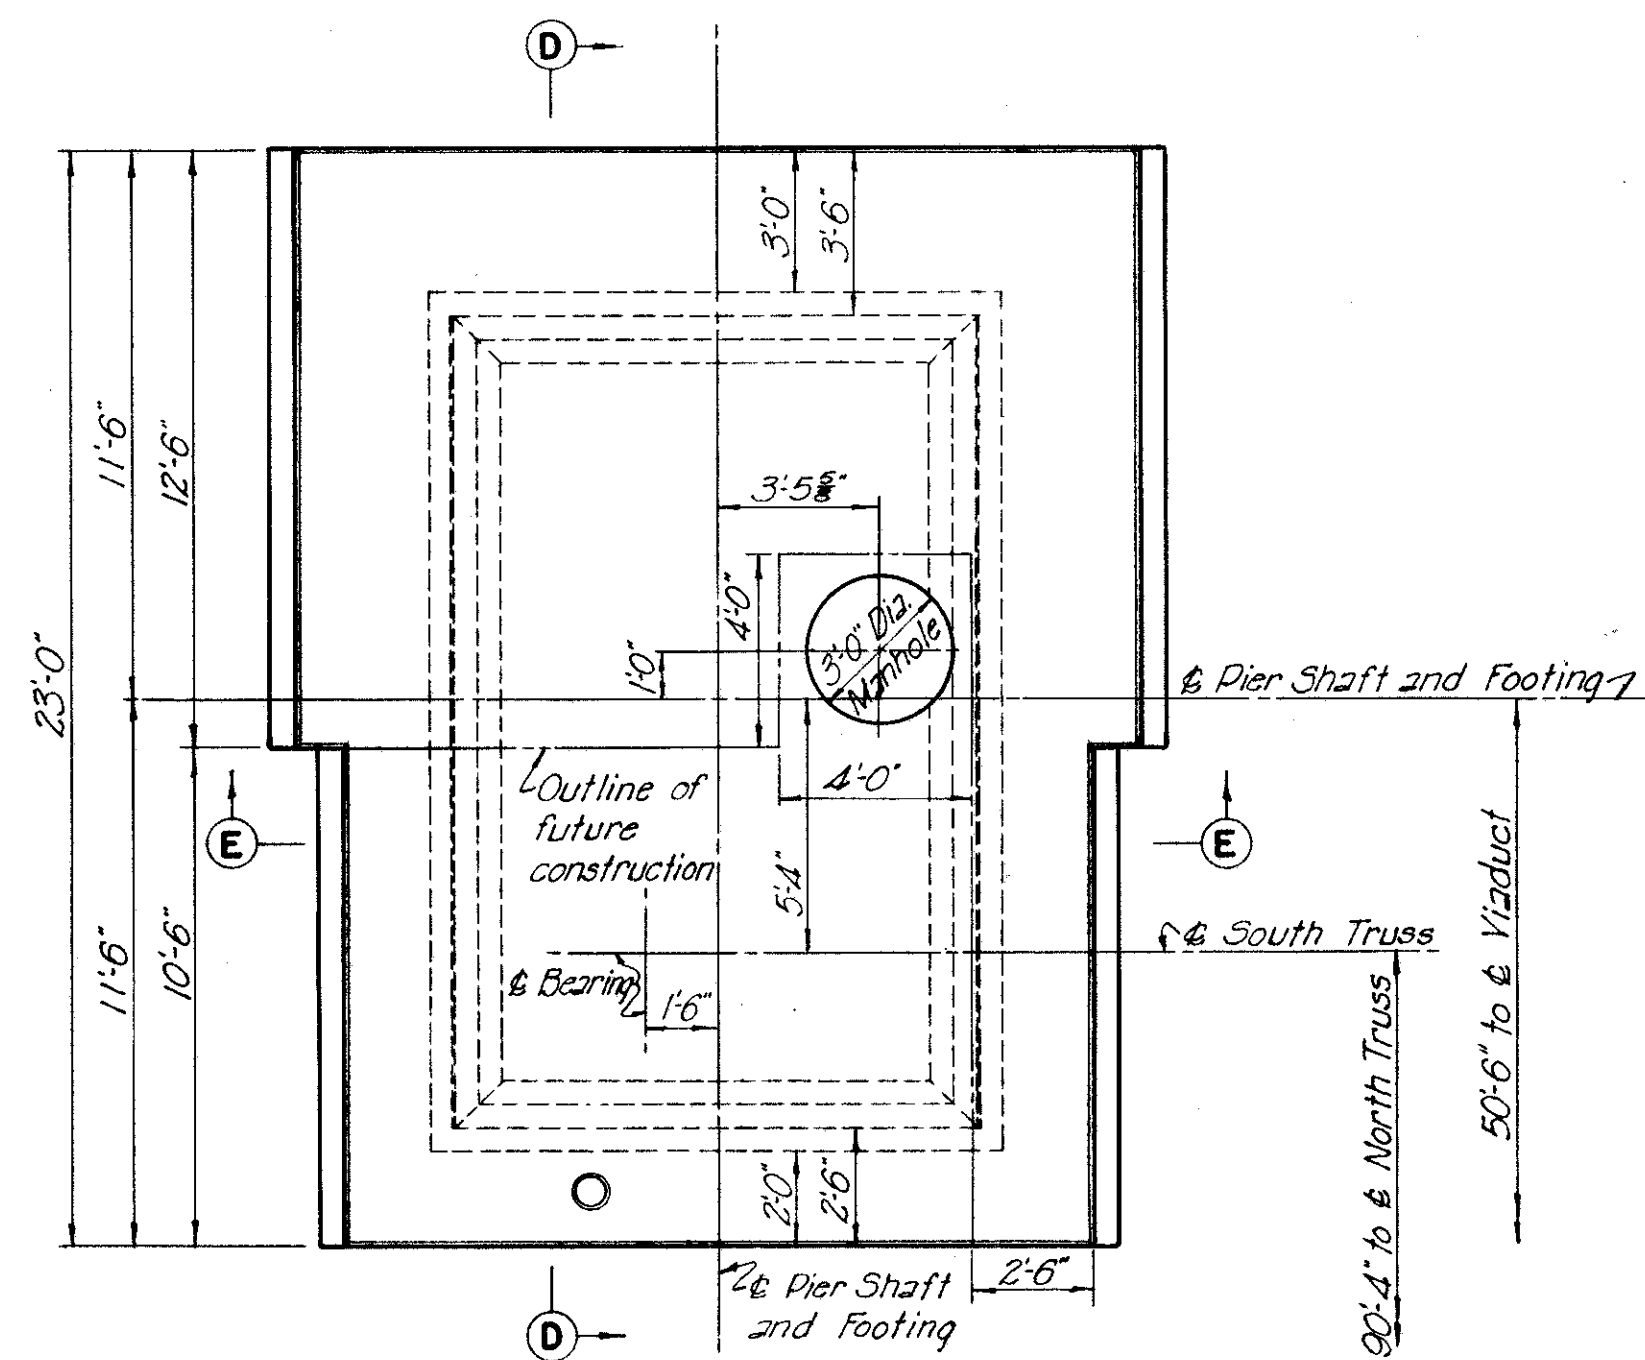


PLAN

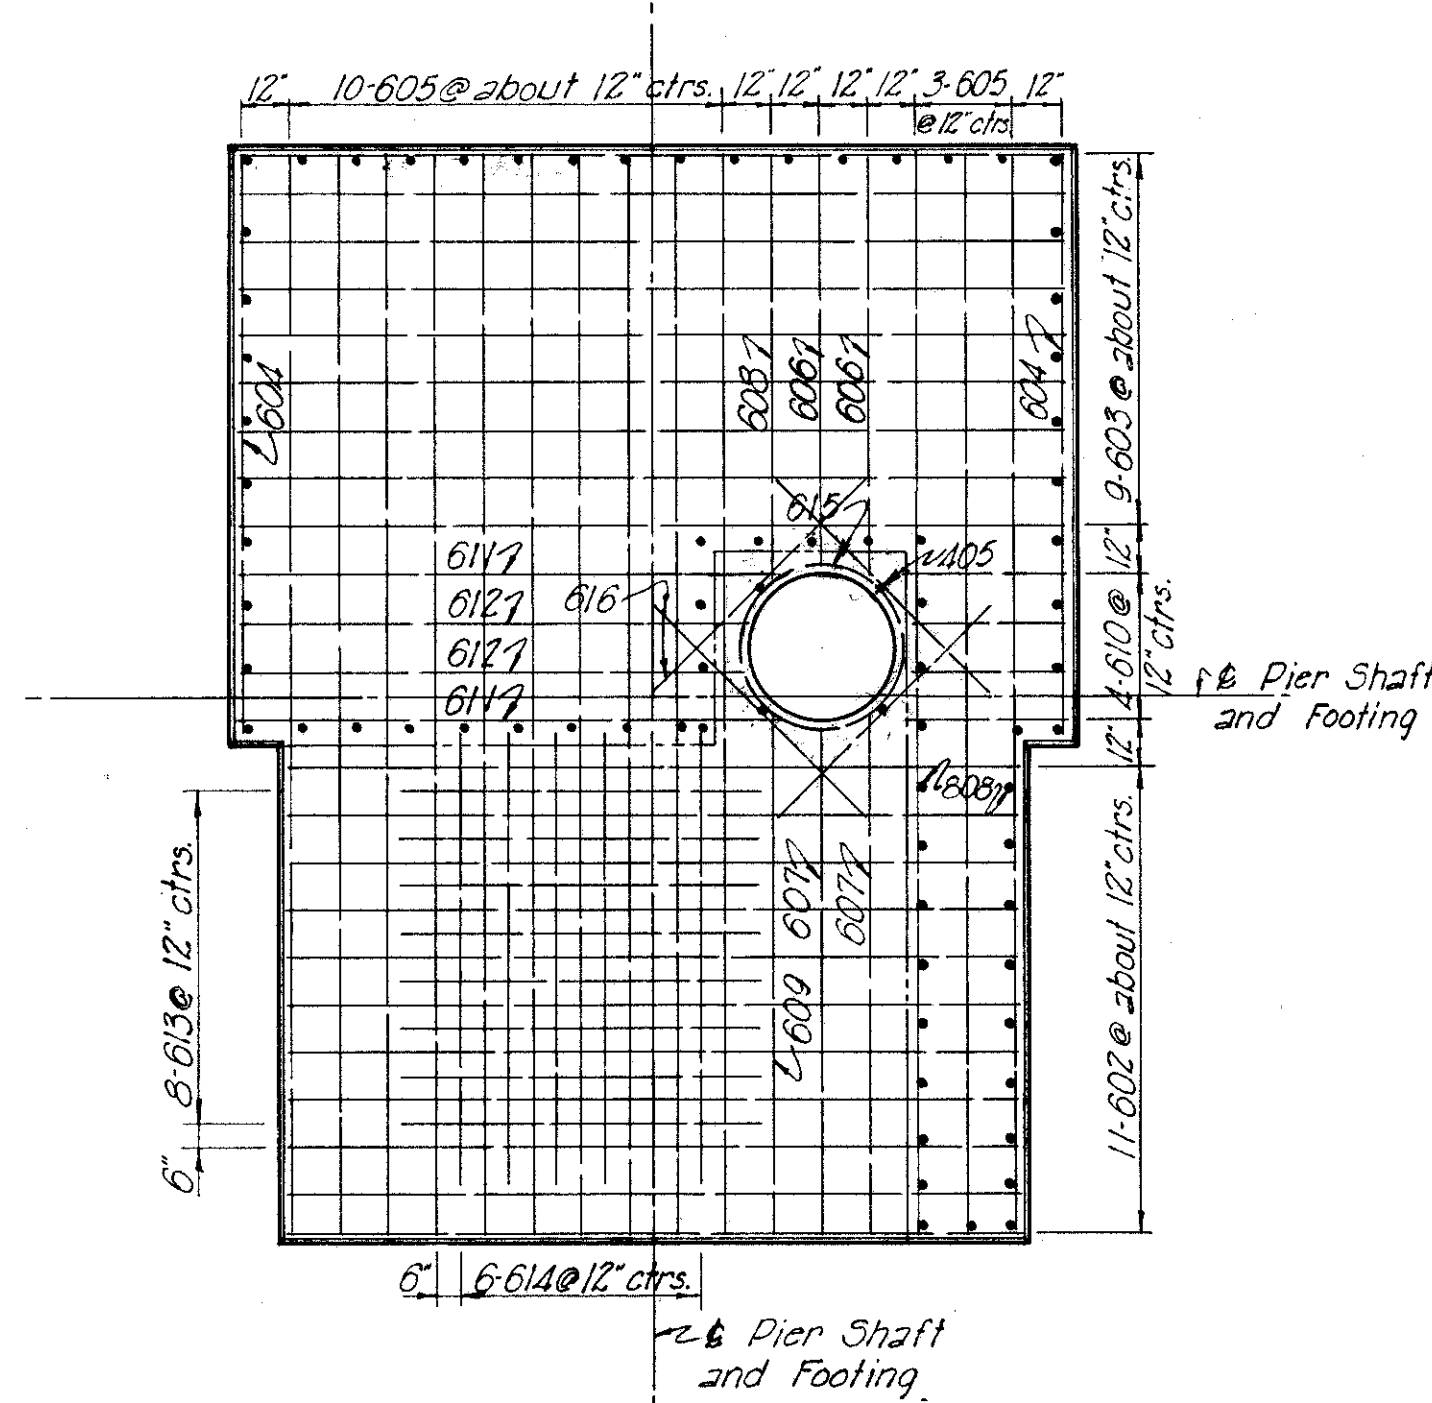

SECTION A-A

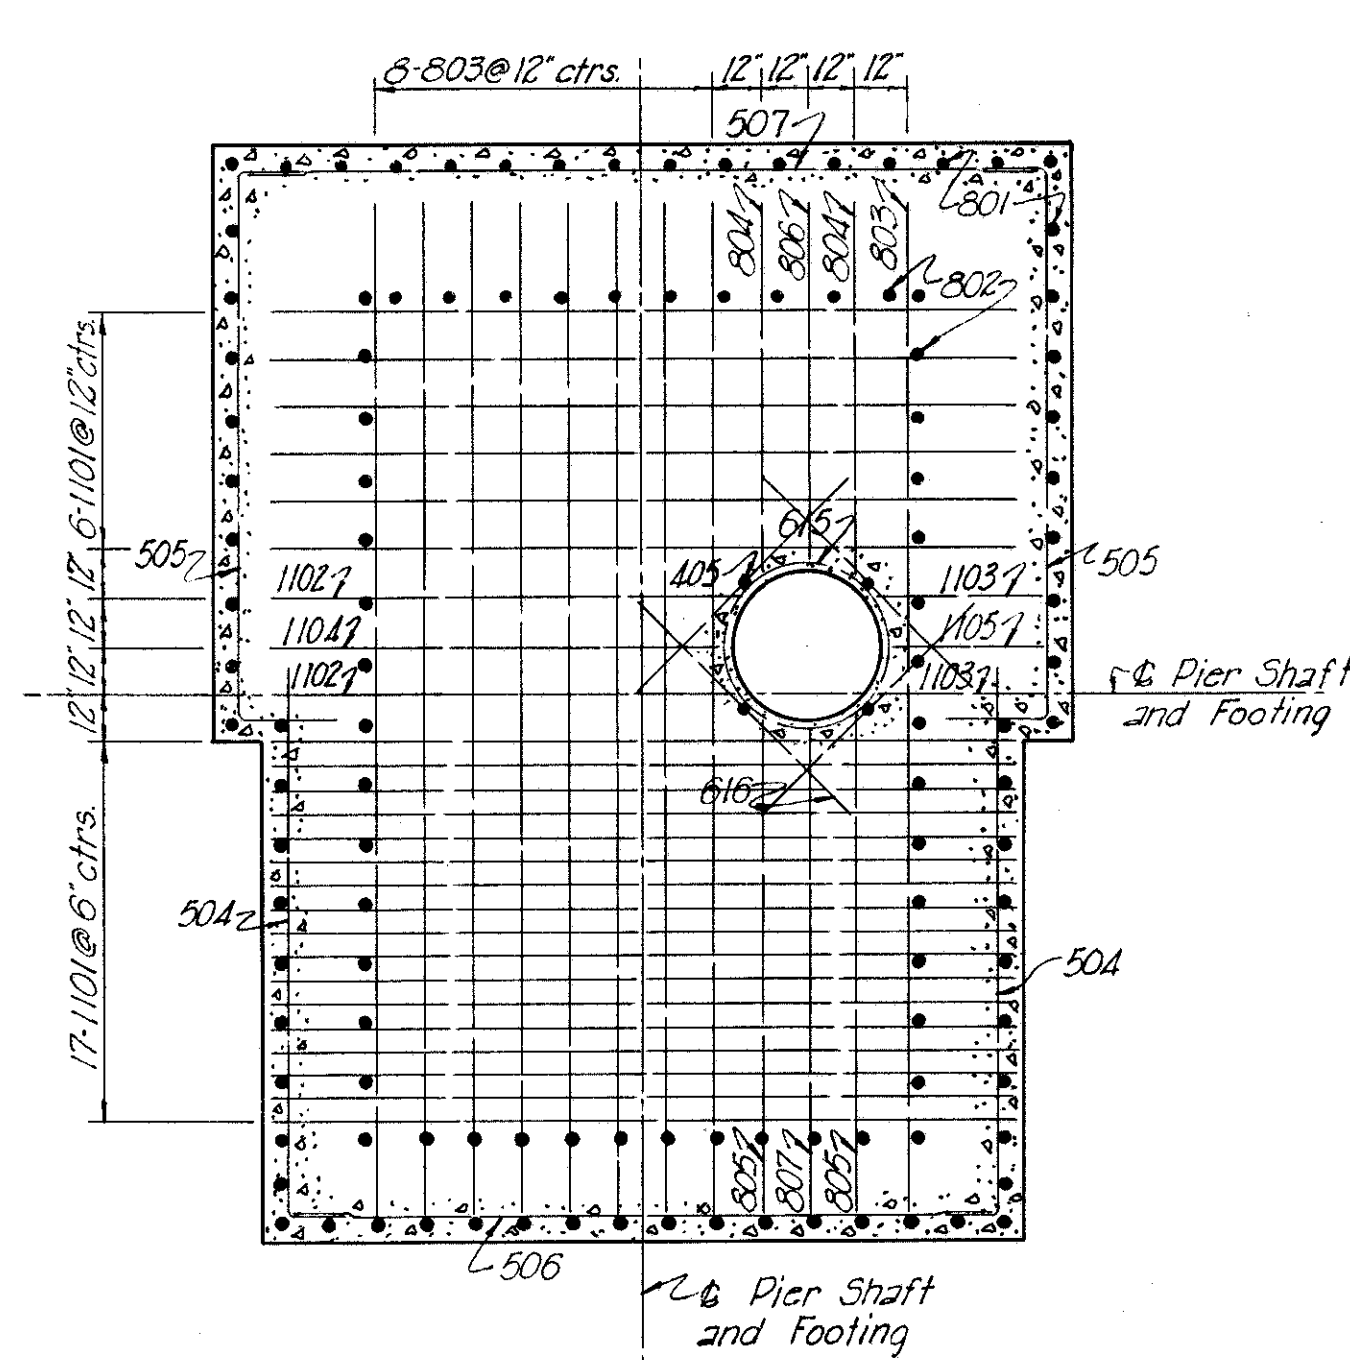


SECTION B-B

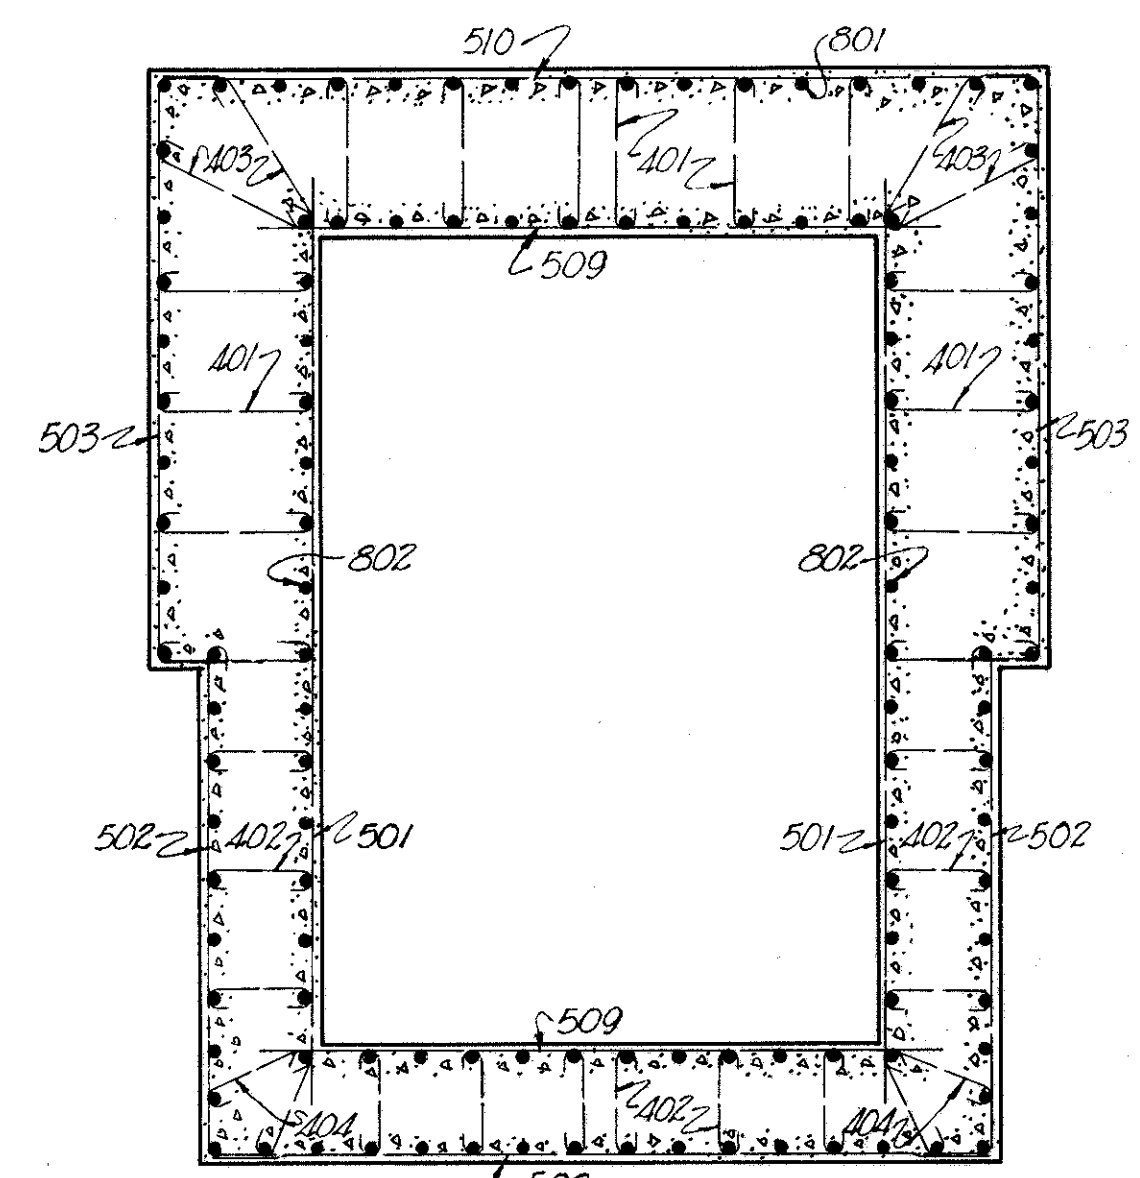


SECTION C-C


Note:
All bars shall have a minimum clearance of 2" from face of concrete.
For location and details of ladder rungs see Sh. 28.
For details of drain pipe and manhole cover see Sh. 28.
For details of Footing see Sh. 14.
For Reinforcement Schedule see Sh. 32.
For Anchor Bolt Detail and Anchor Bolt Spacing see Sh. 29.

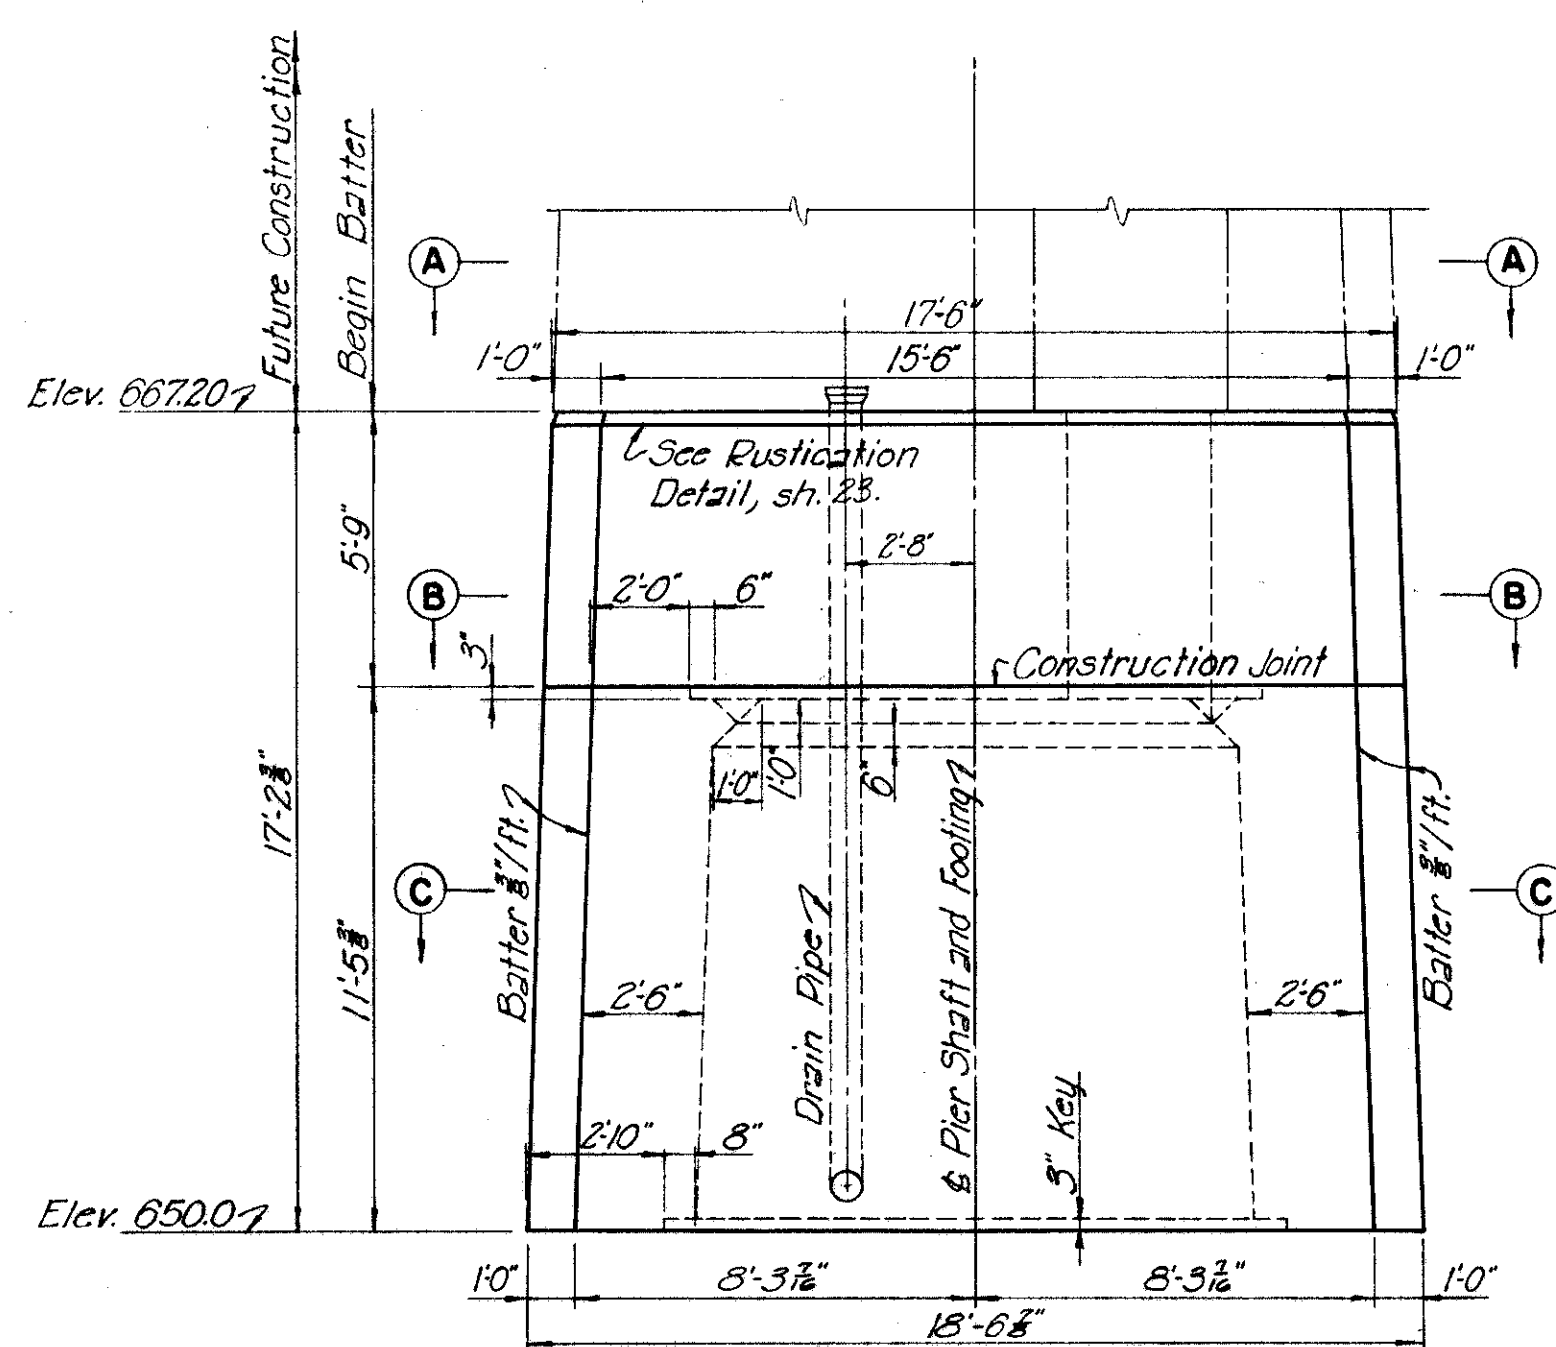

ELEVATION

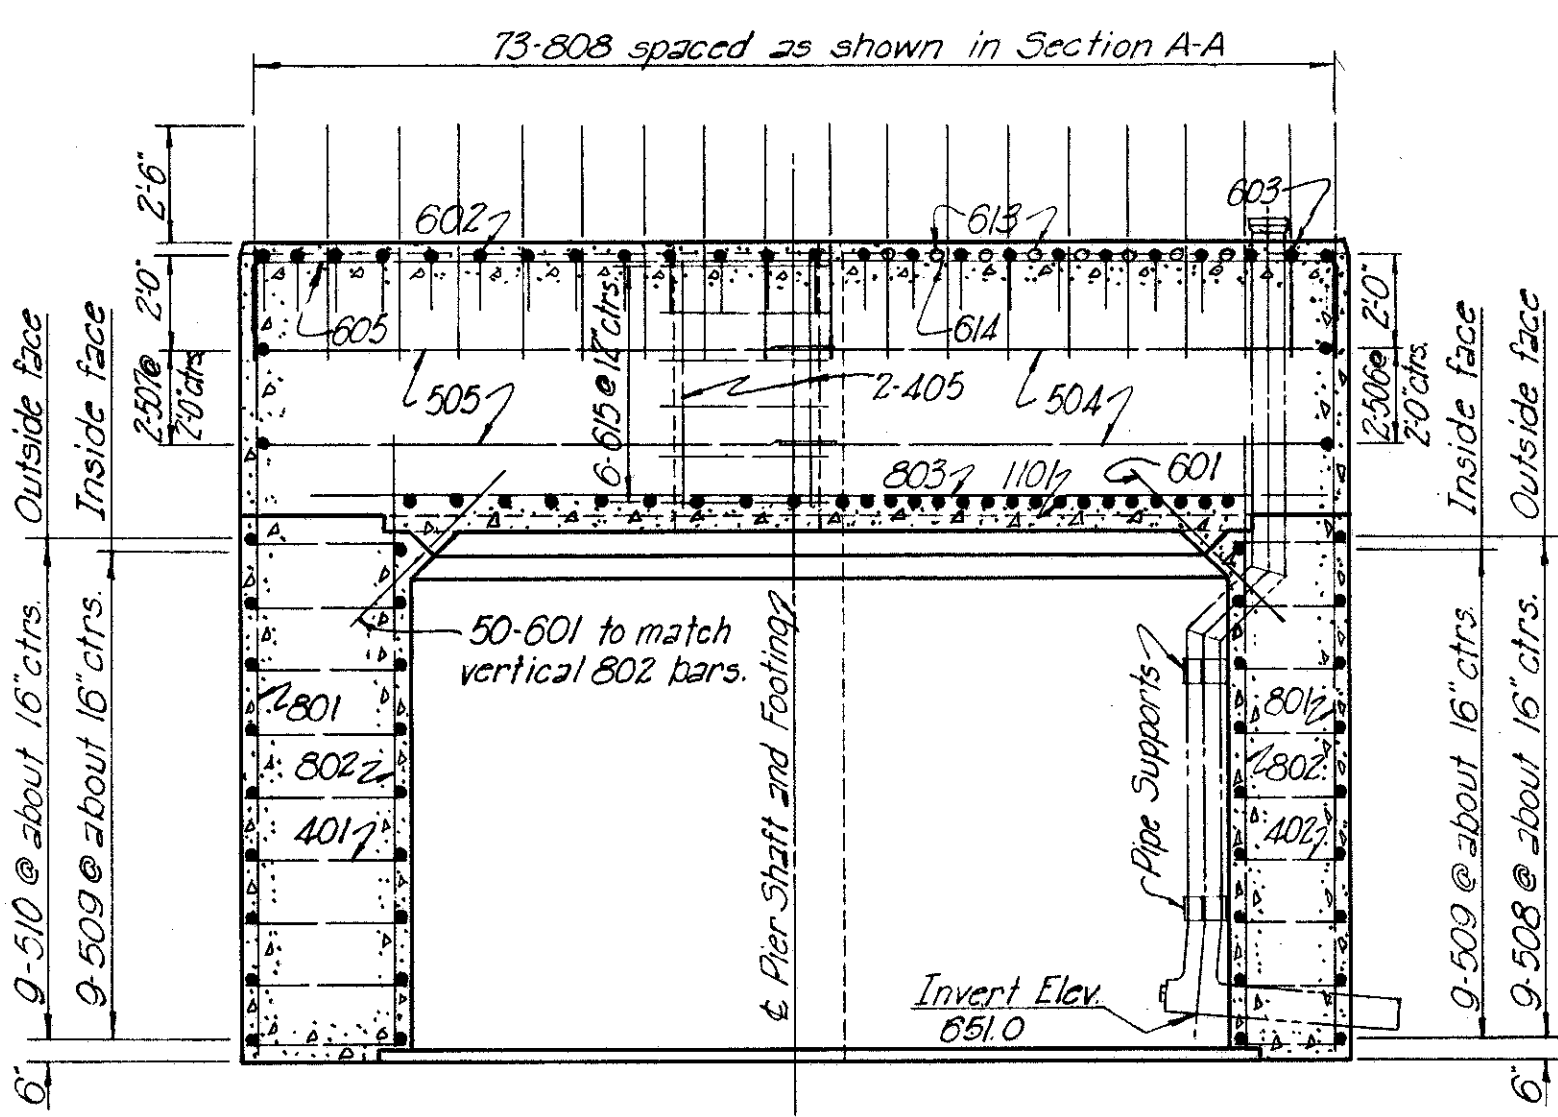


SECTION D-D

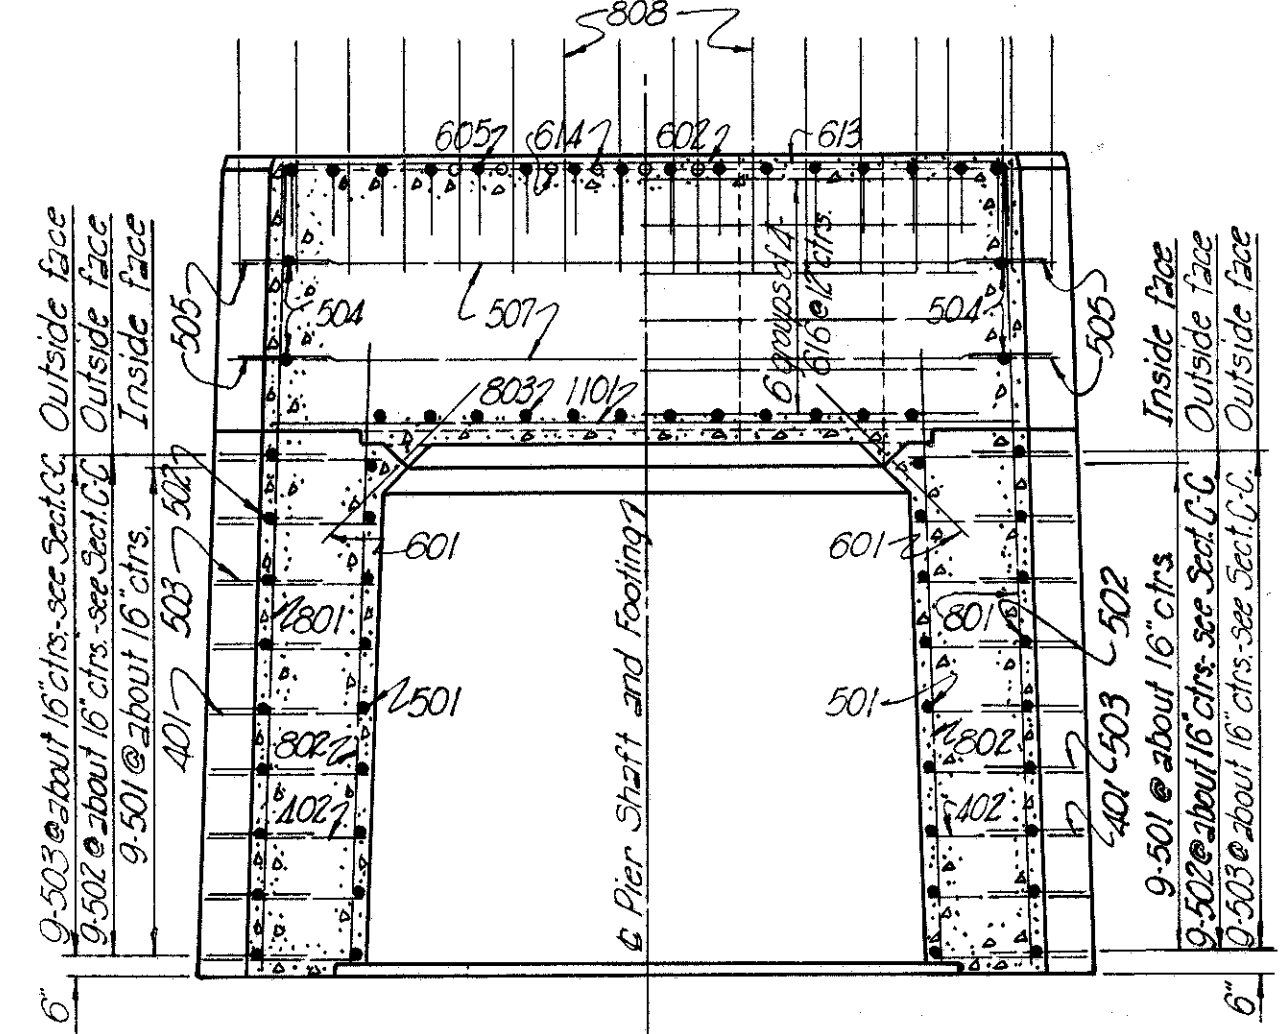


SECTION E-E


CUYAHOGA COUNTY
CITY OF CLEVELAND
INNER BELT FREEWAY
CENTRAL VIADUCT
CUY-42R-17.50

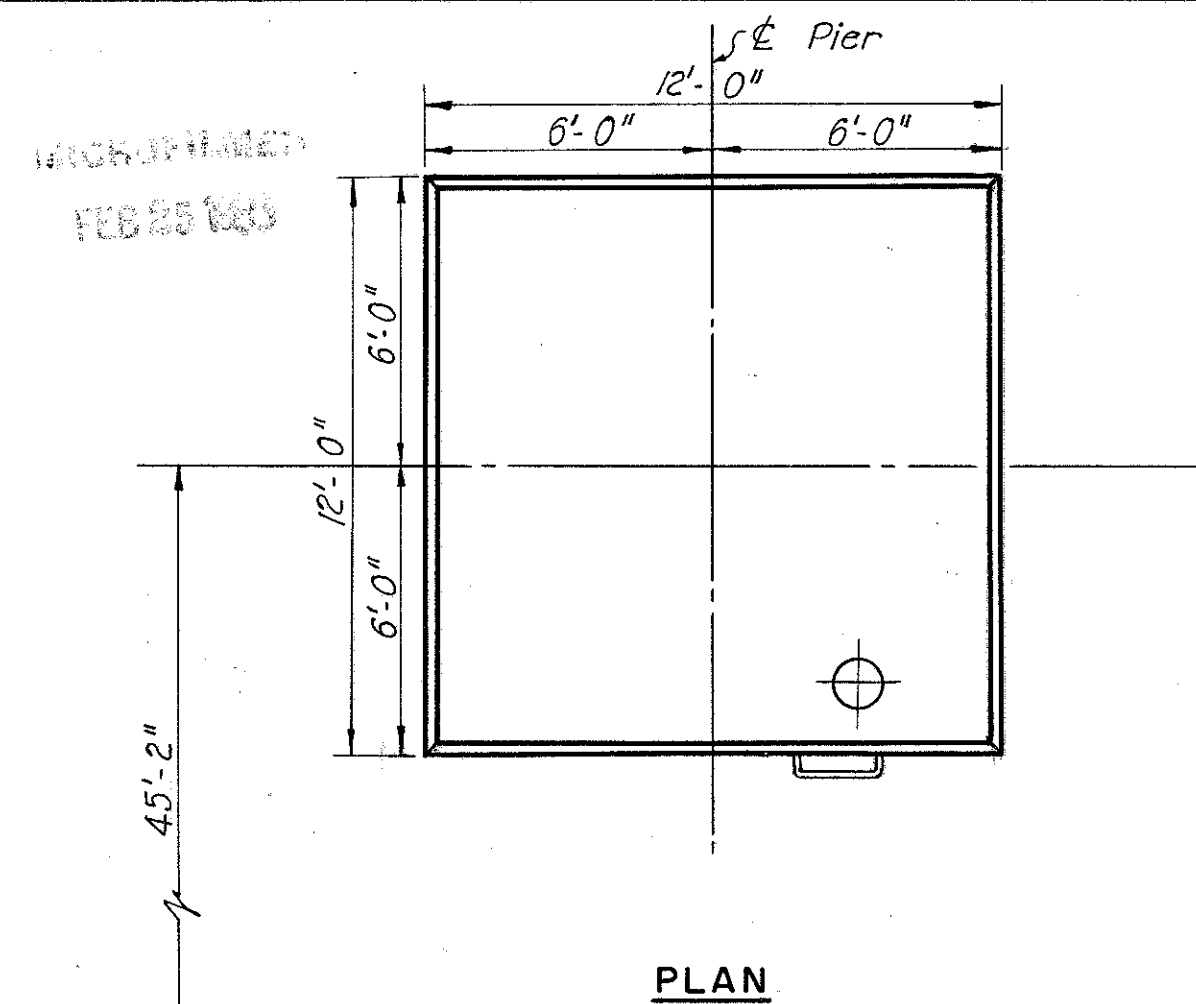


PLAN

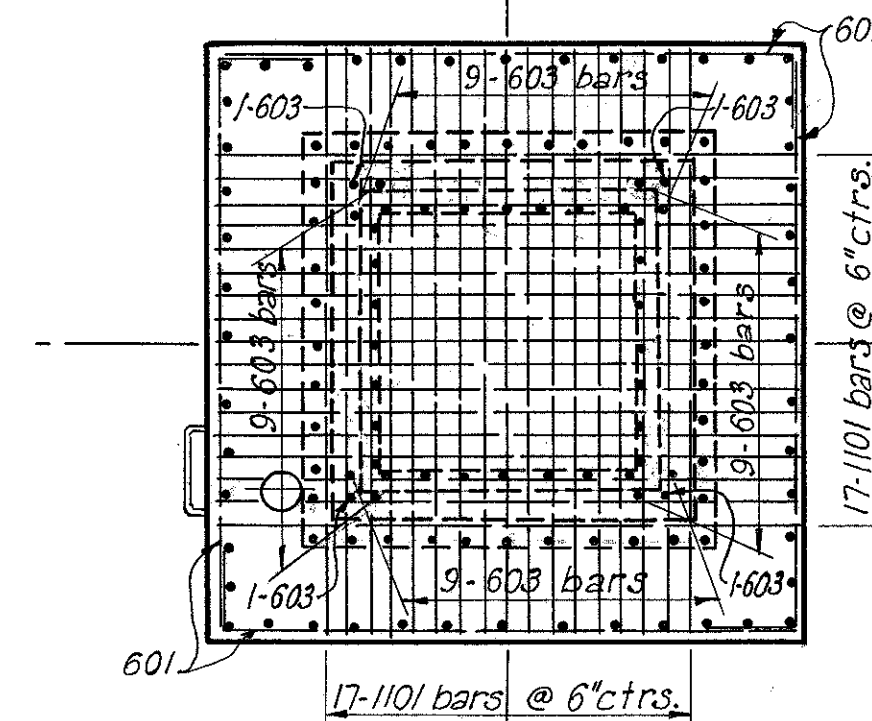


SECTION A-A

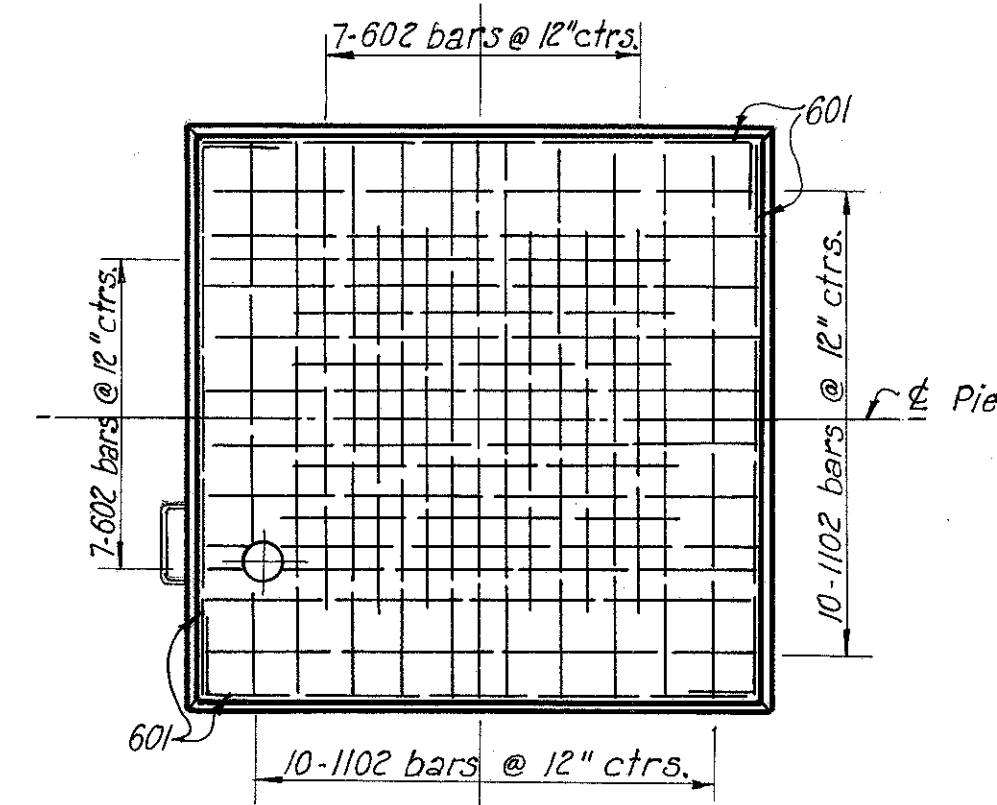


PLAN

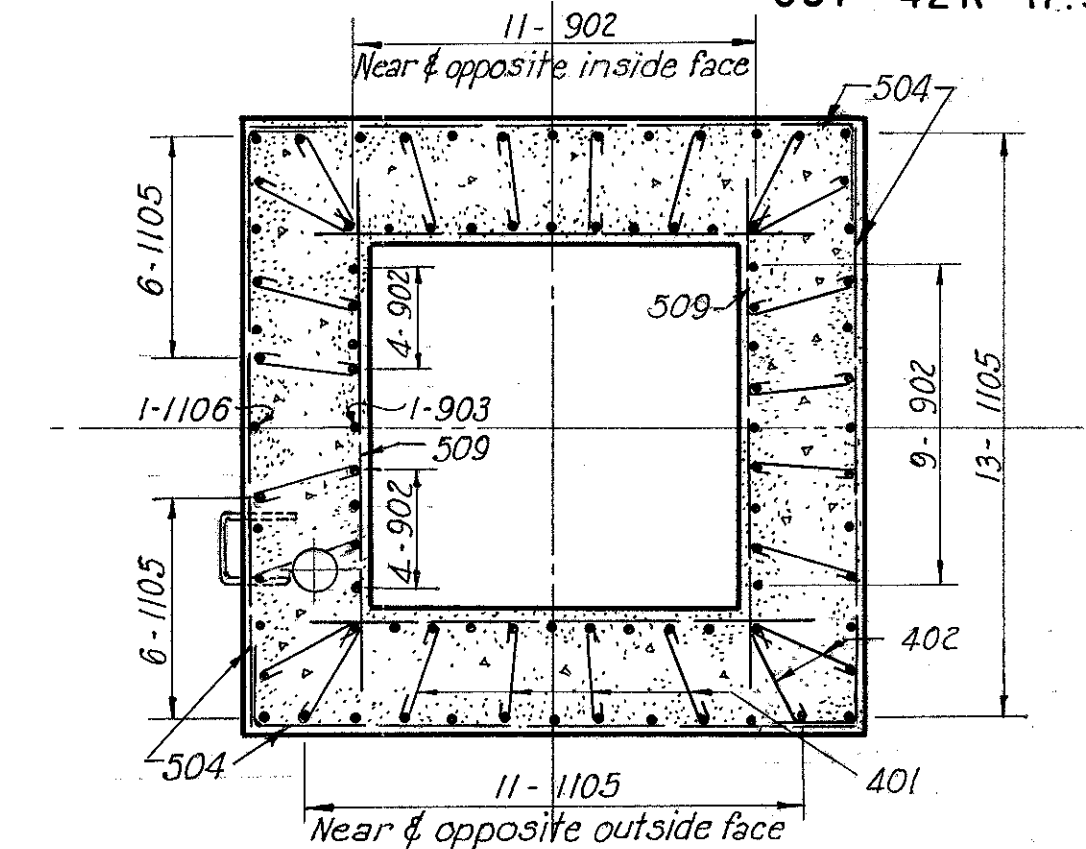


SECTION B-B

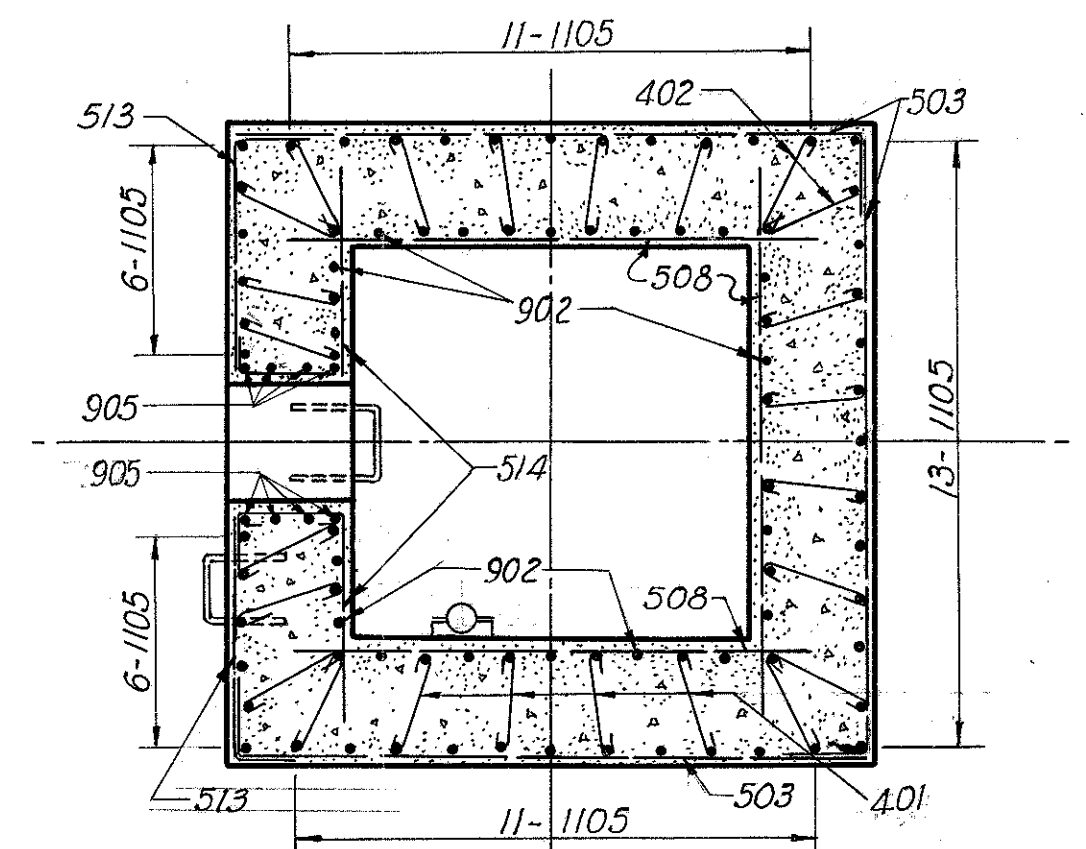

SECTION C-C

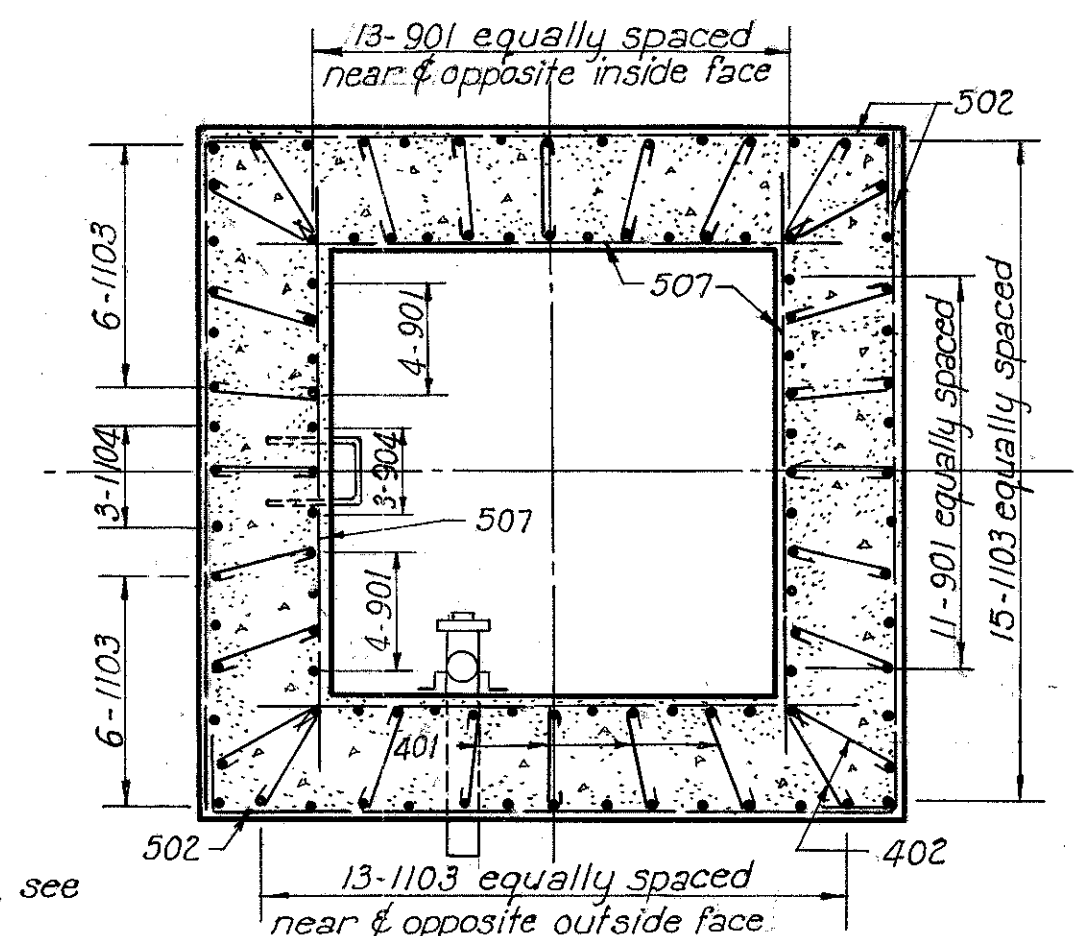


SECTION D-D

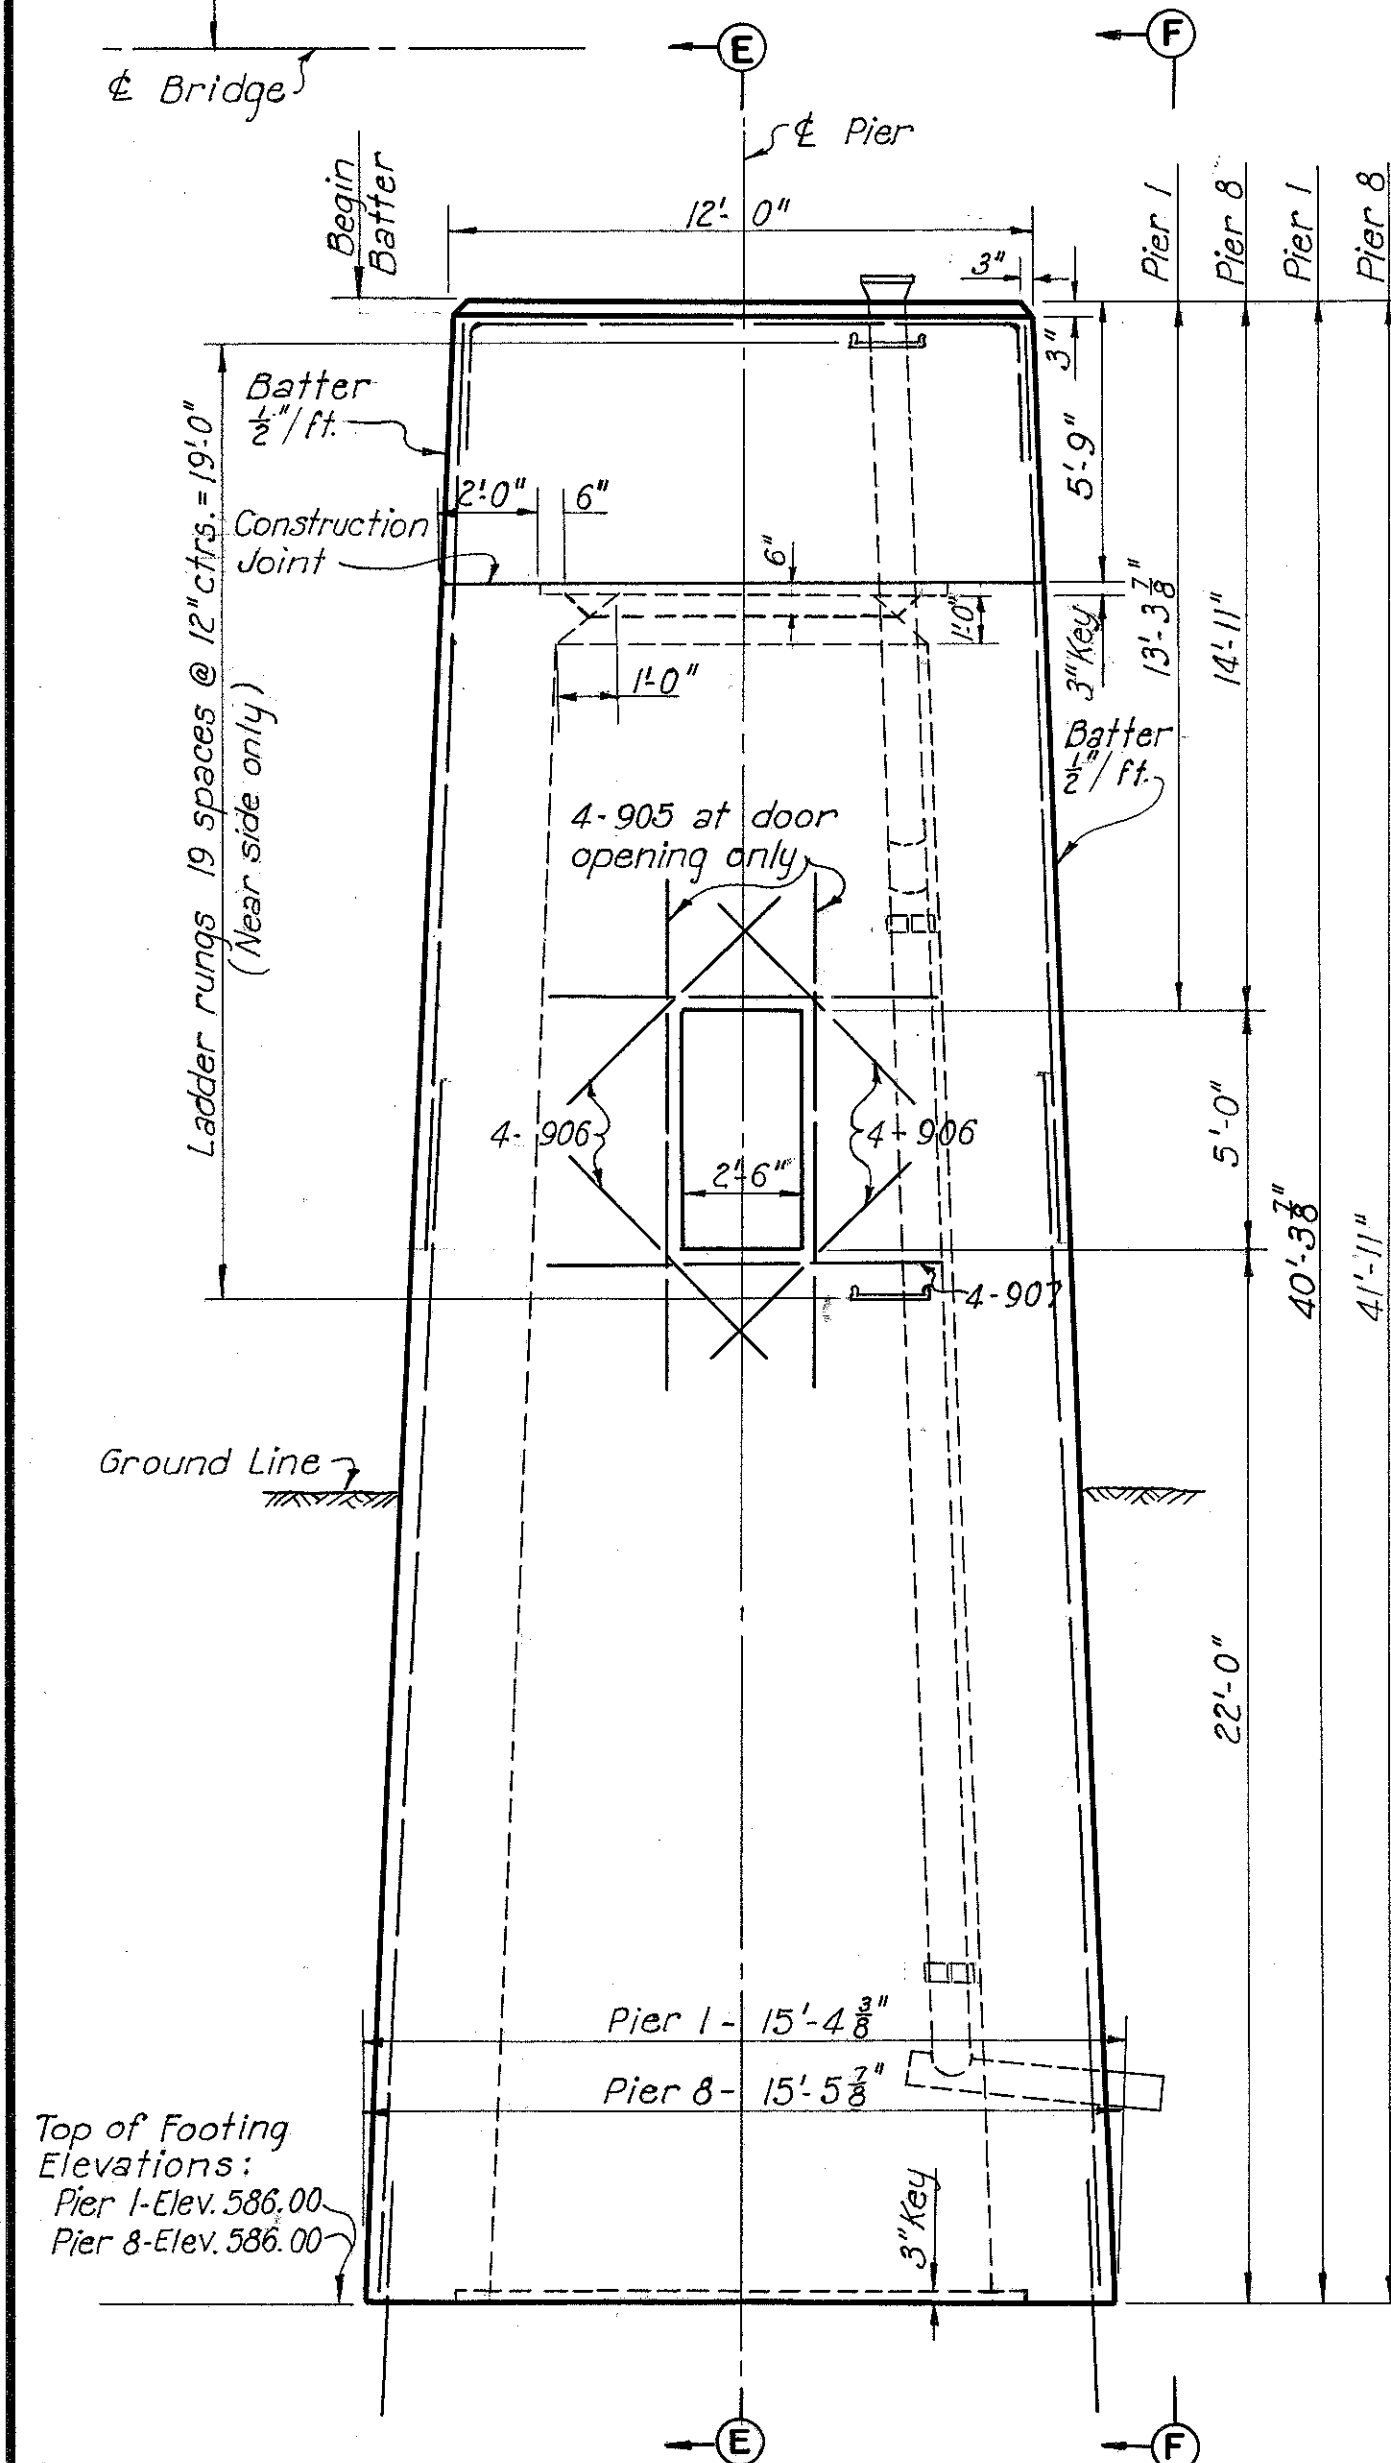


ELEVATION

Looking from Bridge

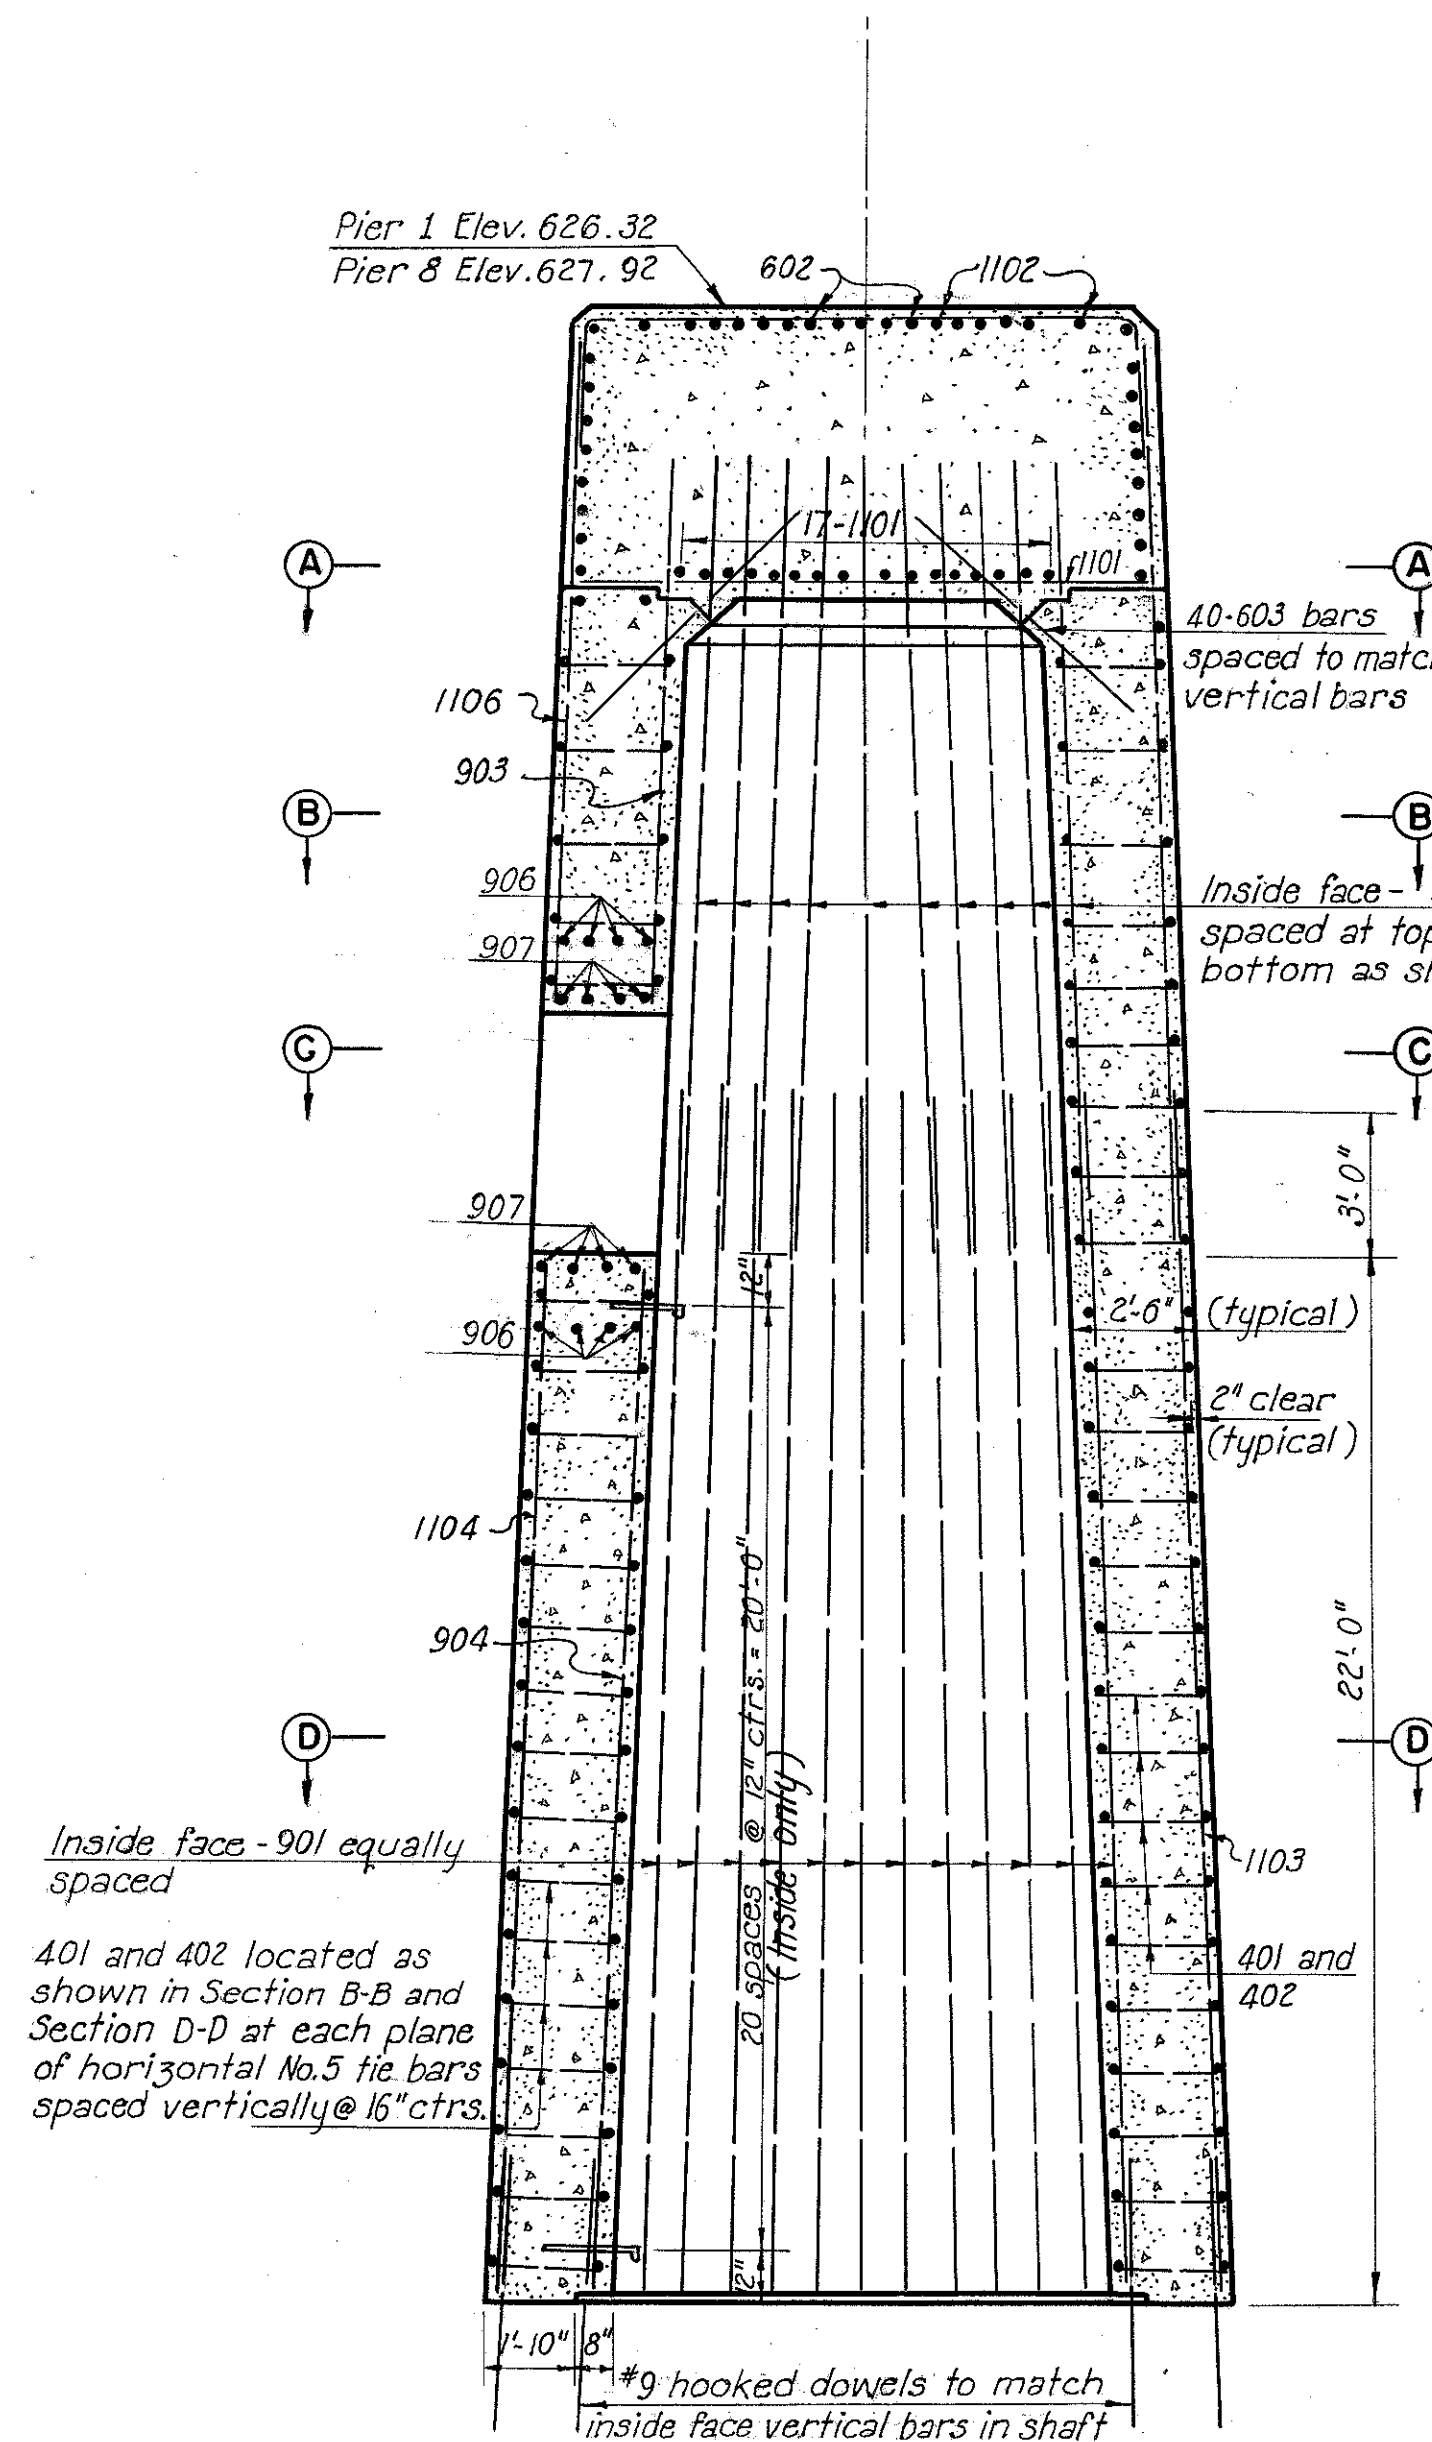

SECTION E-E

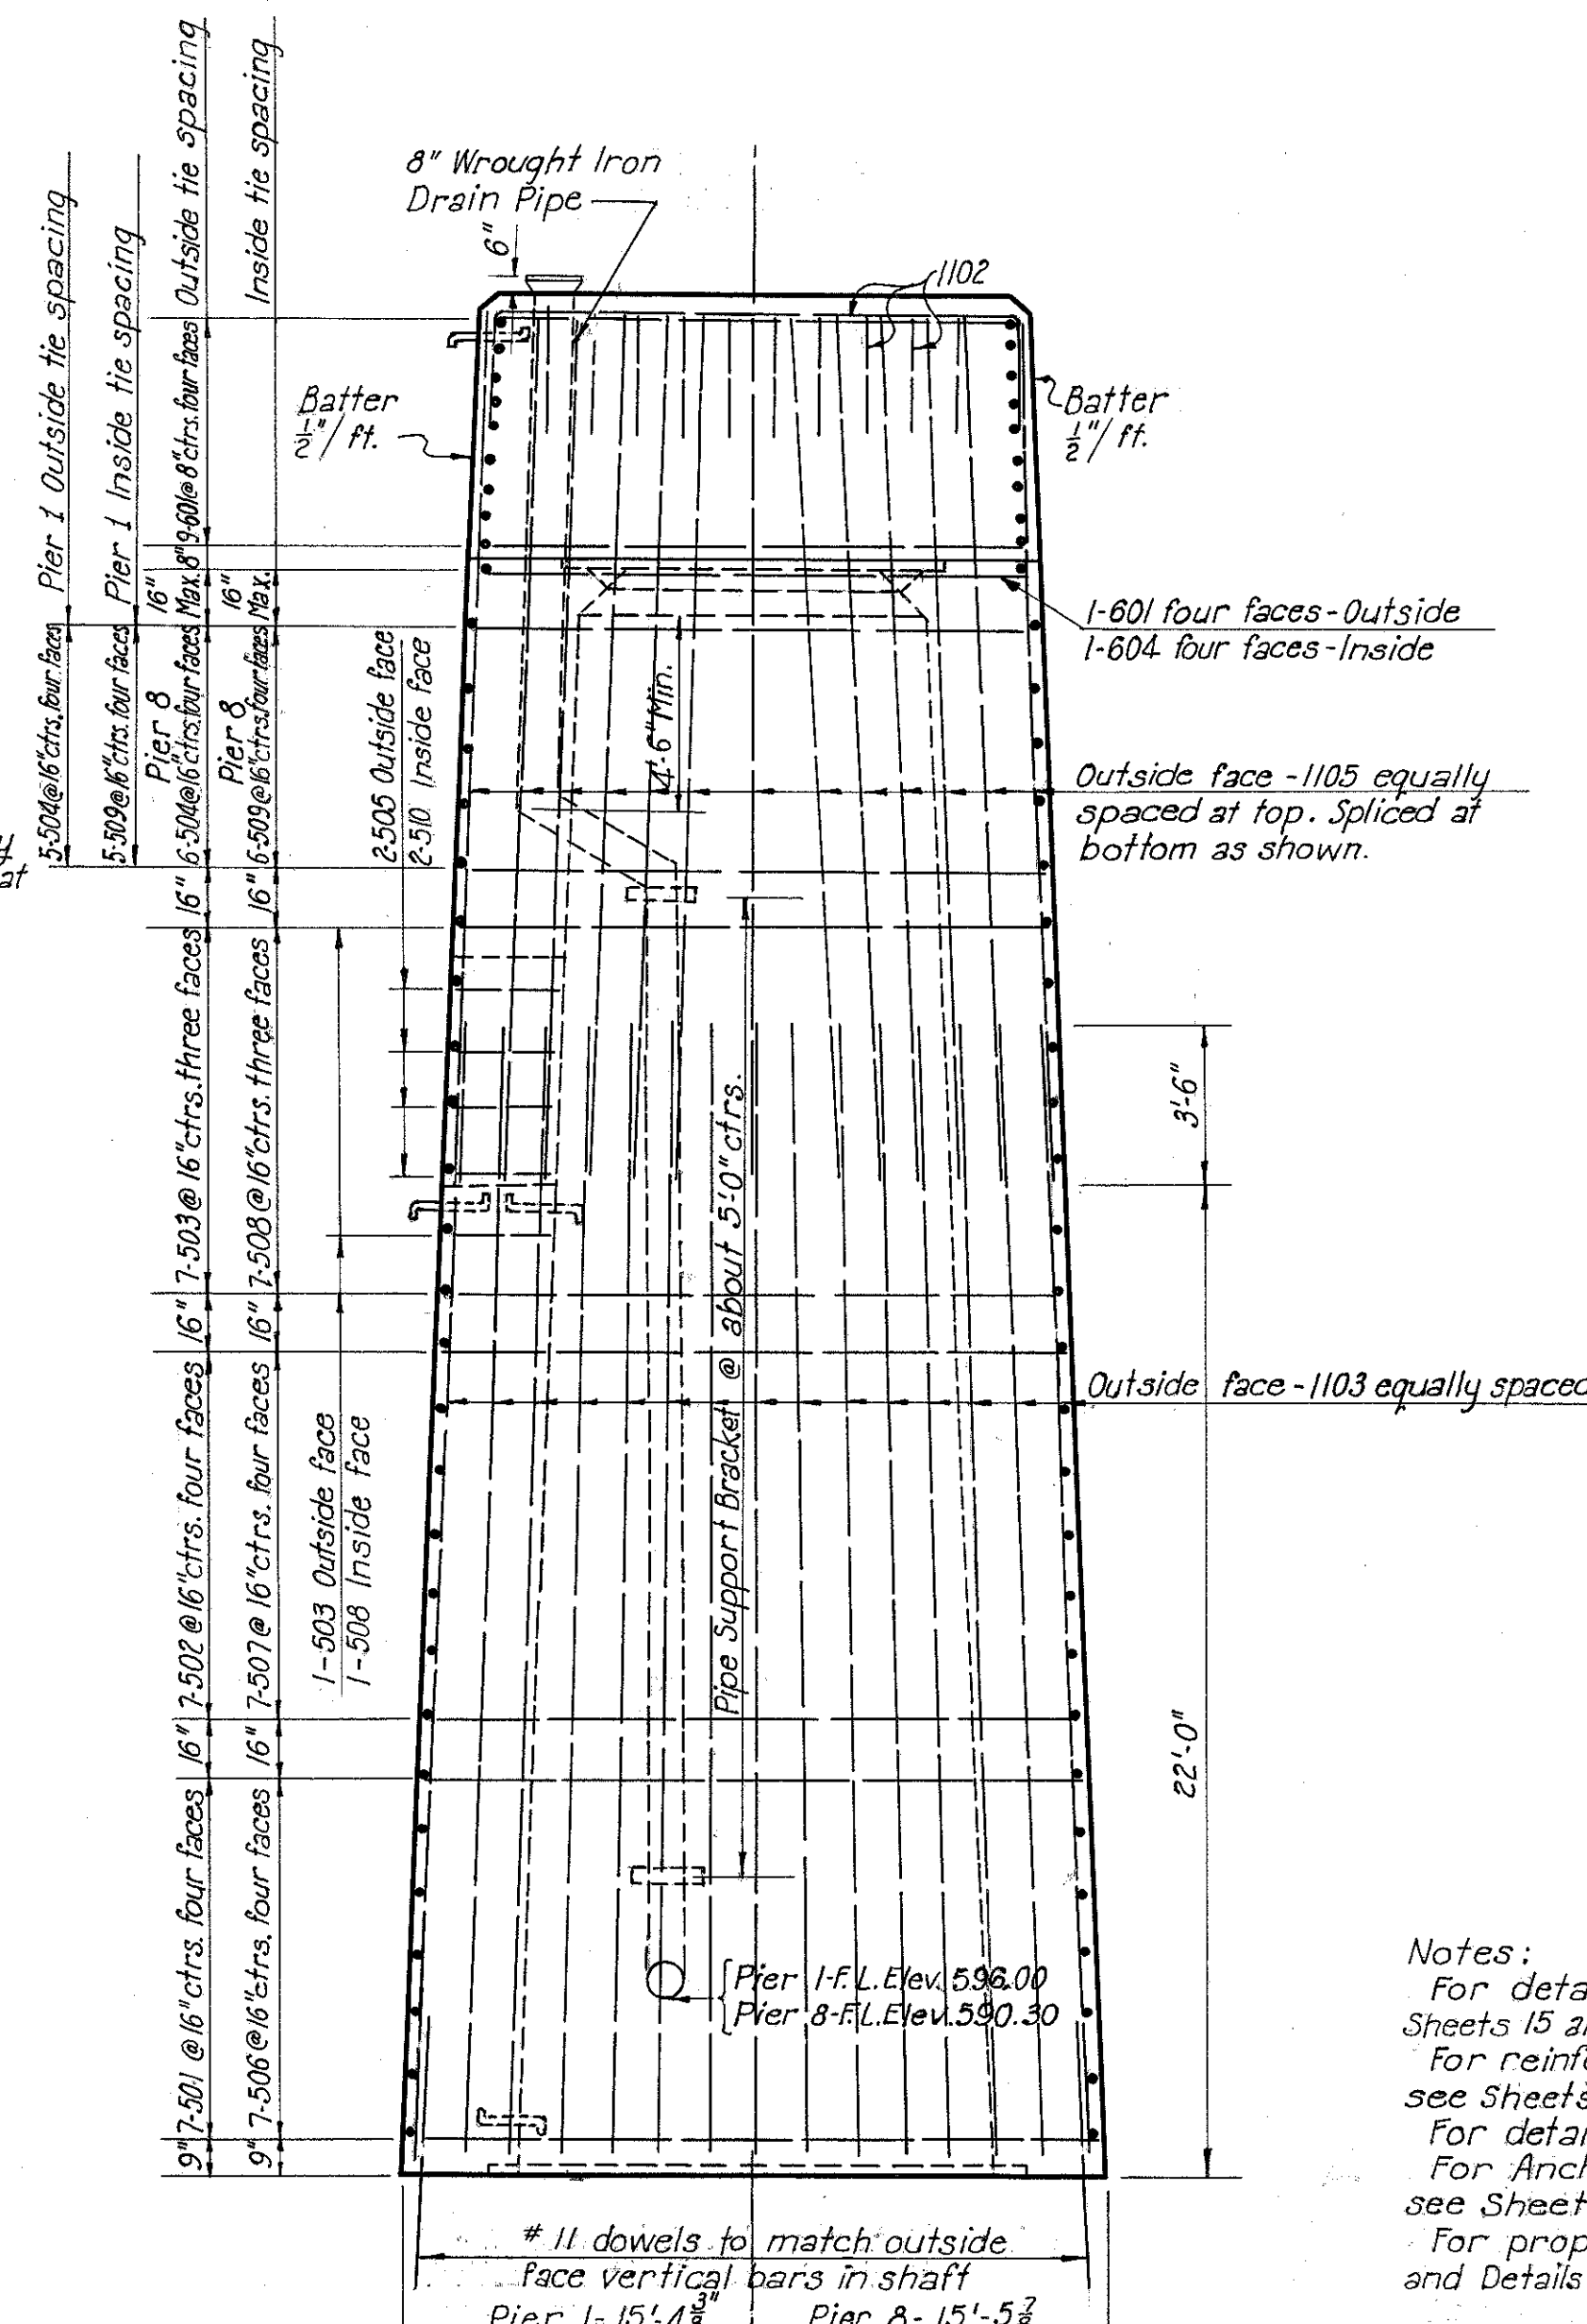

SIDE ELEVATION F-F

Notes:
For details of footings, see Sheets 15 and 21.
For reinforcement schedule, see Sheets 30 and 31.
For details of ladder, see Sheet 28.
For Anchor Bolt Plan and Details see Sheet 29.
For proper location of Drain Pipe and Details, see Sheet 28.

PART 2




U. S. ROUTE 42 RELOCATION
INNER BELT FREEWAY - CENTRAL VIADUCT

SHAFTS - PIERS I AND 8

CLEVELAND CUYAHOGA COUNTY OHIO

SCALE: 1/4" = 1'-0"
MADE 4-18 DATE 3-5-54
TRCD. B.H. DATE 6-8-54
CKD. J.G.S. DATE 6-16-54
HOWARD, NEEDLES, TAMMEN & BERGENDOFF
CONSULTING ENGINEERS
KANSAS CITY CLEVELAND NEW YORK
914-1A SHEET 1.25

CUYAHOGA COUNTY
CITY OF CLEVELAND
INNER BELT FREEWAY
CENTRAL VIADUCT
CUY - 42 B - 17.50

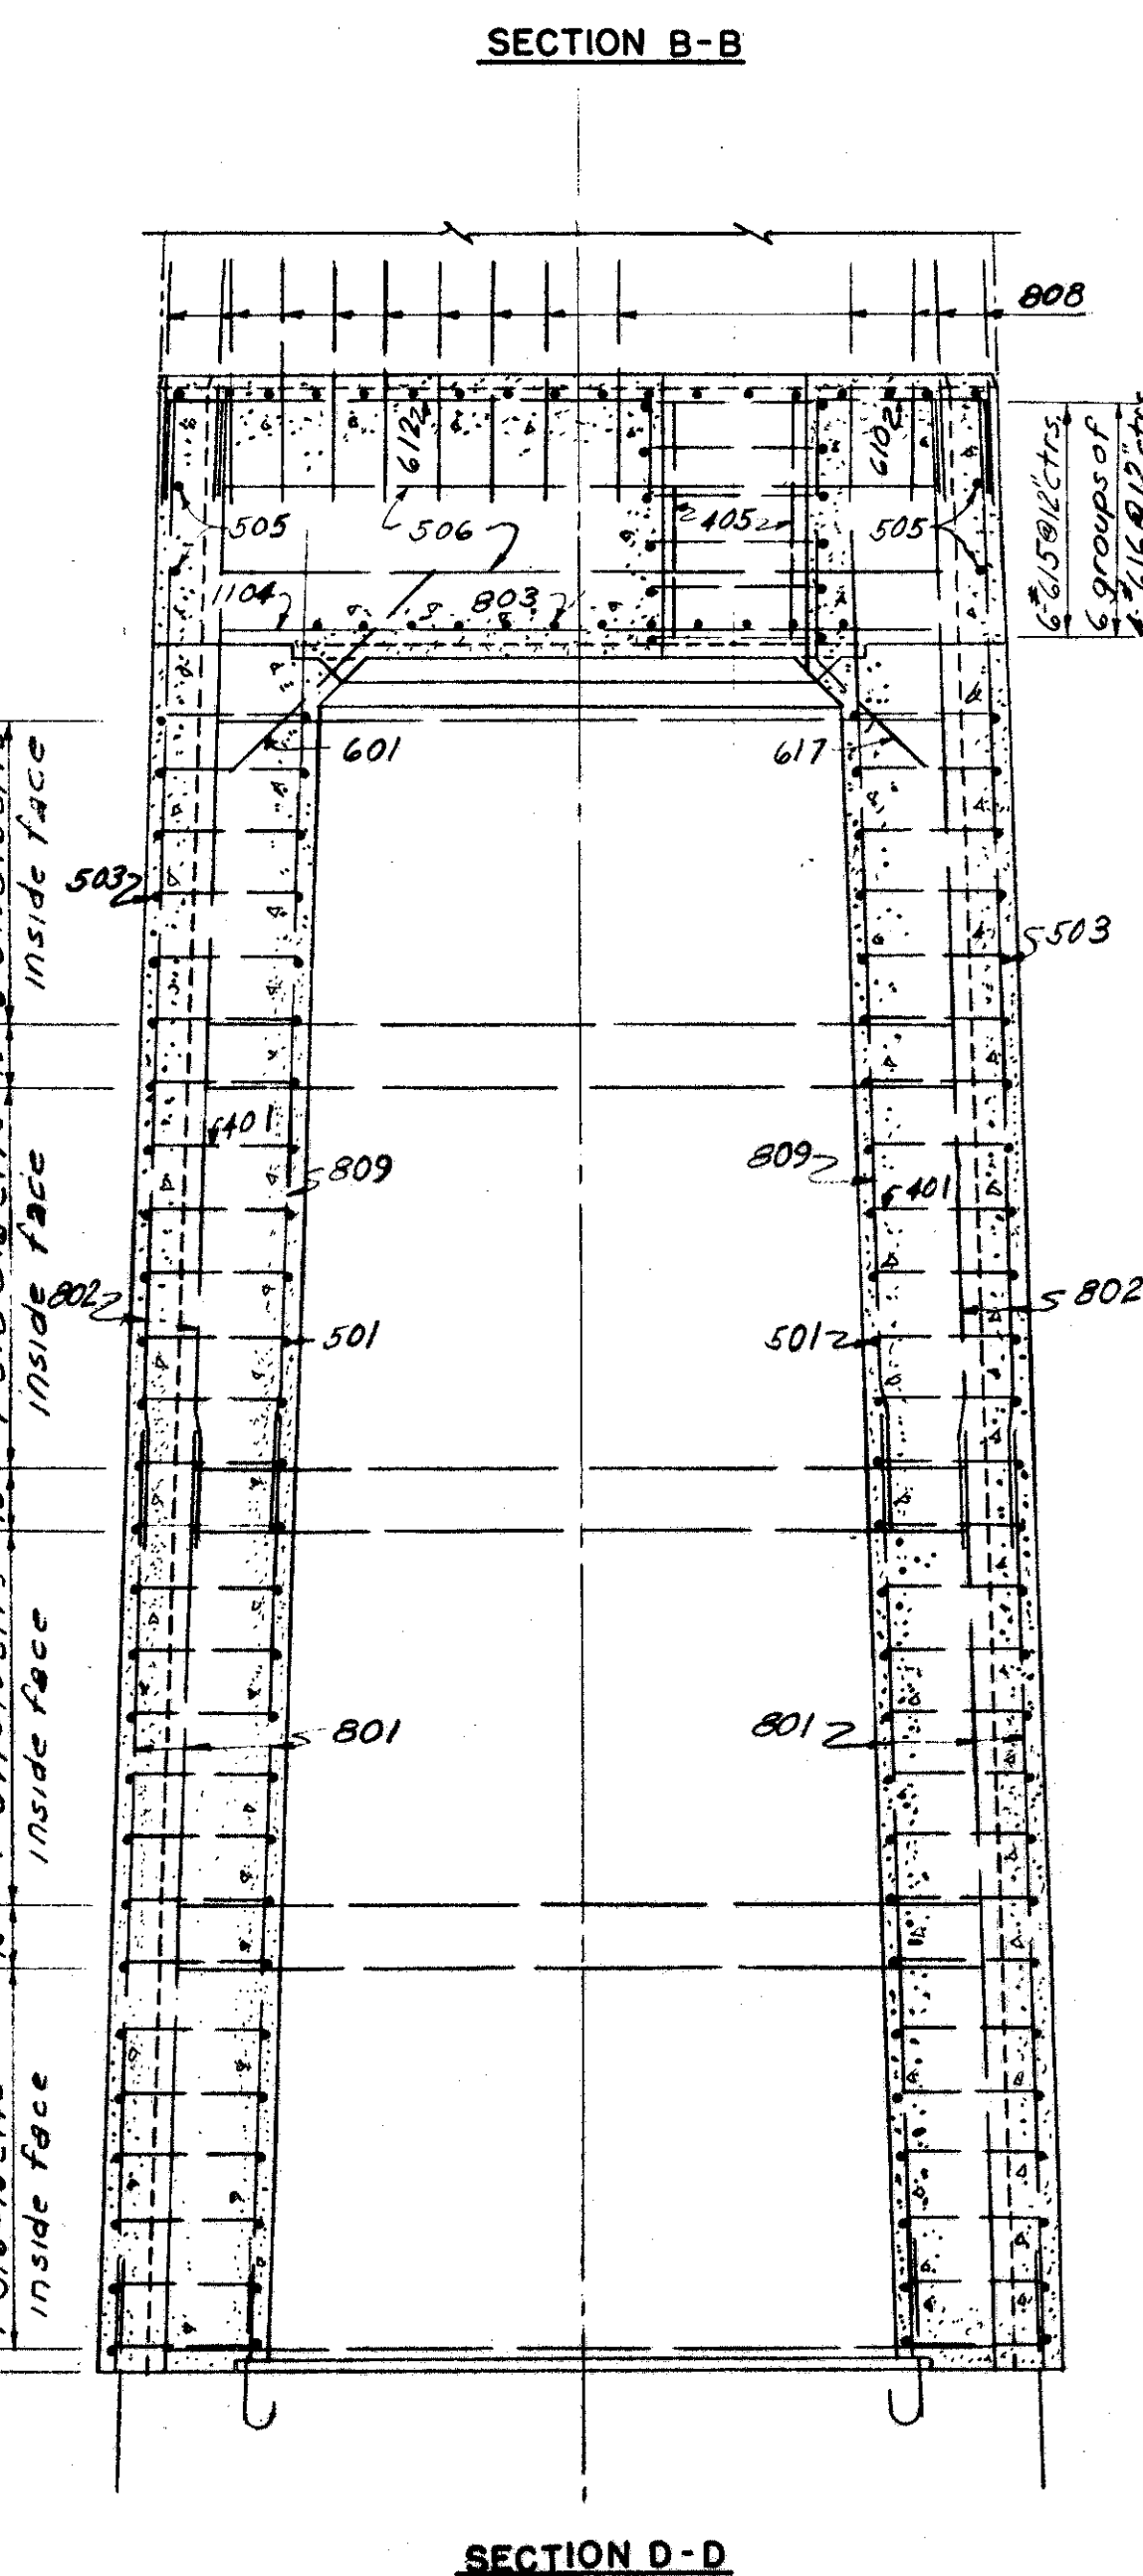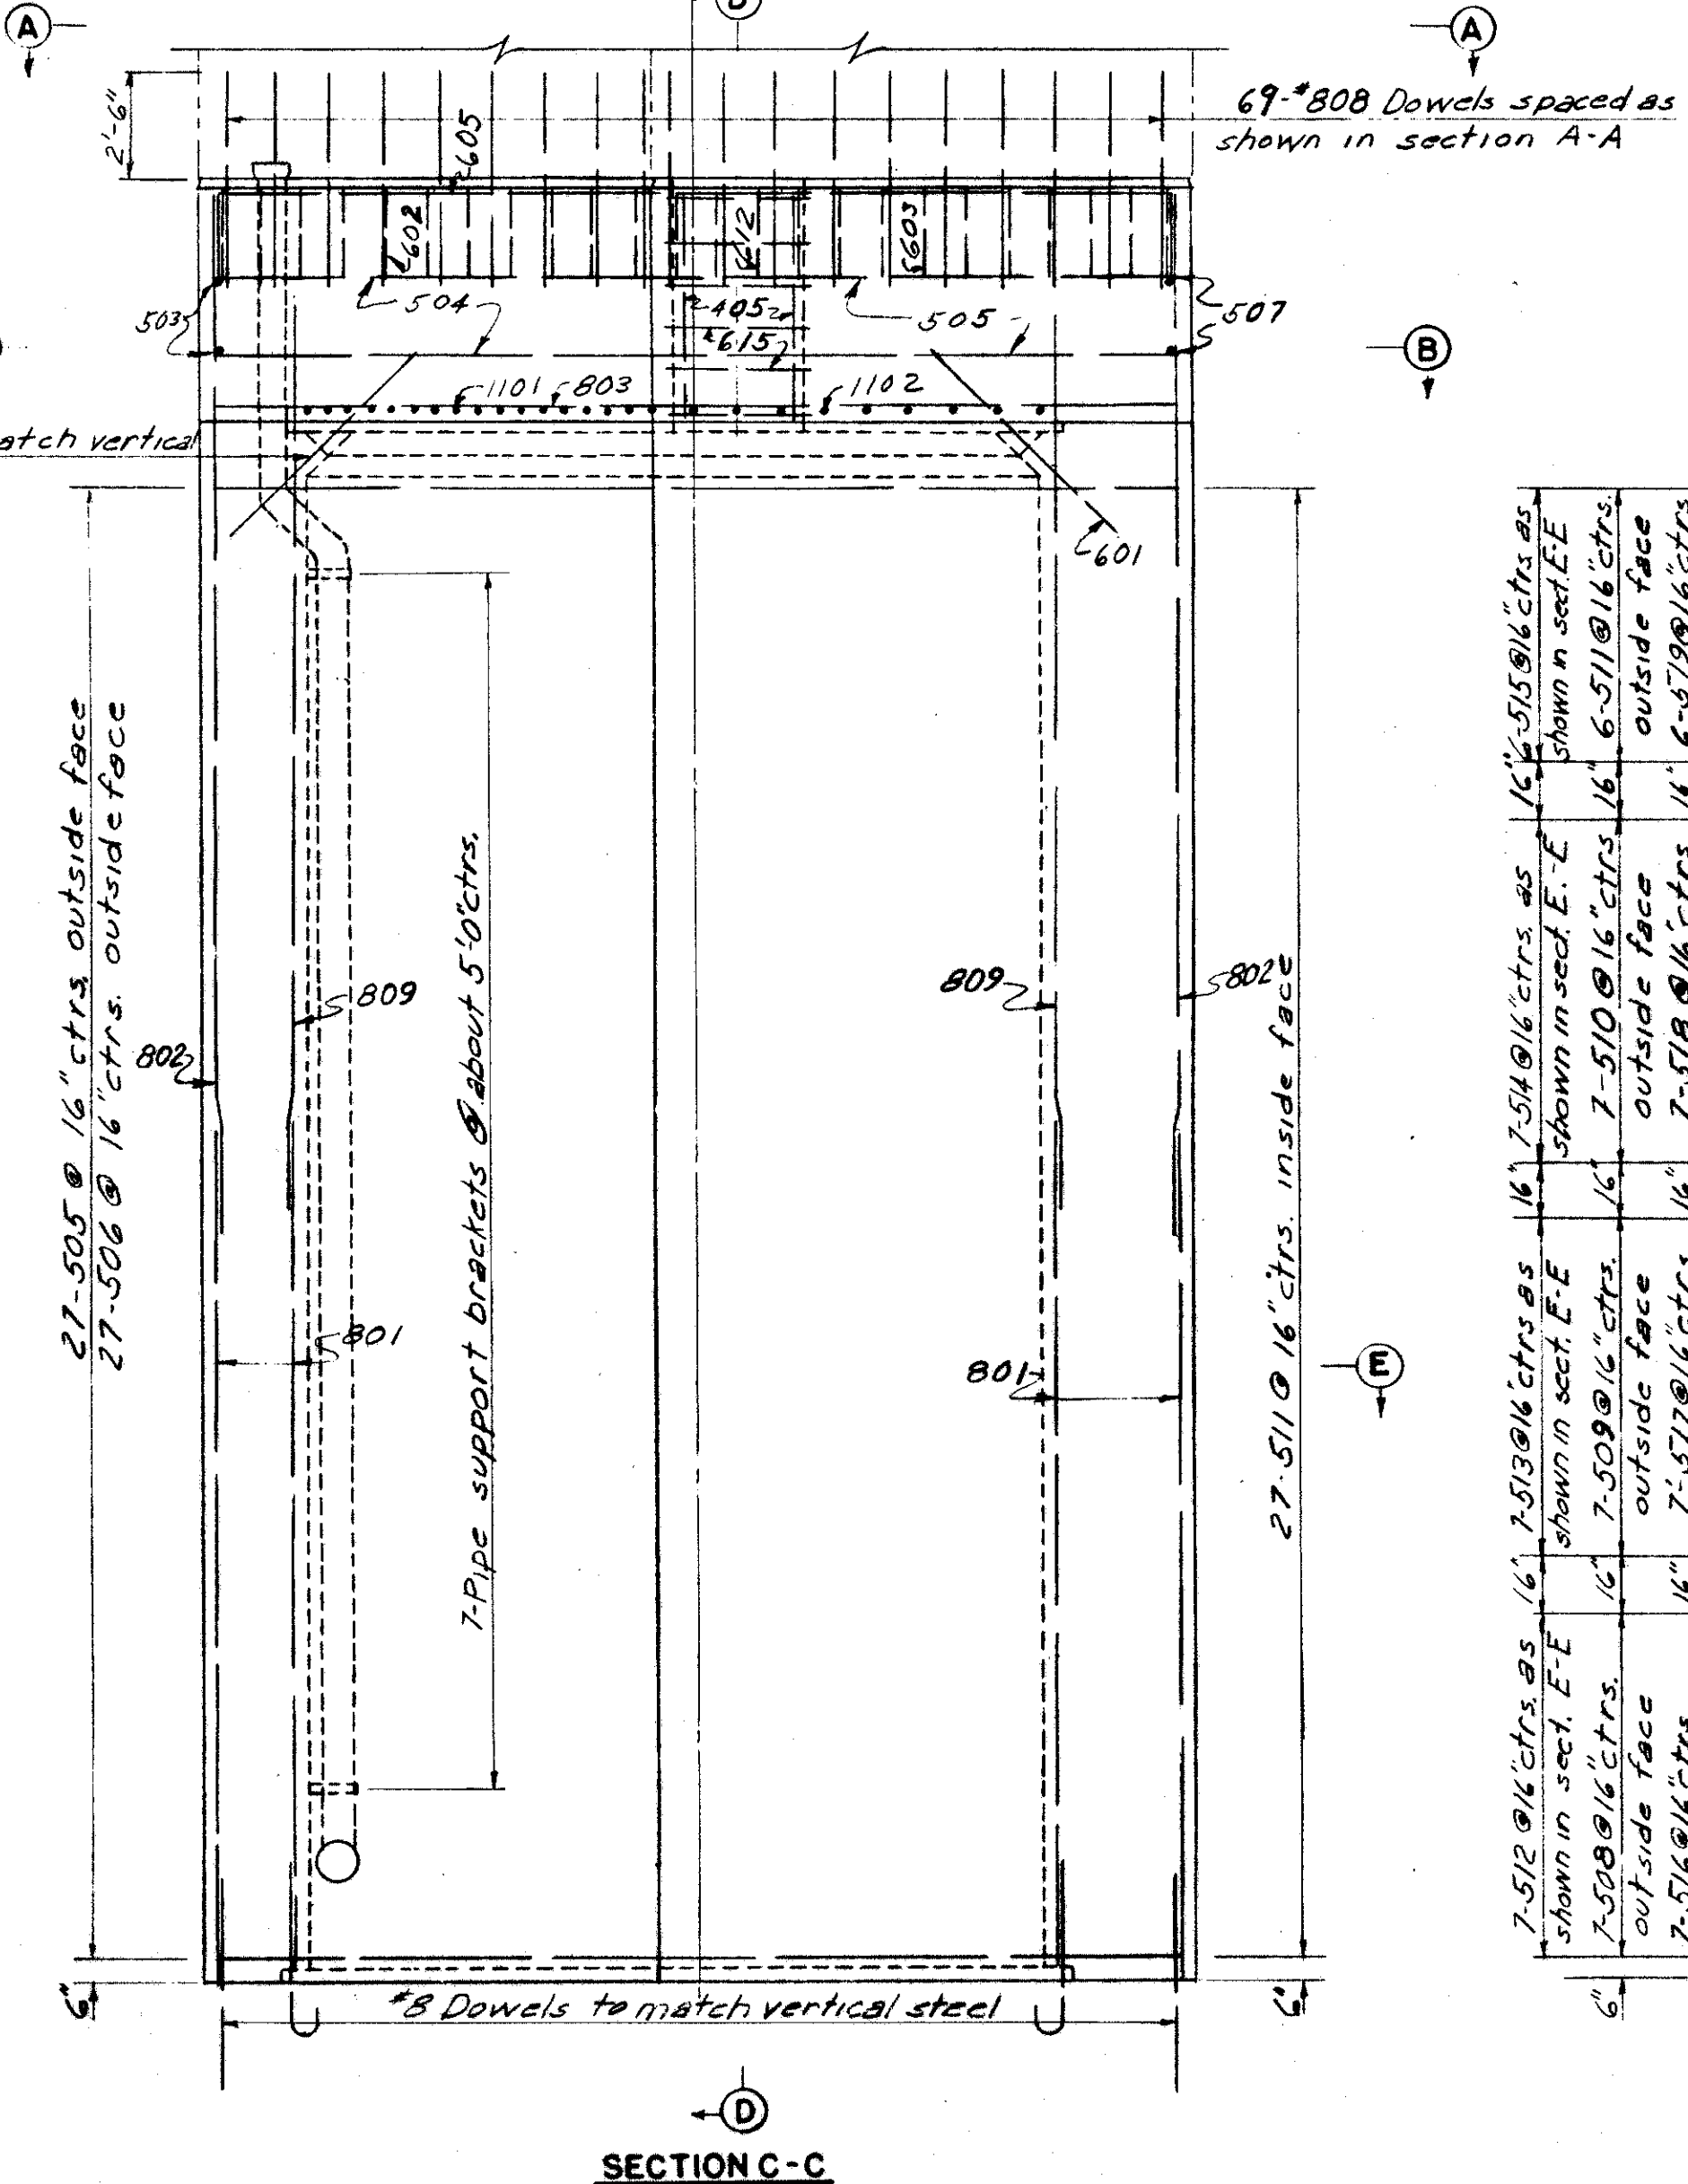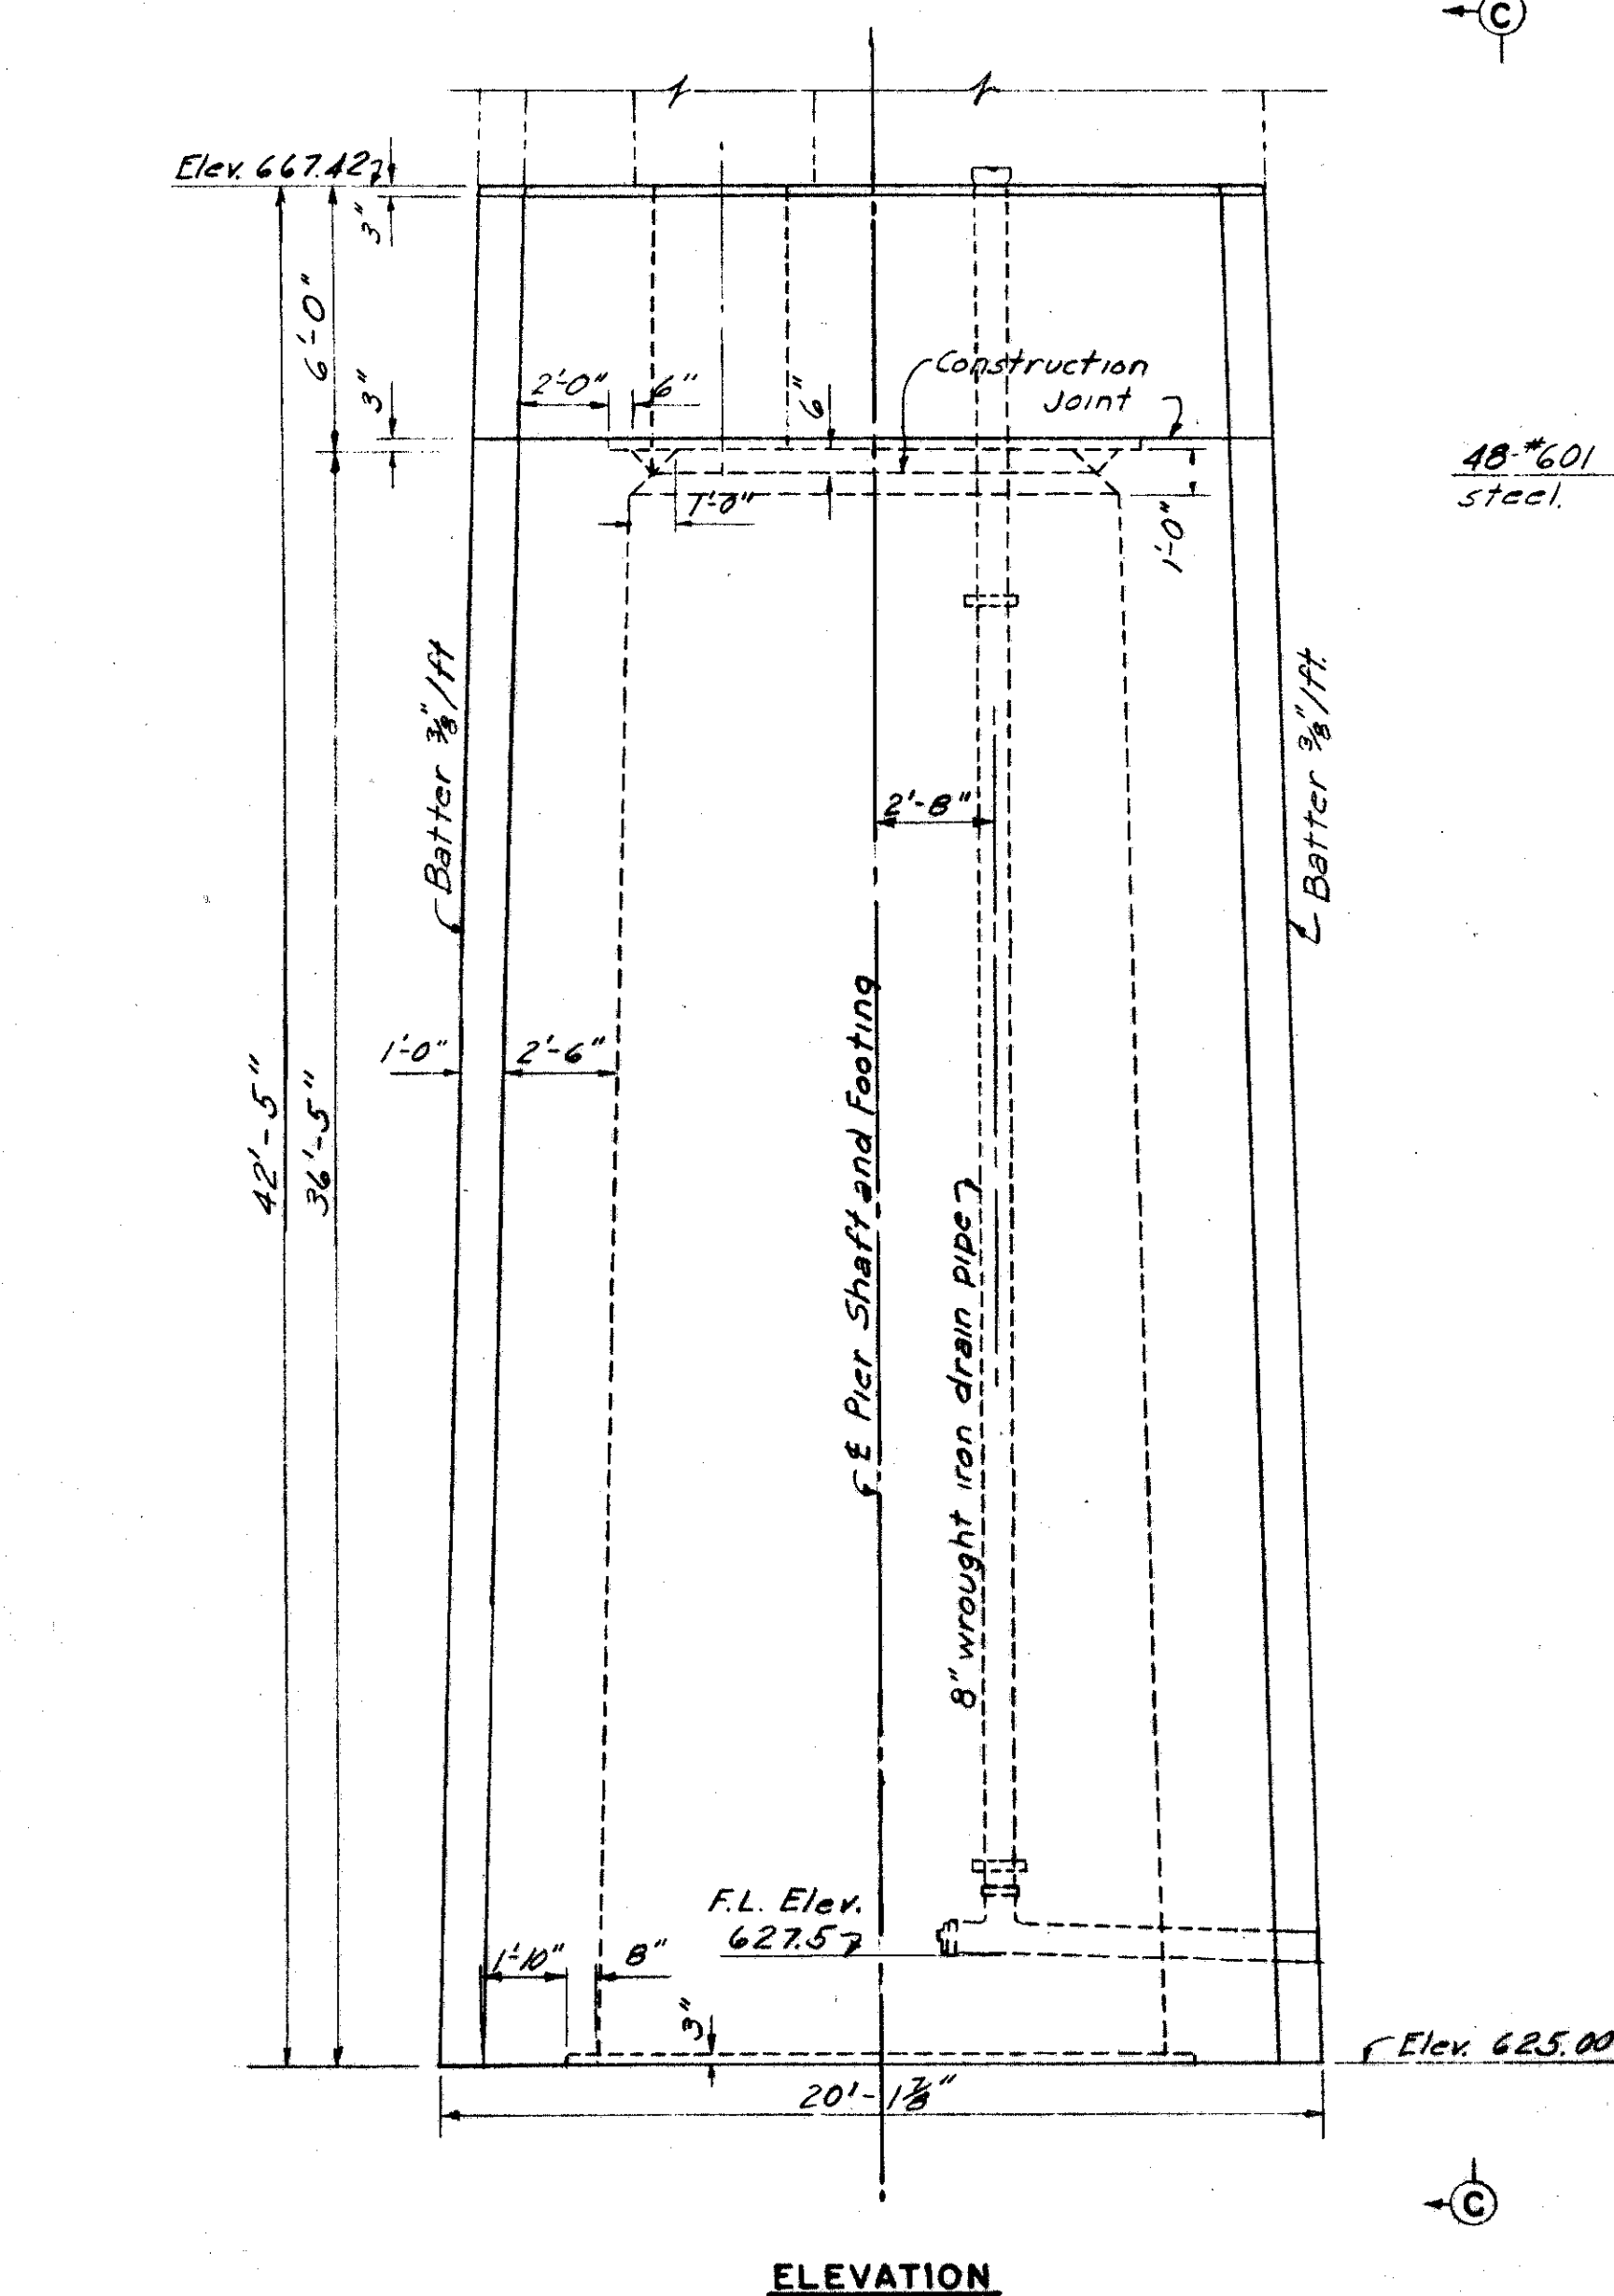

Notes:
For details of footings see sheet 22.
For details of iron rungs see sheet 28.
For reinforcement schedule see sheet 32.
For anchor bolt detail and anchor bolt spacing see sheet 29.
For location and direction of drain pipe, see sheets 28 and 35.
For detail of manhole cover see sheet 28.
For location of iron rungs see sheet 28.
For detail of rustication see sheet 23.

PART 2

U. S. ROUTE 42 RELOCATION.
INNER BELT FREEWAY - CENTRAL VIADUCT


EAST END PIER SHAFTS EN AND ES

CLEVELAND GUYAHOGA COUNTY OHIO


SCALE 3" = 1'-0"
MADE DEF DATE 7-2-54
TRCD _____ DATE _____
CKD GNC DATE 7-9-54

HOWARD, NEEDLES, TAMMEN & BERGENDOFF
CONSULTING ENGINEERS
KANSAS CITY CLEVELAND NEW YORK
914-1A SHEET 127

5 £ Pier

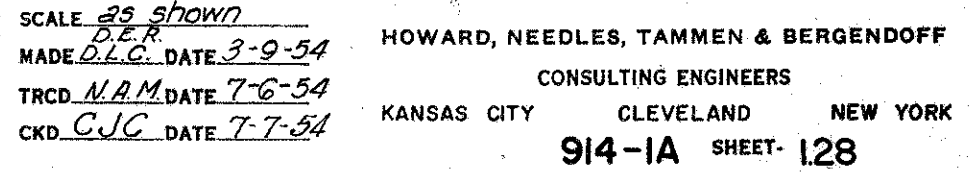


CUYAHOGA COUNTY
CITY OF CLEVELAND
INNER BELT FREEWAY
CENTRAL VIADUCT
CUY-42R-17.50

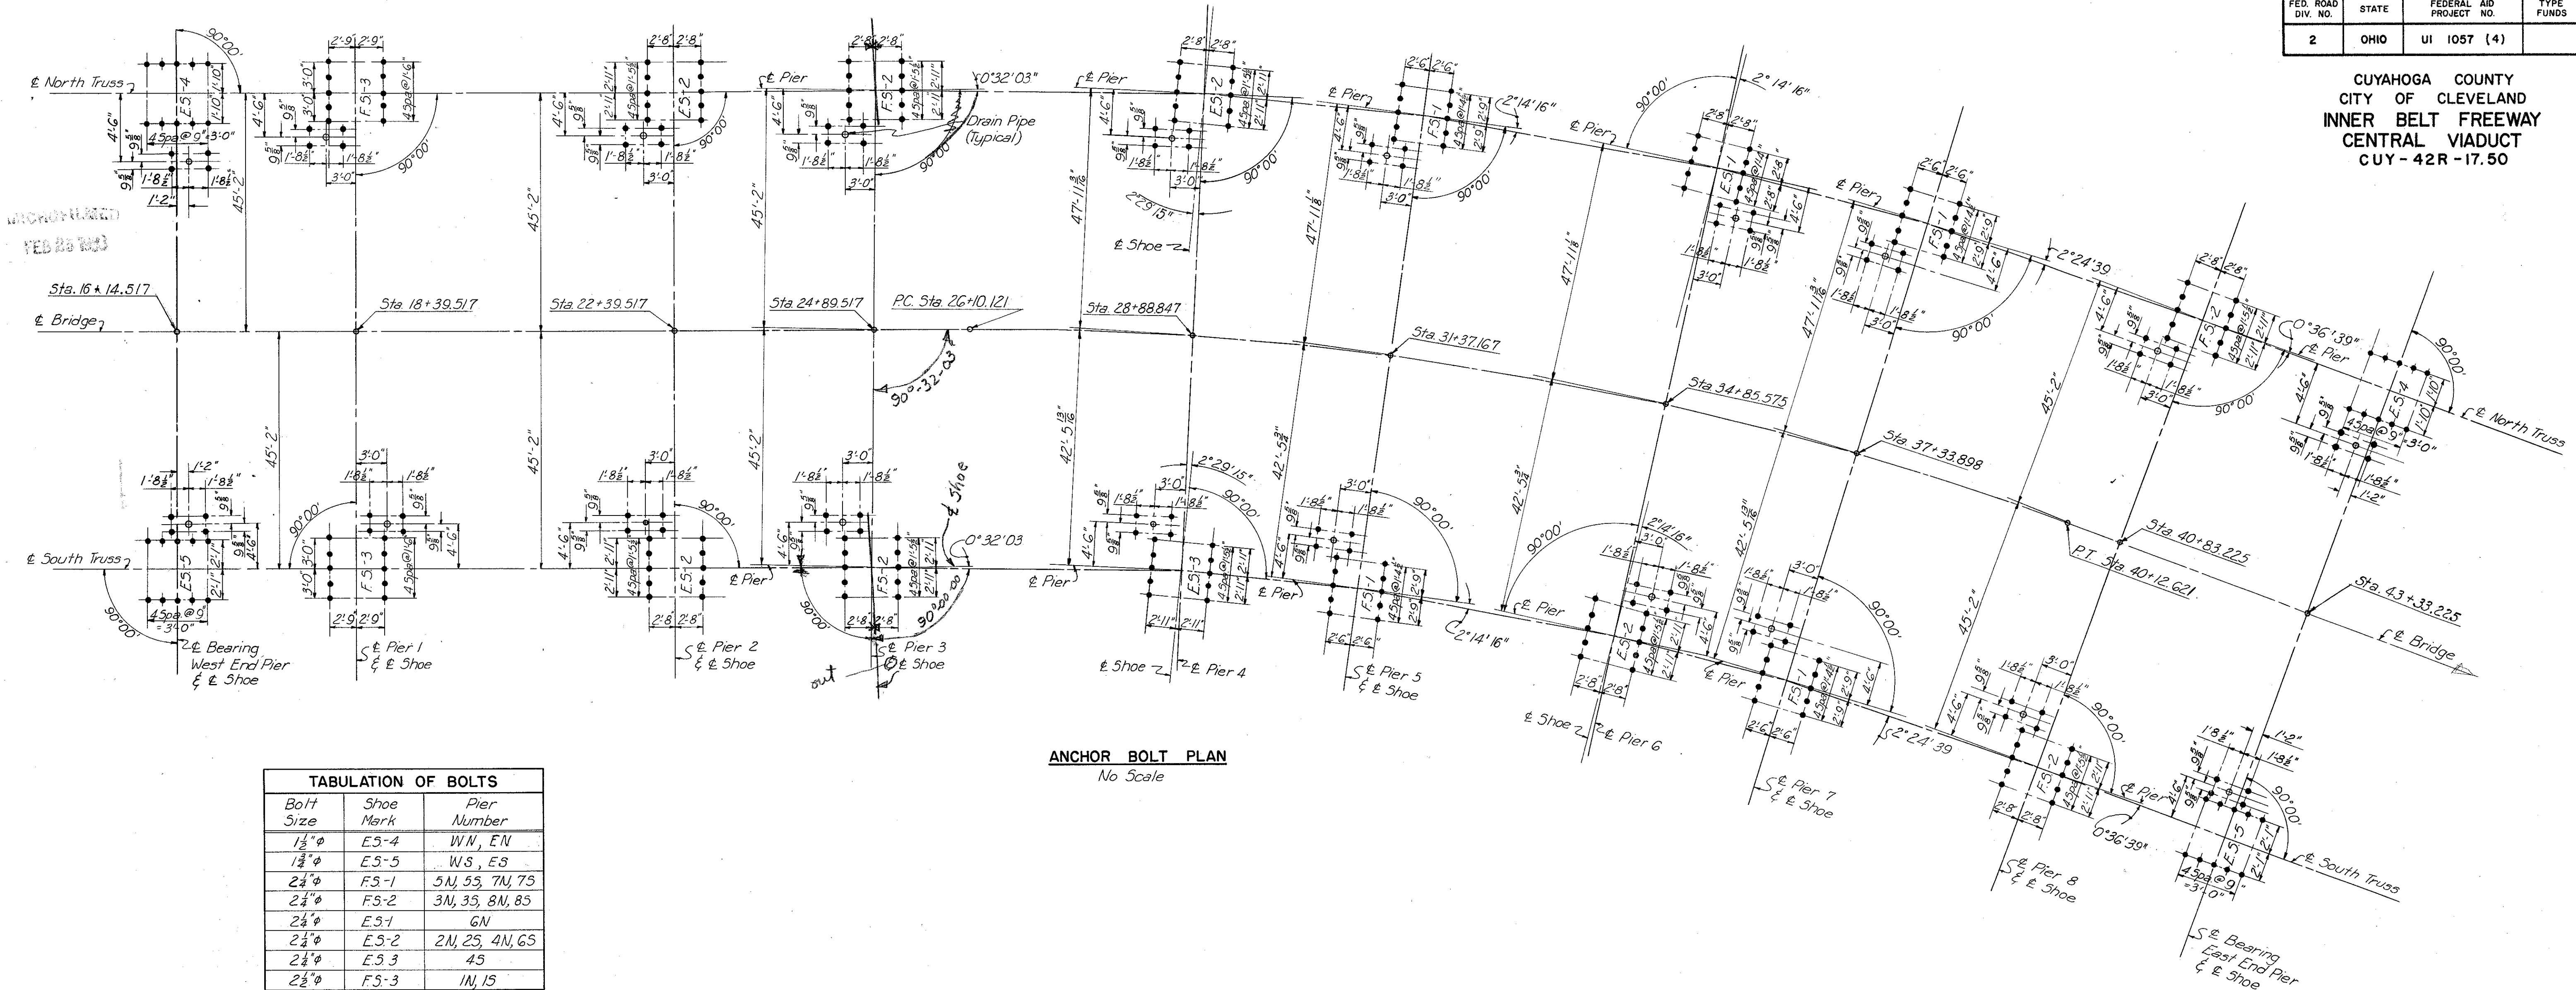


TABULATION OF BOLTS		
Bolt Size	Shoe Mark	Pier Number
1 1/2" φ	ES-4	WN, EN
1 3/4" φ	ES-5	WS, ES
2 1/4" φ	FS-1	5N, 5S, 7N, 7S
2 1/4" φ	FS-2	3N, 3S, 8N, 8S
2 1/4" φ	ES-1	GN
2 1/4" φ	ES-2	2N, 2S, 4N, 4S
2 1/4" φ	ES-3	4S
2 1/2" φ	FS-3	1N, 1S

All shoe anchor bolts to be threaded 8" and provided with lock washer and three hex nuts.


ANCHOR BOLT PLAN
No Scale

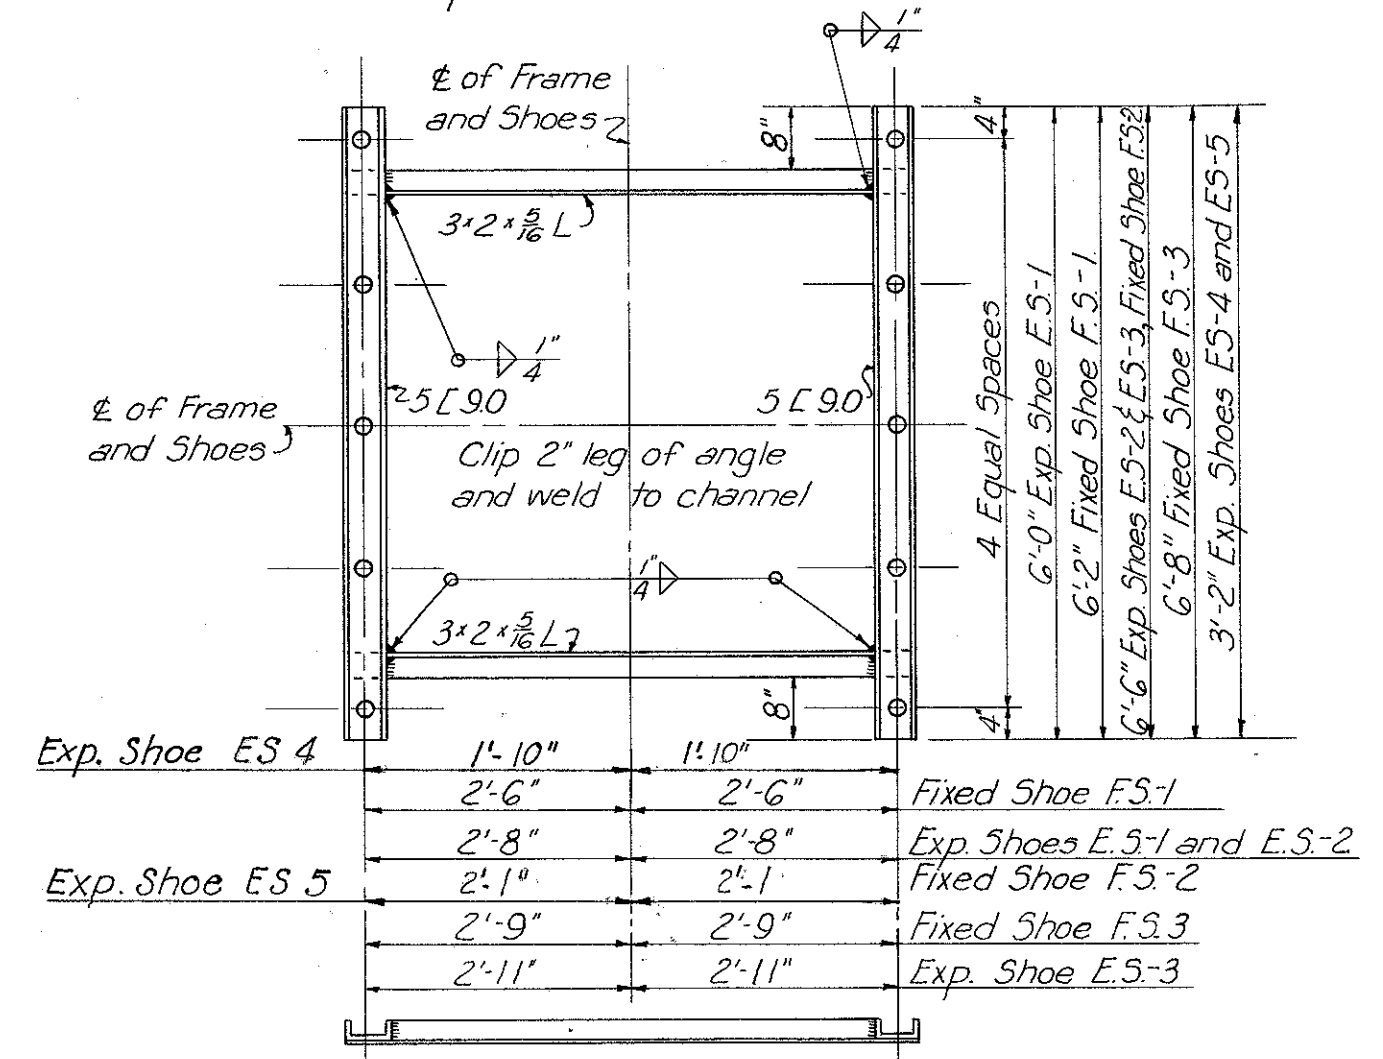

ANCHOR BOLT FRAME
Scale: 1/2" = 1'-0"
Holes in anchor bolt frame to be 1/8" larger than anchor bolt

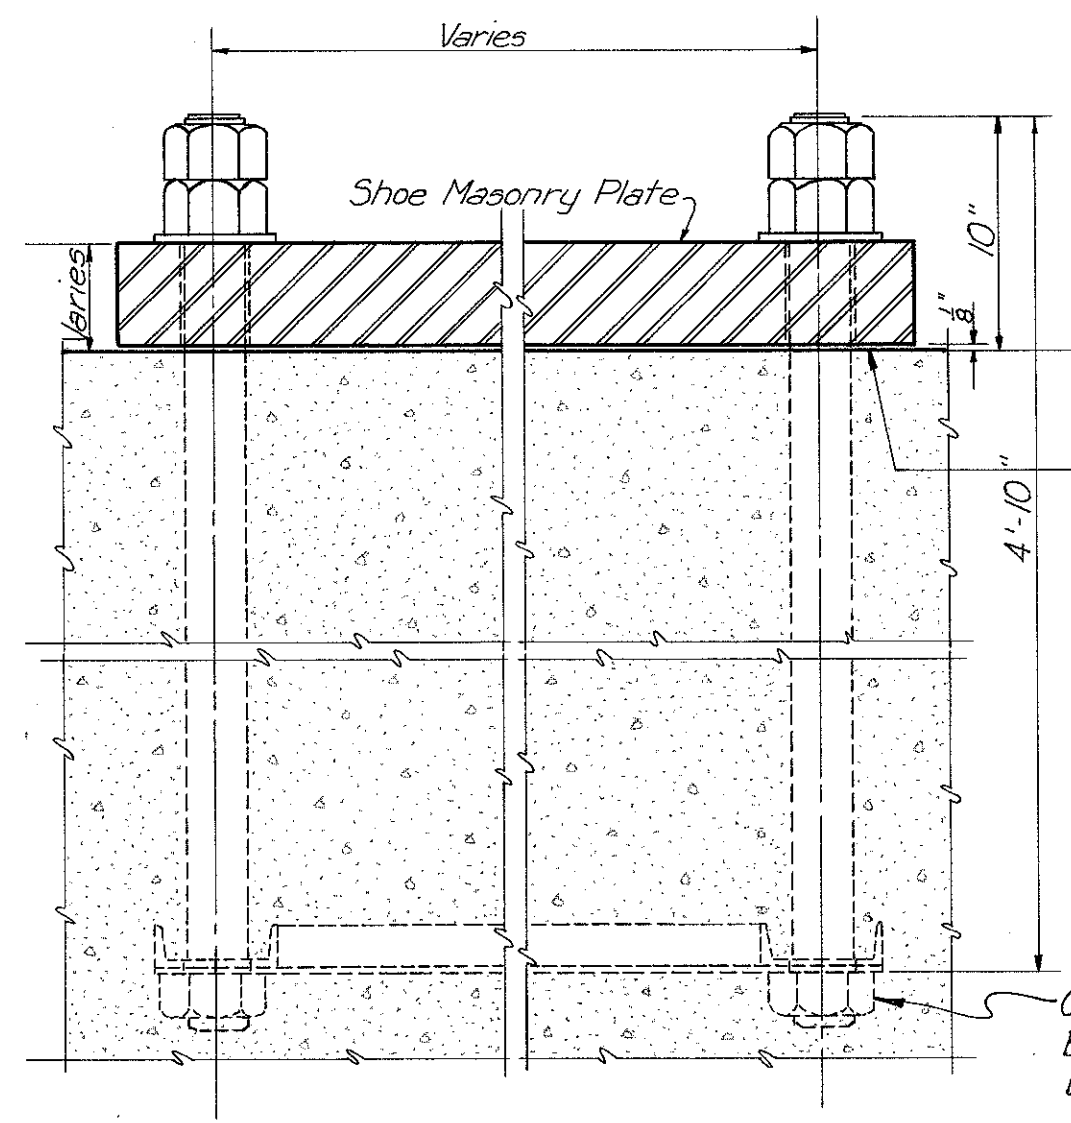

ANCHOR BOLT DETAIL
Scale: 1 1/2" = 1'-0"

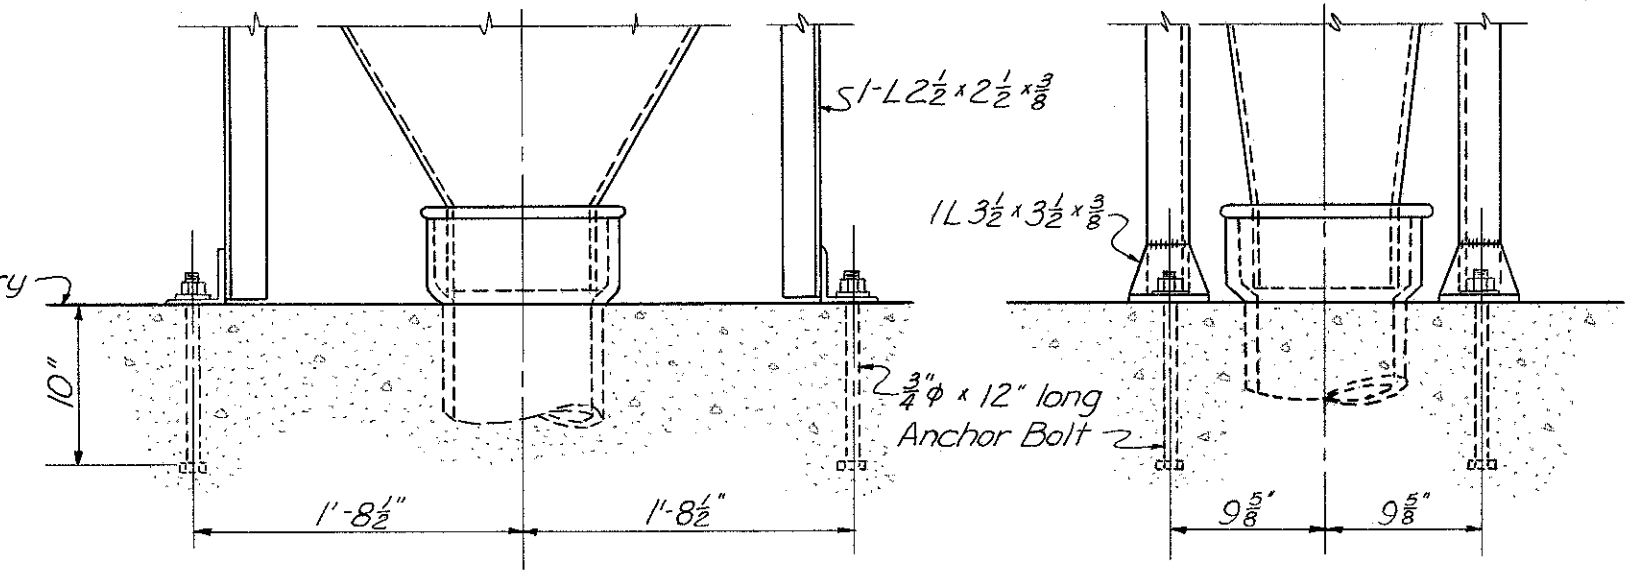

HOPPER ANCHOR BOLT DETAIL
Scale: 1" = 1'-0"

Note: All steel work except anchor bolts by others.

REVISED, DEC. 6, 1954

PART 2


U. S. ROUTE 42 RELOCATION
INNER BELT FREEWAY - CENTRAL VIADUCT

ANCHOR BOLT PLAN
AND DETAILS

CLEVELAND CUYAHOGA COUNTY OHIO

SCALE: As Shown
MADE: 12-1-54 DATE: 3-9-54
TRCD: N.R.M. DATE: 6-4-54
CKD: D.E.R. DATE: 6-28-54
HOWARD, NEEDLES, TAMMEN & BERGENDOFF
CONSULTING ENGINEERS
KANSAS CITY CLEVELAND NEW YORK
914-1A SHEET 1.29

CUYAHOGA COUNTY
CITY OF CLEVELAND
INNER BELT FREEWAY
CENTRAL VIADUCT
CUY-42 R-17.50

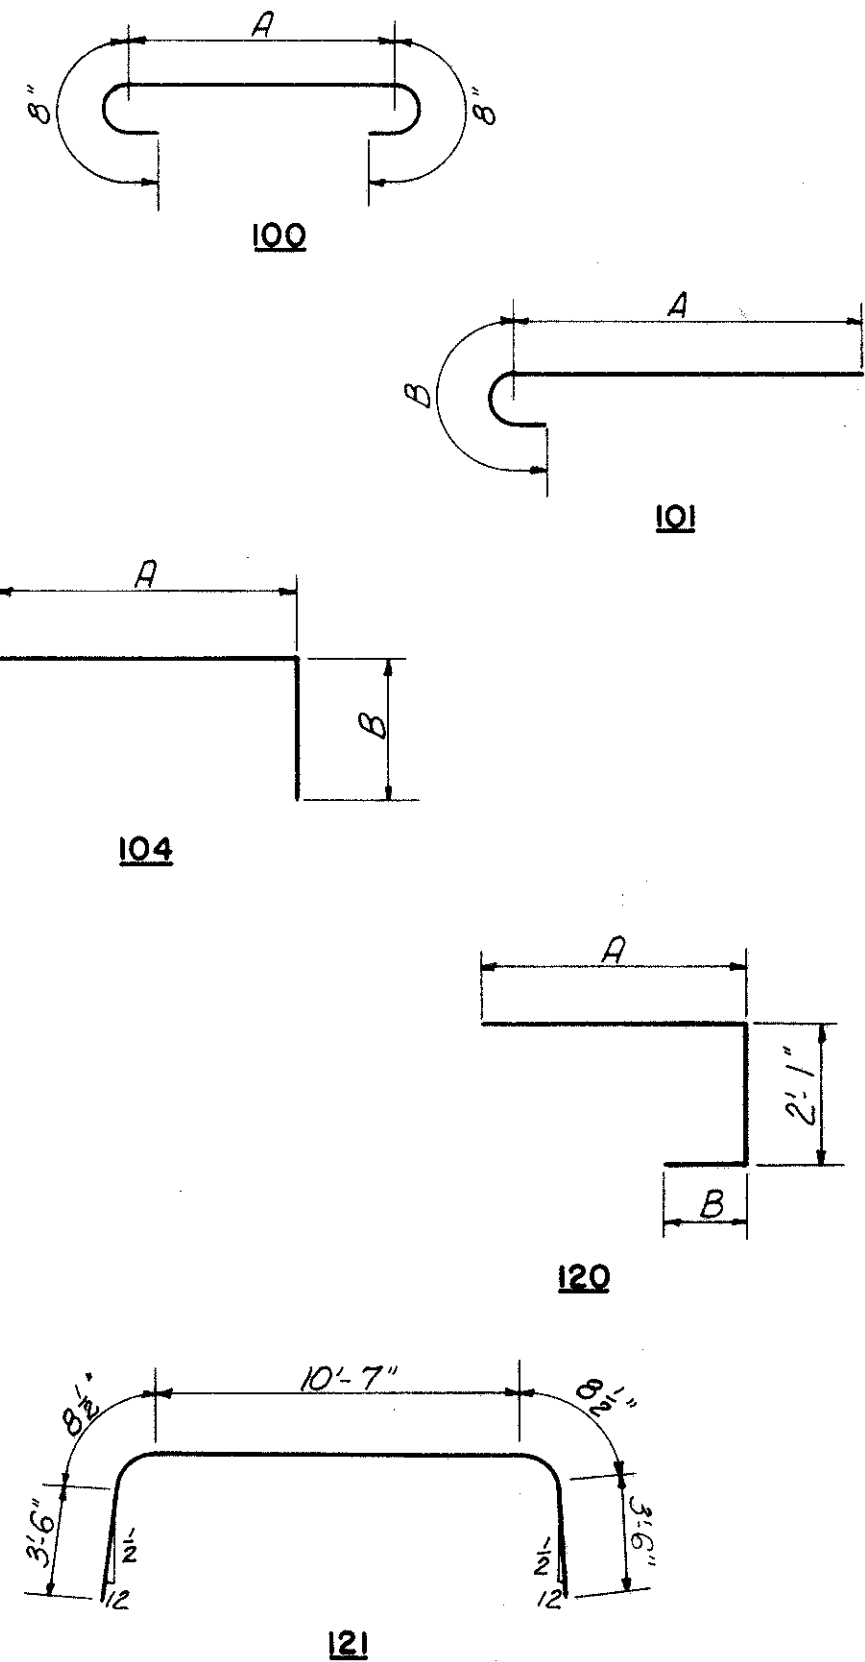

BENDING DIAGRAM

PART 2

U. S. ROUTE 42 RELOCATION
INNER BELT FREEWAY - CENTRAL VIADUCT

REINFORCEMENT SCHEDULE

CLEVELAND CUYAHOGA COUNTY OHIO


SCALE: No. Scale
MADE: 3-9-54
TRCD: 6-1-54
CKD: 6-23-54
HOWARD, NEEDLES, TAMMEN & BERGENOFF
CONSULTING ENGINEERS
KANSAS CITY CLEVELAND NEW YORK
914-1A SHEET: 1.30

MARK	SIZE	NO.	LENGTH	TYPE	DIMENSION A B	WEIGHT LBS.
PIER FOOTING 1-N						
601	6	41	35' - 6"	Str.		2,186
602	6	37	39' - 6"	Str.		2,195
901	9	48	5' - 9"	101	4' - 1" 1'-8"	938
1101	11	82	35' - 6"	Str.		15,466
1102	11	124	39' - 6"	Str.		26,023
1103	11	56	9' - 0"	Str.		2,678
PIER FOOTING 1-S						
601	6	41	35' - 6"	Str.		2,186
602	6	37	39' - 6"	Str.		2,195
901	9	48	5' - 9"	101	4' - 1" 1'-8"	938
1101	11	82	35' - 6"	Str.		15,466
1102	11	124	39' - 6"	Str.		26,023
1103	11	56	9' - 0"	Str.		2,678
PIER FOOTING 2-N						
601	6	74	35' - 6"	Str.		3,946
901	9	48	5' - 9"	101	4' - 1" 1'-8"	938
1101	11	182	35' - 6"	Str.		34,327
1102	11	56	8' - 0"	Str.		2,380
PIER FOOTING 2-S						
601	6	33	39' - 6"	Str.		1,958
602	6	179	31' - 6"	Str.		8,469
901	9	48	5' - 9"	101	4' - 1" 1'-8"	938
1101	11	110	39' - 6"	Str.		23,085
1102	11	56	9' - 0"	Str.		2,678
PIER FOOTING 3-N						
601	6	37	39' - 6"	Str.		2,195
602	6	41	35' - 6"	Str.		2,186
901	9	48	5' - 9"	101	4' - 1" 1'-8"	938
1101	11	108	39' - 6"	Str.		22,665
1102	11	70	35' - 6"	Str.		13,203
1103	11	56	9' - 0"	Str.		2,678
PIER FOOTING 3-S						
601	6	37	39' - 6"	Str.		2,195
602	6	41	35' - 6"	Str.		2,186
901	9	48	5' - 9"	101	4' - 1" 1'-8"	938
1101	11	108	39' - 6"	Str.		22,665
1102	11	70	35' - 6"	Str.		13,203
1103	11	56	9' - 0"	Str.		2,678
PIER FOOTING 4-N						
601	6	74	35' - 6"	Str.		3,946
901	9	48	5' - 9"	101	4' - 1" 1'-8"	938
1101	11	182	35' - 6"	Str.		34,327
1102	11	56	8' - 0"	Str.		2,380
PIER FOOTING 4-S						
601	6	41	35' - 6"	Str.		2,186
602	6	37	39' - 6"	Str.		2,195
901	9	48	5' - 9"	101	4' - 1" 1'-8"	938
1101	11	70	35' - 6"	Str.		13,203
1102	11	116	39' - 6"	Str.		24,344
1103	11	56	9' - 0"	Str.		2,678

MARK	SIZE	NO.	LENGTH	TYPE	DIMENSION A B	WEIGHT LBS.
PIER FOOTING 5-N						
601	6	74	35' - 6"	Str.		3,946
901	9	48	5' - 9"	101	4' - 1" 1'-8"	938
1101	11	182	35' - 6"	Str.		34,327
1102	11	56	8' - 0"	Str.		2,380
PIER FOOTING 5-S						
601	6	41	35' - 6"	Str.		2,186
602	6	37	39' - 6"	Str.		2,195
901	9	48	5' - 9"	101	4' - 1" 1'-8"	938
1101	11	70	35' - 6"	Str.		13,203
1102	11	116	39' - 6"	Str.		24,344
1103	11	56	9' - 0"	Str.		2,678
PIER FOOTING 6-N						
601	6	74	35' - 6"	Str.		3,946
901	9	48	5' - 9"	101	4' - 1" 1'-8"	938
1101	11	182	35' - 6"	Str.		34,327
1102	11	56	8' - 0"	Str.		2,380
PIER FOOTING 6-S						
601	6	74	35' - 6"	Str.		3,946
901	9	48	5' - 9"	101	4' - 1" 1'-8"	938
1101	11	182	35' - 6"	Str.		34,327
1102	11	56	8' - 0"	Str.		2,380
PIER FOOTING 7-N						
601	6	74	35' - 6"	Str.		3,946
901	9	48	5' - 9"	101	4' - 1" 1'-8"	938
1101	11	182	35' - 6"	Str.		34,327
1102	11	56	8' - 0"	Str.		2,380
PIER FOOTING 7-S						
601	6	41	35' - 6"	Str.		2,186
602	6	37	39' - 6"	Str.		2,195
901	9	48	5' - 9"	101	4' - 1" 1'-8"	938
1101	11	70	35' - 6"	Str.		13,203
1102	11	116	39' - 6"	Str.		24,344
1103	11	56	9' - 0"	Str.		2,678
PIER FOOTING 8-N						
601	6	74	35' - 6"	Str.		3,946
901	9	48	5' - 9"	101	4' - 1" 1'-8"	938
1101	11	196	35' - 6"	Str.		36,969
1102	11	56	9' - 0"	Str.		2,678
PIER FOOTING 8-S						
601	6	74	35' - 6"	Str.		3,946
901	9	48	5' - 9"	101	4' - 1" 1'-8"	938
1101	11	196	35' - 6"	Str.		36,969
1102	11	56	9' - 0"	Str.		2,678

MARK	SIZE	NO.	LENGTH	TYPE	DIMENSIONS		WEIGHT LBS.
					A	B	
PIER SHAFT 8N							
401	4	505	3' - 3"	100	1' - 11"		1,097
402	4	216	3' - 4"	100	2' - 0"		481
501	5	28	16' - 7"	104	14' - 2"	2'-5"	484
502	5	28	15' - 11"	104	13' - 6"	2'-5"	464
503	5	24	15' - 1"	104	12' - 8"	2'-5"	378
504	5	24	14' - 4"	104	11' - 11"	2'-5"	359
513	5	8	7' - 4"	104	4' - 11"	2'-5"	61
506	5	28	13' - 6"	Str.			394
507	5	28	12' - 9"	Str.			372
508	5	24	12' - 6"	Str.			300
509	5	24	11' - 3"	Str.			282
514	5	8	8' - 5"	120	4' - 5"	1'-11"	70
601	6	40	13' - 8"	104	11' - 2"	2'-6"	821
602	6	14	7' - 0"	Str.			147
603	6	40	6' - 0"	Str.			360
604	6	4	11' - 0"	Str.			66
901	9	45	24' - 9"	Str.			3,787
902	9	39	17' - 0"	Str.			2,555
903	9	1	11' - 9"	Str.			40
904	9	3	21' - 6"	Str.			219
905	9	8	11' - 0"	Str.			299
906	9	16	5' - 9"	Str.			313
907	9	8	8' - 6"	Str.			231
1101	11	34	12' - 0"	Str.			2,168
1102	11	20	19' - 0"	121			2,019
1103	11	53	25' - 6"	Str.			7,181
1104	11	3	21' - 9"	Str.			387
1105	11	47	19' - 6"	Str.			4,870
1106	11	1	14' - 3"	Str.			75
PIER SHAFT 8S							
401	4	505	3' - 3"	100	1' - 11"		1,097
402	4	216	3' - 4"	100	2' - 0"		481
501	5	28	16' - 7"	104	14' - 2"	2'-5"	484
502	5	28	15' - 11"	104	13' - 6"	2'-5"	464
503	5	24	15' - 1"	104	12' - 8"	2'-5"	378
504	5	24	14' - 4"	104	11' - 11"	2'-5"	359
513	5	8	7' - 4"	104	4' - 11"	2'-5"	61
506	5	28	13' - 6"	Str.			394
507	5	28	12' - 9"	Str.			372
508	5	24	12' - 0"	Str.			300
509	5	24	11' - 3"	Str.			282
514	5	8	8' - 5"	120	4' - 5"	1'-11"	70
601	6	40	13' - 8"	104	11' - 2"	2'-6"	821
602	6	14	7' - 0"	Str.			147
603	6	40	6' - 0"	Str.			360
604	6	4	11' - 0"	Str.			66
901	9	45	24' - 9"	Str.			3,787
902	9	39	17' - 0"	Str.			2,555
903	9	1	11' - 9"	Str.			40
904	9	3	21' - 6"	Str.			219
905	9	8	11' - 0"	Str.			299
906	9	16	5' - 9"	Str.			313
907	9	8	8' - 6"	Str.			231
1101	11	34	12' - 0"	Str.			2,168
1102	11	20	19' - 0"	121			2,019
1103	11	53	25' - 6"	Str.			7,181
1104	11	3	21' - 9"	Str.			387
1105	11	47	19' - 6"	Str.			4,870
1106	11	1	14' - 3"	Str.			75

CUYAHOGA COUNTY
CITY OF CLEVELAND
INNER BELT FREEWAY
CENTRAL VIADUCT
CUY-42 R-17.50

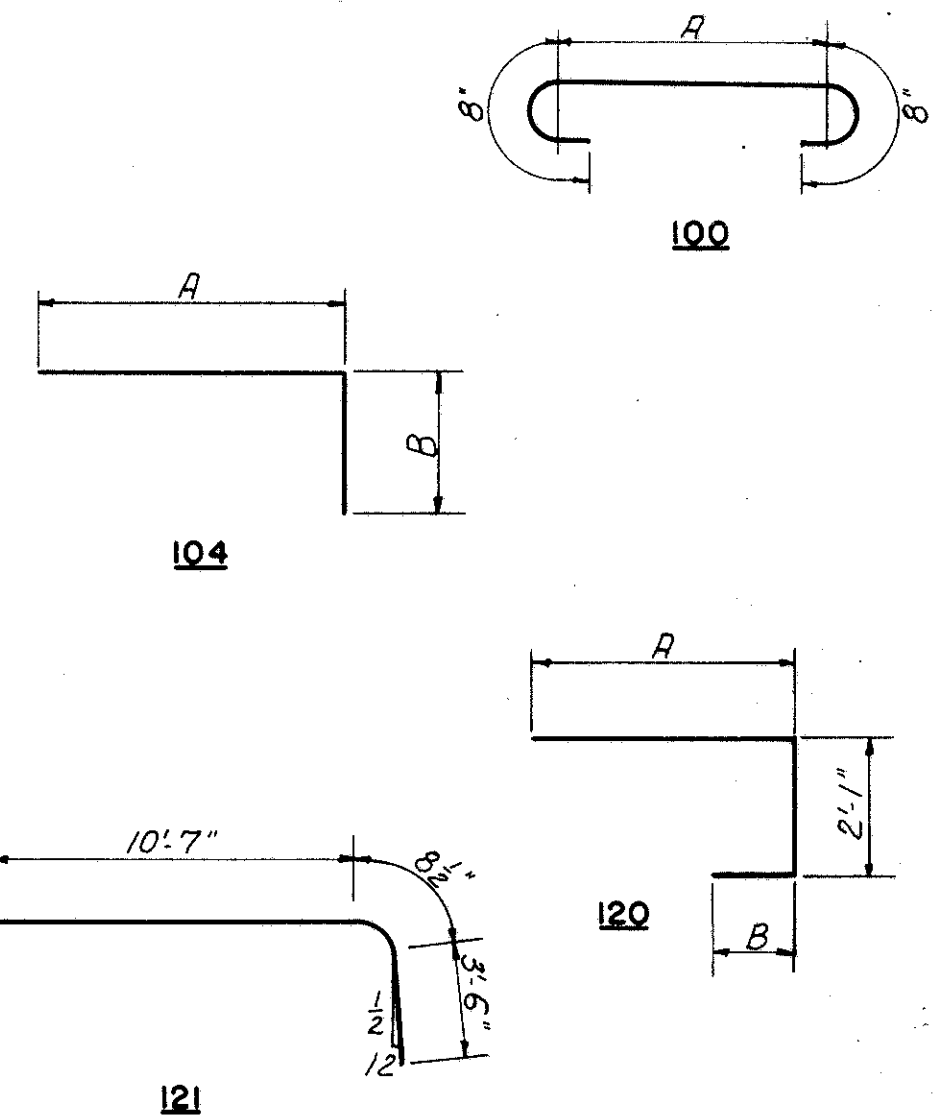

BENDING DIAGRAM

MARK	SIZE	NO.	LENGTH	TYPE	DIMENSIONS		WEIGHT LBS.
					A	B	
PIER SHAFT 1N							
401	4	489	3' - 3"	100	1' - 11"		1,062
402	4	208	3' - 4"	100	2' - 0"		463
501	5	28	16' - 7"	104	14' - 2"	2'-5"	484
502	5	28	15' - 11"	104	13' - 6"	2'-5"	464
503	5	24	15' - 1"	104	12' - 8"	2'-5"	378
504	5	20	14' - 4"	104	11' - 11"	2'-5"	299
513	5	8	7' - 4"	104	4' - 11"	2'-5"	61
506	5	28	13' - 6"	Str.			394
507	5	28	12' - 9"	Str.			372
508	5	24	12' - 0"	Str.			300
509	5	20	11' - 3"	Str.			235
514	5	8	8' - 5"	120	4' - 5"	1'-11"	71
601	6	40	13' - 8"	104	11' - 2"	2'-6"	821
602	6	14	7' - 0"	Str.			147
603	6	40	6' - 0"	Str.			360
604	6	4	11' - 0"	Str.			66
				</			

MARK	SIZE	NO.	LENGTH	TYPE	DIMENSIONS		WEIGHT LBS.
					A	B	
PIER SHAFT 2N							
401	4	702	3' - 3"	100	1' - 11"		1,524
402	4	304	3' - 4"	100	2' - 0"		677
501	5	28	17' - 11"	104	15' - 6"	2'-5"	523
502	5	28	17' - 2"	104	14' - 9"	2'-5"	501
503	5	28	16' - 5"	104	14' - 0"	2'-5"	480
504	5	25	15' - 8"	104	13' - 3"	2'-5"	409
505	5	28	14' - 11"	104	12' - 6"	2'-5"	436
506	5	12	14' - 0"	104	11' - 7"	2'-5"	175
507	5	28	15' - 0"	Str.			438
508	5	28	14' - 3"	Str.			416
509	5	28	13' - 6"	Str.			394
510	5	25	12' - 6"	Str.			326
511	5	28	11' - 9"	Str.			343
512	5	12	11' - 0"	Str.			138
513	5	6	7' - 9"	104	5' - 4"	2'-5"	48
514	5	6	8' - 9"	120	4' - 9"	1'-11"	55
601	6	40	13' - 8"	104	11' - 2"	2'-6"	821
602	6	14	7' - 0"	Str.			147
603	6	40	6' - 0"	Str.			360
604	6	4	11' - 0"	Str.			66
901	9	45	31' - 9"	Str.			4,858
902	9	3	28' - 6"	Str.			291
903	9	39	25' - 0"	Str.			3,315
904	9	1	19' - 9"	Str.			67
905	9	8	11' - 0"	Str.			299
906	9	16	5' - 9"	Str.			313
907	9	8	8' - 6"	Str.			231
1101	11	34	12' - 0"	Str.			2,168
1102	11	20	19' - 0"	121			2,019
1103	11	53	32' - 6"	Str.			9,152
1104	11	3	28' - 9"	Str.			458
1105	11	47	27' - 3"	Str.			6,805
1106	11	1	22' - 3"	Str.			118
PIER SHAFT 2S							
401	4	702	3' - 3"	100	1' - 11"		1,524
402	4	304	3' - 4"	100	2' - 0"		677
501	5	28	17' - 11"	104	15' - 6"	2'-5"	523
502	5	28	17' - 2"	104	14' - 9"	2'-5"	501
503	5	28	16' - 5"	104	14' - 0"	2'-5"	480
504	5	25	15' - 8"	104	13' - 3"	2'-5"	409
505	5	28	14' - 11"	104	12' - 6"	2'-5"	436
506	5	12	14' - 0"	104	11' - 7"	2'-5"	175
507	5	28	15' - 0"	Str.			438
508	5	28	14' - 3"	Str.			416
509	5	28	13' - 6"	Str.			394
510	5	25	12' - 6"	Str.			326
511	5	28	11' - 9"	Str.			343
512	5	12	11' - 0"	Str.			138
513	5	6	7' - 9"	104	5' - 4"	2'-5"	48
514	5	6	8' - 9"	120	4' - 9"	1'-11"	55
601	6	40	13' - 8"	104	11' - 2"	2'-6"	821
602	6	14	7' - 0"	Str.			147
603	6	40	6' - 0"	Str.			360
604	6	4	11' - 0"	Str.			66
901	9	45	31' - 9"	Str.			4,858
902	9	3	28' - 6"	Str.			291
903	9	39	25' - 0"	Str.			3,315
904	9	1	19' - 9"	Str.			67
905	9	8	11' - 0"	Str.			299
906	9	16	5' - 9"	Str.			313
907	9	8	8' - 6"	Str.			231
1101	11	34	12' - 0"	Str.			2,168
1102	11	20	19' - 0"	121			2,019
1103	11	53	32' - 6"	Str.			9,152
1104	11	3	28' - 9"	Str.			458
1105	11	47	27' - 3"	Str.			6,805
1106	11	1	22' - 3"	Str.			118

MARK	SIZE	NO.	LENGTH	TYPE	DIMENSIONS		WEIGHT LBS.
					A	B	
PIER SHAFT 3N							
401	4	718	3' - 3"	100	1' - 11"		1,559
402	4	312	3' - 4"	100	2' - 0"		695
501	5	28	18' - 1"	104	15' - 8"	2'-5"	528
502	5	28	17' - 4"	104	14' - 11"	2'-5"	506
503	5	28	16' - 7"	104	14' - 2"	2'-5"	484
504	5	25	15' - 9"	104	13' - 4"	2'-5"	411
505	5	28	15' - 0"	104	12' - 7"	2'-5"	438
506	5	16	14' - 2"	104	11' - 9"	2'-5"	236
507	5	28	15' - 0"	Str.			438
508	5	28	14' - 3"	Str.			416
509	5	28	13' - 6"	Str.			394
510	5	25	12' - 9"	Str.			332
511	5	28	12' - 0"	Str.			350
512	5	16	11' - 3"	Str.			188
513	5	6	7' - 10"	104	5' - 5"	2'-5"	49
514	5	6	8' - 11"	120	4' - 11"	1'-11"	56
601	6	40	13' - 8"	104	11' - 2"	2'-6"	821
602	6	14	7' - 0"	Str.			147
603	6	40	6' - 0"	Str.			360
604	6	4	11' - 0"	Str.			66
901	9	45	31' - 9"	Str.			4,858
902	9	3	28' - 6"	Str.			291
903	9	39	26' - 6"	Str.			3,514
904	9	1	21' - 3"	Str.			72
905	9	8	11' - 0"	Str.			299
906	9	16	5' - 9"	Str.			313
907	9	8	8' - 6"	Str.			231
1101	11	34	12' - 0"	Str.			2,168
1102	11	20	19' - 0"	121			2,019
1103	11	53	32' - 6"	Str.			9,152
1104	11	3	28' - 9"	Str.			458
1105	11	47	28' - 9"	Str.			7,179
1106	11	1	23' - 6"	Str.			125
PIER SHAFT 3S							
401	4	718	3' - 3"	100	1' - 11"		1,559
402	4	312	3' - 4"	100	2' - 0"		695
501	5	28	18' - 1"	104	15' - 8"	2'-5"	528
502	5	28	17' - 4"	104	14' - 11"	2'-5"	506
503	5	28	16' - 7"	104	14' - 2"	2'-5"	484
504	5	25	15' - 9"	104	13' - 4"	2'-5"	411
505	5	28	15' - 0"	104	12' - 7"	2'-5"	438
506	5	16	14' - 2"	104	11' - 9"	2'-5"	236
507	5	28	15' - 0"	Str.			438
508	5	28	14' - 3"	Str.			416
509	5	28	13' - 6"	Str.			394
510	5	25	12' - 9"	Str.			332
511	5	28	12' - 0"	Str.			350
512	5	16	11' - 3"	Str.			188
513	5	6	7' - 10"	104	5' - 5"	2'-5"	49
514	5	6	8' - 11"	120	4' - 11"	1'-11"	56
601	6	40	13' - 8"	104	11' - 2"	2'-6"	821
602	6	14	7' - 0"	Str.			147
603	6	40	6' - 0"	Str.			360
604	6	4	11' - 0"	Str.			66
901	9	45	31' - 9"	Str.			4,858
902	9	3	28' - 6"	Str.			291
903	9	39	26' - 6"	Str.			3,514
904	9	1	21' - 3"	Str.			72
905	9	8	11' - 0"	Str.			299
906	9	16	5' - 9"	Str.			313
907	9	8	8' - 6"	Str.			231
1101	11	34	12' - 0"	Str.			2,168
1102	11	20	19' - 0"	121			2,019
1103	11	53	32' - 6"	Str.			9,152
1104	11	3	28' - 9"	Str.			458
1105	11	47	28' - 9"	Str.			7,179
1106	11	1	23' - 6"	Str.			125

RECEIVED
FEB 25 1954

FED. ROAD DIV. NO.	STATE	FEDERAL AID PROJECT NO.	TYPE FUNDS
2	OHIO	UI 1057 (4)	

32
43

CUYAHOGA COUNTY
CITY OF CLEVELAND
INNER BELT FREEWAY
CENTRAL VIADUCT
CUY - 42 R - 17.50

MARK	SIZE	NO.	LENGTH	TYPE	DIMENSIONS		WEIGHT LBS.
					A	B	
WEST END PIER FOOTING WN							
601	6	29	23'-6"	Str.			1024
602	6	25	27'-6"	Str.			1033
801	8	68	5'-6"	Str.			999
802	8	50	5'-0"	101			668
	</						

MARK	SIZE	NO.	LENGTH	TYPE	DIMENSIONS		WEIGHT LBS.
					A	B	
WEST END PIER FOOTING WS							
601	6	29	23'-6"	Str.			1024
602	6	25	27'-6"	Str.			1033
801	8	68	5'-6"	Str.			999
802	8	50	5'-0"	101			668
</							

MARK	SIZE	NO.	LENGTH	TYPE	DIMENSIONS		WEIGHT LBS.
					A	B	
EAST END PIER FOOTING EN							
601	6	29	23'-6"	Str.			1024
602	6	25	27'-6"	Str.			1033
801	8	68	5'-6"	Str.			999
802	8	50	5'-0"	101			668
</							



MARK	SIZE	NO.	LENGTH	TYPE	DIMENSIONS		WEIGHT LBS.
					A	B	
EAST END PIER FOOTING ES							
601	6	33	23'-6"	Str.			1165
801	8	68	5'-6"	Str.			999
802	8	50	5'-0"	101			668
1001	10	36	31'-6"	Str.			4880

CUYAHOGA COUNTY
CITY OF CLEVELAND
INNER BELT FREEWAY
CENTRAL VIADUCT
CUY-42R-17.50

STORM SEWER DATA				
Location	Size	Class	Length	
WS End Pier to M.H. #13	12	A	77	
M.H. #13 to M.H. "A"	12	A	50	
Pier 15 to M.H. "B"	12	A	115	
Pier 1N to M.H. "B"	12	A	39	
Manhole "C" to Dock Line	36	C	30	
Outlet Structure "A" to M.H. #1	27	D	80	
Pier 2N to M.H. #1	12	A	39	
Pier 2S to M.H. #1	12	A	29	
M.H. #1 to M.H. #2	24	C	250	
Pier 3N to M.H. #2	12	A	39	
Pier 3S to M.H. #2	15	C	29	
M.H. #2 to M.H. #3	24	A	370	
Pier 4N to M.H. #3	12	A	30	
Pier 4S to M.H. #3	12	A	71	
M.H. #3 to M.H. #4	15	A	180	
Pier 5N to M.H. #4	12	A	34	
Pier 5S to M.H. #4	15	C	34	
Outlet Structure "B" to M.H. #11	24	D	60	90
M.H. #11 to M.H. #16	24	B	116	84
M.H. #16 to M.H. #10	24	A	240	
M.H. #10 to M.H. #9	24	A	322	
M.H. #9 to M.H. #8	12	B	140	
M.H. #8 to M.H. #12	12	A	55	
M.H. #12 to Pier 6N	12	A	78	
M.H. #9 to M.H. #5	21	A	142	
M.H. #5 to Pier 7N	12	A	62	
M.H. #5 to Pier 7S	12	A	40	
M.H. #5 to M.H. #6	15	C	165	
M.H. #6 to Pier 8N	12	A	109	
M.H. #6 to Pier 8S	12	A	109	
M.H. "D" to M.H. #7	12	A	240	
M.H. #7 to EN End Pier	12	A	92	
M.H. #7 to ES End Pier	12	A	25	
M.H. #14 to M.H. #15	12	B	54	
M.H. #15 to M.H. "F"	12	B	57	
Replacement at Pier 7N	18	B	80	
WN End Pier to M.H. #13	8	A	3	
Pier 6S to M.H. #12	8	A	3	


Class "C" Extra Strength Reinforced Concrete Culvert Pipe, Sec. M-6.6(c) for Storm Sewers.
Class "D" Paved Bituminous Coated Corrugated Metal Pipe, Sec. M-6.4(d) for Storm Sewers. 12 Gage for both 24" and 27" diameter.
Class "A" Pipe for Storm Sewers.
Class "B" Pipe for Storm Sewers under Pavement.

PENCIL REVISIONS
SEPT. 20, 1955

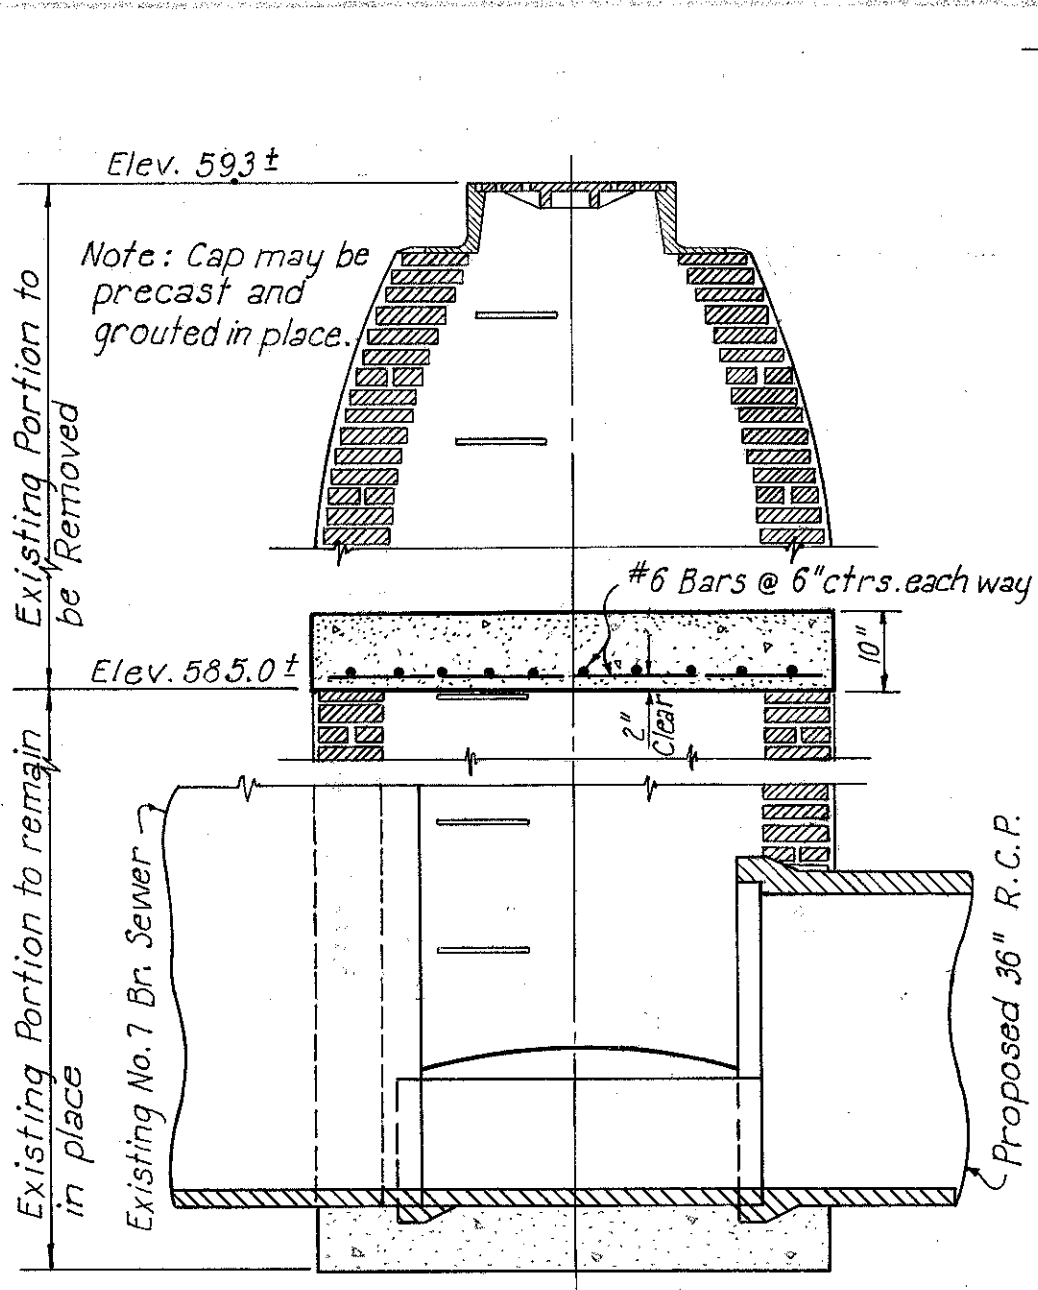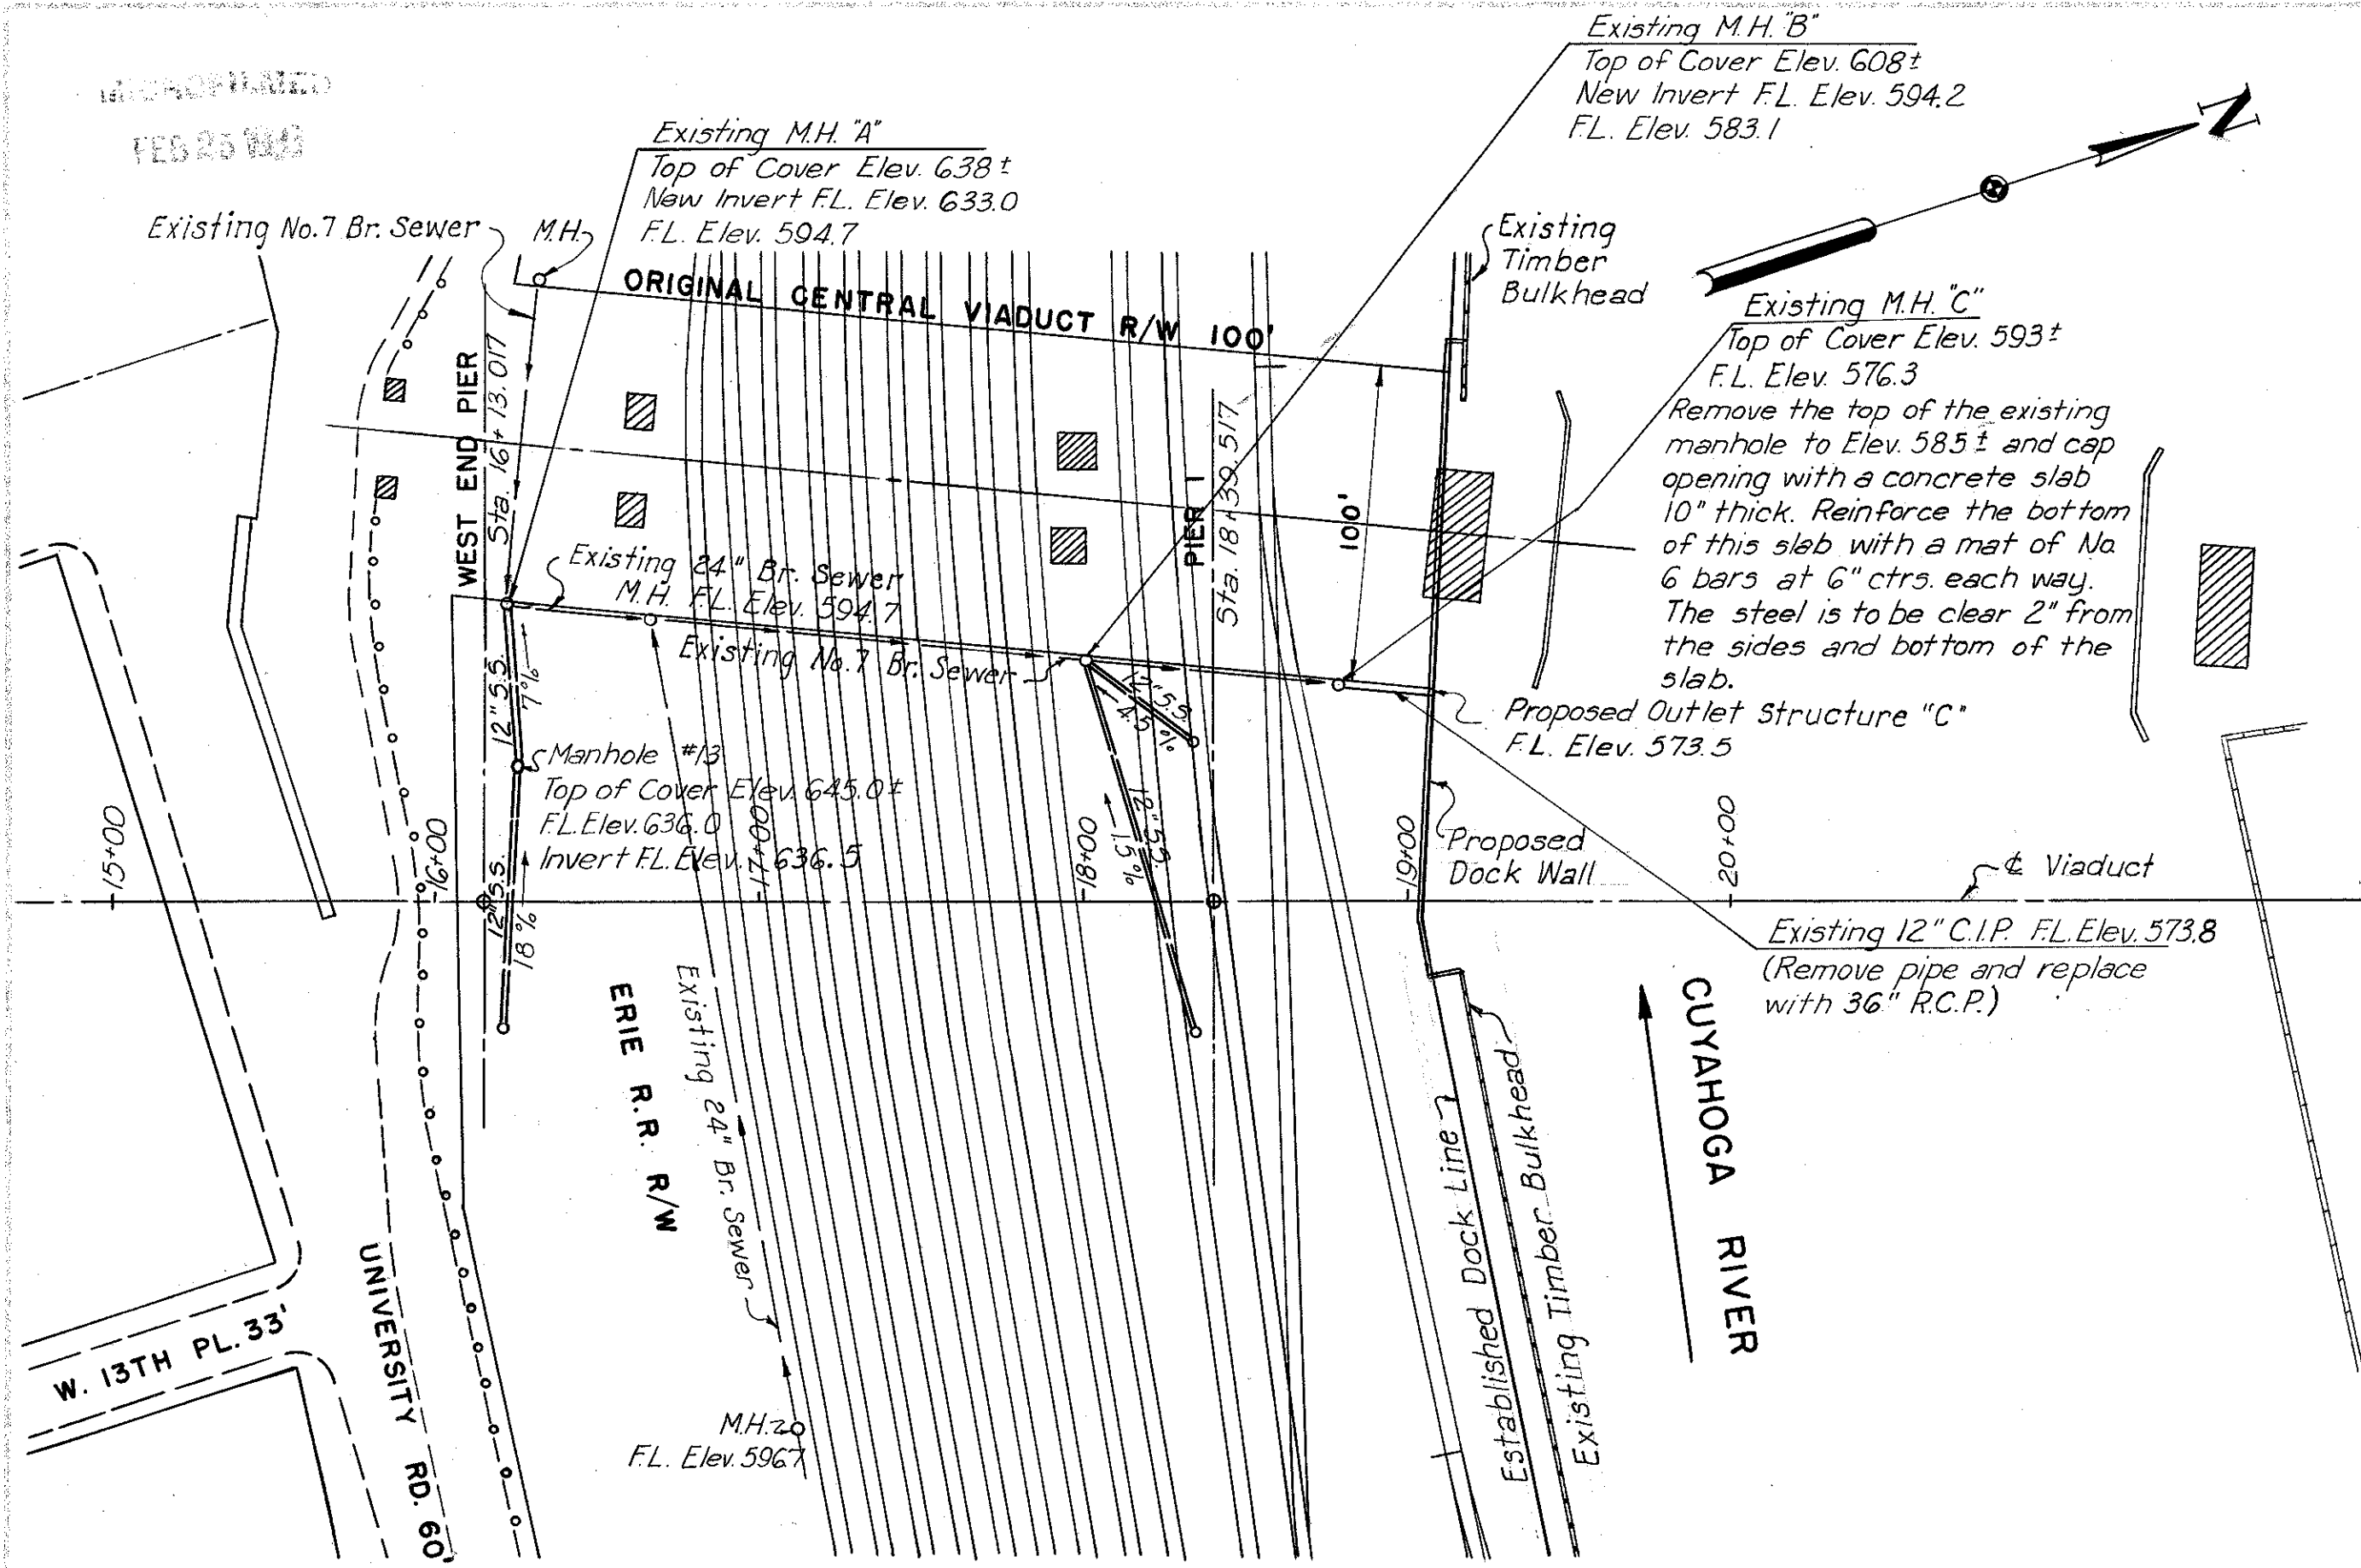


DETAILS OF ALTERATIONS TO
EXISTING MANHOLE "C"

No scale

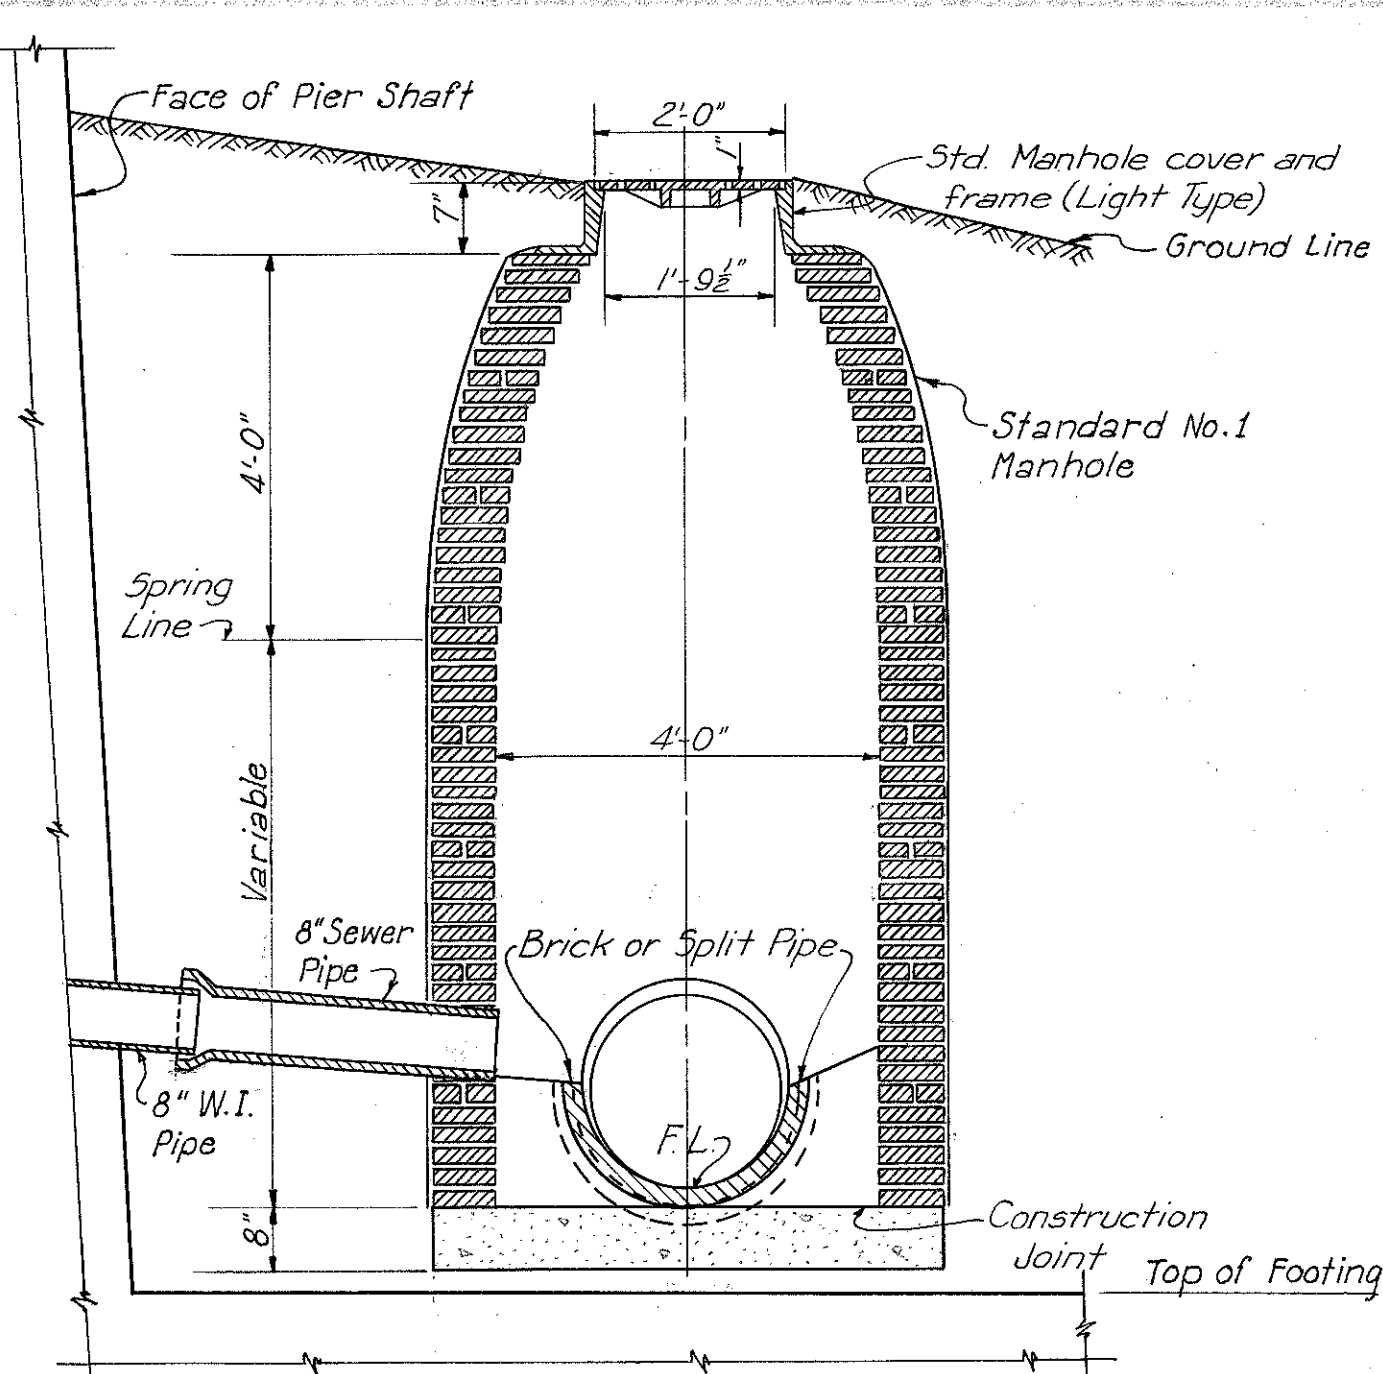



DETAILS OF DOWNPIPE CONNECTION
AT MANHOLES NO. 12 AND NO. 13

No scale

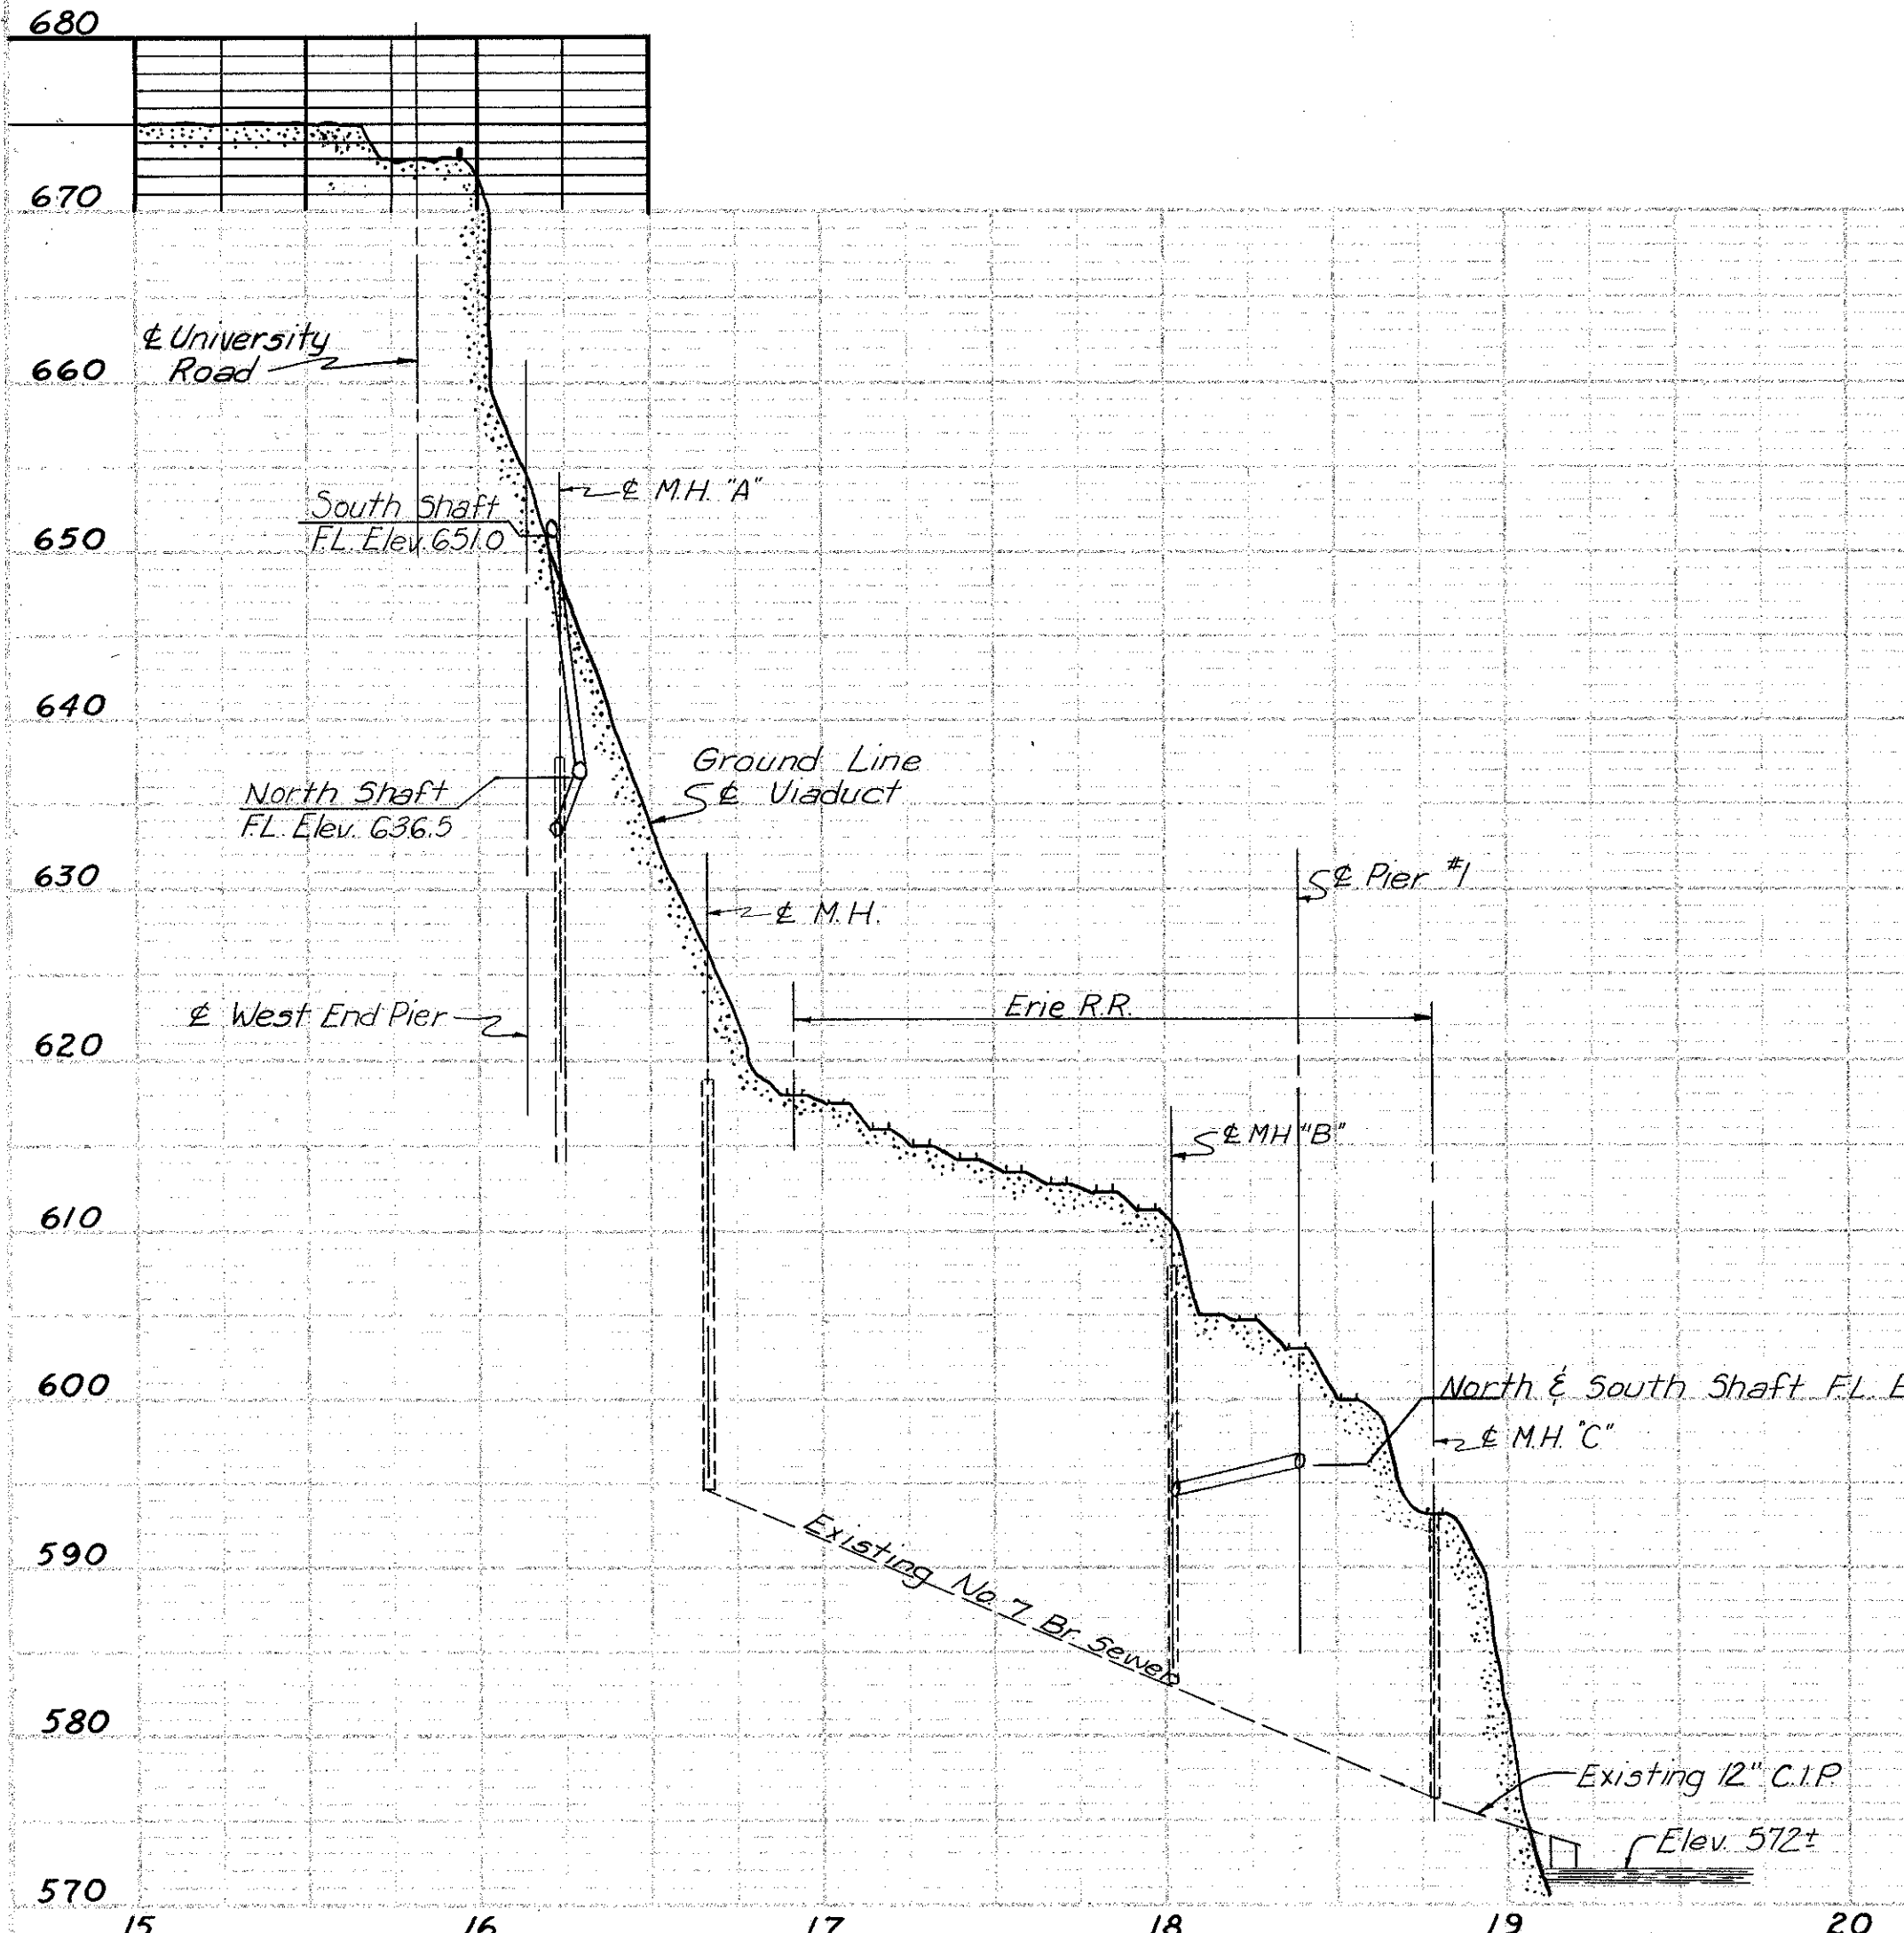

FED. ROAD DIV. NO.	STATE	FEDERAL AID PROJECT NO.	TYPE FUNDS	34
2	OHIO	UI 1057 (4)		43

CUYAHOGA COUNTY
CITY OF CLEVELAND
INNER BELT FREEWAY
CENTRAL VIADUCT
CUY - 42 R - 17.50

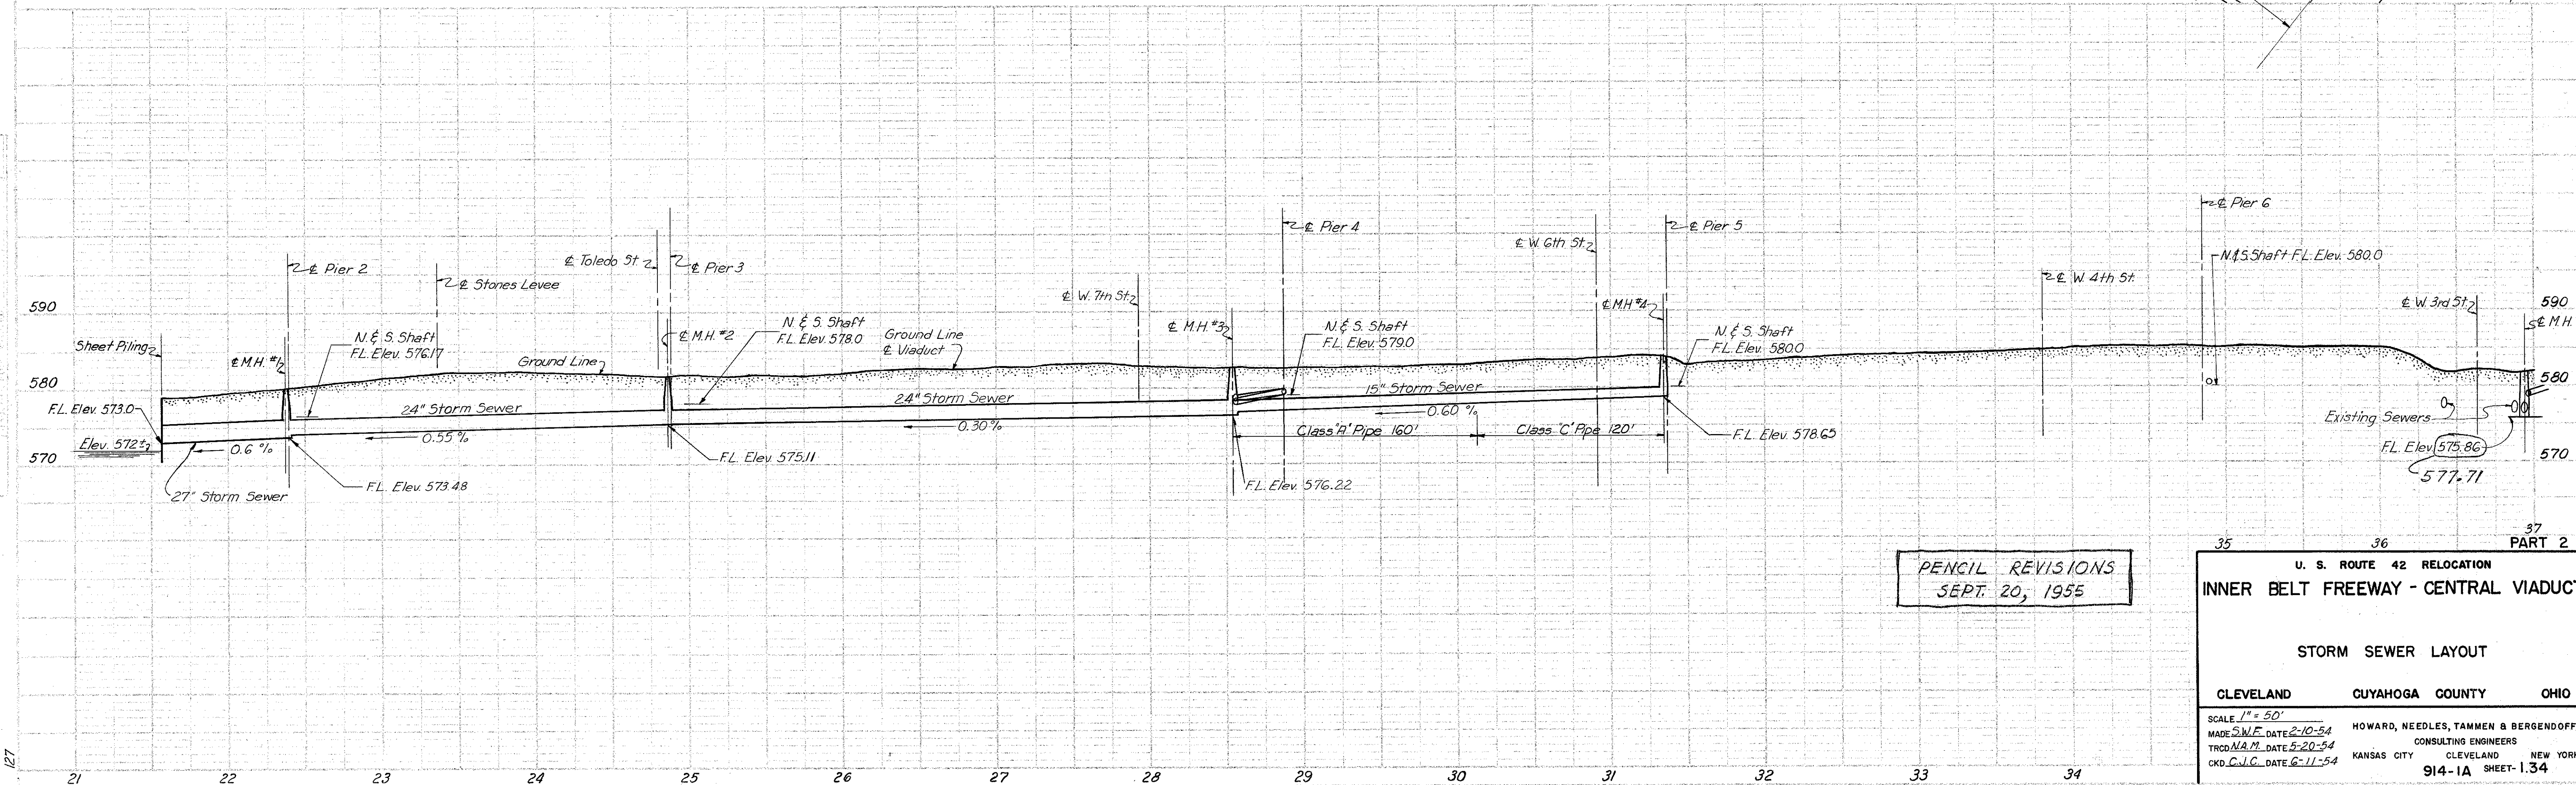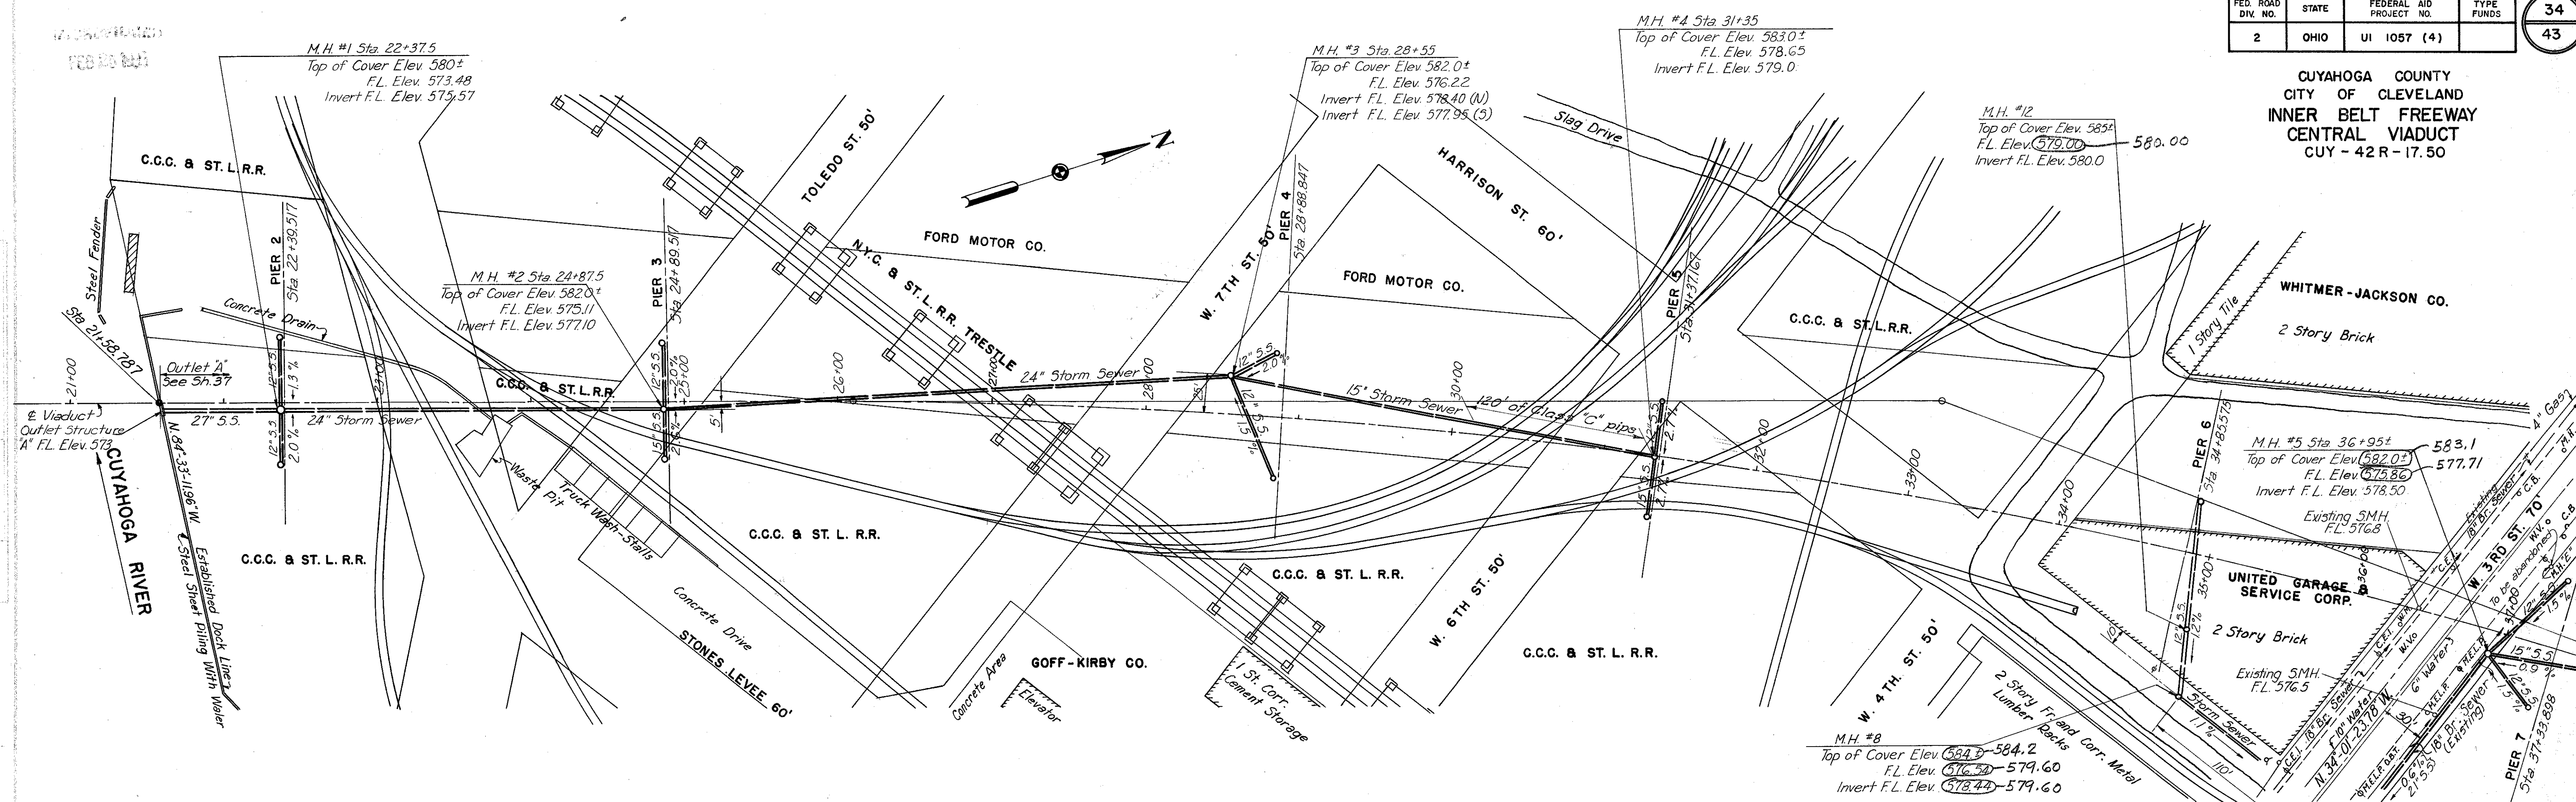

PENCIL REVISIONS
SEPT. 20, 1955

U. S. ROUTE 42 RELOCATION
INNER BELT FREEWAY - CENTRAL VIADUCT

STORM SEWER LAYOUT

CLEVELAND CUYAHOGA COUNTY OHIO

SCALE 1" = 50'

MADE S.W.E. DATE 2-10-54
TRCD N.A.M. DATE 5-20-54
CKD C.J.C. DATE 6-11-54

HOWARD, NEEDLES, TAMMEN & BERGENDOFF
CONSULTING ENGINEERS
KANSAS CITY CLEVELAND NEW YORK

914-1A SHEET-134

FED. ROAD DIV. NO.	STATE	FEDERAL AID PROJECT NO.	TYPE FUNDS
2	OHIO	UI 1057 (4)	



35
43

CUYAHOGA COUNTY
CITY OF CLEVELAND
INNER BELT FREEWAY
CENTRAL VIADUCT
CUY - 42 R - 17.50

FORCE ACCOUNT WORK
by The Baltimore and Ohio Railroad Co.

A. Preliminary Engineering Lump Sum
B. Construction Engineering Lump Sum
C. Temporary Supporting Lump Sum

NOTE:
The labor and the furnishing of materials in connection with the temporary and permanent track work as shown on this sheet and as called for in the estimate will be performed by the Baltimore and Ohio Railroad Company by force account.

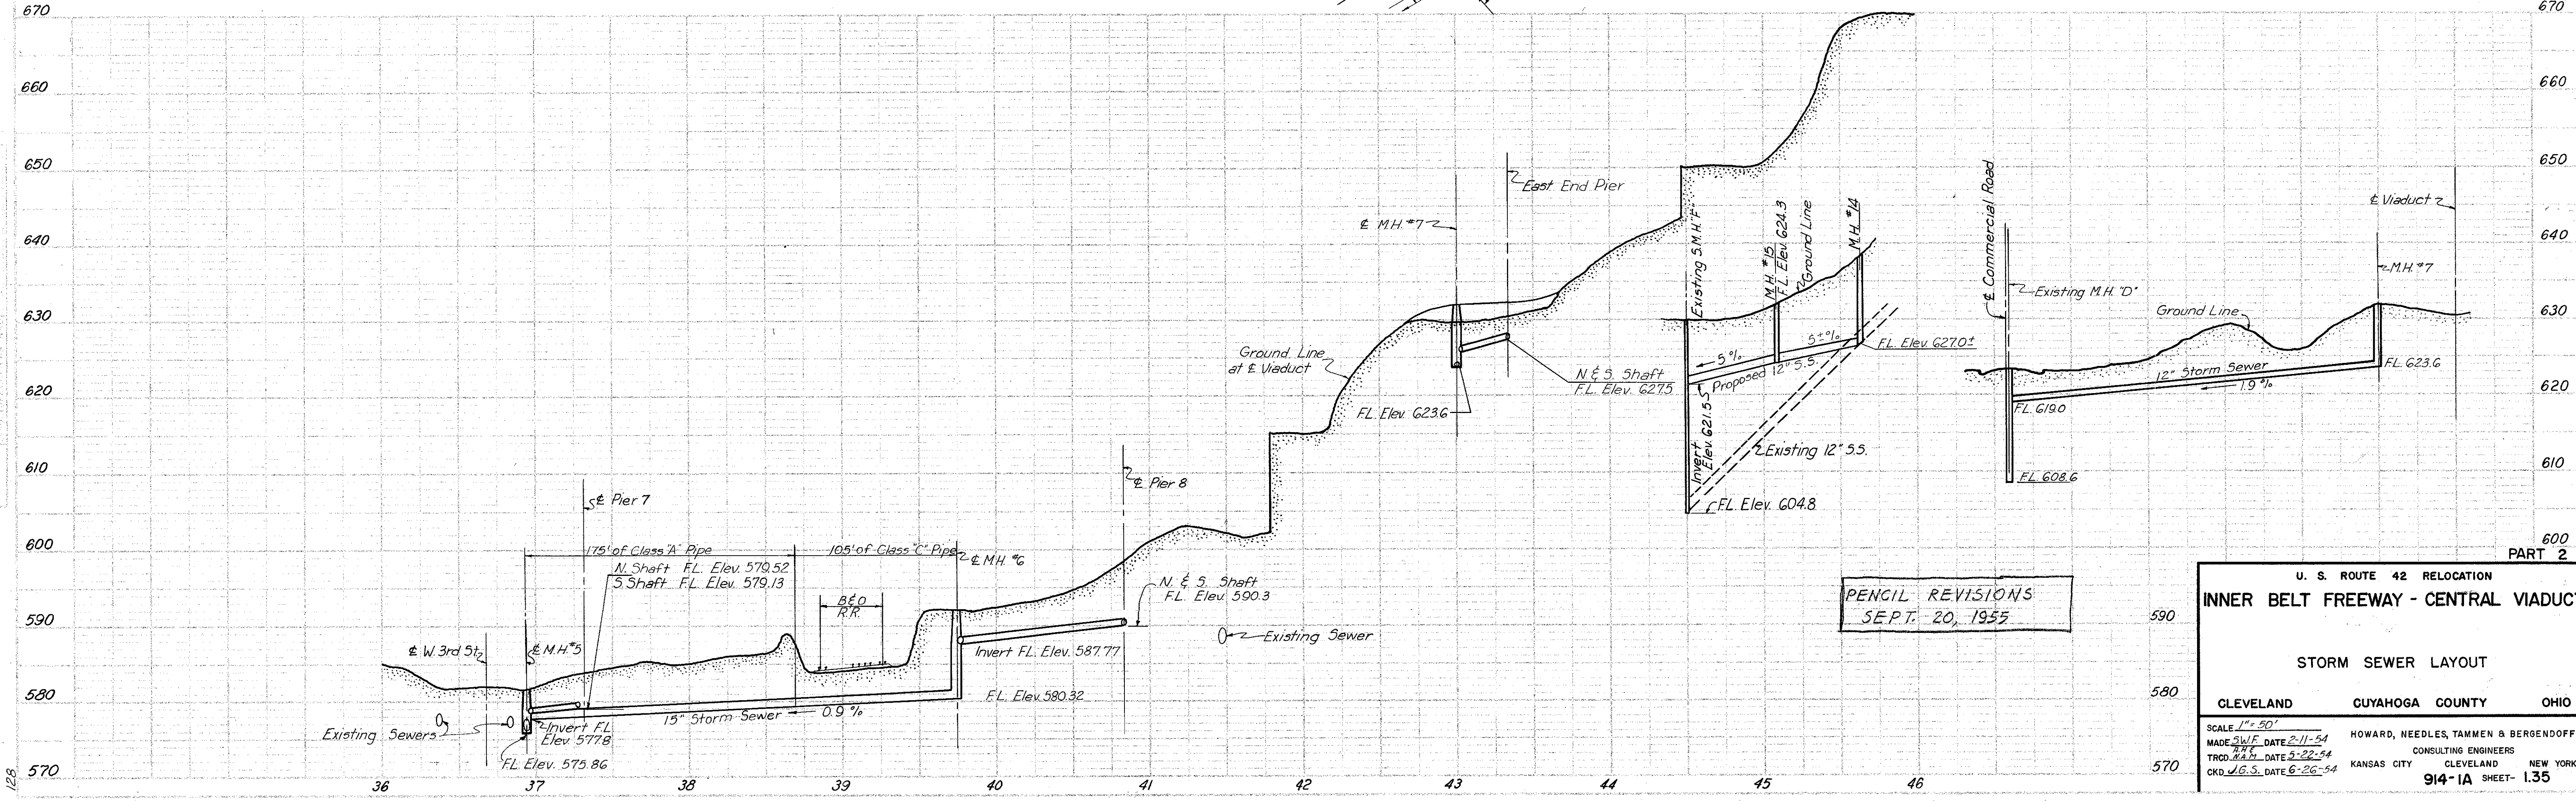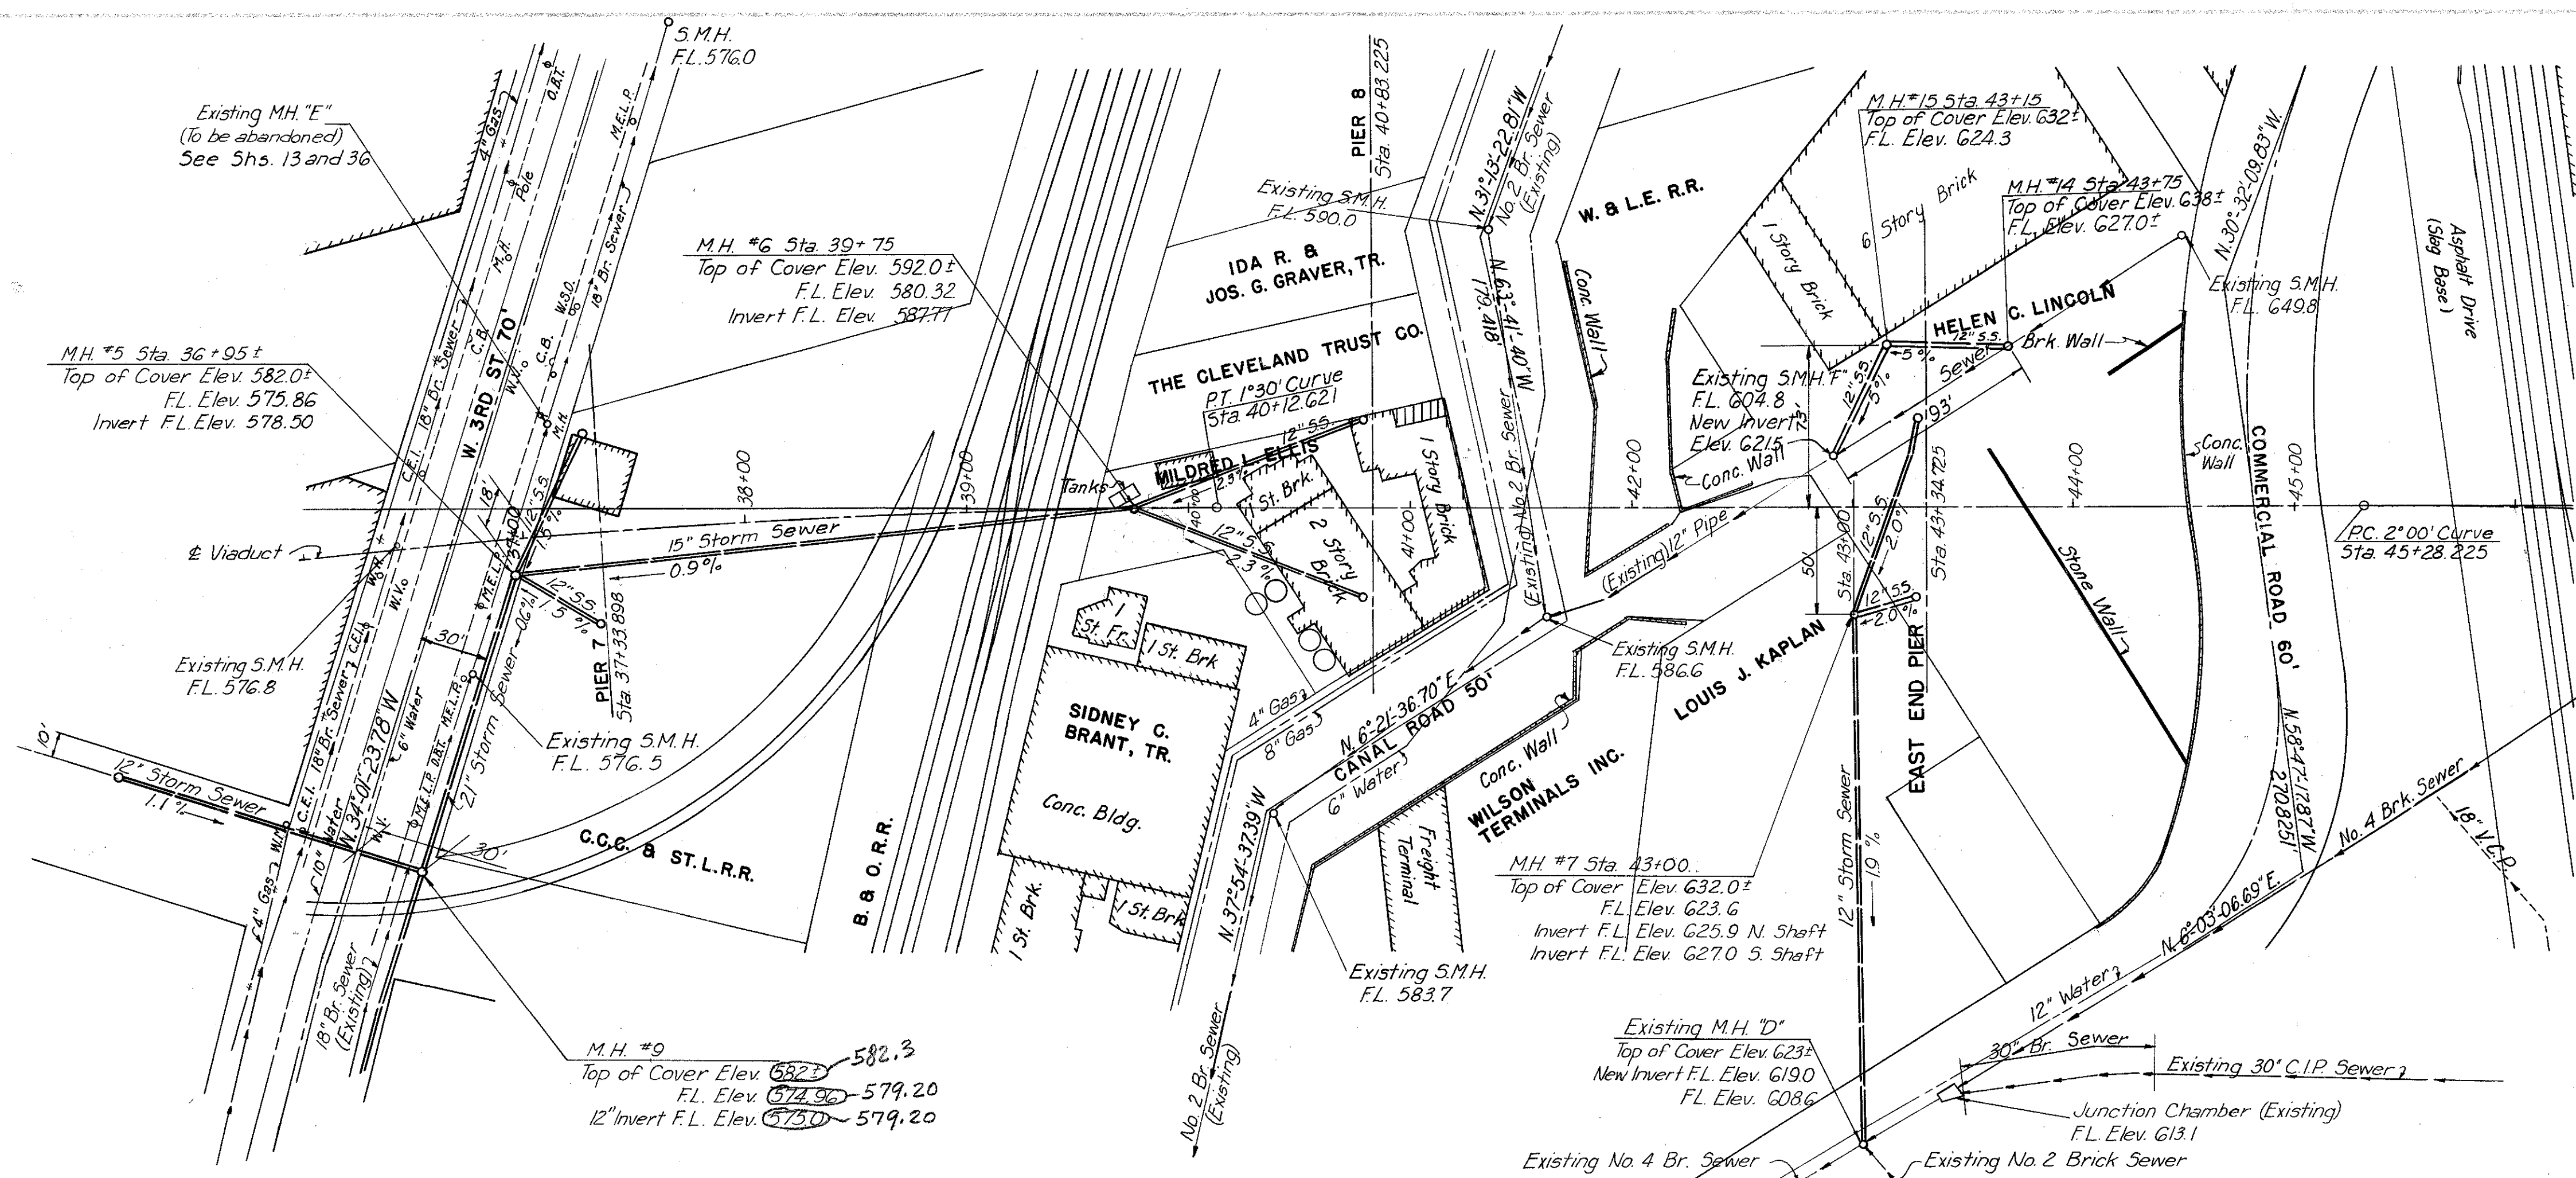

PENCIL REVISIONS
SEPT. 20, 1955

U. S. ROUTE 42 RELOCATION
INNER BELT FREEWAY - CENTRAL VIADUCT

STORM SEWER LAYOUT

CLEVELAND	CUYAHOGA COUNTY	OHIO
-----------	-----------------	------


SCALE 1" = 50'
MADE BY DATE 2-11-54
TRD. DATE 5-22-54
CKD. DATE 6-26-54

HOWARD, NEEDLES, TAMMEN & BERGENDOFF
CONSULTING ENGINEERS
KANSAS CITY CLEVELAND NEW YORK
914-1A SHEET-1.35


FED. ROAD DIV. NO.	STATE	FEDERAL AID PROJECT NO.	TYPE FUNDS
2	OHIO	UI 1057 (4)	

36
43


CUYAHOGA COUNTY
CITY OF CLEVELAND
INNER BELT FREEWAY
CENTRAL VIADUCT
CUY - 42 R - 17.50

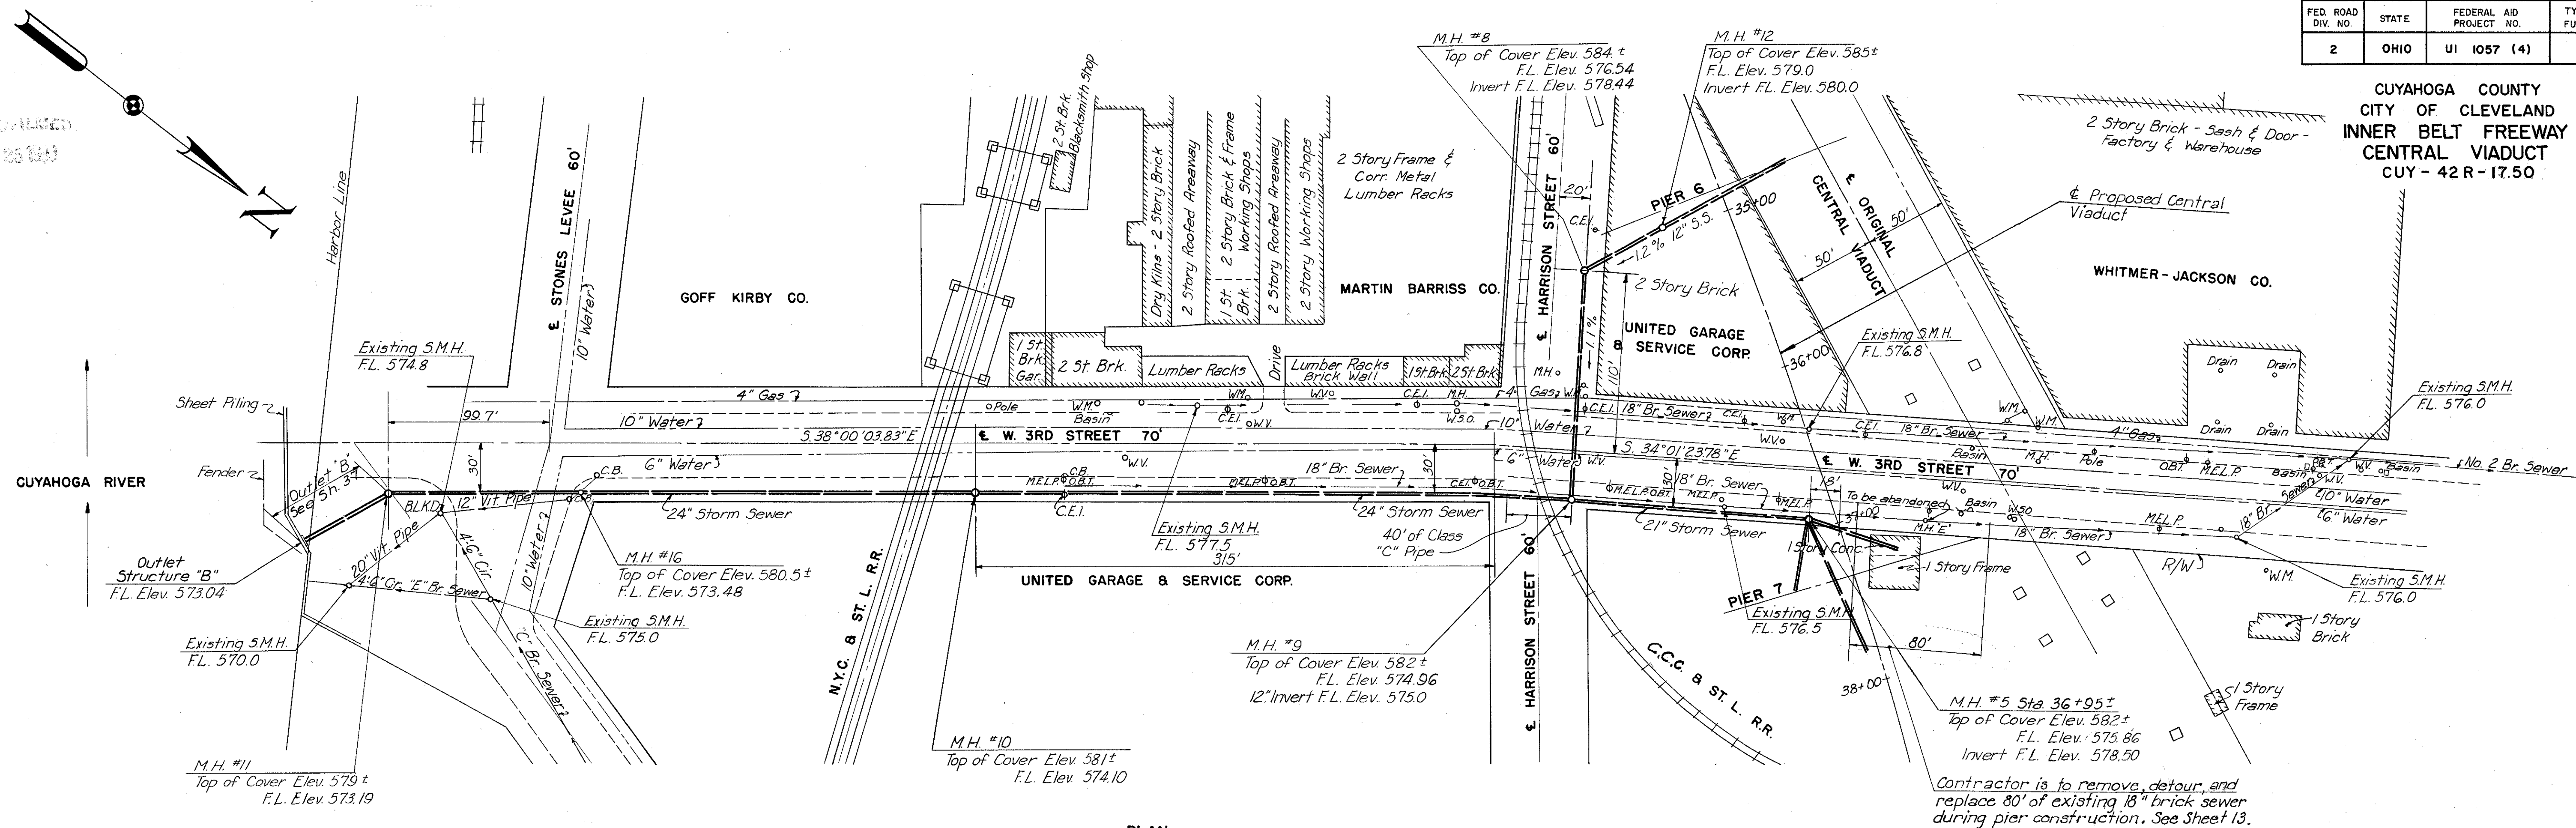

PLAN

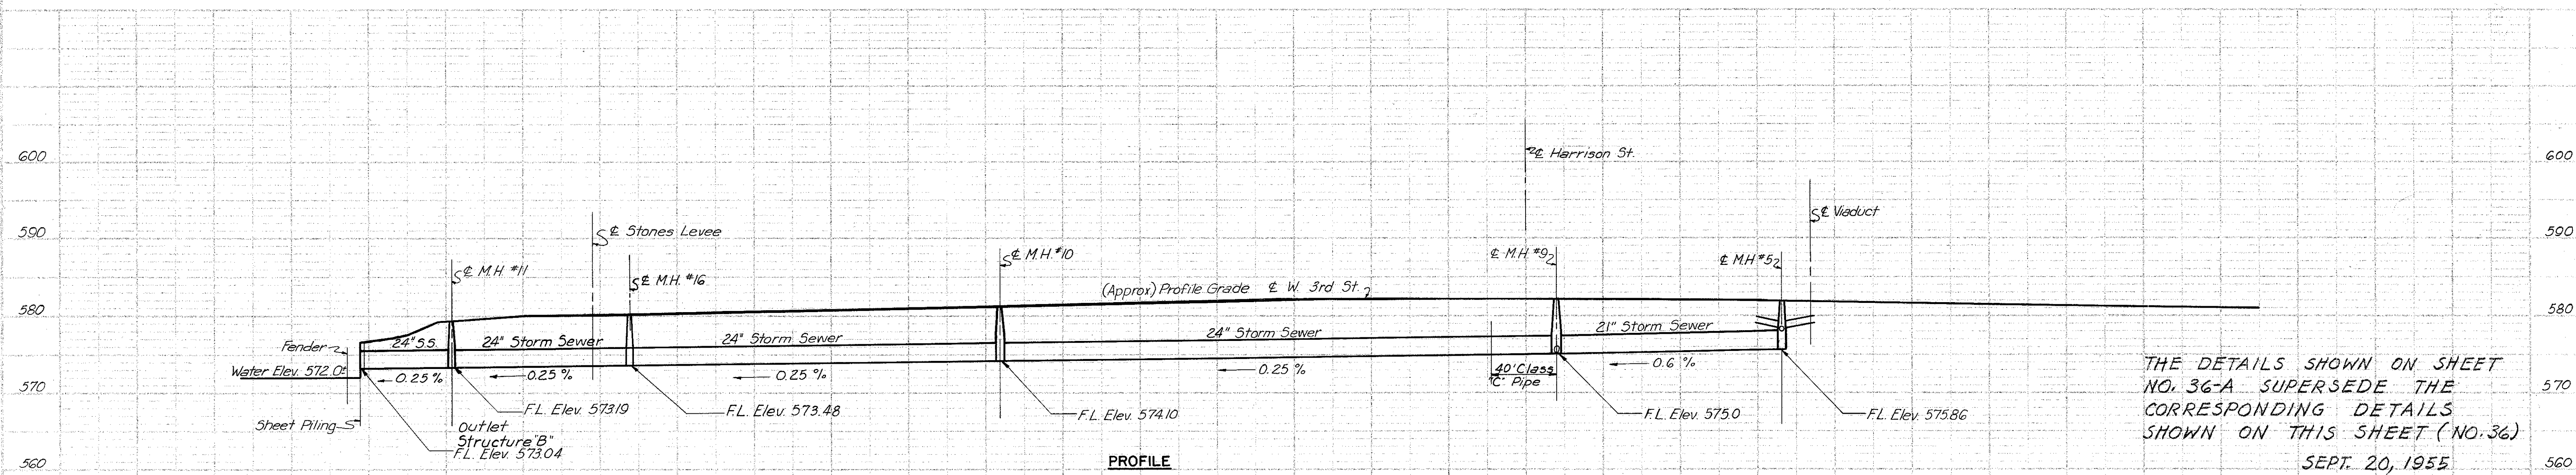

PROFILE

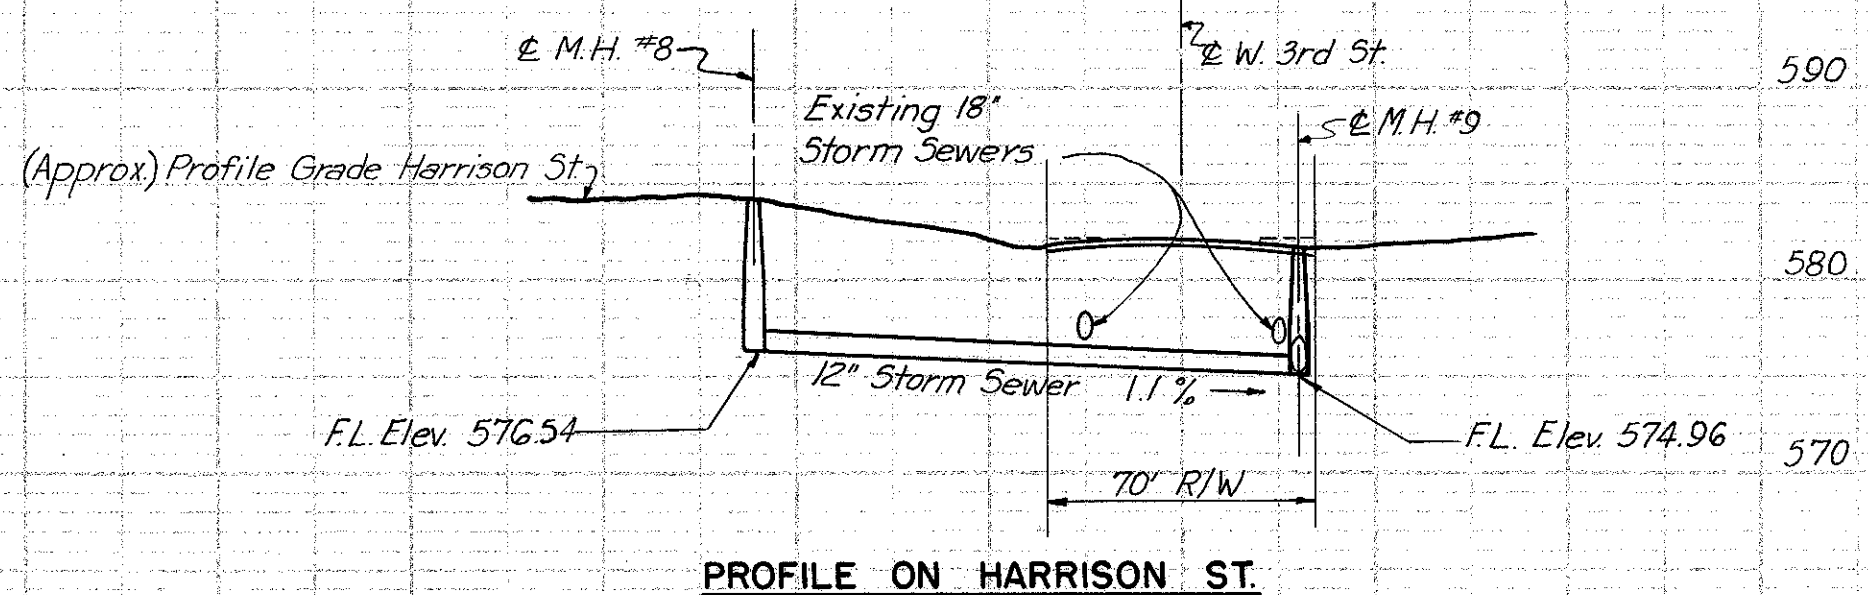

PROFILE ON HARRISON ST.

THE DETAILS SHOWN ON SHEET
NO. 36-A SUPERSEDE THE
CORRESPONDING DETAILS
SHOWN ON THIS SHEET (NO. 36)
SEPT. 20, 1955

U. S. ROUTE 42 RELOCATION
INNER BELT FREEWAY - CENTRAL VIADUCT

STORM SEWER LAYOUT



CLEVELAND CUYAHOGA COUNTY OHIO

SCALE 1" = 50'
MADE BY DATE 2-10-54
TRCD N.B.M. DATE 3-18-54
CKD C.J.C. DATE 6-12-54

HOWARD, NEEDLES, TAMMEN & BERGENDOFF
CONSULTING ENGINEERS
KANSAS CITY CLEVELAND NEW YORK

914-1A SHEET- 1.36

CUYAHOGA COUNTY
CITY OF CLEVELAND
INNER BELT FREEWAY
CENTRAL VIADUCT
CUY-42R-17.50

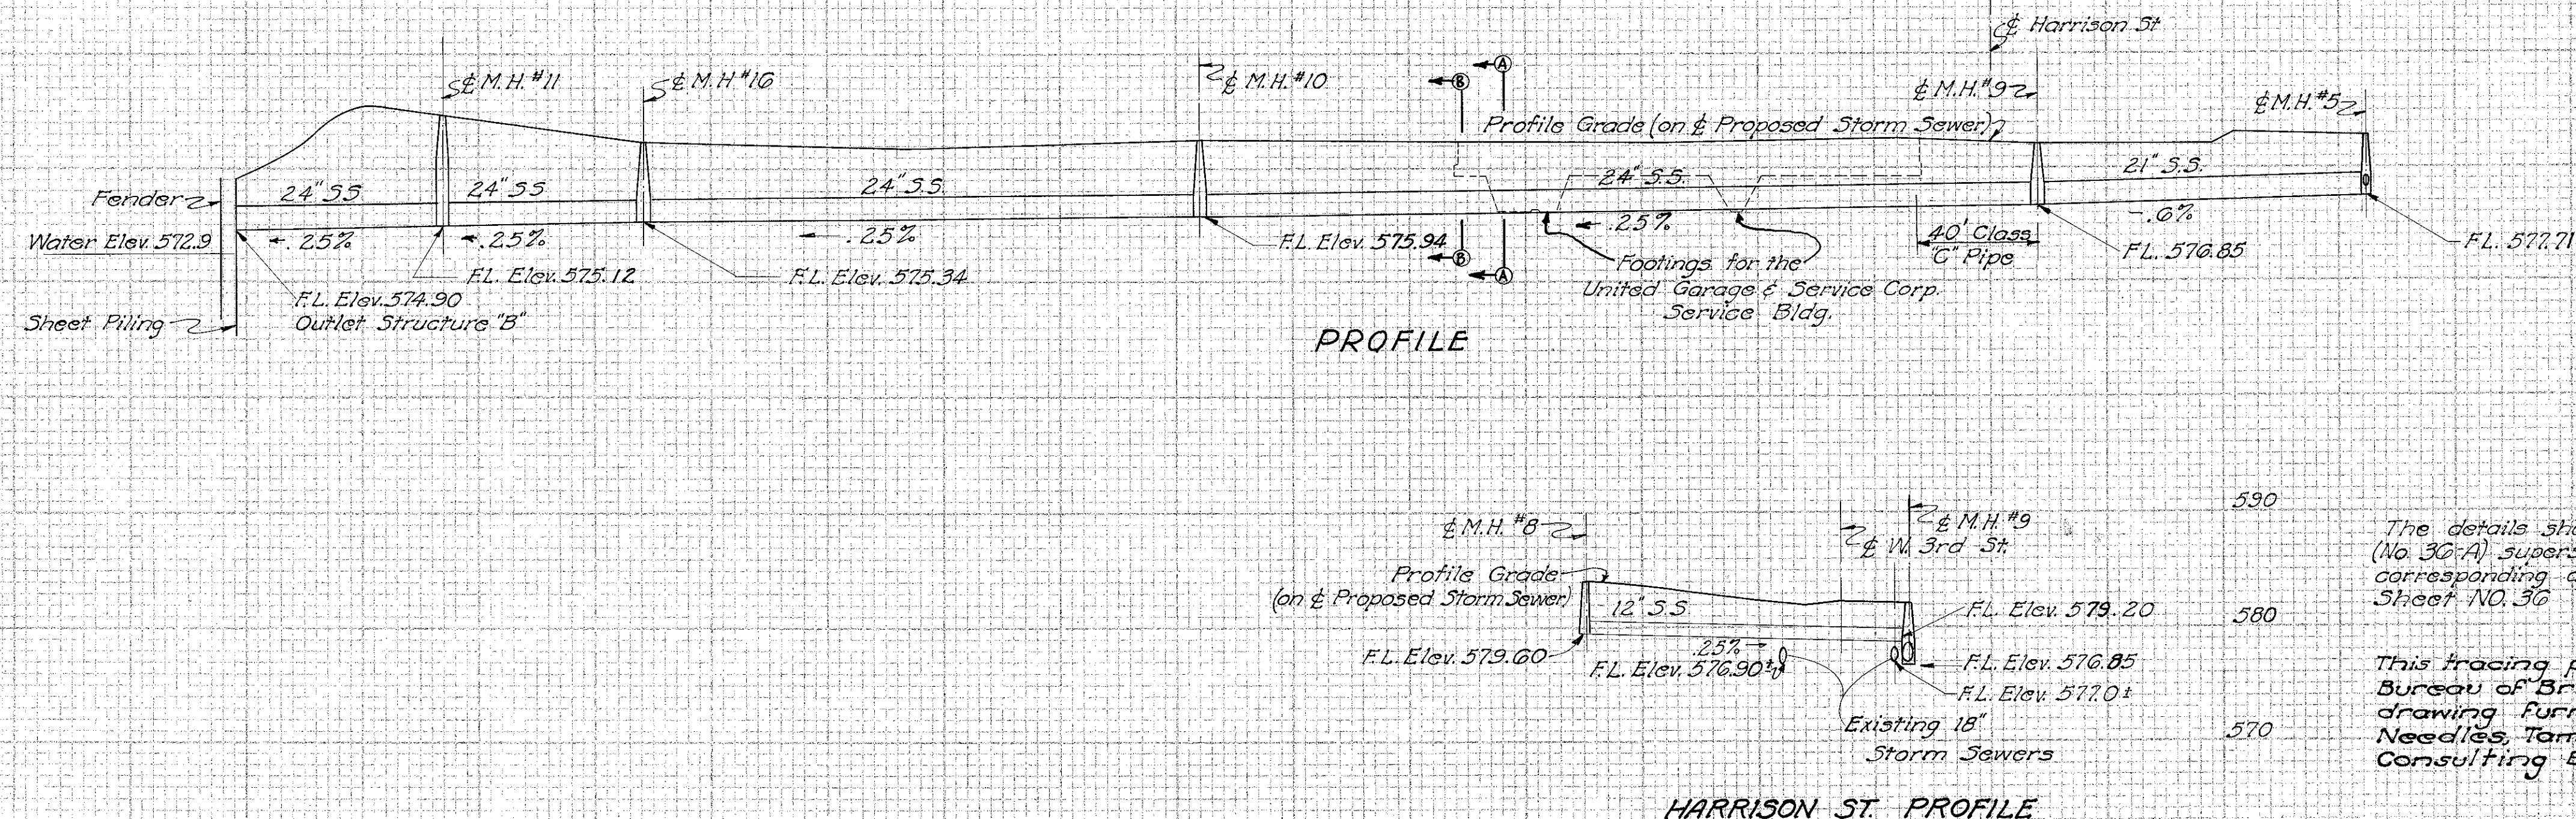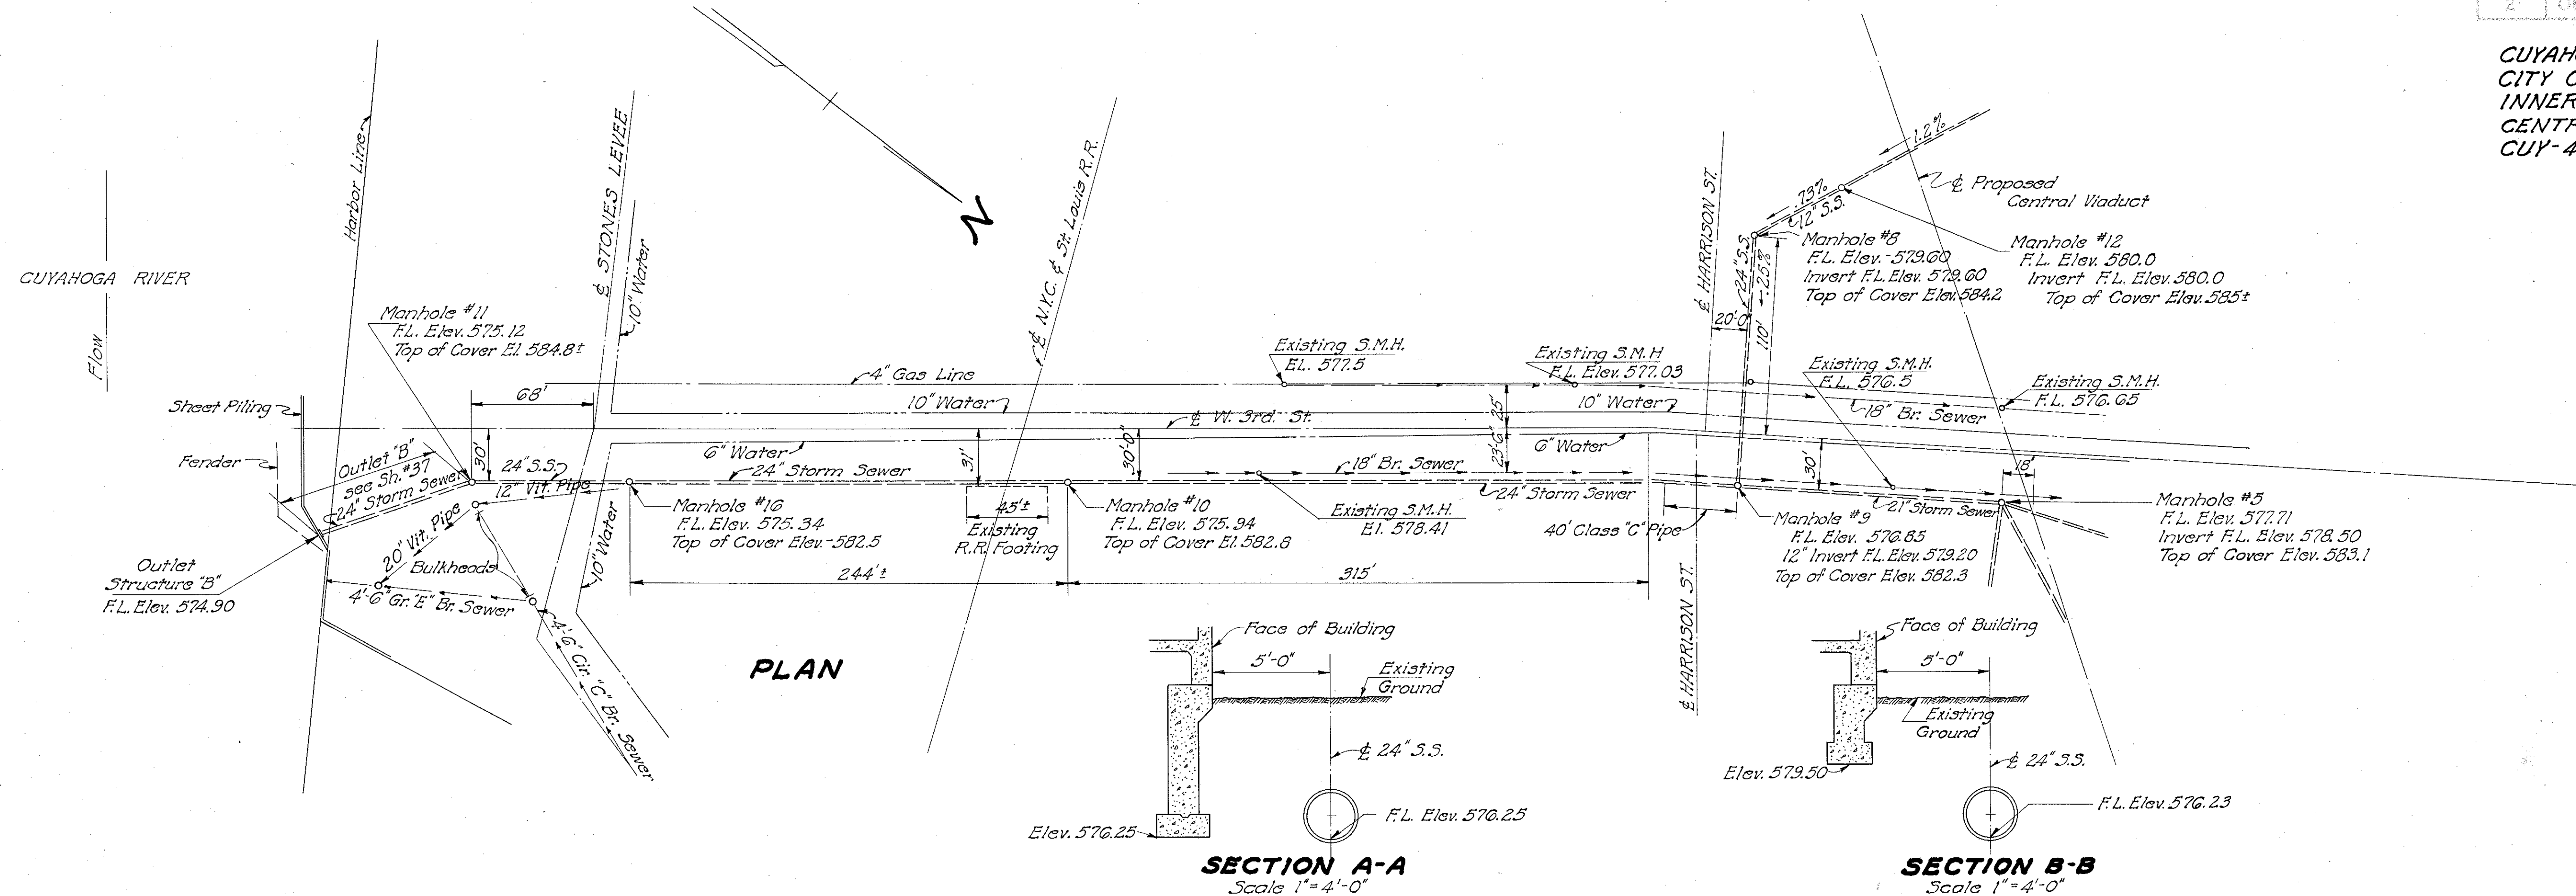

Note: For original storm sewer layout see Sheet 1.30

The details shown on this sheet (No. 30-A) supersede the corresponding details on Sheet No. 30.

This tracing prepared in the Bureau of Bridges from pencil drawing furnished by Howard, Needles, Tammen & Bergendoff, Consulting Engineers.

FED. ROAD DIV. NO.	STATE	FEDERAL AID PROJECT NO.	TYPE FUND
2	OHIO	UI 1087 (4)	

28


43

[illegible]


GENERAL NOTES

GENERAL NOTES
All splice plates to be fillet welded in shop to structural members.
All bolted connections, including anchor rods, shall have the threads jammed to form a definite lock.
The concrete anchor pile cap must be constructed in sections. Bar splices for the six construction joints shown are included in the estimated quantities. Locations may be shifted to any typical position.

LOCATION PLAN
Scale: 1"=10'-0"

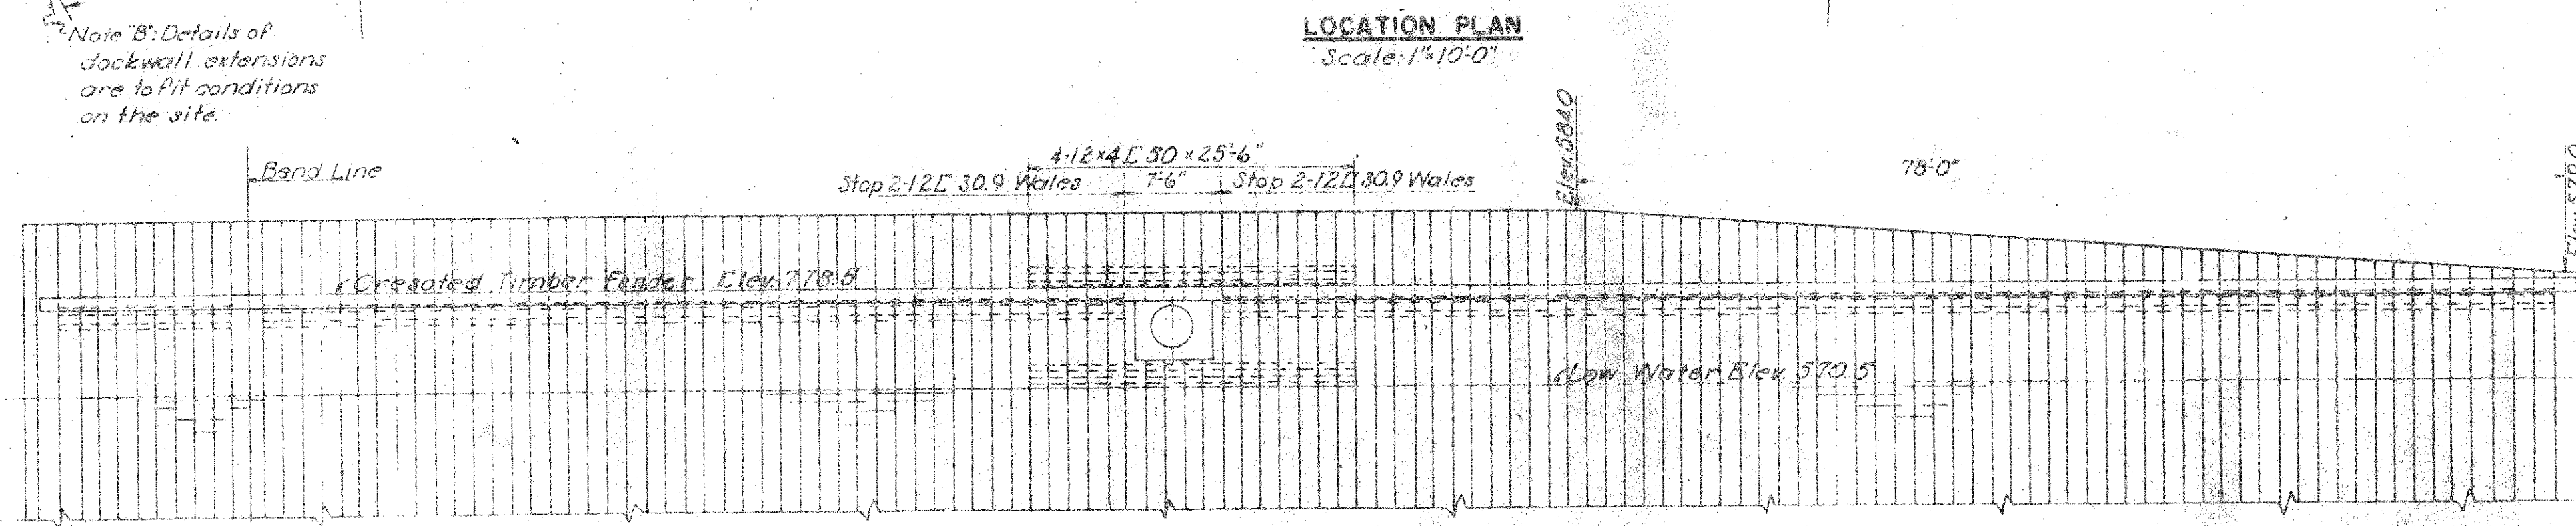

FRONT ELEVATION
Scale 1"=10'-0"

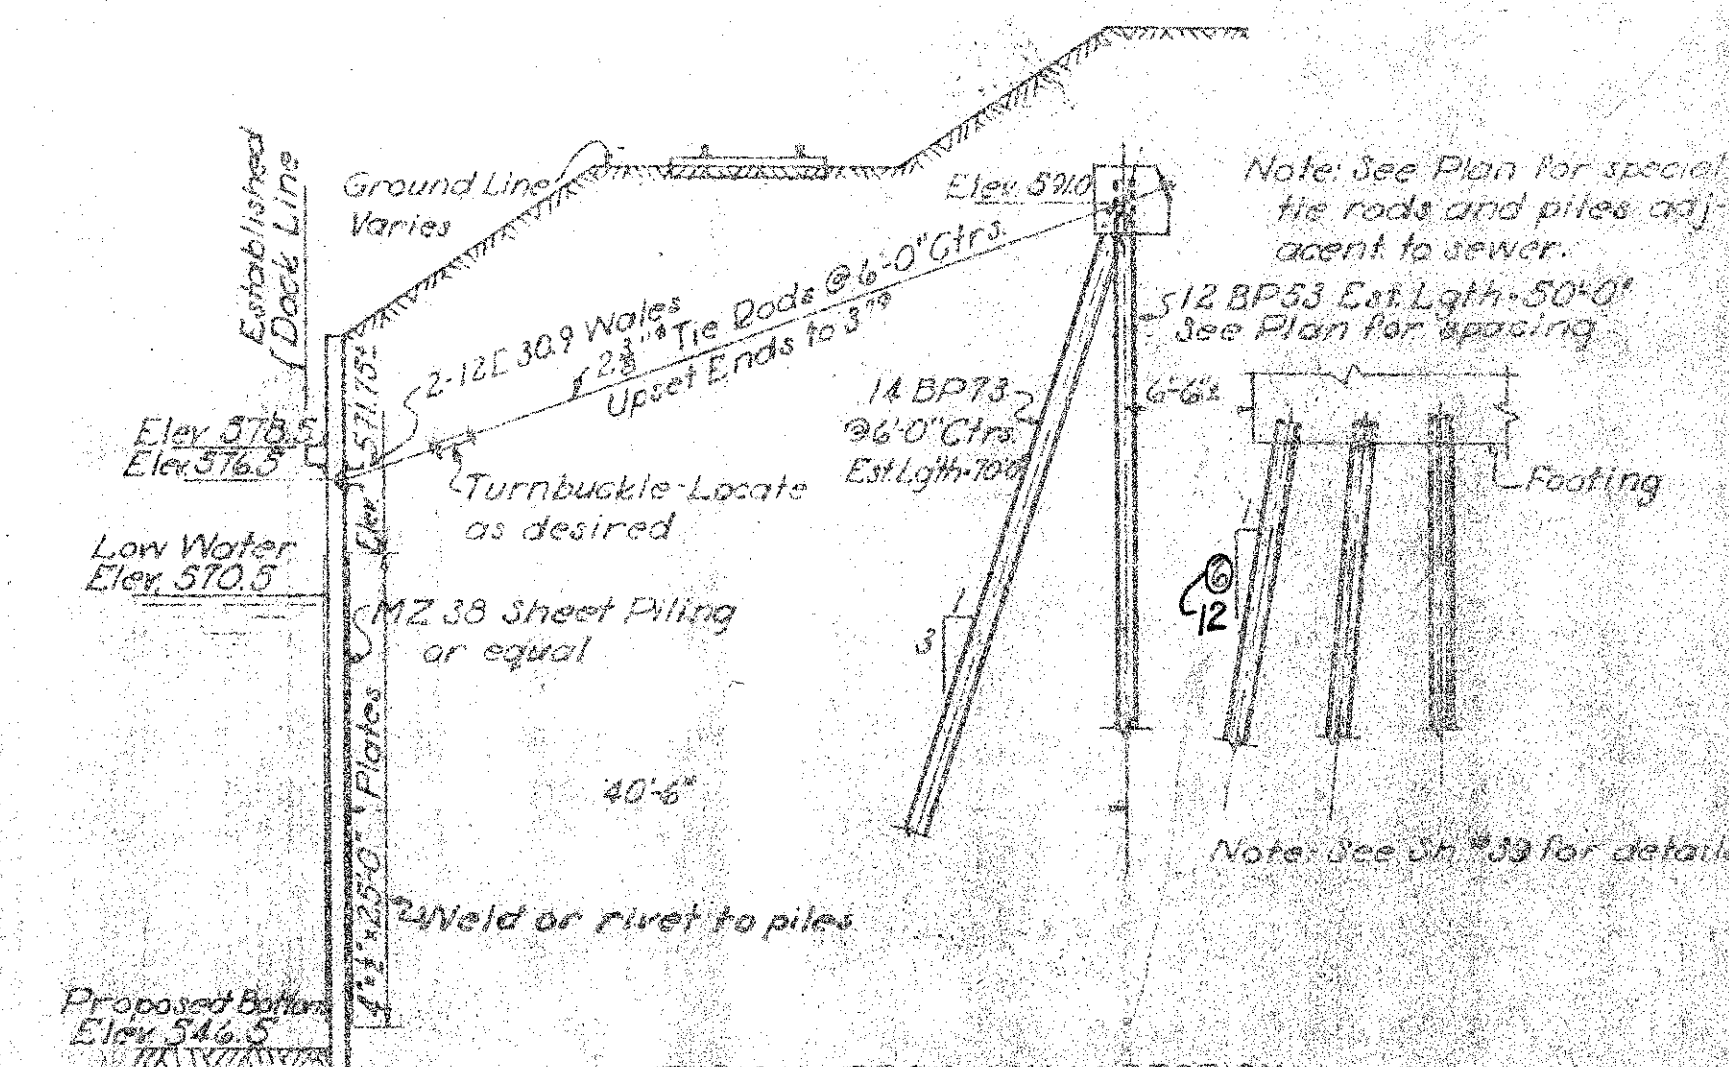

TYPICAL DOCK WALL SECTION
Scale: 1"=10'-0"

U. S. ROUTE 42 - RELOCATION
INNER BELT FREEWAY - CENTRAL VIADUCT

DOCK WALL

LOCATION PLAN AND TYPICAL SECTION

CLEVELAND CUYAHOGA COUNTY OHIO

SCALE 1/100 HOWARD, NEEDLES, TAMMEN & BERENSON
MADE CIC DATE 8/21/54 CONSULTING ENGINEERS
TICK CIC DATE 8/21/54 KANSAS CITY CLEVELAND NEW YORK
CRD JK DATE 8/21/54 214-14 DICKET 138

Supersedes Sheet 38
Revised anchor pile spacing - GA 2-15-55


FEB 23 1963

FED. ROAD DIV. NO.	STATE	FEDERAL AID PROJECT NO.	TYPE FUNDS
2	OHIO	UI 1057 (4)	

39
43


CUYAHOGA COUNTY
CITY OF CLEVELAND
INNER BELT FREEWAY
CENTRAL VIADUCT
CUI-42R-17.50

Connect $\frac{1}{2}$ " Bars to piling with $\frac{1}{8}$ " continuous fillet weld

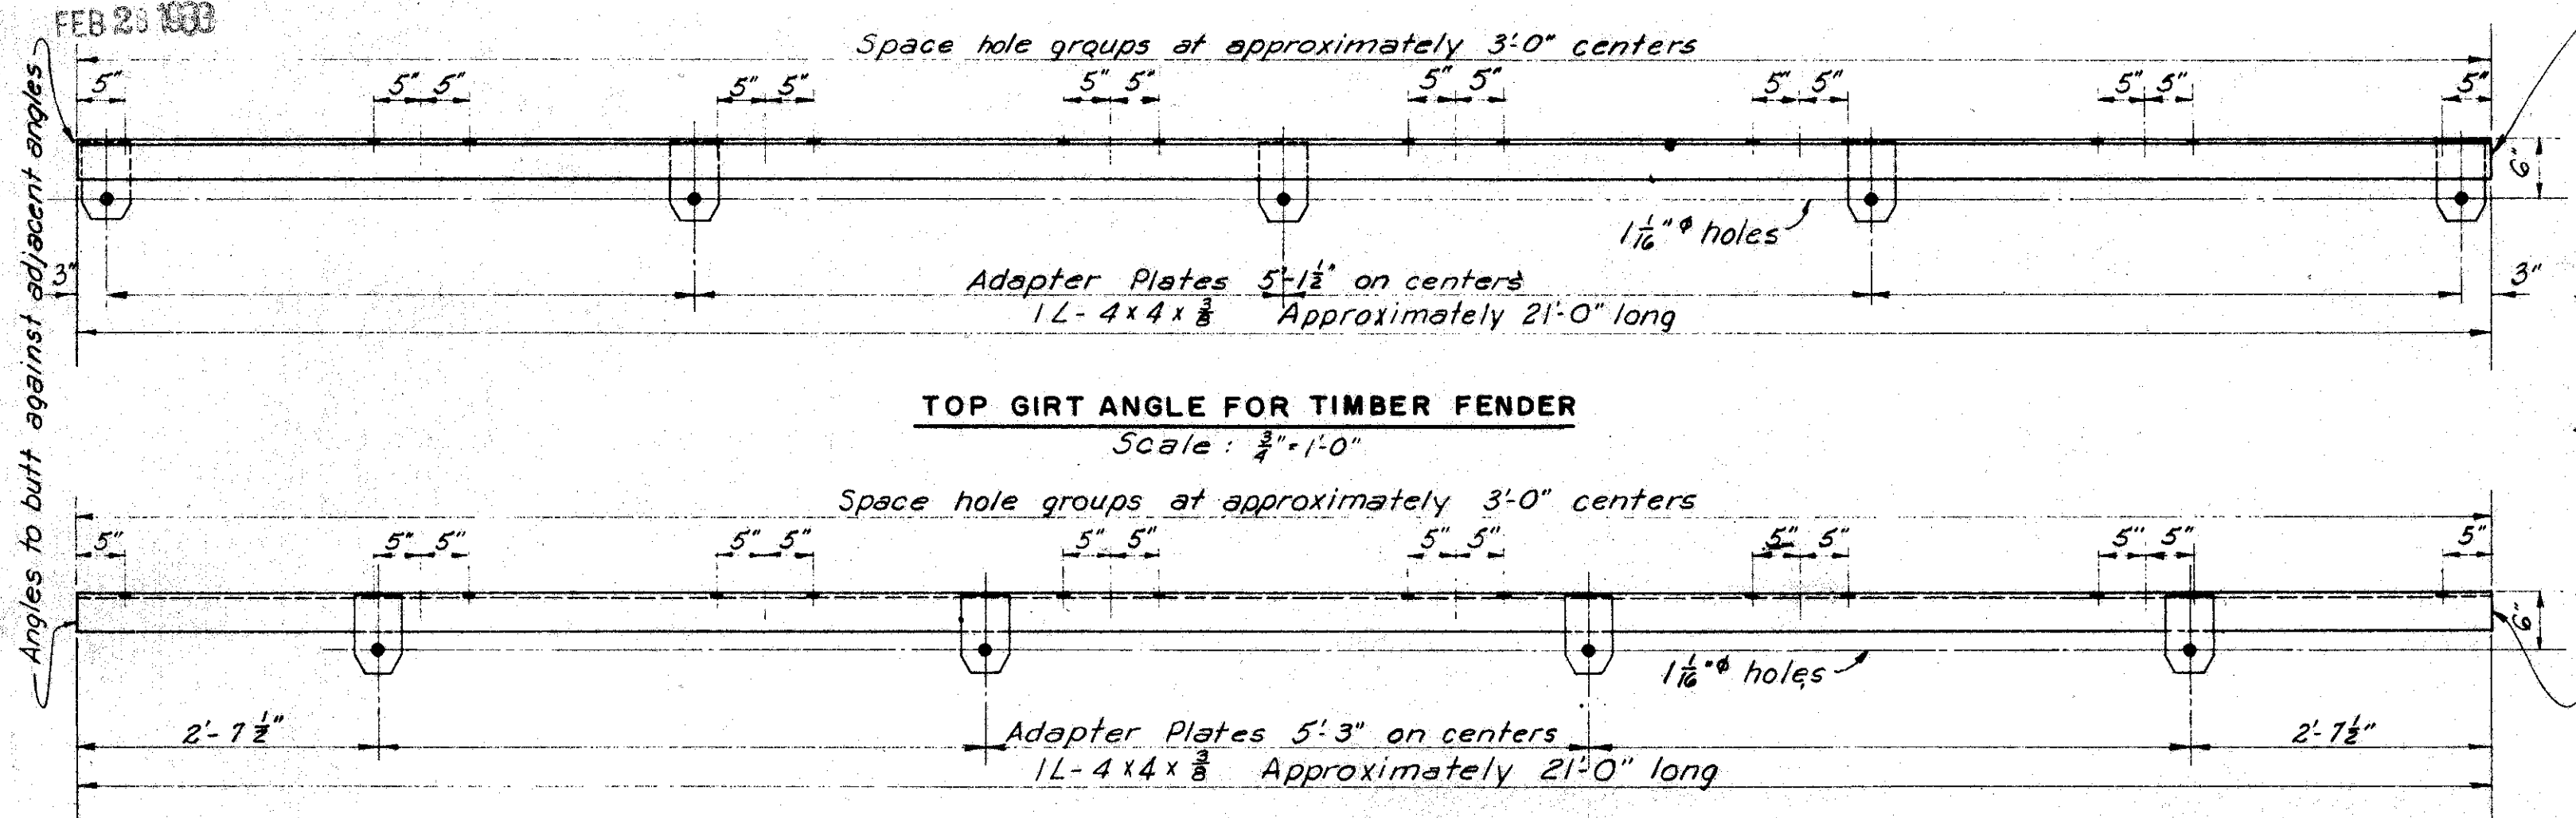


TOP GIRT ANGLE FOR TIMBER FENDER

Scale: $\frac{3}{4}$ " = 1'-0"

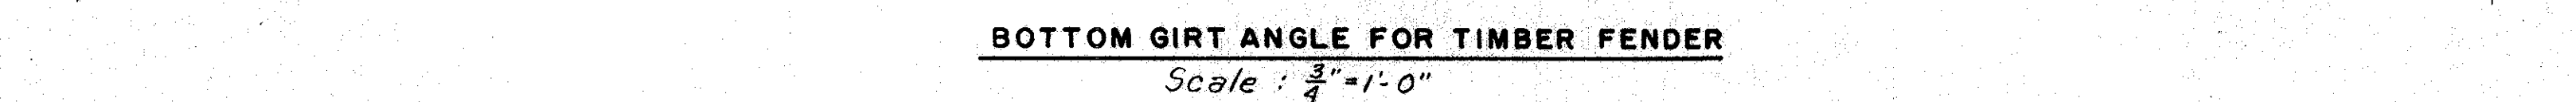


BOTTOM GIRT ANGLE FOR TIMBER FENDER

Scale: $\frac{3}{4}$ " = 1'-0"

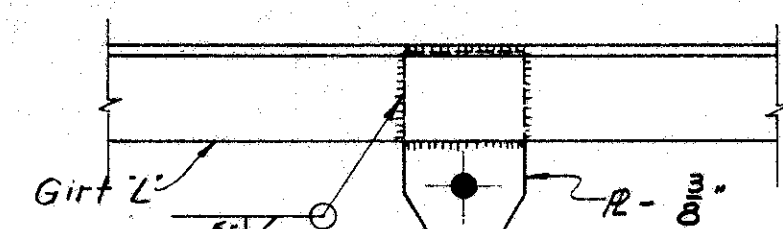


ADAPTER PLATE DETAIL

Scale: $1\frac{1}{2}$ " = 1'-0"

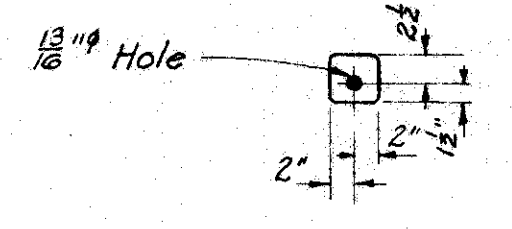

SPACER WASHER


Scale: $\frac{3}{4}$ " = 1'-0"

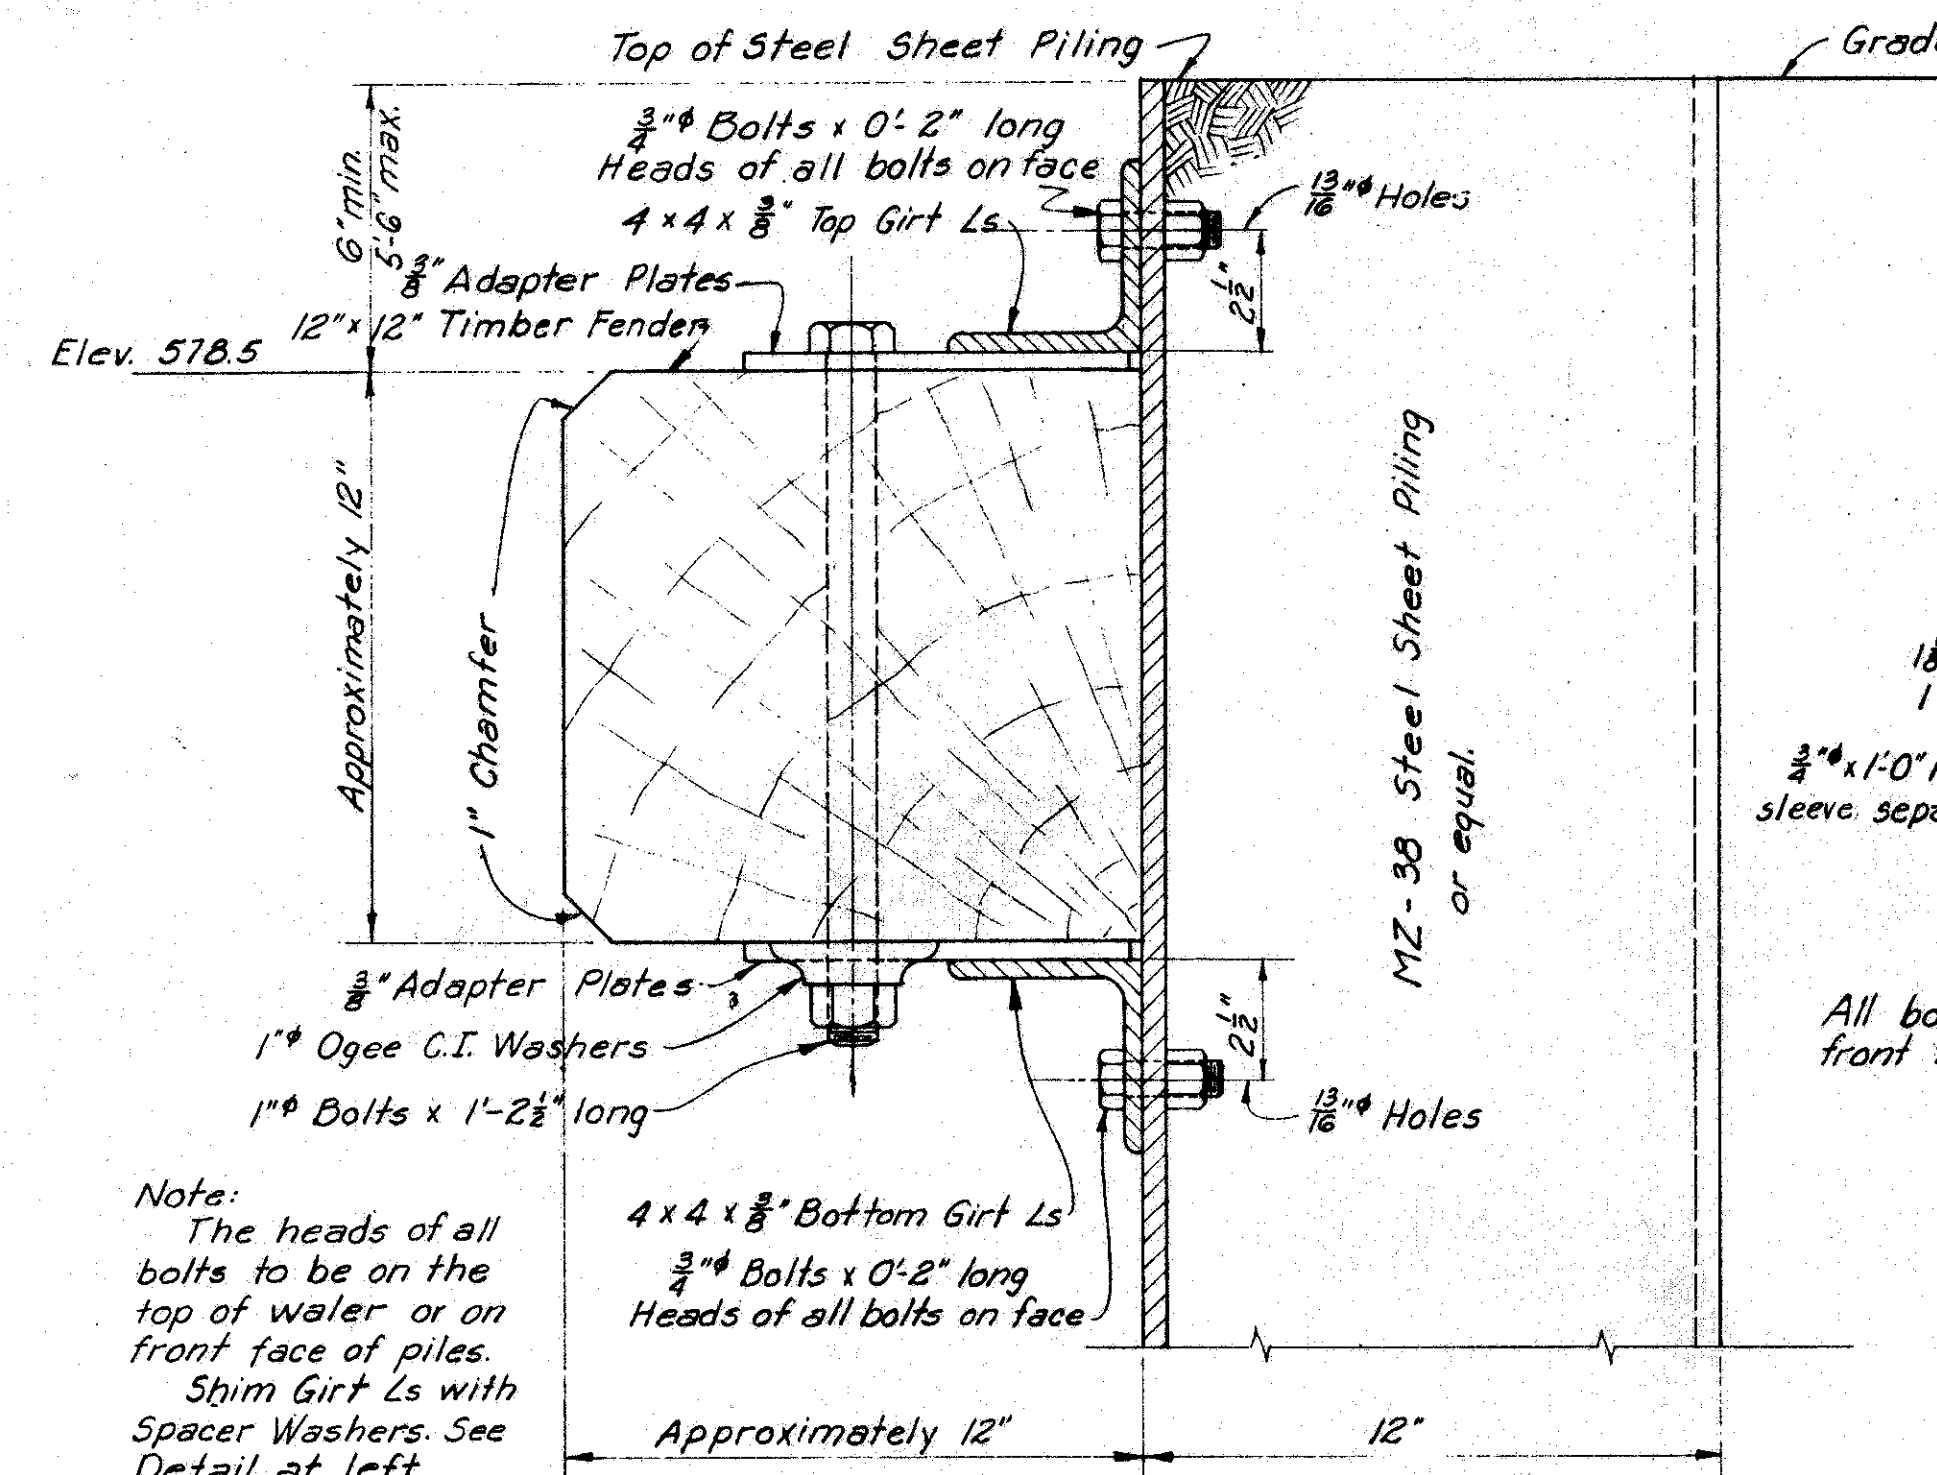


SECTION THROUGH TIMBER FENDER

Scale: 3" = 1'-0"

Note:
The heads of all bolts to be on the top of waler or on front face of piles.
Shim Girt Ls with Spacer Washers. See Detail at left.

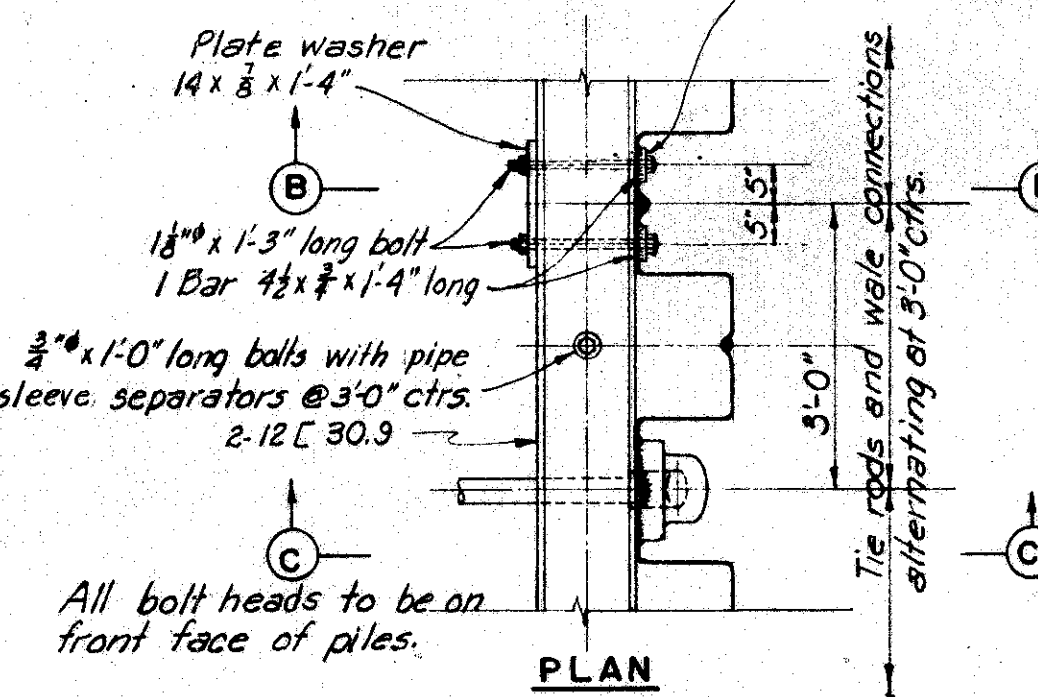

PLAN

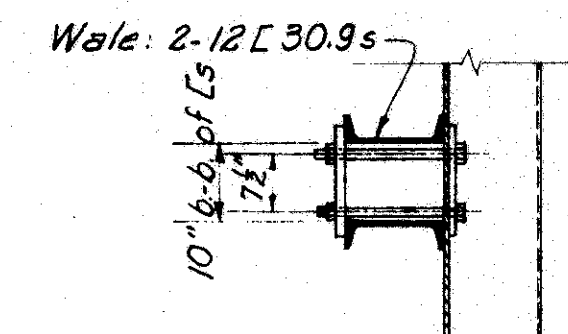


SECTION B-B

Splice for top or bottom L
12" x 9" x 1/2" Stagger splices. Connect to webs with 3/8" fillet weld.
2 1/2" or 2 3/8" tie rods @ 6'-0" ctrs. See Sheet 1.38 for location and sizes.

SECTION C-C


CONNECTION OF ANCHOR RODS AND CHANNEL WALES TO SHEET PILING

Scale: $\frac{1}{2}$ " = 1'-0"

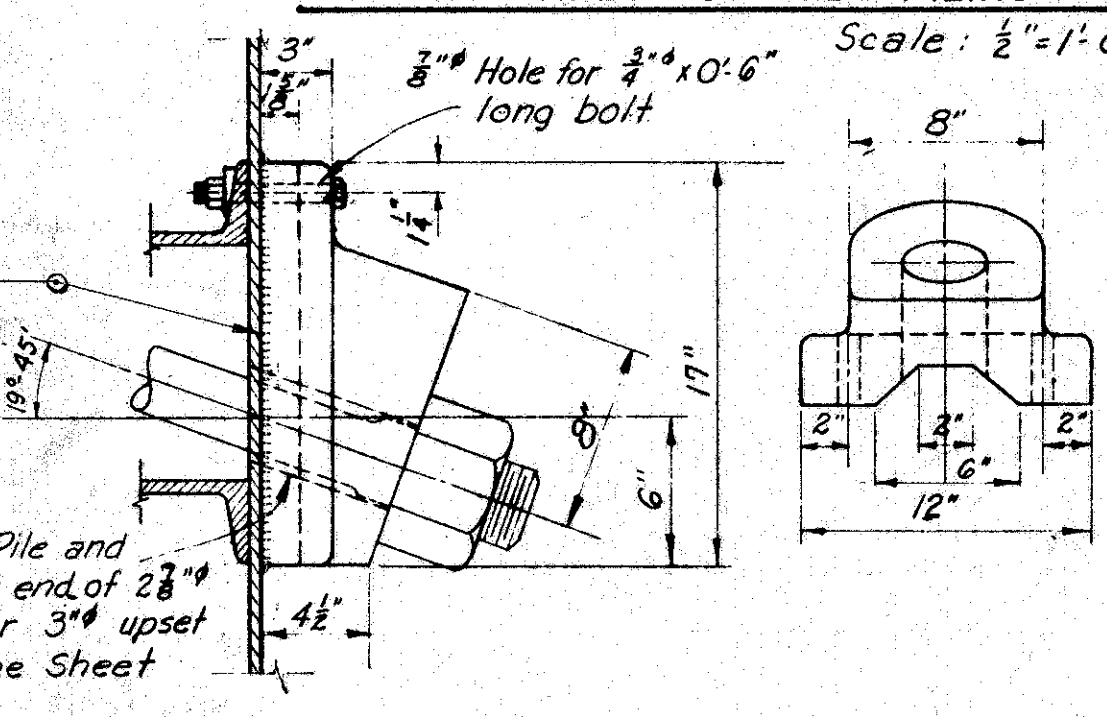


ANCHOR ROD CASTING

Scale: $1\frac{1}{2}$ " = 1'-0"

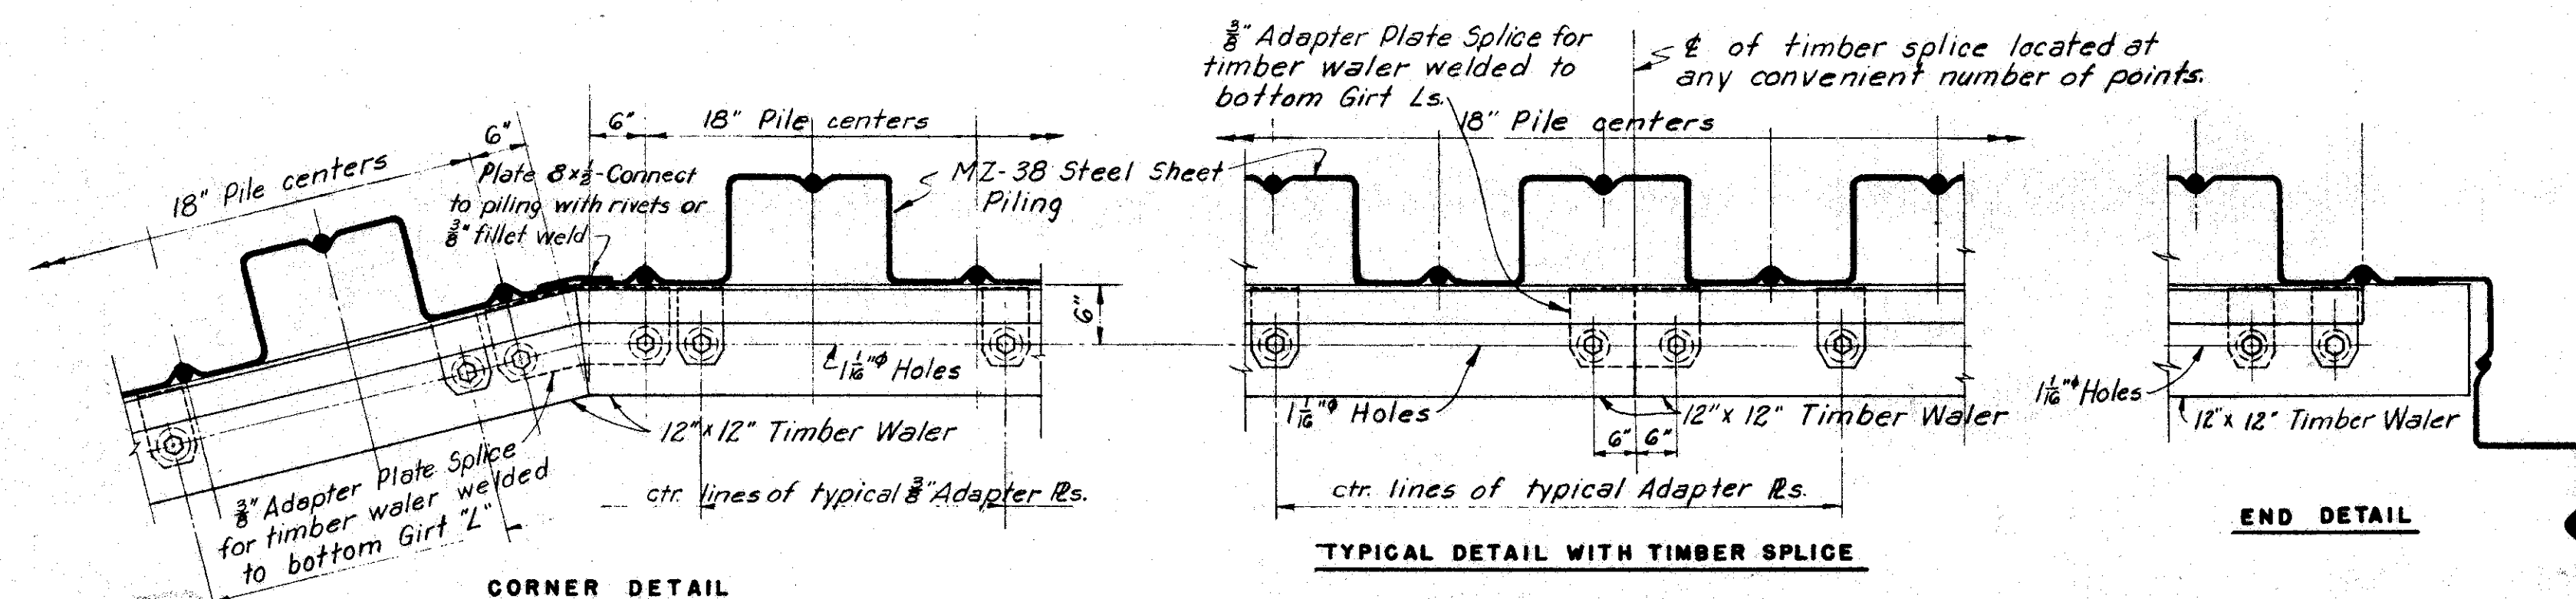


CORNER DETAIL

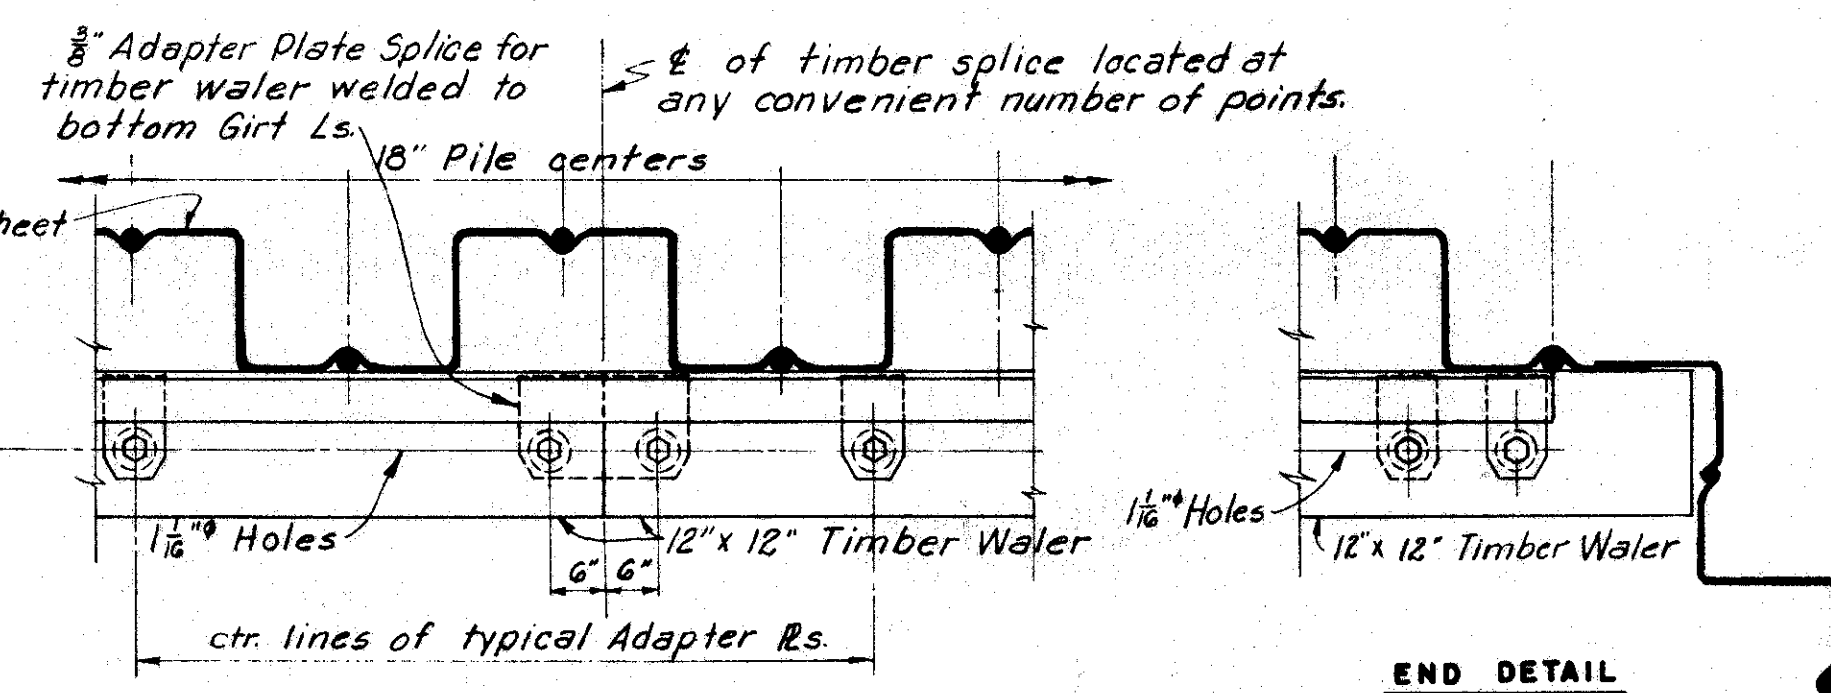


TYPICAL DETAIL WITH TIMBER SPLICE

END DETAIL

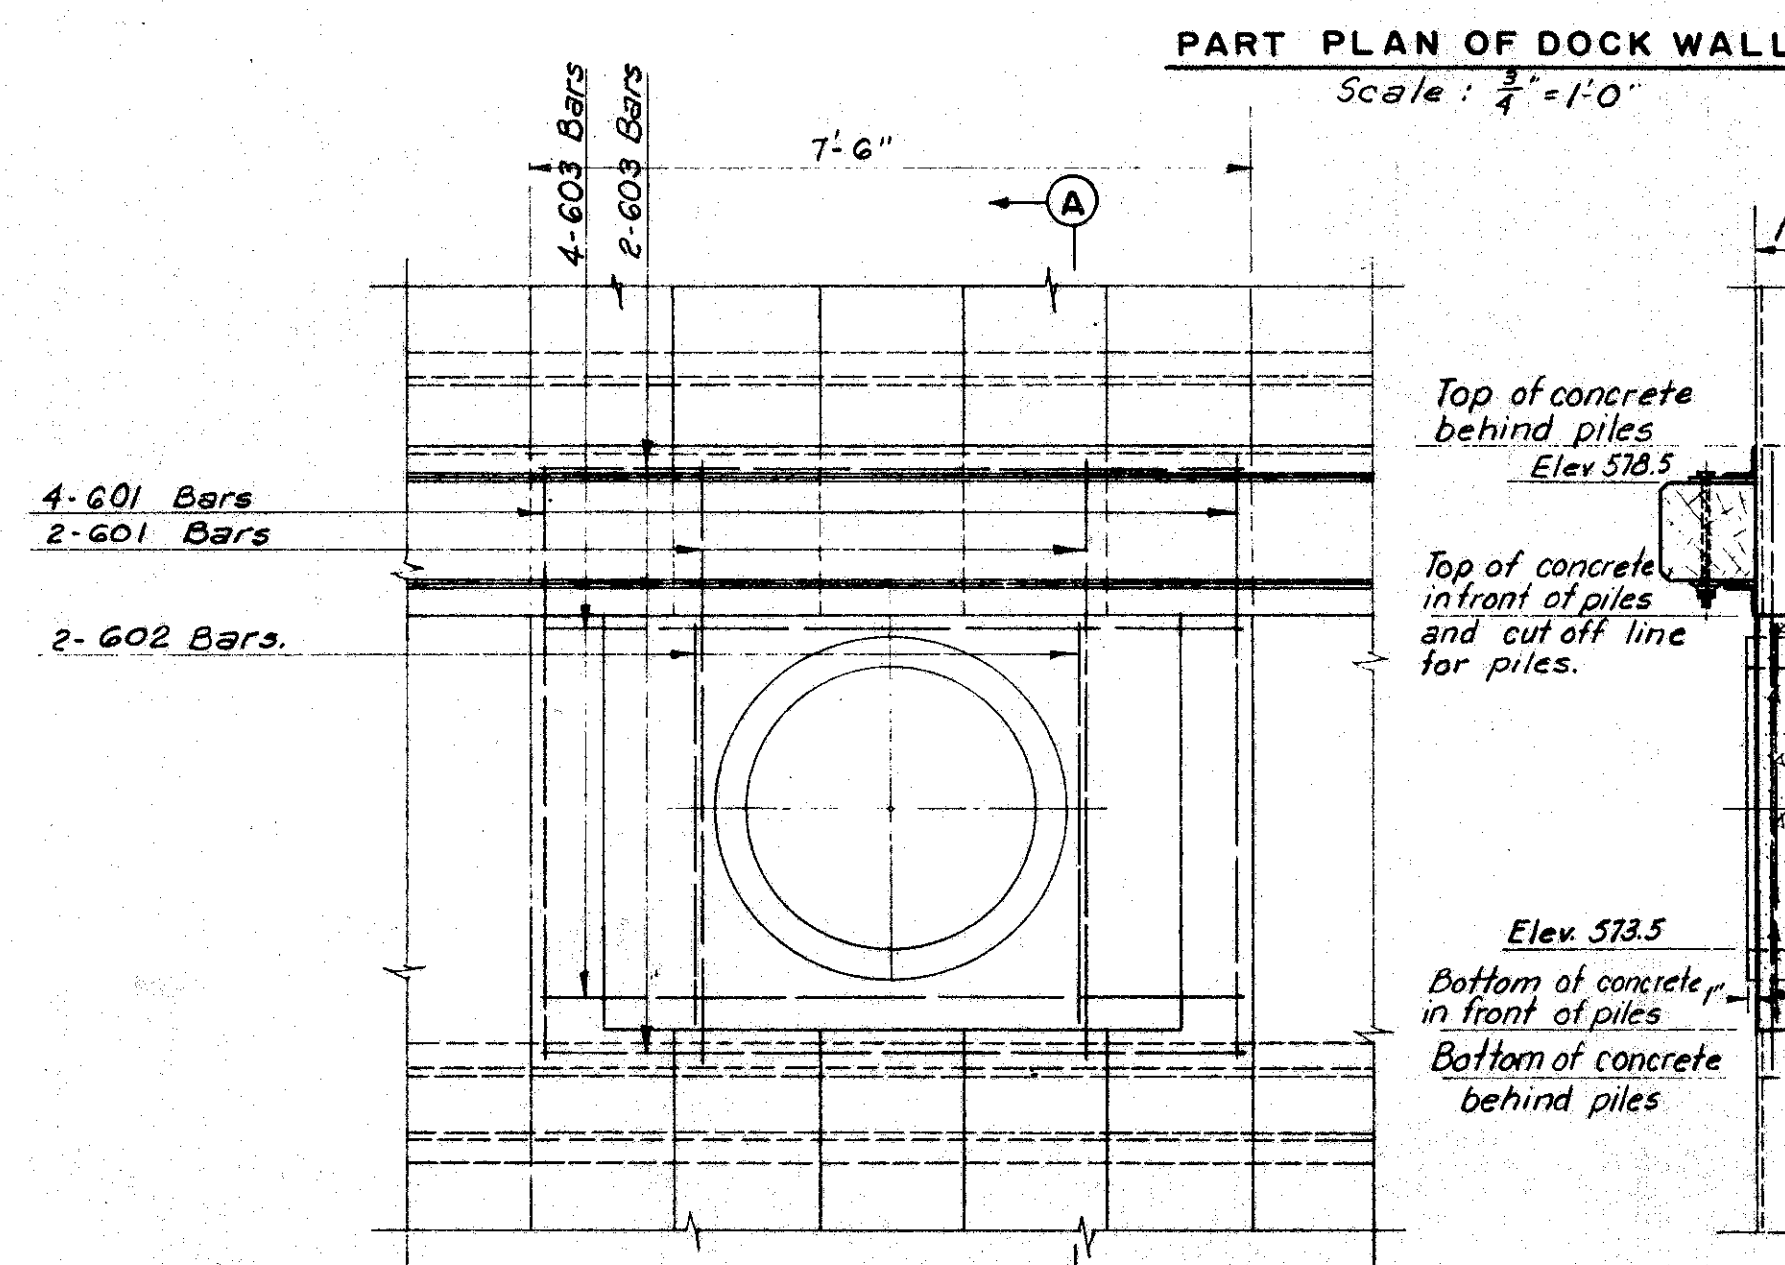

PART PLAN OF DOCK WALL


Scale: $\frac{3}{4}$ " = 1'-0"

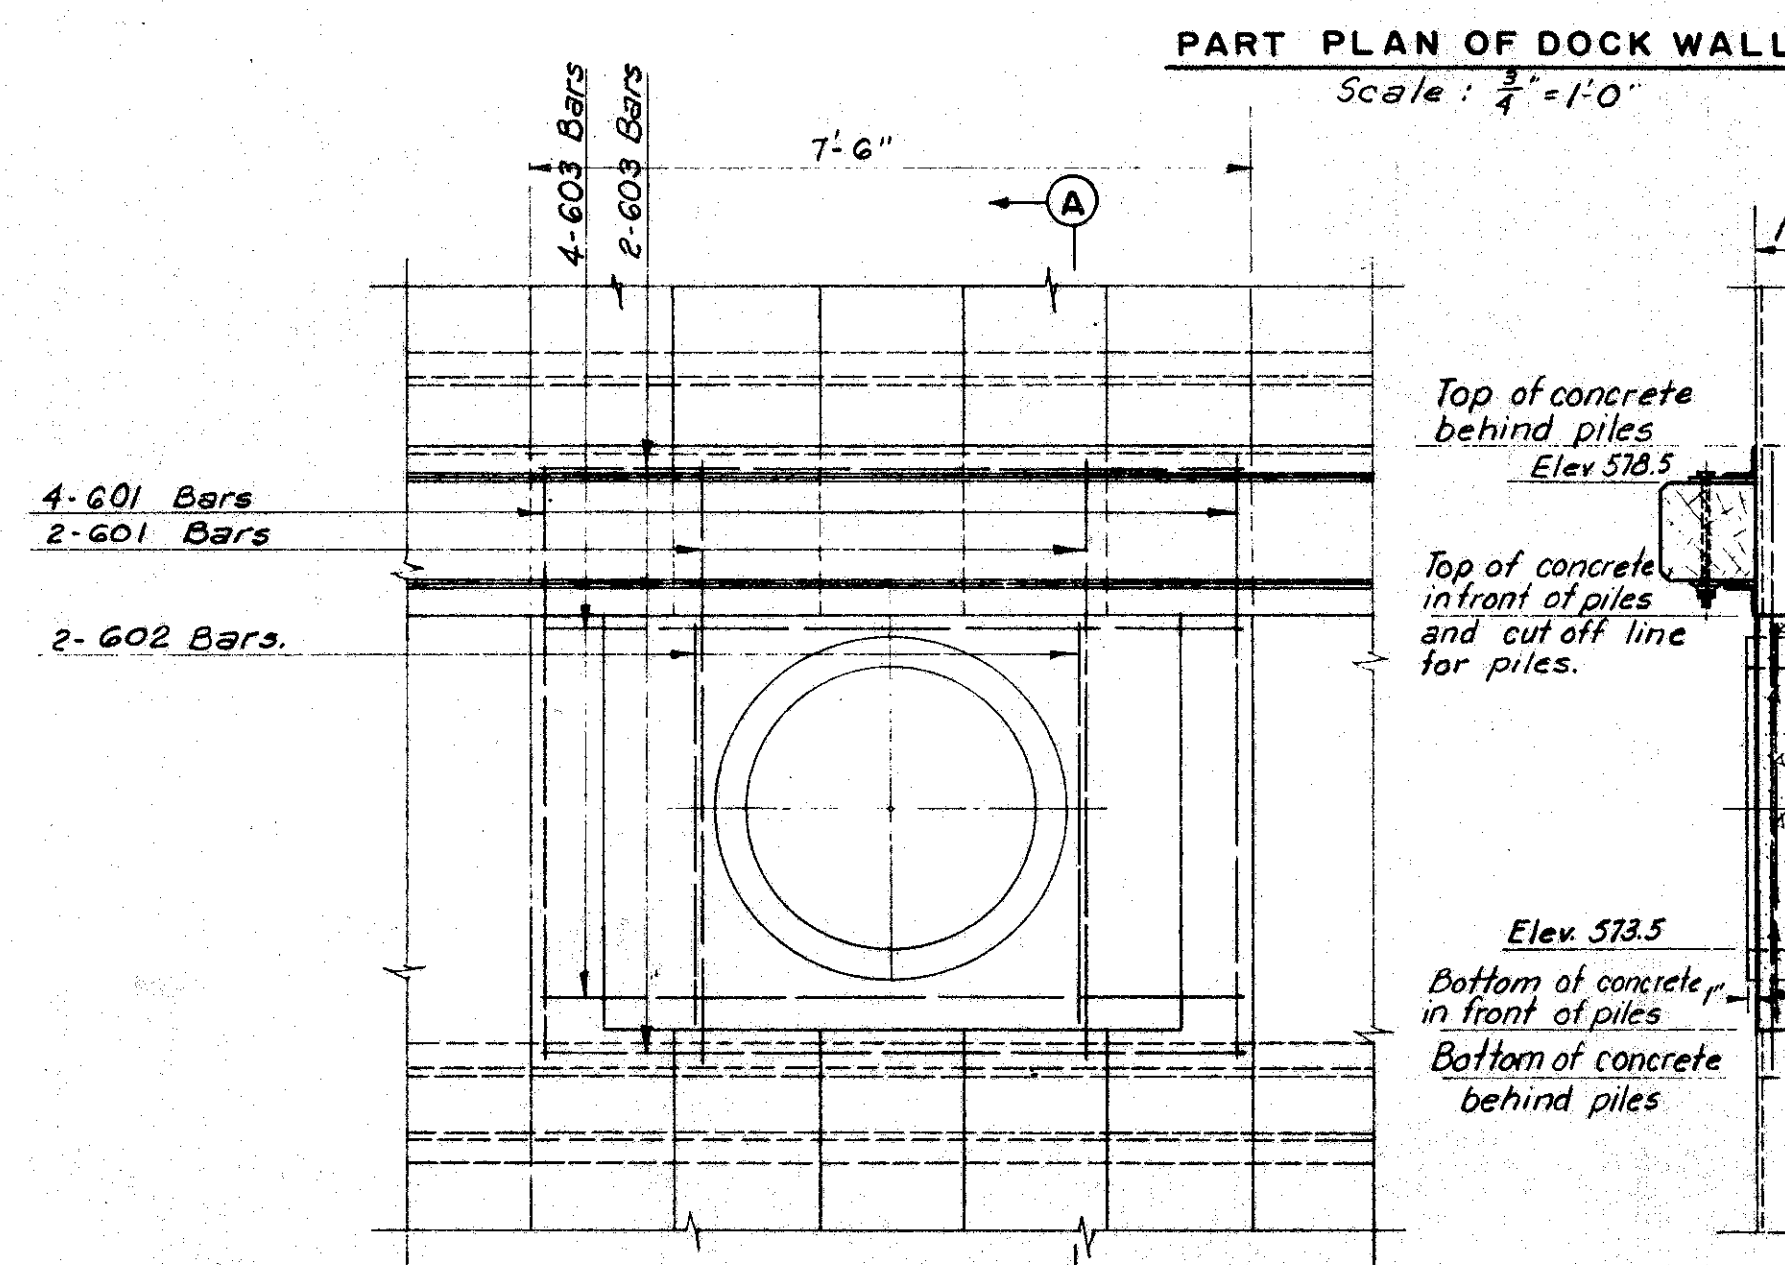

ELEVATION

OUTFALL STRUCTURE "C"


Scale: $\frac{1}{2}$ " = 1'-0"

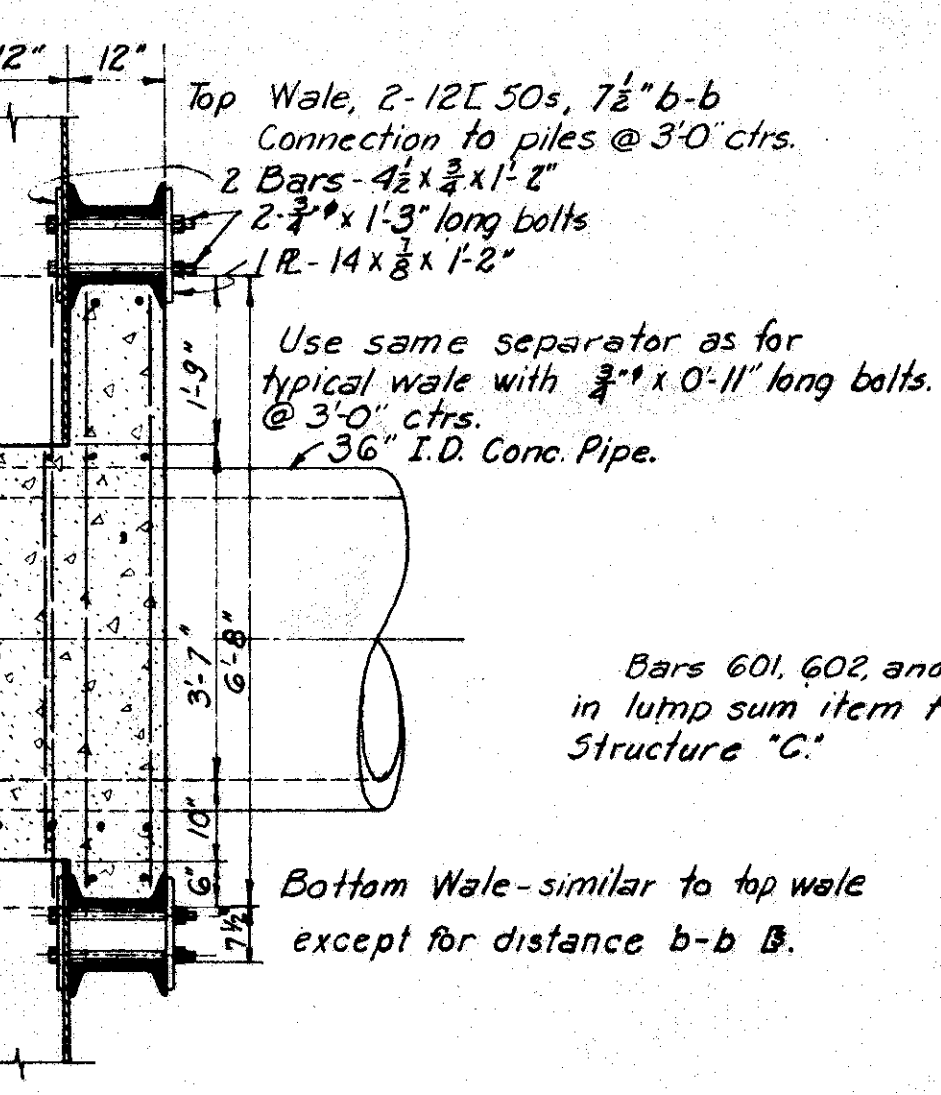

SECTION A-A

Bars 601, 602, and 603 included in lump sum item for Outfall Structure "C."

Bottom Wale-similar to top wale except for distance b-b B.

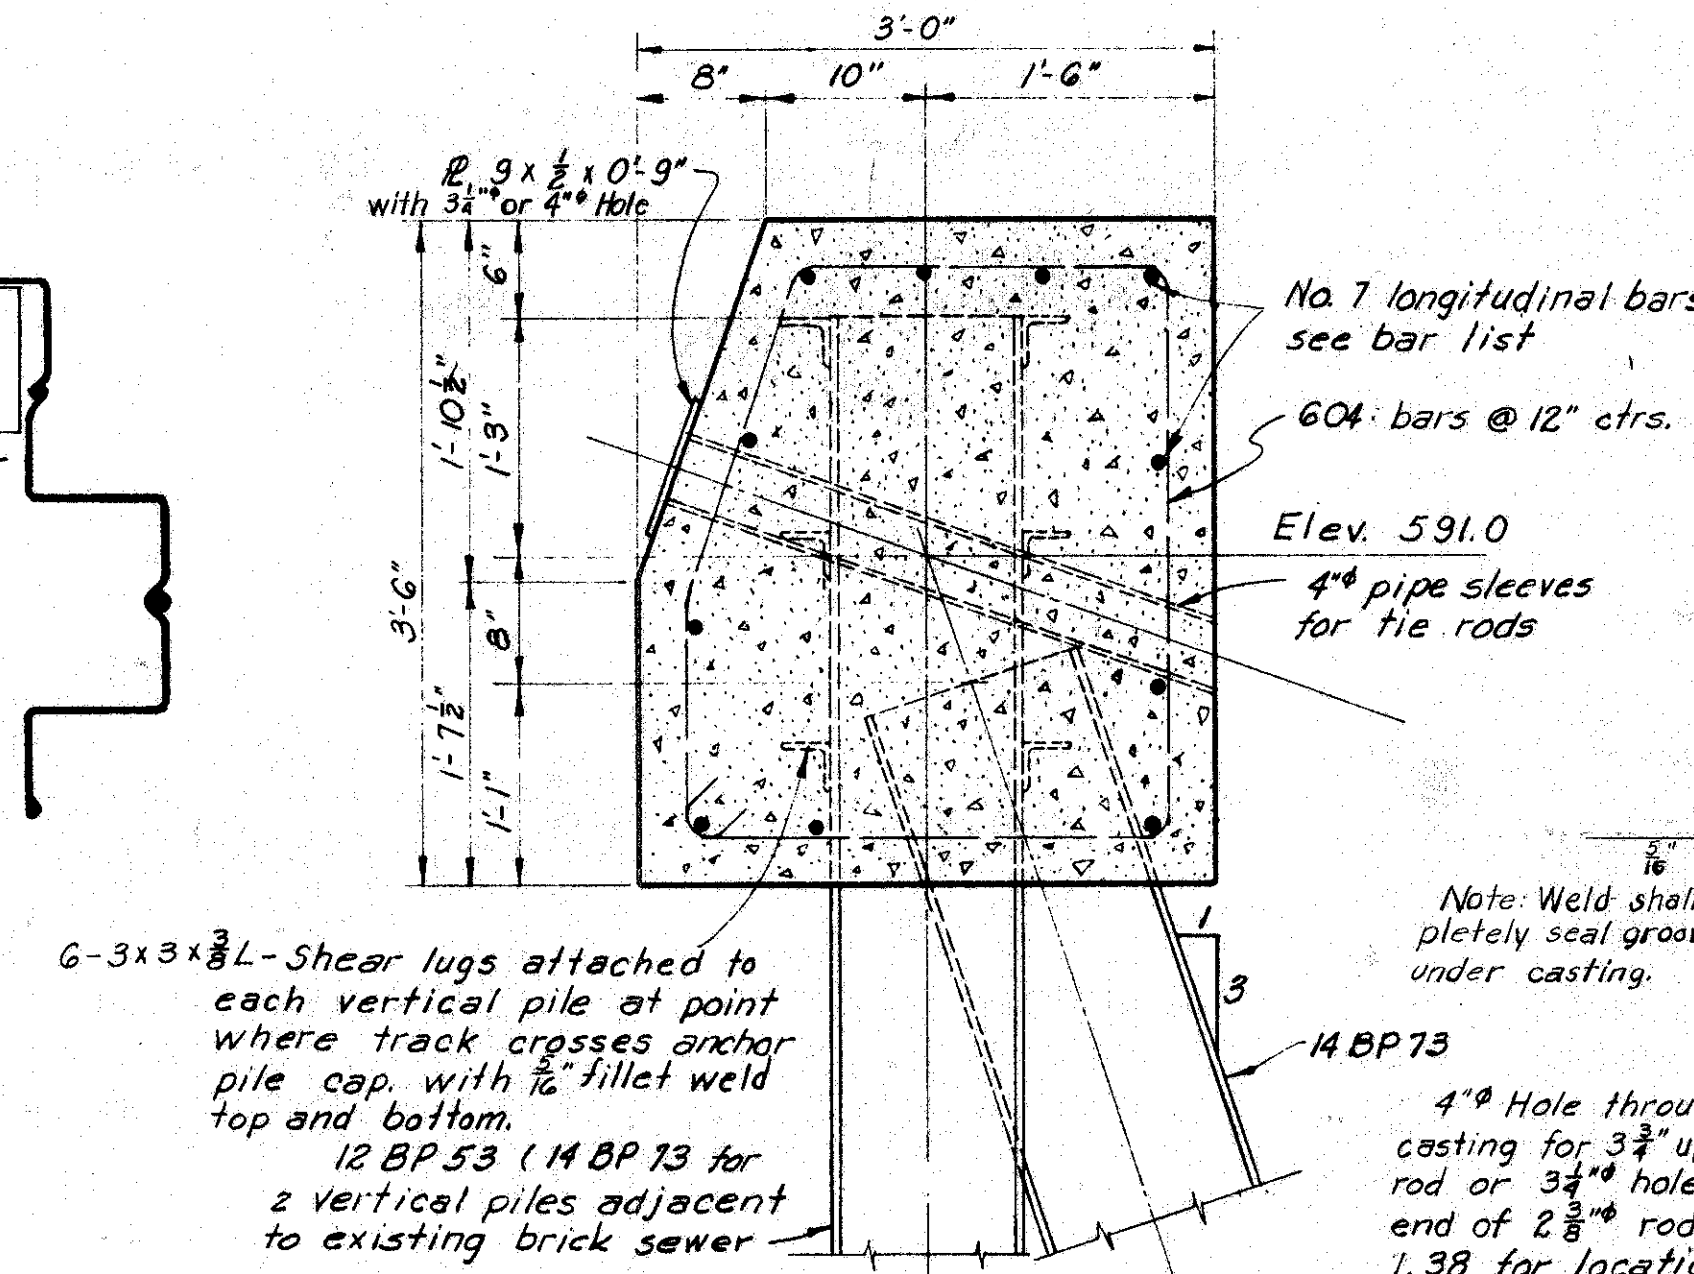

SECTION THROUGH ANCHOR PILE CAP


Scale: 1" = 1'-0"

6-3x3x3/8 L-Shear lugs attached to each vertical pile at point where track crosses anchor pile cap, with 1/2" fillet weld top and bottom.
12 BP 53 (14 BP 13 for 2 vertical piles adjacent to existing brick sewer)

Note: Weld shall completely seal groove under casting.
4" Hole through Pile and casting for 3 3/4" upset end of 2 1/2" rod or 3 1/4" hole for 3" upset end of 2 3/8" rod. See Sheet 1.38 for location.

Mark	Size	Type	Length	No.	Total Weight
601	Str.	6'-0"	12	108	
602	Str.	4'-0"	4	24	
603	Str.	7'-0"	12	126	
604	Bent	11'-0"	198	3268	
701	Str.	17'-6"	11	393	
702	Str.	23'-6"	44	2293	
703	Str.	26'-6"	22	1282	
704	Str.	29'-6"	11	663	

Lengths for bars 701, 702, 703, 704 subject to revision and dependent on location of construction joints in anchor pile cap

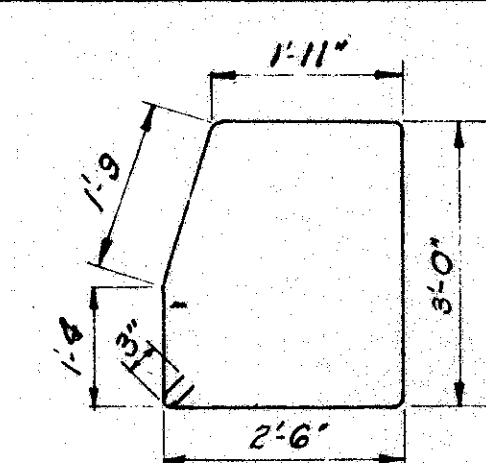

Bent Bar Dimensions

U. S. ROUTE 42 RELOCATION
INNER BELT FREEWAY - CENTRAL VIADUCT

DOCK WALL DETAILS

CLEVELAND CUYAHOGA COUNTY OHIO

SCALE: As Shown
MADE: DME DATE: 3-31-54
TRCD: DATE: HOWARD, NEEDLES, TAMMEN & BERGENDOFF
CKD: DATE: KANSAS CITY CONSULTING ENGINEERS
914-1A SHEET 139

MICROFILMED
FEB 23 1983

TIMBER CRIB WALL INSTALLATION

PREPARING BASE - The foundation or bed for the cribbing shall be firm and shall be approved by the Engineer before any cribbing is placed.

The foundation shall be sloped at right angles to the finished crib batter face.

FACE TIMBERS OR STRETCHERS - The timbers in the base tier and in alternate tiers above the base shall be as long as practicable. Preferably they shall have a minimum length of 8 feet. Joints in each tier shall stagger with joints in adjacent tiers.

Care shall be exercised in the erection of cribs to produce a true and even face built to line as shown on the plans. All face timbers shall be set parallel to grade.


TIES OR HEADERS - Ties shall be anchored to the face by framing, drift bolt- ing or other approved means.

Ties should be anchored in the fill to stretchers fastened to them at right angles by drift bolts or other suitable means.


FASTENING - Each successive tier of open face cribbing shall be drift bolted together at each tie, using one $\frac{3}{4}$ " drift bolt at each intersection where no splice occurs or at lap joints and two $\frac{3}{4}$ " drift bolts at butt joints. Drift bolts shall be long enough to extend through one tier and at least $\frac{3}{4}$ " of the distance into the next tier. Stagger drift bolts from tier to tier.

FILLING - The filling of the interior of the crib shall follow closely the erection of the successive tiers of units and at no time shall the wall be laid up higher than 3 feet above the back filled portion.


In open face cribbing a layer of hand-placed stone shall be placed in back of the front members of the cribbing to prevent loss of fill material through the openings.

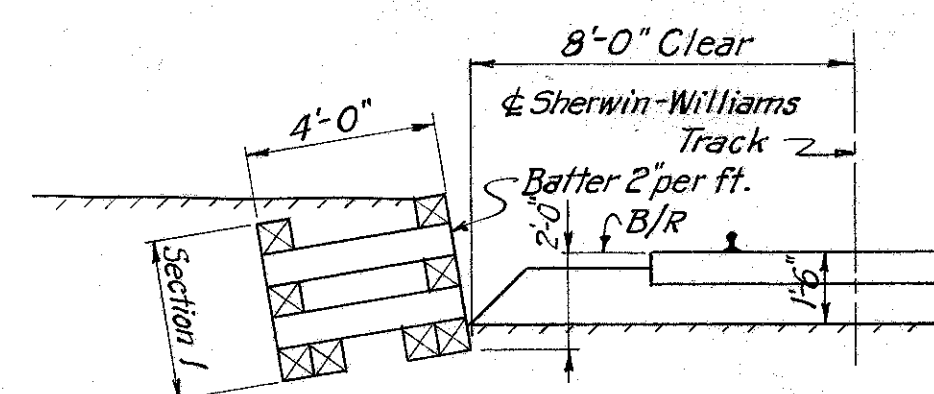


SECTION 1
Scale $\frac{1}{4}$ " = 1'-0"

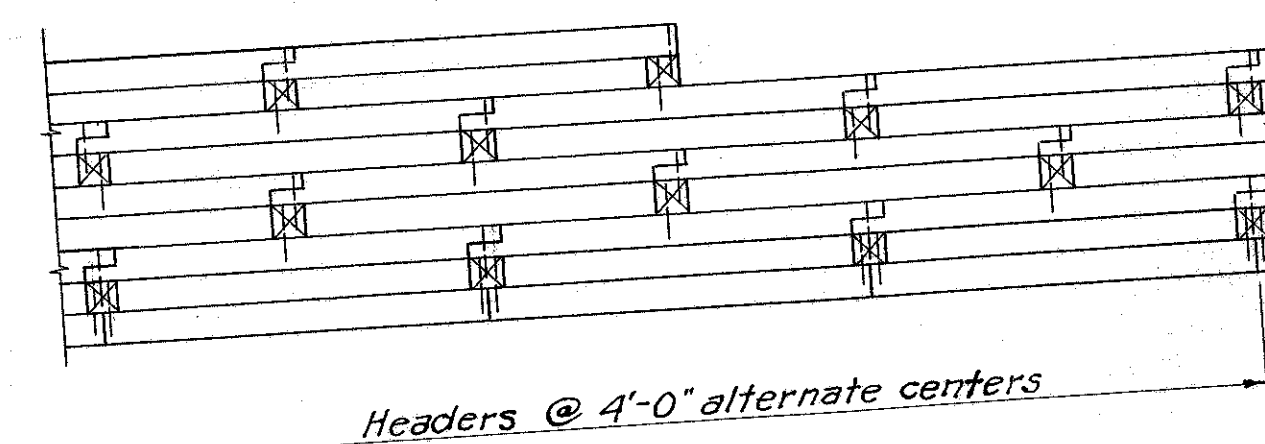


SPLICING DETAIL
Scale $\frac{1}{4}$ " = 1'-0"

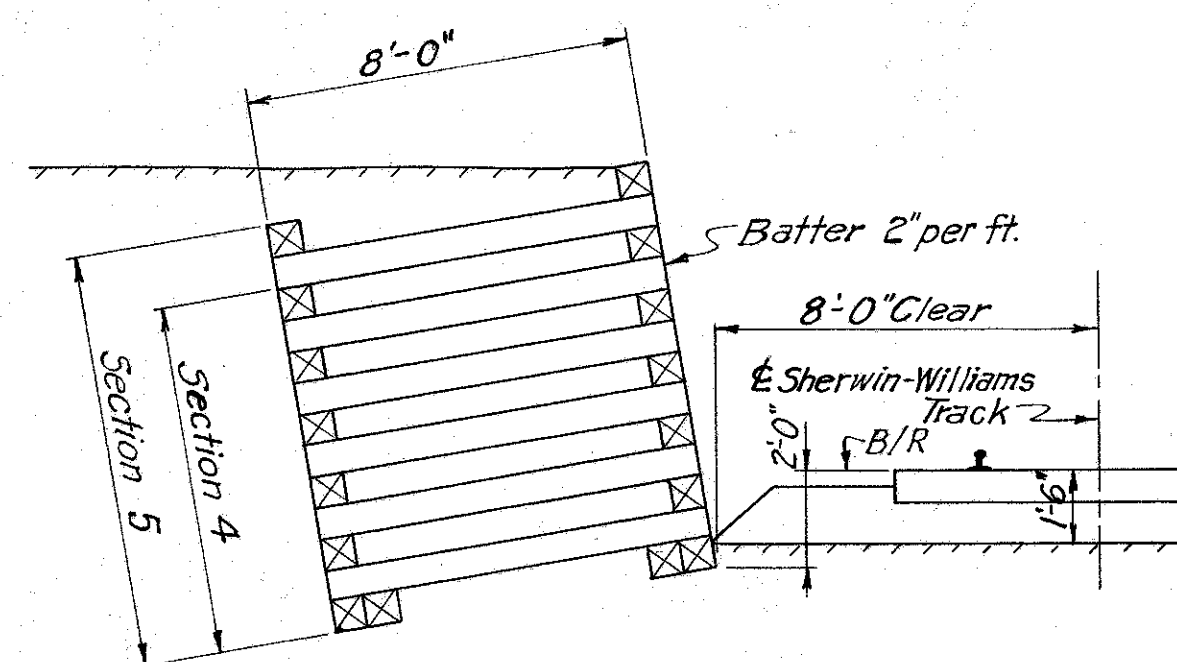

SECTIONS 4 AND 5
Scale $\frac{1}{4}$ " = 1'-0"

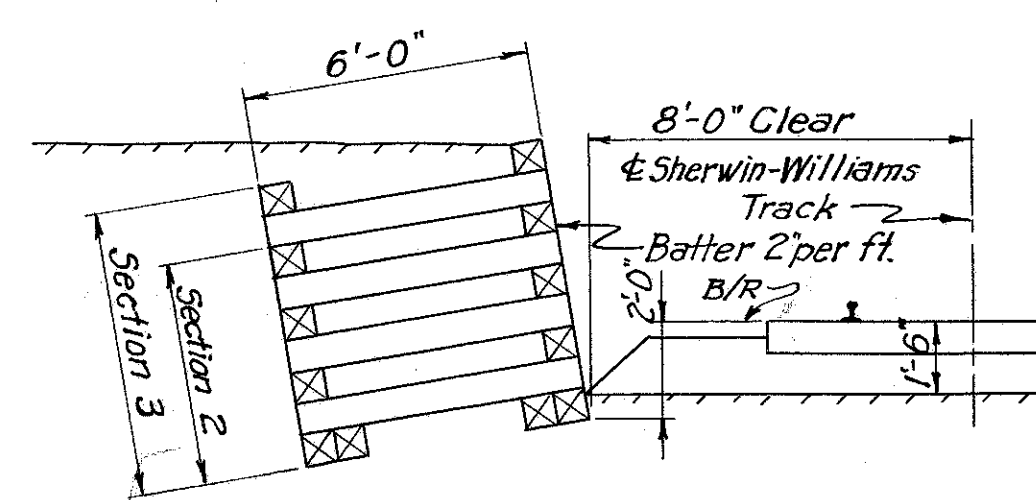

SECTIONS 2 AND 3
Scale $\frac{1}{4}$ " = 1'-0"

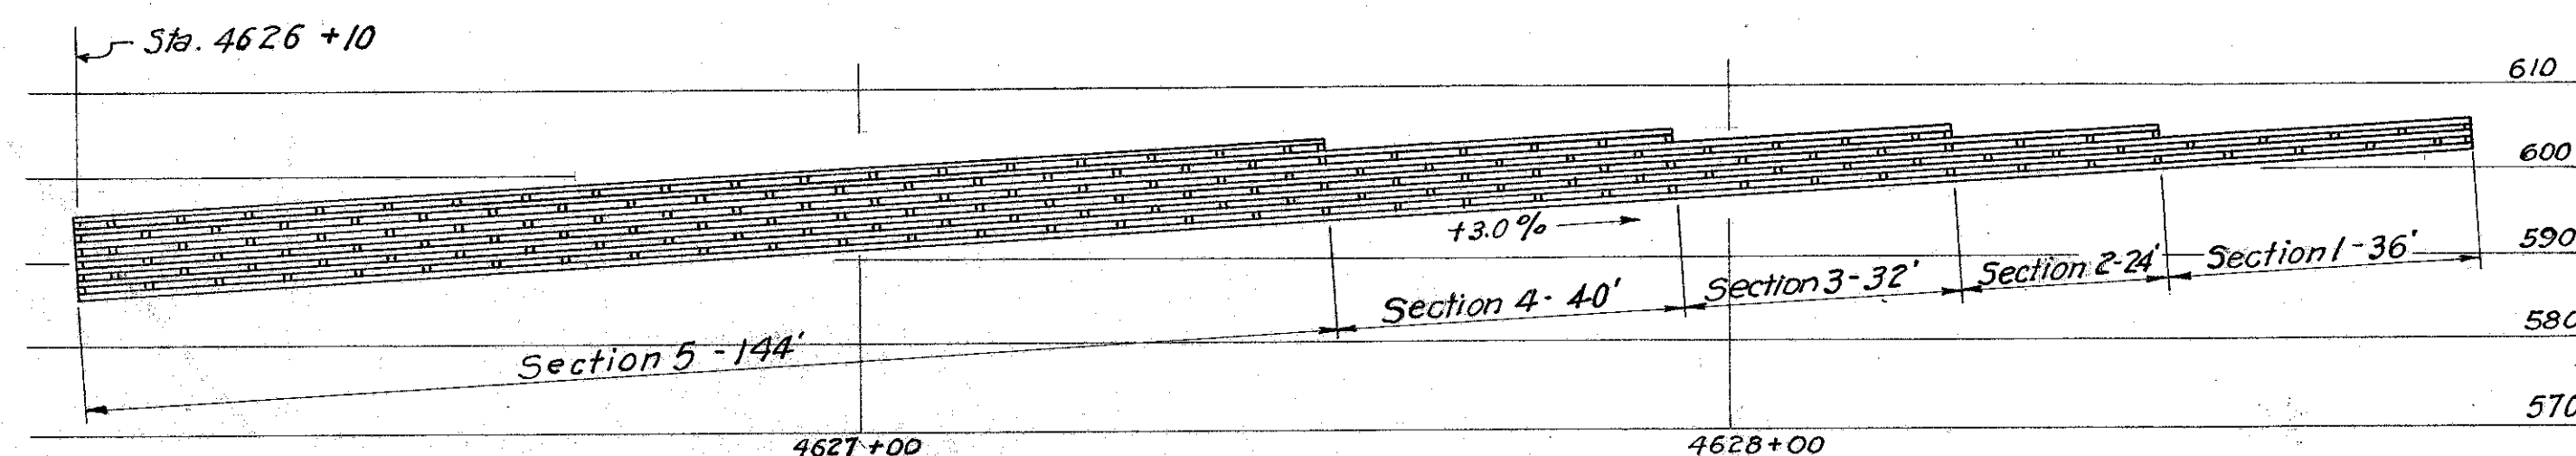


FRONT ELEVATION
Scale 1" = 20'-0"


Note: All timbers are 8" x 8"

TEMPORARY TIMBER CRIB WALL


For location of crib wall in plan, see Sheet 10.

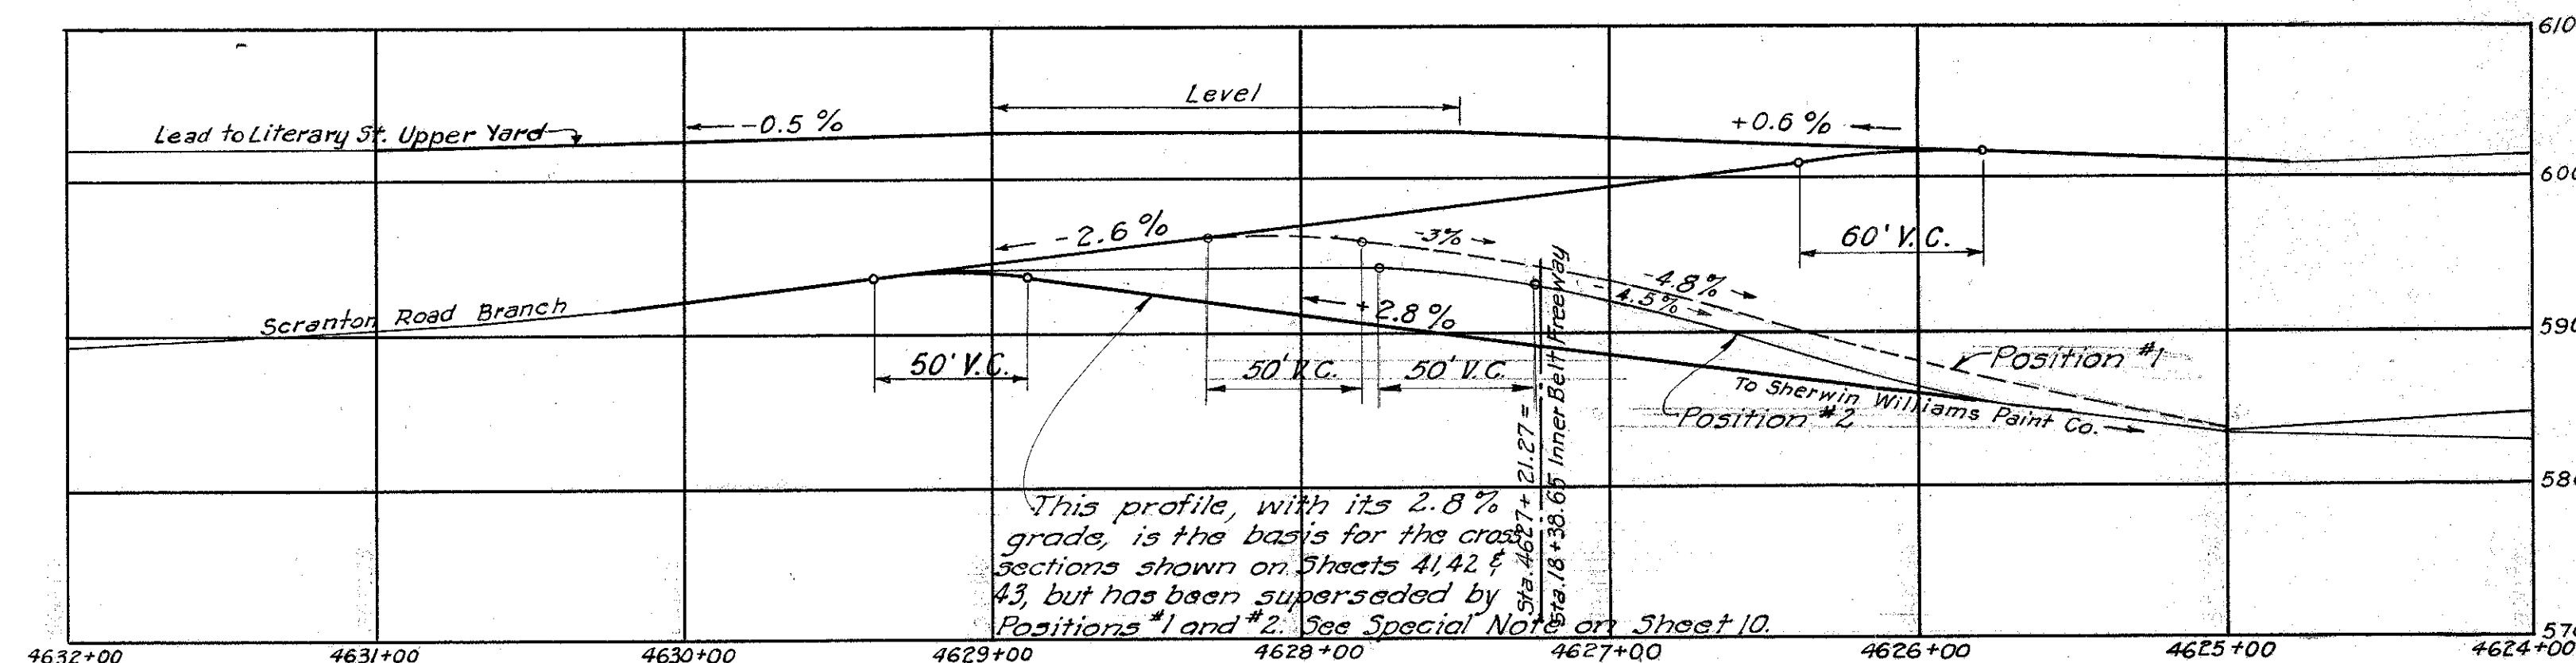

SUBGRADE PROFILES - PHASE I - CONSTRUCTING DOCKWALL

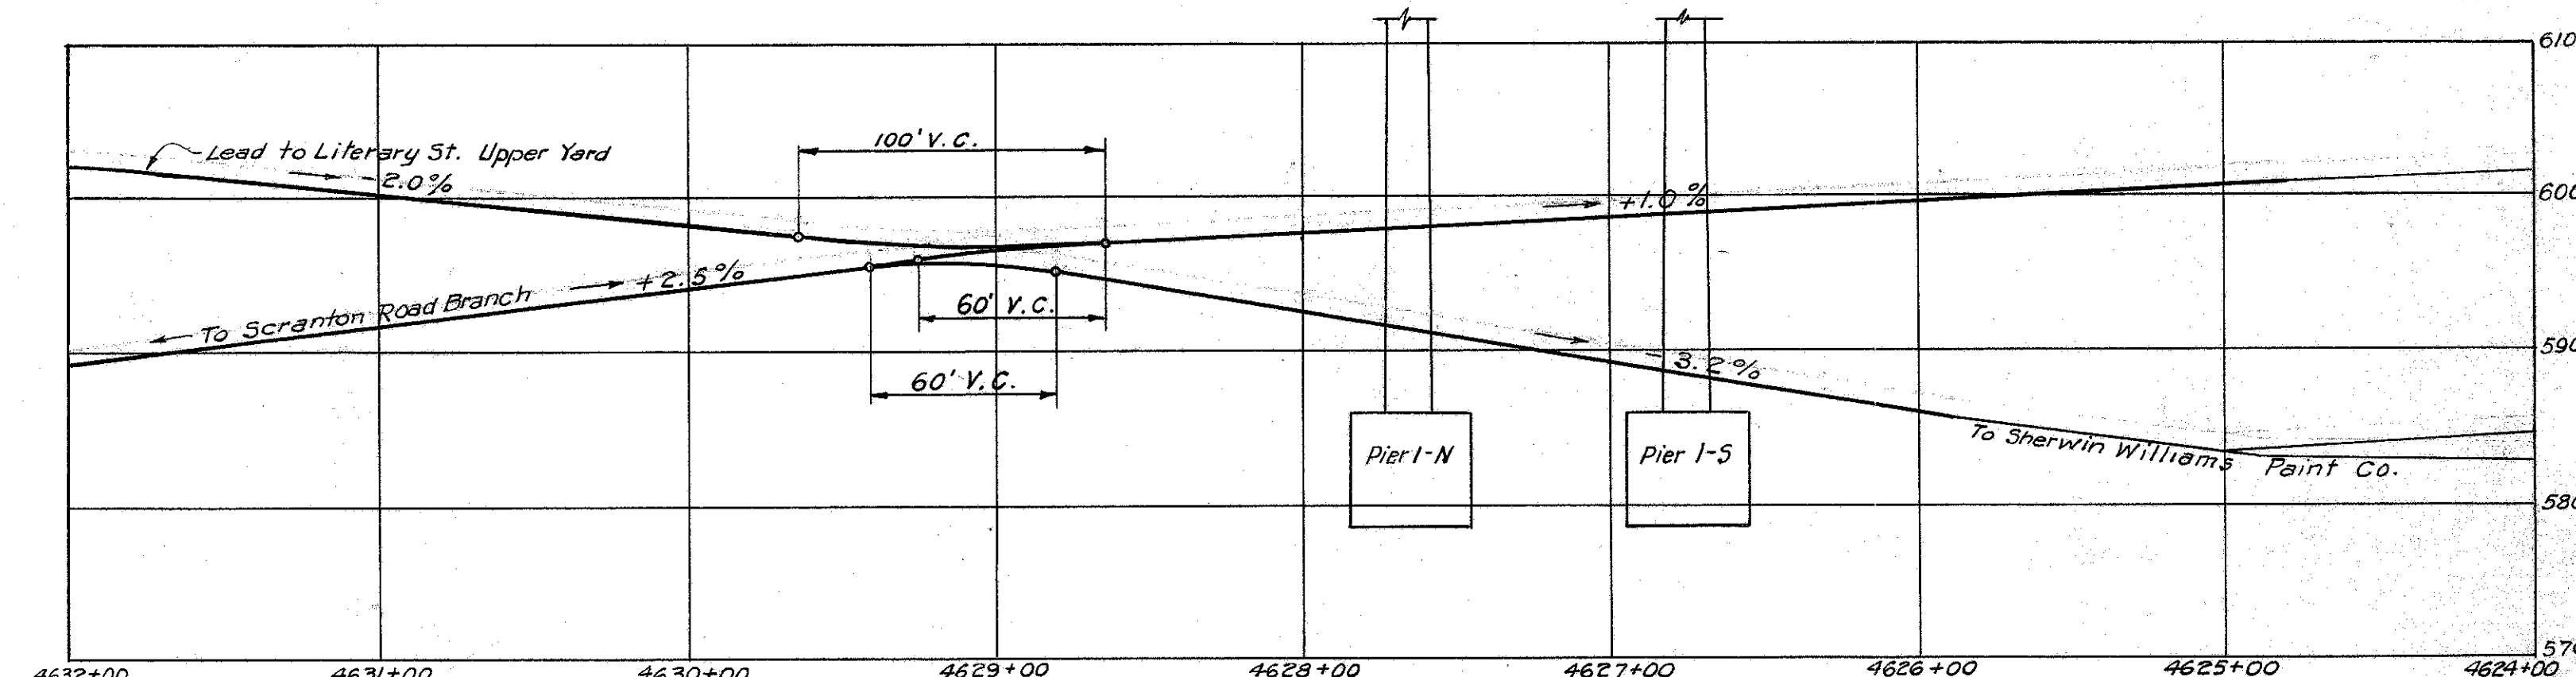

SUBGRADE PROFILES - PHASE II - CONSTRUCTION OF PIERS I-N AND I-S

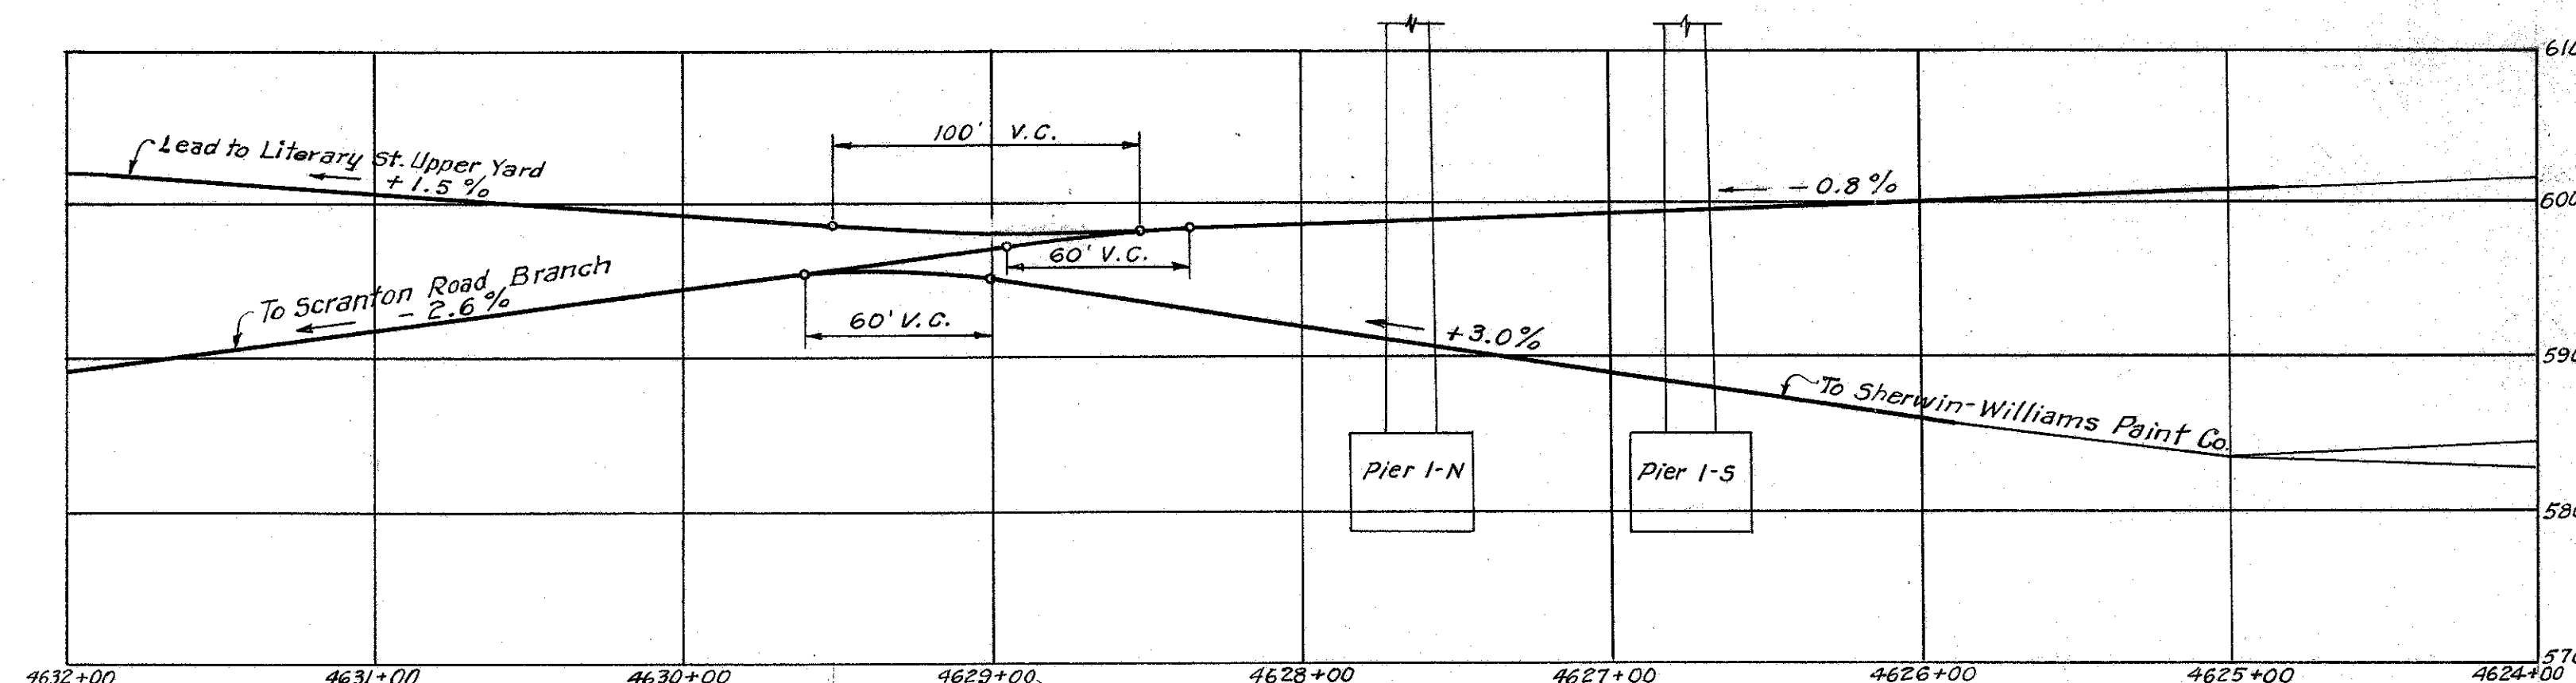

SUBGRADE PROFILES - PHASE III - PERMANENT TRACK LOCATIONS

NOTE (Reference Phase I)
With tracks in position #1, construct entire dockwall and westerly 150' of anchor piles. Install tie rods in easterly 50' of dockwall to within 10' of track in position #1.
With tracks in position #2, install easterly 50' of anchor piles and complete tie rod connections.
If necessary, support the easterly 50' of dockwall by temporary shoring.

Note:
Subgrade profiles are shown 1'-0" below base of rail elevations given on Erie Railroad Company drawings D-194, D-195 and D-196 revised Aug. 13, 1954.
For track locations in plan see Sheet 10.
For cross sections parallel to & proposed Central Viaduct see Sheets 41, 42 and 43.
Subgrade Profile Scale: Hor. 1" = 50'-0" Vert. 1" = 10'-0"

FED. ROAD DIV. NO.	STATE	FEDERAL AID PROJECT NO.	TYPE FUNDS
2	OHIO	UI 1057 (4)	

CUYAHOGA COUNTY
CITY OF CLEVELAND
INNER BELT FREEWAY
CENTRAL VIADUCT
CUY - 42R - 17.50

PART 2

U. S. ROUTE 42 RELOCATION			
INNER BELT FREEWAY - CENTRAL VIADUCT			
BR. NO.			
SUBGRADE PROFILES AND			
TEMPORARY TIMBER CRIB DETAILS			
CLEVELAND	CUYAHOGA COUNTY	OHIO	
SCALE: <i>As Shown</i>			
MADE <i>D.L.C.</i> DATE <i>8-30-54</i>			
TRCD <i>2/75</i> DATE <i>8-30-54</i>			
CKD <i>J.G.S.</i> DATE <i>9-1-54</i>			
HOWARD, NEEDLES, TAMMEN & BERGENDOFF		CONSULTING ENGINEERS	
KANSAS CITY	CLEVELAND	NEW YORK	
914-1A		SHEET	1. 40


MICROFILMED
FEB 23 1983

W.B. Main

FED. ROAD DIV. NO.	STATE	FEDERAL AID PROJECT NO.	TYPE FUNDS
2	OHIO	UI 1057 (4)	


41
43

CUYAHOGA COUNTY
CITY OF CLEVELAND
INNER BELT FREEWAY
CENTRAL VIADUCT
CUI - 42R - 17.50

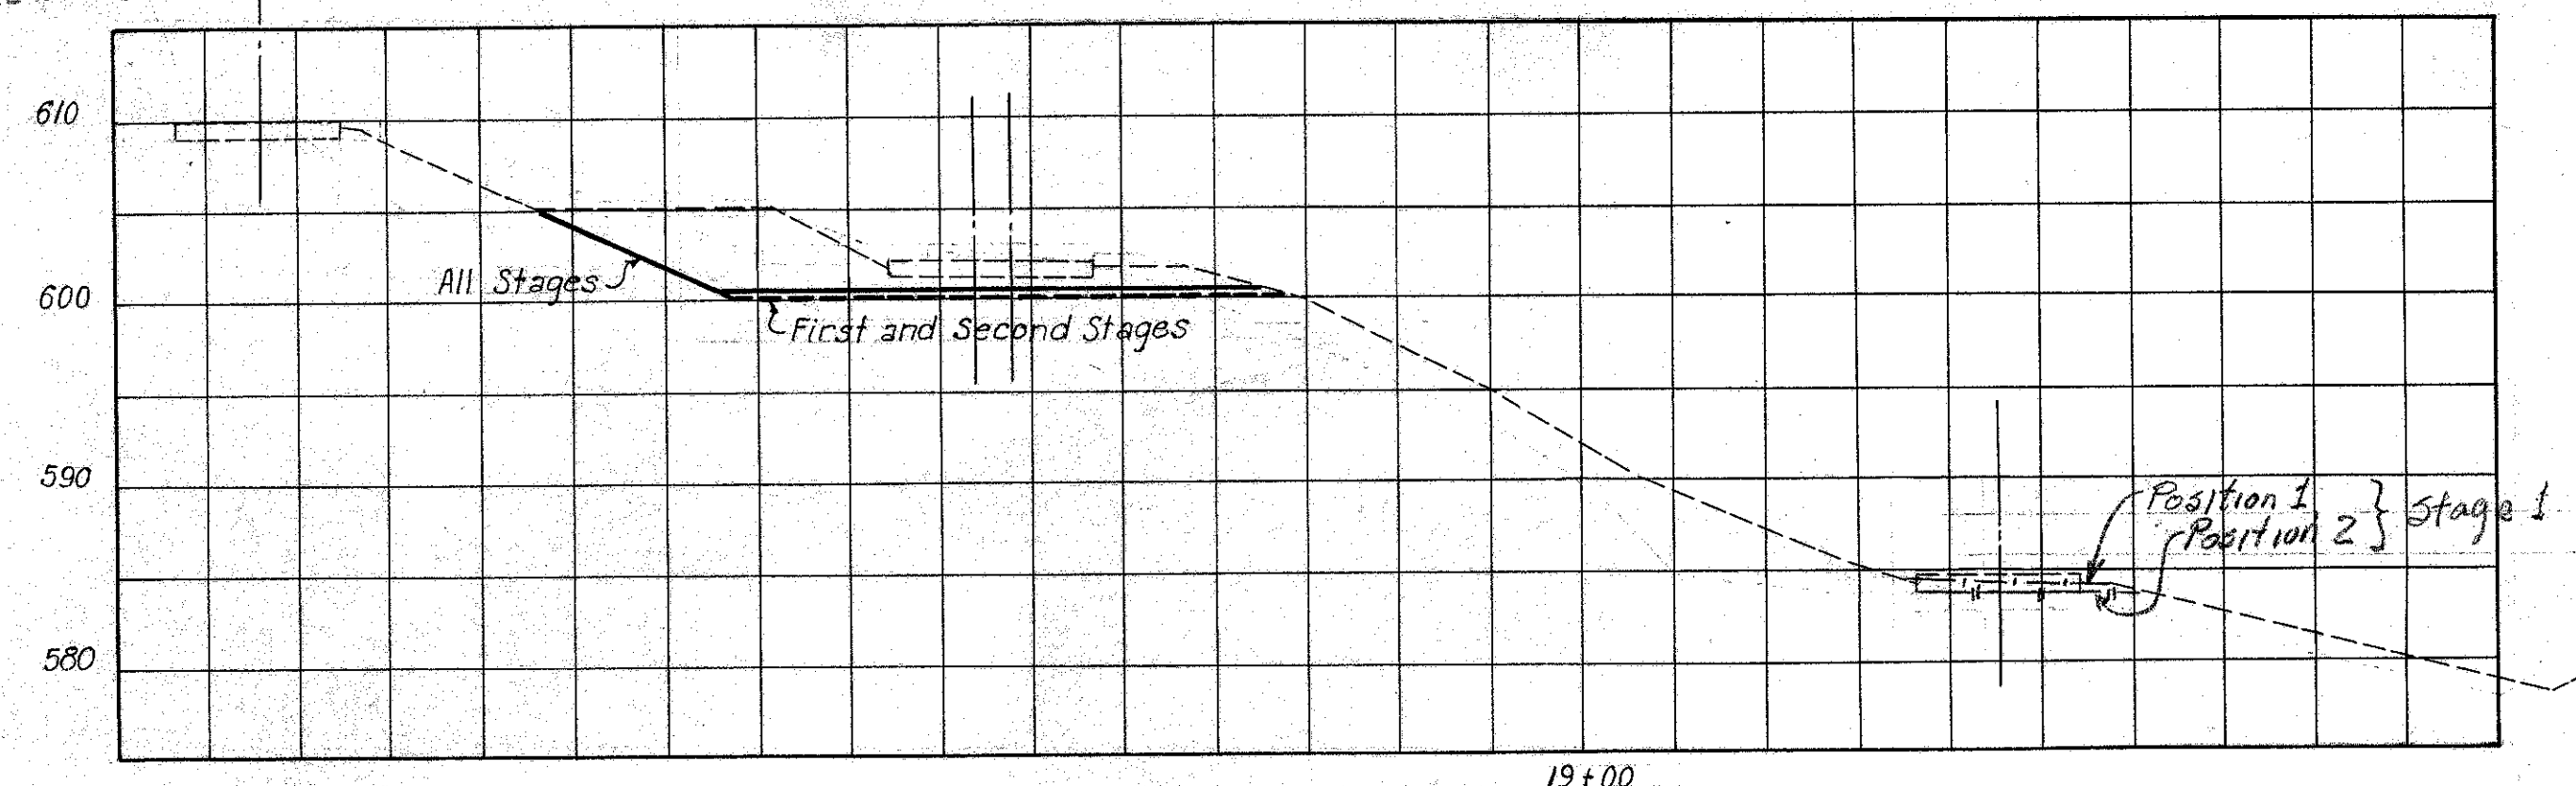


W.B. Main

200 FEET RIGHT OF VIADUCT C

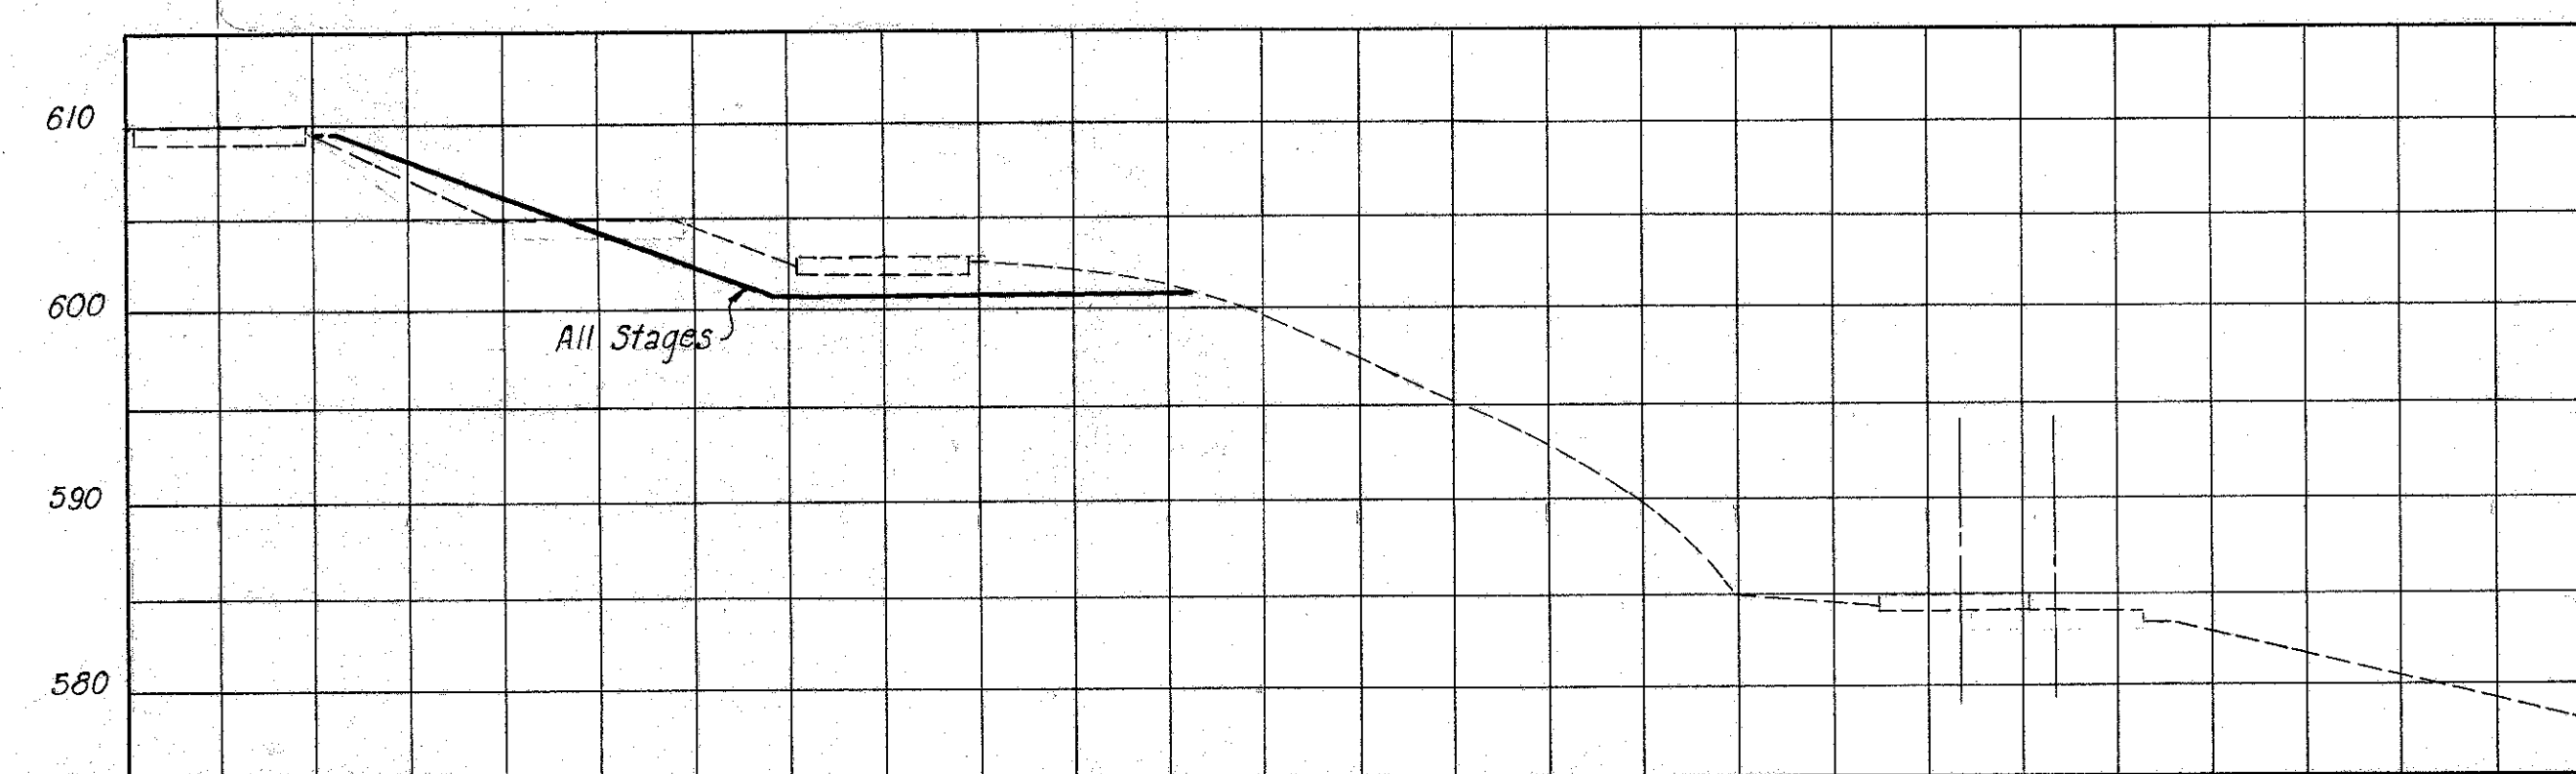


W.B. Main

250 FEET RIGHT OF VIADUCT C

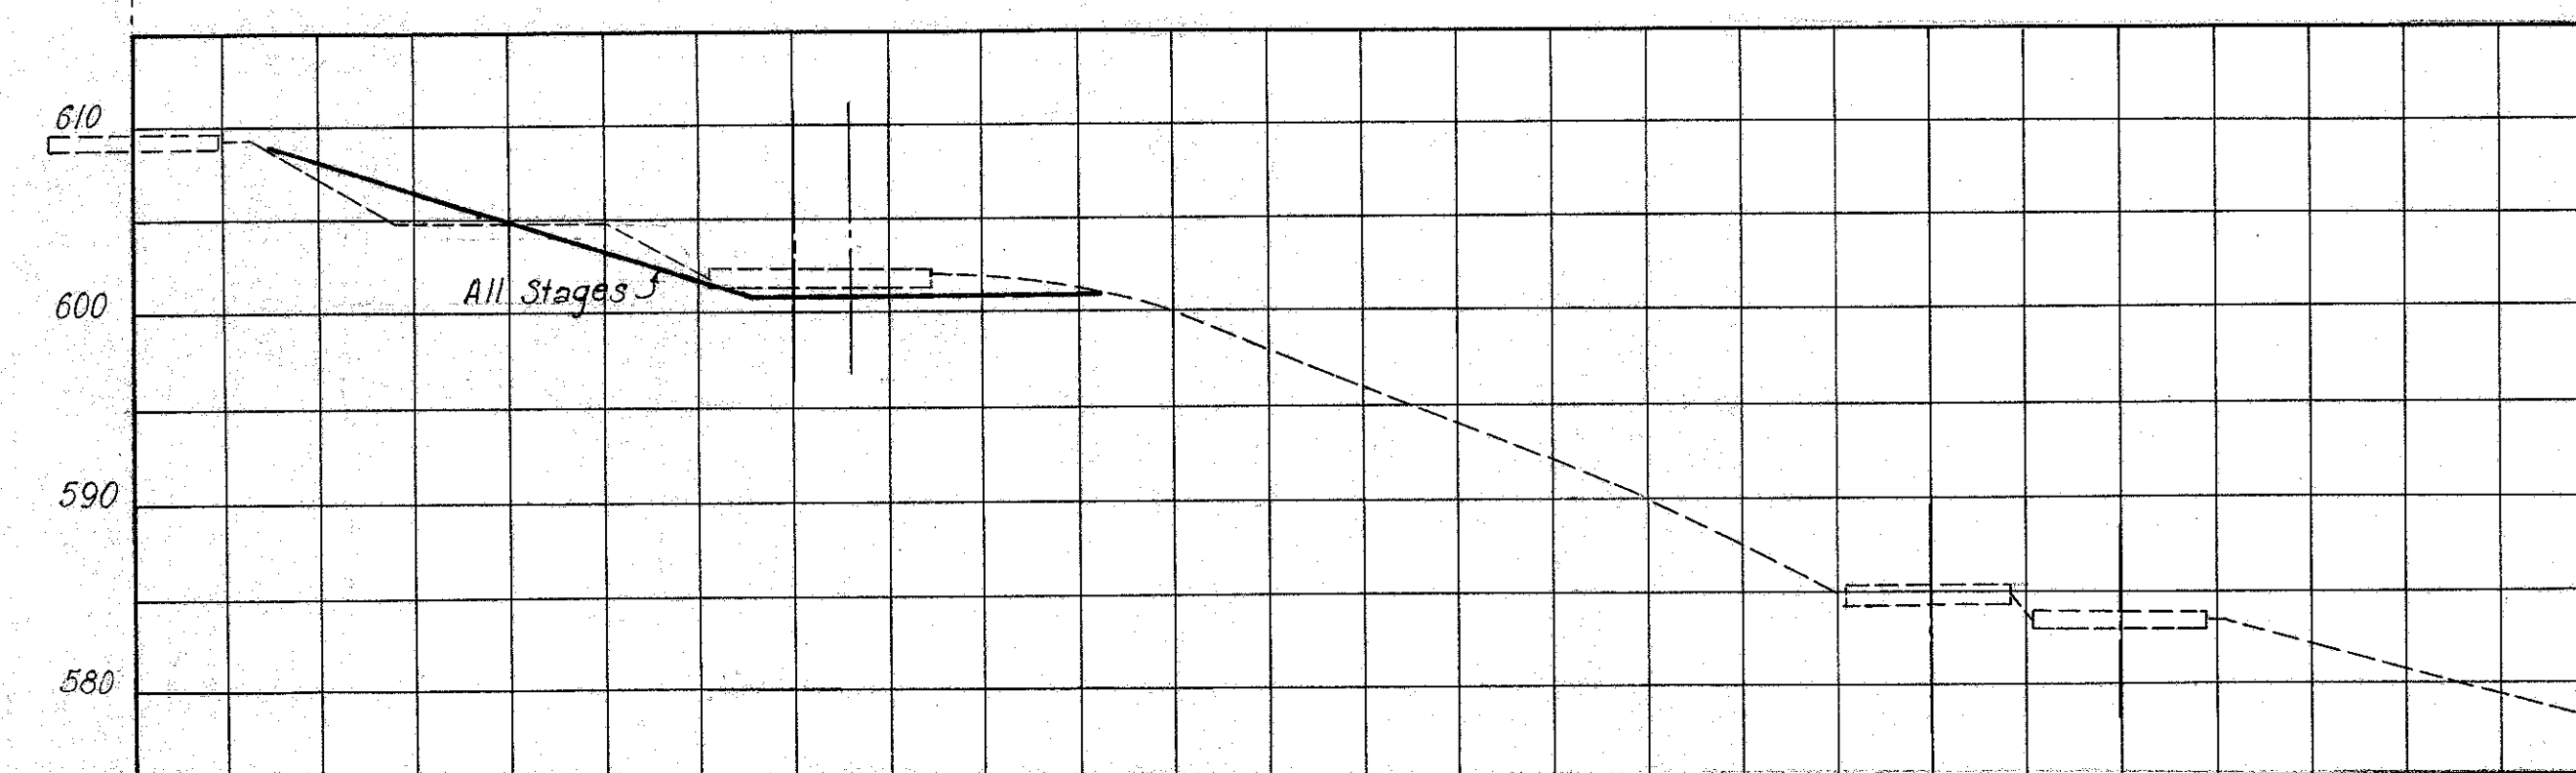

W.B. Main


300 FEET RIGHT OF VIADUCT C

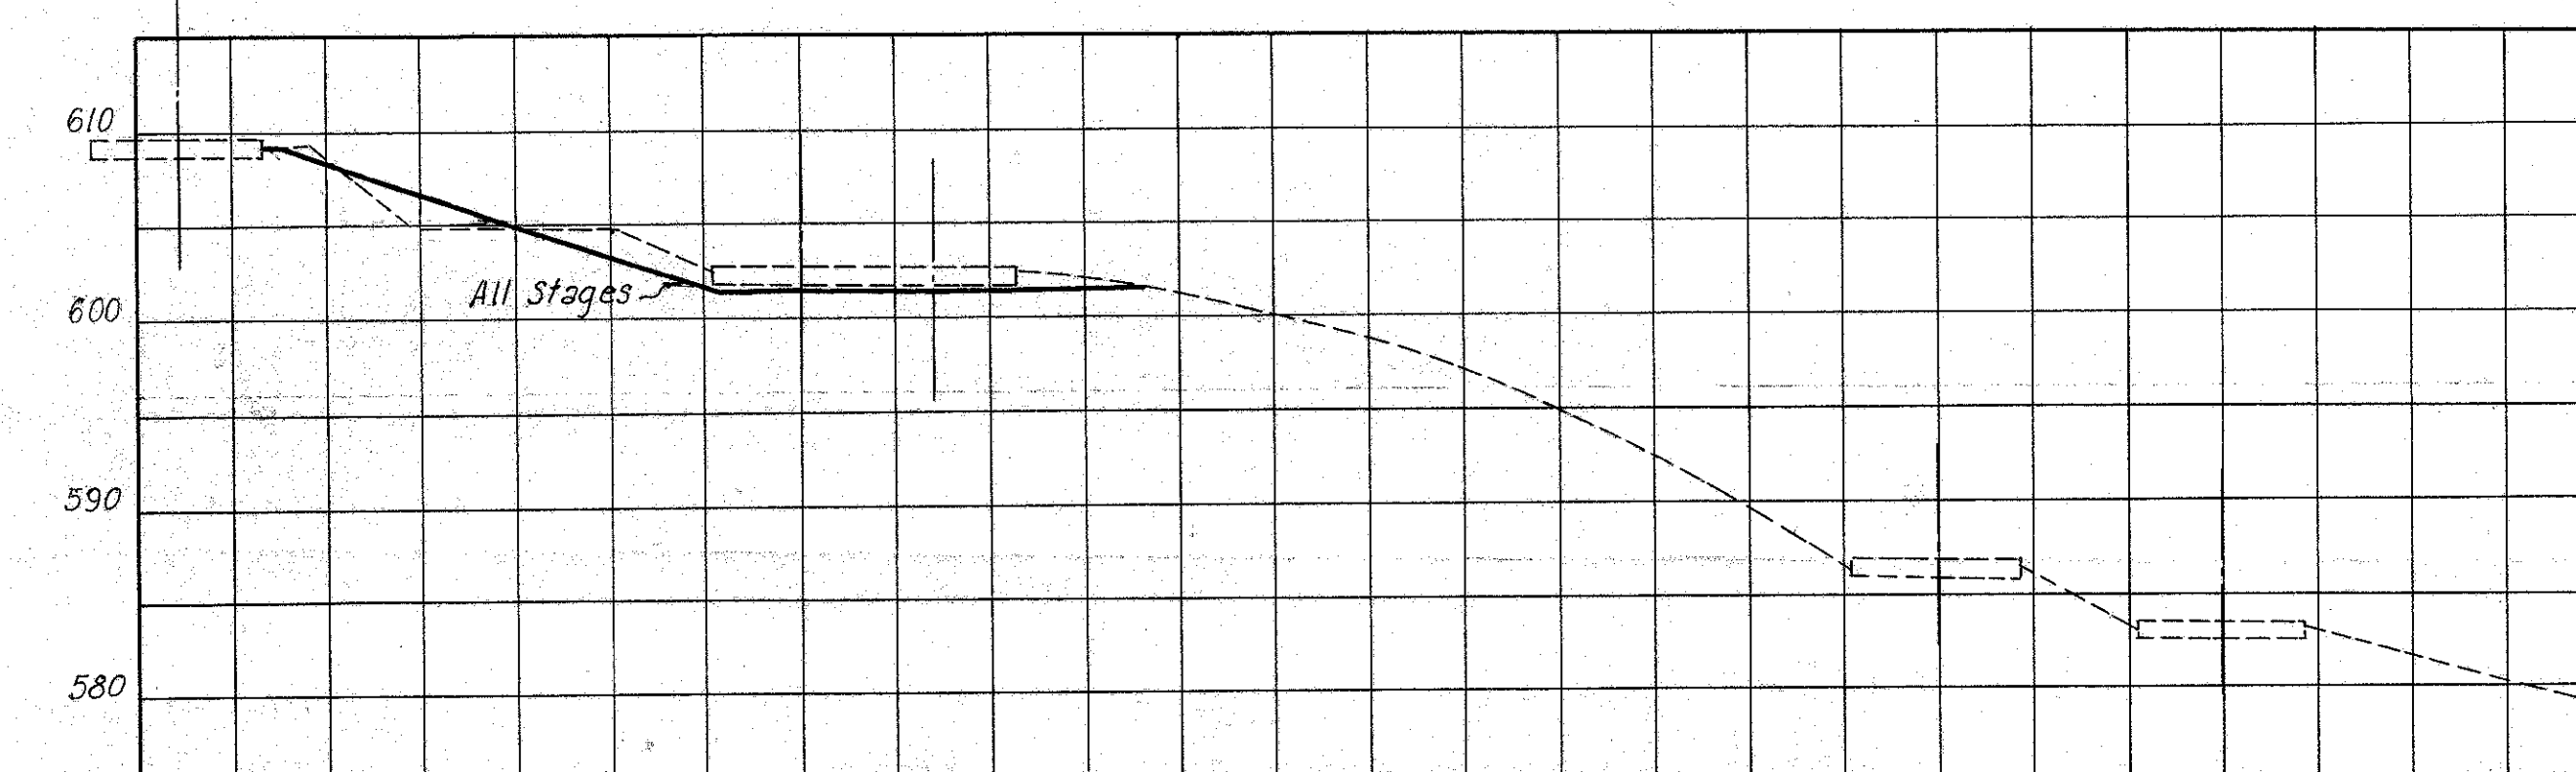

19+00

350 FEET RIGHT OF VIADUCT C

W.B. Main

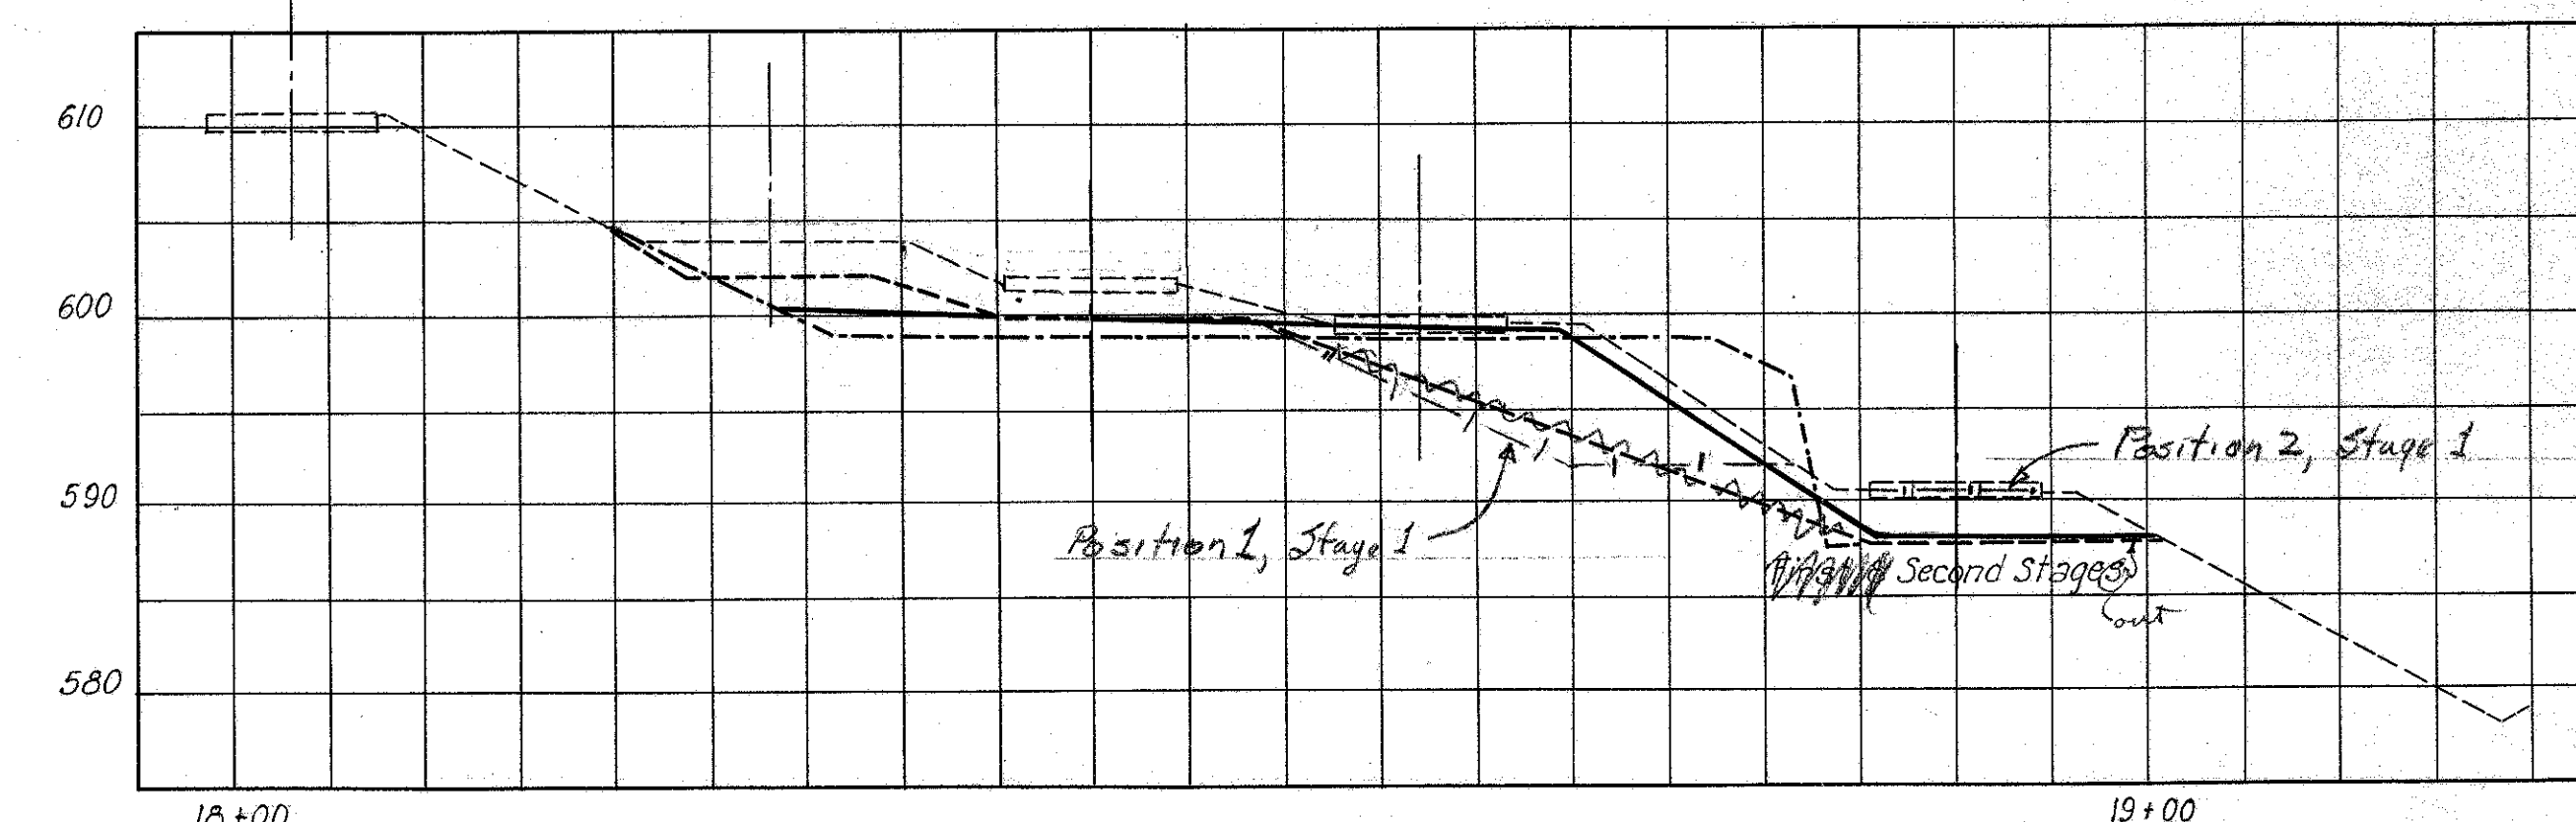


18+00

19+00

W.B. Main

50 FEET RIGHT OF VIADUCT C

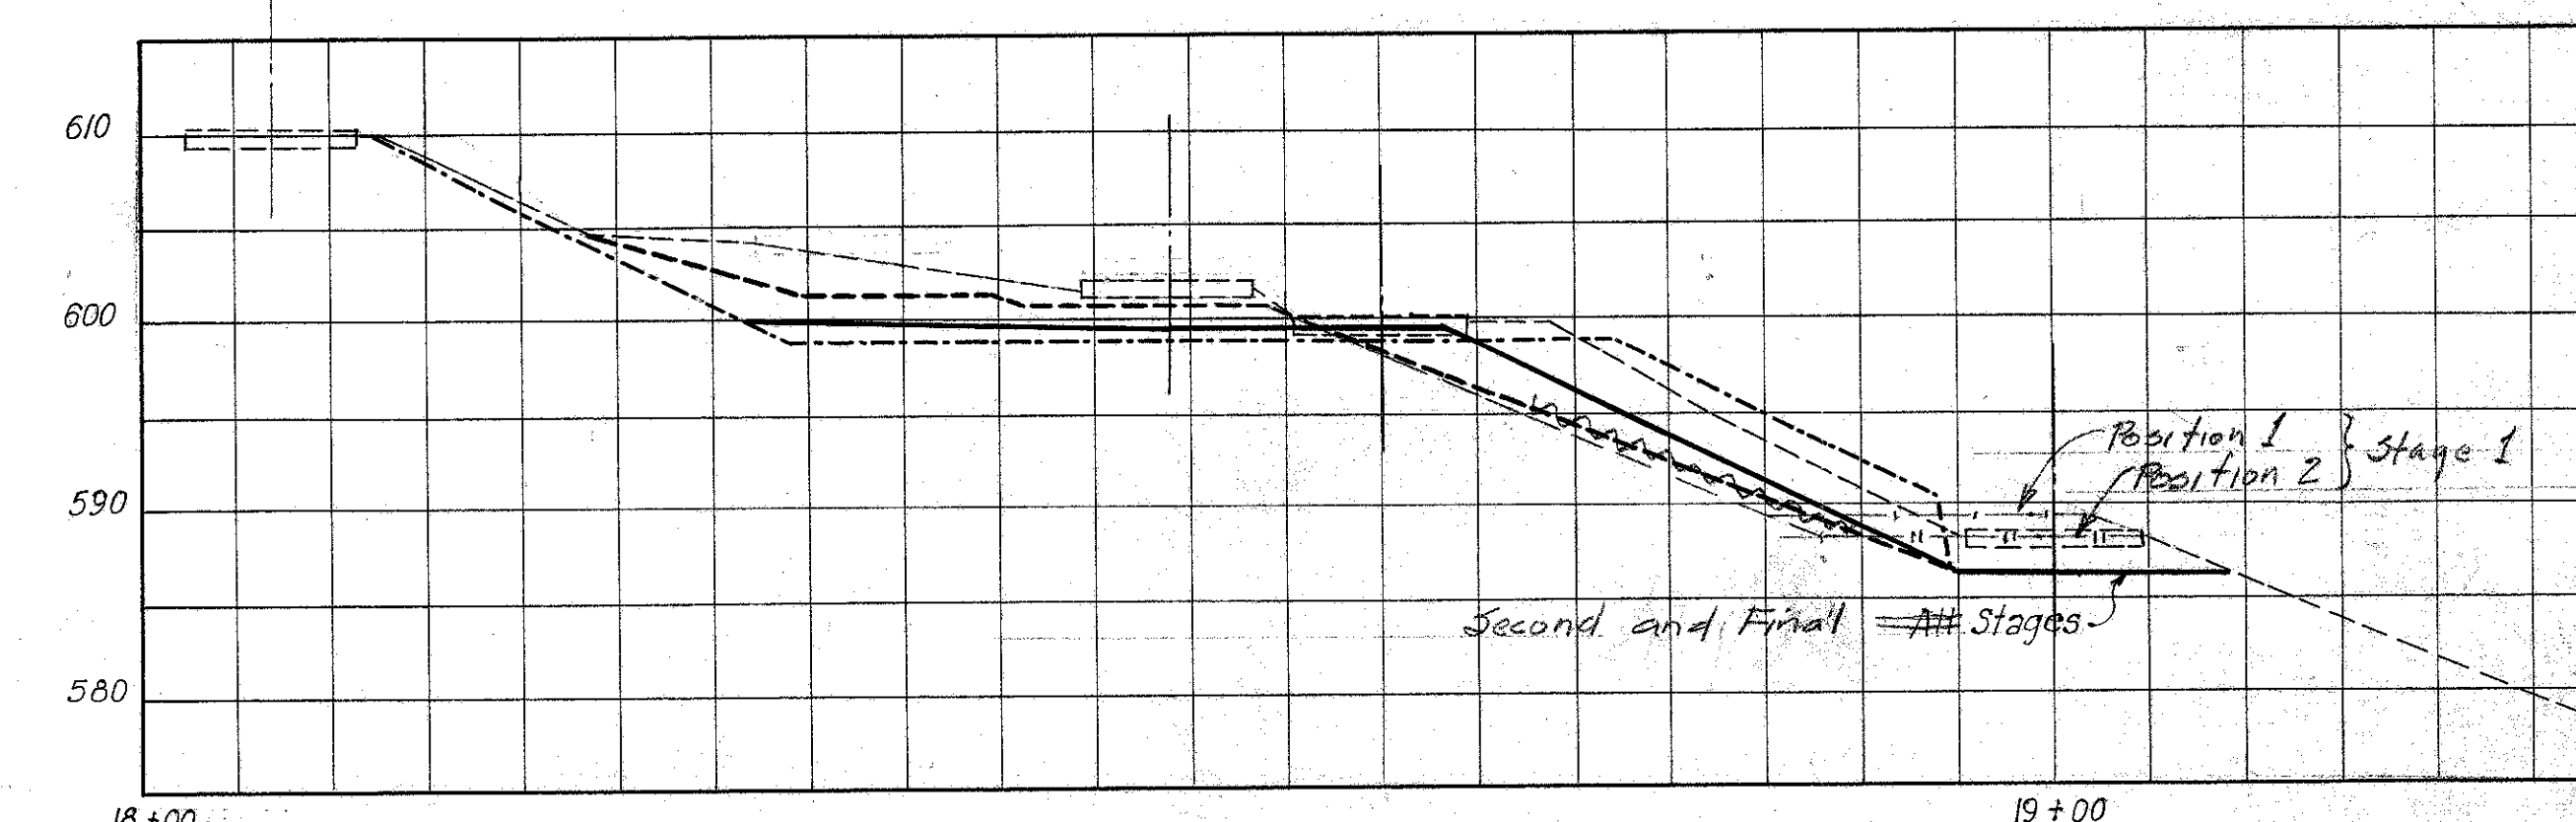


18+00

19+00

W.B. Main

100 FEET RIGHT OF VIADUCT C

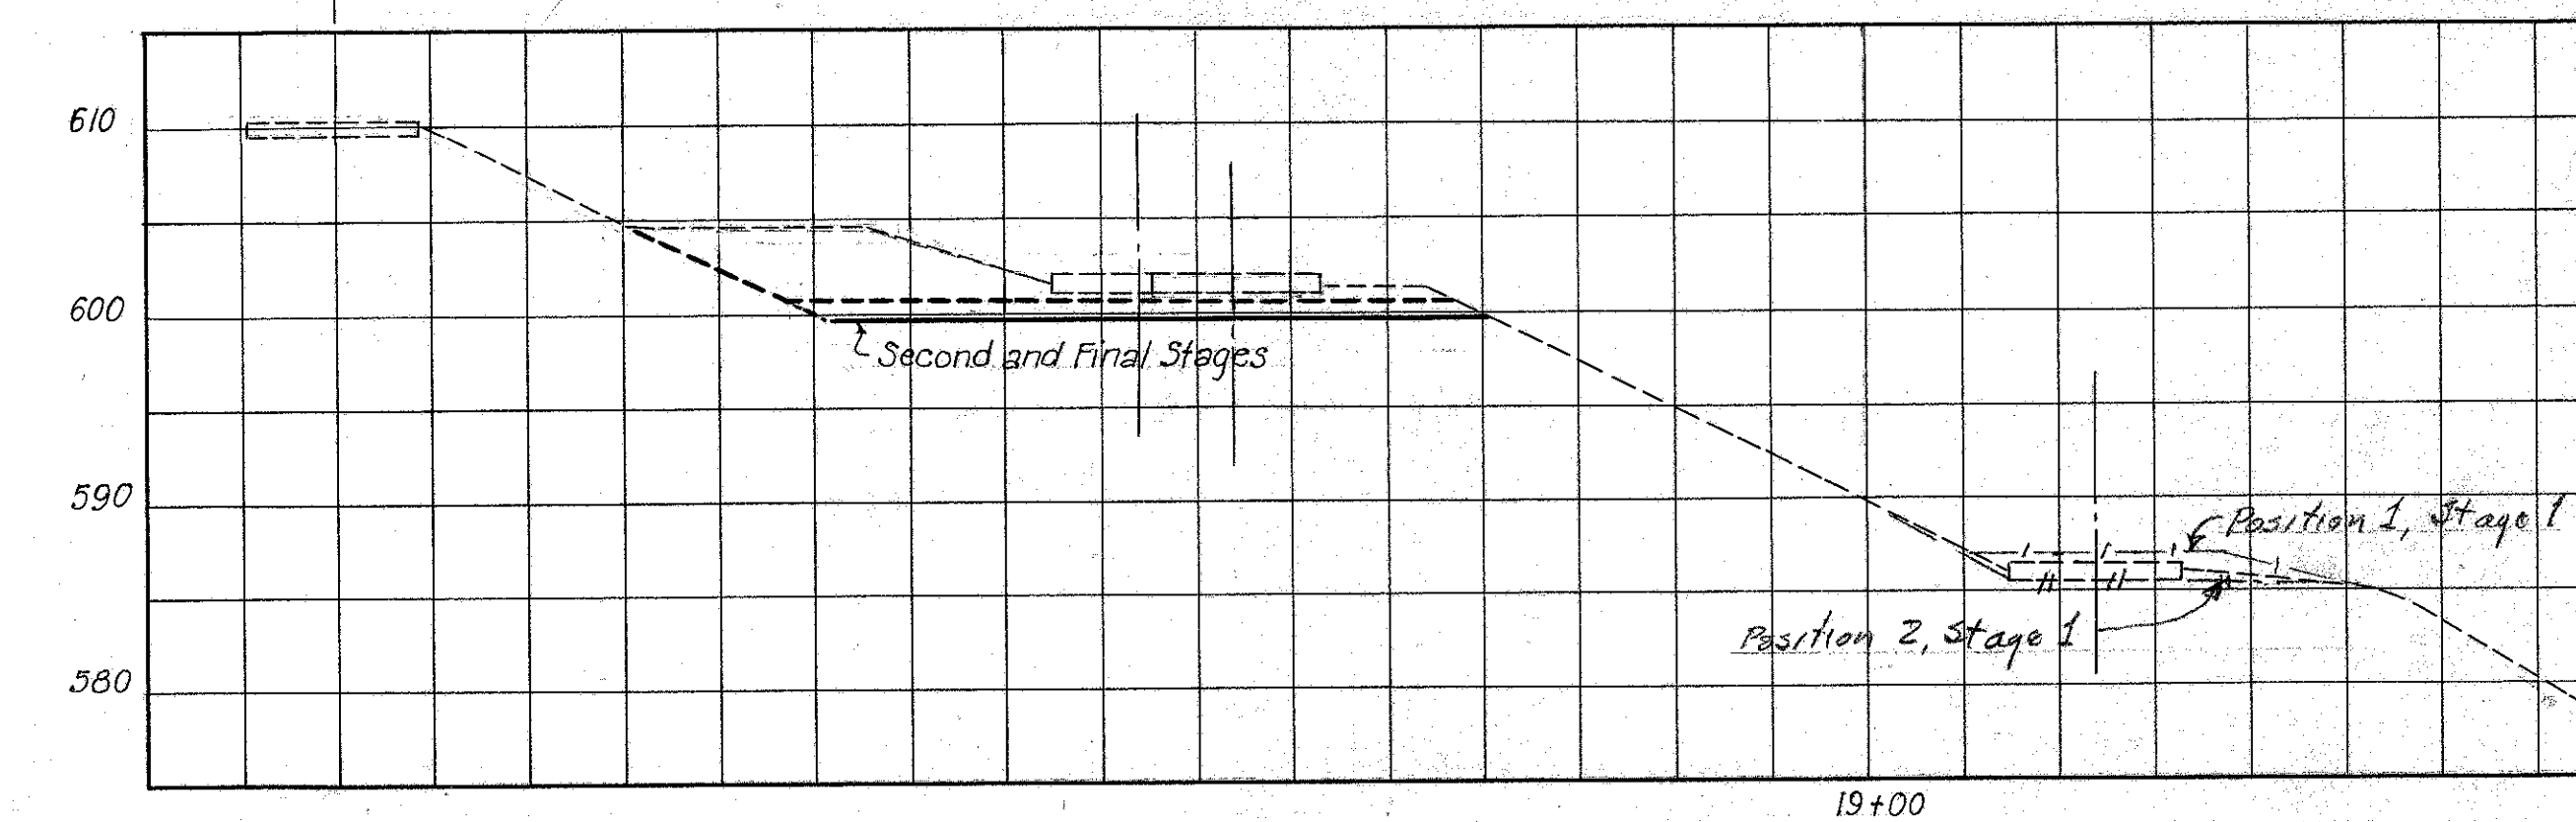

19+00

150 FEET RIGHT OF VIADUCT C

LEGEND
Original ground line
First stage - build anchor and dock wall
Second stage - shift tracks to build footing
Final condition

Note:
Original ground line as shown by Erie Railroad Co.
Track Cross Sections Inner Belt Freeway Viaduct
at M.P. 1.58 July 7, 1954.
For track locations in plan see Sheet 10.
For profiles at C of tracks see Sheet 40.

PENCILED REVISIONS 11-15-54

PART 2

U. S. ROUTE 42 RELOCATION
INNER BELT FREEWAY - CENTRAL VIADUCT


CROSS SECTIONS FOR
CONSTRUCTION IN ERIE RAILROAD YARD

CLEVELAND CUYAHOGA COUNTY OHIO


SCALE: 1" = 10'-0"
MADE: J.G.S. DATE: 8-25-54
TRCD: A.H. DATE: 8-20-54
CKD: J.G.S. DATE: 8-31-54

HOWARD, NEEDLES, TAMMEN & BERGENDOFF
CONSULTING ENGINEERS
KANSAS CITY CLEVELAND NEW YORK
914-1A SHEET 1.41


MICROFILMED
FEB 23 1983

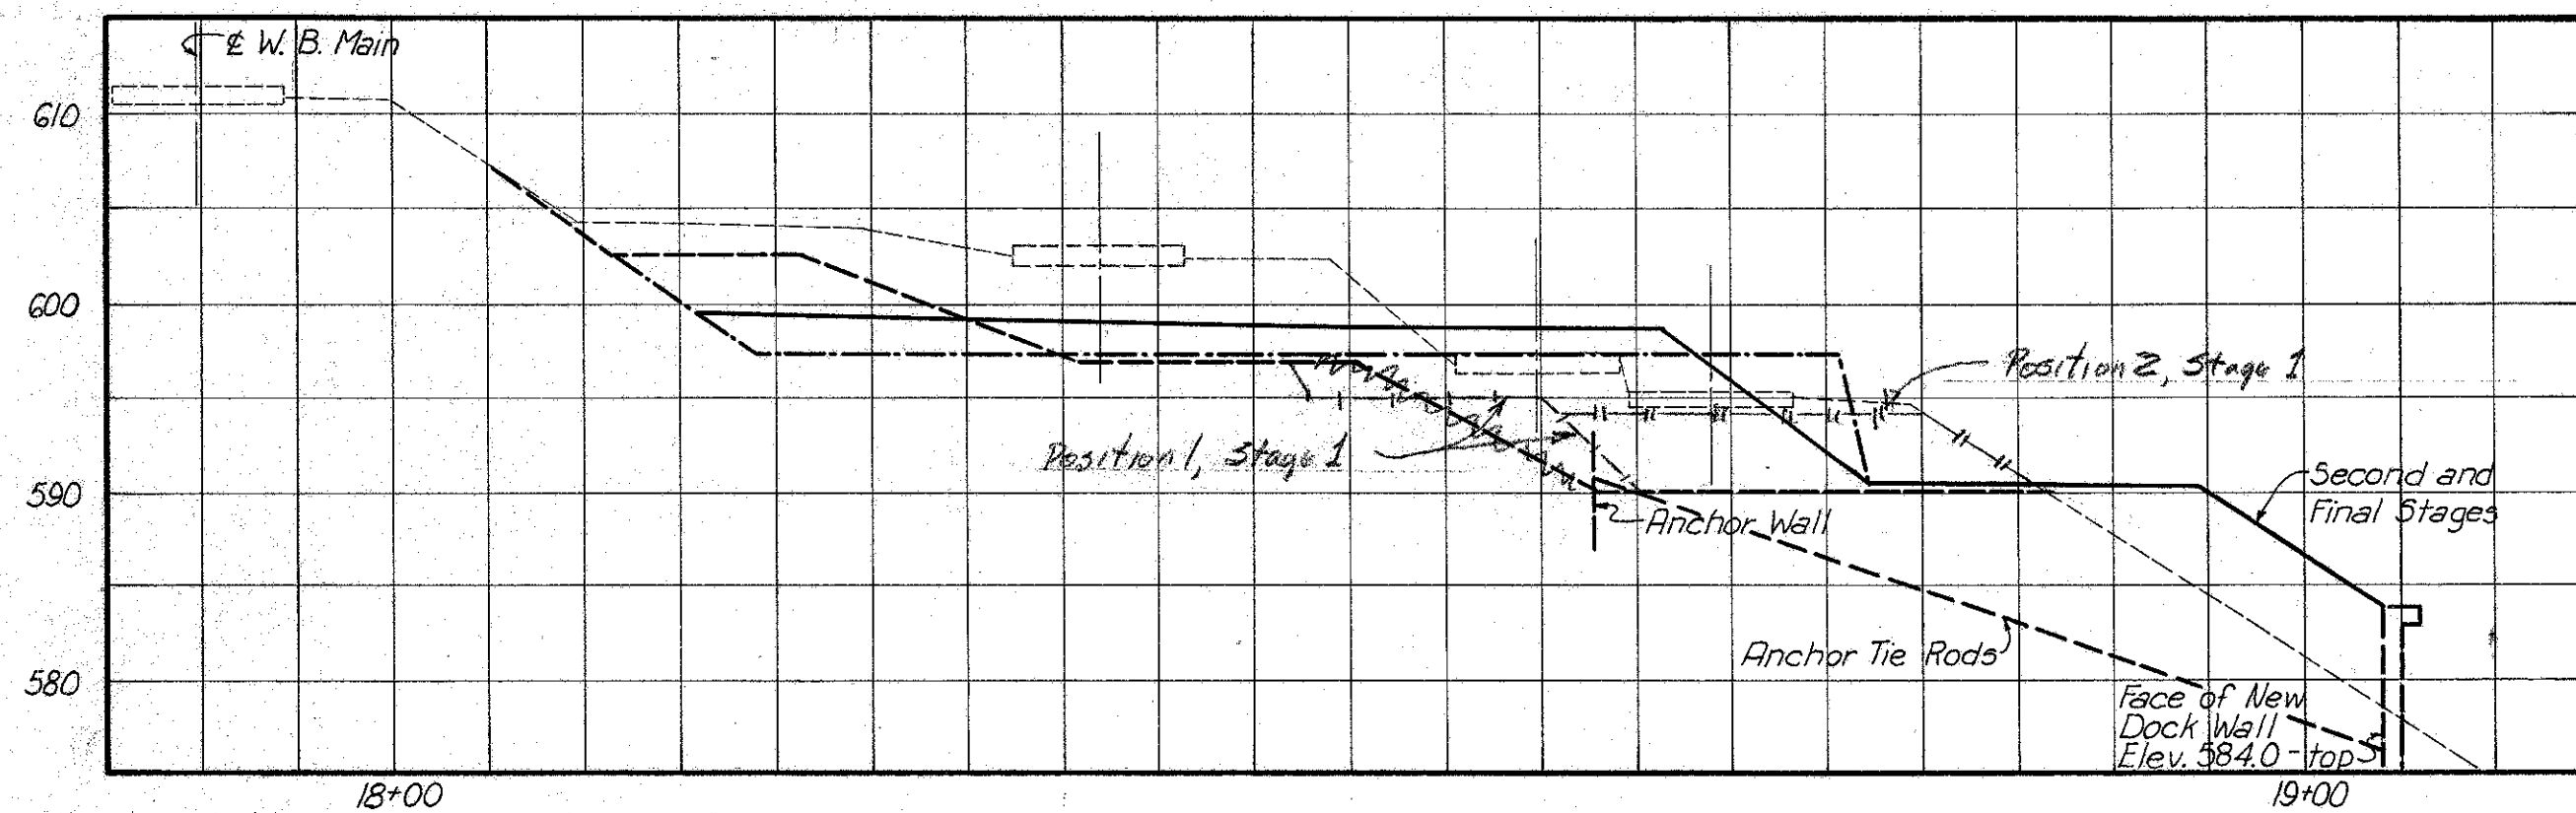


50 FEET LEFT OF VIADUCT C

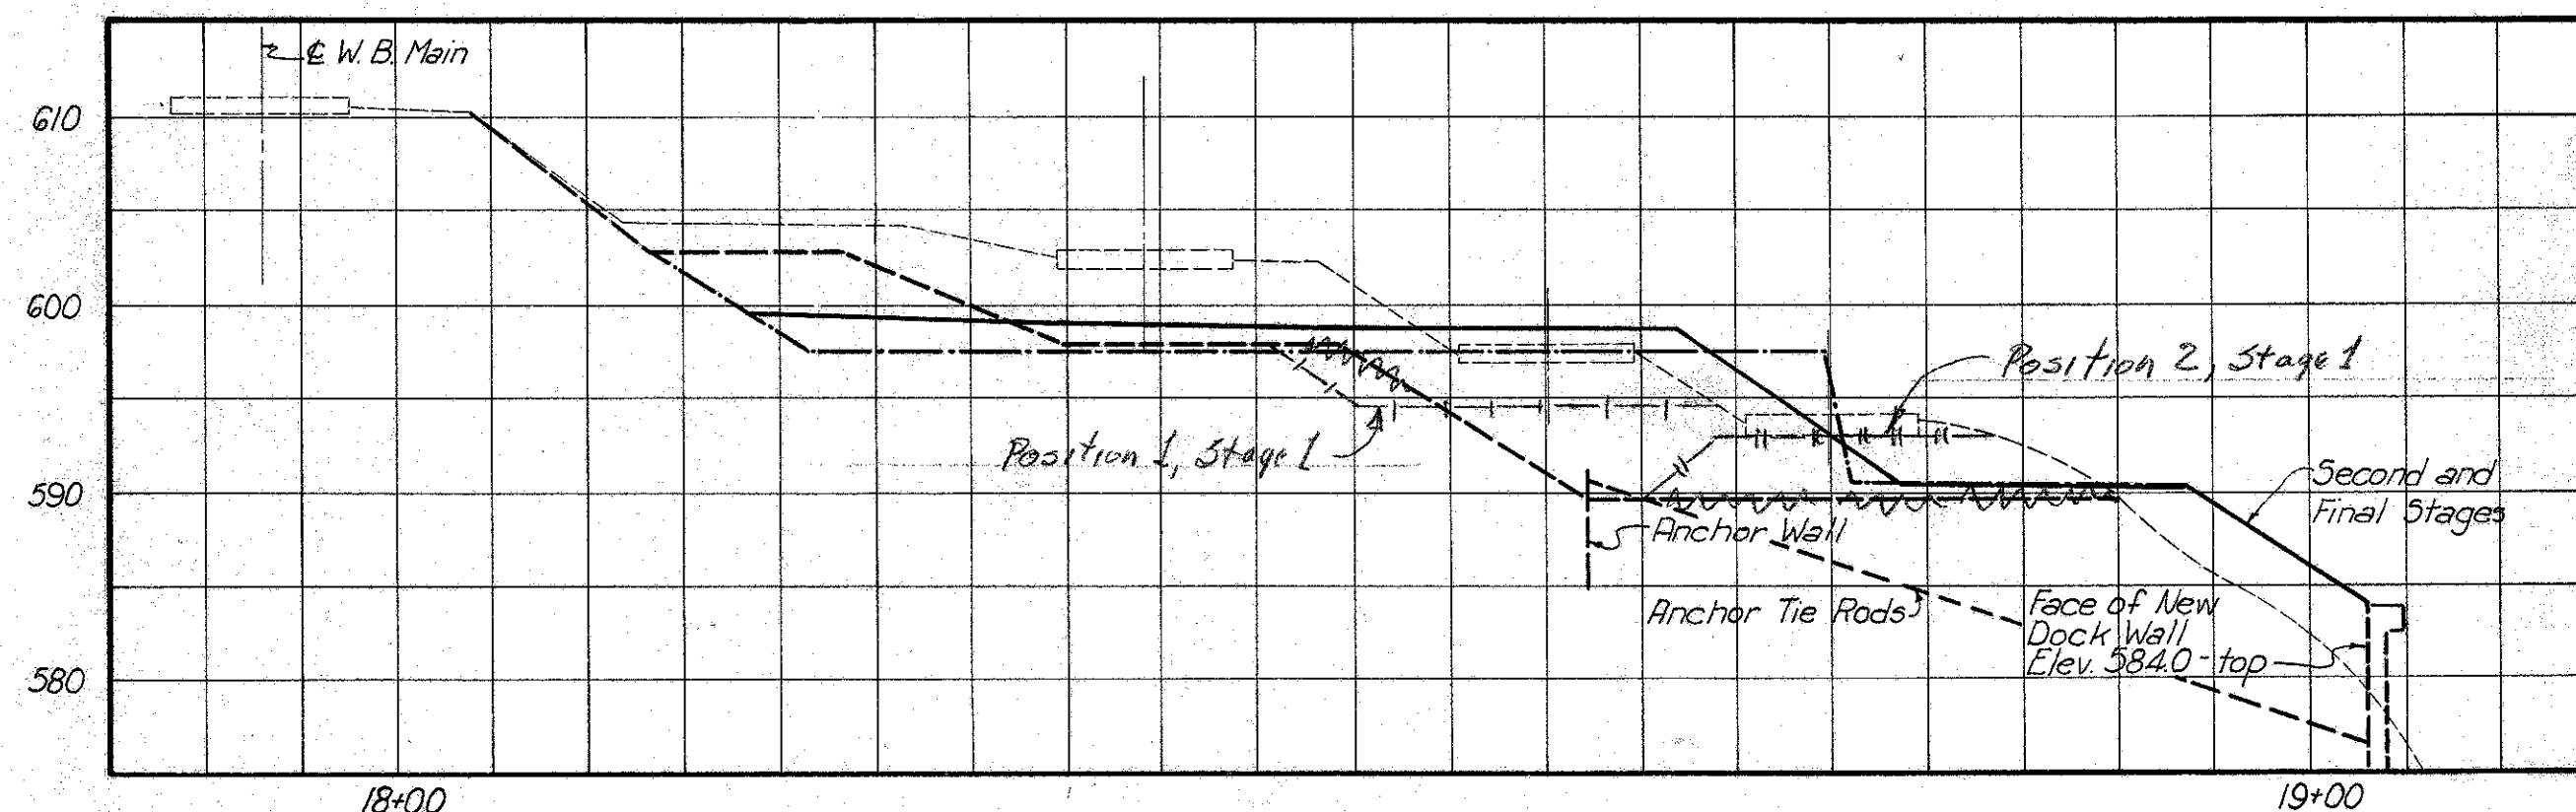


25 FEET LEFT OF VIADUCT C

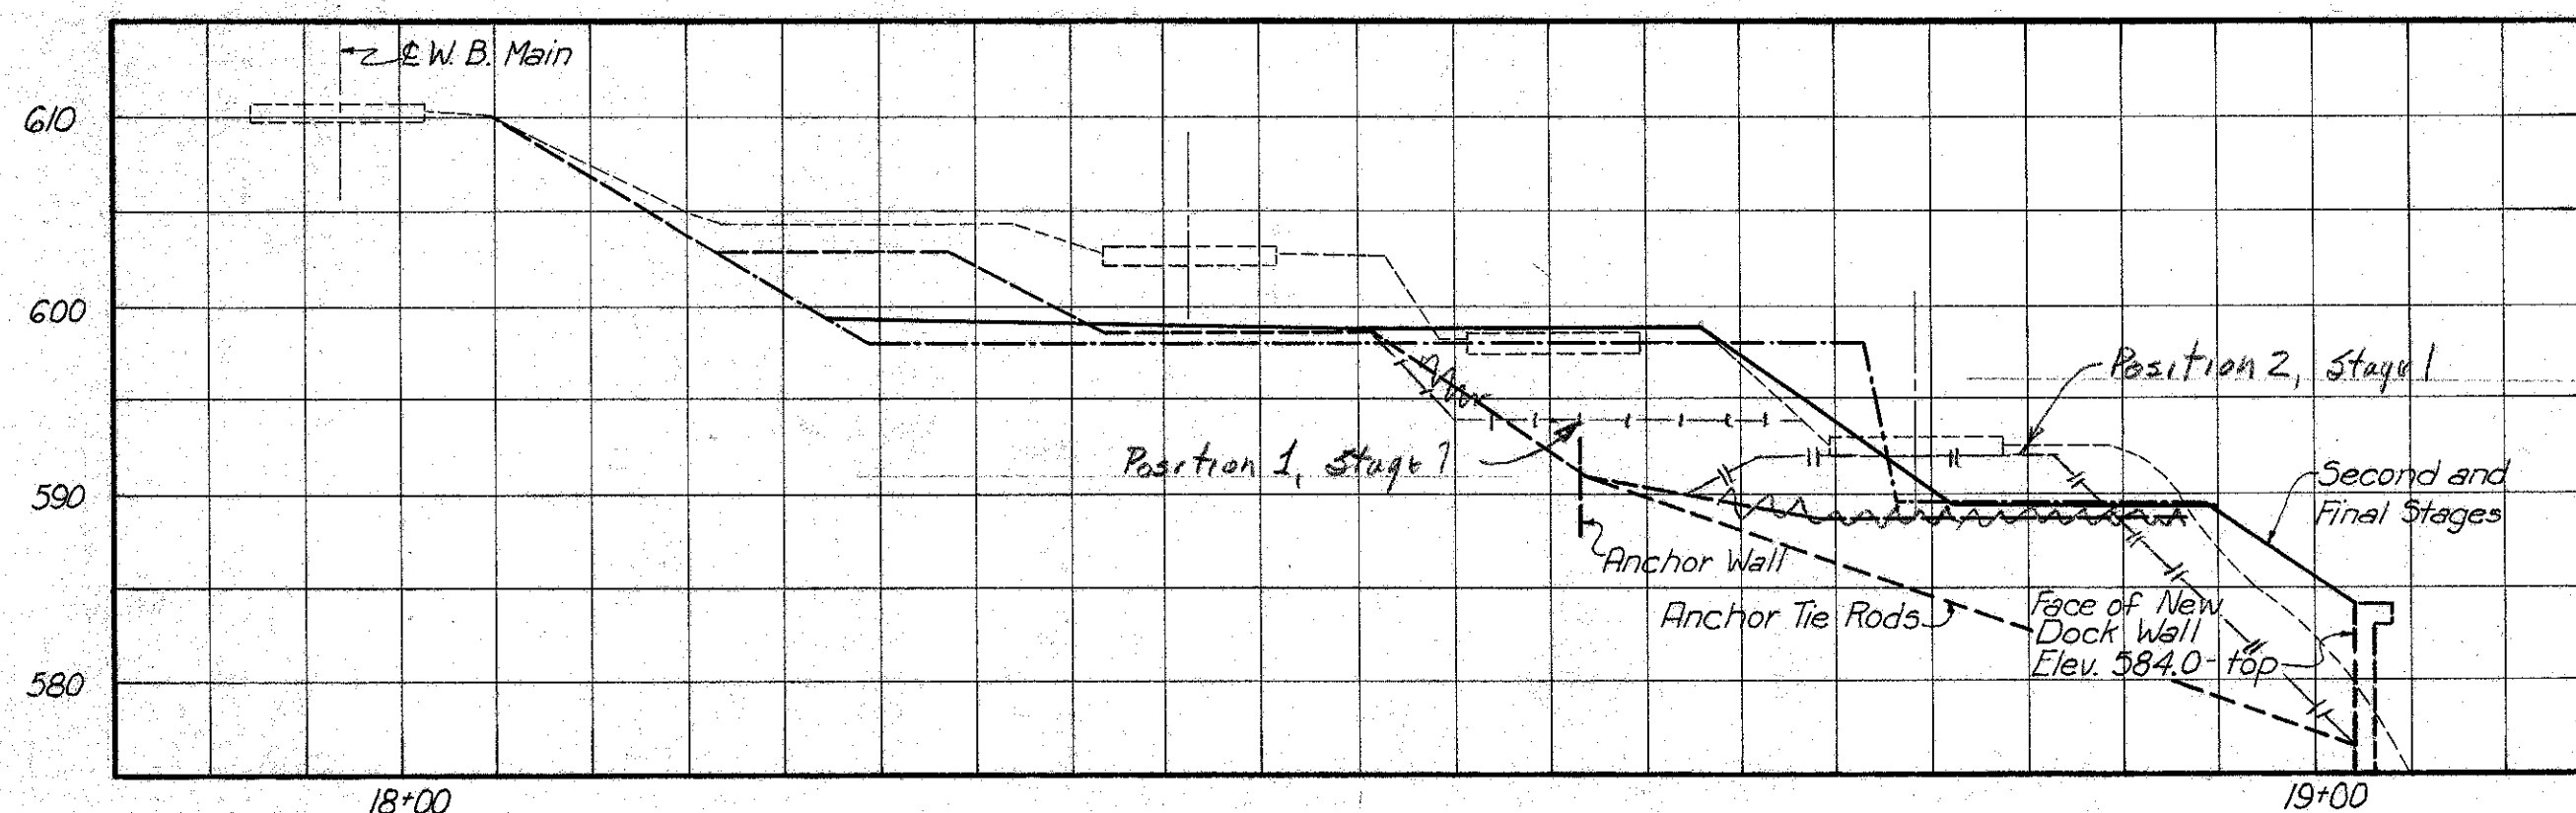


AT C OF VIADUCT

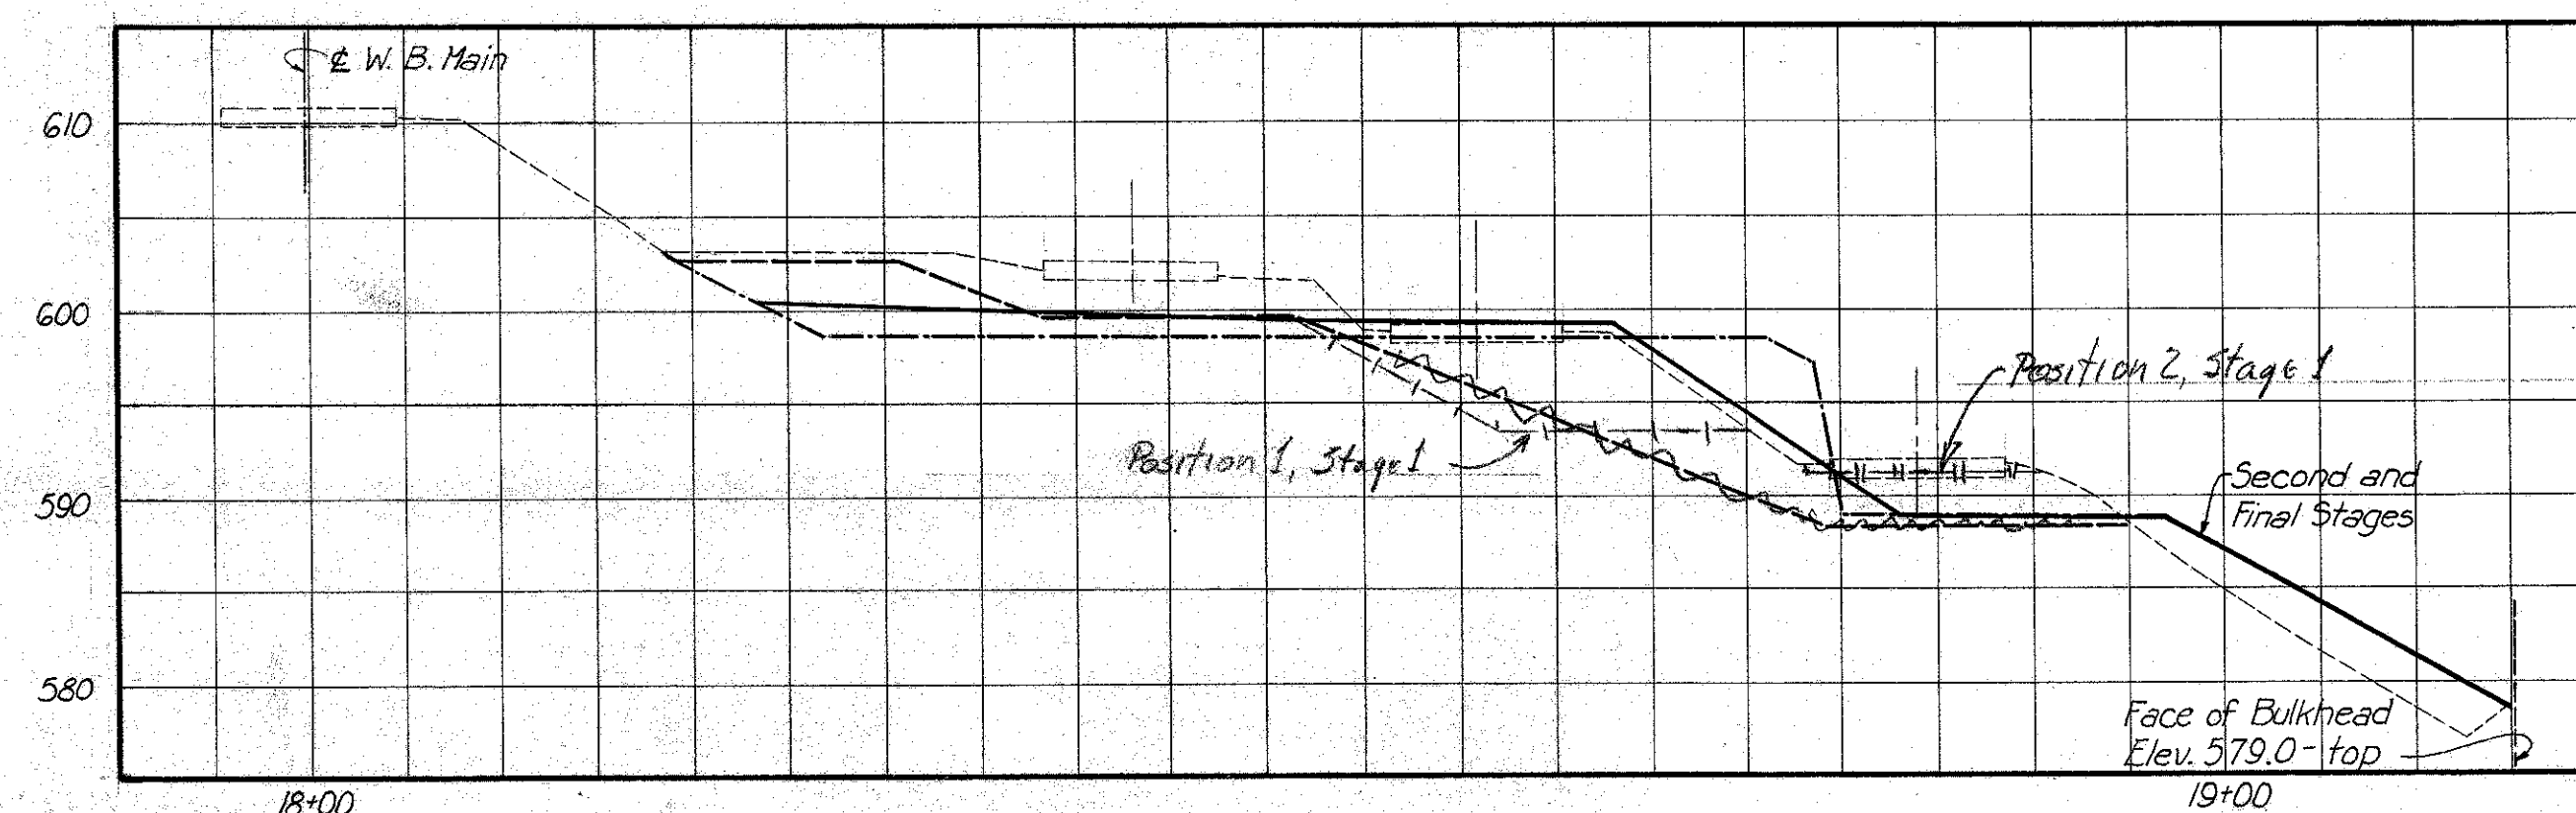


25 FEET RIGHT OF VIADUCT C

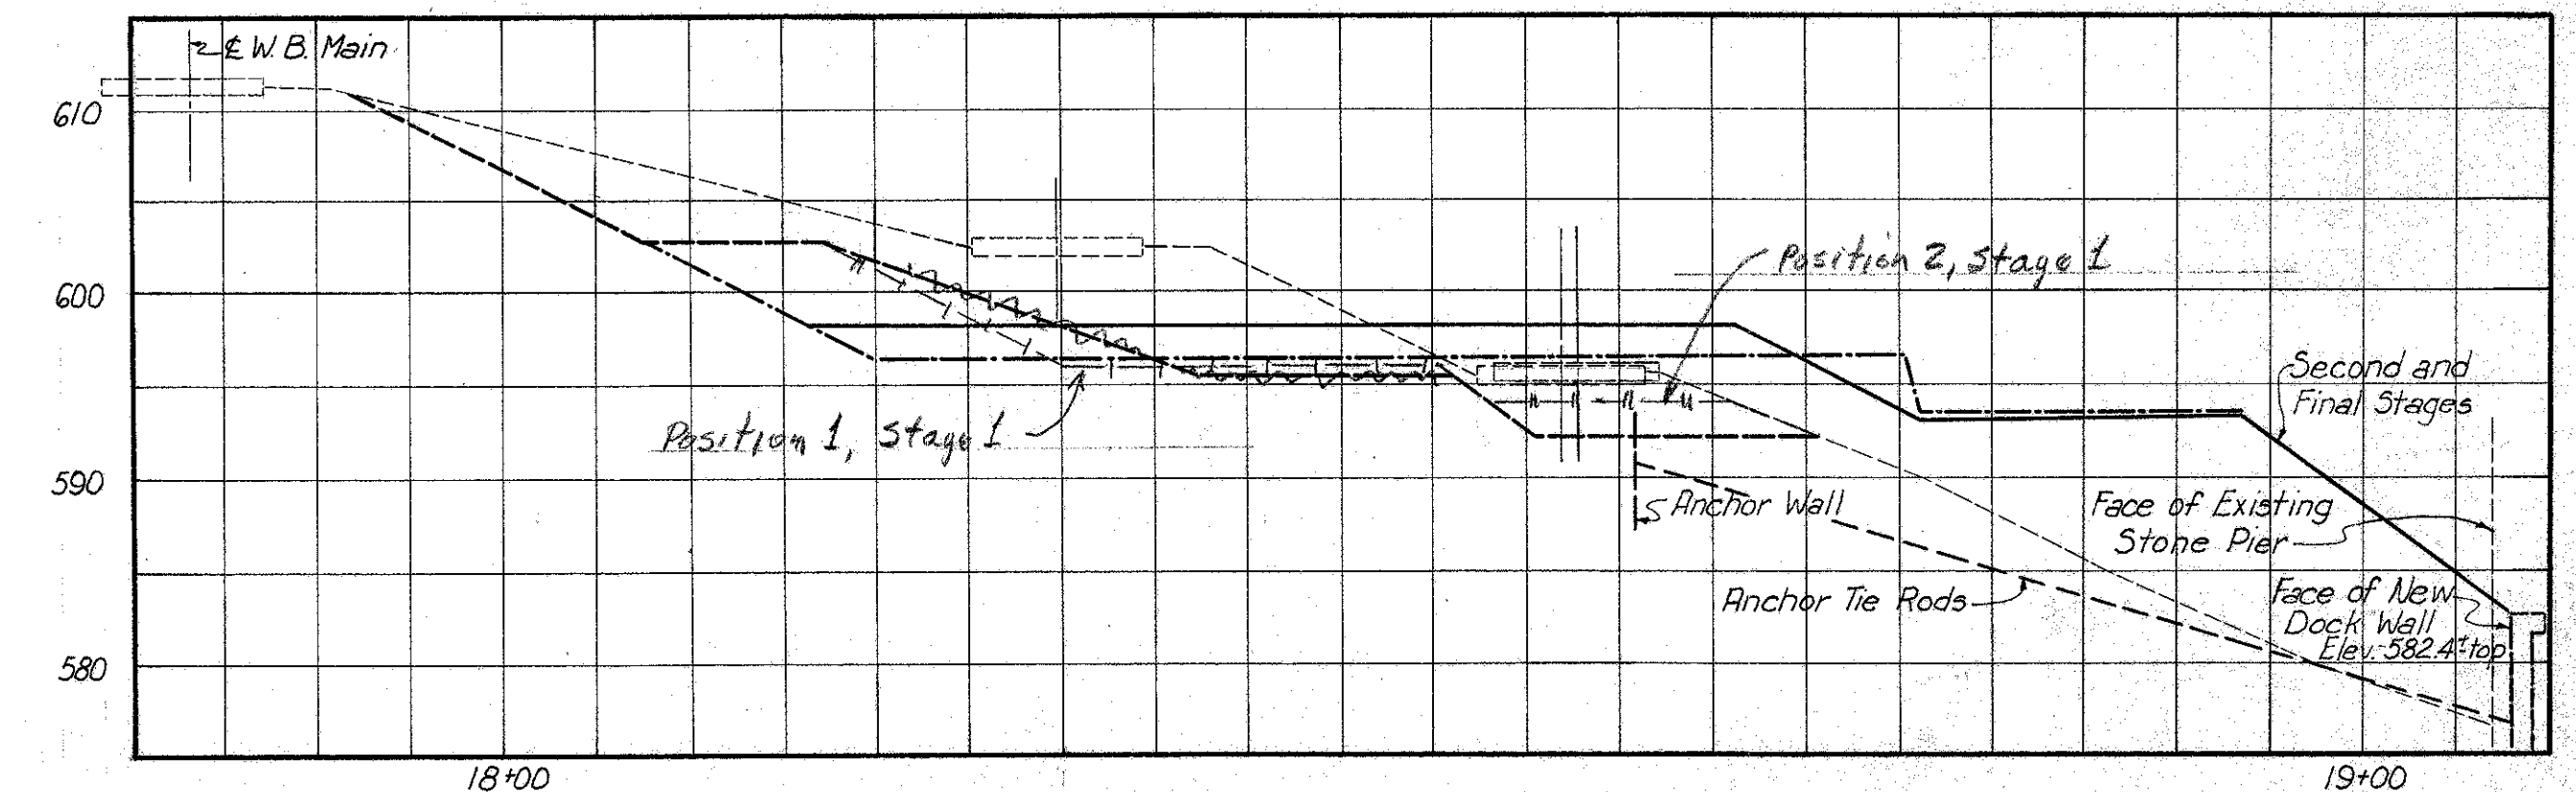

125 FEET LEFT OF VIADUCT C

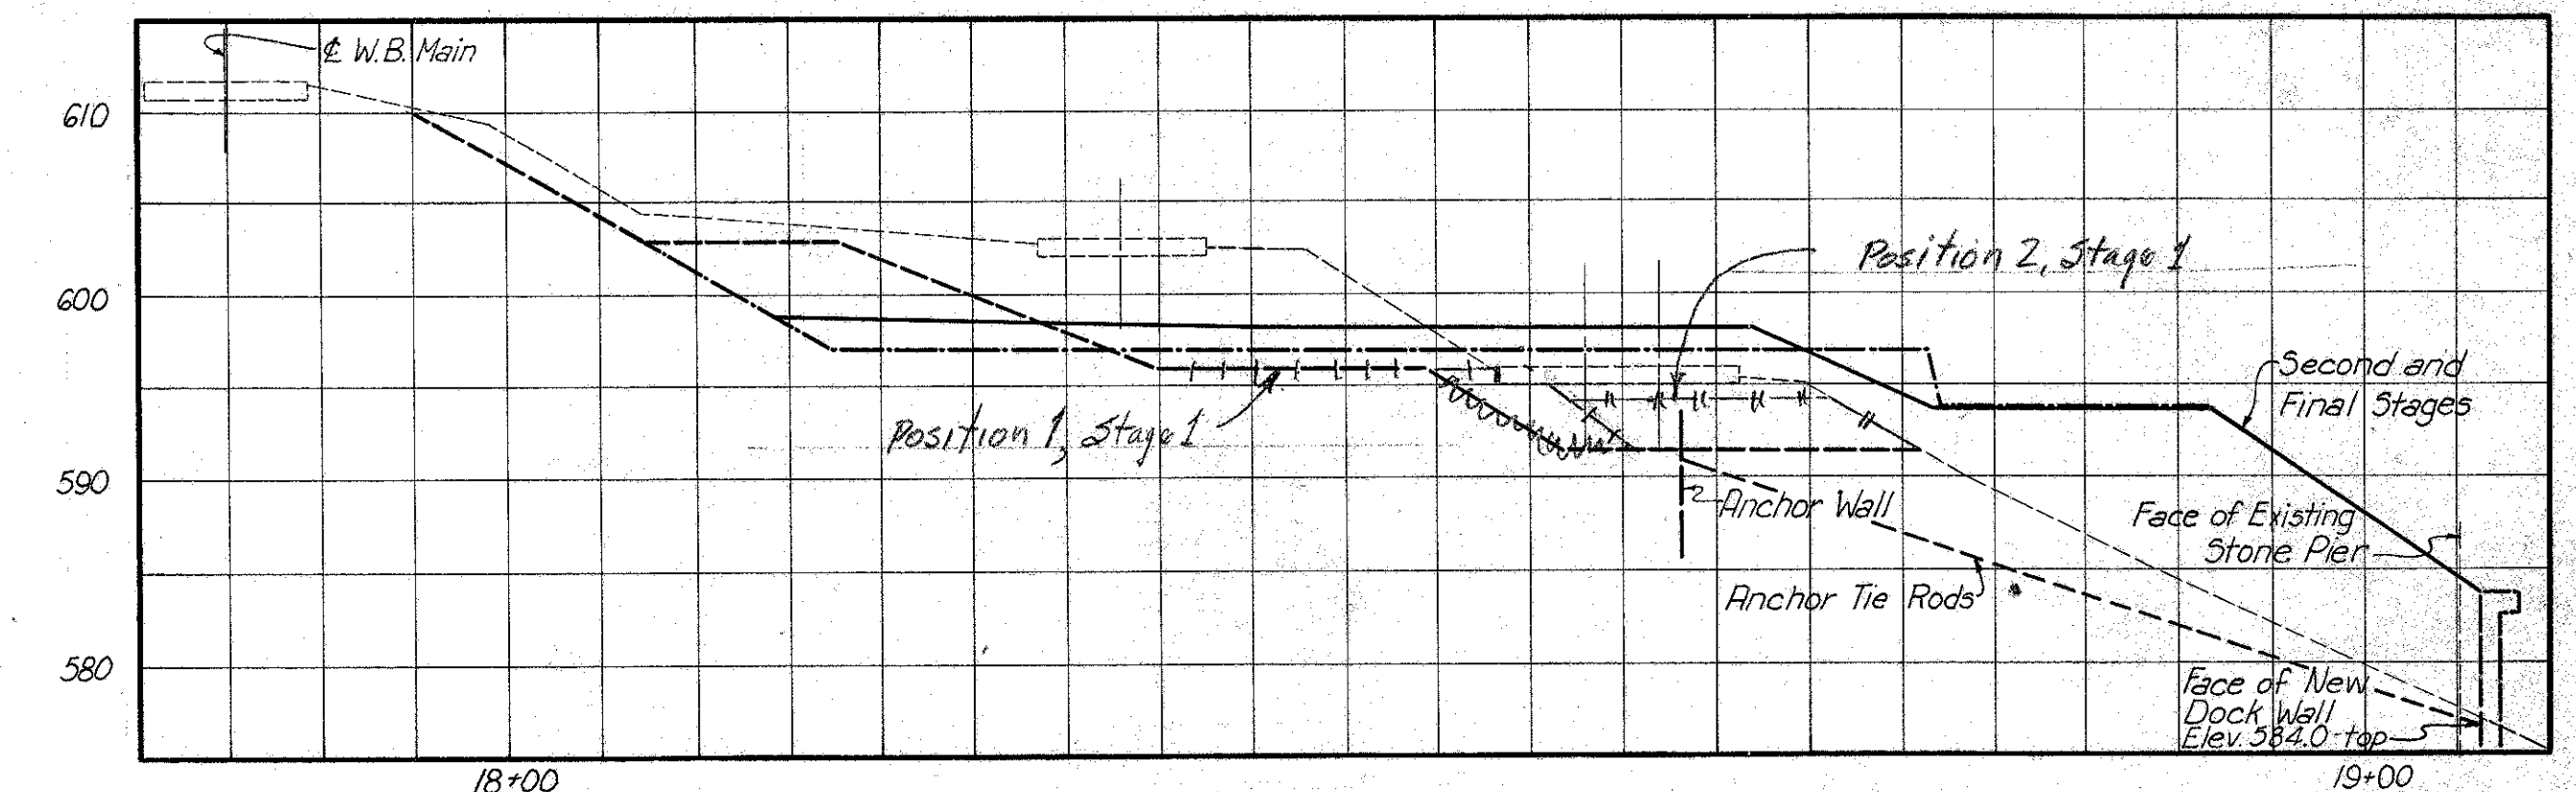

100 FEET LEFT OF VIADUCT C

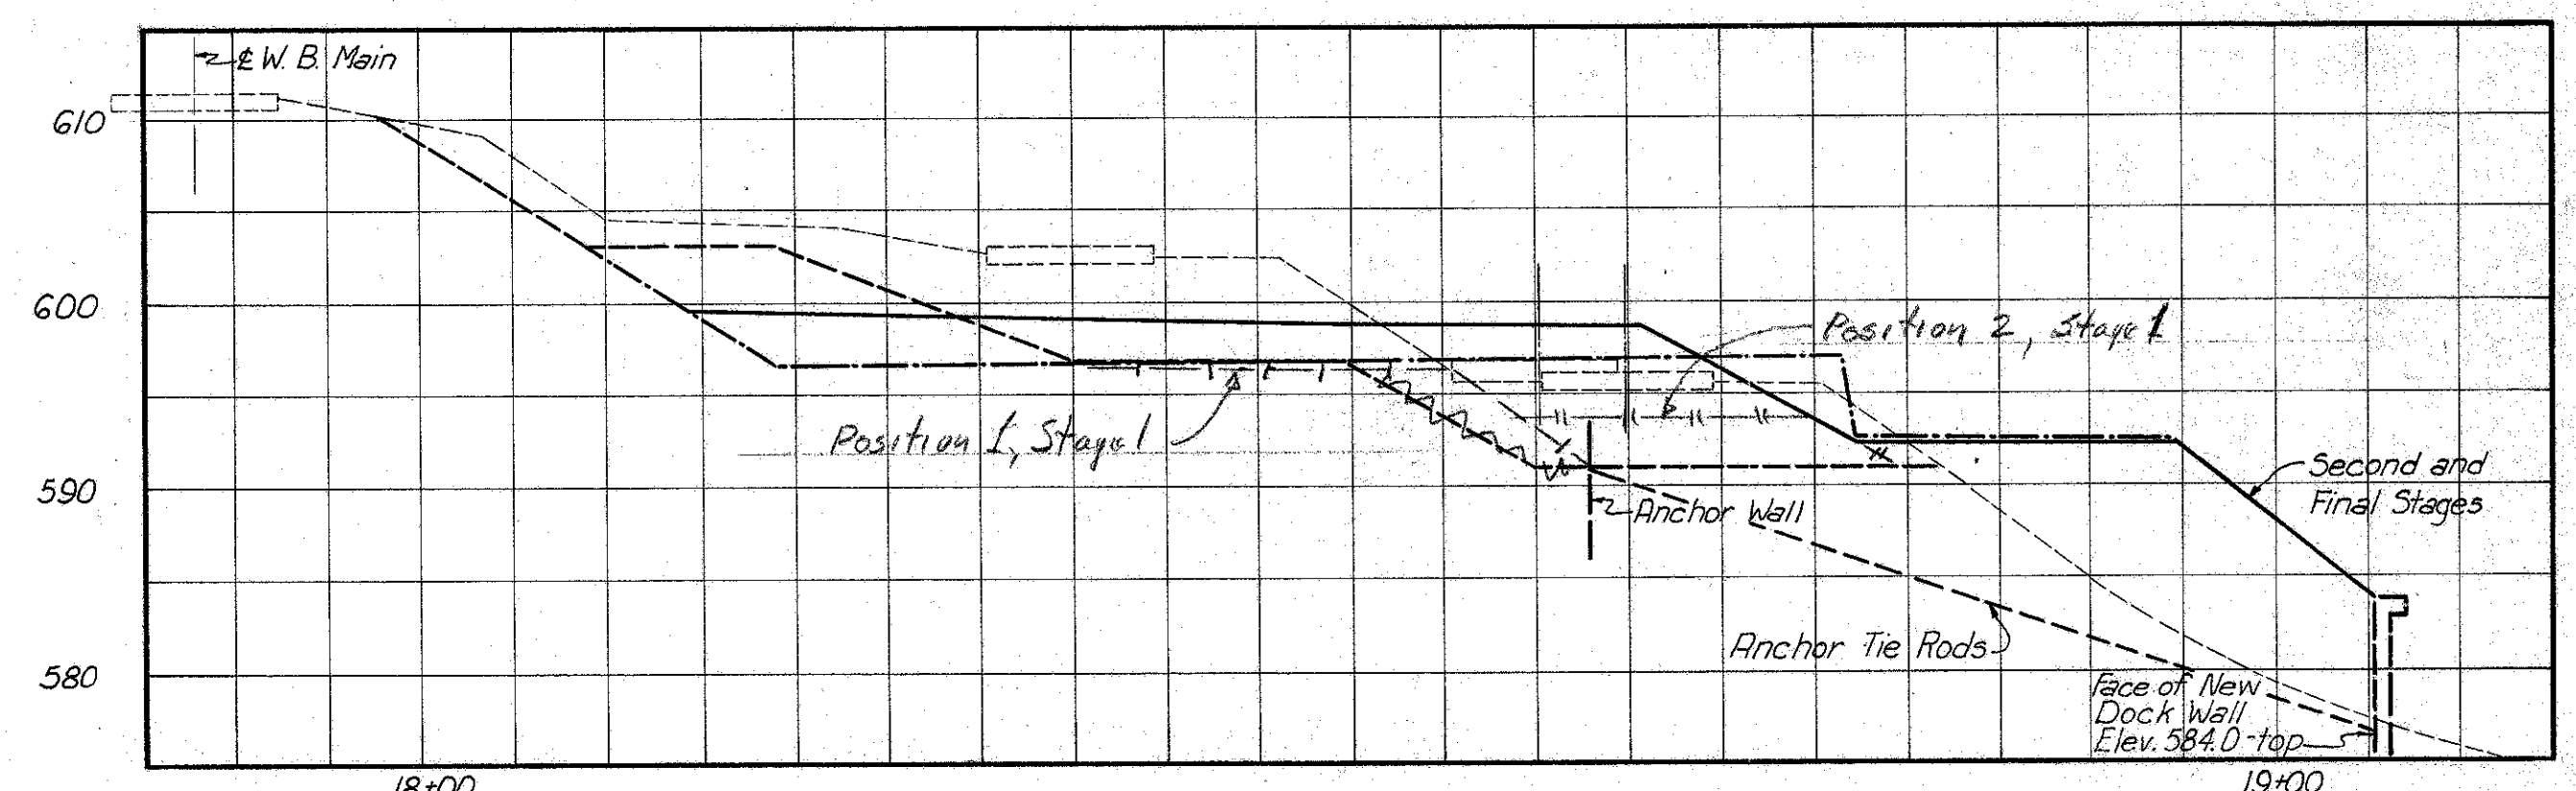

75 FEET LEFT OF VIADUCT C

Position 1 ————
Position 2 ————
Original ground line
First stage-build anchor and dockwall
Second stage-shift tracks to build footing
Final condition

Note: See Sheet 41.

PENCILLED REVISIONS 11-15-54

FED. ROAD DIV. NO.	STATE	FEDERAL AID PROJECT NO.	TYPE FUNDS
2	OHIO	UI 1057 (4)	

CUYAHOGA COUNTY
CITY OF CLEVELAND
INNER BELT FREEWAY
CENTRAL VIADUCT
CUY-42R-17.50

For detail of
Existing Pier,
see Sheet 9.

For detail of
Existing Pier,
see Sheet 9.

PART 2

U. S. ROUTE 42 RELOCATION
INNER BELT FREEWAY - CENTRAL VIADUCT

CROSS SECTIONS FOR
CONSTRUCTION IN ERIE RAILROAD YARD


CLEVELAND CUYAHOGA COUNTY OHIO

SCALE 1"=10'-0"
MADE J.G.S. DATE 8-25-54
TRCD N.A.M. DATE 8-30-54
CKD J.G.S. DATE 8-31-54
HOWARD, NEEDLES, TAMMEN & BERGENDOFF
CONSULTING ENGINEERS
KANSAS CITY CLEVELAND NEW YORK
914-1A SHEET 142


REFILMED
8-23-1983

FED. ROAD DIV. NO.	STATE	FEDERAL AID PROJECT NO.	TYPE FUNDS	43
2	OHIO	UI 1057 (4)		43


CUYAHOGA COUNTY
CITY OF CLEVELAND
INNER BELT FREEWAY
CENTRAL VIADUCT
CUI-42R-17.50

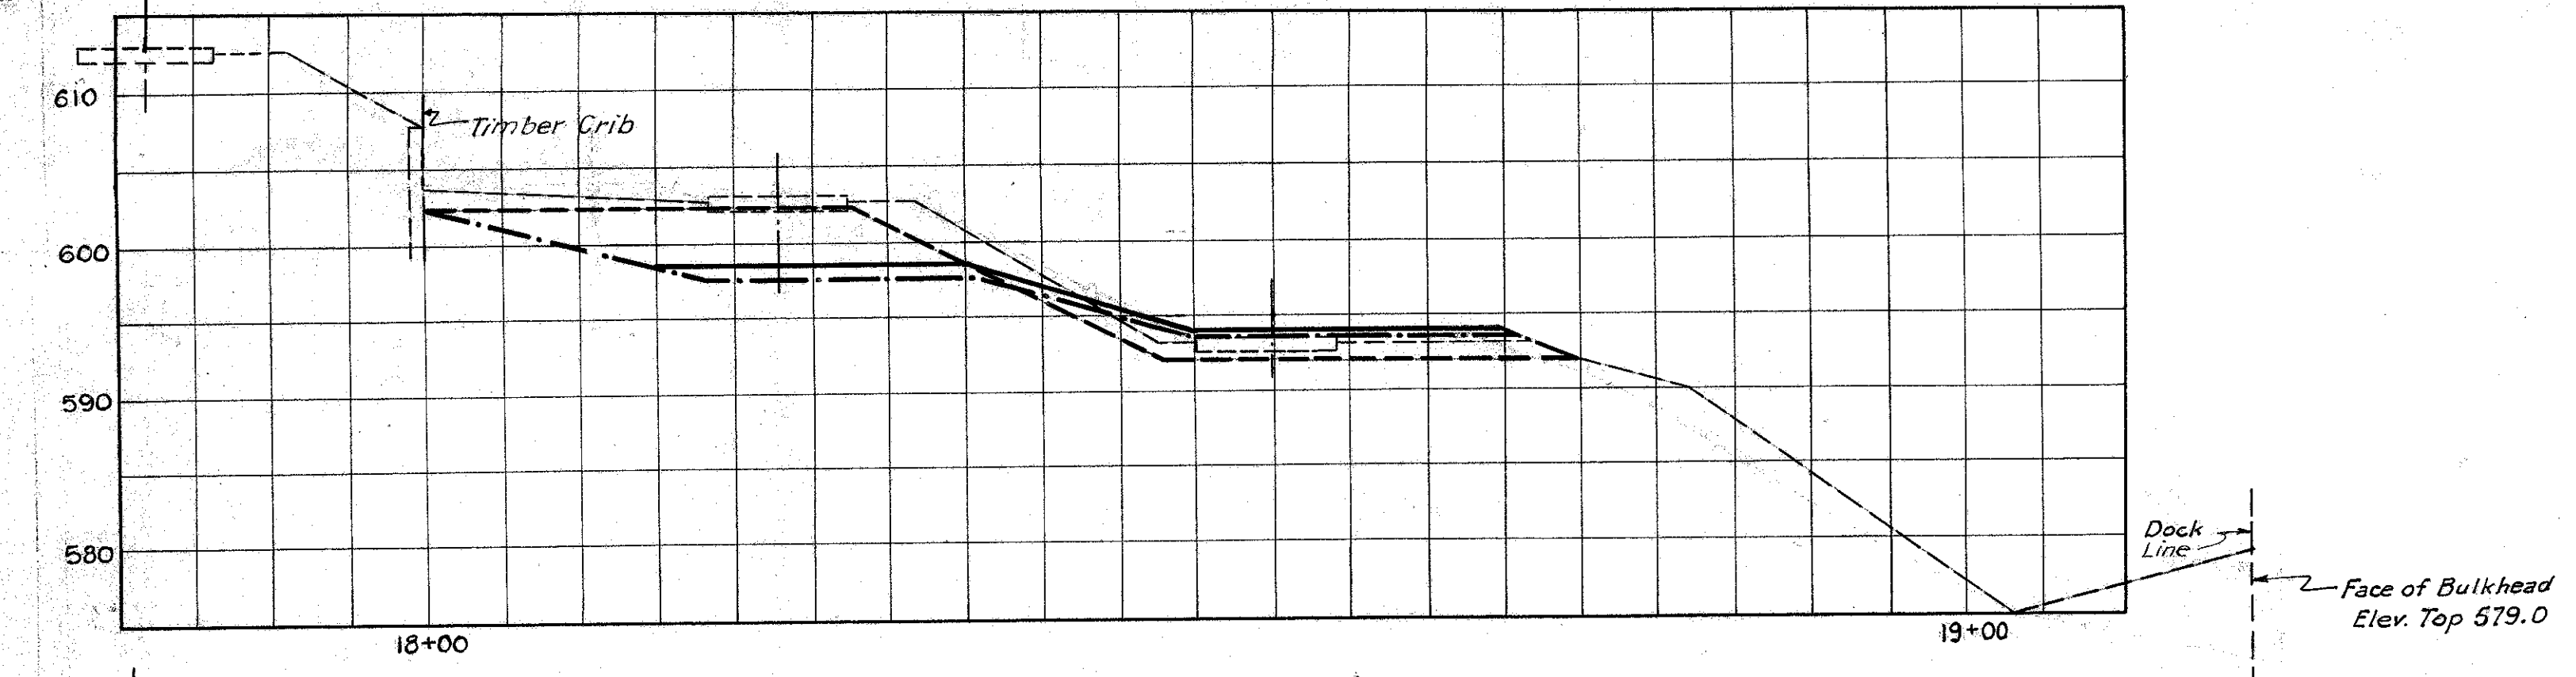


275 FEET LEFT OF VIADUCT CL

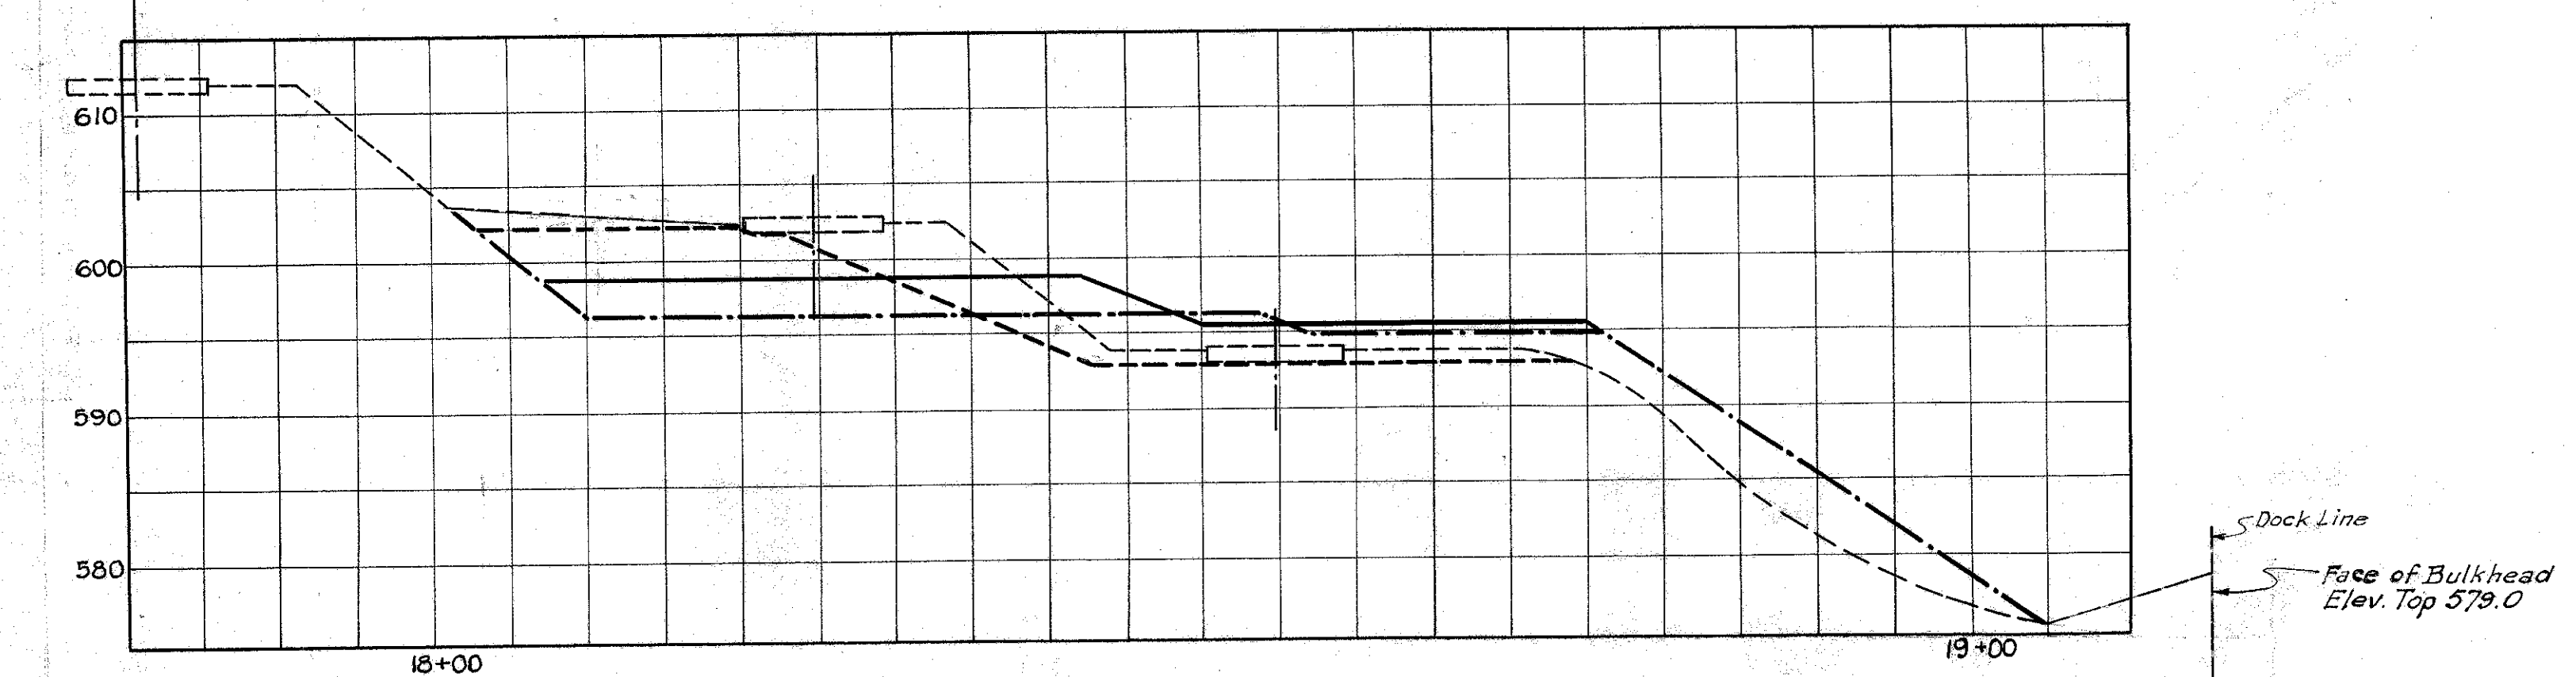


225 FEET LEFT OF VIADUCT CL

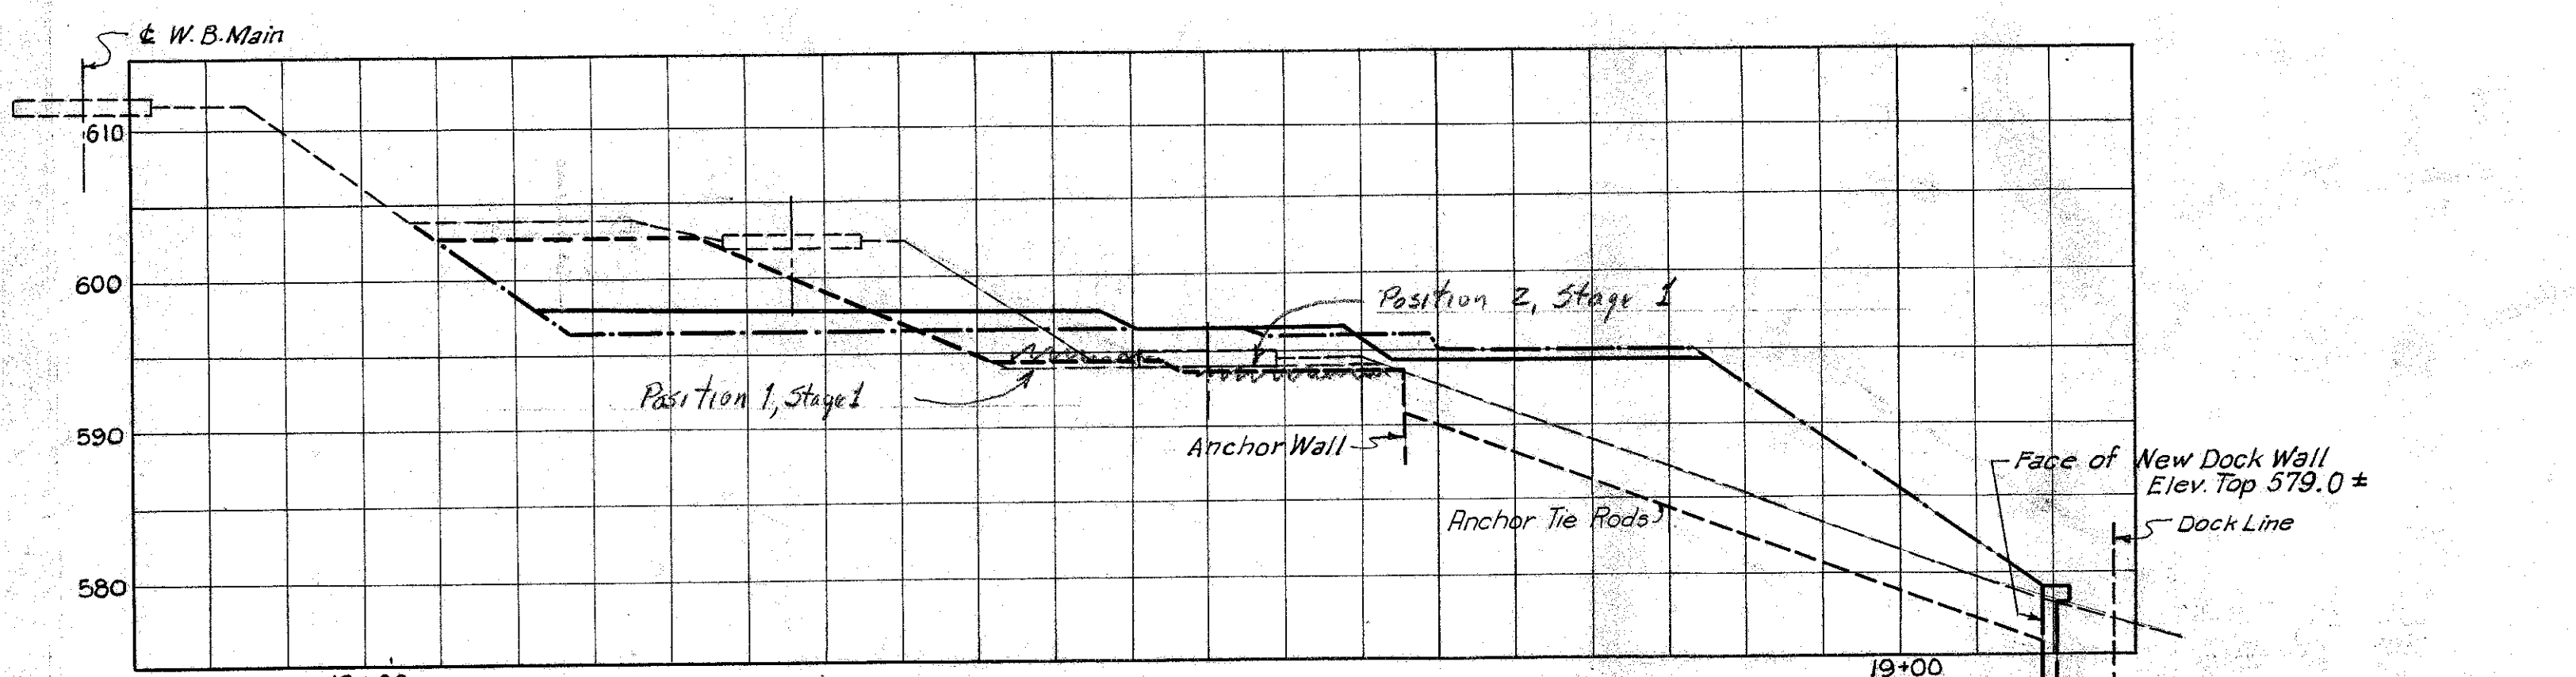


175 FEET LEFT OF VIADUCT CL

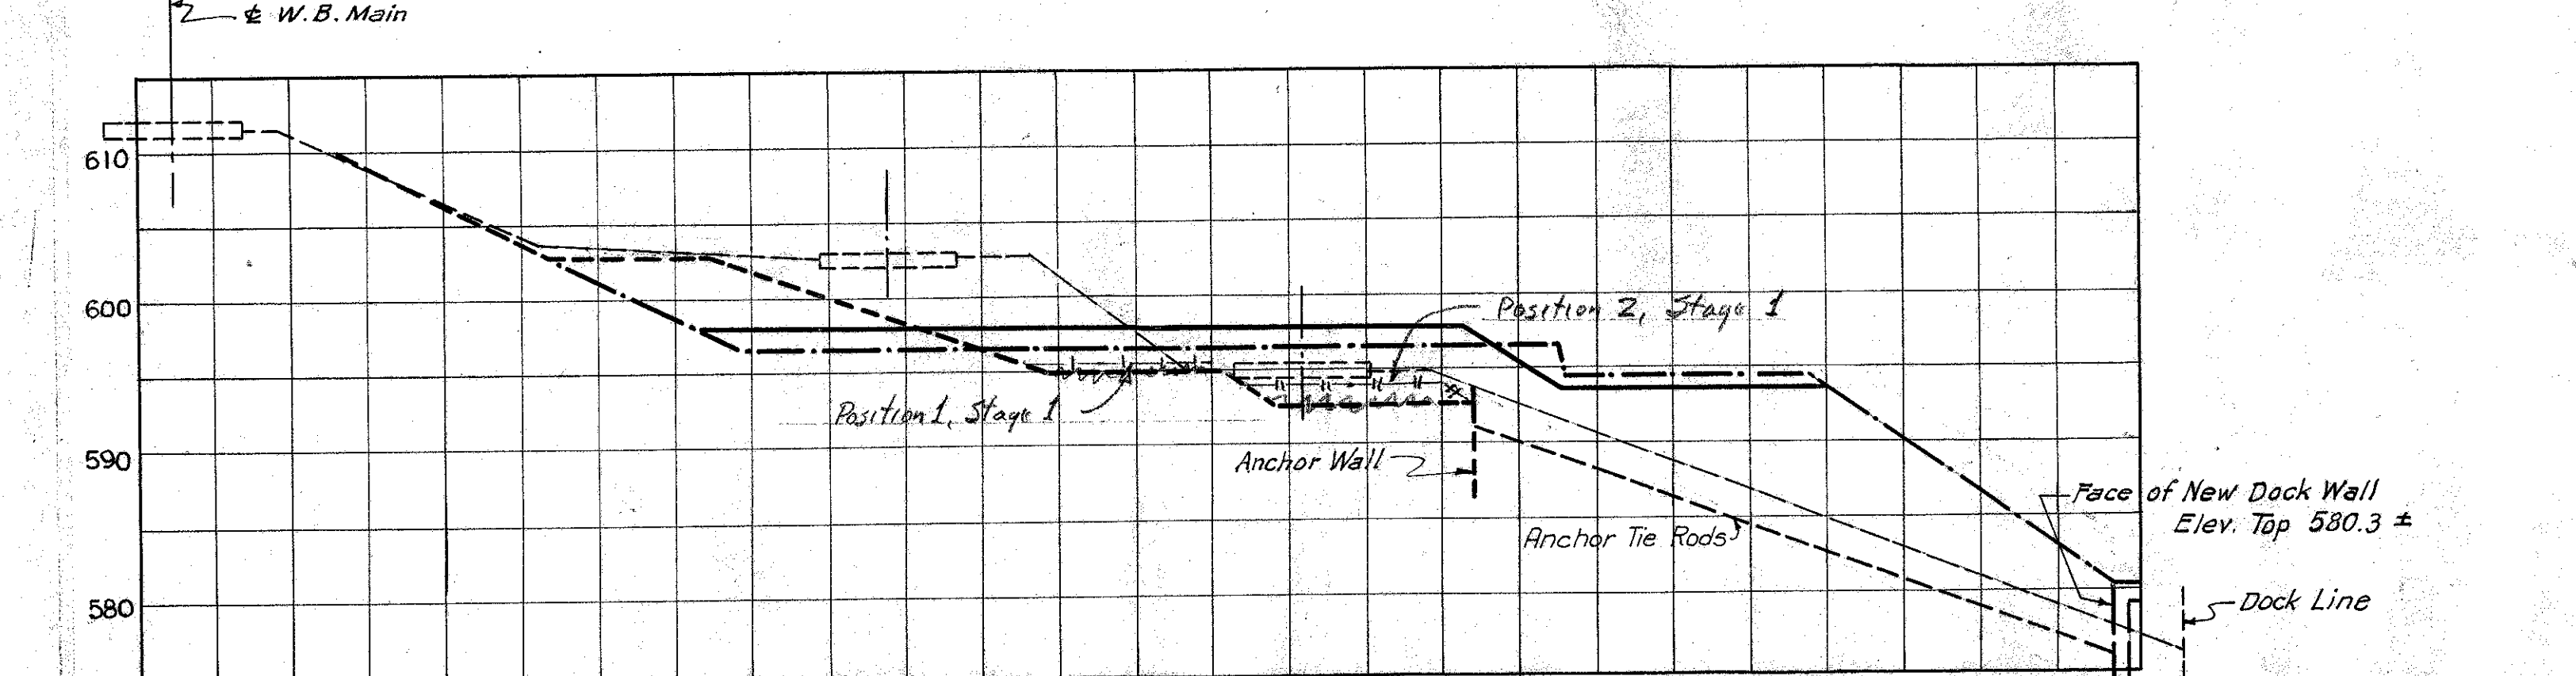


150 FEET LEFT OF VIADUCT CL

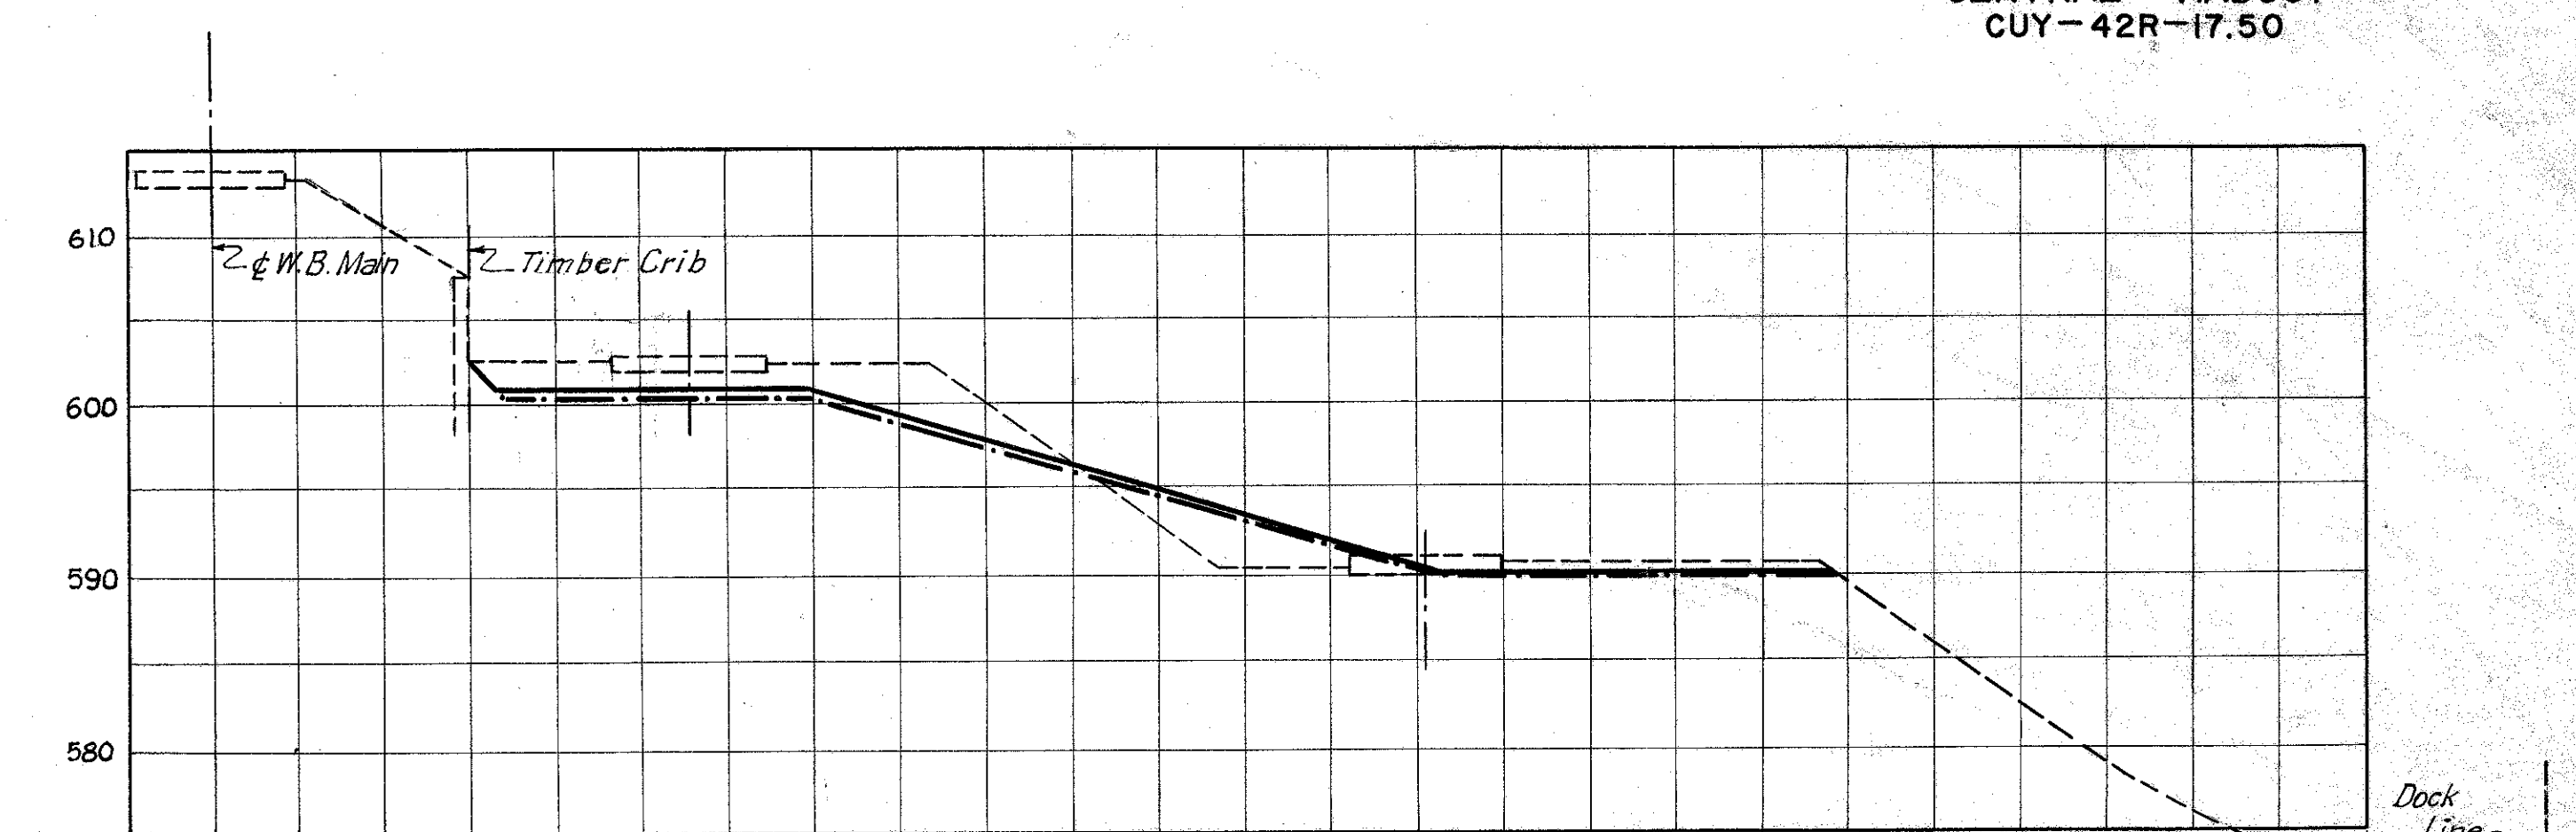

425 FEET LEFT OF VIADUCT CL

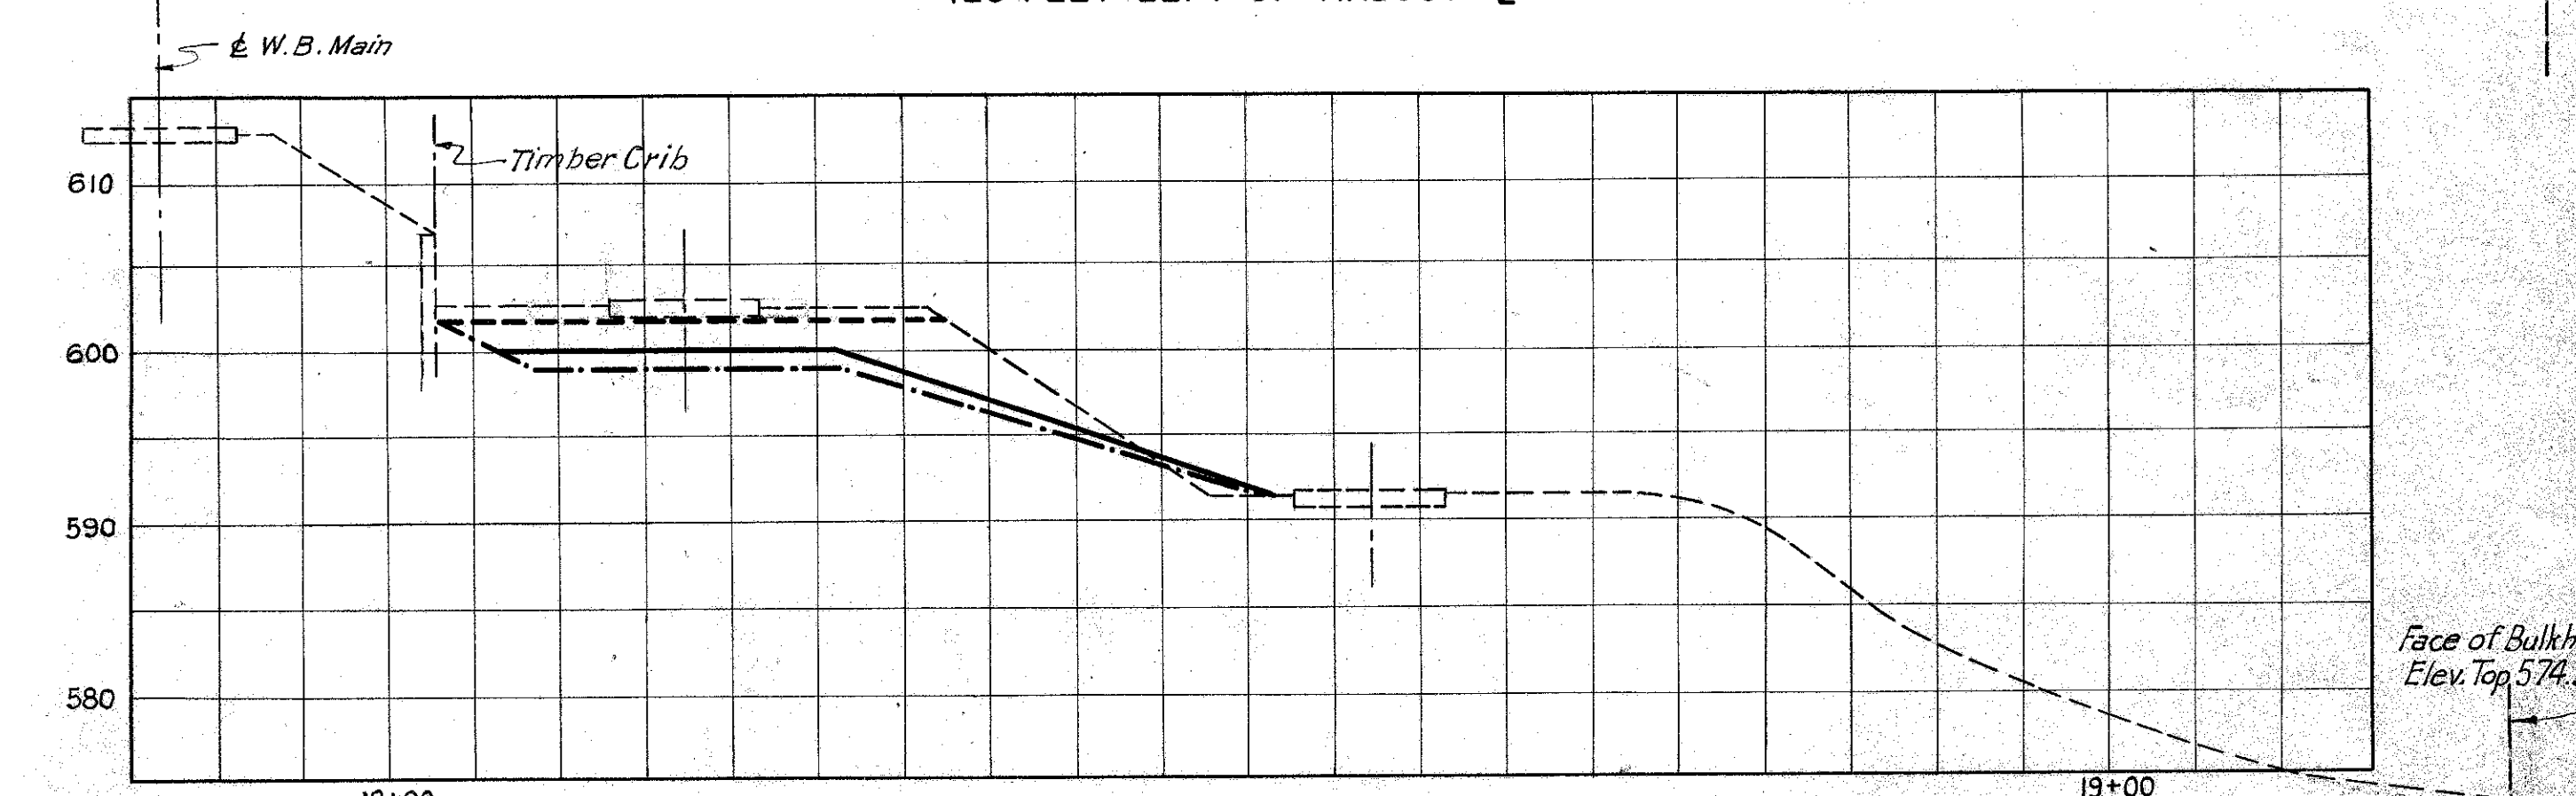

375 FEET LEFT OF VIADUCT CL

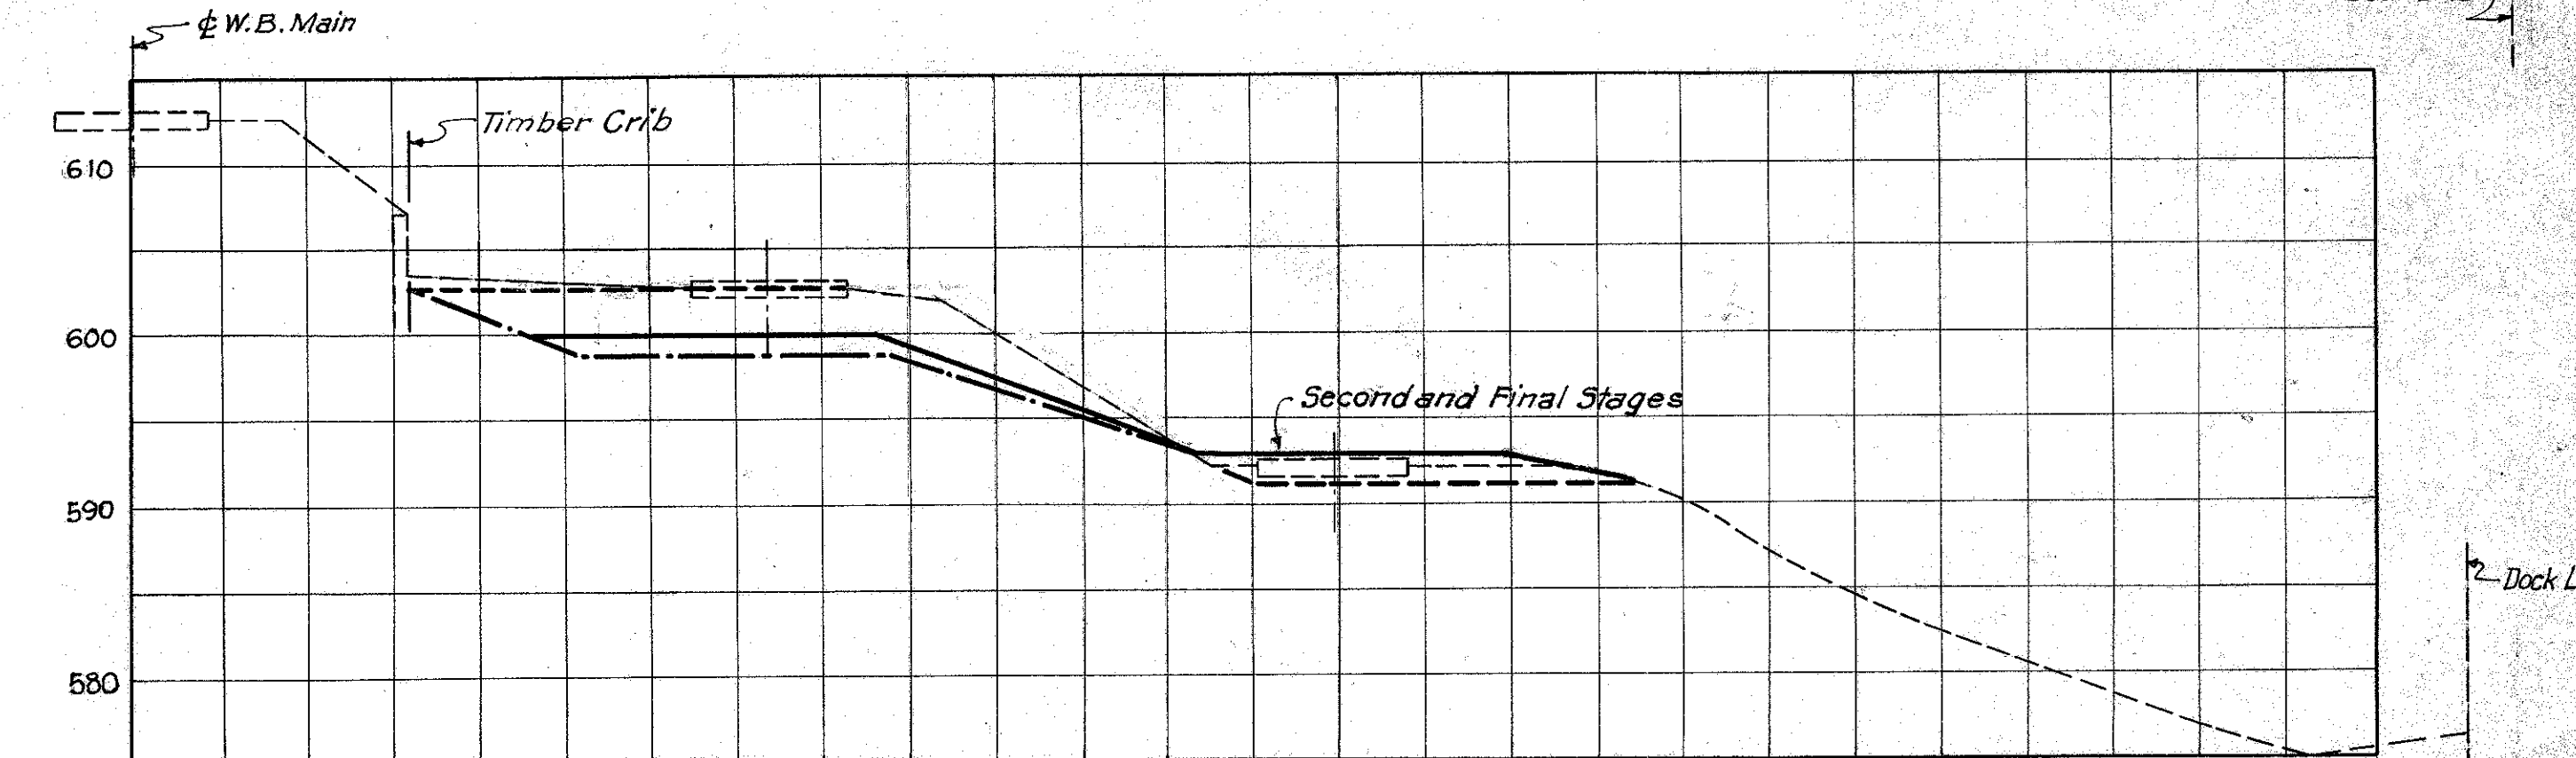

325 FEET LEFT OF VIADUCT CL

- LEGEND**
- Original ground line
 - First Stage - build anchor and dock wall
 - Second Stage - shift tracks to build footing
 - Final condition

PENCILLED REVISIONS 11-15-54

Note: See Sheet 41.

U. S. ROUTE 42 RELOCATION
INNER BELT FREEWAY - CENTRAL VIADUCT

CROSS SECTIONS FOR
CONSTRUCTION IN ERIE RAILROAD YARD

CLEVELAND CUYAHOGA COUNTY OHIO

SCALE: 1"=10'-0"

MADE J.G.S. DATE 8-25-54 HOWARD, NEEDLES, TAMMEN & BERGENDOFF
TRCD J.G.S. DATE 8-30-54 CONSULTING ENGINEERS
CKD J.G.S. DATE 8-31-54 KANSAS CITY CLEVELAND NEW YORK

914-1A SHEET 1.43

CUY-90-15.45

STATE OF OHIO
DEPARTMENT OF HIGHWAYS

FED. ROAD DIV. NO.	STATE	FEDERAL AID PROJECT NO.	TYPE FUNDS
2	OHIO	STATE	

1
122

CUYAHOGA COUNTY
CITY OF CLEVELAND
INNER BELT FREEWAY
CENTRAL VIADUCT
CUY-42R-17.50 PART 3

MICROFILMED
FEB 15 1983

CUY - 42R - 17.50

INNER BELT FREEWAY - CENTRAL VIADUCT

BR. NO. CU-42R-175

CUYAHOGA COUNTY

CITY OF CLEVELAND

PART 3 - SUPERSTRUCTURE

MAR 15 1962
GROUND PHOTOLAB

THIS IMPROVEMENT HAS BEEN DECLARED A LIMITED ACCESS HIGHWAY OR FREEWAY BY ACTION OF THE DIRECTOR OF HIGHWAYS IN ACCORDANCE WITH THE PROVISIONS OF SECTION 5511.02 REVISED CODE OF OHIO AND IS ESPECIALLY DESIGNED FOR THROUGH TRAFFIC.

INDEX OF SHEETS


1	TITLE SHEET	58-62	TRUSS STRESSES AND DETAILS - UNIT 4
2	GENERAL PLAN AND ELEVATION	63-76	TRUSS STRESSES AND DETAILS - UNIT 5
3-5	GENERAL NOTES	77-79	TRUSS STRESSES AND DETAILS - UNIT 6
6	QUANTITIES	80-87	TRUSS STRESSES AND DETAILS - UNIT 7
7-9	GENERAL LAYOUT, EXISTING CONDITIONS, TEST HOLE BORINGS	88	TRUSS STRESSES - UNIT 8
10, 11	RAILROAD TRACK MODIFICATIONS	89-94	TRUSS STRESSES AND DETAILS - UNIT 9
12	GRADES AND ELEVATIONS	95	ANCHOR BOLT PLAN AND DETAILS
13-17	GENERAL CROSS SECTIONS	96-98	SHOES
18-26	FRAMING PLANS	99, 100	HANDRAIL, FASCIA, MEDIAN
27, 28	FLOORBEAMS AND STRINGERS	101, 102	LADDERS
29-34	FLOORBEAM TRUSSES	103-109	ROADWAY DRAINAGE
35-37	LATERAL BRACING	110-113	ROADWAY EXPANSION JOINTS
38-43	TRUSS STRESSES AND DETAILS - UNIT 1	114-119	ROADWAY SLAB DETAILS
44-46	TRUSS STRESSES AND DETAILS - UNIT 2	120, 121	REINFORCEMENT SCHEDULES
47-57	TRUSS STRESSES AND DETAILS - UNIT 3	122	LIGHTING

LINE DATA


BEGIN PROJECT STA. 16 + 13.02
END PROJECT STA. 43 + 34.72
NET LENGTH 2,721.70 LIN. FT. OR 0.515 MILES

HOWARD NEEDLES TAMMEN & BERGENDOFF
CONSULTING ENGINEERS
KANSAS CITY CLEVELAND NEW YORK


H.G. SOURS
ASSOCIATE
COLUMBUS

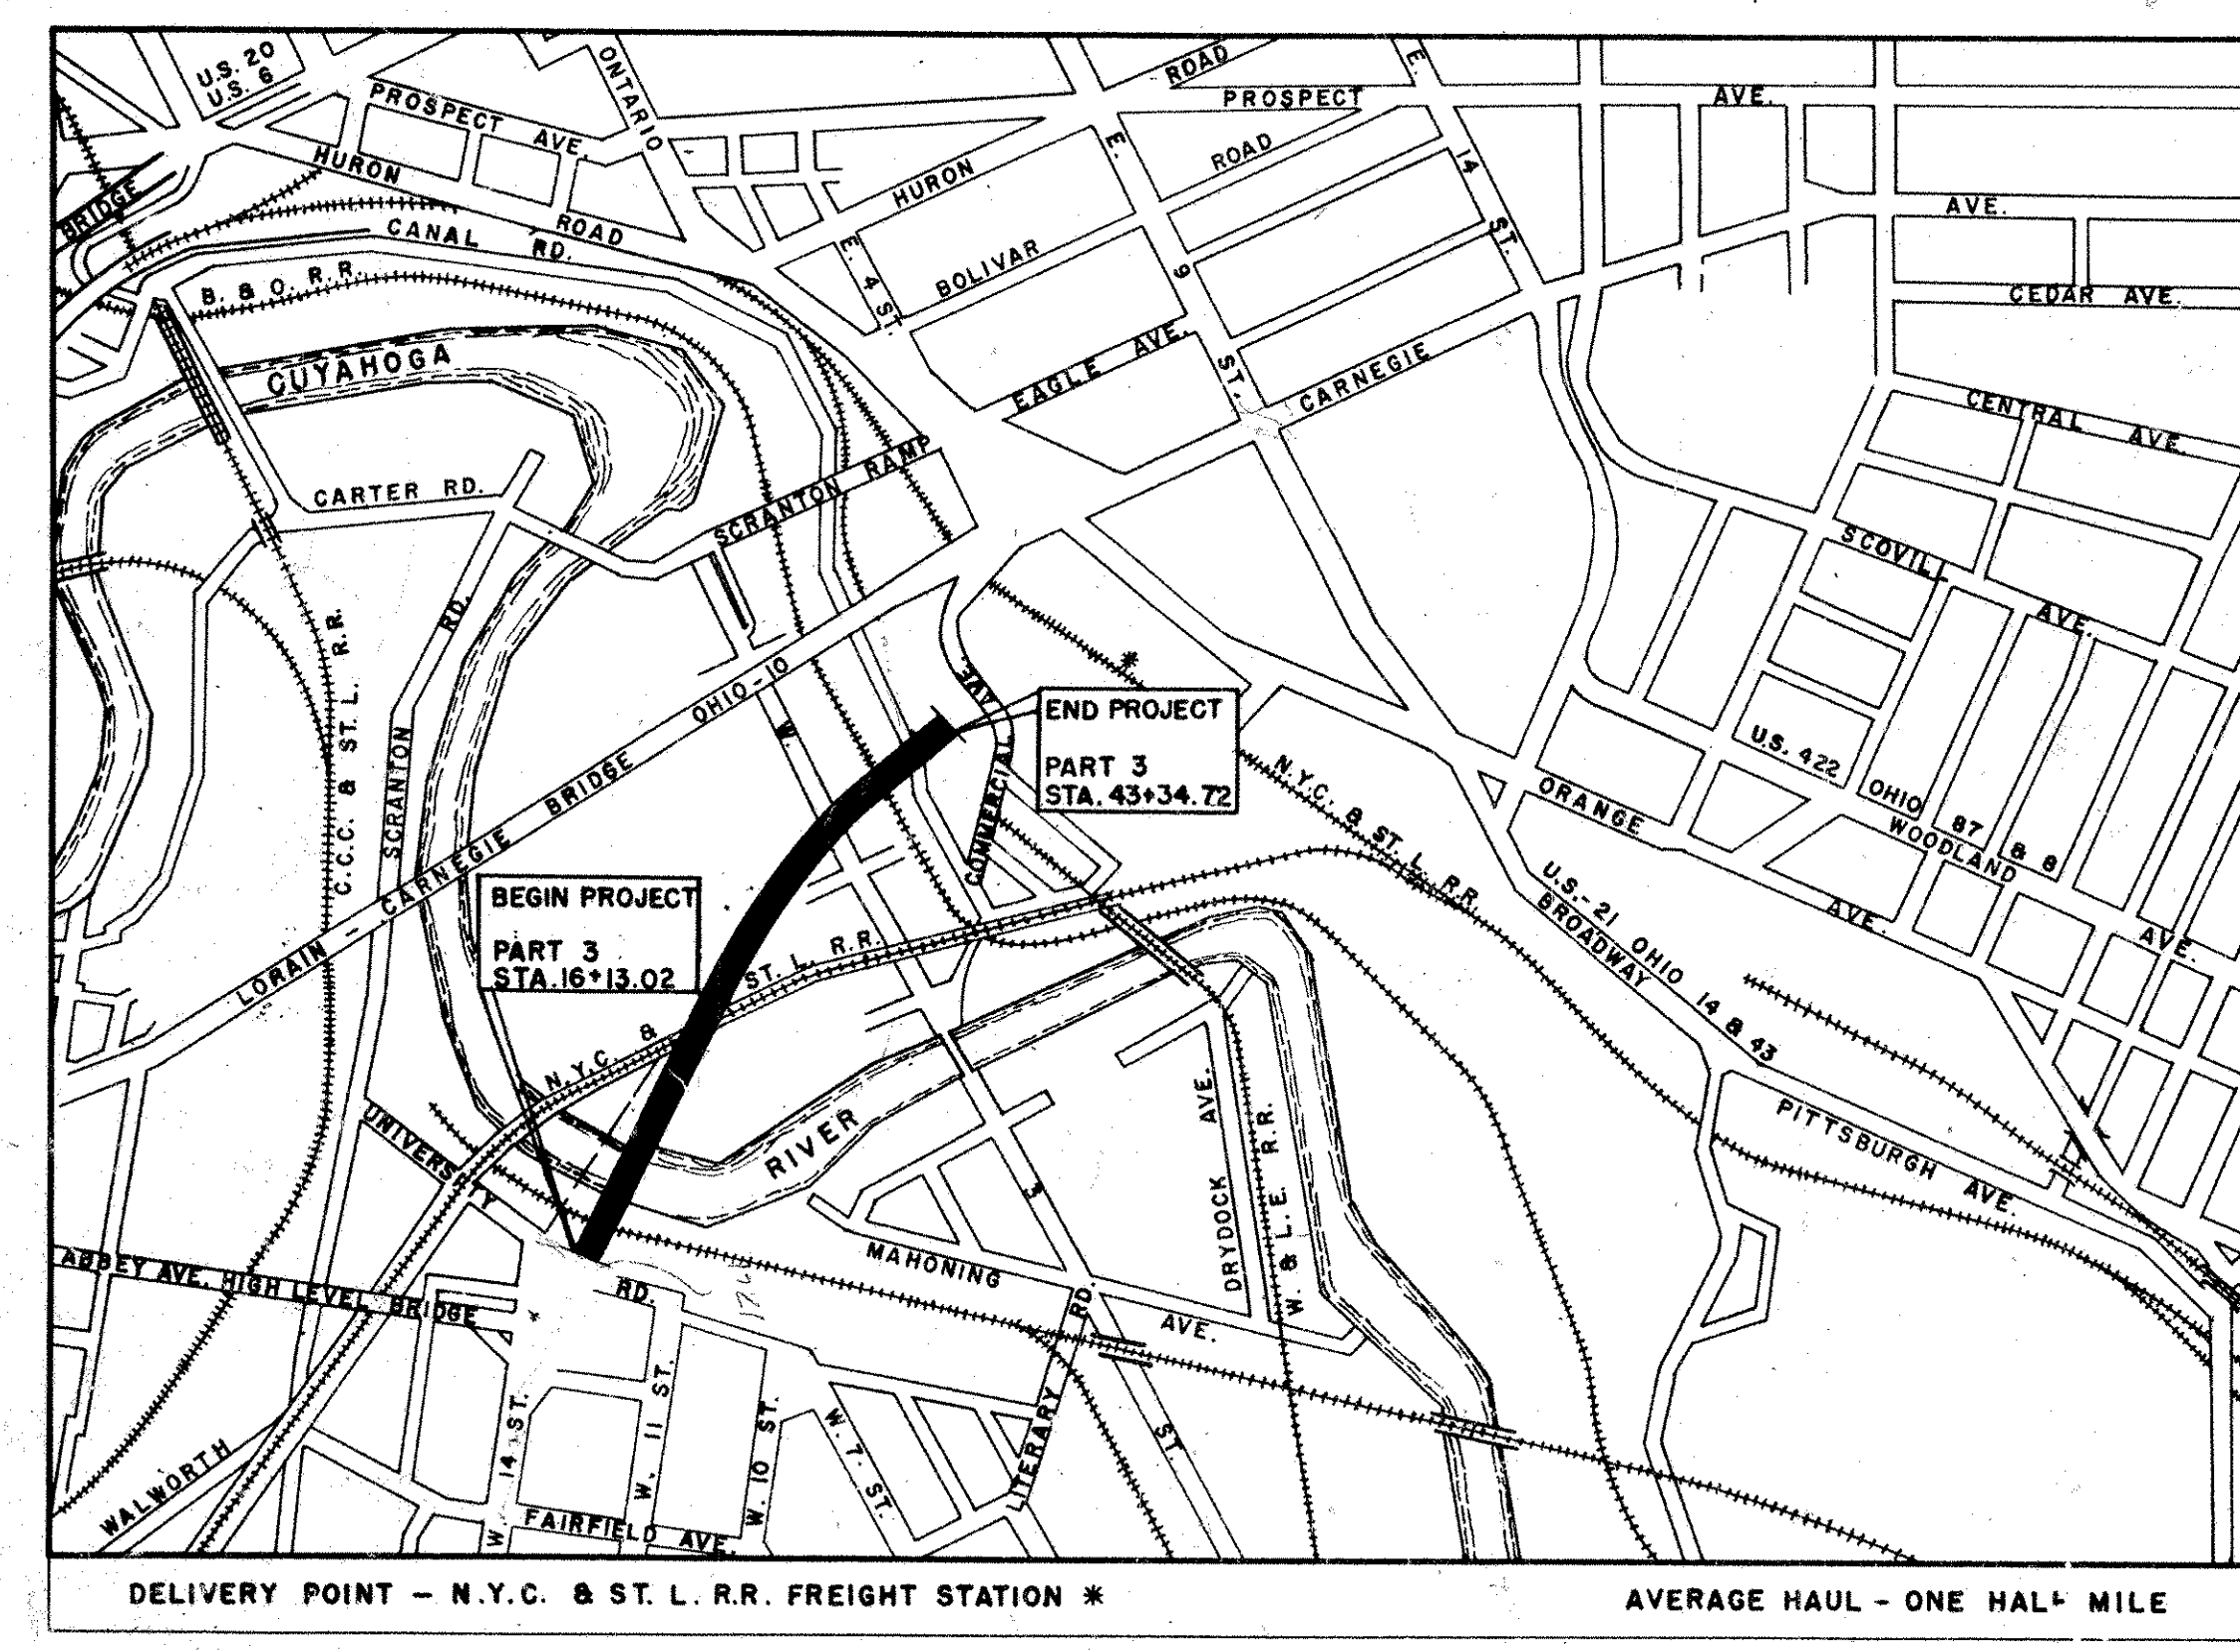

CUYAHOGA COUNTY
CITY OF CLEVELAND
INNER BELT FREEWAY
CENTRAL VIADUCT

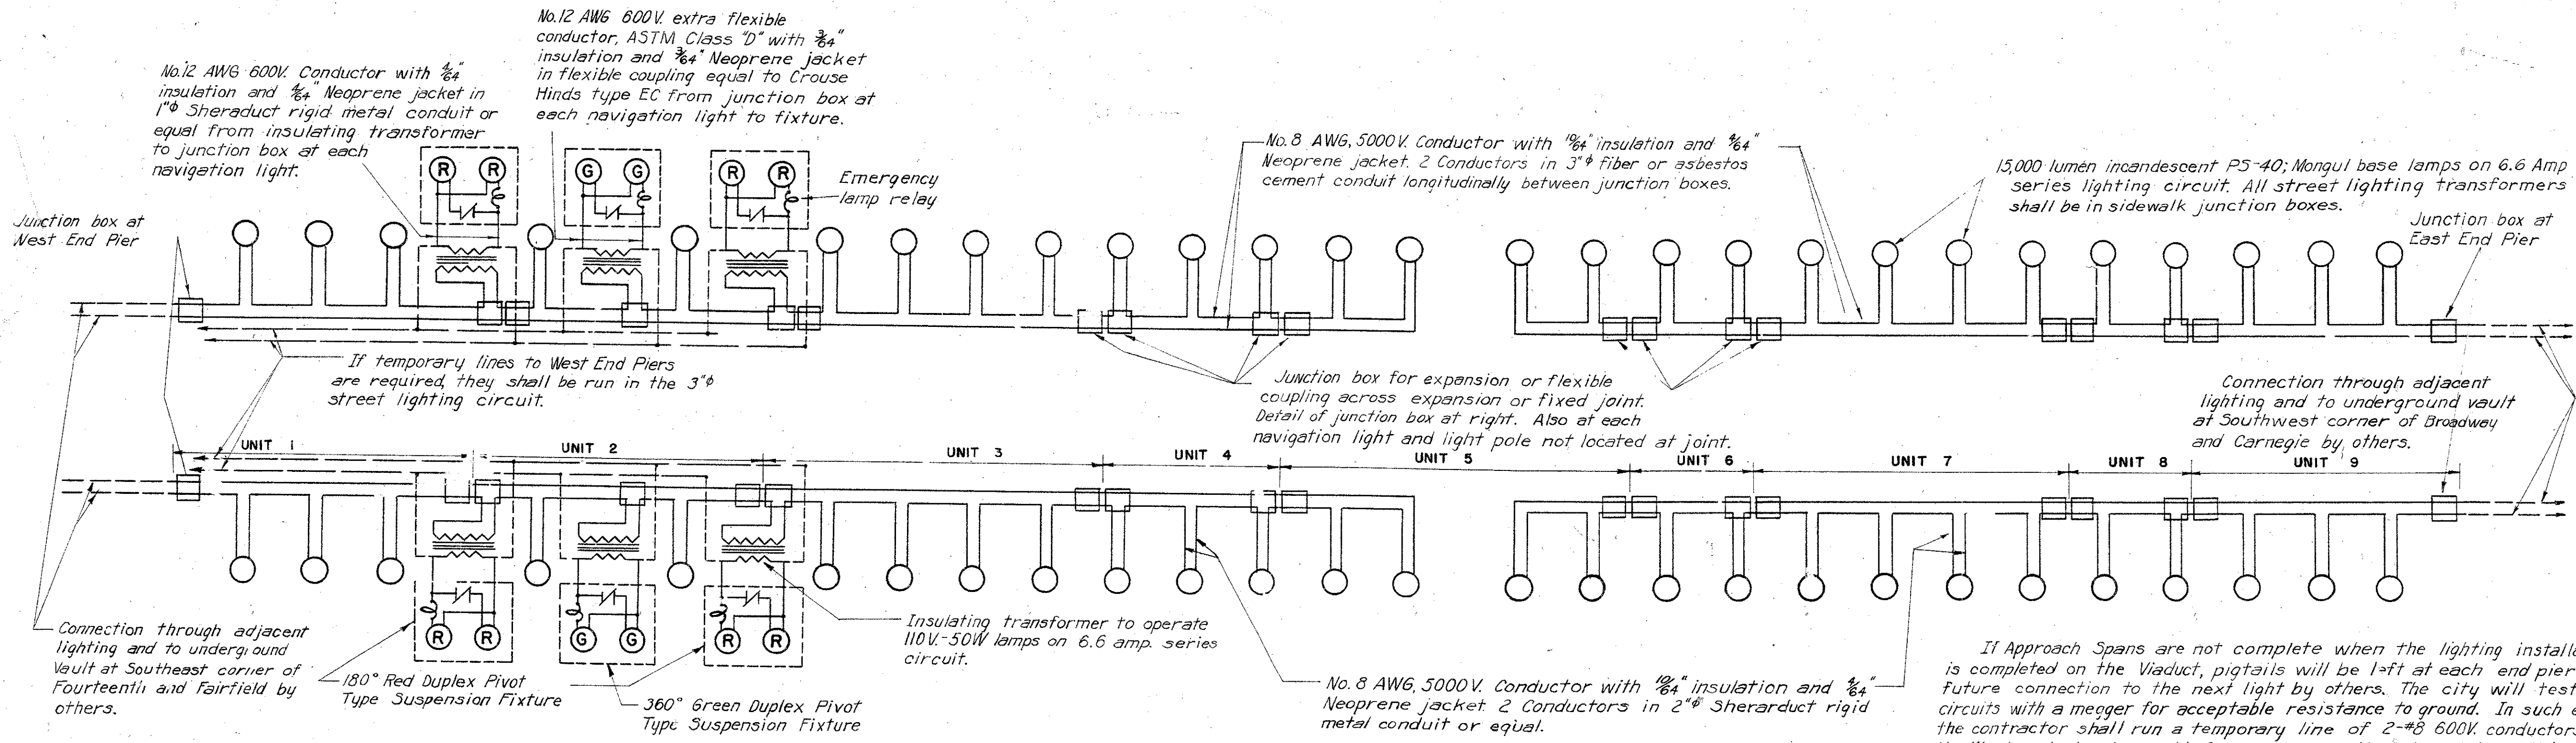


ROADWAY AND NAVIGATION LIGHTING
SERIES WIRING DIAGRAM
No Scale

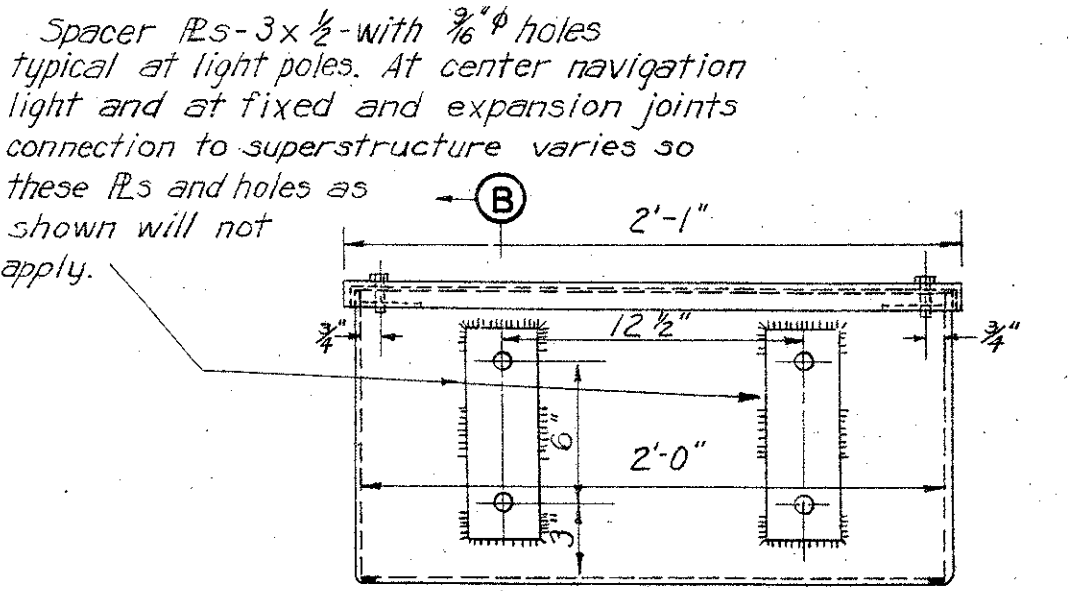


SECTION B-B

Scale: 3" = 1'-0"


JUNCTION BOX - 84 REQUIRED

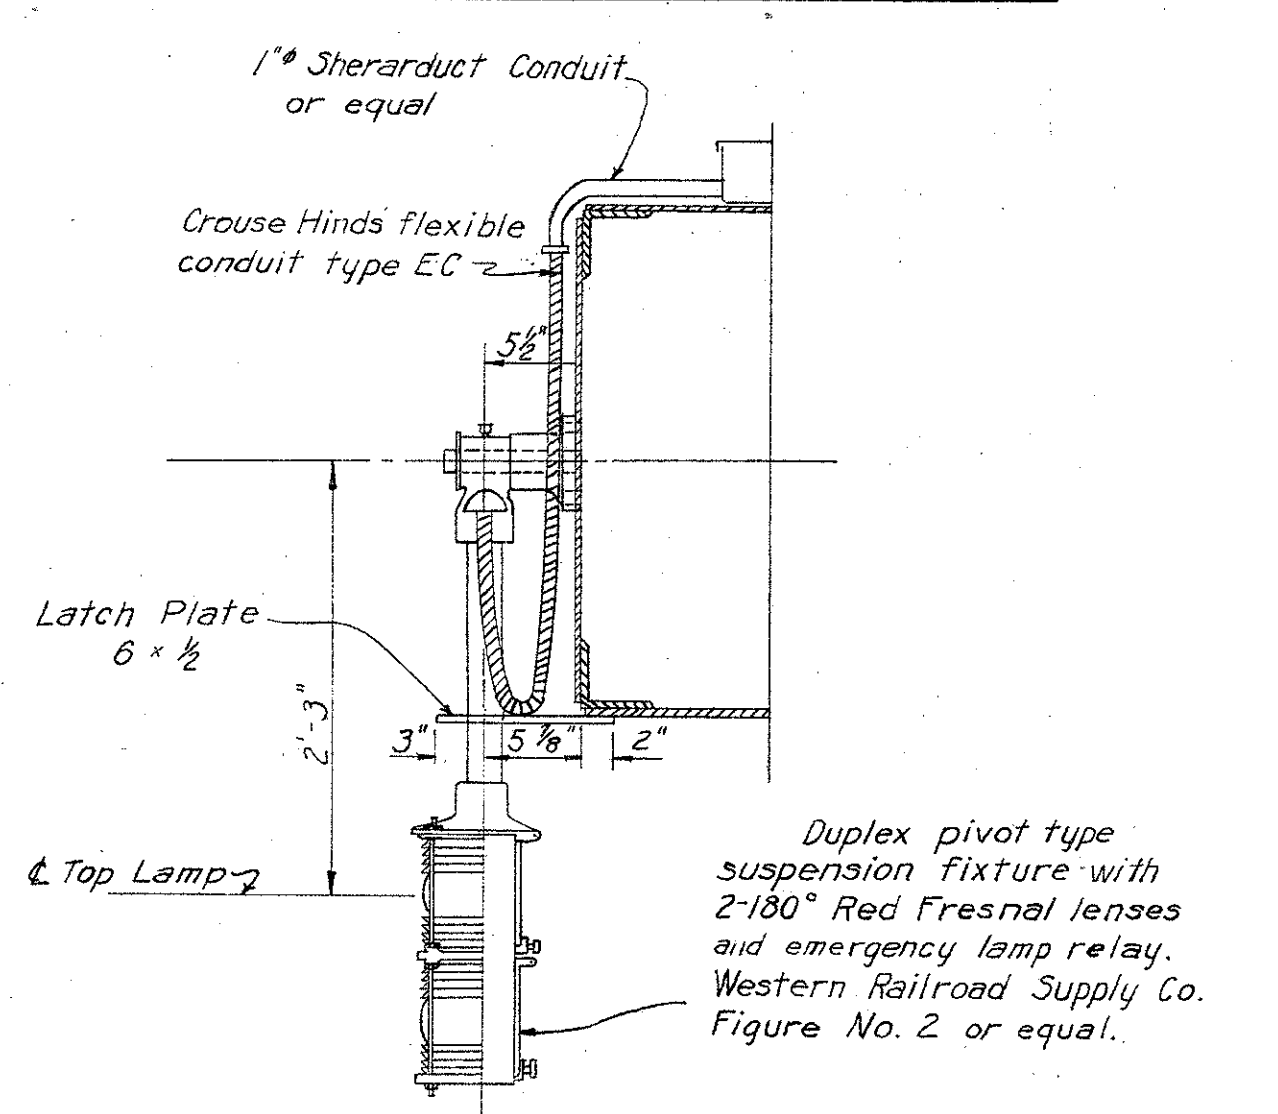


180° RED CHANNEL MARKER

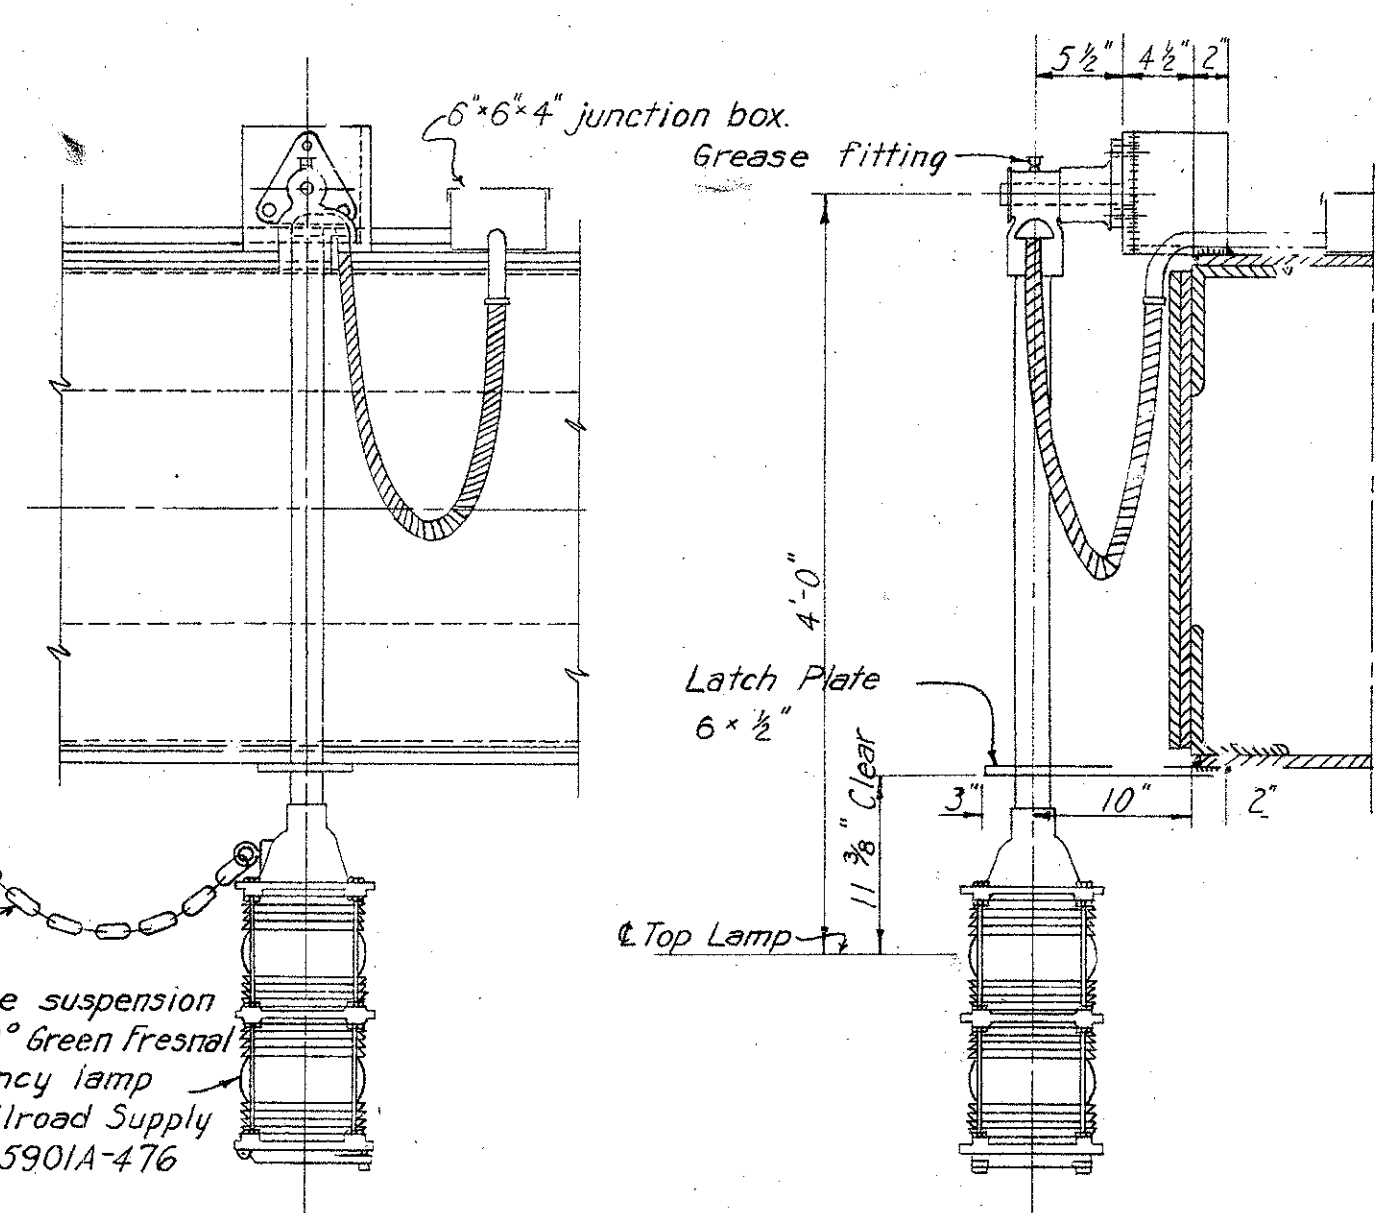


ELEVATION
HALF SECTION THROUGH
BOTTOM CHORD
360° GREEN CLEARANCE LIGHT

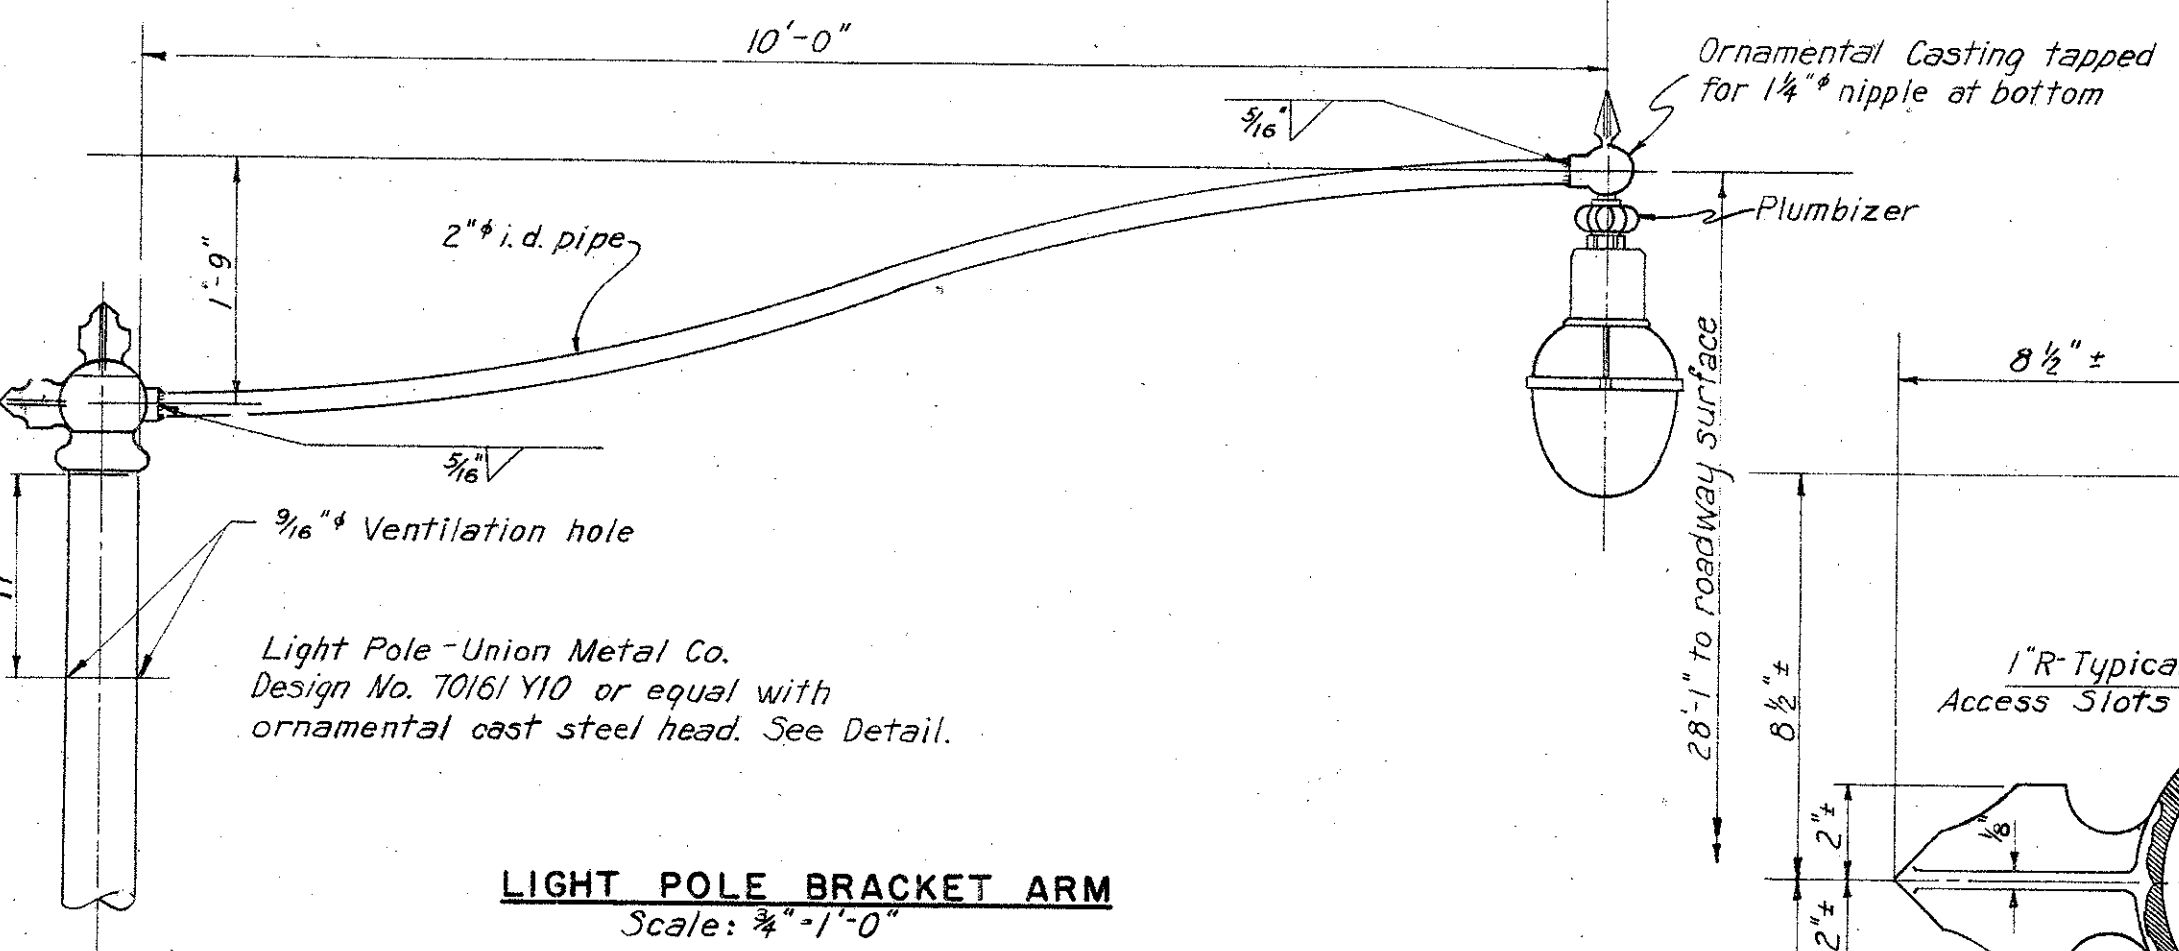


LIGHT POLE BRACKET ARM
Scale: 3/4" = 1'-0"

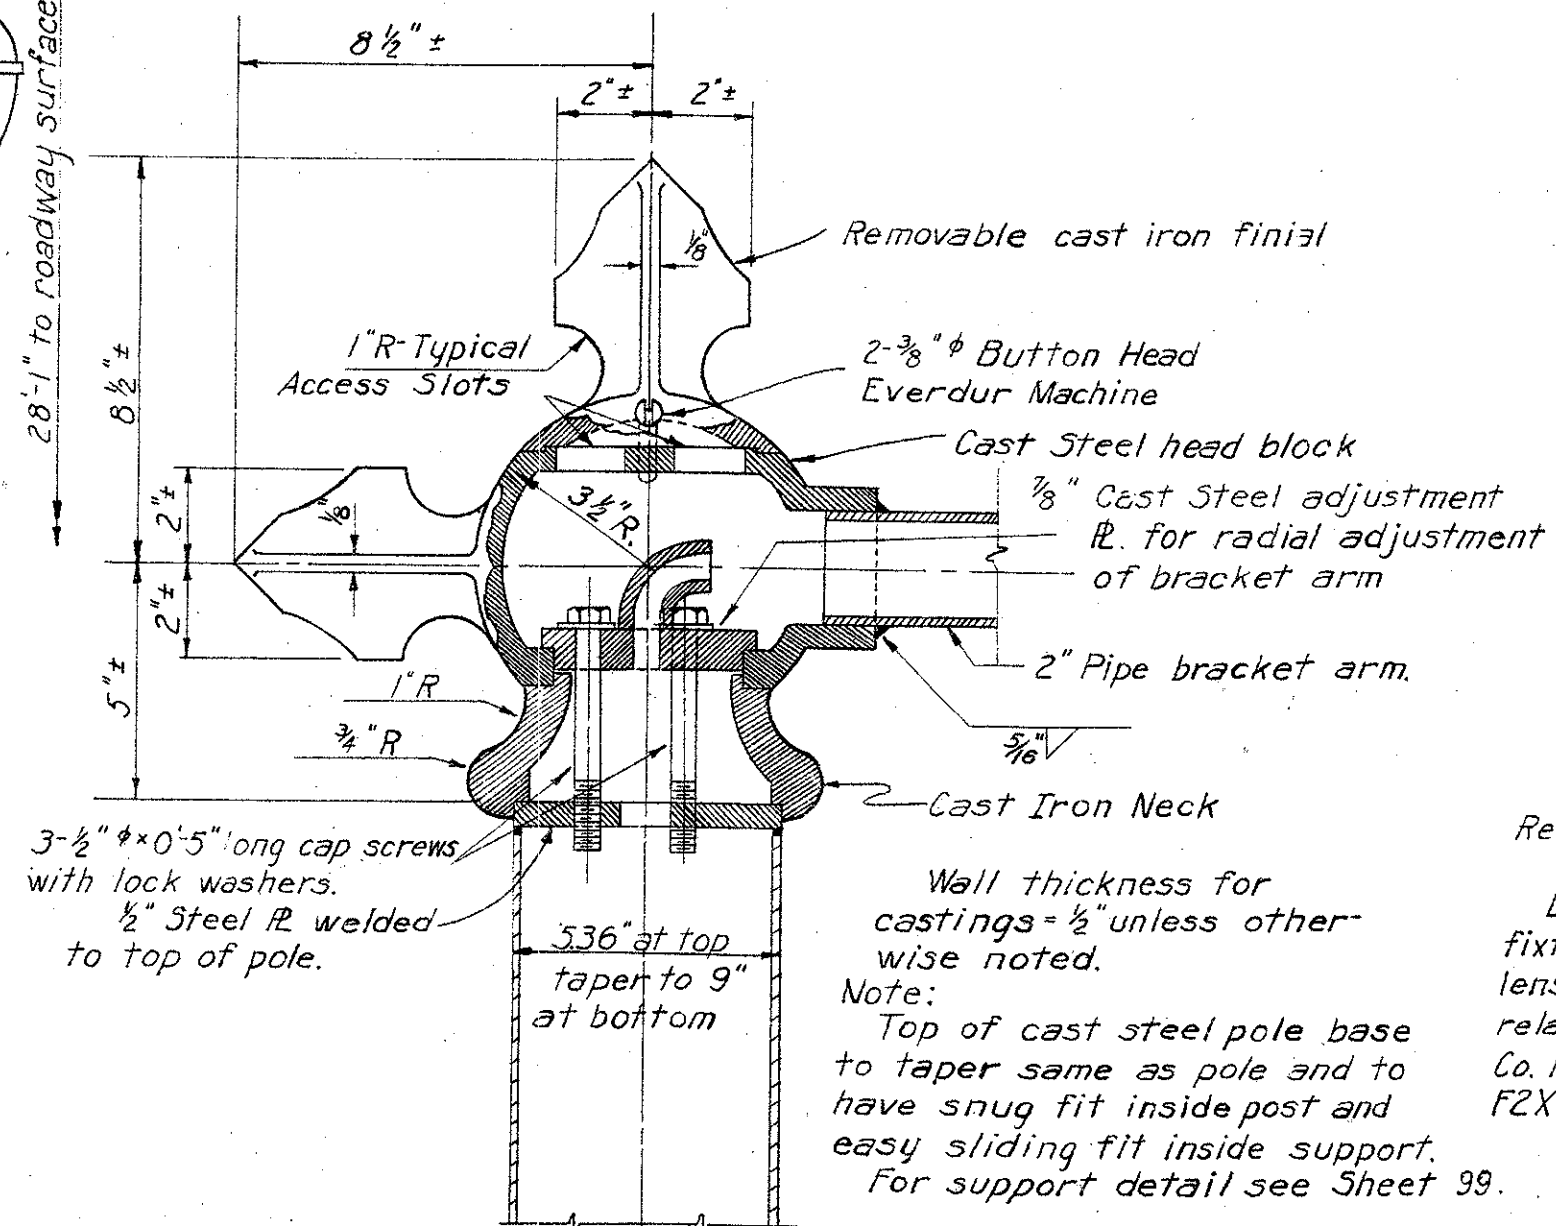

ORNAMENTAL LIGHT POLE HEAD
Scale: 3" = 1'-0"

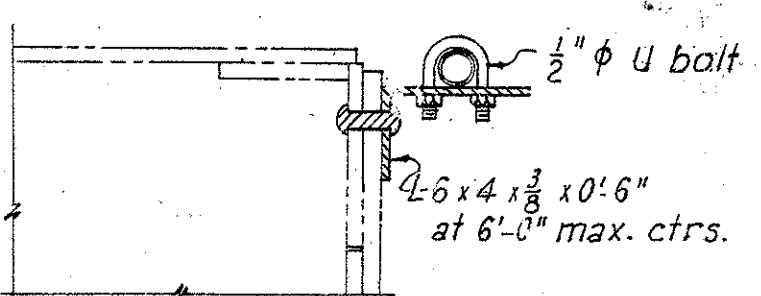

SUPPORTING BRACKET FOR CONDUIT
TO NAVIGATION LIGHTS

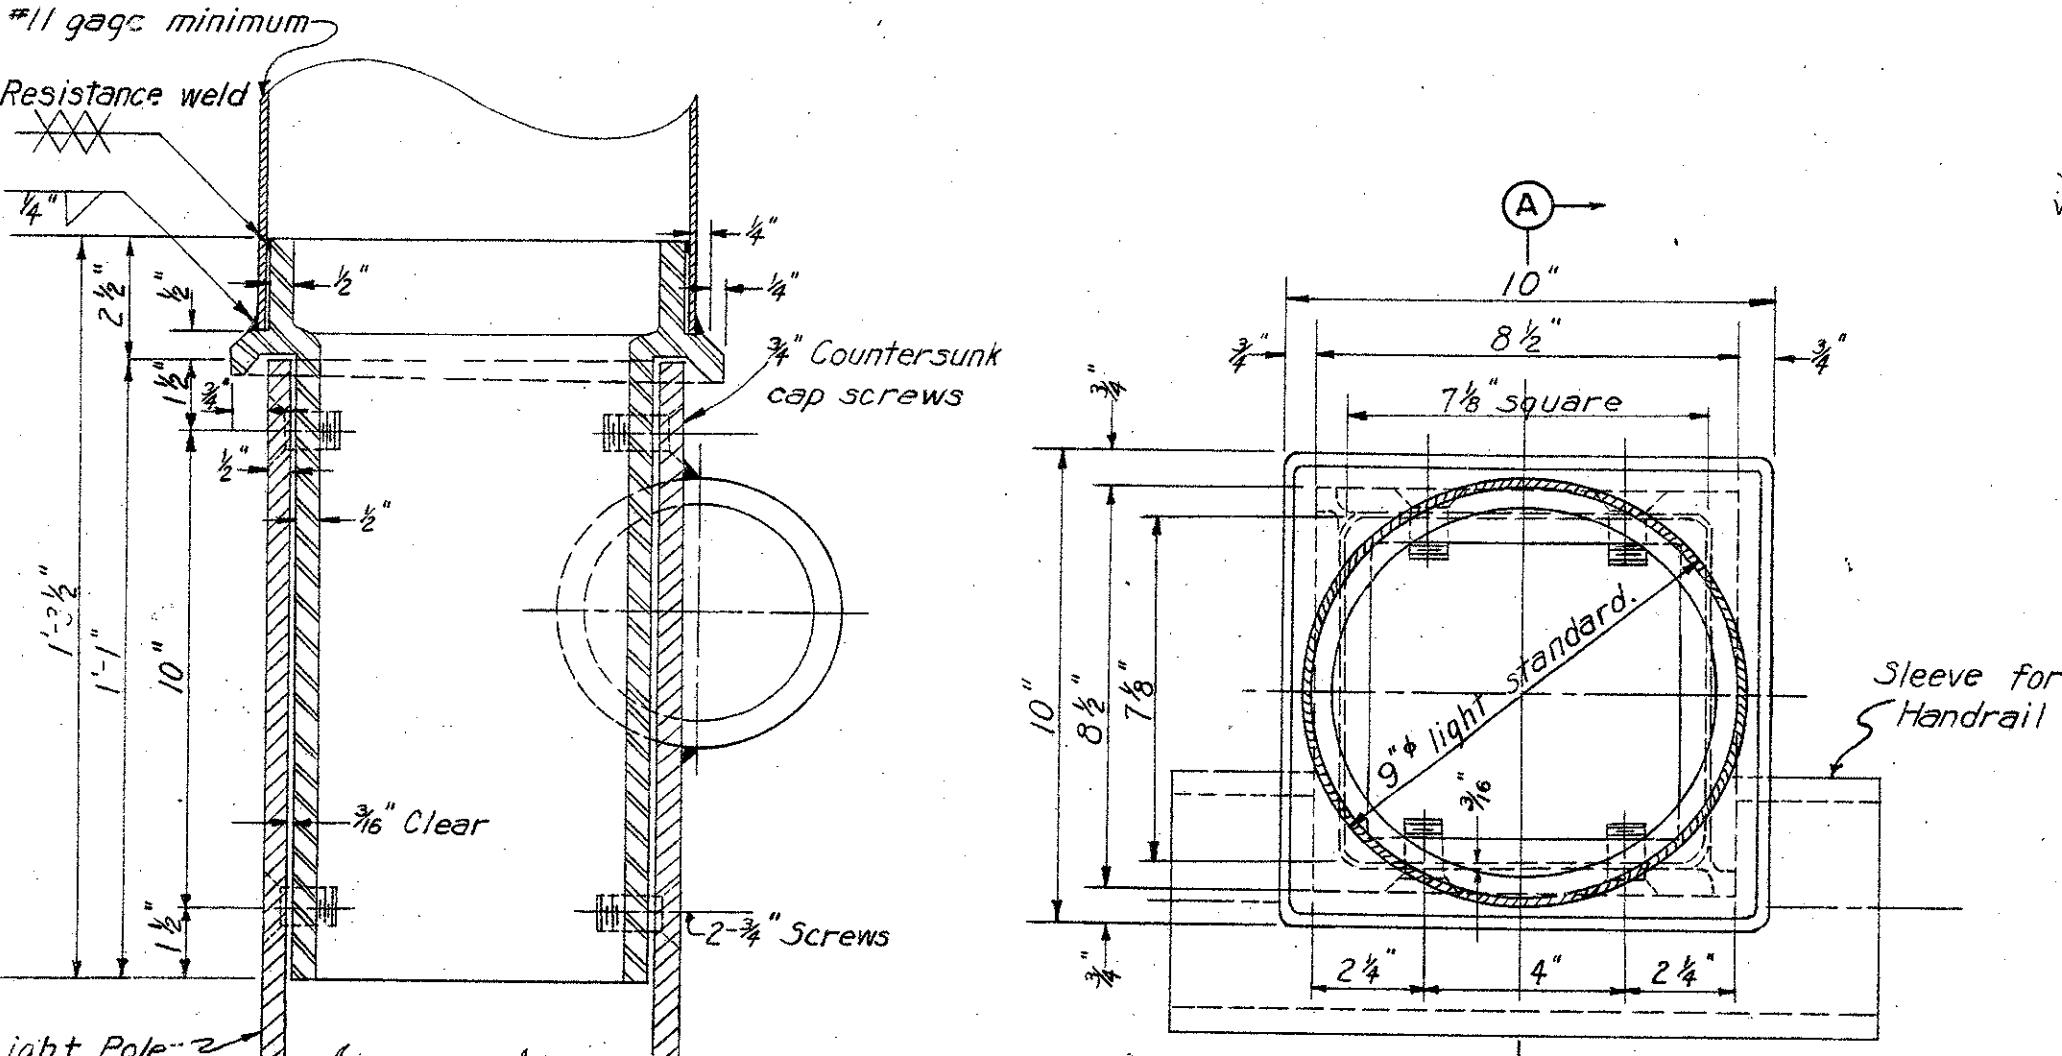

LIGHT POLE BASE
Scale: 3" = 1'-0"

UNCOPY LINKED
FEB 16 1954

FED. ROAD DIV. NO.	STATE	FEDERAL AID PROJECT NO.	TYPE FUNDS
2	OHIO		

121
122

CUYAHOGA COUNTY
CITY OF CLEVELAND
INNER BELT FREEWAY
CENTRAL VIADUCT

MARK	SIZE	NO.	LENGTH	TYPE	DIMENSIONS		WEIGHT LBS.
					A	B	
UNIT 6							
501	5	313	42'-0"	Str.			13,711
502	5	327	38'-6"	101	37'-8"	10"	13,131
503	5	140	35'-6"	Str.			5,184
504	5	45	35'-0"	Str.			1,643
505	5	72	35'-3"	Str.			2,647
506	5	56	35'-9"	Str.			2,088
507	5	109	38'-6"	101	38'-8"	10"	4,376
508	5	31	34'-0"	Str.			1,099
509	5	64	33'-9"	Str.			2,253
510	5	84	33'-6"	Str.			2,935
511	5	134	33'-3"	Str.			4,647
404	4	158	5'-9"	120			607
401	4	10	38'-9"	Str.			259
402	4	10	38'-6"	Str.			257
601	6	288	38'-0"	Str.			16,438
602	6	313	50'-3"	Str.			23,624
603	6	31	30'-3"	Str.			1,409
604	6	140	31'-9"	Str.			6,676
605	6	45	31'-3"	Str.			2,112
606	6	72	31'-6"	Str.			3,407
607	6	56	32'-0"	Str.			2,692
608	6	96	38'-6"	Str.			5,551
609	6	64	30'-0"	Str.			2,884
610	6	84	29'-9"	Str.			3,753
611	6	134	29'-6"	Str.			5,937

MARK	SIZE	NO.	LENGTH	TYPE	DIMENSIONS		WEIGHT LBS.
					A	B	
UNIT 7 CONTINUED							
545	5	4	20'-9"	Str.			87
546	5	4	29'-9"	Str.			124
547	5	2	20'-8"	101	19'-10"	10"	43
404	4	461	5'-9"	120			1771
401	4	30	33'-0"	Str.			661
402	4	20	37'-6"	Str.			501
403	4	15	34'-0"	Str.			341
601	6	644	3'-6"	101	2'-6"	1'-0"	3,386
602	6	908	50'-3"	Str.			68,532
603	6	63	32'-3"	Str.			3,052
604	6	115	31'-9"	Str.			5,484
605	6	59	31'-3"	Str.			2,769
606	6	100	31'-0"	Str.			4,656
607	6	40	30'-9"	Str.			1,847
608	6	382	38'-6"	Str.			22,090
609	6	382	16'-3" to 20'-9"	Str.			2,584
610	6	2 Ser 12	34'-3" to 38'-6"	Str.			10,053
611	6	1	17'-6"	Str.			26
612	6	192	50'-9"	Str.			14,635
613	6	1 Ser 33	16'-3" to 20'-6"	Str.			2,567
614	6	1	20'-9"	Str.			31
615	6	2	34'-3"	Str.			103
616	6	103	30'-6"	Str.			4,719
617	6	2	42'-0"	Str.			126
618	6	74	32'-9"	Str.			3,640
619	6	78	28'-6"	Str.			3,339
620	6	2	16'-3"	Str.			49
621	6	41	30'-3"	Str.			1,863
622	6	247	30'-0"	Str.			11,130
623	6	57	29'-9"	Str.			2,547
624	6	145	29'-6"	Str.			6,425
625	6	70	29'-3"	Str.			3,075
626	6	78	29'-0"	Str.			3,398
627	6	36	28'-9"	Str.			1,555
628	6	176	31'-6"	Str.			8,327
629	6	140	32'-0"	Str.			6,729
630	6	64	32'-6"	Str.			3,124
631	6	96	33'-3"	Str.			4,794
632	6	2	33'-0"	Str.			99
633	6	3	25'-0"	Str.			113
634	6	2	13'-0"	Str.			39
635	6	190	40'-0"	Str.			11,415
636	6	38	28'-3"	Str.			1,612
637	6	2	16'-0"	Str.			48
638	6	1	8'-6"	Str.			13
639	6	1	20'-6"	Str.			31
640	6	4 Ser 3	4'-0" to 28'-0"	Str.			288
641	6	4 Ser 11	12'-0" to 41'-0"	Str.			637
642	6	4	17'-0"	Str.			102
643	6	4	26'-0"	Str.			156
644	6	2	5'-0"	Str.			15
645	6	2	20'-0"	Str.			60


MARK	SIZE	NO.	LENGTH	TYPE	DIMENSIONS		WEIGHT LBS.
					A	B	
UNIT 8							
501	5	309	42'-0"	Str.			13,536
502	5	24	36'-0"	Str.			901
503	5	26	33'-3"	Str.			902
504	5	26	33'-0"	Str.			895
505	5	25	32'-9"	Str.			854
506	5	51	32'-6"	Str.			1,729
507	5	26	35'-9"	Str.			969
508	5	23	36'-3"	Str.			870
509	5	80	37'-0"	Str.			3,087
510	5	106	36'-9"	Str.			4,063
511	5	1	24'-9"	Str.			26
512	5	1	13'-8"	101	12'-10"	10"	14
513	5	29	32'-0"	Str.			968
514	5	217	38'-6"	101	37'-8"	10"	8,714
515	5	218	38'-2"	101	37'-4"	10"	8,678
516	5	50	36'-6"	Str.			1,903
517	5	152	32'-3"	Str.			5,113
404	4	158	5'-9"	120			607
401	4	10	38'-9"	Str.			259
402	4	10	38'-6"	Str.			257
601	6	92	3'-6"	101	2'-6"	1'-0"	484
602	6	309	50'-3"	Str.			23,322
603	6	24	32'-3"	Str.			1,163
604	6	26	29'-6"	Str.			1,152
605	6	26	29'-3"	Str.			1,142
606	6	25	29'-0"	Str.			1,089
607	6	51	28'-9"	Str.			2,202
608	6	26	32'-0"	Str.			1,250
609	6	23	32'-6"	Str.			1,123
610	6	80	33'-3"	Str.			3,995
611	6	106	33'-0"	Str.			5,254
612	6	1	25'-0"	Str.			38
613	6	1	13'-0"	Str.			20
614	6	29	28'-3"	Str.			1,231
615	6	191	38'-0"	Str.			10,902
616	6	152	28'-6"	Str.			6,507
617	6	192	37'-9"	Str.			10,886
618	6	50	32'-9"	Str.			2,460

RECEIVED
FEB 16 1954

FED. ROAD DIV. NO.	STATE	FEDERAL AID PROJECT NO.	TYPE FUNDS
2	OHIO		

120
122

CUYAHOGA COUNTY
CITY OF CLEVELAND
INNER BELT FREEWAY
CENTRAL VIADUCT

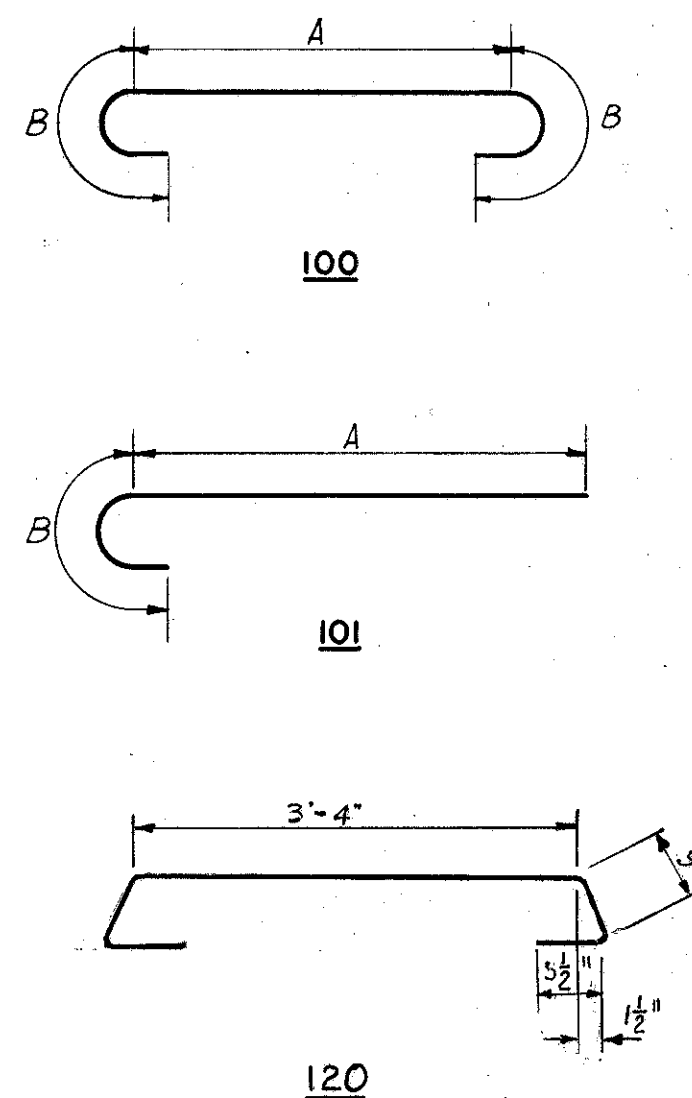

BENDING DIAGRAMS

MARK	SIZE	NO.	LENGTH	TYPE	DIMENSIONS		WEIGHT LBS.
					A	B	
UNIT 1							
501	5	669	42'-0"	Str.			29,306
502	5	218	20'-8"	100	19'-0"	10"	4,700
503	5	218	28'-2"	101	27'-0"	10"	6,405
504	5	109	45'-8"	100	44'-0"	10"	5,192
505	5	218	40'-0"	101	39'-2"	10"	9,095
506	5	1338	34'-6"	Str.			48,146
507	5	218	36'-0"	101	35'-2"	10"	8,185
508	5	109	36'-3"	Str.			4,121
404	4	339	5'-8"	120			1,302
401	4	15	1'-9"	Str.			428
402	4	30	3'-0"	Str.			68
</							

MARK	SIZE	NO.	LENGTH	TYPE	DIMENSIONS		WEIGHT LBS.
					A	B	
UNIT 3							
501	5	922	42'-6"	Str.			40,389
502	5	218	39'-0"	101	38'-2"	10"	8,868
503	5	136	20'-6"	100	18'-10"	10"	2,908
504	5	328	38'-3"	101	37'-5"	10"	13,085
505	5	218	51'-3"	101	50'-5"	10"	11,653
506	5	108	38'-6"	101	37'-8"	10"	4,337
507	5	42	34'-9"	Str.			1,522
508	5	28	20'-0"	100	18'-4"	10"	584
509	5	54	35'-3"	Str.			1,985
510	5	56	35'-9"	Str.			2,088
511	5	54	36'-3"	Str.			2,042
512	5	54	34'-0"	Str.			1,915
513	5	56	33'-6"	Str.			1,957
514	5	54	33'-0"	Str.			1,859
515	5	1	14'-3"	101	13'-5"	10"	15
516	5	216	40'-0"	101	39'-2"	10"	9,012
517	5	1	29'-3"	Str.			31
518	5	1	17'-6"	Str.			18
519	5	1474	34'-6"	Str.			53,400
520	5	26	20'-9"	100	19'-1"	10"	563
521	5	27	20'-3"	100	18'-7"	10"	570
522	5	1	21'-0"	100	19'-4"	10"	22
404	4	468	5'-9"	120			1798
401	4	15	33'-3"	Str.			333
402	4	20	38'-6"	Str.			514
403	4	30	34'-0"	Str.			681
601	6	922	50'-3"	Str.			69,588
602	6	188	38'-6"	Str.			10,872
603	6	118	19'-3"	Str.			3,412
604	6	282	37'-9"	Str.			15,990
605	6	188	50'-9"	Str.			14,331
606	6	94	38'-0"	Str.			5,365
607	6	42	31'-0"	Str.			1,956
608	6	24	18'-9"	Str.			676
609	6	54	31'-6"	Str.			2,555
610	6	56	32'-0"	Str.			2,692
611	6	54	32'-6"	Str.			2,636
612	6	54	30'-3"	Str.			2,454
613	6	56	29'-9"	Str.			2,502
614	6	54	29'-3"	Str.			2,372
615	6	1	13'-6"	Str.			20
616	6	190	39'-6"	Str.			11,273
617	6	1	29'-6"	Str.			44
618	6	1	17'-9"	Str.			27
619	6	1474	30'-9"	Str.			68,079
620	6	644	31'-6"	101	2'-6"	1'-0"	3,386
621	6	23	19'-6"	Str.			674
622	6	24	19'-0"	Str.			685
623	6	1	19'-9"	Str.			30

FEB 16 1963

119
122

CUYAHOGA COUNTY
CITY OF CLEVELAND
INNER BELT FREEWAY
CENTRAL VIADUCT



Notes:

All longitudinal bars are to be parallel to stringer except bars at the edges of slab which are parallel to gutter lines. For spacing of longitudinal bars, see Typical Section, Sheet.

All transverse bars are to be normal to stringer and at 5 $\frac{1}{2}$ " ctrs. except extra bars parallel to edge of joints and cross drains. Top transverse are to be spliced at mid-point between Stringers "E" and "F" and Stringers "J" and "K". Bottom transverse bars are to be spliced over Stringer "E" and Stringer "K".

For Details of Contraction Joint, see Sheet 114.
For Reinforcing Steel Schedule, see Sheet 121.
For Details of Cross-Drain, See Sheet 105.

PART 3

U. S. ROUTE 42 RELOCATION
INNER BELT FREEWAY - CENTRAL VIADUCT
BR. NO. CU - 42R-175

SLAB PLAN
UNIT 9

CLEVELAND CUYAHOGA COUNTY OHIO

SCALE 1/8" = 1'-0"
MADE R.K. DATE 2-4-54
TRCD BMO DATE 8-26-54
CKD BEE DATE 9-11-54


HOWARD, NEEDLES, TAMMEN & BERGENDOFF
CONSULTING ENGINEERS
KANSAS CITY CLEVELAND NEW YORK
914-1A SHEET 2.119

REPRODUCED
FEB 16 1983


FED. ROAD DIV. NO.	STATE	FEDERAL AID PROJECT NO.	TYPE FUNDS
2	OHIO		

118
122

CUYAHOGA COUNTY
CITY OF CLEVELAND
INNER BELT FREEWAY
CENTRAL VIADUCT

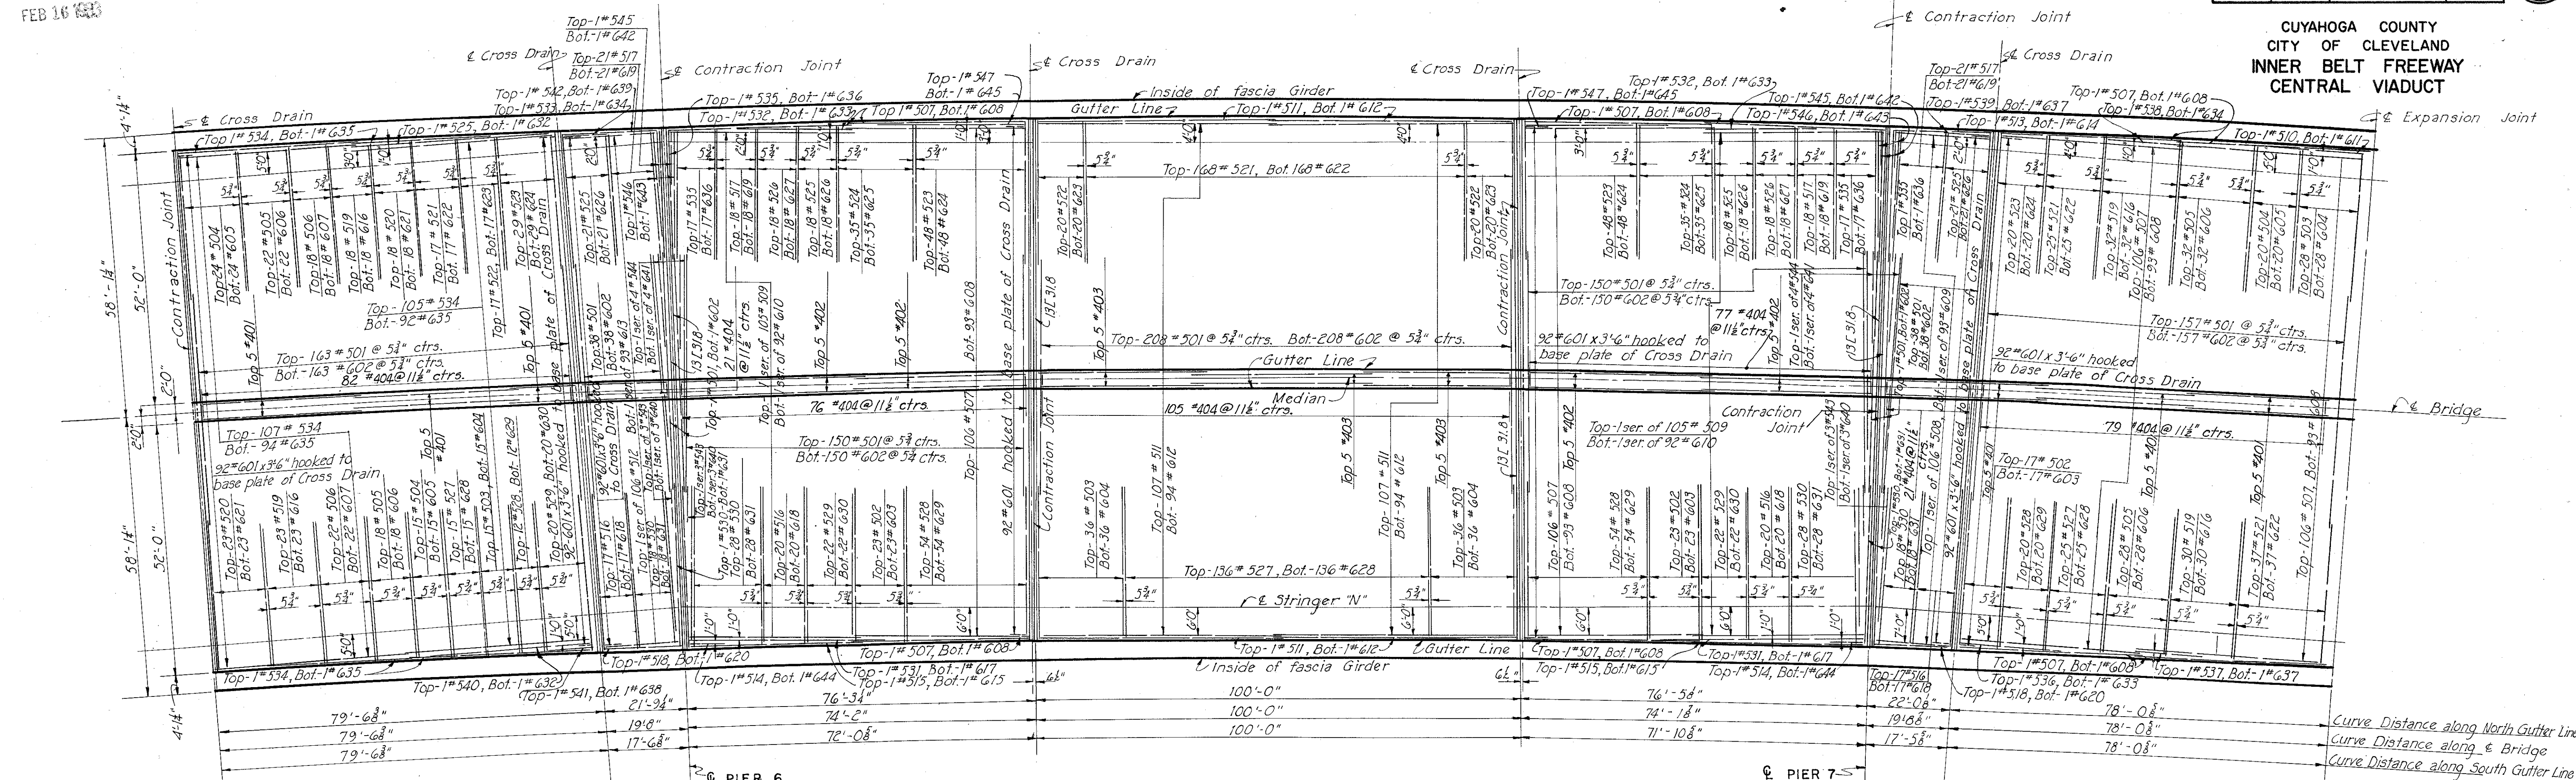

SLAB PLAN - UNIT 7

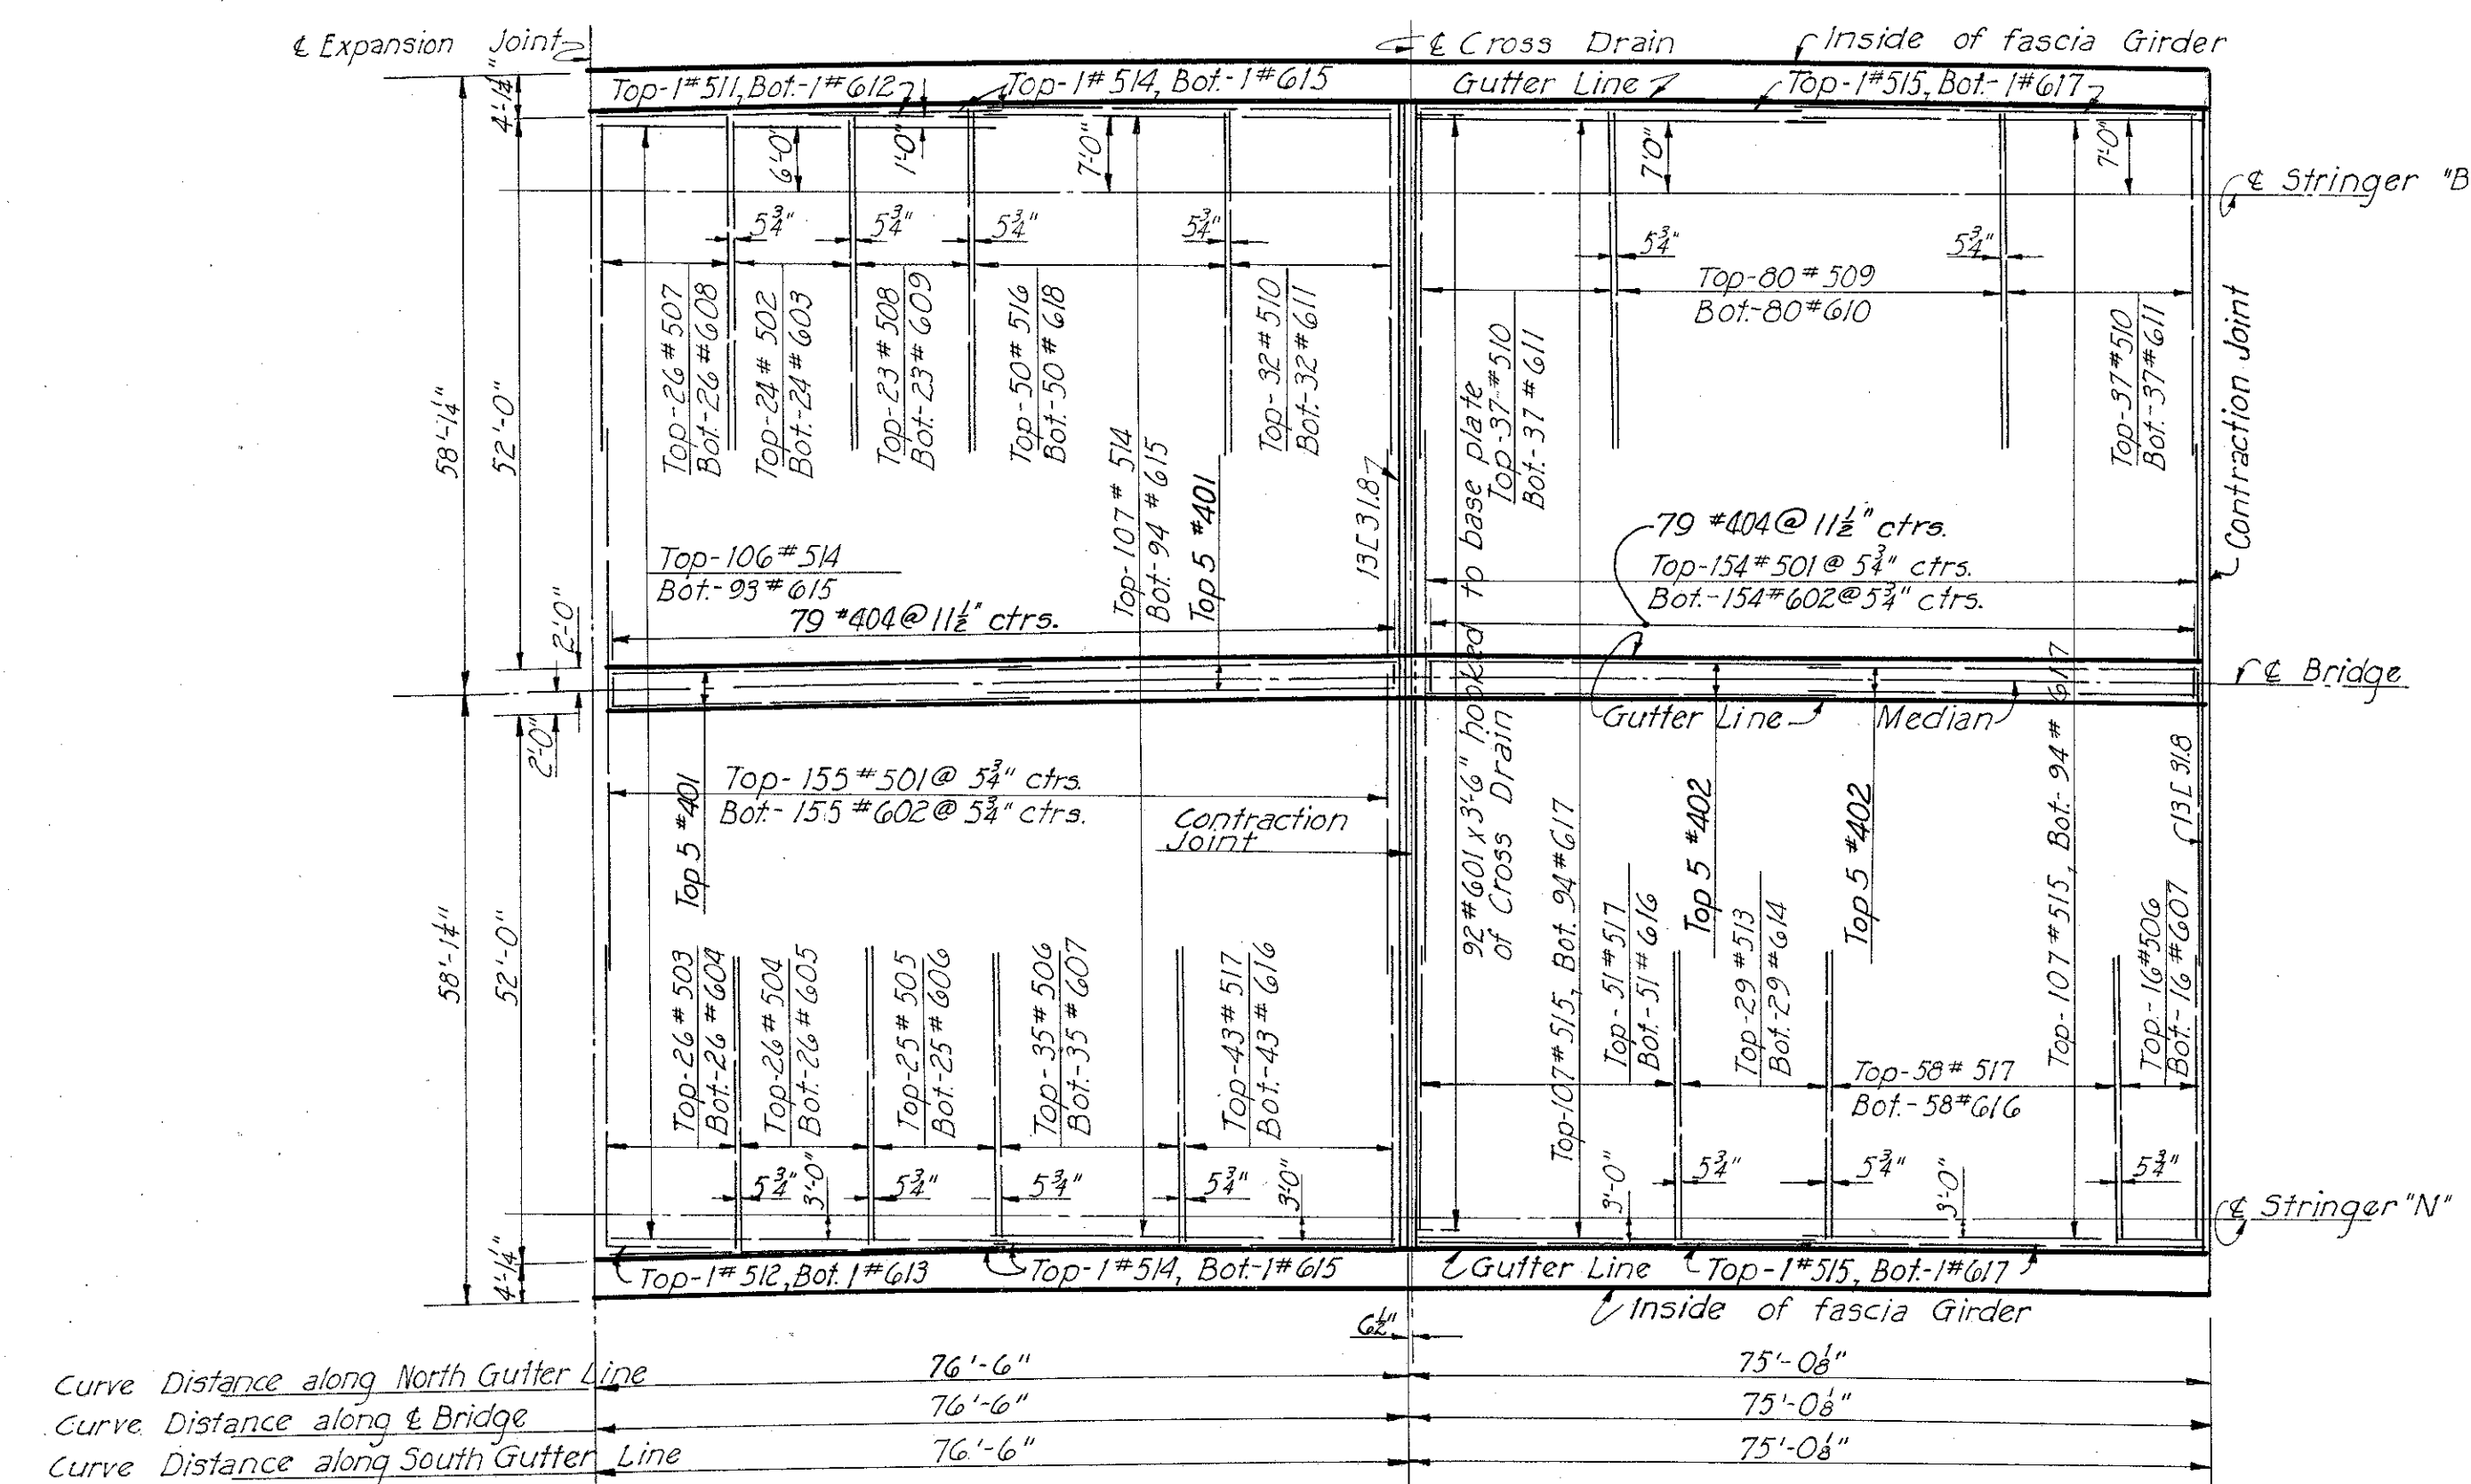

SLAB PLAN - UNIT 8

All longitudinal bars are to be parallel to stringer except the bars at the edges of slab which are parallel to gutter lines. For spacing of longitudinal bars, see Typical Section, Sheet 114.

All transverse bars are to be normal to stringers and at 5 1/2\"/>

PART 3

U. S. ROUTE 42 RELOCATION
INNER BELT FREEWAY - CENTRAL VIADUCT
BR. NO. CU - 42 R-17.5

SLAB PLAN
UNITS 7 AND 8

CLEVELAND CUYAHOGA COUNTY OHIO

SCALE 1/2\"/>

HOWARD, NEEDLES, TAMMEN & BERGENDOFF

CONSULTING ENGINEERS

KANSAS CITY CLEVELAND NEW YORK

914-1A SHEET 2.118


MICROFILMED
FEB 16 1983

FED. ROAD DIV. NO.	STATE	FEDERAL AID PROJECT NO.	TYPE FUNDS
2	OHIO		


117

122

CUYAHOGA COUNTY
CITY OF CLEVELAND
INNER BELT FREEWAY
CENTRAL VIADUCT

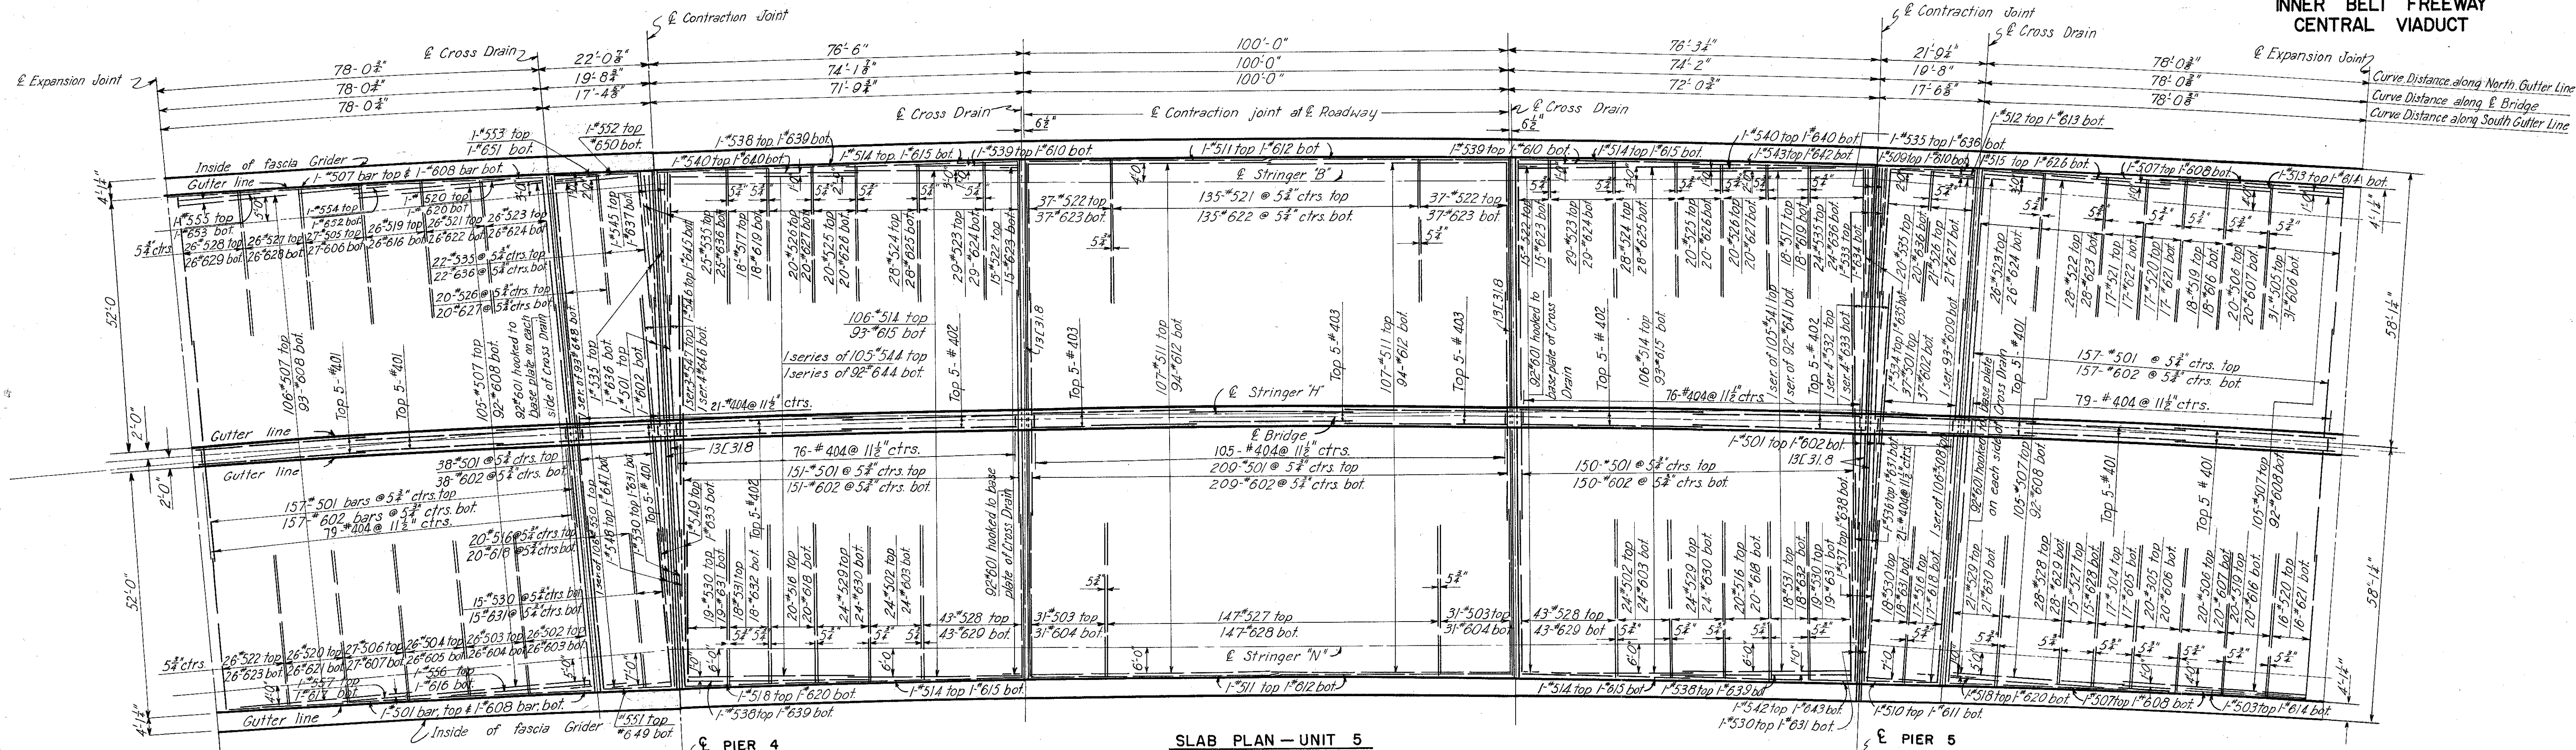

SLAB PLAN - UNIT 5

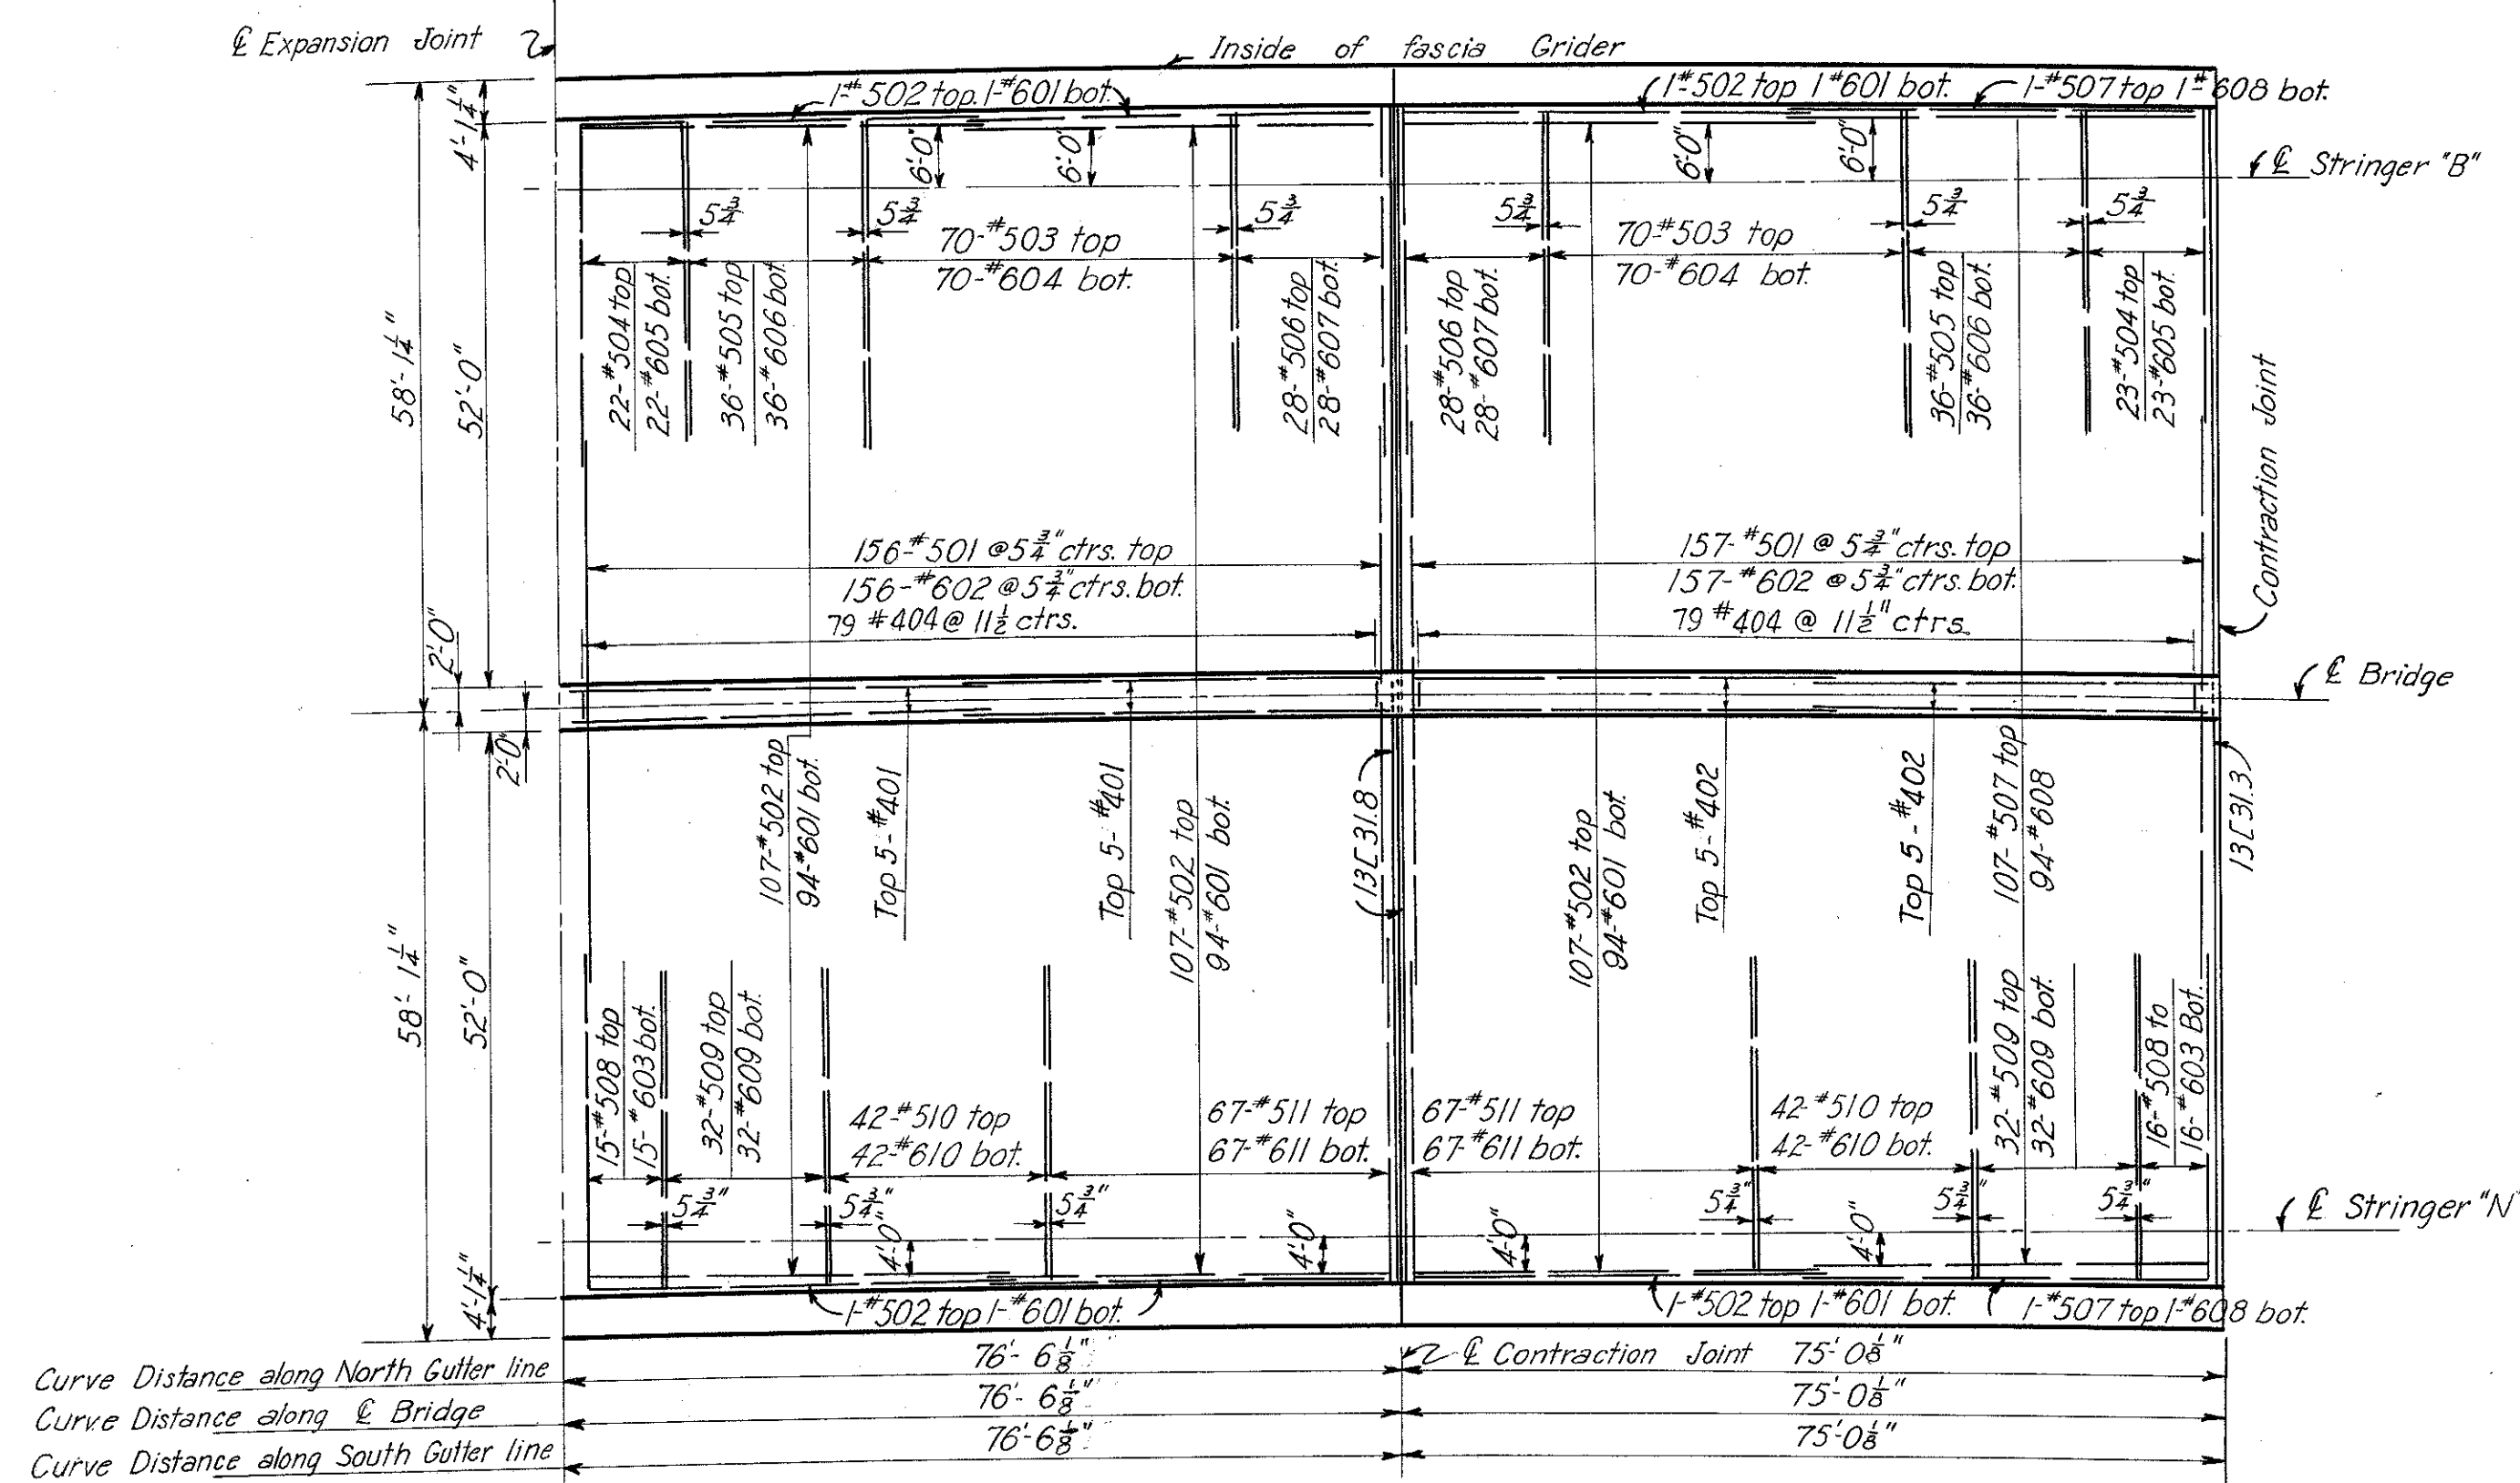

SLAB PLAN - UNIT 6

Notes:
All longitudinal bars are to be parallel to stringers except the bars at the edges of slab which are parallel to gutter lines. For spacing of longitudinal bars, see Typical Section, Sheet 114.
All transverse bars are to be normal to stringers and of 5# ctrs. except extra bars parallel to edge of joints and cross drains. Top transverse bars are to be spliced at mid-point between Stringers "E" and "F" and Stringers "J" and "K". Bottom transverse bars are to be spliced over Stringer "E" and Stringer "K".
For Details of Contraction Joint, see Sheet 114.
For Reinforcing Steel Schedule, see Sheets 120 and 121.
For Details of Cross Drain, see Sheets 105, 107 and 109.


PART 3

U. S. ROUTE 42 RELOCATION		
INNER BELT FREEWAY - CENTRAL VIADUCT		
BR. NO. CU - 42R-175		
SLAB PLAN		
UNITS 5 AND 6		
CLEVELAND	CUYAHOGA COUNTY	OHIO
SCALE: 1/8" = 1'-0"		
MADE: 8-2-54 DATE: 2-18-54		
TRCD: 11-4-54 DATE: 8-25-54		
CKD: 2-6-54 DATE: 9-10-54		
HOWARD, NEEDLES, TAMMEN & BERGENDOFF CONSULTING ENGINEERS KANSAS CITY CLEVELAND NEW YORK		
914-1A SHEET 2.117		


MICROFILMED
FEB 16 1983

FED. ROAD DIV. NO.	STATE	FEDERAL AID PROJECT NO.	TYPE FUNDS	116 122
2	OHIO			

CUYAHOGA COUNTY
CITY OF CLEVELAND
INNER BELT FREEWAY
CENTRAL VIADUCT

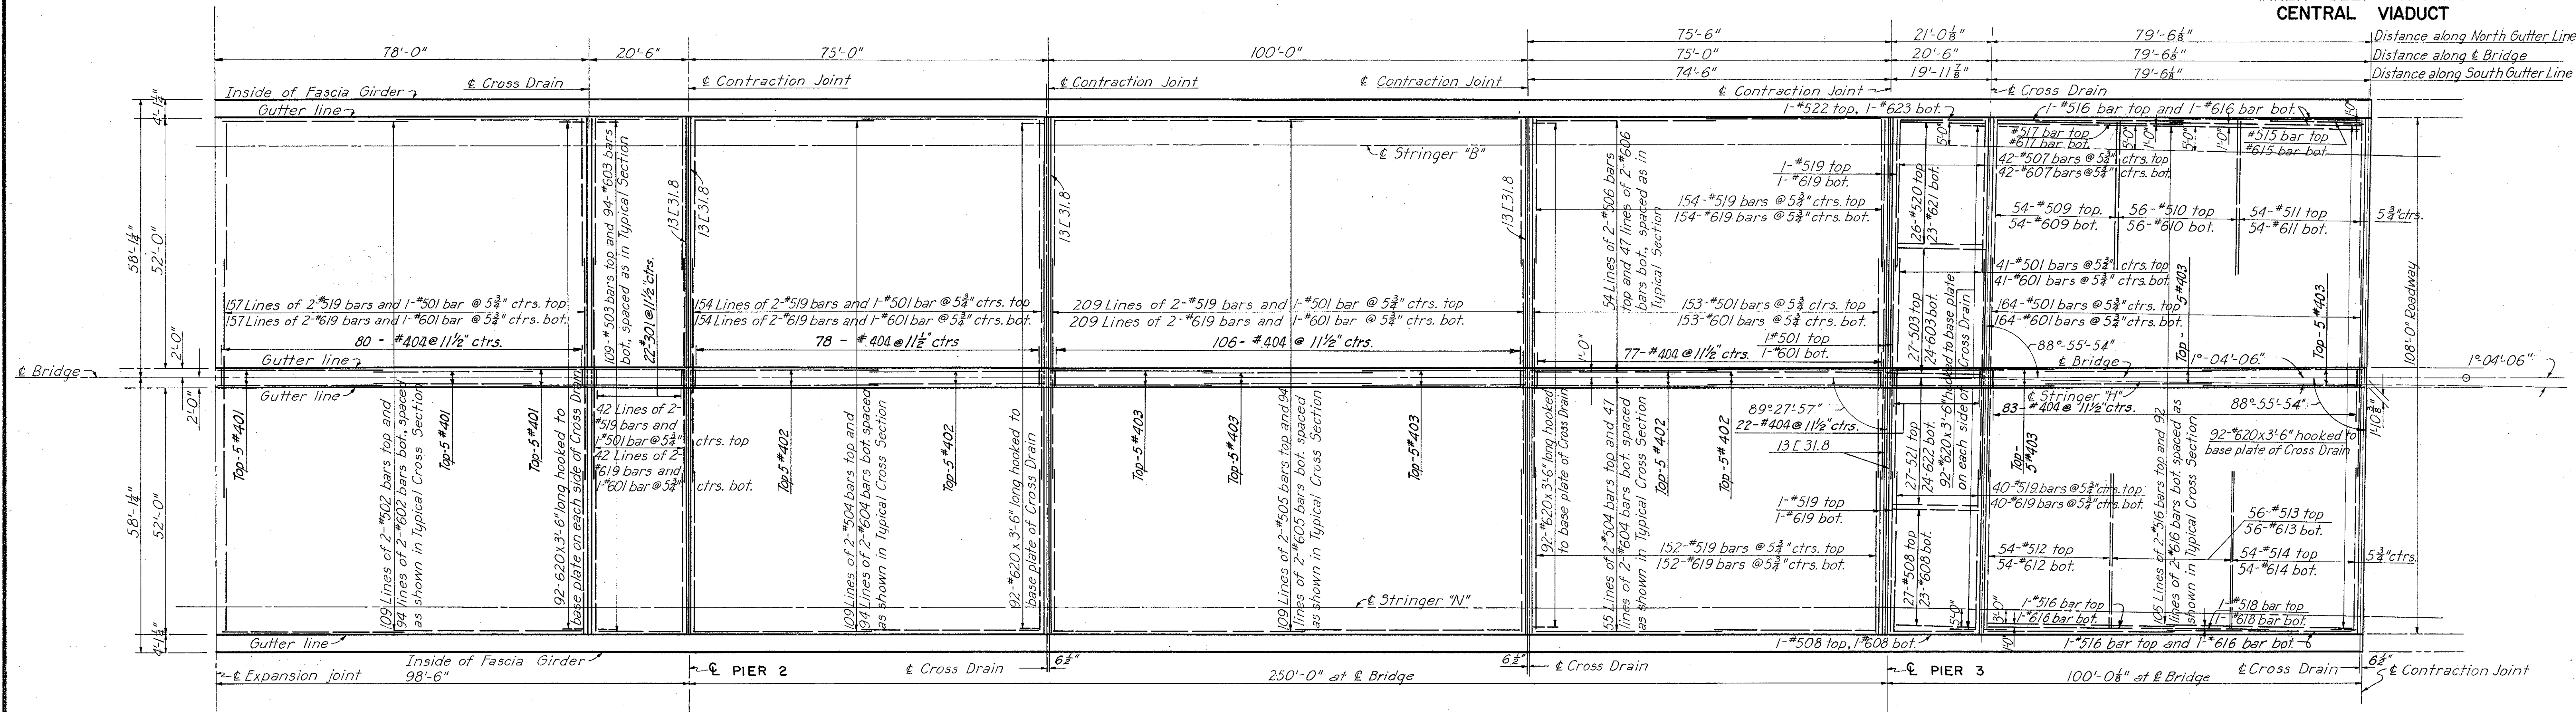

SLAB PLAN—UNIT 3

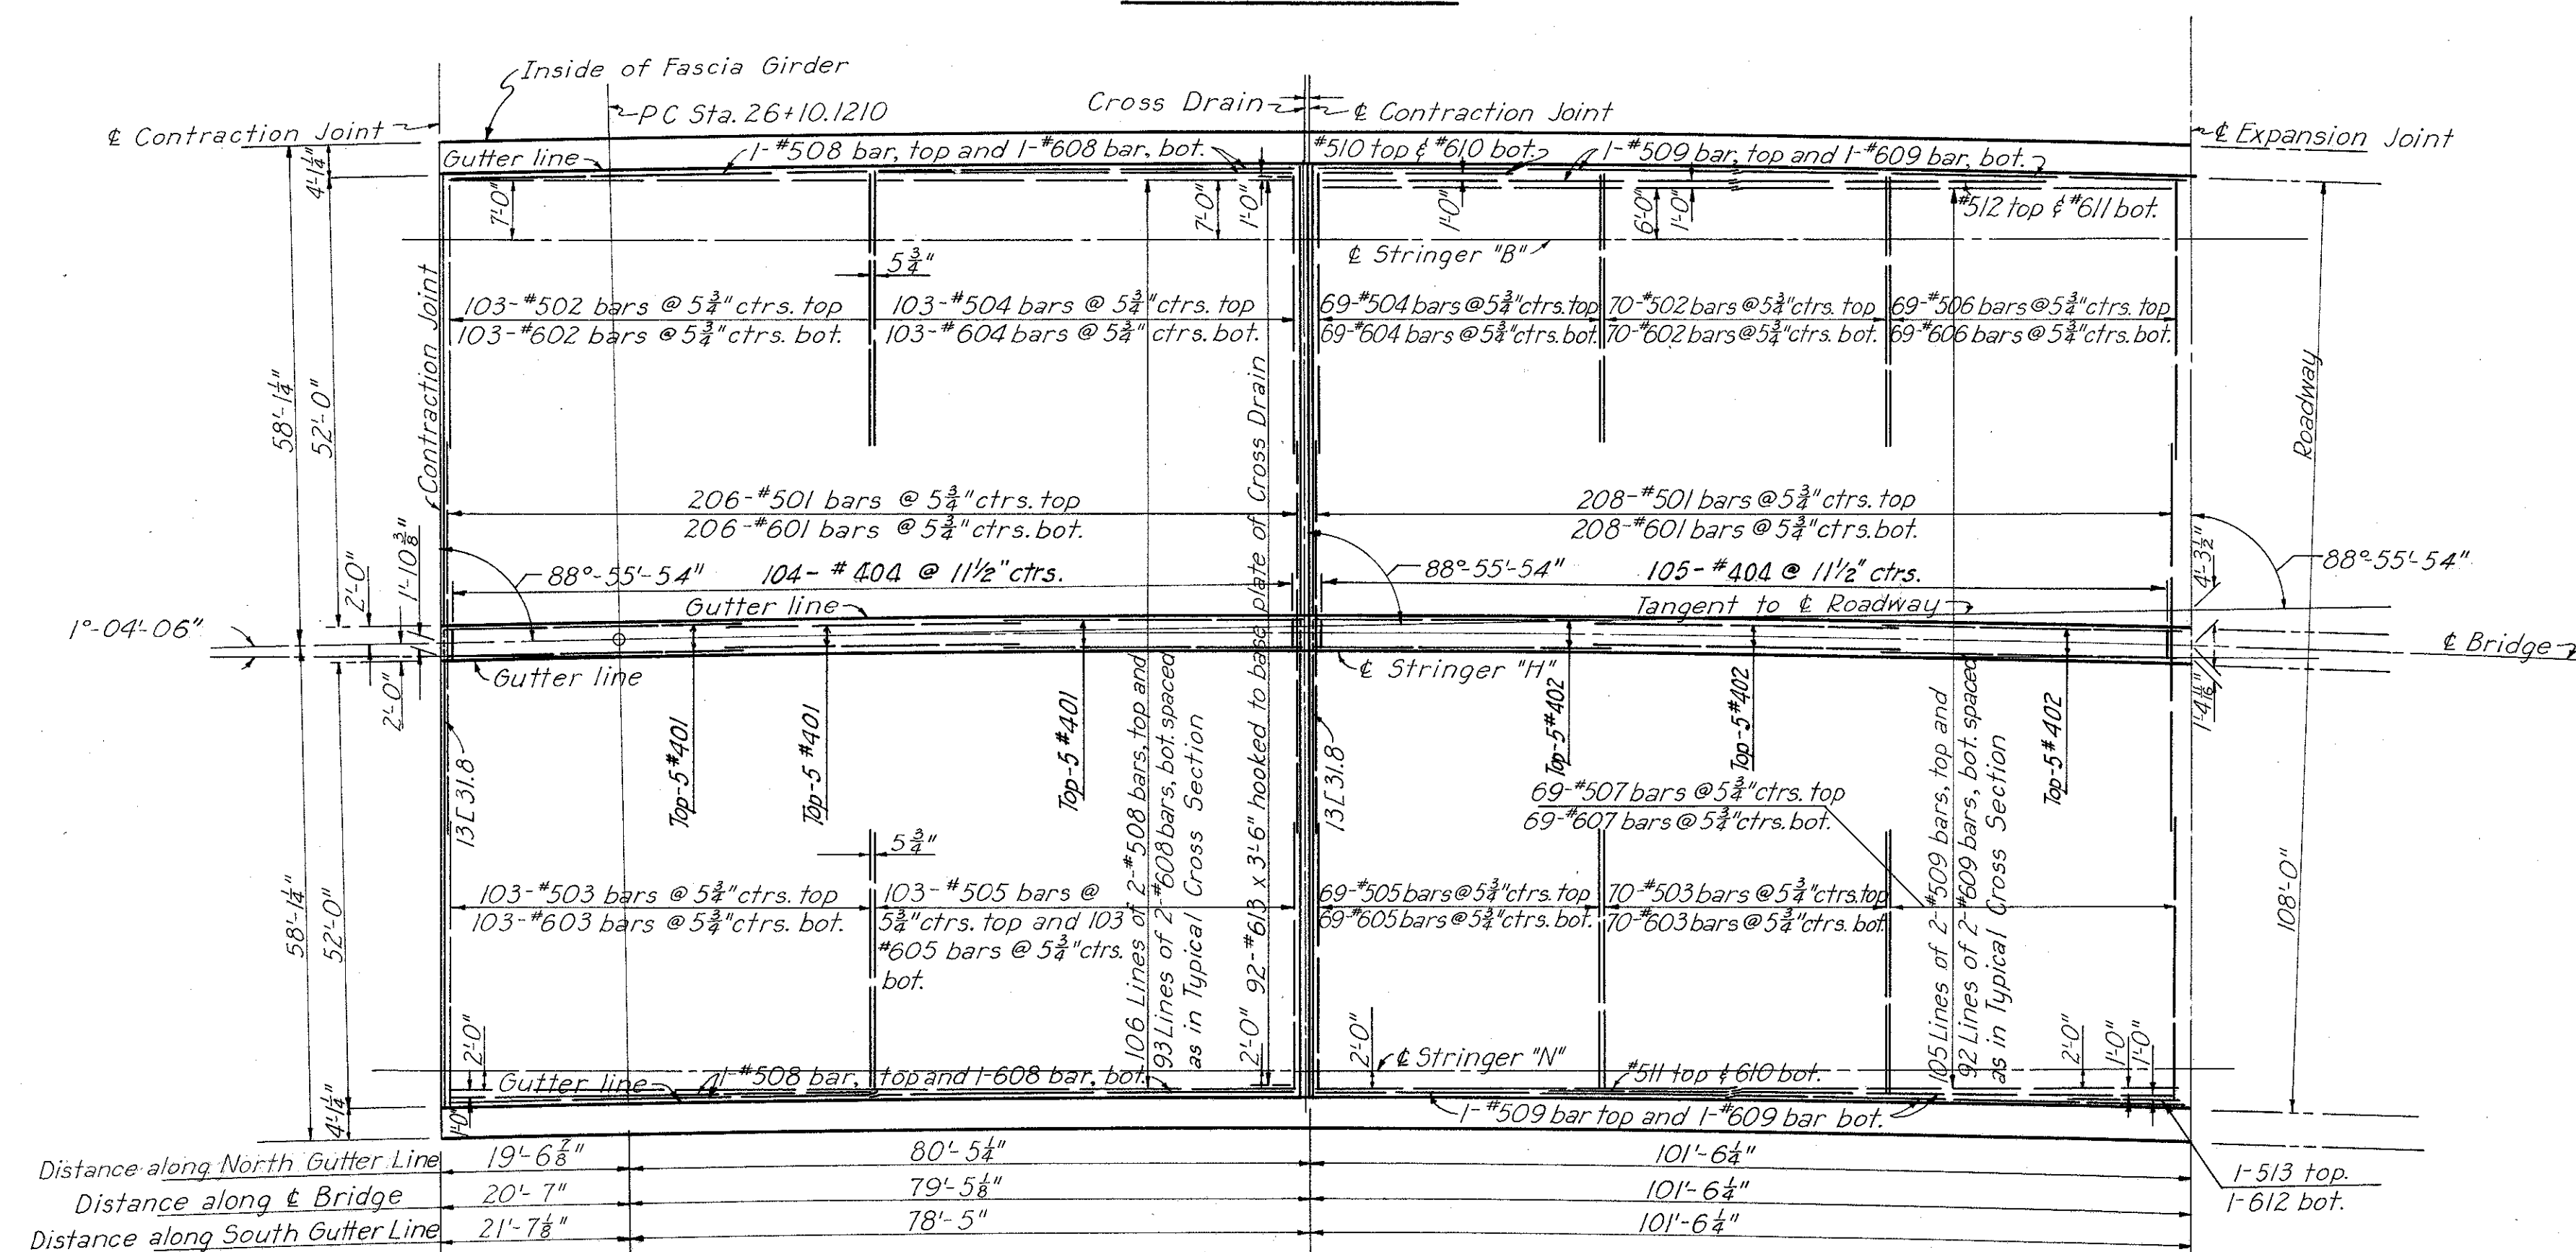

SLAB PLAN—UNIT 4

Notes: All longitudinal bars are to be parallel to stringers except the bars at the edges of slab which are parallel to gutter lines. For spacing of longitudinal bars, see Typical Section, Sheet 114.
All transverse bars are to be normal to stringers and at 5 3/4" ctrs. except extra bars parallel to edges of joints and cross drains. Top traverse bars are to be spliced at mid-point between Stringers "E" and "F", and Stringers "J" and "K". Bottom transverse bars are to be spliced over Stringer "E" and Stringer "K".
For Contraction Joint Detail, see Sheet 114.
For Cross Drain Details, see Sheets 103, 107 and 109.
For Reinforcement Schedule, see Sheet 120.

PART 3

U. S. ROUTE 42 RELOCATION
INNER BELT FREEWAY - CENTRAL VIADUCT
BR. NO. CU - 42 R-17.5

SLAB PLAN
UNITS 3 AND 4

CLEVELAND CUYAHOGA COUNTY OHIO


SCALE 1/8" = 1'-0"
MADE W.B.C. DATE 1-29-54 HOWARD, NEEDLES, TAMMEN & BERGENDOFF
TRCD JAV DATE 8-24-54 CONSULTING ENGINEERS
KANSAS CITY CLEVELAND NEW YORK
CKD B.E.B. DATE 9-10-54 914-1A SHEET 2.116

INCH POUNDS
FEB 16 1954


FED. ROAD DIV. NO.	STATE	FEDERAL AID PROJECT NO.	TYPE FUNDS
2	OHIO		

115
122

CUYAHOGA COUNTY
CITY OF CLEVELAND
INNER BELT FREEWAY
CENTRAL VIADUCT

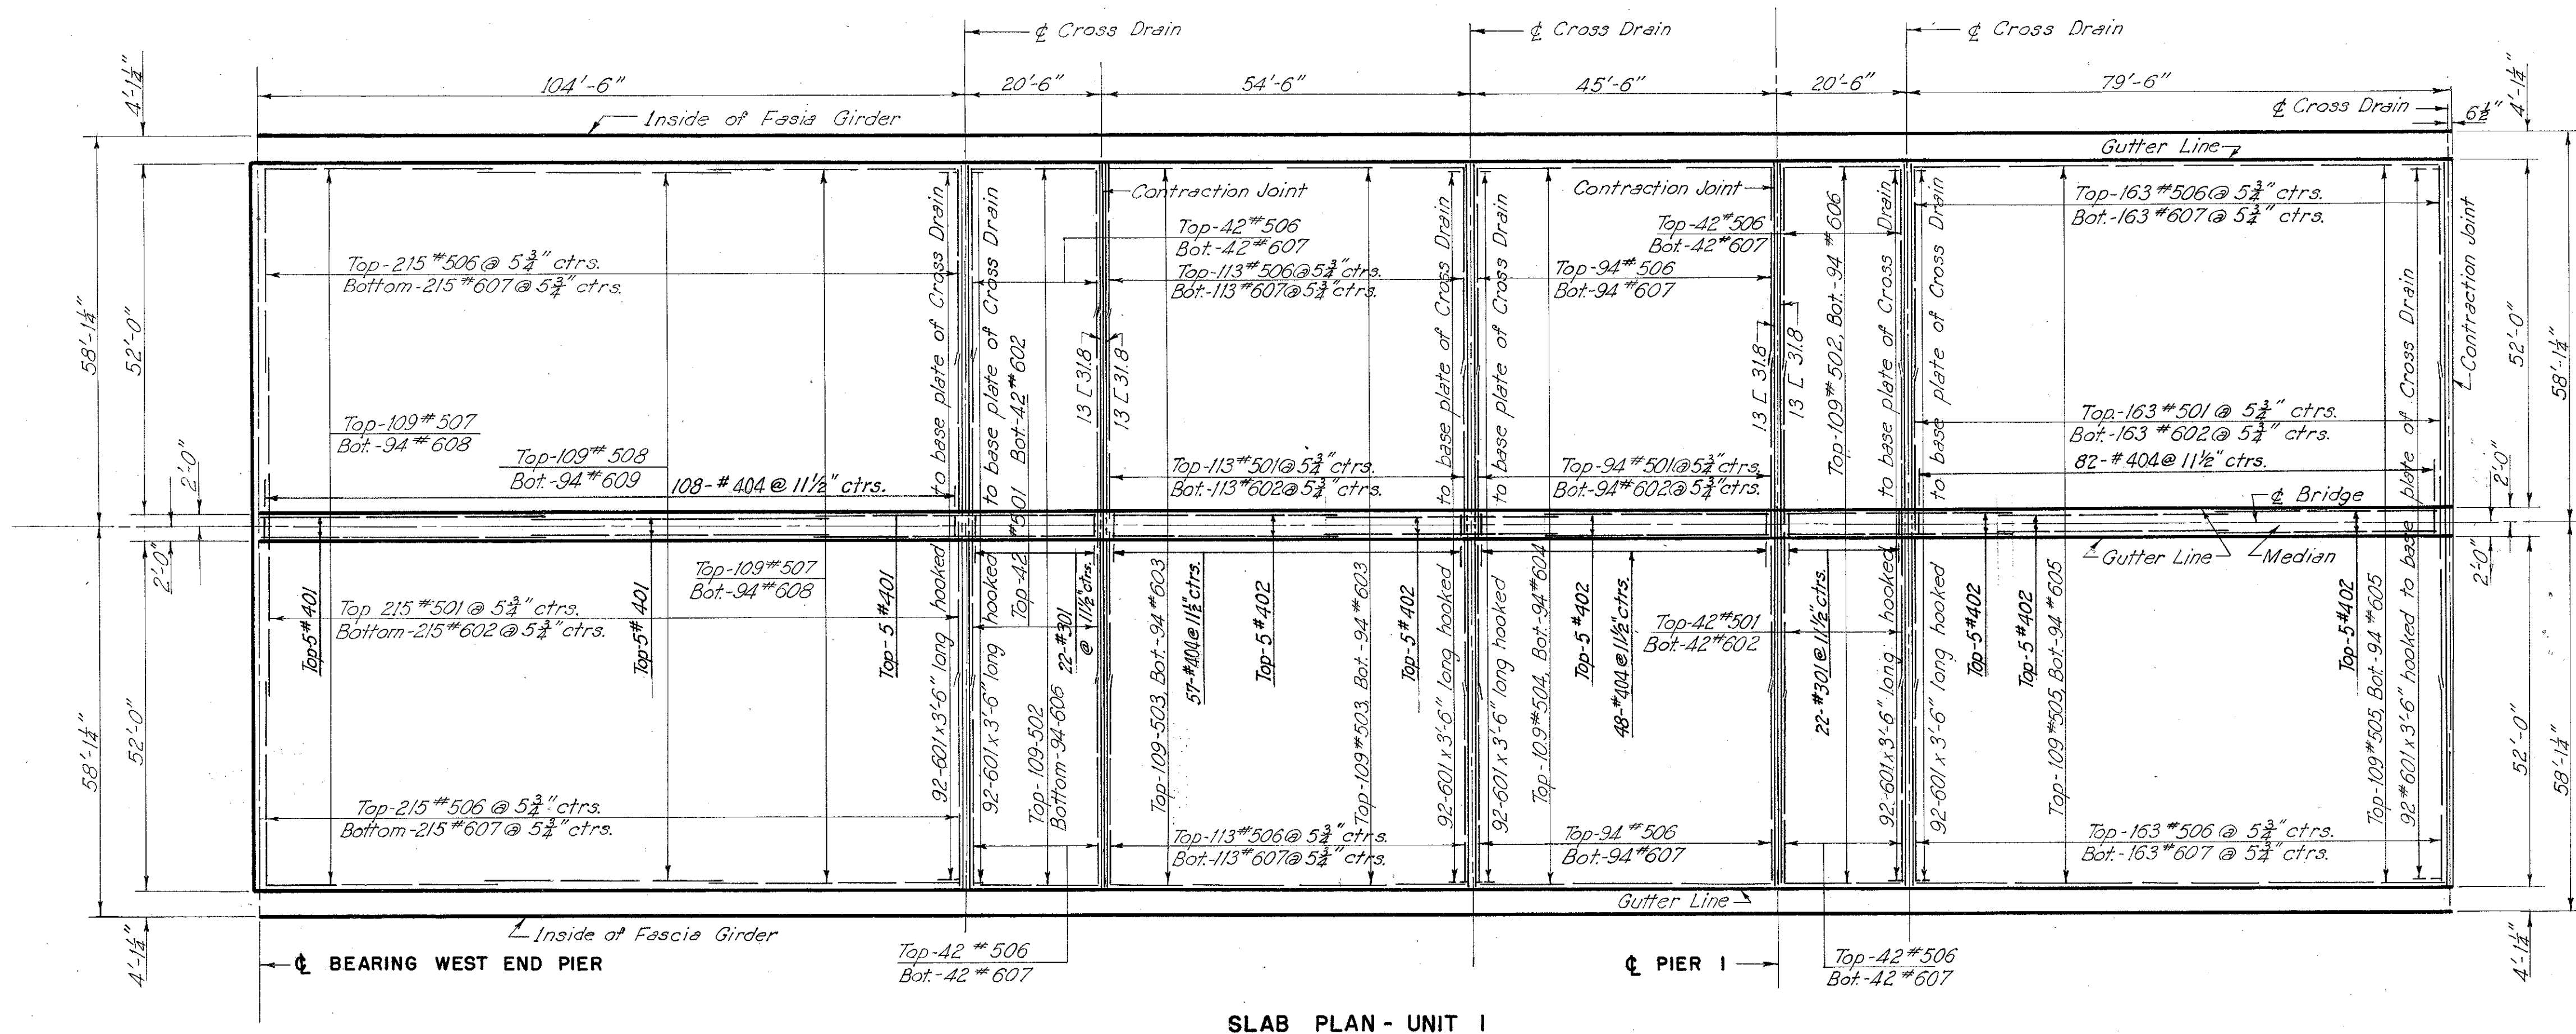

SLAB PLAN - UNIT 1

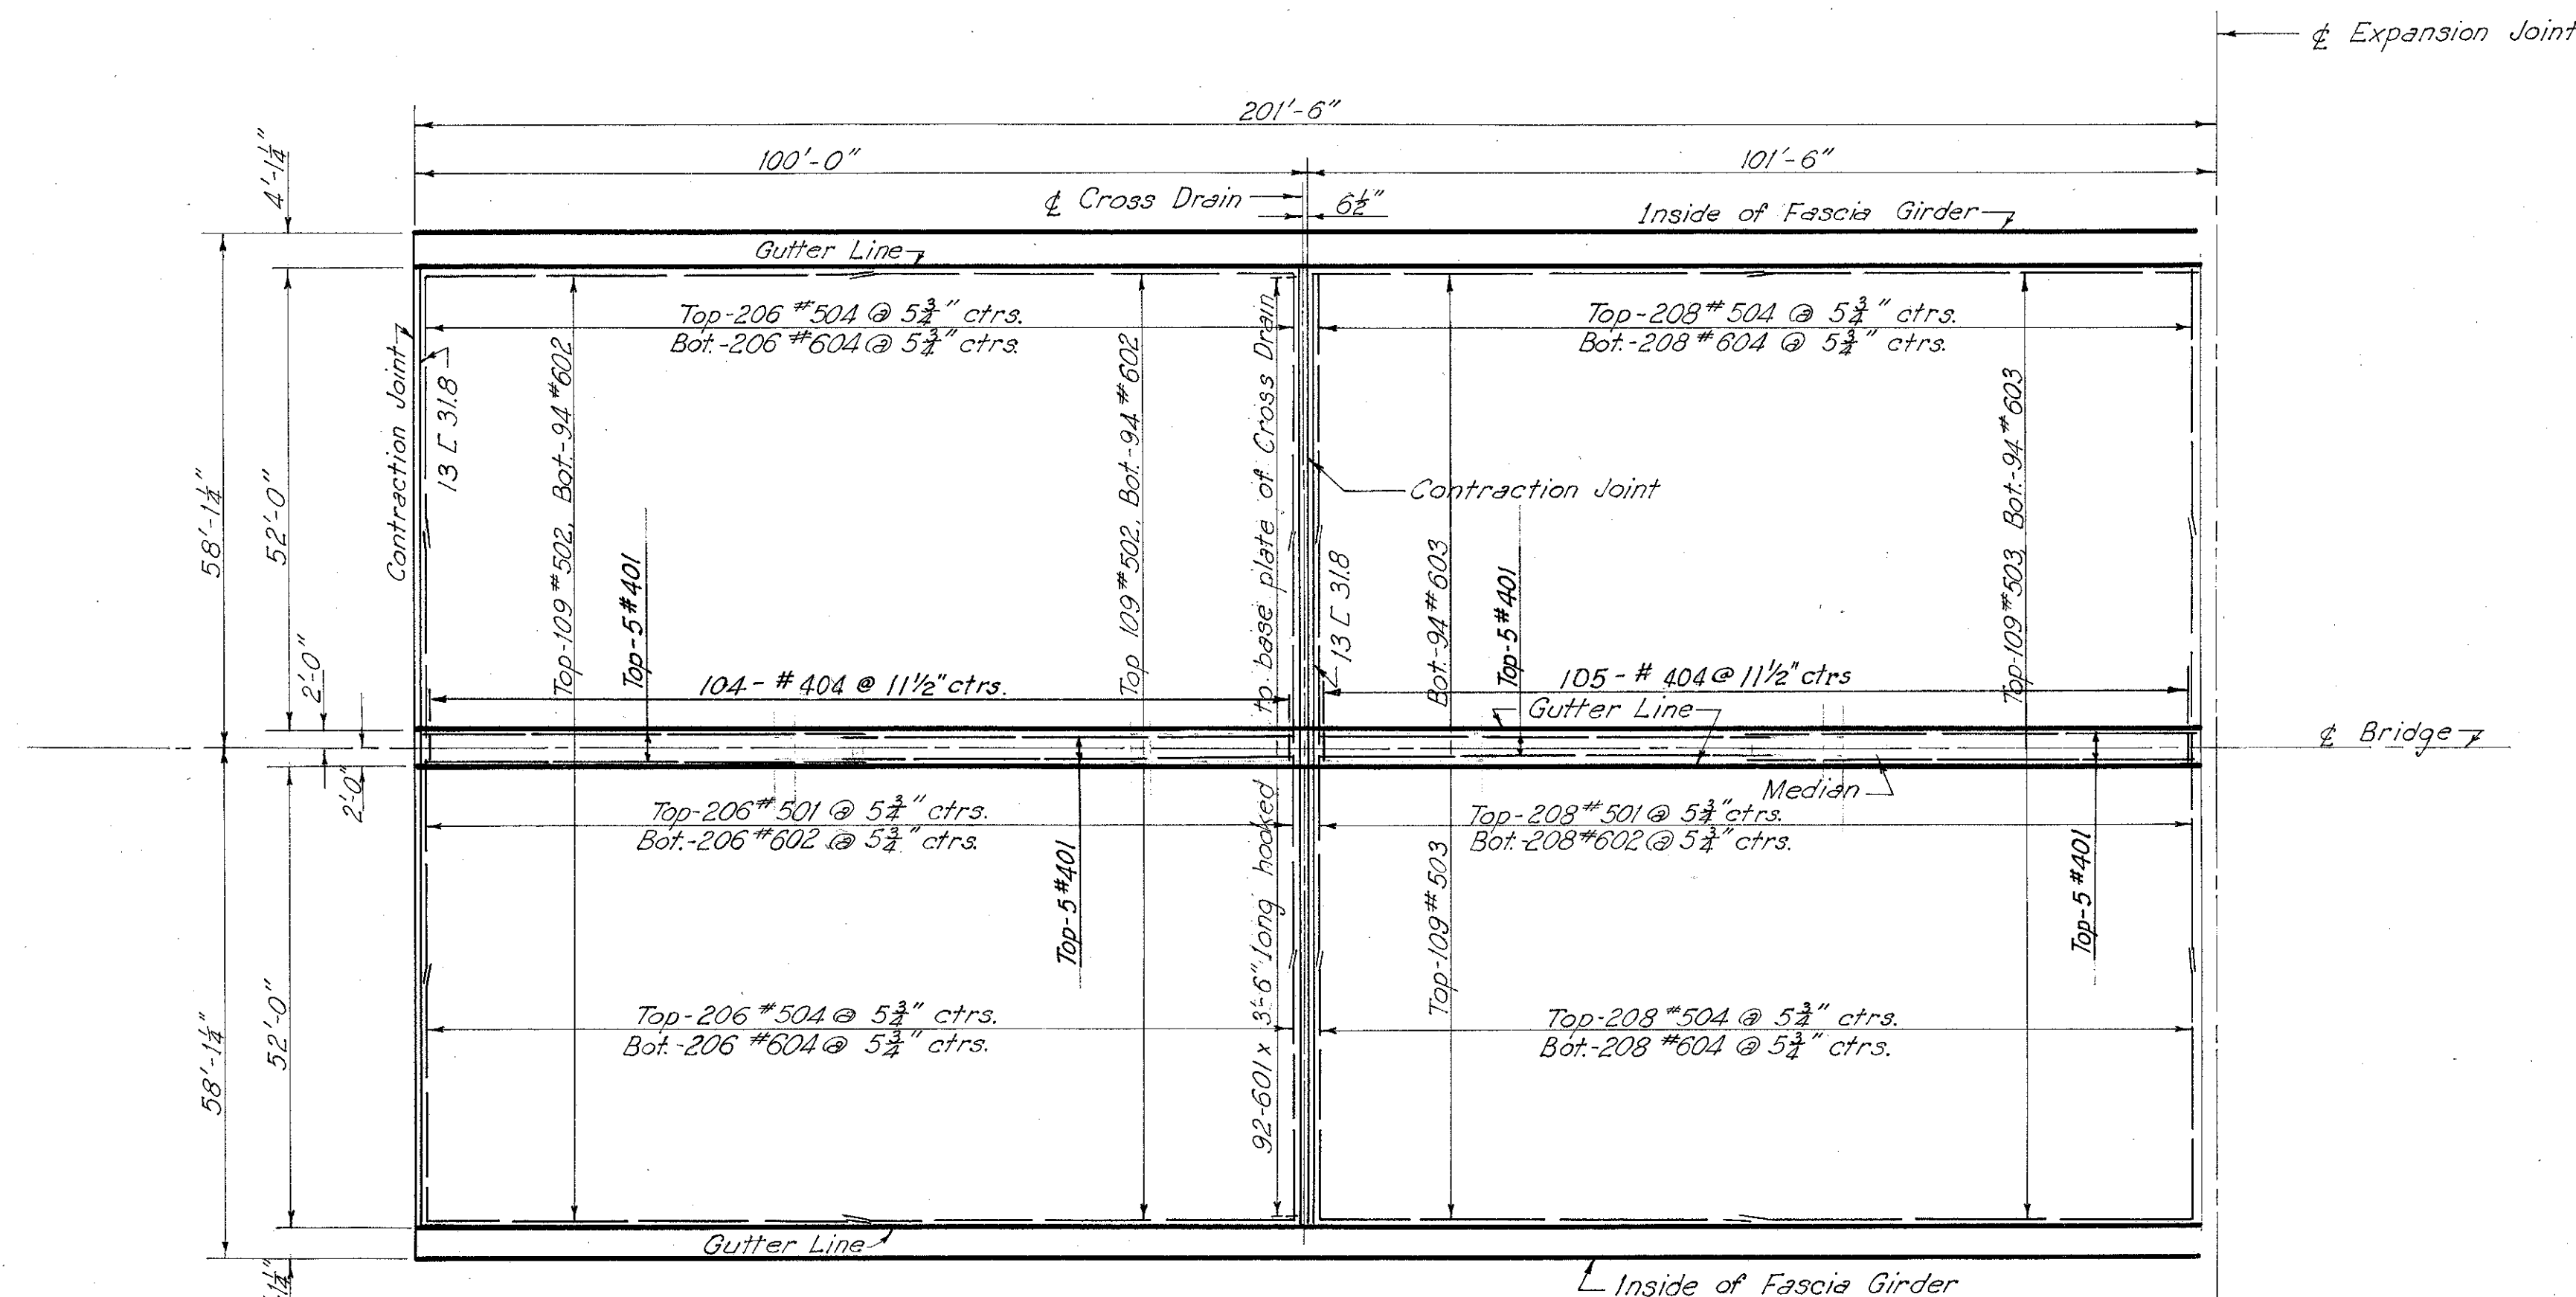


SLAB PLAN - UNIT 2

Note:
All longitudinal bars are to be parallel to stringers except bars at edges of curved portion of slab which are parallel to gutter line. For spacing of longitudinal bars, see Typical Section Sheet 114.
All transverse bars are to be normal to Bridge and at 5 1/2" ctrs. Top transverse bars are to be spliced at mid-point between Stringers "E" and "F" and Stringers "J" and "K." Bottom transverse bars are to be spliced over Stringer "E" and Stringer "K."
For Contraction Joint Detail, see Sheet 114.
For Cross Drain Details, see Sheets 105, 107 and 109.
For Reinforcement Schedule, see Sheet 120.


PART 3			
U. S. ROUTE 42 RELOCATION			
INNER BELT FREEWAY - CENTRAL VIADUCT			
BR. NO. CU - 42R-17.5			
SLAB PLAN			
UNITS 1 AND 2			
CLEVELAND	CUYAHOGA COUNTY	OHIO	
SCALE: 1/4" = 1'-0"			
MADE <u>R.K.</u> DATE <u>1-22-54</u>			
TRCD <u>AMO</u> DATE <u>8-19-54</u>			
CKD <u>DER</u> DATE <u>9-9-54</u>			
HOWARD, NEEDLES, TAMMEN & BERGENOFF			
CONSULTING ENGINEERS			
KANSAS CITY		CLEVELAND NEW YORK	
914-1A		SHEET 2.115	

CUYAHOGA COUNTY
CITY OF CLEVELAND
INNER BELT FREEWAY
CENTRAL VIADUCT

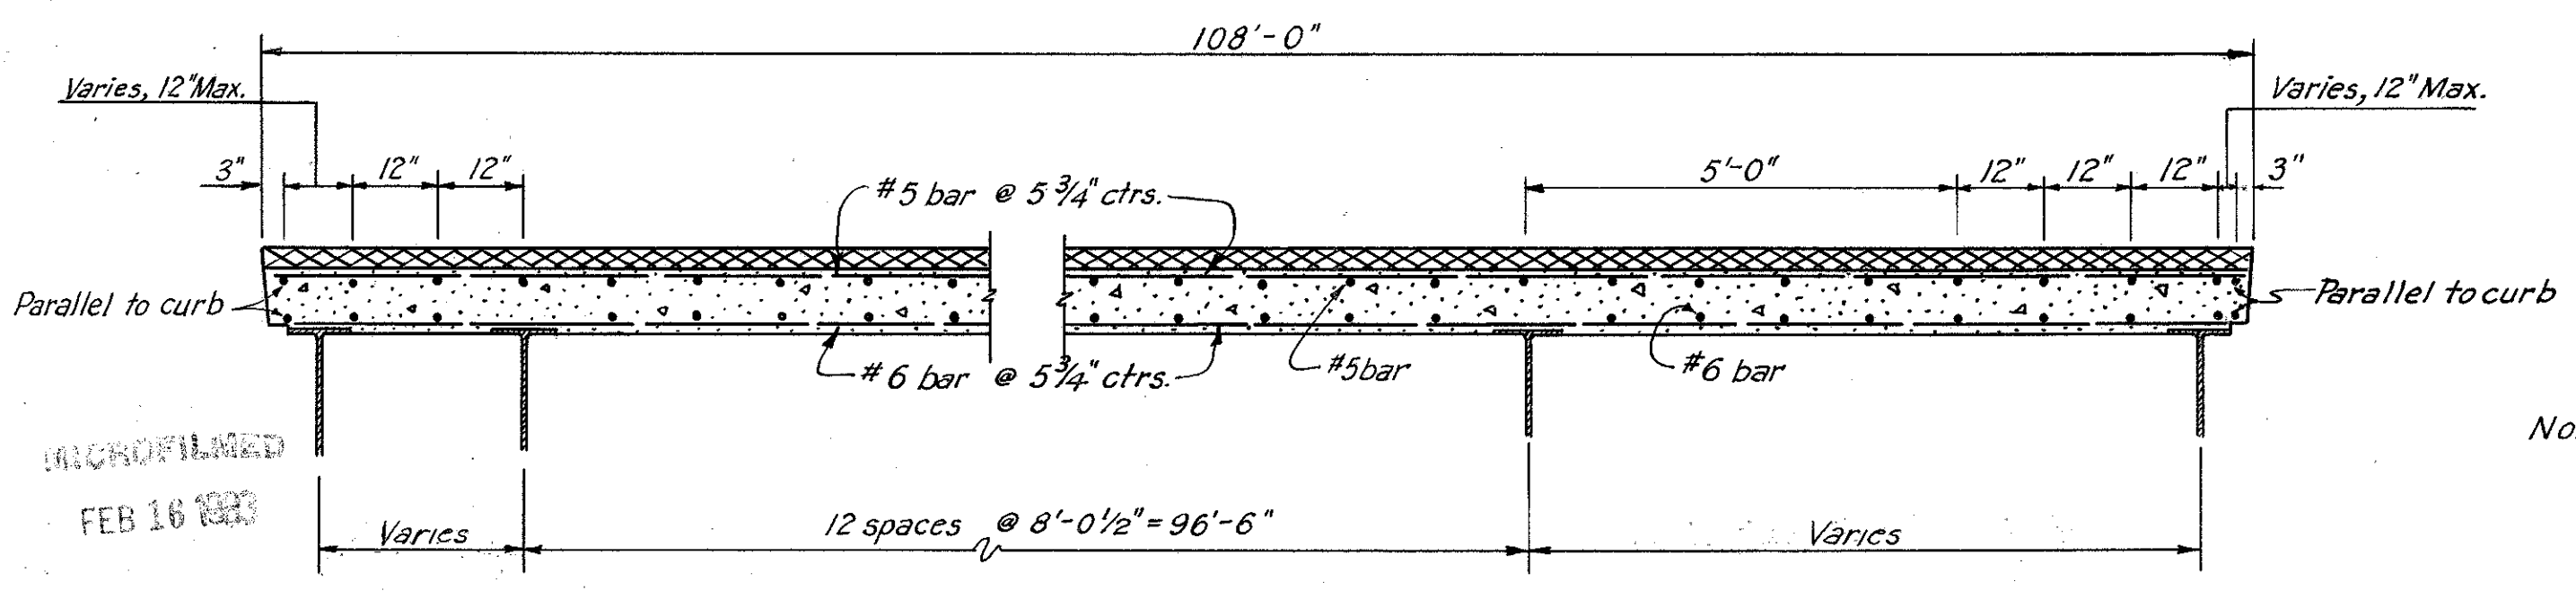


TYPICAL SECTION - STA. 24+89.52 TO STA. 40+83.22
Scale 1/2" = 1'-0"

Notes: Longitudinal bars are to be parallel to stringers except bars adjacent to curb as noted.
Top longitudinal bars - #5 bars spaced as shown.
Bottom longitudinal bars - #6 bars spaced as shown.
Transverse bars are to be normal to stringers.
Top transverse bars - #5 bars @ 5 3/4" ctrs.
Bottom transverse bars - #6 bars @ 5 1/4" ctrs.

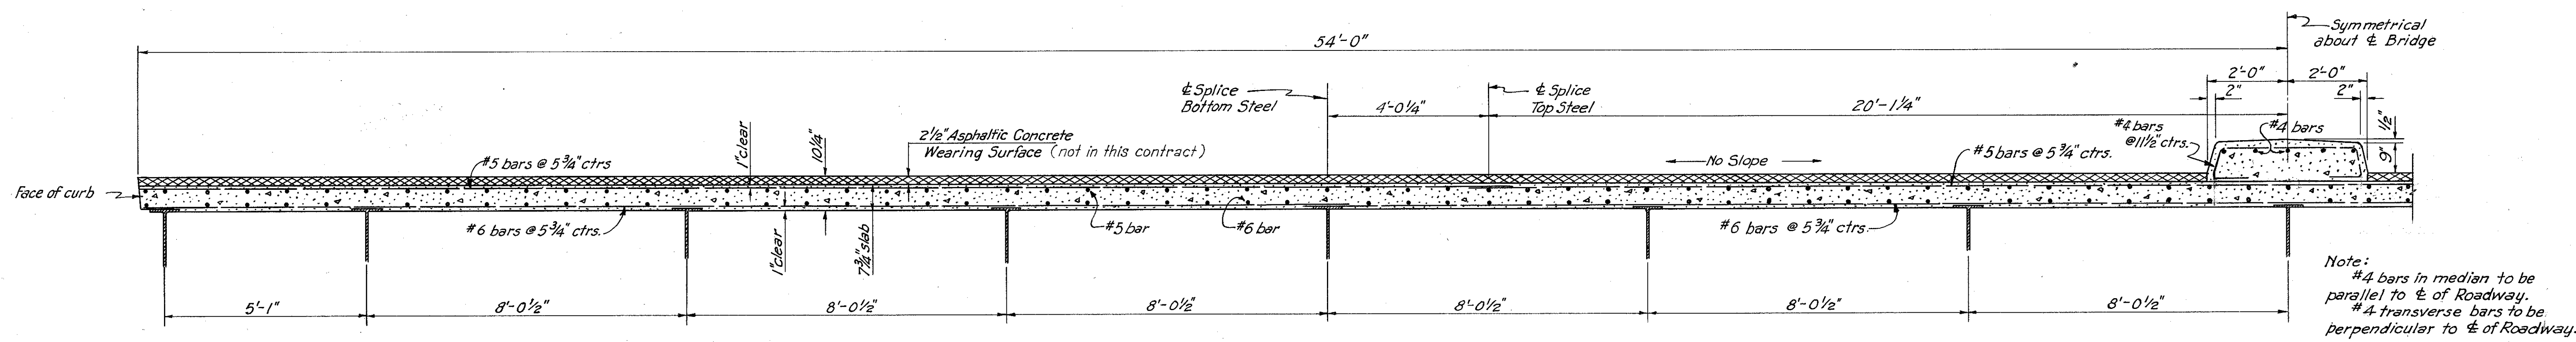


Note: #4 bars in median to be parallel to centerline of Roadway.
#4 transverse bars to be perpendicular to centerline of Roadway.


TYPICAL HALF SECTION - STA. 16+13.02 TO STA. 24+89.52 AND STA. 40+83.22 TO STA. 43+34.72
Scale 1/2" = 1'-0"

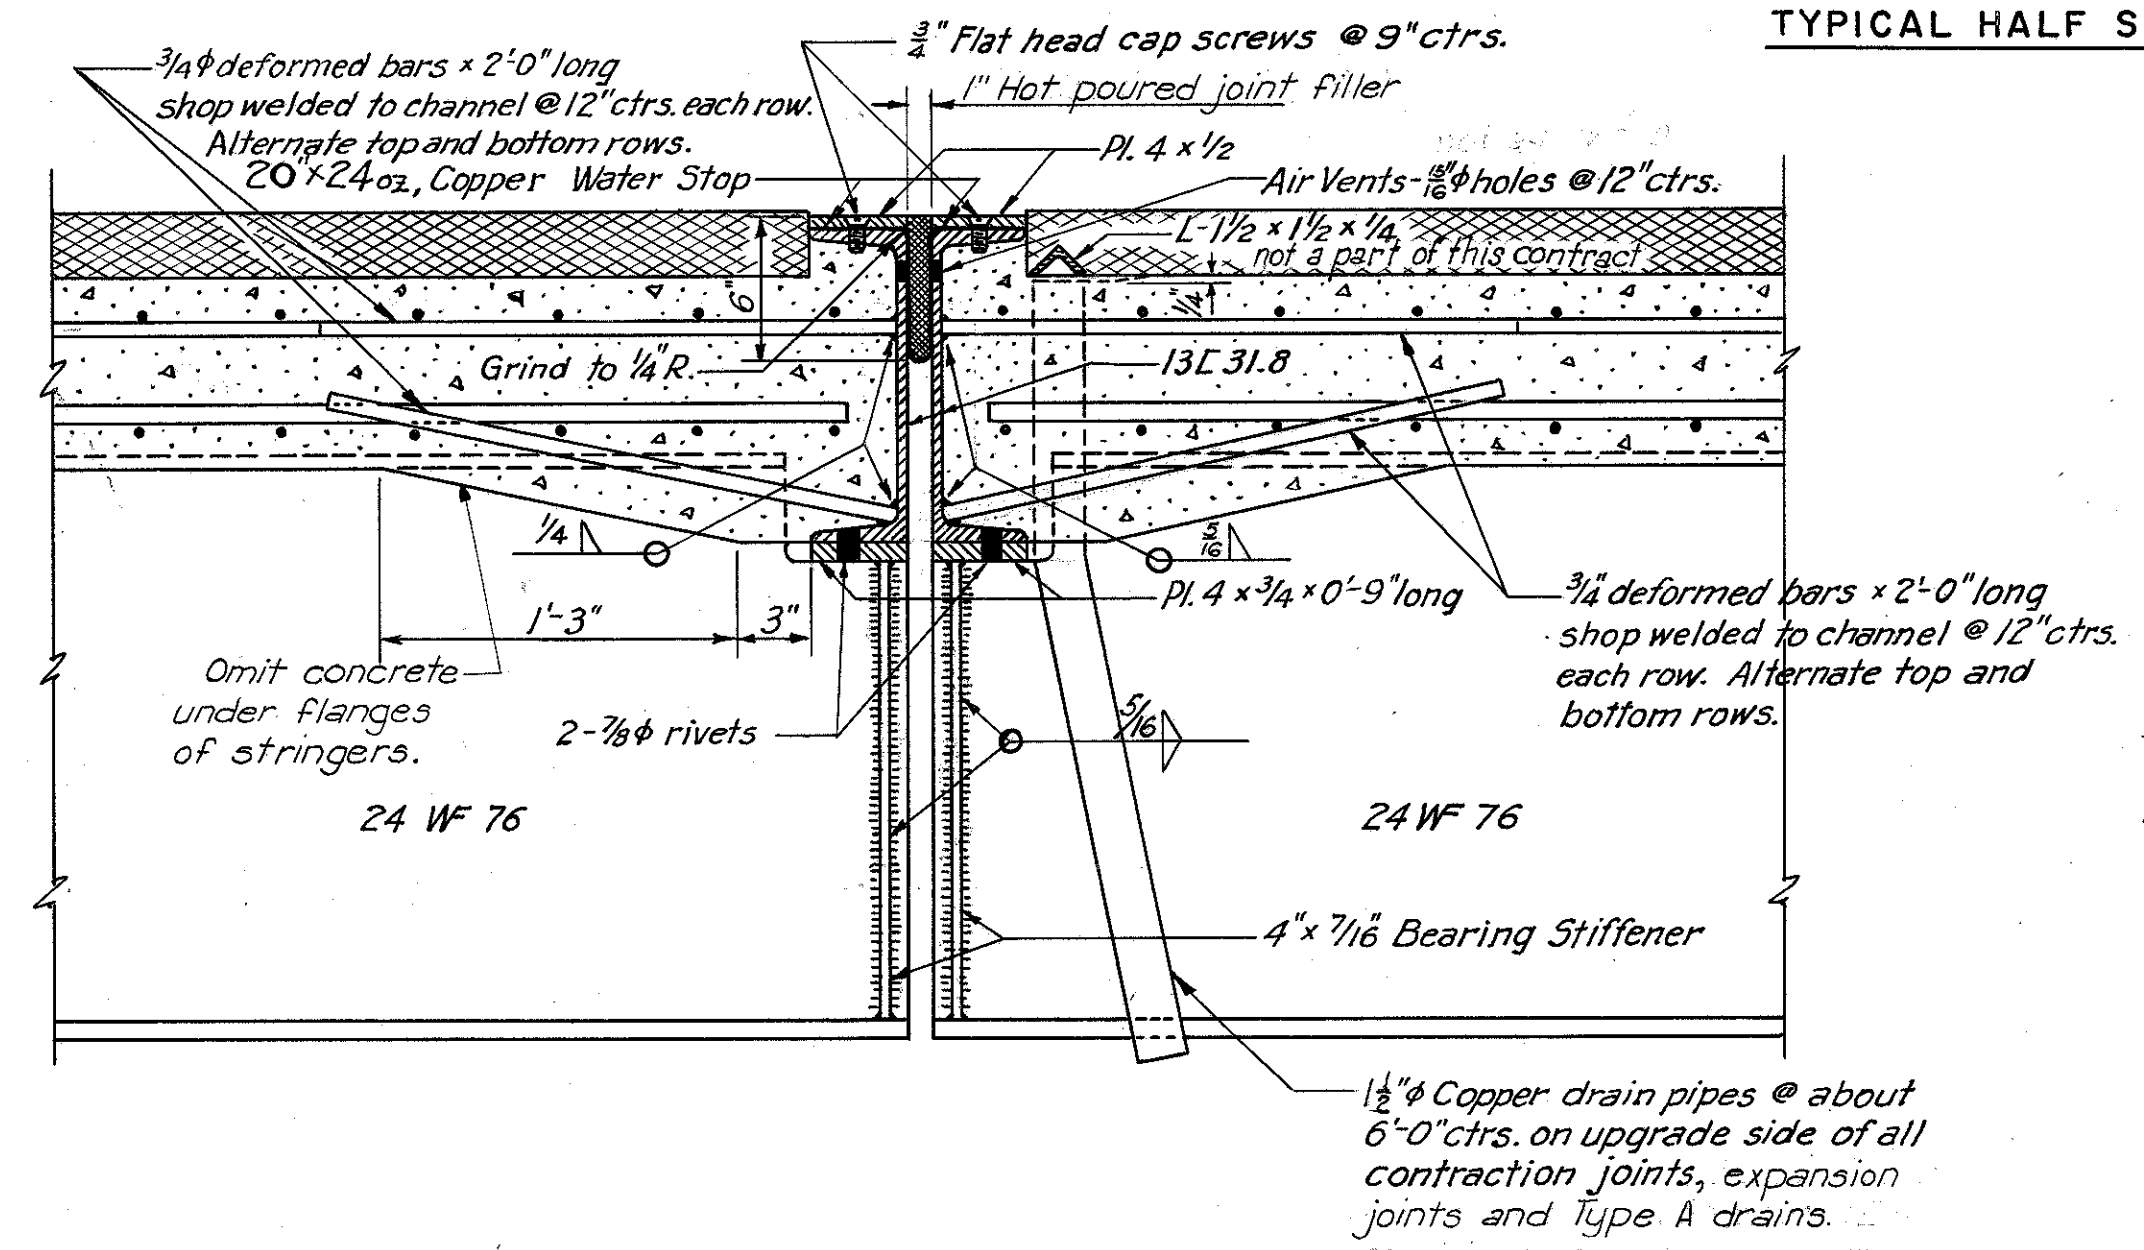


CONTRACTION JOINT DETAILS
Scale 1/2" = 1'-0"
For locations see Sh. 103

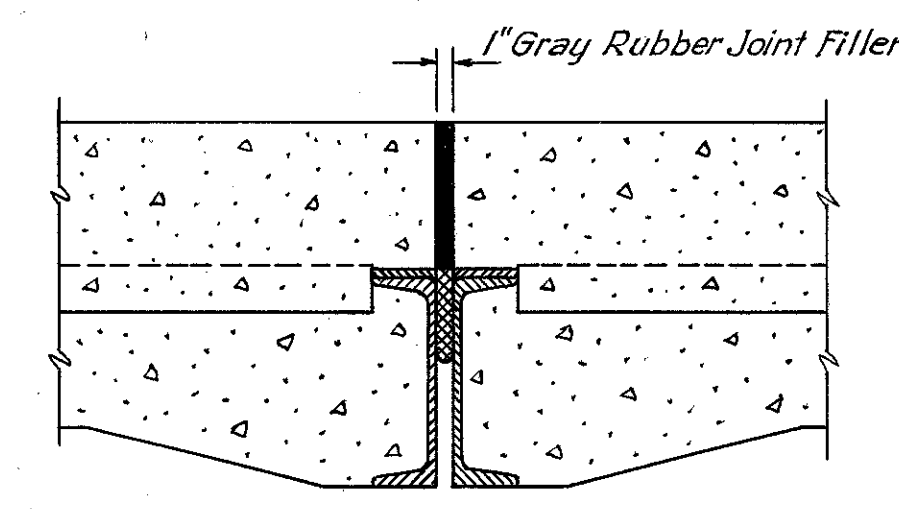

AT CONTRACTION JOINT

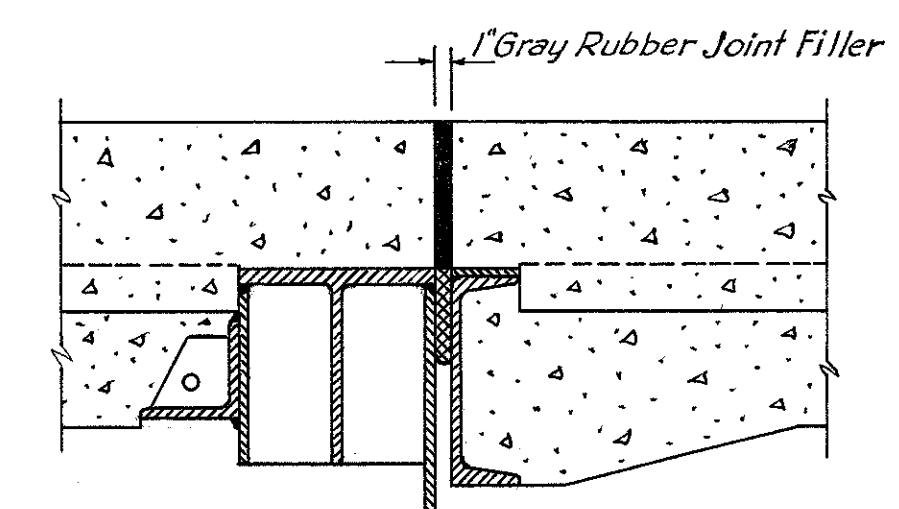


AT TYPE B DRAINS

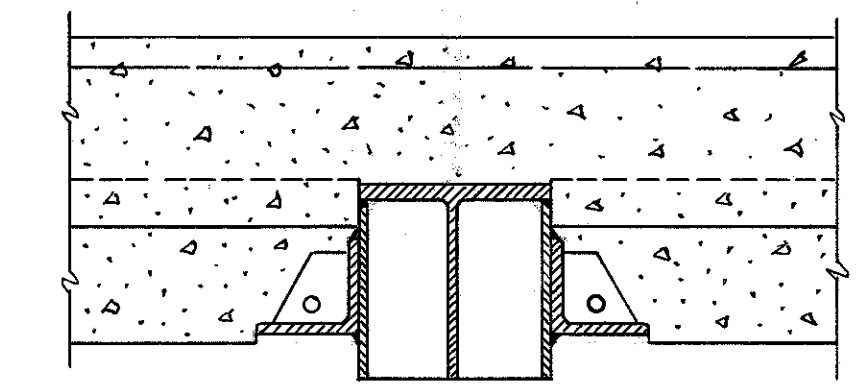


AT TYPE A DRAINS

MEDIAN JOINTS
Scale 1" = 1'-0"

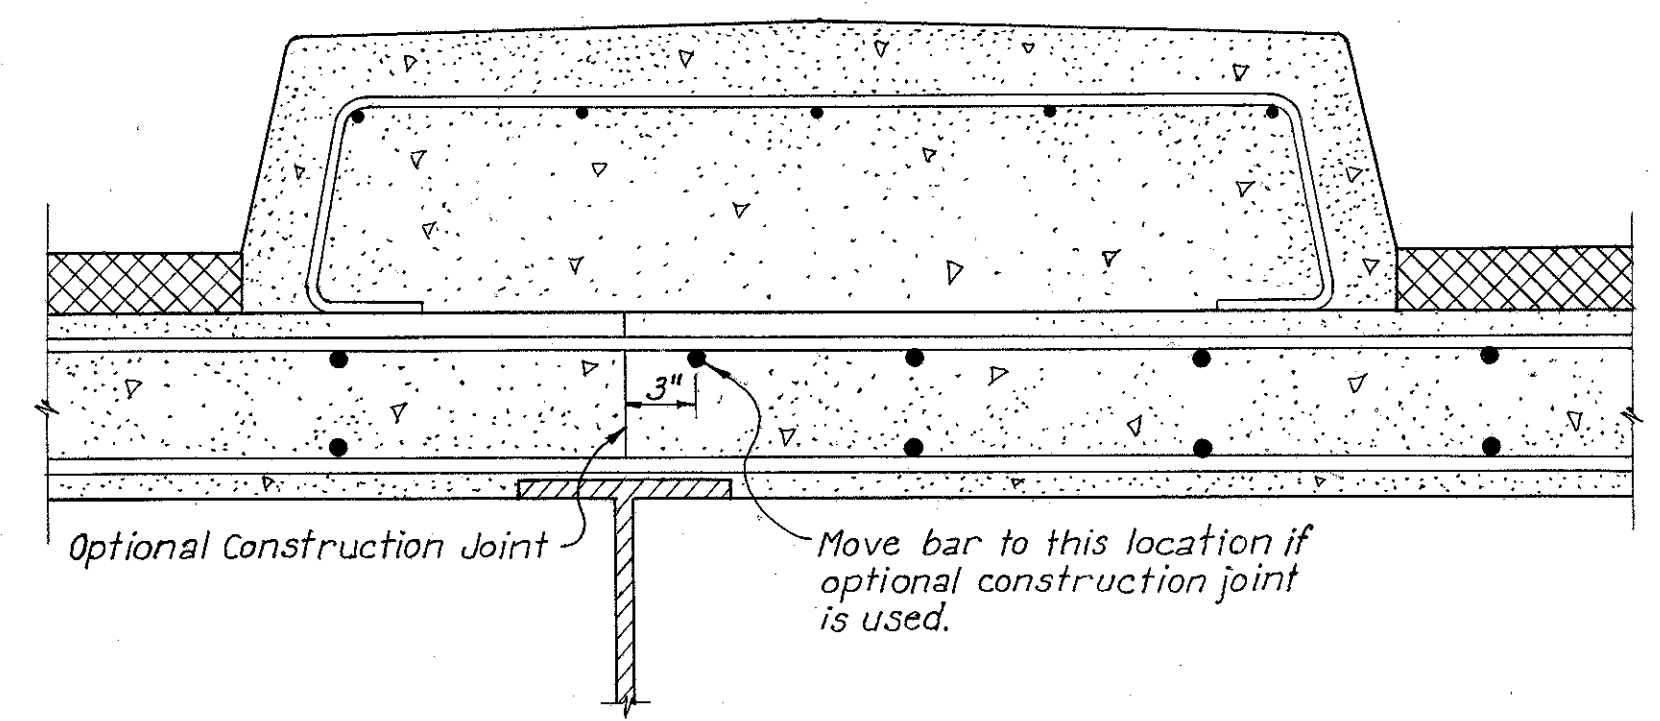

OPTIONAL LONGITUDINAL CONSTRUCTION JOINT
Scale: 1 1/2" = 1'-0"

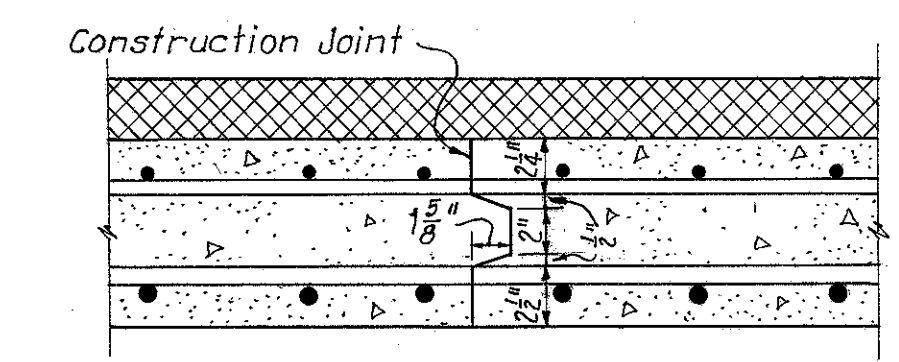

TRANSVERSE CONSTRUCTION JOINT
Scale: 1 1/2" = 1'-0"

For slab pouring sequence see Sh. 103

PART 3

U. S. ROUTE 42 RELOCATION
INNER BELT FREEWAY - CENTRAL VIADUCT
BR. NO. CU - 42 R-17.5

TYPICAL SLAB SECTIONS

CLEVELAND	CUYAHOGA COUNTY	OHIO
-----------	-----------------	------

SCALE: As Shown
MADE R.E. DATE 2-12-54
TRCD R.E.S. DATE 10-1-54
CKD R.E.R. DATE 10-1-54

HOWARD, NEEDLES, TAMMEN & BERGENDOFF
CONSULTING ENGINEERS
KANSAS CITY CLEVELAND NEW YORK







914-1A SHEET 2.114

MICROFILMED
FEB 16 1983

FED. ROAD DIV. NO.	STATE	FEDERAL AID PROJECT NO.	TYPE FUNDS
2	OHIO		

113	122
-----	-----





CUYAHOGA COUNTY
CITY OF CLEVELAND
INNER BELT FREEWAY
CENTRAL VIADUCT

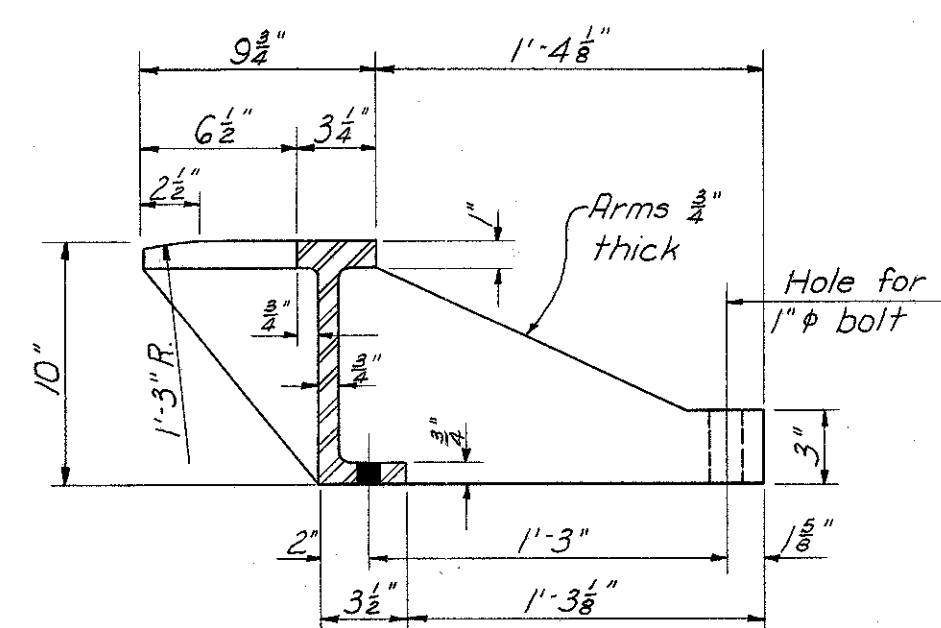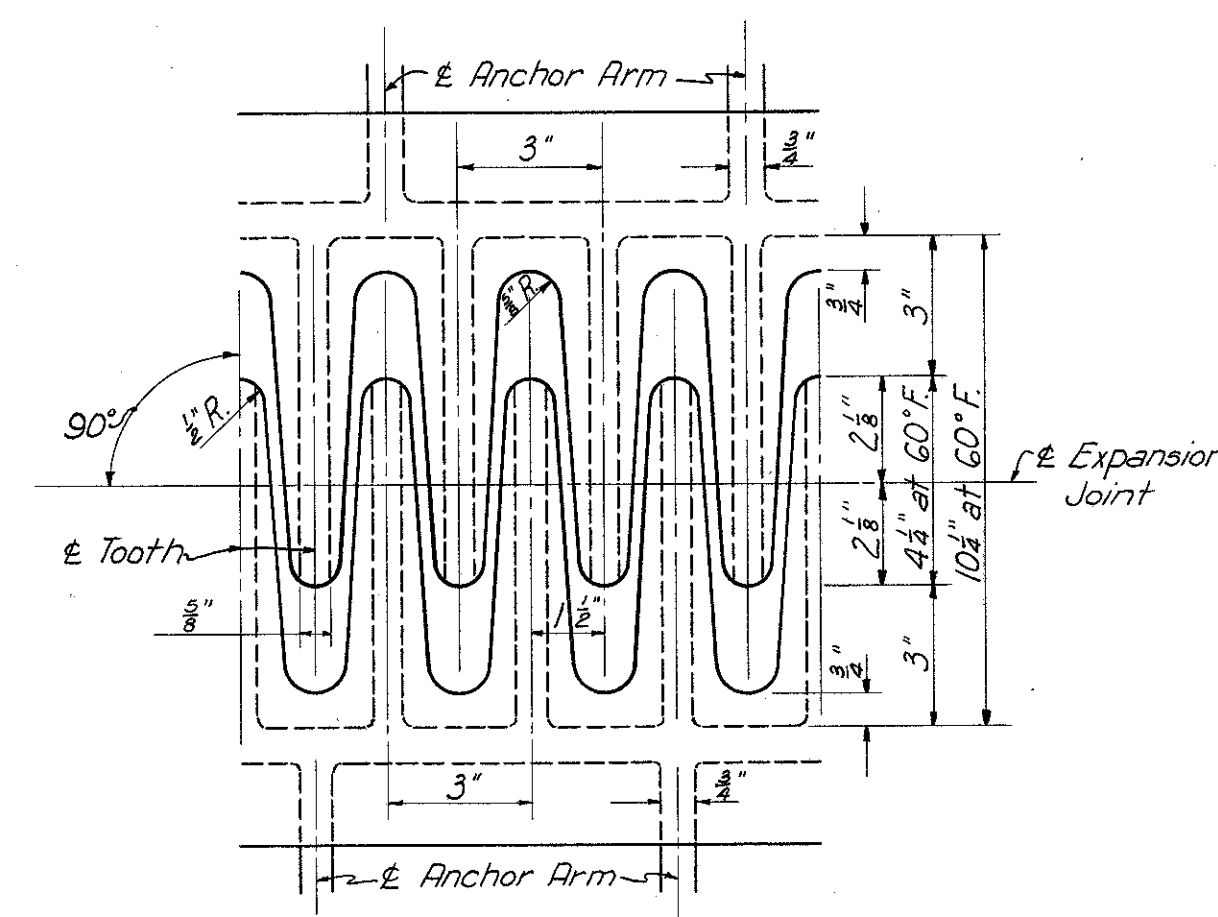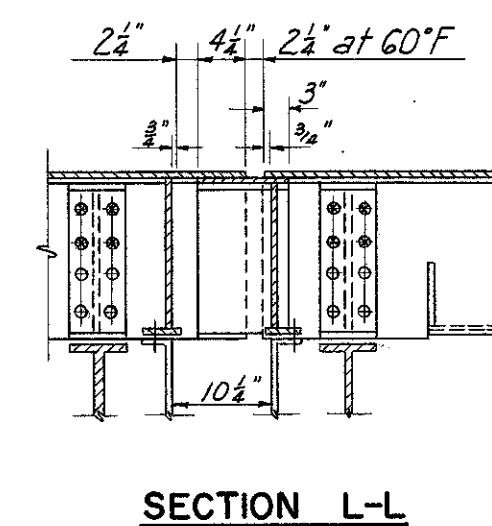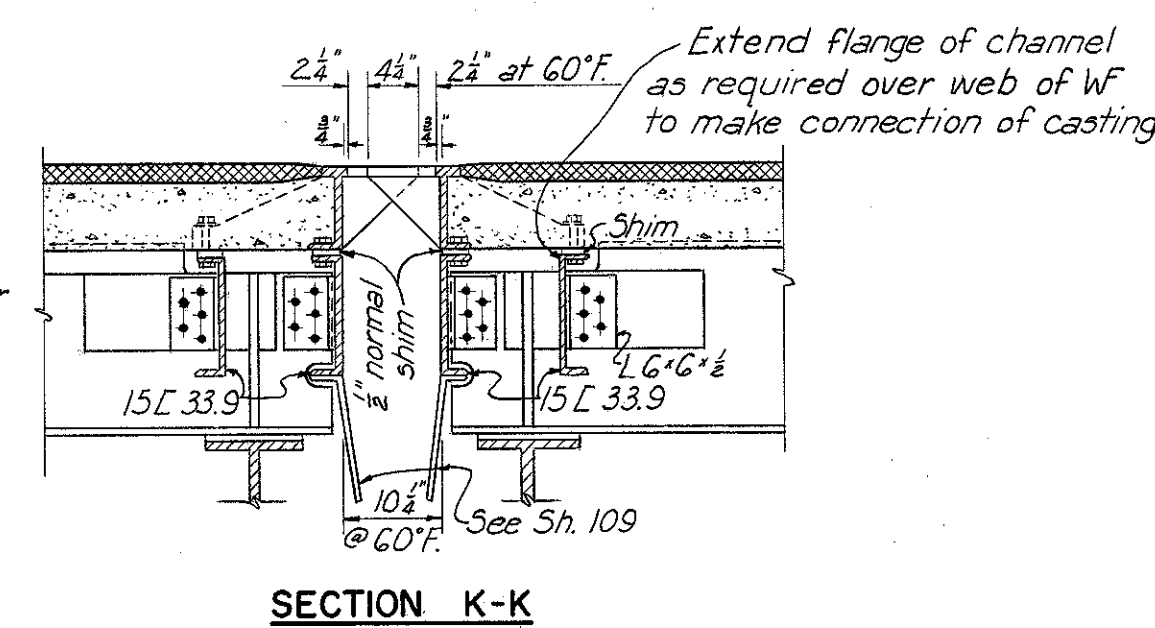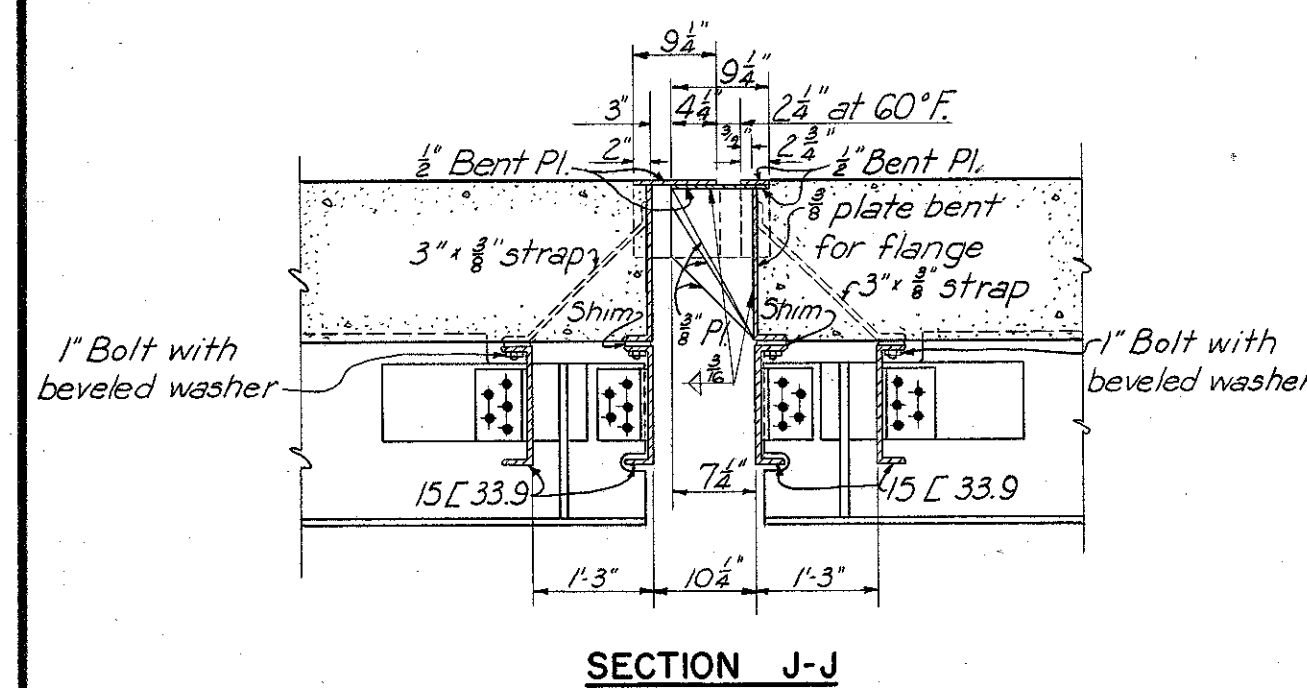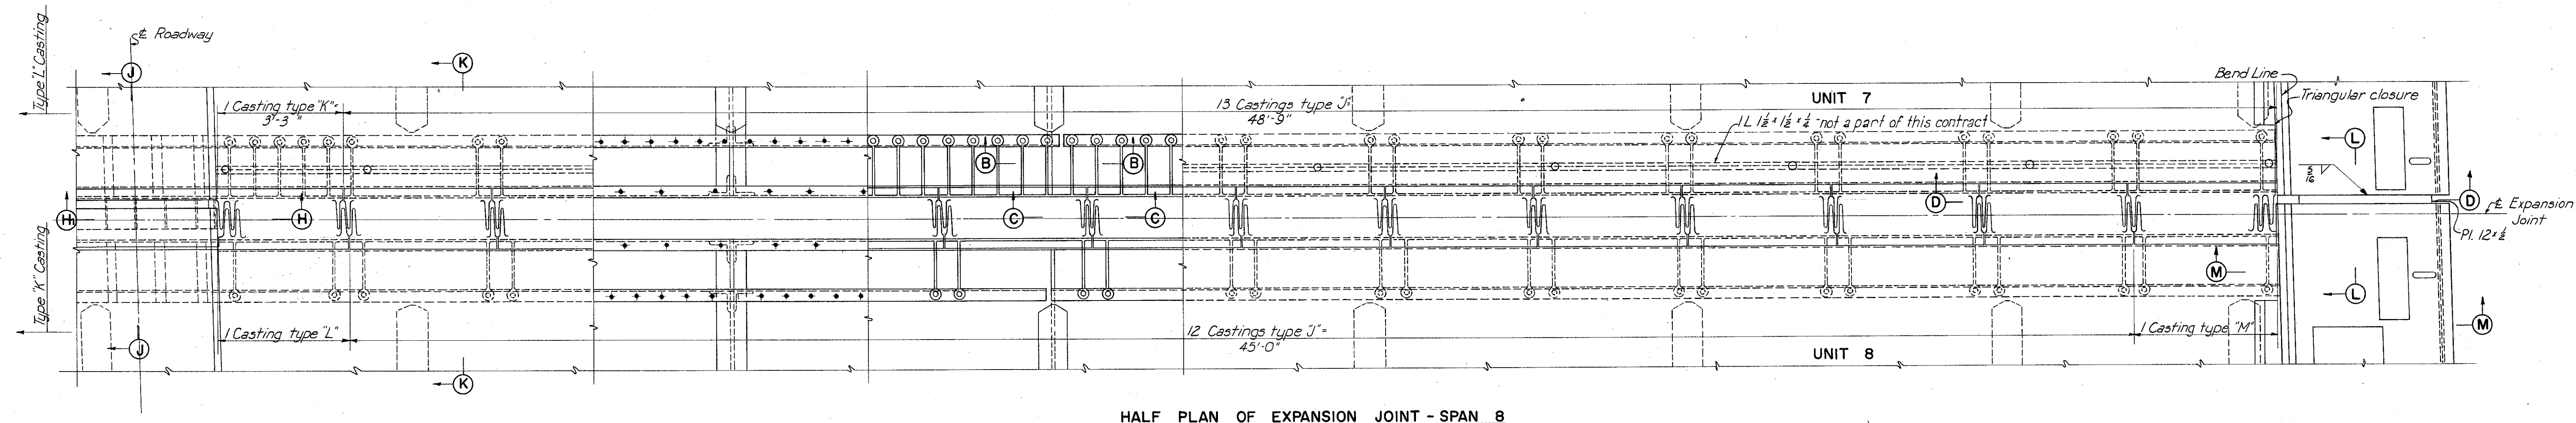

CROSS SECTION OF JOINT CASTING

Scale: 1/2\"/>

For casting J, see casting A, 50 required.
For casting K, see casting B, 2 required.
For casting L, see casting C, 2 required.
For casting M, see casting D, 2 required.

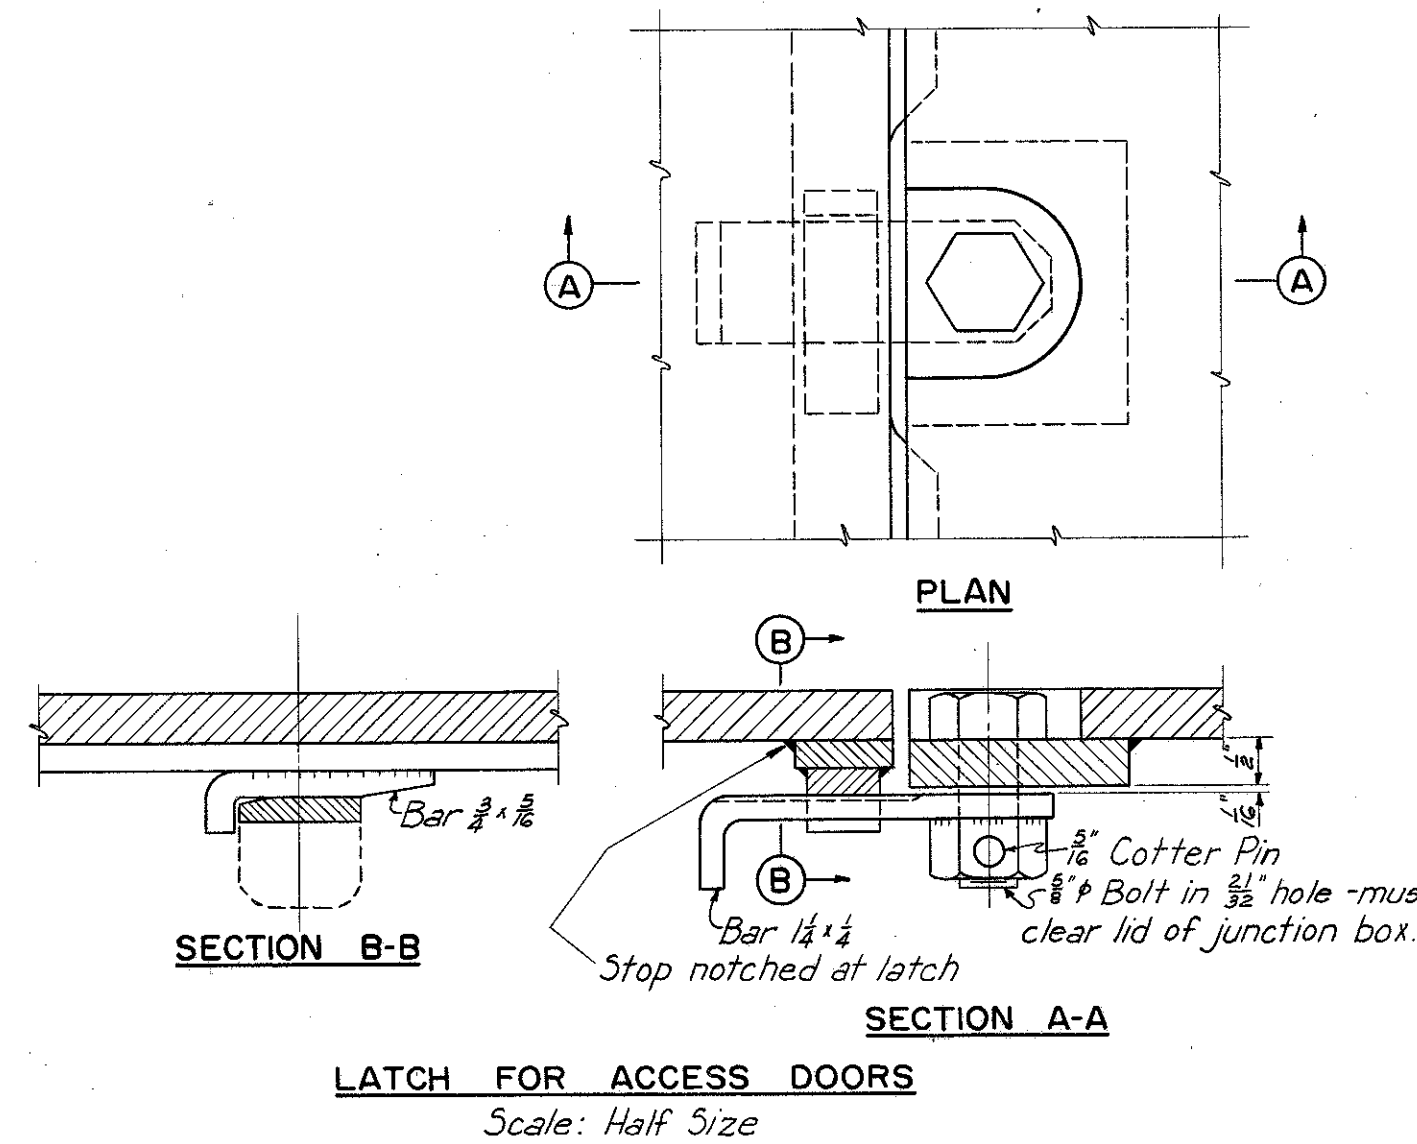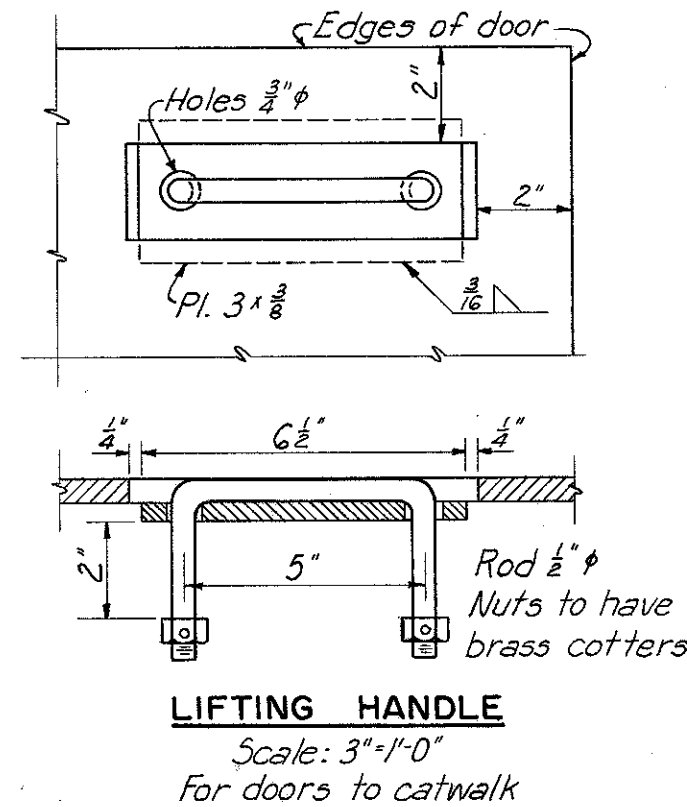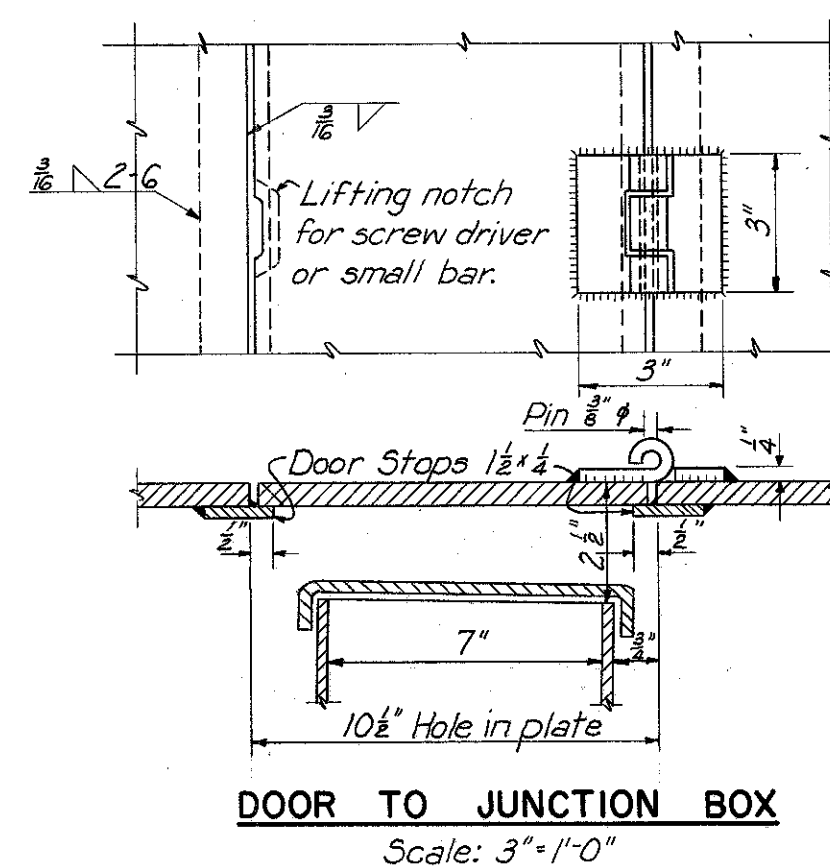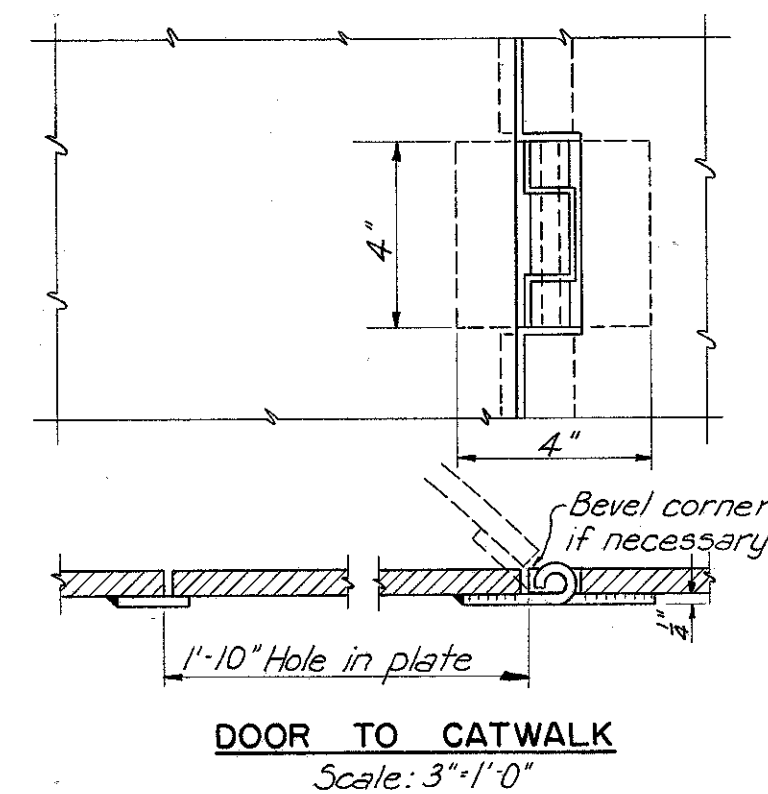

Notes:
For Section H-H see Sh. 112.
For Sections B-B, C-C and D-D, see Sh. 111.
For other notes, see Sh. 111.

PART 3

U. S. ROUTE 42 RELOCATION
INNER BELT FREEWAY - CENTRAL VIADUCT
BR. NO. CU - 42 R-17 5

EXPANSION JOINT - SPAN 8

CLEVELAND CUYAHOGA COUNTY OHIO


SCALE: 1/2\"/>

RECEIVED
FEB 16 1953


FED. ROAD DIV. NO.	STATE	FEDERAL AID PROJECT NO.	TYPE FUNDS
2	OHIO		

112
122


CUYAHOGA COUNTY
CITY OF CLEVELAND
INNER BELT FREEWAY
CENTRAL VIADUCT

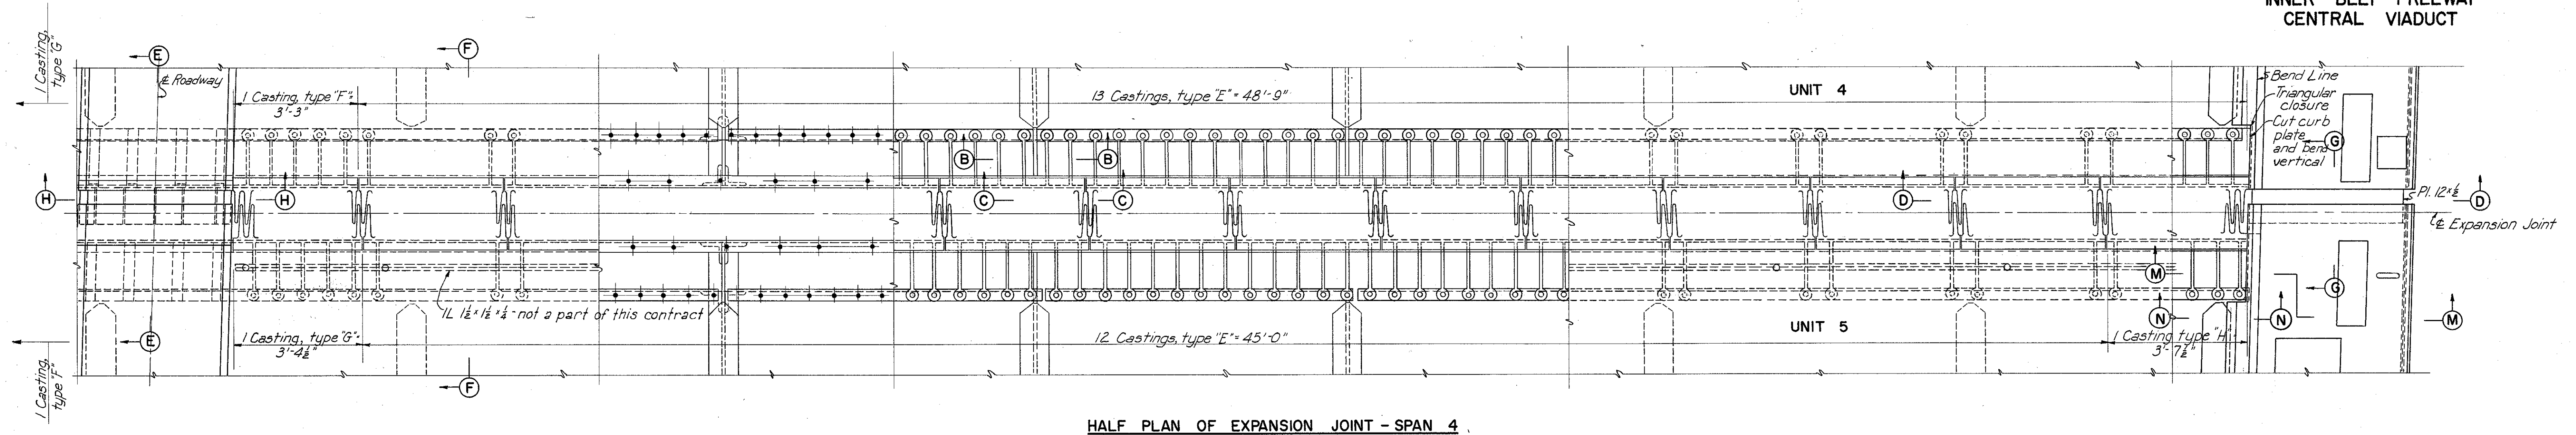

HALF PLAN OF EXPANSION JOINT - SPAN 4

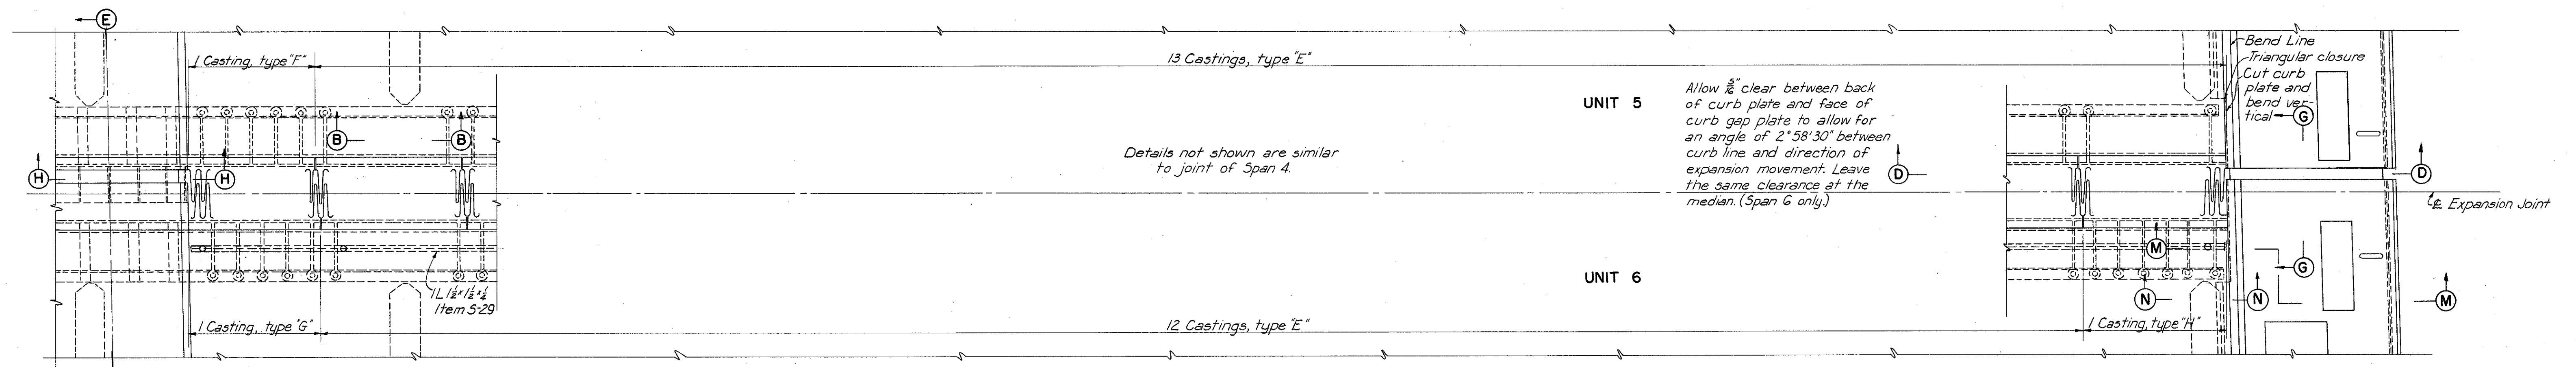

HALF PLAN OF EXPANSION JOINT - SPAN 6

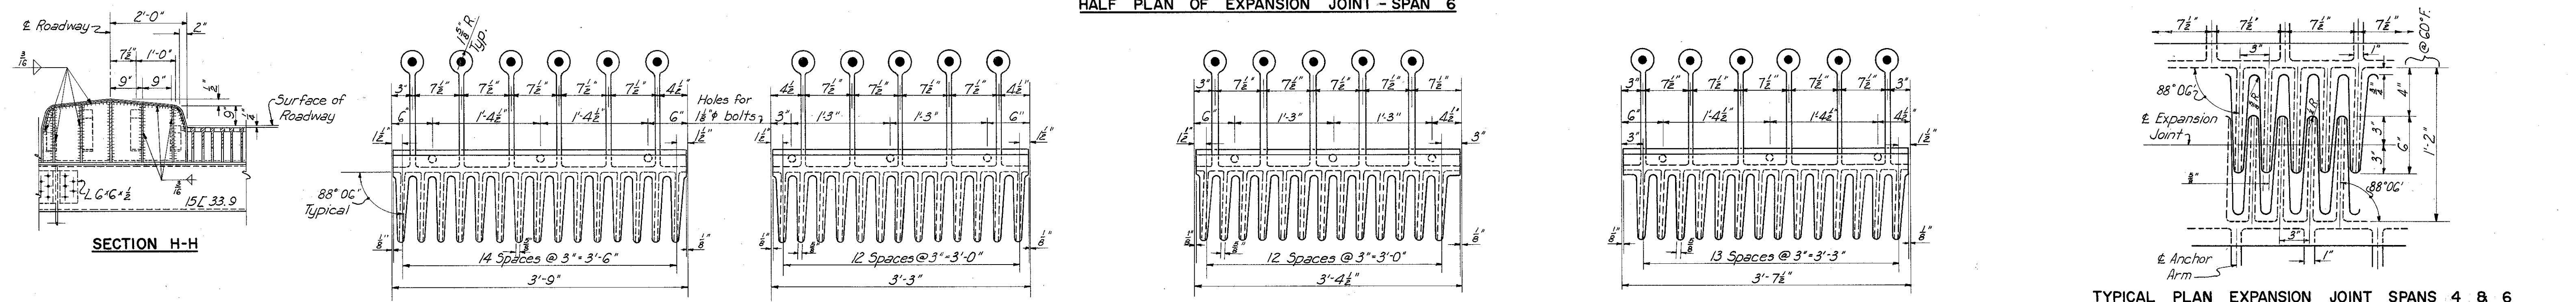

TYPICAL PLAN EXPANSION JOINT SPANS 4 & 6

Scale: 1/2" = 1'-0"

PART 3

U. S. ROUTE 42 RELOCATION
INNER BELT FREEWAY - CENTRAL VIADUCT
BR. NO. CU - 42 R-17 5


EXPANSION JOINT - SPANS 4 AND 6

CLEVELAND CUYAHOGA COUNTY OHIO

SCALE: 1/2" = 1'-0" except as noted
MADE: J.M.S. DATE: 2-8-54
TRCD: J.A.M. DATE: 11-9-54
CKD: M.D. DATE: 11-10-54
HOWARD, NEEDLES, TAMMEN & BERGENDOFF
CONSULTING ENGINEERS
KANSAS CITY CLEVELAND NEW YORK
914-1A SHEET 2.112

Notes:
Sections B-B, C-C, D-D, E-E, F-F, M-M, N-N,
and G-G are shown on Sh. III.
For notes on expansion joints,
see Sh. III.

CROSS SECTION OF JOINT CASTING
Scale: 1" = 1'-0"




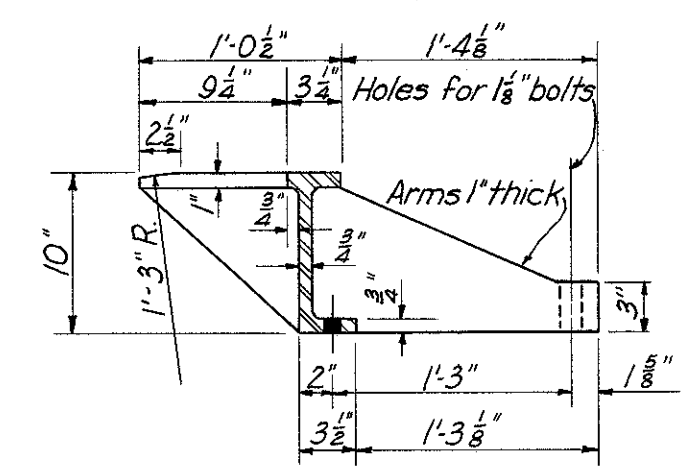


CASTING E
Scale: 1" = 1'-0"
No. Required - 100

CASTING F
Scale: 1" = 1'-0"
No. Required - 4

CASTING G
Scale: 1" = 1'-0"
No. Required - 4

CASTING H
Scale: 1" = 1'-0"
No. Required - 4

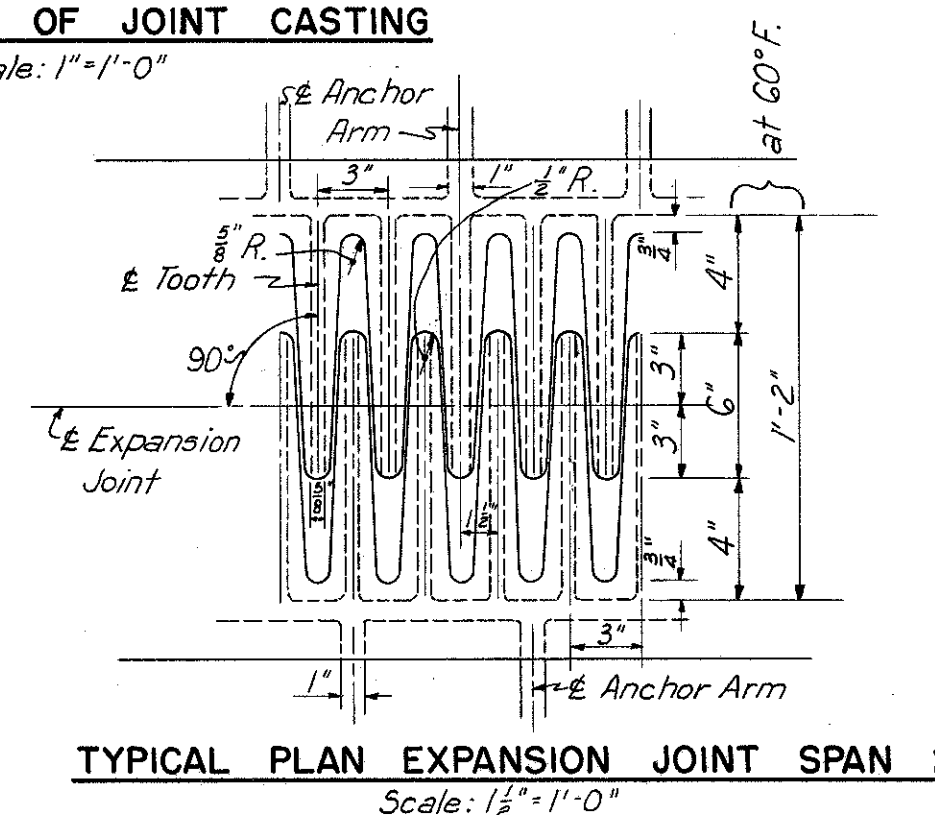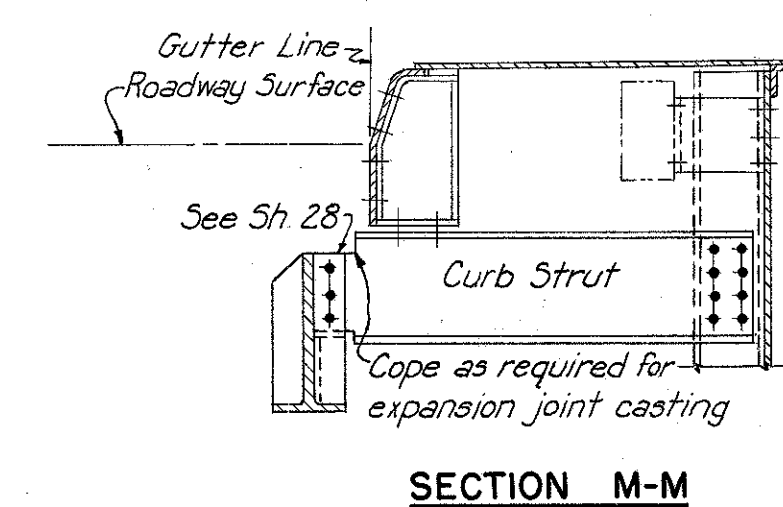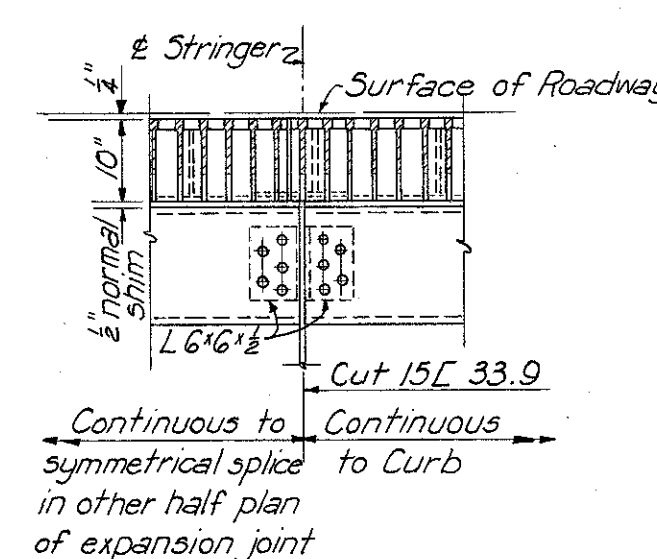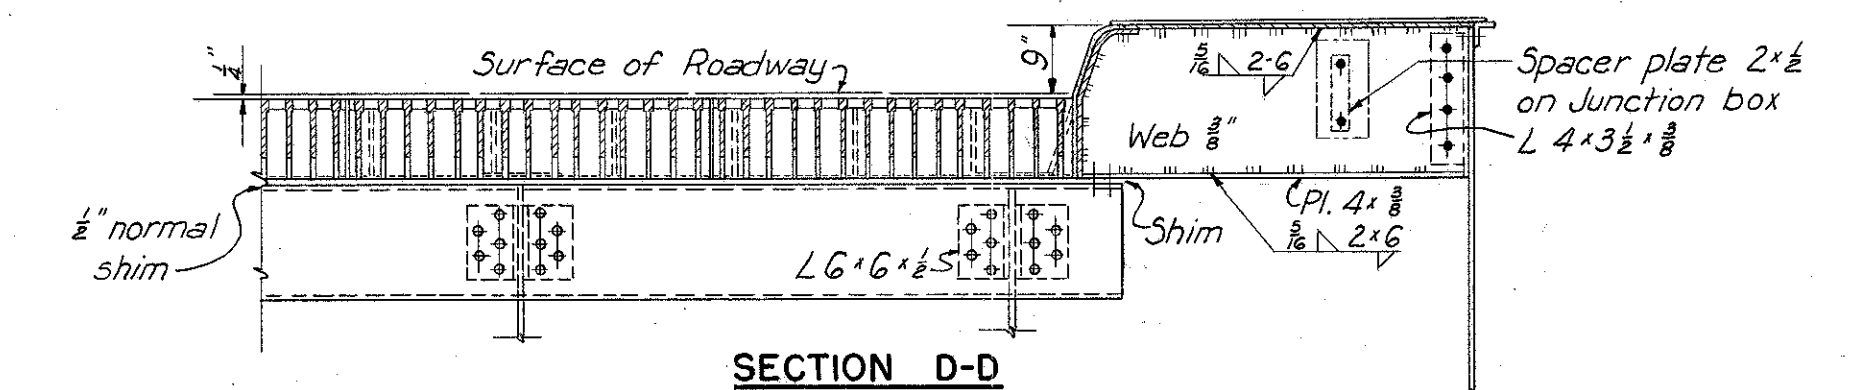

PART 3

U. S. ROUTE 42 RELOCATION
INNER BELT FREEWAY - CENTRAL VIADUCT
BR. NO. CU - 42 R-17 5

EXPANSION JOINT SPAN 2

CLEVELAND CUYAHOGA COUNTY OHIO

SCALE $\frac{1}{8}" = 1'-0"$ except as noted
MADE J.M.S. DATE 1-27-54
TRCD N.A.M. DATE 10-28-54
CKD D.M.D. DATE 10-29-54

HOWARD, NEEDLES, TAMMEN & BERGENDOFF
CONSULTING ENGINEERS
KANSAS CITY CLEVELAND NEW YORK
914-1A SHEET- 211

Technical drawing of a bridge structure, likely a girder bridge, showing spans, stringers, and various components. The drawing includes dimensions and labels for different parts.

Dimensions and Spacing:

- Span 1: 52'-0"
- Span 2: 48'-3" (6-Spacing @ 8'-0 1/2")
- Span 3: 51'-1"
- Span 4: 48'-9" (13-Castings Type "A")
- Span 5: 3'-3" (1-Casting type "B")
- Span 6: 4'-1 1/4"

Labels and Components:

- Stringer Spacing
- Other end of joint requires 1-Type C, 12 Type A and 1-Type D casting as shown for Span 2.
- 1-Casting type "B"
- 13-Castings Type "A"
- 1 1/2" φ Copper Pipe
- L 1 1/2 x 1 1/2 x 1/4 not a part of this contract
- Conduit below
- Future pier above
- Joint in sidewalk is the same as in Span 2.

Notes:

- 1 1/2" φ Copper Pipe
- L 1 1/2 x 1 1/2 x 1/4 not a part of this contract

Scale: $\frac{1}{2}'' = 1'-0''$

Technical drawing showing the half plan of an expansion joint at the east and west end piers. The drawing includes dimensions, material specifications (e.g., 15 L 33.9, L 6x6 1/2), and labels for components like 'Stringer', 'Surface of Roadway', and 'Fascia Beam'. The scale is 1/2" = 1'-0".

Scale : $\frac{1}{2}'' = 1'-0''$

Scale : $\frac{1}{2}'' = 1'-0''$

Scale : $\frac{1}{2}'' = 1'-0''$

Scale : $\frac{1}{2}'' = 1'-0''$

Scale: $\frac{1}{2}'' = 1'-0''$

Scale: $\frac{1}{2}'' = 1'-0''$

10

10

Scale : $\frac{1}{2}'' = 1'-0''$


Scale : $\frac{1}{2}'' = 1'-0''$

Scale : $1\frac{1}{2}'' = 1'.0'$

Scale: 1" = 1'-0"

Scale: 1" = 1'-0" ¹⁵⁰
No required ~~100~~ for
Span 2 and both
end piers.

Scale: 1" = 1'-0"

Scale: 1" = 1'-0" 
No. required $\frac{6}{4}$ for
Span 2 and both
end piers.

Scale: 1" = 1'-0"

Scale: 1" = 1'-0"

Scale: $\frac{1}{2}'' = 1.0''$

Scale: $\frac{1}{2}'' = 1.0''$

Scale: $\frac{1}{2}'' = 1'-0''$

Scale: $\frac{1}{2}'' = 1'-0''$

Note:
For notes on expansion joints
see Sheet III.
For details of castings C and D
see Sheet III.


U. S. ROUTE 42 RELOCATION
INNER BELT FREEWAY - CENTRAL VIADUCT
BR. NO. CU - 42 R-17 5
EXPANSION JOINT AT EAST AND WEST
END PIERS
CLEVELAND CUYAHOGA COUNTY OHIO

SCALE As shown
MADE D.E.R. DATE 8-16-54
TRCD D.E.F. DATE 10-27-54
CKD D.H.D. DATE 10-28-54


HOWARD, NEEDLES, TAMMEN & BERGENDOFF
CONSULTING ENGINEERS
KANSAS CITY CLEVELAND NEW YORK

914-1A SHEET 2.110


CUYAHOGA COUNTY
CITY OF CLEVELAND
INNER BELT FREEWAY
CENTRAL VIADUCT

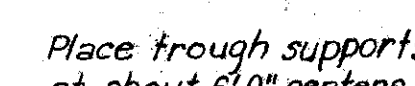

Scale: $\frac{1}{4}'' = 1'-0''$
 Looking east at west end
 Looking west at east end

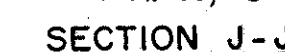

HOPPER DETAILS
Scale: $\frac{3}{4}'' = 1'-0''$

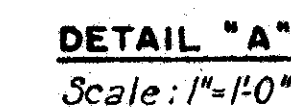

SECTION G-G
Scale: 1"=1'-0"

RVA

Note:
Details not shown are the same
as for Type C Sh. 109.

PART 3

U. S. ROUTE 42 RELOCATION
INNER BELT FREEWAY - CENTRAL VIADUCT
BR. NO. CUY-42 R-17.50

ROADWAY DRAINS AND CATWALKS
AT END PIERS

CLEVELAND CUYAHOGA COUNTY OHIO

SCALE As shown
MADE DMD DATE 8-2-56
TRCD GJK DATE 8-8-56
CKD _____ DATE _____

HOWARD, NEEDLES, TAMMEN & BERGENDOORF
CONSULTING ENGINEERS
KANSAS CITY CLEVELAND NEW YORK
914-1A SHEET 2 109A


914-1A SHEET. 2.109A

INCORPORATED
FEB 16 1983


FED. ROAD DIV. NO.	STATE	FEDERAL AID PROJECT NO.	TYPE FUNDS
2	OHIO		

107
122

CUYAHOGA COUNTY
CITY OF CLEVELAND
INNER BELT FREEWAY
CENTRAL VIADUCT


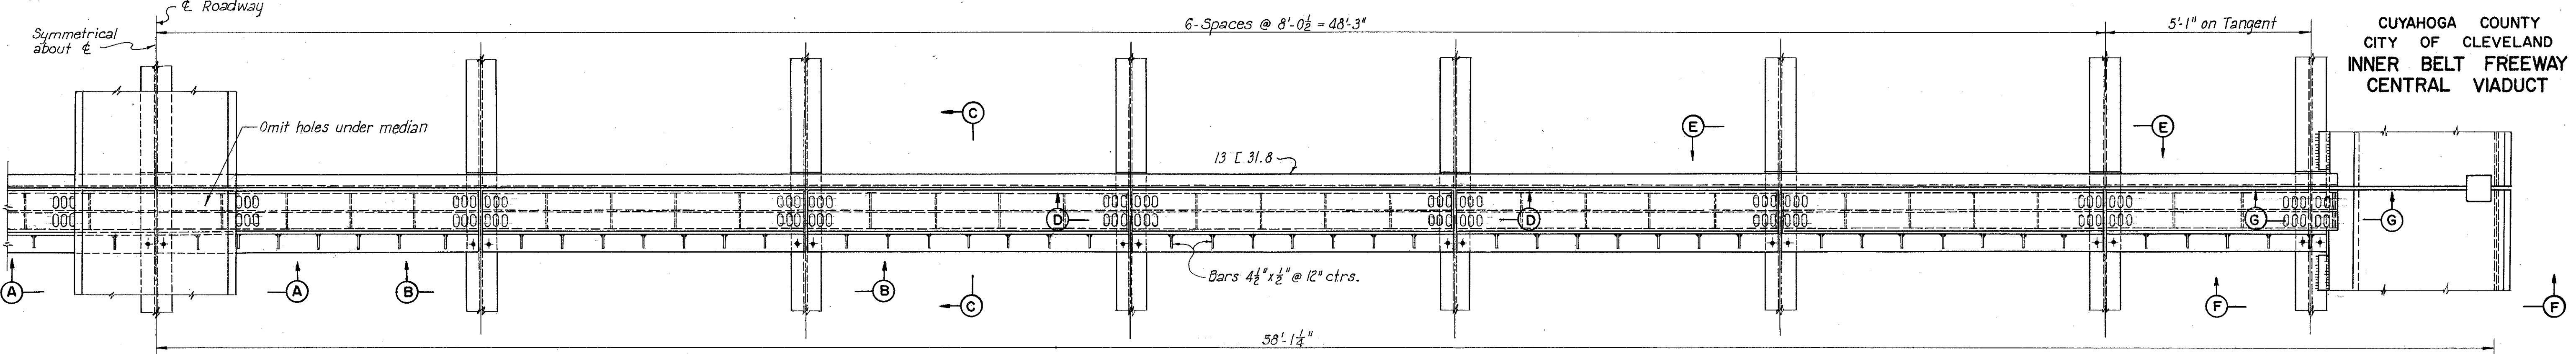


HALF PLAN OF CROSS DRAIN AND SLAB JOINT

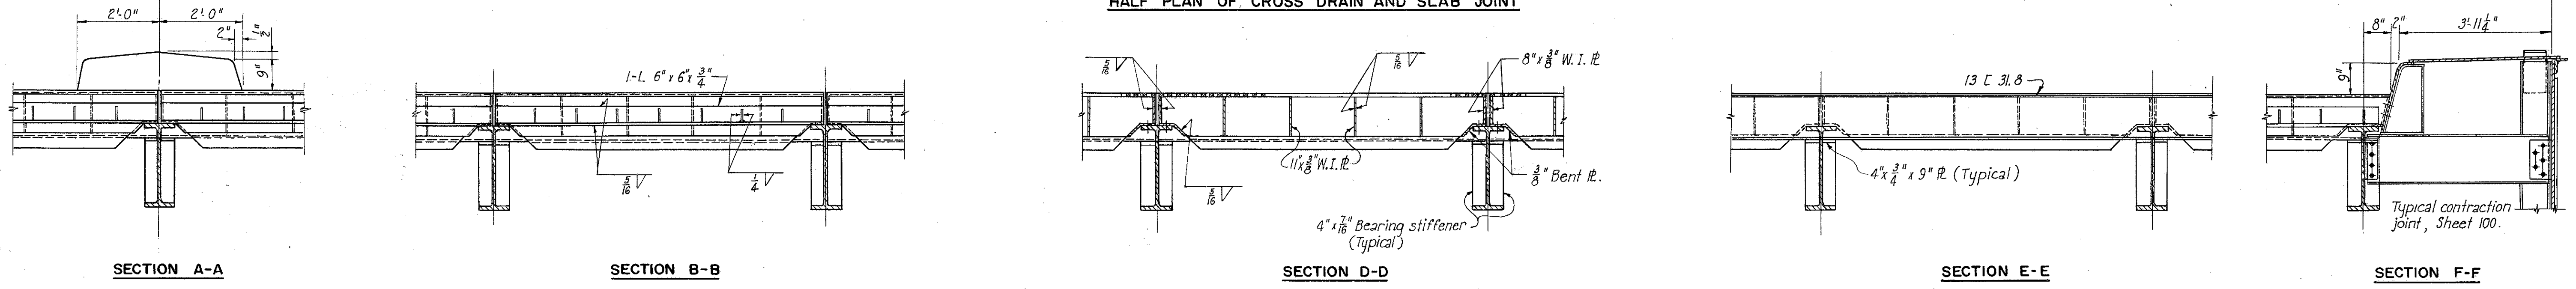


CROSS DRAIN AND SLAB JOINT WITH FRAMING CENTERED UNDER ROADWAY DECK

Panel Points 113, 24, 307, and 311.

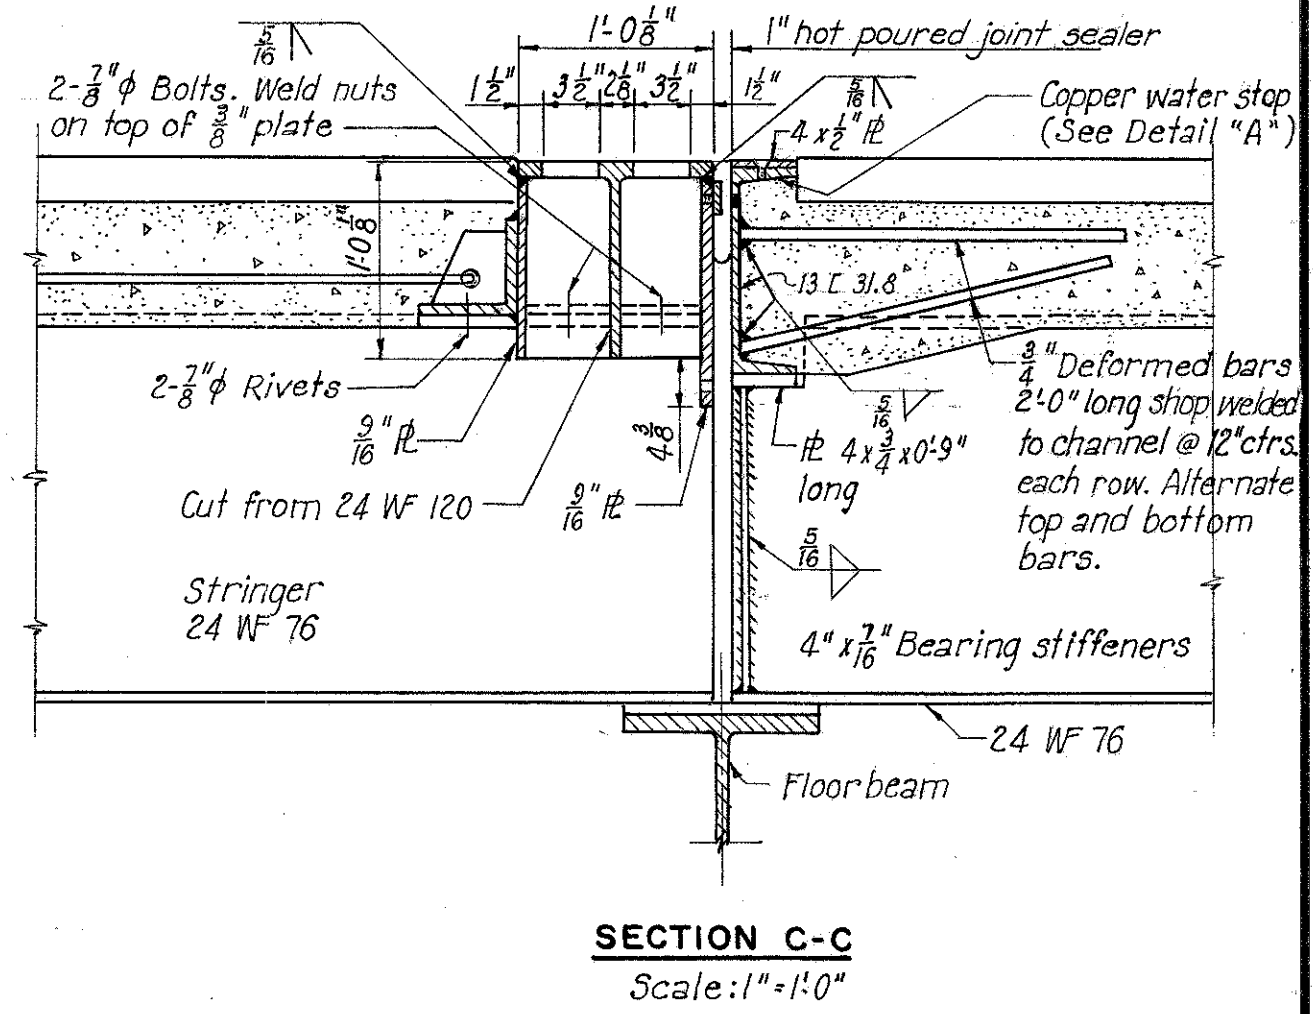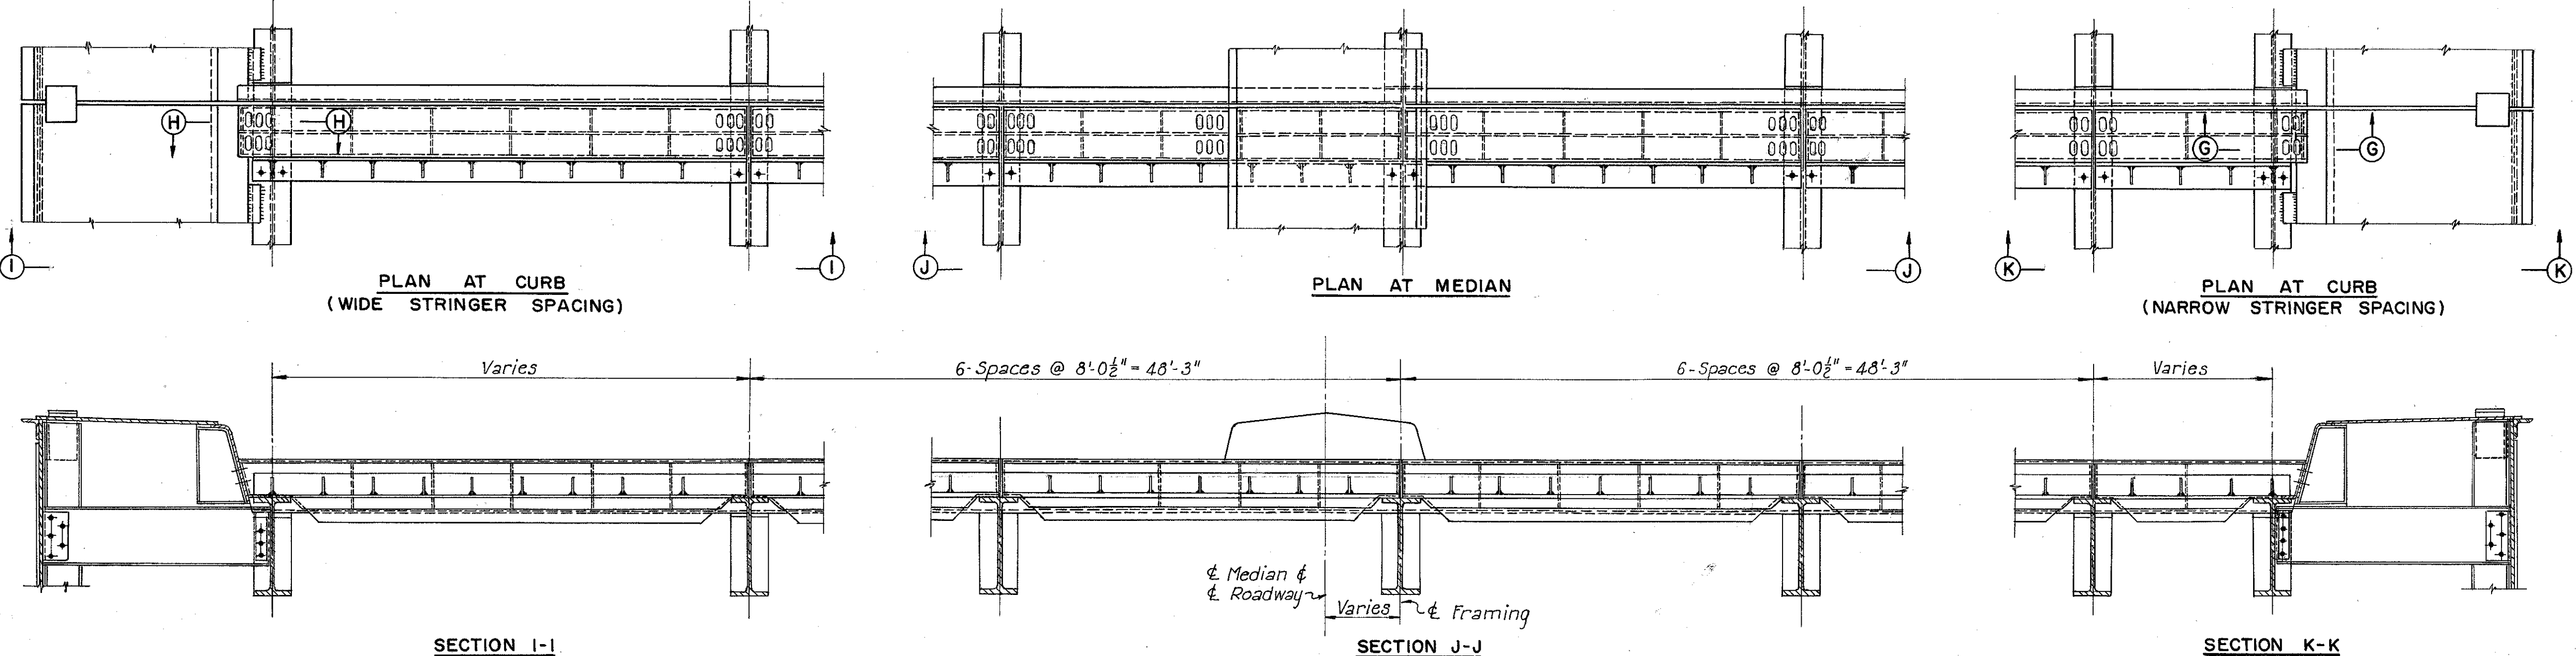

CROSS DRAIN AND SLAB JOINT WITH FRAMING NOT CENTERED UNDER ROADWAY DECK

Panel Points 318, 44, 507, 511, 700, 707, 711, 83, and 900

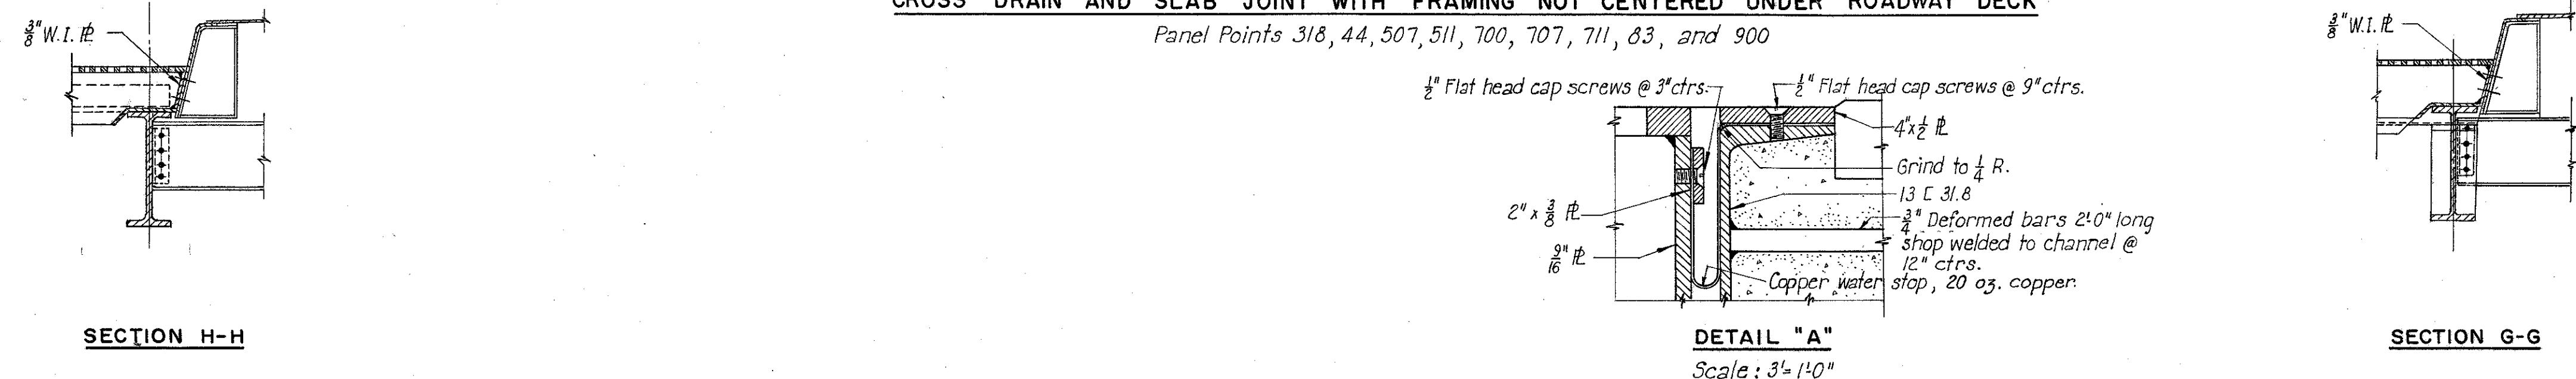


PART

U. S. ROUTE 42 RELOCATION			
INNER BELT FREEWAY - CENTRAL VIADUCT			
BR. NO. CU - 42 R - 17 5			
ROADWAY DRAINS			
TYPE B			
CLEVELAND	CUYAHOGA COUNTY	OHIO	
SCALE: 1" = 1'-0" except as shown			
MADE V.E.A. DATE 3-10-54			
TRCD A.H. DATE 11-23-54			
CKD DMD DATE 11-24-54			
HOWARD, NEEDLES, TAMMEN & BERGENDOFF			
CONSULTING ENGINEERS			
KANSAS CITY	CLEVELAND	NEW YORK	
914-1A SHEET 2. 107			


FEB 16 1965

106
122


CUYAHOGA COUNTY
CITY OF CLEVELAND
INNER BELT FREEWAY
CENTRAL VIADUCT

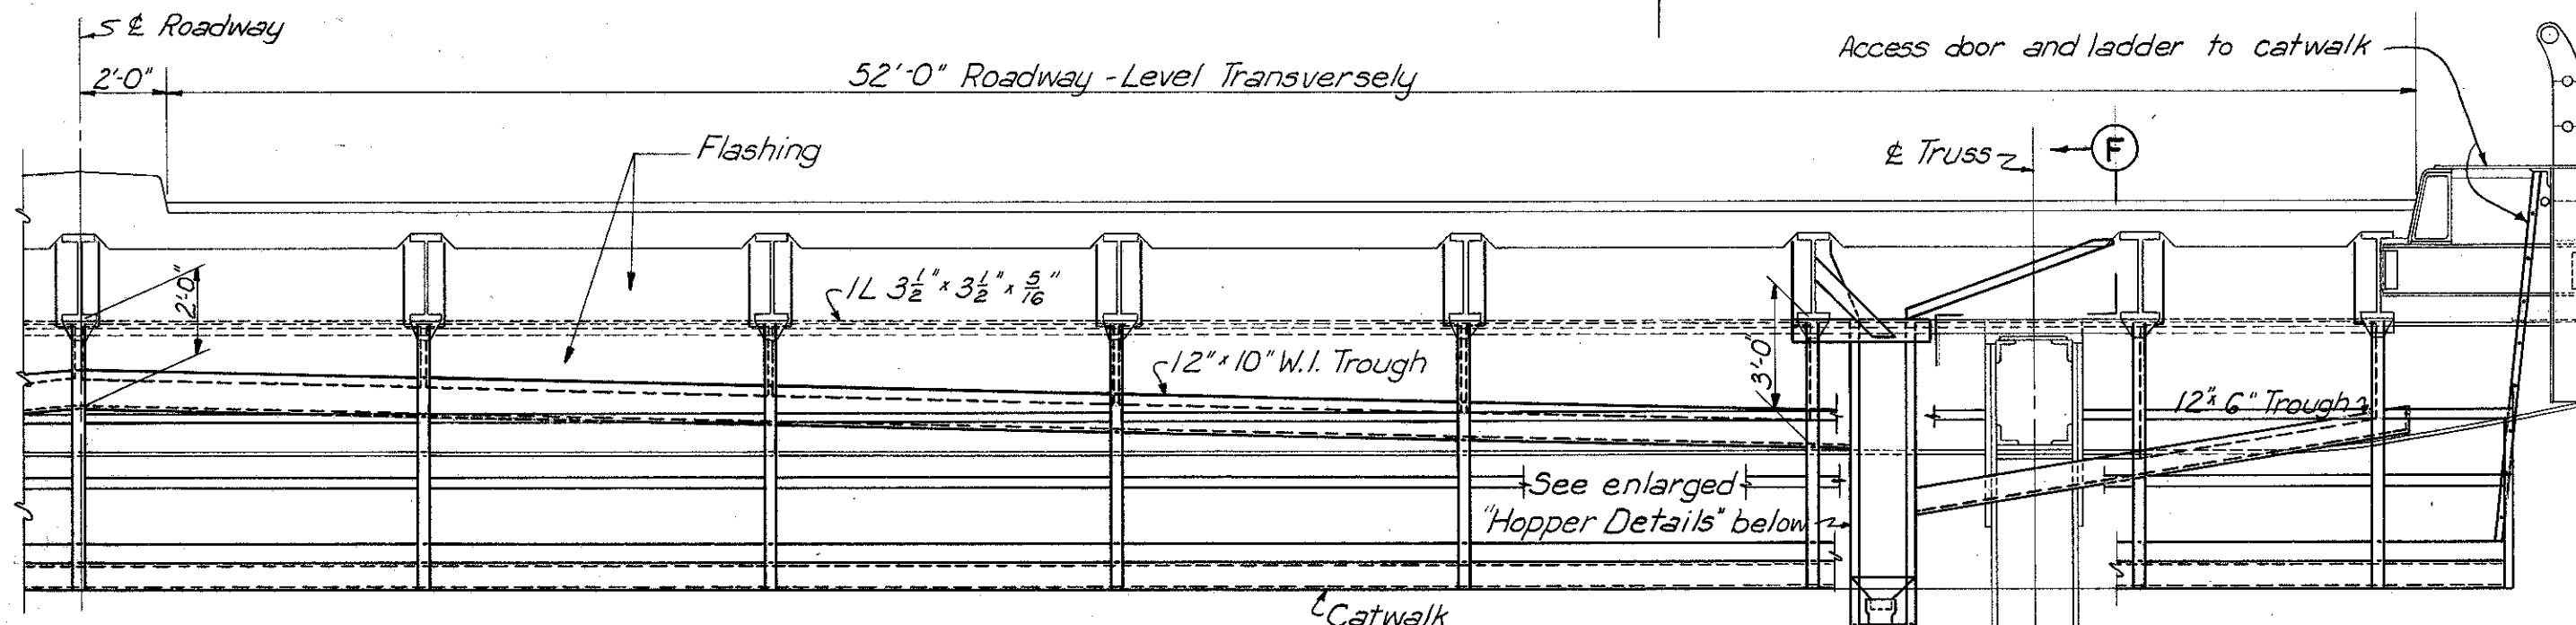


TYPICAL HALF SECTION AT CROSS DRAINS
Scale: $\frac{1}{2}" = 1'-0"$

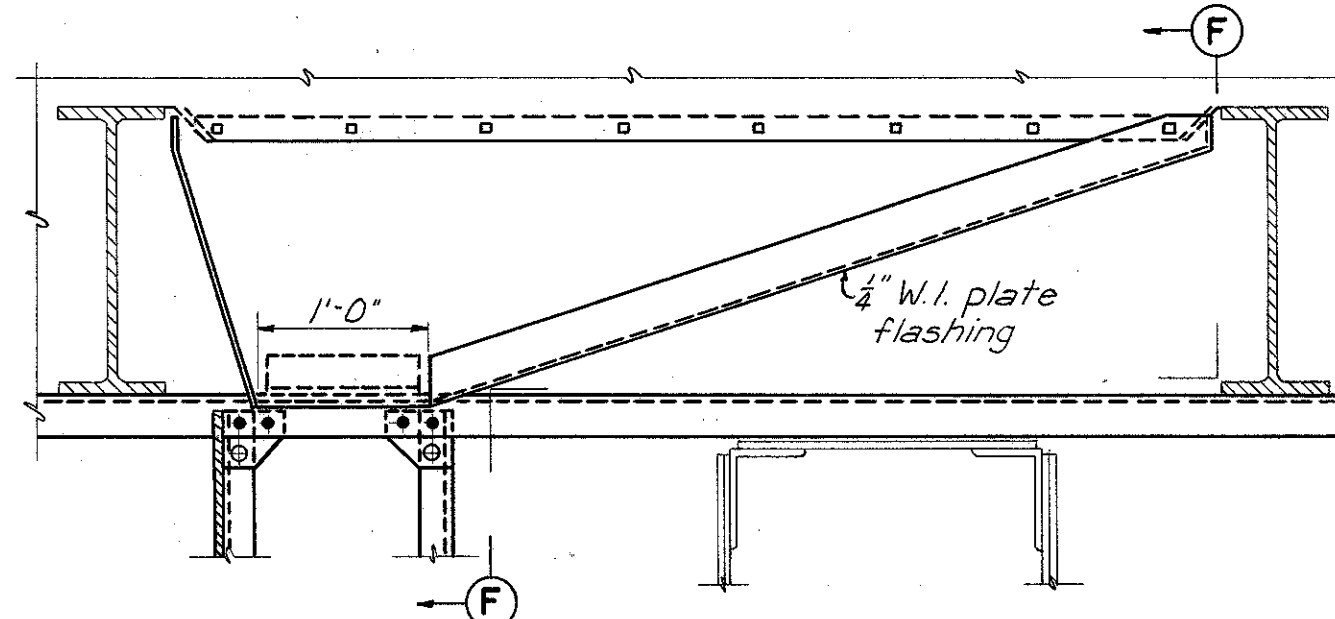


SECTION G-
Scale: 1/8" = 1'-0"

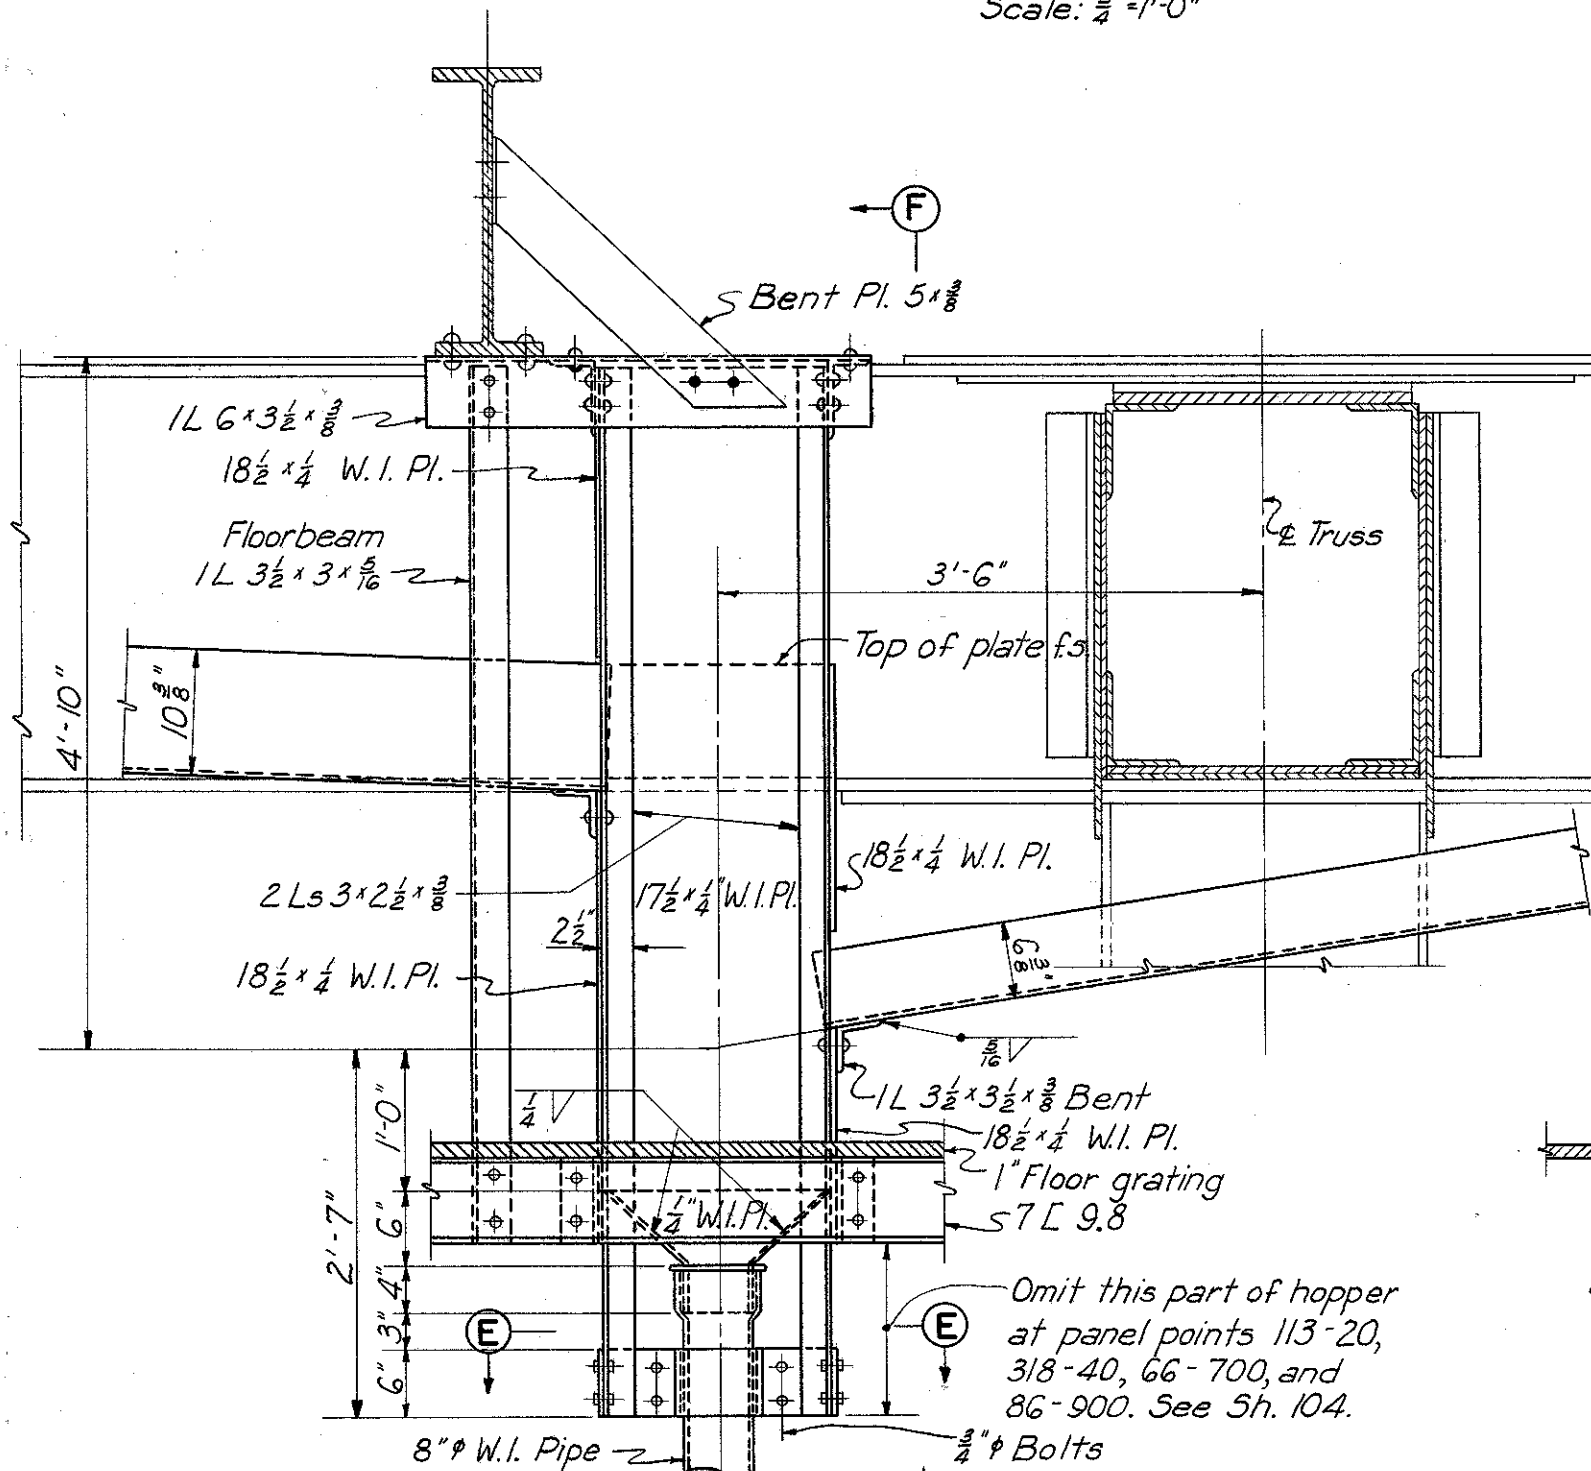


SECTION D-

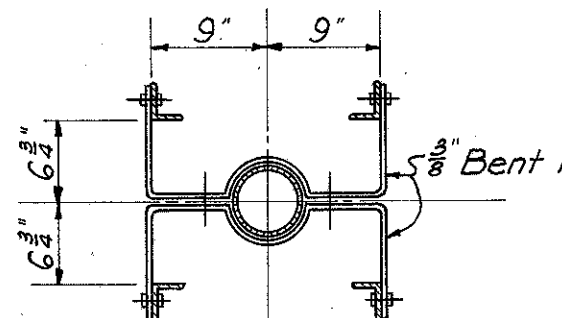


SECTION E
Scale: $\frac{3}{8}'' = 1'-0''$

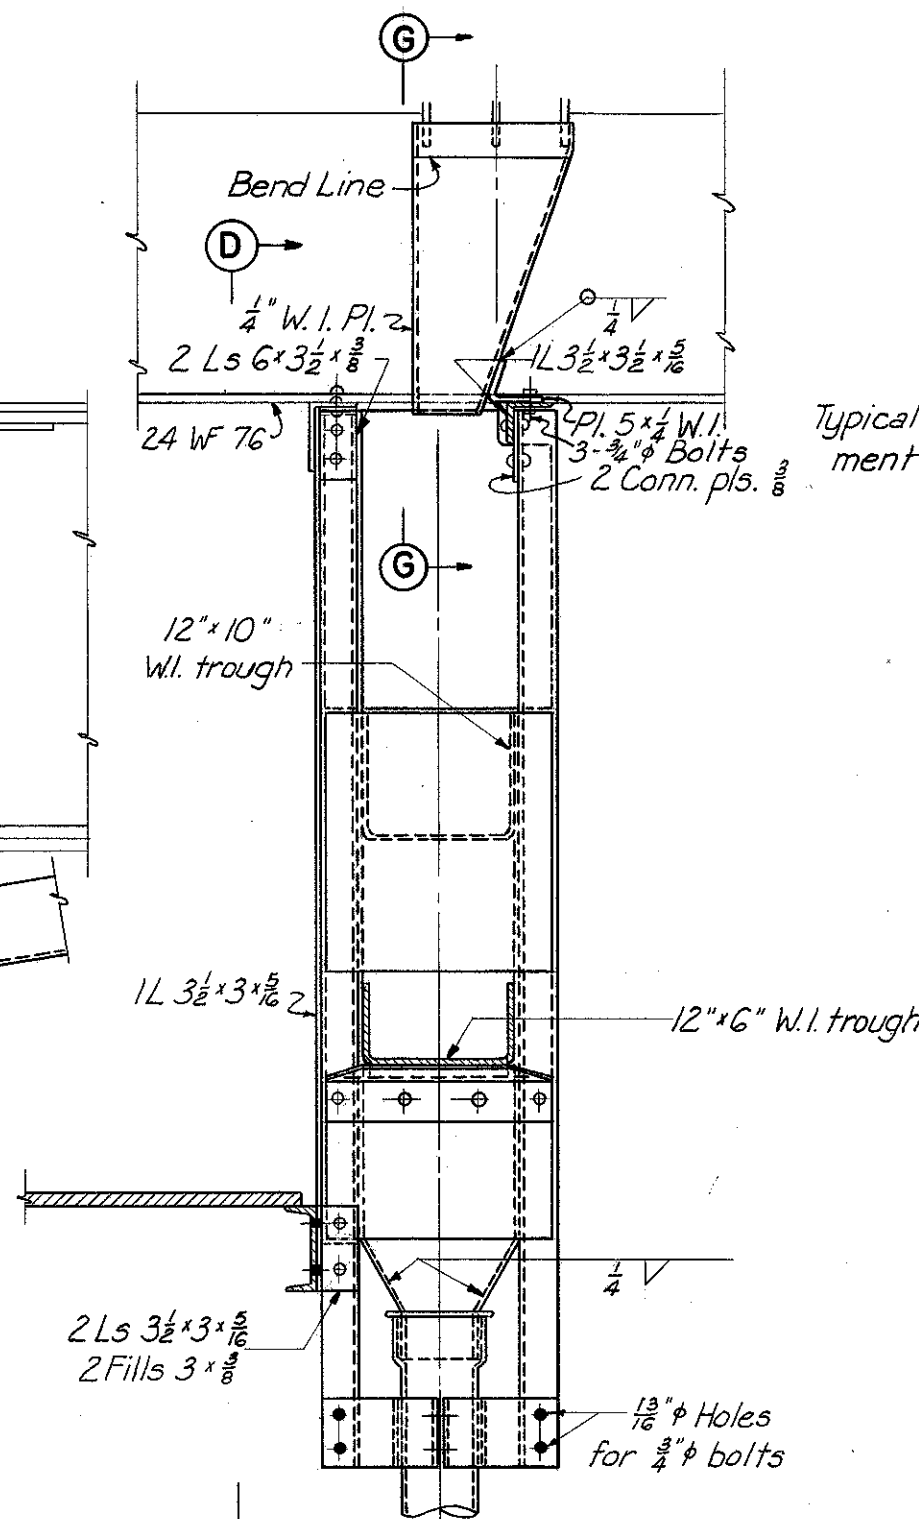


SECTION F-

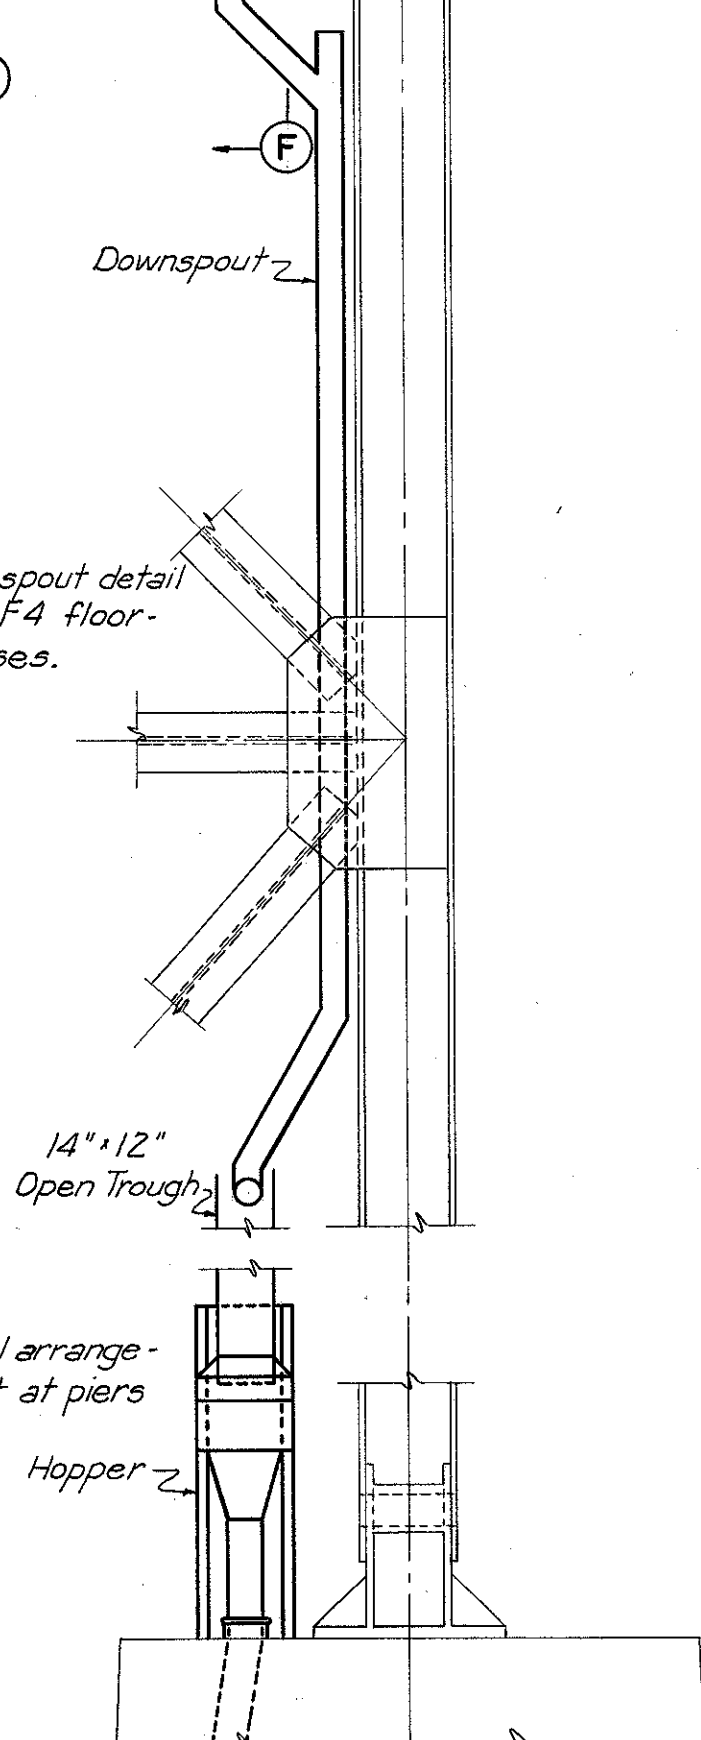


Typical downspout detail
at F3 and F4 floor-
beam trusses

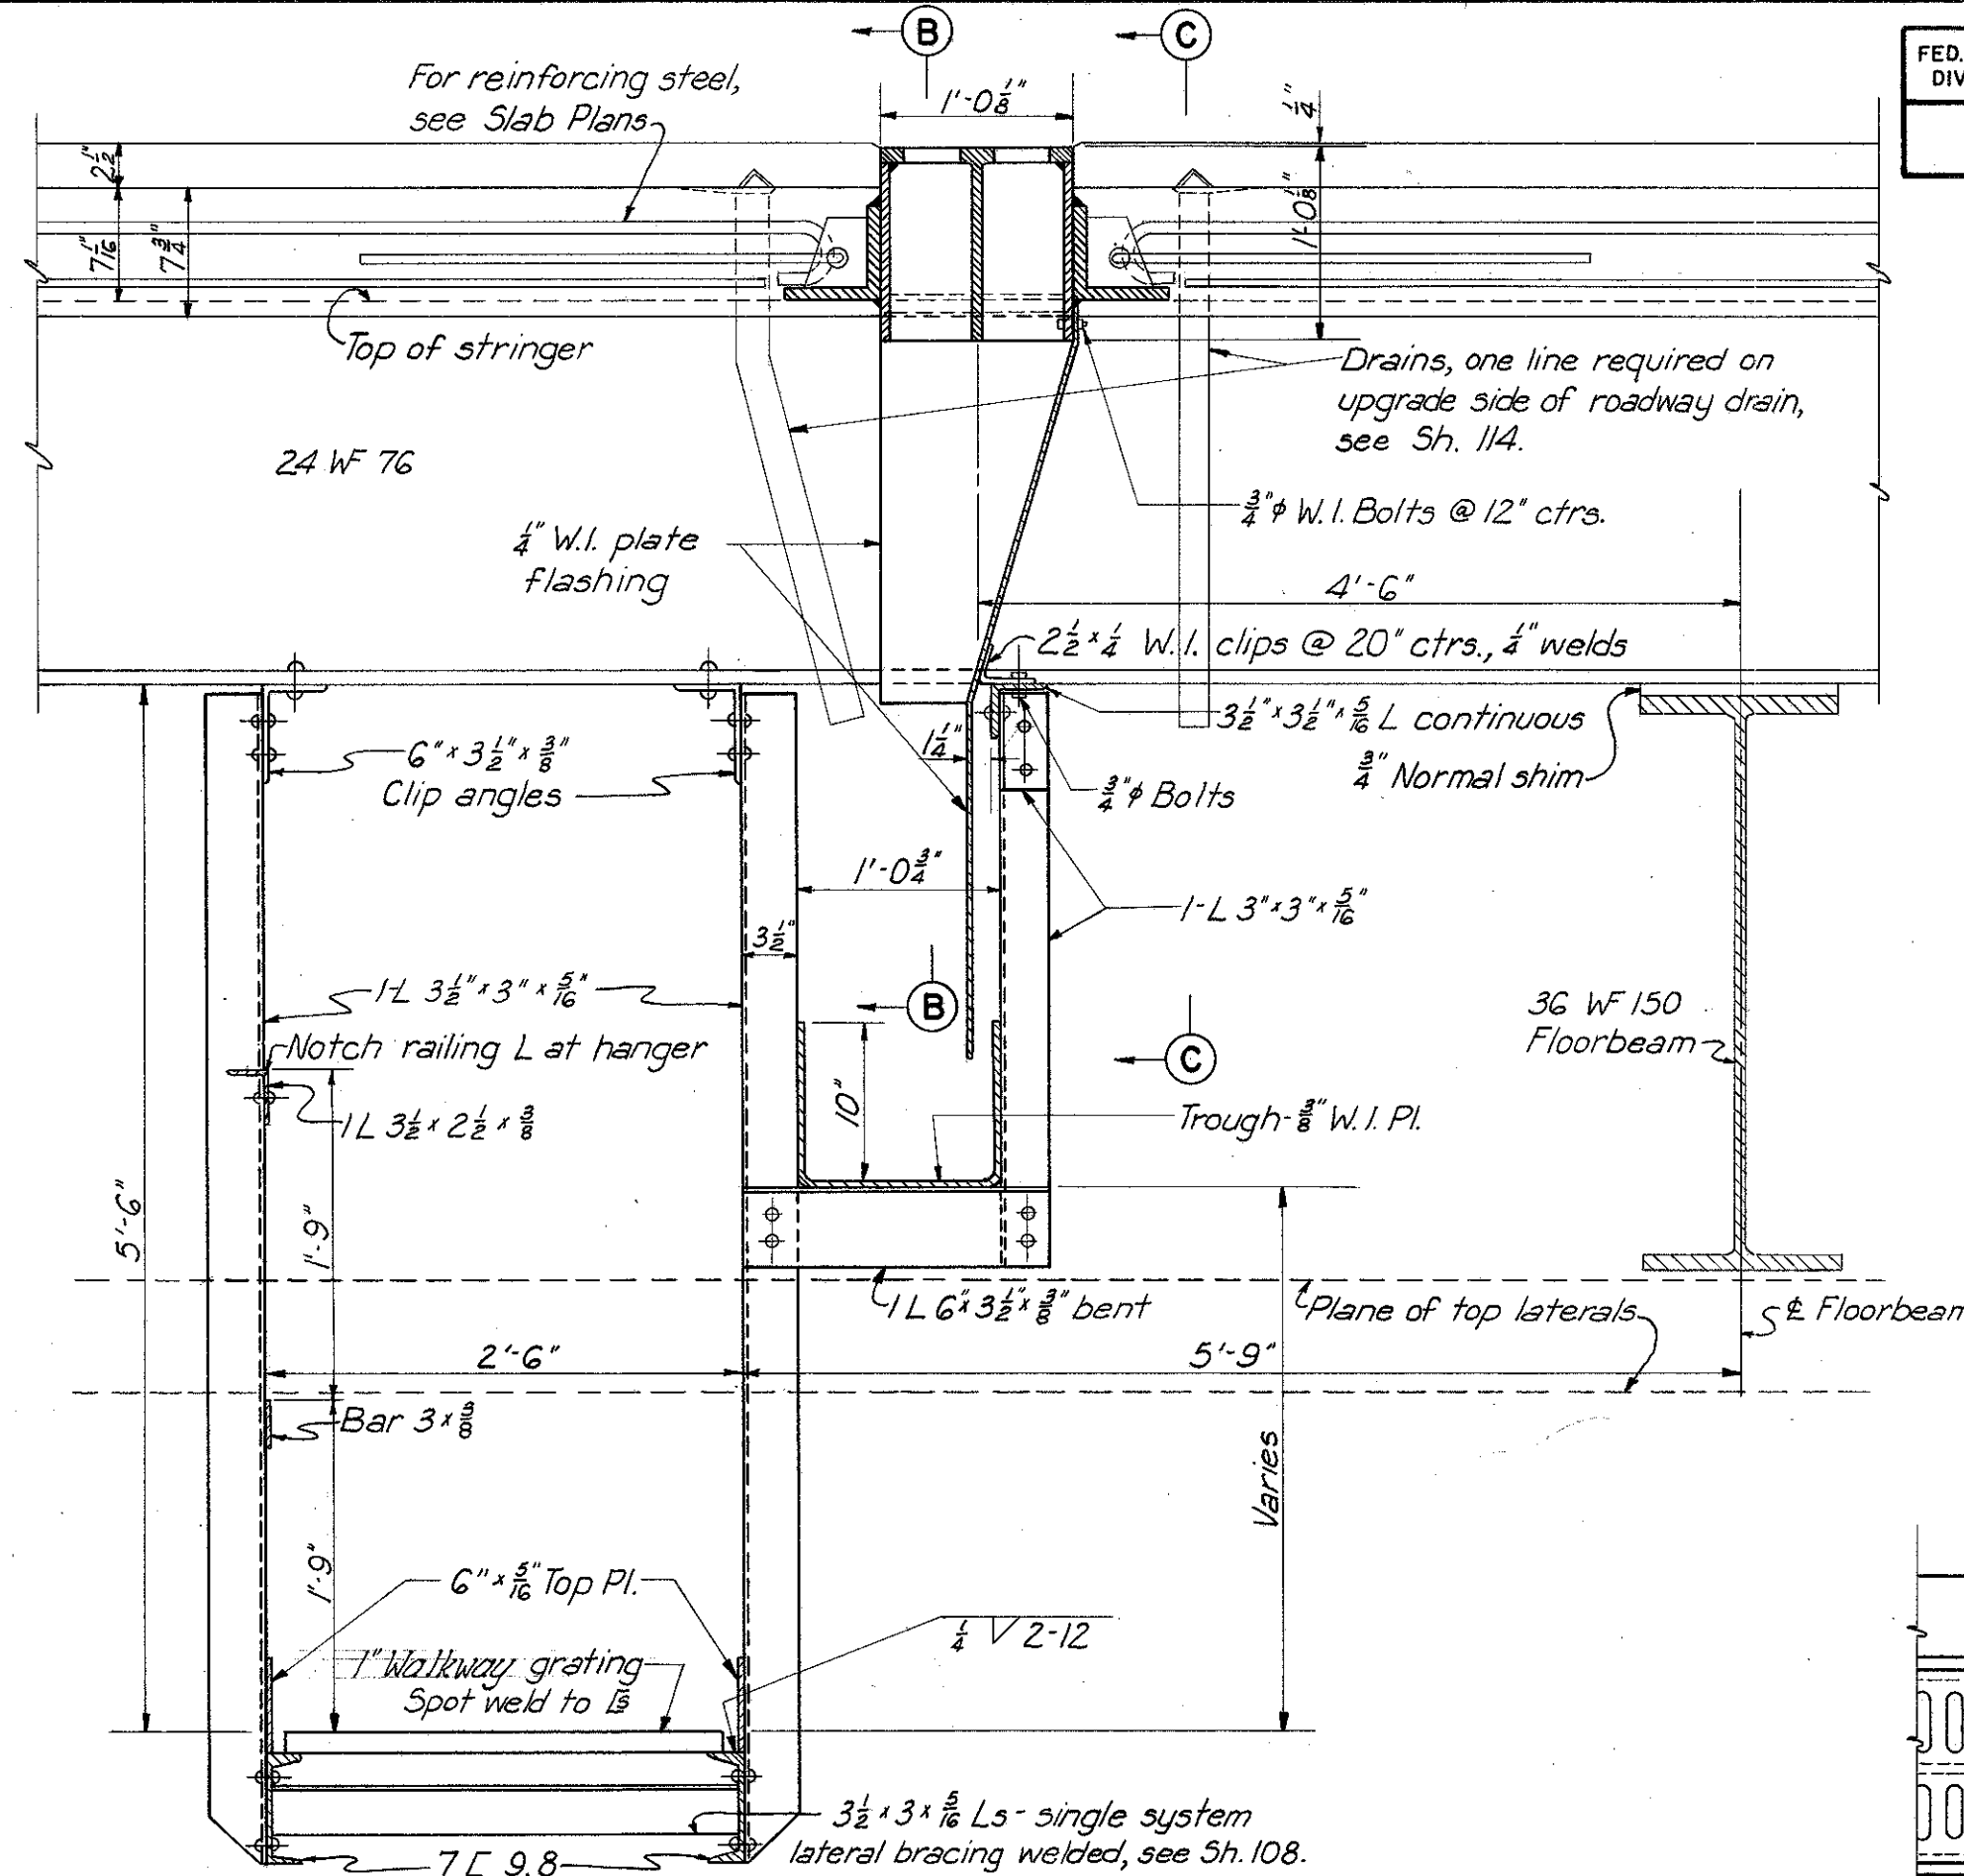


SECTION A-
Scale: 1" = 1'-0"

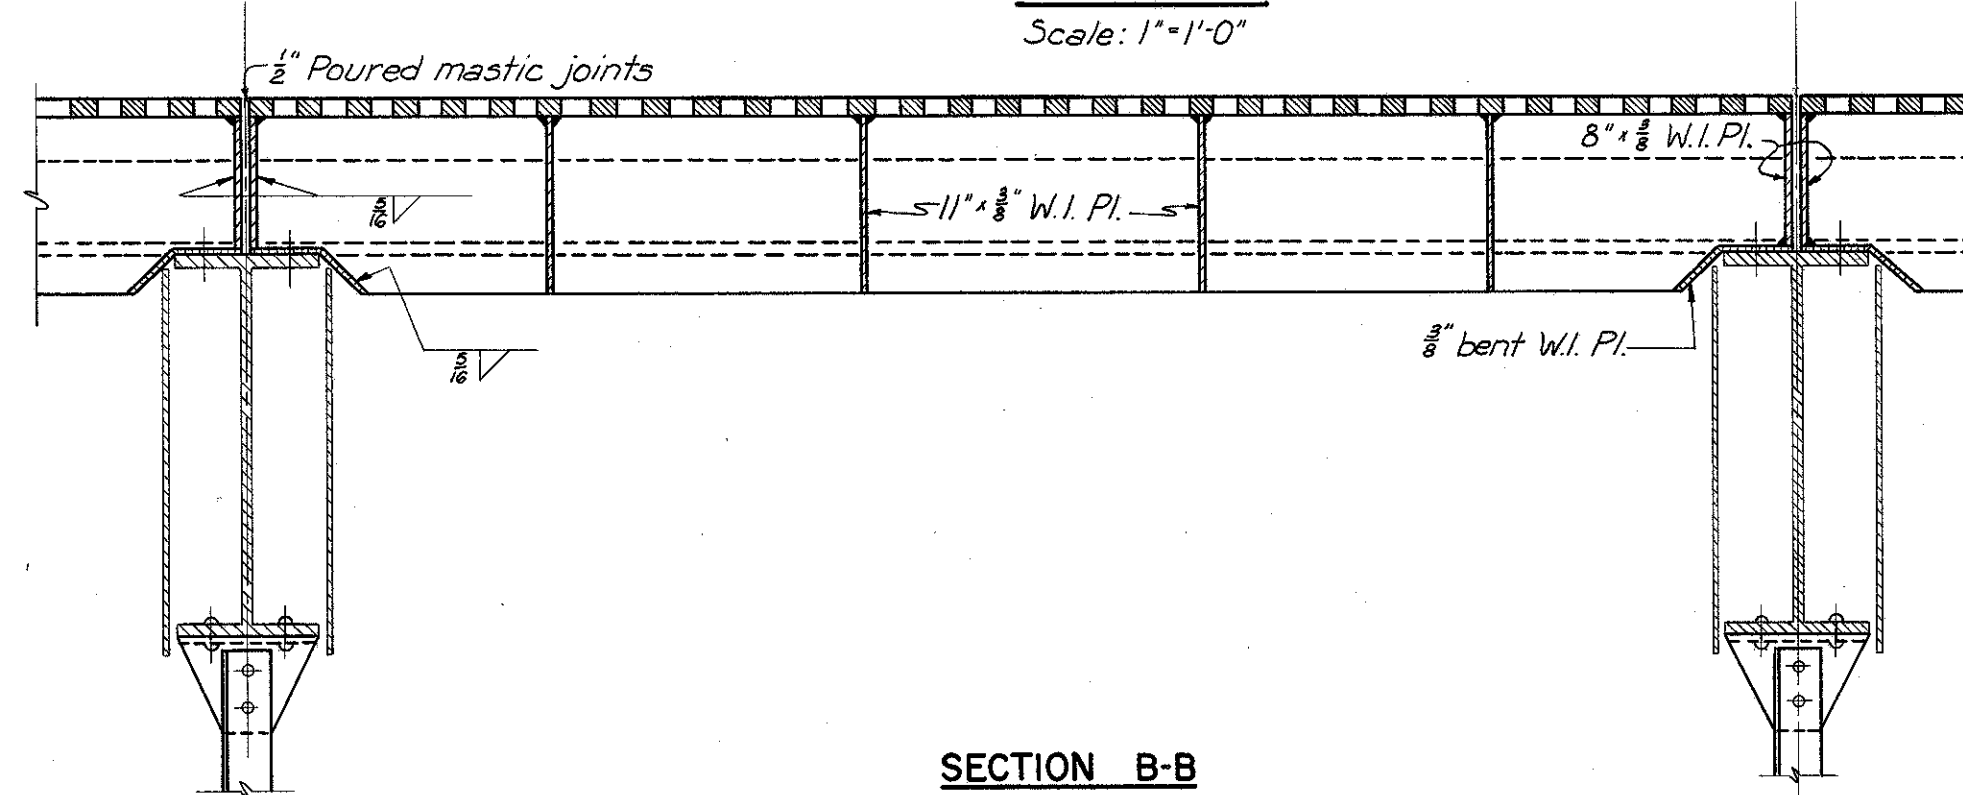


SECTION B-B
Scale: 1"=1'-0"

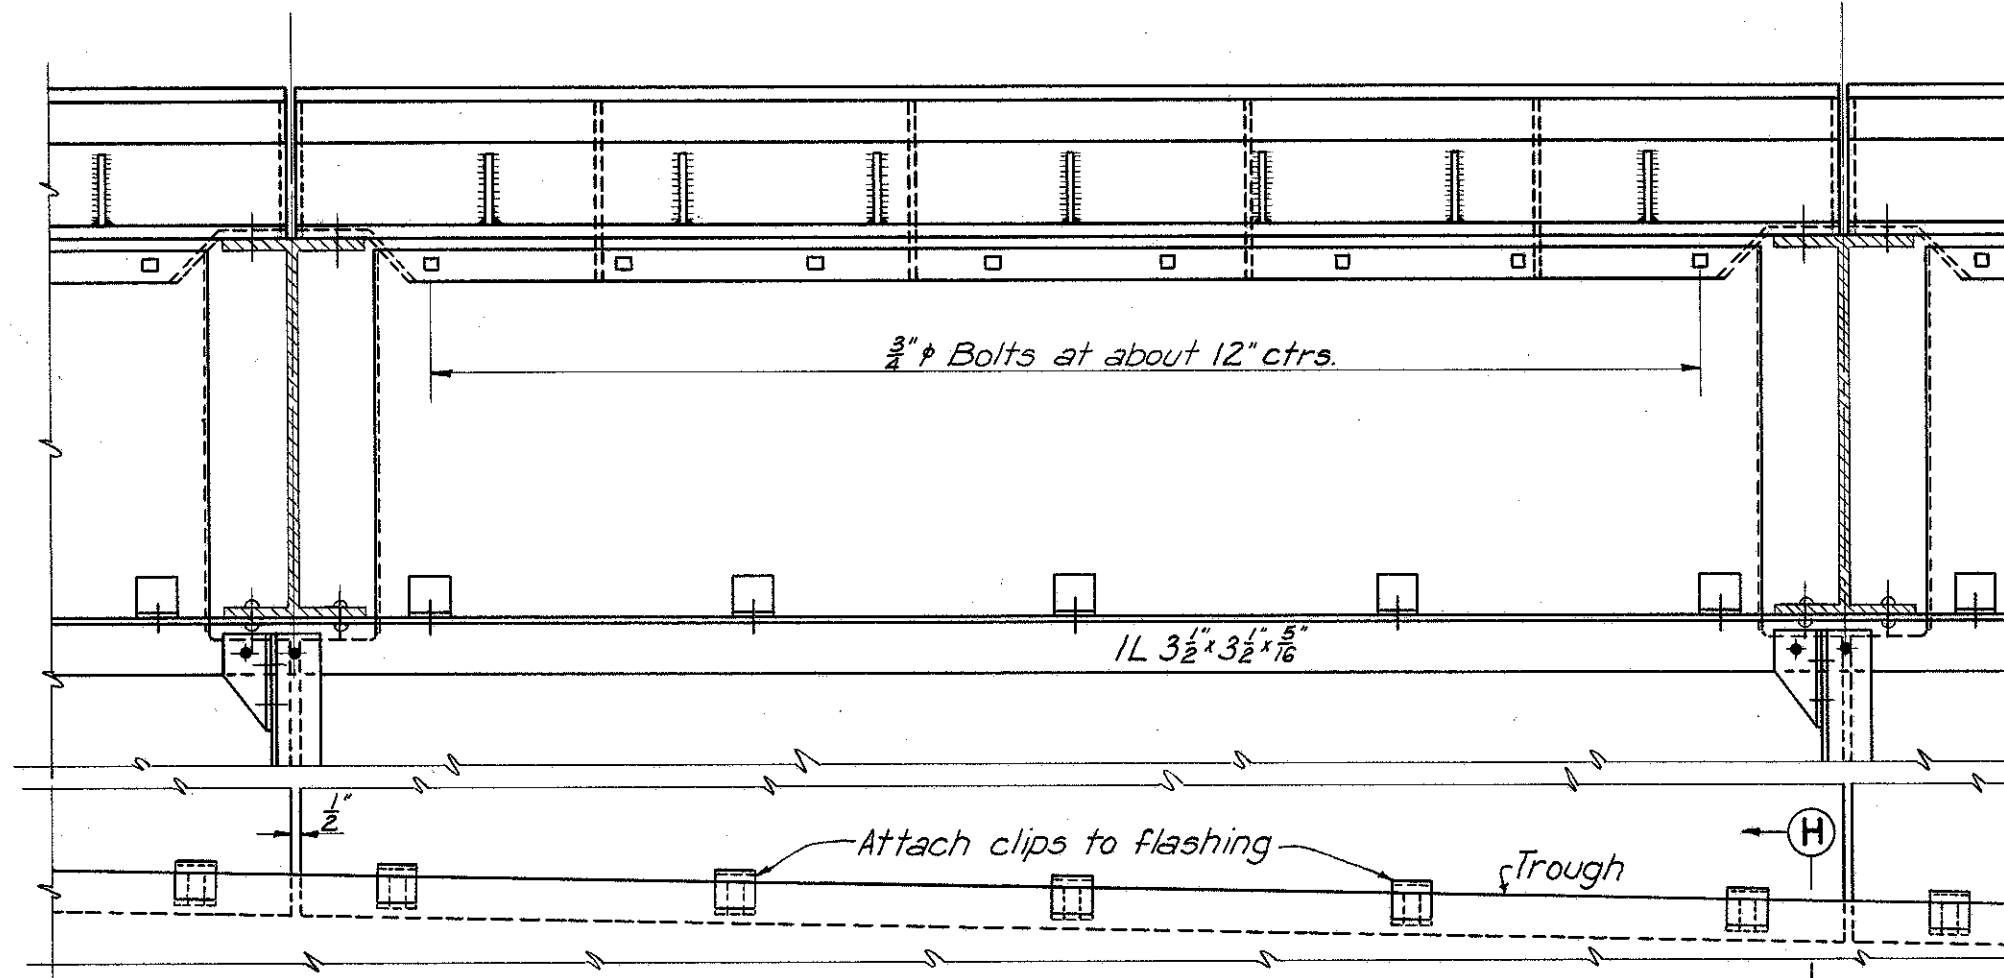

SECTION C-C
Scale: 1"=1'-0"

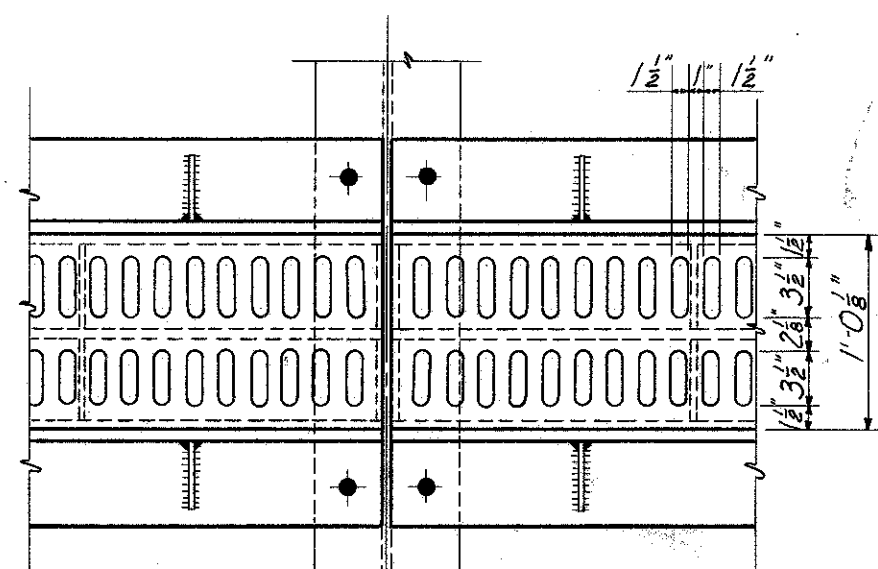

PLAN OF DRAIN
Scale: 1"=1'-0"

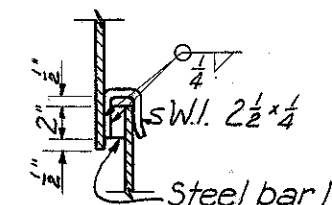

SECTION H-H
Scale: 1" = 1'-0"

Note: Rivets in all framing for catwalks and drains to be $\frac{3}{4}$ " ϕ except in connections to main members. All cross drain troughs and longitudinal troughs are of $\frac{3}{8}$ " wrought iron.

PART 3

U. S. ROUTE 42 RELOCATION
INNER BELT FREEWAY - CENTRAL VIADUCT
BR. NO. CU - 42 R-17 5

ROADWAY DRAINS AND CATWALK
TYPE A

CLEVELAND CUYAHOGA COUNTY OHIO


SCALE As Shown
MADE V.E.A. DATE 1-26-54
TRCD N.A.M. DATE 11-24-54
CKD O.M.D. DATE 11-29-54

HOWARD, NEEDLES, TAMMEN & BERGENDOFF
CONSULTING ENGINEERS
KANSAS CITY CLEVELAND NEW YORK
914-1A SHEET- 2.106

FEB 16 1963




CUYAHOGA COUNTY
CITY OF CLEVELAND
INNER BELT FREEWAY
CENTRAL VIADUCT

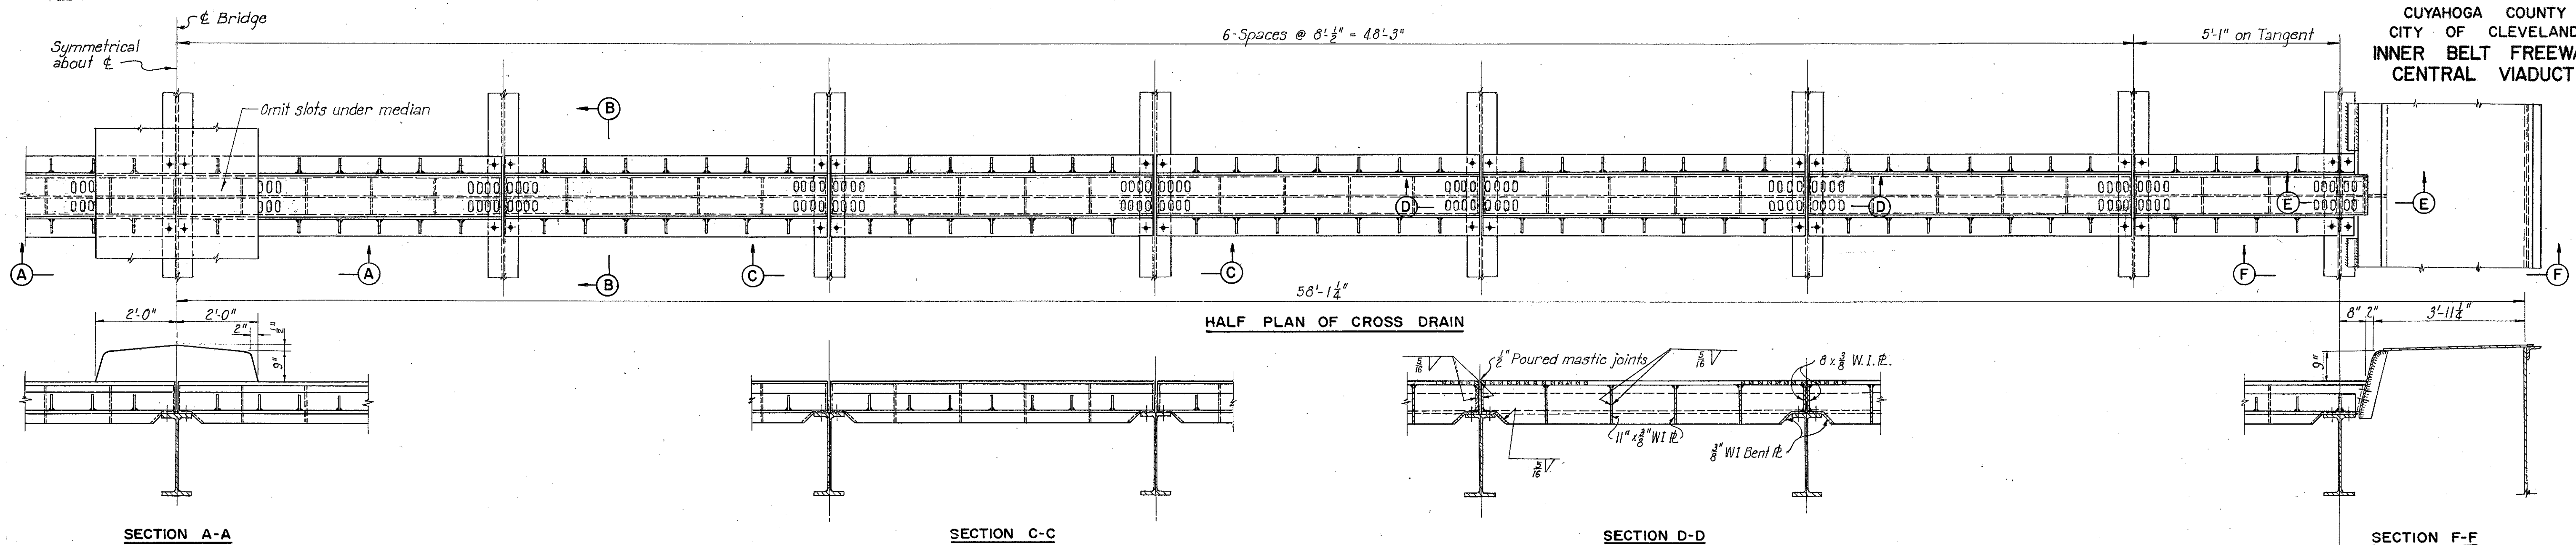


CROSS DRAIN WITH FRAMING CENTERED UNDER ROADWAY DECK

Panel Points 104, 107, 110, 303, 906 and 910

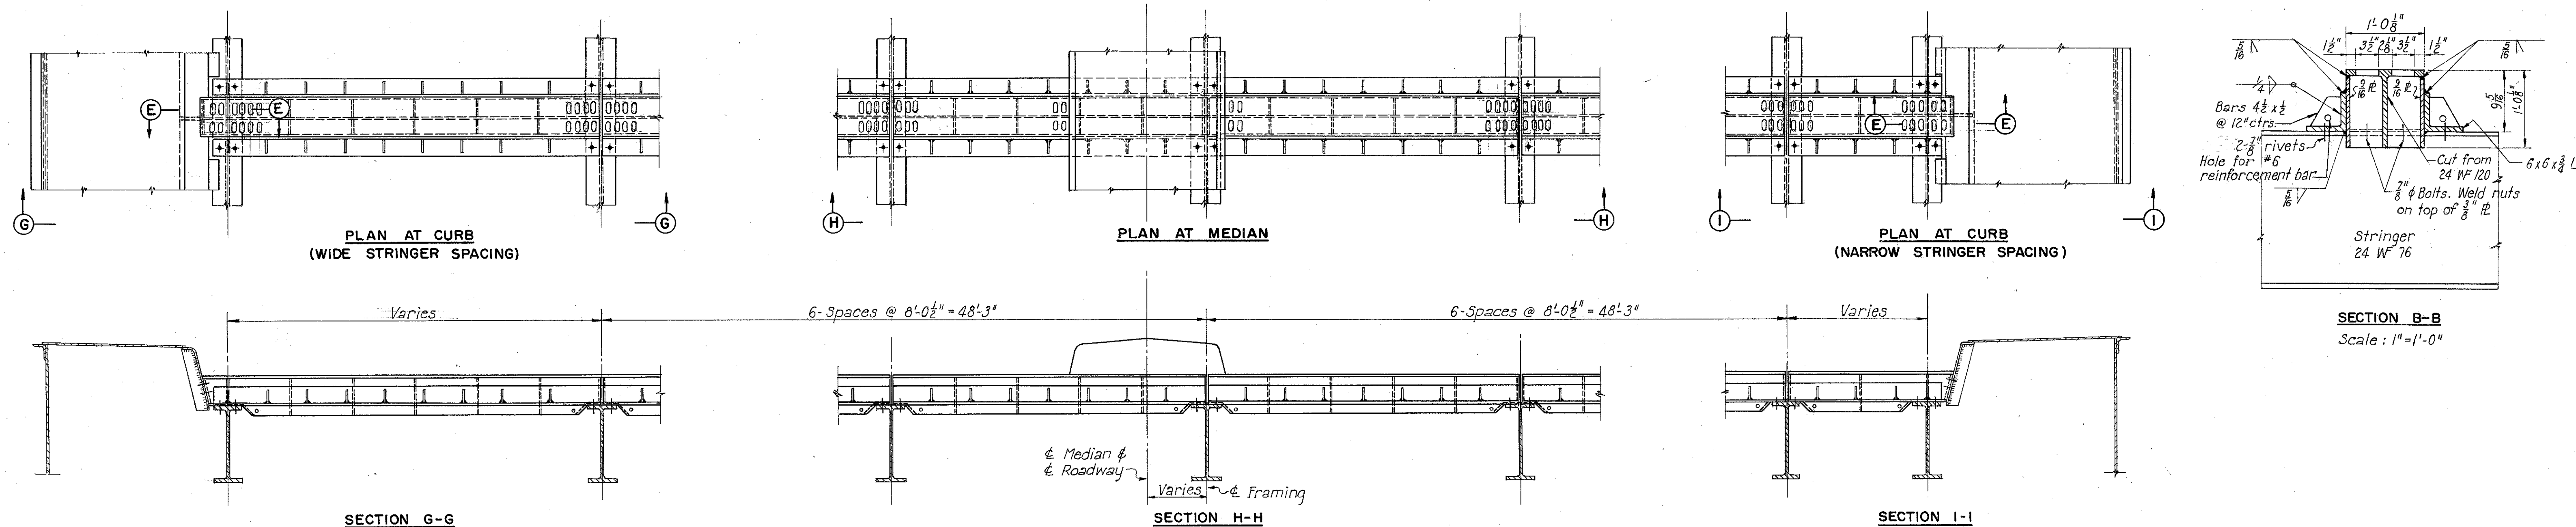


CROSS DRAIN WITH FRAMING NOT CENTERED UNDER ROADWAY DECK

Panel Points 315, 503, 515, 703, 715 and 903.

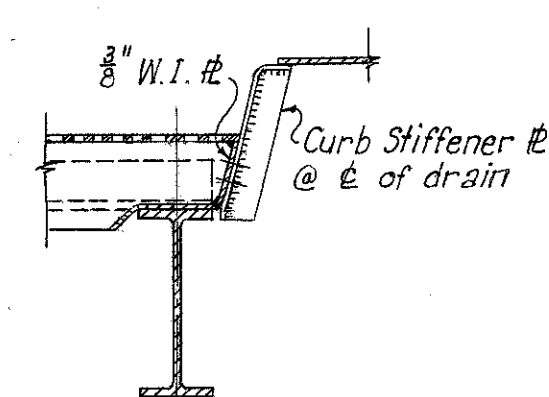

SECTION E-E

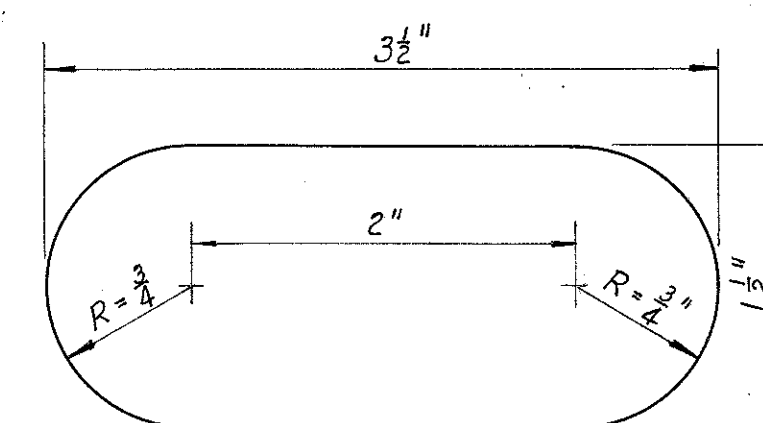

DETAIL OF DRAIN HOLE

Scale: Full Size

PART 3

U. S. ROUTE 42 RELOCATION
INNER BELT FREEWAY - CENTRAL VIADUCT
BR. NO. CU - 42 R-17 5


ROADWAY DRAINS TYPE A

CLEVELAND CUYAHOGA COUNTY OHIO


SCALE $\frac{1}{2}'' = 10'$ except as shown
MADE VCA DATE 3-2-54
TRCD AH DATE 11-16-54
CKD DMD DATE 11-18-54

HOWARD, NEEDLES, TAMMEN & BERGENDOFF
CONSULTING ENGINEERS
KANSAS CITY CLEVELAND NEW YORK
914-1A SHEET- 2.105

CUYAHOGA COUNTY
CITY OF CLEVELAND
INNER BELT FREEWAY
CENTRAL VIADUCT

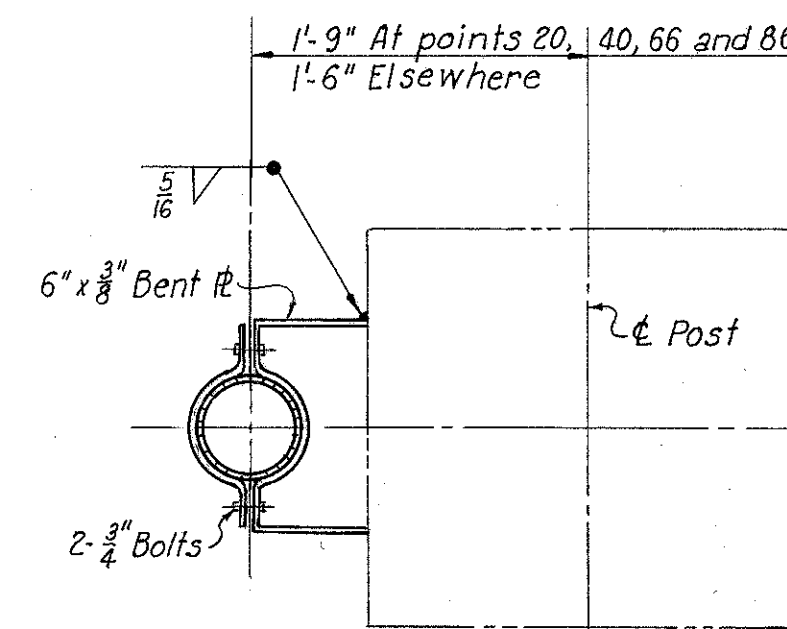

SECTION D-D
Scale: 1"=1'-0"

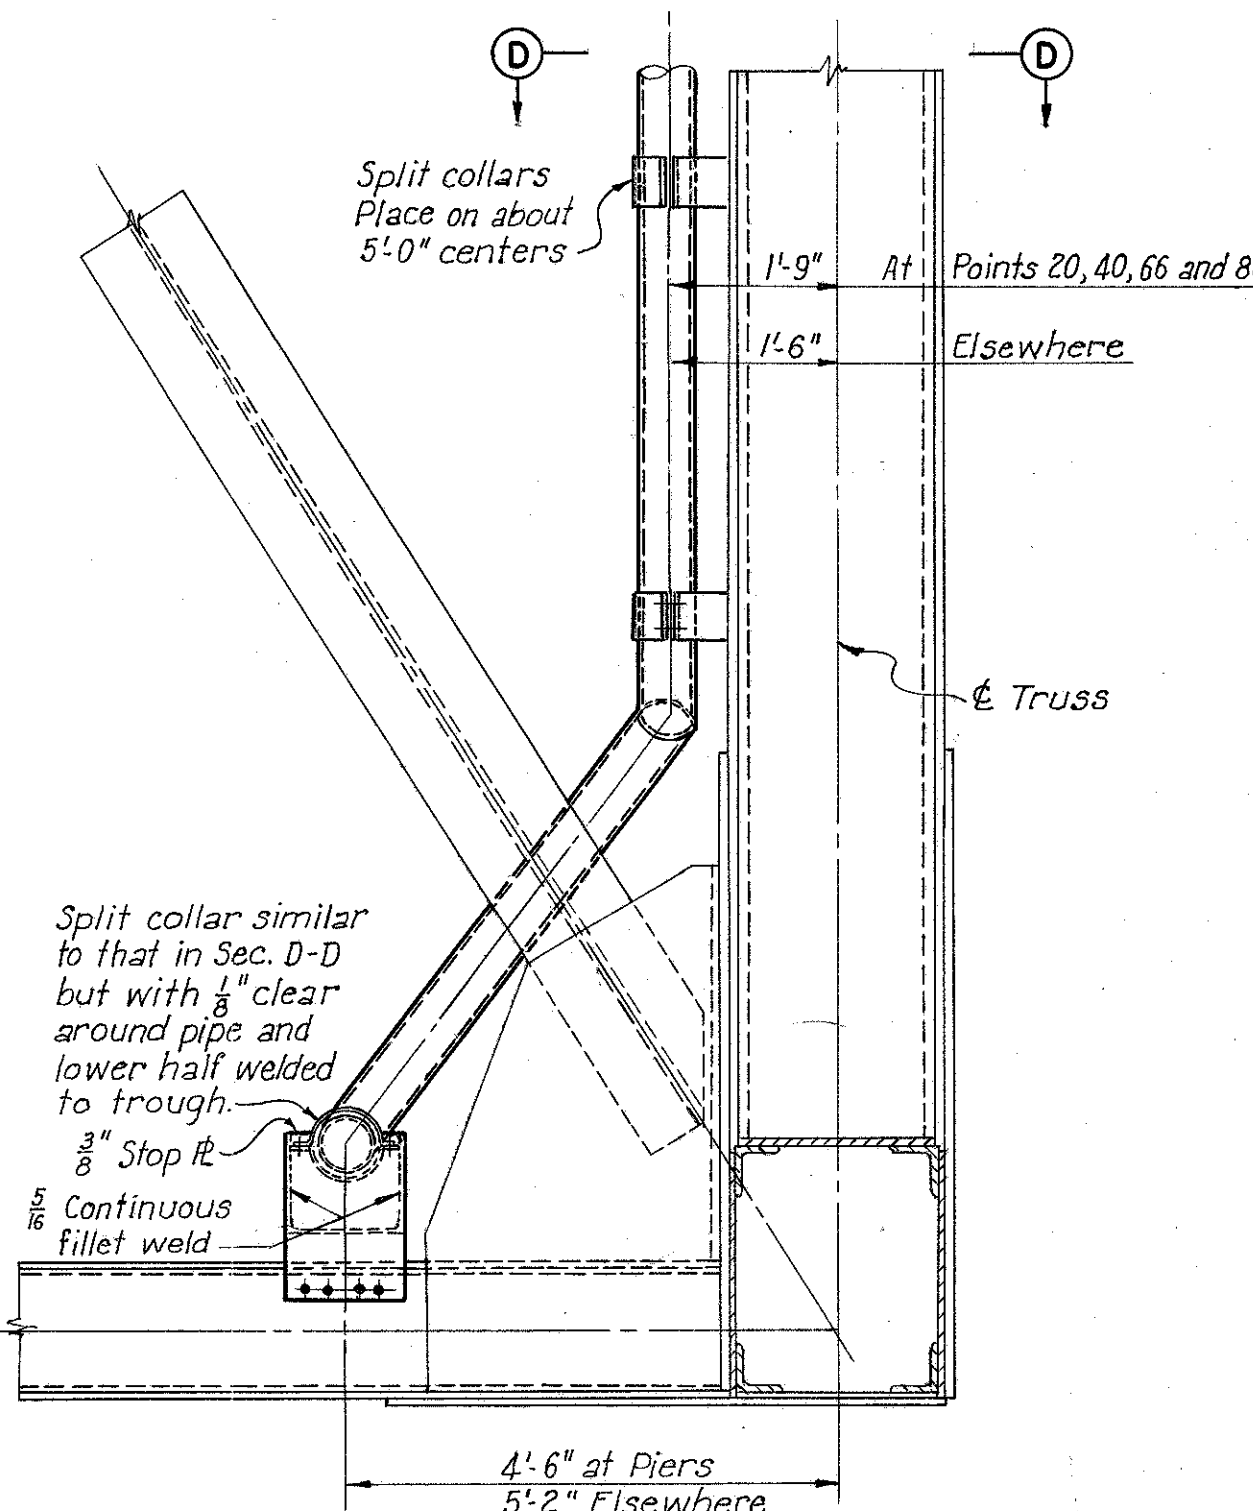

SECTION B-B
Scale: 1/2"=1'-0"

Notes:
For Section A-A, see Shs. 106 and 108.
All bolts to have lock washers.
All trough to be of 8" W.I. R.
Where wrought iron is specified on sheets 104 to 109 for flashing, troughs, hoppers, or downspouts, the contractor may use Mayari R or Corten steel instead at his option.

PART 3

U. S. ROUTE 42 RELOCATION
INNER BELT FREEWAY - CENTRAL VIADUCT
BR. NO. CU - 42R-17 5


ROADWAY DRAINAGE SYSTEM
COLLECTION TROUGHS

CLEVELAND CUYAHOGA COUNTY OHIO

SCALE: As shown
MADE VEA DATE: 2-3-54
TRCD. AH DATE: 11-8-54
CKD. DMD DATE: 11-2-54


HOWARD, NEEDLES, TAMMEN & BERGENDOFF
CONSULTING ENGINEERS
KANSAS CITY CLEVELAND NEW YORK

914-1A SHEET 2.104

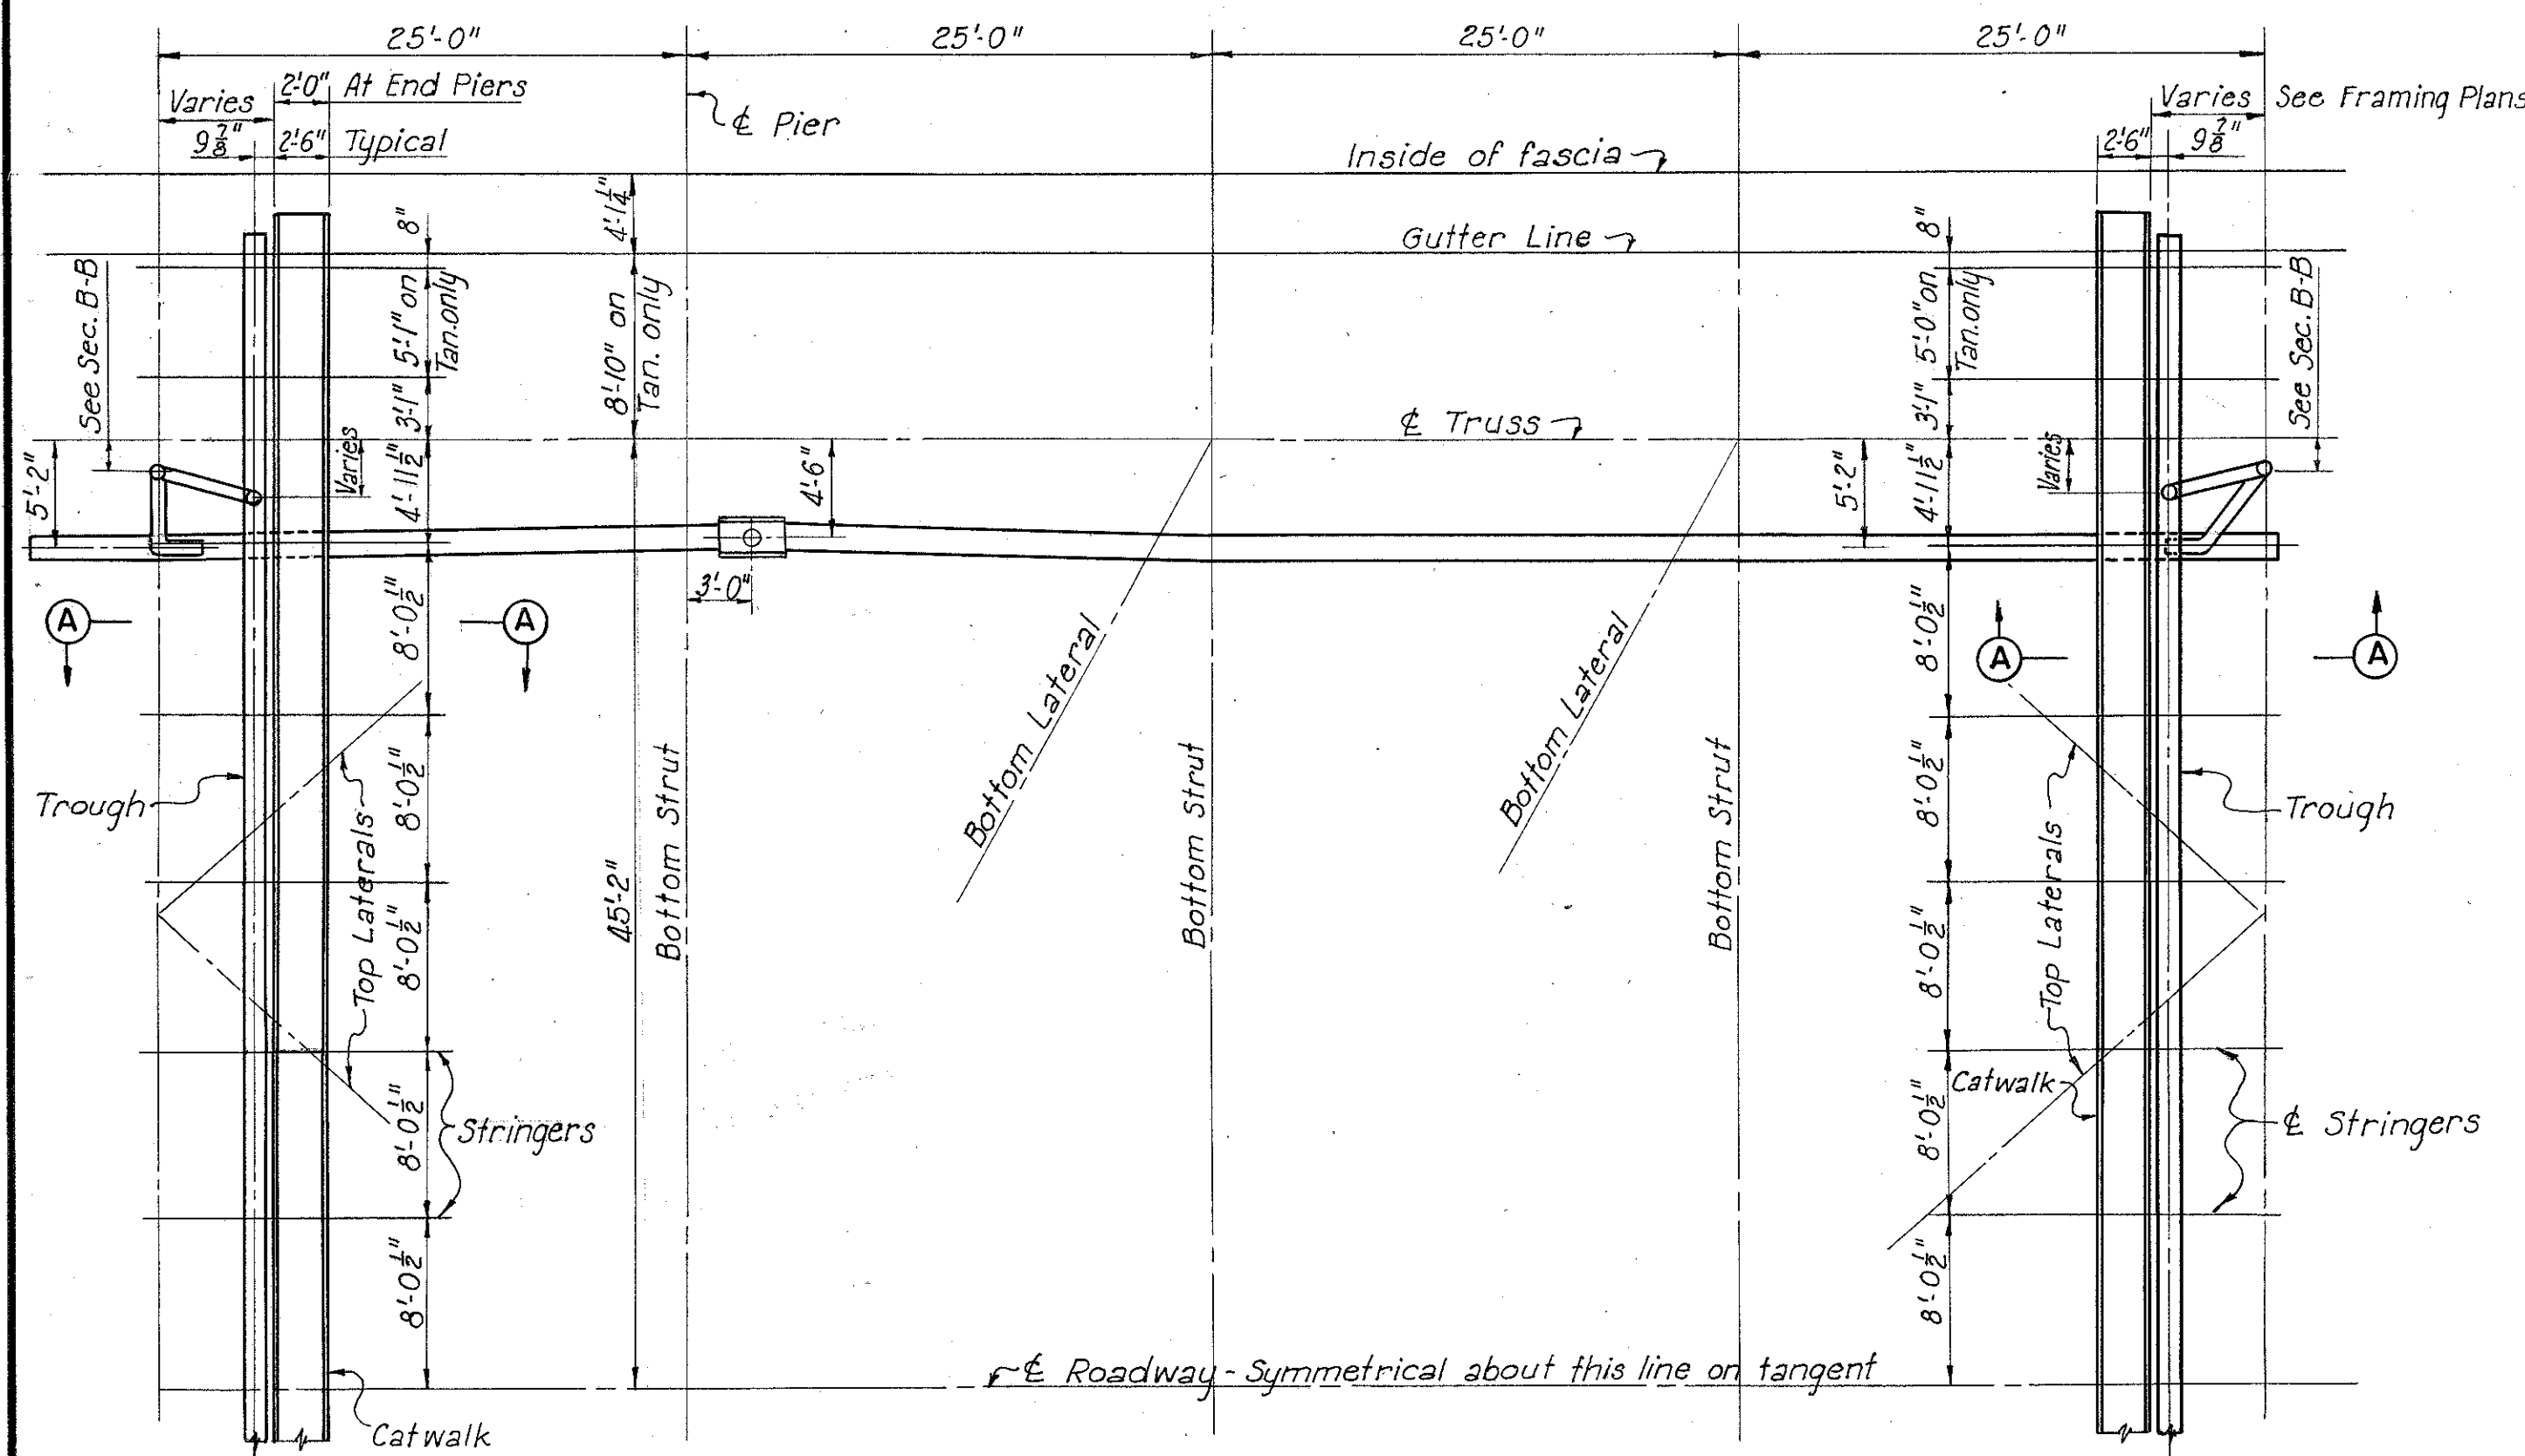


TYPICAL PLAN
Scale: 1/8"=1'-0"


MICROFILMED
FEB 16 1983

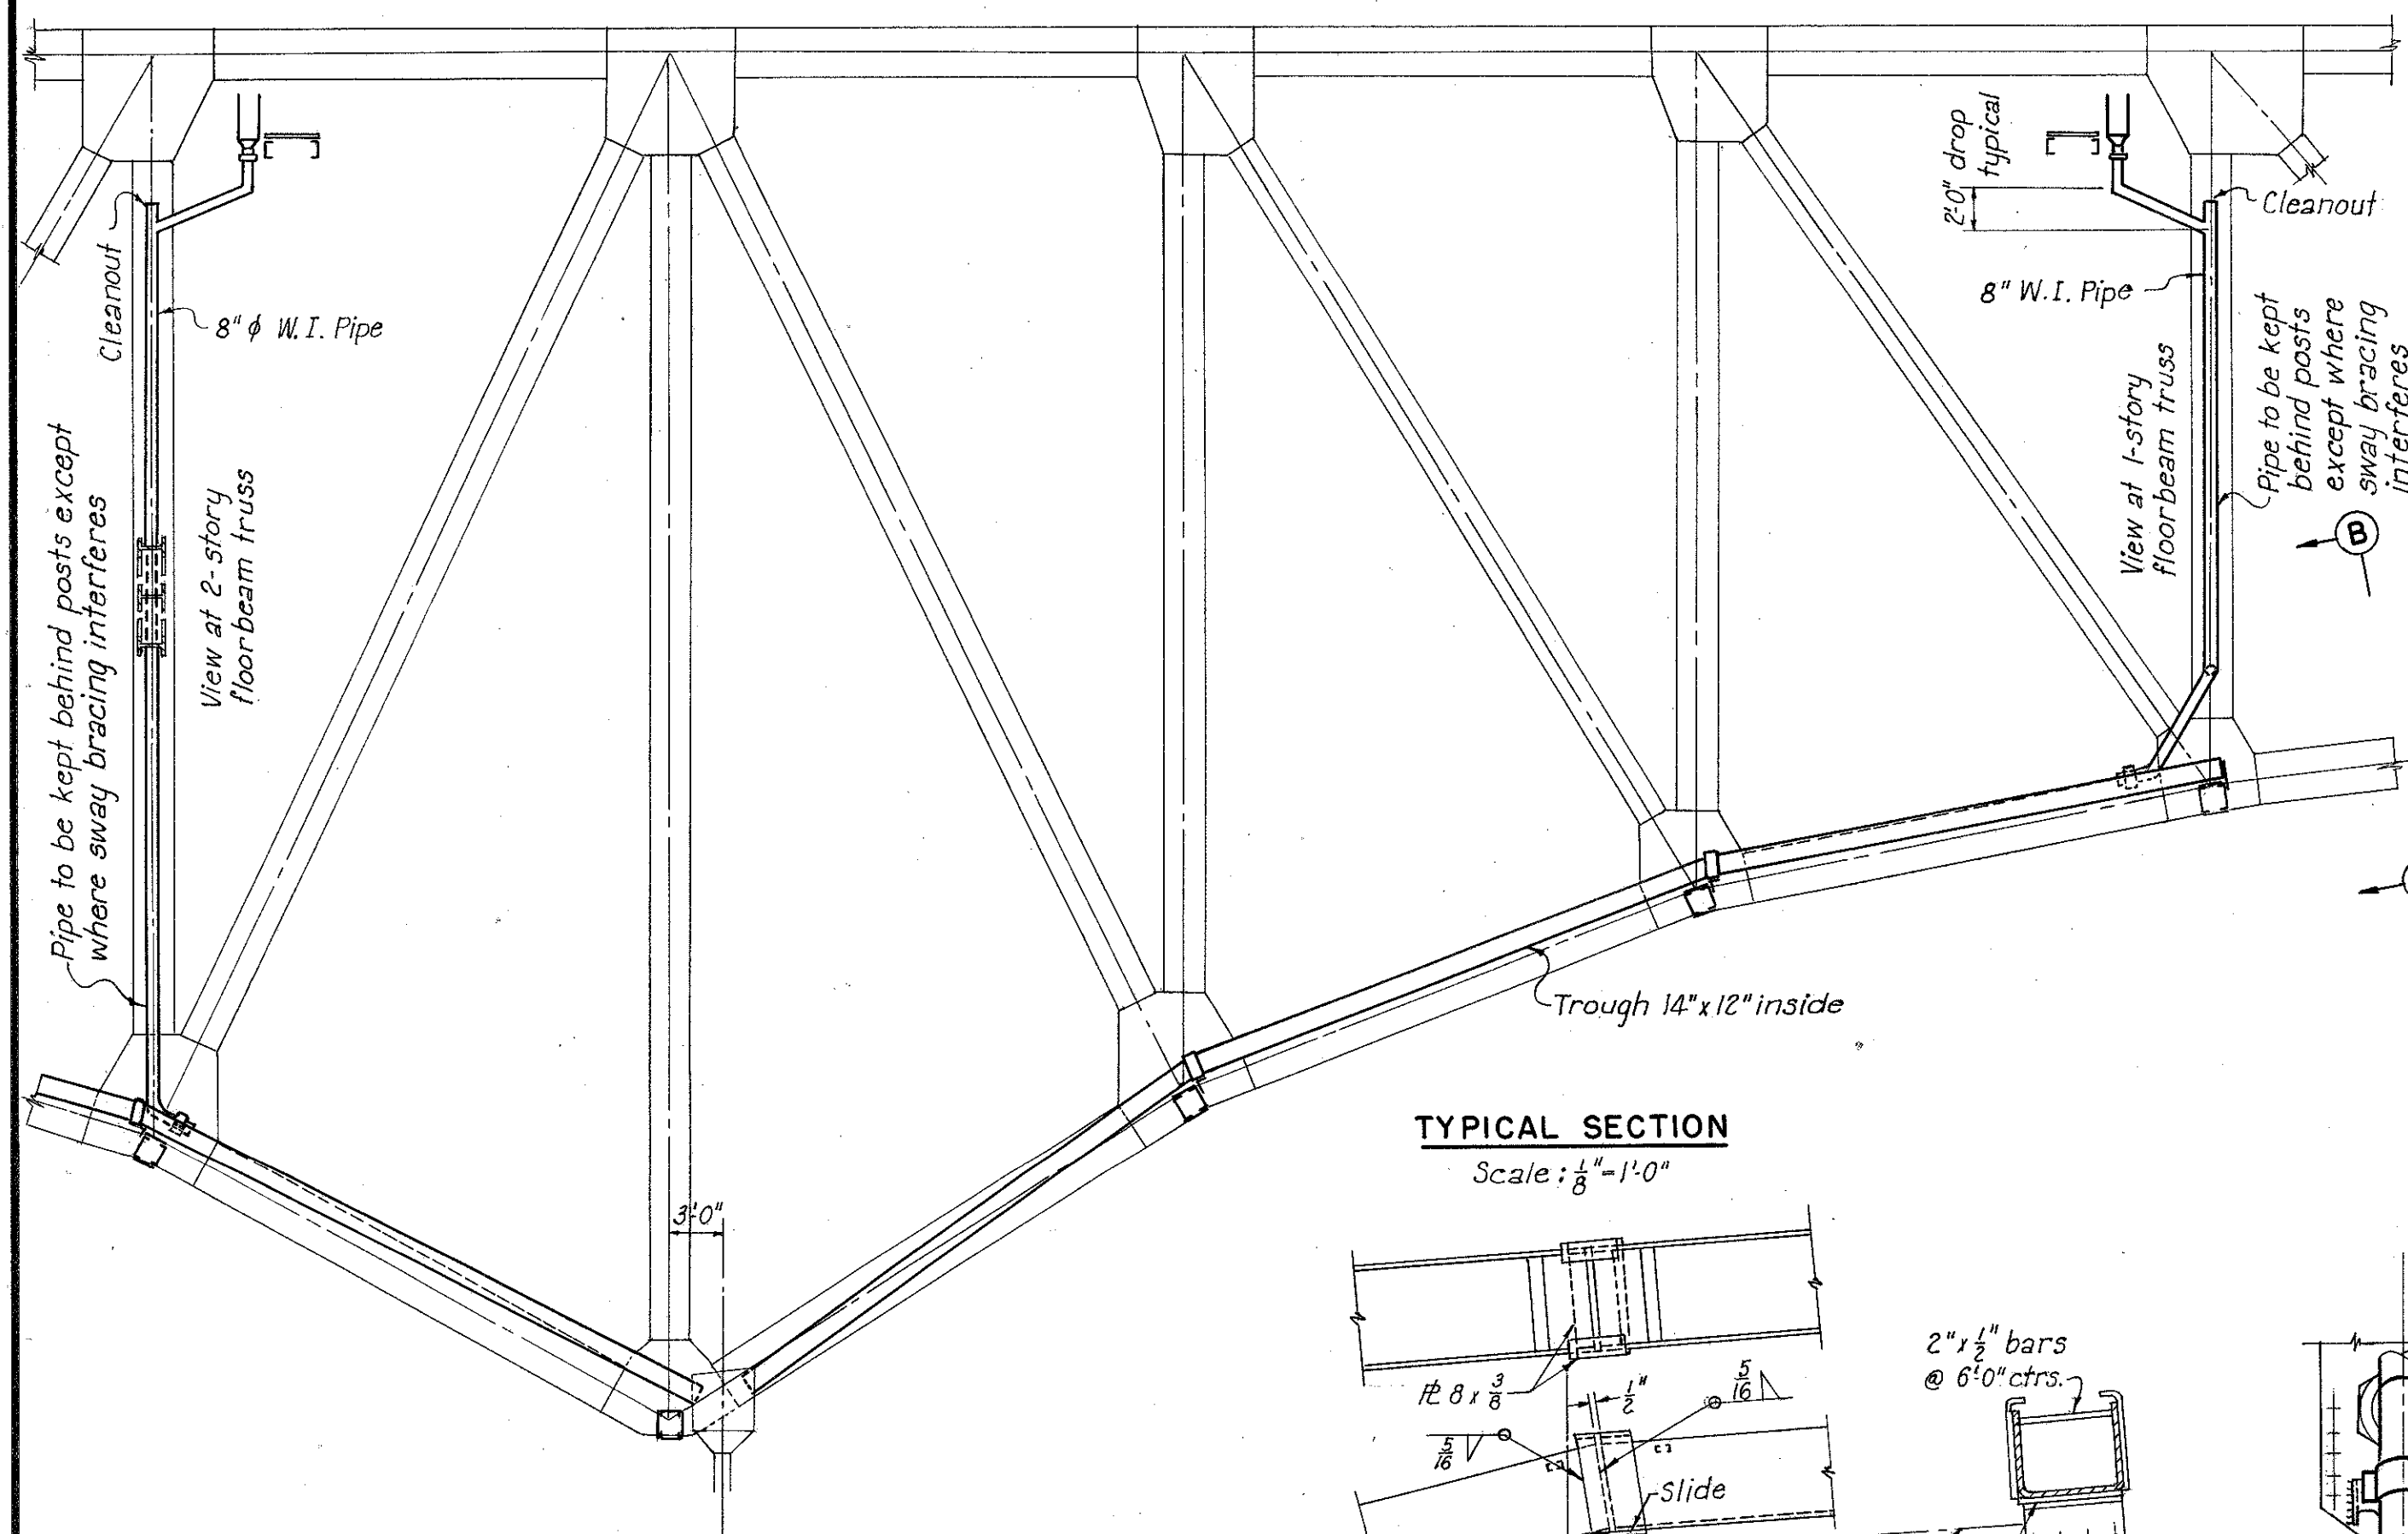

TYPICAL SECTION
Scale: 1/8"=1'-0"

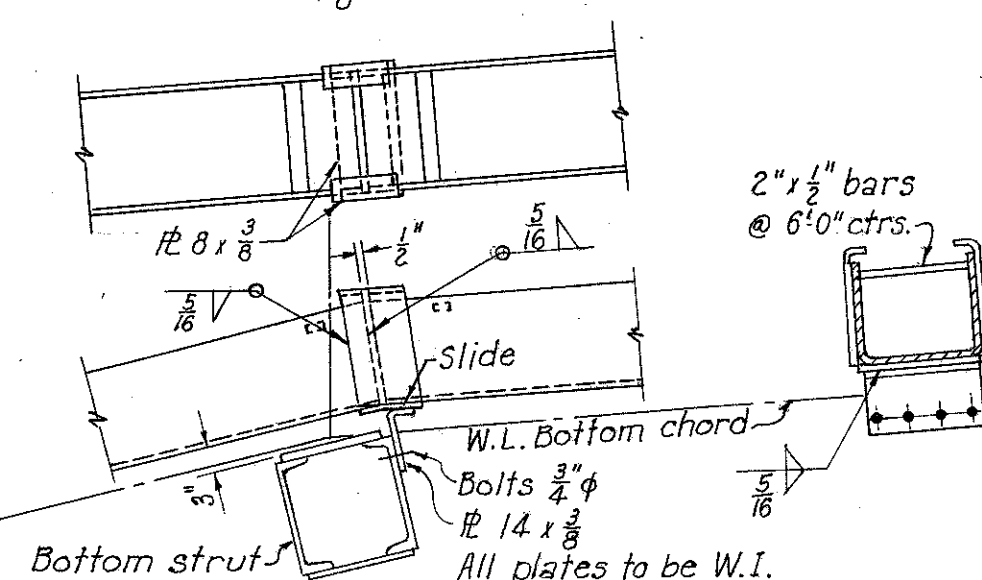


TROUGH SUPPORT AT
BOTTOM STRUTS

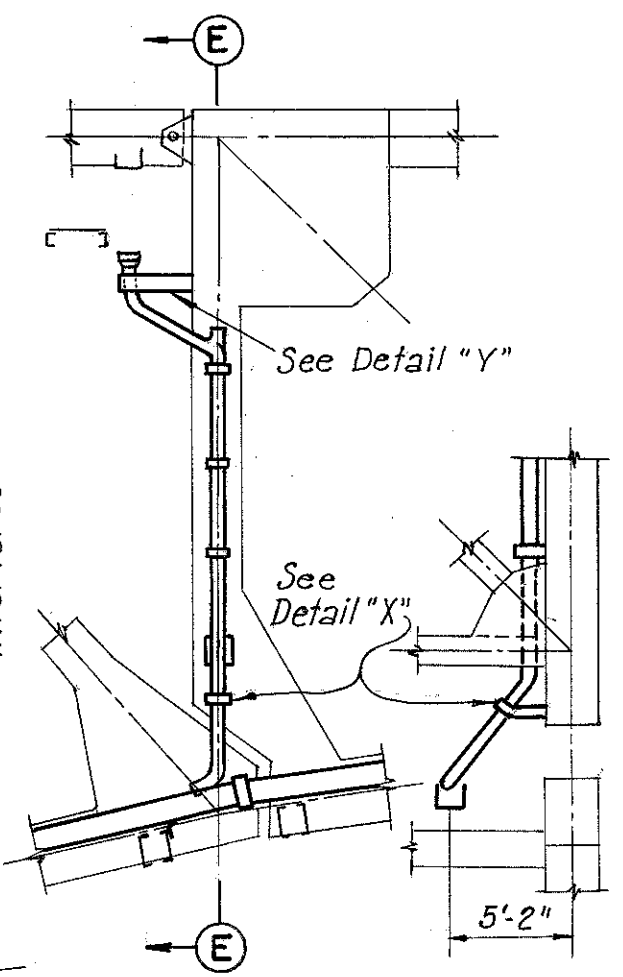

SECTION E-E
Scale: 1/8"=1'-0"


East End Pier is shown. At West End Pier the trough is omitted and the downspout goes down into the hopper as shown dotted with a typical split collar at the bottom strut.
Hopper is of typical construction. Split cover at spout.

SECTION AT END PIERS
Scale: 1/8"=1'-0"

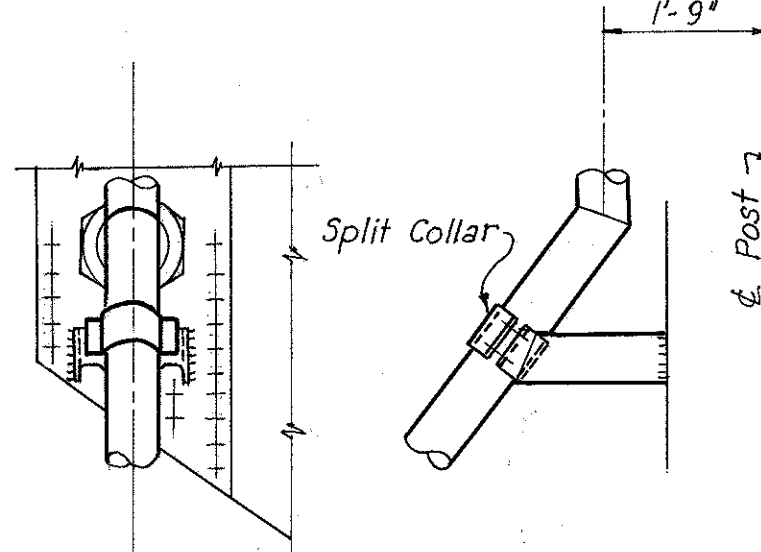

DETAIL "X"
Scale: 1/2"=1'-0"


DETAIL OF HOPPER
Scale: 1/4"=1'-0"

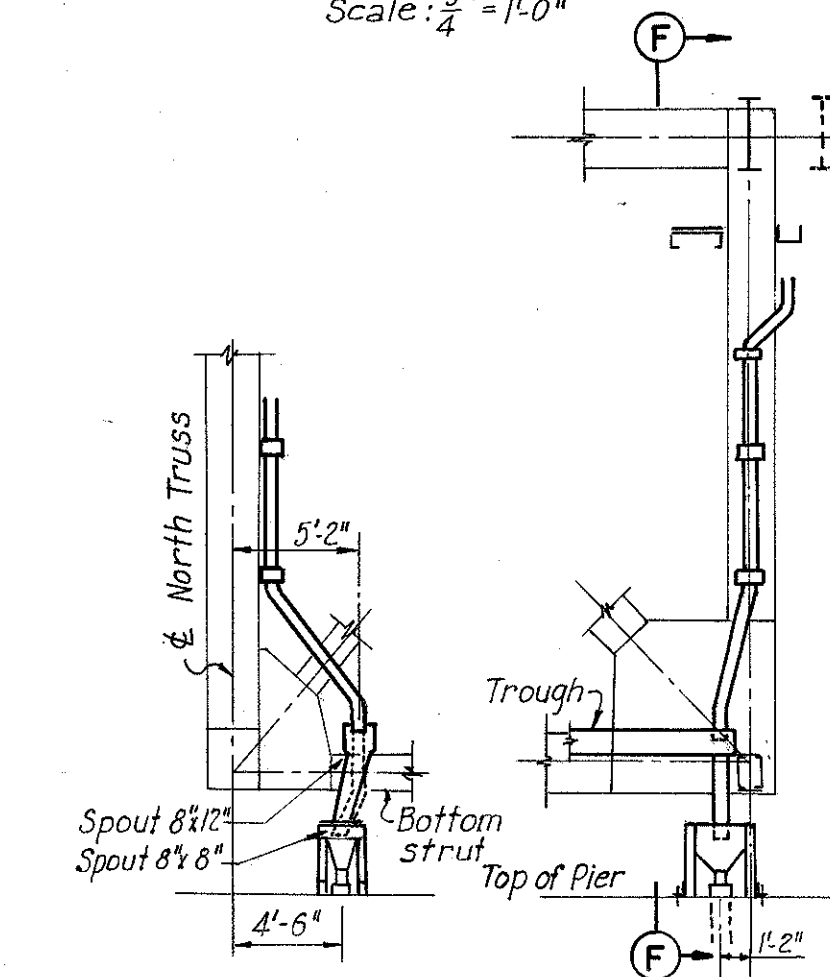


SECTION F-F

ELEVATION

SECTION C-C

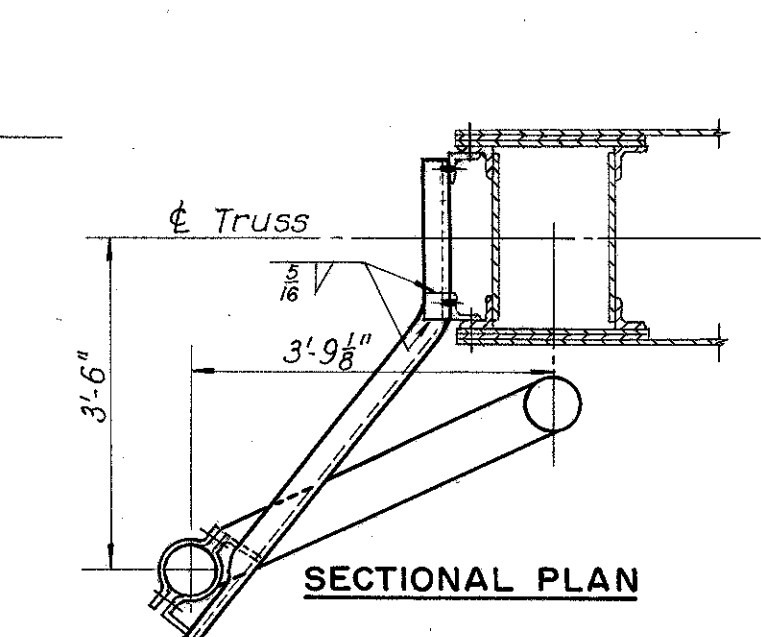

SECTIONAL PLAN

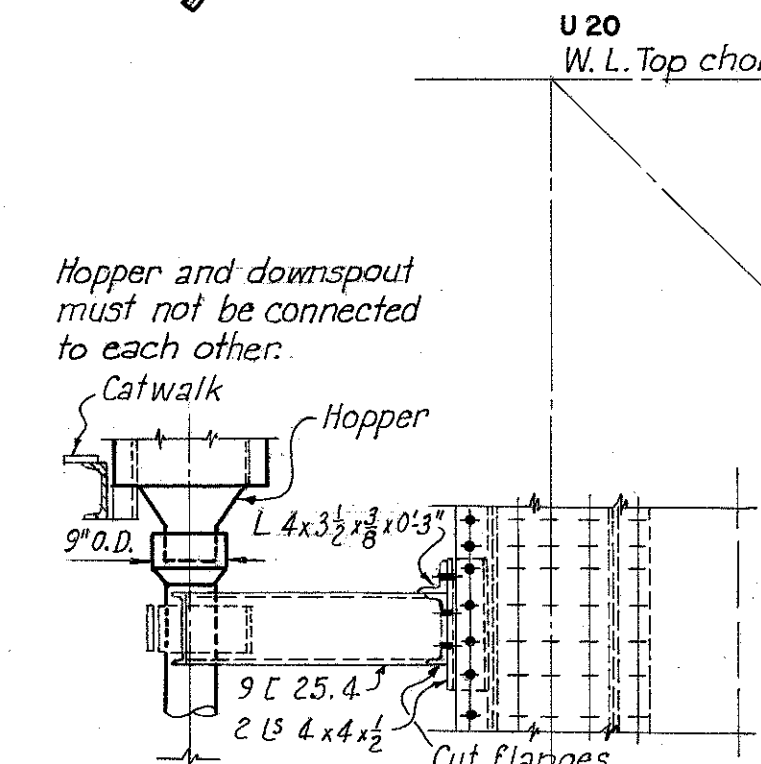

ELEVATION

DETAIL "Y"
Scale: 1/2"=1'-0"


Drawn for panel point 113-20.
Typical for 318-40, 66-700
and 86-900.

RECORDED
FEB 16 1953


FED. ROAD DIV. NO.	STATE	FEDERAL AID PROJECT NO.	TYPE FUNDS
2	OHIO		

103
122


CUYAHOGA COUNTY
CITY OF CLEVELAND
INNER BELT FREEWAY
CENTRAL VIADUCT

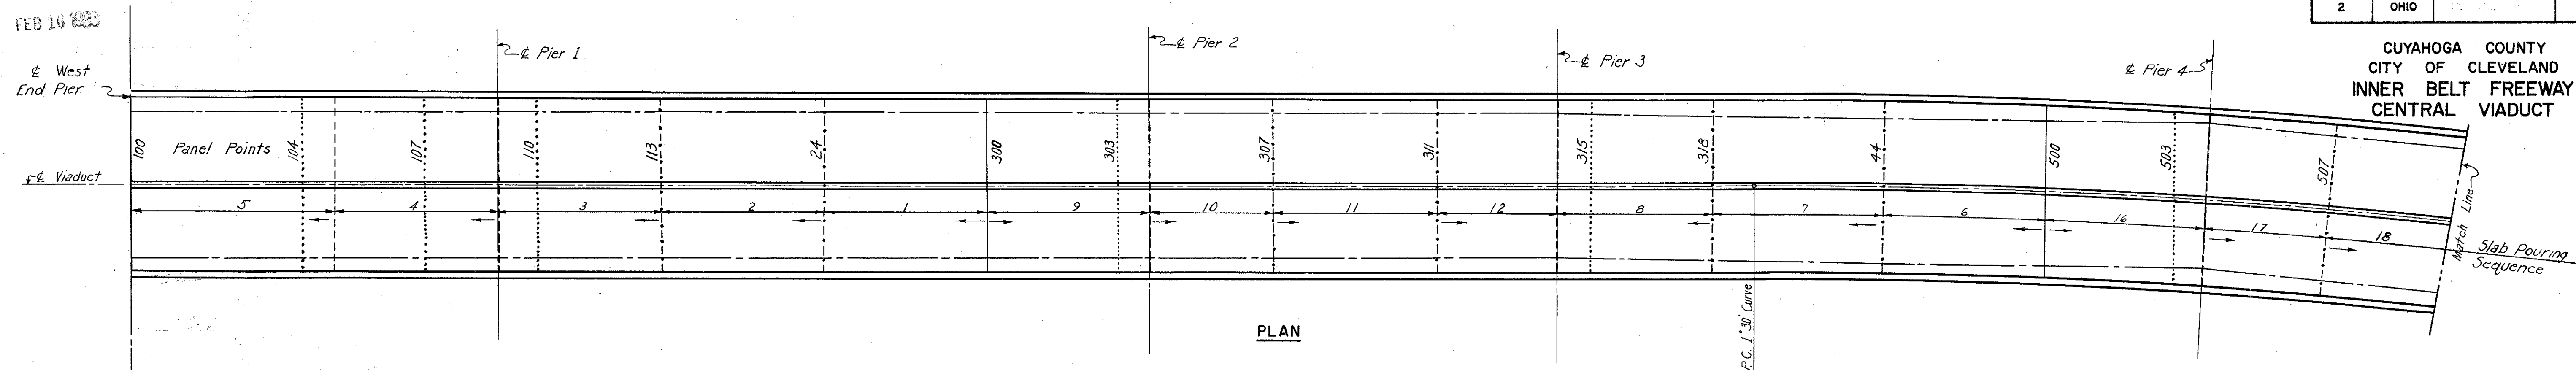


PLAN

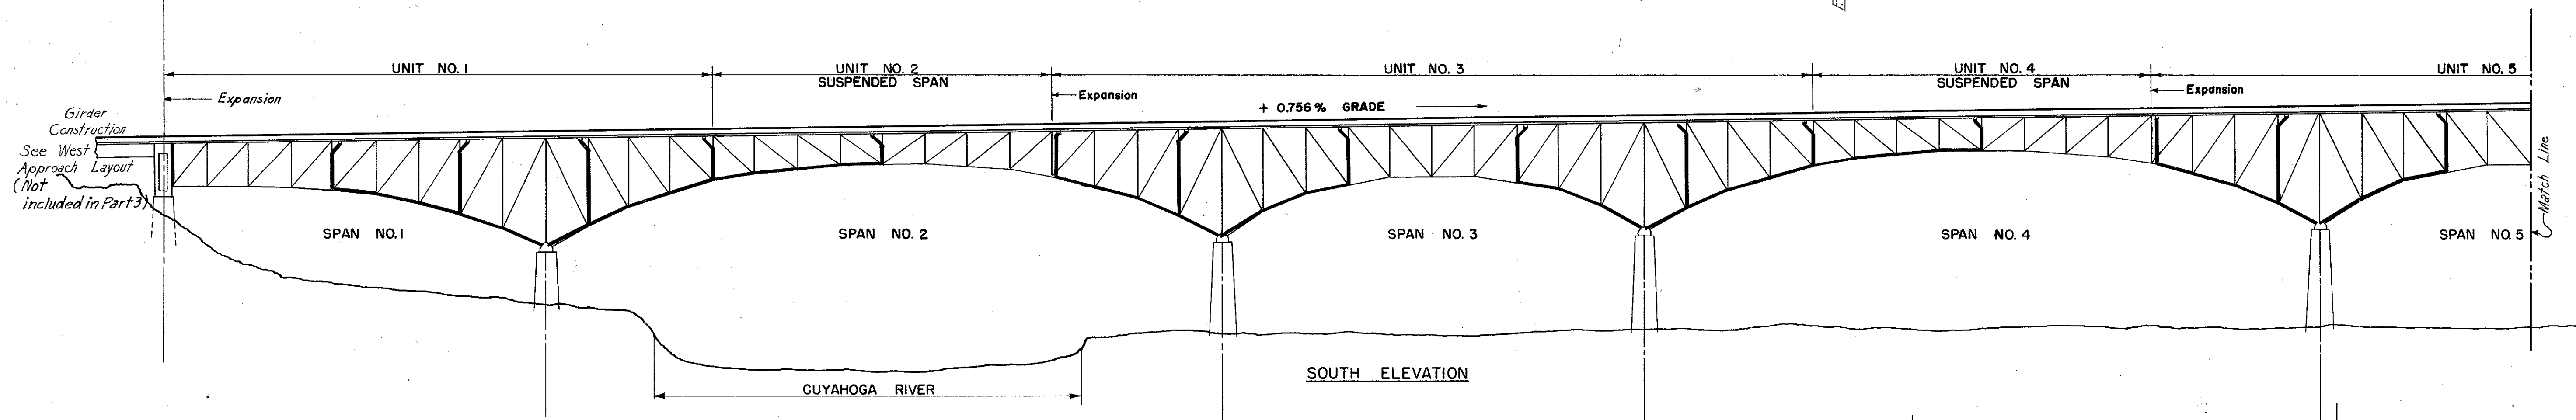

SOUTH ELEVATION

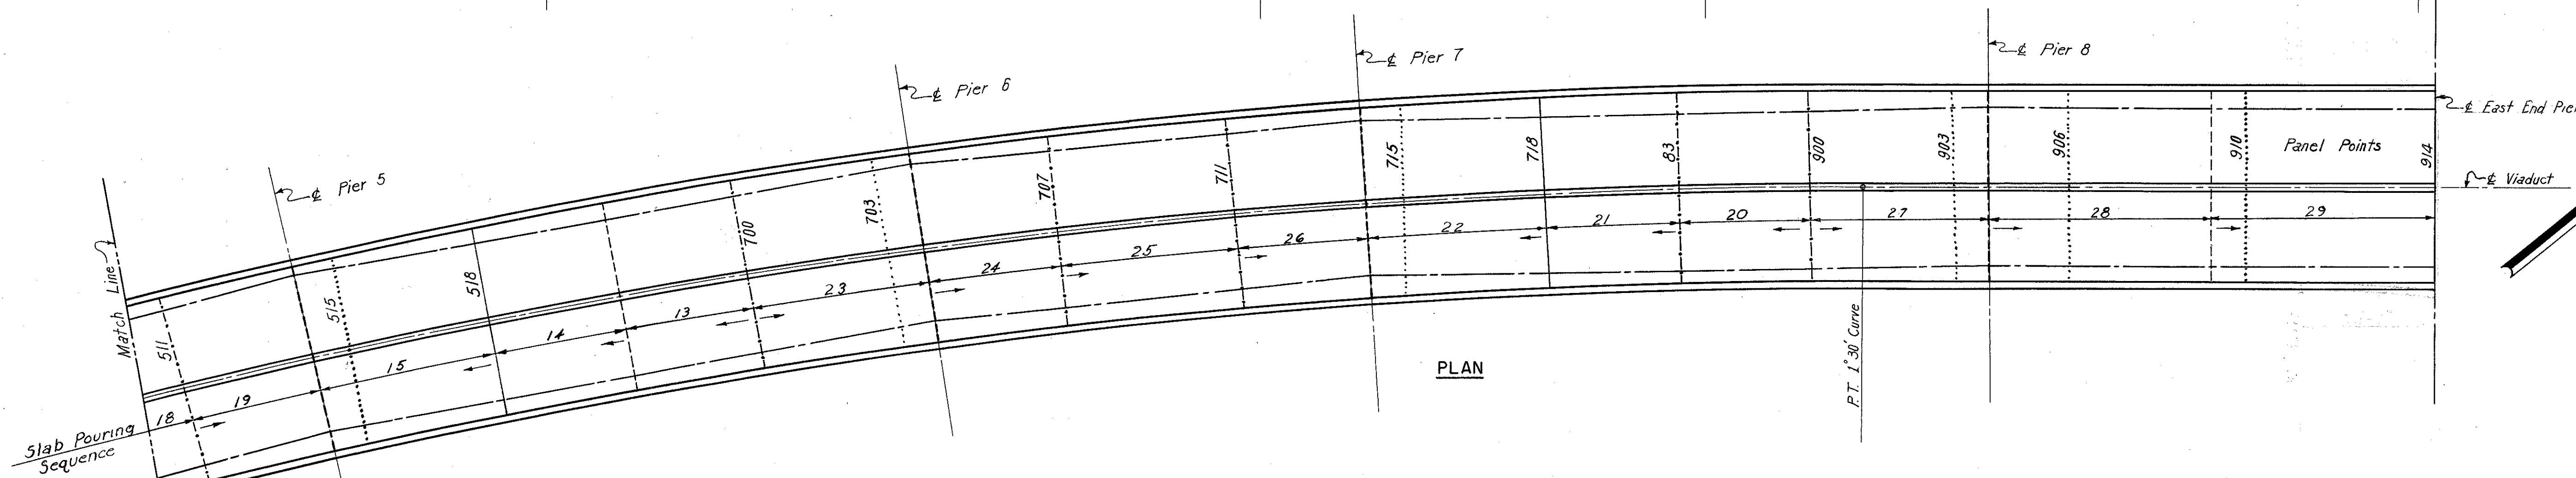

PLAN

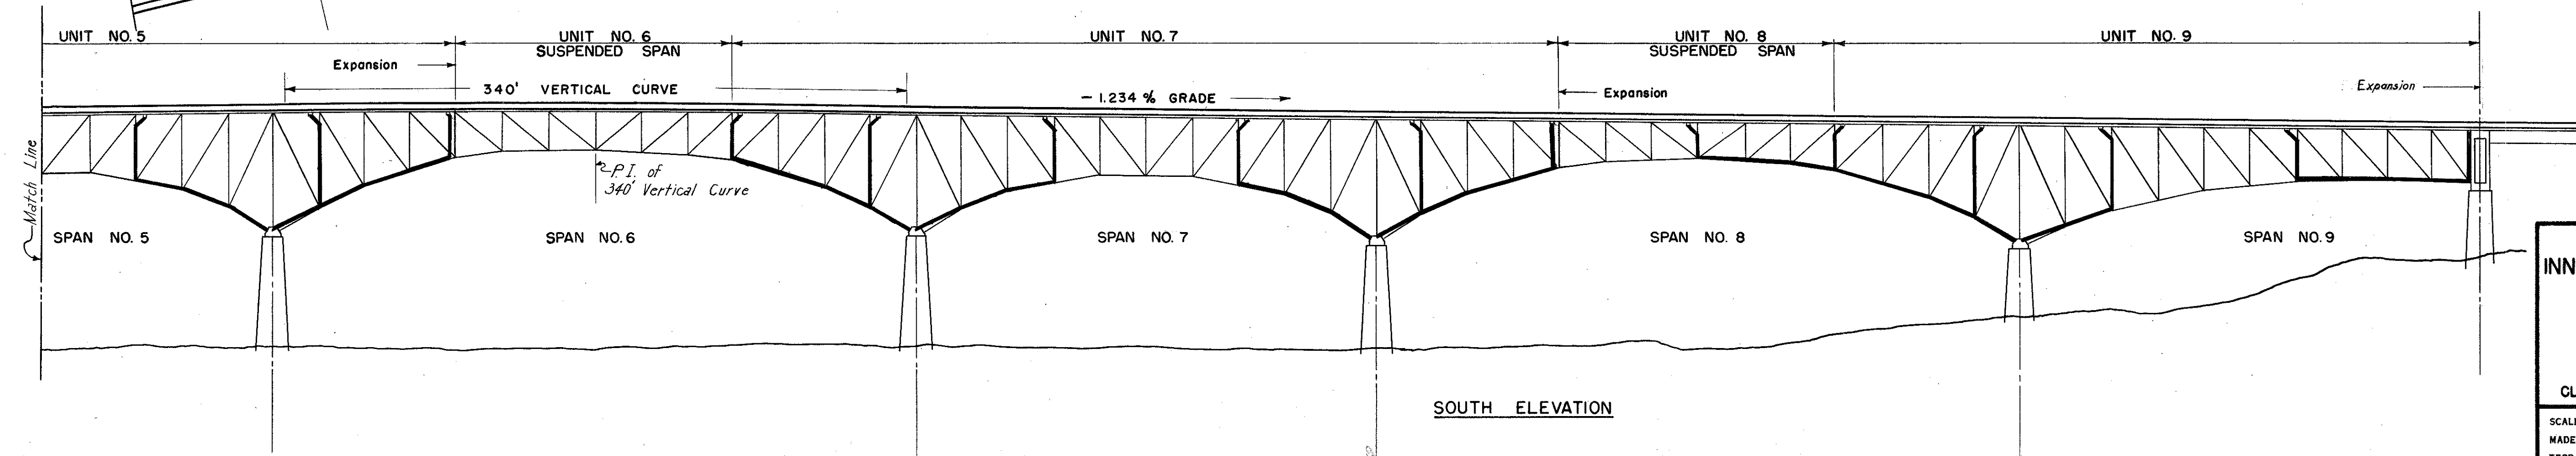

SOUTH ELEVATION

LEGEND

- Cross Drain Type A, see Sheets 105, 106 and 114.
- Cross Drain Type B, contraction joint. See Sheets 107, 108 and 114.
- Cross drain Type C at expansion joint. See Sheets 109 to 113.
- Contraction joint - no drain. See Sheet 114.

PART 3

U. S. ROUTE 42 RELOCATION
INNER BELT FREEWAY - CENTRAL VIADUCT
BR. NO. CU - 42 R-175

GENERAL LAYOUT
ROADWAY DRAINAGE SYSTEM

CLEVELAND CUYAHOGA COUNTY OHIO


SCALE: 1" = 50'-0"
MADE: VEA DATE 12-28-53
TRCD: VEA DATE 2-6-54
CKD: DMD DATE 11-19-54
HOWARD, NEEDLES, TAMMEN & BERGENDOFF
CONSULTING ENGINEERS
KANSAS CITY CLEVELAND NEW YORK
914-1A SHEET 2.103

REPRODUCED
FEB 16 1953


FED. ROAD DIV. NO.	STATE	FEDERAL AID PROJECT NO.	TYPE FUNDS
2	OHIO		

102
122

CUYAHOGA COUNTY
CITY OF CLEVELAND
INNER BELT FREEWAY
CENTRAL VIADUCT

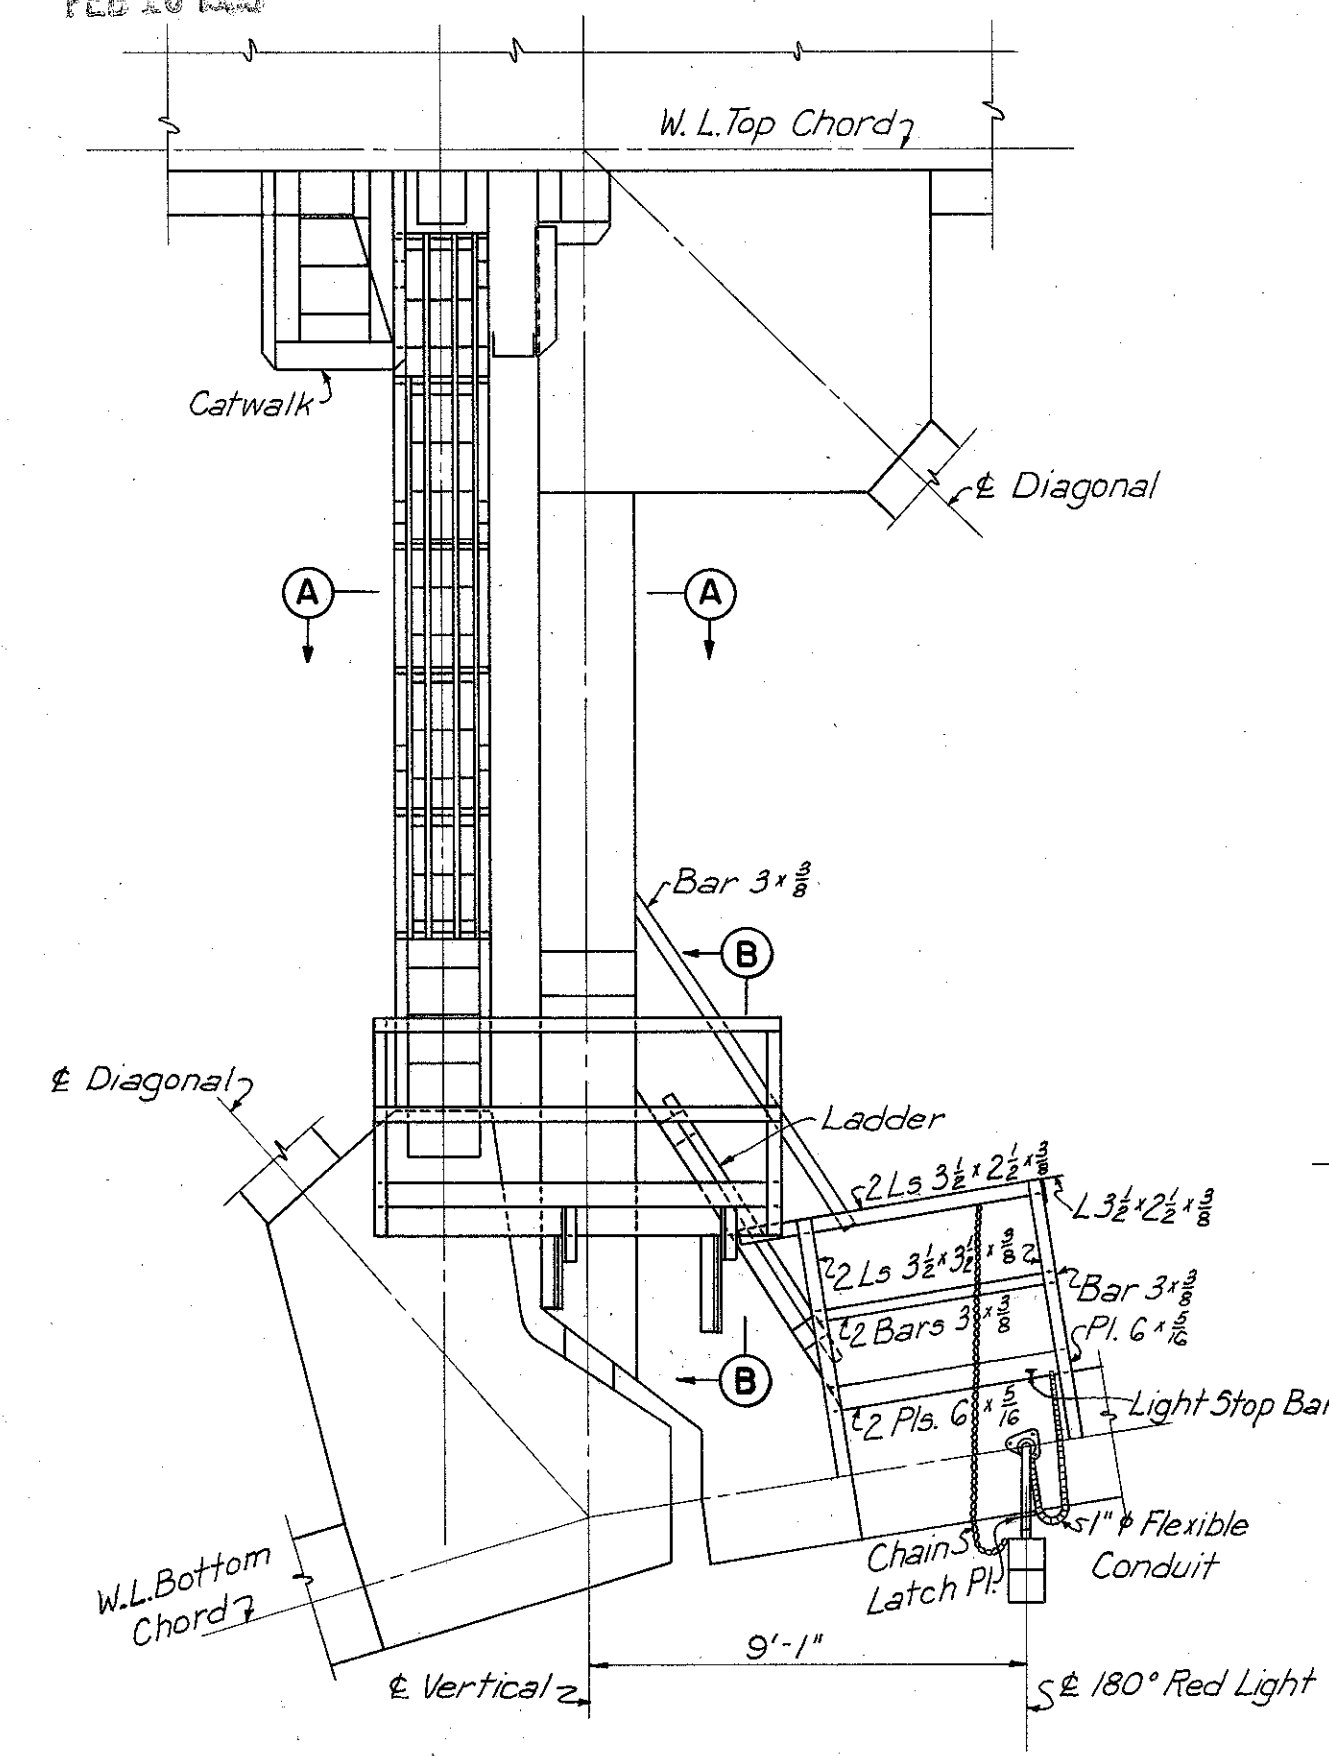


L28-U28

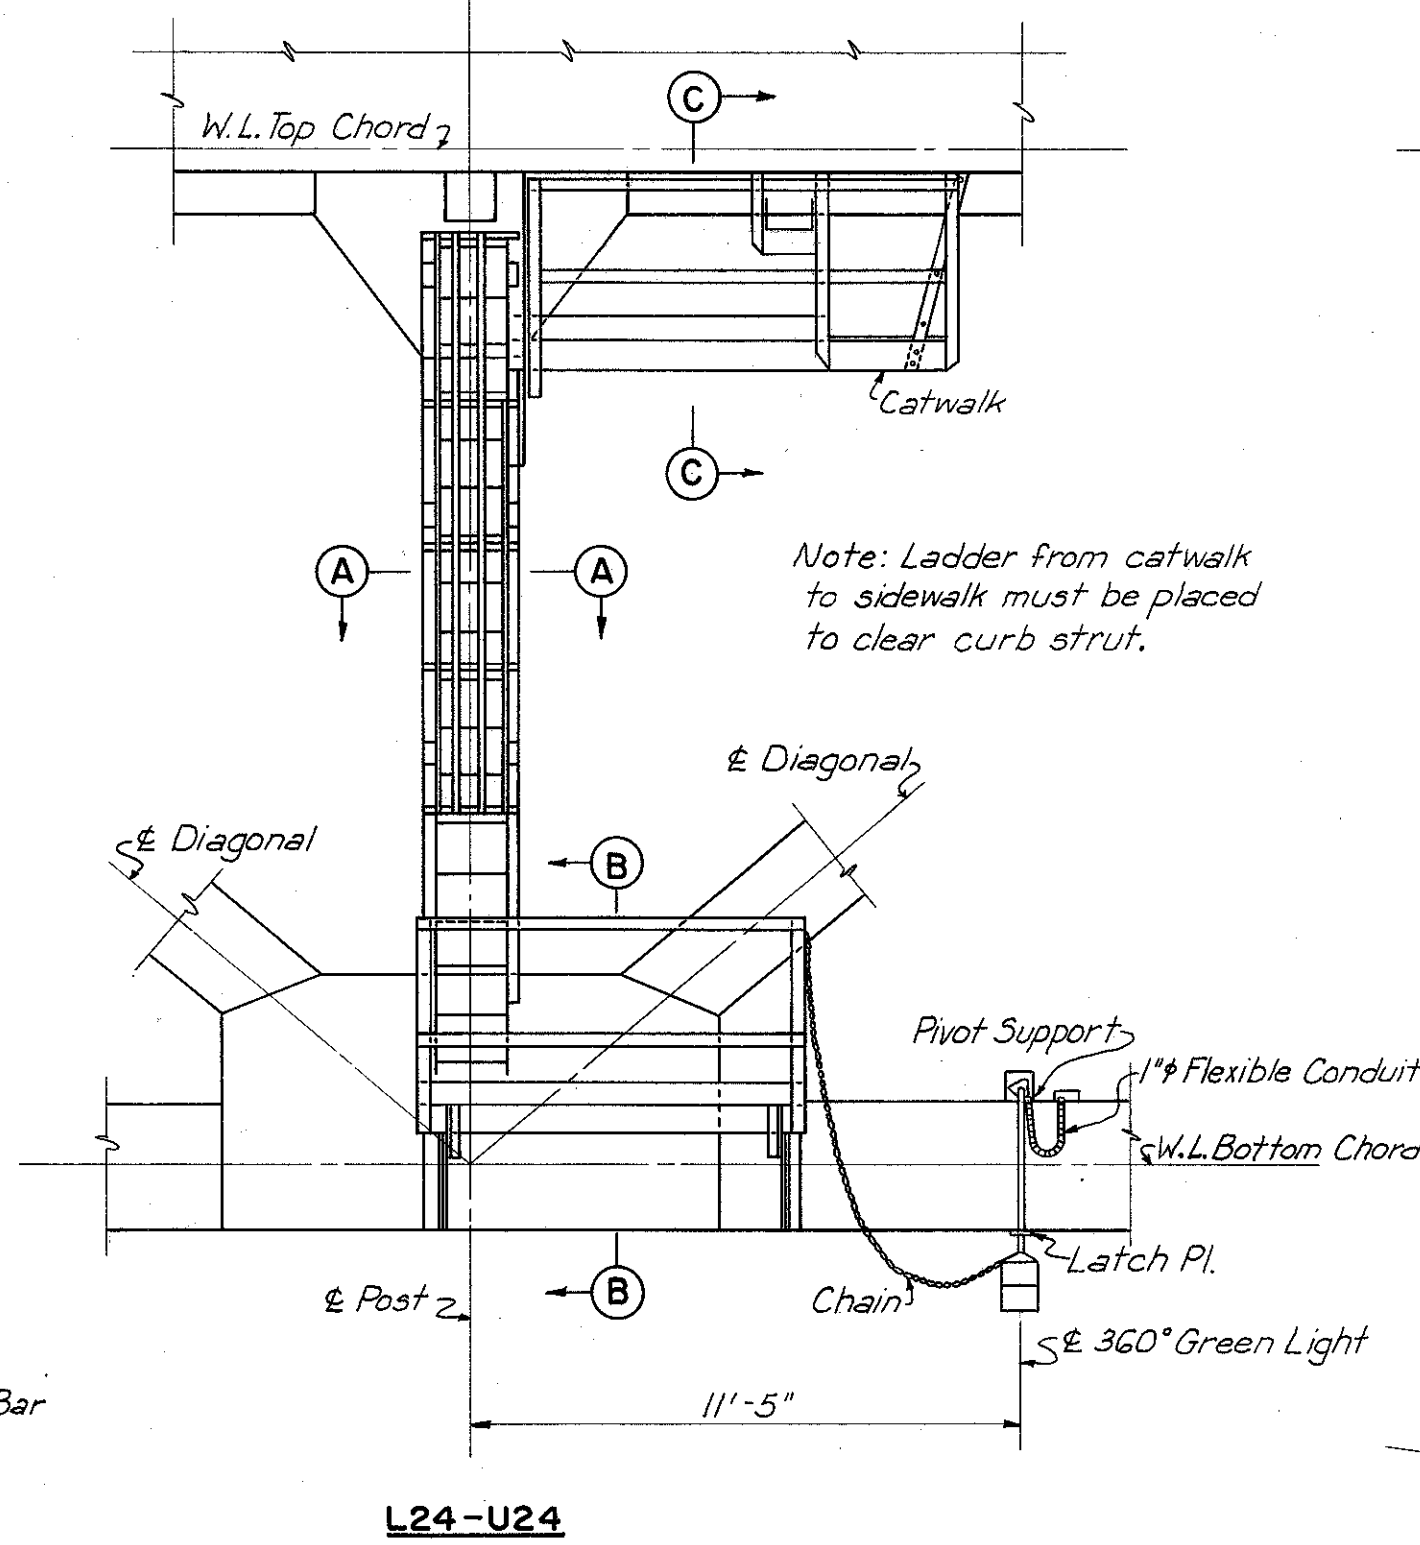


L24-U24


NORTH TRUSS UNIT NO. 2
Scale: 1/4" = 1'-0"

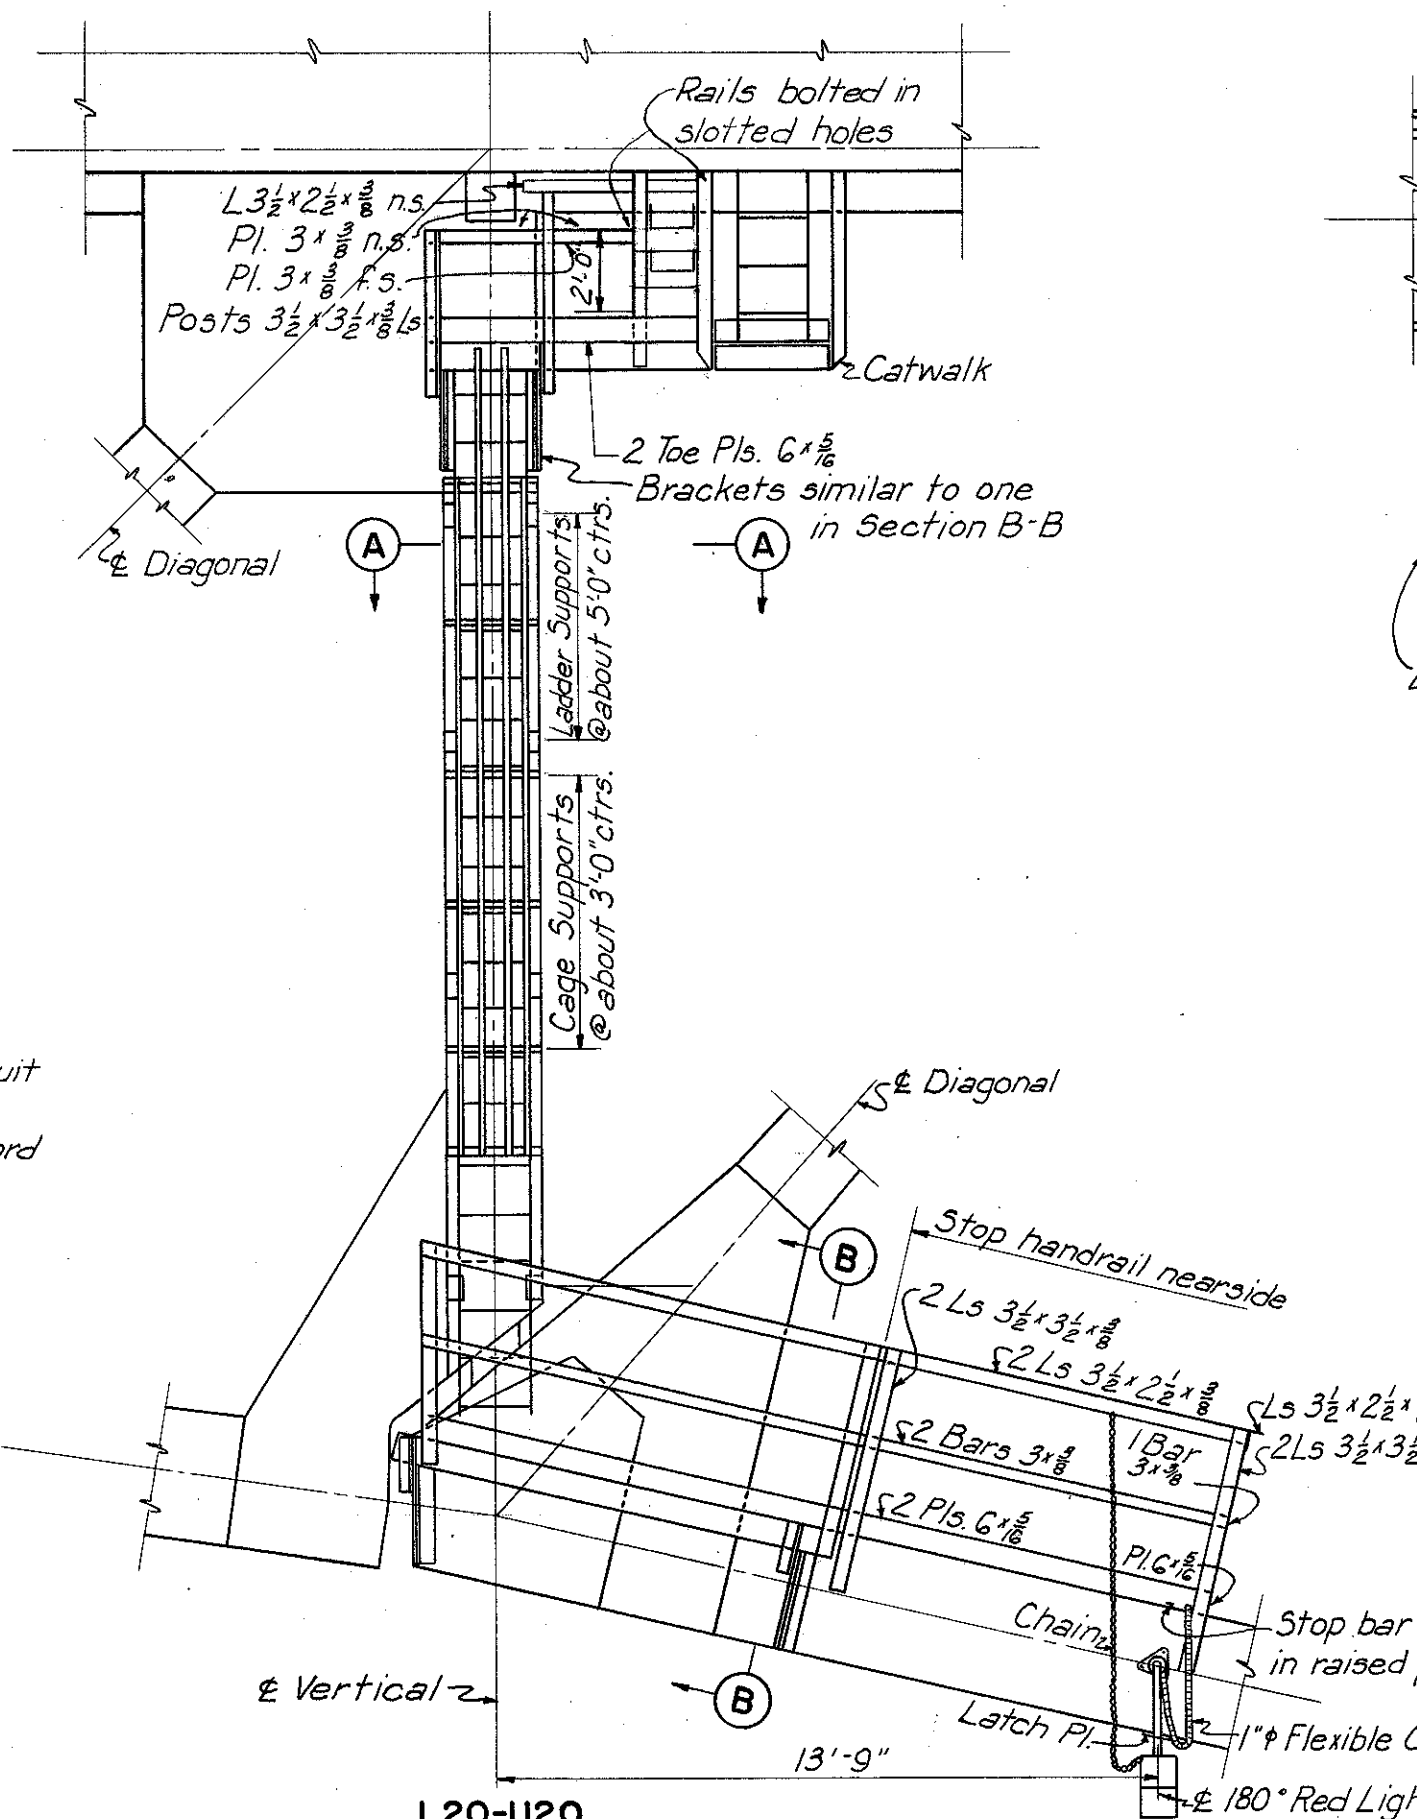


L20-U20

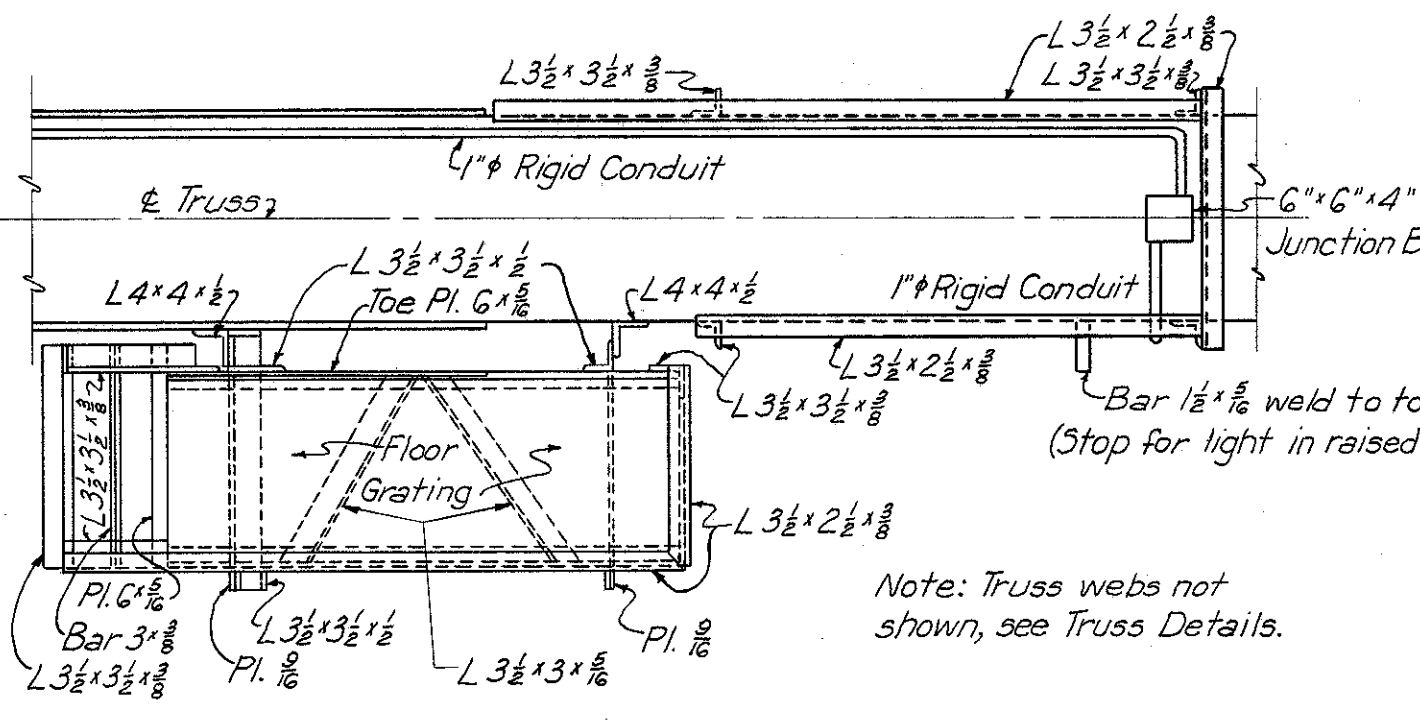


SECTION D-D
Scale: 1/2" = 1'-0"

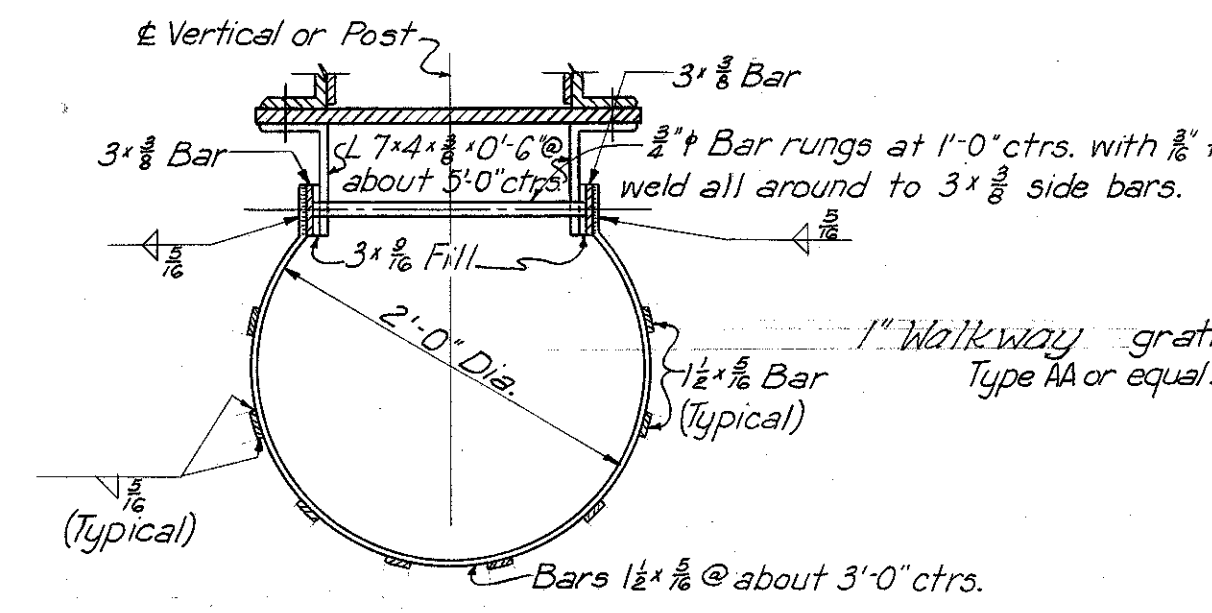


SECTION A-A
Scale: 1" = 1'-0"

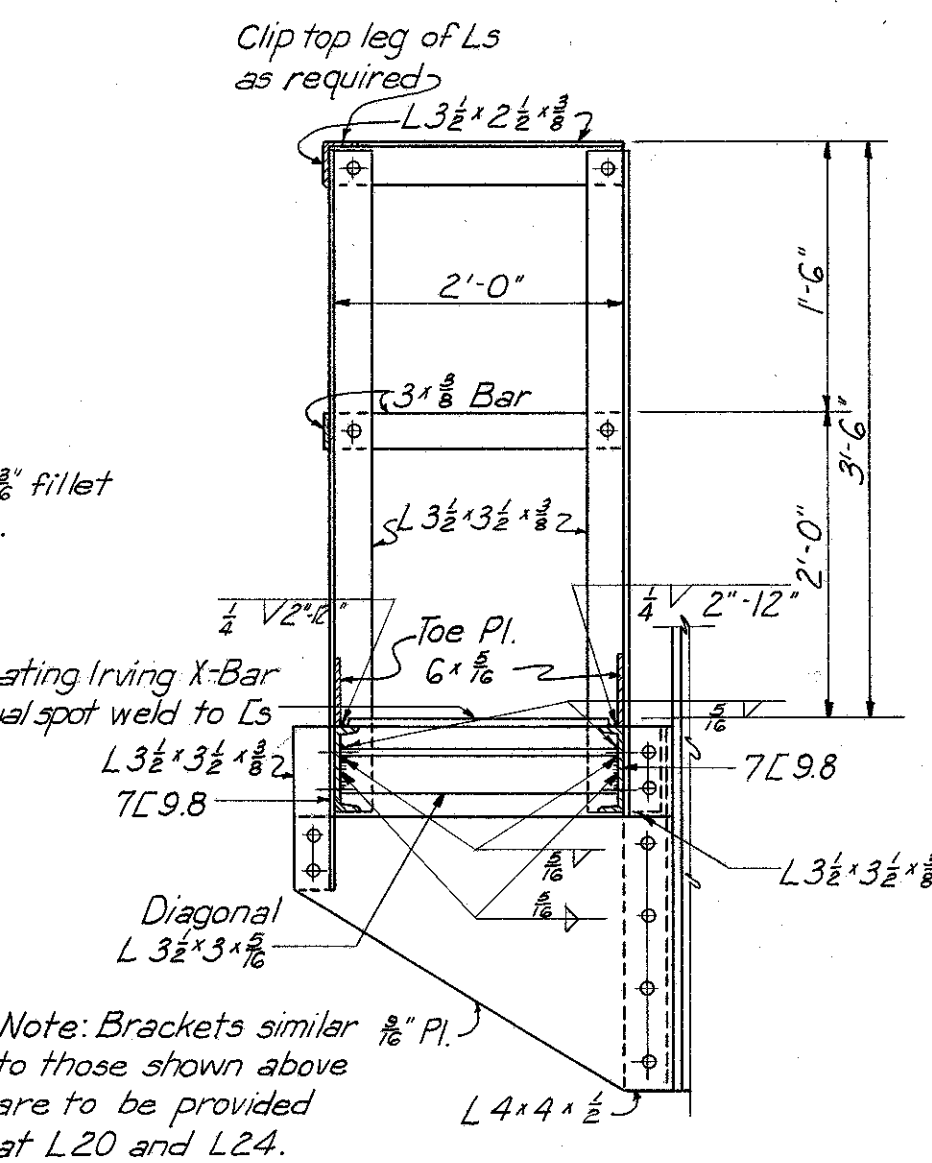

SECTION B-B
Scale: 1/2" = 1'-0"

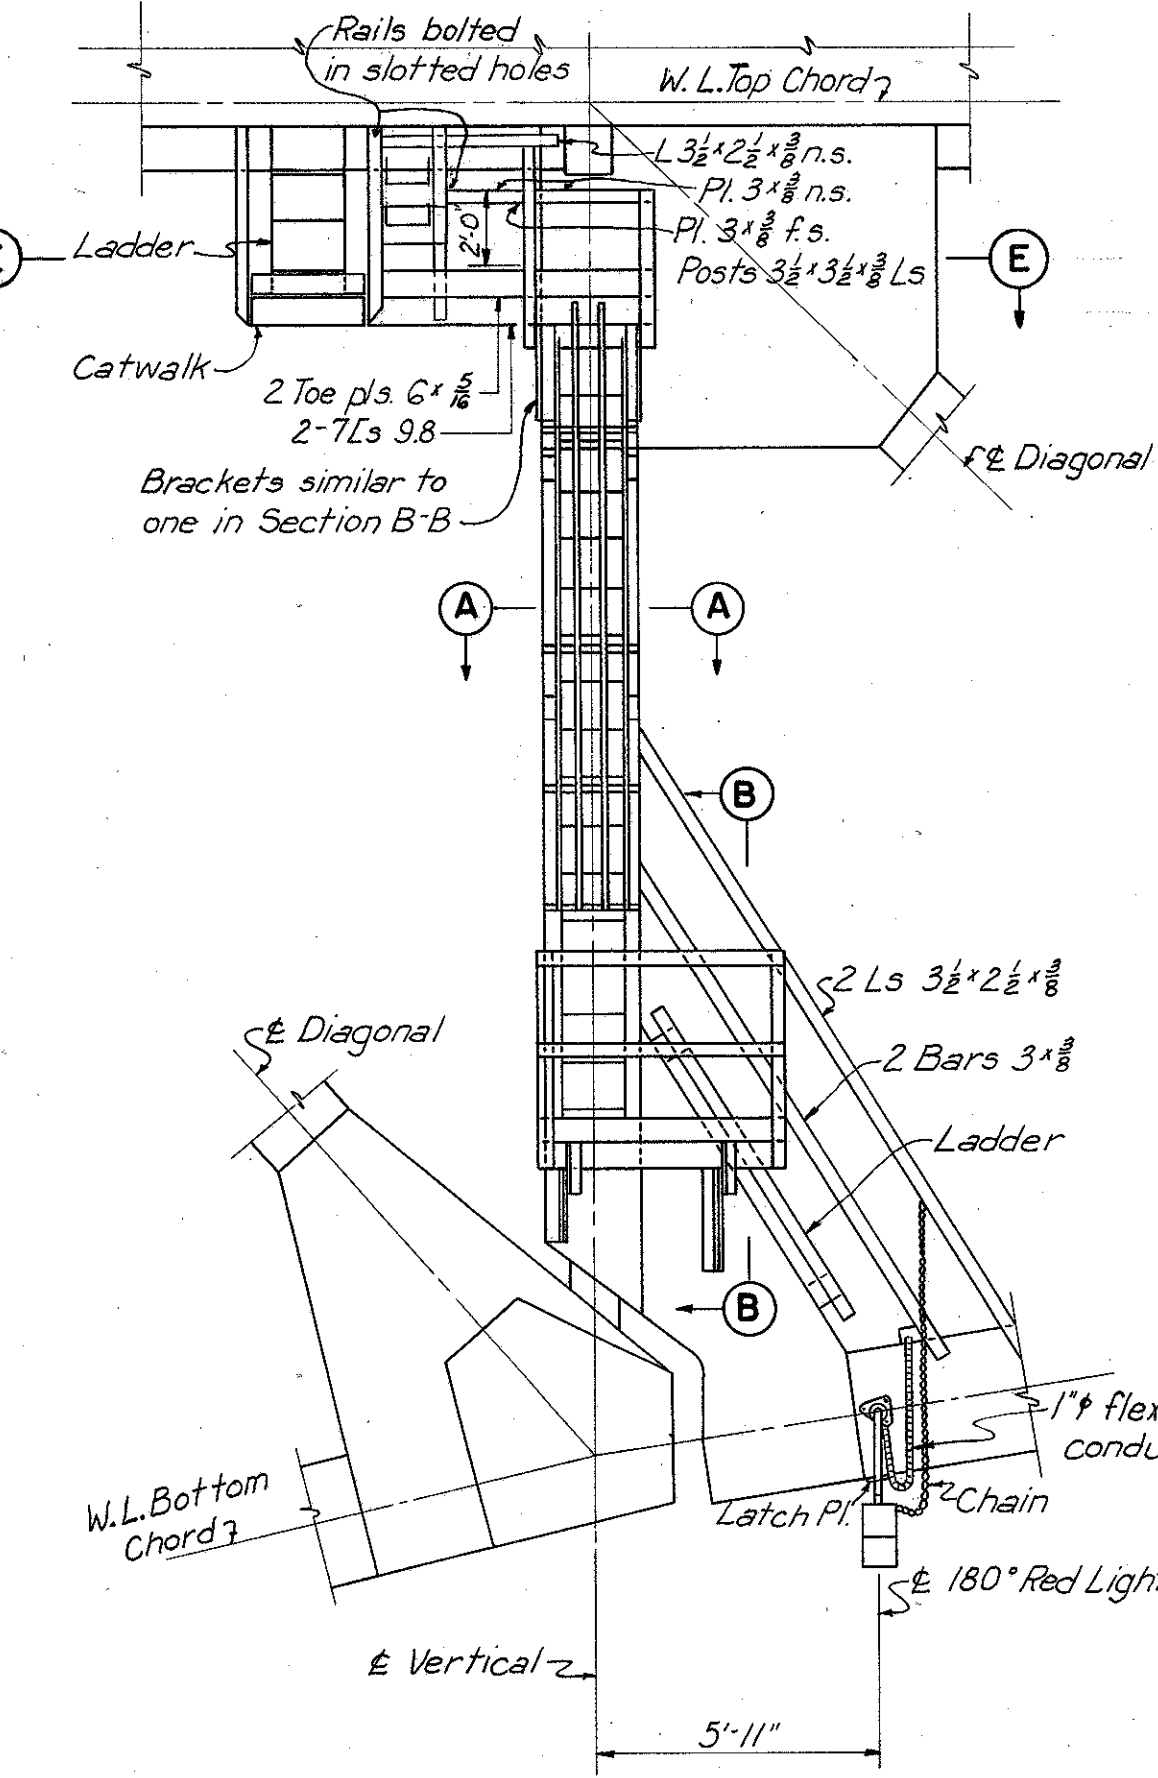


L20-U20

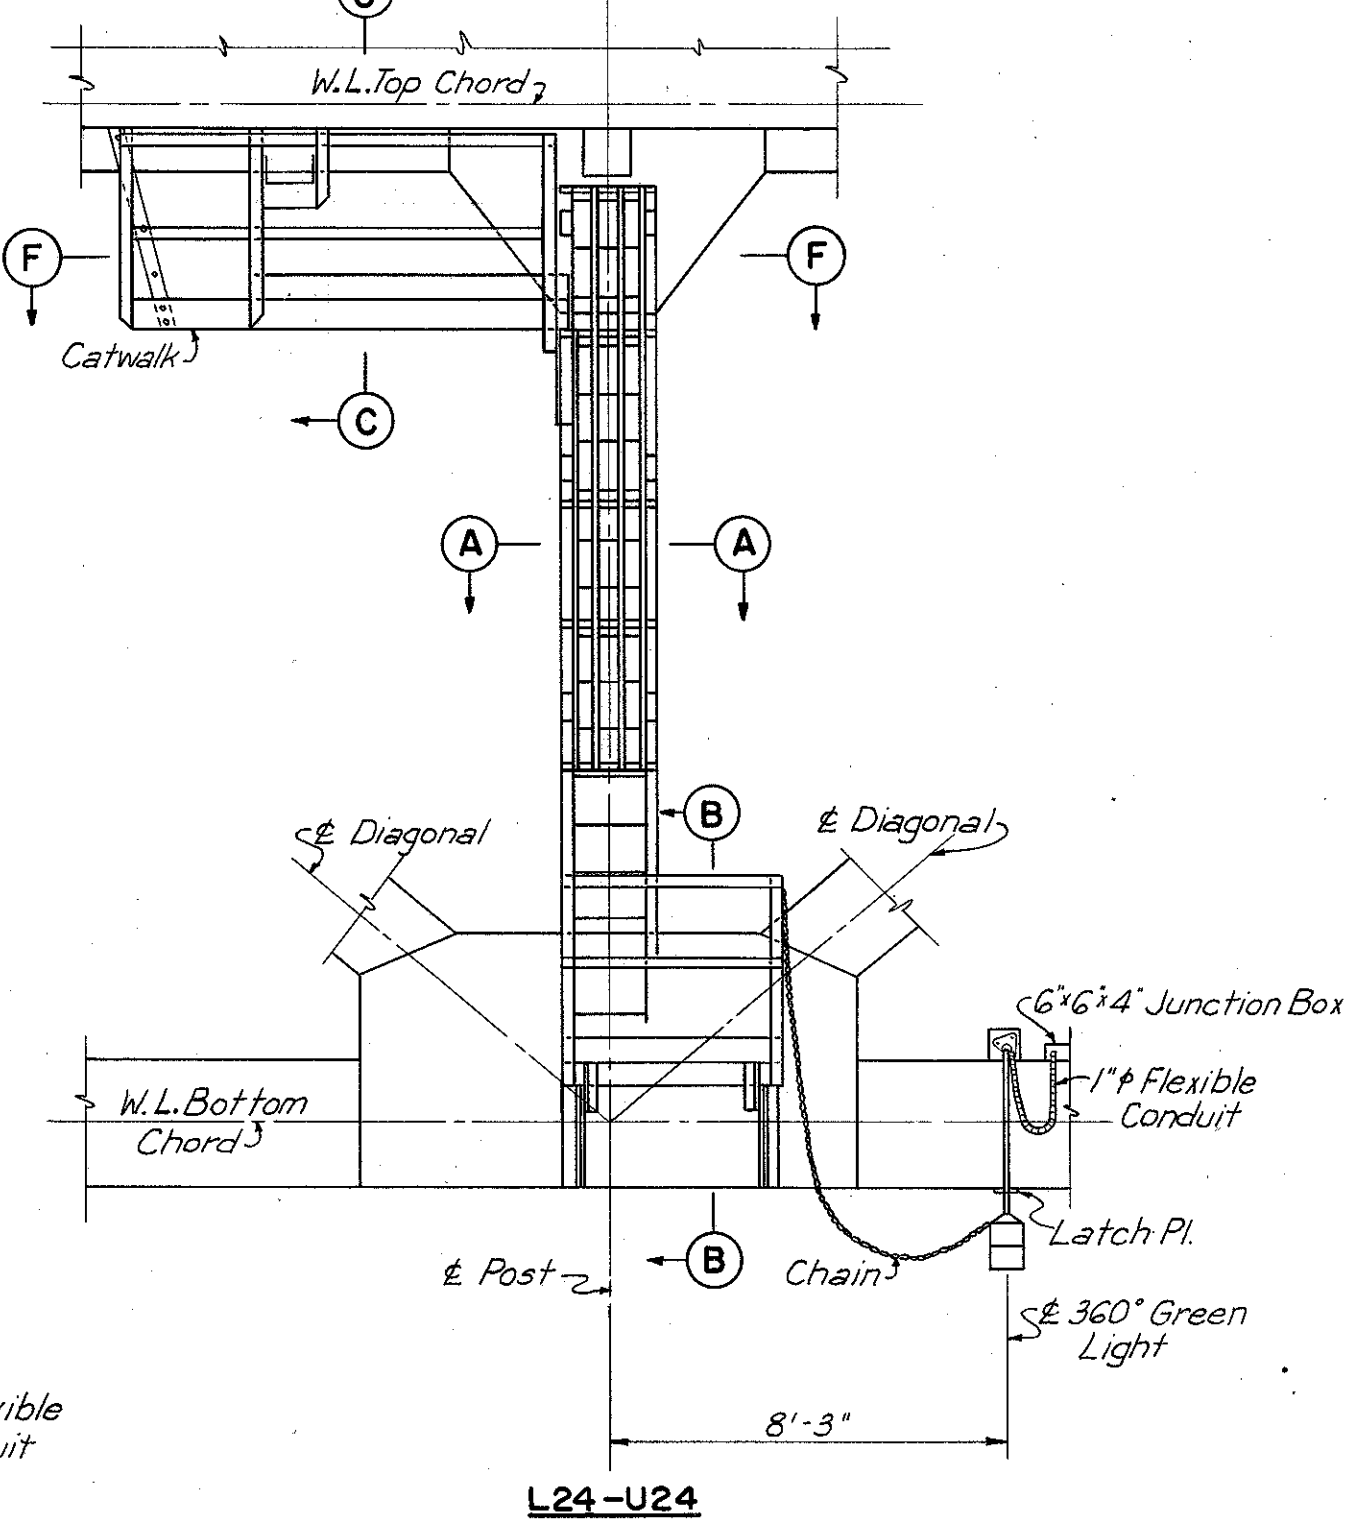


L24-U24


SOUTH TRUSS UNIT NO. 2
Scale: 1/4" = 1'-0"

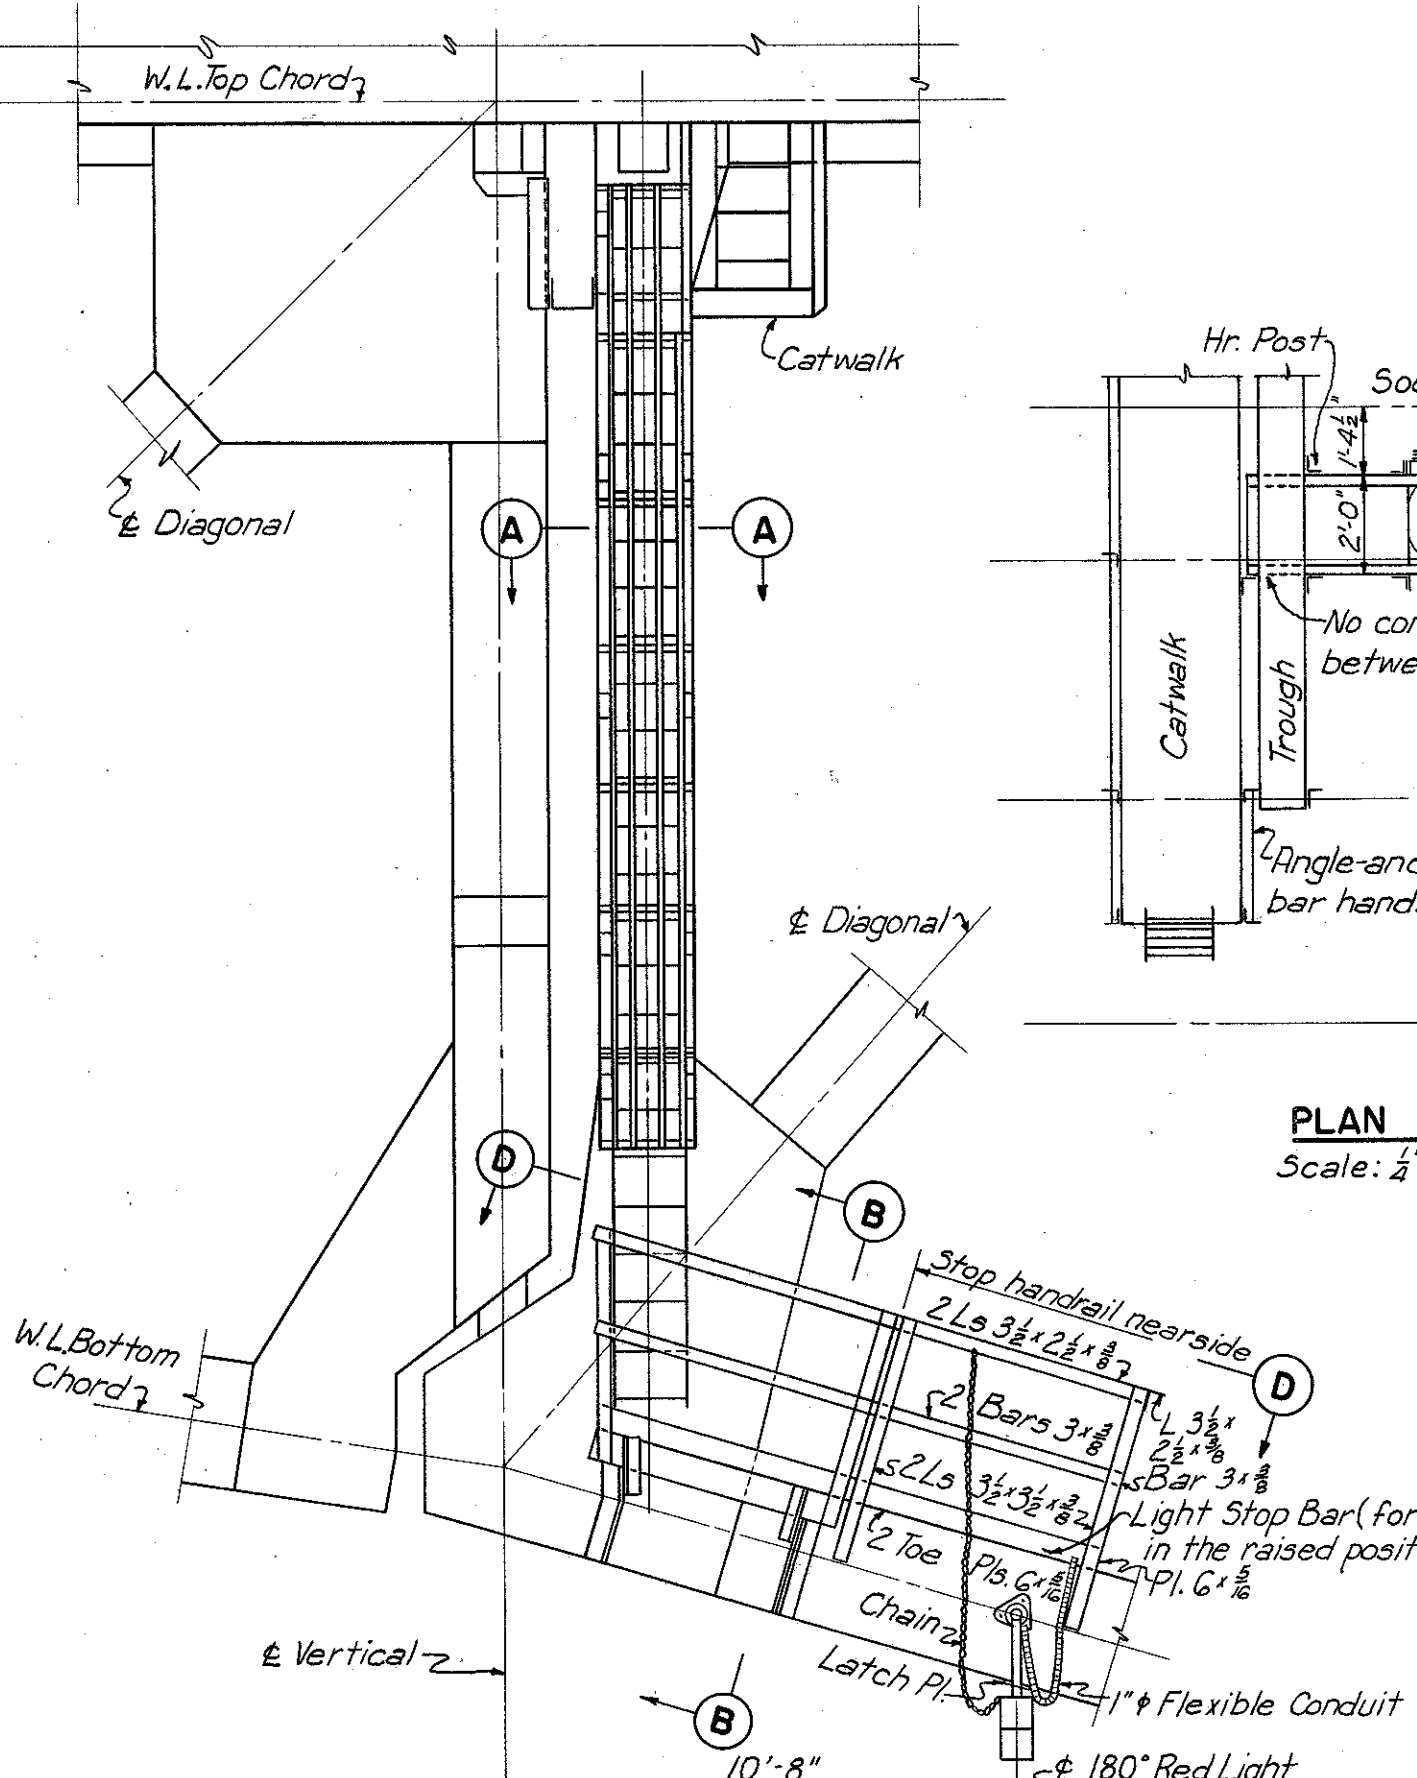


L28-U28

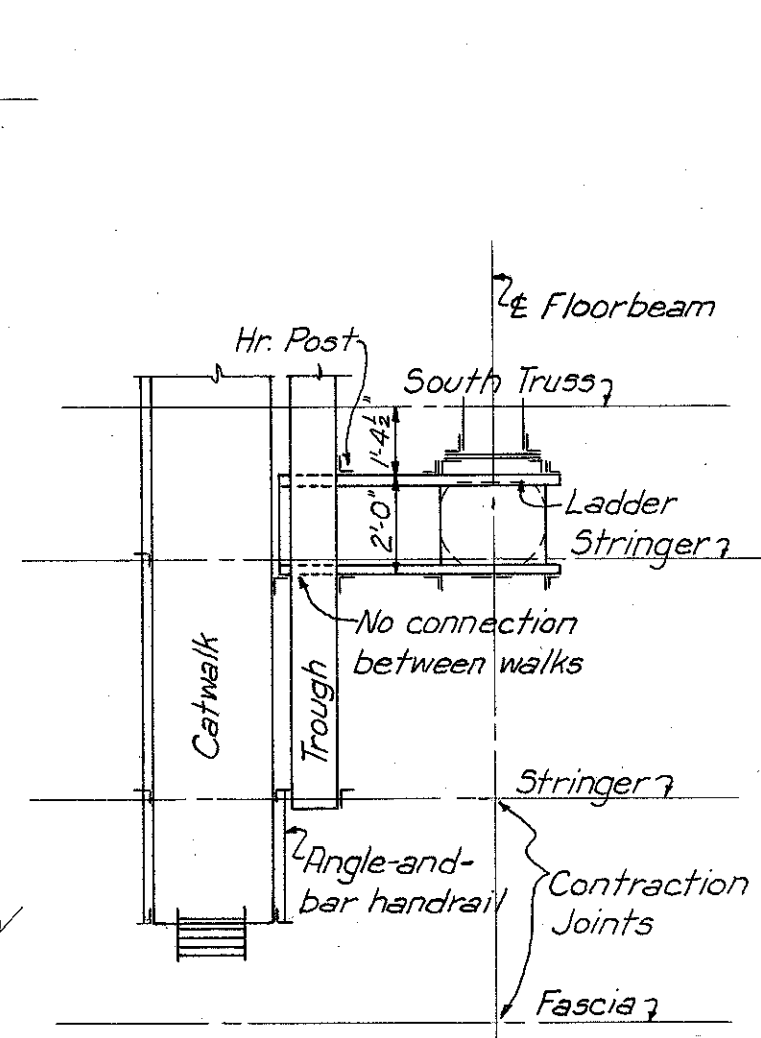

PLAN E-E
Scale: 1/4" = 1'-0"

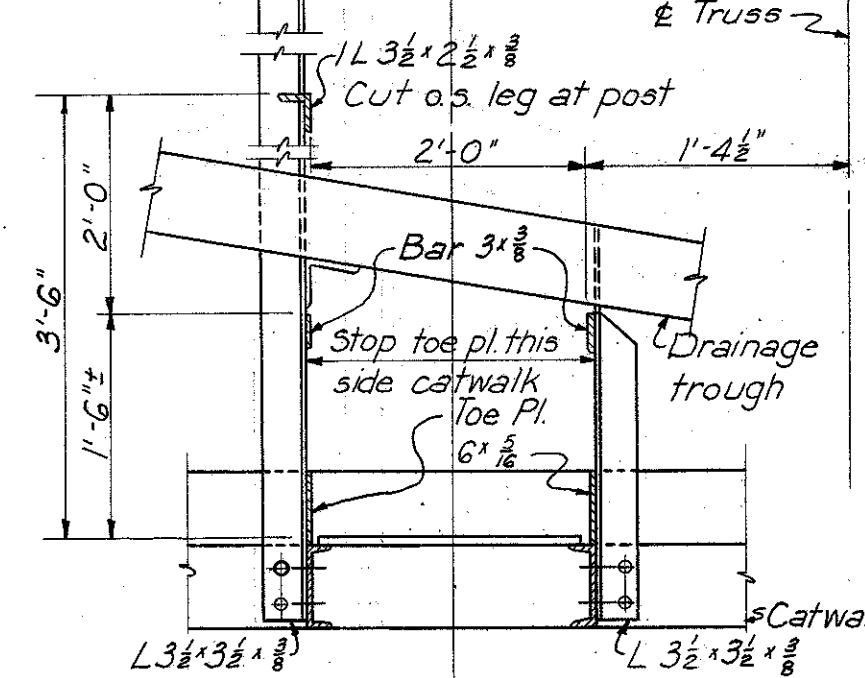

SECTION C-C
Scale: 1/2" = 1'-0"

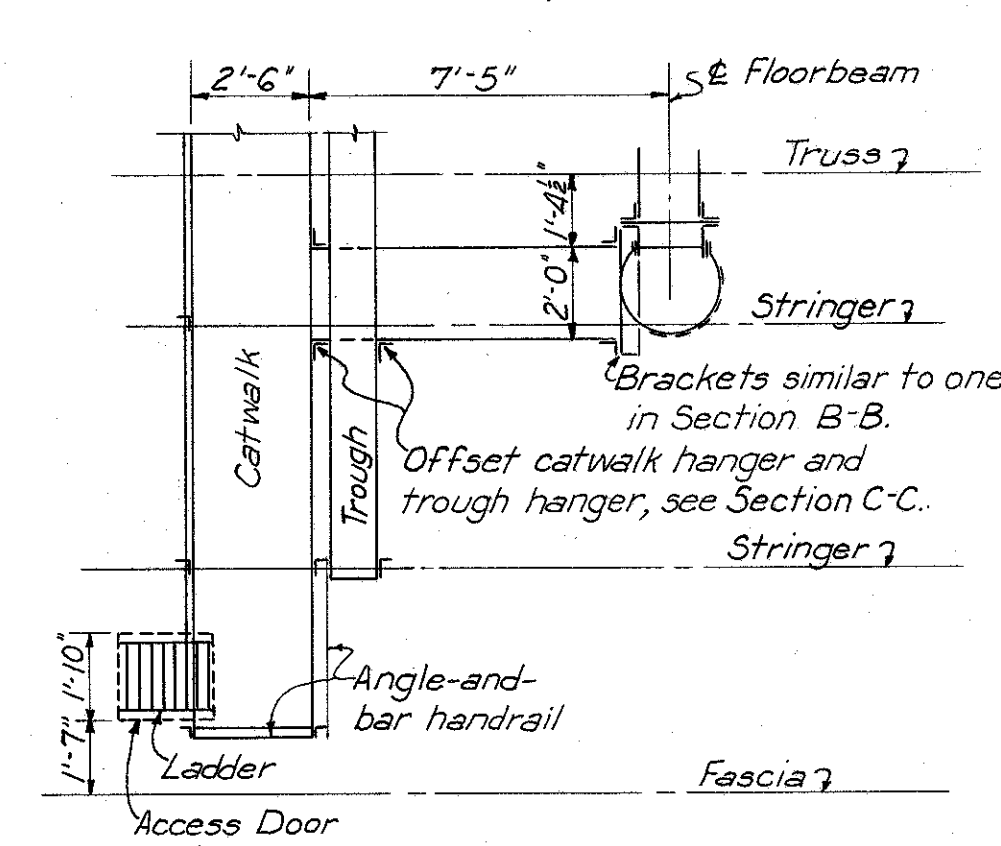

SECTION F-F
Scale: 1/4" = 1'-0"

Notes:
For detail of navigation lights, see Sh. 122.
For detail of catwalk, see Sh. 106.
Where no light stop bar is provided, a chain catch shall be provided.
For additional details of latch plate, see Sh. 122.
Rivets to be 1/2" except in connections to main members.

PIVOT SUPPORT
Scale: 1/2" = 1'-0"

LATCH PLATE
Scale: 1/2" = 1'-0"

PART 3


U. S. ROUTE 42 RELOCATION INNER BELT FREEWAY - CENTRAL VIADUCT BR. NO. CU - 42 R-17 5		
ACCESS TO NAVIGATION LIGHTS		
CLEVELAND	CUYAHOGA COUNTY	OHIO
SCALE: As Shown MADE: D.E. DATE: 10-8-54 TRCD: N.A.M. DATE: 12-6-54 CKD: M.D. DATE: 12-14-54		
HOWARD, NEEDLES, TAMMEN & BERGENDOFF CONSULTING ENGINEERS KANSAS CITY CLEVELAND NEW YORK 914-1A SHEET 2.102		

REPRODUCTION
FEB 16 1963


FED. ROAD DIV. NO.	STATE	FEDERAL AID PROJECT NO.	TYPE FUNDS
2	OHIO		

101
122


CUYAHOGA COUNTY
CITY OF CLEVELAND
INNER BELT FREEWAY
CENTRAL VIADUCT

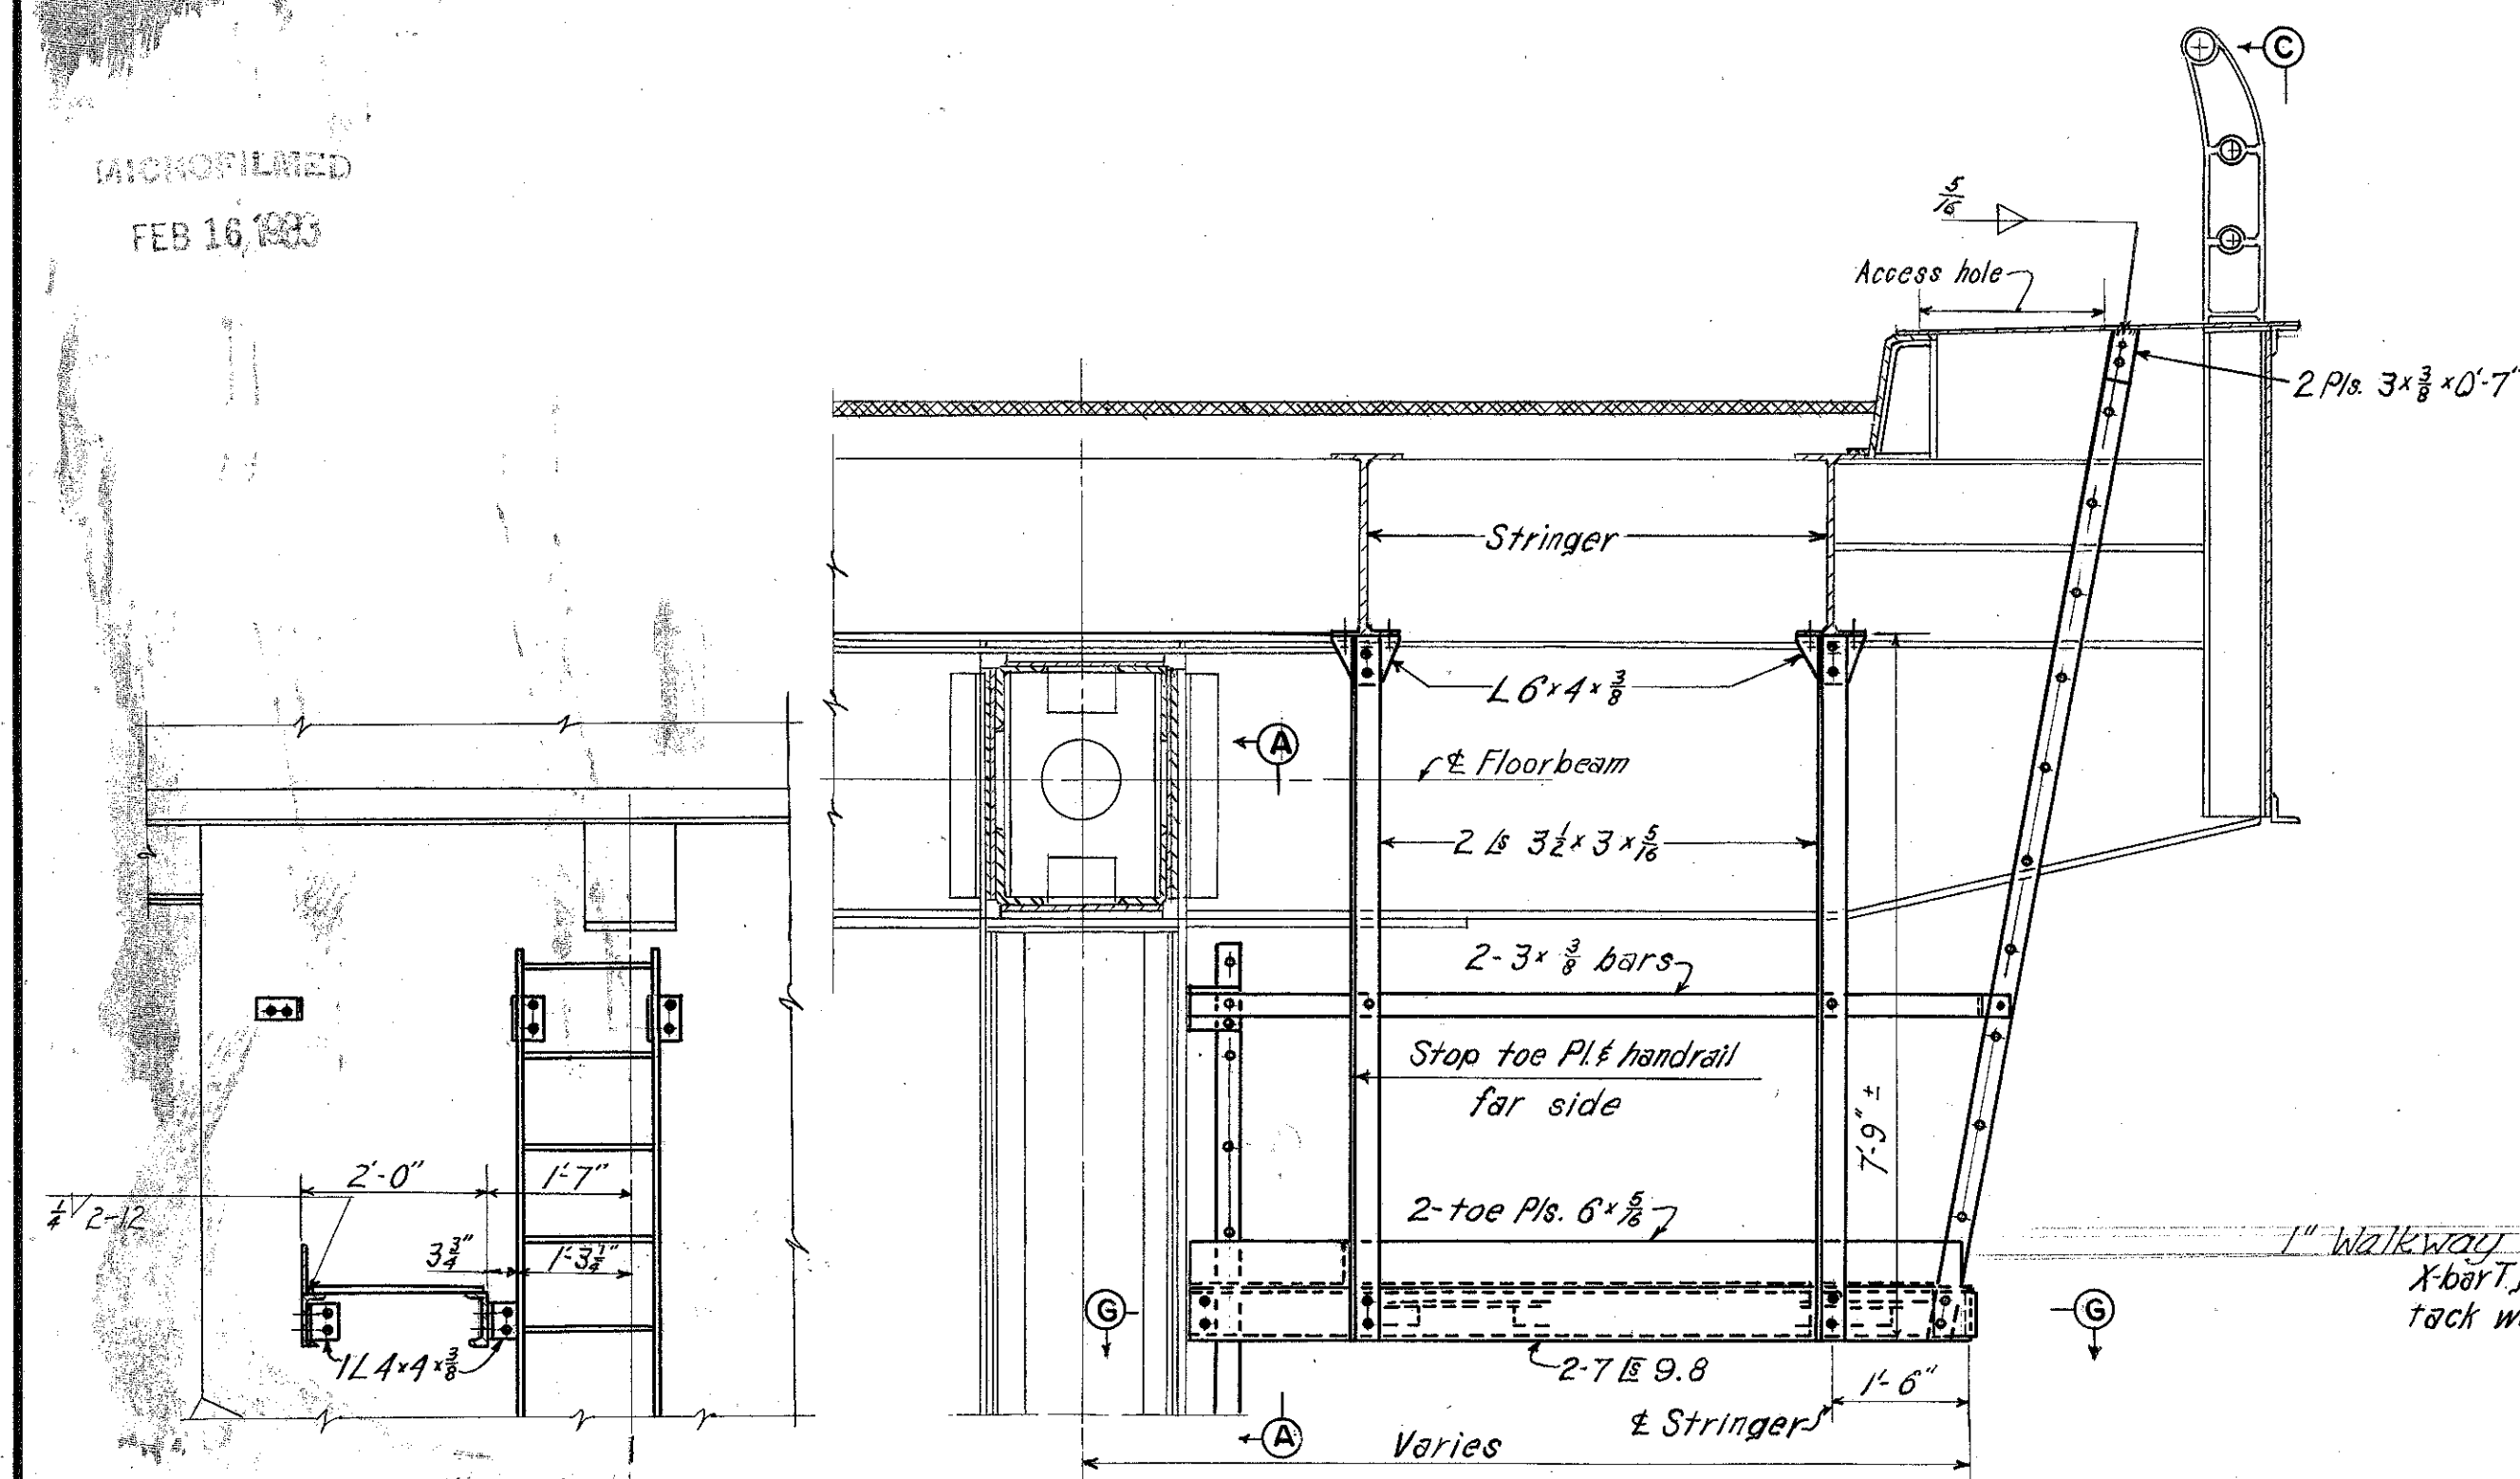


SECTION A-A
Scale 1/2" = 1'-0"

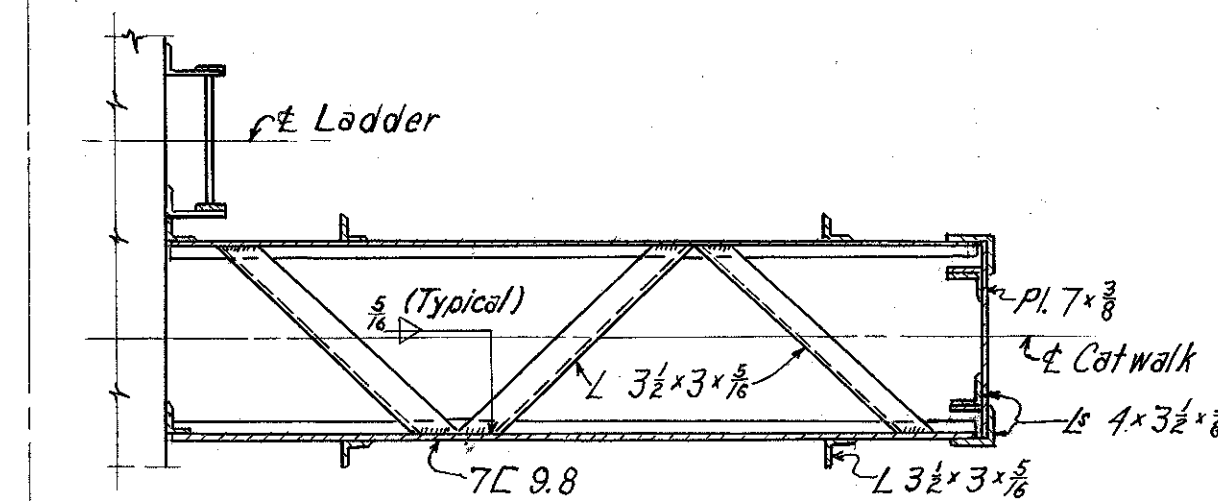


SECTION G-G
Scale 1/2" = 1'-0"

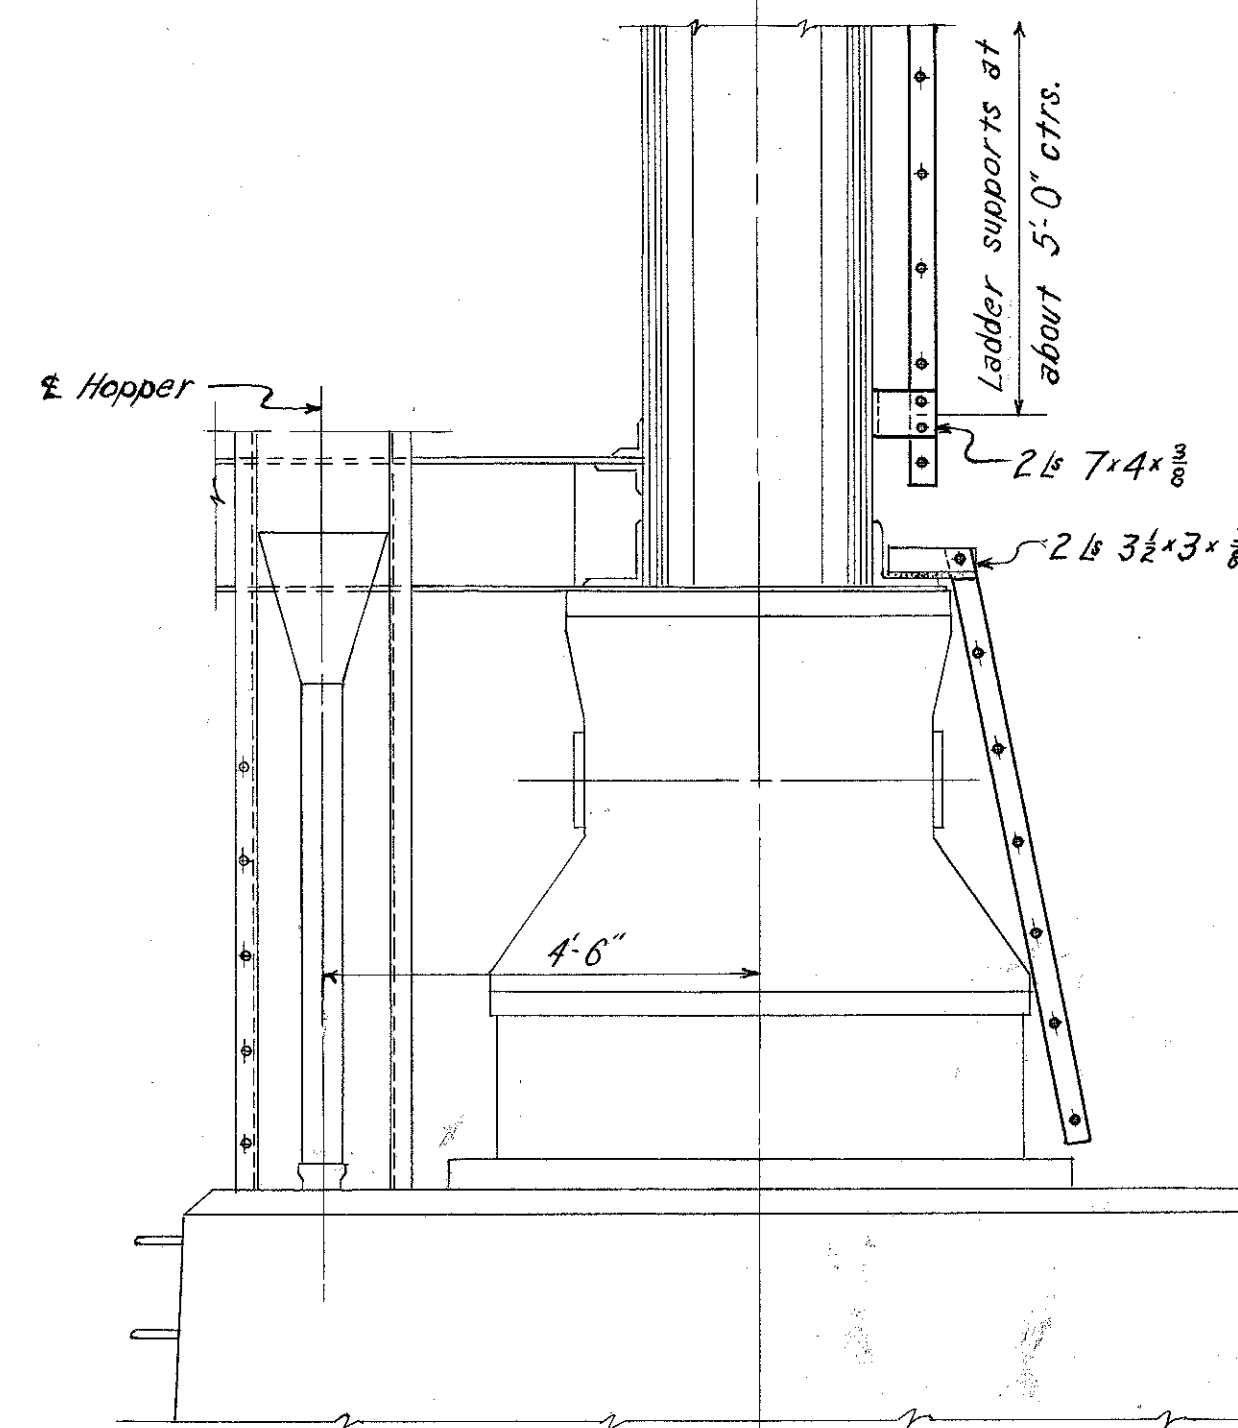



ELEVATION
Scale 1/2" = 1'-0"

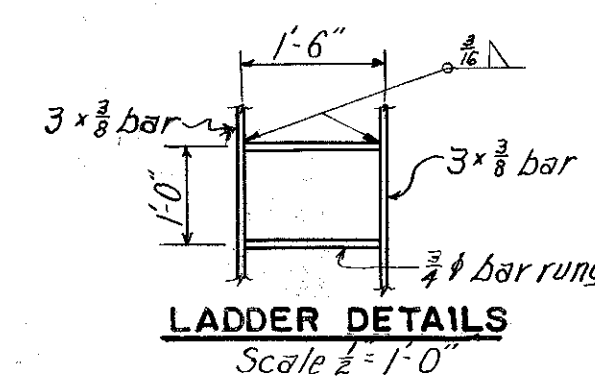

INTERIOR PIERS 1 TO 8

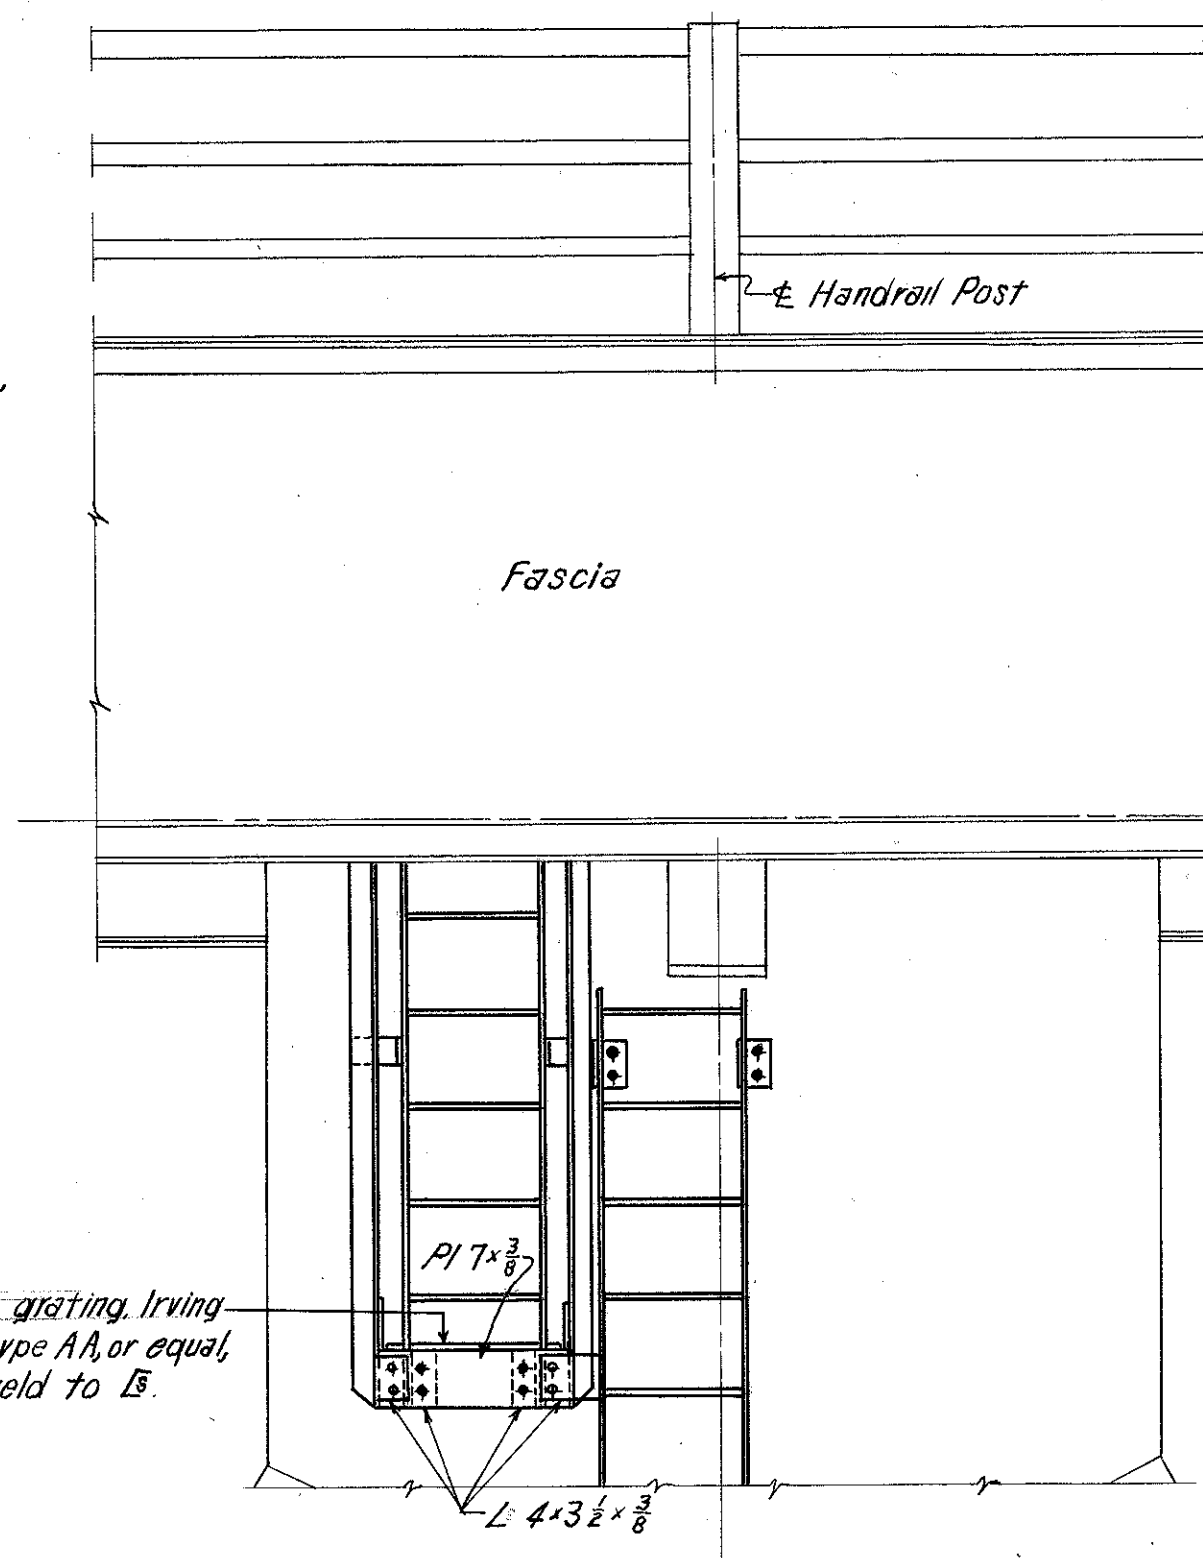

SECTION C-C
Scale 1/2" = 1'-0"

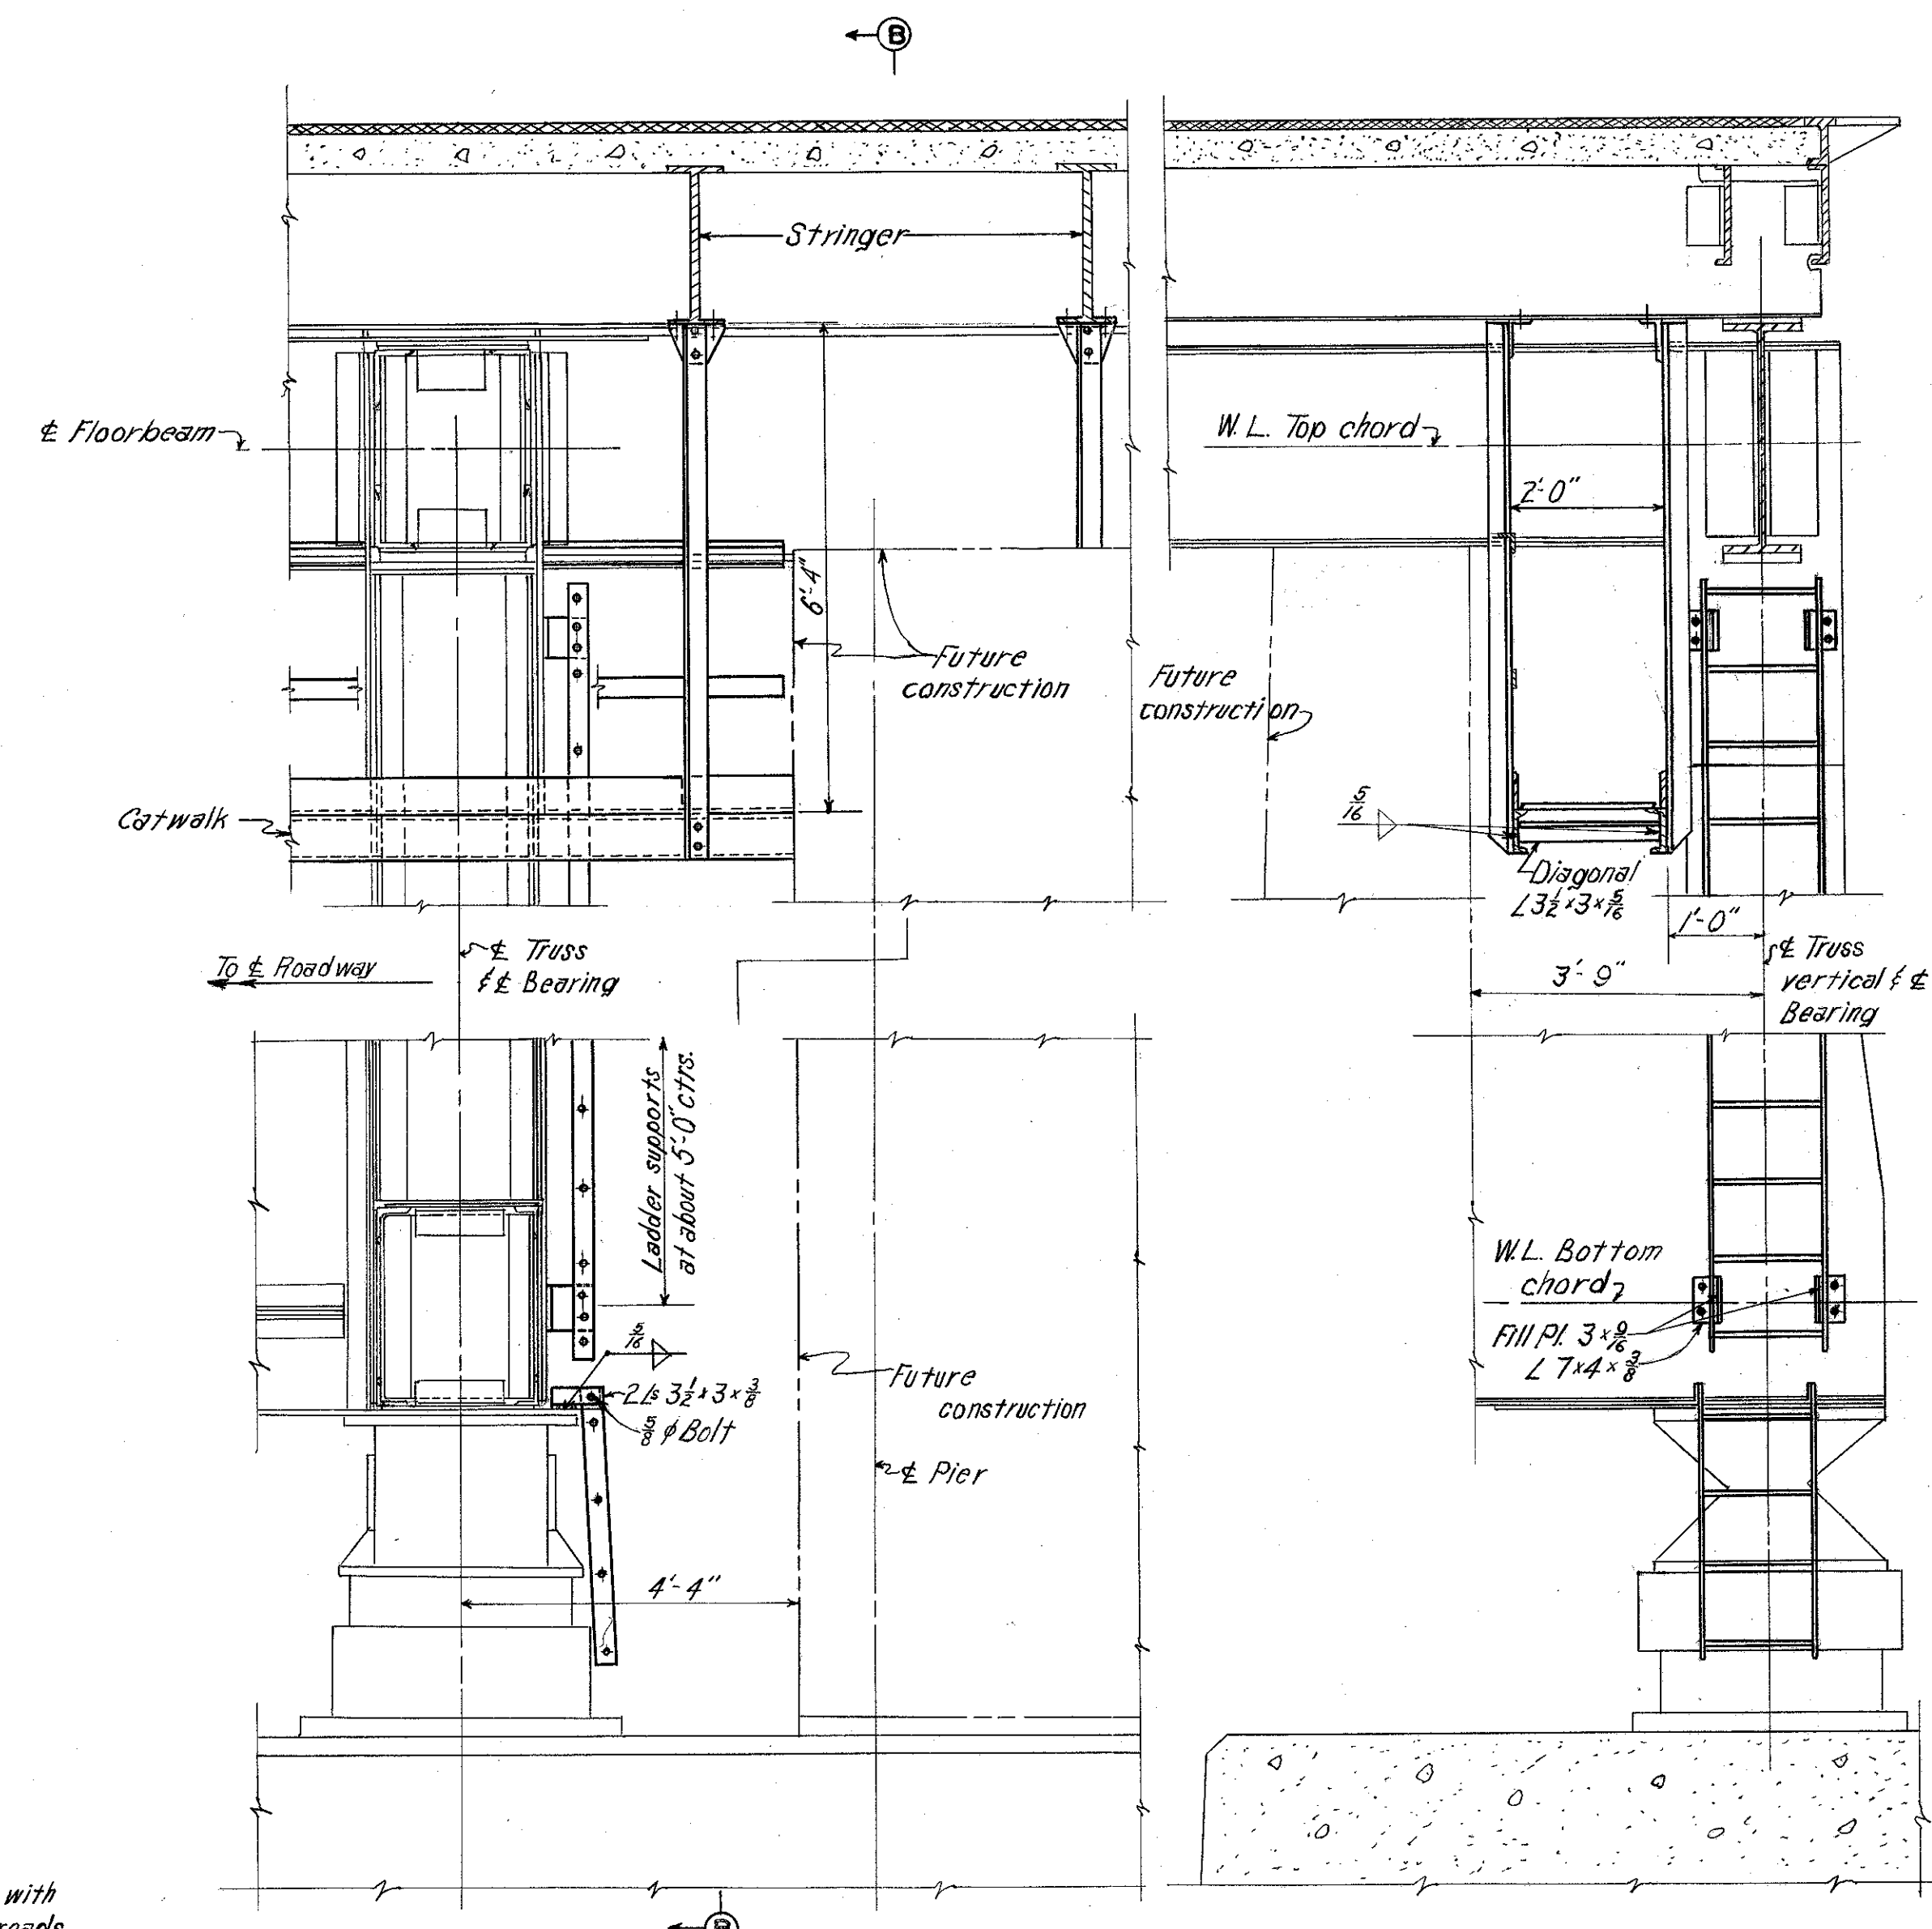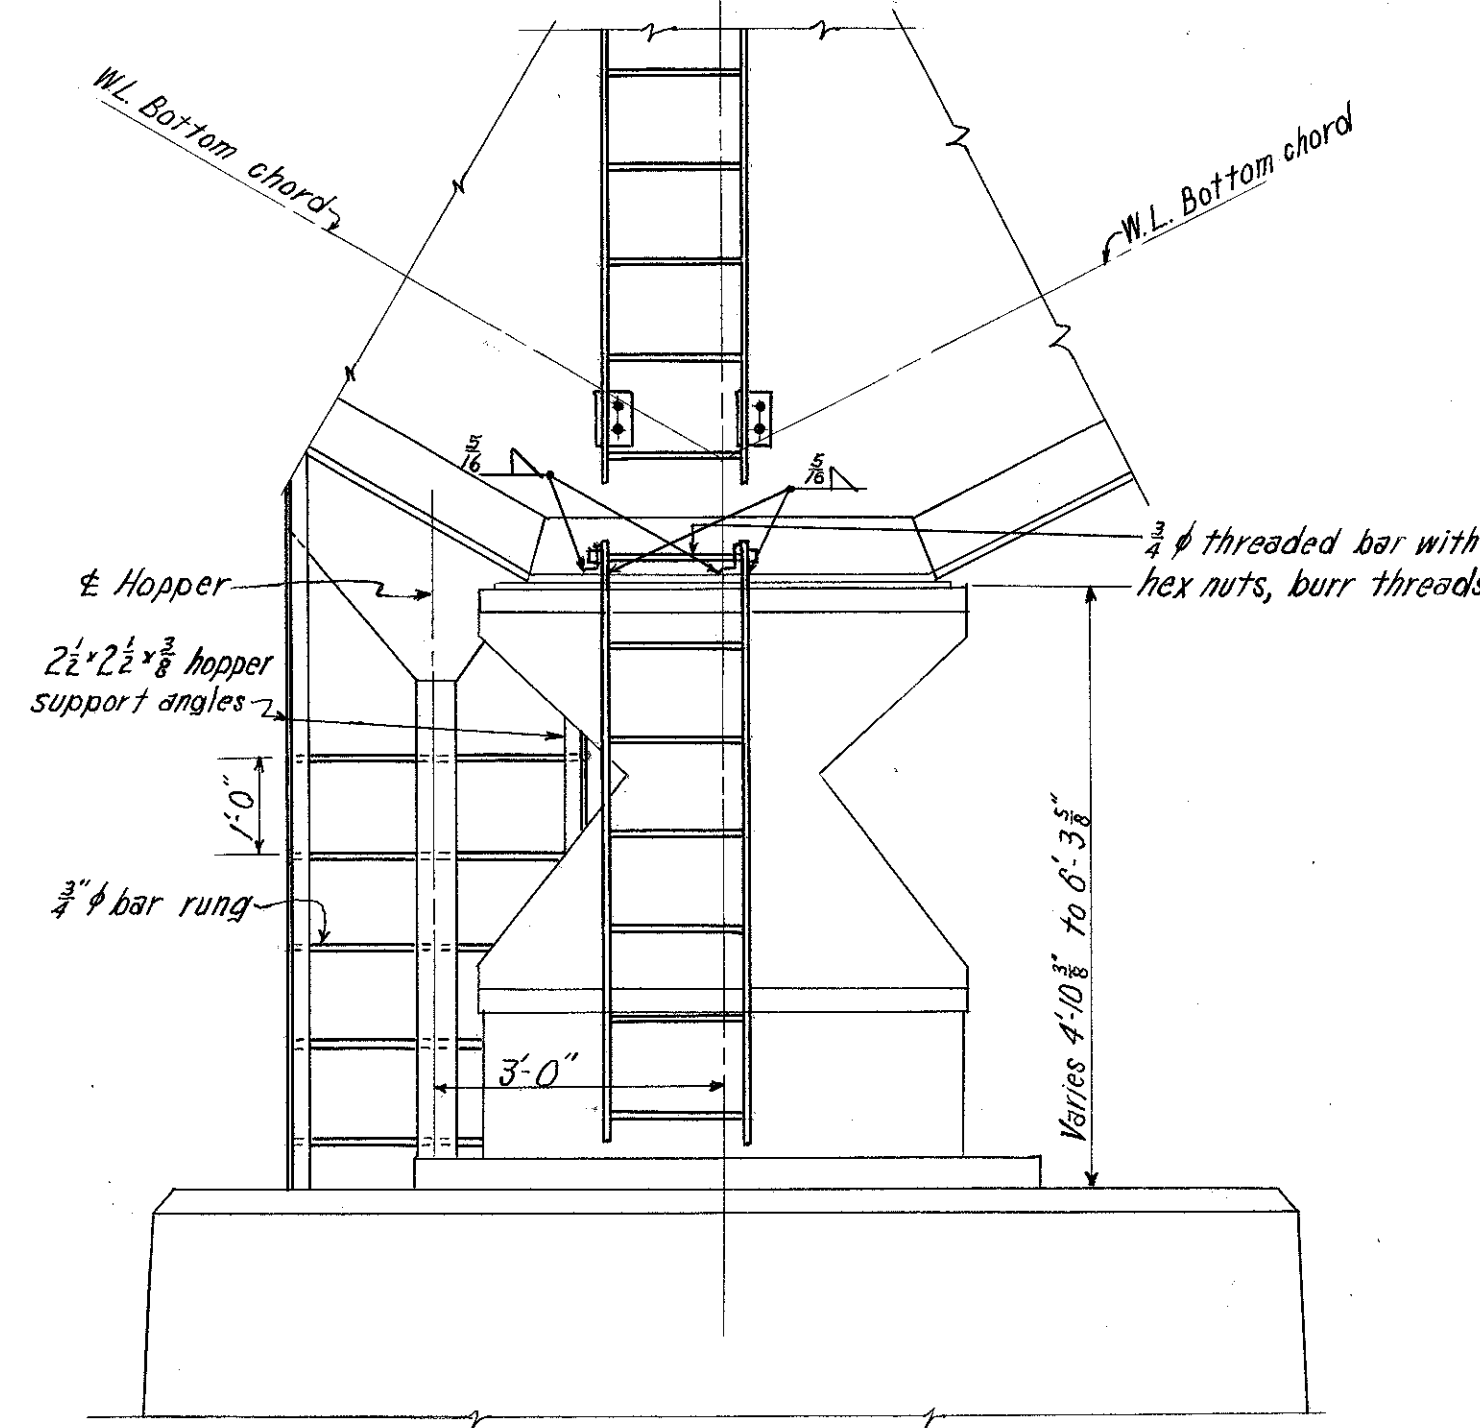

TRANSVERSE ELEVATION
Scale 1/2" = 1'-0"

LONGITUDINAL ELEVATION SECTION B-B
Scale 1/2" = 1'-0"

END PIERS

Notes:
For detail of access hole and
cover see sheets 100 and 113.

For other details of catwalks see
section A-A, sheet 109, 106, 108
For details of shoes see sheets
96, 97 and 98.

PART 3

U. S. ROUTE 42 RELOCATION
INNER BELT FREEWAY - CENTRAL VIADUCT
BR. NO. CU - 42 R-17 5


LADDERS AT PIERS

CLEVELAND CUYAHOGA COUNTY OHIO


SCALE: AS SHOWN
MADE: D.E.R. DATE: 8-27-54
TRCD: M.E.J. DATE: 11-2-54
CKD: E.J.D. DATE: 11-4-54
HOWARD, NEEDLES, TAMMEN & BERGENDOFF
CONSULTING ENGINEERS
KANSAS CITY CLEVELAND NEW YORK
914-1A SHEET 2.101

2. West End Pier and Expansion Joint

FED. ROAD DIV. NO.	STATE	FEDERAL AID PROJECT NO.	TYPE FUNDS
2	OHIO		




CUYAHOGA COUNTY
CITY OF CLEVELAND
INNER BELT FREEWAY
CENTRAL VIADUCT

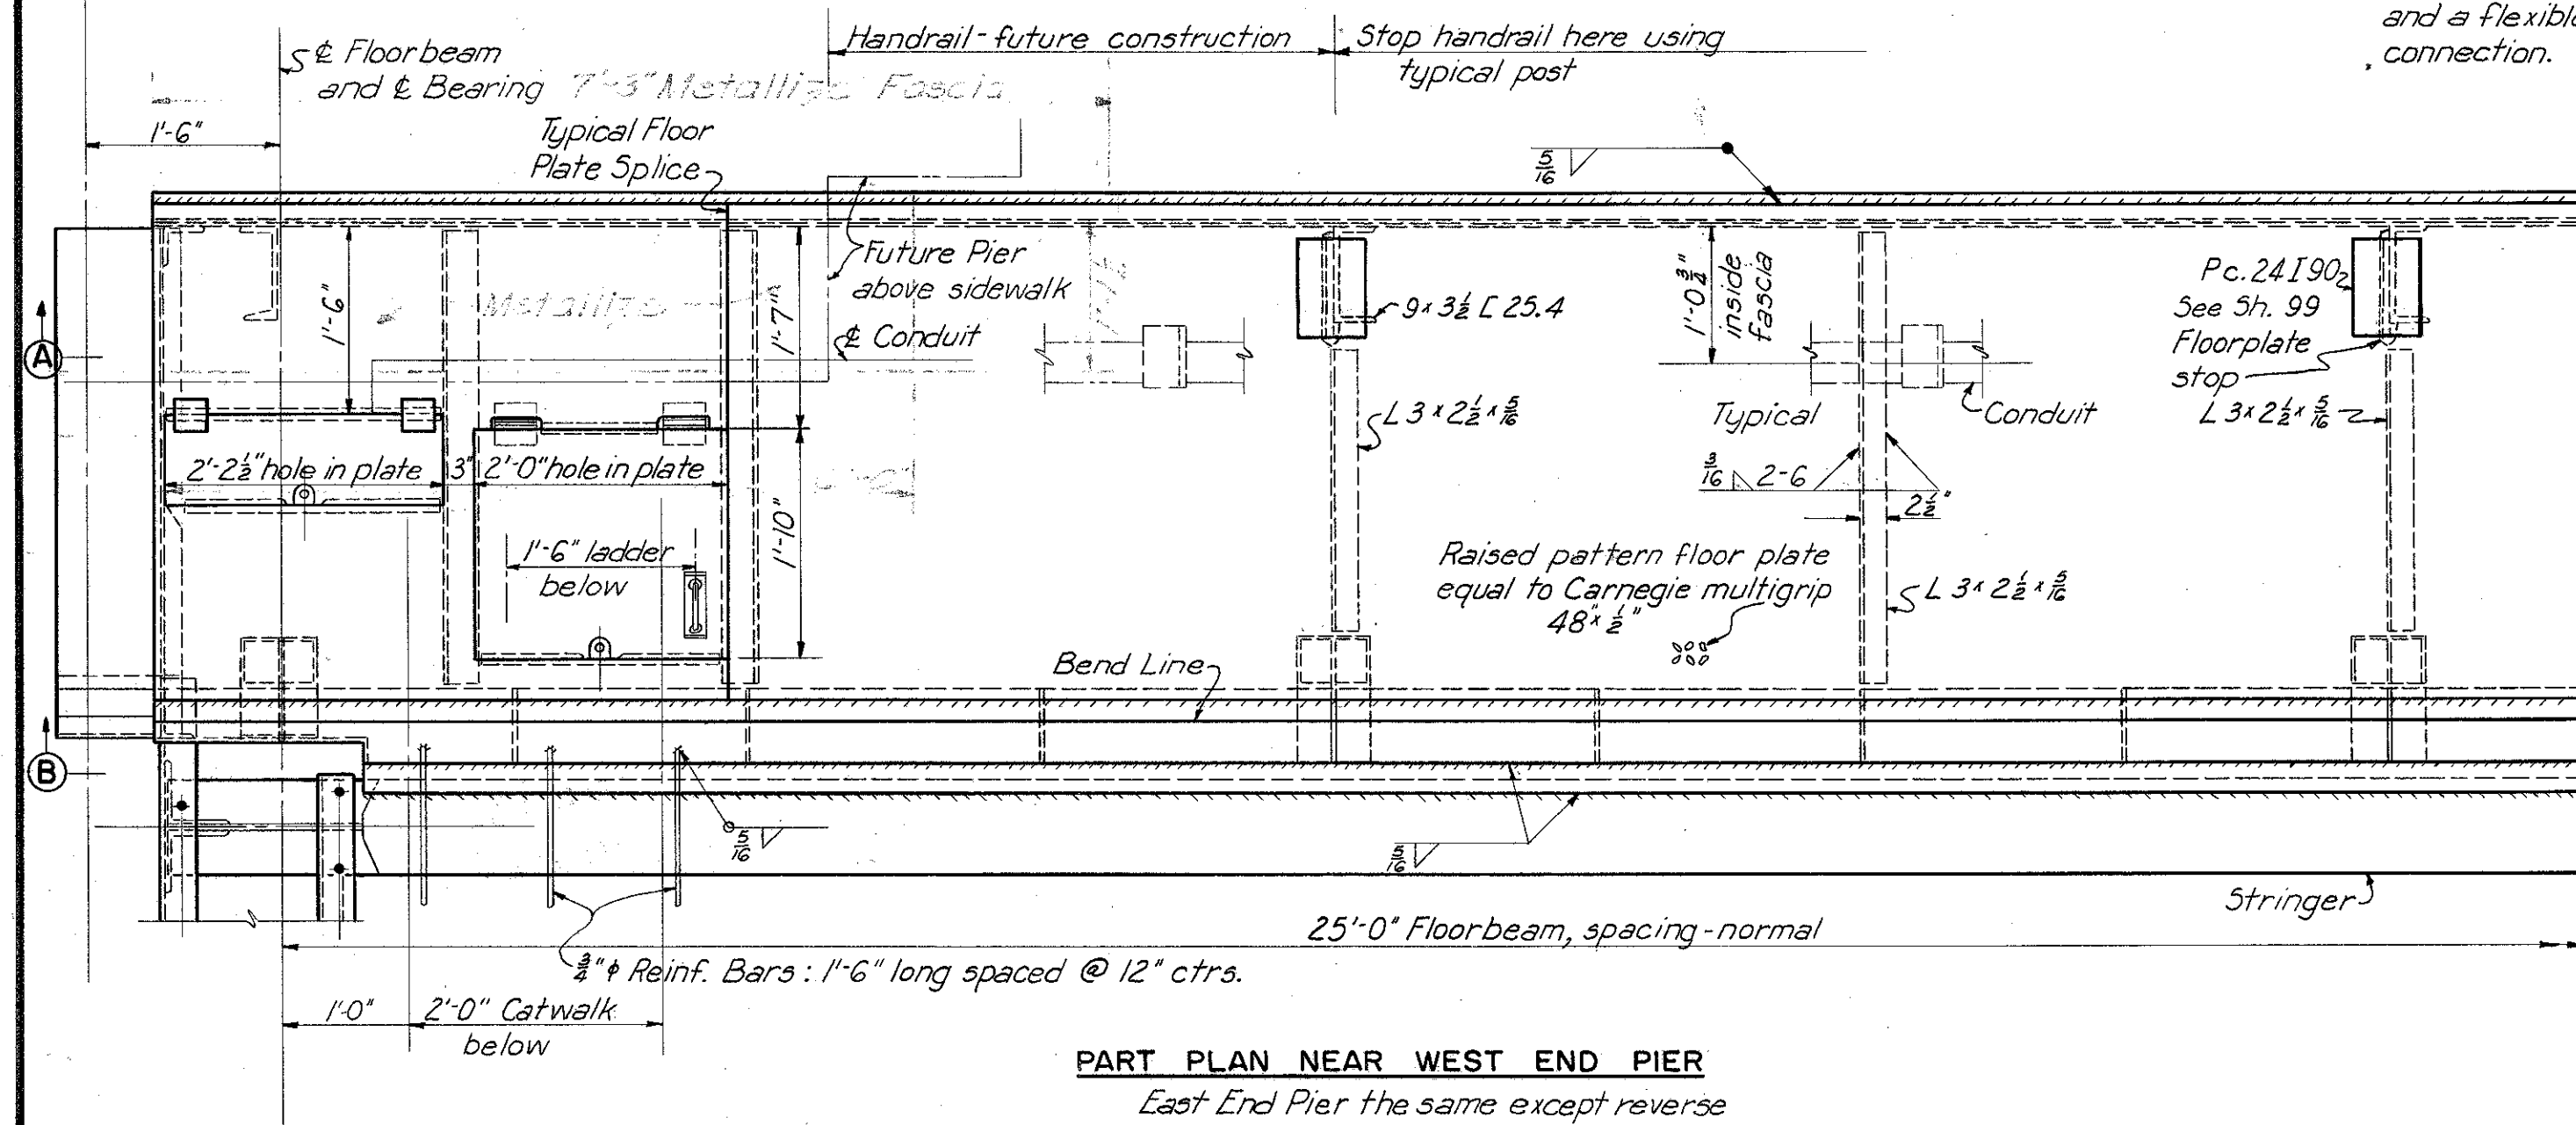


PART PLAN NEAR WEST END PIER
East End Pier the same except reverse

This detail is for points 314, 44, 504, 704 and 904. At points 40, 66, and 86, add a second junction box and a flexible conduit connection.

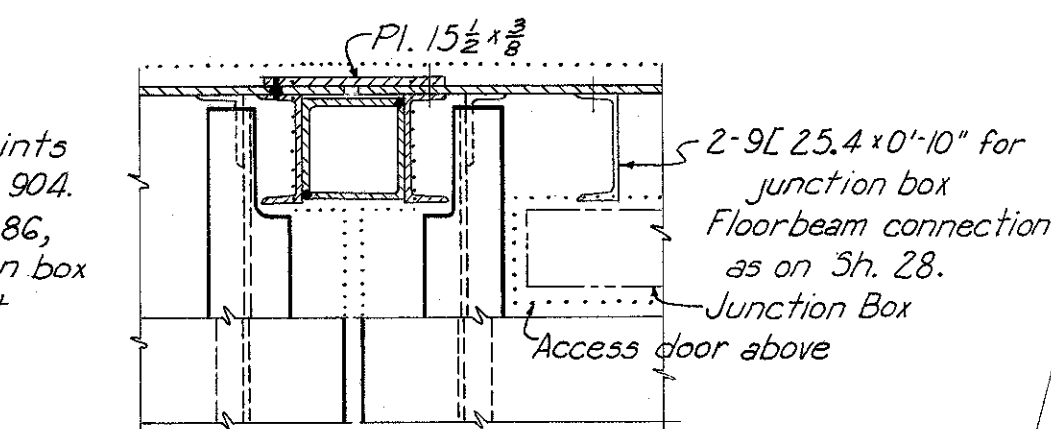


CONTRACTION JOINT AT LIGHT POLE

Typical Floor Plate Splice
Attach angle to left hand plate
with $\frac{5}{16}$ " and $\frac{1}{4}$ " fillet shop welds
as shown.
Erect floor plates with $\frac{1}{4}$ " space
between them and fill space full
with weld metal.

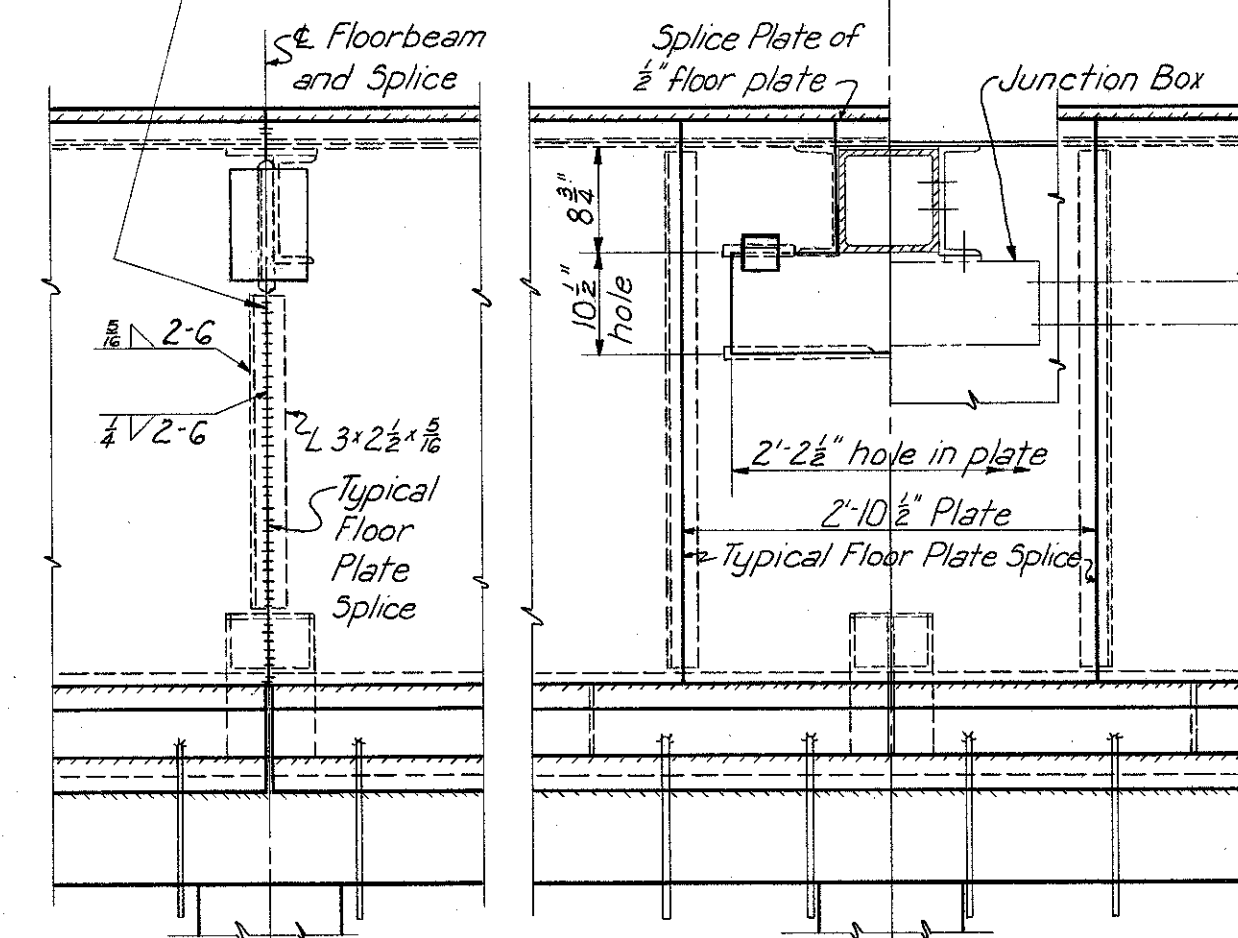



HANDRAIL POST CONNECTION
FLOOR PLATE SPLICE

Note: For details
of hatch, see
Sh. 113.

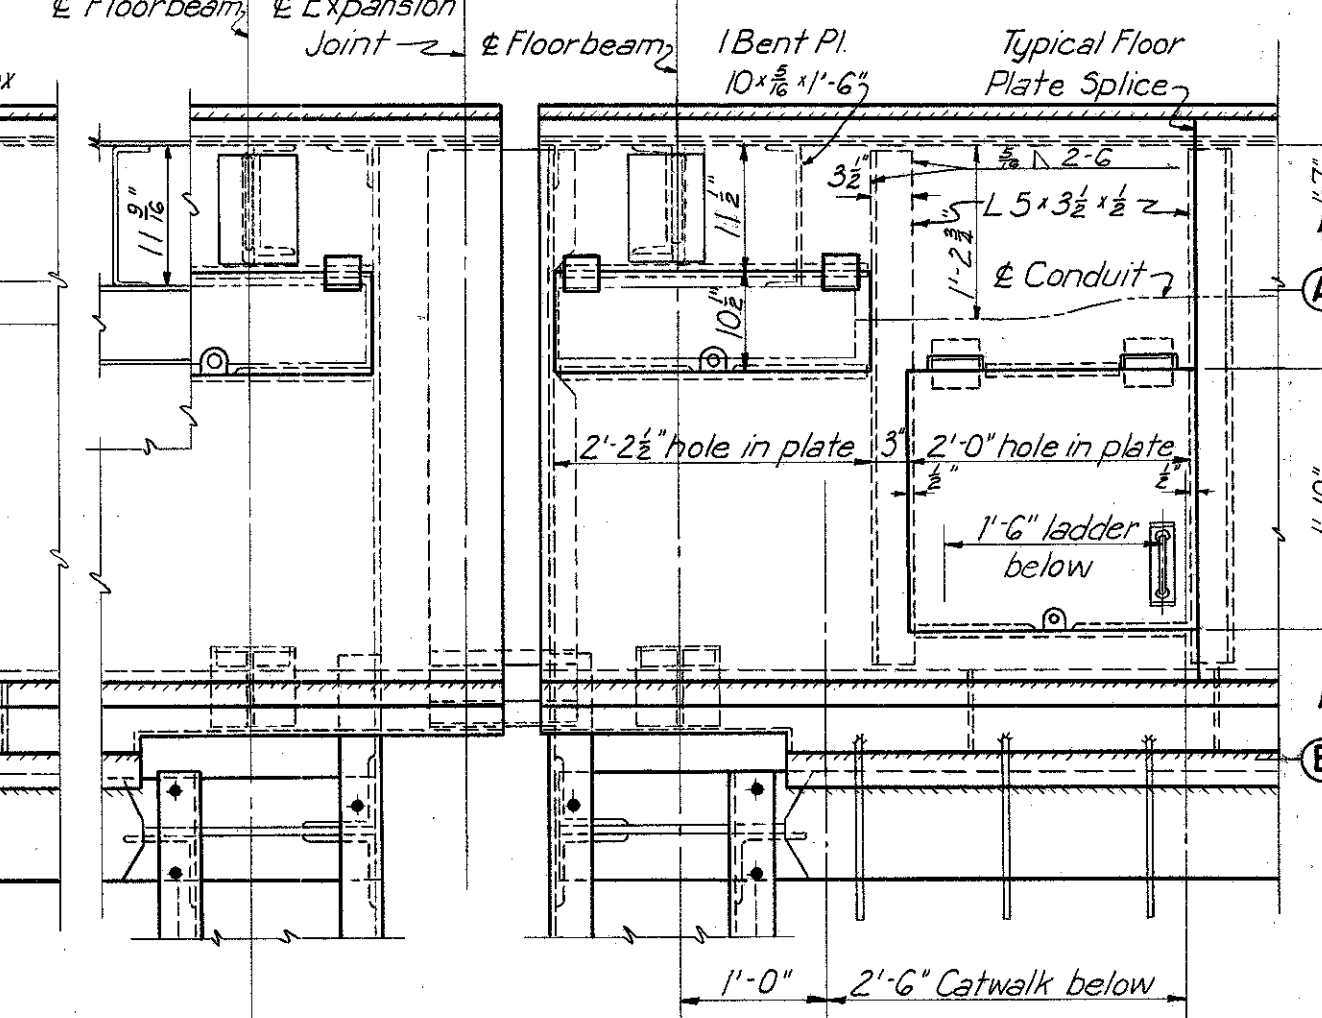


PLAN AT EXPANSION JOINT

SIDEWALK DETAILS

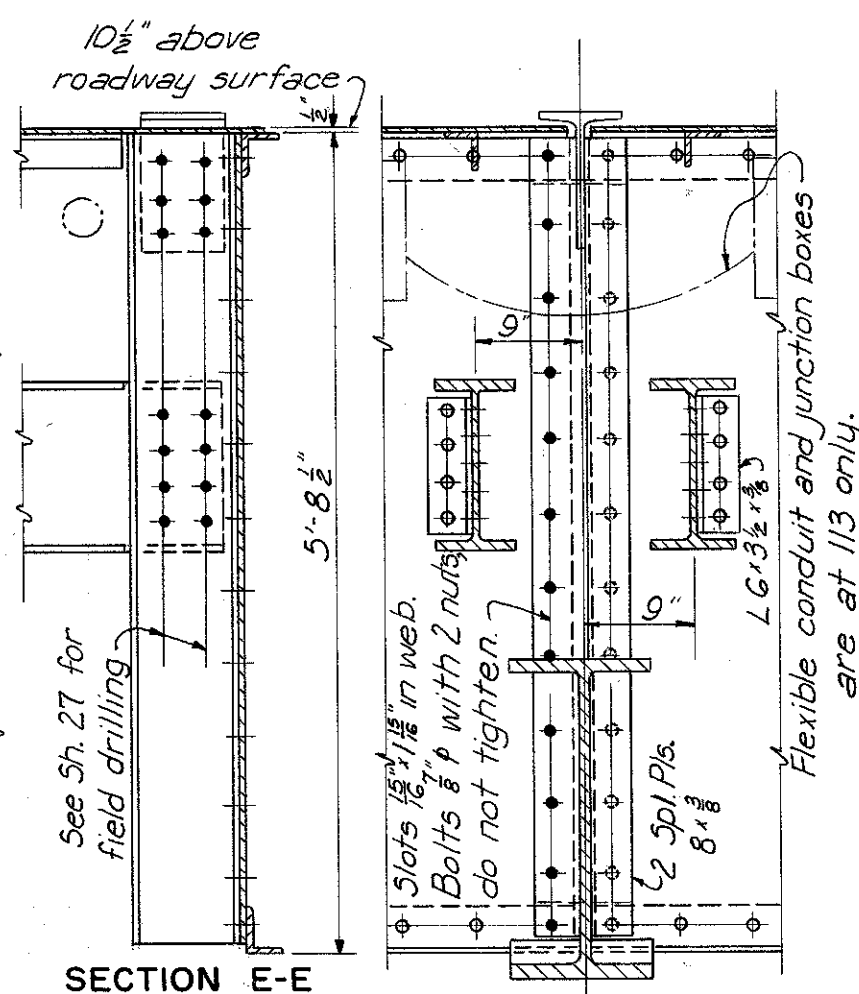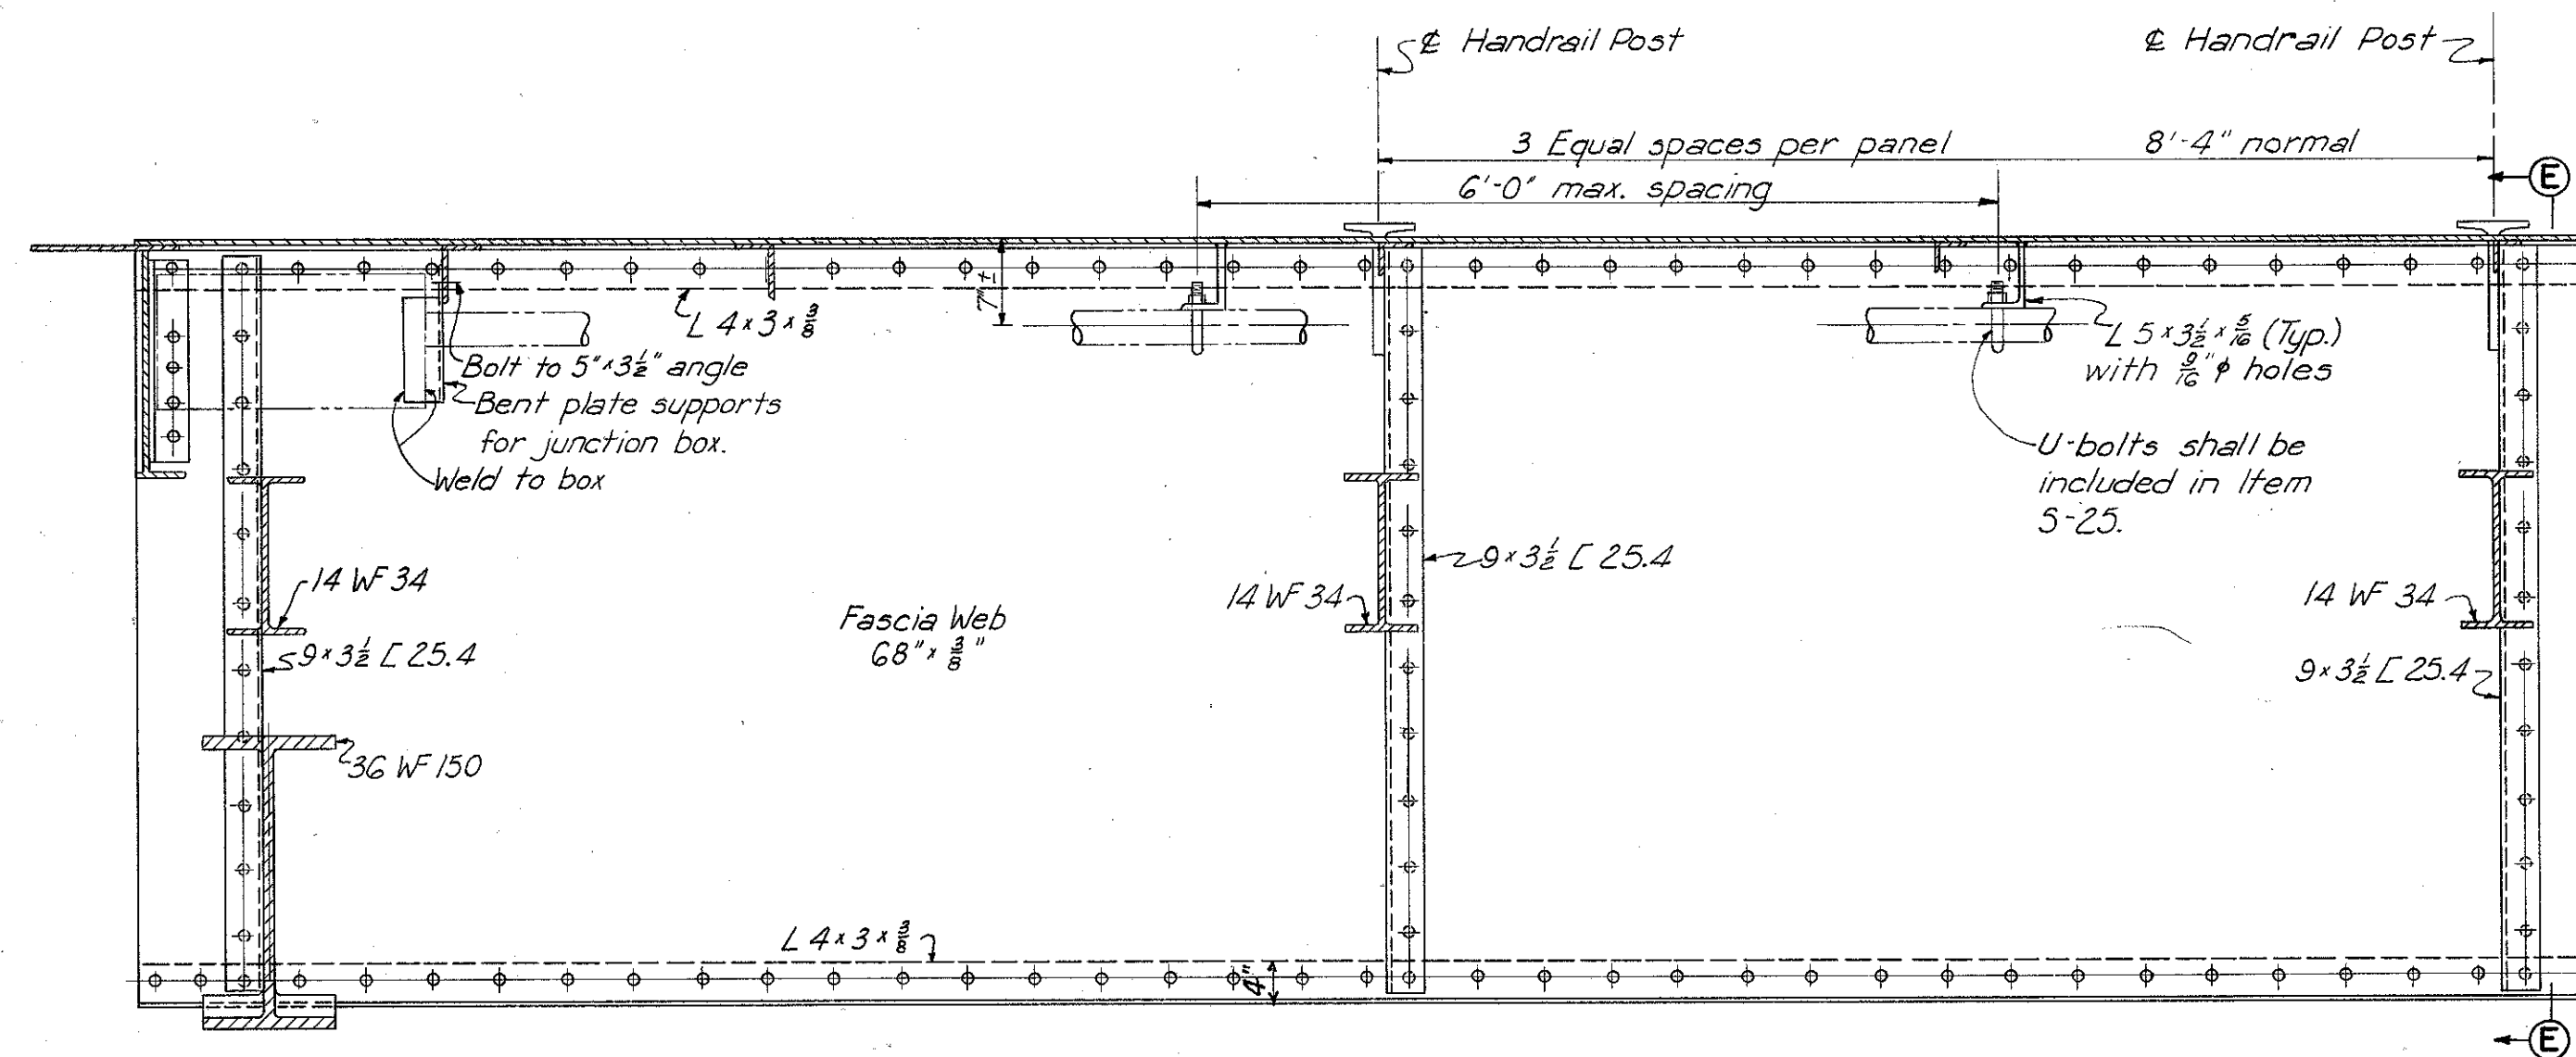


SECTION E-E


FASCIA DETAILS
SECTION A-A

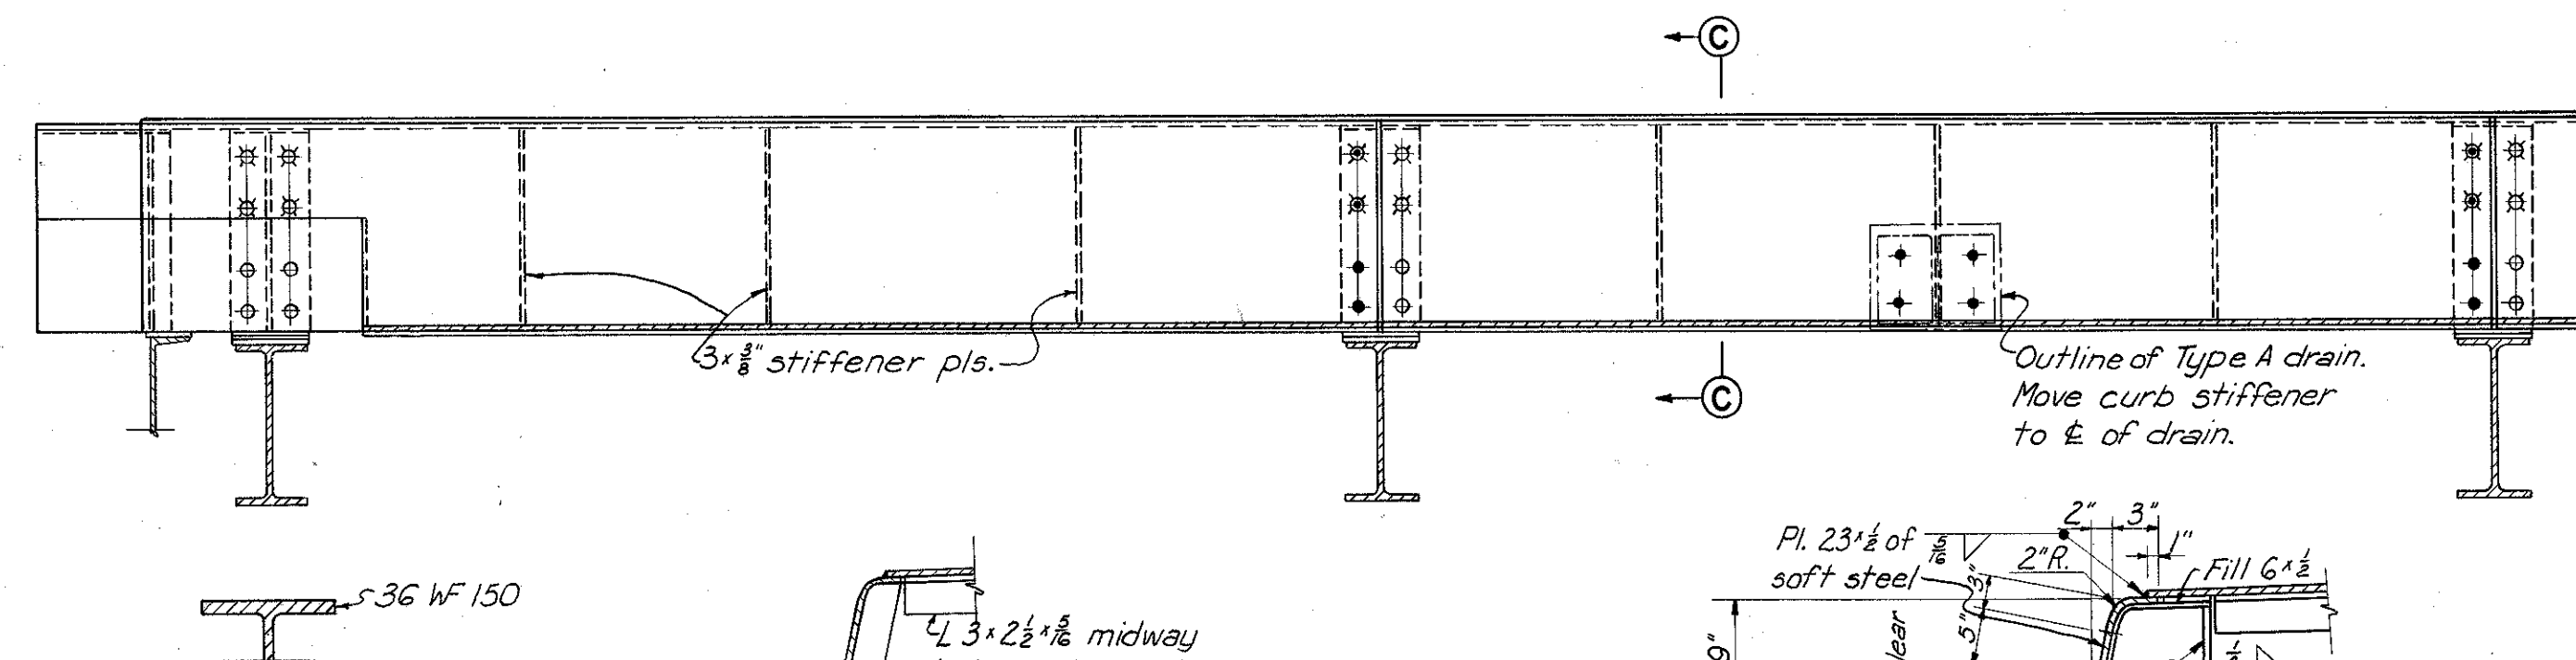


SECTION C-C-TYPICAL CURB STIFFENER

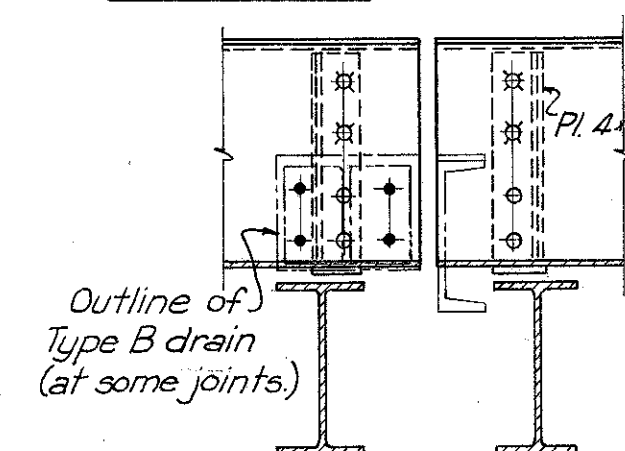

Outline of
Type B drain
(at some joints.)

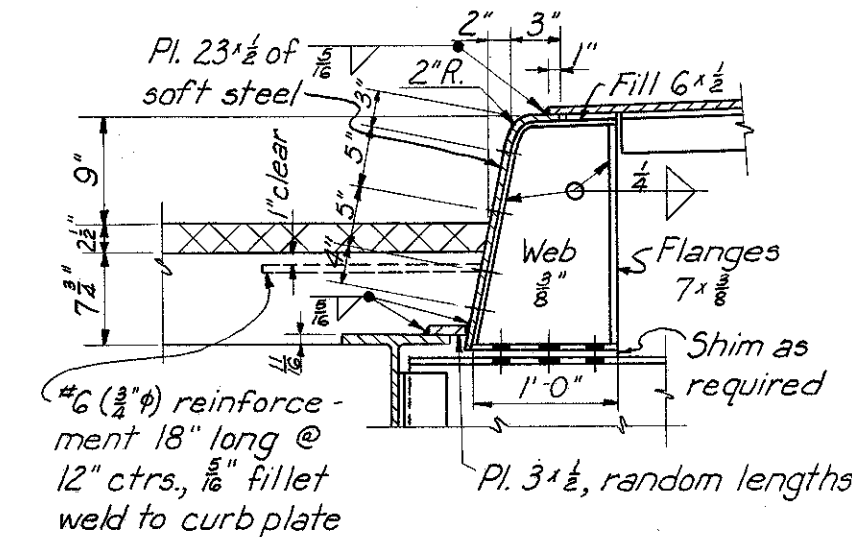

SECTION D-D - TYPICAL CURB SUPPORT

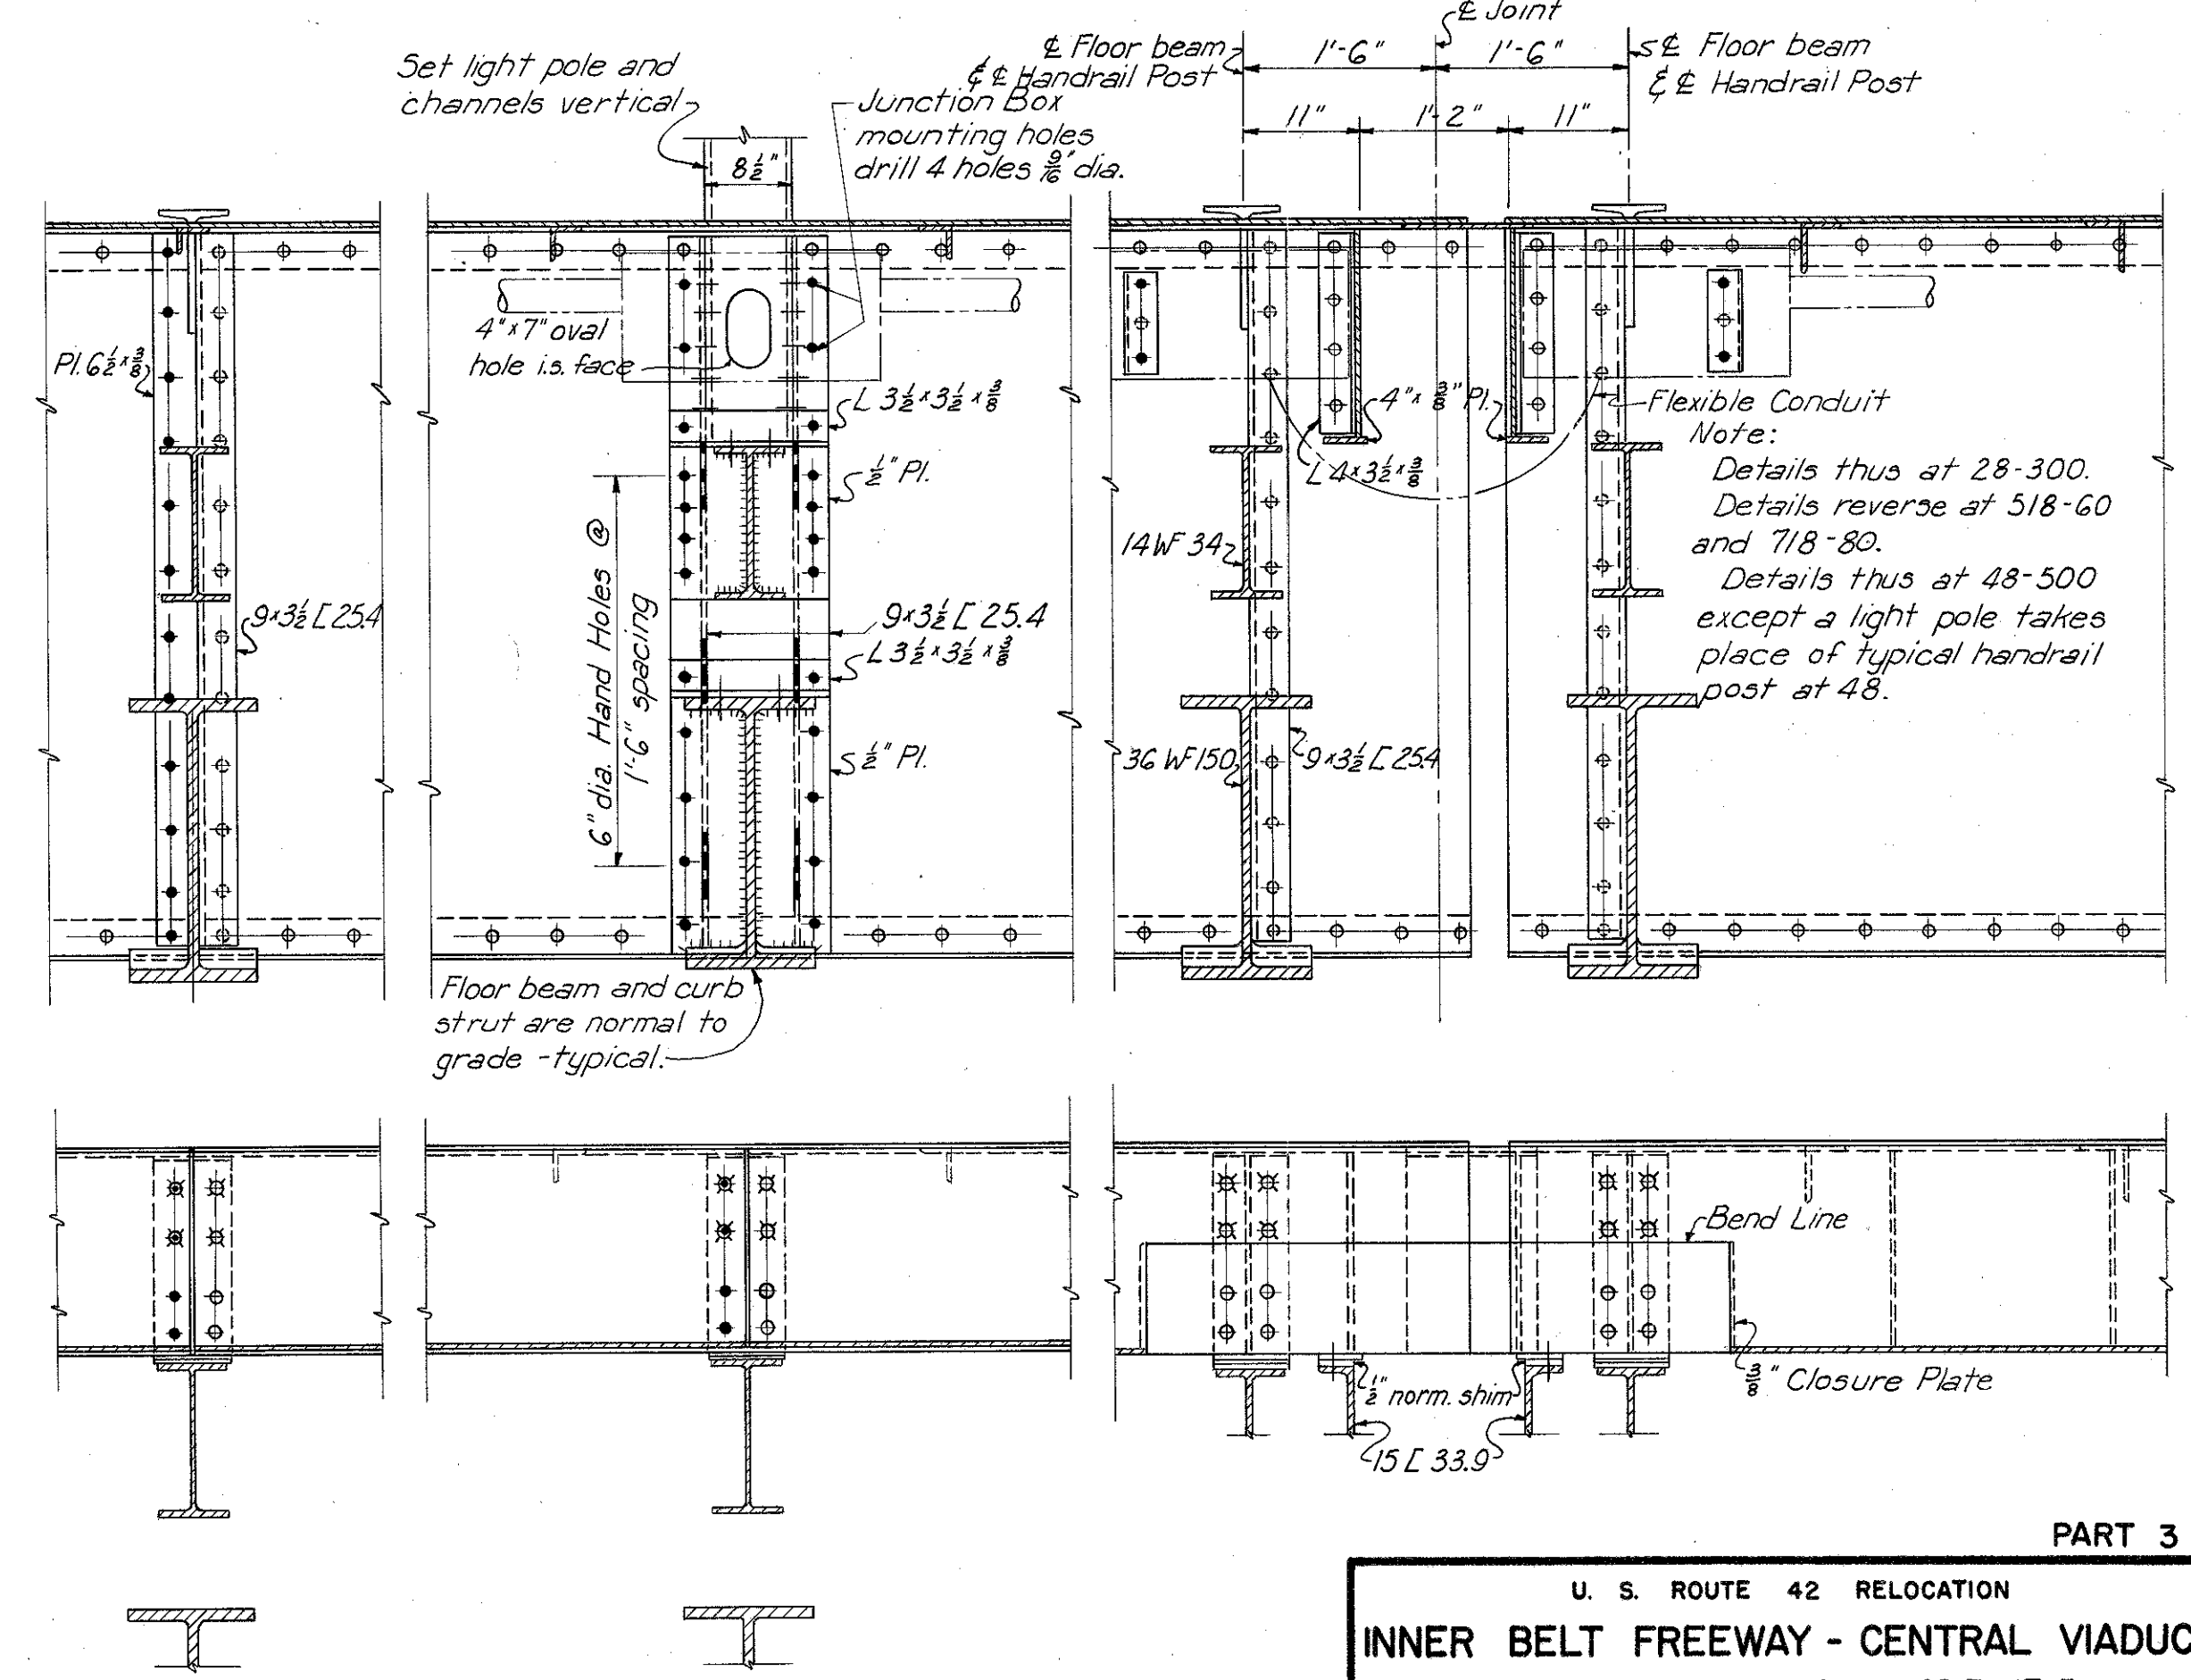

PART 3

U. S. ROUTE 42 RELOCATION
INNER BELT FREEWAY - CENTRAL VIADUCT
BR. NO. CU - 42 R-17.5


FASCIA, SIDEWALK, & CURB DETAILS

CLEVELAND CUYAHOGA COUNTY OHIO

SCALE $\frac{3}{8}" = 1'-0"$
MADE P.L.L. DATE 9-10-54
TRCD N.A.M. DATE 10-22-54
CKD D.M.D. DATE 10-25-54


HOWARD, NEEDLES, TAMMEN & BERGENDOFF
CONSULTING ENGINEERS
KANSAS CITY CLEVELAND NEW YORK
914-1A SHEET 2100

Use this drawing with
Sh. 27, 28, 111, 112, and 113.

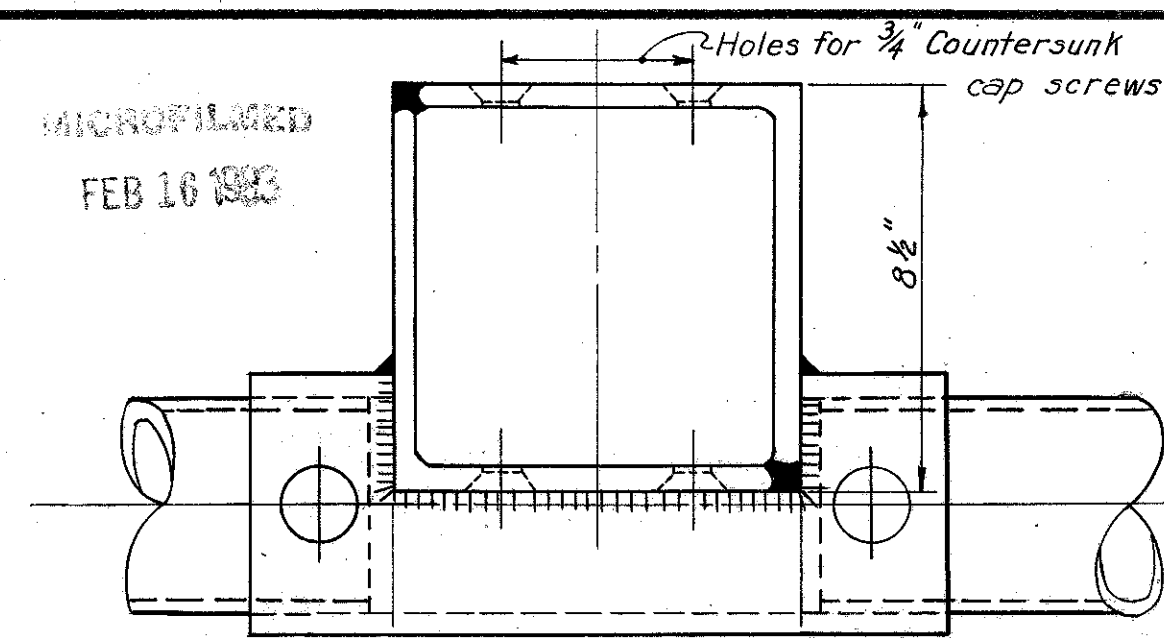

Some of these made from 4-8" $\frac{1}{2}$ " Plates

Fort Pitt asked for this in place
of angles because of large amounts
of warpage they got with angles

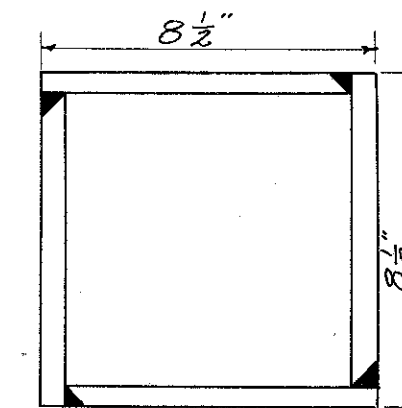


4 R's - $8 \times \frac{1}{2}$ instead of 24's $8 \times 8 \times \frac{1}{2}$


Revised As-Built

FED. ROAD DIV. NO.	STATE	FEDERAL AID PROJECT NO.	TYPE FUNDS
2	OHIO		

CUYAHOGA COUNTY
CITY OF CLEVELAND
INNER BELT FREEWAY
CENTRAL VIADUCT

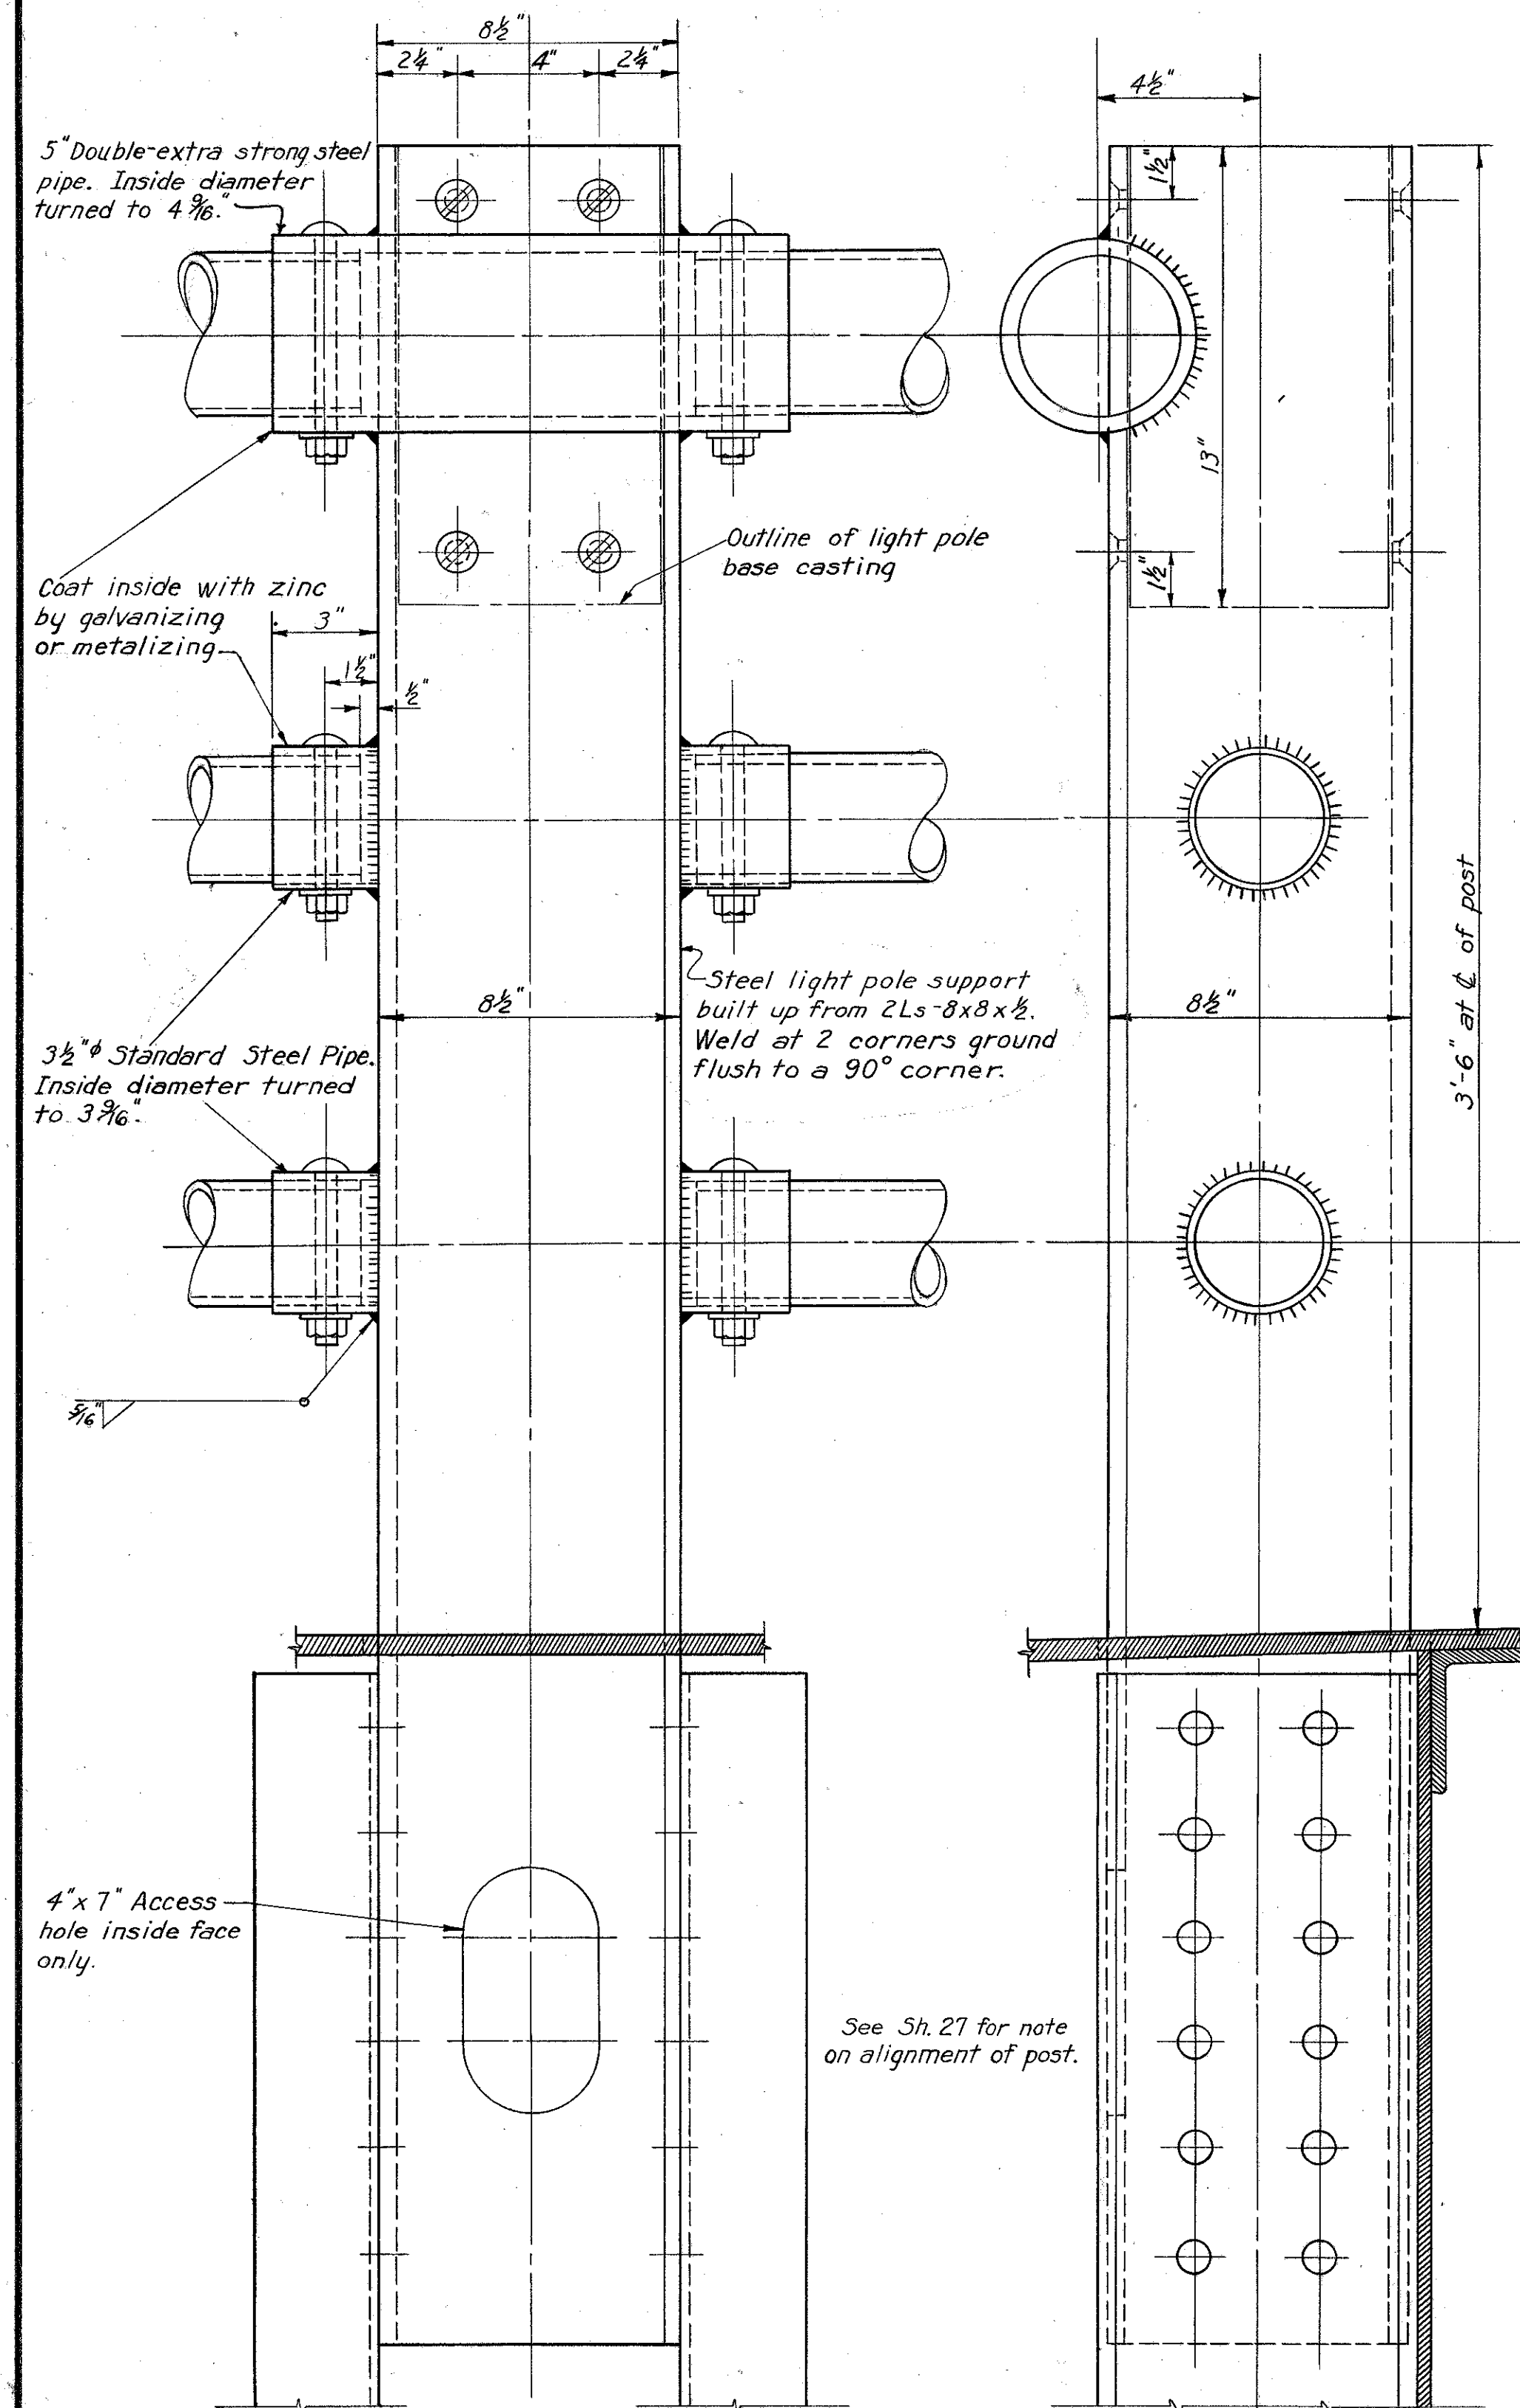

LIGHT POLE SUPPORT HP-2 54 REQUIRED
For details not noted see Typical Handrail Post.

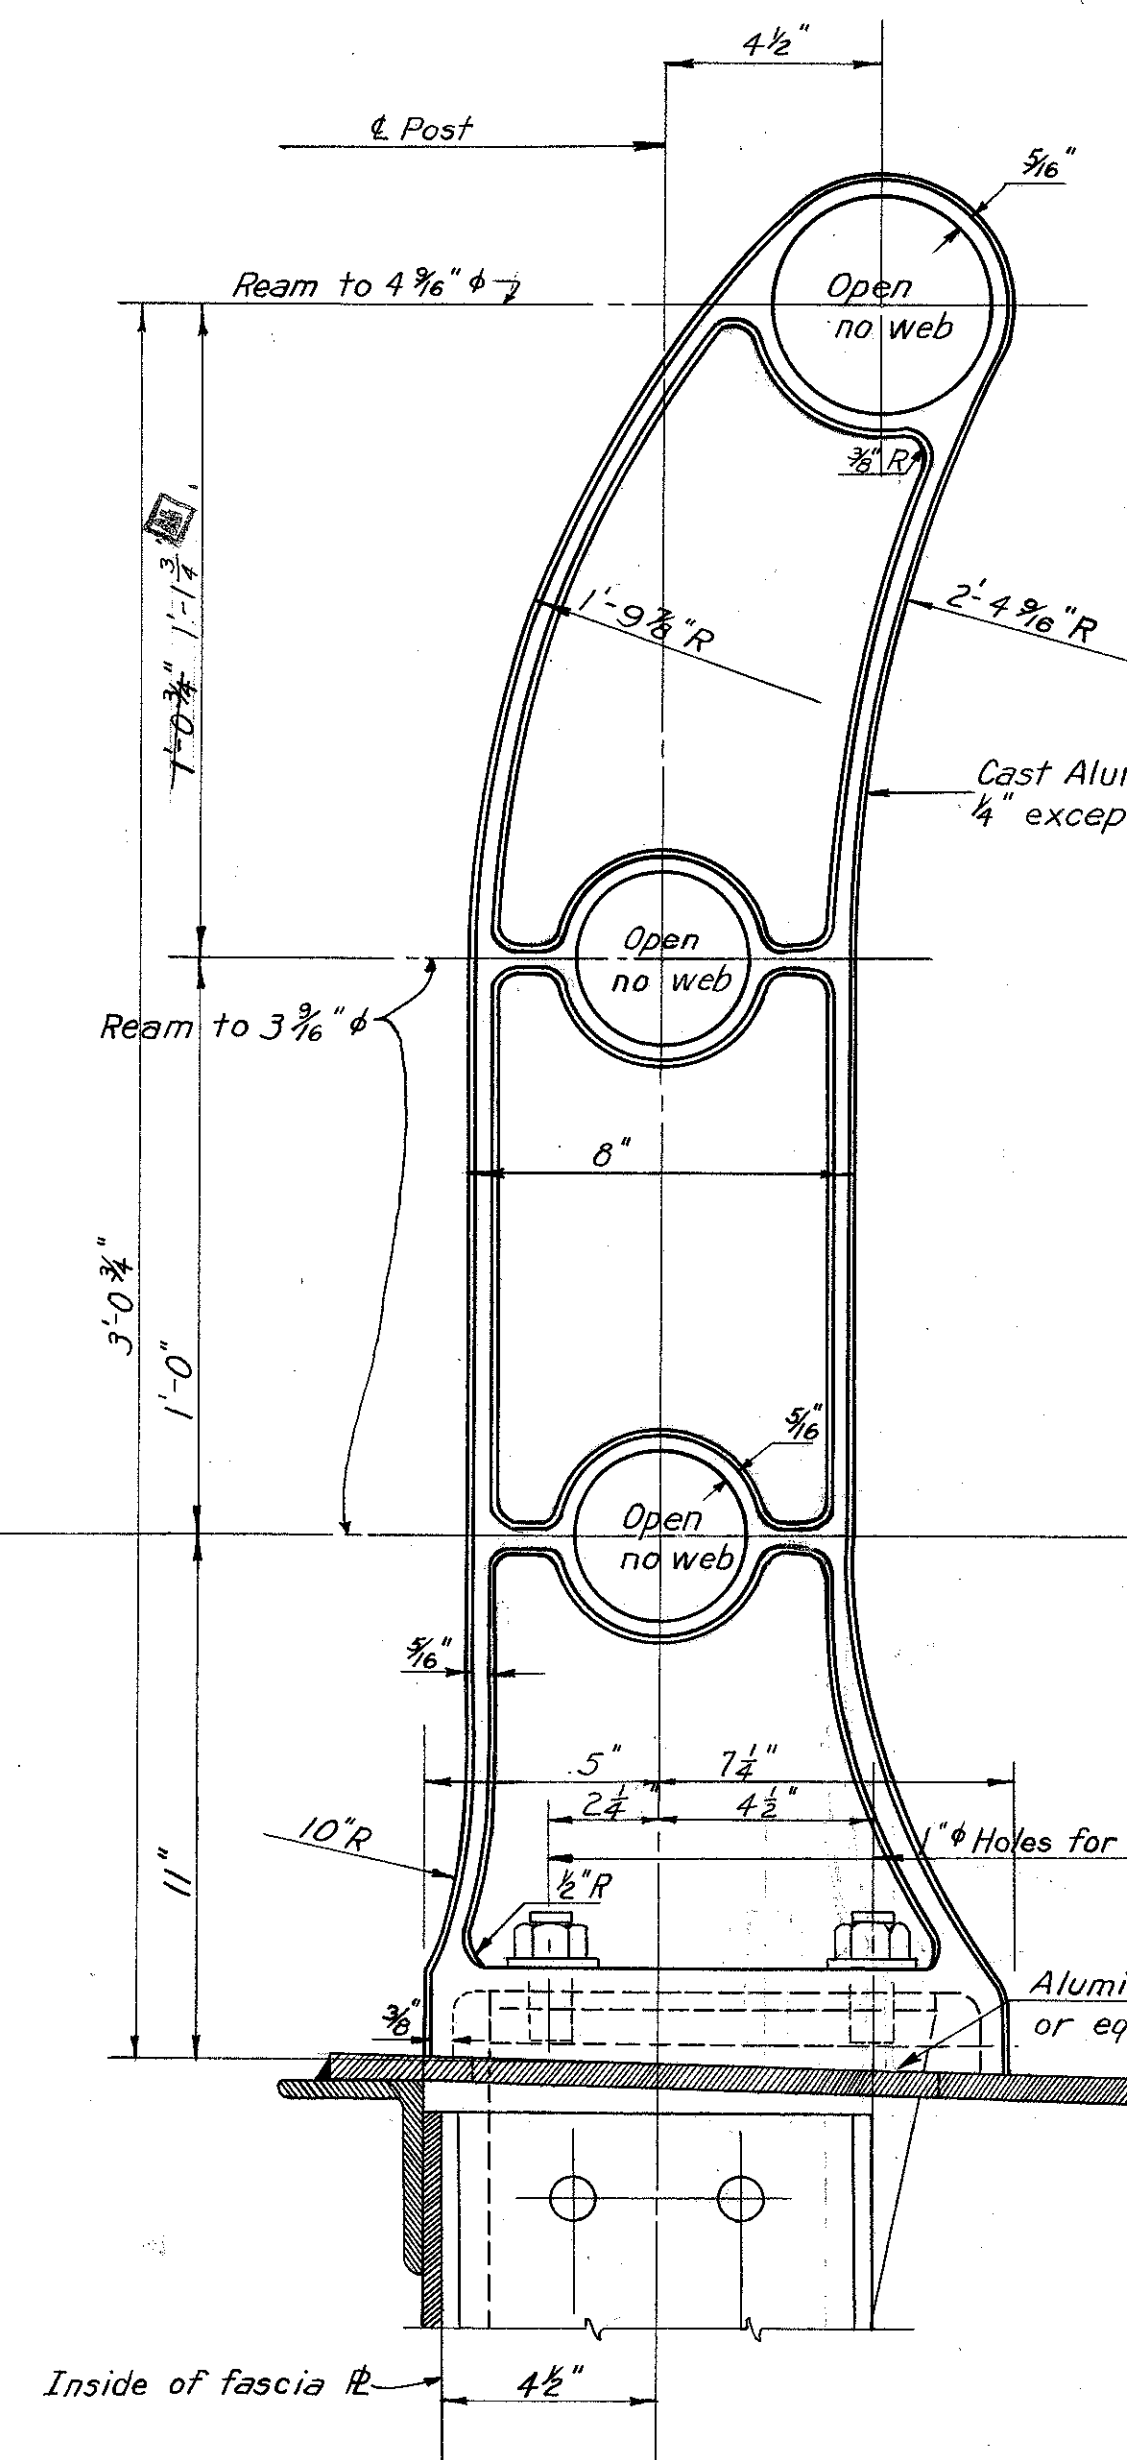

$\frac{1}{16}$ " square holes under heads, $\frac{1}{16}$ " ϕ under nuts.

1" Clearance at 60°
4 1/2" O.D. x 3/16" wall
aluminum tube →

. All fillets
 . All draft

3 1/2" O.D. x 5/16" wall
aluminum tube
or 3" Extra Strong
Aluminum pipe

$\frac{5}{8}$ " ϕ Aluminum carriage bolts with hex nuts; $6\frac{1}{2}$ " long in top rail and $5\frac{1}{2}$ " long in bottom rail. Burr

long in top rail and 32
long in bottom rail. Burr
threads $10''$ p

4"

2- $\frac{7}{8}''$ ϕ studs with washers
and hex nuts. All galvanized.

Spot face under washers

weld, $\frac{5}{16}$ " min.—

10"x1" Slot in
sidewalk plate

All vertical dimensions for base of post are at
£ Post.

TYPICAL HANDRAIL POST HP-1 606 REQUIRED

NOTES ON HANDRAILS

Handrails shall be fabricated in lengths equal to 1 space, generally 8'-3". See framing plans for exact spacing.


Bolt holes in tubes shall be $\frac{1}{16}$ " ϕ at one end. Other end shall have slotted holes $\frac{1}{16}$ " x 1" except at expansion joint where no holes are required at expansion end. Bolts to be centered in slots at 60°F.

Aluminum washer shims may be used between steel and post base to align posts. Maximum thickness shall be $\frac{1}{8}$ ". Space below post base plate shall be thoroughly calked with Alumilastic compound or equal.

Handrail posts shall be set normal to grade.

Light pole supports shall be set vertical.

For connection of light pole supports and handrail posts to superstructure see Sheets 27, 28, and 100. Handrail is to end 8'-4" from C of Bearing of end piers. See Sheet 100.

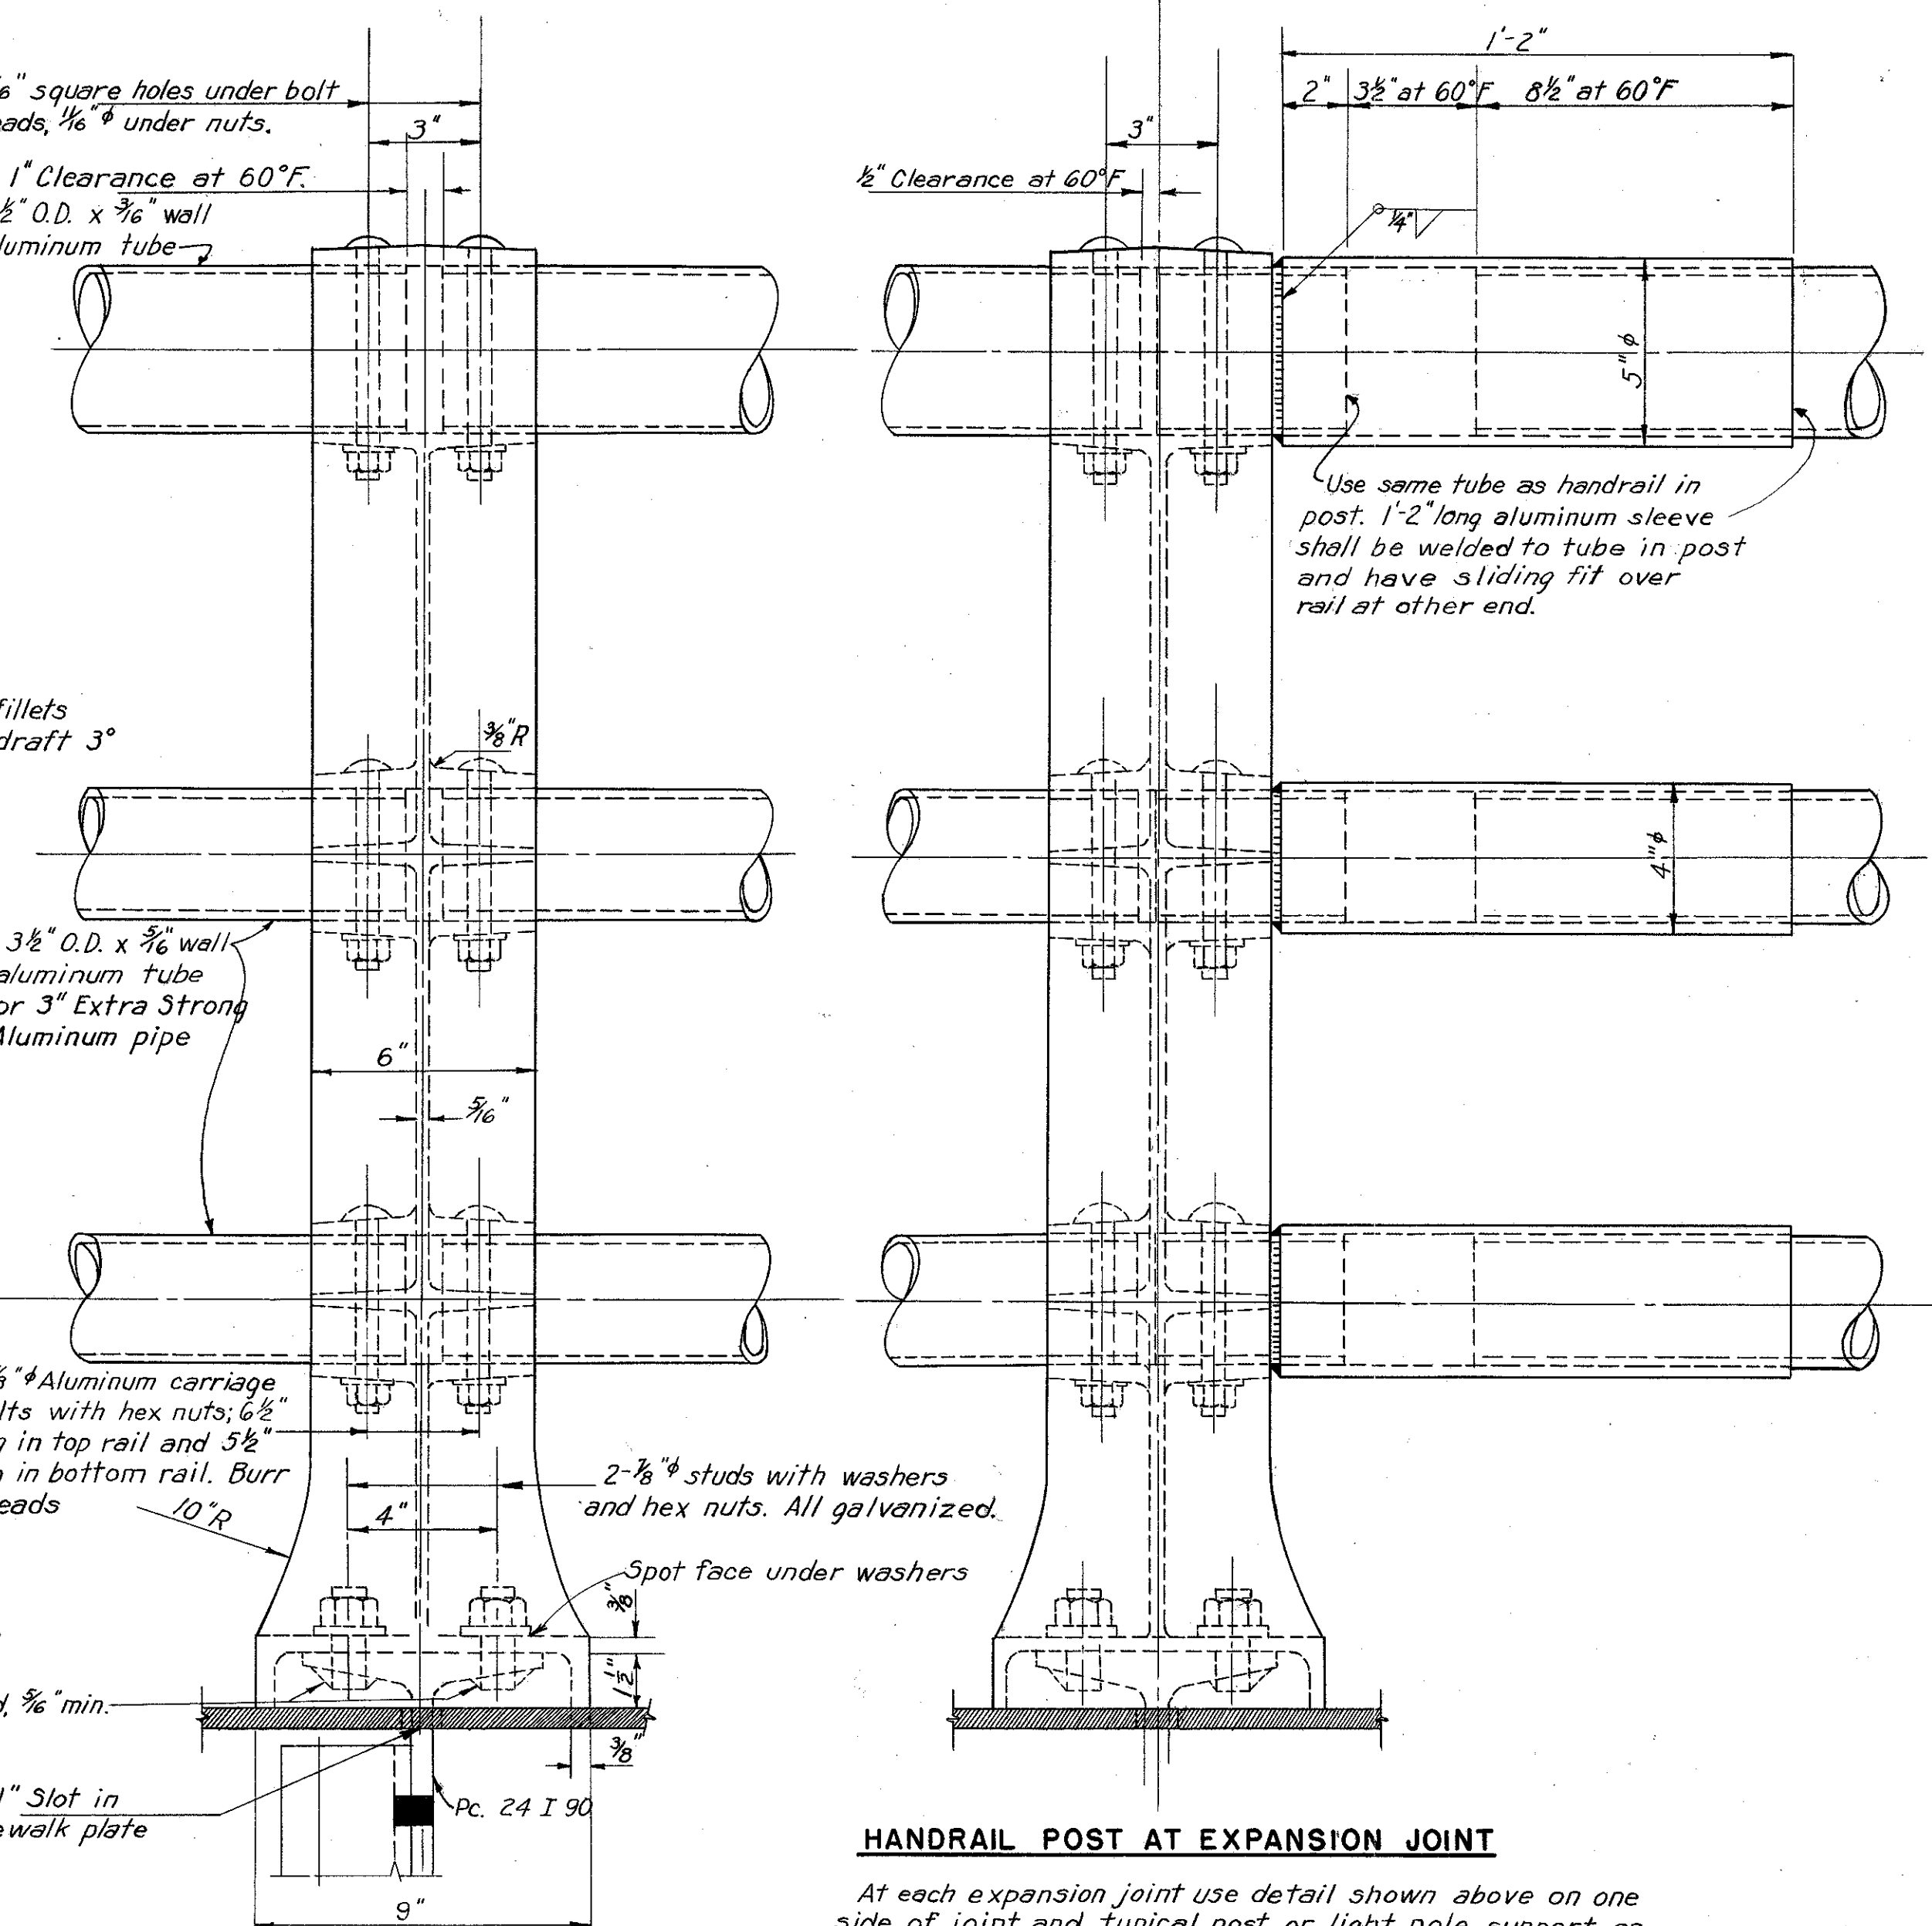

HANDRAIL POST AT EXPANSION JOINT

At each expansion joint use detail shown above on one side of joint and typical post or light pole support on other side.

PART 3

U. S. ROUTE 42 RELOCATION
INNER BELT FREEWAY - CENTRAL VIADUCT
BR. NO. CU - 42 R-17 5

HANDRAIL

CLEVELAND CUYAHOGA COUNTY OHIO

SCALE $3'' = 1' - 0''$
MADE DME DATE 8-24-54
TRCD GJK DATE 12-8-54
CKD DMD DATE 11-22-54

HOWARD, NEEDLES, TAMMEN & BERGENDOFF
CONSULTING ENGINEERS
KANSAS CITY CLEVELAND NEW YORK

10-18-58

Revised As-Built JEP



MICROFILMED
FEB 16 1980

FED. ROAD DIV. NO.	STATE	FEDERAL AID PROJECT NO.	TYPE FUNDS
2	OHIO		




98
122

CUYAHOGA COUNTY
CITY OF CLEVELAND
INNER BELT FREEWAY
CENTRAL VIADUCT




TABULATION OF SHOES	
SHOE	PIER
F31	5 N, 53, 7N, 73
F32	3 N, 33, 8N, 83
F33	1N, 13

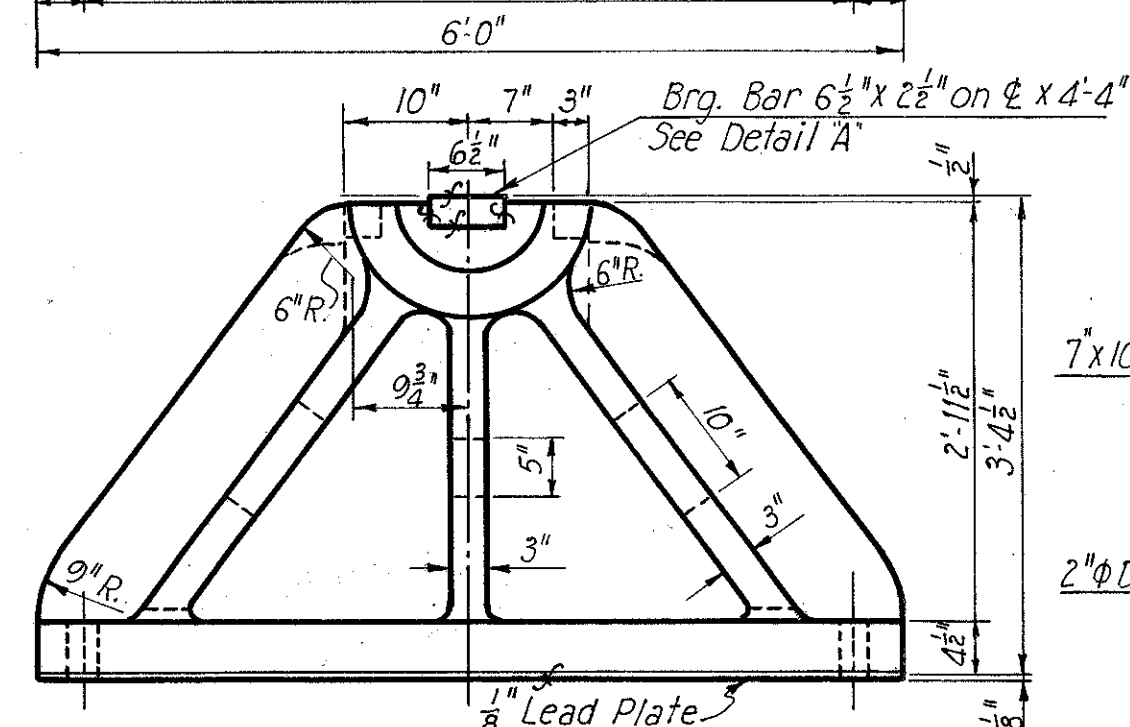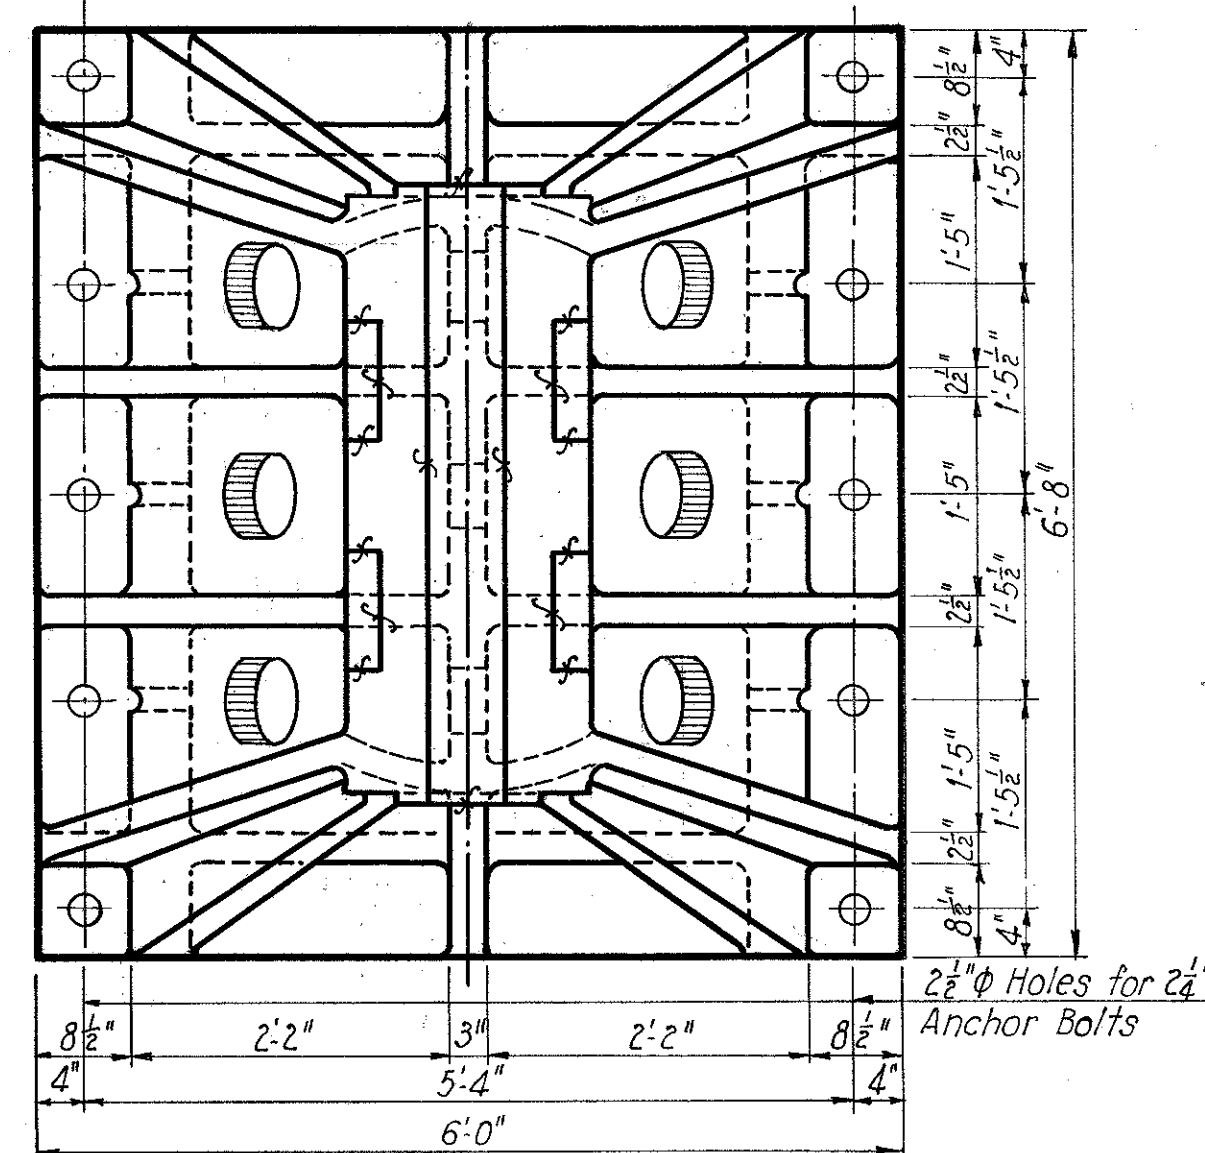



FIXED SHOE F.S.-2
Scale: 3/4" = 1'-0"

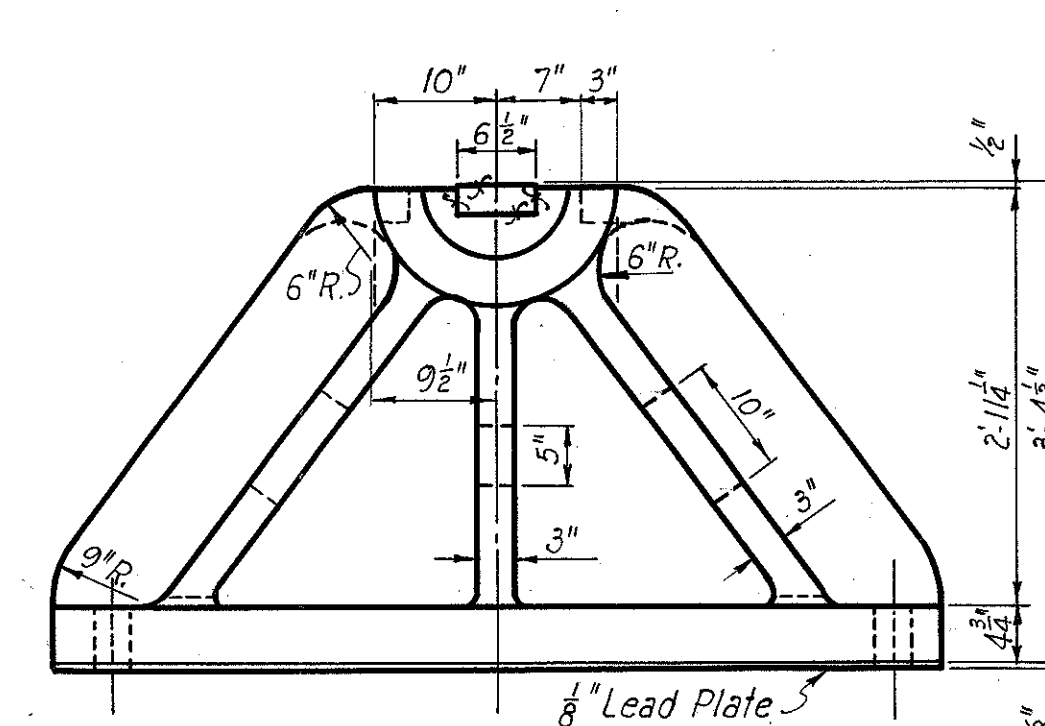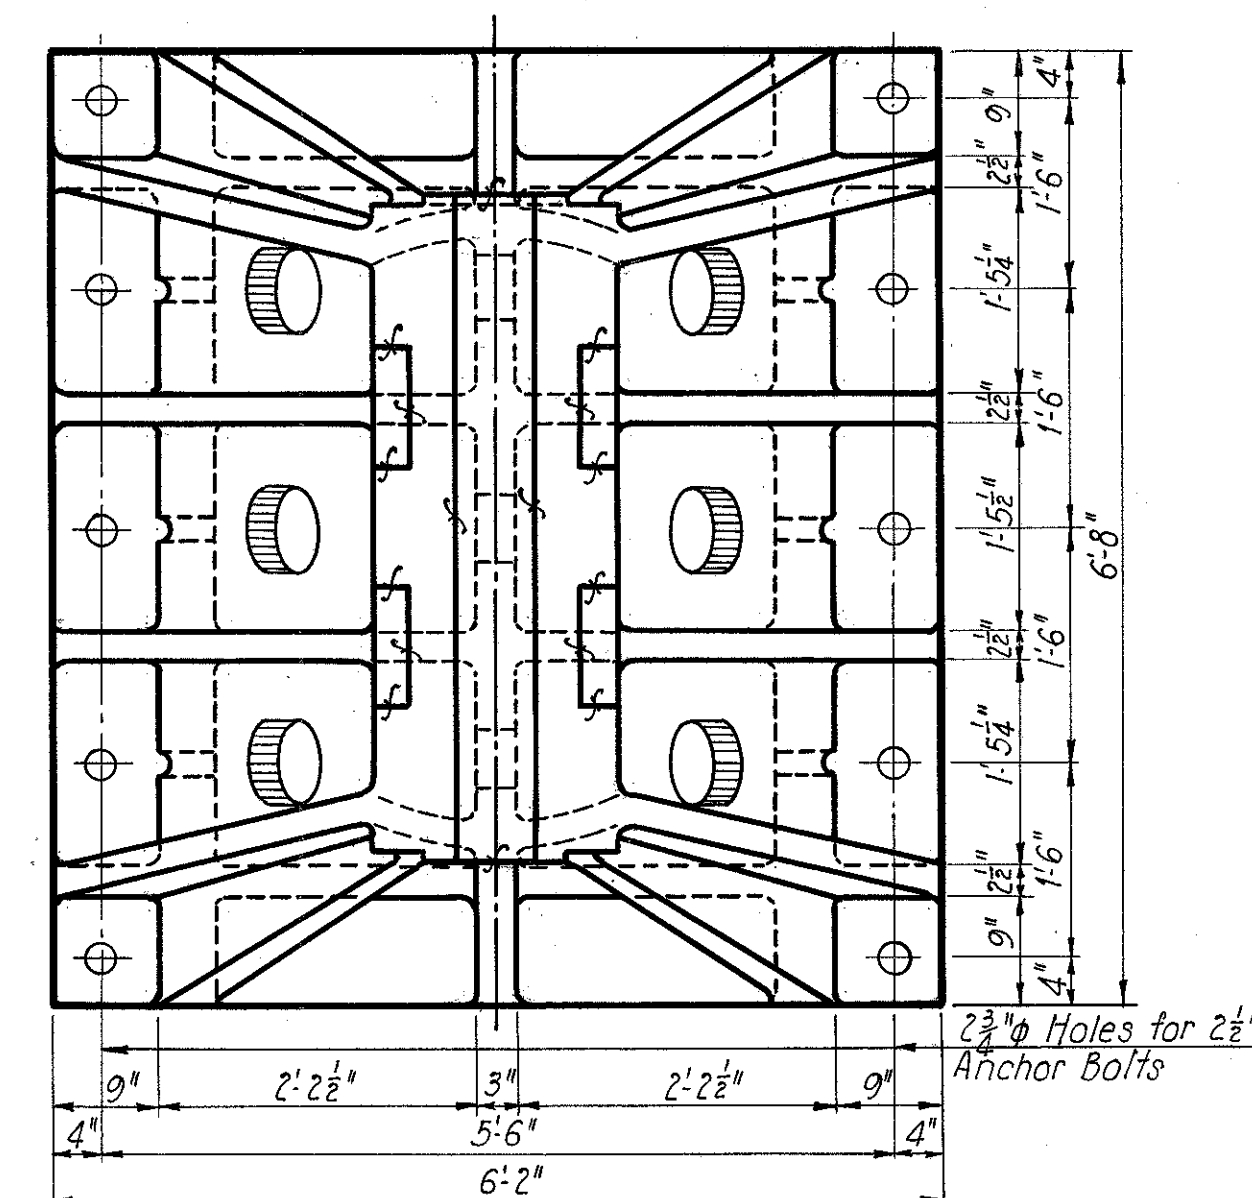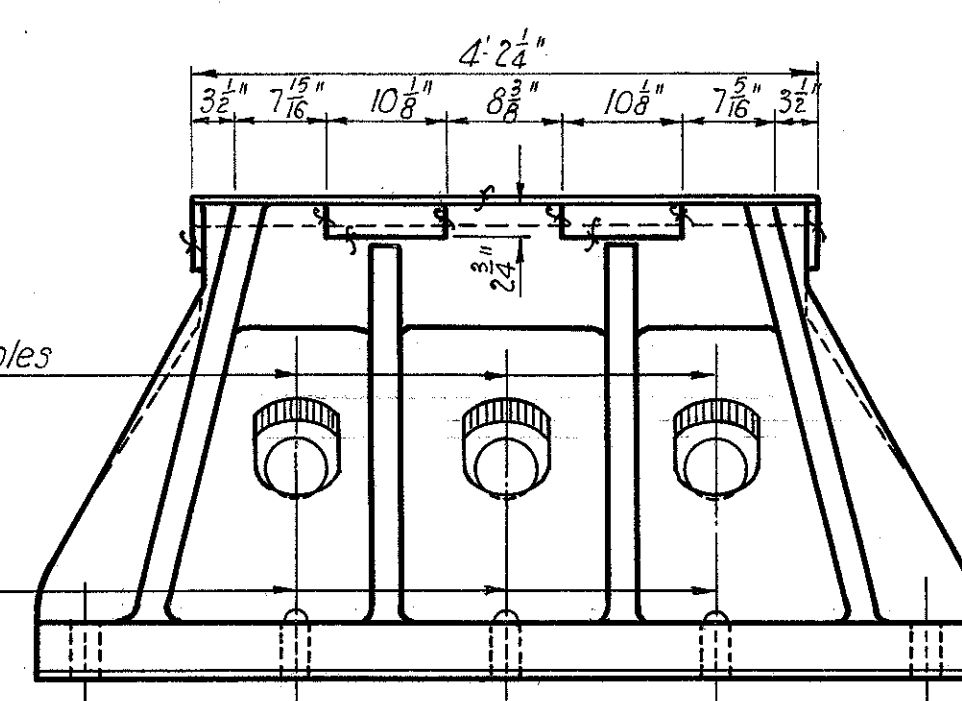


FIXED SHOE F.S.-3
Scale: 3/4" = 1'-0"

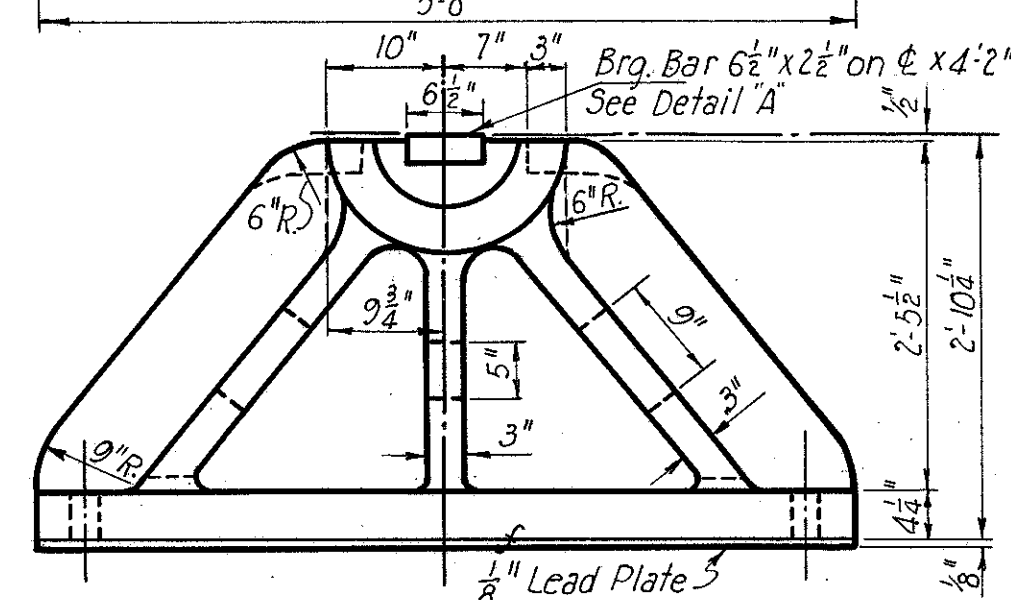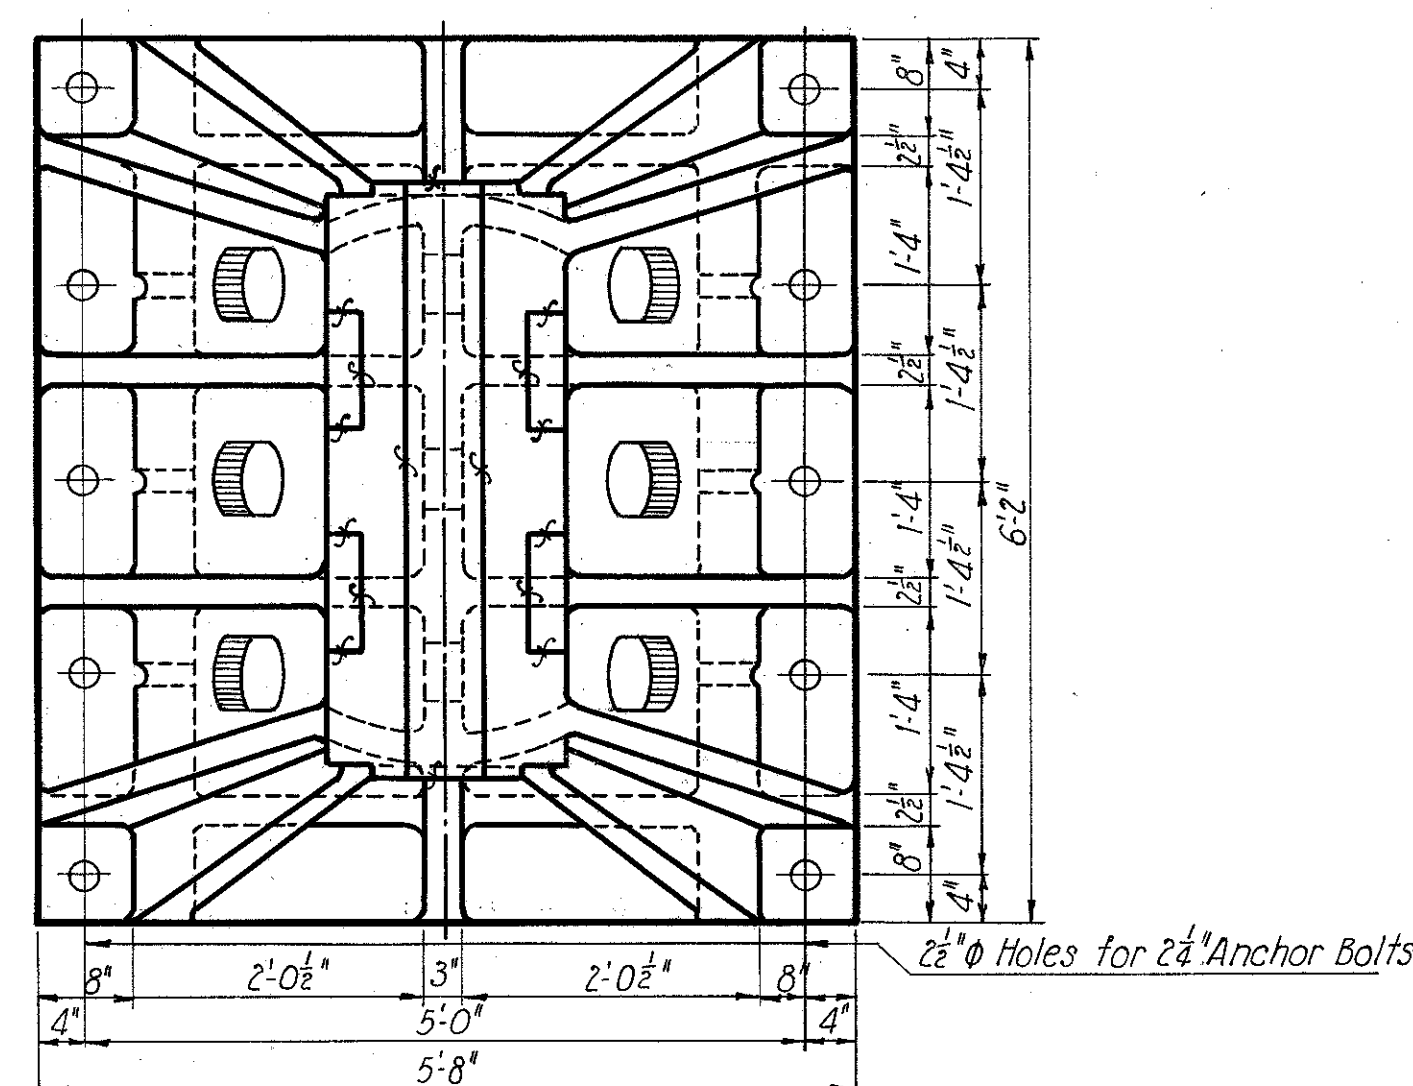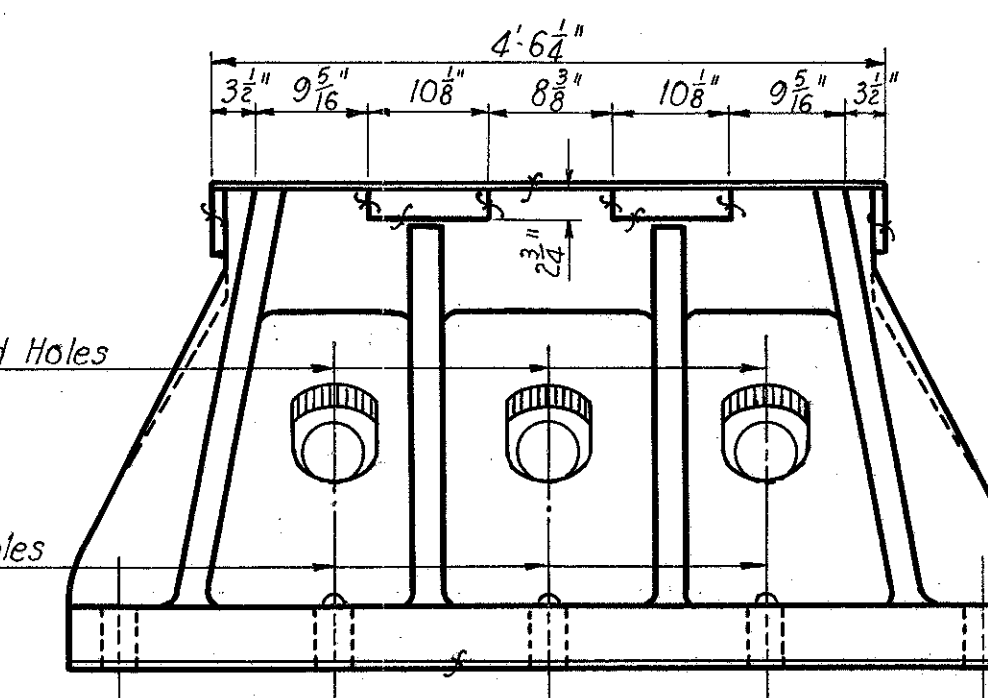

FIXED SHOE F.S.-1
Scale: 3/4" = 1'-0"

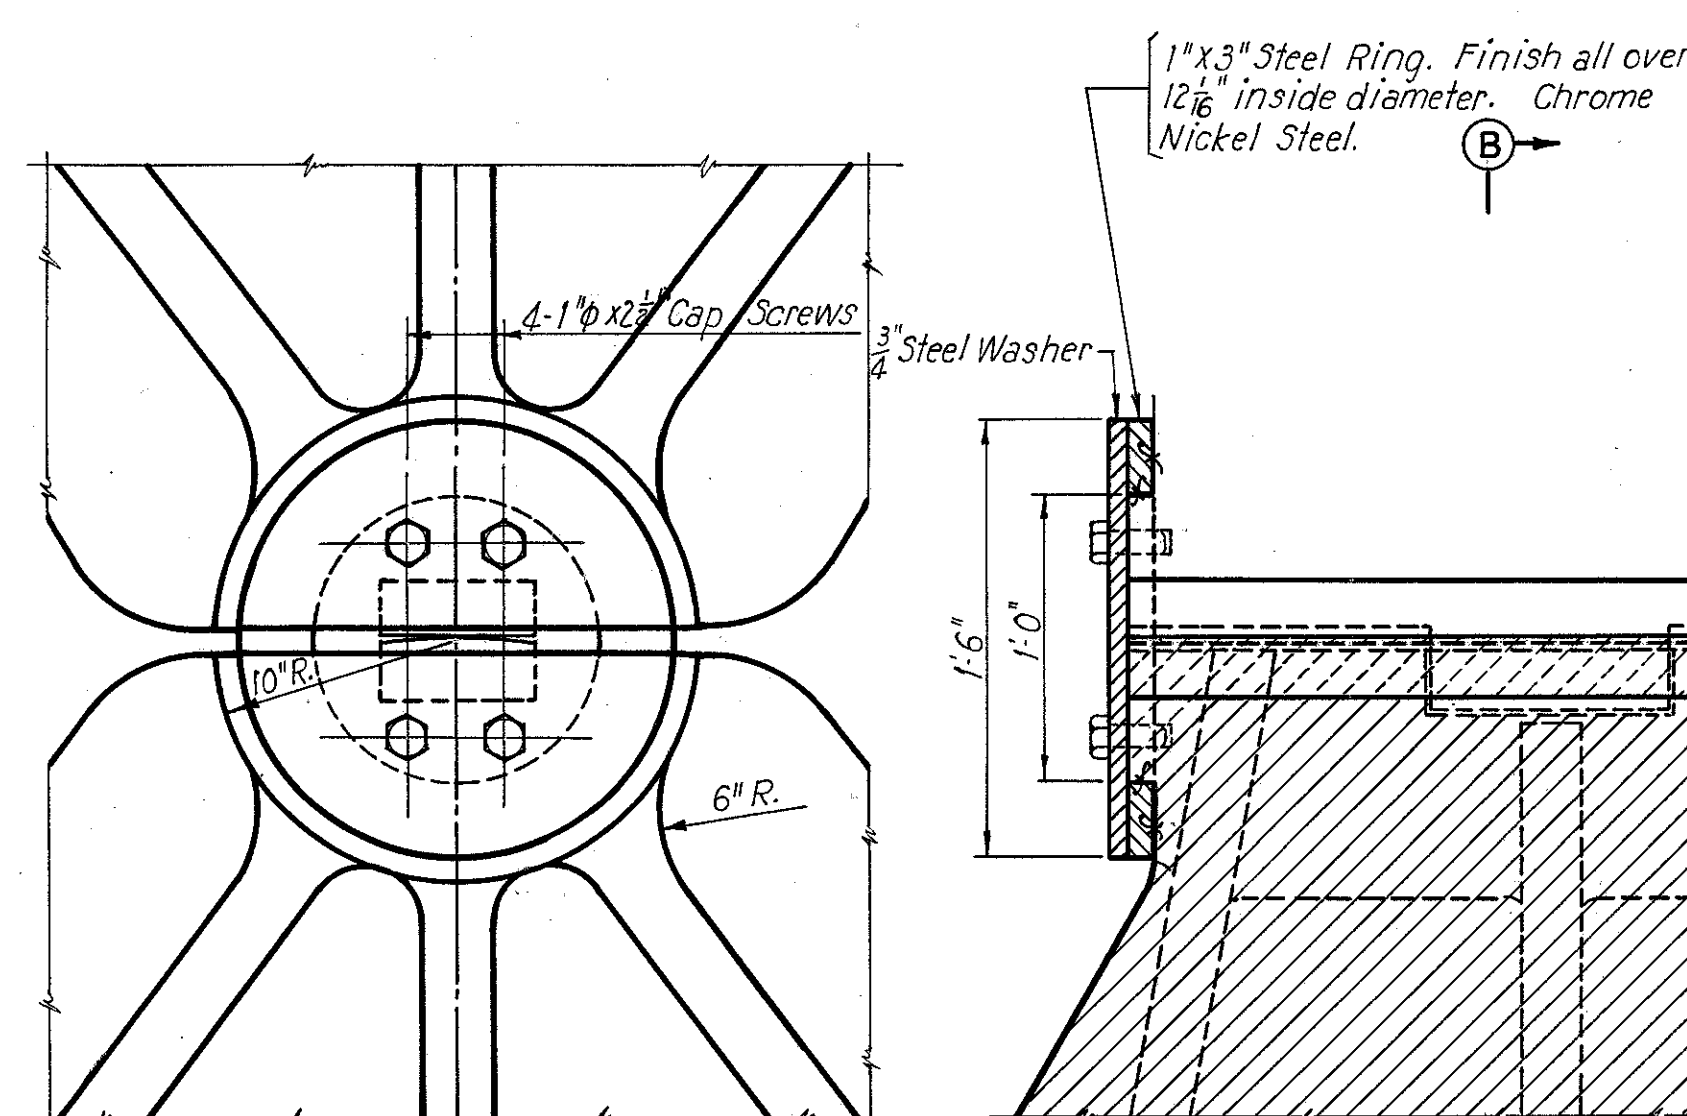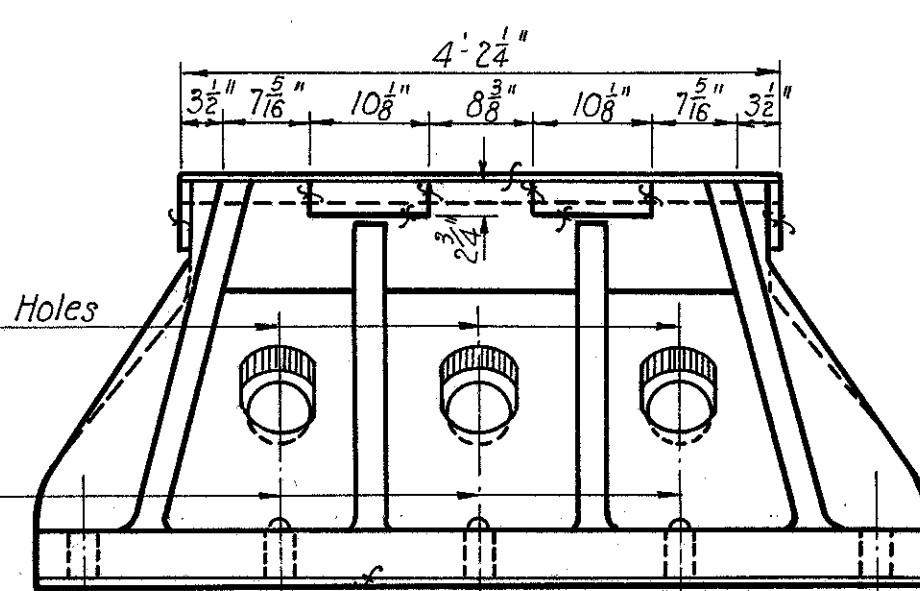

DETAIL "A"
Scale: 1 1/2" = 1'-0"

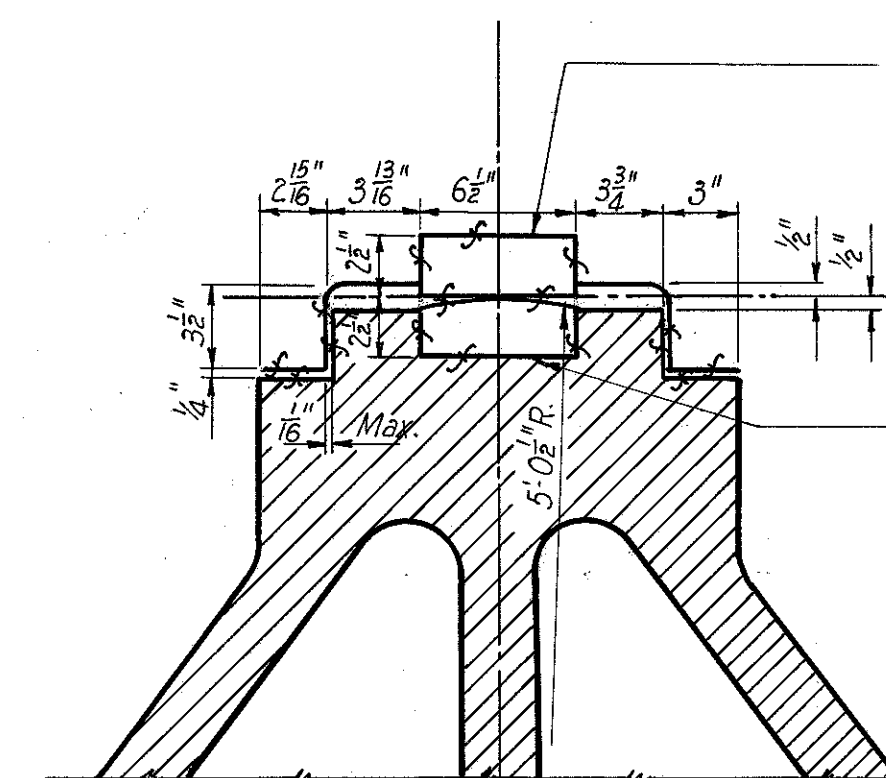

SECTION B B
Scale: 1 1/2" = 1'-0"

Note:
For General Notes on fabrication and materials of shoe castings, see Sh. 97.

PART 3



U. S. ROUTE 42 RELOCATION
INNER BELT FREEWAY - CENTRAL VIADUCT
BR. NO. CU - 42 R-17 5

FIXED SHOES











CLEVELAND CUYAHOGA COUNTY OHIO

SCALE: 3/4" = 1'-0"
MADE D.L.C. DATE: 2-26-54
TRCD. R.P. DATE: 8-2-54
CKD. D.M.E. DATE: 9-2-54
HOWARD, NEEDLES, TAMMEN & BERGENDOFF
CONSULTING ENGINEERS
KANSAS CITY CLEVELAND NEW YORK
914-1A SHEET 2.98

CUYAHOGA COUNTY
CITY OF CLEVELAND
INNER BELT FREEWAY
CENTRAL VIADUCT

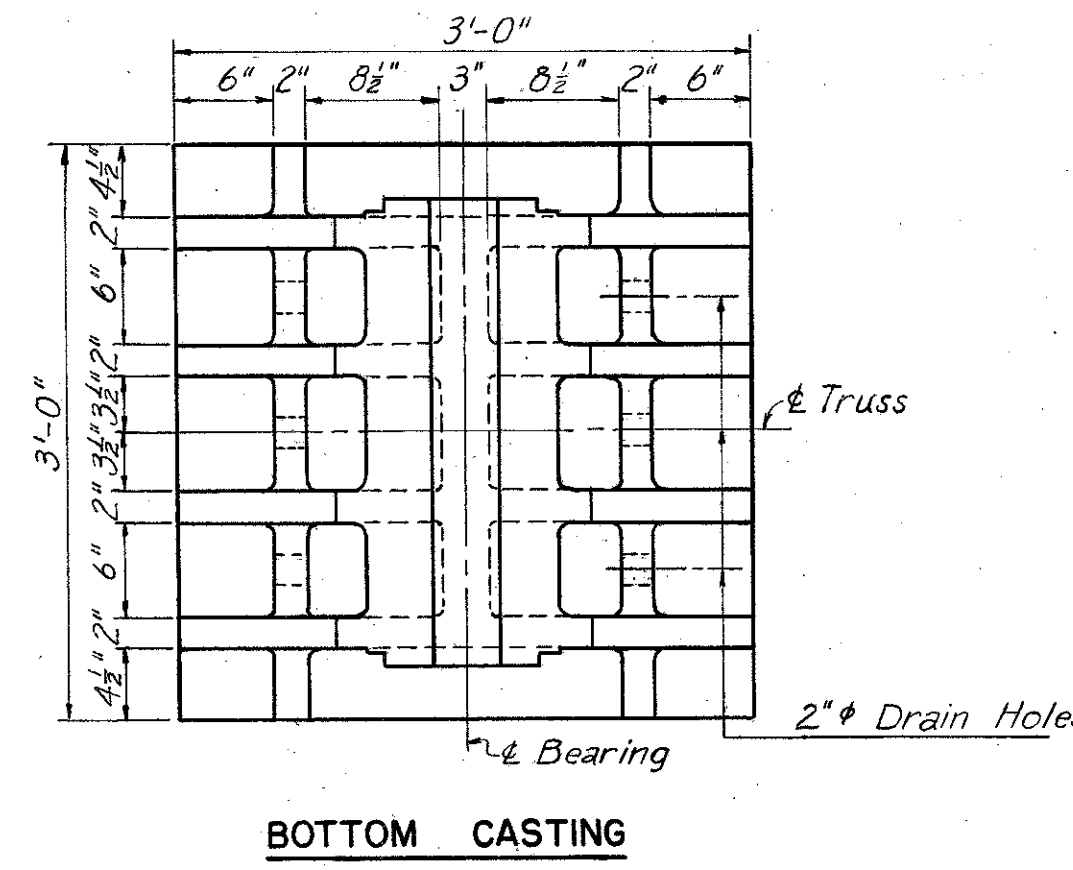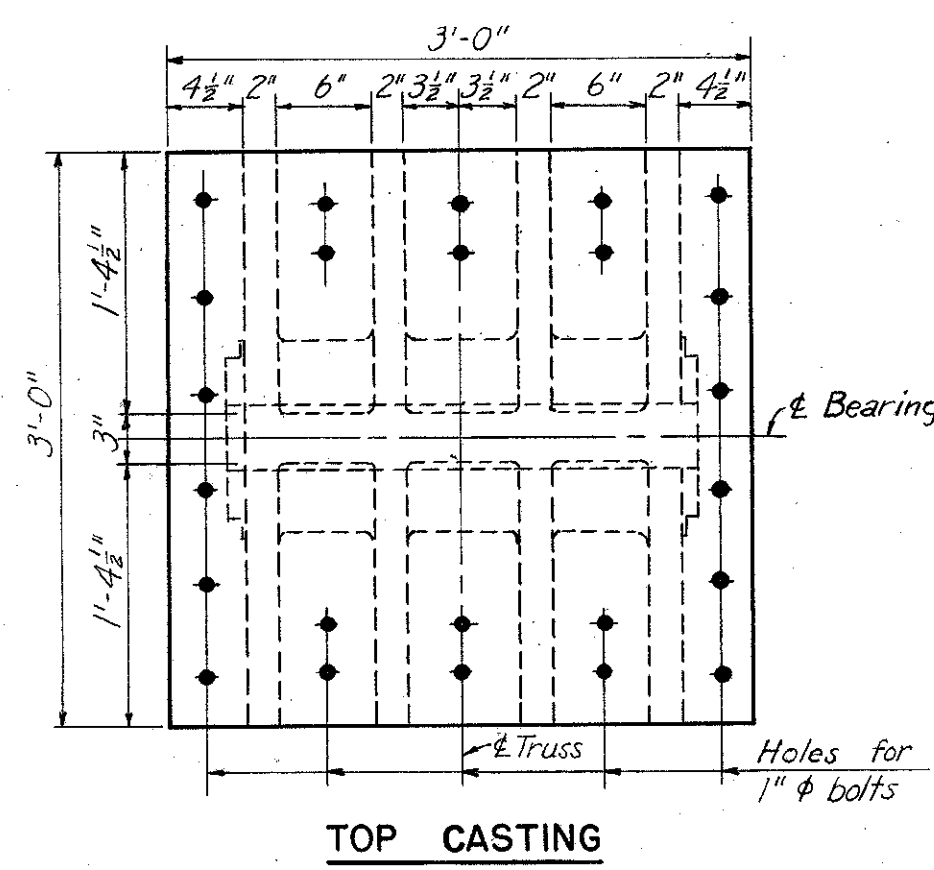





Top casting same as top casting for shoe ES-4

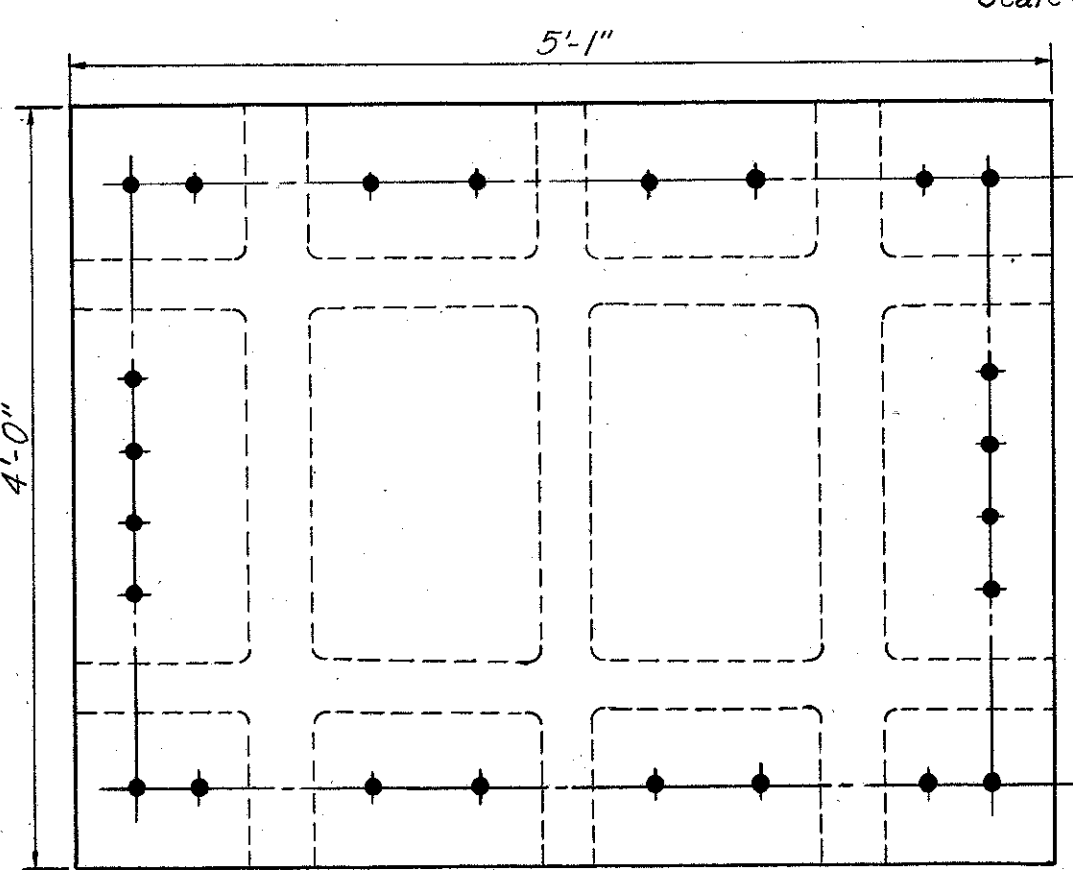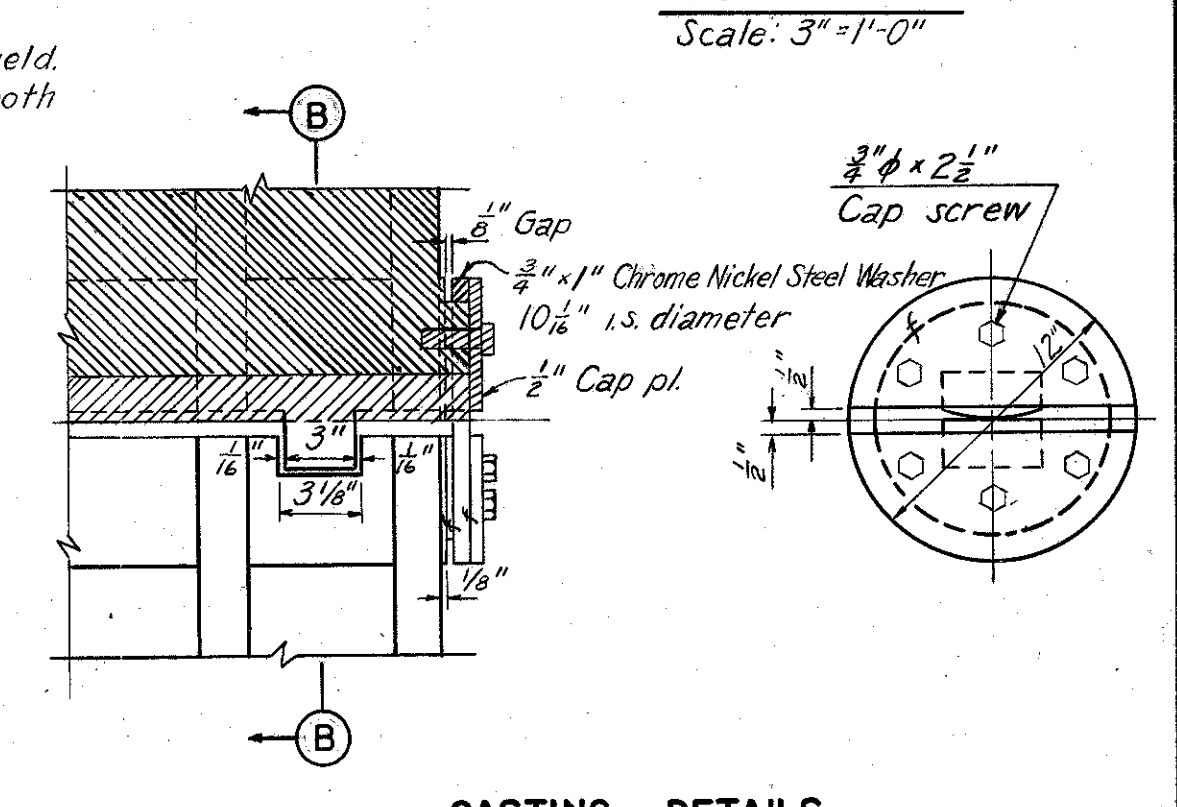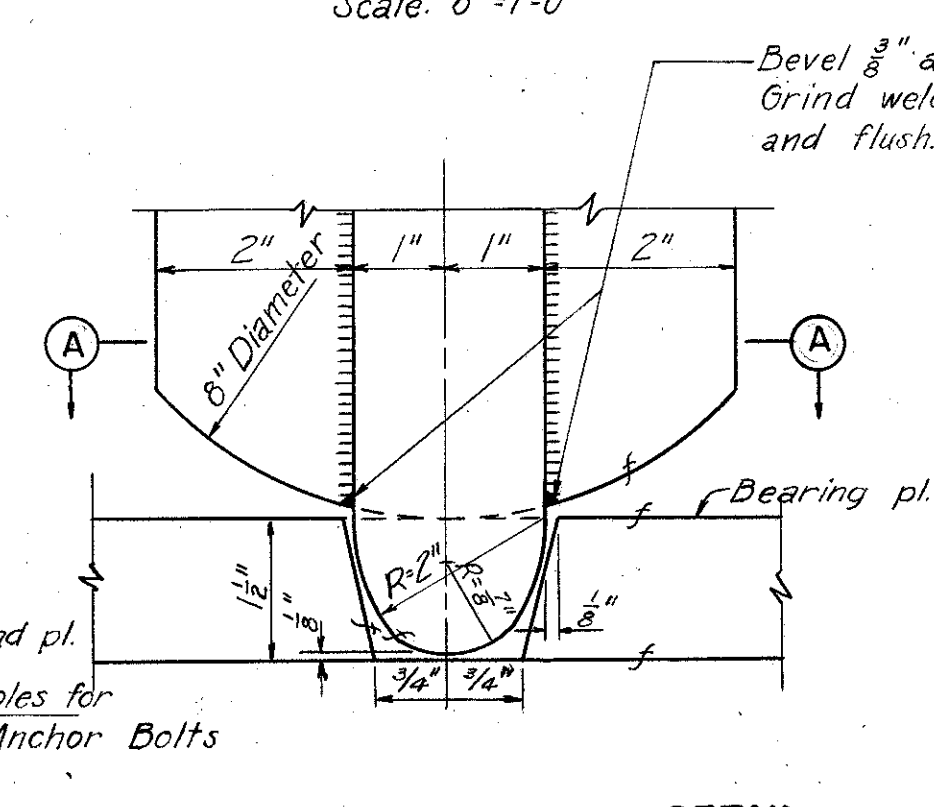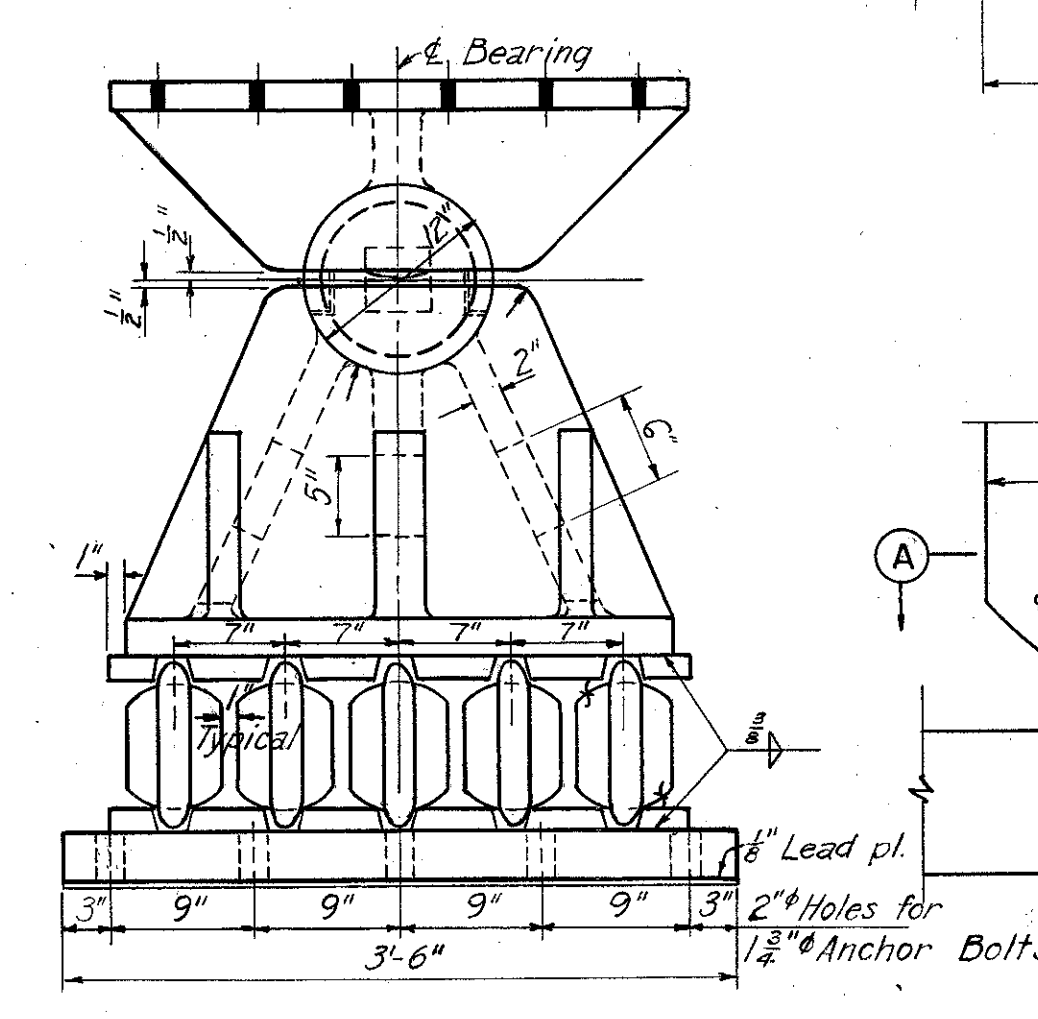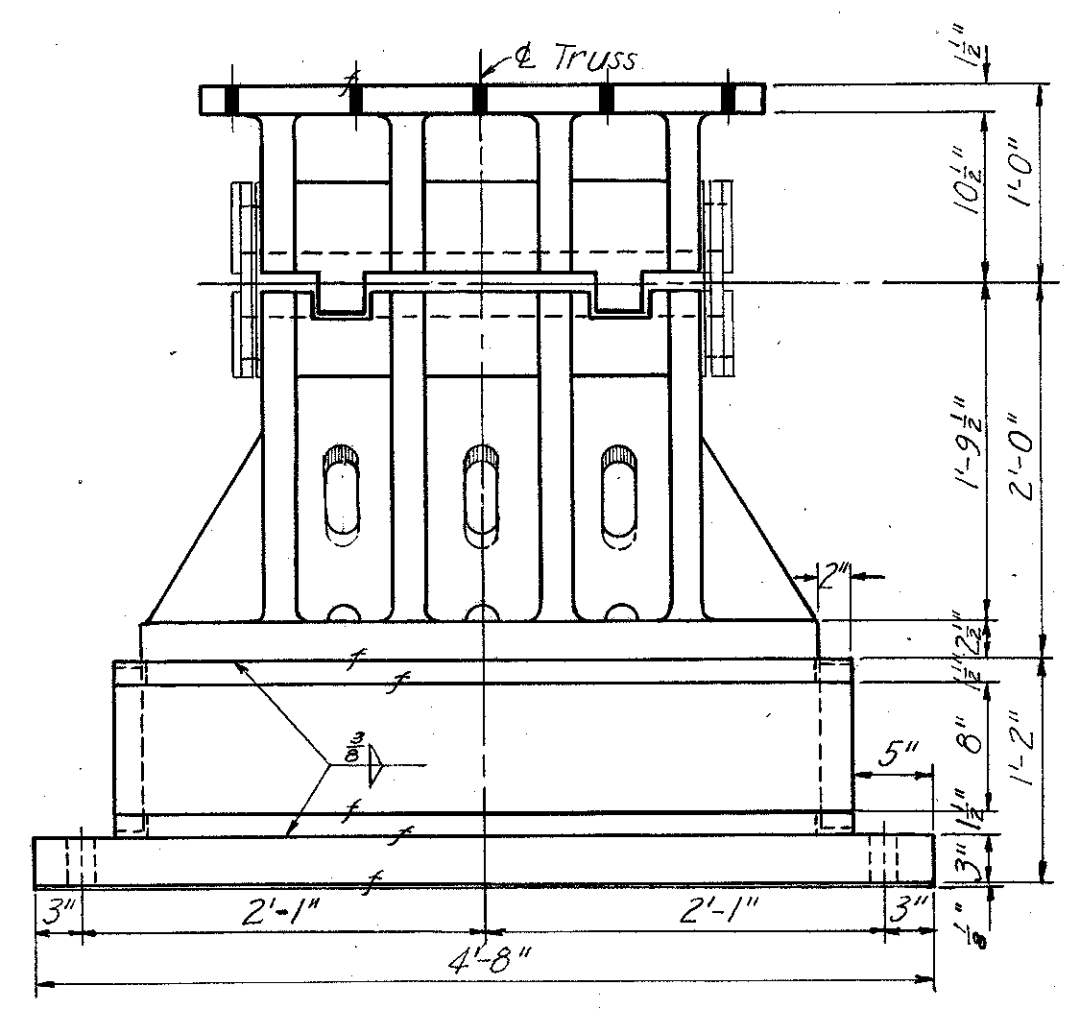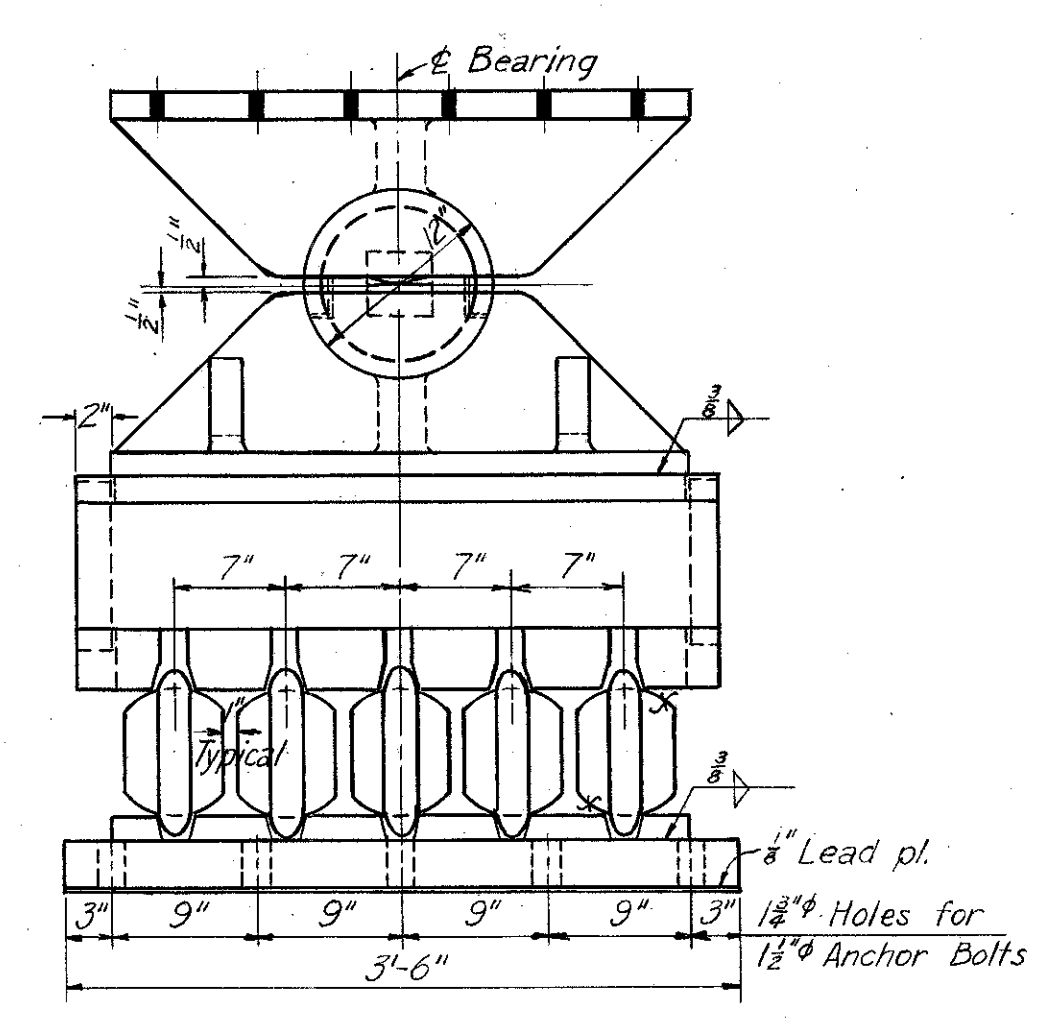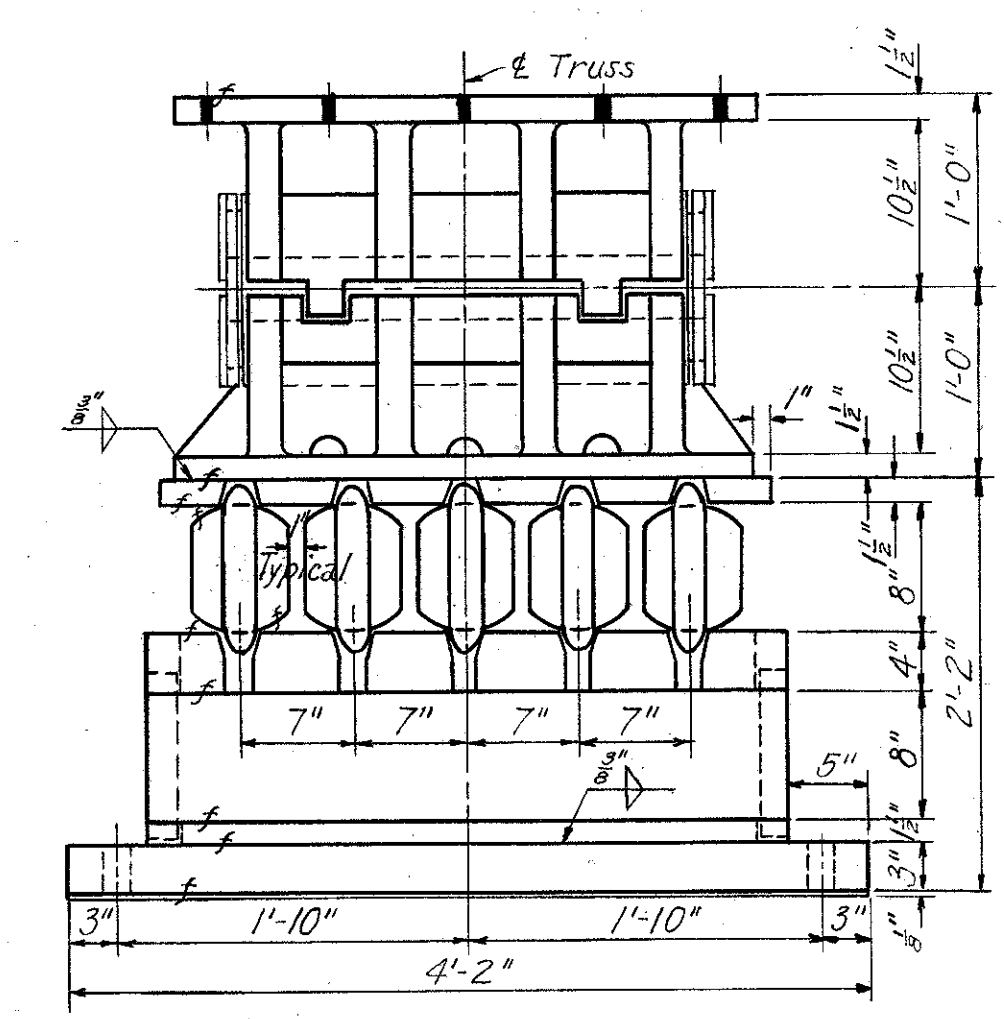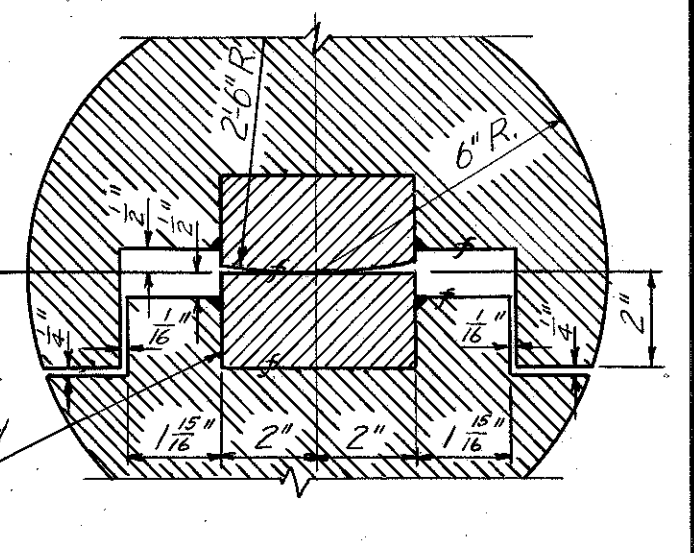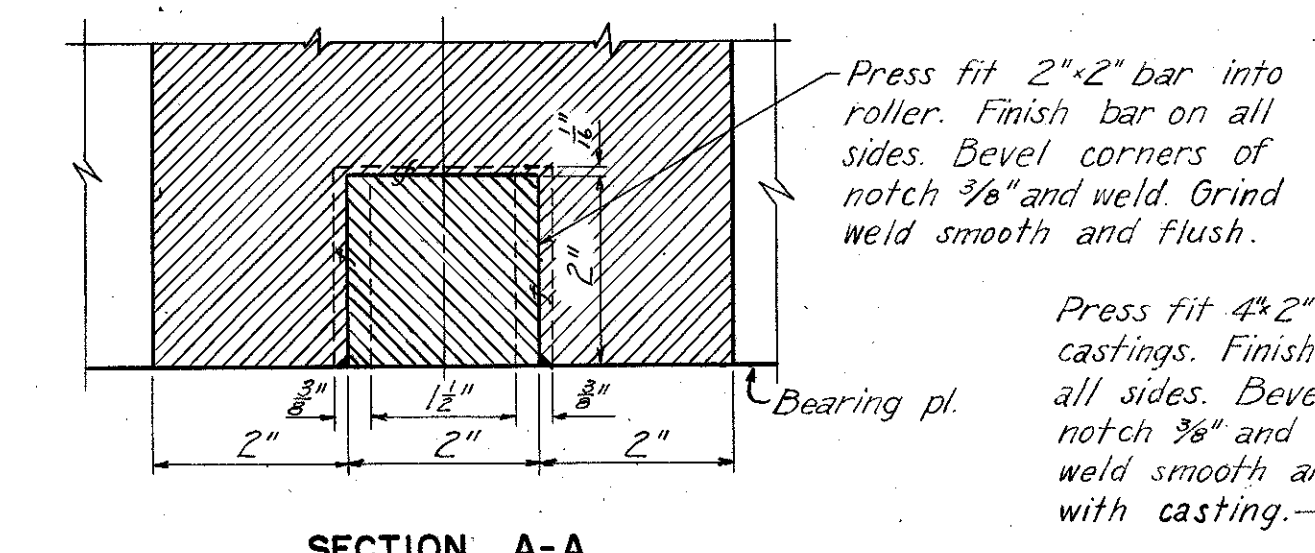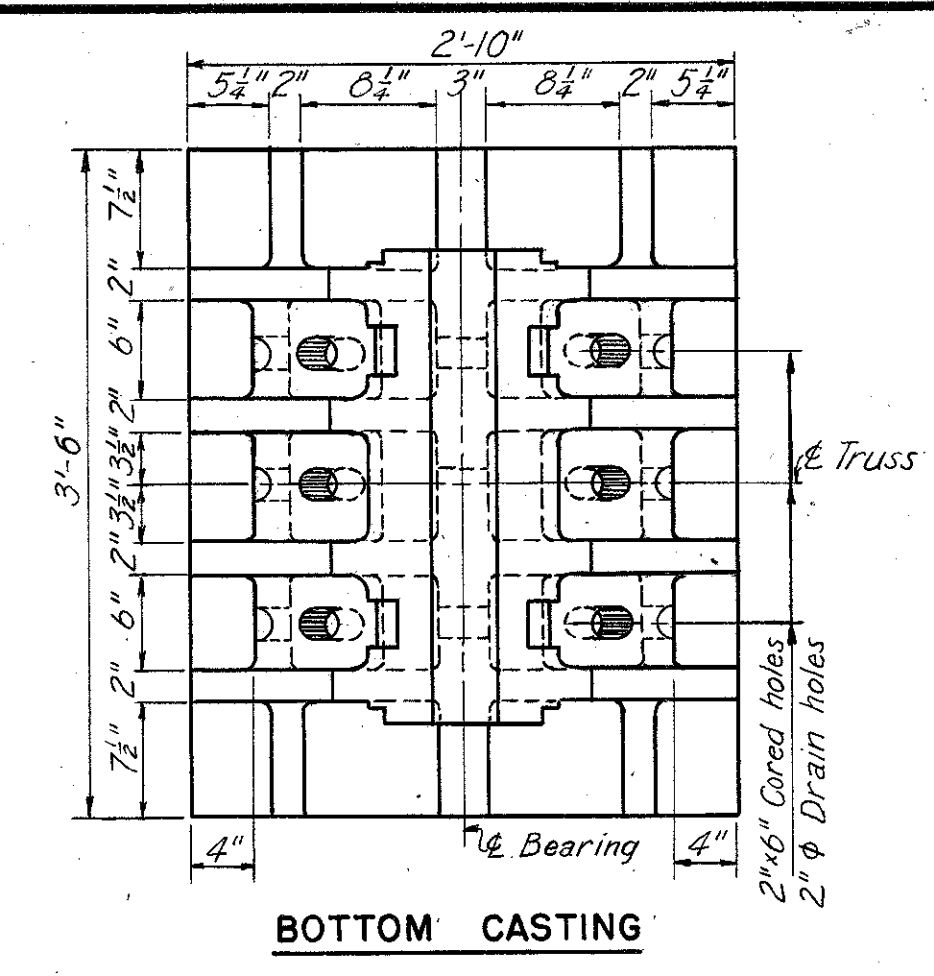

Rocker Bar 'R'
1 Bar 6 1/2" x 2 1/2" pressed fit into casting.
Bevel edges of casting 1/8" x 45° and weld bar in place. Bar to be U.S.S. Carilloy T1 or equal, with a minimum yield point of 90,000 psi. All surfaces to be finished.

TABULATION OF SHOE TOP CASTINGS	
Casting	Pier
TS 1	6N
TS 2	2N, 2S, 3N, 3S, 4N, 5N, 5S, 6S, 7N, 7S, 8N, 8S
TS 3	1N, 1S, 4S

SHOES FOR END PIERS	
Shoe	Pier
ES 4	WN, EN
ES 5	WS, ES

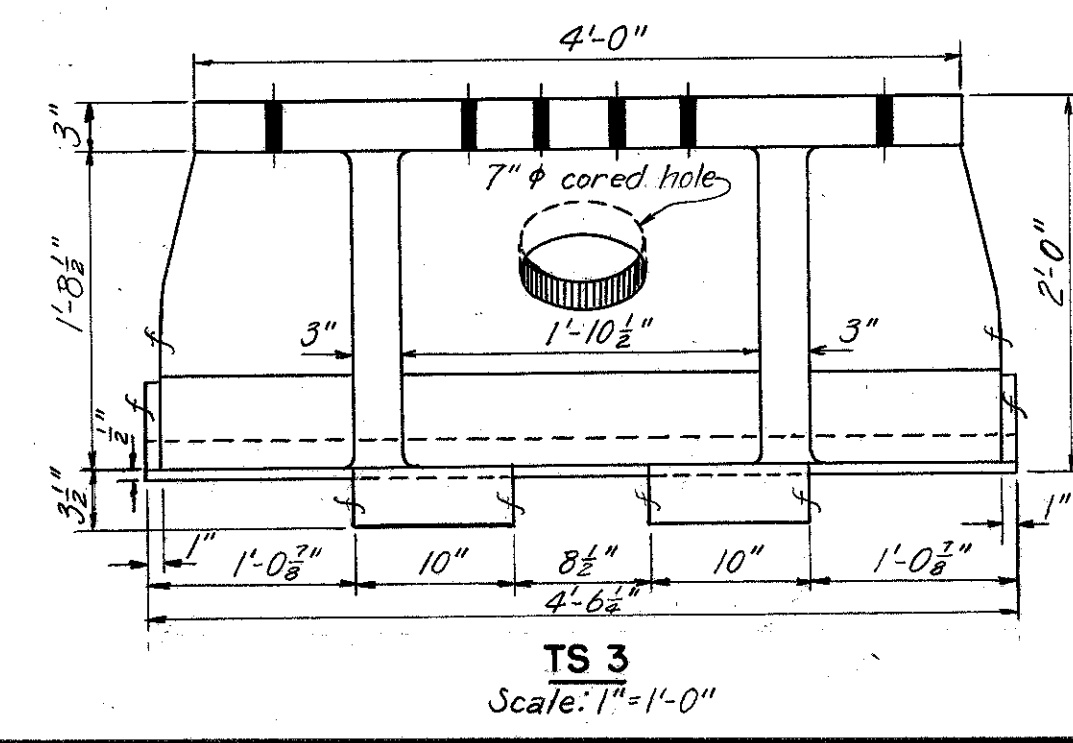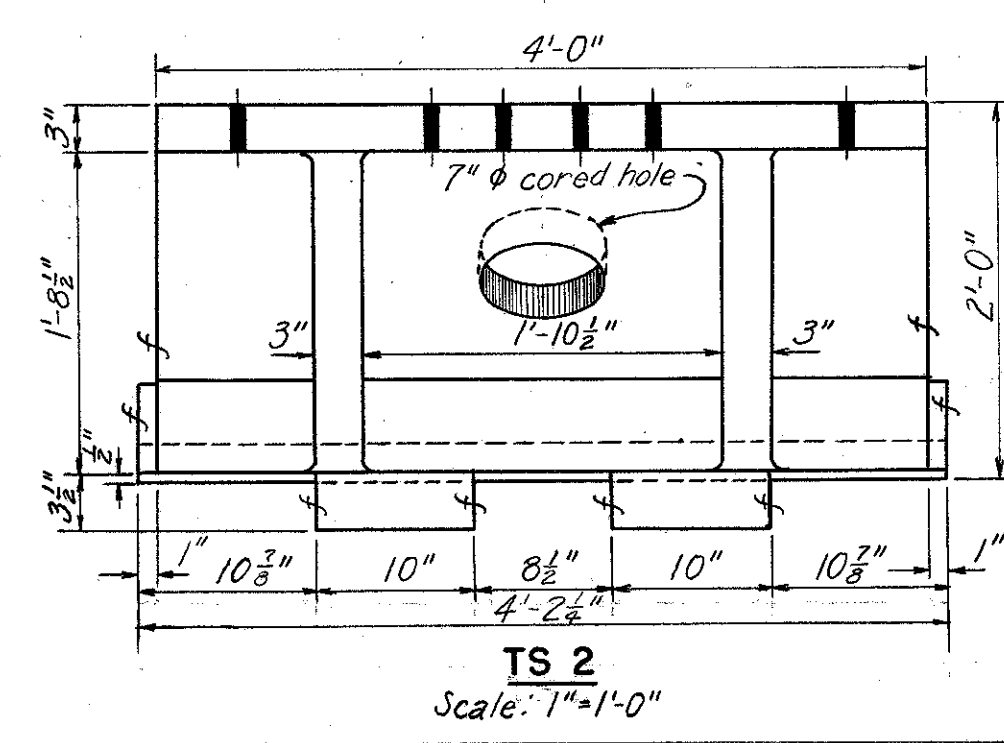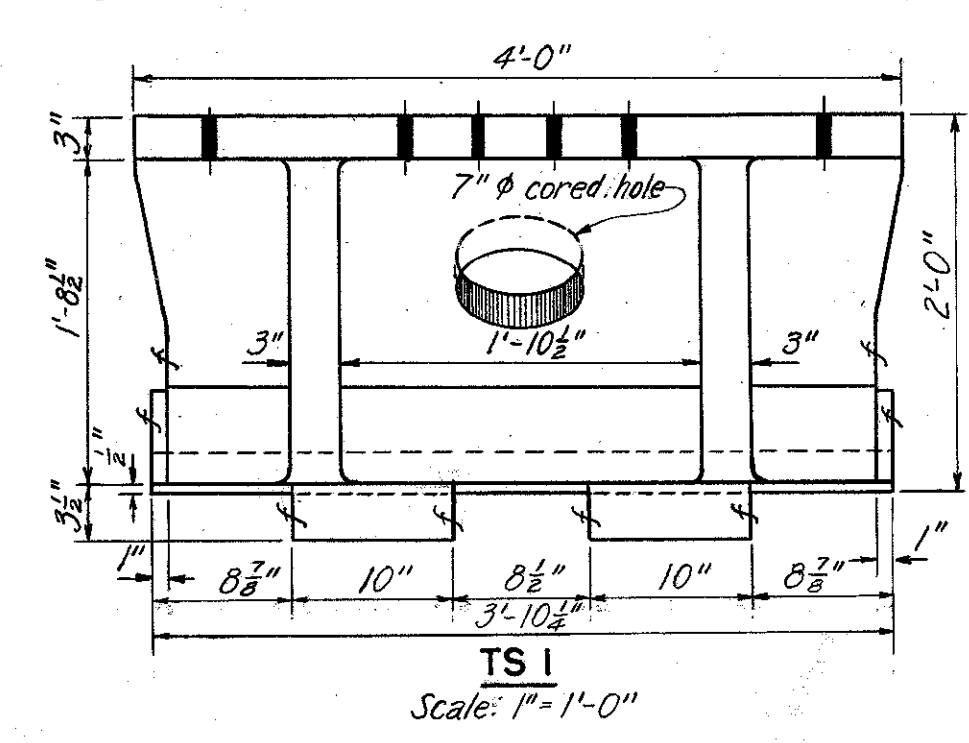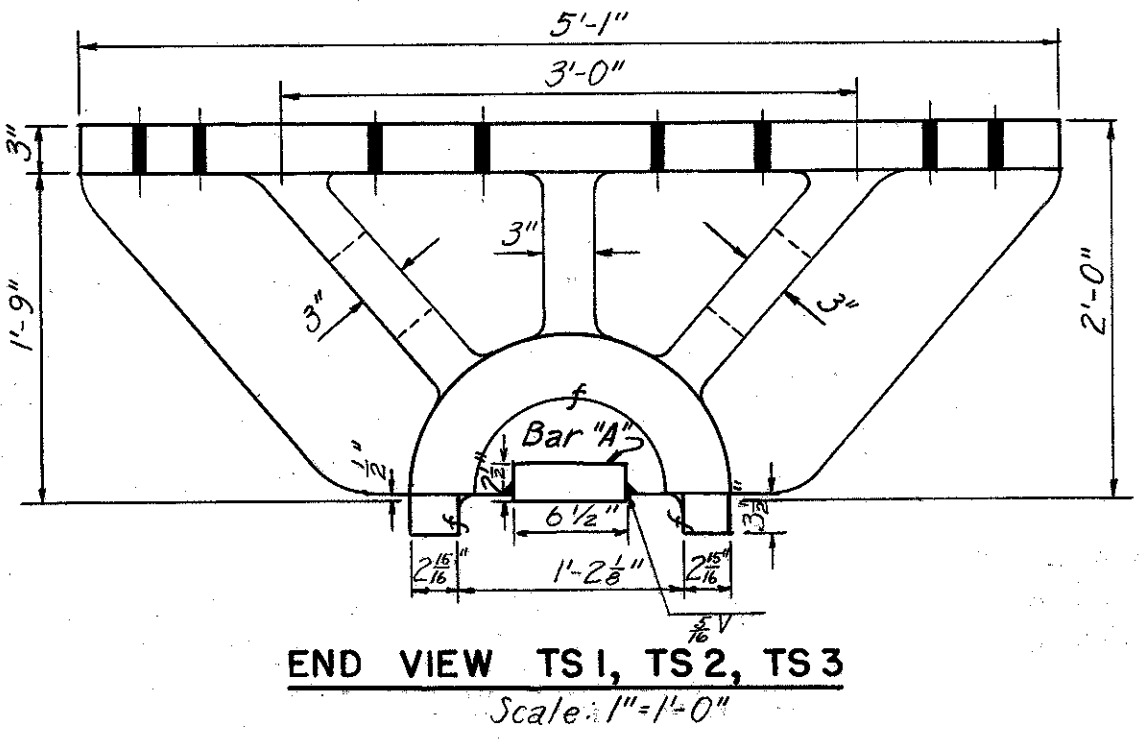

Note:
For General Notes on fabrication and materials of shoe castings, see Sh. 97.

PART 3

U. S. ROUTE 42 RELOCATION
INNER BELT FREEWAY - CENTRAL VIADUCT
BR. NO. CU - 42R-17.5

**SHOES AT END PIERS
AND SHOE TOP CASTINGS**

CLEVELAND CUYAHOGA COUNTY OHIO

SCALE: As Shown
MADE: VDB DATE 4-25-54
TRCD: JDB DATE 8-11-54
CKD: DME DATE 8-19-54

HOWARD, NEEDLES, TAMMEN & BERGENDOFF
CONSULTING ENGINEERS
KANSAS CITY CLEVELAND NEW YORK


914-1A SHEET: 2.96

REVISIONS
FEB 10 1954

FED. ROAD DIV. NO.	STATE	FEDERAL AID PROJECT NO.	TYPE FUNDS
2	OHIO		



95
122

CUYAHOGA COUNTY
CITY OF CLEVELAND
INNER BELT FREEWAY
CENTRAL VIADUCT

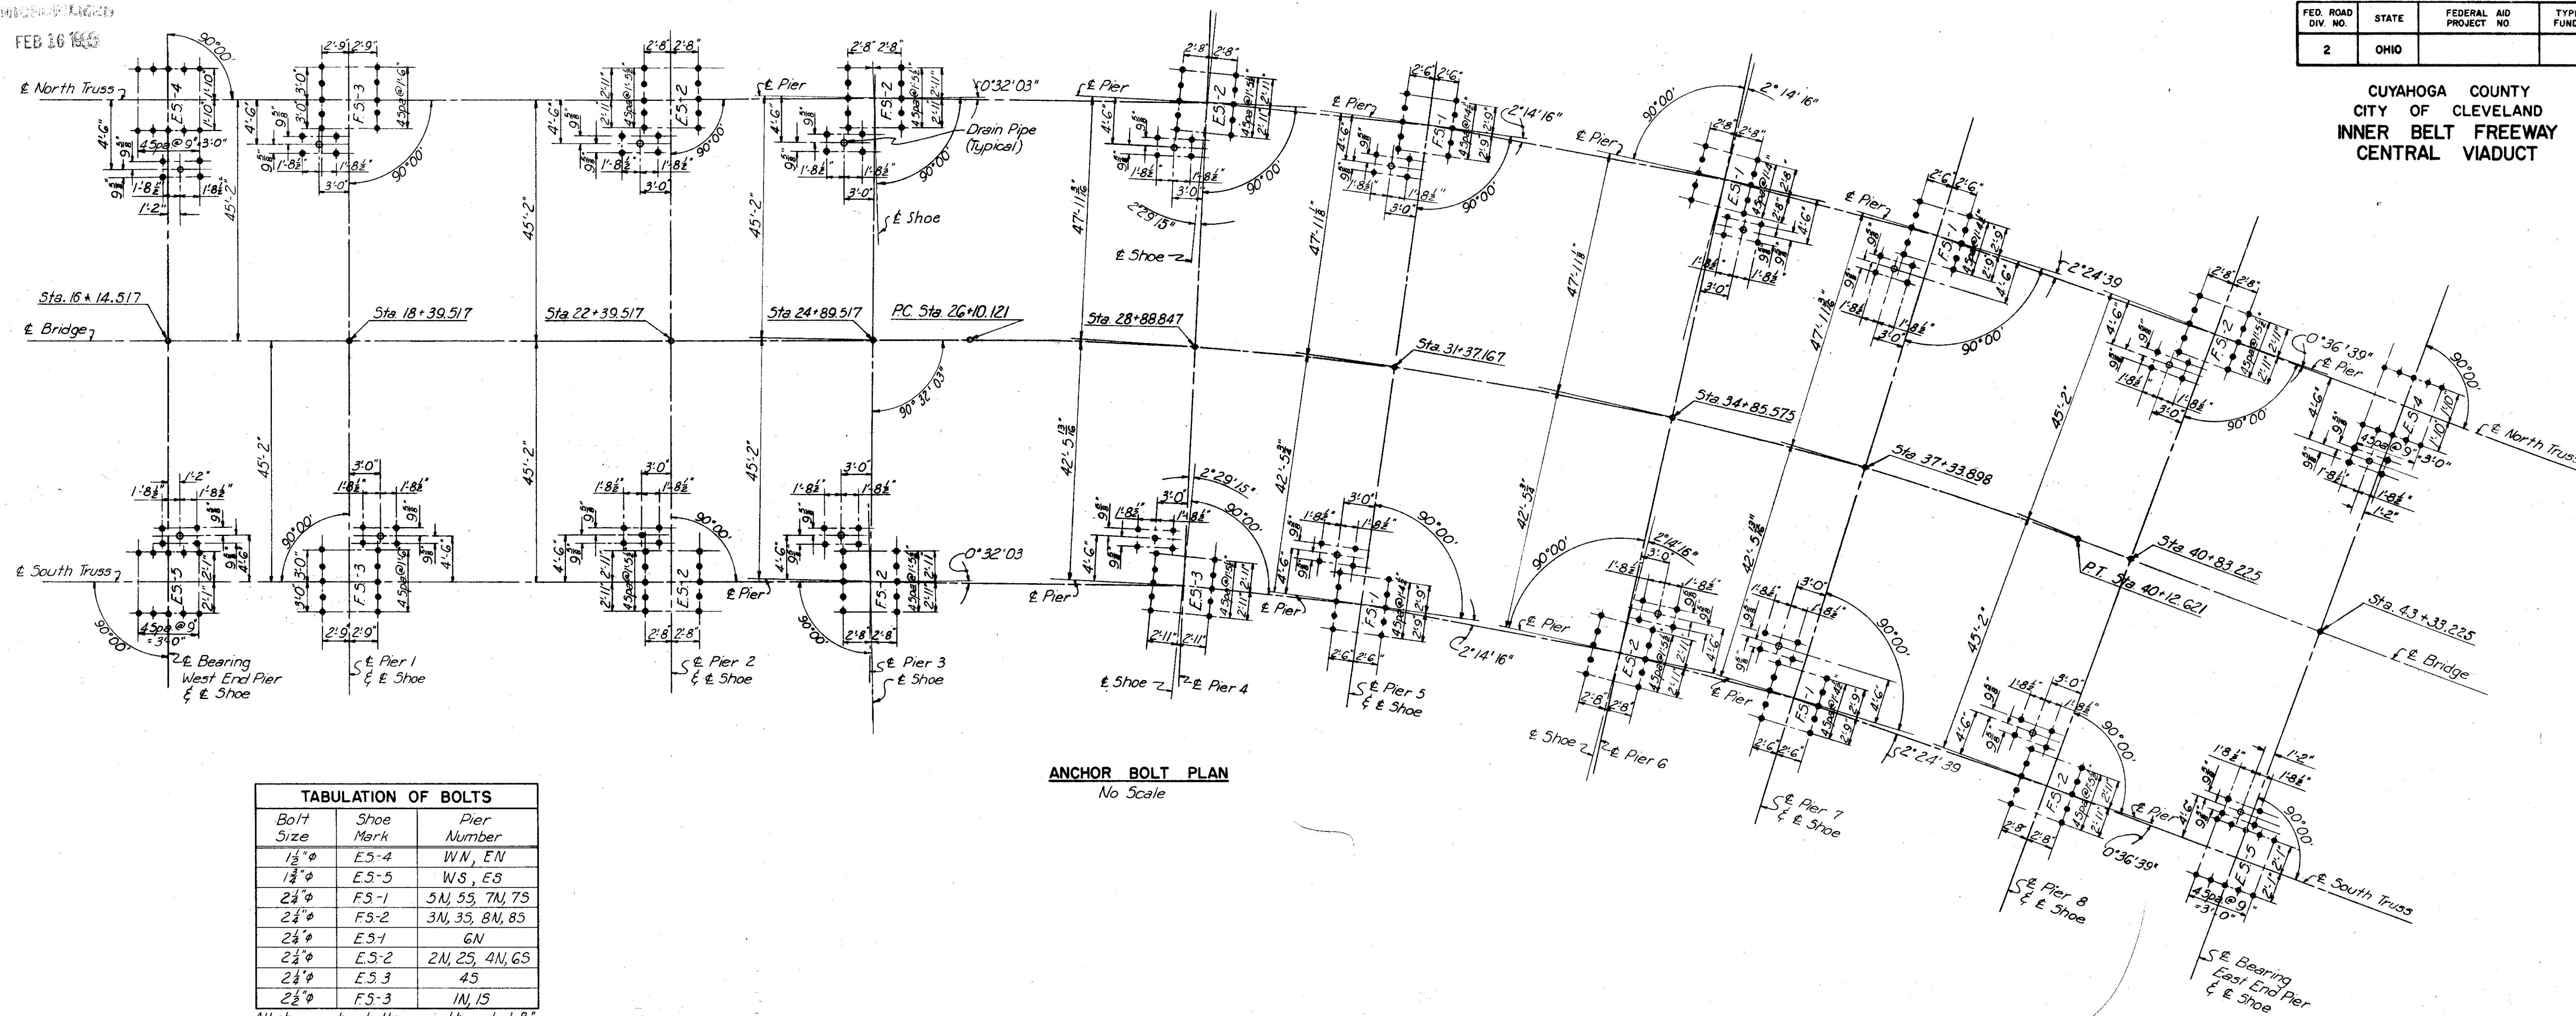


TABULATION OF BOLTS		
Bolt Size	Shoe Mark	Pier Number
1 1/2"	ES-4	WN, EN
1 1/2"	ES-5	WS, ES
2 1/2"	FS-1	5N, 5S, 7N, 7S
2 1/2"	FS-2	3N, 3S, 8N, 8S
2 1/2"	ES-1	6N
2 1/2"	ES-2	2N, 2S, 4N, 4S
2 1/2"	ES-3	4S
2 1/2"	FS-3	1N, 1S

All shoe anchor bolts are threaded 8" and provided with lock washer and hex nuts.
All bolts furnished under a previous contract.

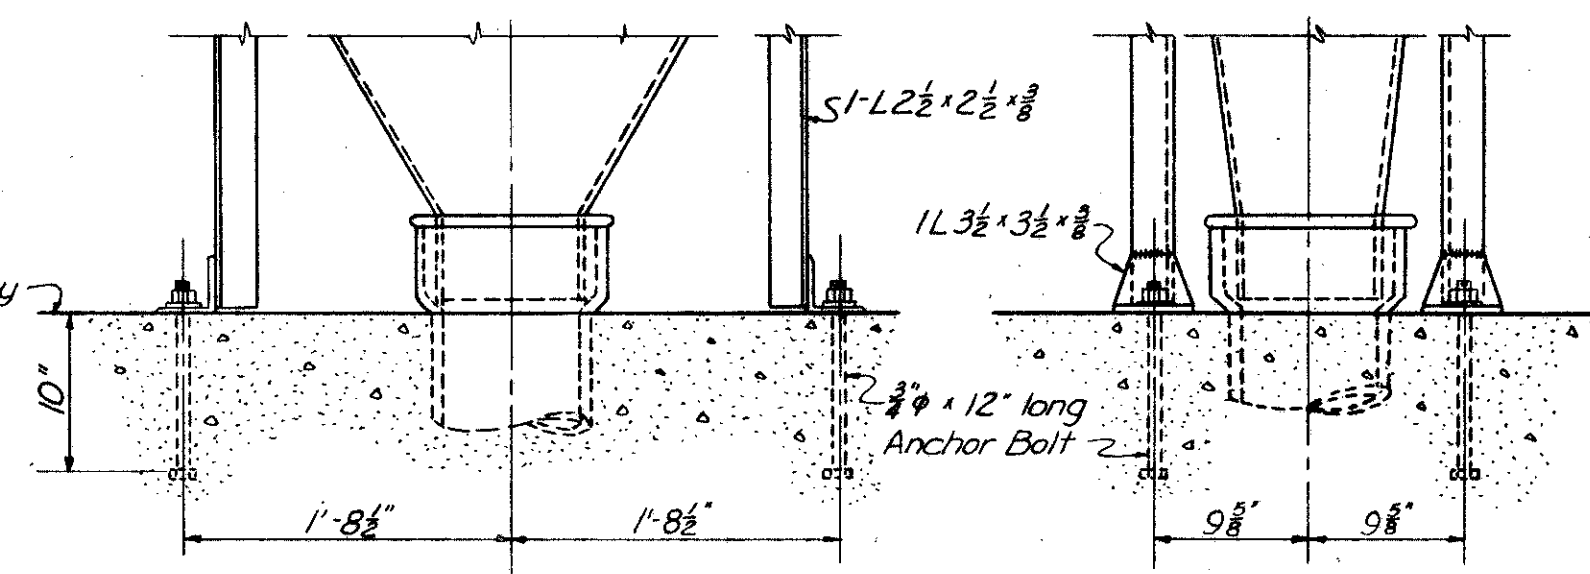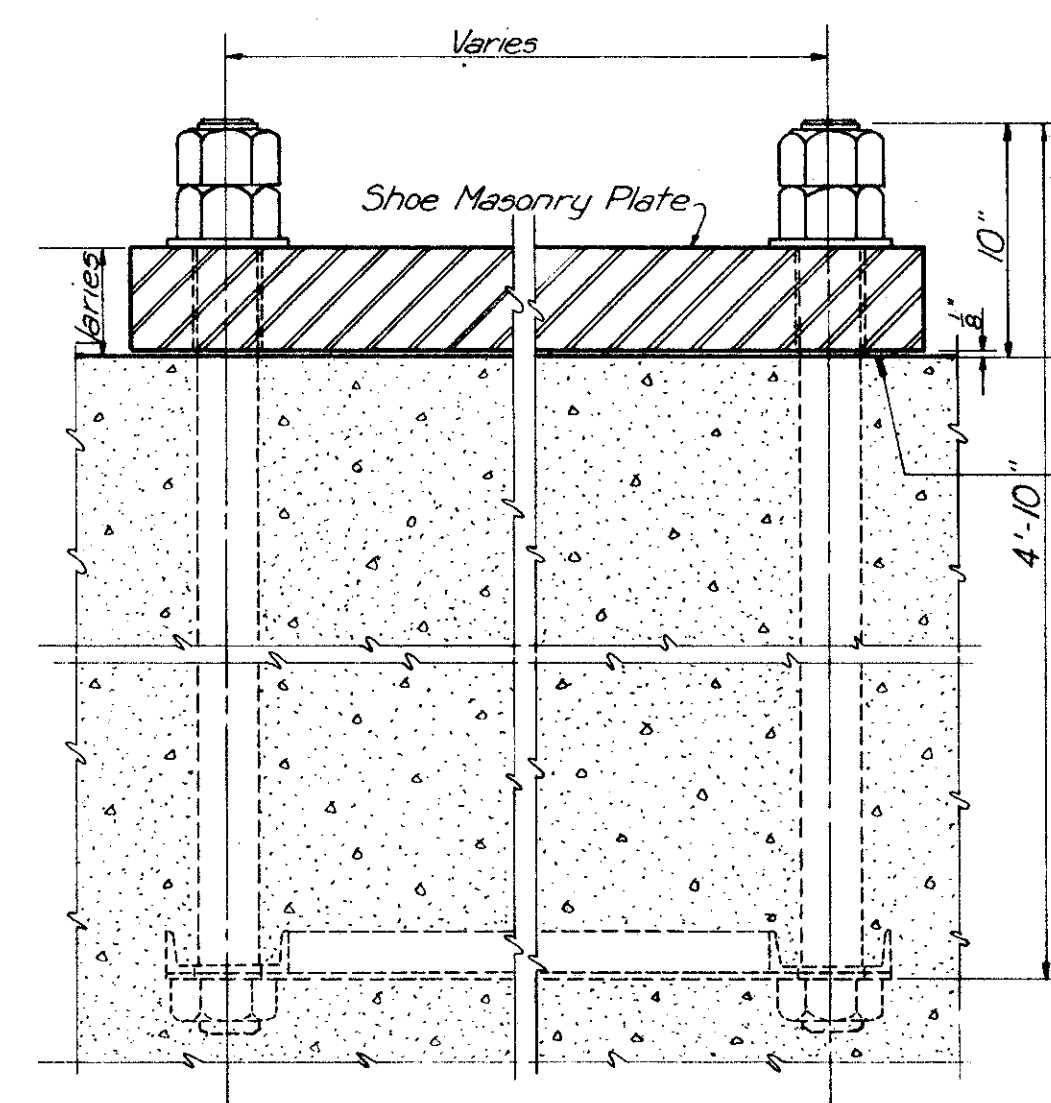

HOPPER ANCHOR BOLT DETAIL
Scale: 1" = 1'-0"
Bolts furnished and set under a previous contract.

94
12

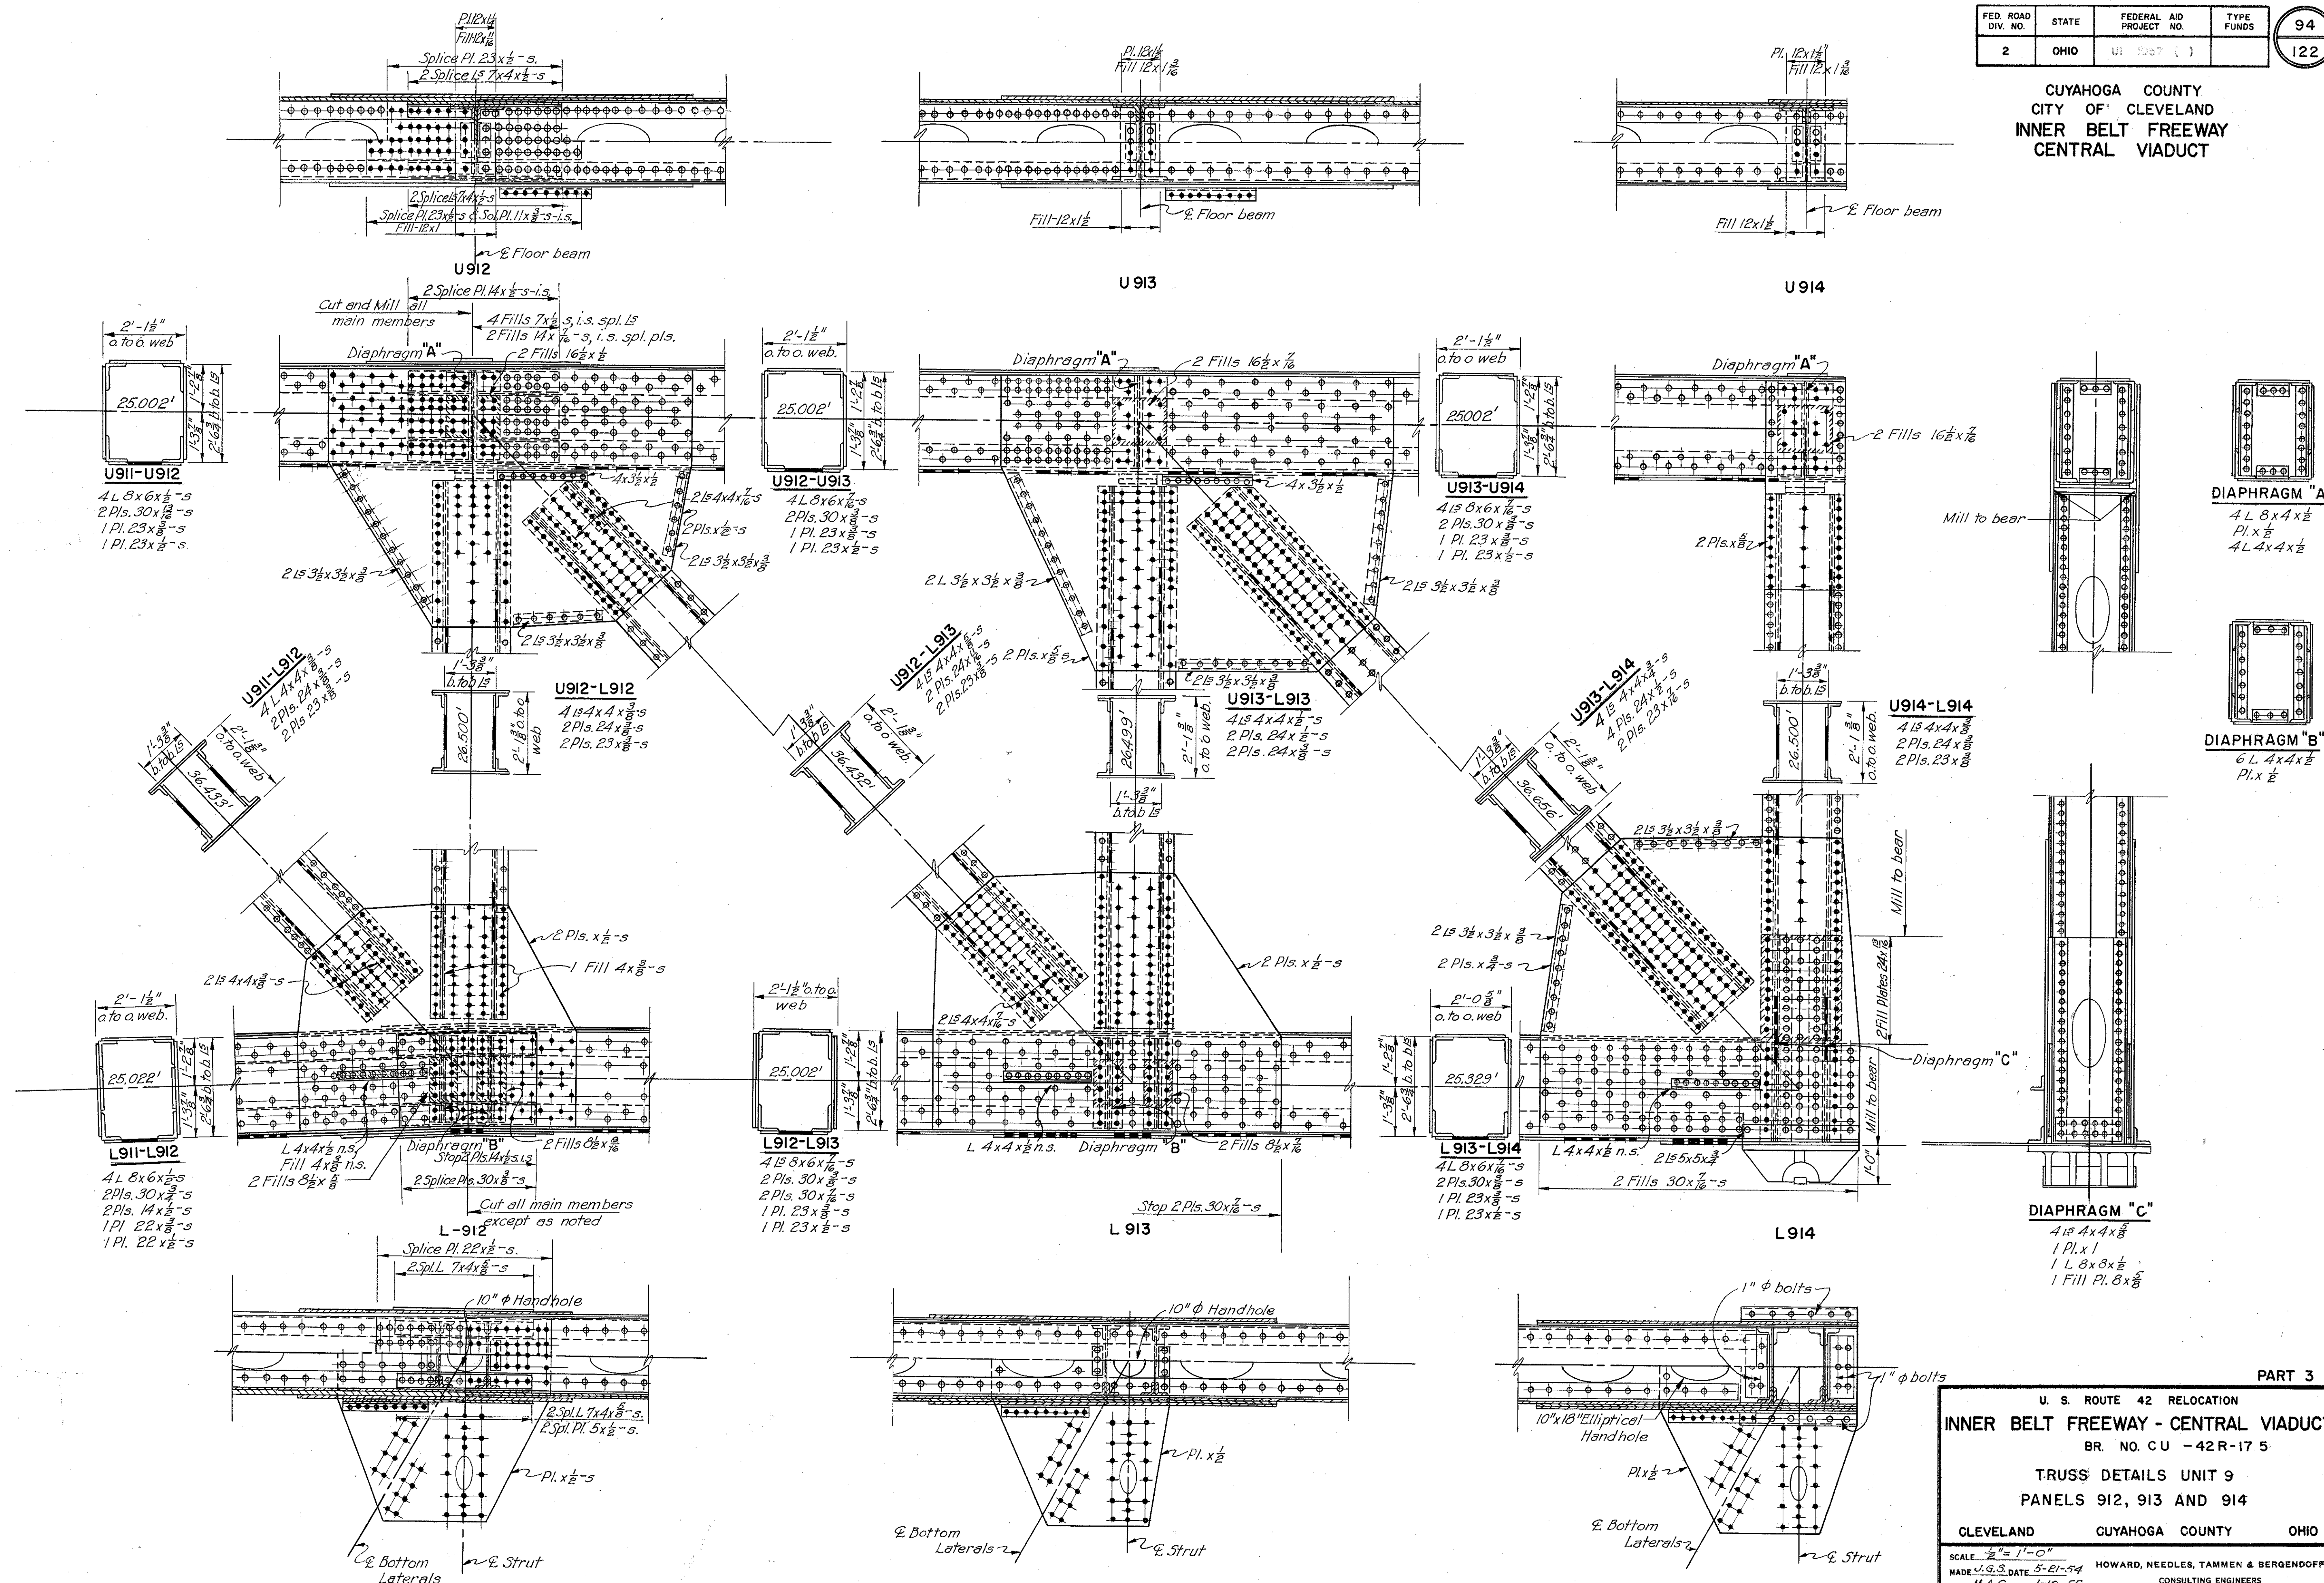

U. S. ROUTE 42 RELOCATION
INNER BELT FREEWAY - CENTRAL VIADUCT
BR. NO. CU - 42R-175

TRUSS DETAILS UNIT 9
PANELS 912, 913 AND 914

CLEVELAND GUYAHOGA COUNTY OHIO


SCALE $\frac{1}{2}'' = 1' - 0''$
MADE J.G.S. DATE 5-21-54
TRCD M.A.C. DATE 1-10-55
CKD D.L.C. DATE 7-15-54

HOWARD, NEEDLES, TAMMEN & BERGENDOFF
CONSULTING ENGINEERS
KANSAS CITY CLEVELAND NEW YORK
914-1A SHEET- 2.94

MICROFILMED
FEB 16 1968

FED. ROAD DIV. NO.	STATE	FEDERAL AID PROJECT NO.	TYPE FUNDS	93 122
2	OHIO			

CUYAHOGA COUNTY
CITY OF CLEVELAND
INNER BELT FREEWAY
CENTRAL VIADUCT

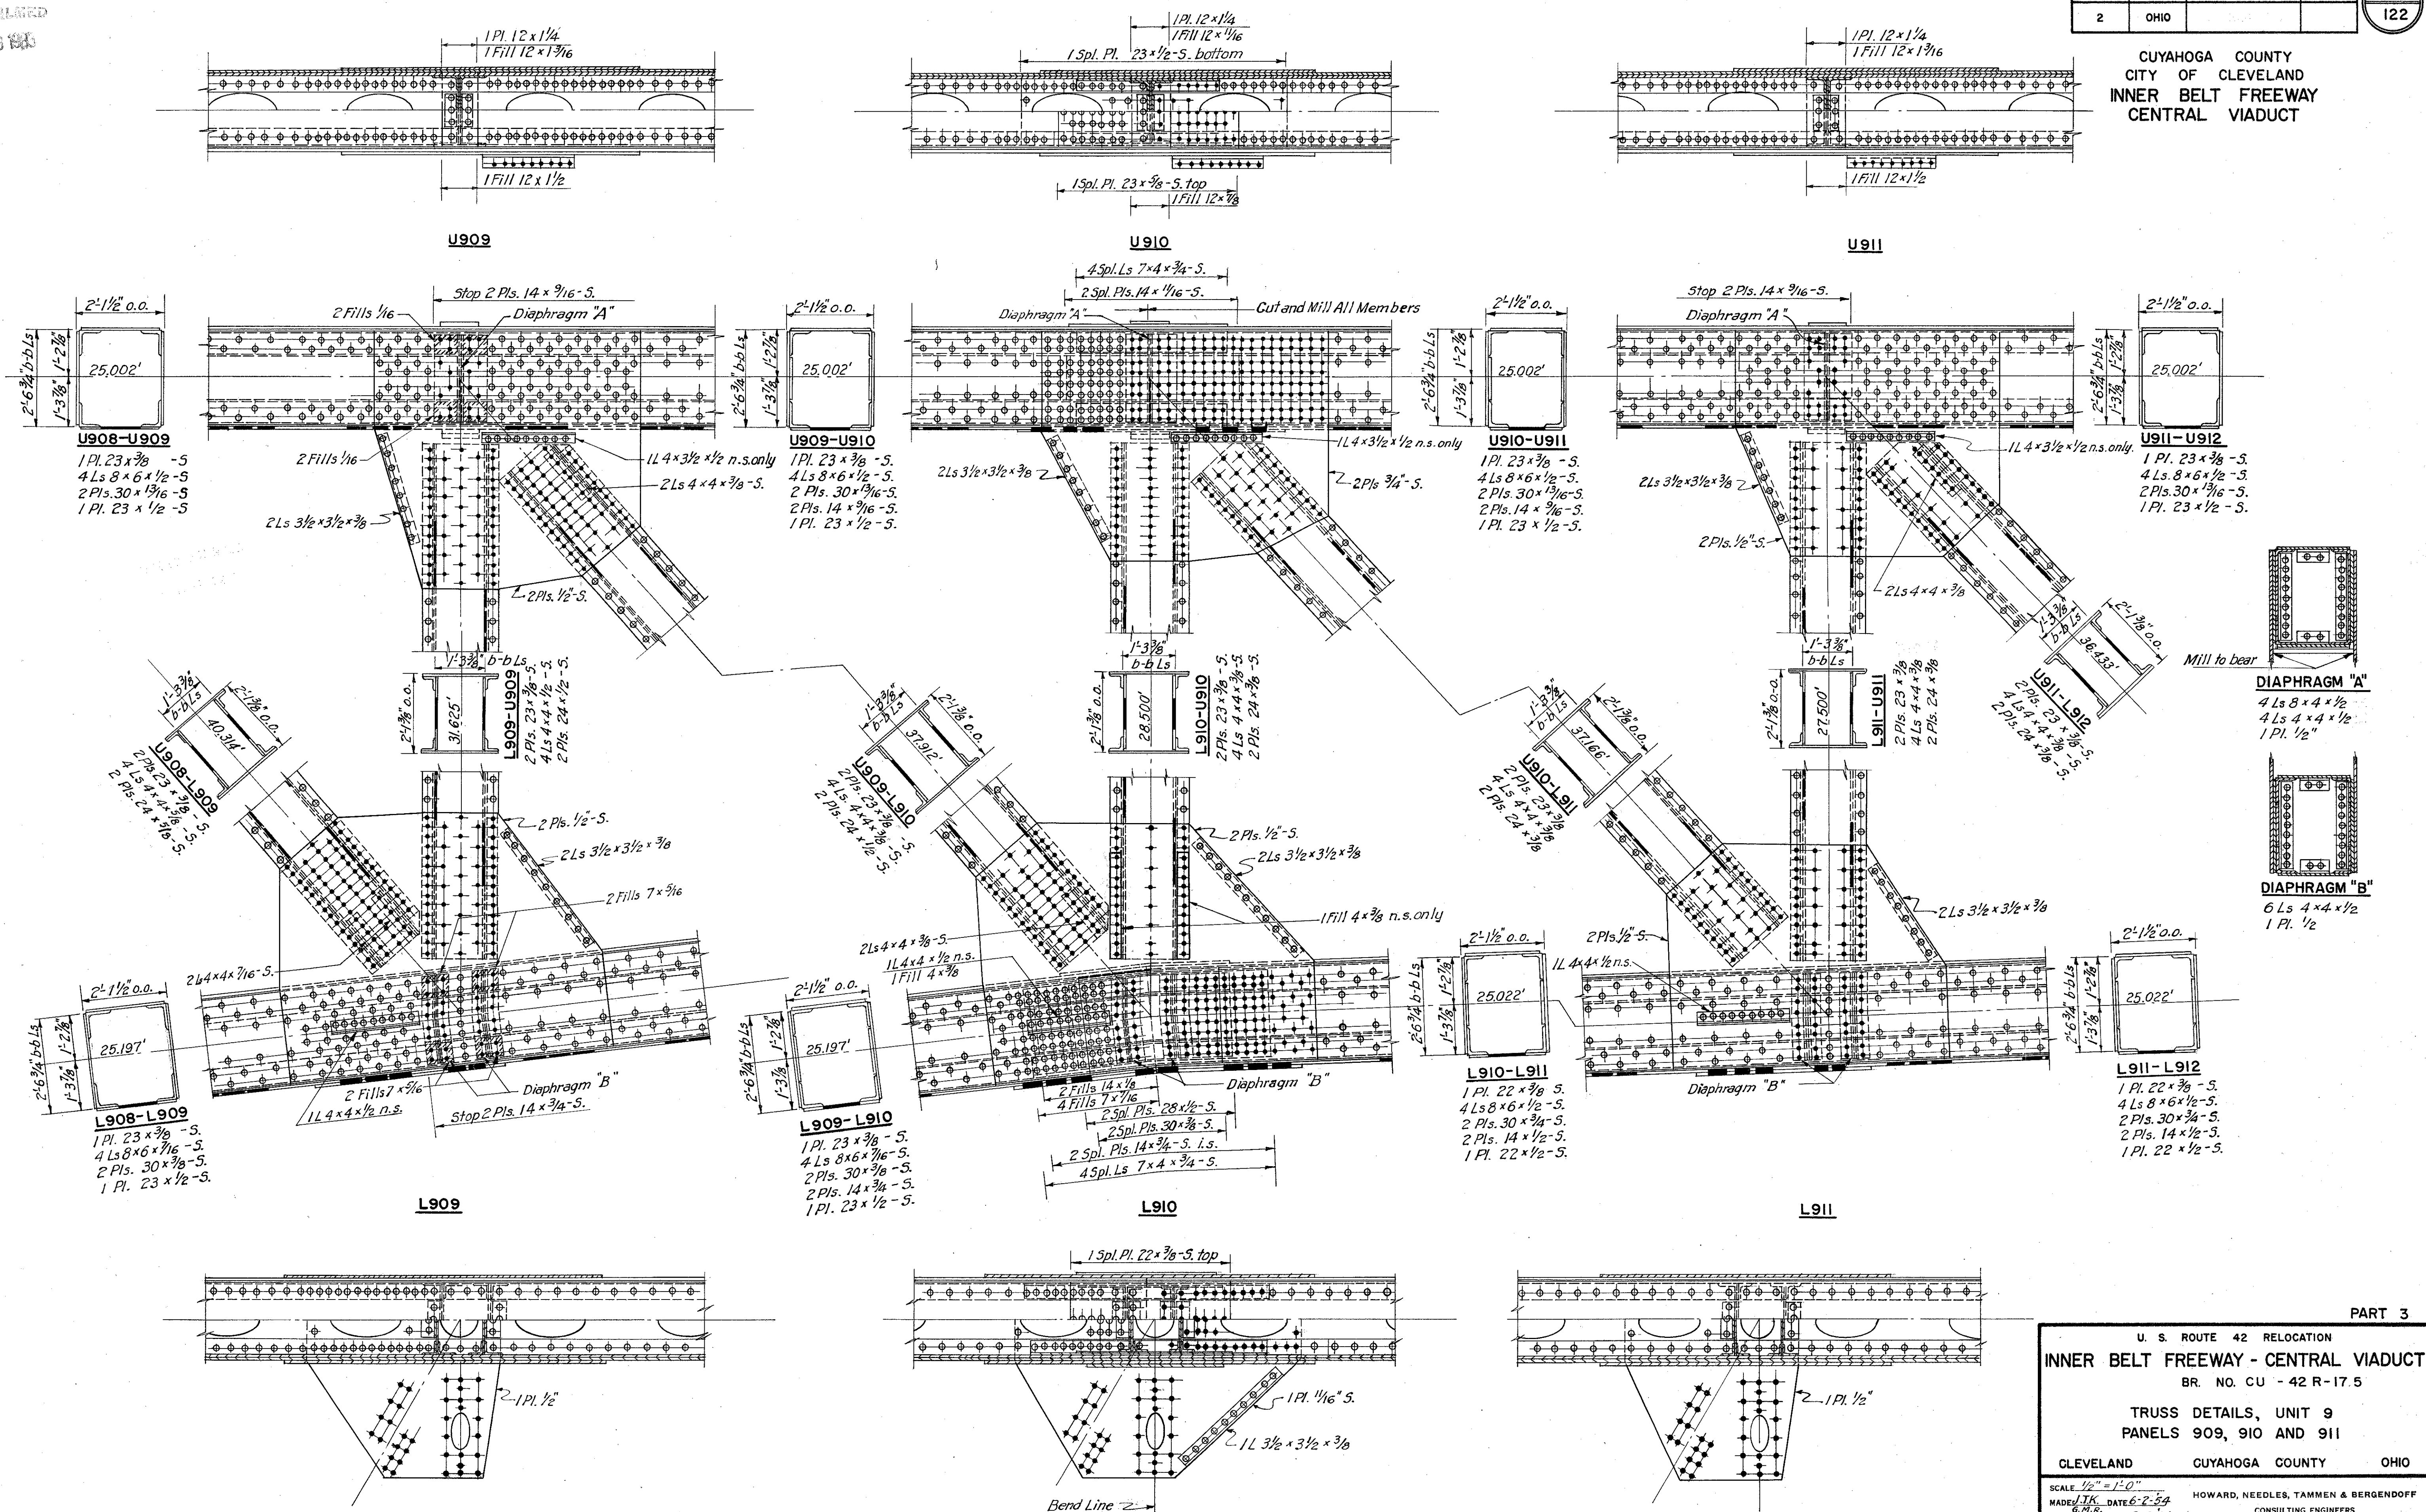

DIAPHRAGM "A"
4 Ls 8 x 4 x 1/2
4 Ls 4 x 4 x 1/2
1 Pl. 1/2"

DIAPHRAGM "B"
6 Ls 4 x 4 x 1/2
1 Pl. 1/2"

PART 3

U. S. ROUTE 42 RELOCATION
INNER BELT FREEWAY - CENTRAL VIADUCT
BR. NO. CU - 42 R-17.5

TRUSS DETAILS, UNIT 9
PANELS 909, 910 AND 911

CLEVELAND CUYAHOGA COUNTY OHIO

SCALE 1/2" = 1'-0"
MADE BY J.K. DATE 6-2-54
TRCD BY J.S. DATE 9-8-54
CKD BY D.L.C. DATE 9-20-54


HOWARD, NEEDLES, TAMMEN & BERGENDOFF
CONSULTING ENGINEERS
KANSAS CITY CLEVELAND NEW YORK
914-1A SHEET 2.93

60
FEB 16 1954

CUY-90-1545

FED. ROAD DIV. NO.	STATE	FEDERAL AID PROJECT NO.	TYPE FUNDS	92
2	OHIO			122

CUYAHOGA COUNTY
CITY OF CLEVELAND
INNER BELT FREEWAY
CENTRAL VIADUCT

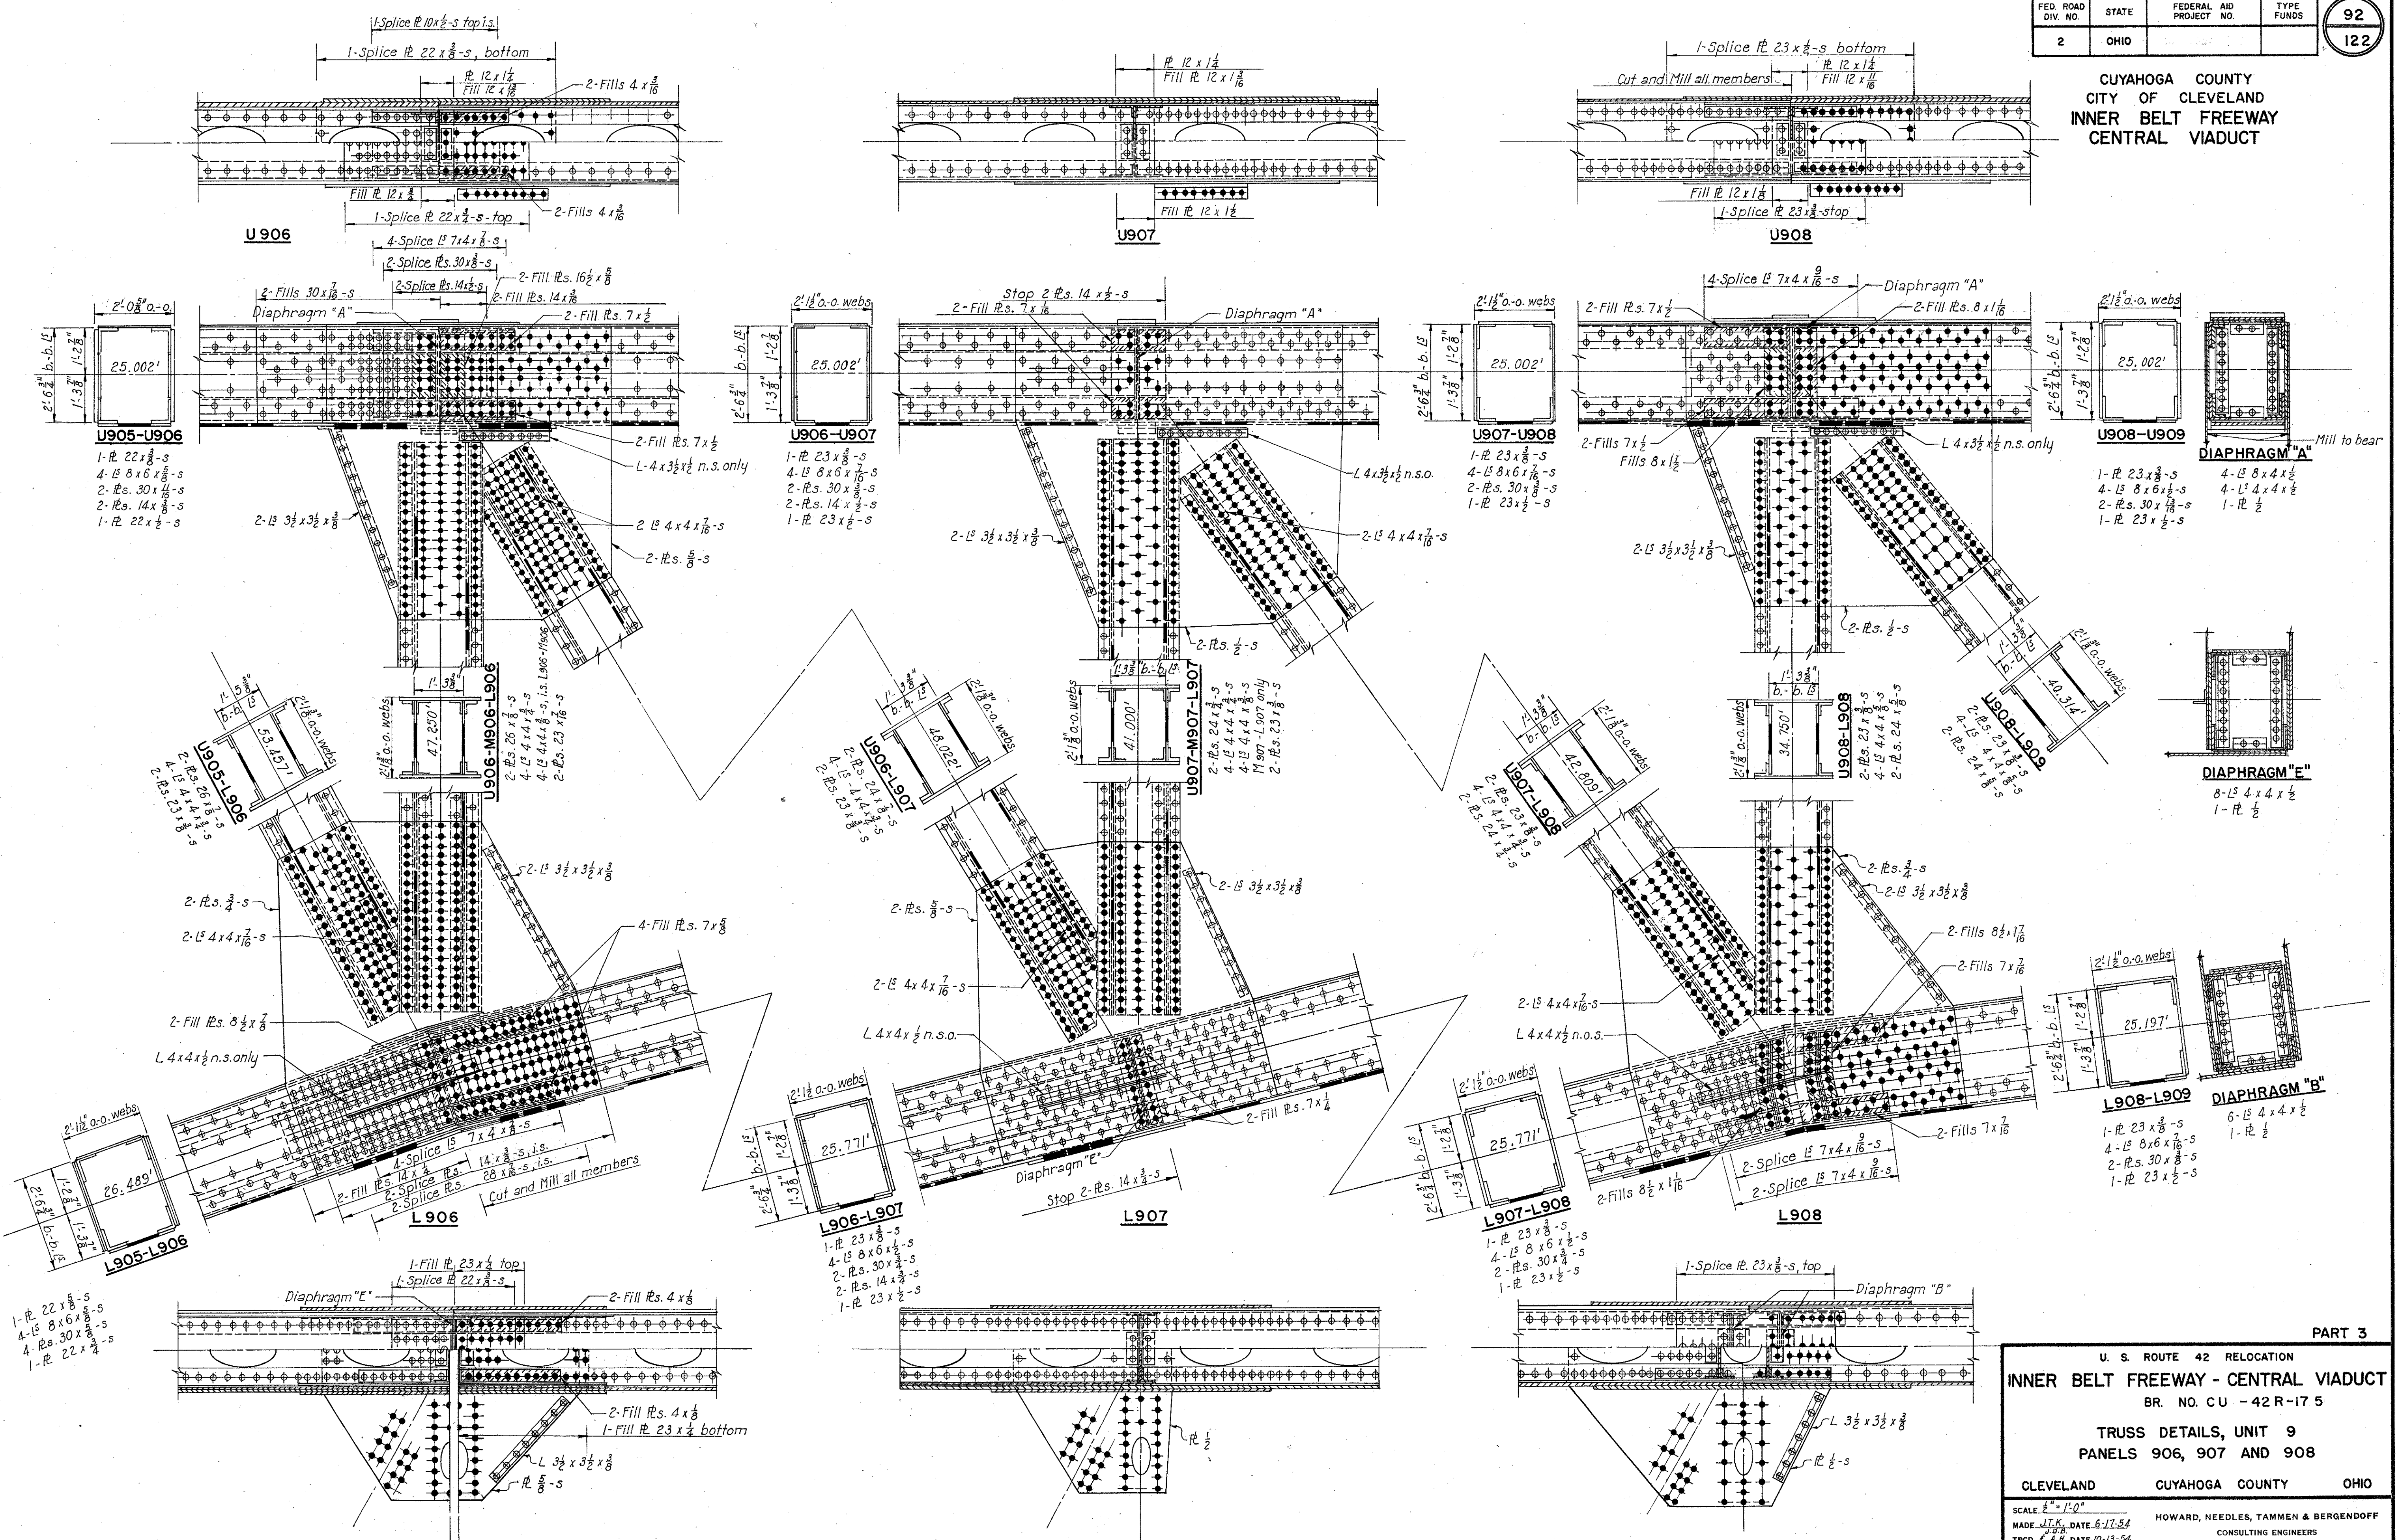

PART 3

U. S. ROUTE 42 RELOCATION
INNER BELT FREEWAY - CENTRAL VIADUCT
BR. NO. CU - 42 R-17 5

TRUSS DETAILS, UNIT 9
PANELS 906, 907 AND 908

CLEVELAND CUYAHOGA COUNTY OHIO

SCALE 1" = 1'-0"

MADE J.T.K. DATE 6-17-54
TRCD L.A.H. DATE 10-13-54
CKD D.L.C. DATE 9-22-54

HOWARD, NEEDLES, TAMMEN & BERGENDOFF
CONSULTING ENGINEERS
KANSAS CITY CLEVELAND NEW YORK




914-1A SHEET 2.92

MICROFILMED
FEB 16 1982




FED. ROAD DIV. NO.	STATE	FEDERAL AID PROJECT NO.	TYPE FUNDS
2	OHIO		

91
122

CUYAHOGA COUNTY
CITY OF CLEVELAND
INNER BELT FREEWAY
CENTRAL VIADUCT

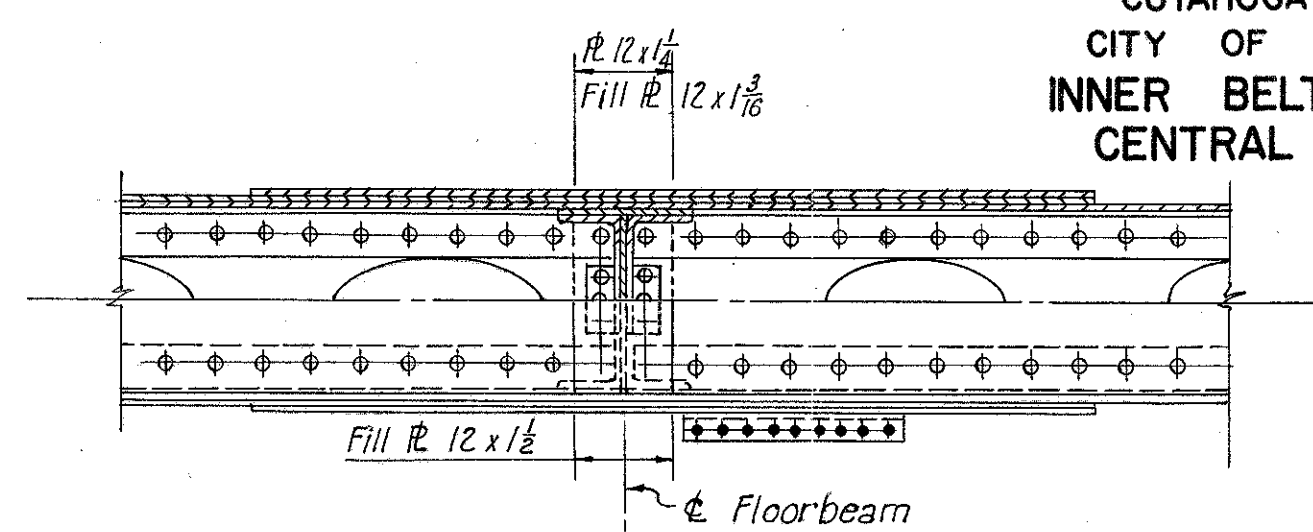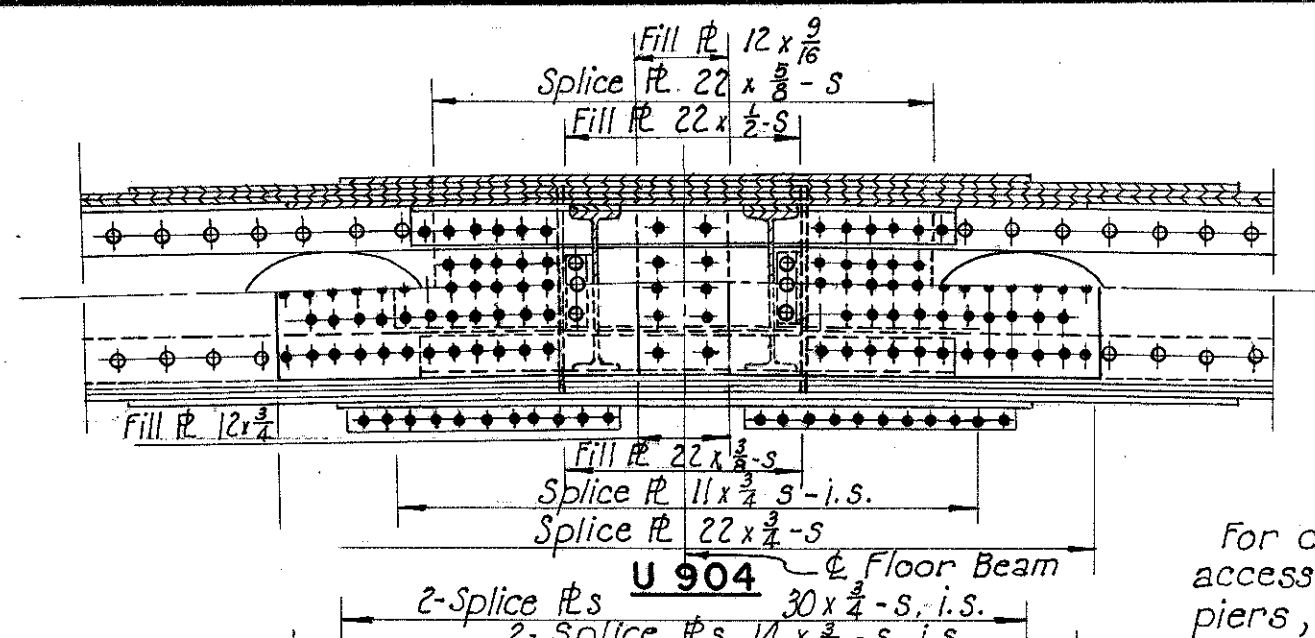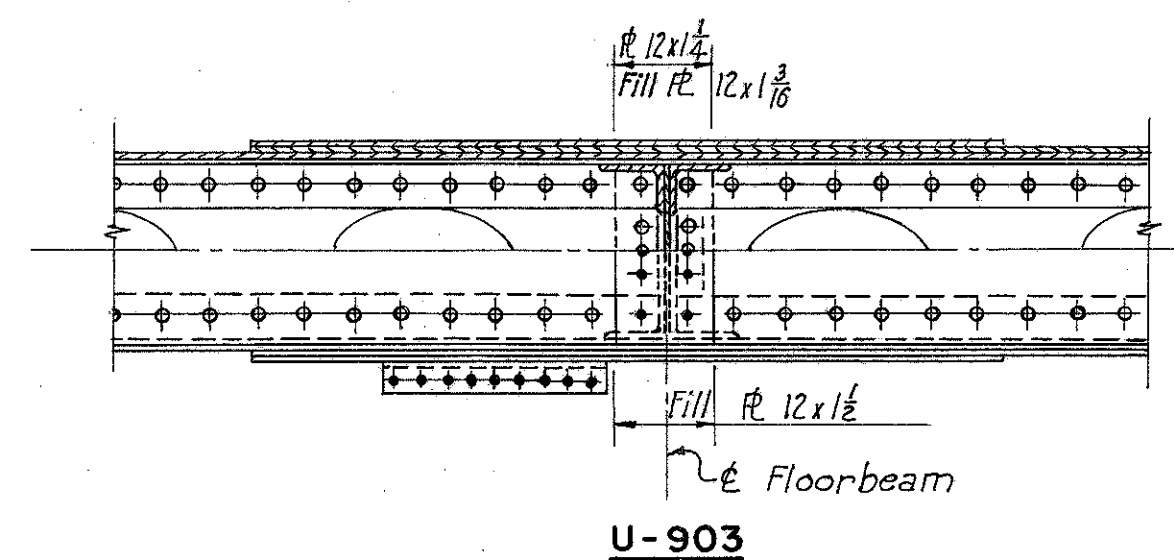

For details and connections of
access walkway and ladders to
piers, see Sheet 101.

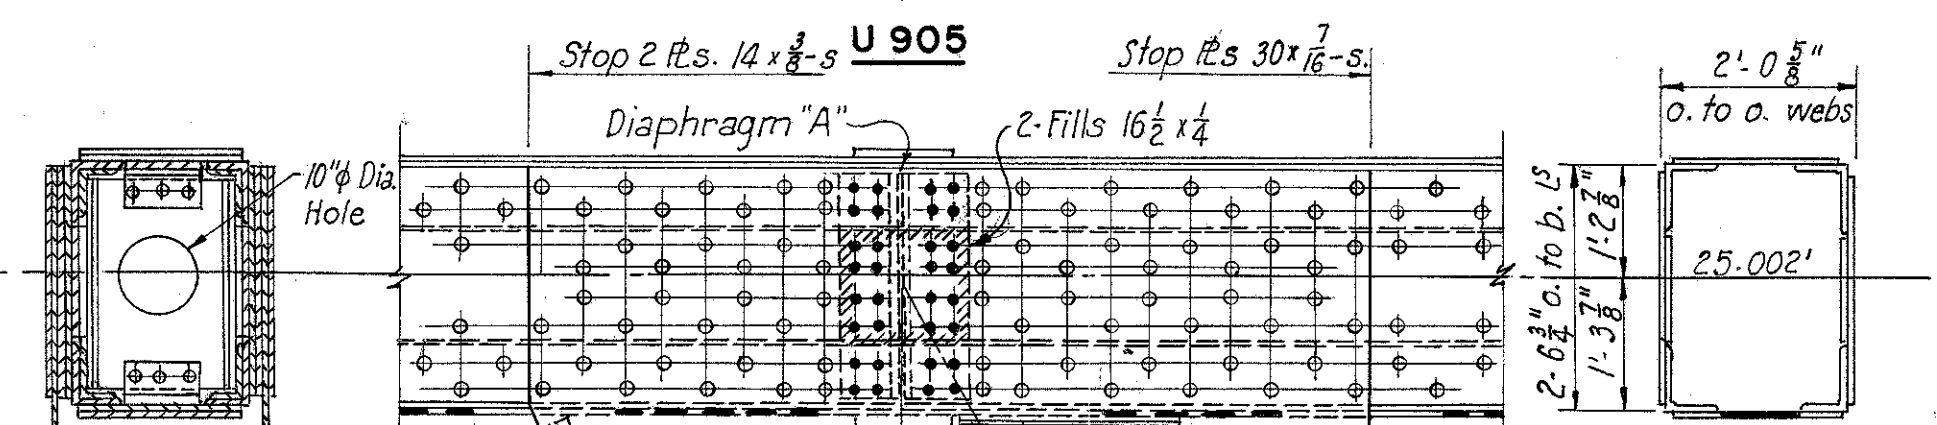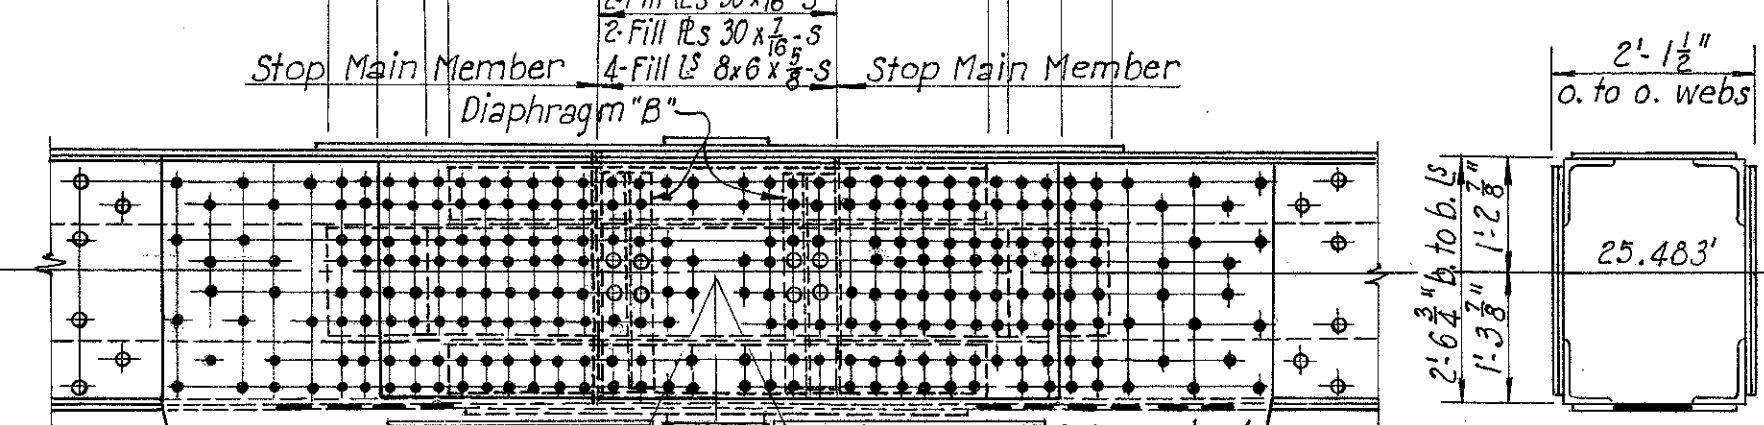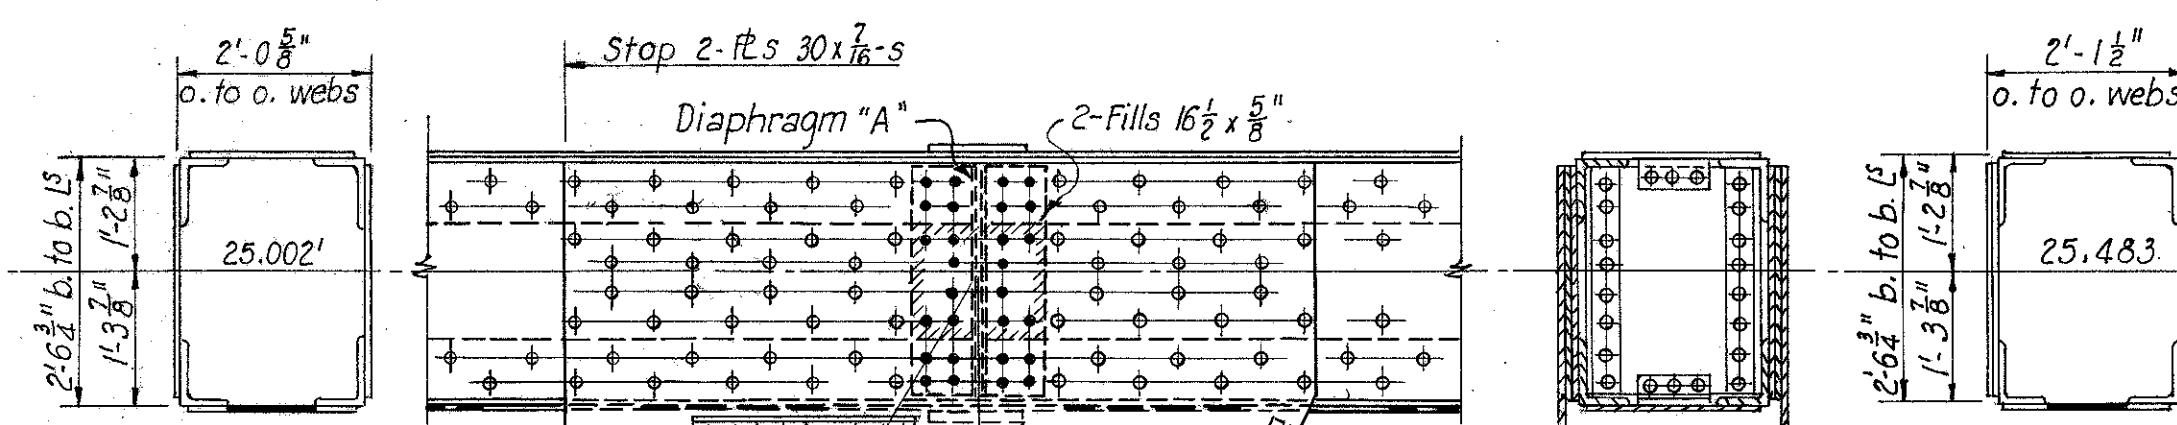

- U902-U903**
4-15 8x6x $\frac{5}{8}$ -s
2-15 30x $\frac{1}{2}$ -s
1-15 22x $\frac{3}{4}$ -s
1-15 22x $\frac{1}{2}$ -s
2-15 4x4x $\frac{1}{2}$ -s

- U903-U904**
4-15 8x6x $\frac{5}{8}$ -s
2-15 30x $\frac{1}{2}$ -s
2-15 30x $\frac{1}{2}$ -s
1-15 22x $\frac{3}{4}$ -s
1-15 22x $\frac{1}{2}$ -s

- U904-U905**
4-15 8x6x $\frac{5}{8}$ -s
2-15 30x $\frac{1}{2}$ -s
2-15 30x $\frac{1}{2}$ -s
1-15 22x $\frac{3}{4}$ -s
1-15 22x $\frac{1}{2}$ -s

- U905-U906**
4-15 8x6x $\frac{5}{8}$ -s
2-15 30x $\frac{1}{2}$ -s
2-15 30x $\frac{1}{2}$ -s
1-15 22x $\frac{3}{4}$ -s
1-15 22x $\frac{1}{2}$ -s

- L902-U903**
4-15 4x4x $\frac{1}{2}$ -s
2-15 28x $\frac{3}{4}$ -s
2-15 23x $\frac{3}{4}$ -s

- U903-L903-L903**
4-15 6x4x $\frac{1}{2}$ -s
4-15 4x4x $\frac{1}{2}$ -s (Below M 903)
2-15 28x $\frac{3}{4}$ -s
2-15 23x $\frac{3}{4}$ -s

- L903-U904**
4-15 4x4x $\frac{1}{2}$ -s
2-15 28x $\frac{3}{4}$ -s
2-15 23x $\frac{3}{4}$ -s

- U904-L905**
4-15 4x4x $\frac{1}{2}$ -s
2-15 28x $\frac{3}{4}$ -s
2-15 23x $\frac{3}{4}$ -s

- U905-M905-L905**
(Below 905)
4-15 6x4x $\frac{1}{2}$ -s
4-15 4x4x $\frac{1}{2}$ -s
2-15 28x $\frac{3}{4}$ -s
2-15 23x $\frac{3}{4}$ -s






- U905-L906**
4-15 4x4x $\frac{1}{2}$ -s
2-15 28x $\frac{3}{4}$ -s
2-15 23x $\frac{3}{4}$ -s

- L905-L906**
4-15 8x6x $\frac{5}{8}$ -s
4-15 30x $\frac{1}{2}$ -s
1-15 22x $\frac{3}{4}$ -s
1-15 22x $\frac{1}{2}$ -s


- L904-L905**
4-15 8x6x $\frac{5}{8}$ -s
4-15 30x $\frac{1}{2}$ -s
1-15 22x $\frac{3}{4}$ -s
1-15 22x $\frac{1}{2}$ -s

- L903-L904**
4-15 8x6x $\frac{5}{8}$ -s
4-15 30x $\frac{1}{2}$ -s
1-15 22x $\frac{3}{4}$ -s
1-15 22x $\frac{1}{2}$ -s

- L902-L903**
4-15 8x6x $\frac{5}{8}$ -s
4-15 30x $\frac{1}{2}$ -s
1-15 22x $\frac{3}{4}$ -s
1-15 22x $\frac{1}{2}$ -s

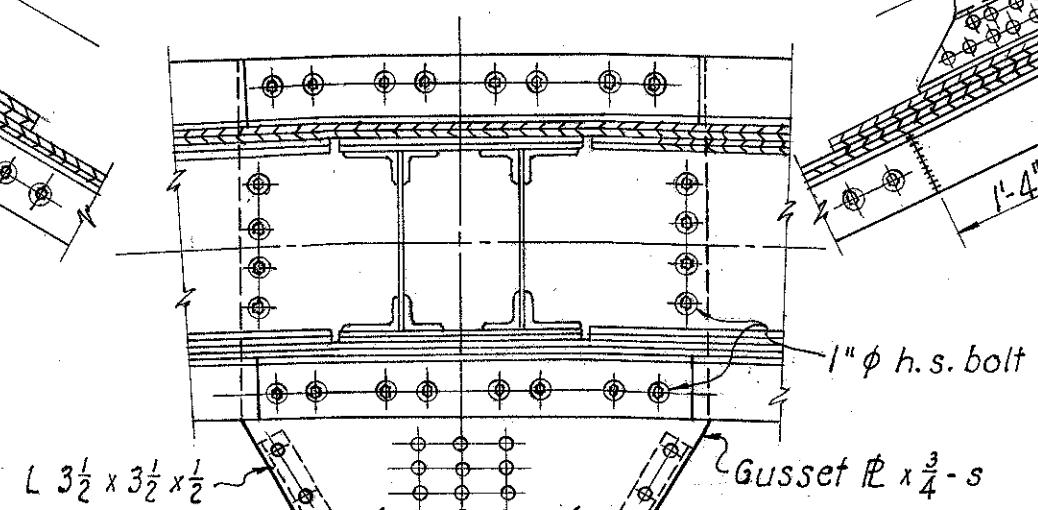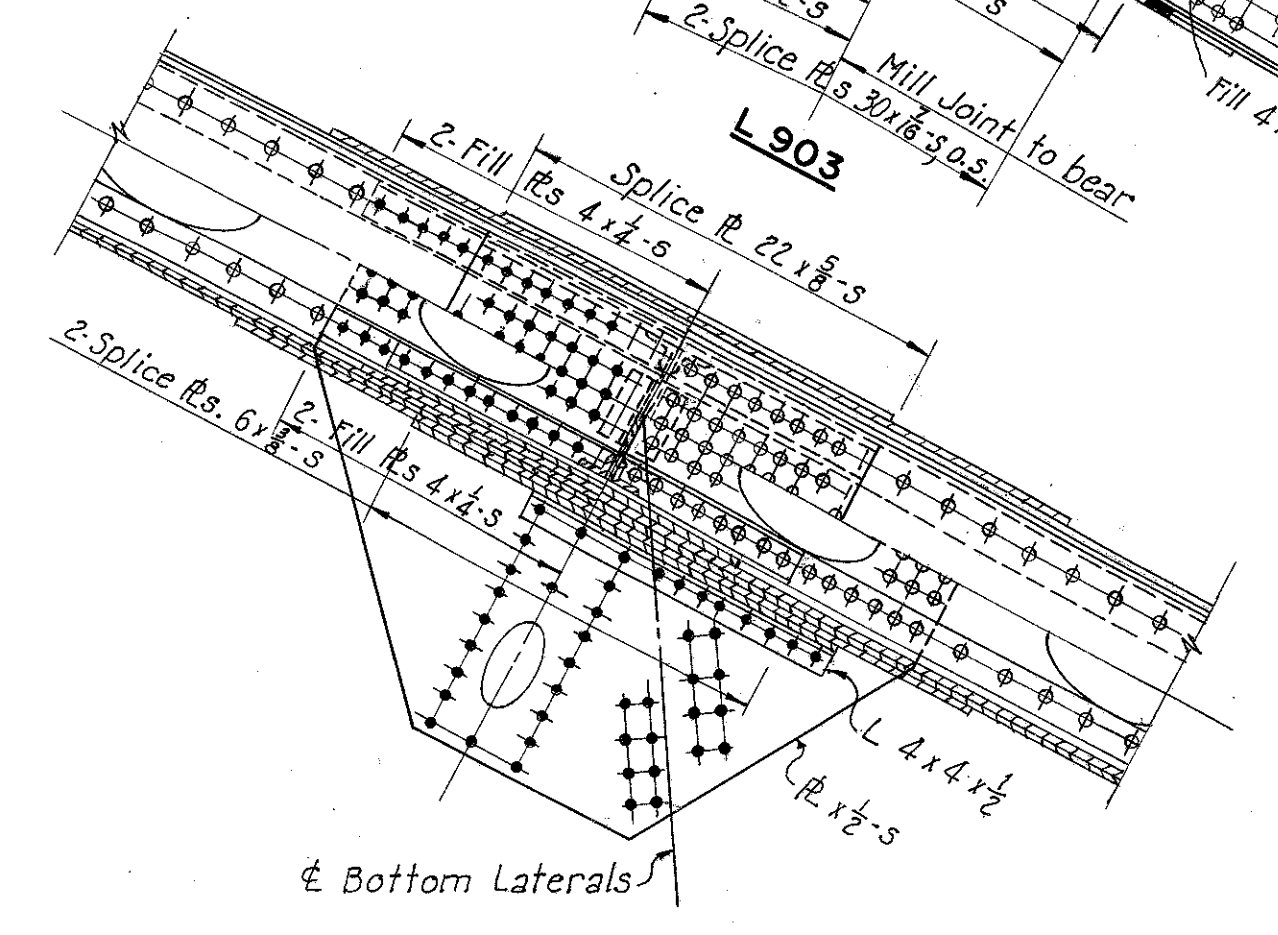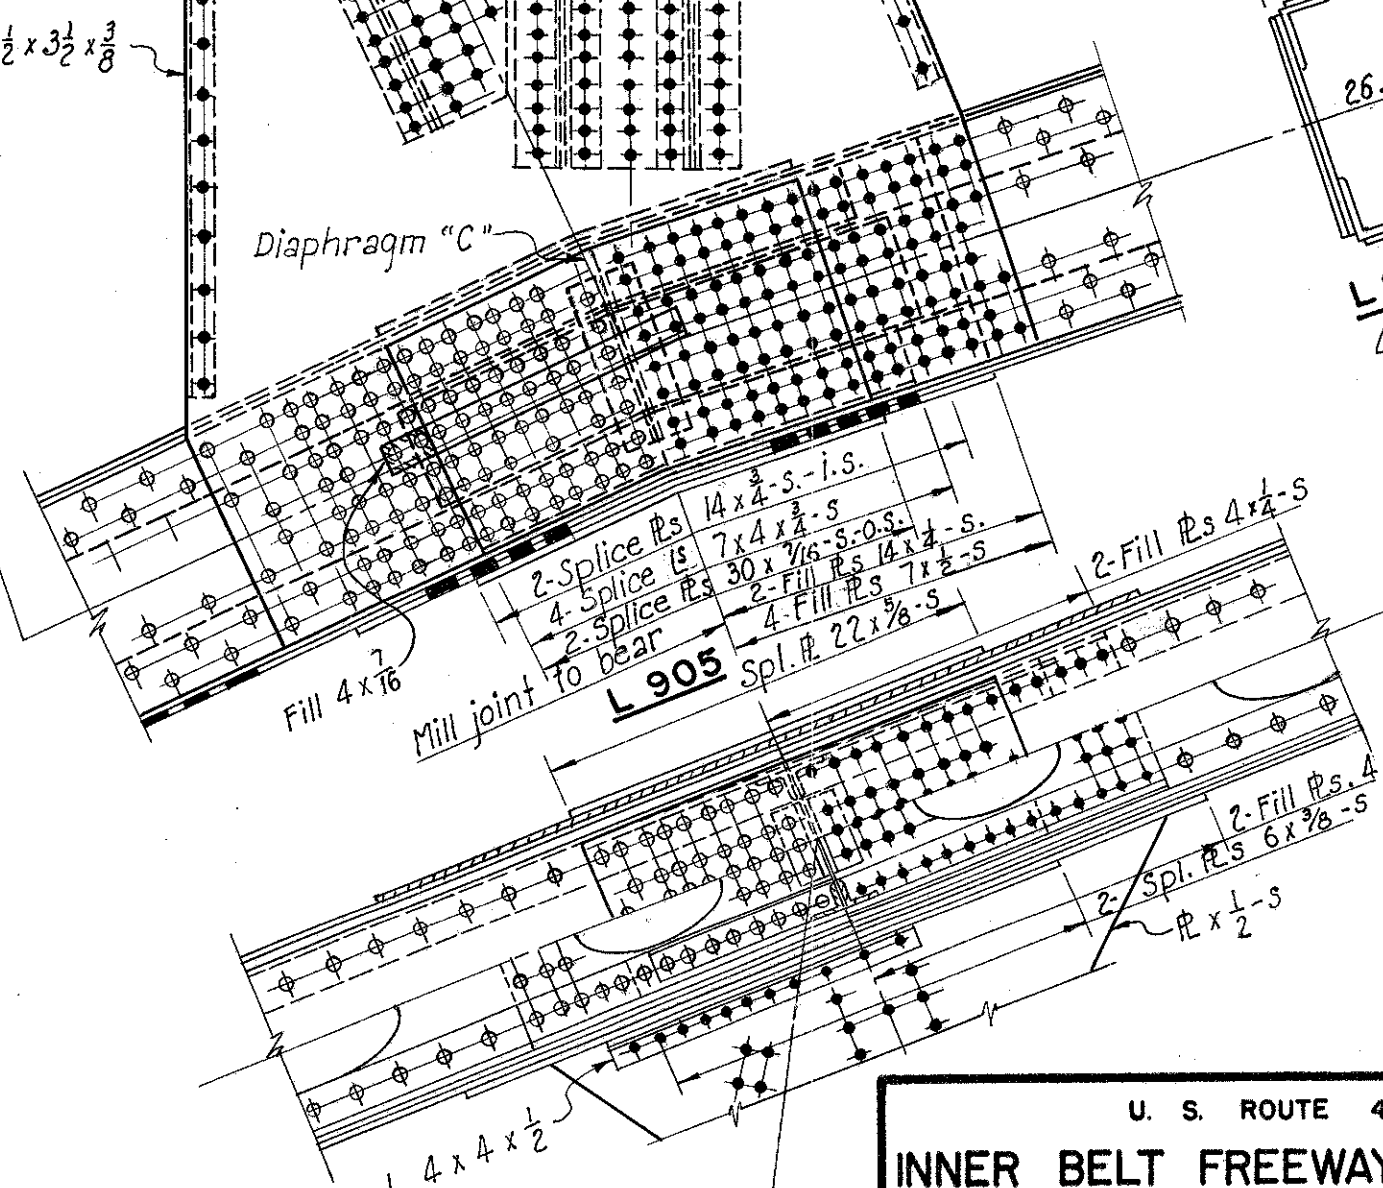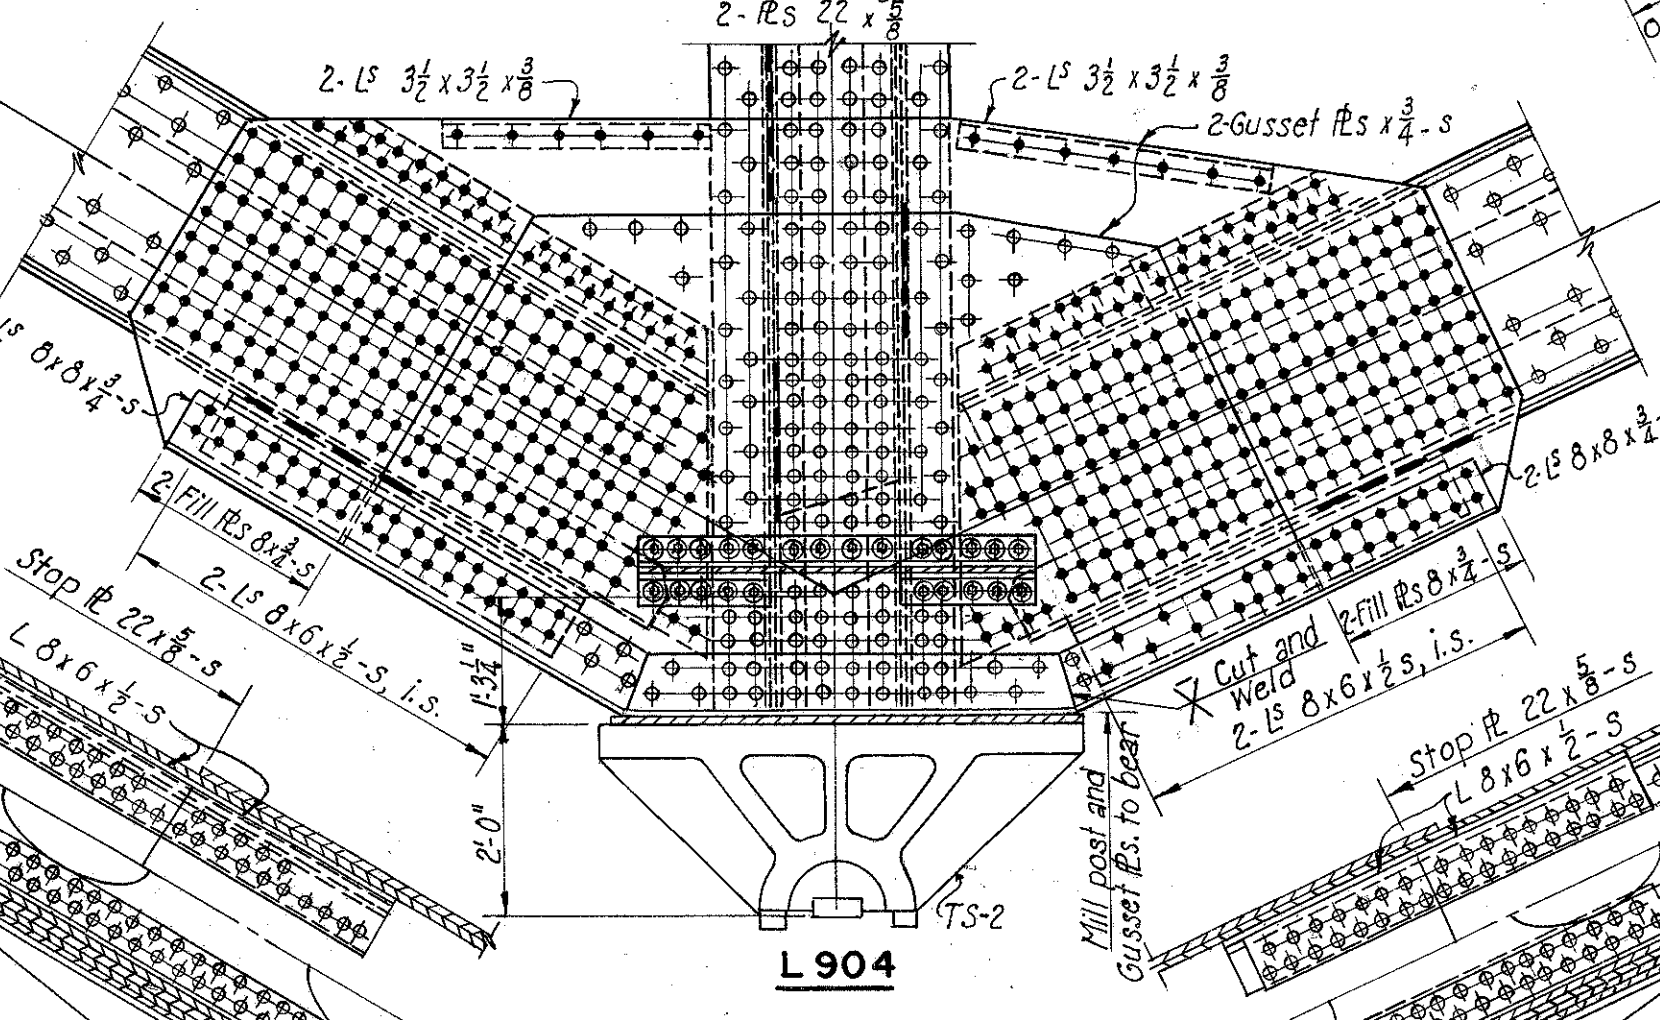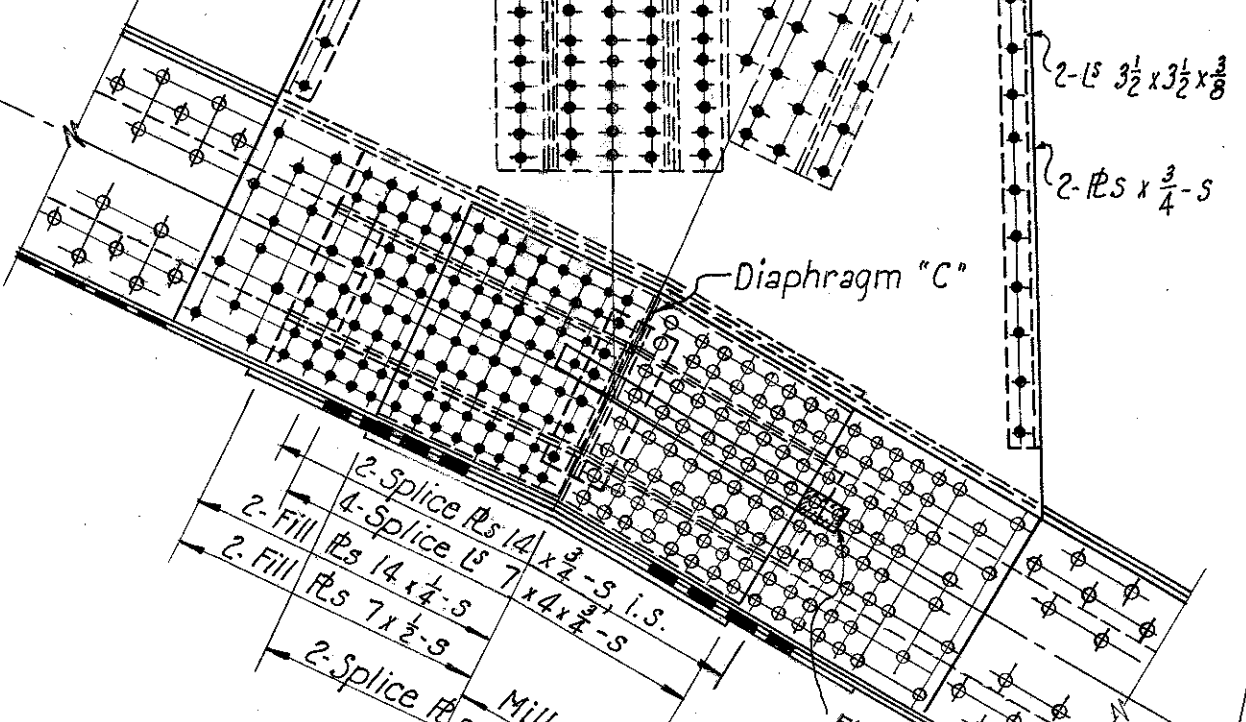

Note: For details of top shoe
casting TS-2, see Sheet 96.
Fill post with concrete up
to line marked "Conc."
For diaphragms inside at
joint L904 see Sheets 33 and 34.

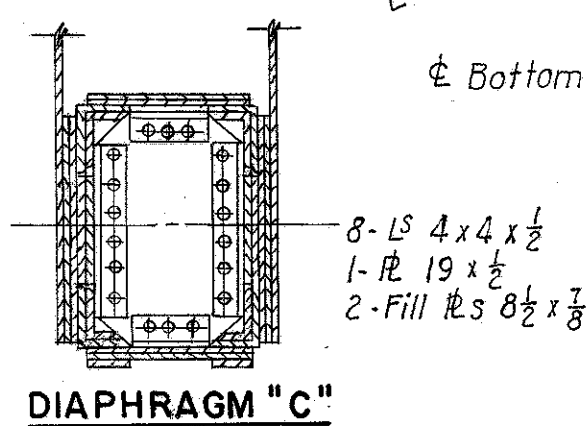

PART 3

U. S. ROUTE 42 RELOCATION
INNER BELT FREEWAY - CENTRAL VIADUCT
BR. NO. CU - 42R-17 5

TRUSS DETAILS UNIT 9
PANELS 903, 904 AND 905

CLEVELAND CUYAHOGA COUNTY OHIO


SCALE: $\frac{1}{2}'' = 1'-0''$
MADE: J.E.S. DATE: 6-30-94
TRCD: A.H. DATE: 12-13-94
CKD: D.L.C. DATE: 9-9-94

HOWARD, NEEDLES, TAMMEN & BERGENDOFF
CONSULTING ENGINEERS
KANSAS CITY CLEVELAND NEW YORK

914-1A SHEET- 2.91

LINE		MEMBER	TENSION WEB MEMBERS																COMPRESSION WEB MEMBERS																	
			L 900 U 901	L 901 U 902	L 902 U 903	L 903 U 904	U 904 L 905	U 905 L 906	U 906 L 907	U 907 L 908	U 908 L 909	U 909 L 910	U 910 L 911	U 912 L 912	U 913 L 913	U 901 L 901	U 902 L 902	M 902 L 902	U 903 L 903	M 903 L 903	U 904 L 904	M 904 L 904	U 905 L 905	M 905 L 905	U 906 L 906	M 906 L 906	U 907 L 907	M 907 L 907	U 908 L 908	U 909 L 909	U 910 L 910	U 911 L 911	U 911 L 912	U 912 L 913	U 913 L 914	U 914 L 914
1	Dead Load		+ 1063	+ 1072	+ 850	+ 680	+ 1050	+ 1169	+ 1188	+ 1058	+ 906	+ 655	+ 211	+ 334	+ 609	- 898	- 991	- 1134	- 872	- 1015	- 1709	- 1927	- 1178	- 1321	- 1162	- 1305	- 993	- 1136	- 836	- 616	- 289	+ 2	- 170	- 625	- 1010	- 98
2	0.8 Dead Load		+ 850	+ 858	+ 680	+ 544	+ 840	+ 935	+ 950	+ 846	+ 725	+ 524	+ 169	+ 267	+ 487	- 718	- 793	- 907	- 698	- 812	- 1367	- 1543	- 942	- 1057	- 930	- 1044	- 794	- 909	- 669	- 493	- 231	+ 2	- 136	- 500	- 808	- 78
3	Live Load + Imp. - Tension																																			
4	Reduced LL + Imp. - Tension		+ 282	+ 279	+ 215	+ 178	+ 334	+ 336	+ 310	+ 297	+ 228	+ 200	+ 190	+ 223	- 274						+ 54	+ 45	+ 52	+ 52	+ 7	+ 7	+ 9	+ 9	+ 23	+ 42	+ 111	+ 154	+ 172	+ 176	+ 177	
5	Live Load + Imp. - Comp.																																			
6	Reduced LL + Imp. - Comp.																																			
7	Reduced LL + Imp. - Ten. x 0 (CF) e		+ 467	+ 462	+ 356	+ 295	- 118	- 59	- 9	- 10	- 47	- 78	- 186	- 128	- 128	- 222	- 239	- 285	- 200	- 249	- 354	- 395	- 311	- 353	- 275	- 324	- 249	- 306	- 186	- 157	- 142	- 125	- 251	- 349	- 422	- 36
8	Reduced LL + Imp. - Comp. x 0 (CF) e						- 196	- 98	- 15	- 17	- 78	- 129	- 308	- 212	- 212	- 368	- 396	- 472	- 331	- 413	- 587	- 655	- 515	- 585	- 456	- 537	- 413	- 507	- 308	- 260	- 235	- 207	- 416	- 578	- 699	- 60
9	Ratio = $\frac{U_{904} + U_{905} + U_{906} + U_{907} + U_{908} + U_{909} + U_{910} + U_{911} + U_{912} + U_{913}}{U_{901} + U_{902} + U_{903} + U_{904} + U_{905} + U_{906} + U_{907} + U_{908} + U_{909} + U_{910} + U_{911} + U_{912} + U_{913}}$						- 0.11	- 0.05	- 0.008	- 0.01	- 0.05	- 0.12	- 0.88	- 0.39	- 0.21						- 0.03	- 0.03	- 0.04	- 0.04	- 0.00	- 0.00	- 0.01	- 0.00	- 0.03	- 0.05	- 0.38	- 62.5	- 1.01	- 0.28	- 0.17	
10	LL Sidewalk - Tension		+ 13	+ 13	+ 10	+ 8	+ 17	+ 16	+ 14	+ 13	+ 12	+ 11	+ 11	+ 14							+ 2	+ 2	+ 3	+ 3	0	0	0	0	+ 1	+ 1	+ 5	+ 7	+ 10	+ 9	+ 9	
11	LL Sidewalk - Comp.						- 6	- 9	- 0	- 1	- 2	- 3	- 8	- 7	- 7	- 11	- 12	- 14	- 10	- 12	- 20	- 22	- 15	- 17	- 13	- 15	- 12	- 14	- 11	- 9	- 8	- 7	- 11	- 16	- 21	- 1
12	Direct Design Stress		+ 1330	+ 1333	+ 1046	+ 847	+ 1411	+ 1508	+ 1478	+ 1351	+ 1115	+ 866	+ 495	+ 648	+ 955	- 1097	- 1201	- 1393	- 1039	- 1237	- 1974	- 2220	- 1472	- 1659	- 1399	- 1596	- 1219	- 1430	- 988	- 772	- 474	- 264	- 563	- 1094	- 1528	- 139
13	Reverse Design Stress																																			
14																																				
15																																				
	Section	Holes out for Tension																																		
a	Outer Angles	2	4 x 4 x 3/8	4 x 4 x 3/4	4 x 4 x 1/2	4 x 4 x 3/8	4 x 4 x 3/4	4 x 4 x 3/4	4 x 4 x 3/4	4 x 4 x 3/8	4 x 4 x 3/8	b	1. Web Plates	3	24 x 3/8	24 x 3/8	26 x 3/8	28 x 1/2	28 x 3/4	26 x 3/4	24 x 3/4	24 x 3/4	24 x 3/4	24 x 3/4	24 x 3/4	24 x 3/4	24 x 3/4	24 x 3/4	26 x 3/4	26 x 3/4	28 x 3/4	30 x 3/4	30 x 3/4	28 x 3/4	28 x 3/4	28 x 3/4	26 x 3/4	26 x 3/8	24 x 3/4	24 x 3/4	24 x 3/4	24 x 3/4	24 x 3/4	24 x 3/4	24 x 3/4	24 x 3/4	24 x 3/4	24 x 3/4
c	Cover Plates	2	23 x 1/8 (**)	23 x 3/8 (**)	23 x 3/8 (**)
e	Inner Angles	2																																		
g	2. Web Plates	3																																		
25	Length	In.														408"	496"	496"	636"	636"	816"	816	672"	672"	567"	567"	492"	492"	417"	379.5"	342"	330"	437.2	437.2	439.87"	318"
26	Minimum Radius of Gyration In.															7.67	7.99	7.77	8.54	8.25	9.08	8.92	8.53	8.28	7.96	7.75	7.75	7.55	7.4	7.71	7.70	7.70	7.70	7.63	7.70	
27	Allowable Stress Lbs./Sq. In.		24,000	24,000	24,000	24,000	24,000	24,000	24,000	24,000	24,000	24,000	24,000	24,000	24,000	18,700	18,120	18,120	17,270	17,270	16,160	16,160	17,180	17,180	17,540	17,540	18,050	18,050	18,670	18,690	19,090	14,540	16,520	18,520	18,470	14,570
28	Actual Gross Area Sq. In.		72.14	72.14	57.25	49.19	73.51	77.01	73.51	67.51	58.19	45.19	39.19	39.19	49.50	64.19	72.14	83.58	65.38	76.82	125.44	136.88	88.14	99.58	78.64	90.08	67.51	78.95	58.19	48.75	39.19	39.19	61.19	81.14	39.19	
29	Net Area Sq. In.		59.52	59.52	46.75	40.69	60.01	62.51	60.76	55.51	47.94	37.69	32.44	32.44	40.00	64.19	72.14	83.58	61.78	76.82	125.44	136.88	88.14	99.58	78.64	90.08	67.51	78.95	54.50	42.09	31.33	31.33	59.64	81.14	31.33	
30	Actual Unit Stress Lbs./Sq. In.		22,340	22,340	22,370	20,810	23,510	24,120	24,300	23,260	22,980	15,250	19,980	23,880	17,090	16,650	16,680	16,810	16,100	15,740	16,200	16,700	16,700	16,660	17,180	17,720	18,130	18,130	15,130	6,650	17,960	18,340	18,810	4,360		
31	Material		S	S	S	S	S	S	S	S	S	S	S	S	S	S	S	S	S	S	S	S	S	S	S	S	S	S	S	S	C	S	S	S	C	

Diagram of a web member. It is a rectangular section with width b and height c . The top edge is labeled a and the bottom edge is labeled a . The left edge is labeled b and the right edge is labeled b . The top corners are labeled a and a , and the bottom corners are labeled a and a . The diagram is labeled **WEB MEMBER**.

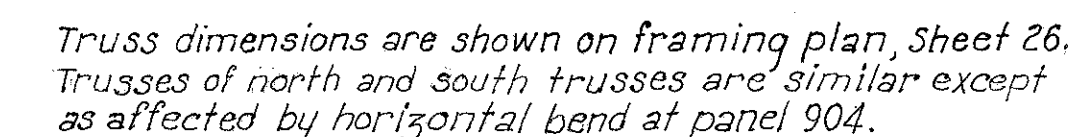

Line 29, net area for tension or effective gross area for compression.

WEB MEMBER

U. S. ROUTE 42 RELOCATION

INNER BELT FREEWAY - CENTRAL VIADUCT

BR. NO. CU - 42 R-17 5

STRESS SHEET UNIT 9

NORTH TRUSS

CLEVELAND	CUYAHOGA COUNTY	OHIO
-----------	-----------------	------

SCALE None

MADE H. W. L. DATE 5-8-54

~~TRCD~~ MADE F. L. DATE 9-24-54

CKD. G. H. H. DATE 7-28-54

HOWARD, NEEDLES, TAMMEN & BERGENDOFF	CONSULTING ENGINEERS	
KANSAS CITY	CLEVELAND	NEW YORK

914-1A SHEET 2.89


MICROFILMED
FEB 16 1983

FED. ROAD DIV. NO.	STATE	FEDERAL AID PROJECT NO.	TYPE FUNDS
2	OHIO		


88

122

CUYAHOGA COUNTY
CITY OF CLEVELAND
INNER BELT FREEWAY
CENTRAL VIADUCT

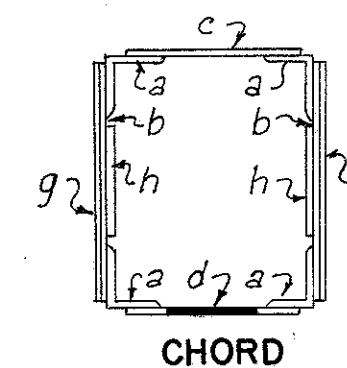

TENSION CHORD-SOUTH TRUSS						COMPRESSION CHORD-SOUTH TRUSS						LINE	TENSION CHORD-NORTH TRUSS						COMPRESSION CHORD-NORTH TRUSS						
L80	L81	L82	L83	L84	L85	U80	U81	U82	U83	U84	U85		L80	L81	L82	L83	L84	L85	U80	U81	U82	U83	U84	U85	
0	+ 731	+ 1,222	+ 1,222	+ 731	0	- 731	- 1,221	- 1,445	- 1,445	- 1,221	- 731	1	Dead Load	0	+ 784	+ 1,312	+ 1,312	+ 784	0	- 783	- 1,311	- 1,550	- 1,550	- 1,311	- 783
0	+ 585	+ 978	+ 978	+ 585	0	- 585	- 977	- 1,156	- 1,156	- 977	- 585	2	0.8 Dead Load	0	+ 627	+ 1,050	+ 1,050	+ 627	0	- 626	- 1,049	- 1,240	- 1,240	- 1,049	- 626
0	+ 227	+ 366	+ 366	+ 277	0							3	Live Load + Impact - Tension	0	+ 246	+ 397	+ 397	+ 246	0						
0	+ 227	+ 366	+ 366	+ 277	0							4	Reduced L.L. + Impact - Tension	0	+ 246	+ 397	+ 397	+ 246	0						
						- 227	- 366	- 407	- 407	- 366	- 227	5	Live Load + Impact - Comp.						- 246	- 397	- 441	- 441	- 397	- 246	
						- 227	- 366	- 407	- 407	- 366	- 227	6	Reduced L.L. + Impact - Comp.						- 246	- 397	- 441	- 441	- 397	- 246	
0	+ 376	+ 606	+ 606	+ 376	0							7	Red. L.L. + Imp. - Tension x D (C.F.) ^e	0	+ 408	+ 658	+ 658	+ 408	0						
						- 376	- 606	- 675	- 675	- 606	- 376	8	Red. L.L. + Imp. - Comp. x D (C.F.) ^e						- 408	- 658	- 731	- 731	- 658	408	
												9	Ratio = $\frac{\text{Live Comp.}}{\text{Live Tension}}$												
0	+ 9	+ 15	+ 15	+ 9	0							10	L.L. Sidewalk - Tension	0	+ 10	+ 16	+ 16	+ 10	0						
0	+ 970	+ 1,599	+ 1,599	+ 970	0	- 970	- 1,598	- 1,849	- 1,849	- 1,598	- 970	11	L.L. Sidewalk - Compression						- 10	- 16	- 19	- 19	- 16	- 10	
												12	Direct Design Stress- \odot + \odot + \odot or \odot + \odot + \odot	0	+ 1,045	+ 1,724	+ 1,724	+ 1,045	0	- 1,044	- 1,723	- 1,990	- 1,990	- 1,723	- 1,044
												13	Reverse Design Stress												
												14													
												15													
												16													
												17													
4 x 4 x $\frac{3}{16}$	4 x 4 x $\frac{3}{16}$	4 x 4 x $\frac{3}{8}$	4 x 4 x $\frac{3}{8}$	4 x 4 x $\frac{3}{8}$	4 x 4 x $\frac{3}{16}$	8 x 6 x $\frac{1}{16}$	8 x 6 x $\frac{1}{16}$	8 x 6 x $\frac{1}{2}$	8 x 6 x $\frac{1}{2}$	8 x 6 x $\frac{3}{16}$	8 x 6 x $\frac{1}{16}$	Section													
30 x $\frac{3}{8}$	30 x $\frac{3}{16}$	30 x $\frac{1}{16}$	30 x $\frac{1}{16}$	30 x $\frac{1}{16}$	30 x $\frac{1}{16}$	30 x $\frac{3}{8}$	30 x $\frac{3}{8}$	30 x $\frac{3}{8}$	30 x $\frac{3}{8}$	30 x $\frac{3}{8}$	30 x $\frac{3}{8}$	a	Flange Angles	2	4 x 4 x $\frac{3}{16}$	4 x 4 x $\frac{3}{16}$	4 x 4 x $\frac{3}{8}$	4 x 4 x $\frac{3}{8}$	4 x 4 x $\frac{3}{16}$	8 x 6 x $\frac{1}{2}$	8 x 6 x $\frac{1}{2}$	8 x 6 x $\frac{1}{2}$	8 x 6 x $\frac{1}{2}$	8 x 6 x $\frac{1}{2}$	8 x 6 x $\frac{1}{2}$
												f	Inside Web Plate	2						14 x $\frac{3}{16}$	14 x $\frac{3}{16}$				
18,000	24,000	24,000	24,000	24,000	18,000	19,630	19,670	19,660	19,660	19,670	19,630	25	Length	In.						300"	300"	300"	300"	300"	300"
43.79	52.32	82.32	82.32	52.32	43.79	60.85	63.35	97.13	97.13	83.35	60.85	26	Min. Radius of Gyration	In.					10.59	11.18	10.84	10.84	11.18	10.59	
36.60	43.69	69.69	69.69	43.69	36.60	54.28	82.97	96.75	96.75	82.97	54.28	27	Allowable Stress	Lbs./Sq. In.	18,000	24,000	24,000	24,000	18,000	19,630	19,670	19,660	19,660	19,630	
0	22,180	22,920	22,920	22,180	0	17,860	19,260	19,100	19,100	19,260	17,860	28	Actual Gross Area	Sq. In.	43.79	56.07	86.07	86.07	43.79	64.13	90.38	102.63	102.63	90.38	64.13
C	S	S	S	S	C	S	S	S	S	S	S	29	Net Area	Sq. In.	36.60	46.94	72.94	72.94	36.60	57.56	90.00	102.25	102.25	90.00	57.56
												30	Actual Unit Stress	Lbs./Sq. In.	0	22,250	23,360	22,250	0	18,150	19,150	19,460	19,460	18,150	
												31	Material	C	S	S	S	S	C	S	S	S	S	S	

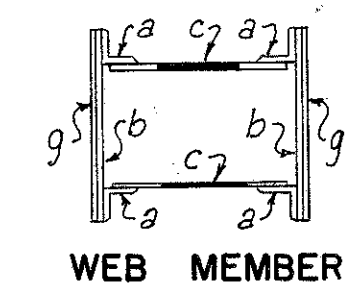
[illegible]

*S = Special Steel
C = Carbon Steel*

All dead and live load stresses are in kips.

Line 29, net are for tension or effective gross area for compression.

All details are the same as for the respective truss of Unit 6 except as modified by grades. See Sheets 28 and 29.

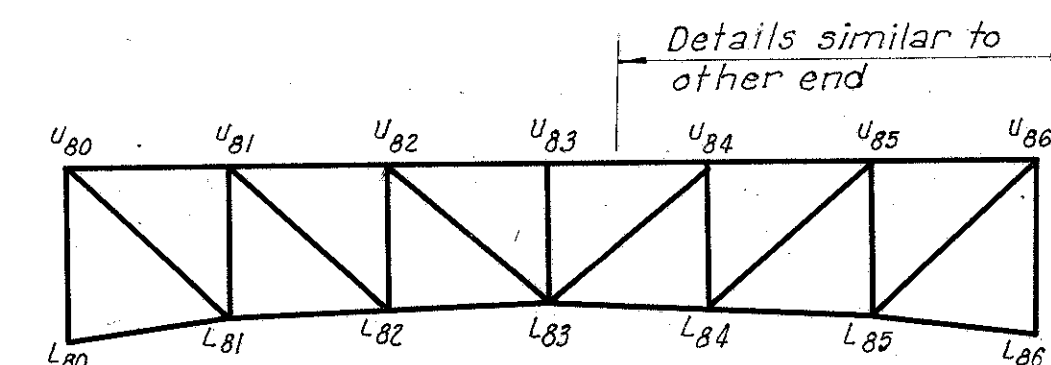

Truss dimensions are shown on framing plan, Sheet 25.

PART 3

U. S. ROUTE 42 RELOCATION
INNER BELT FREEWAY - CENTRAL VIADUCT
BR. NO. CU - 42 R-17.5

STRESS SHEET UNIT 8
NORTH AND SOUTH TRUSSES

CLEVELAND CUYAHOGA COUNTY OHIO

SCALE None
MADE D.M.E. DATE 5-4-54
C.H.K.
TRCD A.H. DATE 9-17-54
CKD H.W.L. DATE 5-19-54


HOWARD, NEEDLES, TAMMEN & BERGENDOFF
CONSULTING ENGINEERS
KANSAS CITY CLEVELAND NEW YORK
914-1A SHEET 2.88

UNRECORDED
FEB 16 1954


FED. ROAD DIV. NO.	STATE	FEDERAL AID PROJECT NO.	TYPE FUNDS
2	OHIO		

87
122


CUYAHOGA COUNTY
CITY OF CLEVELAND
INNER BELT FREEWAY
CENTRAL VIADUCT

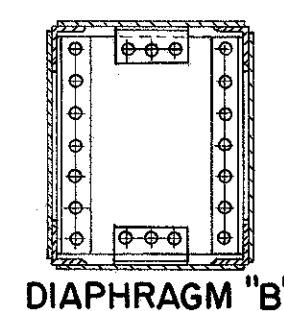


DIAPHRAGM "B"
4 B 8x4 1/2
4 B 4x4 1/2
1 Pl. 1/2

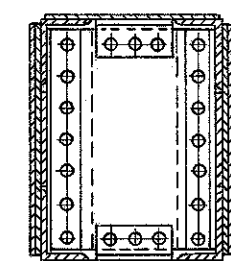


DIAPHRAGM "C"
2 B 8x4 1/2 n.s.
2 B 8x6 1/2 f.s.
4 B 4x4 1/2
4 Fill 8x 1/2
1 Pl. 1/2

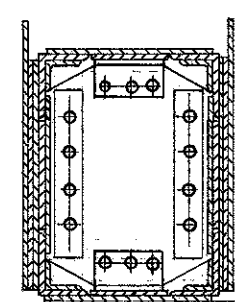


DIAPHRAGM "G"
4 B 4x4 1/2
4 B 4x4 1/2
2 Fill 9x 1/2
1 Pl. 20x 1/2

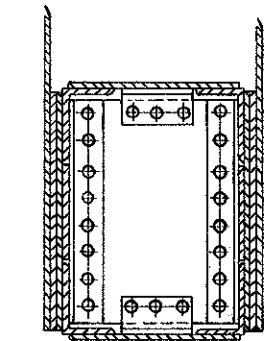


DIAPHRAGM "F"
4 B 4x4 1/2 bent
2 B 4x4 1/2
1 Pl. 1/2 bent

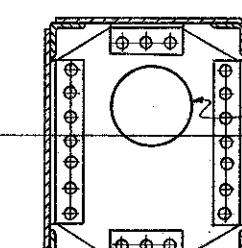

DIAPHRAGM "A"
8 B 4x4 1/2
1 Pl. 1/2

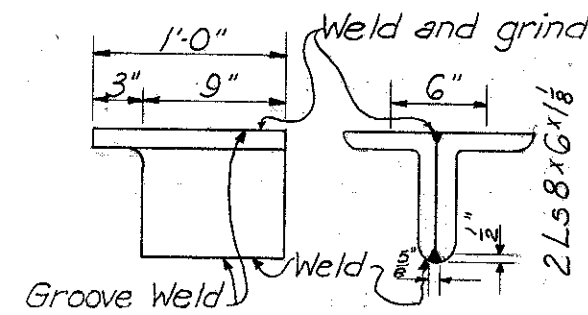

DETAIL "A"
Scale: 1"=1'-0"

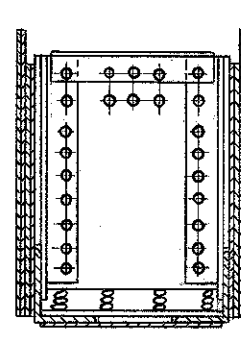

DIAPHRAGM "D"
3 B 4x4 1/2
2 Fill 4x 1/2
1 Fill 4x 1/2
1 Pl. 22x 1/2 bent
1 Fill 11x 1/2

Notes:
For Pin Detail, see
Sheet 70.
For Link Details, see
Sheet 78.

PART 3

U. S. ROUTE 42 RELOCATION
INNER BELT FREEWAY - CENTRAL VIADUCT
BR. NO. CU - 42 R-17.5

TRUSS DETAILS, UNIT 7 SOUTH
PANELS 702, 701 AND 700

CLEVELAND CUYAHOGA COUNTY OHIO

SCALE: 3/8"=1'-0"






MADE BY: DATE 6-2-54
TRUSS: DATE 6-2-54
CHKD: DATE 10-13-54

HOWARD, NEEDLES, TAMMEN & BERGENDOFF
CONSULTING ENGINEERS
KANSAS CITY CLEVELAND NEW YORK
914-1A SHEET 2.87

UNREPRODUCED
FEB 16 1964

FED. ROAD DIV. NO.	STATE	FEDERAL AID PROJECT NO.	TYPE FUNDS	86 122
2	OHIO			

CUYAHOGA COUNTY
CITY OF CLEVELAND
INNER BELT FREEWAY
CENTRAL VIADUCT

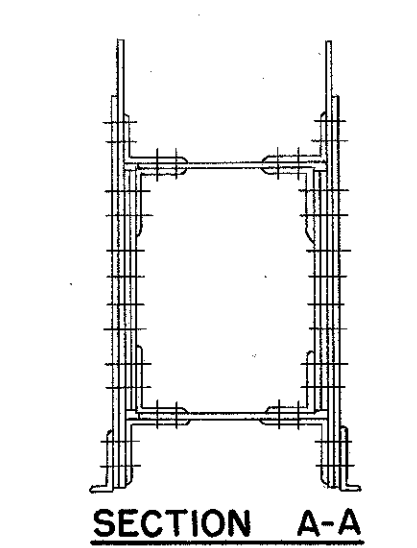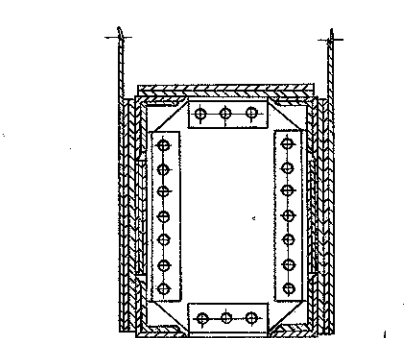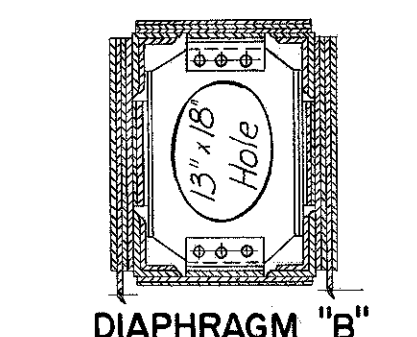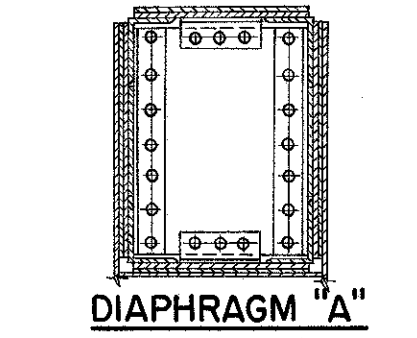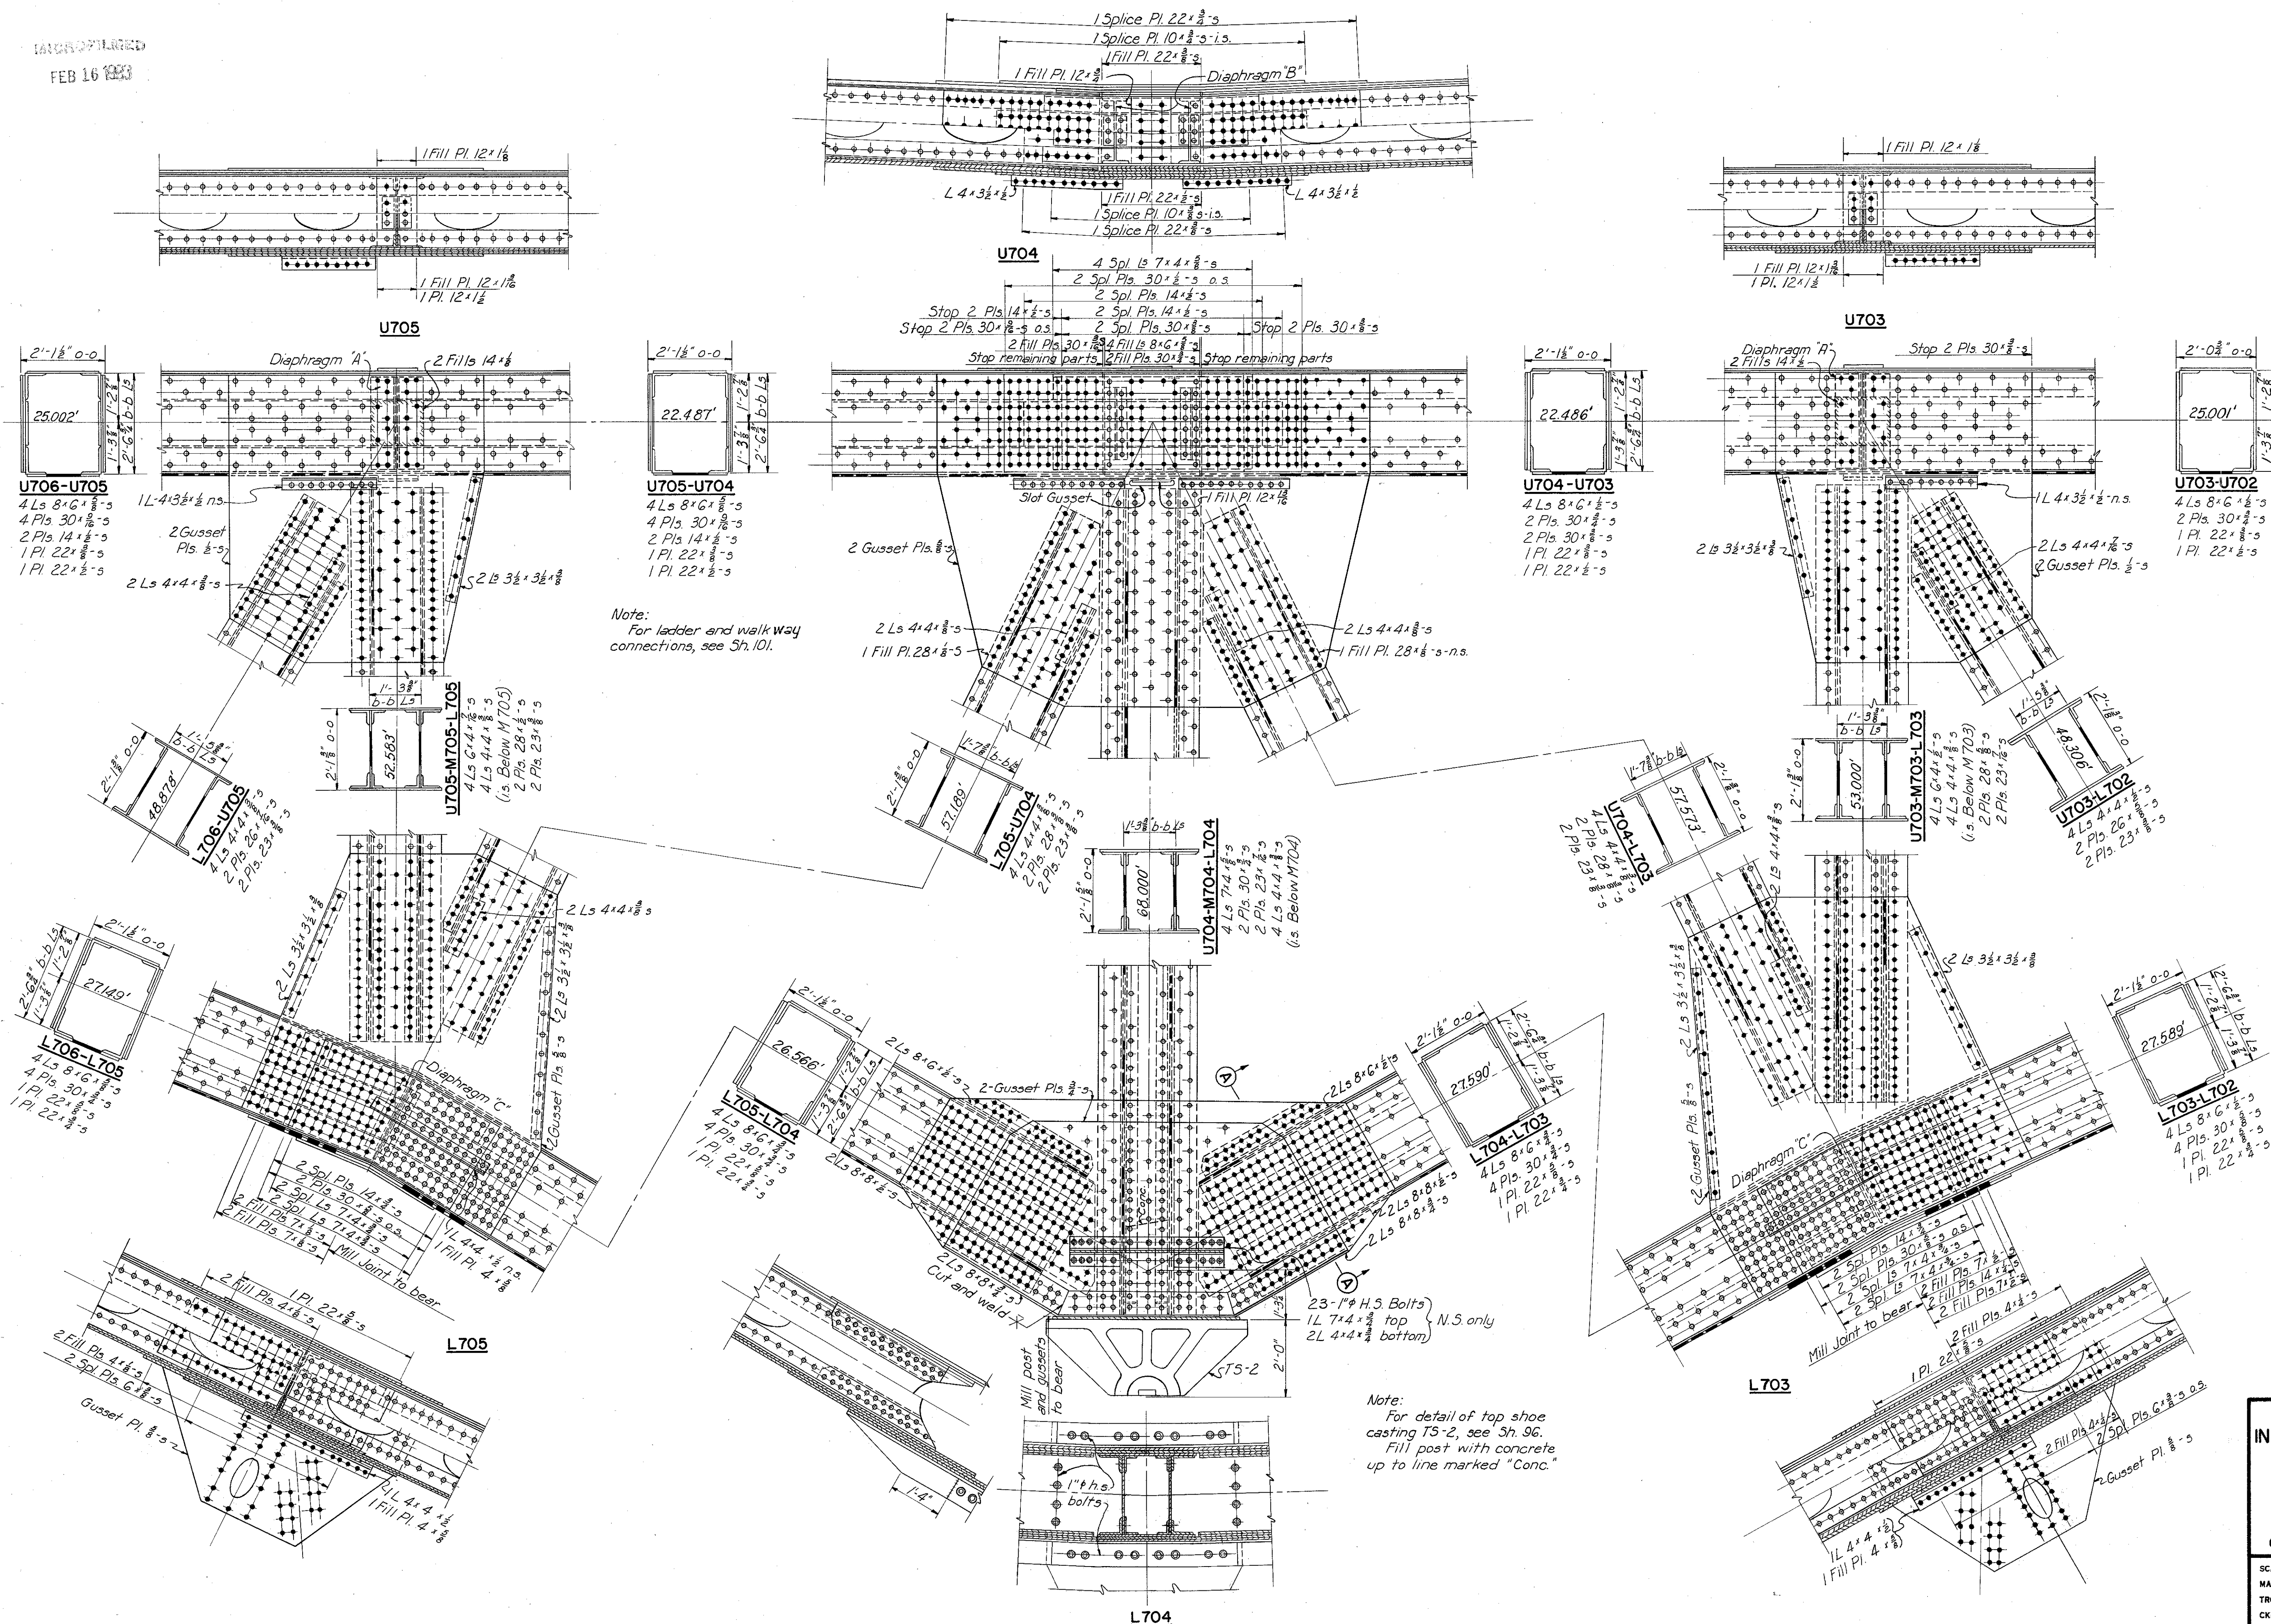

PART 3

U. S. ROUTE 42 RELOCATION
INNER BELT FREEWAY - CENTRAL VIADUCT
BR. NO. CU -42 R-17.5

TRUSS DETAILS, UNIT 7 SOUTH
PANELS 705, 704 AND 703

CLEVELAND CUYAHOGA COUNTY OHIO


SCALE: 1" = 1'-0"
MADE BY DATE 7-16-54
TRCD A.M. DATE 7-26-54
CKD J.G.S. DATE 10-19-54

HOWARD, NEEDLES, TAMMEN & BERGENDOFF
CONSULTING ENGINEERS
KANSAS CITY CLEVELAND NEW YORK
914-1A SHEET 2.86

MICROFILMED
FEB 16 1983

FED. ROAD DIV. NO.	STATE	FEDERAL AID PROJECT NO.	TYPE FUNDS	85 122
2	OHIO			

CUYAHOGA COUNTY
CITY OF CLEVELAND
INNER BELT FREEWAY
CENTRAL VIADUCT

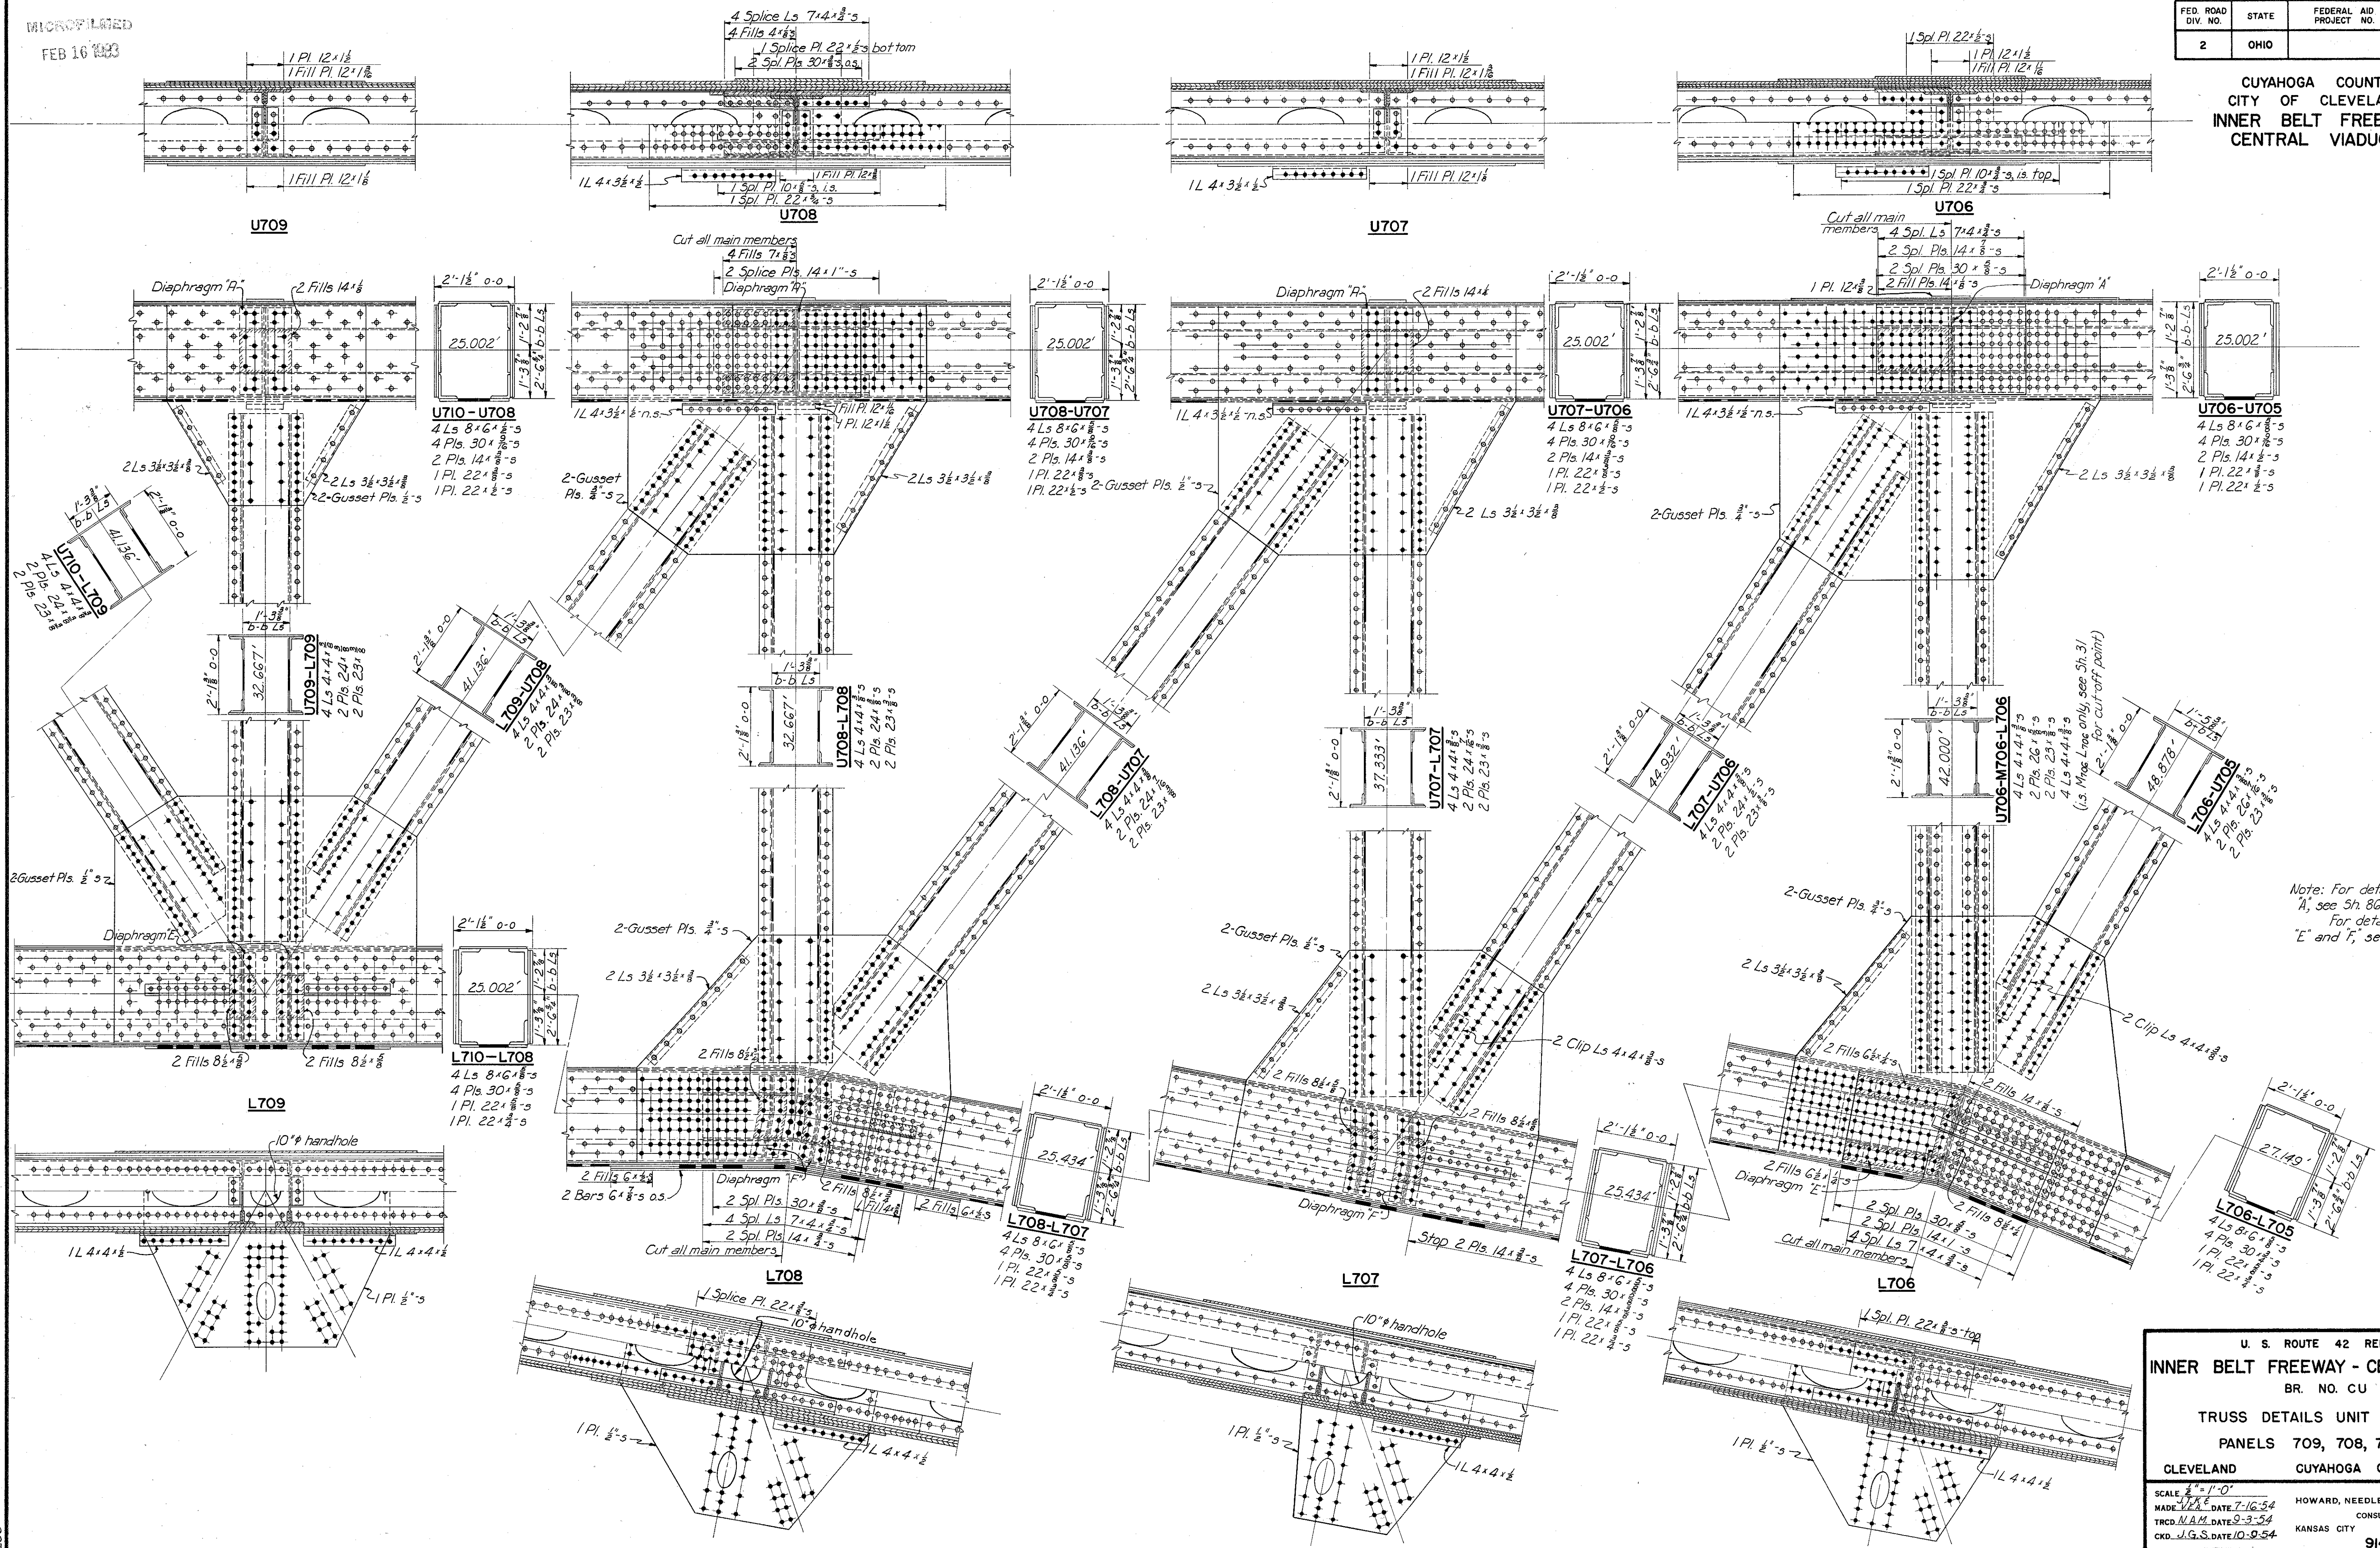

Note: For details of Diaphragm
"A", see Sh. 86.
For details of Diaphragms
"E" and "F", see Sh. 87.

PART 3


U. S. ROUTE 42 RELOCATION
INNER BELT FREEWAY - CENTRAL VIADUCT
BR. NO. CU -42R-175
TRUSS DETAILS UNIT 7 - SOUTH
PANELS 709, 708, 707, 706
CLEVELAND CUYAHOGA COUNTY OHIO
SCALE: 1/4" = 1'-0"
MADE: 1/16/54 DATE: 7-16-54
TRCD: N.A.H. DATE: 9-3-54
CKD: J.G.S. DATE: 10-9-54
HOWARD, NEEDLES, TAMMEN & BERGENDOFF
CONSULTING ENGINEERS
KANSAS CITY CLEVELAND NEW YORK
914-1A SHEET: 2.85

MICROFILMED
FEB 16 1983

FED. ROAD DIV. NO.	STATE	FEDERAL AID PROJECT NO.	TYPE FUNDS
2	OHIO		

84
122

CUYAHOGA COUNTY
CITY OF CLEVELAND
INNER BELT FREEWAY
CENTRAL VIADUCT

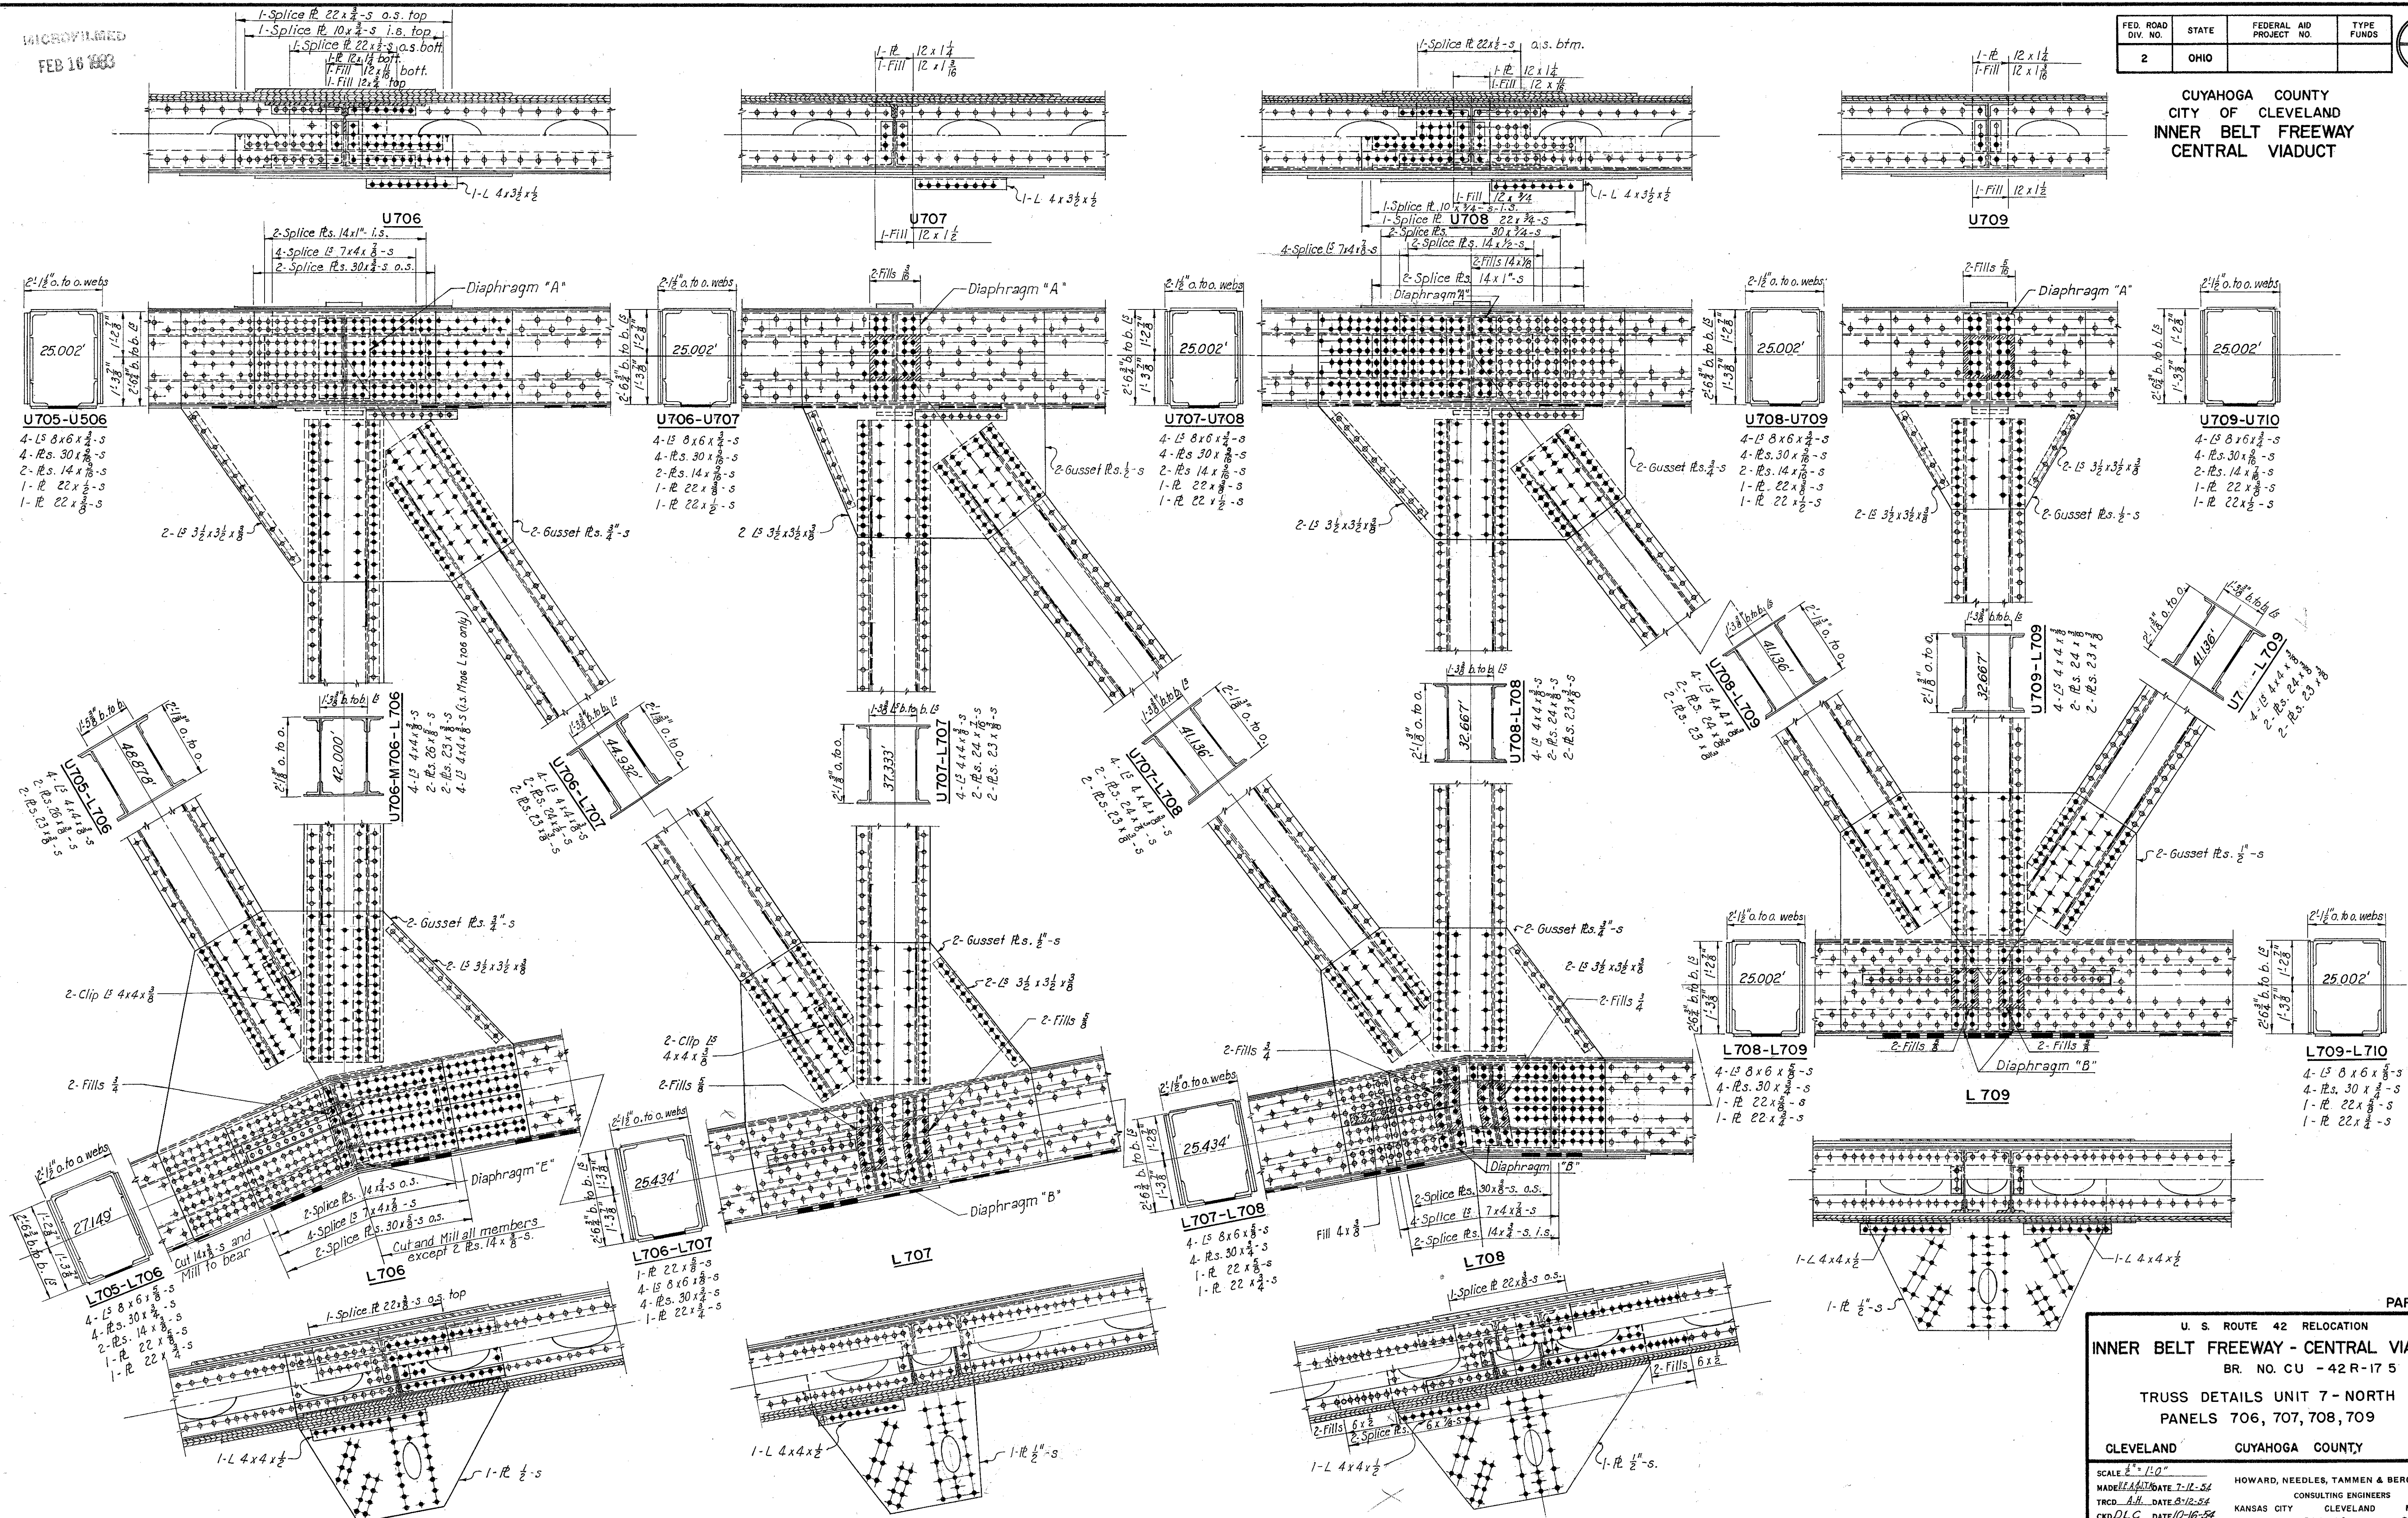


PART 3

U. S. ROUTE 42 RELOCATION
INNER BELT FREEWAY - CENTRAL VIADUCT
BR. NO. CU - 42 R-17 5
TRUSS DETAILS UNIT 7 - NORTH
PANELS 706, 707, 708, 709
CLEVELAND CUYAHOGA COUNTY OHIO
SCALE: 1" = 10'-0"
MADE BY: DATE: 7-12-54
TRCD: A.H. DATE: 8-12-54
CKD: D.L.C. DATE: 10-16-54
HOWARD, NEEDLES, TAMMEN & BERGENDOFF
CONSULTING ENGINEERS
KANSAS CITY CLEVELAND NEW YORK
914-1A SHEET 2.84

PART 3

SCALE $\frac{1}{2}'' = 1'-0''$
MADE C.I.C. DATE 6-3-54
TRCD N.A.M. DATE 12-13-54
CKD R.L.C. DATE _____

HOWARD, NEEDLES, TAMMEN & BERGENDOFF
CONSULTING ENGINEERS
KANSAS CITY CLEVELAND NEW YORK
914-1A SHEET 2-83

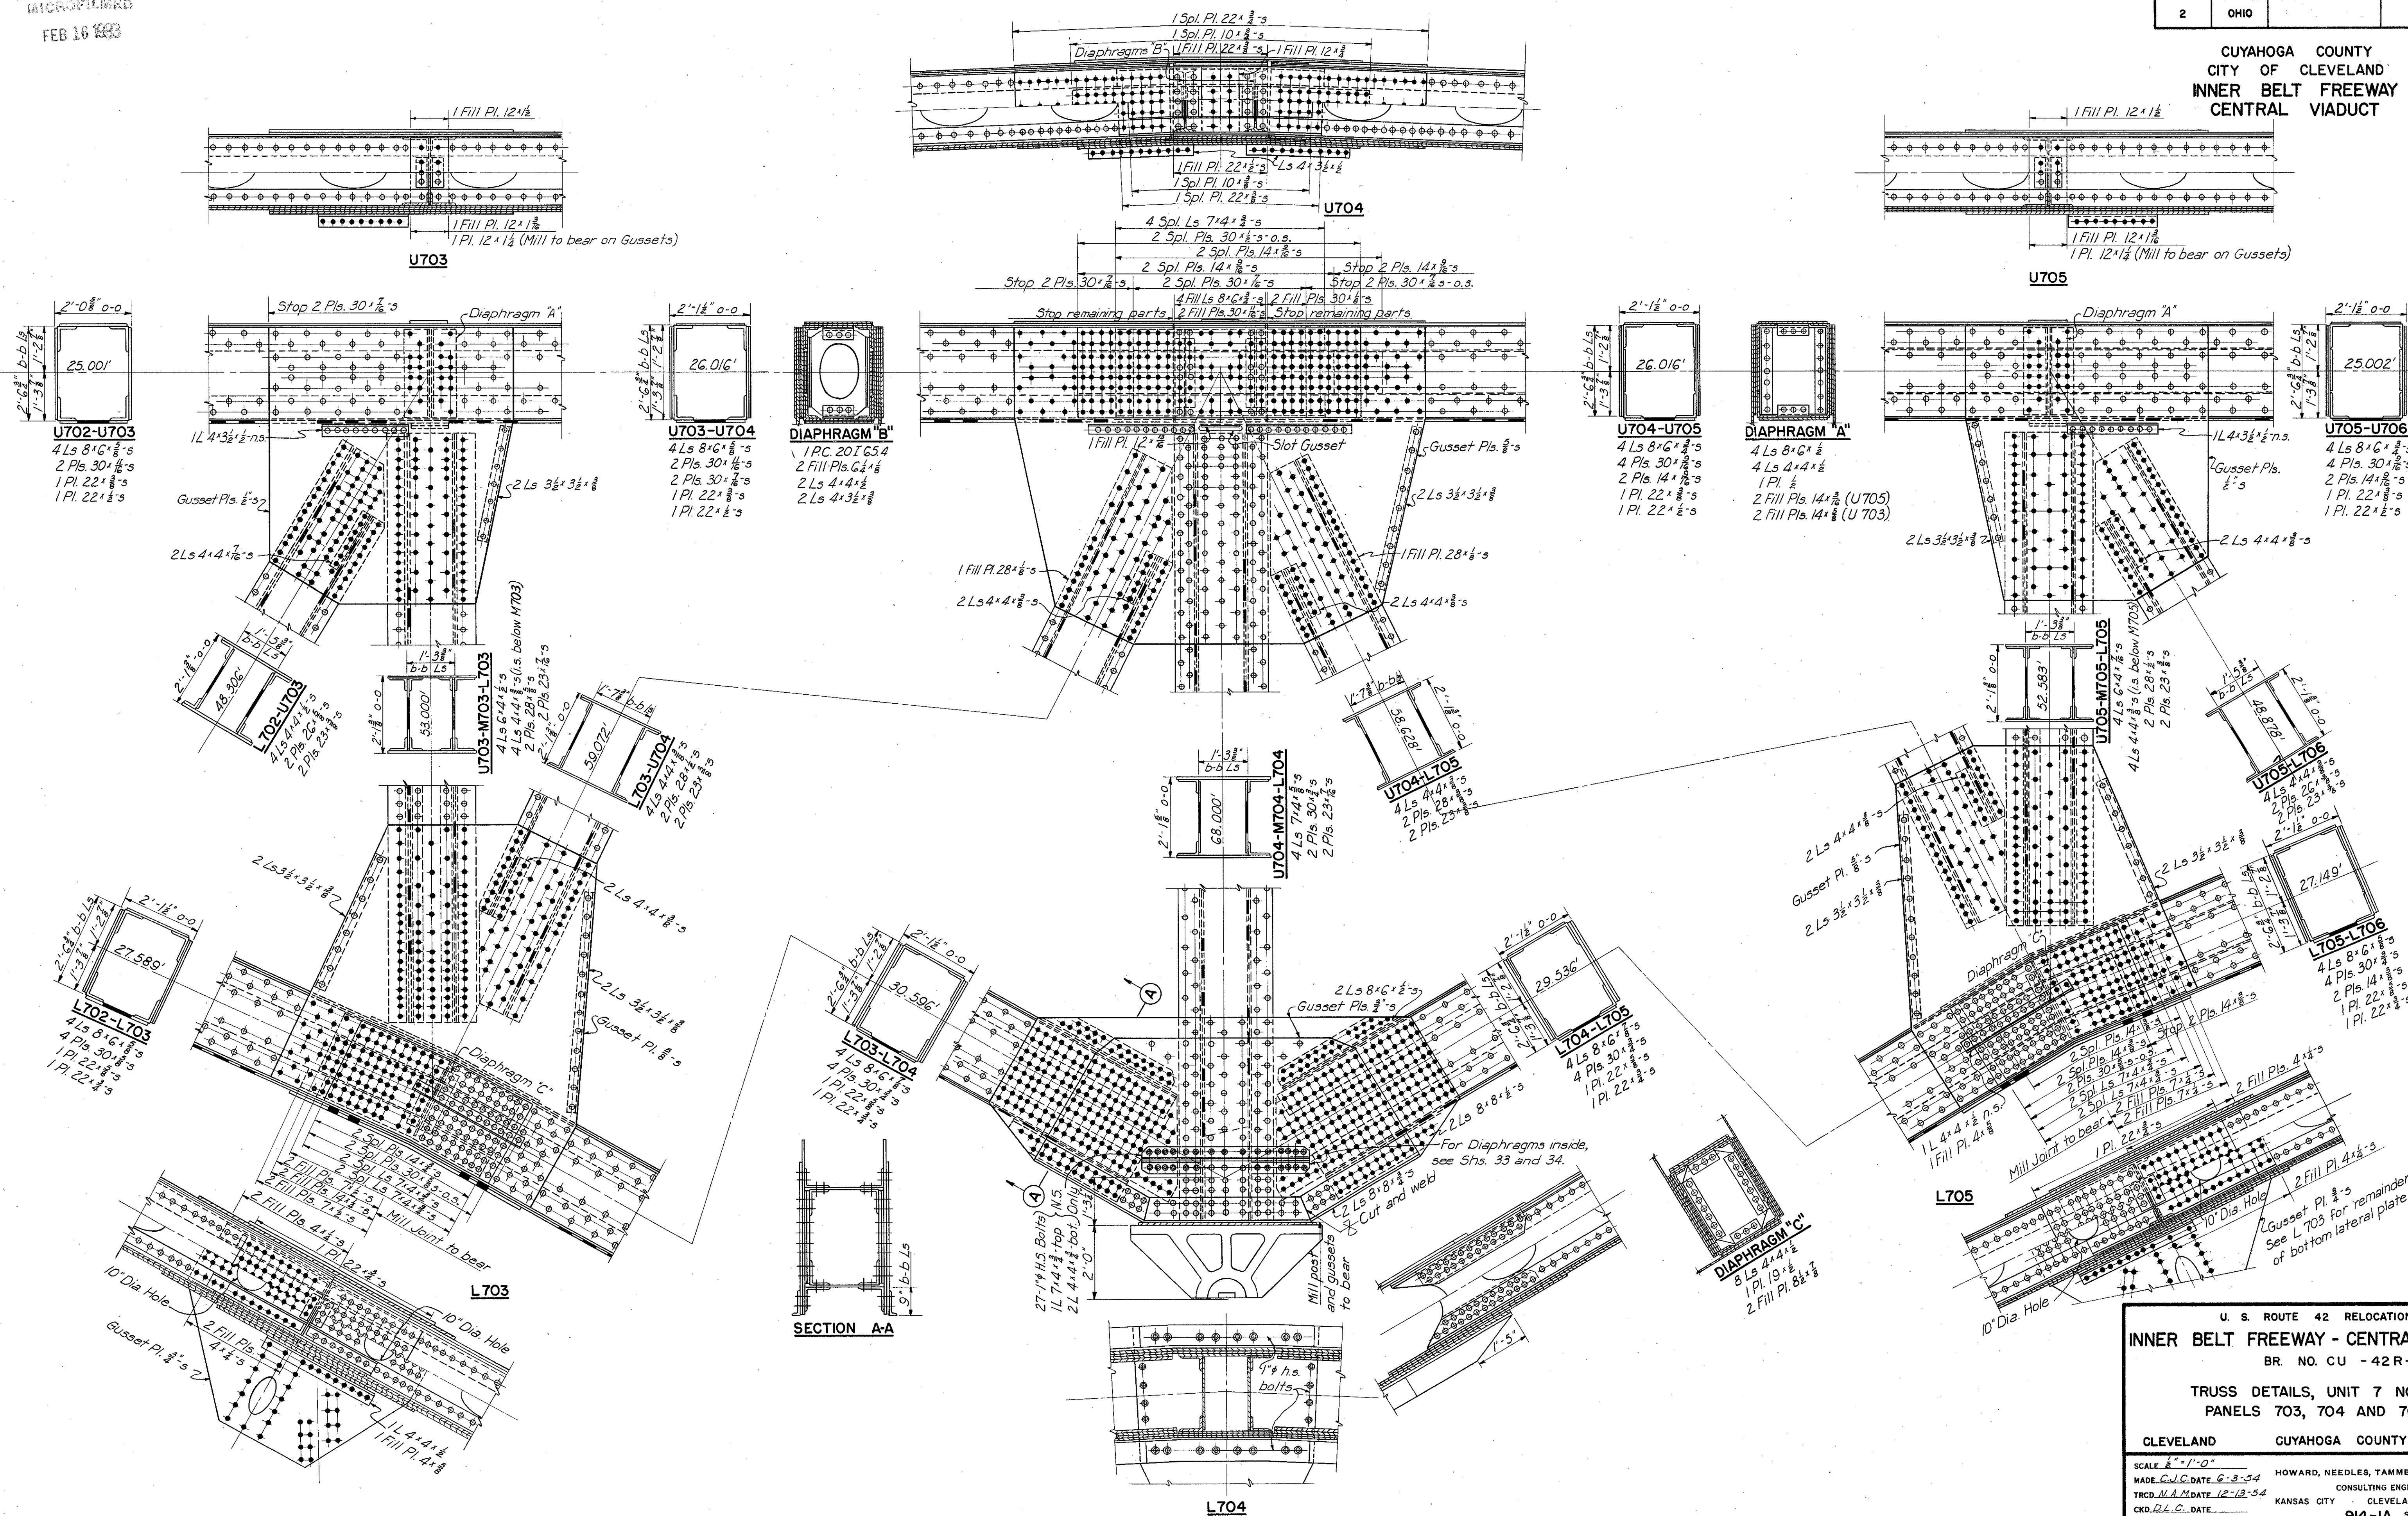

MICROFILMED
FEB 16 1983

FED. ROAD DIV. NO.	STATE	FEDERAL AID PROJECT NO.	TYPE FUNDS
2	OHIO		


81
122

CUYAHOGA COUNTY
CITY OF CLEVELAND
INNER BELT FREEWAY
CENTRAL VIADUCT


LINE		MEMBER	COMPRESSION CHORD																		TENSION CHORD																		
			L 700	L 701	L 702	L 703	L 704	L 705	L 706	L 707	L 708	L 709	L 710	L 711	L 712	L 713	L 714	L 715	L 716	L 717	L 718	U 700	U 701	U 702	U 703	U 704	U 705	U 706	U 707	U 708	U 709	U 710	U 711	U 712	U 713	U 714	U 715	U 716	U 717
1	Dead Load		-769	-1445	-2027	-2486	-2507	-2263	-2006	-1743	-1621	-1626	-1752	-2018	-2277	-2521	-2500	-2041	-1459	-775		+738	+1386	+1836	+2083	+1971	+1713	+1621	+1510	+1510	+1626	+1723	+1983	+2096	+1849	+1398	+743		
2	0.8 Dead Load		-615	-1156	-1622	-1989	-2006	-1810	-1605	-1394	-1297	-1301	-1402	-1614	-1822	-2017	-2000	-1633	-1166	-620		+590	+1109	+1469	+1666	+1577	+1371	+1297	+1208	+1208	+1301	+1379	+1586	+1677	+1480	+1118	+594		
3	Live Load + Imp. Tension																																						
4	Reduced LL + Imp. Tension							+146	+317	+473	+603	+603	+473	+317	+146							+200	+351	+440	+549	+608	+646	+717	+718	+718	+716	+644	+601	+542	+433	+347	+196		
5	Live Load + Imp. Comp.																																						
6	Reduced LL + Imp. Comp.		-209	-366	-484	-563	-567	-598	-619	-658	-717	-716	-654	-612	-590	-559	-557	-477	-362	-204					-133	-311	-464	-603	-619	-619	-603	-644	-311	-133					
7	Reduced LL + Imp. Ten. x D(CF) ^e							+242	+326	+785	+1000	+1000	+785	+526	+242							+332	+582	+729	+910	+1008	+1071	+1188	+1190	+1190	+1187	+1067	+997	+898	+718	+575	+325		
8	Reduced LL + Imp. Comp. x D(CF) ^e		-346	-606	-802	-933	-940	-991	-1025	-1091	-1188	-1187	-1084	-1014	-978	-926	-923	-791	-600	-338					-220	-515	-769	-1000	-1028	-1000	-1028	-769	-517	-220					
9	Ratio = $\frac{\text{Line 4}}{\text{Line 3}}$ or $\frac{\text{Line 6}}{\text{Line 5}}$							-0.06	-0.16	-0.27	-0.37	-0.37	-0.27	-0.16	-0.06										-0.06	-0.16	-0.27	-0.37	-0.41	-0.41	-0.037	-0.27	-0.16	-0.06					
10	L.L. Sidewalk - Tension							+7	+15	+23	+30	+30	+23	+15	+7																								
11	L.L. Sidewalk - Comp.		-9	-17	-24	-29	-29	-31	-32	-44	-50	-50	-44	-32	-31	-29	-29	-24	-17	-9		+9	+16	+22	+28	+31	+44	+50	+50	+50	+44	+31	+28	+22	+16	+9			
12	Direct Design Stress		-970	-1779	-2448	-2951	-2975	-2832	-2662	-2529	-2535	-2538	-2530	-2660	-2831	-2972	-2952	-2448	-1783	-967		+931	+1707	+2220	+2604	+2616	+2486	+2535	+2448	+2448	+2538	+2490	+2614	+2603	+2220	+1709	+928		
13	Reverse Design Stress																																						
14																																							
15																																							
SECTION		Holes out for Tension																																					
a	Flange Angles	2	8 x 6 x 1/2	8 x 6 x 1/2	8 x 6 x 1/2	8 x 6 x 3/4	8 x 6 x 3/4	8 x 6 x 3/4	8 x 6 x 3/8	8 x 6 x 3/8	8 x 6 x 3/8	8 x 6 x 3/8	8 x 6 x 3/8	8 x 6 x 3/8	8 x 6 x 3/8	8 x 6 x 3/8	8 x 6 x 3/8	8 x 6 x 3/8	8 x 6 x 3/8	8 x 6 x 3/8	4 x 4 x 1/2	4 x 4 x 1/2	8 x 6 x 1/2	8 x 6 x 1/2	8 x 6 x 3/8	8 x 6 x 3/8	8 x 6 x 3/8	8 x 6 x 3/8	8 x 6 x 3/8	8 x 6 x 3/8	8 x 6 x 3/8	8 x 6 x 3/8	8 x 6 x 3/8	8 x 6 x 3/8	8 x 6 x 3/8	8 x 6 x 3/8	8 x 6 x 3/8	8 x 6 x 3/8	
b	1st Web Plate	4	30 x 3/8	30 x 3/8	30 x 3/8	30 x 3/4	30 x 3/4	30 x 3/4	30 x 3/8	30 x 3/8	c	Top Cover Plate	3	23 x 3/8	23 x 3/8	22 x 3/8	22 x 3/8	22 x 3/8	22 x 3/8	22 x 3/8	22 x 3/8	22 x 3/8	22 x 3/8	22 x 3/8	22 x 3/8	22 x 3/8	22 x 3/8	22 x 3/8	22 x 3/8	22 x 3/8	22 x 3/8	23 x 3/8	23 x 3/8	23 x 3/8	23 x 3/8	23 x 3/8	23 x 3/8	23 x 3/8	23 x 3/8	23 x 3/8	23 x 3/8	23 x 3/8	23 x 3/8	23 x 3/8	23 x 3/8	23 x 3/8	23 x 3/8	23 x 3/8	23 x 3/8	23 x 3/8
d	Bottom Cover Plate	2	23 x 1/2 *	23 x 1/2 *	22 x 3/4 **	22 x 3/4 **	22 x 3/4 **	22 x 3/4 **	22 x 3/4 **	22 x 3/4 **	22 x 3/4 **	22 x 3/4 **	22 x 3/4 **	22 x 3/4 **	22 x 3/4 **	22 x 3/4 **	22 x 3/4 **	22 x 3/4 **	22 x 3/4 **	22 x 3/4 **	23 x 1/2 *	23 x 1/2 *	23 x 3/8	23 x 3/8	23 x 3/8	23 x 3/8	23 x 3/8	23 x 3/8	23 x 3/8	23 x 3/8	23 x 3/8	23 x 3/8	23 x 3/8	23 x 3/8	23 x 3/8	23 x 3/8	23 x 3/8	23 x 3/8	23 x 3/8
e	1st Inside Web Plate	2	14 x 3/8	14 x 3/8	g	2nd Outside Web Plate	4	30 x 3/8	30 x 3/8	30 x 3/8	30 x 3/4	30 x 3/4	30 x 3/4	30 x 3/8	30 x 3/8	h	2nd Inside Web Plate	2																																					
25	Length	In.	316.3"	312.7"	331.1"	331.1"	334.0"	325.8"	305.2"	305.2"	300"	300"	305.2"	305.2"	325.8"	334.0"	331.1"	331.1"	312.7"	316.3"																			
26	Min. Radius of Gyration	In.	10.63	10.92	10.95	10.85	10.85	10.90	10.90	10.90	10.90	10.90	10.90	10.92	10.90	10.85	10.85	10.95	10.92	10.63																			
27	Allowable Stress	Lbs./Sq. In.	19,590	19,620	19,580	19,570	19,560	19,590	19,640	19,640	19,650	19,640	19,650	19,640	19,590	19,560	19,570	19,580	19,620	19,590	24,000	24,000	24,000	24,000	24,000	24,000	24,000	24,000	24,000	24,000	24,000	24,000	24,000	24,000	24,000	24,000	24,000	24,000	
28	Actual Gross Area	Sq. In.	60.85	63.85	62.75	62.51	62.51	64.69	64.69	64.69	64.69	64.69	64.69	64.69	64.69	64.69	64.69	64.69	64.69	64.69	49.19	49.19	49.19	49.19	49.19	49.19	49.19	49.19	49.19	49.19	49.19	49.19	49.19	49.19	49.19	49.19	49.19		
29	Net Area	Sq. In.	54.28	53.47	52.75	52.51	52.51	54.69	54.69	54.69	54.69	54.69	54.69	54.69	54.69	54.69	54.69	54.69	54.69	54.69	40.50	40.50	40.50	40.50	40.50	40.50	40.50	40.50	40.50	40.50	40.50	40.50	40.50	40.50	40.50	40.50	40.50		
30	Actual Unit Stress	Lbs./Sq. In.	17,870	19,000	19,620	19,360	19,360	19,360	19,360	19,360	19,360	19,360	19,360	19,360	19,360	19,360	19,360	19,360	19,360	19,360	23,000	23,000	23,000	23,000	23,000	23,000	23,000	23,000	23,000	23,000	23,000	23,000	23,000	23,000	23,000	23,000	23,000		
31	Material		S	S	S	S	S	S	S	S	S	S	S	S	S	S	S	S	S	S	S	S	S	S	S	S	S	S	S	S	S	S	S	S	S	S	S		

COMPRESSION WEB MEMBERS																				TENSION WEB MEMBERS																	
LINE	MEMBER	L700	L701	L702	L703	L704	L705	L706	L707	L708	L709	L710	L711	L712	L713	L714	L715	L716	L717	L718																	
1	Dead Load	+1069	+1097	+870	+569	-42	+218	+464	+151	+146	+190	+138	+469	+219	-43	+587	+872	+1104	+1094																		
2	0.8 Dead Load	+855	+878	+696	+471	-34	+174	+371	+121	+182	+150	+126	+375	+175	-34	+469	+698	+883	+875																		
3	Live Load + Imp.-Tension																																				
4	Reduced LL + Imp.- Tension	+294	+288		+222	+160	+340	+366	+312	+290	+247	+247	+290	+312	+386	+340	+159	+220	+284	+288																	
5	Live Load + Imp.-Comp.																																				
6	Reduced LL + Imp.-Comp.					-260	-220	-188	-221	-212	-213	-225	-191	-221	-259																						
7	Reduced LL + Imp.- Ten. x D (CF) ^e	+487	+477	+368	-265	+564	+608	+517	+481	+410	+481	+517	+606	+564	+264	+365	+471	+477																			
8	Reduced LL + Imp.-Comp. x D (CF) ^e					-431	-365	-312	-366	-352	-353	-317	-366	-429																							
9	Ratio = $\frac{\text{Live Load} + \text{Imp. Load}}{\text{Dead Load} + \text{Imp. Load}}$					-8.11	-1.01	-0.41	-1.46	-1.16	-1.12	-1.42	-0.41	-1.01	-791																						
10	LL Sidewalk - Tension	+13	+13	+10	+6	+16	+18	+14	+12	+14	+14	+12	+14	+18	+16	+6	+10	+13	+13																		
11	LL Sidewalk - Comp.					-18	-15	-10	-11	-12	-12	-11	-10	-15	-18																						
12	Direct Design Stress	+1355	+1368	+1074	+742	-483	+798	+902	+614	+570	+619	+906	+799	-481	+739	+1073	+1367	+1365																			
13	Reverse Design Stress					+546	-3																														
14																																					
15																																					
	SECTION	Holes out for Tension																																			
a	Flange Angles	3	4x4x½	4x4x½	4x4x½	4x4x½	4x4x½	4x4x½	4x4x½	4x4x½	4x4x½	4x4x½	4x4x½	4x4x½	4x4x½	4x4x½	4x4x½	4x4x½	4x4x½	4x4x½																	
b	1 st Web Plate	2	24x½	24x¾	26x¾	28x¾	28x¾	24x½	24x½	24x½	24x½	24x½	24x½	26x½	28x½	28x¾	26x¾	28x¾	26x¾	24x¾																	
c	Cover Plates	2	23x½***	23x¾***	23x¾***	23x¾***	23x¾***	23x¾***	23x¾***	23x¾***	23x¾***	23x¾***	23x¾***	23x¾***	23x¾***	23x¾***	23x¾***	23x¾***	23x¾***	23x¾***																	
e	Inside Angles	2																																			
25	Length	In.	496"	496"	496"	496"	496"	496"	496"	496"	496"	496"	496"	496"	496"	496"	496"	496"	496"	496"																	
26	Min. Radius of Gyration	In.	7.69	7.93	7.71	8.54	8.25	9.10	8.80	8.57	8.21	9.10	8.80	8.54	8.25	7.93	7.71	7.69	7.20	7.20																	
27	Allowable Stress	Lbs./Sq. In.	24,000	24,000	24,000	24,000	24,000	24,000	24,000	24,000	24,000	24,000	24,000	24,000	24,000	24,000	24,000	24,000	24,000	24,000																	
28	Actual Gross Area	Sq. In.	69.14	69.14	69.14	69.14	69.14	69.14	69.14	69.14	69.14	69.14	69.14	69.14	69.14	69.14	69.14	69.14	69.14	69.14																	
29	Net Area	Sq. In.	56.89	56.89	56.89	56.89	56.89	56.89	56.89	56.89	56.89	56.89	56.89	56.89	56.89	56.89	56.89	56.89	56.89	56.89																	
30	Actual Unit Stress	Lbs./Sq. In.	23,820	24,040	23,000	21,360	15,750	22,250	23,930	17,500	17,500	17,500	17,500	22,250	23,820	24,040	23,980	23,980	23,980	23,980																	
31	Material	S	S	S	S	S	S	S	S	S	S	S	S	S	S	S	S	S	S	S																	


REPRODUCED
FEB 16 1983

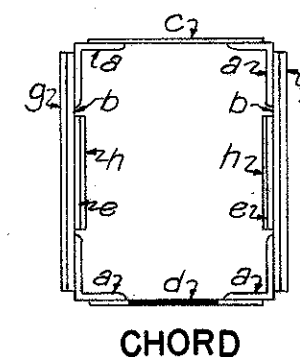

CHORD

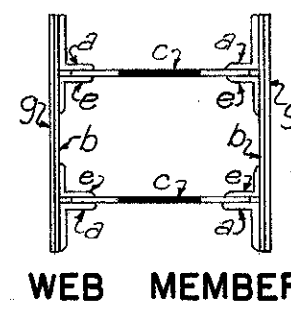

WEB MEMBER

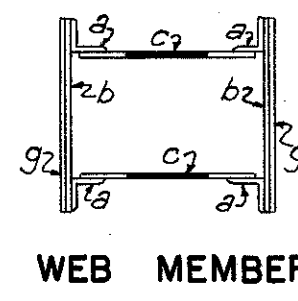

WEB MEMBER

FED. ROAD DIV. NO.	STATE	FEDERAL AID PROJECT NO.	TYPE FUNDS
2	OHIO		

80
122

CUYAHOGA COUNTY
CITY OF CLEVELAND
INNER BELT FREEWAY
CENTRAL VIADUCT


LINE		MEMBER	COMPRESSION CHORD																		TENSION CHORD																	
			L700 L701	L701 L702	L702 L703	L703 L704	L704 L705	L705 L706	L706 L707	L707 L708	L708 L709	L709 L710	L710 L711	L711 L712	L712 L713	L713 L714	L714 L715	L715 L716	L716 L717	L717 L718	U700 U701	U701 U702	U702 U703	U703 U704	U704 U705	U705 U706	U706 U707	U707 U708	U708 U709	U709 U710	U710 U711	U711 U712	U712 U713	U713 U714	U714 U715	U715 U716	U716 U717	U717 U718
1	Dead Load		- 790	-1486	-2077	-2560	-2578	-2392	-2177	-1951	-1867	-1892	-1905	-2237	-2460	-2649	-2631	-2142	-1536	- 819	+ 758	+ 1426	+ 1882	+ 2202	+ 2140	+ 1918	+ 1867	+ 1768	+ 1768	+ 1892	+ 1962	+ 2198	+ 2264	+ 1940	+ 1474	+ 786		
2	0.8 Dead Load		- 632	-1189	-1662	-2048	-2062	-1914	-1742	-1561	-1494	-1514	-1536	-1790	-1968	-2119	-2105	-1714	-1229	- 655	+ 606	+ 1141	+ 1506	+ 1762	+ 1712	+ 1534	+ 1494	+ 1414	+ 1414	+ 1514	+ 1570	+ 1758	+ 1811	+ 1522	+ 1179	+ 629		
3	Live Load + Imp. - Tension																																					
4	Reduced LL + Imp.-Tension																																					
5	Live Load + Imp.-Comp.							+ 161	+ 325	+ 473	+ 599	+ 599	+ 473	+ 325	+ 161						+ 205	+ 360	+ 448	+ 577	+ 641	+ 689	+ 767	+ 769	+ 769	+ 769	+ 693	+ 650	+ 586	+ 455	+ 367	+ 208		
6	Reduced LL + Imp.-Comp.		- 214	- 377	- 494	- 571	- 576	- 624	- 652	- 701	- 767	- 769	- 706	- 662	- 635	- 586	- 581	- 502	- 383	- 219					- 148	- 320	- 460	- 599	- 614	- 614	- 599	- 465	- 320	- 148				
7	Reduced LL + Imp.-Ten. + D(CF) ^e							+ 267	+ 539	+ 785	+ 993	+ 993	+ 785	+ 539	+ 267						+ 340	+ 596	+ 742	+ 956	+ 1062	+ 1141	+ 1271	+ 1274	+ 1274	+ 1148	+ 1077	+ 971	+ 754	+ 608	+ 345			
8	Reduced LL + Imp.-Comp. + D(CF) ^e		- 355	- 625	- 818	- 947	- 955	- 1034	- 1080	- 1162	- 1271	- 1274	- 1170	- 1087	- 1052	- 971	- 963	- 832	- 635	- 363					- 245	- 530	- 771	- 993	- 1017	- 1017	- 993	- 771	- 530	- 245				
9	Ratio = $\frac{\text{Live Load + Imp. - Tension}}{\text{Live Load + Imp. - Comp.}}$							-0.067	-0.149	-0.242	-0.321	-0.316	-0.237	-0.145	-0.065										-0.067	-0.149	-0.242	-0.321	-0.347	-0.347	-0.317	-0.237	-0.146	-0.065				
10	LL Sidewalk - Tension							+ 8	+ 17	+ 25	+ 32	+ 32	+ 25	+ 17	+ 8						+ 8	+ 16	+ 21	+ 29	+ 32	+ 46	+ 53	+ 54	+ 54	+ 53	+ 46	+ 32	+ 29	+ 21	+ 16	+ 8		
11	LL Sidewalk - Comp.		- 9	- 17	- 24	- 29	- 29	- 32	- 37	- 47	- 53	- 47	- 33	- 32	- 29	- 29	- 24	- 17	- 9					- 8	- 17	- 24	- 32	- 33	- 33	- 32	- 24	- 17	- 8					
12	Direct Design Stress		- 996	-1831	-2504	-3024	-3046	-2980	-2855	-2770	-2818	-2841	-2813	-2920	-3052	-3119	-3097	-2570	-1881	-1027	+ 954	+ 1753	+ 2269	+ 2747	+ 2806	+ 2721	+ 2818	+ 2742	+ 2742	+ 2841	+ 2764	+ 2867	+ 2811	+ 2327	+ 1803	+ 982		
13	Reverse Design Stress																																					
14																																						
15																																						
SECTION			Holes out for tension																																			
a	Flange Angles	2	8x6x 7/16	8x6x 7/16	8x6x 7/16	8x6x 7/16	8x6x 7/16	8x6x 7/16	8x6x 7/16	8x6x 7/16	8x6x 7/16	8x6x 7/16	8x6x 7/16	8x6x 7/16	8x6x 7/16	8x6x 7/16	8x6x 7/16	8x6x 7/16	8x6x 7/16	4x4x 3/4	4x4x 3/4	8x6x 7/16	8x6x 7/16	8x6x 7/16	8x6x 7/16	8x6x 7/16	8x6x 7/16	8x6x 7/16	8x6x 7/16	8x6x 7/16	8x6x 7/16	8x6x 7/16	8x6x 7/16	8x6x 7/16	8x6x 7/16	4x4x 3/4	4x4x 3/4	
b	1 Web Plate	4	30x 3/4	30x 3/4	30x 3/4	30x 3/4	30x 3/4	30x 3/4	30x 3/4	30x 3/4	30x 3/4	30x 3/4	30x 3/4	30x 3/4	30x 3/4	30x 3/4	30x 3/4	30x 3/4	30x 3/4	30x 3/4	30x 3/4	30x 11/16	30x 11/16	30x 9/16	30x 9/16	30x 9/16	30x 9/16	30x 9/16	30x 9/16	30x 9/16	30x 9/16	30x 9/16	30x 9/16	30x 9/16	30x 9/16	30x 9/16	30x 9/16	
c	Top Cover Plate	2	23x 3/4	23x 3/4	22x 3/4	22x 3/4	22x 3/4	22x 3/4	22x 3/4	22x 3/4	22x 3/4	22x 3/4	22x 3/4	22x 3/4	22x 3/4	22x 3/4	22x 3/4	22x 3/4	22x 3/4	23x 5/16	23x 5/16	22x 3/4	22x 3/4	22x 3/4	22x 3/4	22x 3/4	22x 3/4	22x 3/4	22x 3/4	22x 3/4	22x 3/4	22x 3/4	22x 3/4	22x 3/4	22x 3/4	22x 3/4	22x 3/4	
d	Bottom Cover Plate	2	23x 3/4	23x 3/4	22x 3/4	22x 3/4	22x 3/4	22x 3/4	22x 3/4	22x 3/4	22x 3/4	22x 3/4	22x 3/4	22x 3/4	22x 3/4	22x 3/4	22x 3/4	22x 3/4	22x 3/4	23x 5/16	23x 5/16	22x 3/4	22x 3/4	22x 3/4	22x 3/4	22x 3/4	22x 3/4	22x 3/4	22x 3/4	22x 3/4	22x 3/4	22x 3/4	22x 3/4	22x 3/4	22x 3/4	22x 3/4	22x 3/4	
26	Min. Radius of Gyration - In.		10.63	10.84	10.90	10.80	10.80	10.9	10.9	10.9	10.90	10.90	10.9	10.9	10.8	10.80	10.80	10.9	10.84	10.63																		
27	Allowable Stress - Lbs./Sq. In.		19,590	19,620	19,570	19,470	19,450	19,580	19,640	19,640	19,650	19,650	19,640	19,640	19,580	19,450	19,470	19,570	19,620	19,590	24,000	24,000	24,000	24,000	24,000	24,000	24,000	24,000	24,000	24,000	24,000	24,000	24,000	24,000	24,000	24,000	24,000	
28	Actual Gross Area - Sq. In.		60.85	60.85	60.85	60.85	60.85	60.85	60.85	60.85	60.85	60.85	60.85	60.85	60.85	60.85	60.85	60.85	60.85	49.19	49.19	49.19	49.19	49.19	49.19	49.19	49.19	49.19	49.19	49.19	49.19	49.19	49.19	49.19	49.19	49.19	49.19	
29	Net Area - Sq. In.		54.28	55.22	131.19	158.67	158.67	156.69	146.19	146.19	146.19	146.19	146.19	146.19	156.69	158.67	158.67	131.19	95.22	54.28	40.50	40.50	75.82	98.57	117.39	114.39	117.39	117.39	117.39	117.39	117.39	117.39	117.39	117.39	117.39	117.39		
30	Actual Unit Stress - Lbs./Sq. In.		18,380	19,230	19,090	19,060	19,200	19,020	19,530	18,950	19,280	19,430	19,240	19,300	19,480	19,660	19,520	19,600	18,920	59.50	59.50	59.50	59.50	59.50	59.50	59.50	59.50	59.50	59.50	59.50	59.50	59.50	59.50	59.50	59.50	59.50	59.50	
31	Material		S	S	S	S	S	S	S	S	S	S	S	S	S	S	S	S	S	S	S	S	S	S	S	S	S	S	S	S	S	S	S	S	S	S		

COMPRESSION WEB MEMBERS																												TENSION WEB MEMBERS																											
U701 L701	U702 L702	U703 L703	U704 L704	U705 L705	U706 L706	U707 L707	U708 L708	U709 L709	U710 L710	U711 L711	U712 L712	U713 L713	U714 L714	U715 L715	U716 L716	U717 L717	U718 L718	LINE	MEMBER	L700 U701	L701 U702	L702 U703	L703 U704	U704 L705	U705 L706	U706 L707	U707 L708	U708 L709	L709 U710	U710 L711	L711 U712	L712 U713	L713 U714	U714 L715	U715 L716	U716 L717	U717 L718																		
- 935	-1041	-1184	- 899	-1054	- 877	- 780	- 237	- 381	- 463	- 605	- 200	- 295	- 121	- 287	- 224	- 485	- 627	- 246	- 391	- 886	- 766	-1917	-1062	-1069	-1212	- 968	- 89	1	Dead Load	+1103	+1126	+ 883	+ 766	+ 43	+121	+ 398	+ 82	+164	+ 205	+113	+ 425	+129	+ 42	+ 775	+ 901	+161	+1156								
- 748	- 833	- 947	- 719	- 836	- 702	- 624	- 189	- 305	- 371	- 484	- 160	- 204	- 97	- 230	- 179	- 388	- 502	- 197	- 313	- 709	- 613	- 734	- 850	- 855	- 970	- 774	- 71	2	0.8 Dead Load	+ 882	+ 901	+ 706	+ 613	+ 34	+ 97	+ 319	+ 66	+131	+164	+ 90	+ 340	+105	+ 34	+ 620	+ 721	+ 929									
																													3	Live Load + Imp. - Tension	+ 300	+ 289	+ 219	+186	+ 332	+ 355	+ 300	+ 280	+ 247	+ 248	+ 280	+ 300	+ 353	+ 332	+187	+ 222	+ 291	+ 305							
																													4	Reduced LL + Imp. - Tension																									
																													5	Live Load + Imp. - Comp.																									
- 236	- 247	- 293	- 204	- 254	- 344	- 377	- 319	- 362	- 260	- 306	- 237	- 195	- 45	- 198	- 237	- 260	- 306	- 319	- 366	- 344	- 376	- 205	- 256	- 250	- 297	- 238	- 47	6	Reduced LL + Imp. - Comp.																										
																													7	Reduced LL + Imp. - Ten + D(CF)*	+ 497	+ 480	+ 363	+ 308	+ 550	+ 589	+ 497	+ 463	+ 409	+ 411	+ 463	+ 497	+ 589	+ 550	+ 310	+ 368	+ 483	+ 506							
- 392	- 410	- 496	- 338	- 421	- 570	- 625	- 529	- 600	- 431	- 507	- 393	- 323	- 75	- 328	- 393	- 431	- 507	- 529	- 606	- 570	- 623	- 340	- 424	- 415	- 492	- 395	- 78	8	Reduced LL + Imp. - Comp + D(CF)*																										
																													9	Ratio = (Comp) / (Tension)																									
																													10	LL Sidewalk - Tension	+ 13	+ 13	+ 10	+ 8	+ 17	+ 17	+ 14	+ 12	+ 14	+ 14	+ 12	+ 14	+ 12	+ 14	+ 12	+ 17	+ 17	+ 8	+ 10	+ 13	+ 13				
- 11	- 12	- 14	- 10	- 12	- 20	- 22	- 16	- 19	- 13	- 8	- 15	- 11	- 12	- 1	- 12	- 11	- 13	- 8	- 16	- 19	- 20	- 10	- 12	- 12	- 14	- 9	- 1	11	LL Sidewalk - Comp.																										
-1151	-1255	-1447	-1067	-1269	-1292	-1271	- 734	- 924	- 815	-1006	- 564	- 539	- 173	- 570	- 583	- 832	-1024	- 742	- 938	-1299	-1258	-1084	-1286	-1282	-1476	-1178	-150	12	Direct Design Stress	+1392	+1394	+1079	+ 929	+ 601	+ 703	+ 830	+541	+ 554	+ 589	+ 565	+ 851	+ 709	+ 601	+ 938	+1099	+1425	+1444								
																													13	Reverse Design Stress																									
																													14																										
																													15																										
																																		</																					

UNRECORDED
FEB 16 1963

FED. ROAD DIV. NO.	STATE	FEDERAL AID PROJECT NO.	TYPE FUNDS	79 122
2	OHIO			

CUYAHOGA COUNTY
CITY OF CLEVELAND
INNER BELT FREEWAY
CENTRAL VIADUCT

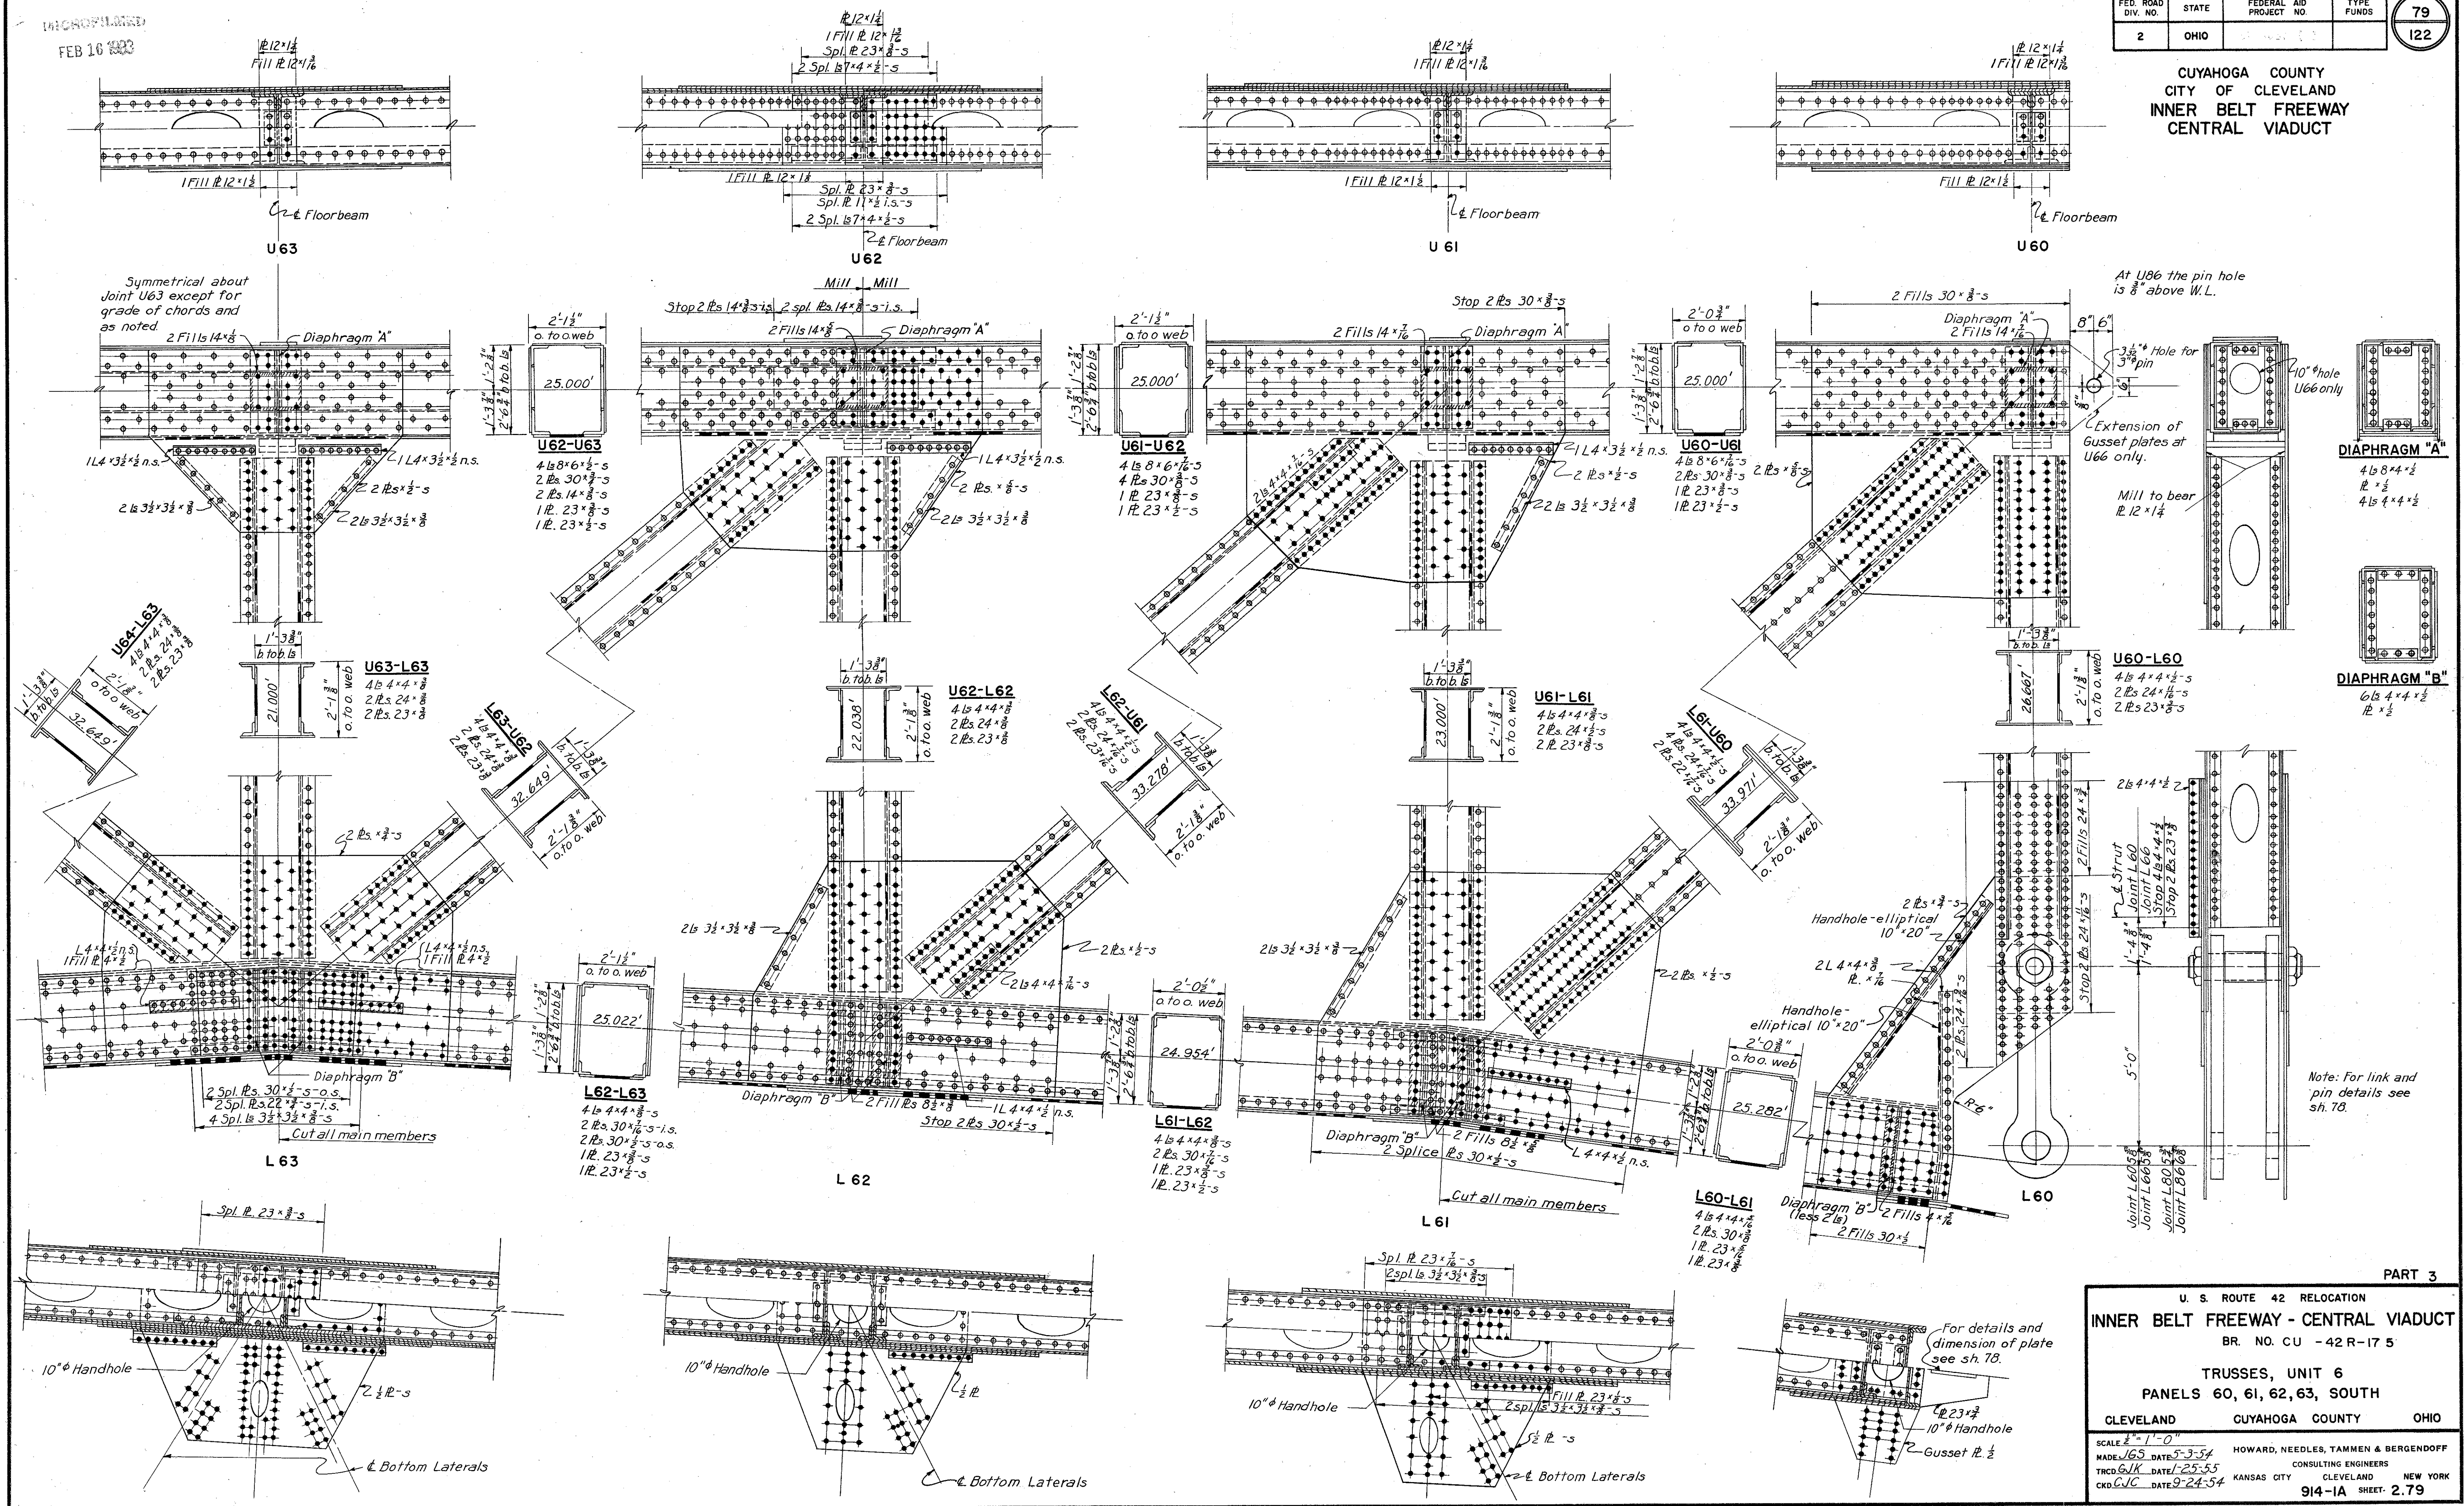

PART 3

U. S. ROUTE 42 RELOCATION
INNER BELT FREEWAY - CENTRAL VIADUCT
BR. NO. CU - 42 R-17 5

TRUSSES, UNIT 6
PANELS 60, 61, 62, 63, SOUTH

CLEVELAND CUYAHOGA COUNTY OHIO

SCALE: 1" = 1'-0"
MADE: 1/65 DATE: 5-3-54
TRCD: GJC DATE: 9-24-54

HOWARD, NEEDLES, TAMMEN & BERGENDOFF
CONSULTING ENGINEERS
KANSAS CITY CLEVELAND NEW YORK


914-1A SHEET: 2.79

1-Fill 12 x 1/2

CENTRAL VIADUCT

Diaphragm "A"


1-Fill 12 x 1/2

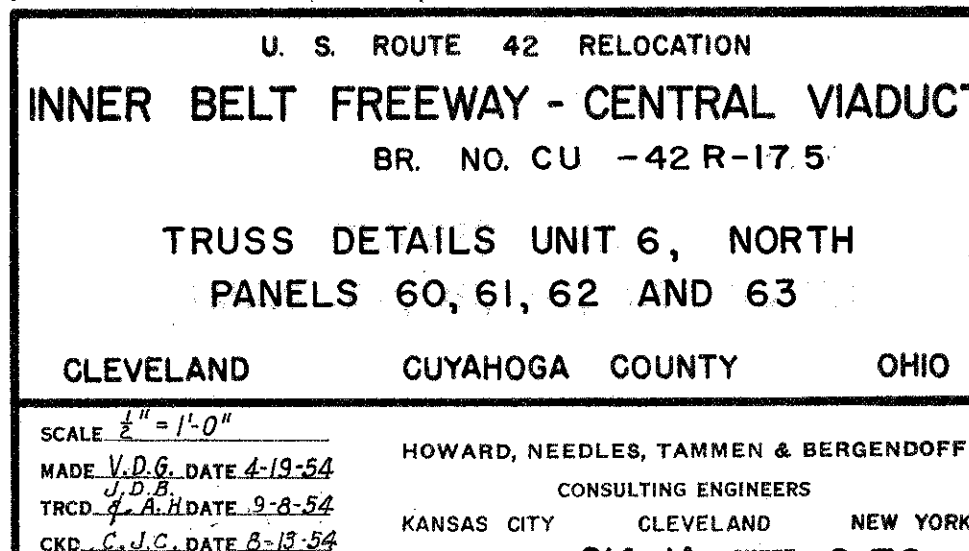


[illegible]

TENSION WEB MEMBERS - SOUTH TRUSS						COMPRESSION WEB MEMBERS - SOUTH TRUSS						LINE	MEMBER	TENSION WEB MEMBERS - NORTH TRUSS						COMPRESSION WEB MEMBERS - NORTH TRUSS							
U60 L61	U61 L62	U62 L63	L63 U64	L64 U65	L65 U66	U60 L60	U61 L61	U62 L62	U63 L63	U64 L64	U65 L65			U66 L66	U60 L61	U61 L62	U62 L63	L63 U64	L64 U65	L65 U66	U60 L60	U61 L61	U62 L62	U63 L63	U64 L64	U65 L65	U66 L66
+1,009	+665	+298	+298	+665	+1,009	-763	-556	-303	-120	-303	-556	-827	1	Dead Load	+1,044	+693	+307	+307	+693	+1,044	-789	-586	-326	-137	-326	-586	-856
+807	+532	+238	+238	+532	+807	-611	-445	-242	-96	-242	-445	-662	2	0.8 Dead Load	+835	+554	+246	+246	+554	+835	-631	-469	-261	-110	-261	-469	-685
+315	+231	+149	+149	+231	+315			+15		+15			3	Live Load + Imp. - Tension	+328	+240	+155	+155	+240	+328			+13		+13		
+315	+231	+149	+149	+231	+315			+15		+15			4	Reduced LL + Imp. - Tension	+328	+240	+155	+155	+240	+328			+13		+13		
	-20	-55	-55	-20		-223	-168	-105	-48	-105	-168	-229	5	Live Load + Imp. - Comp.		-21	-57	-57	-21		-232	-175	-109	-50	-109	-175	-235
	-20	-55	-55	-20		-223	-168	-105	-48	-105	-168	-226	6	Reduced LL + Imp. - Comp.		-21	-57	-57	-21		-232	-175	-109	-50	-109	-175	-235
+522	+363	+247	+247	+363	+522			+25		+25			7	Reduced LL + Imp. - Ten. x D (CF) ^e	+542	+398	+257	+257	+398	+542			+22		+22		
	-33	-91	-91	-33		-370	-278	-174	-80	-174	-278	-374	8	Reduced LL + Imp. - Comp x D (CF) ^e		-35	-94	-94	-35		-384	-290	-181	-83	-181	-290	-389
	-0.030	-0.185	-0.185	-0.030				-0.020		-0.020			9	Ratio = $\frac{LL+Imp}{LL+Imp+Comp}$ or $\frac{LL+Imp}{LL+Imp}$ (Ten)		-0.030	-0.186	-0.186	-0.030				-0.018		-0.018		
+12	+9	+5	+5	+9	+12								10	LL Sidewalk - Tension	+13	+9	+6	+6	+9	+13							
	-2	-2				-10	-7	-4	-1	-4	-7	-10	11	LL Sidewalk - Comp.		-0.4	-2	-2	-0.4		-9	-7	-4	-1	-4	-7	-9
+1,341	+924	+490	+490	+924	+1,341	-991	-730	-420	-177	-420	-730	-1,046	12	Direct Design Stress	+1,390	+961	+509	+509	+961	+1,390	-1,024	-766	-446	-194	-446	-766	-1,083
													13	Reverse Design Stress													

Line 29, - Net area for tension or effective gross area for compression.

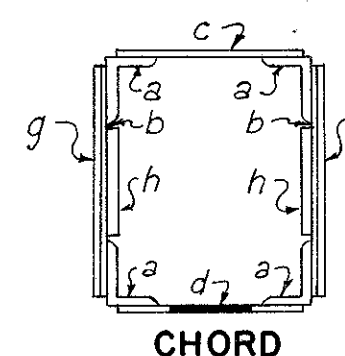


CHORD

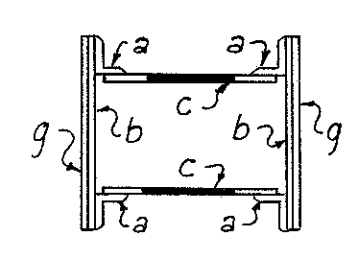


WEB MEMBER

S = Special Steel
C = Carbon Steel
* = 11" Hole
** = 10" Hole

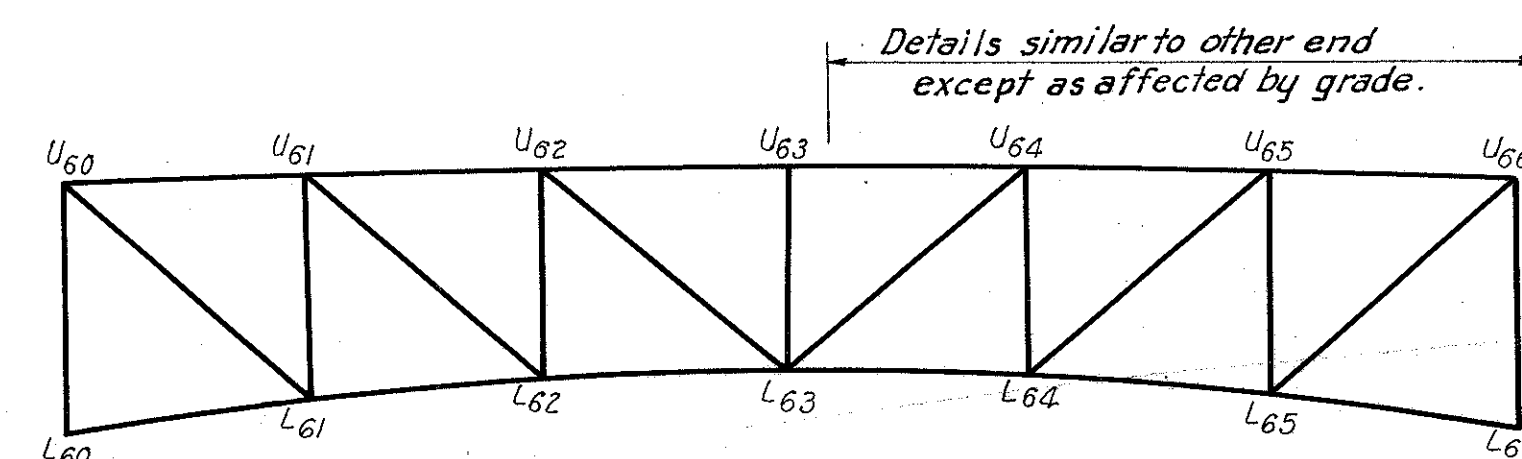

Truss dimensions are shown on Framing Plan, Sh. 23.

CUYAHOGA COUNTY
CITY OF CLEVELAND
INNER BELT FREEWAY
CENTRAL VIADUCT

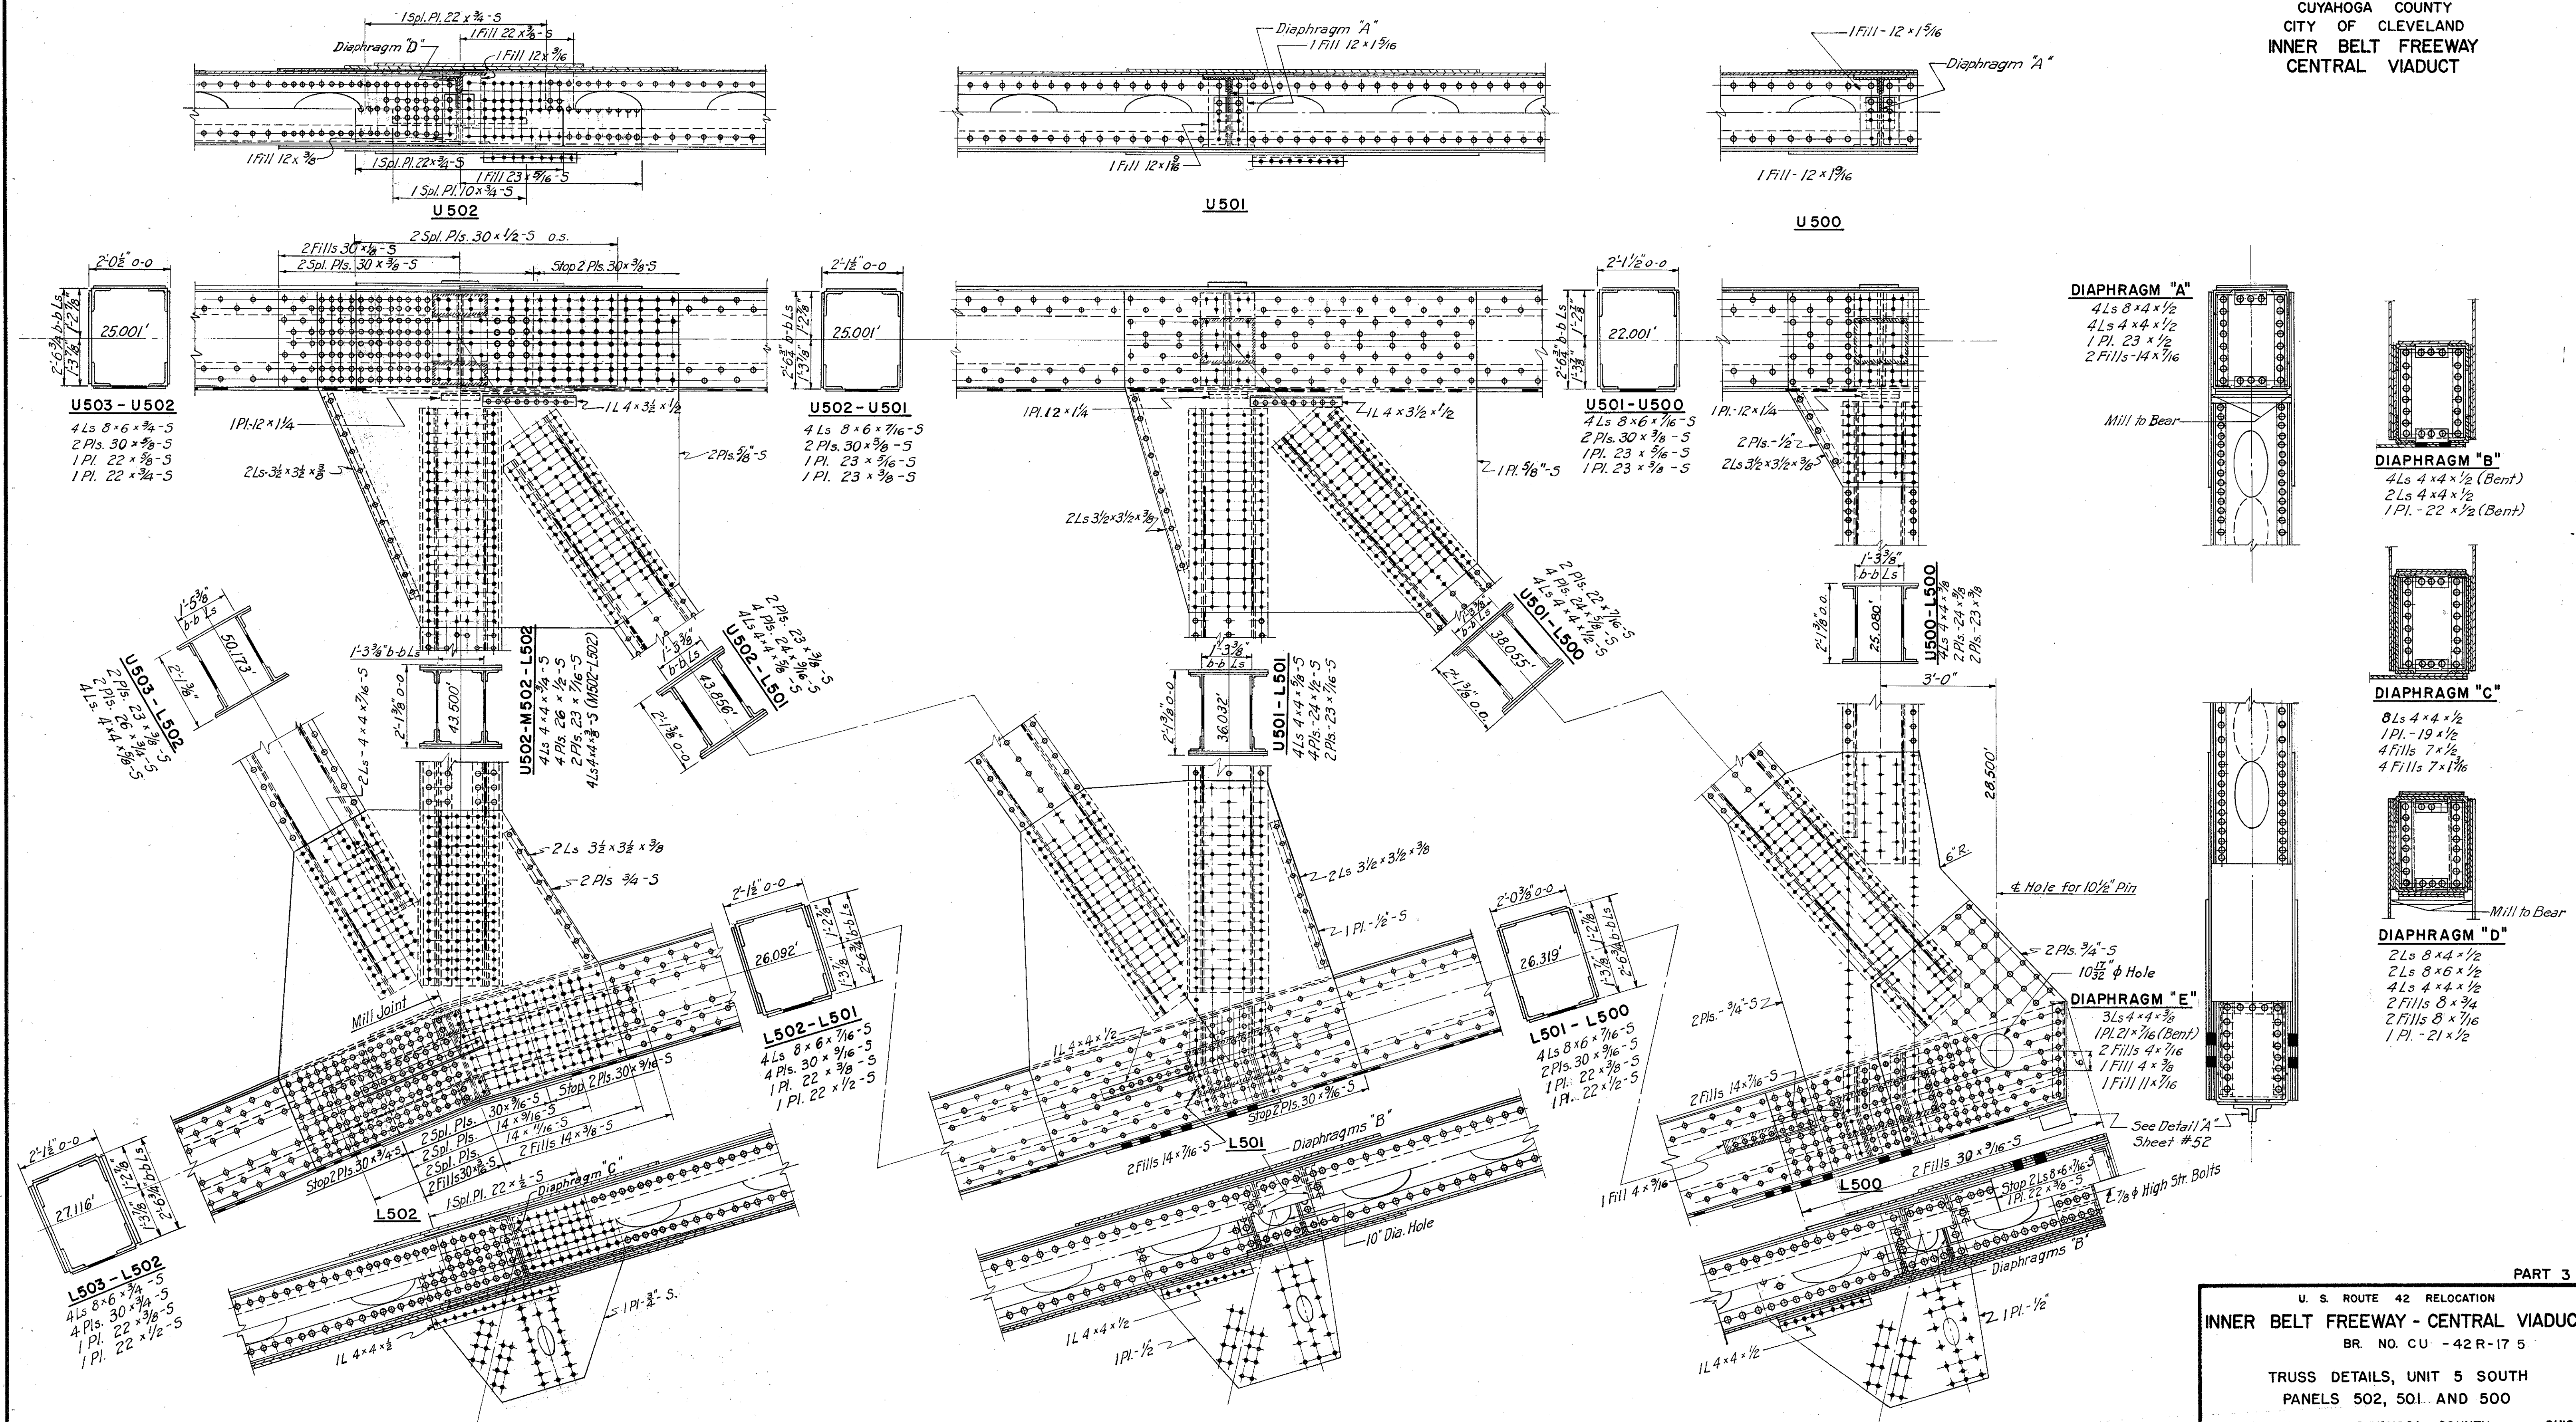

PART 3


U. S. ROUTE 42 RELOCATION
INNER BELT FREEWAY - CENTRAL VIADUCT
BR. NO. CU - 42 R-17 5

TRUSS DETAILS, UNIT 5 SOUTH
PANELS 502, 501 AND 500

CLEVELAND CUYAHOGA COUNTY OHIO

SCALE 1/2" = 1'-0"
MADE C.J.C. DATE 8-2-54
TRCD JLB-WJS DATE 8-20-54
CRD DME DATE 11-8-54

HOWARD, NEEDLES, TAMMEN & BERGENDOFF
CONSULTING ENGINEERS
KANSAS CITY CLEVELAND NEW YORK
914-1A SHEET 276

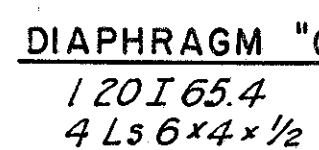


74
122

[illegible]

MICROFILMED
FEB 16 1983

FED. ROAD DIV. NO.	STATE	FEDERAL AID PROJECT NO.	TYPE FUNDS	73 122
2	OHIO			

CUYAHOGA COUNTY
CITY OF CLEVELAND
INNER BELT FREEWAY
CENTRAL VIADUCT

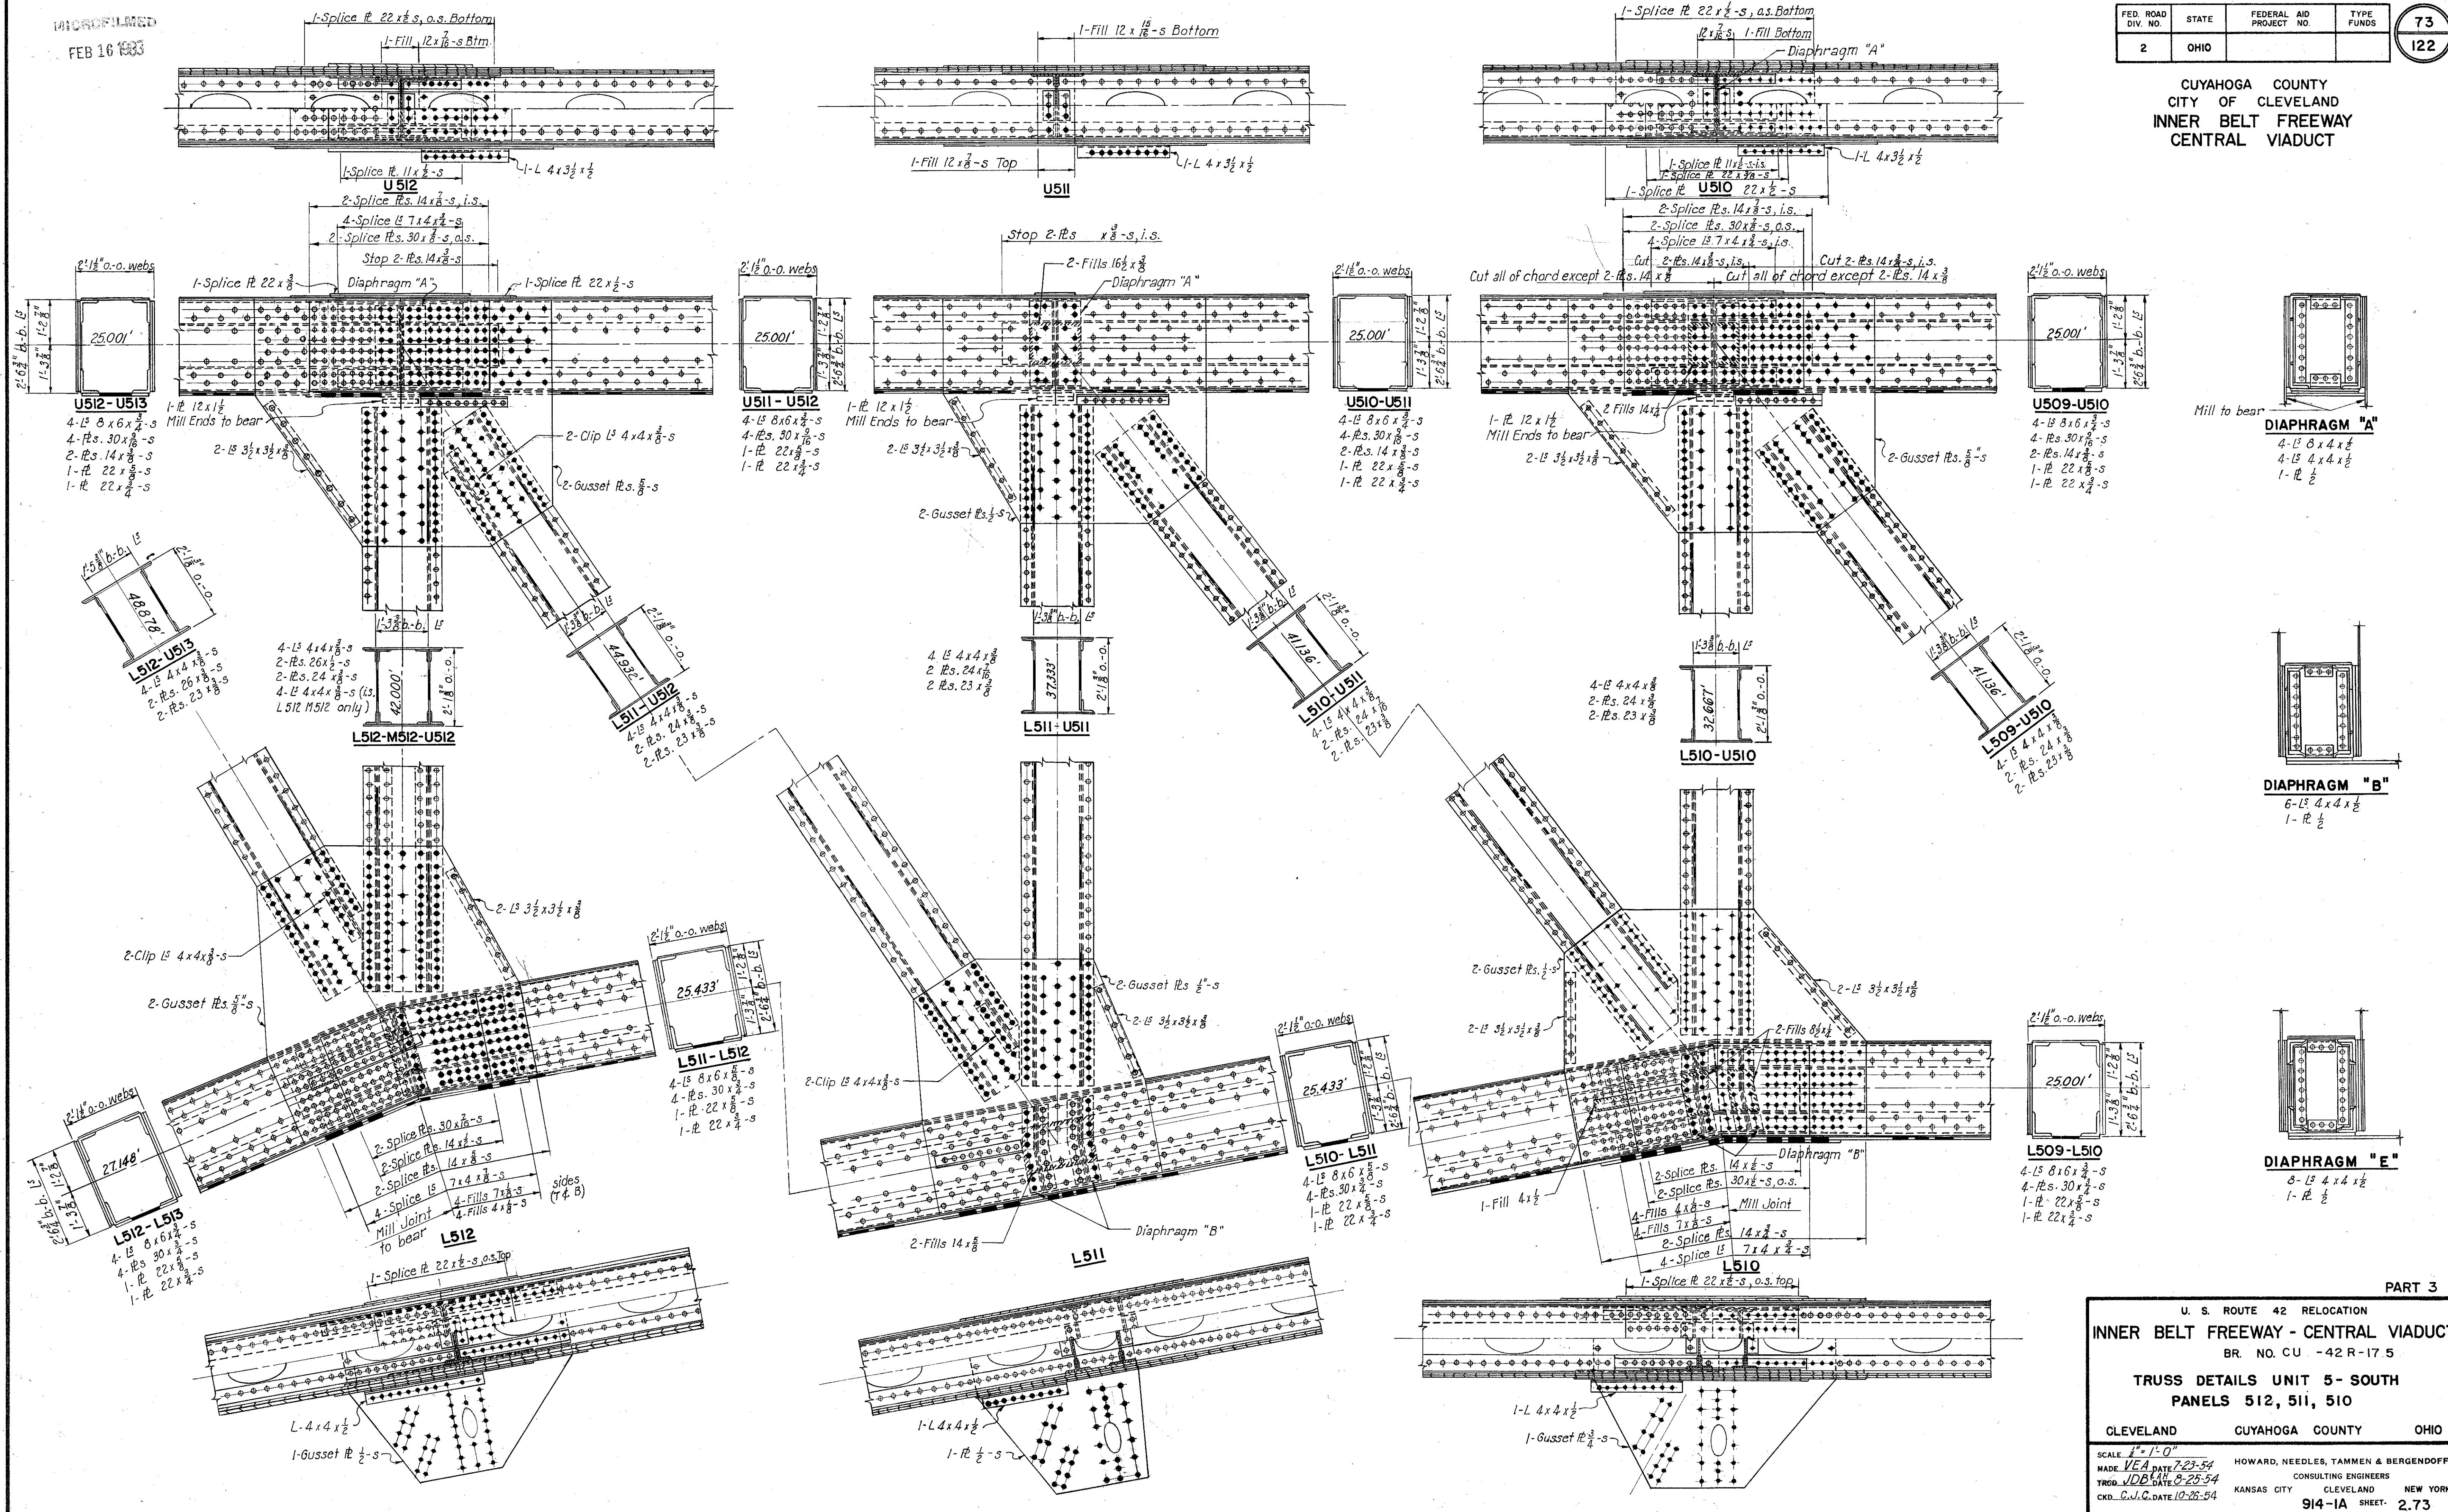

PART 3

U. S. ROUTE 42 RELOCATION
INNER BELT FREEWAY - CENTRAL VIADUCT
BR. NO. CU - 42 R-17.5

TRUSS DETAILS UNIT 5- SOUTH
PANELS 512, 511, 510

CLEVELAND CUYAHOGA COUNTY OHIO

SCALE: 1"=1'-0"
MADE: VEA DATE 7-23-54
TRGS. JDB DATE 8-25-54
CKD. C.J.C. DATE 10-26-54
HOWARD, NEEDLES, TAMMEN & BERGENDOFF
CONSULTING ENGINEERS
KANSAS CITY CLEVELAND NEW YORK
914-IA SHEET 2.73

FED. ROAD DIV. NO.	STATE	FEDERAL AID PROJECT NO.	TYPE FUNDS
2	OHIO		

72

122

Diagram of a rectangular diaphragm with a central opening. The diaphragm is composed of a grid of square panels. The top and bottom panels are labeled 'A' and 'B' respectively. The left and right panels are labeled 'C' and 'D' respectively. The central opening is labeled 'E'. A note points to the right side of the diaphragm, stating 'Mill to bear'.

DIAPHRAGM "A"

4- 1 $\frac{1}{2}$ 8 x 4 x $\frac{1}{2}$
 4- 1 $\frac{1}{2}$ 6 x 4 x $\frac{1}{2}$
 1- 2" ϕ

DIAPHRAGM "B"
 20-I 65.4
 4-15 6 x 4 x 1/2

DIAPHRAGM "C"

$4 - L^S \ 4 \times 4 \times \frac{1}{2}$
 $4 - L^S \ 6 \times 4 \times \frac{1}{2}$
 $1 - \frac{1}{2"} \ \phi$

SECTION A-A

U. S. ROUTE 42 RELOCATION

INNER BELT FREEWAY - CENTRAL VIADUCT

BR. NO. CU - 42R-17 5

TRUSS DETAILS, UNIT 5 SOUTH

PANELS 515, 514, AND 513

CLEVELAND GUYAHOGA COUNTY OHIO

SCALE: $\frac{1}{4"} = 1'-0"$

MADE P.K. 0.2 DATE 8-5-54

1-4-54

TRCD. G.H. DATE 9-1-54

CKD. DER DATE 10-4-54

HOWARD, NEEDLES, TAMMEN & BERGENDOFF
CONSULTING ENGINEERS

KANSAS CITY CLEVELAND NEW YORK


914-14 SHEET 2-72

MICROFILMED
FEB 16 1983

FED. ROAD DIV. NO.	STATE	FEDERAL AID PROJECT NO.	TYPE FUNDS
2	OHIO		

71
122

CUYAHOGA COUNTY
CITY OF CLEVELAND
INNER BELT FREEWAY
CENTRAL VIADUCT

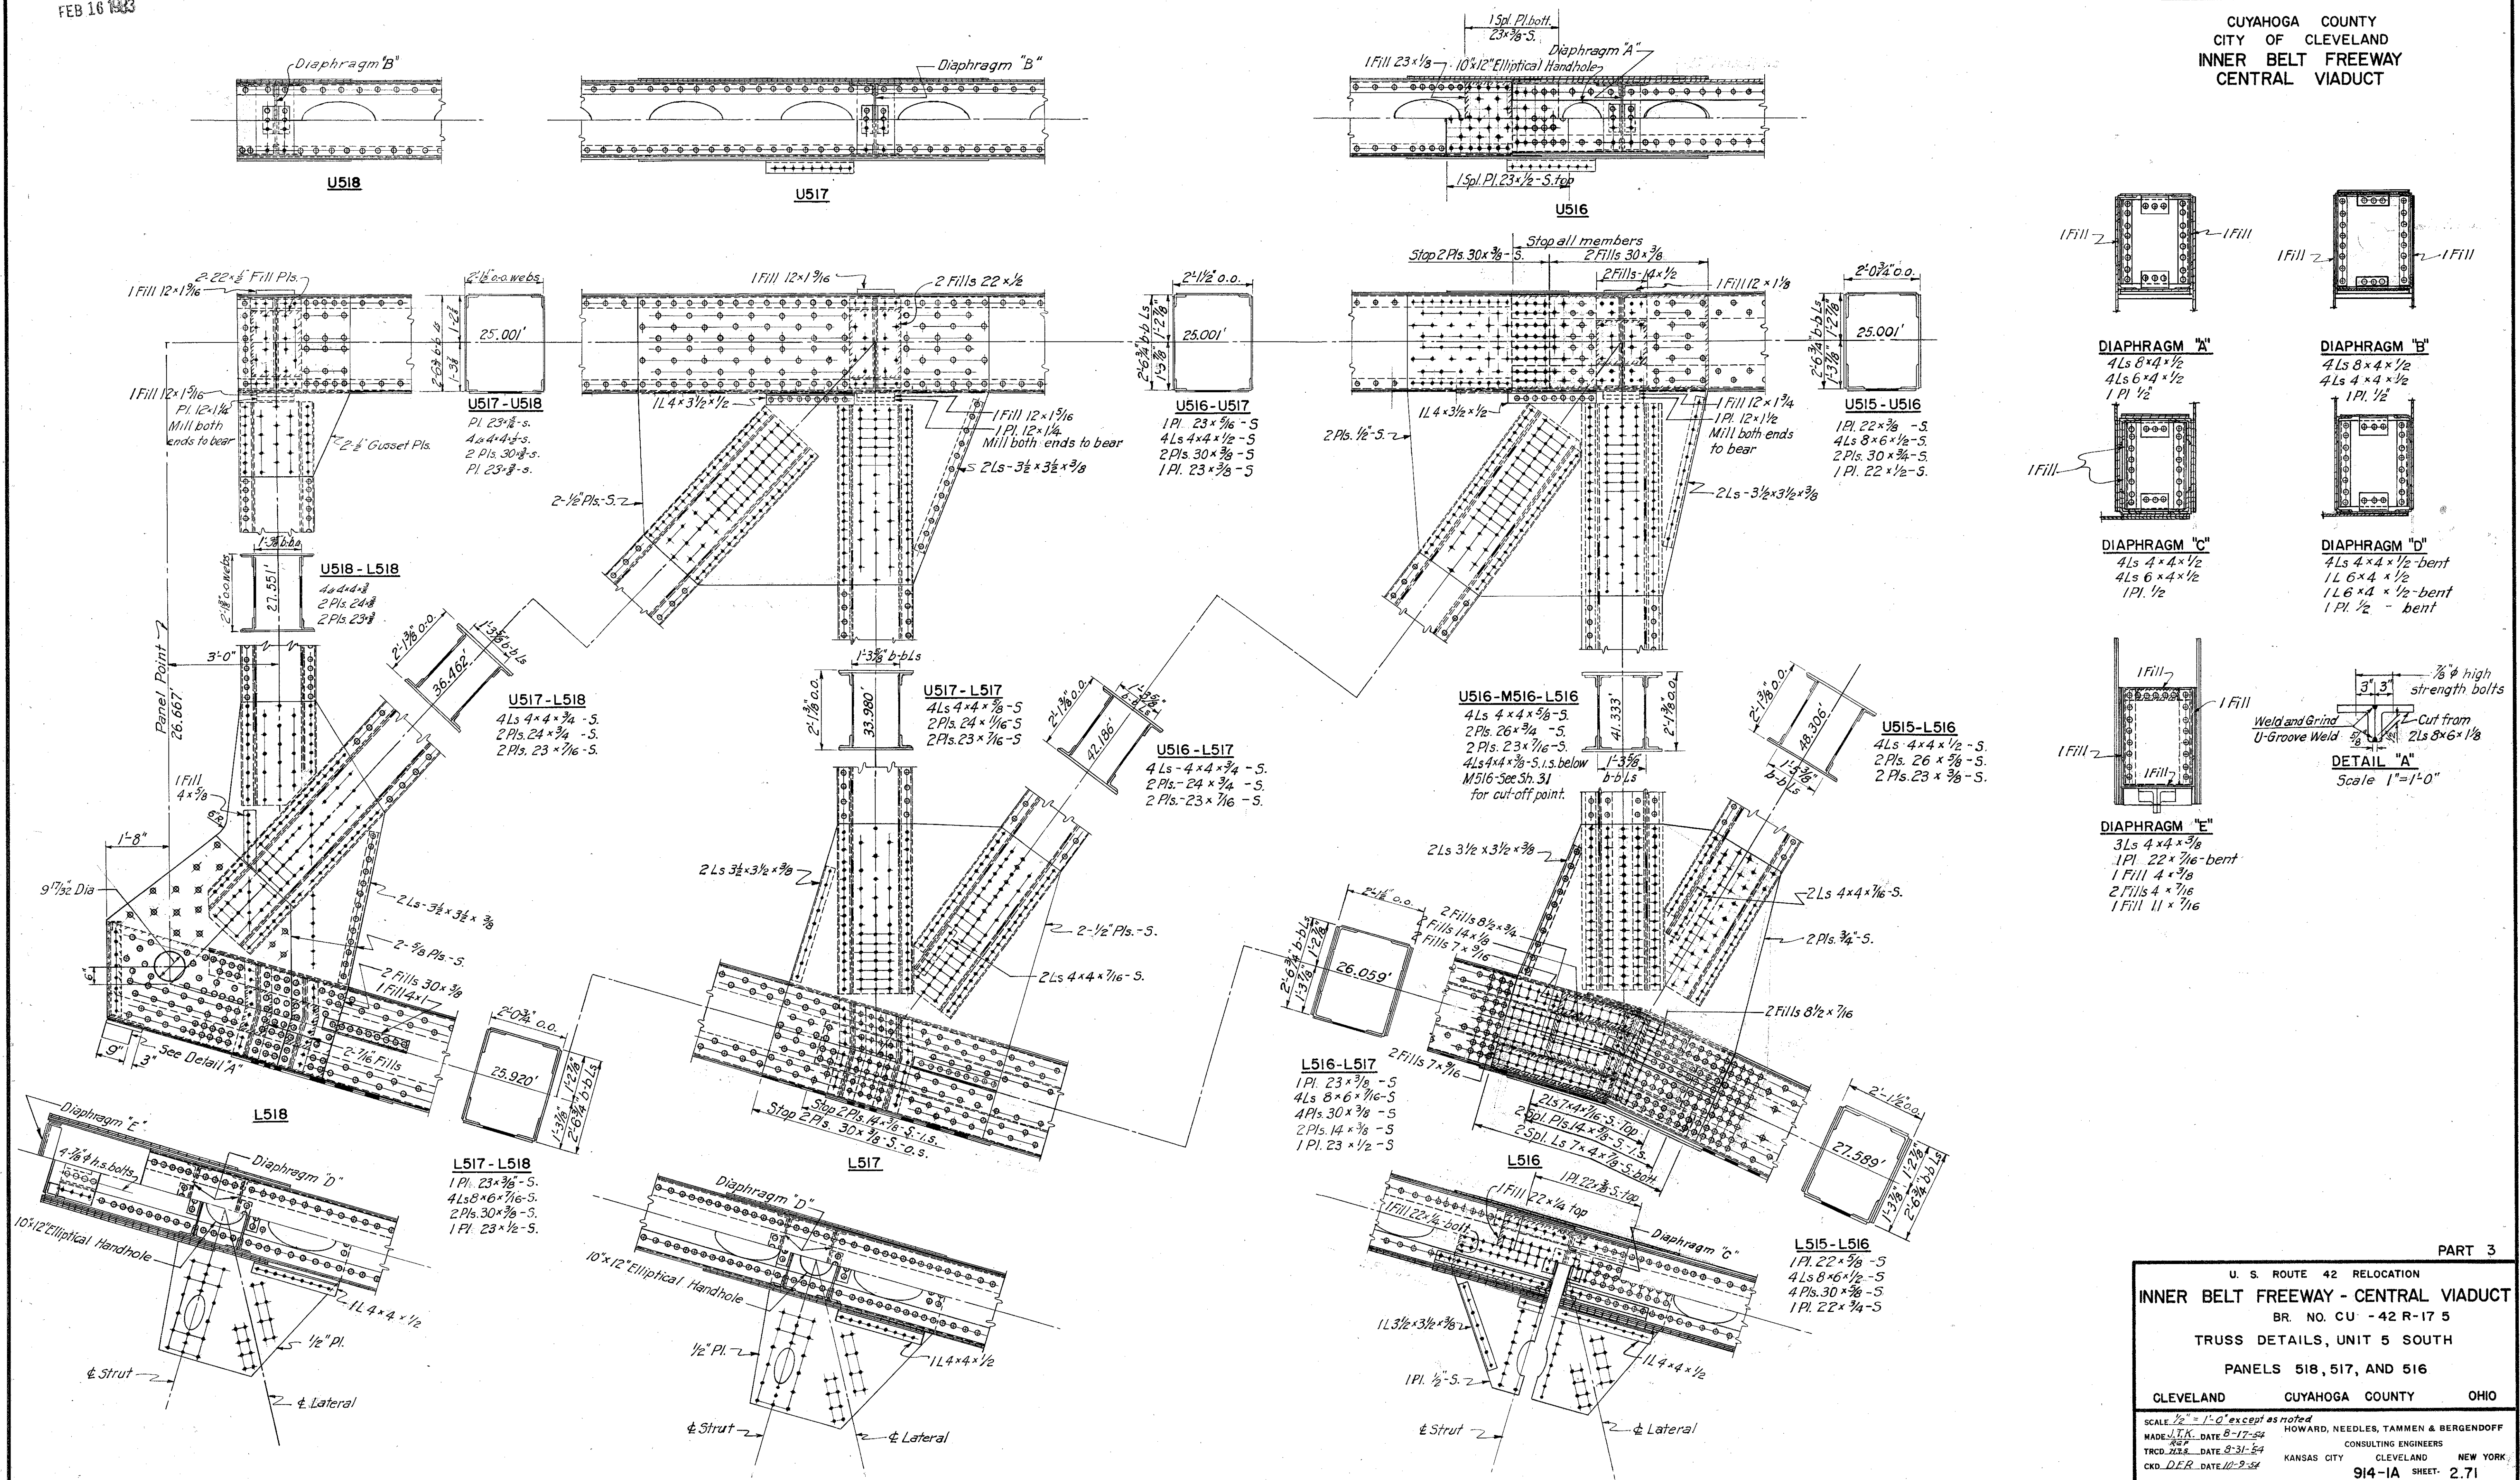

PART 3

U. S. ROUTE 42 RELOCATION
INNER BELT FREEWAY - CENTRAL VIADUCT
BR. NO. CU - 42 R-17 5
TRUSS DETAILS, UNIT 5 SOUTH
PANELS 518, 517, AND 516
CLEVELAND CUYAHOGA COUNTY OHIO
SCALE: 1/2" = 1'-0" except as noted
MADE BY: DATE: 8-17-54 HOWARD, NEEDLES, TAMMEN & BERGENDOFF
TRCD: DATE: 9-31-54 CONSULTING ENGINEERS
KANSAS CITY CLEVELAND NEW YORK
CKD: DATE: 10-9-54 914-1A SHEET: 2.71

U. S. ROUTE 42 RELOCATION


INNER BELT FREEWAY - CENTRAL VIADUCT

BR. NO. CU - 42 R-17 5

TRUSS DETAILS, UNIT 5 NORTH


PANELS 516, 517, AND 518

CLEVELAND	CUYAHOGA	COUNTY	OHIO
SCALE $\frac{1}{2}'' = 1'-0''$ or as shown			
MADE <u>5-20</u> DATE <u>5-10-55</u>			
TRCD <u>8-6</u> DATE <u>1-10-55</u>			
CKD <u>JTK</u> DATE <u>2-2-54</u>			
HOWARD, NEEDLES, TAMMEN & BERGENOFF		CONSULTING ENGINEERS	
KANSAS CITY	CLEVELAND	NEW YORK	
914-14		SHEET- 270	

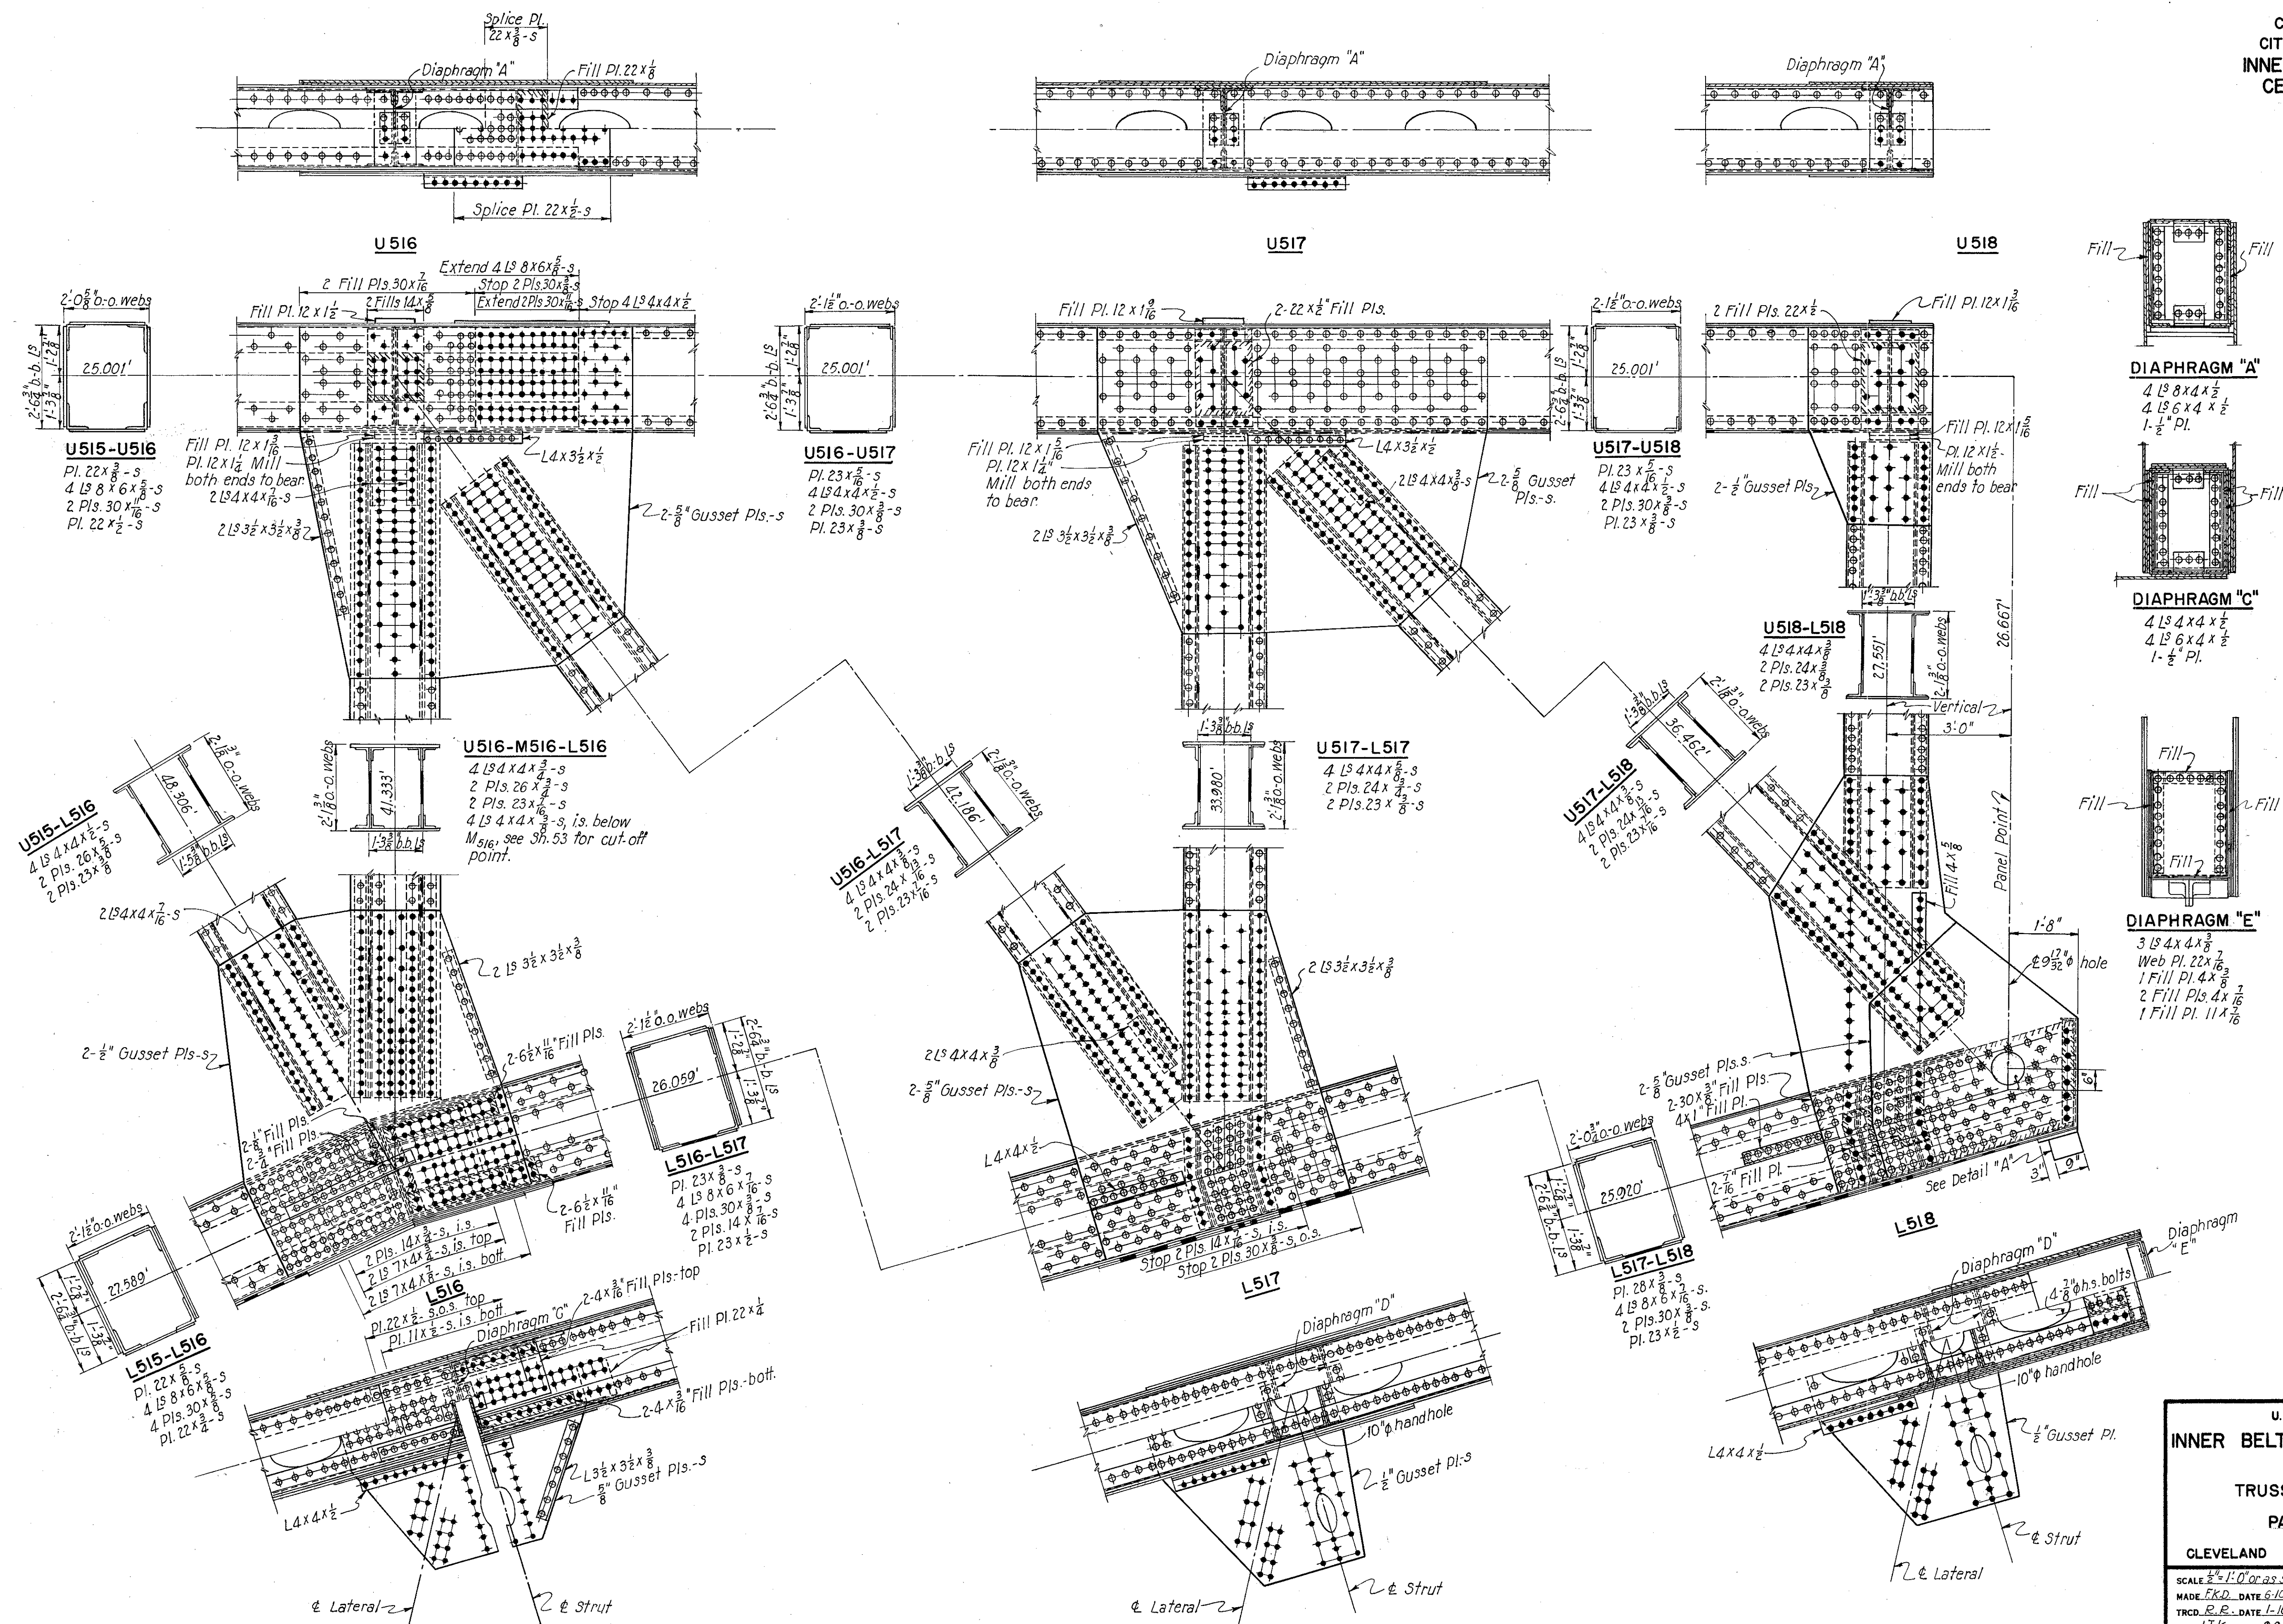


SCALE $\frac{1}{2}" = 1'-0"$
MADE F.K.D. DATE 7-28-54
TRCD M.A.C. DATE 1-5-55
CKD J.T.K. DATE 9-2-54

HOWARD, NEEDLES, TAMMEN & BERGENDOFF
CONSULTING ENGINEERS
KANSAS CITY CLEVELAND NEW YORK
914-1A SHEET 2.69

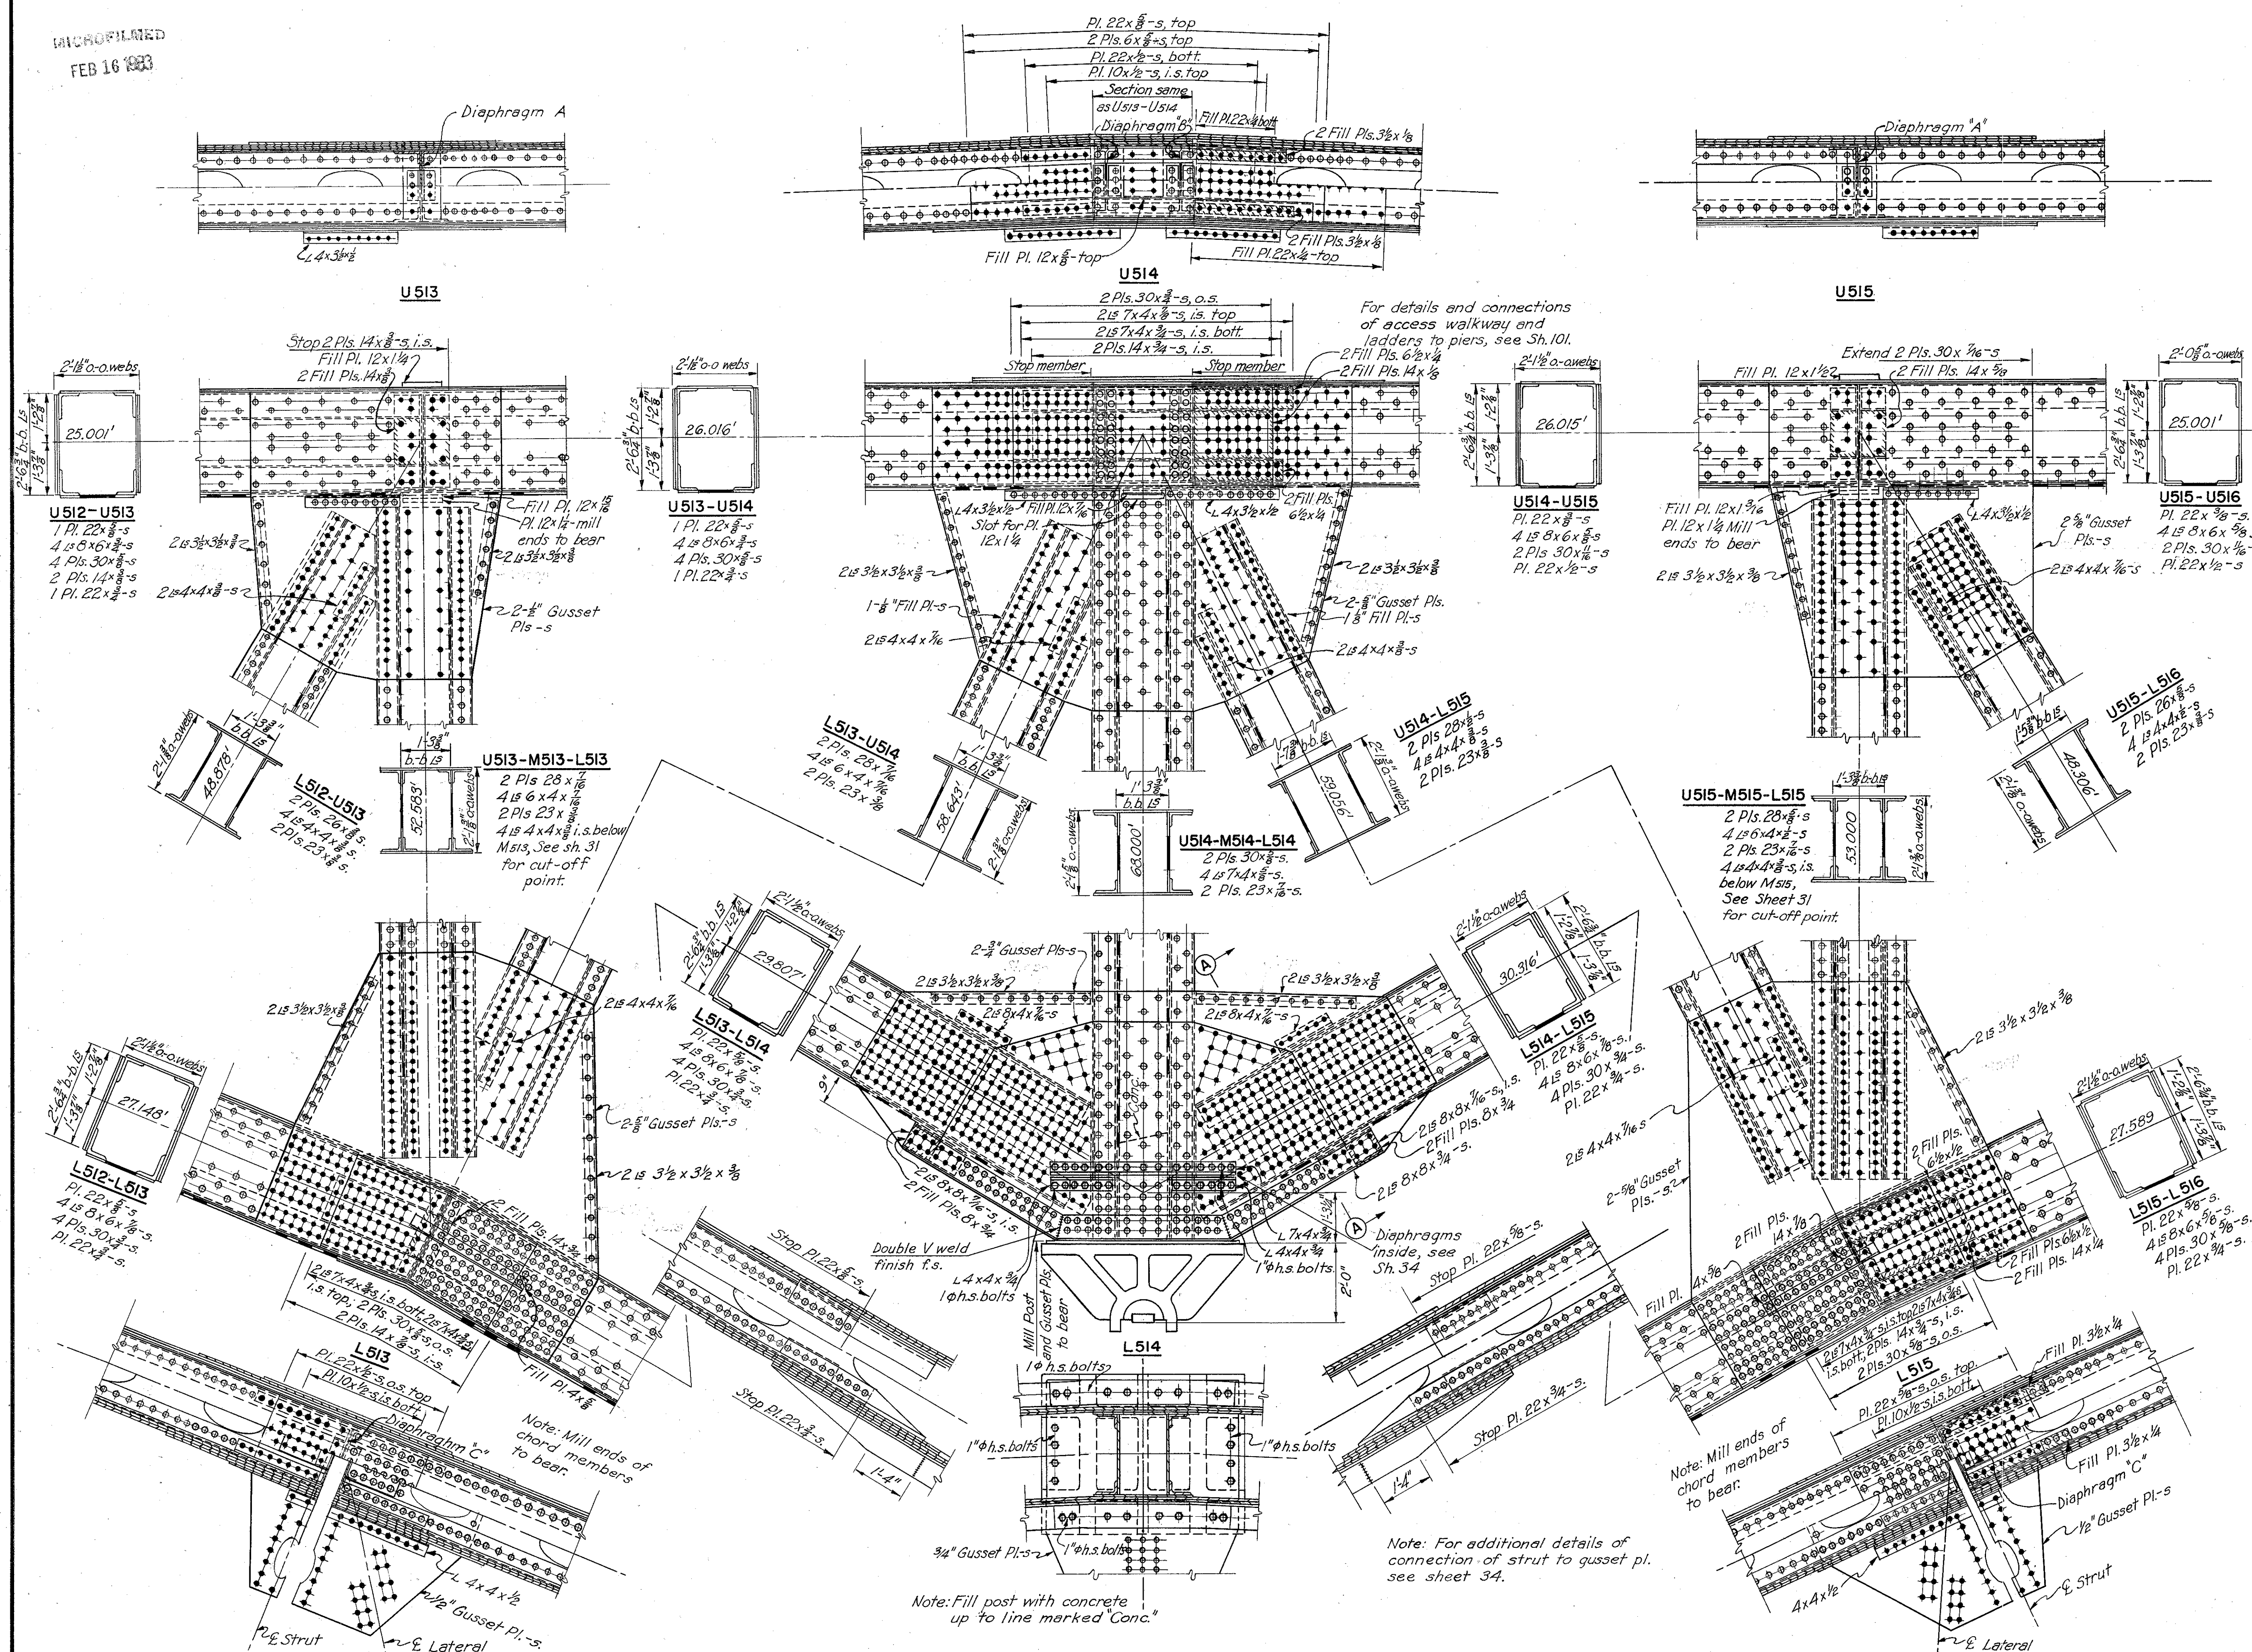

FEB 16 1936

CUYAHOGA COUNTY
CITY OF CLEVELAND
INNER BELT FREEWAY
CENTRAL VIADUCT

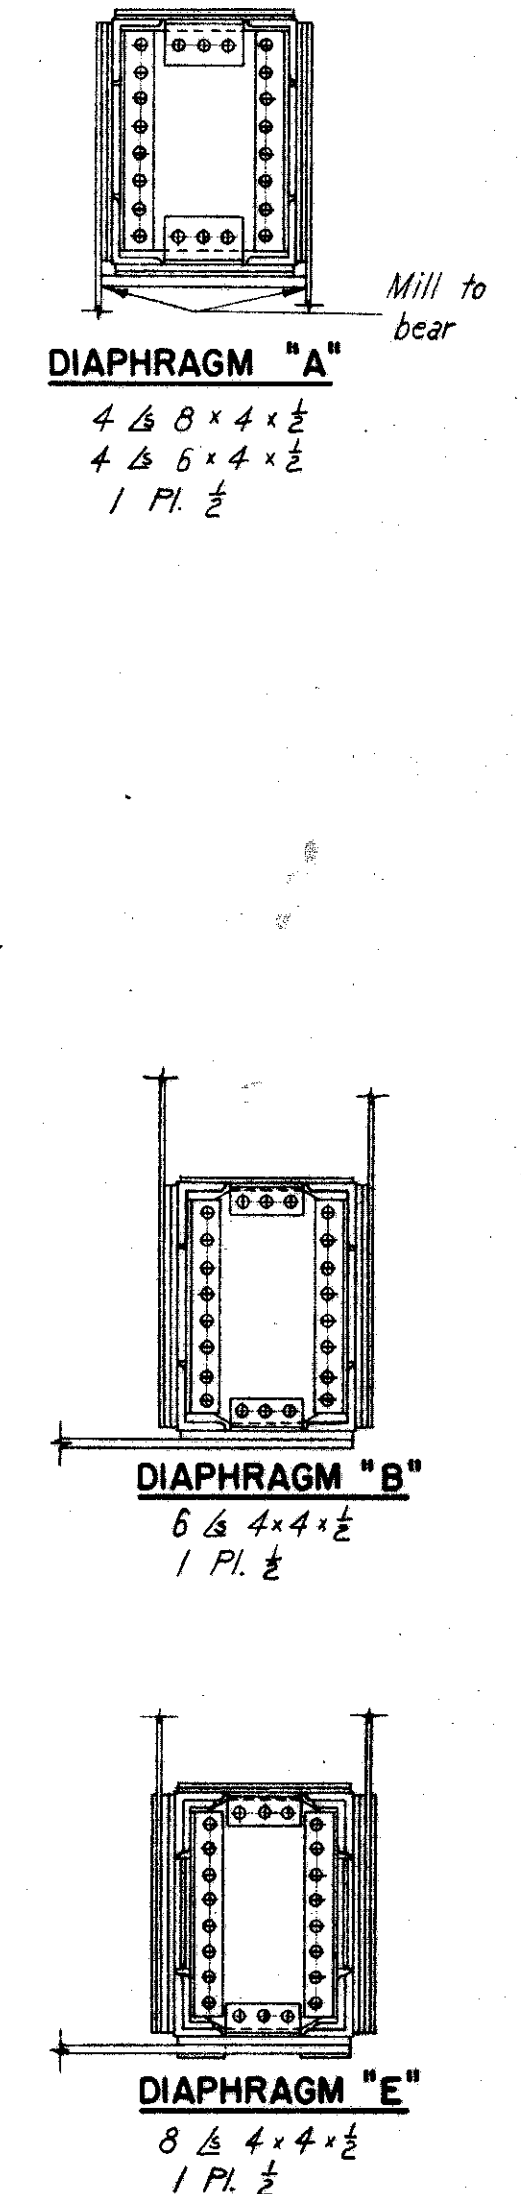

U. S. ROUTE 42 RELOCATION

INNER BELT FREEWAY - CENTRAL VIADUCT

BR. NO. CU - 42 R-17 5

TRUSS DETAILS UNIT 5 - NORTH

PANELS 510, 511, 512

CLEVELAND CUYAHOGA COUNTY OHIO

SCALE $\frac{1}{2"} = 1' - 0"$

MADE VEA DATE 7-23-54

TRCD. VEA DATE 10-15-54

CKD. L.T.K. DATE 10-27-54


HOWARD, NEEDLES, TAMMEN & BERGENDOFF
CONSULTING ENGINEERS

KANSAS CITY CLEVELAND NEW YORK

914-1A SHEET 2.68

U. S. ROUTE 42 RELOCATION
INNER BELT FREEWAY - CENTRAL VIADUCT
 BR. NO. CU - 42 R-17 5
 TRUSS DETAILS UNIT 5 - NORTH
 PANELS 506, 507, 508, 509
 CLEVELAND CUYAHOGA COUNTY OHIO
 SCALE: 1" = 1'-0"
 MADE VEA DATE 7-2-54
 TRCD VEA DATE 10-7-54
 CKD JTK DATE 10-21-54
 HOWARD, NEEDLES, TAMMEN & BERENDSON
 CONSULTING ENGINEERS
 KANSAS CITY CLEVELAND NEW YORK
 914-1A SHEET 2.67

U. S. ROUTE 42 RELOCATION INNER BELT FREEWAY - CENTRAL VIADUCT BR. NO. CU - 42 R-17 5	
TRUSS DETAILS UNIT 5 NORTH PANELS 503, 504 AND 505	
CLEVELAND	CUYAHOGA COUNTY
OHIO	
SCALE $\frac{3}{8}'' = 1'-0''$ MADE <u>VDB</u> DATE <u>7-13-54</u> TRCD <u>AH</u> DATE <u>1-11-54</u> CWD <u>TK</u> DATE <u>1-13-54</u>	
HOWARD, NEEDLES, TAMMEN & BERGENDOFF CONSULTING ENGINEERS KANSAS CITY CLEVELAND NEW YORK	
914-1A SHEET 2.66	

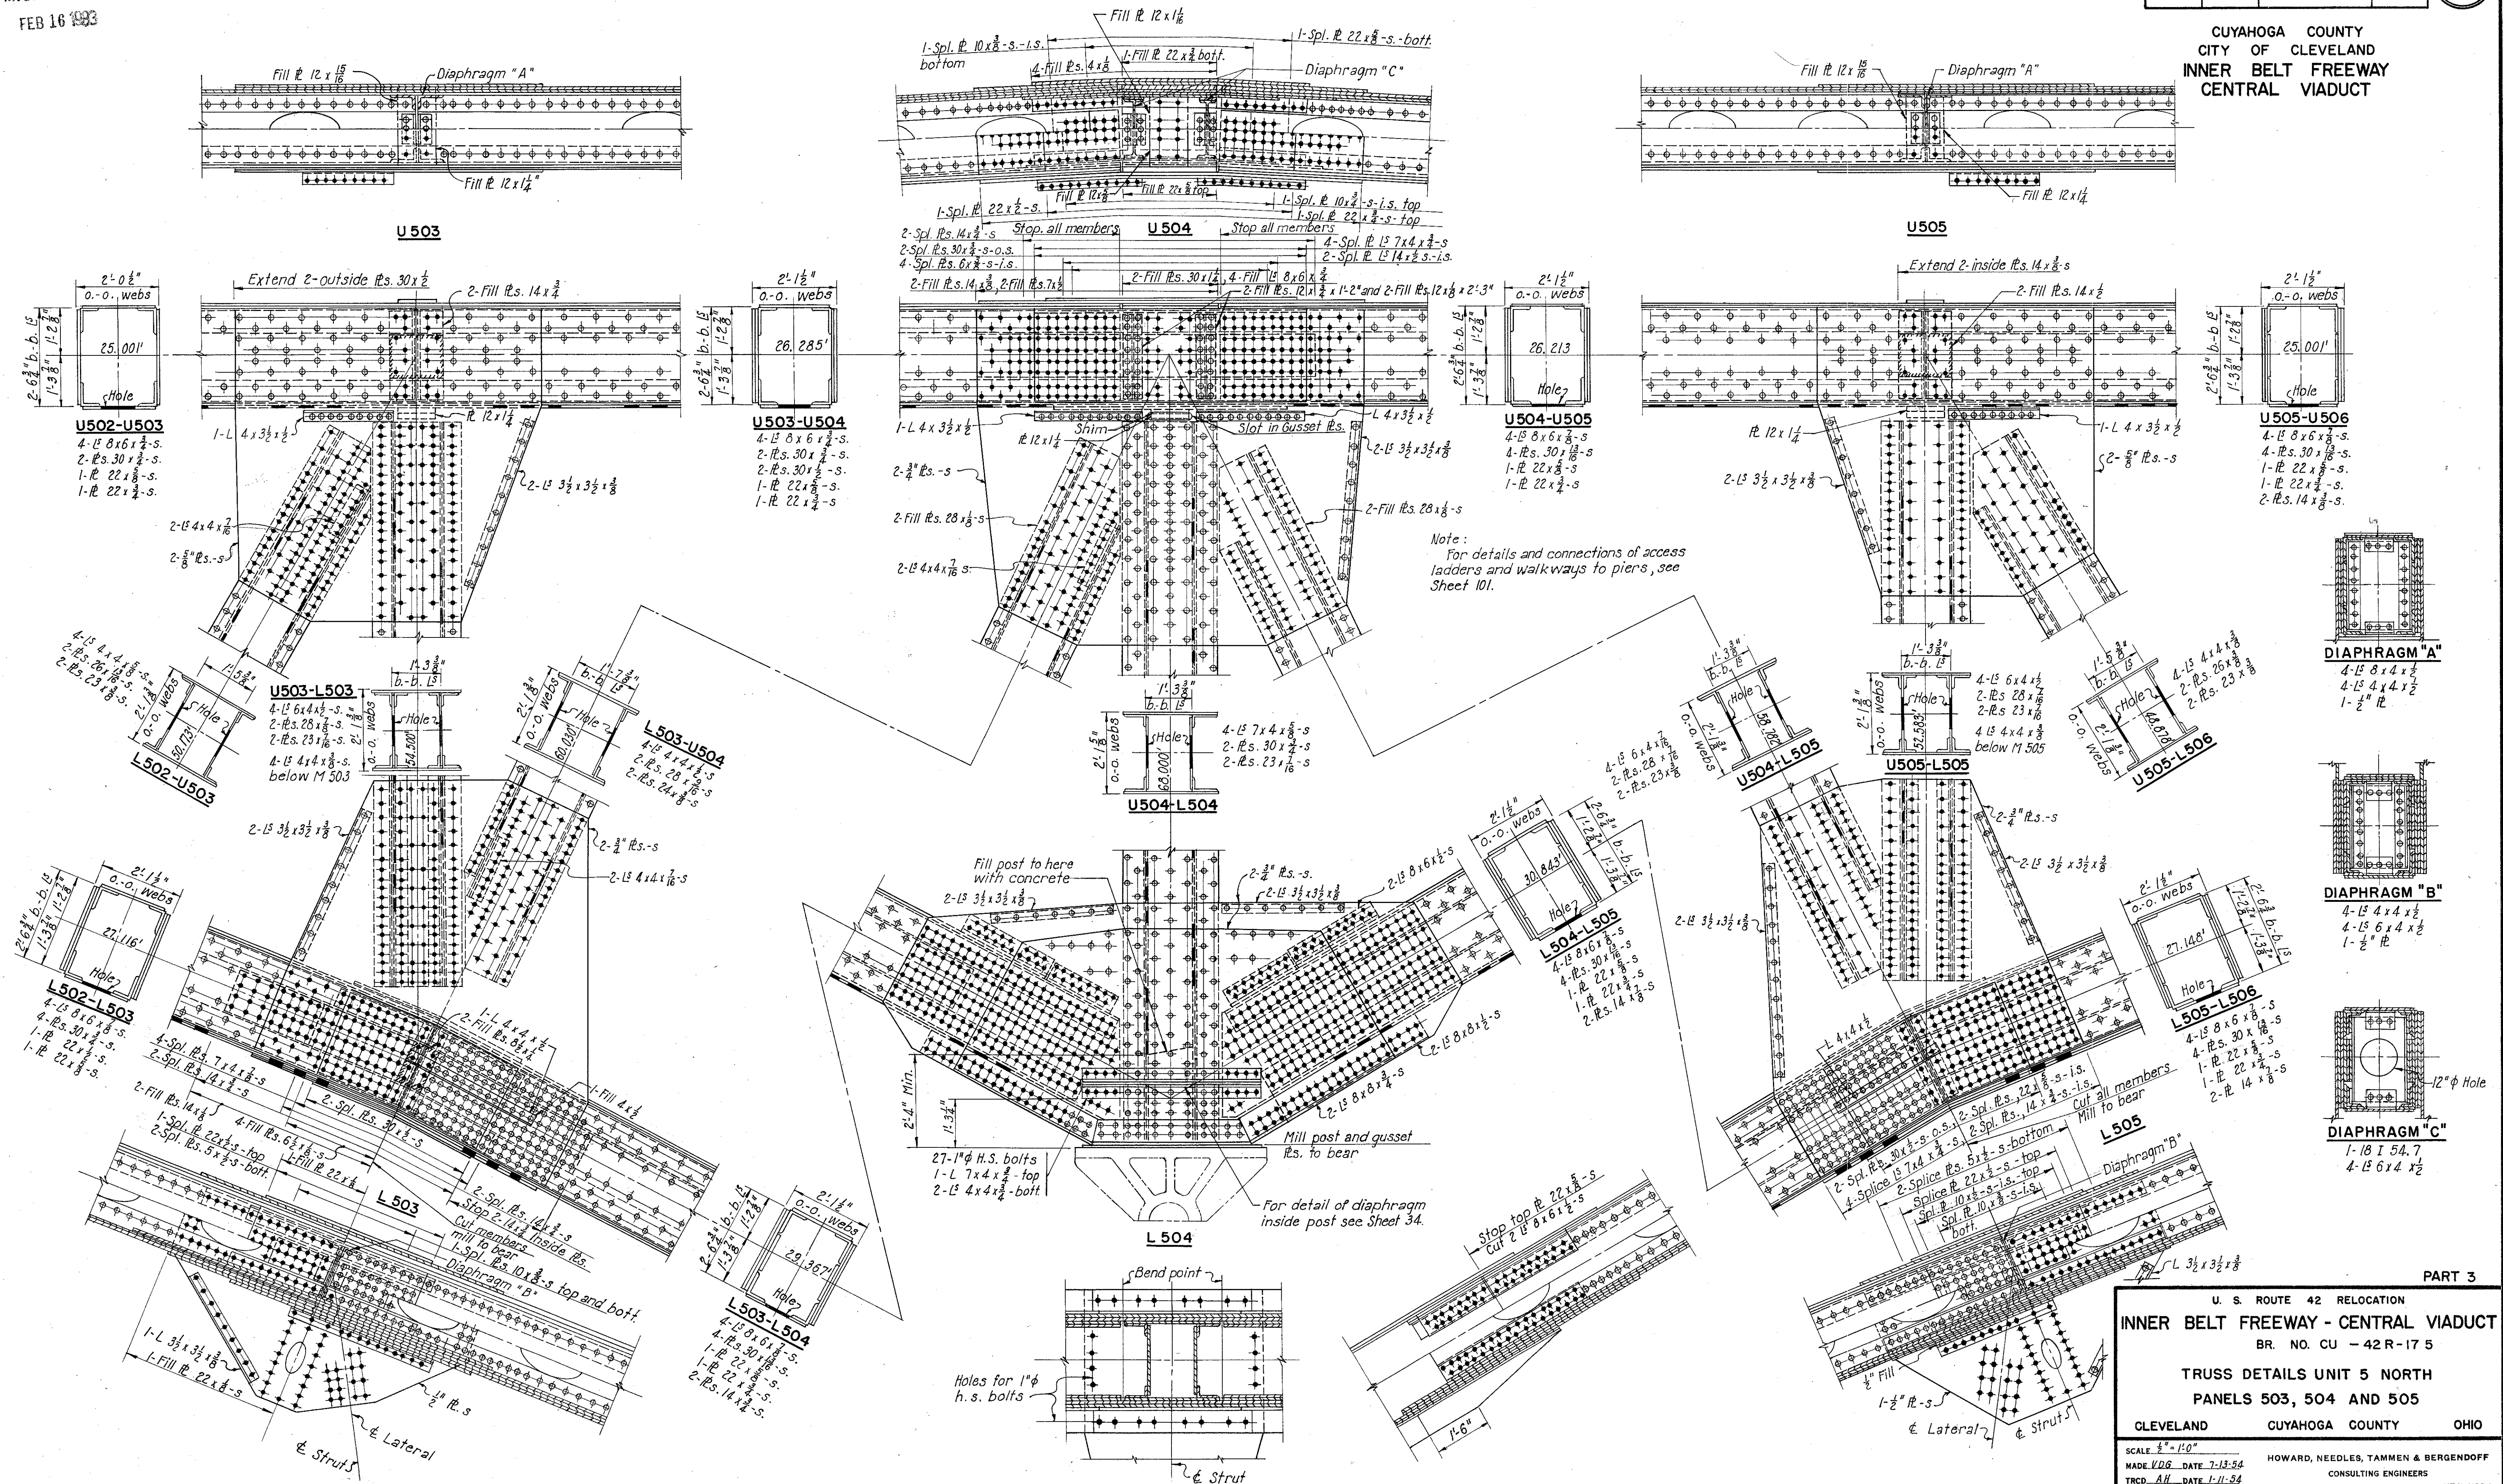

U. S. ROUTE 42 RELOCATION

INNER BELT FREEWAY - CENTRAL VIADUCT

BR. NO. CU - 42 R-17 5

TRUSS DETAILS, UNIT 5 NORTH

PANELS 500, 501 AND 502

CLEVELAND CUYAHOGA COUNTY OHIO

SCALE $\frac{1}{2}" = 1'-0"$

MADE V.D.G. DATE 8-21-54

TRCD. B.H. DATE 10-25-54

CKD. J.T.K. DATE 10-7-54

HOWARD, NEEDLES, TAMMEN & BERGENDOFF
CONSULTING ENGINEERS

KANSAS CITY CLEVELAND NEW YORK

914-1A SHEET 2. 65

U. S. ROUTE 42 RELOCATION INNER BELT FREEWAY - CENTRAL VIADUCT BR. NO. CU - 42 R-17 5	
STRESS SHEET UNIT 5 SOUTH TRUSS	
CLEVELAND	CUYAHOGA COUNTY OHIO
SCALE <u>None</u> MADE <u>H.W.L.</u> DATE <u>5-7-56</u> <u>G.W.L.</u> TRCD <u>9 H.W.L.</u> DATE <u>8-26-54</u> CKD <u>D.F.R.</u> DATE <u>9-27-54</u>	
HOWARD, NEEDLES, TAMMEN & BERGENDOFF CONSULTING ENGINEERS KANSAS CITY CLEVELAND NEW YORK	
914-1A SHEET- 2.64	

CUYAHOGA COUNTY
CITY OF CLEVELAND
INNER BELT FREEWAY
CENTRAL VIADUCT

[illegible]

CHORD

Diagram of a web member showing internal forces. The member is a vertical rectangle. On the left side, there is a vertical force g_2 acting downwards. On the right side, there is a vertical force g_1 acting upwards. Inside the rectangle, there are horizontal forces: c_2 at the top and c_1 at the bottom, both acting to the right. There are also vertical forces: e_2 at the top and e_1 at the bottom, both acting upwards. The bottom of the rectangle is labeled "WEB MEMBER".

Diagram of a web member showing internal forces and dimensions. The member is a rectangular section with width b and height g . Internal forces are labeled: f_a and f_b at the top corners, c_a and c_b at the bottom corners, and g_a and g_b at the left and right ends respectively. The text "WEB MEMBER" is written below the diagram.


PART 3

CLEVELAND CUYAHOGA COUNTY OHIO

SCALE None
MADE H.W.L. DATE 5-6-54
G.A.K.
TRCD # 104 DATE 8-28-54
CKD D.L.C. DATE 8-27-54

HOWARD, NEEDLES, TAMMEN & BERGENDOFF
CONSULTING ENGINEERS
KANSAS CITY CLEVELAND NEW YORK
914-1A SHEET 2.63

FED. ROAD DIV. NO.	STATE	FEDERAL AID PROJECT NO.	TYPE FUNDS
2	OHIO		



MICROFILMED
FEB 16 1983

U42-U43

- 1 Pl. 22x $\frac{1}{2}$ -s
- 4 ls 8x6x $\frac{1}{8}$ -s
- 4 Pls. 30x $\frac{1}{2}$ -s
- 2 Pls. 14x $\frac{1}{2}$ -s
- 1 Pl. 22x $\frac{1}{2}$ -s

U41-U42

- 1 Pl. 22x $\frac{1}{2}$ -s
- 4 ls 8x6x $\frac{1}{8}$ -s
- 4 Pls. 30x $\frac{1}{2}$ -s
- 2 Pls. 14x $\frac{1}{2}$ -s
- 1 Pl. 22x $\frac{1}{2}$ -s

U40-U41

- 1 Pl. 22x $\frac{1}{2}$ -s
- 4 ls 8x6x $\frac{1}{8}$ -s
- 2 Pls. 30x $\frac{1}{2}$ -s
- 1 Pl. 22x $\frac{1}{2}$ -s

L42-L43

- 1 Pl. 22x $\frac{1}{2}$ -s
- 4 ls 8x6x $\frac{1}{8}$ -s
- 4 Pls. 30x $\frac{1}{2}$ -s
- 2 Pls. 14x $\frac{1}{2}$ -s
- 1 Pl. 22x $\frac{1}{2}$ -s

L41-L42

- 1 Pl. 22x $\frac{1}{2}$ -s
- 4 ls 8x6x $\frac{1}{8}$ -s
- 2 Pls. 30x $\frac{1}{2}$ -s
- 1 Pl. 22x $\frac{1}{2}$ -s

L40-L41

- 1 Pl. 23x $\frac{1}{2}$ -s
- 4 ls 4x4x $\frac{1}{8}$ -s
- 2 Pls. 30x $\frac{1}{2}$ -s
- 1 Pl. 23x $\frac{1}{2}$ -s

Note: For Link and pin details and details of slotted Pl. see sheet 45.
See sheet 61 for diaphragms "A", "B" and "E".

PART 3

U. S. ROUTE 42 RELOCATION

INNER BELT FREEWAY - CENTRAL VIADUCT

BR. NO. CU - 42 R-175


TRUSS DETAILS UNIT 4 - SOUTH
PANELS 40, 41, & 42

CLEVELAND	CUYAHOGA COUNTY	OHIO
-----------	-----------------	------

SCALE $\frac{1}{4}'' = 1'-0''$

MADE DLC DATE 5-8-54

TRCD	DATE	HOWARD, NEEDLES, TAMMEN & BERGENDOFF CONSULTING ENGINEERS
CKD <u>EPD</u>	DATE <u>6-22-54</u>	KANSAS CITY CLEVELAND NEW YORK
		914-1A SHEET 2.62

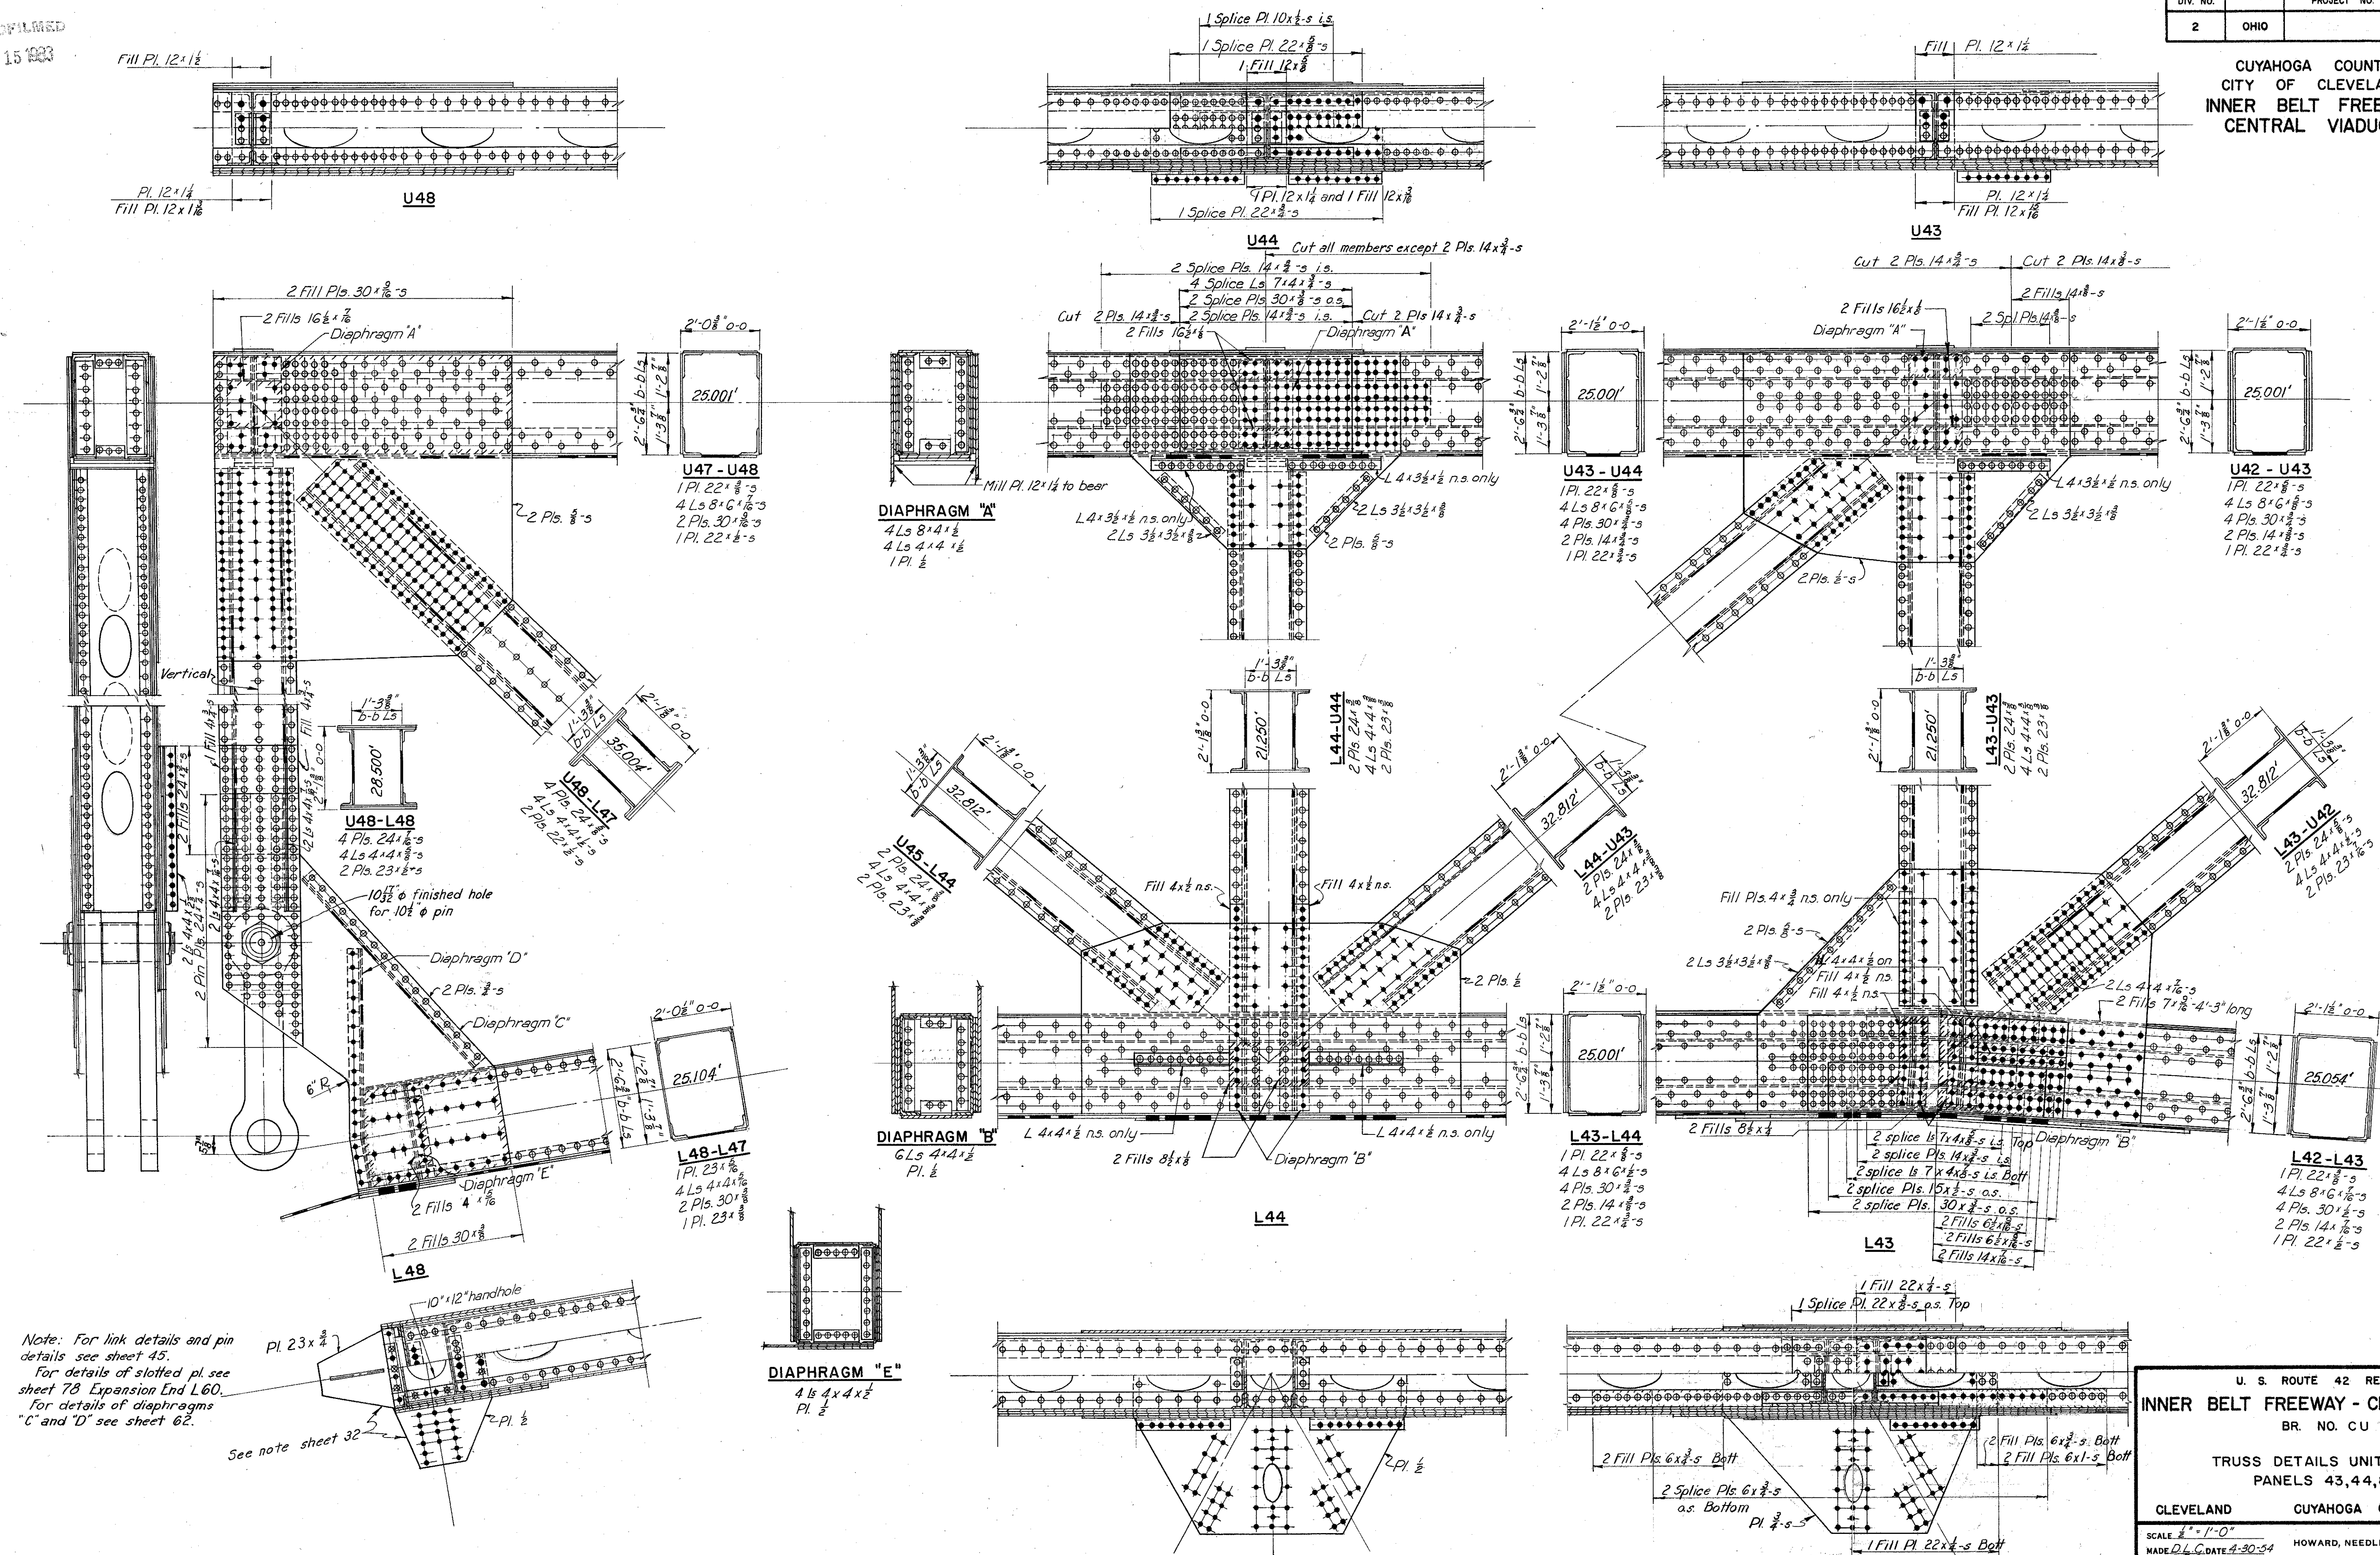

*Note: For link details and pin details see sheet 45.
For details of slotted pl. see sheet 78 Expansion End L60.
For details of diaphragms "C" and "D" see sheet 62.*

See note sheet 32

PART 3

U. S. ROUTE 42 RELOCATION
INNER BELT FREEWAY - CENTRAL VIADUCT
BR. NO. CU - 42 R-17 5




TRUSS DETAILS UNIT 4 - SOUTH
PANELS 43,44,& 48

CLEVELAND CUYAHOGA COUNTY OHIO




SCALE $\frac{1}{2}'' = 1'-0''$
MADE D.L.C. DATE 4-30-54
TRCD G.R.H. DATE 9-7-54
CKD F.K.D. DATE 10-9-54

HOWARD, NEEDLES, TAMMEN & BERGENSDORFF
CONSULTING ENGINEERS
KANSAS CITY CLEVELAND NEW YORK
914-1A SHEET- 261





270

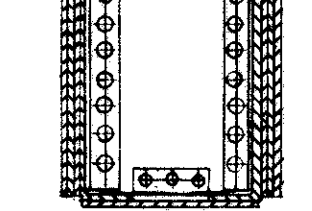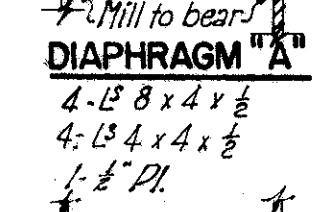

DIAPHRAGM "B"
1- ϕ - $\frac{1}{2}$

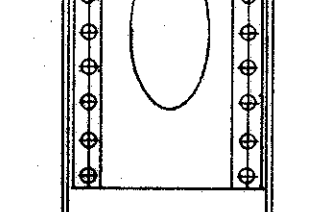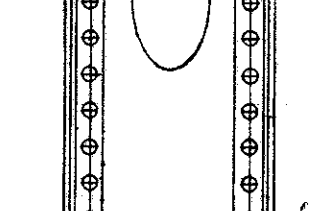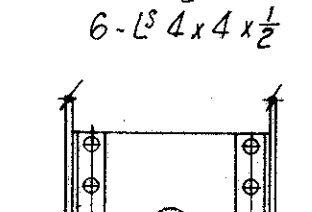

DIAPHRAGM C

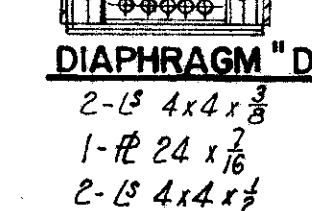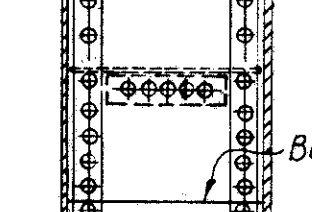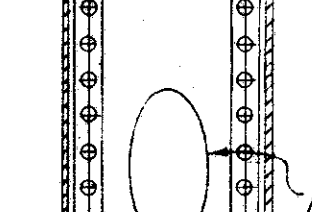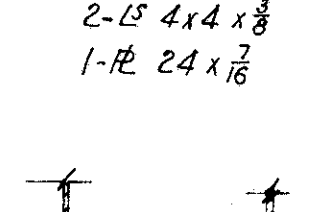

100

U. S. ROUTE 42 RELOCATION

INNER BELT FREEWAY - CENTRAL VIADUCT

BR. NO. CU - 42 R-17 5

TRUSS DETAILS, UNIT 4 NORTH

PANELS 43, 44, AND 48

CLEVELAND CUYAHOGA COUNTY OHIO

SCALE $\frac{1}{2"} = 1'-0"$

MADE P.L.C. DATE 3-31-54


TRCD. C.A.H. DATE 9-1-54

CRD E.Y.D. DATE 10-22-54

HOWARD, NEEDLES, TAMMEN & BERGENDOFF
CONSULTING ENGINEERS

KANSAS CITY CLEVELAND NEW YORK

914-1A SHEET- 2.60

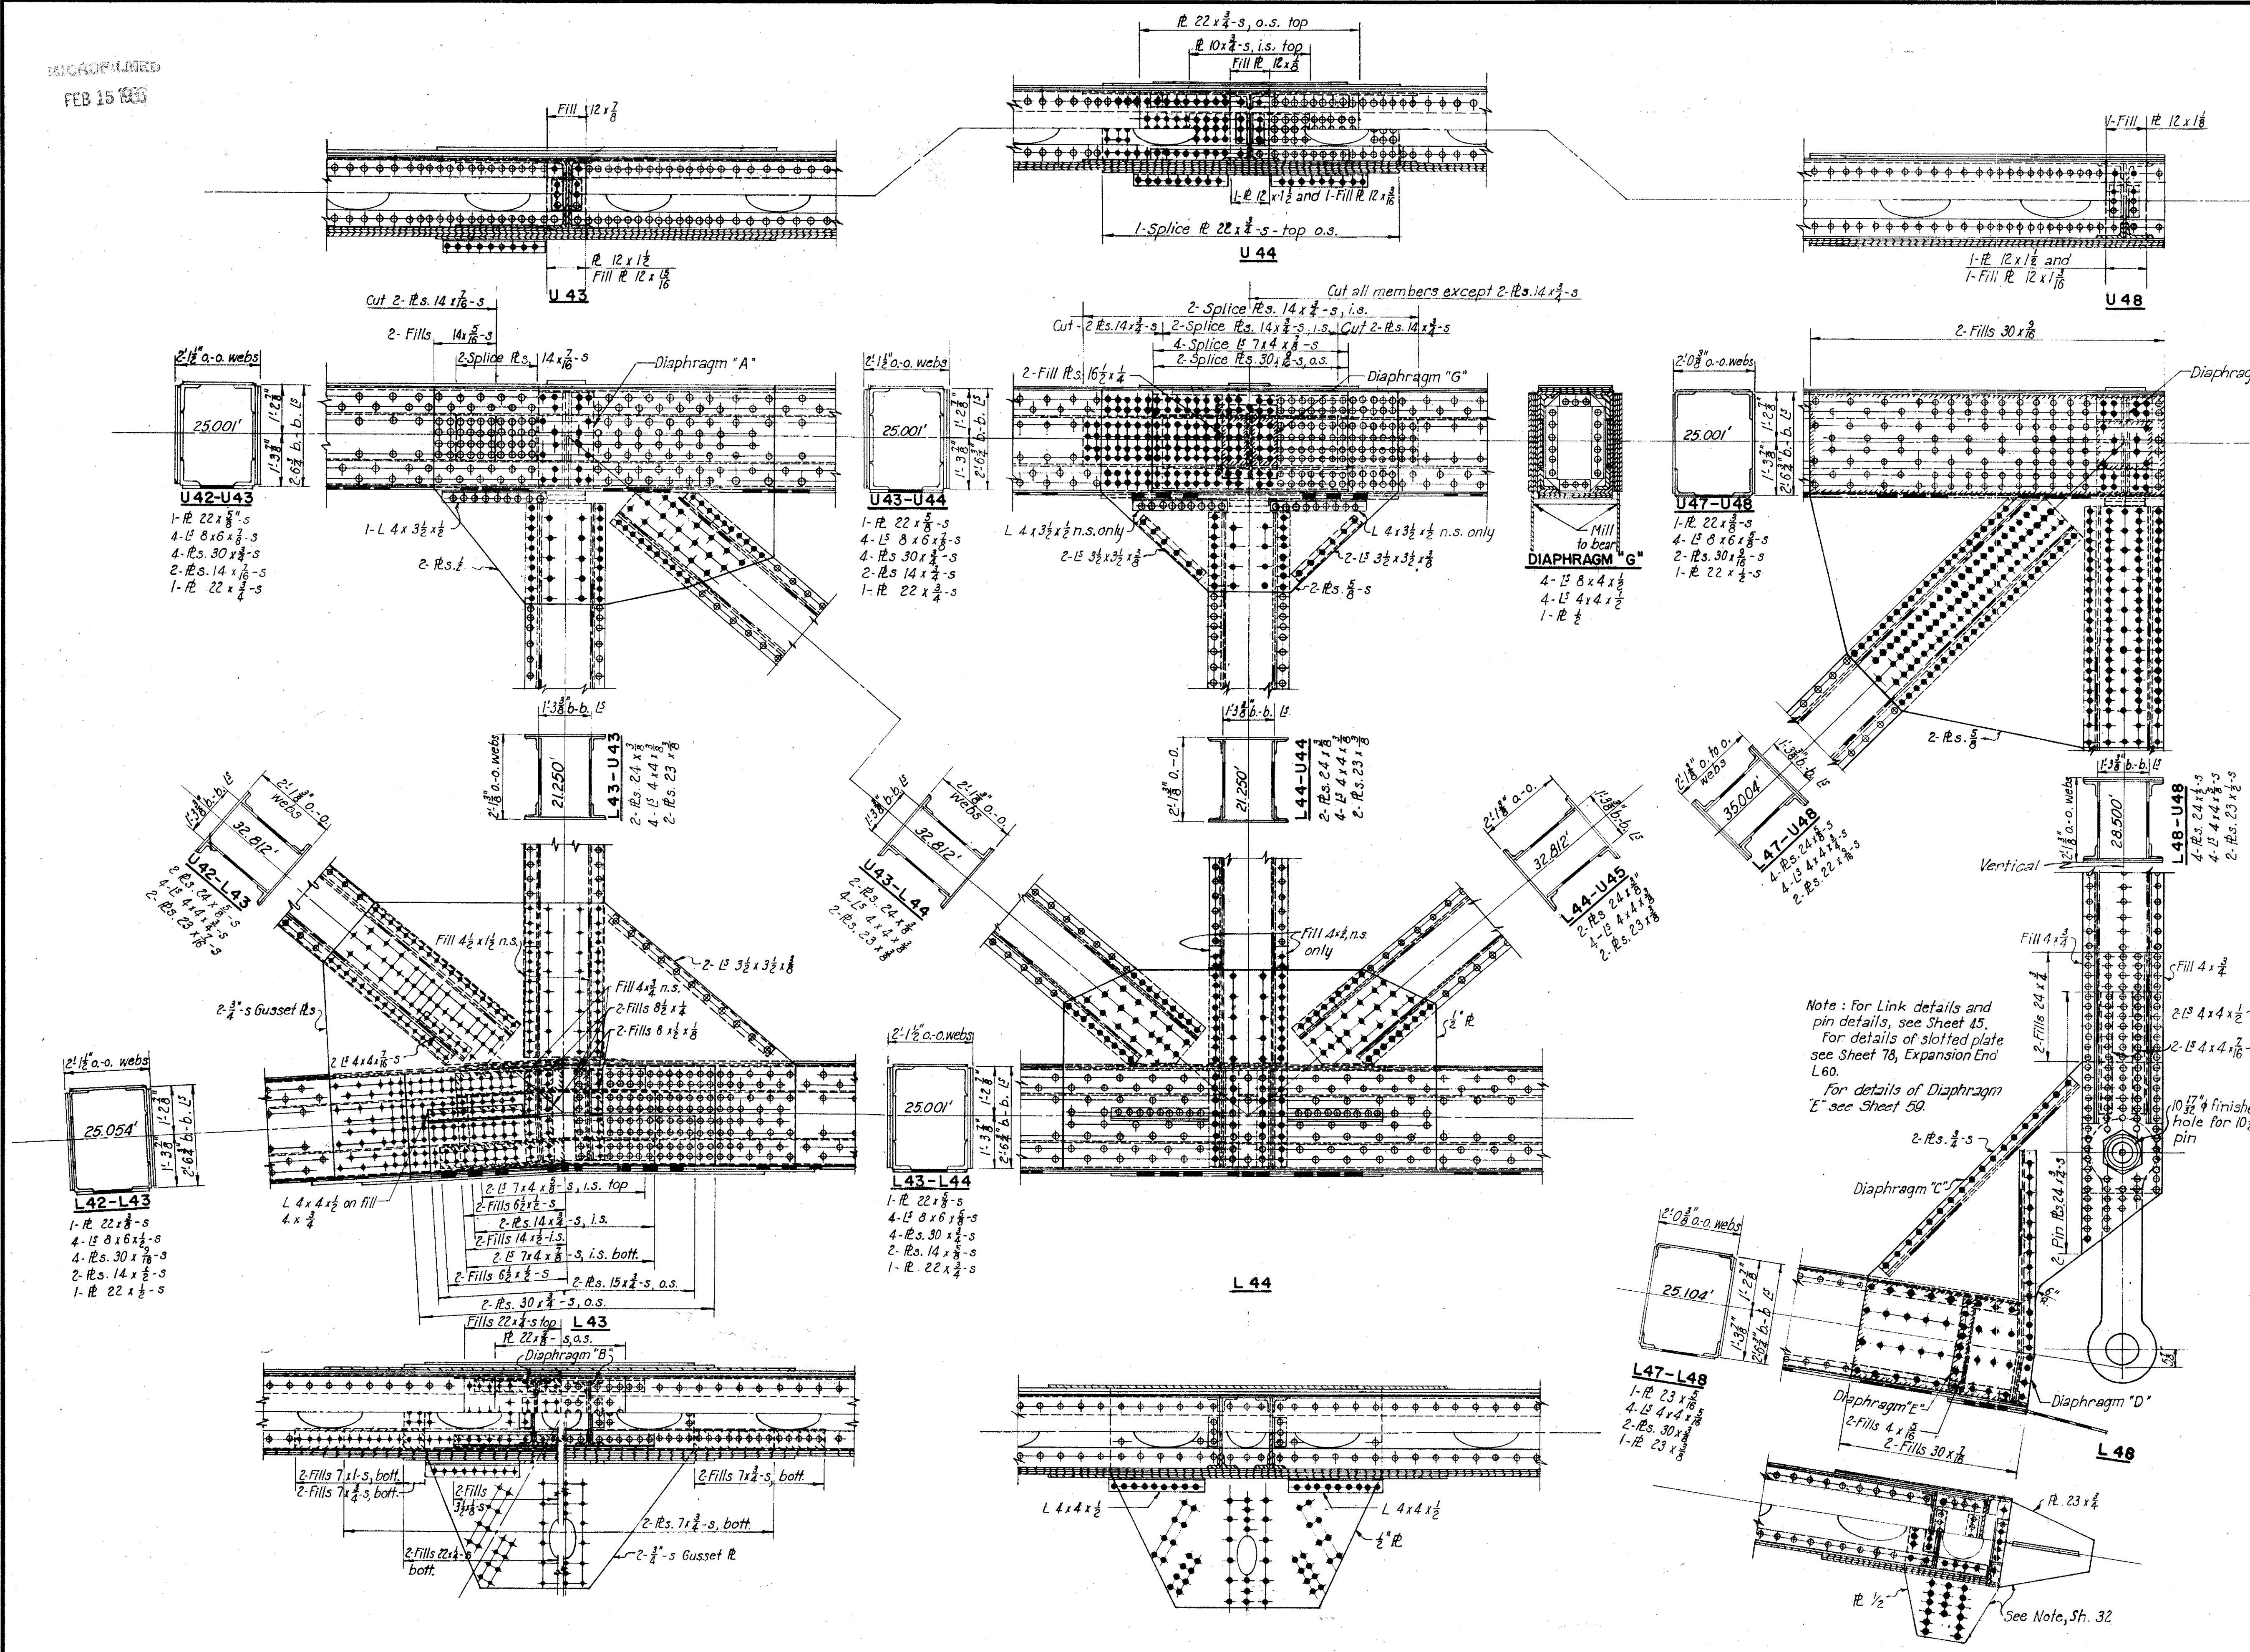


TENSION CHORD—SOUTH TRUSS								COMPRESSION CHORD— SOUTH TRUSS								LINE	MEMBER	TENSION CHORD- NORTH TRUSS								COMPRESSION CHORD— NORTH TRUSS							
L40 L41	L41 L42	L42 L43	L43 L44	L44 L45	L45 L46	L46 L47	L47 L48	U40 U41	U41 U42	U42 U43	U43 U44	U44 U45	U45 U46	U46 U47	U47 U48			L40 L41	L41 L42	L42 L43	L43 L44	L44 L45	L45 L46	L46 L47	L47 L48	U40 U41	U41 U42	U42 U43	U43 U44	U44 U45	U45 U46	U46 U47	U47 U48
0	+ 1015	+ 1865	+ 2509	+ 2509	+ 1865	+ 1015	0	- 1013	- 1861	- 2509	- 2681	- 2681	- 2509	- 1861	- 1013		0	+ 1101	+ 2028	+ 2729	+ 2729	+ 2028	+ 1101	0	- 1098	- 2023	- 2729	- 2916	- 2916	- 2729	- 2023	- 1098	
0	+ 812	+ 1492	+ 2007	+ 2007	+ 1492	+ 812	0	- 811	- 1489	- 2007	- 2145	- 2145	- 2007	- 1489	- 811		0	+ 881	+ 1623	+ 2183	+ 2183	+ 1623	+ 881	0	- 879	- 1619	- 2183	- 2333	- 2333	- 2183	- 1619	- 879	
0	+ 262	+ 470	+ 620	+ 620	+ 470	+ 262	0										0	+ 288	+ 518	+ 682	+ 682	+ 518	+ 288	0									
0								- 259	- 469	- 620	- 643	- 643	- 620	- 469	- 259		0	+ 478	+ 858	+ 1131	+ 1131	+ 858	+ 478	0	- 285	- 517	- 682	- 708	- 708	- 682	- 517	- 285	
0	+ 434	+ 780	+ 1027	+ 1027	+ 780	+ 434	0	- 430	- 779	- 1027	- 1066	- 1066	- 1027	- 779	- 430		0								- 473	- 856	- 1131	- 1173	- 1173	- 1131	- 856	- 473	
0	+ 11	+ 21	+ 29	+ 29	+ 21	+ 11	0	- 11	- 21	- 29	- 31	- 31	- 29	- 21	- 11		0	+ 13	+ 23	+ 31	+ 31	+ 23	+ 13	0	- 13	- 23	- 31	- 34	- 34	- 31	- 23	- 13	
0	+ 1257	+ 2293	+ 3063	+ 3063	+ 2293	+ 1257	0	- 1252	- 2289	- 3063	- 3242	- 3242	- 3063	- 2289	- 1252		0	+ 1372	+ 2504	+ 3345	+ 3345	+ 2504	+ 1372	0	- 1365	- 2498	- 3345	- 3540	- 3540	- 3345	- 2498	- 1365	


[illegible]

S = Special Steel
C = Carbon Steel
) = Handhole 11" Wide
) = Handhole 10" Wide


All dead and live load stresses
are in kips
Line 29, - Net area for tension or
effective gross area for compression.

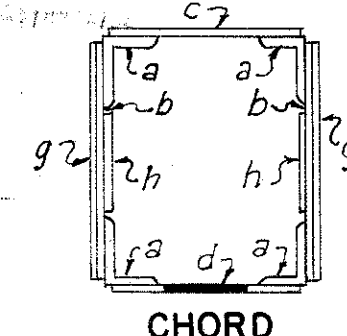

CHORD

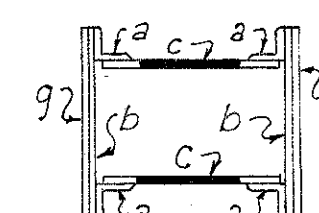

WEB MEMBER

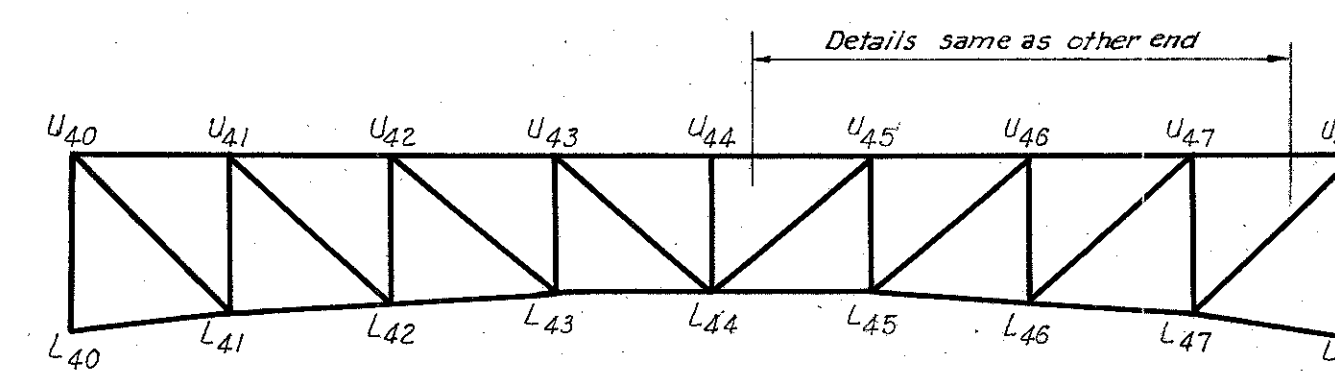

For truss dimensions see Framing Plan, Sh. 2.

PART 3

U. S. ROUTE 42 RELOCATION
INNER BELT FREEWAY - CENTRAL VIADUCT
BR. NO. CU - 42R-175

STRESS SHEET UNIT 4
NORTH AND SOUTH TRUSSES

CLEVELAND CUYAHOGA COUNTY OHIO

SCALE None
MADE D.M.E. DATE 5-7-54
C.S.K.
TRCD 7-16-54 DATE 8-24-54
CKD F.L. DATE 9-28-54

HOWARD, NEEDLES, TAMMEN & BERGENDOFF
CONSULTING ENGINEERS
KANSAS CITY CLEVELAND NEW YORK
914-1A SHEET- 2-58

FED. ROAD DIV. NO.	STATE	FEDERAL AID PROJECT NO.	TYPE FUNDS
2	OHIO		

57

122

PART 3

U. S. ROUTE 42 RELOCATION


INNER BELT FREEWAY - CENTRAL VIADUCT

BR. NO. CU - 42 R-17 5

TRUSS DETAILS, UNIT 3 SOUTH
PANELS 302, 301 AND 300.

CLEVELAND	GUYAHOGA COUNTY	OHIO
-----------	-----------------	------


SCALE: $\frac{1}{8"} = 1'-0"$	HOWARD, NEEDLES, TAMMEN & BERGENDOFF	
MADE. <u>J.G.S.</u> DATE. <u>10-18-54</u>	CONSULTING ENGINEERS	
TRCD. <u>H.S.</u> DATE. <u>11-2-54</u>	KANSAS CITY	CLEVELAND
CKD. <u>J.G.S.</u> DATE. <u>11-4-54</u>	914-1A	SHEET- 2.57

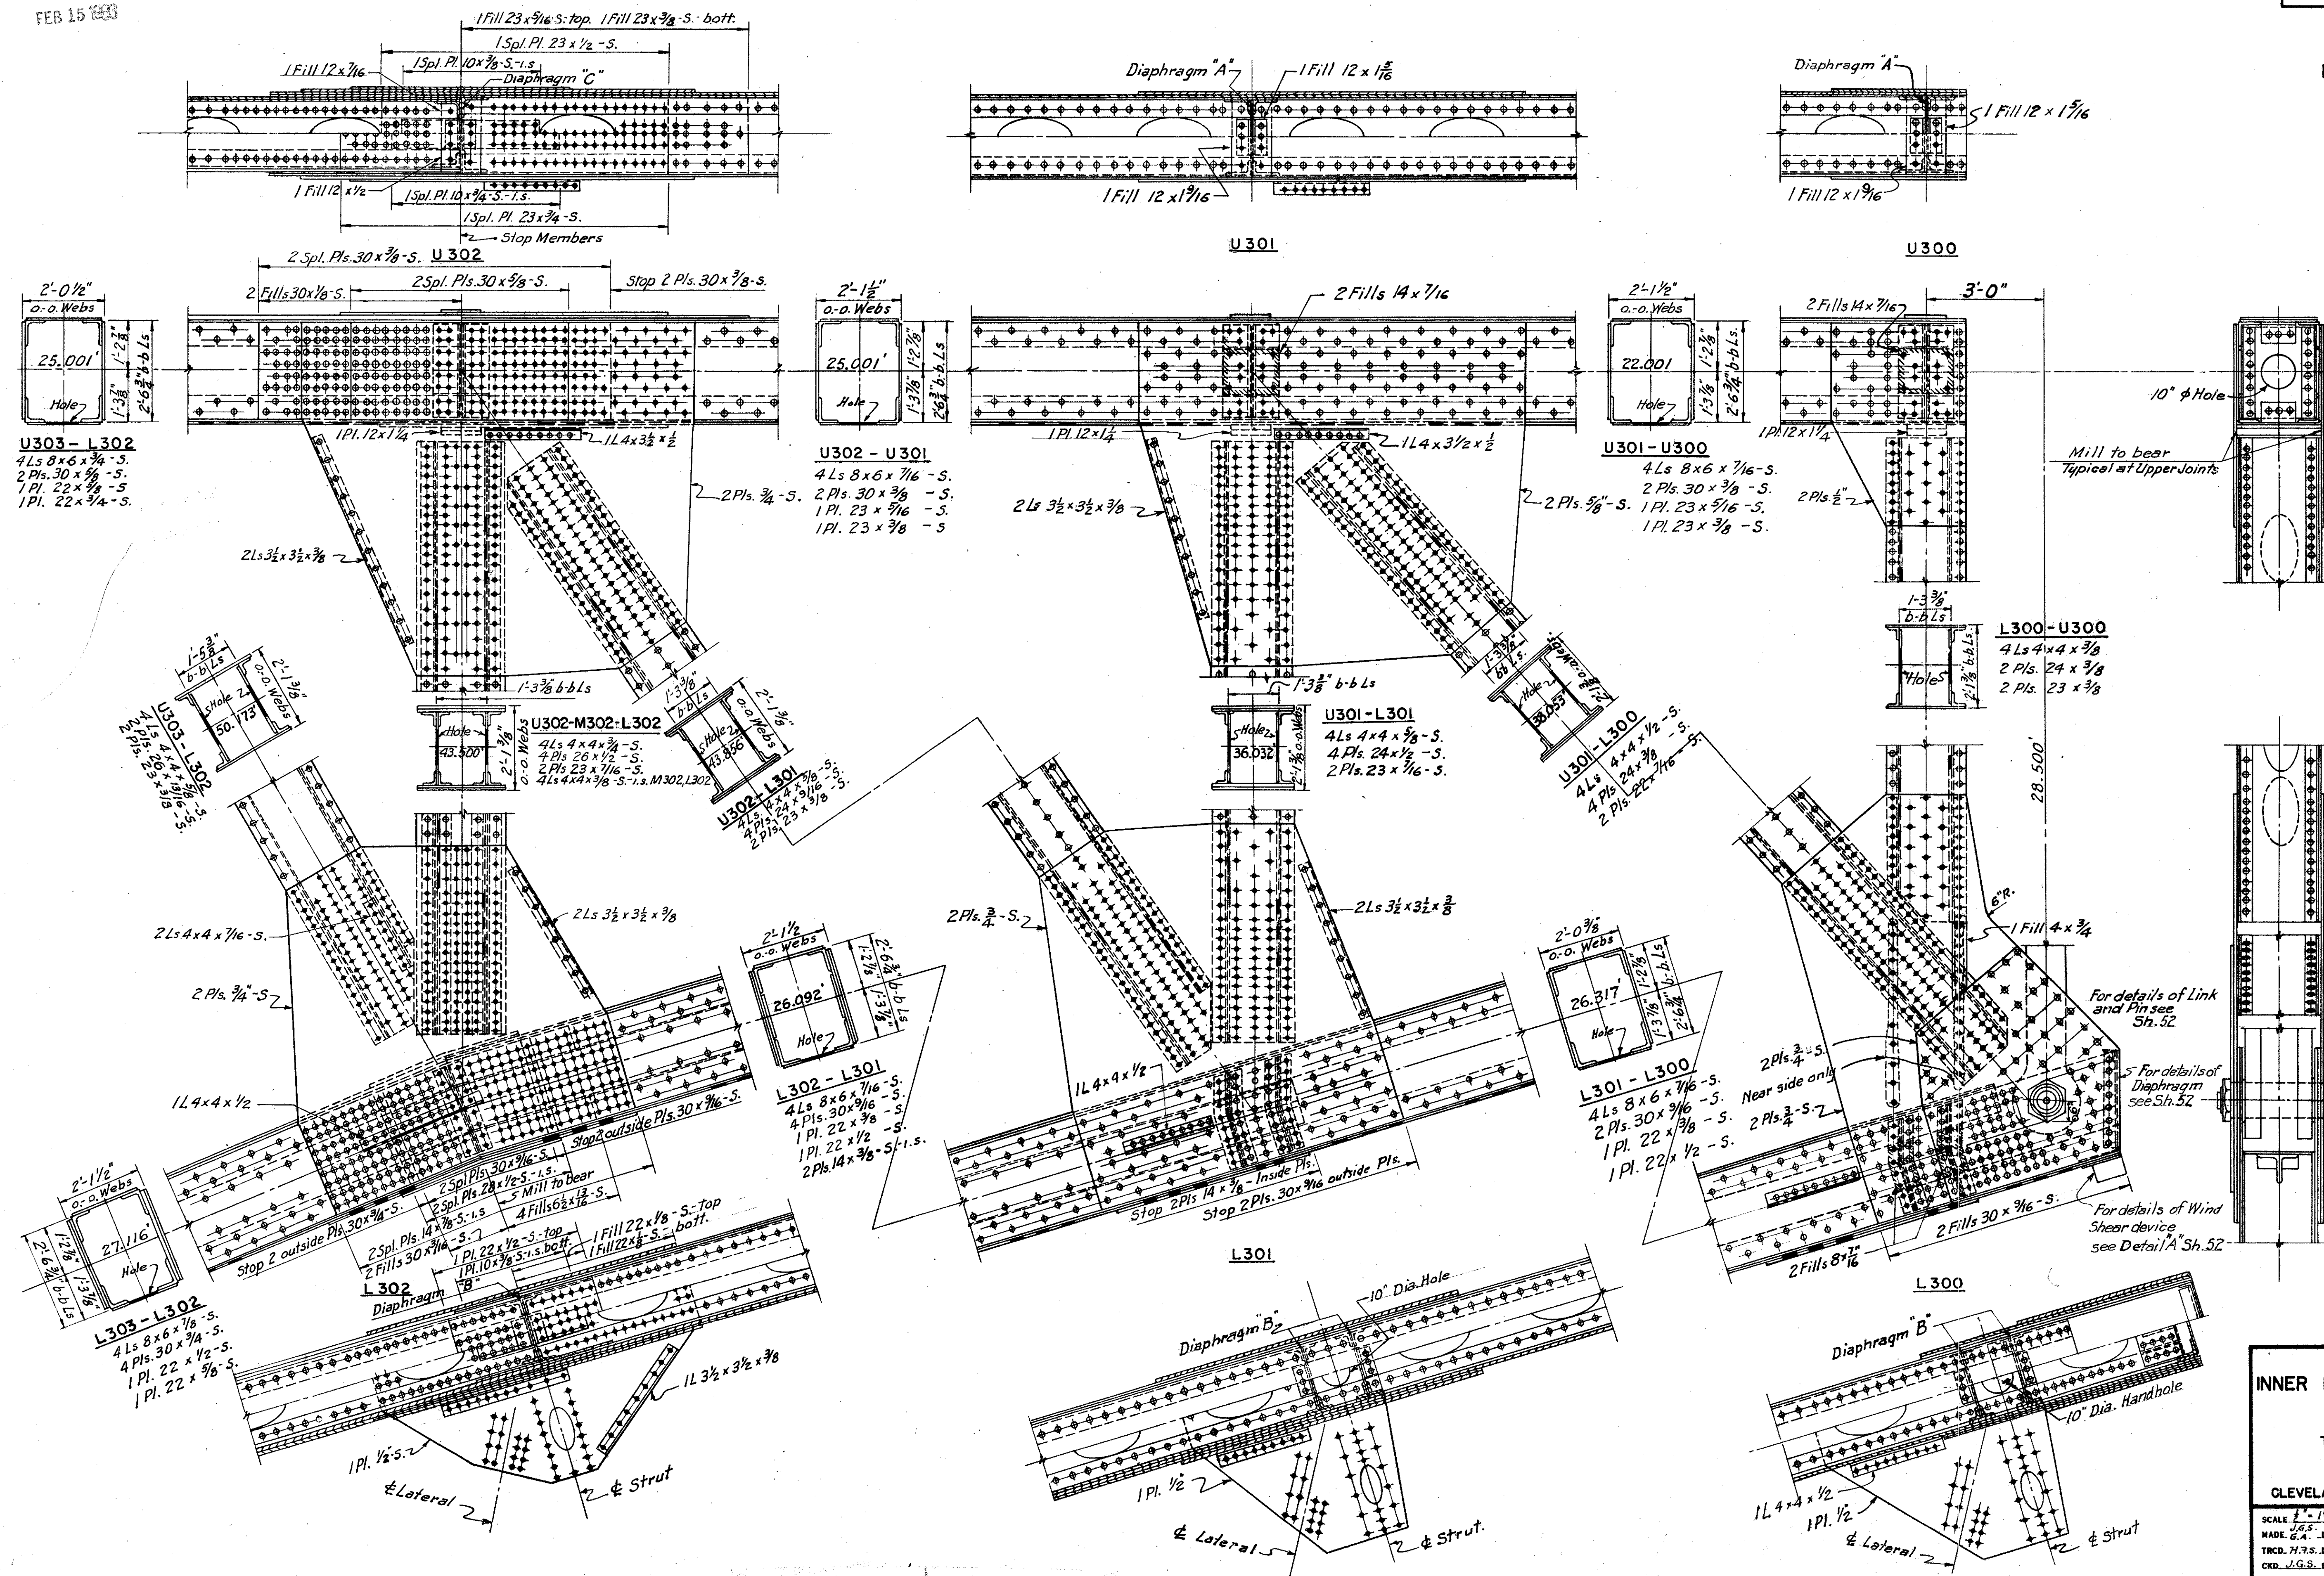


RECEIVED
FEB 15 1954

FED. ROAD DIV. NO.	STATE	FEDERAL AID PROJECT NO.	TYPE FUNDS	56 122
2	OHIO			


CUYAHOGA COUNTY
CITY OF CLEVELAND
INNER BELT FREEWAY
CENTRAL VIADUCT

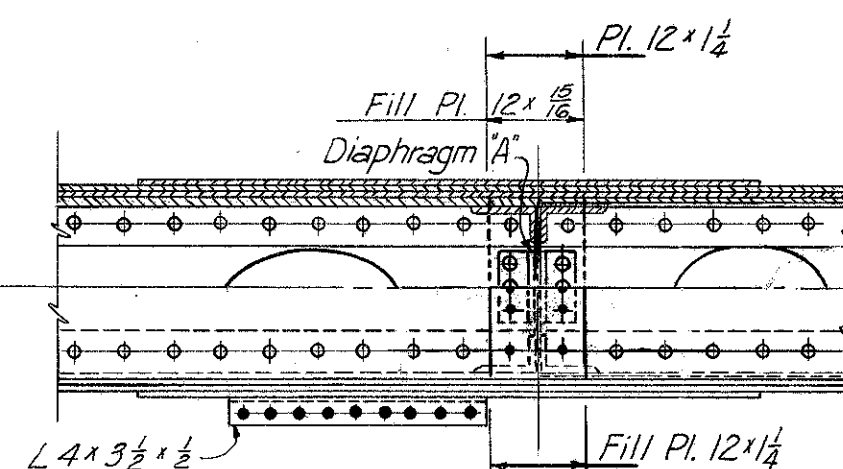

U305

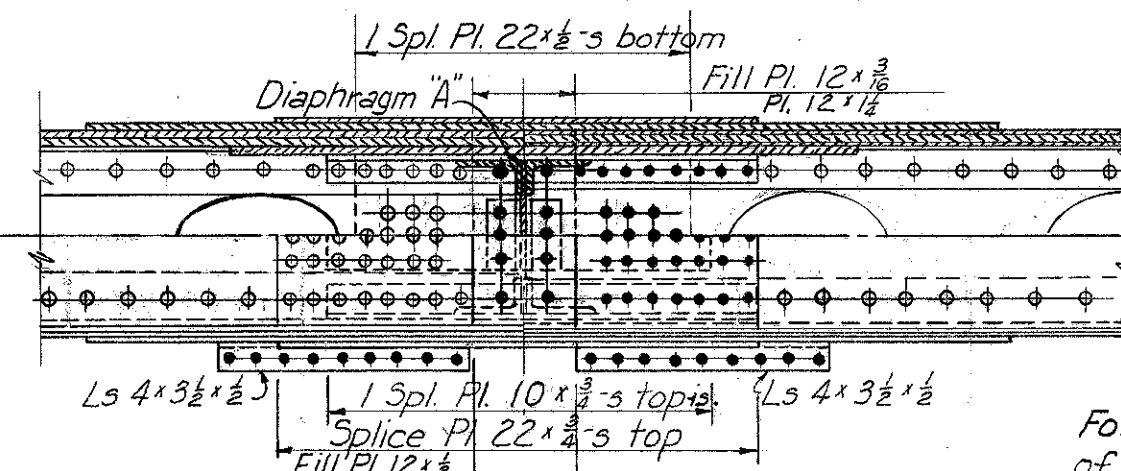


U304

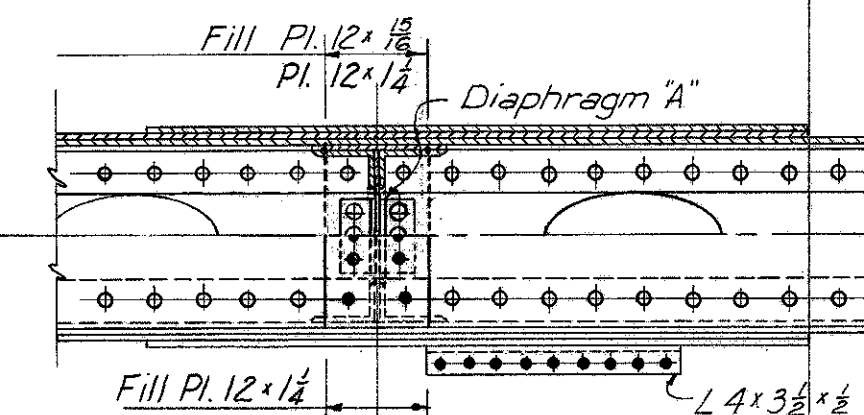


U303

For details and connections
of ladder and access walk-
way, see Sh. 101.

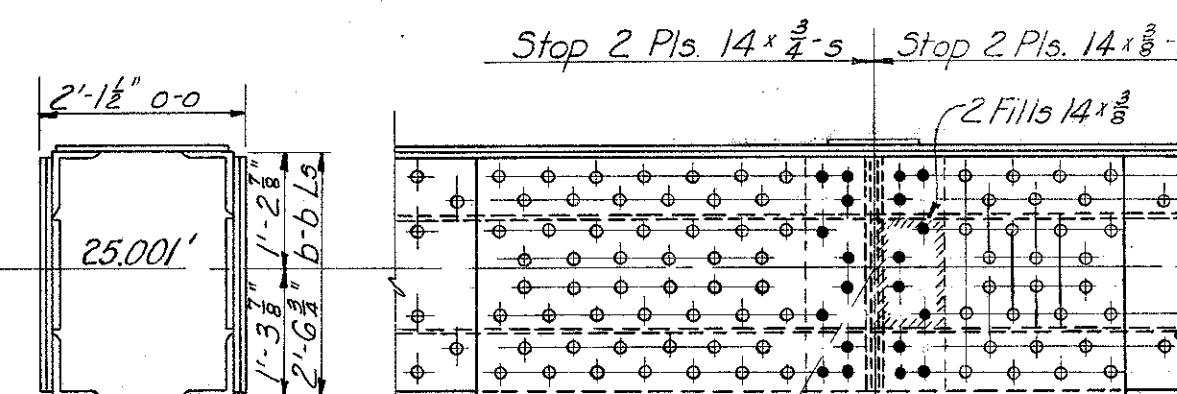


U306-U305

Pl. 22 $\frac{1}{2}$ x 5
4-Ls 8 $\frac{1}{2}$ x 6 $\frac{1}{2}$ x 5
4-Pls. 30 $\frac{1}{2}$ x 5
2-Pls. 14 $\frac{1}{2}$ x 5
Pl. 22 $\frac{1}{2}$ x 5
2-Ls 3 $\frac{1}{2}$ x 3 $\frac{1}{2}$ x 5
2-Clip Ls 4 $\frac{1}{2}$ x 5

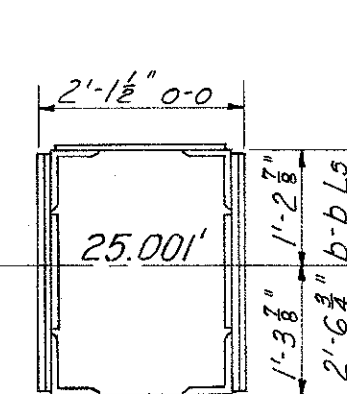


U305-U304

Pl. 22 $\frac{1}{2}$ x 5
4-Ls 8 $\frac{1}{2}$ x 6 $\frac{1}{2}$ x 5
4-Pls. 30 $\frac{1}{2}$ x 5
2-Pls. 14 $\frac{1}{2}$ x 5
Pl. 22 $\frac{1}{2}$ x 5

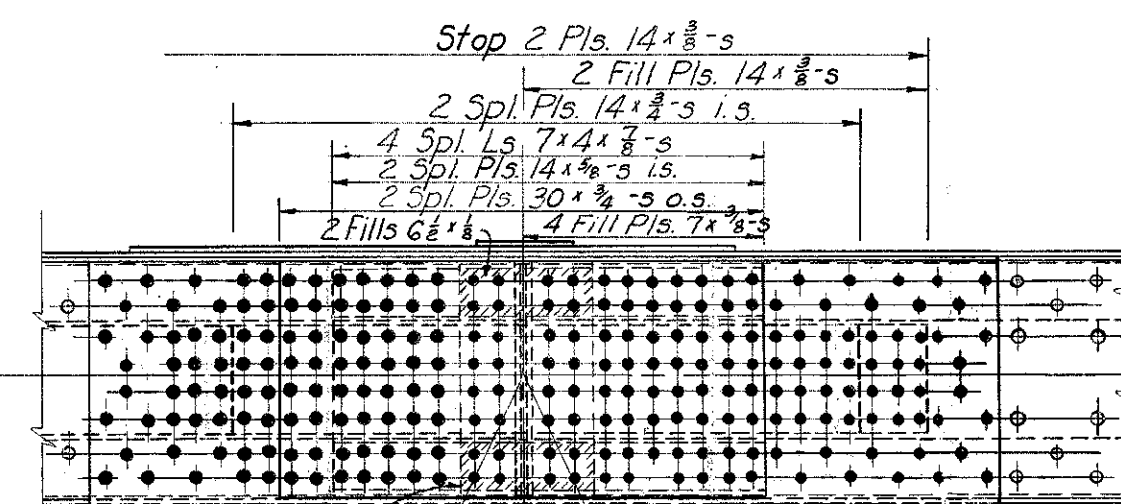


U304-U303

Pl. 22 $\frac{1}{2}$ x 5
4-Ls 8 $\frac{1}{2}$ x 6 $\frac{1}{2}$ x 5
2-Pls. 30 $\frac{1}{2}$ x 5
2-Pls. 30 $\frac{1}{2}$ x 5
Pl. 22 $\frac{1}{2}$ x 5

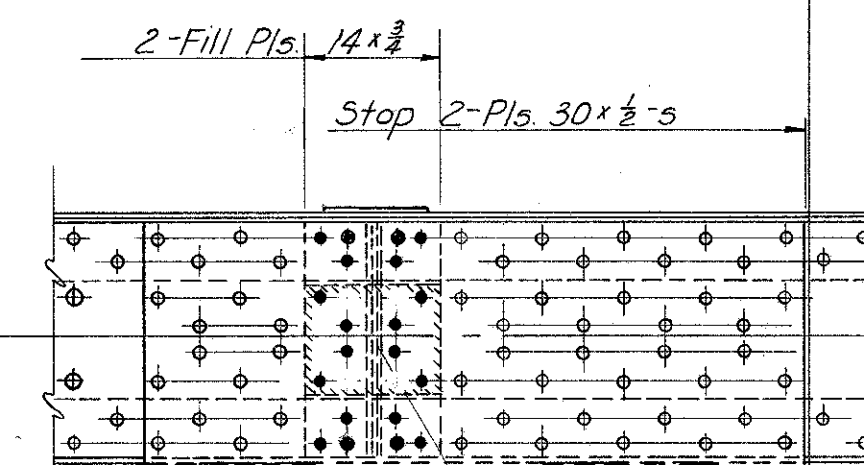


U303-U302

Pl. 22 $\frac{1}{2}$ x 5
4-Ls 8 $\frac{1}{2}$ x 6 $\frac{1}{2}$ x 5
2-Pls. 30 $\frac{1}{2}$ x 5
Pl. 22 $\frac{1}{2}$ x 5
2-Pls. 30 $\frac{1}{2}$ x 5
2-Clip Ls 4 $\frac{1}{2}$ x 5

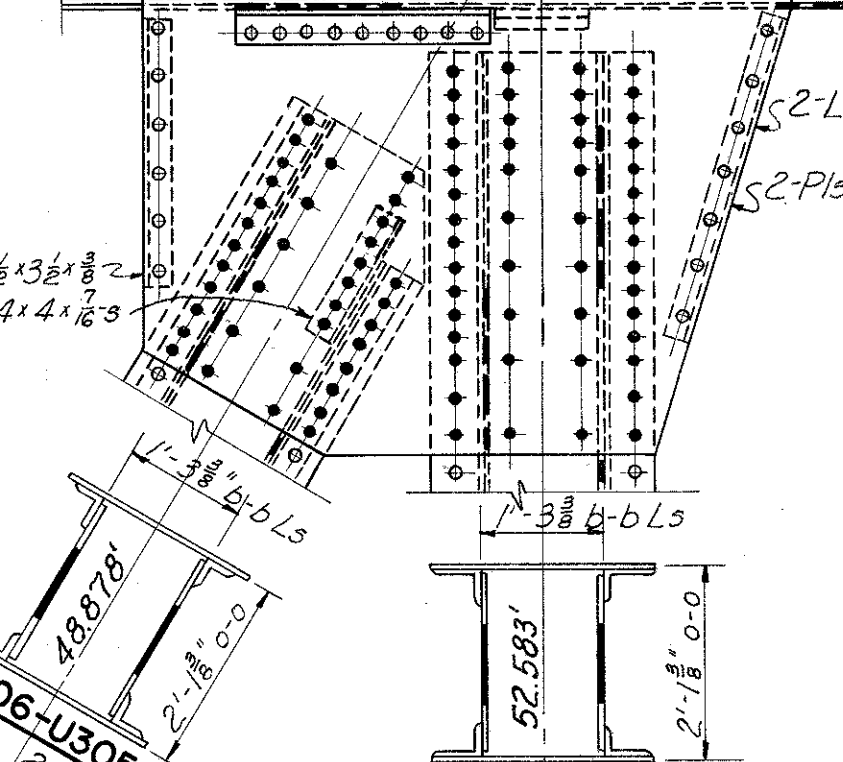


L306-U305

2-Pls. 23 $\frac{1}{2}$ x 5
4-Ls 6 $\frac{1}{2}$ x 4 $\frac{1}{2}$ x 5
2-Pls. 28 $\frac{1}{2}$ x 5

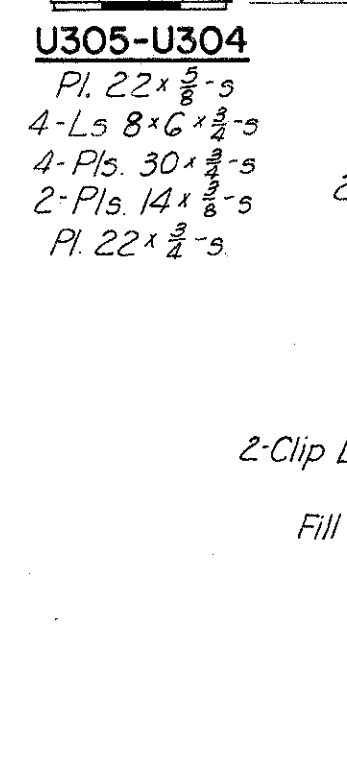


L305-U304

2-Pls. 23 $\frac{1}{2}$ x 5
4-Ls 6 $\frac{1}{2}$ x 4 $\frac{1}{2}$ x 5
2-Pls. 28 $\frac{1}{2}$ x 5

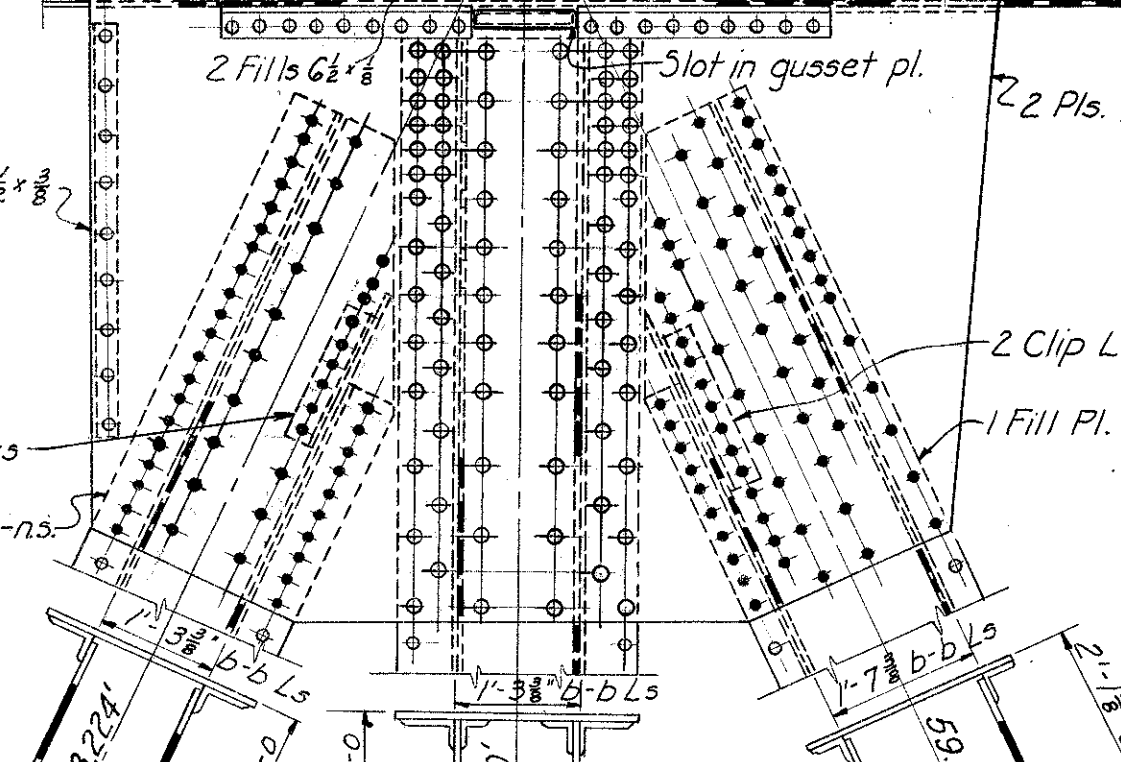


U304-M304-L304

2-Pls. 30 $\frac{1}{2}$ x 5
4-Ls 7 $\frac{1}{2}$ x 4 $\frac{1}{2}$ x 5
2-Pls. 23 $\frac{1}{2}$ x 5
Add 4-Ls 4 $\frac{1}{2}$ x 5 below M₄

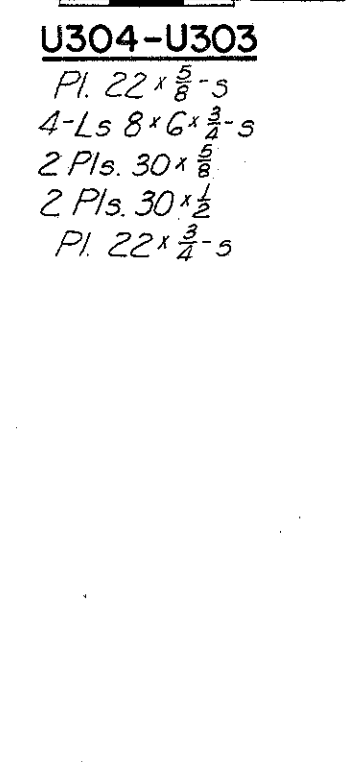


U304-L303

2-Pls. 24 $\frac{1}{2}$ x 5
4-Ls 4 $\frac{1}{2}$ x 4 $\frac{1}{2}$ x 5
2-Pls. 28 $\frac{1}{2}$ x 5

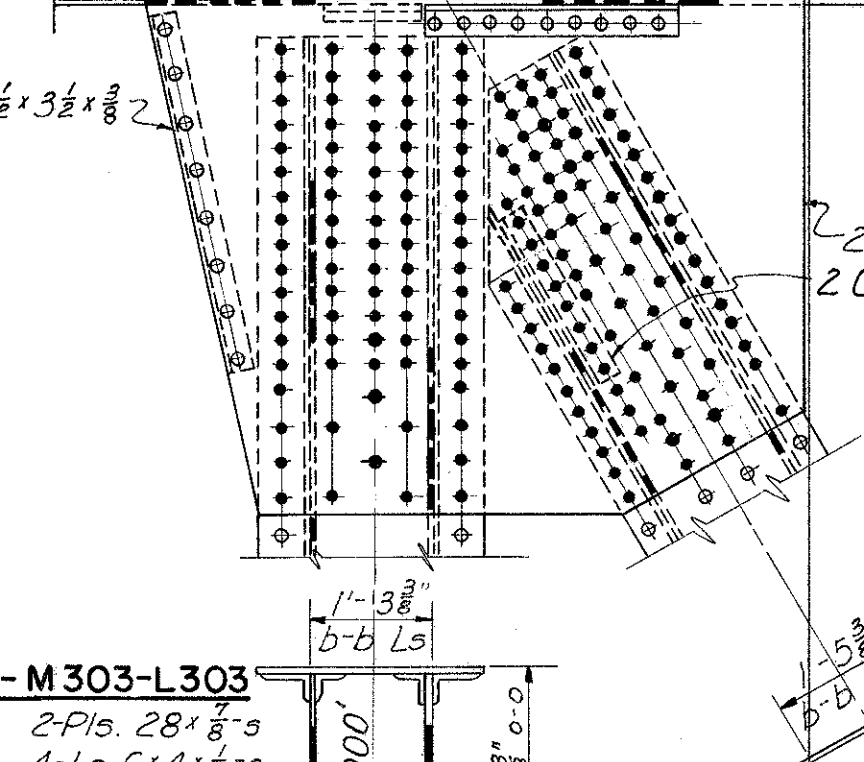


U303-M303-L303

2-Pls. 28 $\frac{1}{2}$ x 5
4-Ls 6 $\frac{1}{2}$ x 4 $\frac{1}{2}$ x 5
2-Pls. 23 $\frac{1}{2}$ x 5
4-Ls 4 $\frac{1}{2}$ x 4 $\frac{1}{2}$ x 5
(Add below M₃)

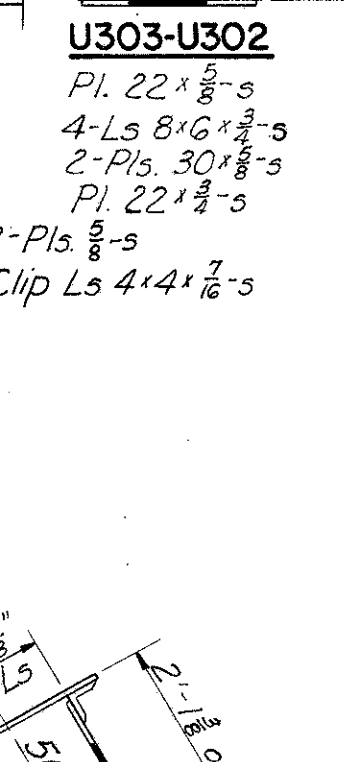


U303-L302

2-Pls. 23 $\frac{1}{2}$ x 5
4-Ls 4 $\frac{1}{2}$ x 4 $\frac{1}{2}$ x 5
2-Pls. 26 $\frac{1}{2}$ x 5

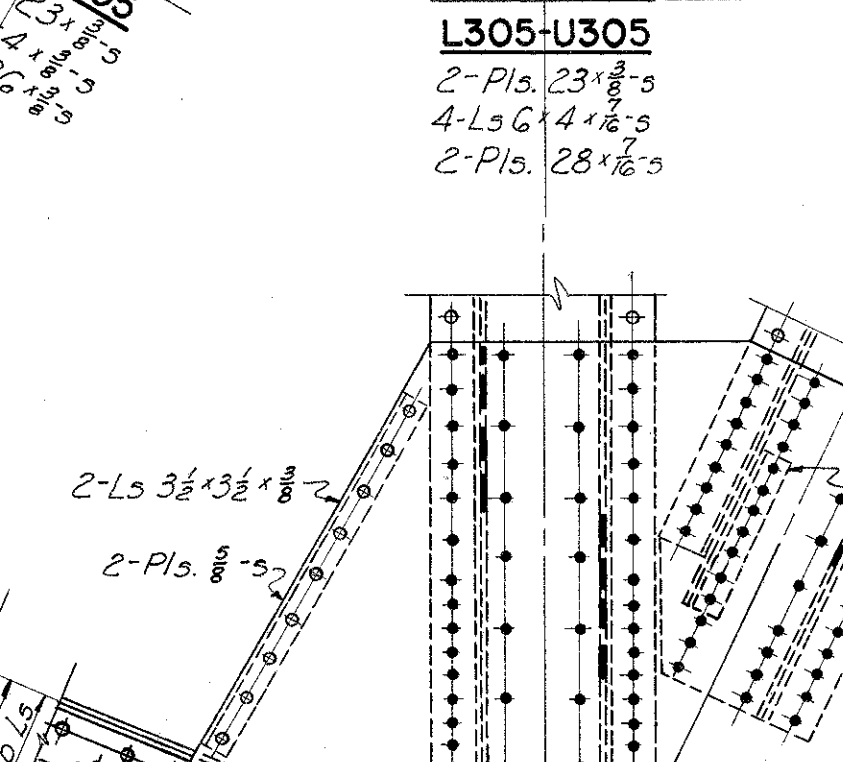


L306-L305

Pl. 22 $\frac{1}{2}$ x 5
4-Ls 8 $\frac{1}{2}$ x 6 $\frac{1}{2}$ x 5
4-Pls. 30 $\frac{1}{2}$ x 5
2-Pls. 14 $\frac{1}{2}$ x 5
Pl. 22 $\frac{1}{2}$ x 5

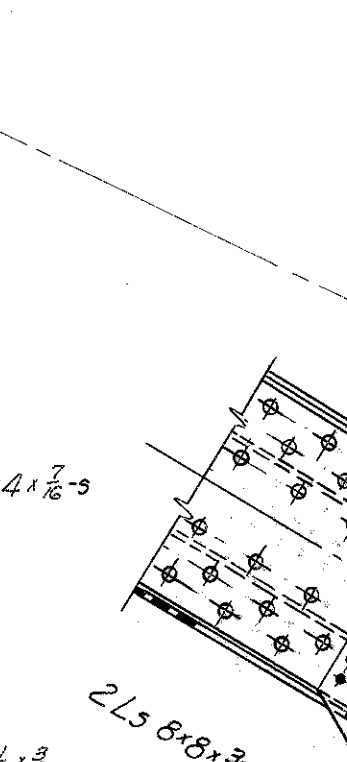


L305-L304

Pl. 22 $\frac{1}{2}$ x 5
4-Ls 8 $\frac{1}{2}$ x 6 $\frac{1}{2}$ x 5
4-Pls. 30 $\frac{1}{2}$ x 5
2-Pls. 14 $\frac{1}{2}$ x 5
Pl. 22 $\frac{1}{2}$ x 5

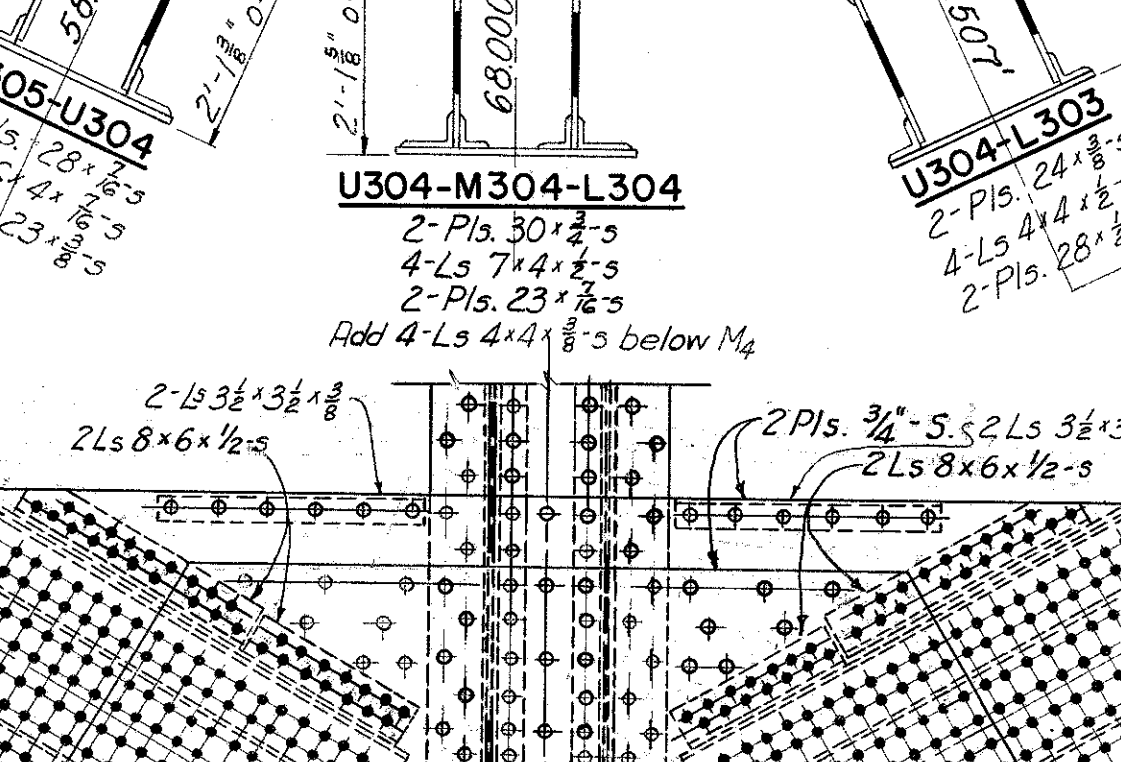


L304

23 $\frac{1}{2}$ x 5 bolts
1L 7 $\frac{1}{2}$ x 4 $\frac{1}{2}$ top
2L 4 $\frac{1}{2}$ x 4 $\frac{1}{2}$ bot

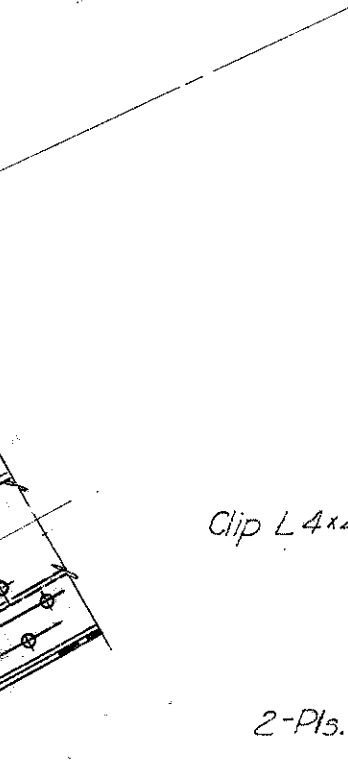


L304-L303

Pl. 22 $\frac{1}{2}$ x 5
4-Ls 8 $\frac{1}{2}$ x 6 $\frac{1}{2}$ x 5
4-Pls. 30 $\frac{1}{2}$ x 5
2-Pls. 14 $\frac{1}{2}$ x 5
Pl. 22 $\frac{1}{2}$ x 5

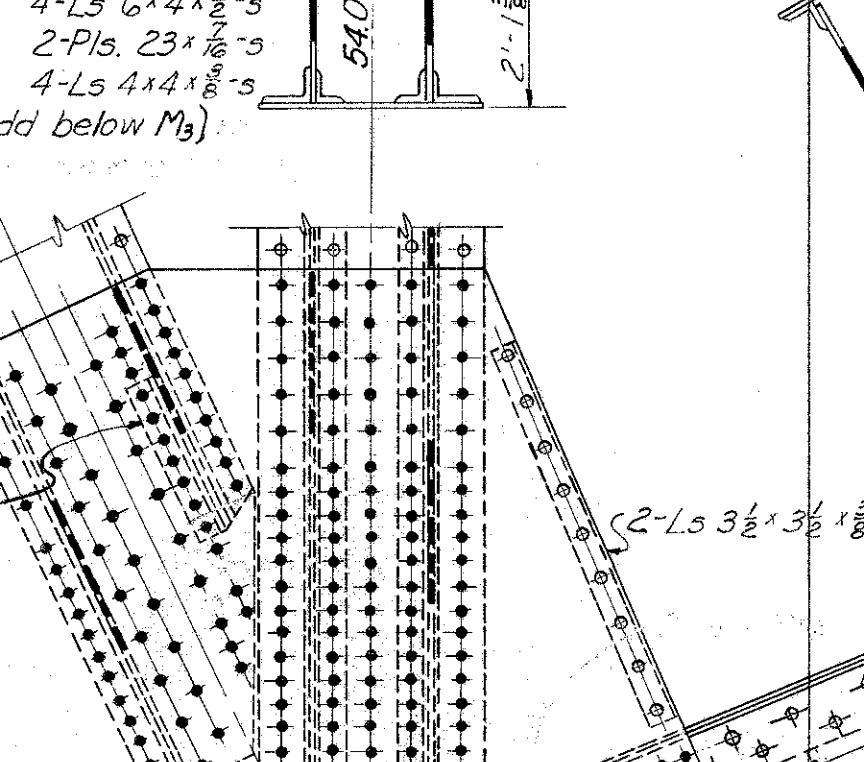


L303

2-Pls. 15 $\frac{1}{2}$ x 5 bot
2-Pls. 15 $\frac{1}{2}$ x 5 top
2-Pls. 15 $\frac{1}{2}$ x 5 top & bot
2-Pls. 15 $\frac{1}{2}$ x 5 top & bot

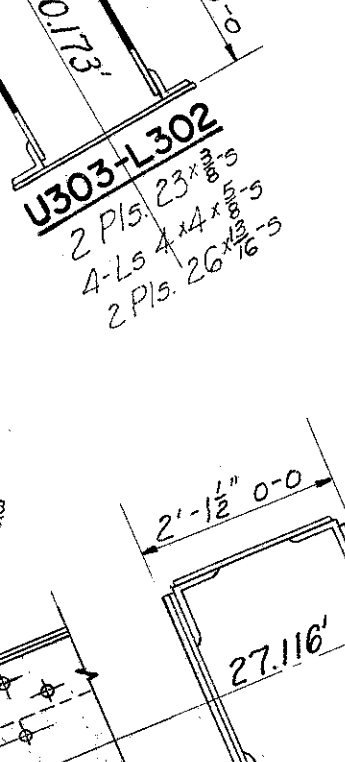


L303-L302

Pl. 22 $\frac{1}{2}$ x 5
4-Ls 8 $\frac{1}{2}$ x 6 $\frac{1}{2}$ x 5
4-Pls. 30 $\frac{1}{2}$ x 5
Pl. 22 $\frac{1}{2}$ x 5

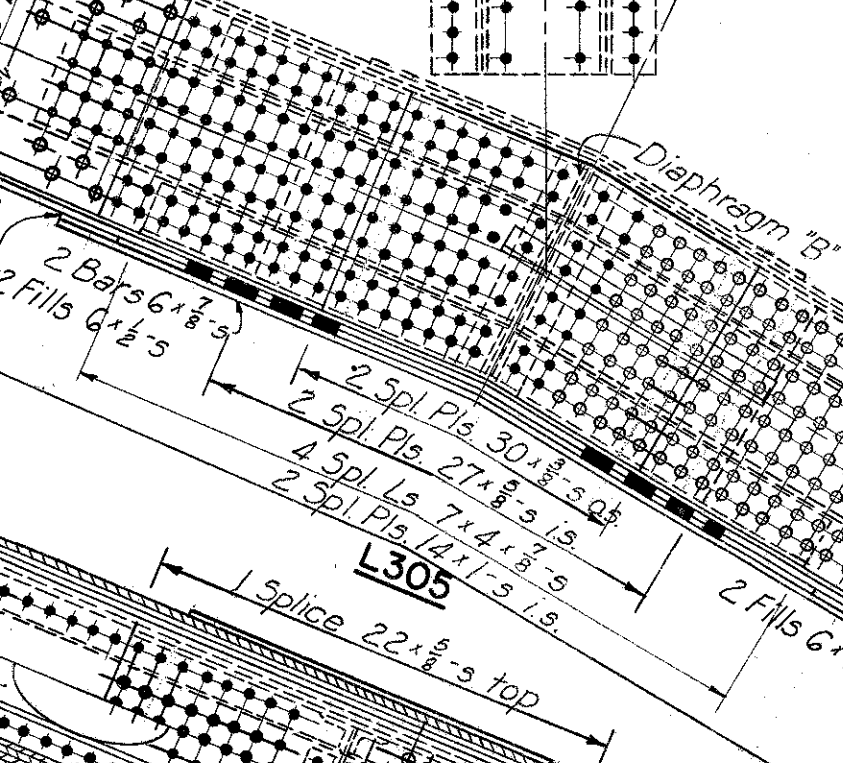


L305

2-Pls. 15 $\frac{1}{2}$ x 5 bot
2-Pls. 15 $\frac{1}{2}$ x 5 top
2-Pls. 15 $\frac{1}{2}$ x 5 top & bot
2-Pls. 15 $\frac{1}{2}$ x 5 top & bot

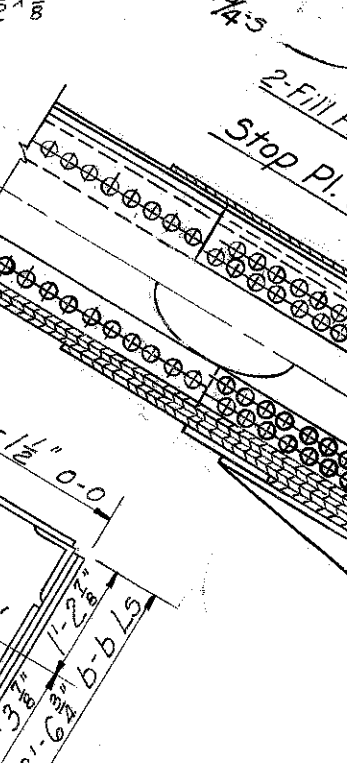


L304

2-Pls. 15 $\frac{1}{2}$ x 5 bot
2-Pls. 15 $\frac{1}{2}$ x 5 top
2-Pls. 15 $\frac{1}{2}$ x 5 top & bot
2-Pls. 15 $\frac{1}{2}$ x 5 top & bot

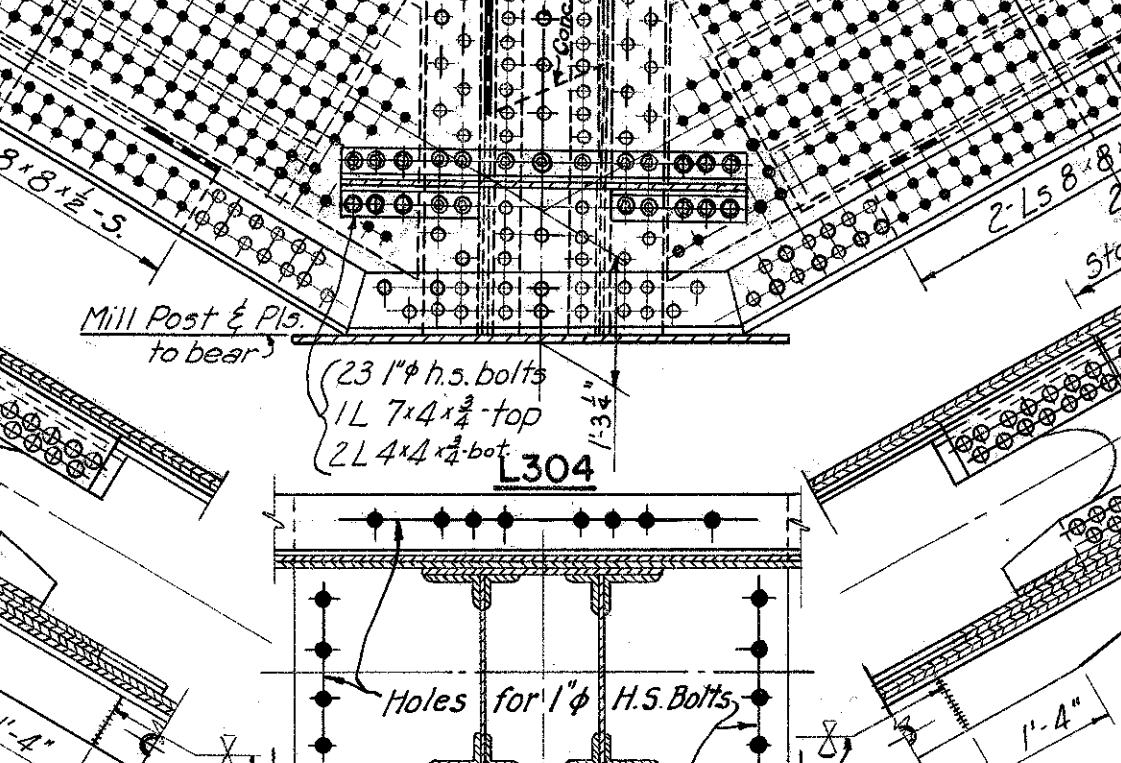


L304

2-Pls. 15 $\frac{1}{2}$ x 5 bot
2-Pls. 15 $\frac{1}{2}$ x 5 top
2-Pls. 15 $\frac{1}{2}$ x 5 top & bot
2-Pls. 15 $\frac{1}{2}$ x 5 top & bot

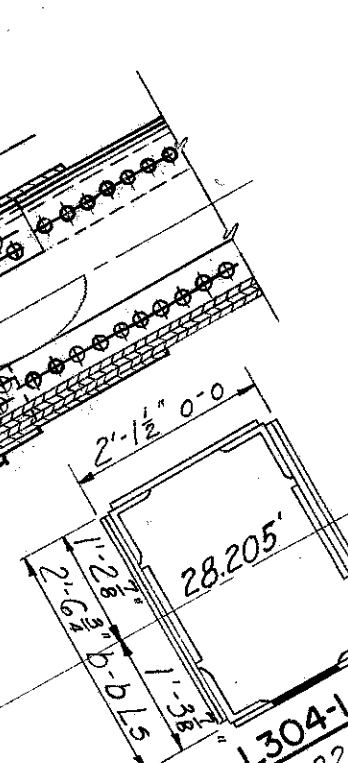


L304-L303

Pl. 22 $\frac{1}{2}$ x 5
4-Ls 8 $\frac{1}{2}$ x 6 $\frac{1}{2}$ x 5
4-Pls. 30 $\frac{1}{2}$ x 5
2-Pls. 14 $\frac{1}{2}$ x 5
Pl. 22 $\frac{1}{2}$ x 5

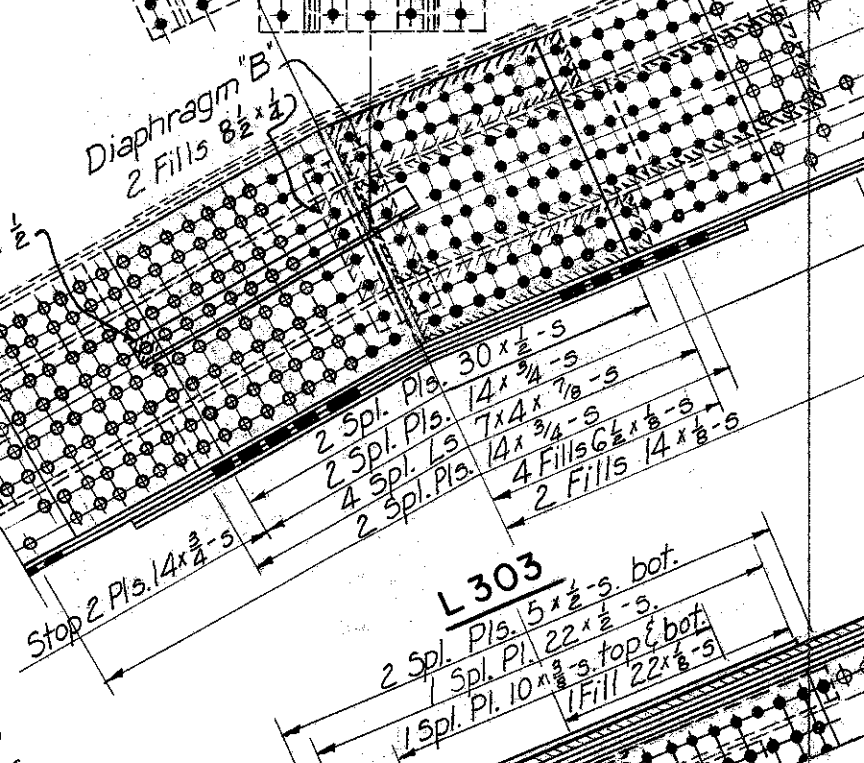


L303

2-Pls. 15 $\frac{1}{2}$ x 5 bot
2-Pls. 15 $\frac{1}{2}$ x 5 top
2-Pls. 15 $\frac{1}{2}$ x 5 top & bot
2-Pls. 15 $\frac{1}{2}$ x 5 top & bot

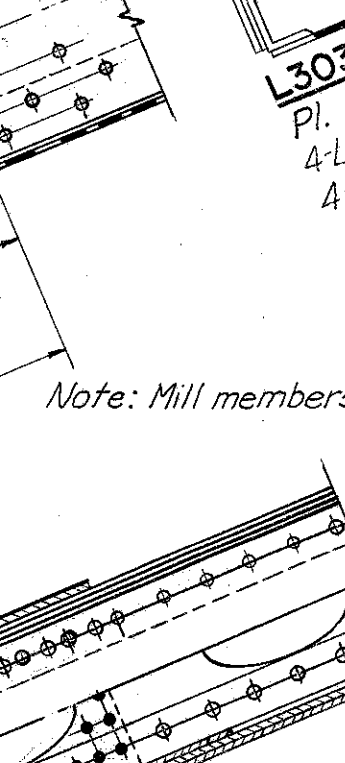


L303-L302

Pl. 22 $\frac{1}{2}$ x 5
4-Ls 8 $\frac{1}{2}$ x 6 $\frac{1}{2}$ x 5
4-Pls. 30 $\frac{1}{2}$ x 5
Pl. 22 $\frac{1}{2}$ x 5

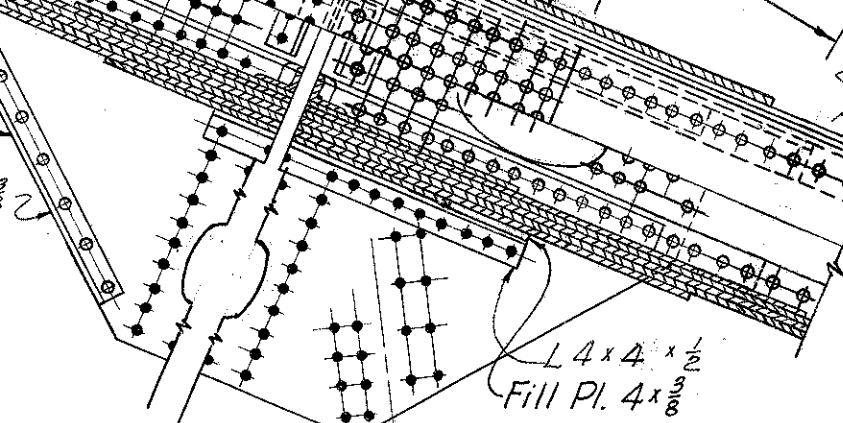


L305

2-Pls. 15 $\frac{1}{2}$ x 5 bot
2-Pls. 15 $\frac{1}{2}$ x 5 top
2-Pls. 15 $\frac{1}{2}$ x 5 top & bot
2-Pls. 15 $\frac{1}{2}$ x 5 top & bot

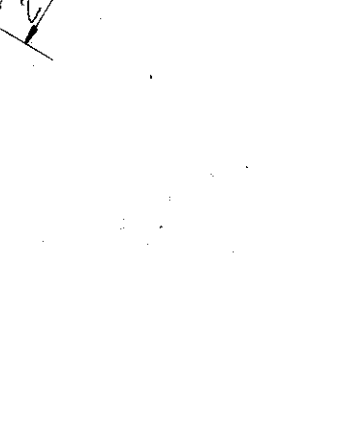


L304

2-Pls. 15 $\frac{1}{2}$ x 5 bot
2-Pls. 15 $\frac{1}{2}$ x 5 top
2-Pls. 15 $\frac{1}{2}$ x 5 top & bot
2-Pls. 15 $\frac{1}{2}$ x 5 top & bot

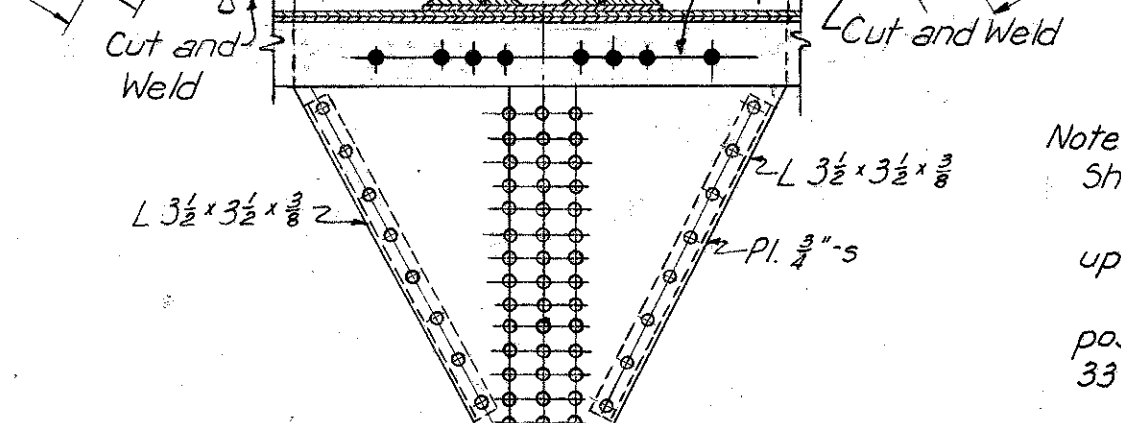


L304

2-Pls. 15 $\frac{1}{2}$ x 5 bot
2-Pls. 15 $\frac{1}{2}$ x 5 top
2-Pls. 15 $\frac{1}{2}$ x 5 top & bot
2-Pls. 15 $\frac{1}{2}$ x 5 top & bot

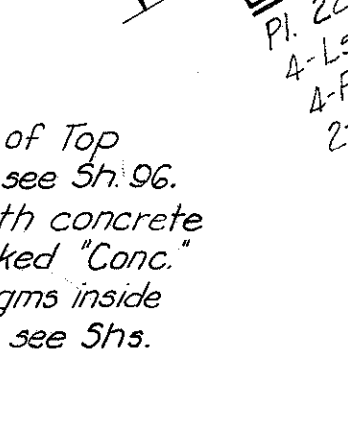


L304-L303

Pl. 22 $\frac{1}{2}$ x 5
4-Ls 8 $\frac{1}{2}$ x 6 $\frac{1}{2}$ x 5
4-Pls. 30 $\frac{1}{2}$ x 5
2-Pls. 14 $\frac{1}{2}$ x 5
Pl. 22 $\frac{1}{2}$ x 5

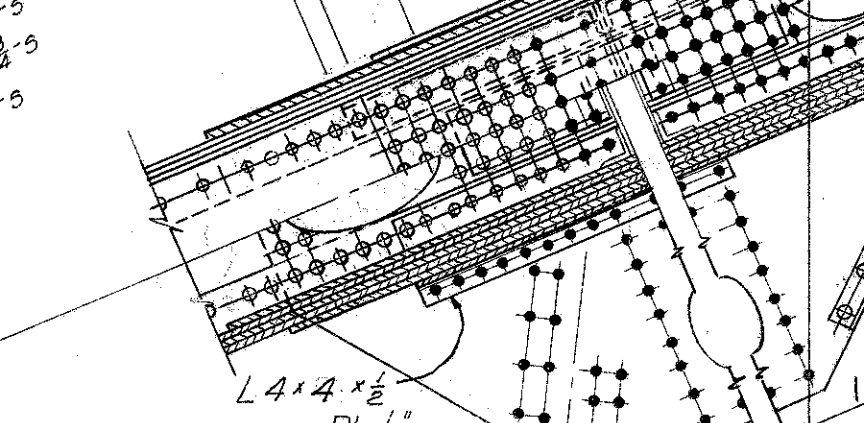

L303

2-Pls. 15 $\frac{1}{2}$ x 5 bot
2-Pls. 15 $\frac{1}{2}$ x 5 top
2-Pls. 15 $\frac{1}{2}$ x 5 top & bot
2-Pls. 15 $\frac{1}{2}$ x 5 top & bot

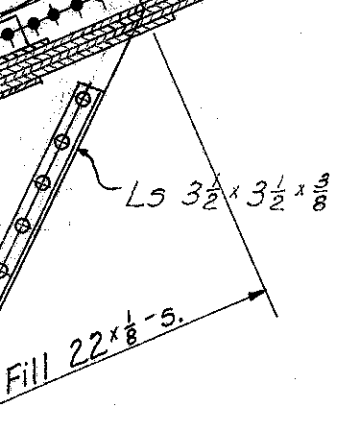

L303-L302

Pl. 22 $\frac{1}{2}$ x 5
4-Ls 8 $\frac{1}{2}$ x 6 $\frac{1}{2}$ x 5
4-Pls. 30 $\frac{1}{2}$ x 5
Pl. 22 $\frac{1}{2}$ x 5

Note: For details of Top
Shoe Casting, see Sh. 96.
Fill post with concrete
up to line marked "Conc."
For Diaphragms inside
post at L304 see Shs.
33 and 34.

Note: For details of Diaphragms
"A" and "B", see Sh. 57.

Note: Mill members to bear.

Note: Mill members to bear.

PART 3

U. S. ROUTE 42 RELOCATION			
INNER BELT FREEWAY - CENTRAL VIADUCT			
BR. NO. CU - 42R-17 5			
TRUSS DETAILS, UNIT 3 SOUTH			
PANELS 305, 304 AND 303			
CLEVELAND	CUYAHOGA COUNTY	OHIO	
SCALE: 1" = 1'-0"			
MADE: 3-11-54 DATE: 6-20-54			
TRCD: N.A.M. DATE: 7-27-54			
CKD: L.G.S. DATE: 11-4-54			
HOWARD, NEEDLES, TAMMEN & BERGENDOFF			
CONSULTING ENGINEERS			
KANSAS CITY CLEVELAND NEW YORK			
914-1A SHEET 2.56			


MICROFILMED
FEB 15 1983

FED. ROAD DIV. NO.	STATE	FEDERAL AID PROJECT NO.	TYPE FUNDS
2	OHIO		

55

122

CUYAHOGA COUNTY
CITY OF CLEVELAND
INNER BELT FREEWAY
CENTRAL VIADUCT

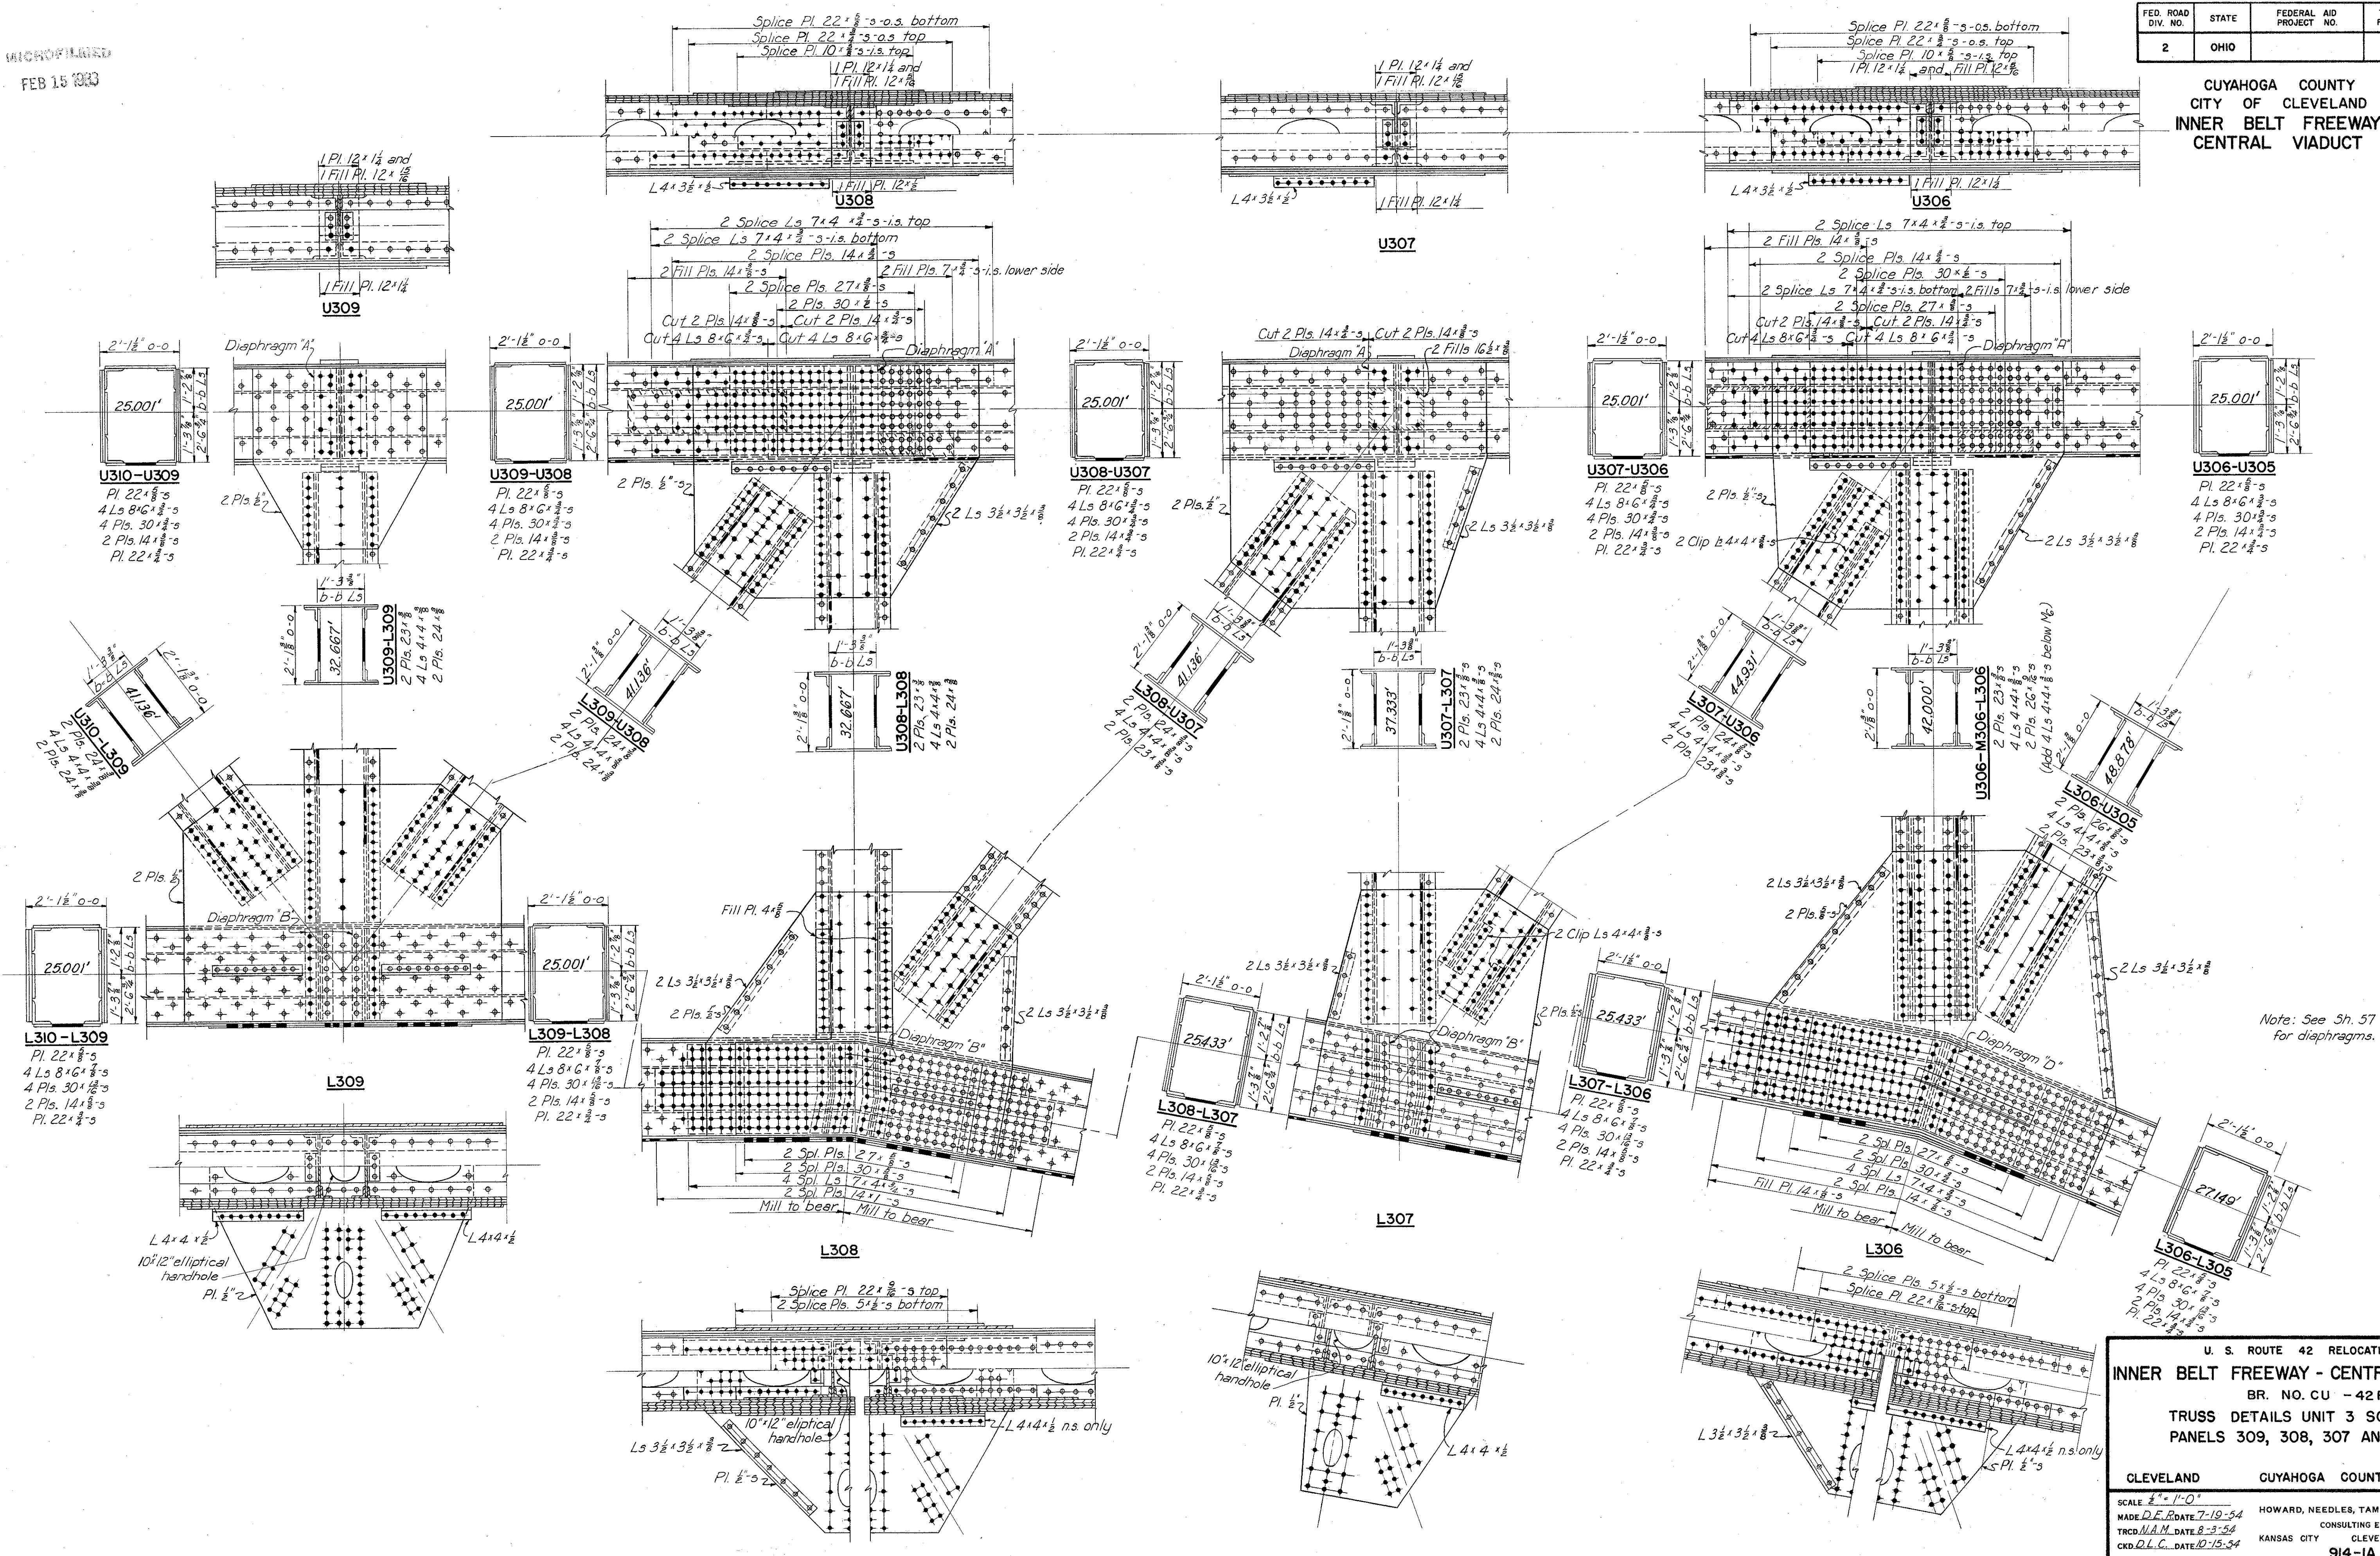

U. S. ROUTE 42 RELOCATION
INNER BELT FREEWAY - CENTRAL VIADUCT
BR. NO. CU - 42R-17 5
TRUSS DETAILS UNIT 3 SOUTH
PANELS 309, 308, 307 AND 306

CLEVELAND GUYAHOGA COUNTY OHIO

SCALE 3/4" = 1'-0"
MADE D.E. ROATE 7-19-54
TRCD N.A.M. DATE 8-3-54
CKD D.L.C. DATE 10-15-54


HOWARD, NEEDLES, TAMMEN & BERGENDOFF
CONSULTING ENGINEERS
KANSAS CITY CLEVELAND NEW YORK

914-1A SHEET 2.55

UNDESIGNED
FEB 15 1959

FED. ROAD DIV. NO.	STATE	FEDERAL AID PROJECT NO.	TYPE FUNDS	54 122
2	OHIO			


CUYAHOGA COUNTY
CITY OF CLEVELAND
INNER BELT FREEWAY
CENTRAL VIADUCT

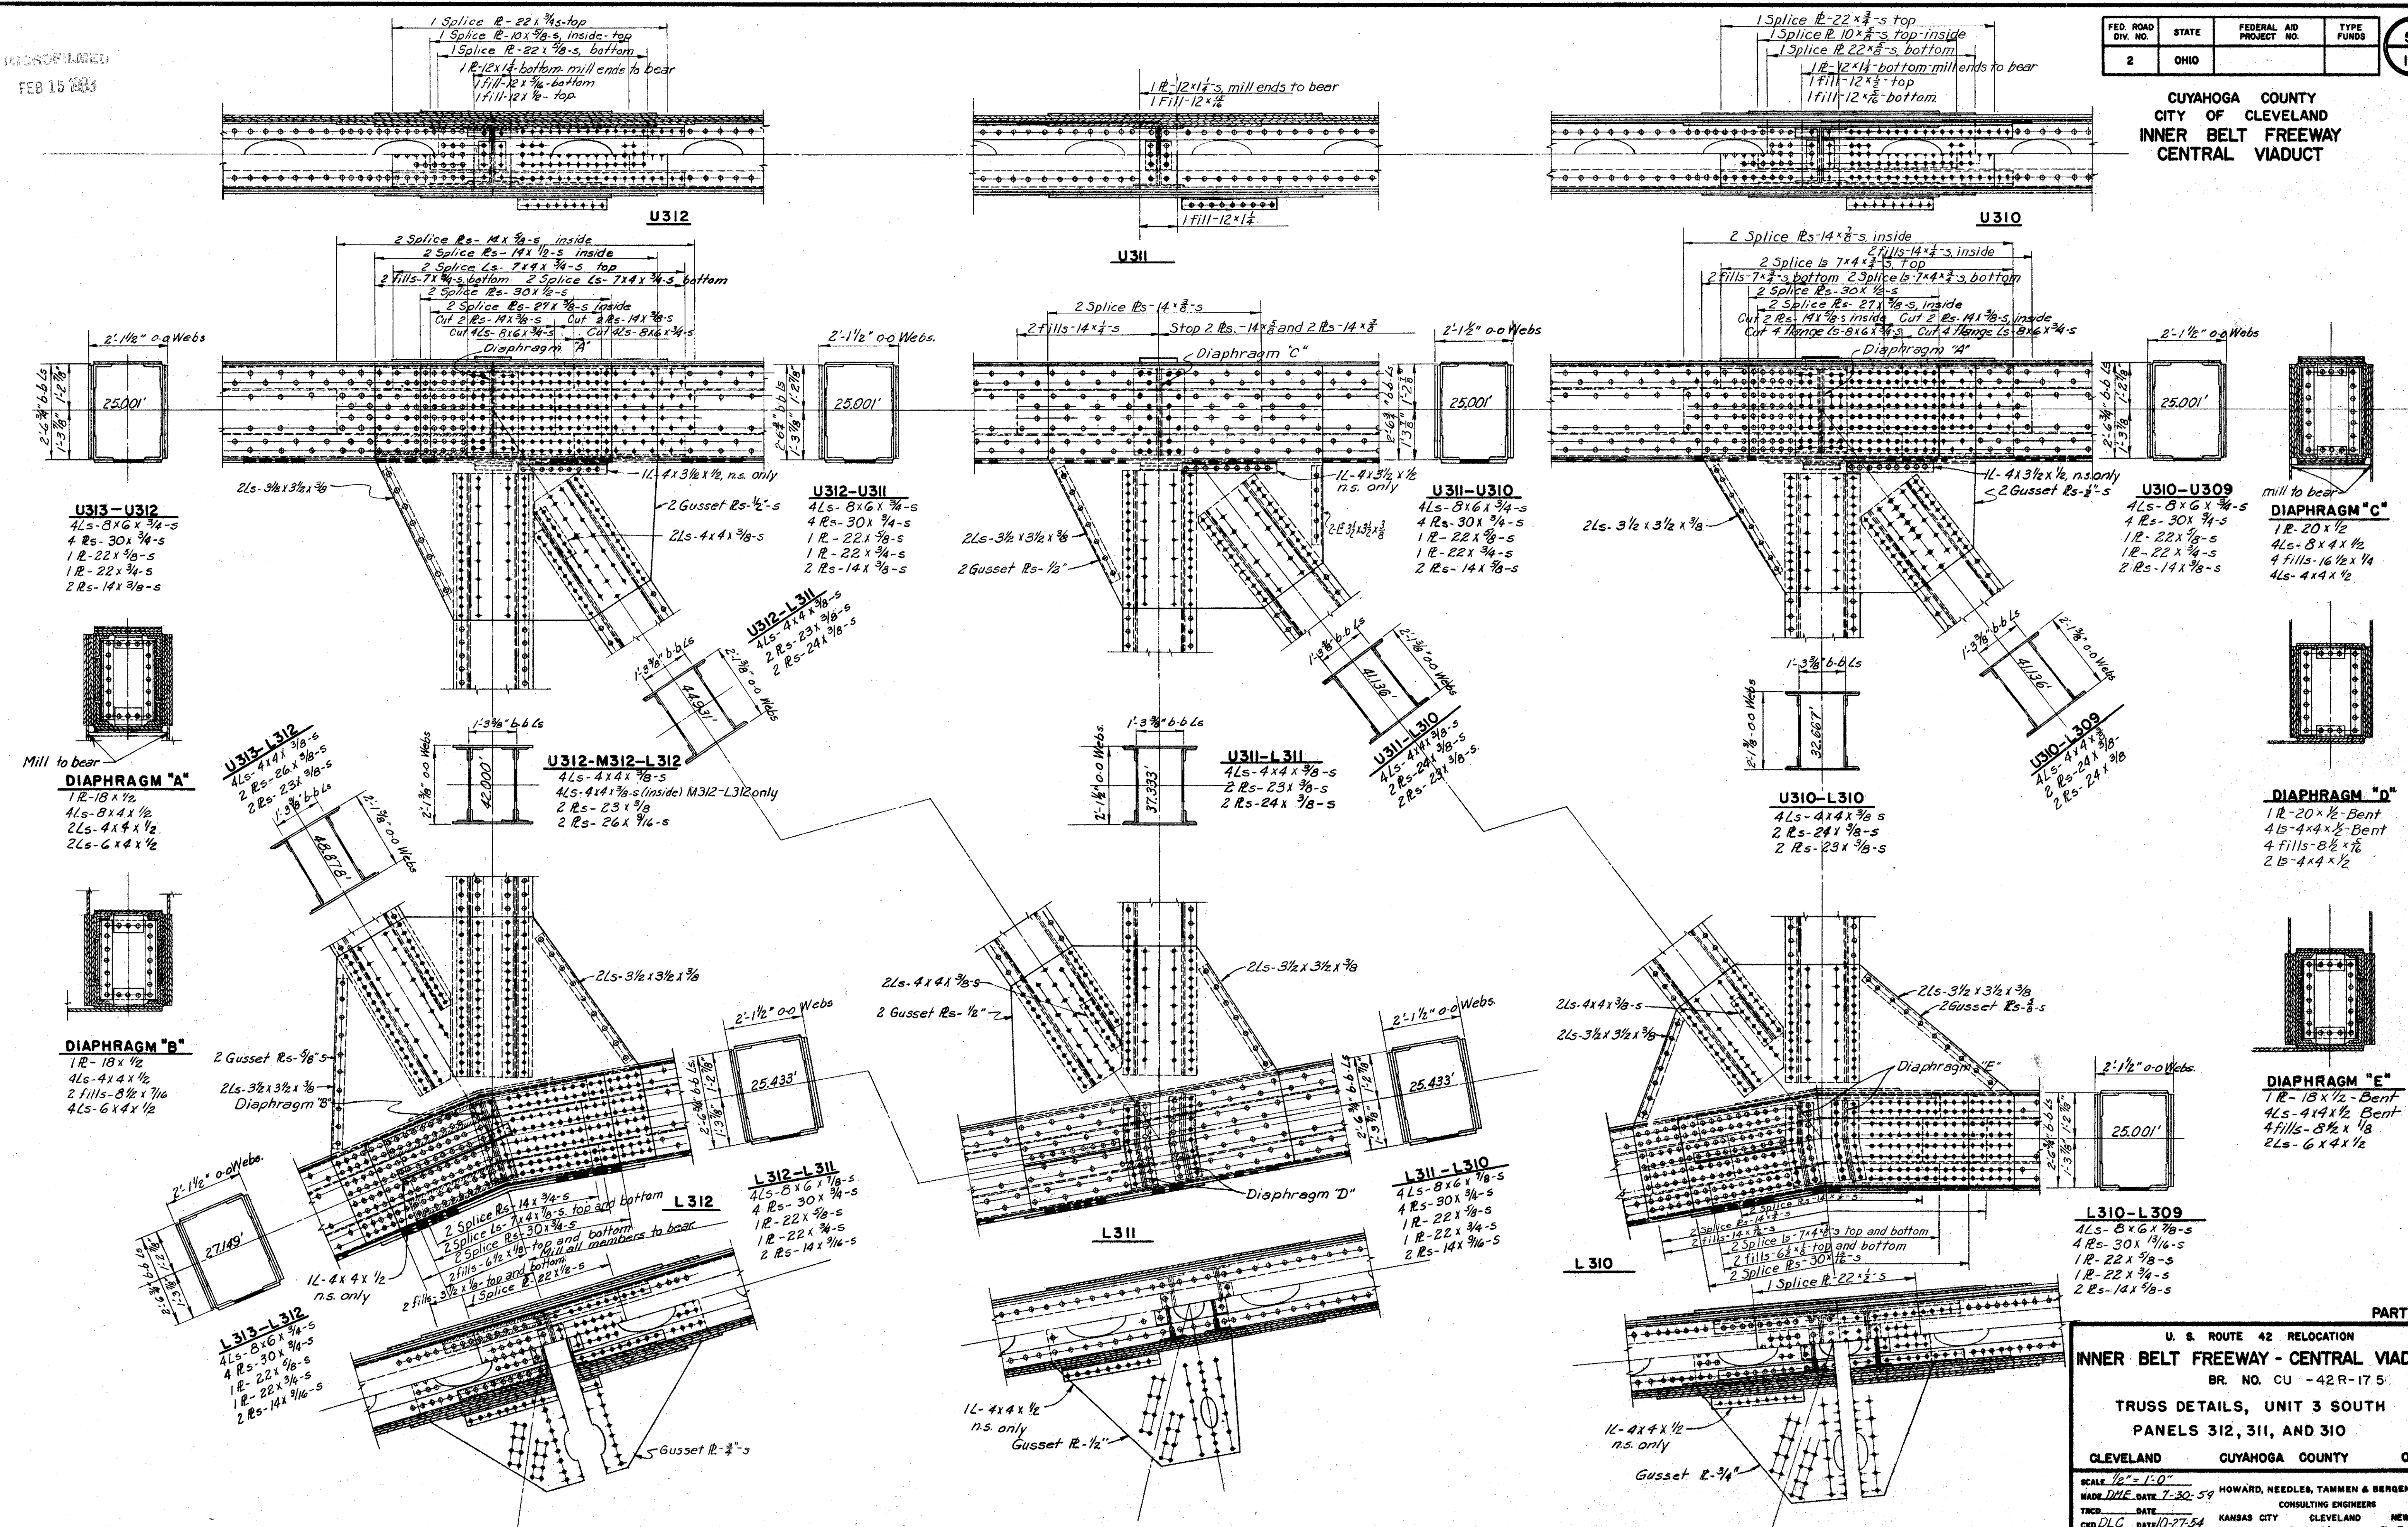

PART 3

U. S. ROUTE 42 RELOCATION
INNER BELT FREEWAY - CENTRAL VIADUCT
BR. NO. CU - 42R-17.5
TRUSS DETAILS, UNIT 3 SOUTH
PANELS 312, 311, AND 310
CLEVELAND CUYAHOGA COUNTY OHIO
SCALE 1/2" = 1'-0"
MADE DME DATE 7-30-59 HOWARD, NEEDLES, TAMMEN & BERGENDOFF
TRCD DATE KANSAS CITY CONSULTING ENGINEERS
CKD DLG DATE 10-27-54 CLEVELAND NEW YORK
914-1A SHEET 2.54

CUYAHOGA COUNTY
CITY OF CLEVELAND
RIVER BELT FREEWAY
CENTRAL VIADUCT

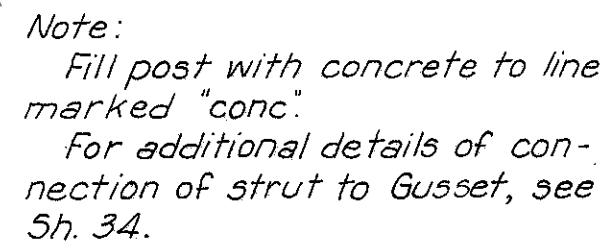


SCALE $\frac{1}{2}'' = 1'-0''$
MADE D.M.E. DATE 6-24-54
TRCD N.R.M. DATE 12-22-54
CKD D.L.C. DATE 10-12-54

HOWARD, NEEDLES, TAMMEN & BERGENDOFF
CONSULTING ENGINEERS
KANSAS CITY CLEVELAND NEW YORK
914-1A SHEET 253


FEB 15 1963

$$\frac{52}{122}$$


914-1A SHEET-252

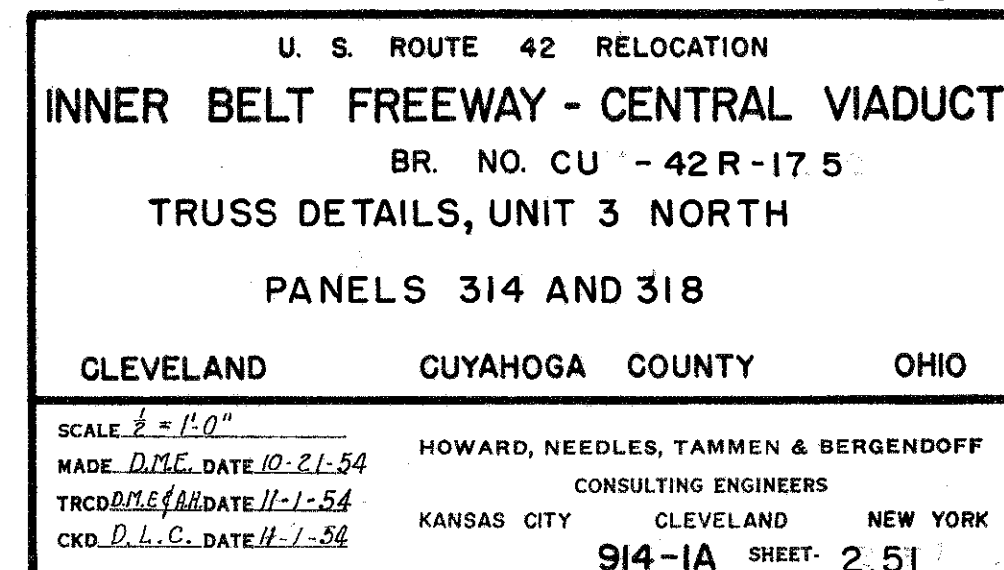

CUYAHOGA COUNTY
CITY OF CLEVELAND
INNER BELT FREEWAY
CENTRAL VIADUCT

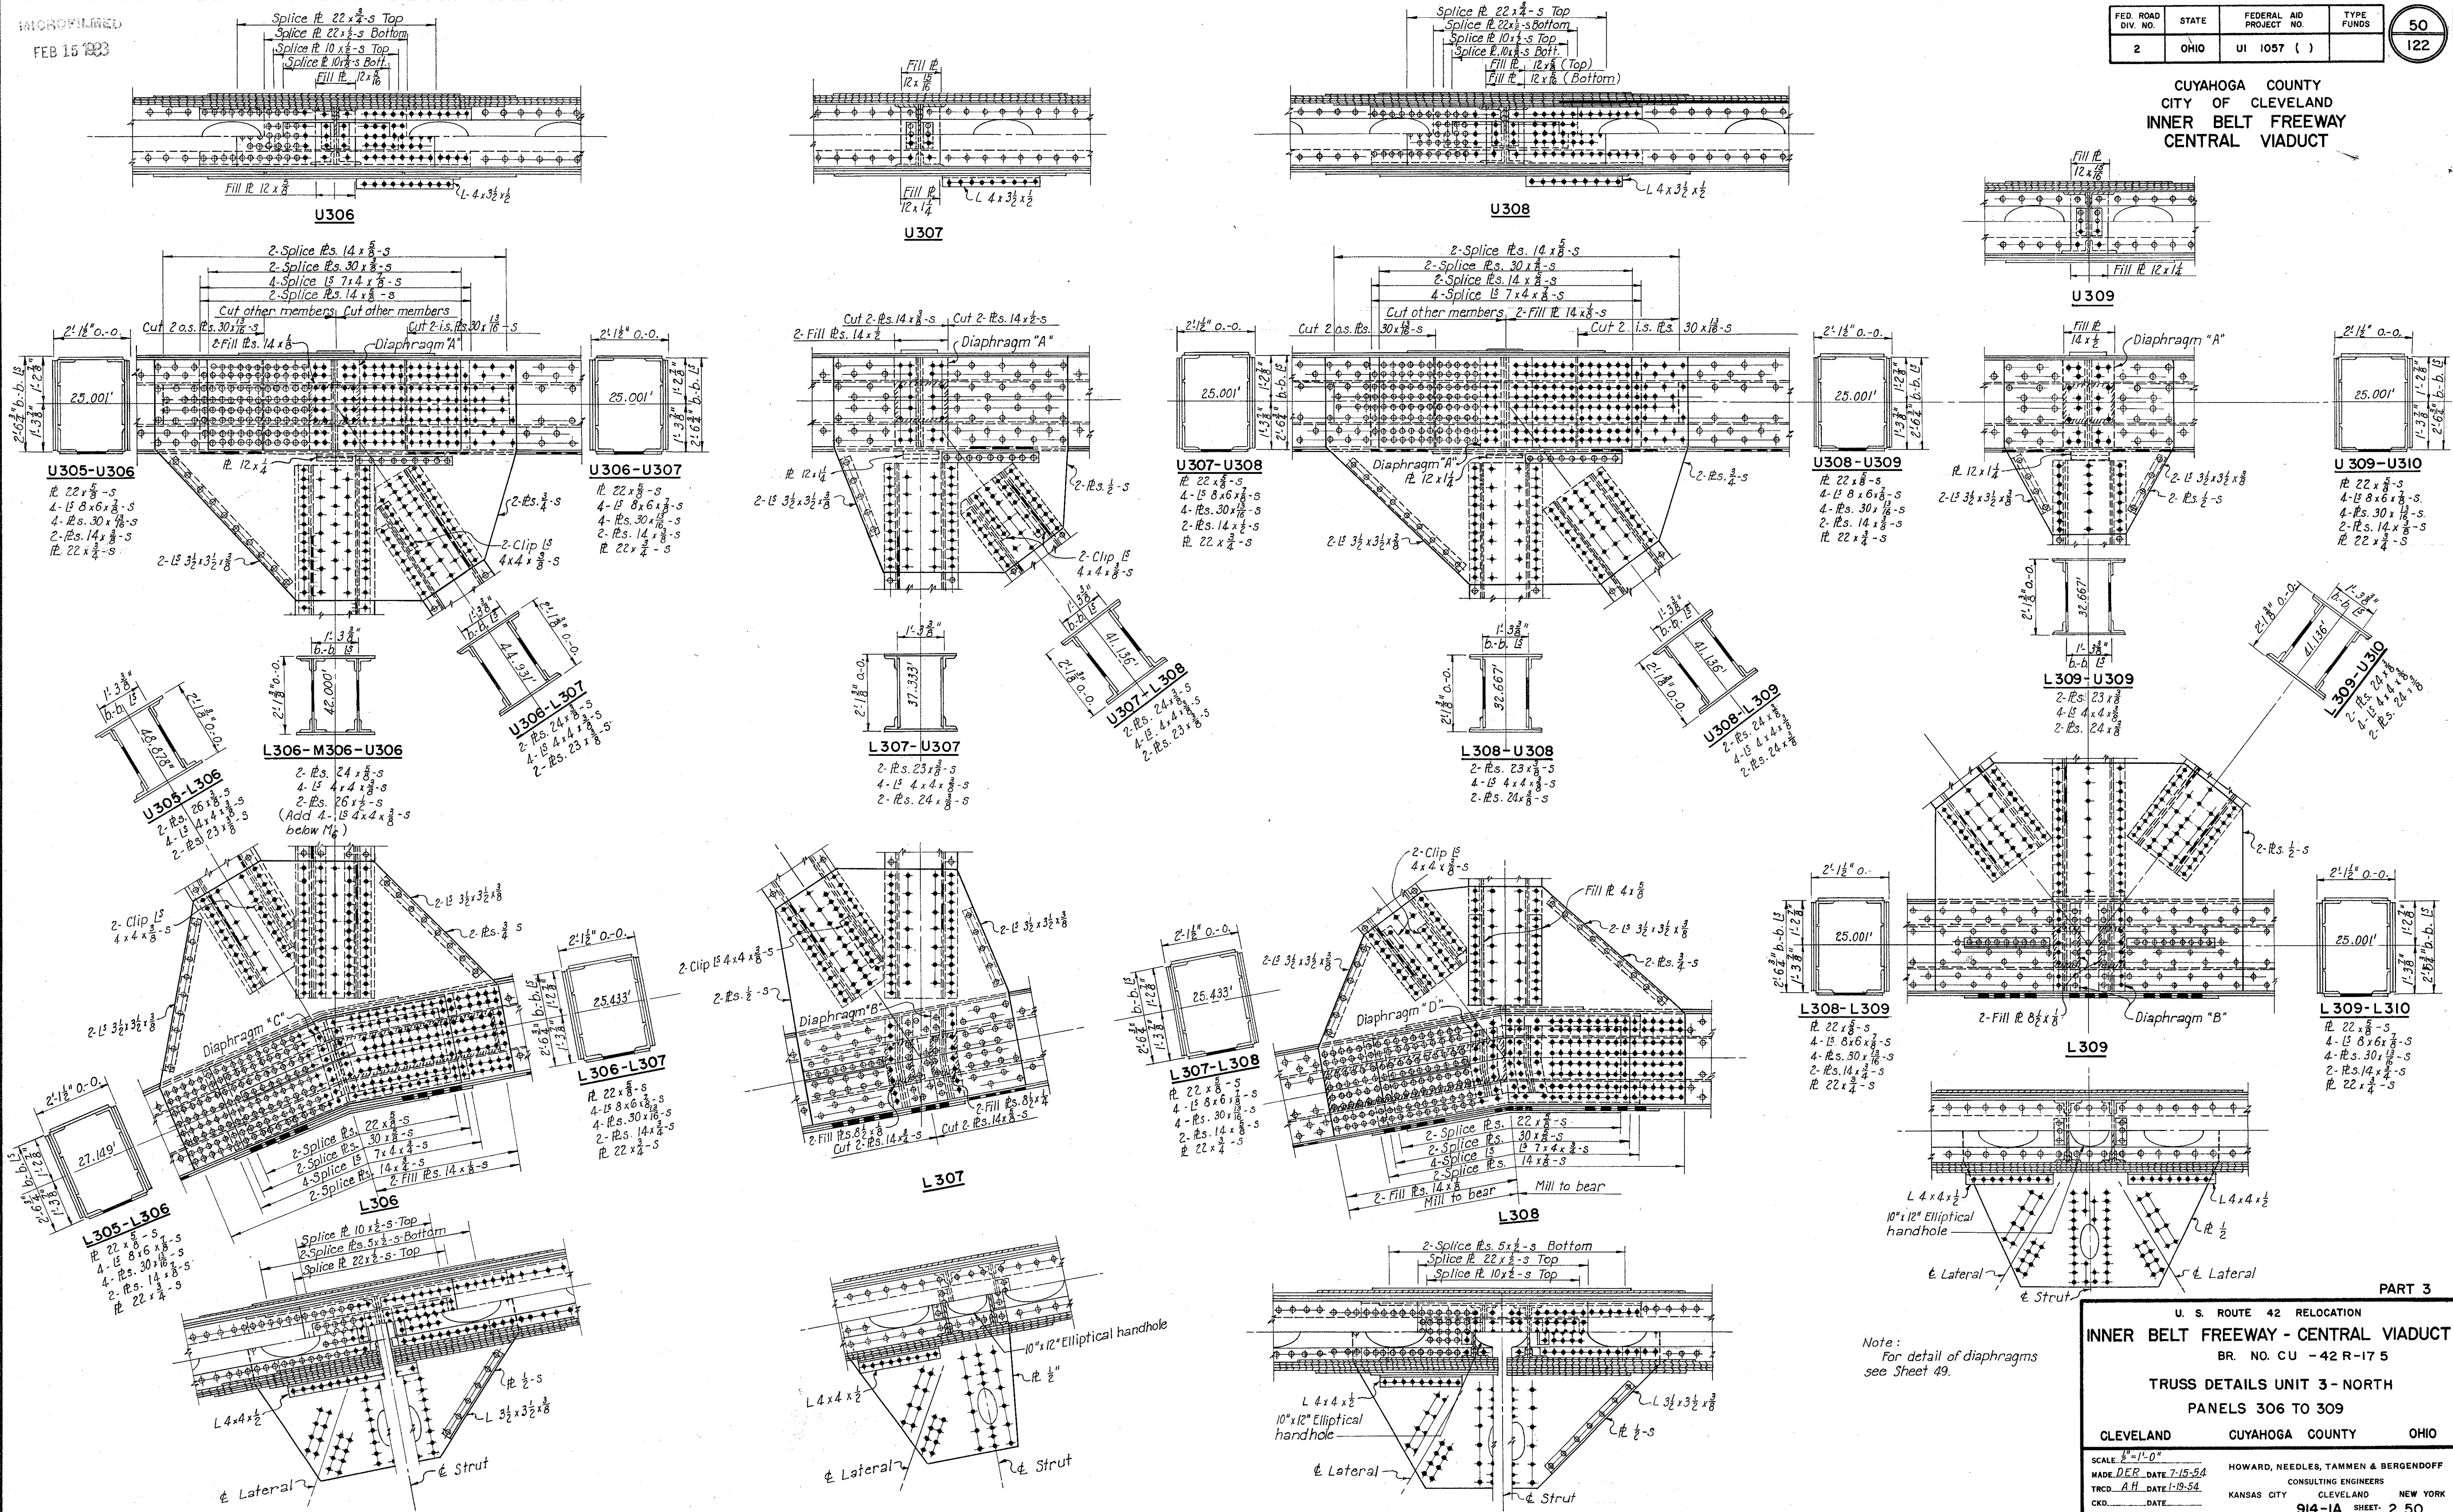

Note:
For detail of diaphragms
see Sheet 49.

U. S. ROUTE 42 RELOCATION

INNER BELT FREEWAY - CENTRAL VIADUCT

BR. NO. CU -42 R-17 5

TRUSS DETAILS UNIT 3 - NORTH

PANELS 306 TO 309

CLEVELAND CUYAHOGA COUNTY OHIO

SCALE $\frac{1}{2}'' = 1'-0''$

MADE DER DATE 7-15-54

TRCD. AH DATE 1-19-54

CHKD. _____ DATE _____


HOWARD, NEEDLES, TAMMEN & BERGENDOFF
CONSULTING ENGINEERS

KANSAS CITY CLEVELAND NEW YORK

914-1A SHEET- 2 50

FED. ROAD DIV. NO.	STATE	FEDERAL AID PROJECT NO.	TYPE FUNDS
2	OHIO		

49
122

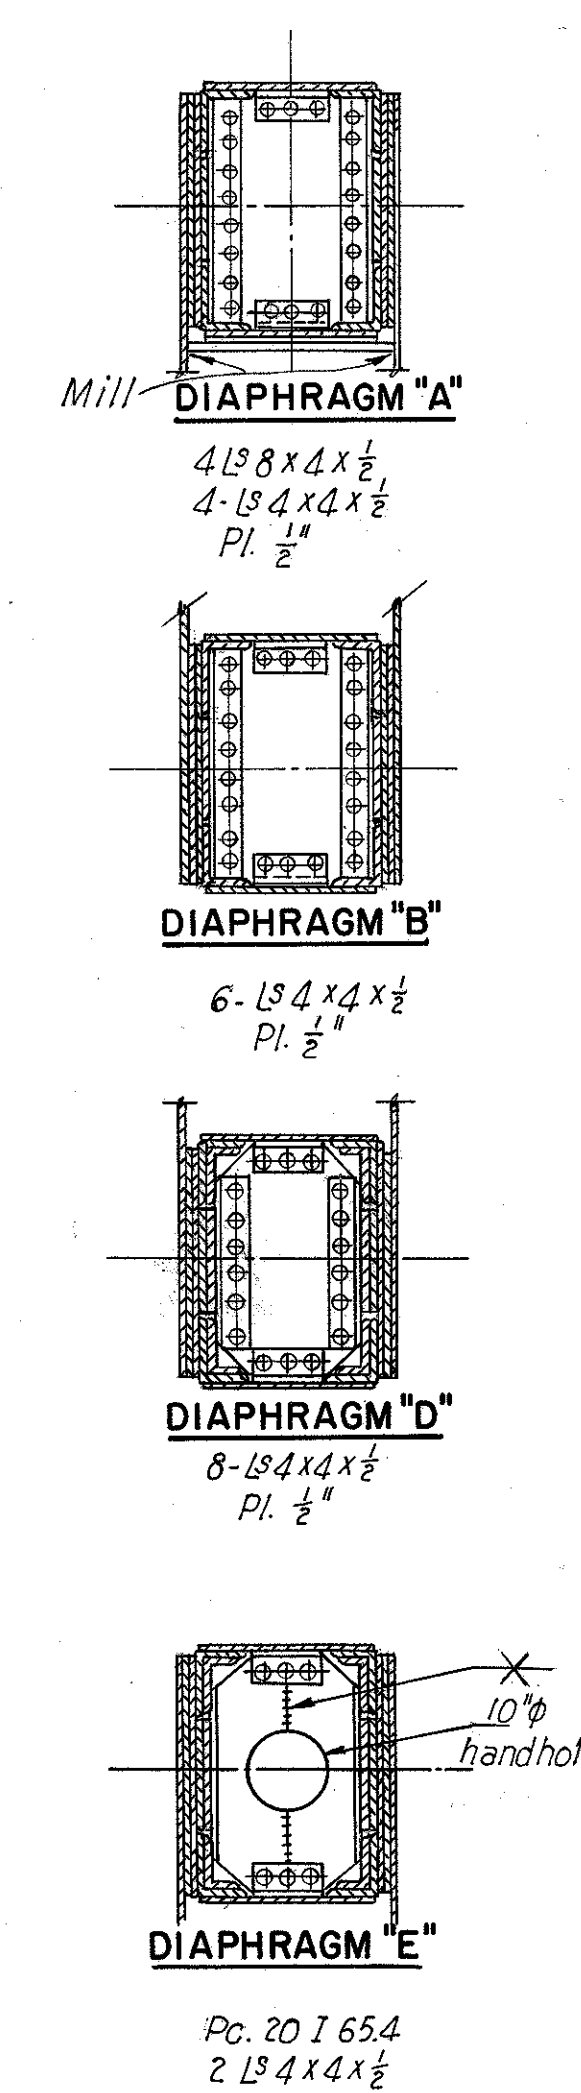

U. S. ROUTE 42 RELOCATION

INNER BELT FREEWAY - CENTRAL VIADUCT

BR. NO. CU - 42 R-17 5

TRUSS DETAILS UNIT 3 NORTH

PANELS 303 TO 305

CLEVELAND CUYAHOGA COUNTY OHIO

SCALE: $\frac{1}{2"} = 1'-0"$

MADE DER DATES 6-14-54

TRCD RR DATE 1-22-54

CKD Y.D.B. DATE 9-23-54

HOWARD, NEEDLES, TAMMEN & BERGENDOFF
CONSULTING ENGINEERS

KANSAS CITY CLEVELAND NEW YORK

914-1A SHEET 249

HOWARD, NEEDLES, TAMMEN & BERGENDOFF
CONSULTING ENGINEERS
KANSAS CITY CLEVELAND NEW YORK
914-1A SHEET- 249


FEB 15 1993

CUYAHOGA COUNTY
CITY OF CLEVELAND
INNER BELT FREEWAY
CENTRAL VIADUCT

[illegible][illegible]


NOTE

*) Handhole 11" Wide
 **) Handhole 10" Wide
 S= Special Steel
 C= Carbon Steel
 ⊕ 3 Holes Out of 24
 4 Holes Out of 26
 And 20" Web

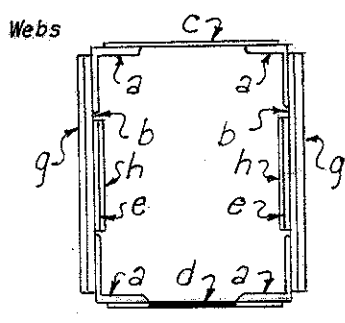


CHORD


All dead load and live load stresses are in kips.
Line 29,- Net area for tension or effective gross area for compression.

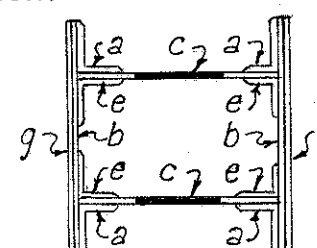

WEB MEMBER

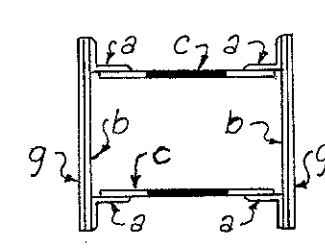

WEB MEMBER

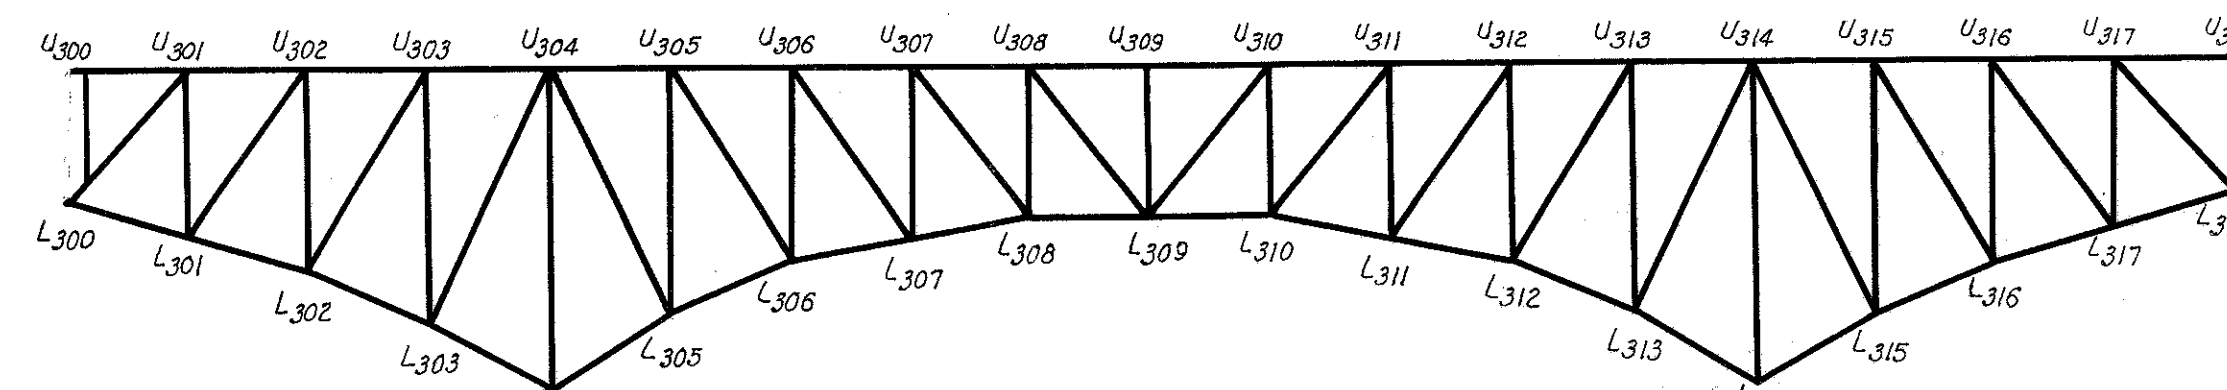

Truss dimensions are shown
on Framing Plan, Sh. 20.

PART 3

U. S. ROUTE 42 RELOCATION
INNER BELT FREEWAY - CENTRAL VIADUCT
BR. NO. CU - 42R-175

STRESS SHEET UNIT 3
SOUTH TRUSS


CLEVELAND	GUYAHOGA	COUNTY	OHIO
SCALE <i>None</i>			
MADE <i>H.W.L.</i> DATE <i>5-3-54</i>		HOWARD, NEEDLES, TAMMEN & BERGENDORF	
TRCD <i>9-14-59</i> DATE <i>8-31-54</i>		CONSULTING ENGINEERS	
CKD <i>8-6-56</i> DATE <i>9-2-59</i>		KANSAS CITY	CLEVELAND NEW YORK
		914-1A SHEET 2-48	

FEB 15 1963


CUYAHOGA COUNTY
CITY OF CLEVELAND
INNER BELT FREEWAY
CENTRAL VIADUCT

[illegible]


COMPRESSION WEB MEMBERS																																	LINE	TENSION WEB MEMBERS																
U304 L305	U305 L306	U307 L308	U310 L311	U312 L313	U314 L315	U300 L300	U301 L301	U307 L307	U308 L308	U309 L309	U310 L310	U302 L302	M302 L302	U303 M303	L303	U304 M304	M304 L304	U305 M305	M305 L305	U306 M306	M306 L306	U312 M312	M312 L312	U313 M313	M313 L313	U314 M314	M314 L314	U315 M315	M315 L315	U316 M316	M316 L316	U311 L311	U317 L317		MEMBER	L300 U301	L301 U302	L302 U303	L303 U304	U306 L307	L308 U309	L309 U310	L311 U312	U314 L315	U315 L316	U317 L318				
-318	-163	-109	-76	-154	-306	-87	-1231	-56	-267	-128	-302	-1303	-1446	-1173	-1317	-686	-839	-1	-145	-346	-489	-371	-514	-11	-155	-742	-821	-1198	-1342	-1327	-1469	-83	-1260	1	Dead Load	+1468	+1417	+1177	+895	+248	+169	+214	+278	+943	+1,201	+1,440	+1,497			
-254	-130	-87	-61	-123	-245	-70	-985	-345	-214	-102	-242	-1042	-1,157	-938	-1,054	-549	-670	-1	-116	-277	-391	-297	-411	-9	-124	-594	-657	-958	-1,074	-1,062	-1,175	-66	-1,008	2	Obs Load	+1,174	+1,134	+942	+716	+198	+135	+171	+222	+754	+961	+1,152	+1,198			
+338	+356	+285	+285	+356	+338			+209	+165		+159					+184	+184	+212	+212	+185	+185	+178	+178	+209	+209	+173						+199	3	Live Load+Imp.-Tension	+334	+313	+255	+192	+307	+245	+249	+307	+196	+262	+323	+349				
-259	-248	-279	-270	-245	-260	-45	-264	-241	-195	-47	-199	-271	-313	-235	-281	-351	-390	-323	-365	-269	-313	-269	-313	-323	-323	-365	-352	-389	-241	-291	-280	-325	-241	-275	4	Reduced L.L.+Imp.-Tension														
+560	+590	+472	+472	+590	+560			+346	+273		+263					+305	+305	+351	+351	+307	+307	+295	+295	+346	+346	+287						+330	5	Live Load+Imp.-Compr.	+553	+519	+423	+318	+509	+406	+413	+509	+325	+434	+535	+578				
-429	-411	-462	-447	-406	-430	-75	-437	-399	-323	-78	-330	-449	-519	-389	-466	-582	-646	-535	-605	-446	-519	-446	-519	-535	-605	-583	-644	-399	-482	-464	-539	-399	-456	6	Reduced L.L.+Imp.-Compr.					+223	-230	-249	-215							
-106	-218	-262	-375	-231	-1105			-374	-0.618		-0.526					-0.268	-0.22	-2.12	-1.46	-0.535	-0.38	-0.48	-0.35	-19.0	-1.35	-0.24						-2.40	7	Red L.L.-Tension x D(CF) ^e					+509	+406	+413	+509	+325	+434	+535	+578				
+17	+17	+13	+13	+17	+17			+11	+10		+10					+13	+13	+16	+16	+10	+10	+10	+10	+16	+16	+13						+11	8	Red L.L.+Imp.-Compr. x D(CF) ^e					-370	-381	-171	-356								
-20	-19	-16	-16	-19	-20	-1	-13	-12	-13	-1	-13	-14	-16	-12	-14	-20	-22	-16	-18	-14	-16	-14	-16	-16	-18	-20	-22	-12	-14	-14	-16	-12	-13	9	Ratio = Tension / Compression					-0.90	-1.36	-1.05	-0.77							
-703	-560	-566	-524	-548	-695	-146	-1,435	-456	-550	-181	-585	-1,505	-1,692	-1339	-1534	-1,151	-1,338	-552	-739	-737	-926	-757	-946	-560	-747	-1,197	-1,323	-1,369	-1,570	-1,540	-1,730	-477	-1,477	10	L.L. Sidewalk -Tension-Compression	+16	+15	+13	+9	+15	+16	+16	+15	+9	+13	+15	+16			
+51	+477	+398	+424	+484	+73			+312										+366	+153					+353	+122						+275	11	L.L. Sidewalk -Compression																	
																																		12	Direct Design Stress	+1,743	+1,668	+1,378	+1,043	+722	+557	+600	+746	+1,088	+1,408	+1,702	+1,792			
																																		13	Reverse Design Stress															
																																		14																
																																		15																
6x4x7/16	4x4x3/8	4x4x3/8	4x4x3/8	4x4x3/8	6x4x7/16	4x4x3/8	4x4x3/8	4x4x3/8	4x4x3/8	4x4x3/8	4x4x3/8	4x4x3/8	4x4x3/8	6x4x7/16	6x4x7/16	7x4x7/16	7x4x7/16	6x4x7/16	6x4x7/16	4x4x3/8	4x4x3/8	4x4x3/8	4x4x3/8	4x4x3/8	4x4x3/8	4x4x3/8	6x4x7/16	6x4x7/16	7x4x7/16	7x4x7/16	6x4x7/16	6x4x7/16	4x4x3/8	4x4x3/8	4x4x3/8	4x4x3/8	a Outer Angles	2	4x4x9/16	4x4x9/16	4x4x9/16	4x4x9/16	4x4x9/16	4x4x9/16	4x4x9/16	4x4x9/16	4x4x9/16	4x4x9/16	4x4x9/16	4x4x9/16
28x7/16	28x7/16	b I. Web Plate	2	28x9/16	28x9/16	28x9/16	28x9/16	28x9/16	28x9/16	28x9/16	28x9/16	28x9/16	28x9/16	28x9/16	28x9/16	
23x3/8	23x3/8	c Cover Plate	2	22x9/16	22x9/16	22x9/16	22x9/16	22x9/16	22x9/16	22x9/16	22x9/16	22x9/16	22x9/16	22x9/16	22x9/16	
																																				d														
																																				e Inner Angles	2													
																																				f														
																																				g														
																																				h														
700.8"	586.5"	493.6"	493.6"	586.5"	700.8"	342"	4324"	448"	392"	392"	392"	522"	522"	648"	648"	816"	816"	631"	631"	504"	504"	504"	504"	631"	631"	816"	816"	648"	648"	522"	522"	448"	432.4"	25	Length	In.														
8.61	7.93	7.70	7.70	7.93	8.61	7.70	7.63	7.70	7.70	7.70	7.70	7.92	7.75	8.47	8.22	8.99	8.69	8.61	8.61	7.86	7.88	7.86	7.88	8.61	8.61	8.99	8.69	8.47	8.22	7.92	7.75	7.70	7.63	26	Min. Radius of Gyration-In.															
16,960	17,480	18,110	18,110	17,480	16,960	14,710	18,520	18,440	18,110	14,350	17,870	18,000	18,000	17,310	17,310	15,950	15,950	17,530	17,530	18,110	18,110	17,530	17,530	15,950	15,950	17,310	17,310	18,000	18,000	18,440	18,520	27	Allowable Stress-Lbs./Sq.In.	24,000	24000	24,000	24,000	24,000	18,000	18,000	24,000	24,000	24,000	24,000	24,000					
50.97	40.69	39.19	39.19	40.69	50.97	39.19	81.14	39.19	39.19	39.19	39.19	39.19	85.14	96.58	79.38	90.82	77.38	88.82	50.97	50.97	47.94	59.38	47.94	59.38	50.97	50.97	77.38	88.82	79.38	90.82	85.14	96.58	39.19	81.14	28	Actual Gross Area	Sq.In.	88.94	87.44	70.44	57.00	39.19	39.94	39.94	39.19	57.00	70.44	88.94		
43.49	32.82	31.33	31.33	32.82	43.49	31.33	81.14	31.33	31.33	31.33	31.33	31.33	85.14	96.58	79.38	90.82	77.38	88.82	43.49	43.49	41.27	59.38	41.27	59.38	43.49	43.49	77.38	88.82	79.38	90.82	85.14	96.58	31.33	81.14	29	Net Area	Sq.In.	74.69	73.44	57.44	47.00	32.44	33.19	33.19	32.44	47.00	57.44	74.69		
16,160	17,070	18,030	16,730	16,700	16,020	4,570	17,660	14,550	17,600	5,670	18,660	17,680	17,520	16,850	16,930	14,870	15,070	12,680	16,990	17,860	15,990	18,340	15,950	12,870	17,170	15,470	14,900	17,250	17,290	18,080	17,920	16,220	18,200	30	Actual Unit Stress-Lbs./Sq.In.	23,360	22,710	24,000	22,190	22,660	16,780	18,080	23,000	23,150	24,500	23,150	23,990			
S	S	S	S	S	S	C	S	S	C	S	C	S	S	S	S	S	S	S	S	S	S	S	S	S	S	S	S	S	S	S	S	S	S	31	Material		S	S	S	S	C	C	C	S	S	S	S			

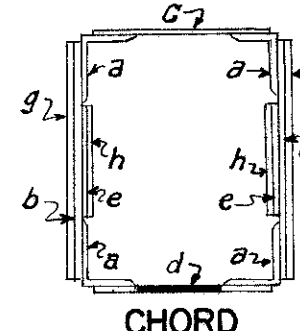


CHORD

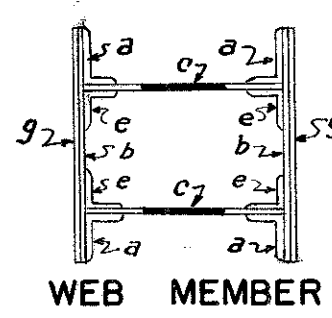

WEB MEMBER

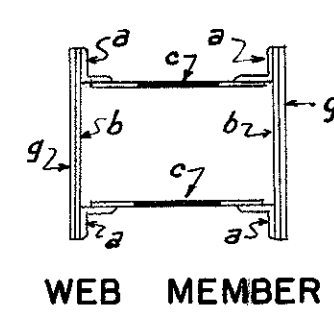

WEB MEMBER

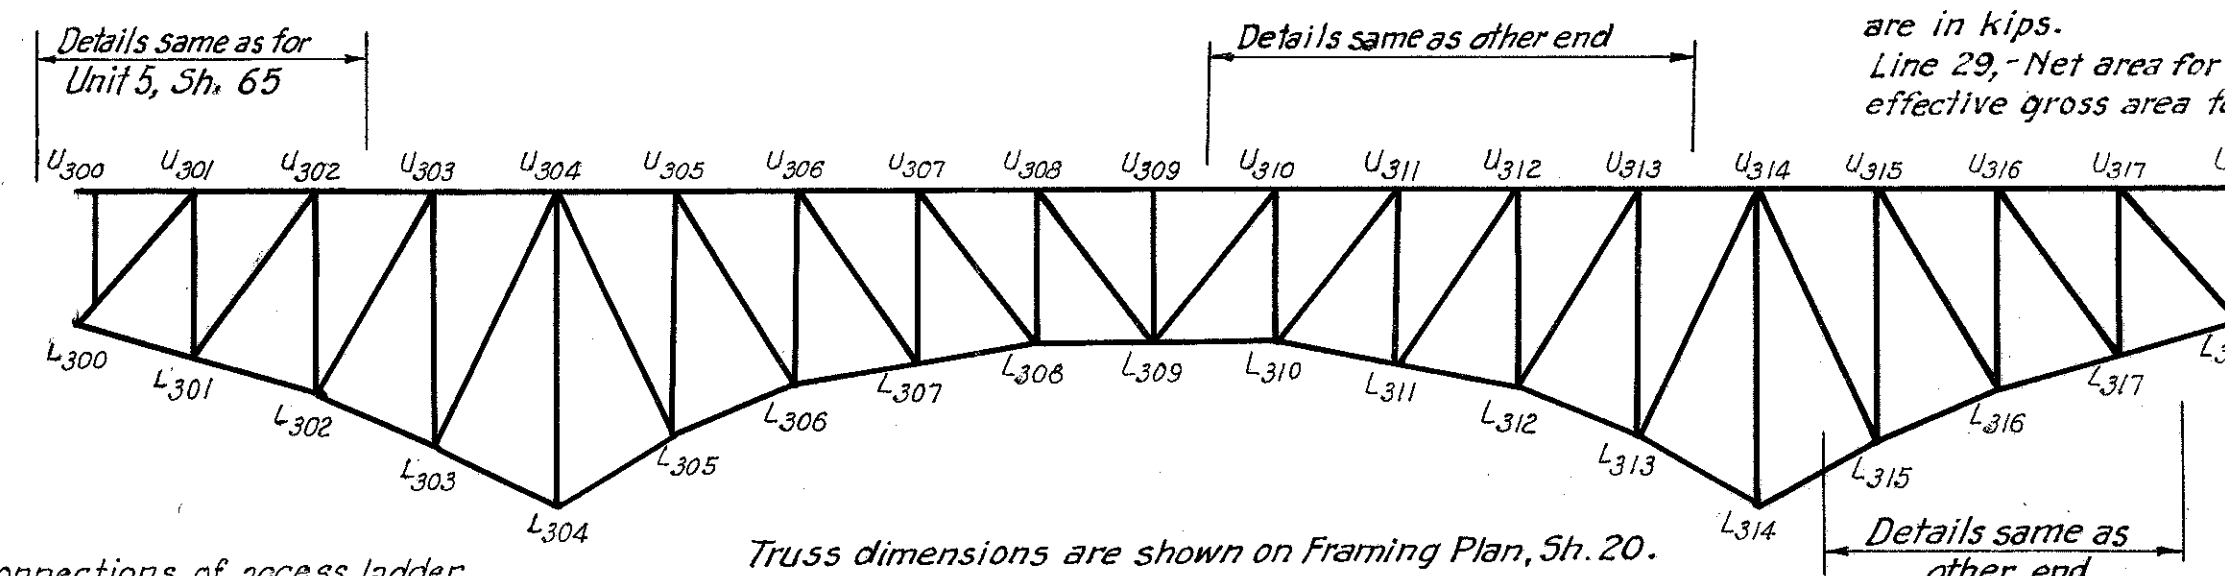

For details and connections of access ladder and walkways to navigation lights panel L300, see Sheet 102.

Truss dimensions are shown on Framing Plan, Sh. 20.

All dead and live load stresses are in kips.
Line 29, -Net area for tension or effective gross area for compression.

LEGEND

- LEGEND
- S Special Steel
 - C Carbon Steel
 - ⊕ 3 Holes out of 24" Webs
 - ⊖ 4 Holes out of 26" and 28" Webs
 - * 10" Holes
 - ** 11" Holes

PART 3

U. S. ROUTE 42 RELOCATION
INNER BELT FREEWAY - CENTRAL VIADUCT
BR. NO. CU - 42 R-17 5

STRESS SHEET UN
NORTH TRUSS

CLEVELAND CUYAHOGA COUNTY OHIO

SCALE None
MADE HWL DATE 4-30-54
G.I.K.
TRCD 7-15 DATE 9-15-54
CKD EL DATE 8-17-54


HOWARD, NEEDLES, TAMMEN & BERGENDOFF
CONSULTING ENGINEERS
KANSAS CITY CLEVELAND NEW YORK
914-1A SHEET 247

REPRODUCED
FEB 15 1960

FED. ROAD DIV. NO.	STATE	FEDERAL AID PROJECT NO.	TYPE FUNDS	46 122
2	OHIO			

CUYAHOGA COUNTY
CITY OF CLEVELAND
INNER BELT FREEWAY
CENTRAL VIADUCT

Note:
Elliptical handholes in bottom of chords
at 3'-6" centers between L-23, L-25 and in
all posts and diagonals. Elliptical handholes
11" x 22" in bottom of chords between L-20,
L-23 and L-25, L-28. Except as noted.

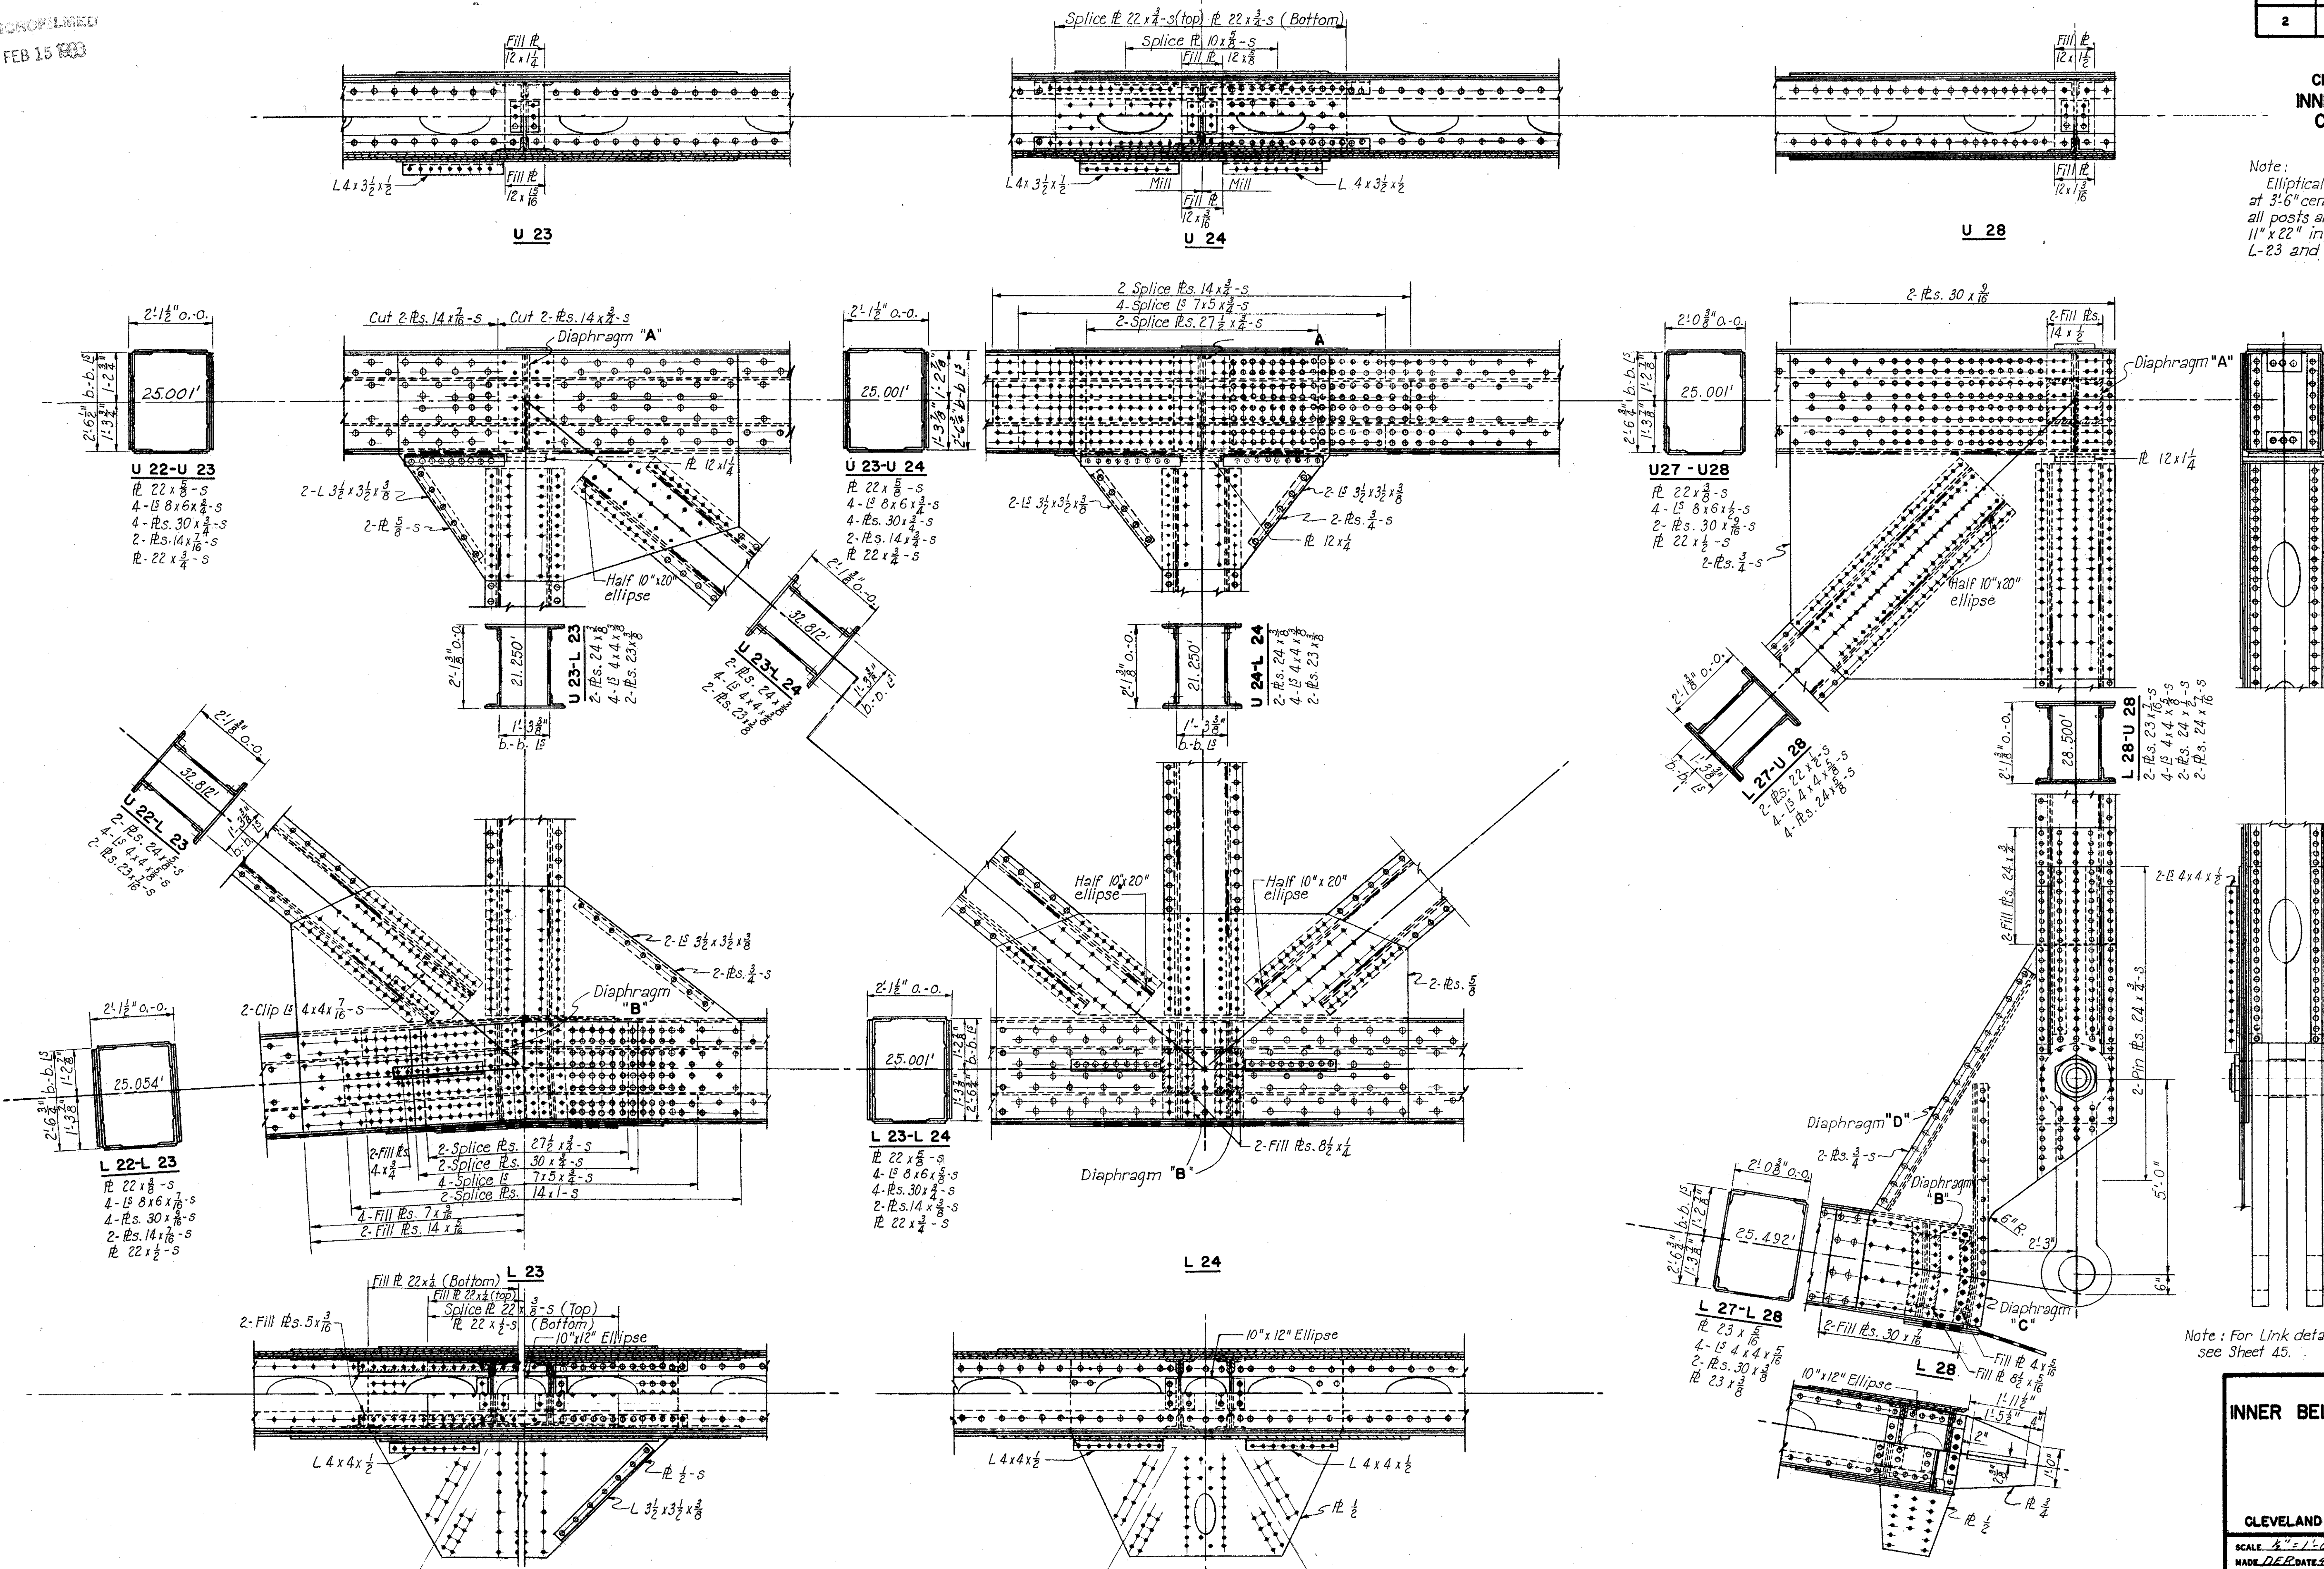

Note: For Link details
see Sheet 45.

PART 3

U. S. ROUTE 42 RELOCATION
INNER BELT FREEWAY - CENTRAL VIADUCT
BR. NO. CU - 42 R - 17 5

TRUSS DETAILS UNIT 2
PANELS 23, 24, AND 28

CLEVELAND CUYAHOGA COUNTY OHIO


SCALE 3/4" = 1'-0"
MADE: DEC 1954
TRCD: A.H. DATE: 12-55
CHK: J.T.K. DATE: 2-12-56

HOWARD, NEEDLES, TAMMEN & BERGENDOFF
CONSULTING ENGINEERS
CLEVELAND NEW YORK
914-1A SHEET 2.46

RECEIVED
FEB 15 1933

FED. ROAD DIV. NO.	STATE	FEDERAL AID PROJECT NO.	TYPE FUNDS
2	OHIO		

CUYAHOGA COUNTY
CITY OF CLEVELAND
INNER BELT FREEWAY
CENTRAL VIADUCT

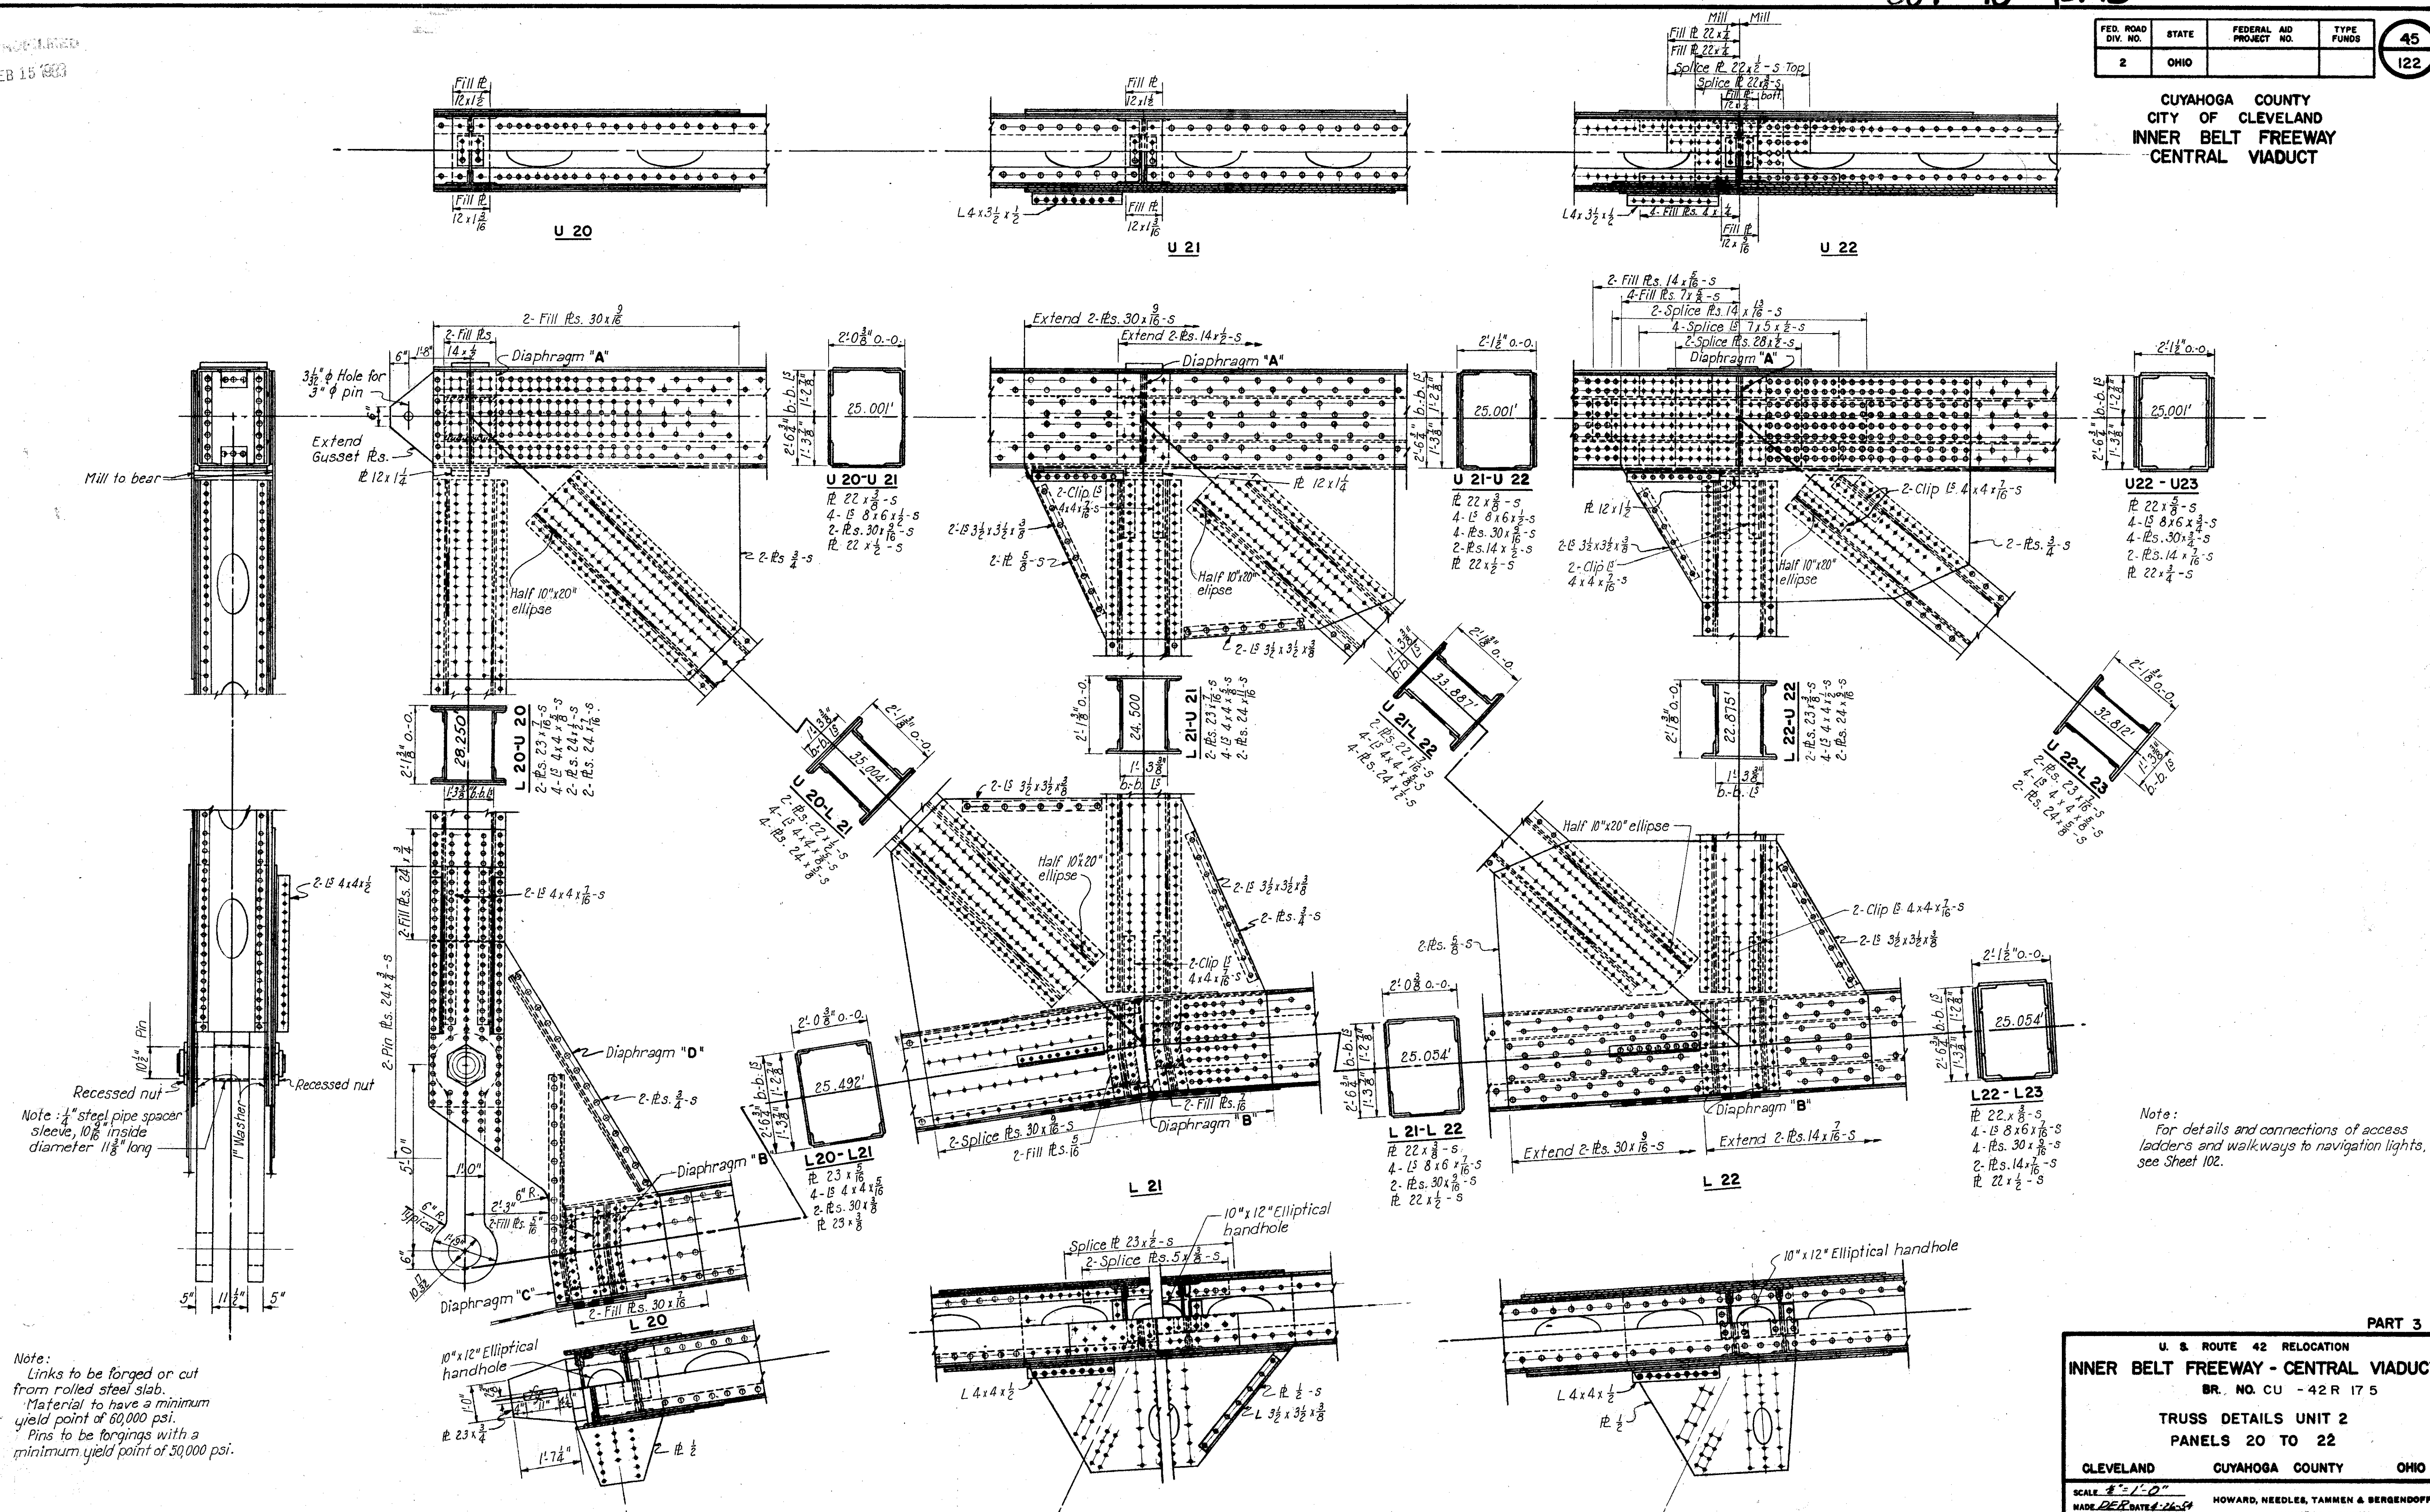

*Note:
For details and connections of access
ladders and walkways to navigation lights,
see Sheet 102.*

PART 3

U. S. ROUTE 42 RELOCATION
INNER BELT FREEWAY - CENTRAL VIADUCT
BR. NO. CU - 42 R 17 5

TRUSS DETAILS UNIT 2
PANELS 20 TO 22

CLEVELAND CUYAHOGA COUNTY OHIO

SCALE 1"=1'-0"
MADE DEF DATE 4-26-54
TRCD _____ DATE _____
CKD ITK DATE 8-12-54

HOWARD, NEEDLES, TAMMEN & BERGENDOFF
CONSULTING ENGINEERS
KANSAS CITY CLEVELAND NEW YORK
914-1A SHEET. 2.45

FED. ROAD DIV. NO.	STATE	FEDERAL AID PROJECT NO.	TYPE FUNDS
2	OHIO		

LINE	MEMBER	TENSION WEB MEMBERS												COMPRESSION WEB MEMBERS											
		U20 L21	U21 L22	U22 L23	U23 L24	L24 U25	L25 U26	L26 U27	L27 U28		U20 L20	U21 L21	U22 L22	U23 L23	U24 L24	U25 L25	U26 L26	U27 L27	U28 L28						
1	Dead Load	+1473	+1199	+ 883	+ 235	+ 235	+ 883	+1199	+1473		-1188	-937	-702	-280	-135	-280	-702	-937	-1112						
2	0.8 Dead Load	+1178	+ 960	+ 707	+ 188	+ 188	+ 707	+1960	+1178		- 951	-750	-562	-224	-108	-224	-562	-750	- 890						
3	Live Load + Imp.-Tension																								
4	Reduced L L + Imp.-Tension	+ 382	+ 332	+ 276	+ 168	+ 168	+ 276	+ 332	+ 382				+ 9	+ 37		+ 37	+ 9								
5	Live Load + Imp.-Comp.																								
6	Reduced L L + Imp.-Comp.		-1111	- 30	+ 104	- 104	- 30	- 11			-282	-239	+192	+113	- 49	-113	-192	-239	-277						
7	Reduced L L + IMP.-Ten. xD (CF) °	+ 633	+550	+ 458	+ 278	+ 278	+ 458	+ 550	+ 633				+ 15	+ 61		+ 61	+ 15								
8	Reduced L L + IMP.-Comp. xD (CF) °		-18	- 50	-172	-172	- 50	- 18			-467	-396	-318	-187	- 81	-187	-318	-396	-459						
9	Ratio = $\frac{Line 4}{Line 1 (Comp.)}$ or $\frac{Line 6}{Line 7 (Ten.)}$		0.009	0.034	0.443	0.443	0.034	0.009					-0.013	-0.132		-0.132	-0.013								
10	L L Sidewalk-Tension	+ 17	+ 14	+ 11	+ 6	+ 6	+ 11	+ 14	+ 17							+ 1									
11	L L Sidewalk-Comp.			- 1	- 3	- 3	- 1				- 13	- 11	- 8	- 4	- 1	- 4	- 8	- 11	- 13						
12	Direct Design Stress	+1828	+1524	+1176	+ 472	+ 472	+1176	+1524	+1828		-1431	-1157	-888	-415	-190	-415	-888	-1157	-1362						
13	Reverse Design Stress																								
14																									
15																									
16																									
17																									
	Section																								
	a. Flange Angles	2	4x4x $\frac{5}{8}$	4x4x $\frac{5}{8}$	4x4x $\frac{5}{8}$	4x4x $\frac{5}{8}$	4x4x $\frac{5}{8}$	4x4x $\frac{5}{8}$	4x4x $\frac{5}{8}$		4x4x $\frac{5}{8}$	4x4x $\frac{5}{8}$	4x4x $\frac{5}{8}$	4x4x $\frac{5}{8}$	4x4x $\frac{5}{8}$	4x4x $\frac{5}{8}$	4x4x $\frac{5}{8}$	4x4x $\frac{5}{8}$	4x4x $\frac{5}{8}$						
	b. 1 St. Web. Plate	3	24x $\frac{3}{4}$	24x $\frac{3}{4}$	24x $\frac{3}{4}$	24x $\frac{3}{4}$	24x $\frac{3}{4}$	24x $\frac{3}{4}$	24x $\frac{3}{4}$		24x $\frac{3}{4}$	24x $\frac{11}{16}$	24x $\frac{3}{16}$	24x $\frac{3}{8}$	24x $\frac{3}{8}$	24x $\frac{3}{8}$	24x $\frac{9}{16}$	24x $\frac{11}{16}$	24x $\frac{3}{8}$						
	c. Cover Plates	2	22x $\frac{3}{4}$ **	22x $\frac{7}{16}$ **	23x $\frac{7}{16}$ **	23x $\frac{3}{8}$ **	23x $\frac{3}{8}$ **	23x $\frac{7}{16}$ **	22x $\frac{7}{16}$ **	22x $\frac{3}{4}$ **		23x $\frac{7}{16}$ **	23x $\frac{7}{16}$ **	23x $\frac{3}{8}$ **	23x $\frac{3}{8}$ **	23x $\frac{3}{8}$ **	23x $\frac{3}{8}$ **	23x $\frac{7}{16}$ **	23x $\frac{7}{16}$ **						
	g. 2 nd. Web Plate	3	24x $\frac{3}{4}$	24x $\frac{3}{4}$				24x $\frac{3}{4}$	24x $\frac{3}{4}$		24x $\frac{3}{4}$								24x $\frac{3}{4}$						
25	Length	In.									342"	294"	274.5"	258"	255"	255"	274.5"	294"	342"						
26	Min. Radius of Gyration	In.									7.57	7.70	7.68	7.70	7.70	7.70	7.68	7.70	7.57						
27	Allowable Stress	Lbs./Sq.In.	24,000	24,000	24,000	18,000	18,000	24,000	24,000		19,060	19,330	19,410	14,720	14,720	14,720	19,410	19,330	19,060						
28	Actual Gross Area	Sq. In.	90.44	76.94	59.82	39.19	39.19	59.82	76.94	90.44	74.82	62.82	51.75	39.19	39.19	39.19	51.75	62.82	74.82						
29	Net Area	Sq. In.	75.94	64.19	49.32	32.44	32.44	49.32	64.19	75.94	74.82	61.27	46.35	31.88	31.88	31.88	46.35	61.27	74.82						
30	Actual Unit Stress	Lbs./Sq. In.	24,070	23,720	23,850	14,550	14,550	23,850	23,720	24,070	19,120	18,900	19,160	13,000	5,950	13,000	19,160	18,900	18,220						
31	Material		S	S	S	C	C	S	S		S	S	S	C	C	C	S	S							

WEB MEMBER

All dead load and live load stresses are in kips.
Line 29,- Net area for tension or effective gross area for compression

U. S. ROUTE 42 RELOCATION
INNER BELT FREEWAY - CENTRAL VIADUCT
BR. NO. CU - 42 R-17 5

SCALE None
MADE DMF DATE 5-5-54
TRCD ^{HRS.} 11:45 DATE 9-20-54
CKD ^{BY} R.W.L. DATE 7-26-54


HOWARD, NEEDLES, TAMMEN & BERGENDOFF
CONSULTING ENGINEERS
KANSAS CITY CLEVELAND NEW YORK
914-1A SHEET 2 44

FED. ROAD DIV. NO.	STATE	FEDERAL AID PROJECT NO.	TYPE FUNDS
2	OHIO		

42

122

42
122

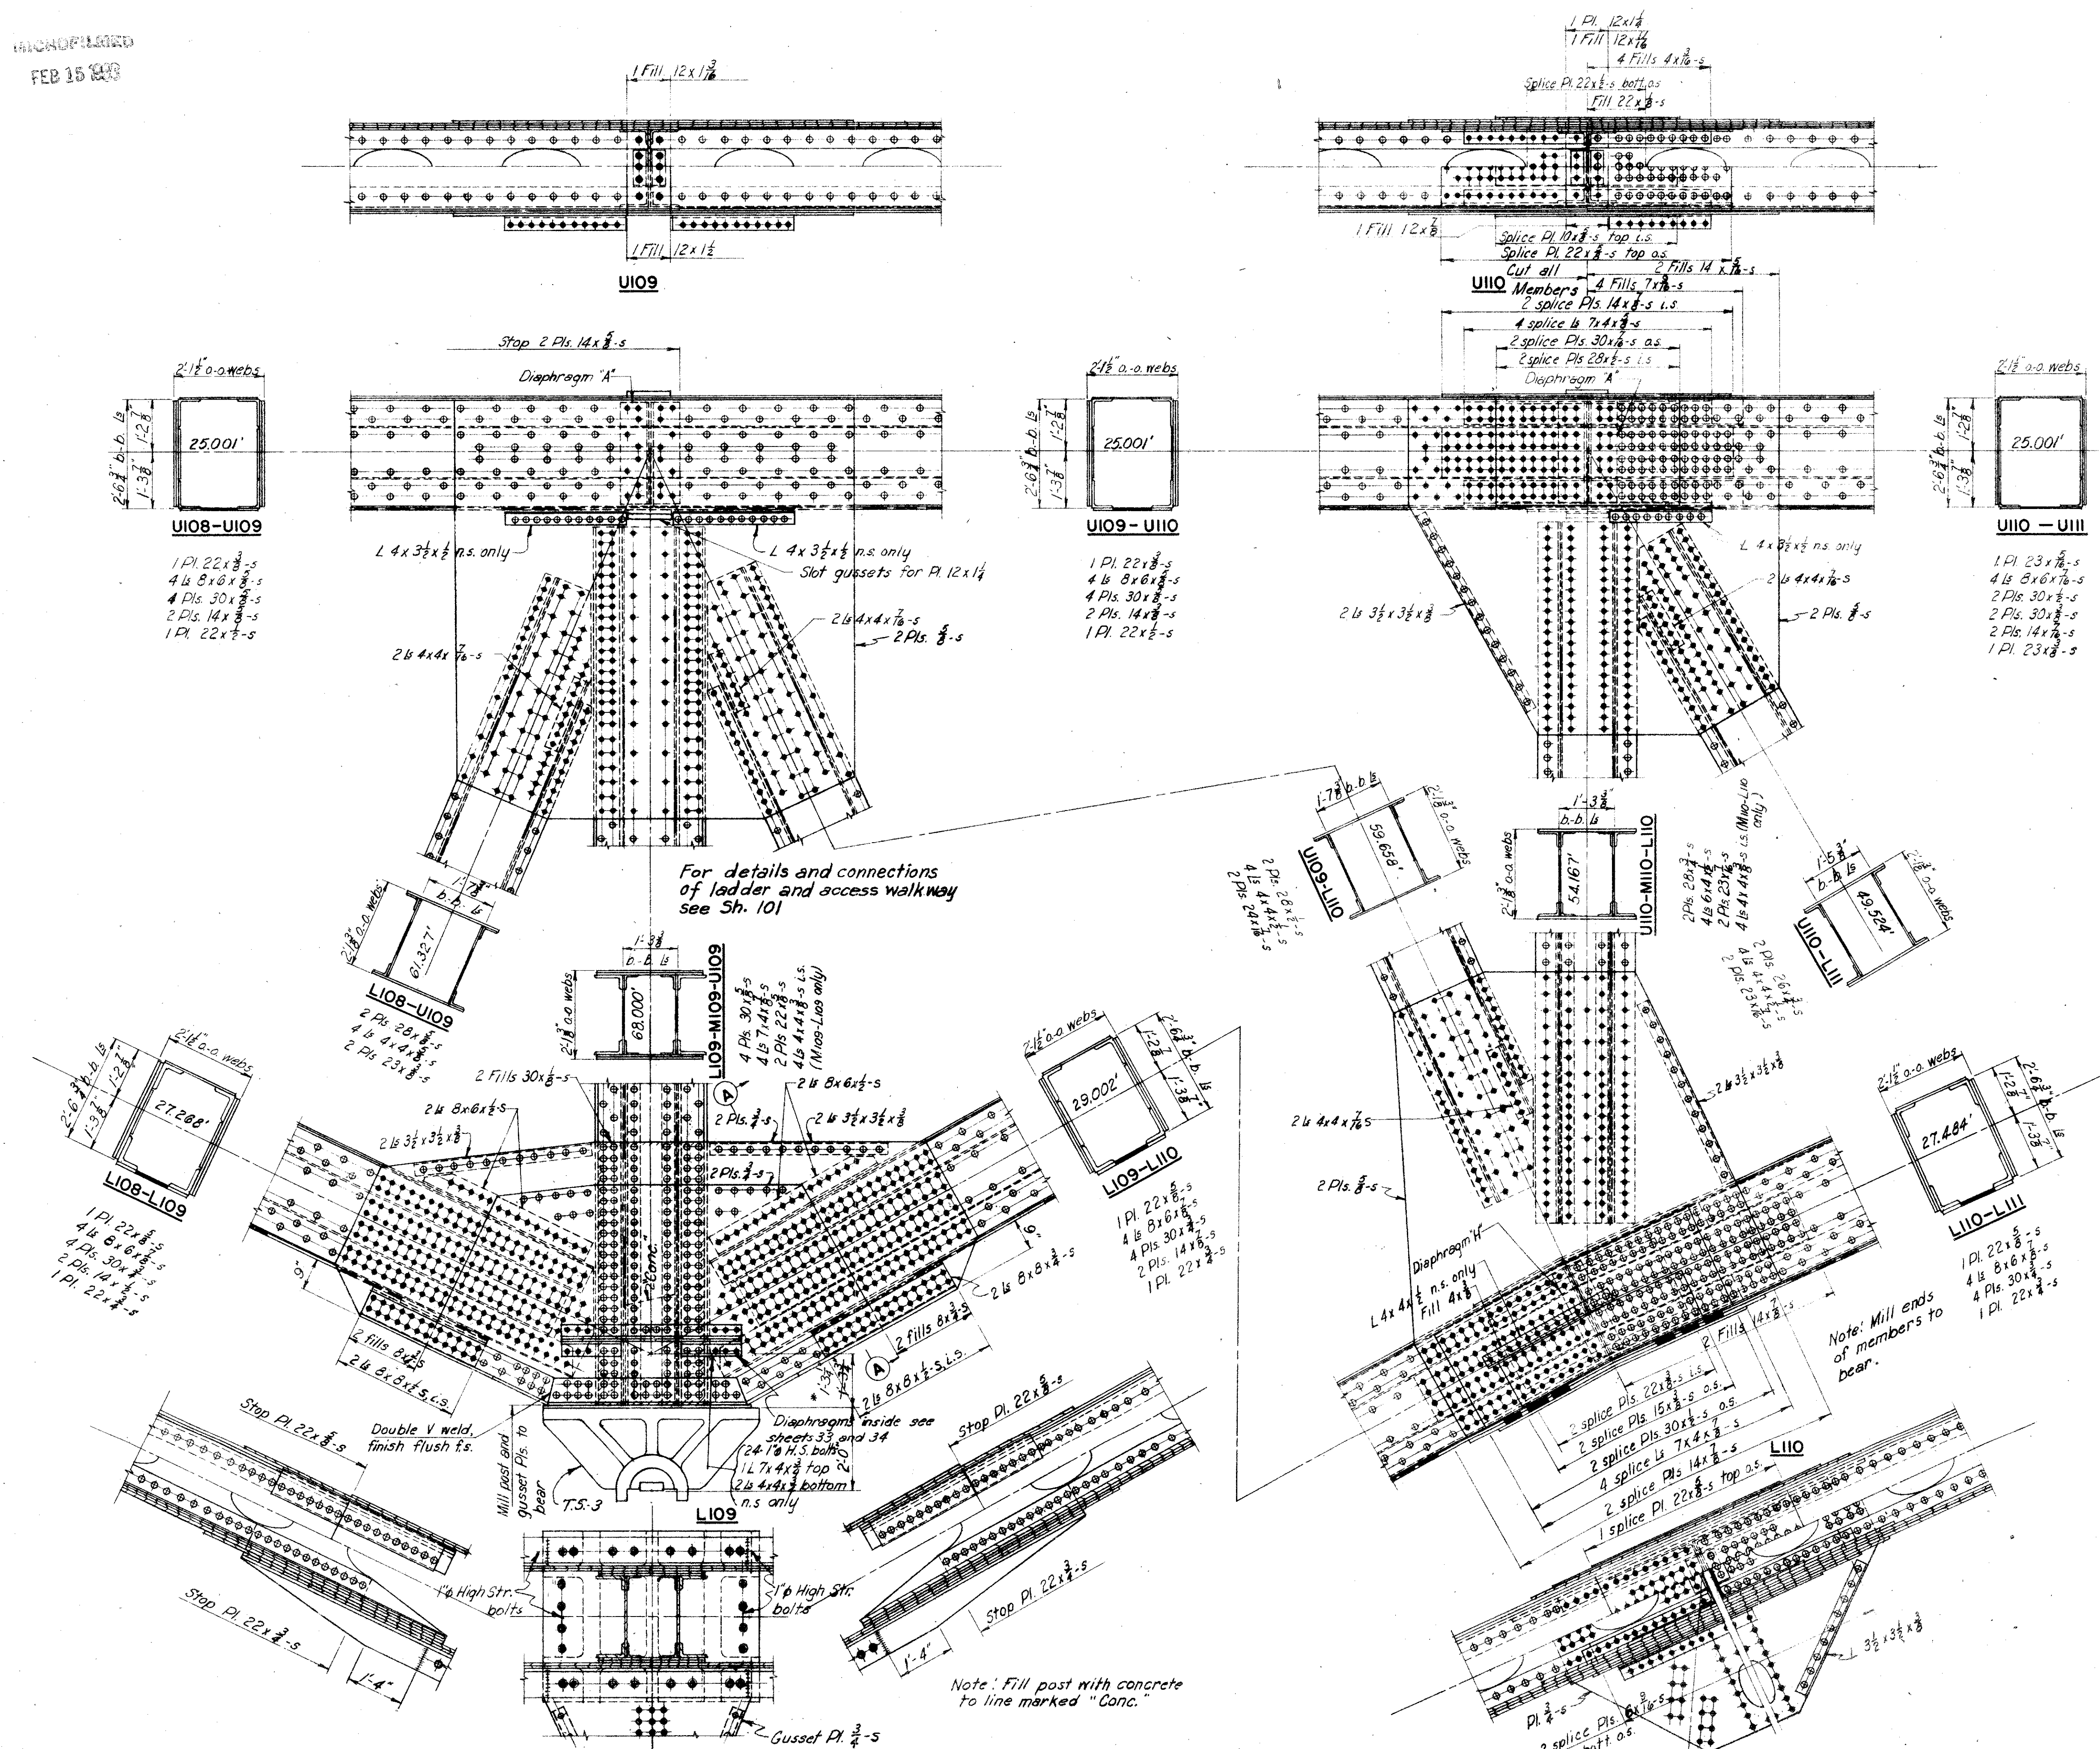

DIAPHRAGM

8 1/2 4x4 x 1/2
1 Pl. 1/2

SECTION A-A

* 5-23 56 HNT:EB PART 3

U. S. ROUTE 42 RELOCATION
INNER BELT FREEWAY - CENTRAL VIADUCT
BR. NO. CU - 42 R-17.5

TRUSS DETAILS, UNIT
PANELS 109 AND 110

CLEVELAND CUYAHOGA COUNTY OHIO

SCALE: 1"=10'


MADE DLC DATE 6-5-54 HOWARD, NEEDLES, TAMMEN & BERGENDORF
TRCD VEA DATE 10-1-54 CONSULTING ENGINEERS
CKD JGS DATE 10-5-54 KANSAS CITY CLEVELAND NEW YORK

914-1A SHEET 2 42

MICROFILMED
FEB 15 1985

FED. ROAD DIV. NO.	STATE	FEDERAL AID PROJECT NO.	TYPE FUNDS	41 122
2	OHIO			

CUYAHOGA COUNTY
CITY OF CLEVELAND
INNER BELT FREEWAY
CENTRAL VIADUCT

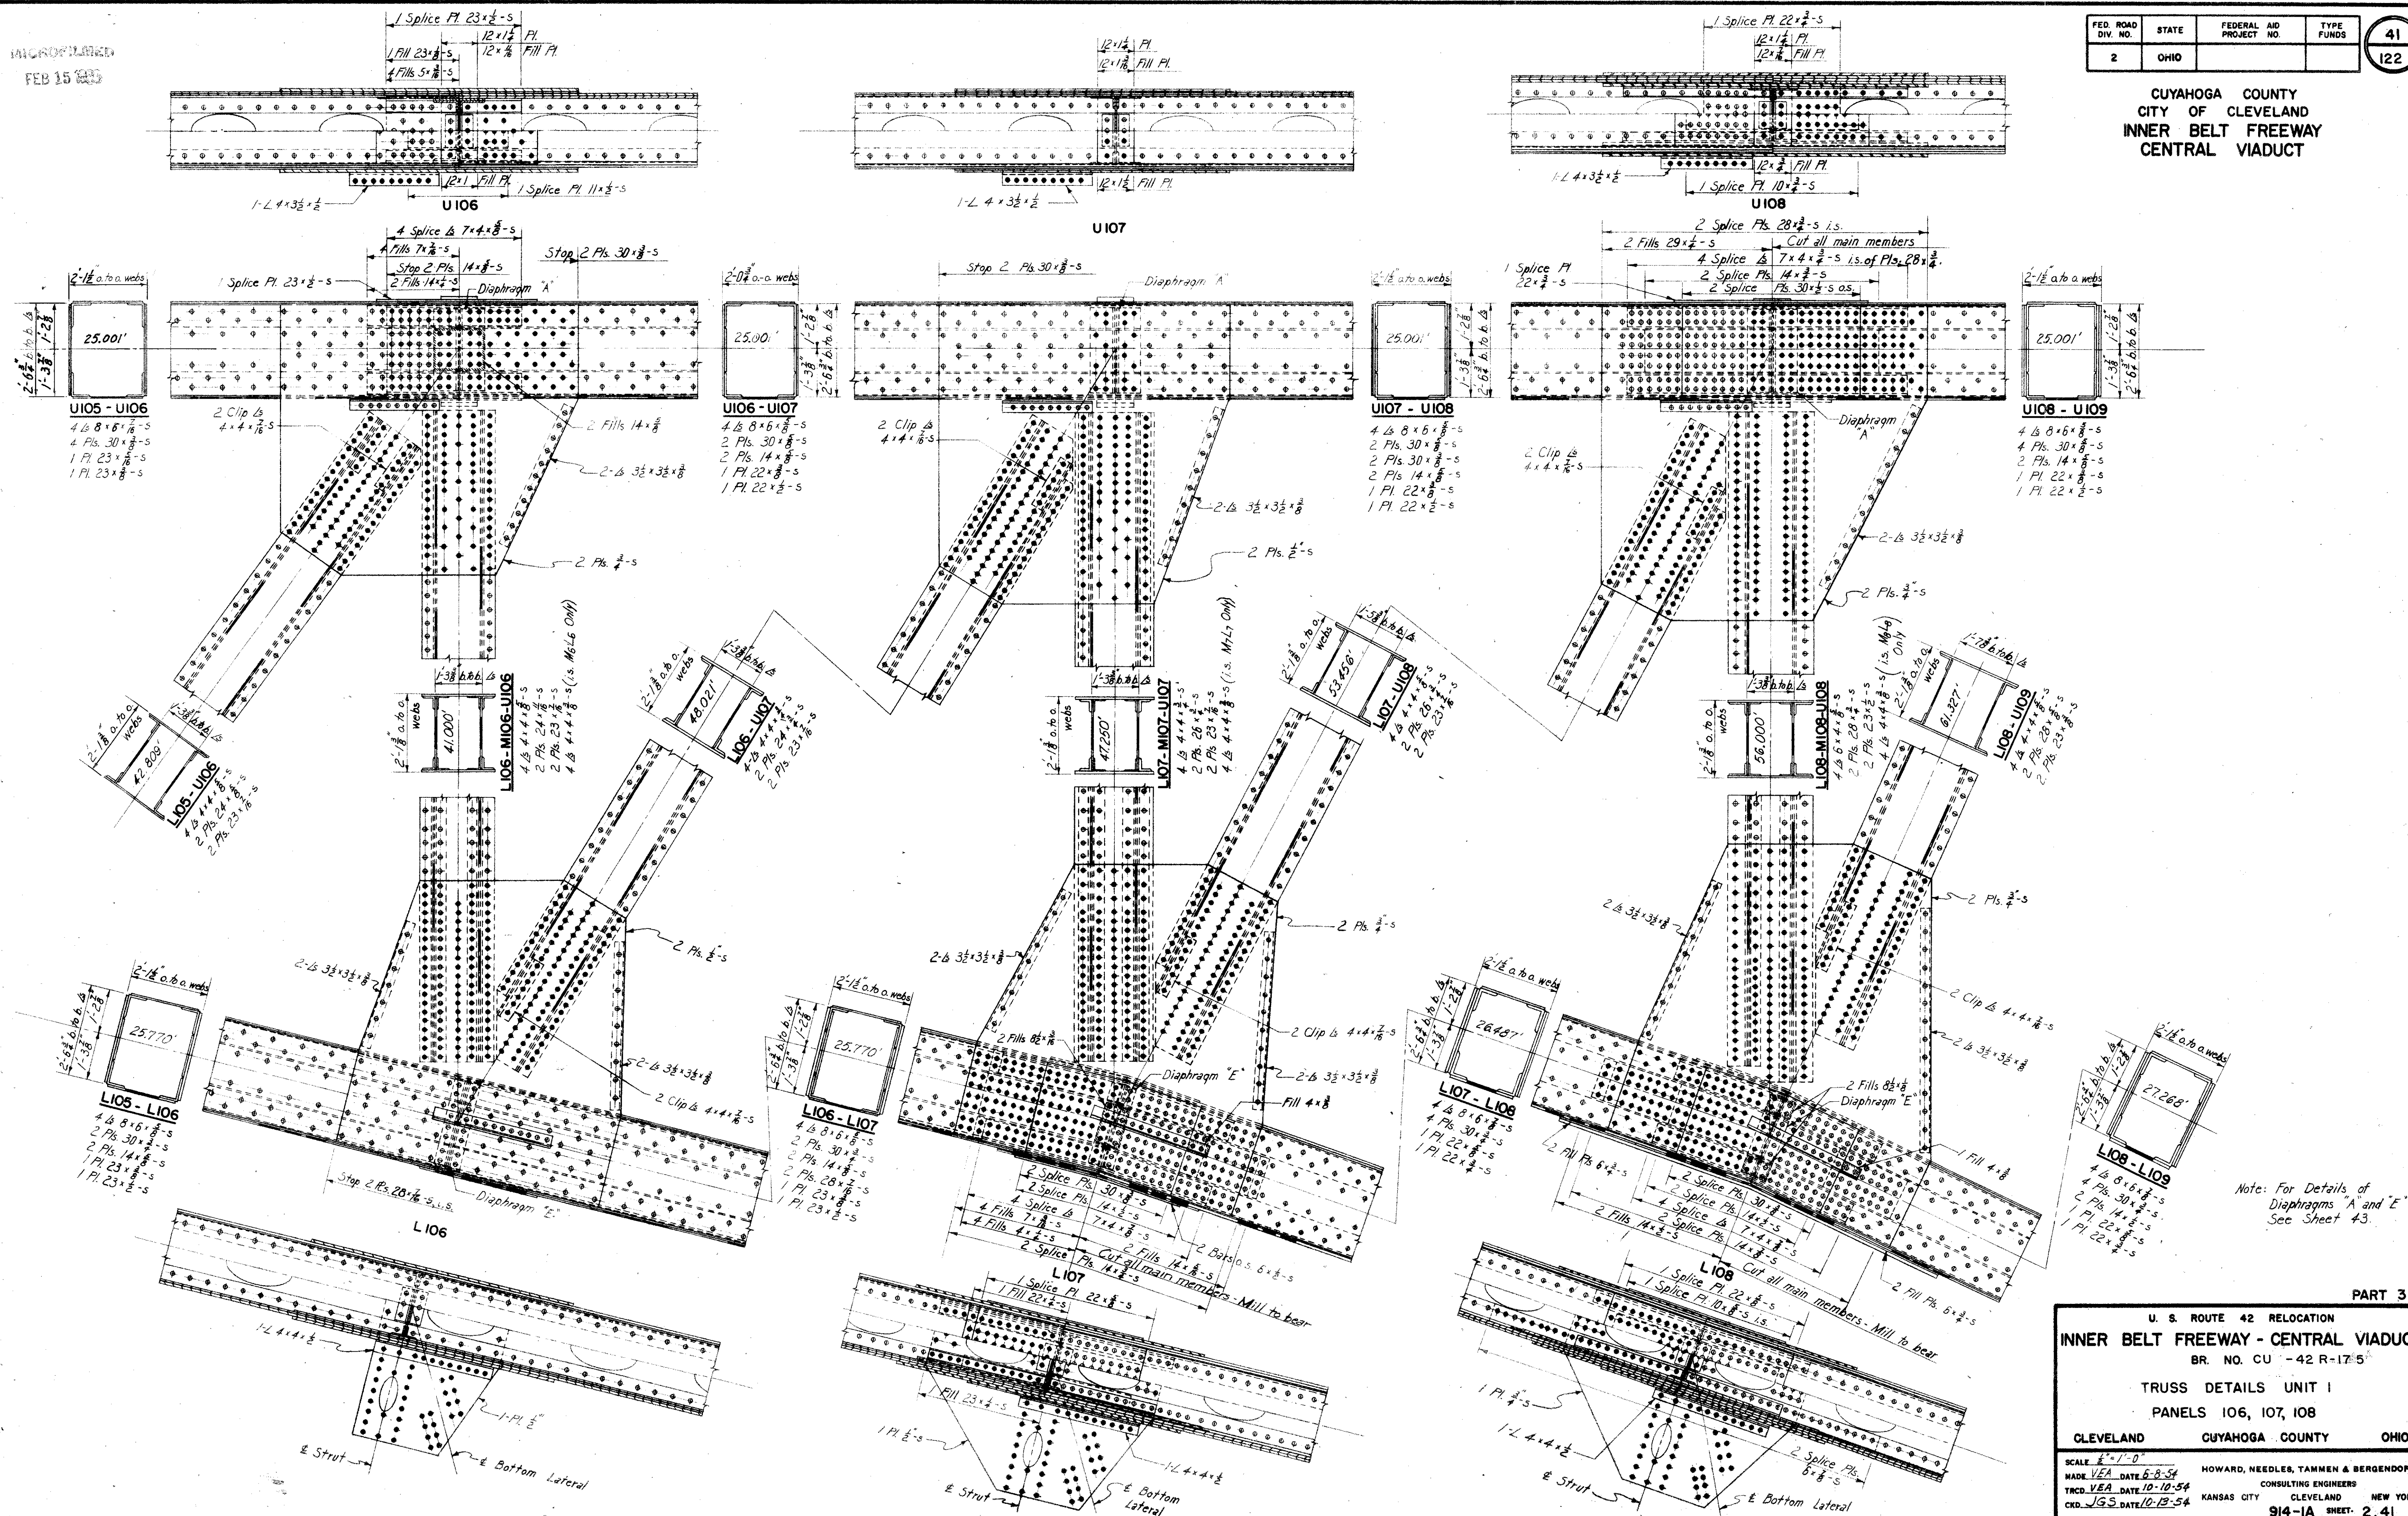


UNRECORDED
FEB 15 1954

FED. ROAD DIV. NO.	STATE	FEDERAL AID PROJECT NO.	TYPE FUNDS
2	OHIO		

40
122

CUYAHOGA COUNTY
CITY OF CLEVELAND
INNER BELT FREEWAY
CENTRAL VIADUCT

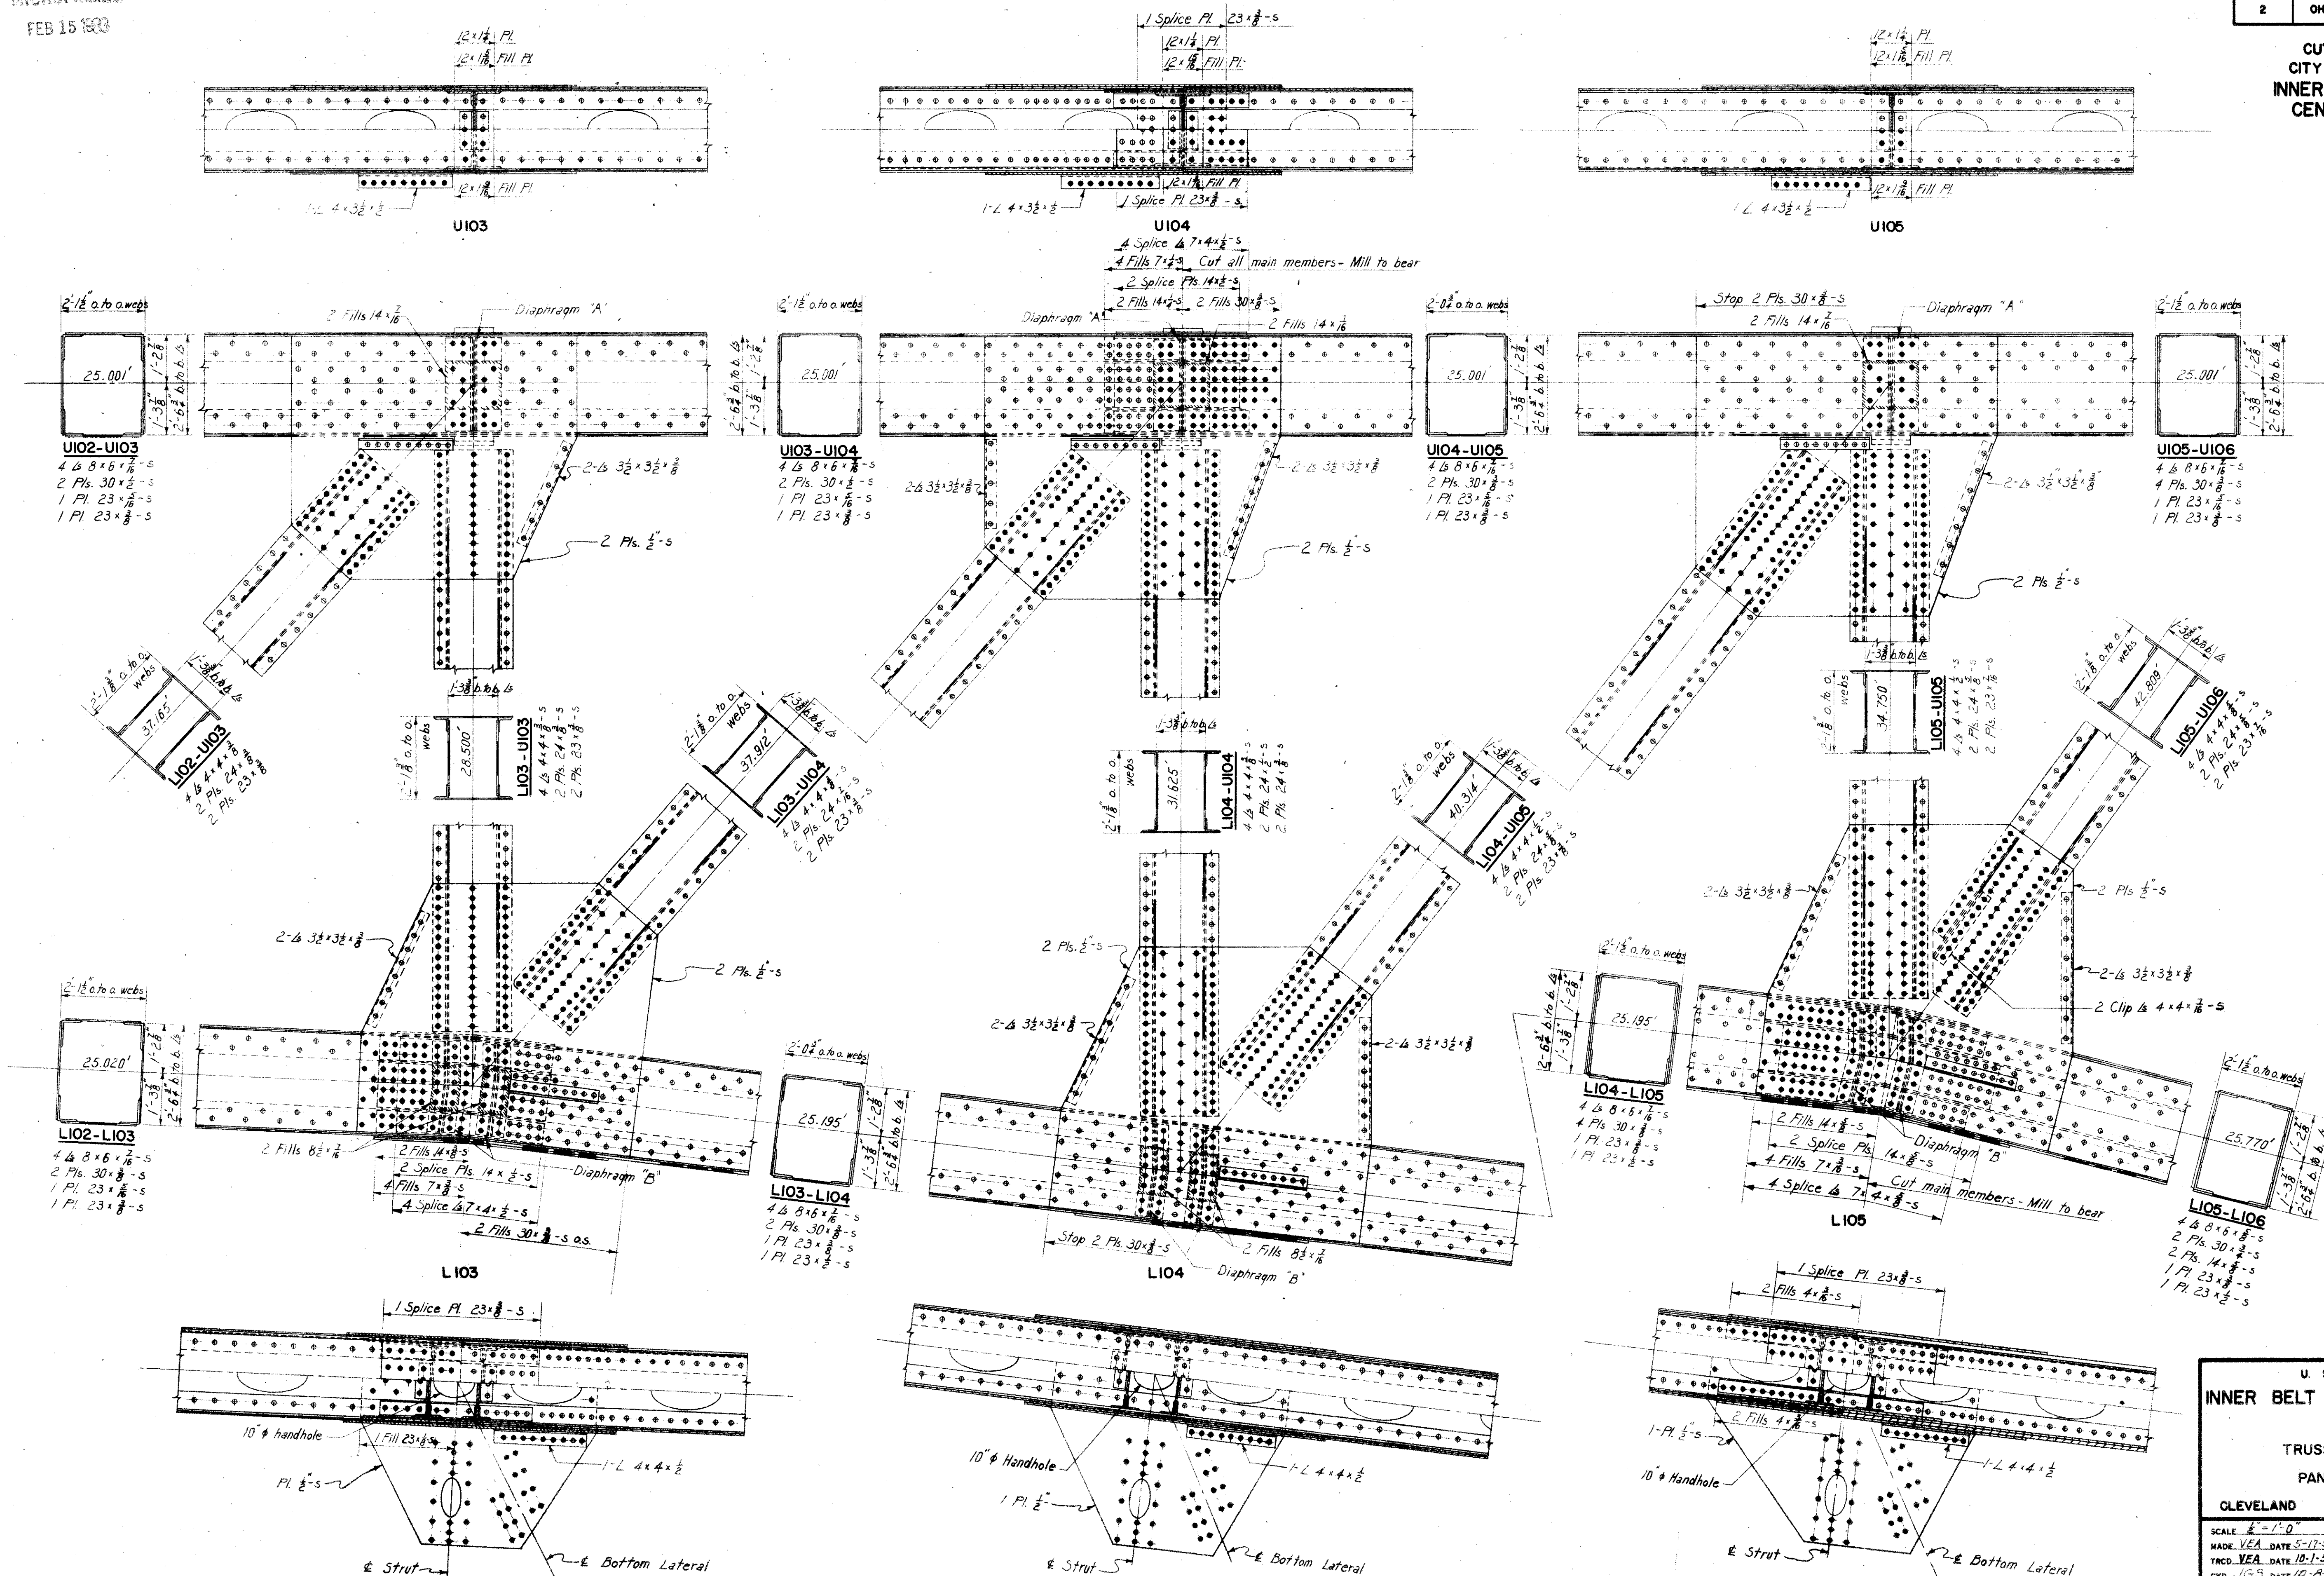

Note: For Details of Diaphragms
"A" and "B" See Sheet 43.

PART 3

U. S. ROUTE 42 RELOCATION
INNER BELT FREEWAY - CENTRAL VIADUCT
BR. NO. CU - 42R-175
TRUSS DETAILS UNIT I
PANELS 103, 104, 105
CLEVELAND CUYAHOGA COUNTY OHIO

SCALE: 1" = 1'-0"
MADE V.E.A. DATE 5-17-54
TRCD V.E.A. DATE 10-1-54
CHKD V.E.A. DATE 10-8-54

HOWARD, NEEDLES, TAMMEN & BERGENDOFF
CONSULTING ENGINEERS
KANSAS CITY CLEVELAND NEW YORK


914-1A SHEET: 2.40

MICROFILMED
FEB 15 1983

FED. ROAD DIV. NO.	STATE	FEDERAL AID PROJECT NO.	TYPE FUNDS
2	OHIO		

39
122

CUYAHOGA COUNTY
CITY OF CLEVELAND
INNER BELT FREEWAY
CENTRAL VIADUCT

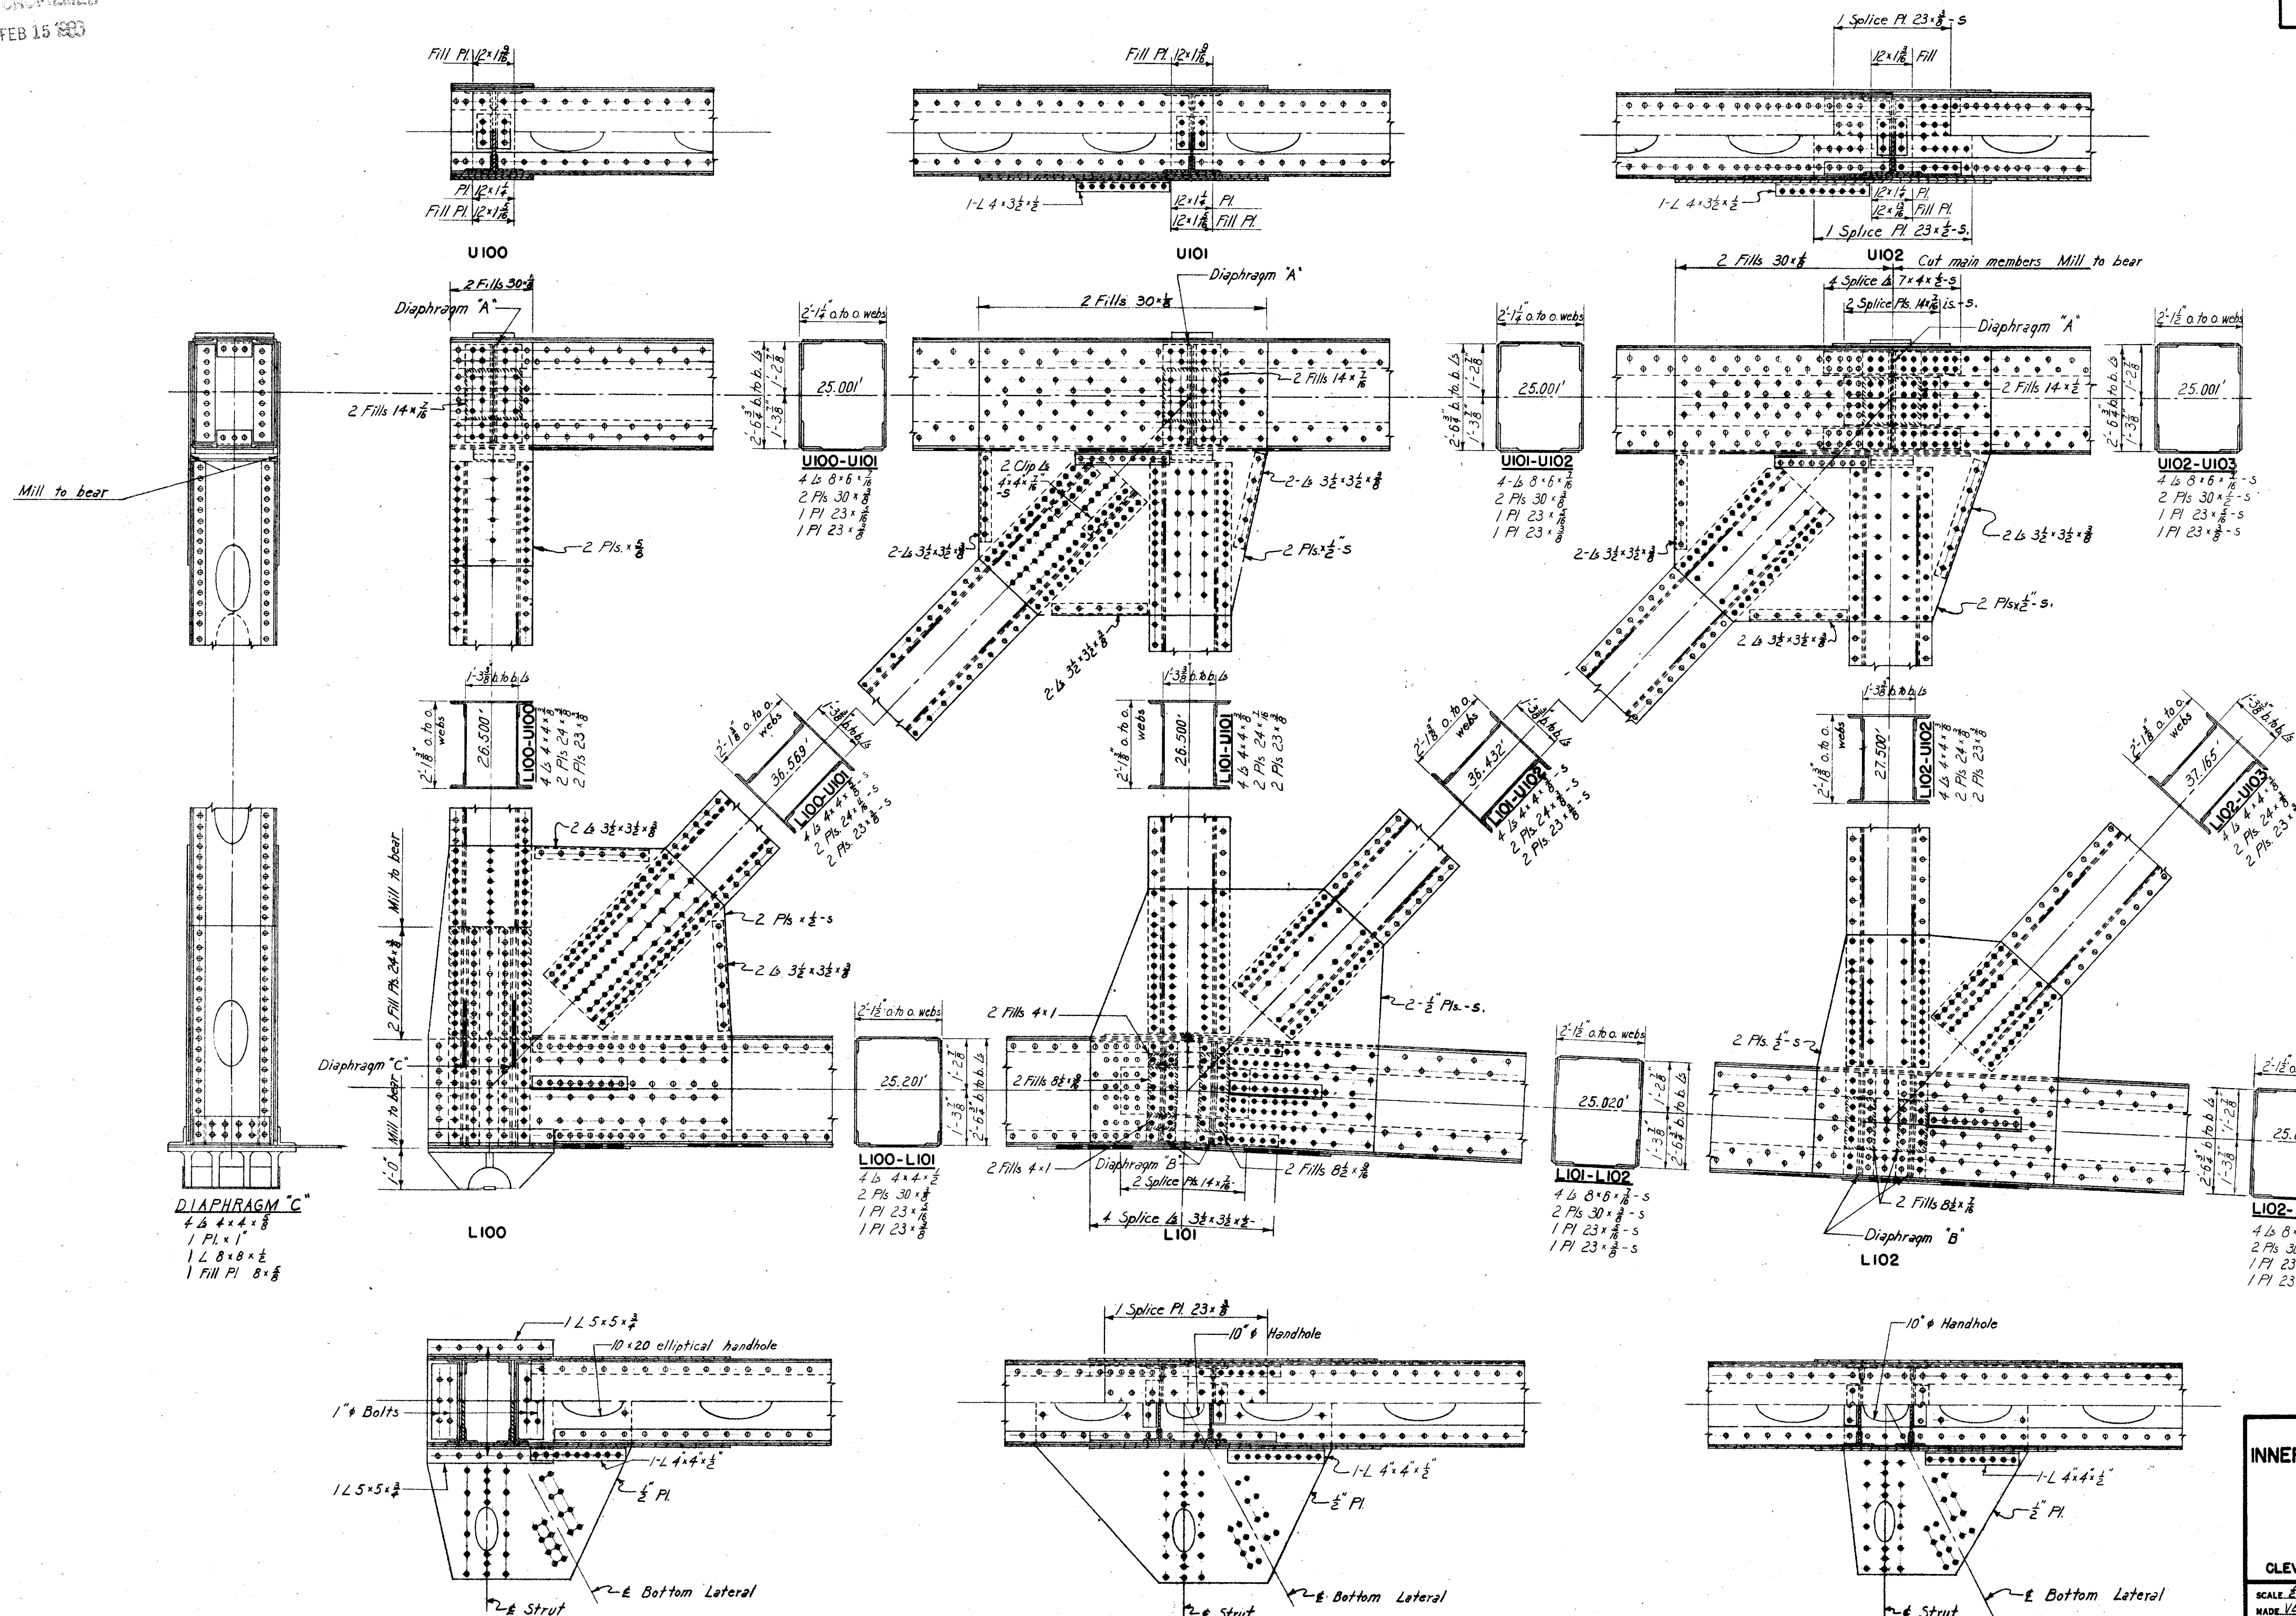

Note: For details of
Diaphragm "A" and "B"
See Sheet #3.

PART 3

U. S. ROUTE 42 RELOCATION		
INNER BELT FREEWAY - CENTRAL VIADUCT		
BR. NO. CU - 42 R-17.5		
TRUSS DETAILS UNIT I		
PANELS 100, 101, 102		
CLEVELAND	CUYAHOGA COUNTY	OHIO
SCALE: 1/2" = 1'-0"		
MADE: VEA DATE 4-28-54		
TRCD: YEA DATE 7-21-54		
CKD: JGS DATE 10-5-54		
HOWARD, NEEDLES, TAMMEN & BERGENDOFF CONSULTING ENGINEERS KANSAS CITY CLEVELAND NEW YORK		
914-1A SHEET 2.39		

REPRODUCED
FEB 15 1983

CUYAHOGA COUNTY
CITY OF CLEVELAND
INNER BELT FREEWAY
CENTRAL VIADUCT

LINE		MEMBER	TENSION CHORD													COMPRESSION CHORD															
			L100 L101	L101 L102	L102 L103	U104 U105	U105 U106	U106 U107	U107 U108	U108 U109	U109 U110	U110 U111	U111 U112	U112 U113	U100 U101	U101 U102	U102 U103	U103 U104	L103 L104	L104 L105	L105 L106	L106 L107	L107 L108	L108 L109	L109 L110	L110 L111	L111 L112	L112 L113			
1	Dead Load		+334	+384	+186	+222	+769	+1310	+1874	+2351	+2311	+1771	+998	0	0	-334	-384	-185	-224	-775	-1351	-1931	-2492	-2939	-3128	-2541	-1873	-1018			
2	0.8 Dead Load		+267	+307	+149	+178	+616	+1048	+1500	+1881	+1849	+1417	+799	0	0	-267	-307	-148	-179	-620	-1081	-1545	-1994	-2351	-2503	-2033	-1499	-815			
3	Live Load+Imp.-Tension																														
4	Reduced LL+Imp.-Tension		+271	+453	+556	+513	+585	+595	+603	+581	+484	+391	+230	0	0	+153	+295	+428	+550	+501	+392	+272	+145	0	0	0	0	0			
5	Live Load+Imp.-Comp.																														
6	Reduced LL+Imp.-Comp.		-153	-295	-428	-545	-497	-385	-266	-129	0	0	0	0	0	-271	-453	-556	-519	-587	-613	-620	-617	-597	-623	-532	-412	-236			
7	Reduced LL+Imp.-Ten.*D(CF)e		+449	+751	+922	+850	+970	+986	+1000	+963	+802	+648	+381	0	0	+254	+489	+709	+912	+830	+650	+451	+240	0	0	0	0	0			
8	Reduced LL+Imp.-Comp.*D(CF)e		-254	-489	-709	-903	-824	-638	-441	-214	0	0	0	0	0	-449	-751	-922	-860	-973	-1016	-1028	-1023	-990	-1033	-882	-683	-391			
9	Ratio = $\frac{L_{100}}{L_{101}}$ or $\frac{L_{102}}{L_{103}}$		0.458	0.768	2.300	2.455	0.647	0.294	0.142	0.055	0	0	0	0	0	0.458	0.768	2.310	2.455	0.647	0.290	0.141	0.058	0	0	0	0	0			
10	LL Sidewalk-Tension		+13	+22	+27	+29	+33	+33	+34	+32	+26	+20	+11	0	0	+9	+16	+24	+27	+25	+19	+13	+6	0	0	0	0	0			
11	LL Sidewalk-Comp.		-9	-16	-24	-27	-25	-19	-13	-6	0	0	0	0	0	-9	-16	-22	-27	-29	-33	-34	-35	-34	-33	-35	-28	-12			
12	Direct Design Stress		+729	+1080	+1098	+1057	+1619	+2067	+2534	+2876	+2677	+2085	+1191	0	0	-729	-1080	-1097	-1068	-1626	-2131	-2608	-3051	-3374	-3571	-2943	-2203	-1218			
13	Reverse Design Stress																														



LINE	MEMBER	TENSION WEB MEMBERS													COMPRESSION WEB MEMBERS																						
		L102 U103	L103 U104	L104 U105	L105 U106	L106 U107	L107 U108	L108 U109	U109 L110	U110 L111	U111 L112	U112 L113	U101 L101	U102 L102				U100 L100	U101 L101	L101 U102	U103 L103	U104 L104	U105 L105	U106 L106	U107 L107	U108 L108	U109 L109	U110 L110	U111 L111	U112 L112							
1	Dead Load	+295	+618	+881	+928	+1082	+1022	+842	+914	+1070	+1306	+1501	+230	+67				-102	-488	-73	-339	-595	-816	-889	-1032	-1075	-1218	-1051	-1195	-1761	-1910	-1078	-1222	-1193	-1336	-1256	
2	0.8 Dead Load	+236	+495	+705	+743	+866	+818	+674	+731	+856	+1045	+1201	+184	+54				-82	-391	-59	-271	-476	-653	-711	-826	-860	-975	-841	-956	-1409	-1528	-863	-978	-954	-1069	-1005	
3	Live Load + Imp.-Tension																	0	+225	+208	+132	+58	+33	+2	+2	+2	+2	+40	+40	+23	+23	0	0	0	0	0	
4	Reduced LL + Imp.-Tension	+207	+196	+211	+252	+277	+308	+315	+201	+238	+298	+347	+254	+183				0	+225	+208	+132	+58	+33	+2	+2	+2	+2	+40	+40	+23	+23	0	0	0	0	0	
5	Live Load + Imp.-Comp.																	0	+225	+208	+132	+58	+33	+2	+2	+2	+2	+40	+40	+23	+23	0	0	0	0	0	
6	Reduced LL + Imp.-Comp.	-219	-112	-69	-7	-3	-47	-105	0	0	0	0	-163	-152				-47	-397	-296	-154	-154	-175	-220	-271	-249	-296	-288	-333	-347	-386	-220	-267	-255	-296	-274	
7	Reduced LL + Imp.-Ten. x D(CF)e	+343	+325	+349	+418	+459	+511	+522	+333	+395	+494	+575	+421	+303				0	+373	+345	+219	+96	+55	+4	+4	+4	+4	+66	+66	+38	+38	0	0	0	0	0	
8	Reduced LL + Imp.-Comp. x D(CF)e	-363	-186	-115	-12	-5	-78	-174	0	0	0	0	-270	-252				-78	-658	-491	-255	-255	-290	-365	-449	-413	-491	-477	-552	-575	-640	-365	-443	-423	-491	-454	
9	Ratio = $\frac{L_{102}}{L_{103}}$ or $\frac{L_{104}}{L_{105}}$	0.742	0.182	0.078	0.007	0.003	0.046	0.125	0	0	0	0	0.709	2.265				0	0.461	2.850	0.407	0.098	0.041	0.002	0.002	0.002	0.038	0.033	0.013	0.012	0	0	0	0	0		
10	LL Sidewalk-Tension	+12	+11	+13	+11	+13	+14	+15	+10	+12	+15	+17	+12	+8				0	+13	+12	+6	+2	+1	0	0	0	0	+2	+2	+1	+1	0	0	0	0	0	
11	LL Sidewalk-Comp.	-9	-4	-2	0	0	-3	-6	0	0	0	0	-9	-8				-1	-19	-13	-9	-9	-11	-10	-12	-12	-14	-14	-16	-20	-22	-12	-14	13	-15	-14	
12	Direct Design Stress	+591	+831	+1067	+1172	+1338	+1343	+1211	+1074	+1263	+1554	+1793	+617	+365				-161	-1068	-563	-535	-740	-954	-1086	-1287	-1285	-1480	-1332	-1524	-2004	-2190	-1240	-1435	-1390	-1575	-1473	
13	Reverse Design Stress													-206						+298																	
SECTION		Holes out for Tension																																			
a	Outer Flange Angles	2	4x4x3/8	4x4x3/8	4x4x1/2	4x4x5/8	4x4x3/4	4x4x3/8	4x4x5/8	4x4x1/2	4x4x3/4	4x4x5/8	4x4x3/8	4x4x3/8	4x4x3/8	4x4x3/8	4x4x3/8	4x4x3/8	4x4x3/8	4x4x3/8	4x4x3/8	4x4x3/8	4x4x1/2	4x4x3/8	4x4x3/8	4x4x3/8	4x4x3/8	4x4x3/8	4x4x3/8	4x4x3/8	4x4x3/8	4x4x3/8	4x4x3/8	4x4x3/8	4x4x3/8	4x4x3/8	
b	1 st Web Plates	3	24 x 3/8	24 x 3/8	24 x 3/8	24 x 3/8	24 x 3/4	26 x 3/4	28 x 5/8	28 x 1/2	26 x 3/4	24 x 1/2	24 x 5/8	24 x 1/8	24 x 3/8	24 x 3/8	24 x 3/8	24 x 3/8	24 x 1/8	24 x 1/8	24 x 1/8	24 x 1/2	24 x 5/8	24 x 1/8	24 x 1/8	24 x 1/8	24 x 1/8	24 x 1/8	24 x 1/8	24 x 1/8	24 x 1/8	24 x 1/8	24 x 1/8	24 x 1/8	24 x 1/8	24 x 1/8	24 x 1/8
c	Cover Plates	2	23x3/8(10"Hole)	23x3/8(10"Hole)	d	Inner Flange Angles	2																																			
e	2 nd Web Plates	3																																			
Length	In.																	318	438.8	437.2	342	379.5	417	492	492	567	567	672	672	816	816	650	650	513	513	410	
Min. Radius of Gyration	In.																	7.70	7.70	7.70	7.70	7.60	7.63	7.69	7.50	8.00	7.78	8.56	8.28	9.08	8.87	8.50	8.23	7.96	7.75	7.63	
Allowable Stress	Lbs./Sq. In.	18,000	24,000	24,000	24,000	24,000	24,000	24,000	24,000	24,000	24,000	24,000	24,000	24,000	18,000	18,000	18,000	14,570	18,510	18,520	19,090	18,850	18,630	18,020	18,020	17,560	17,560	17,040	17,040	16,110	16,110	17,130	17,130	17,980	17,980	18,670	
Actual Gross Area	Sq. In.	39.19	42.19	54.75	59.82	69.14	68.82	63.19	55.25	65.38	80.26	88.94	42.19	39.19	39.19	39.19	39.19	39.19	61.19	39.19	39.19	45.94	56.38	62.82	74.26	72.14	83.58	78.44	89.88	125.44	136.88	72.38	83.82	78.64	90.08	81.74	
Net Area	Sq. In.	32.44	35.07	45.50	49.32	56.89	56.07	51.69	45.50	53.63	66.51	74.69	35.07	32.44	31.88	59.64	31.33	31.33	39.28	52.78	61.27	74.26	72.14	83.58	78.44	89.88	125.44	136.88	72.38	83.82	78.64	90.08	81.74	81.74			
Actual Unit Stress	Lbs./Sq. In.	18,220	23,700	23,450	23,760	23,500	23,950	23,430	23,600	23,550	23,370	24,000	17,600	11,250	5,050	17,910	17,970	17,070	18,820	18,080	17,700	17,300	17,800	17,700	17,000	16,950	15,980	16,000	17,130	17,130	17,670	17,500	18,150	18,150			
Material	C	S	S	S	S	S	S	S	S	S	S	S	S	C	C	S	S	S	S	S	S	S	S	S	S	S	S	S	S	S	S	S	S	S	S		

INCH FILLED
FEB 15 1953

FED. ROAD DIV. NO.	STATE	FEDERAL AID PROJECT NO.	TYPE FUNDS
2	OHIO		

37
122

CUYAHOGA COUNTY
CITY OF CLEVELAND
INNER BELT FREEWAY
CENTRAL VIADUCT

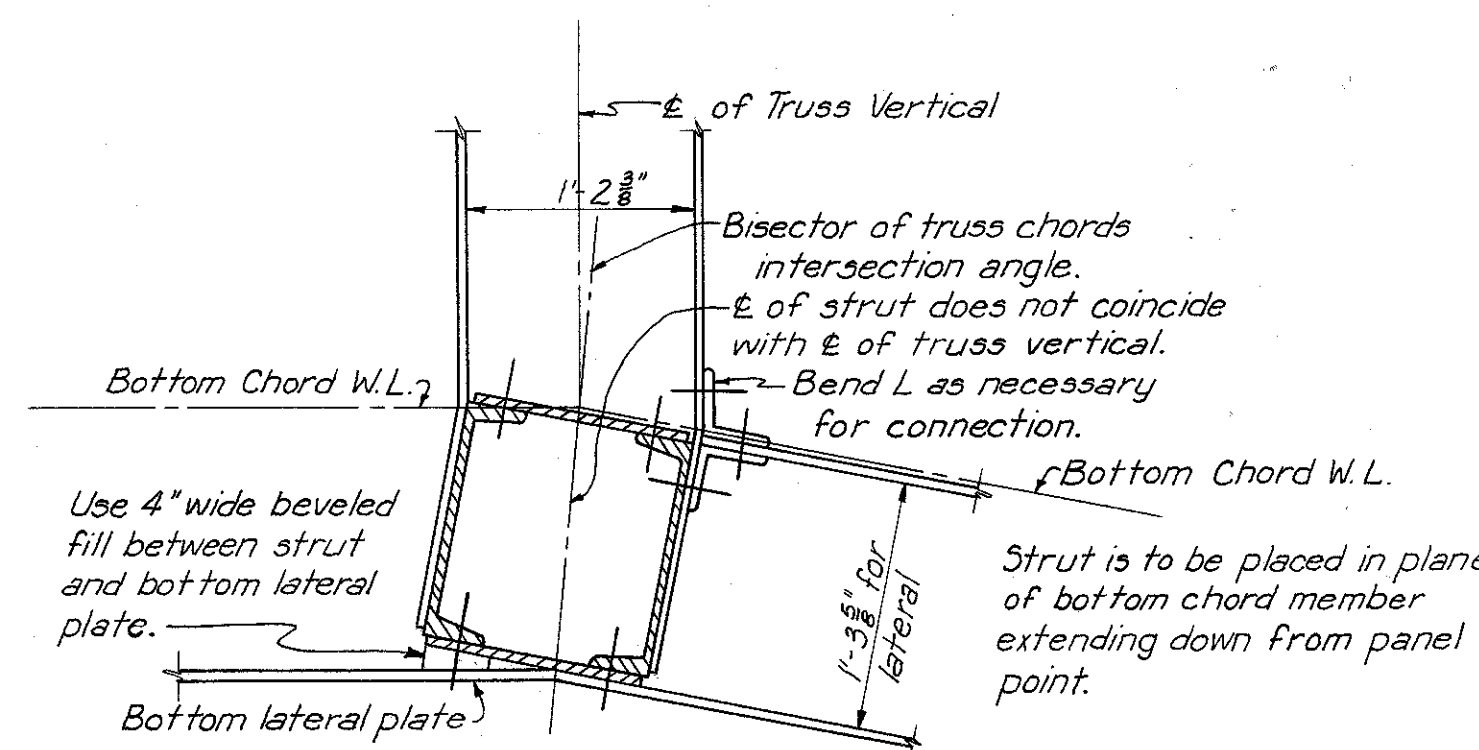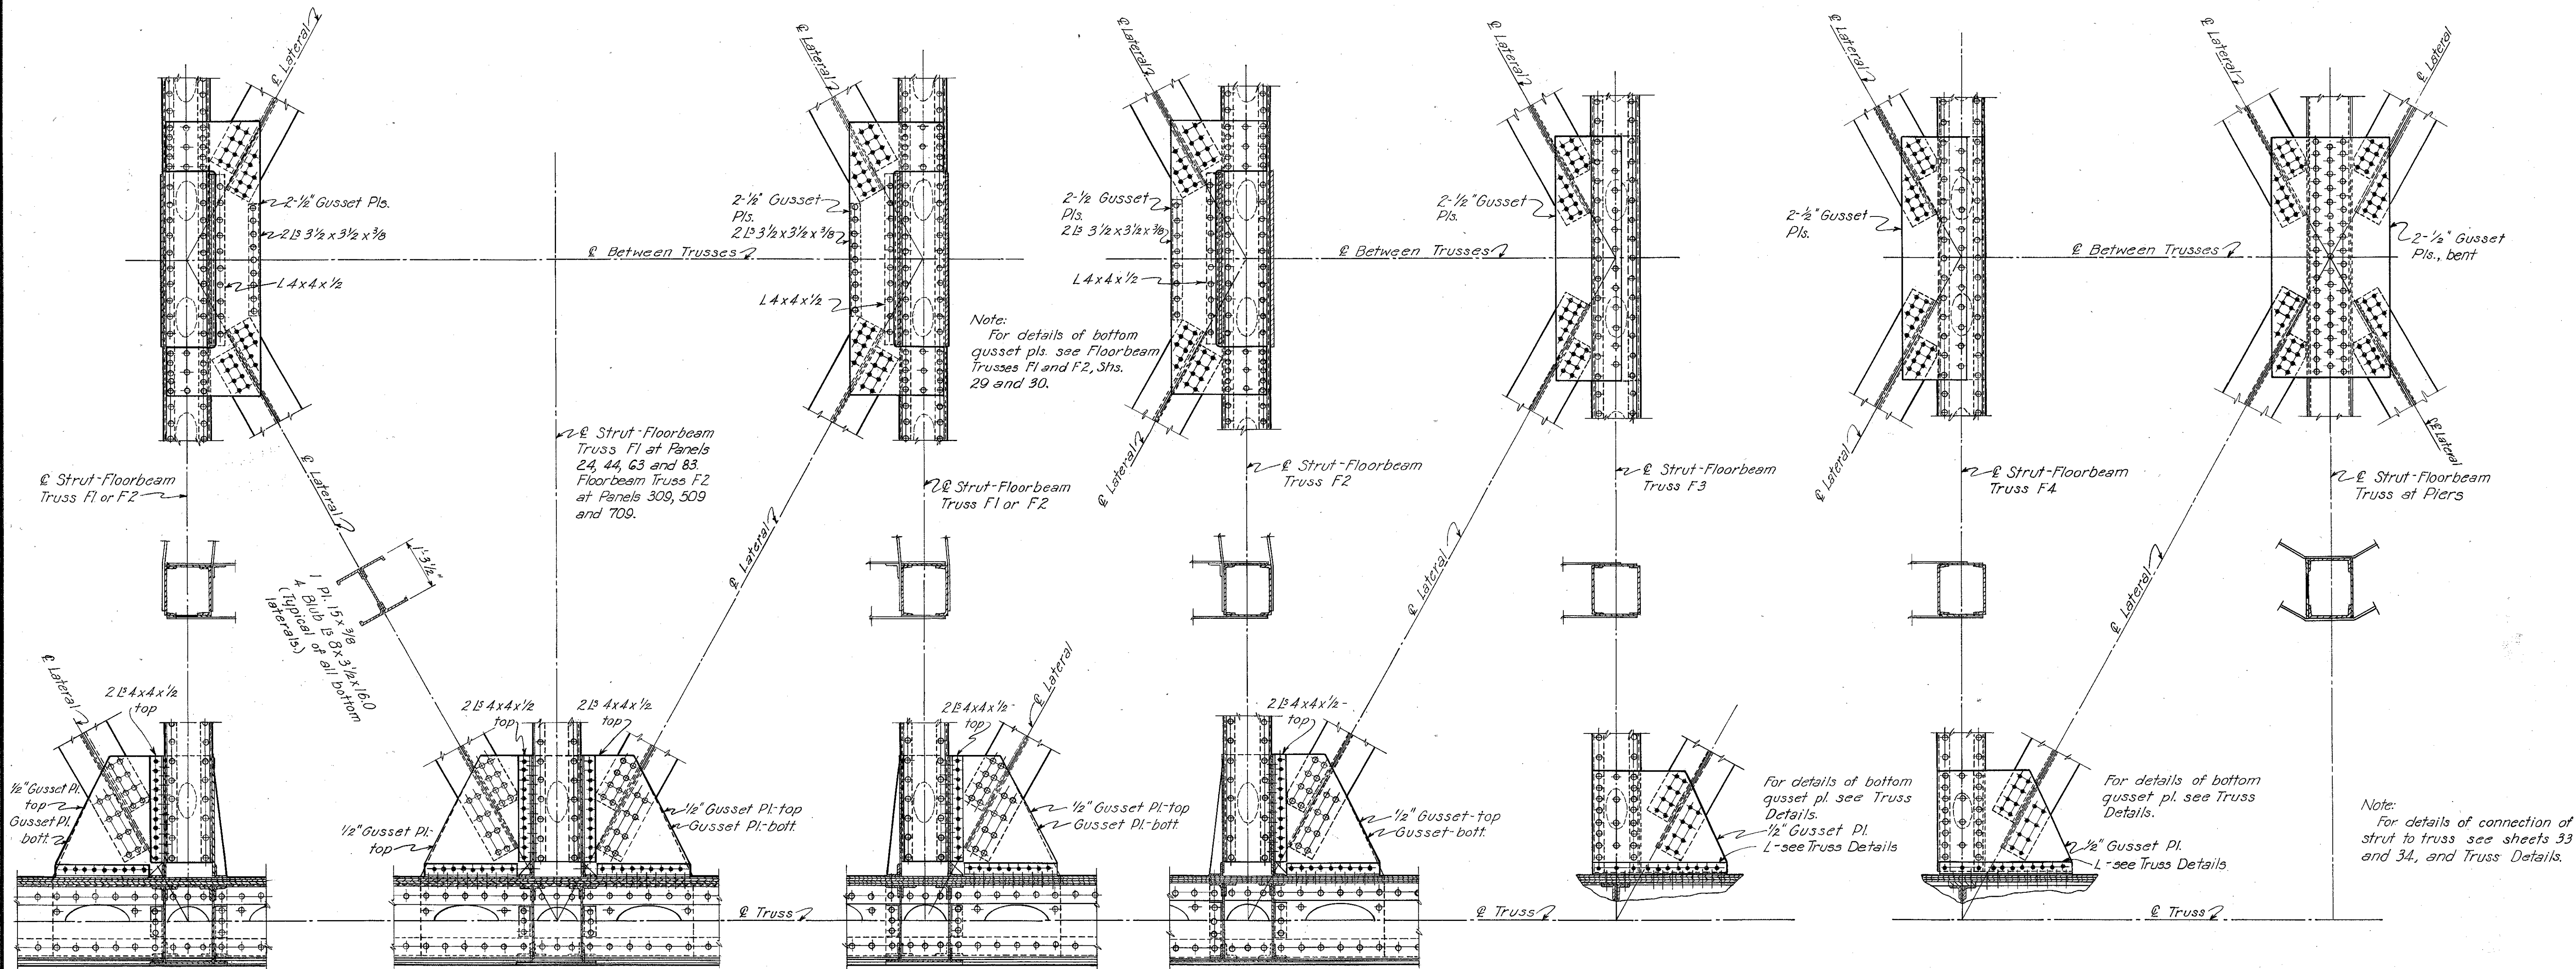

RELATION OF STRUT TO TRUSS MEMBERS
Floorbeam Trusses F1 and F2
Scale: 1\"/>

Material for Floorbeam Truss Bottom Struts
is listed on these sheets:
F1 - Sheet 29
F2 - Sheet 30
F3 - Sheet 31
F4 - Sheet 31
Struts at Piers - Sheets 33 and 34

Note:
For additional details of connections, see
respective Floorbeam Trusses.
For additional details of lower gusset pl.
connecting laterals and strut to truss see Truss
Details.

PART 3

U. S. ROUTE 42 RELOCATION
INNER BELT FREEWAY - CENTRAL VIADUCT
BR. NO. CU - 42 R-17.5

BOTTOM LATERALS





CLEVELAND CUYAHOGA COUNTY OHIO

SCALE: 1/2\"/>

MICROFILMED
FEB 15 1983

FED. ROAD DIV. NO.	STATE	FEDERAL AID PROJECT NO.	TYPE FUNDS	36 122
2	OHIO			

CUYAHOGA COUNTY
CITY OF CLEVELAND
INNER BELT FREEWAY
CENTRAL VIADUCT

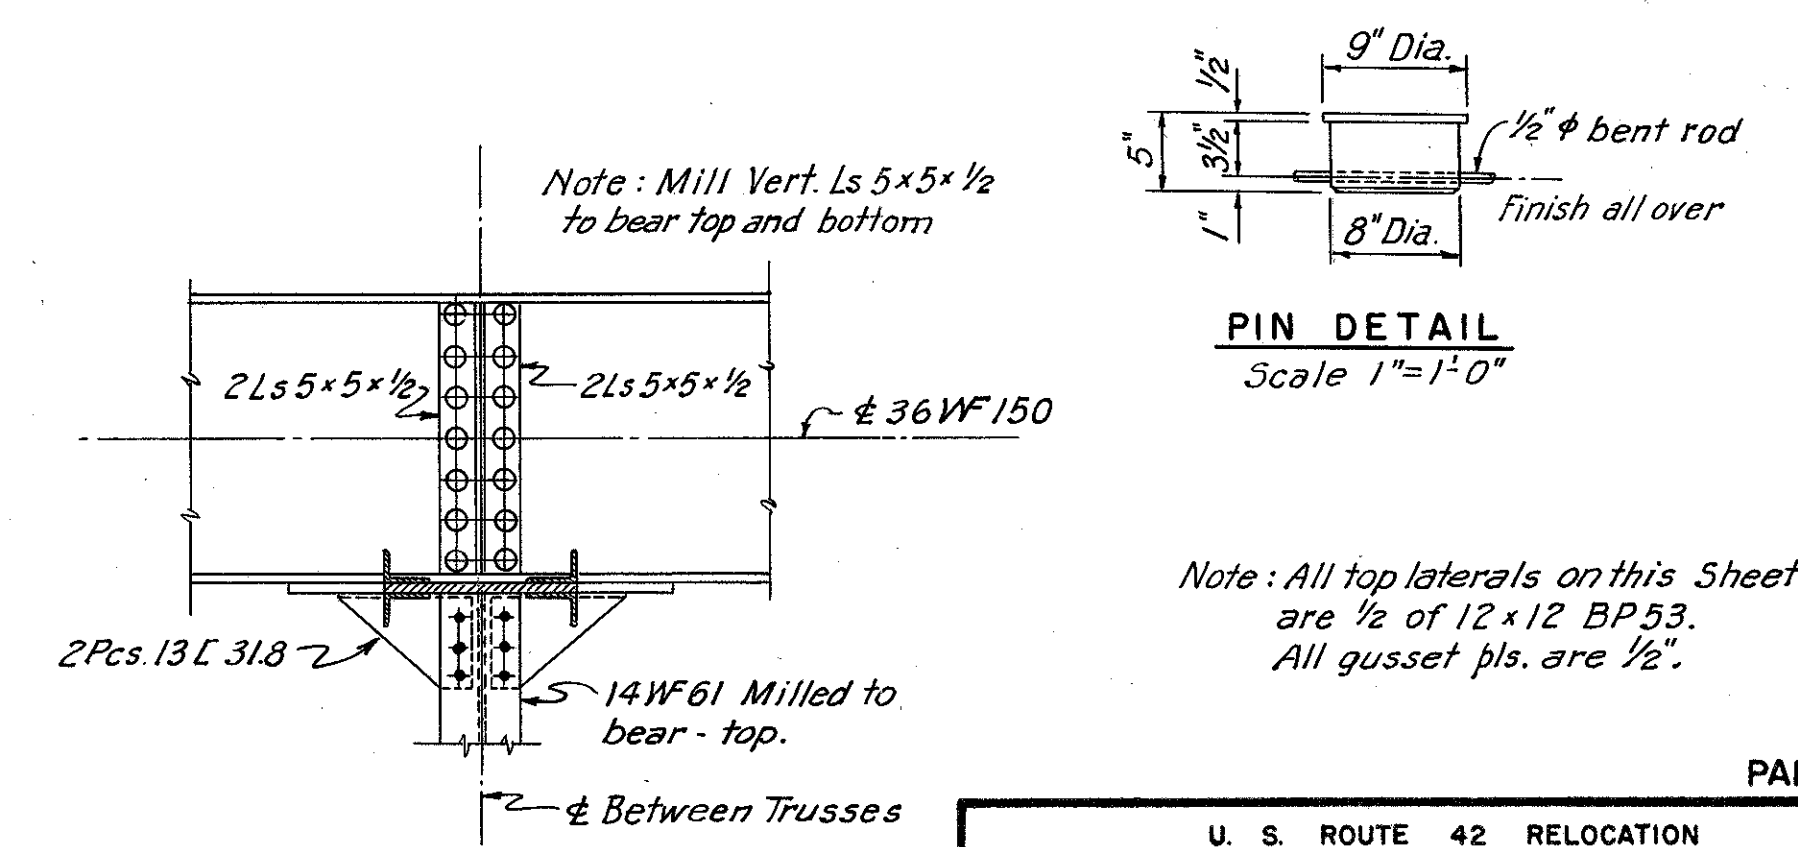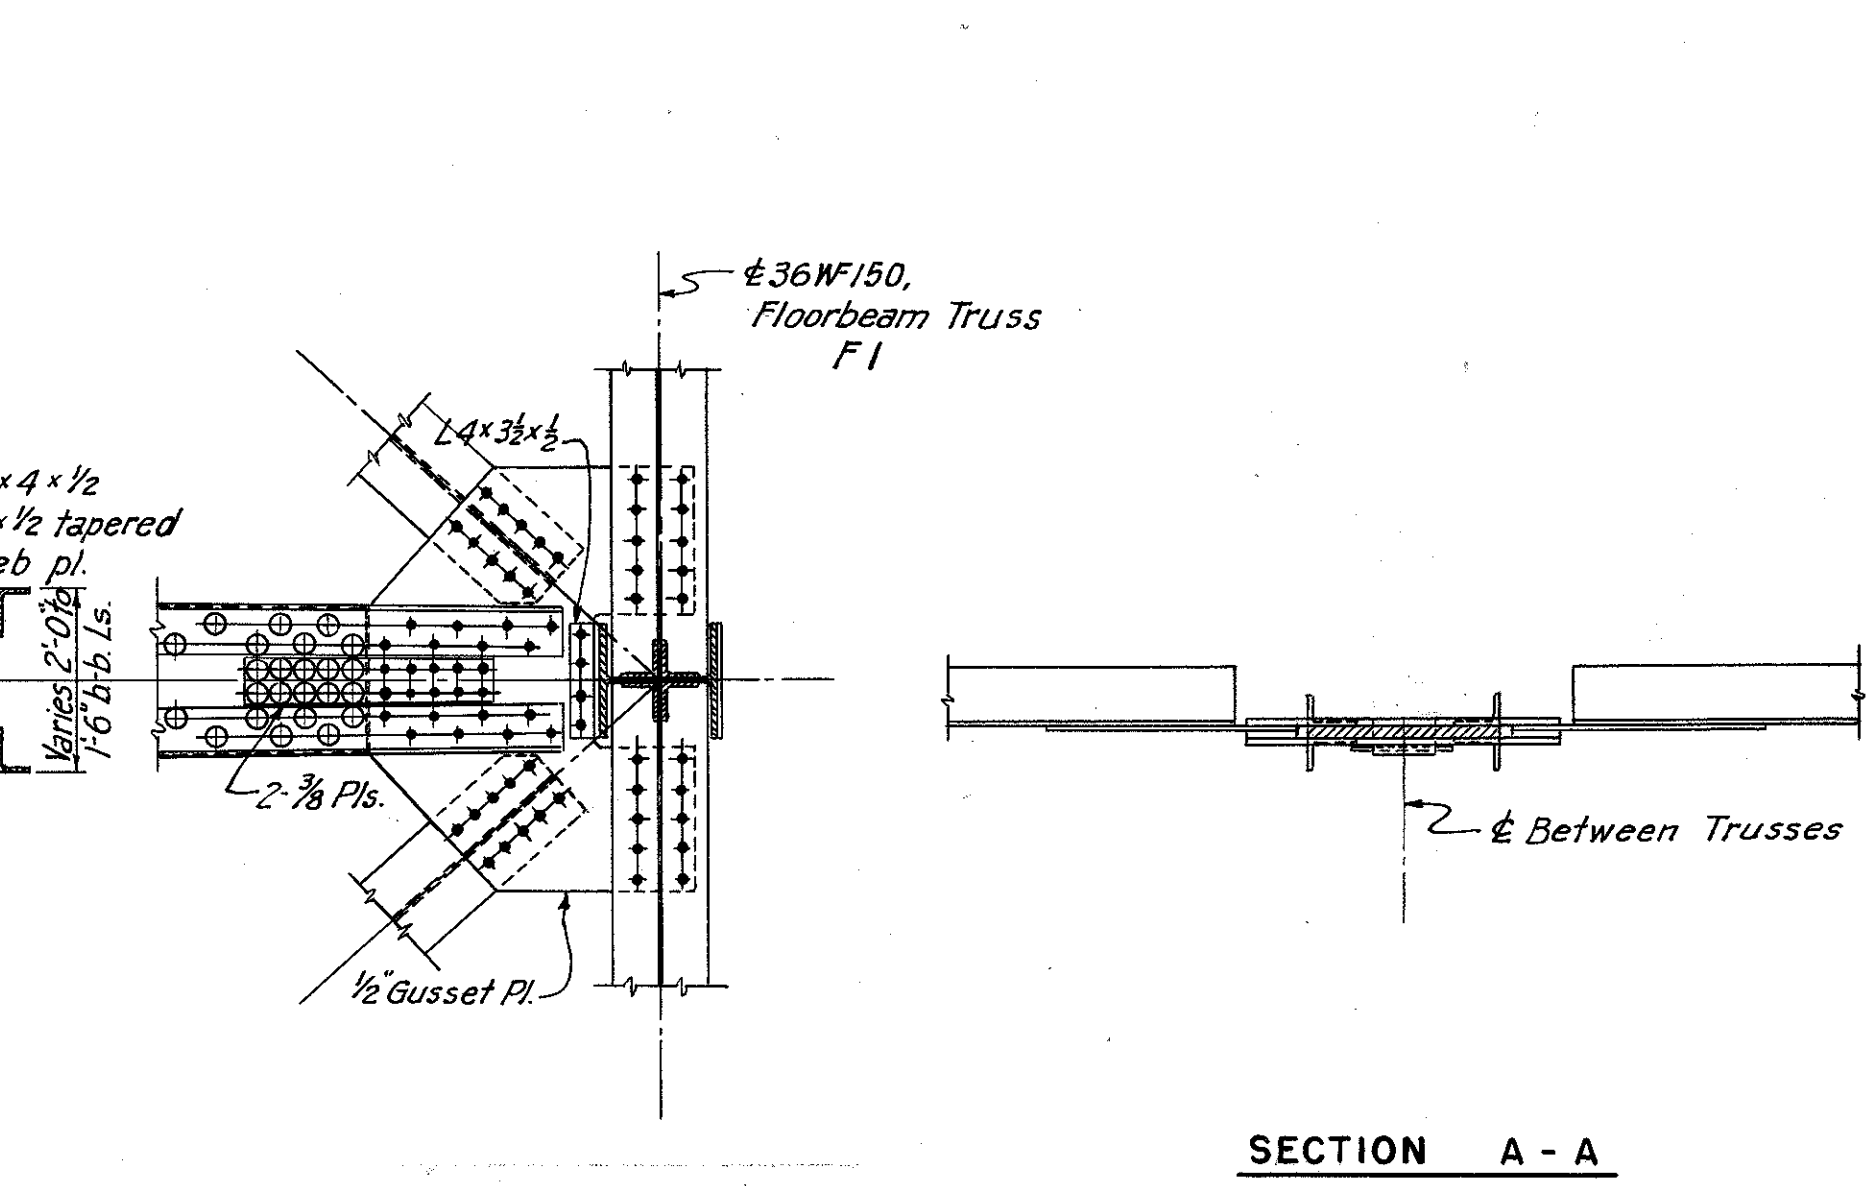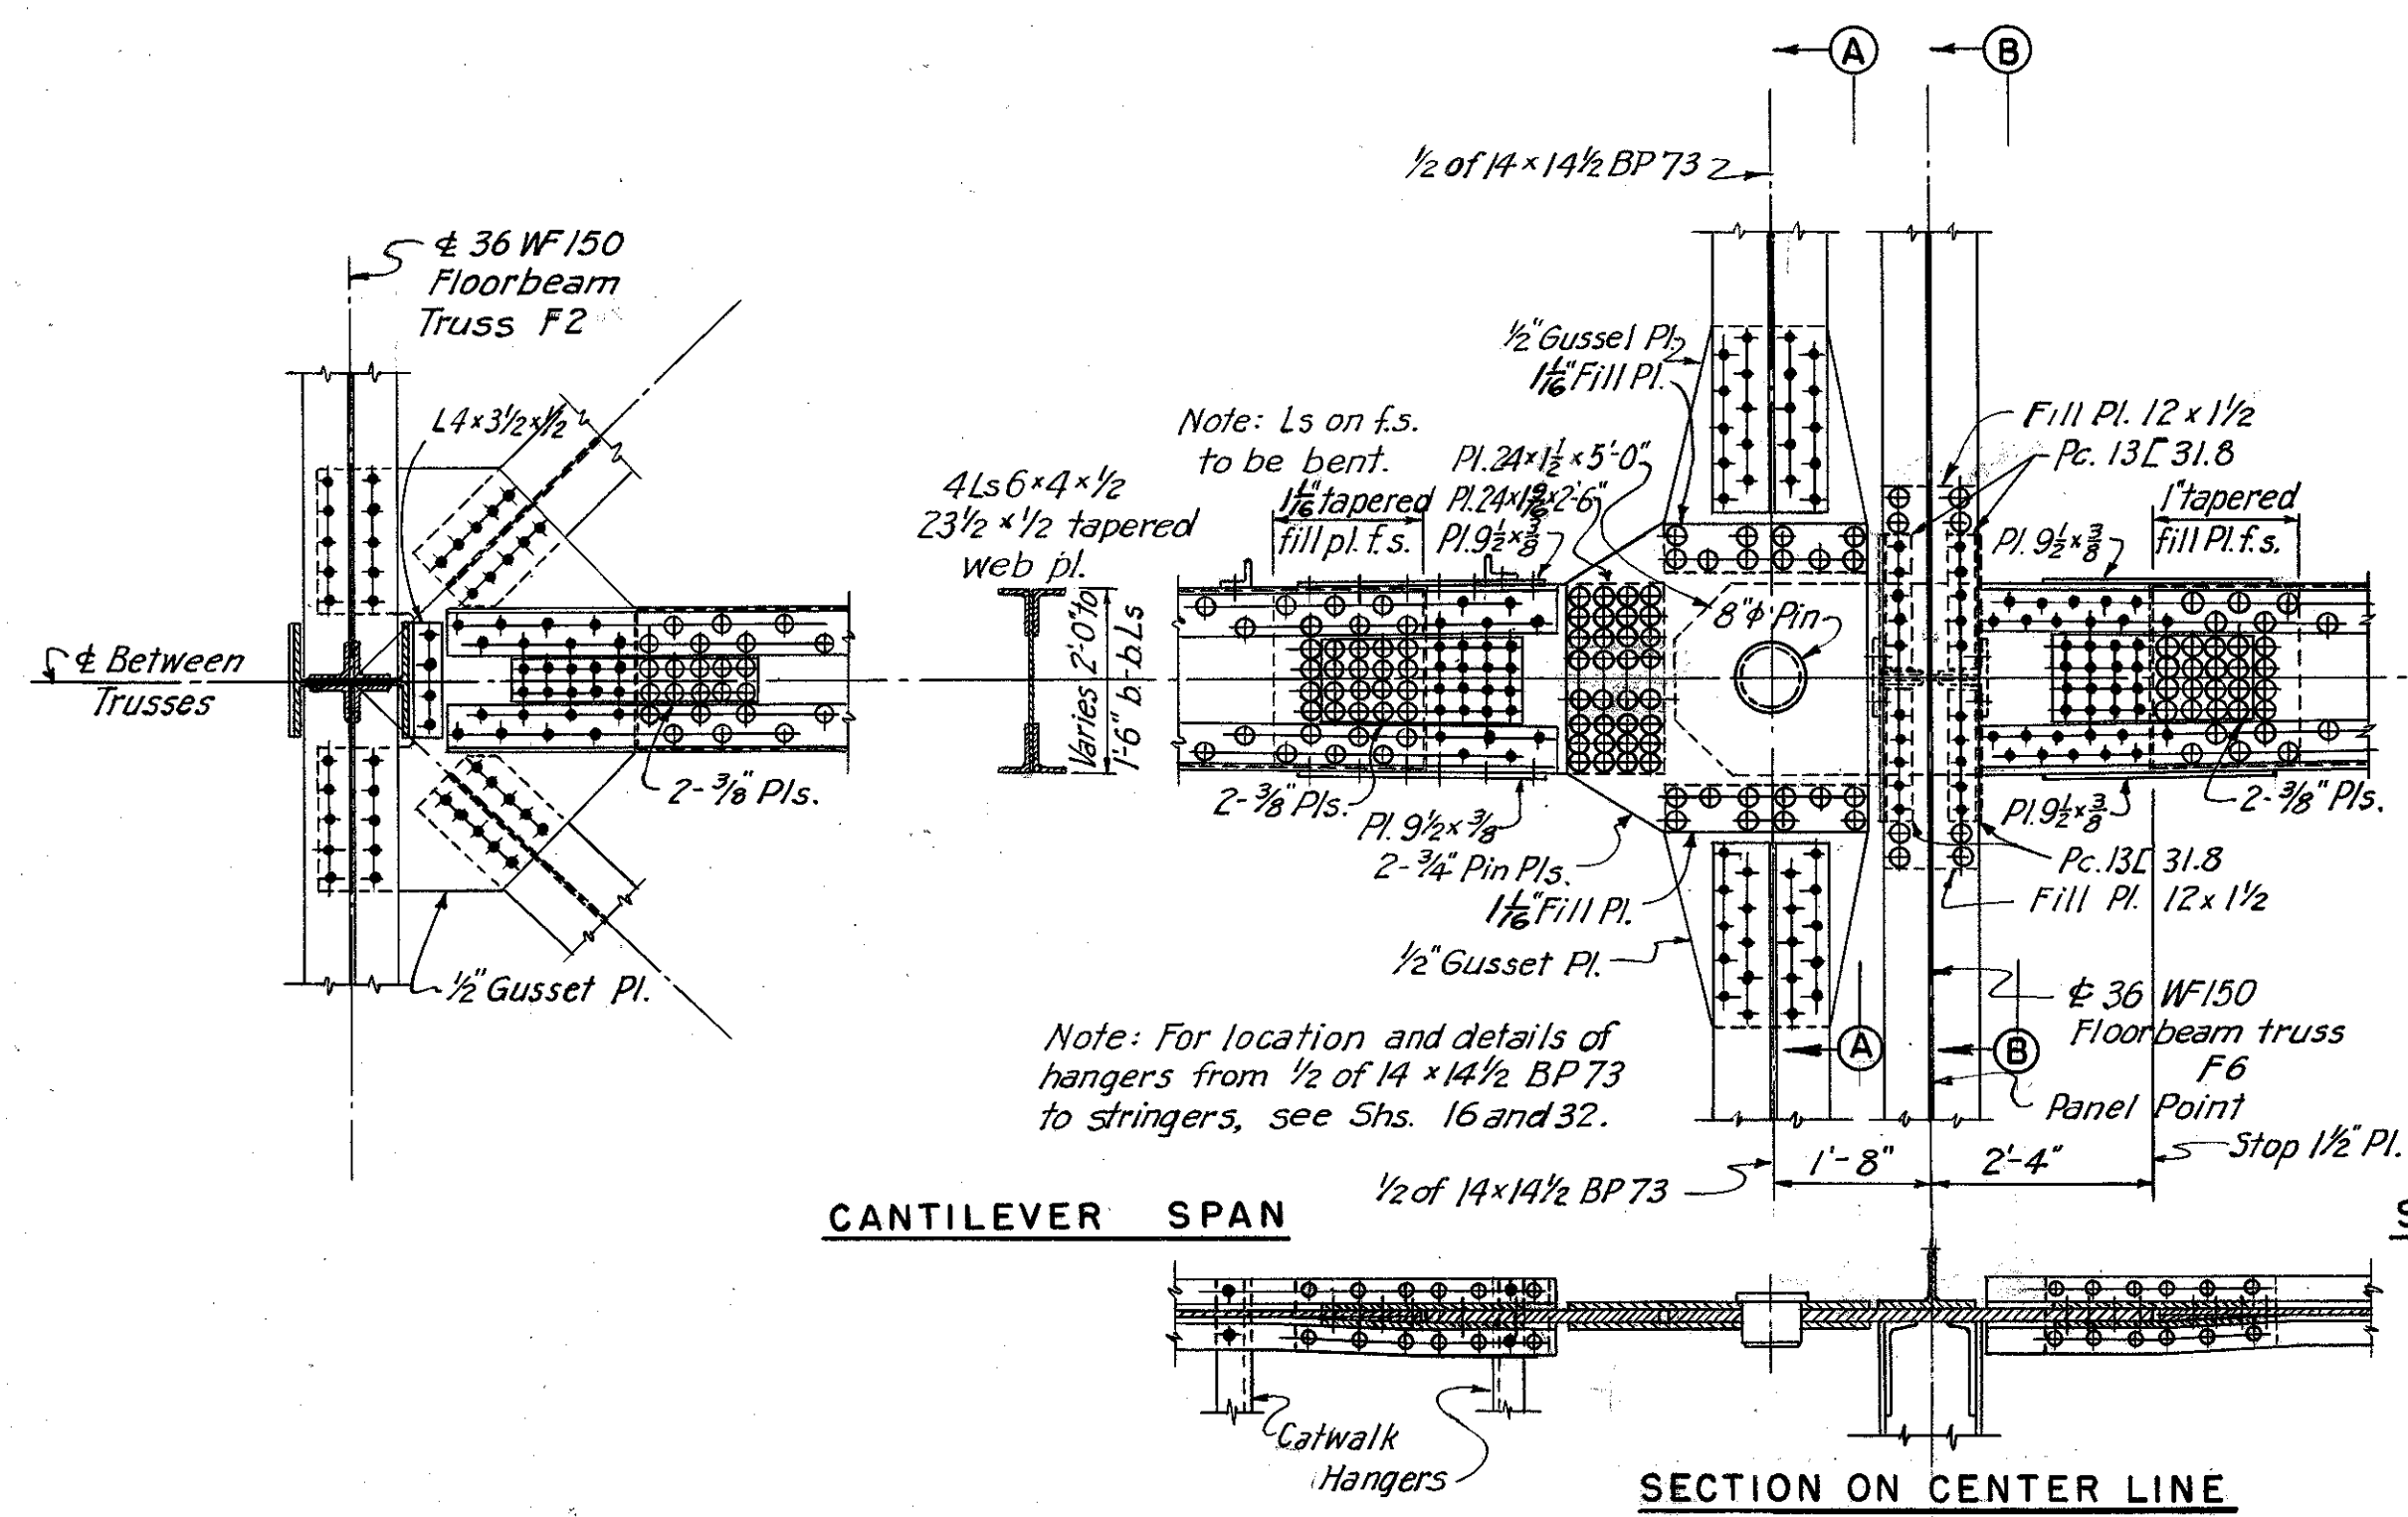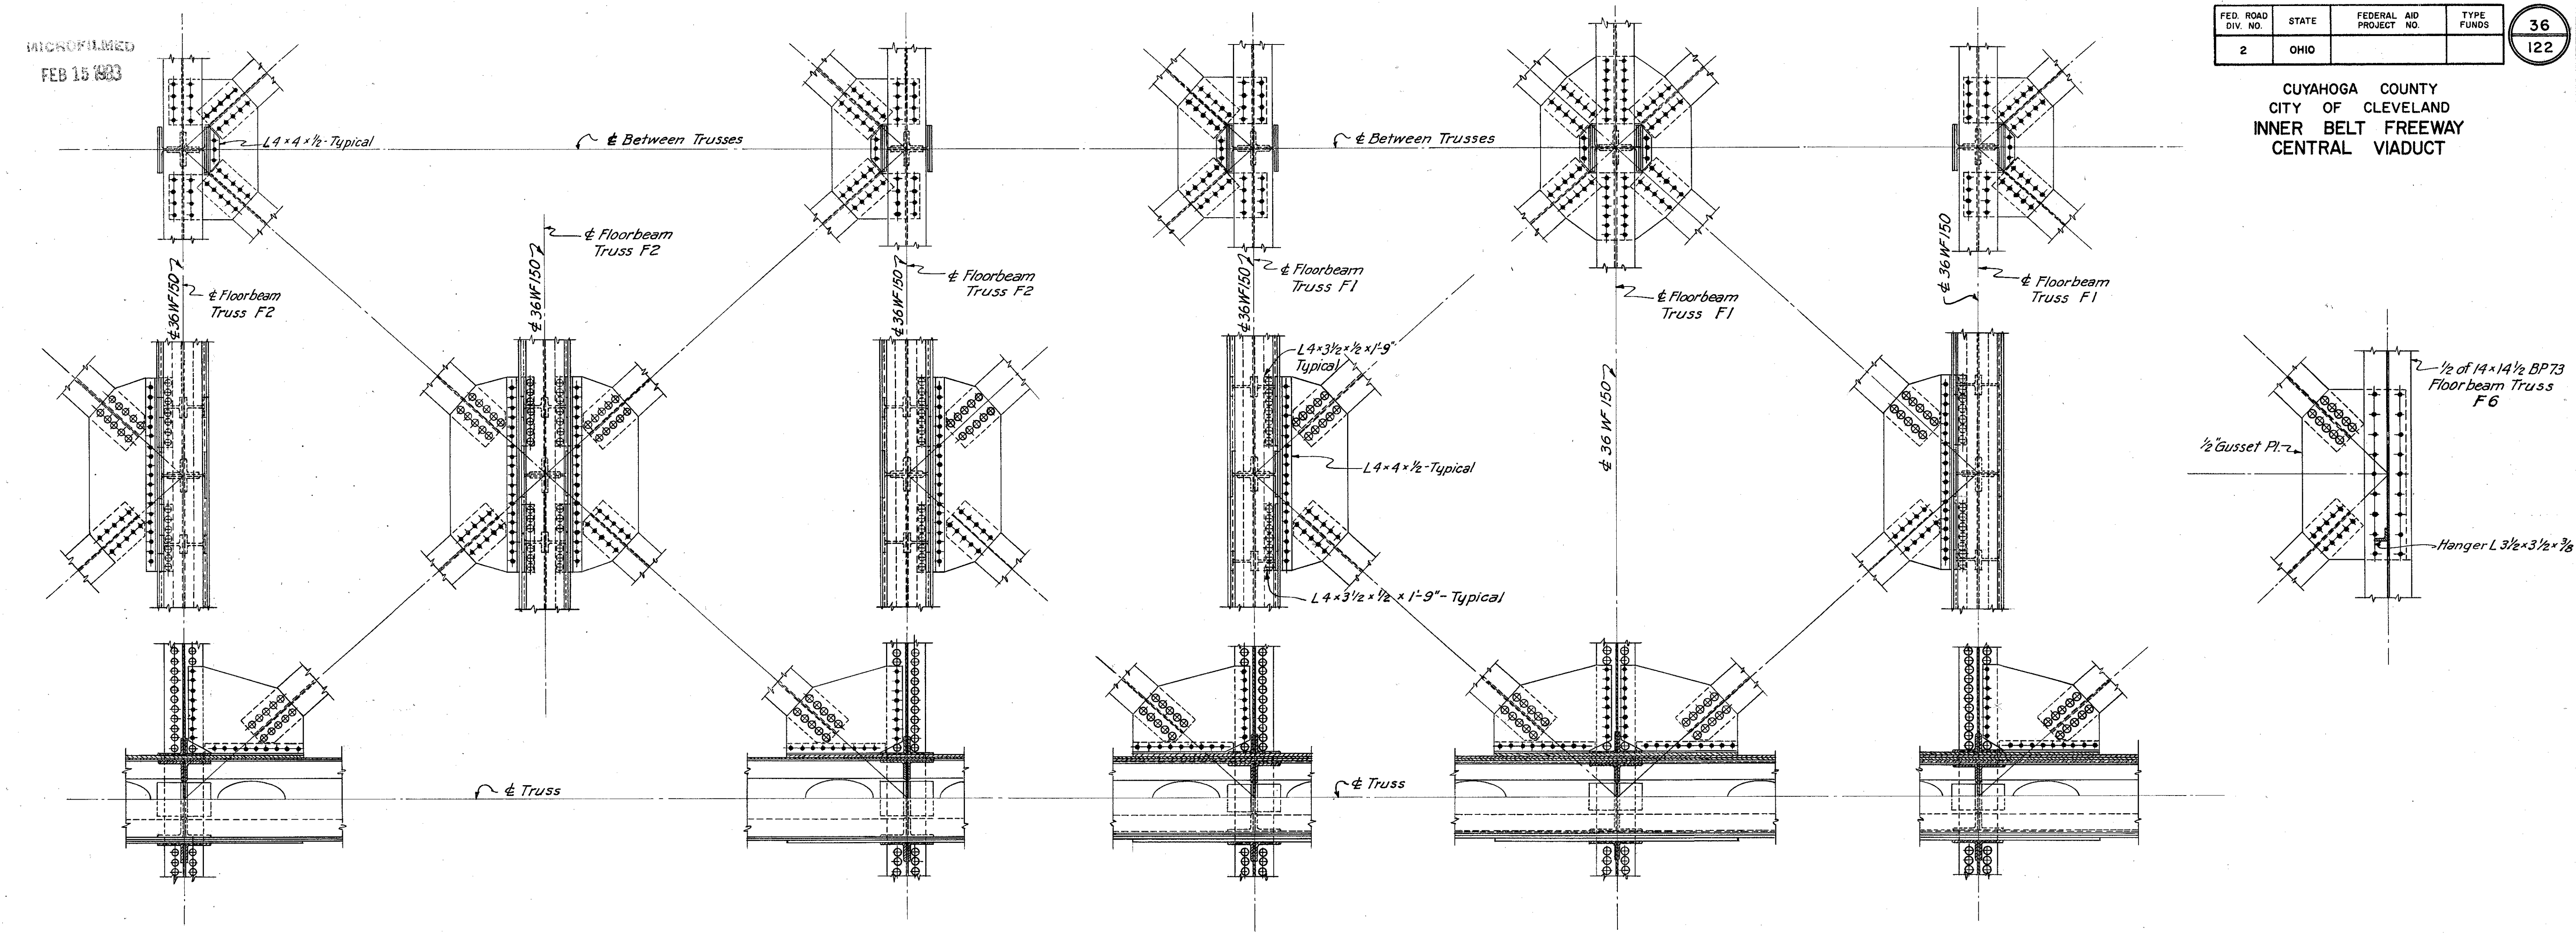

TOP LATERAL WIND SHEAR CONNECTIONS
Typical at Panel Points 113-20,
318-40, 66-700 and 86-900 Fixed Points

PART 3

U. S. ROUTE 42 RELOCATION
INNER BELT FREEWAY - CENTRAL VIADUCT
BR. NO. CU - 42R-17.5

TOP LATERALS


CLEVELAND CUYAHOGA COUNTY OHIO

SCALE $\frac{1}{2}"=1'-0"$ except as noted
MADE F.K.D. DATE 3-31-54
TRCD H.Z.S. DATE 10-28-54
CKD D.M.D. DATE 11-1-54

HOWARD, NEEDLES, TAMMEN & BERGENDOFF
CONSULTING ENGINEERS
KANSAS CITY CLEVELAND NEW YORK

914-1A SHEET 2. 36

CUYAHOGA COUNTY
CITY OF CLEVELAND
INNER BELT FREEWAY
CENTRAL VIADUCT

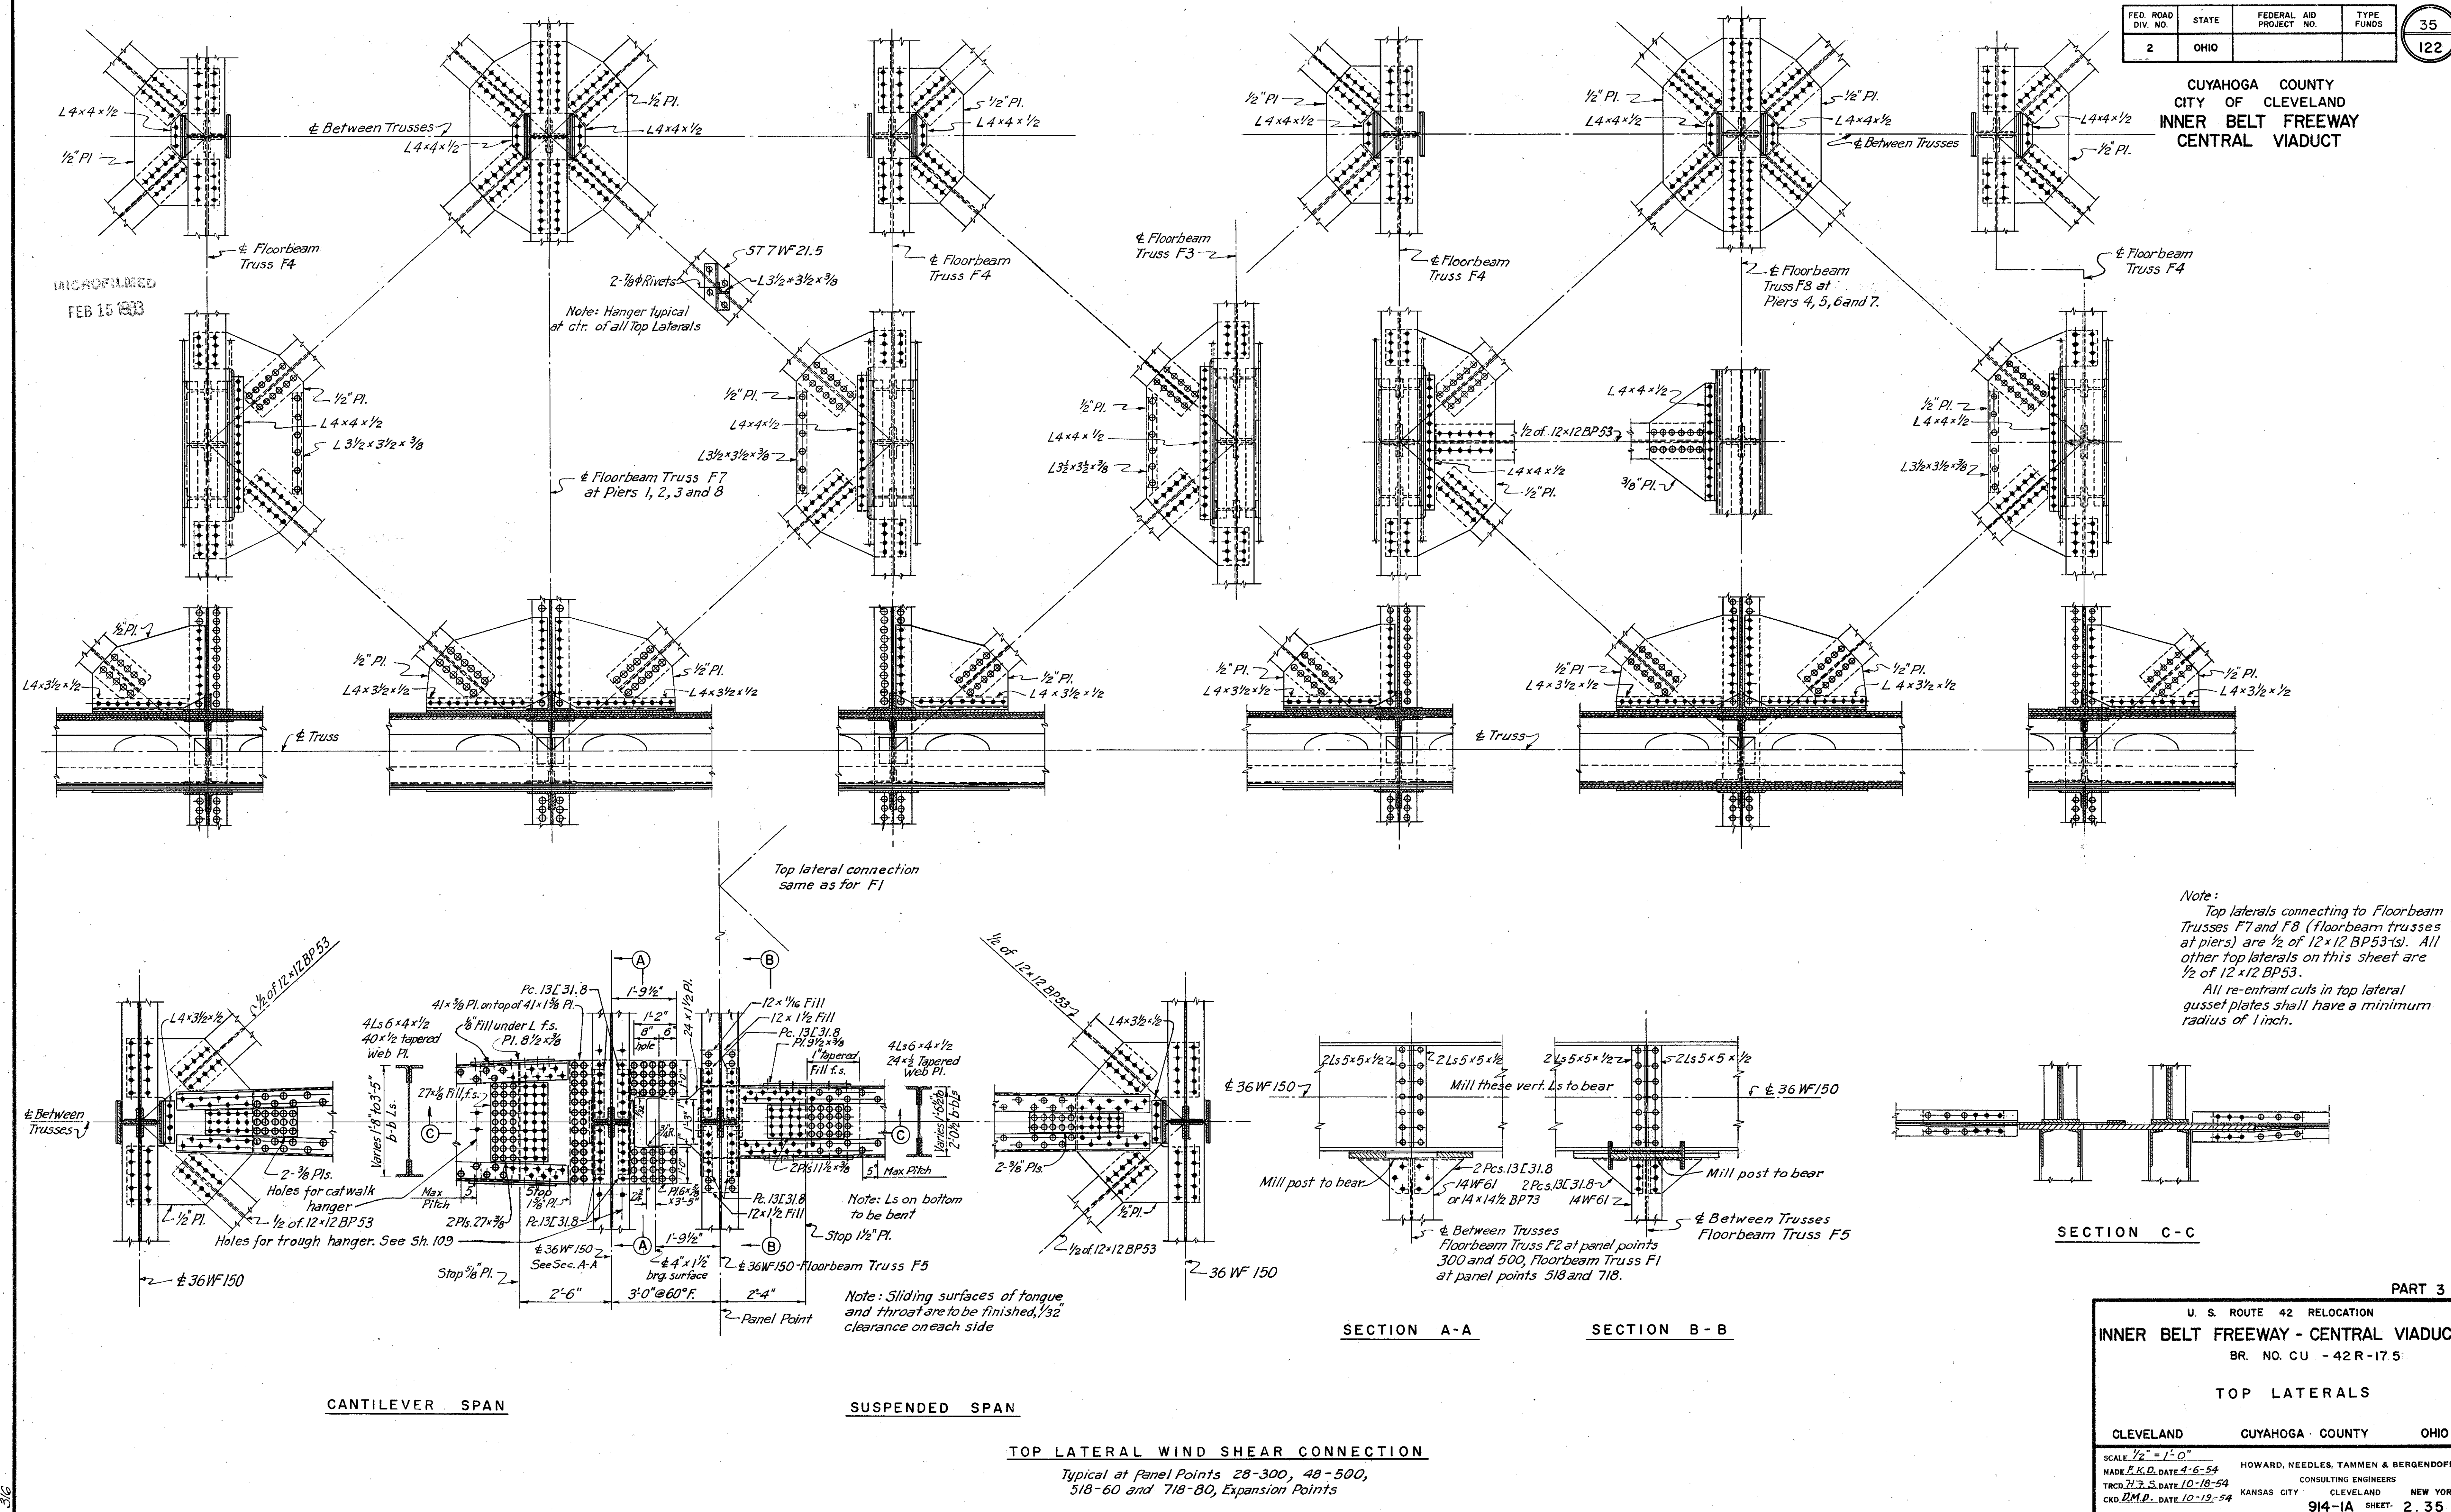

Note:
Top laterals connecting to Floorbeam
Trusses F7 and F8 (floorbeam trusses
at piers) are $\frac{1}{2}$ of 12x12 BP53 (sl. All
other top laterals on this sheet are
 $\frac{1}{2}$ of 12 x 12 BP53.
All re-entrant cuts in top lateral
gusset plates shall have a minimum
radius of 1 inch.

SECTION C-C

SECTION A-A

SECTION B - B

PART 3

U. S. ROUTE 42 RELOCATION
INNER BELT FREEWAY - CENTRAL VIADUCT
BR. NO. CU - 42R-175

TOP LATERALS

CLEVELAND CUYAHOGA COUNTY OHIO

SCALE $\frac{1}{2}'' = 1' - 0''$
MADE F.K.D. DATE 4-6-54
TRCD H.Z.S. DATE 10-18-54
CKD D.M.D. DATE 10-19-54


HOWARD, NEEDLES, TAMMEN & BERGENDORF
CONSULTING ENGINEERS
KANSAS CITY CLEVELAND NEW YORK
914-1A SHEET 2.35

RECORDED
FEB 15 1983

FED. ROAD DIV. NO.	STATE	FEDERAL AID PROJECT NO.	TYPE FUNDS
2	OHIO		

33
122


CUYAHOGA COUNTY
CITY OF CLEVELAND
INNER BELT FREEWAY
CENTRAL VIADUCT

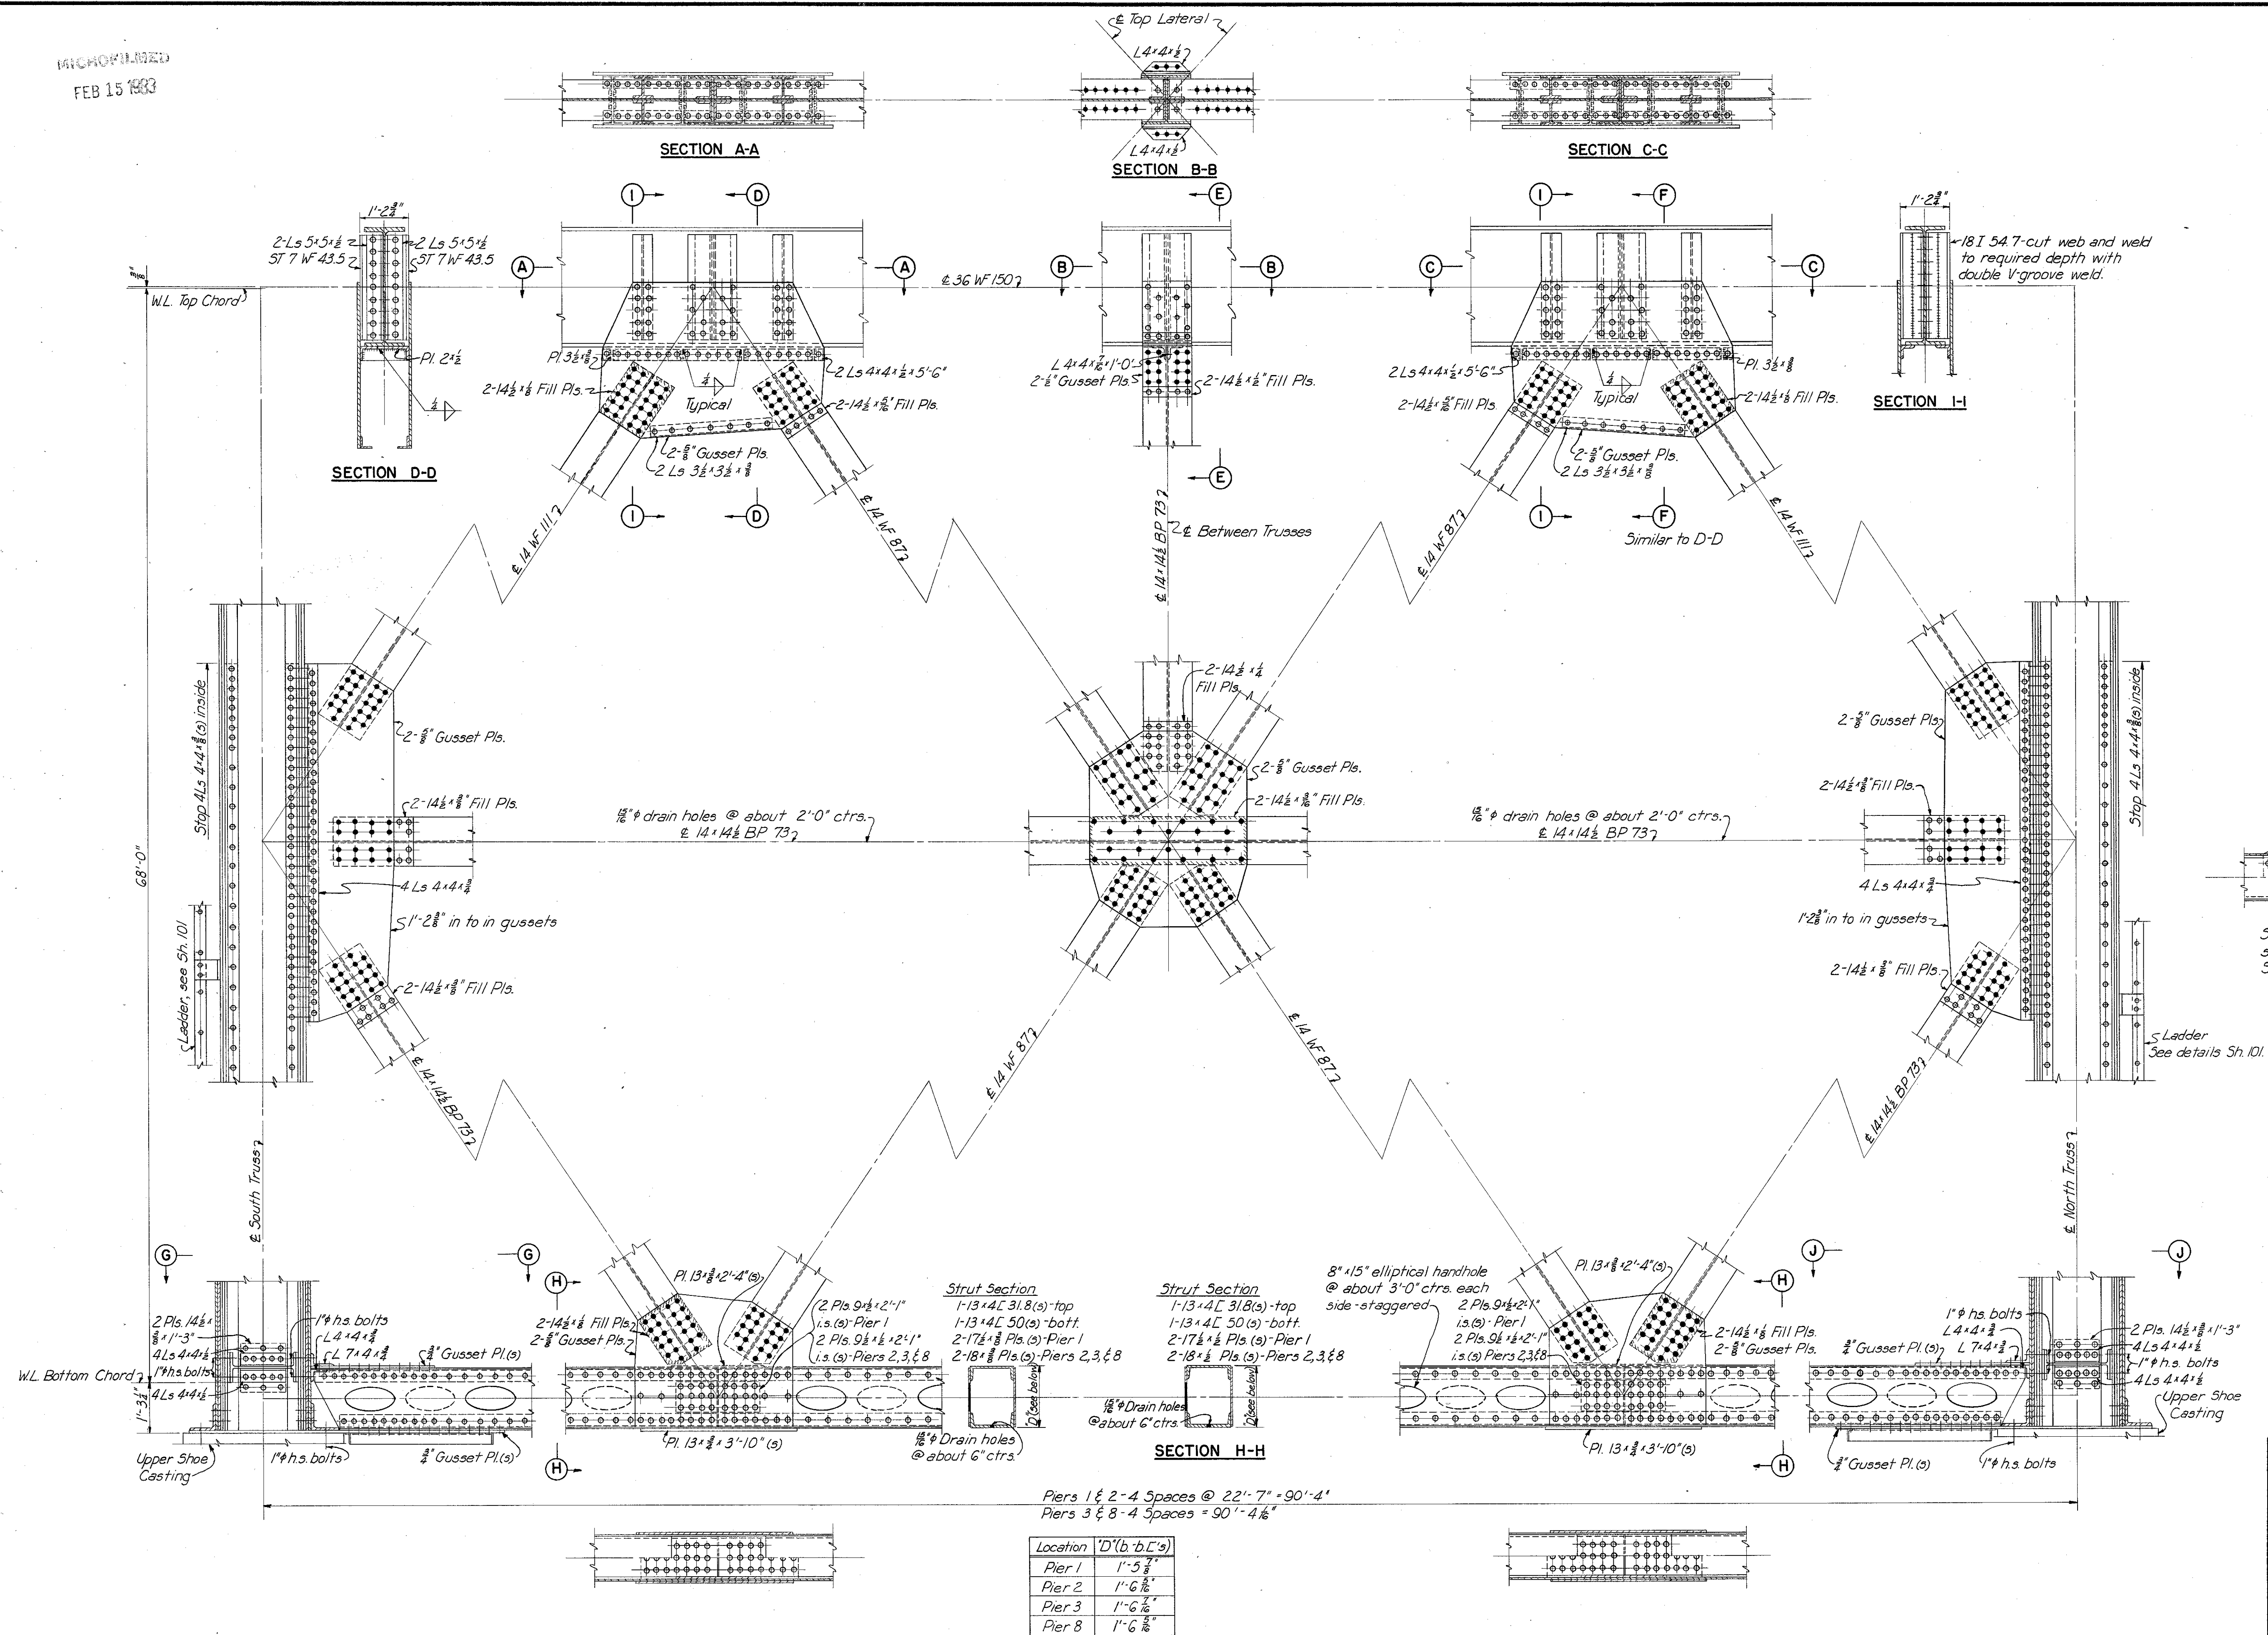

CUYAHOGA COUNTY
CITY OF CLEVELAND
INNER BELT FREEWAY
CENTRAL VIADUCT

14 W61-2
Floorbeam Truss similar to F5
3'-0" About 3'-0"
L5x3½x½ 2-½" φ rivets
L5x3½x½ 2-½" φ rivets
52-½" φ rivets
ST 9 W F 25 12x12 BP 53
2 LG 4x½
2 LG 4x½
ST 9 W F 25 2" Fill PLS 2-½" φ rivets
ST 9 W F 25 2-½" φ rivets
SECTION H-H

Note:
For details of top lateral connections, see Framing Plans and Sh. 36.
For additional details of bottom laterals, see Framing Plans and Sh. 37.
For details of connection of floorbeam to truss, see Sh. 27.

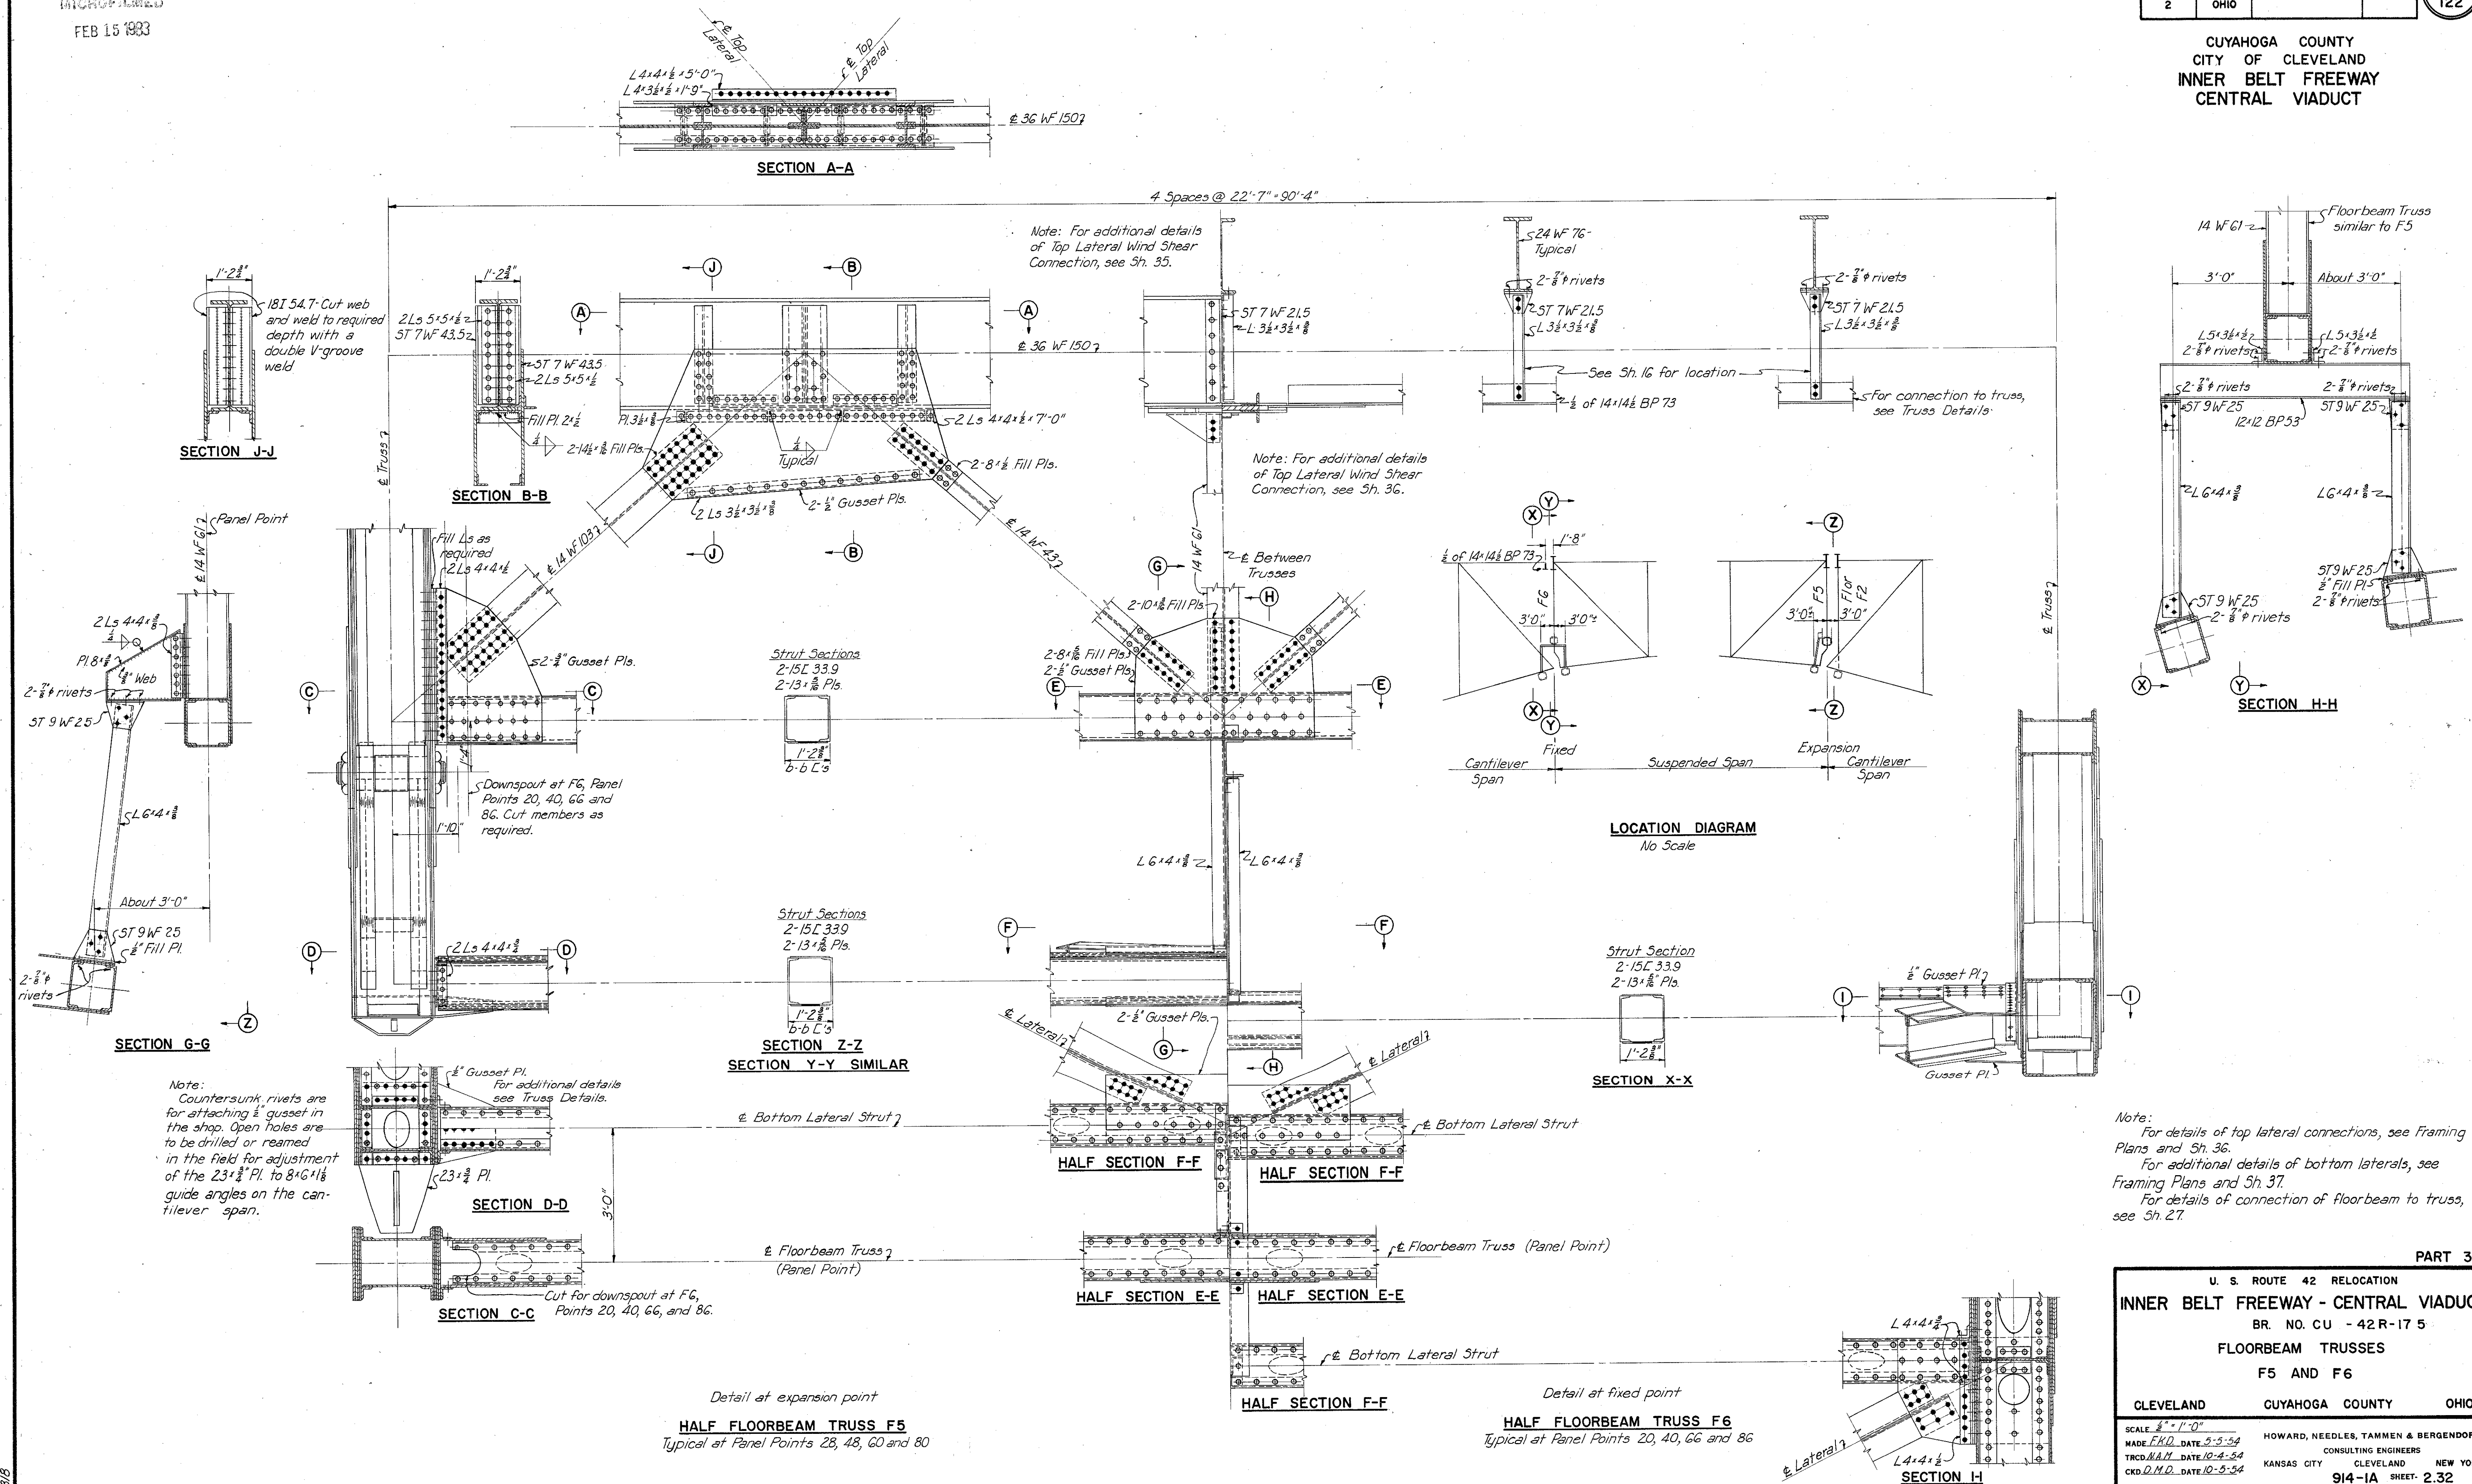

SCALE 1" = 1'-0"
MADE FKD DATE 4-7-54
TRCD JUDY DATE 10-11-54
CKD DMD DATE 10-18-54


HOWARD, NEEDLES, TAMMEN & BERGENDOFF
CONSULTING ENGINEERS
KANSAS CITY CLEVELAND NEW YORK
914-1A SHEET 230

MICROFILMED
FEB 15 1983

FED. ROAD DIV. NO.	STATE	FEDERAL AID PROJECT NO.	TYPE FUNDS
2	OHIO		

29
122

CUYAHOGA COUNTY
CITY OF CLEVELAND
INNER BELT FREEWAY
CENTRAL VIADUCT

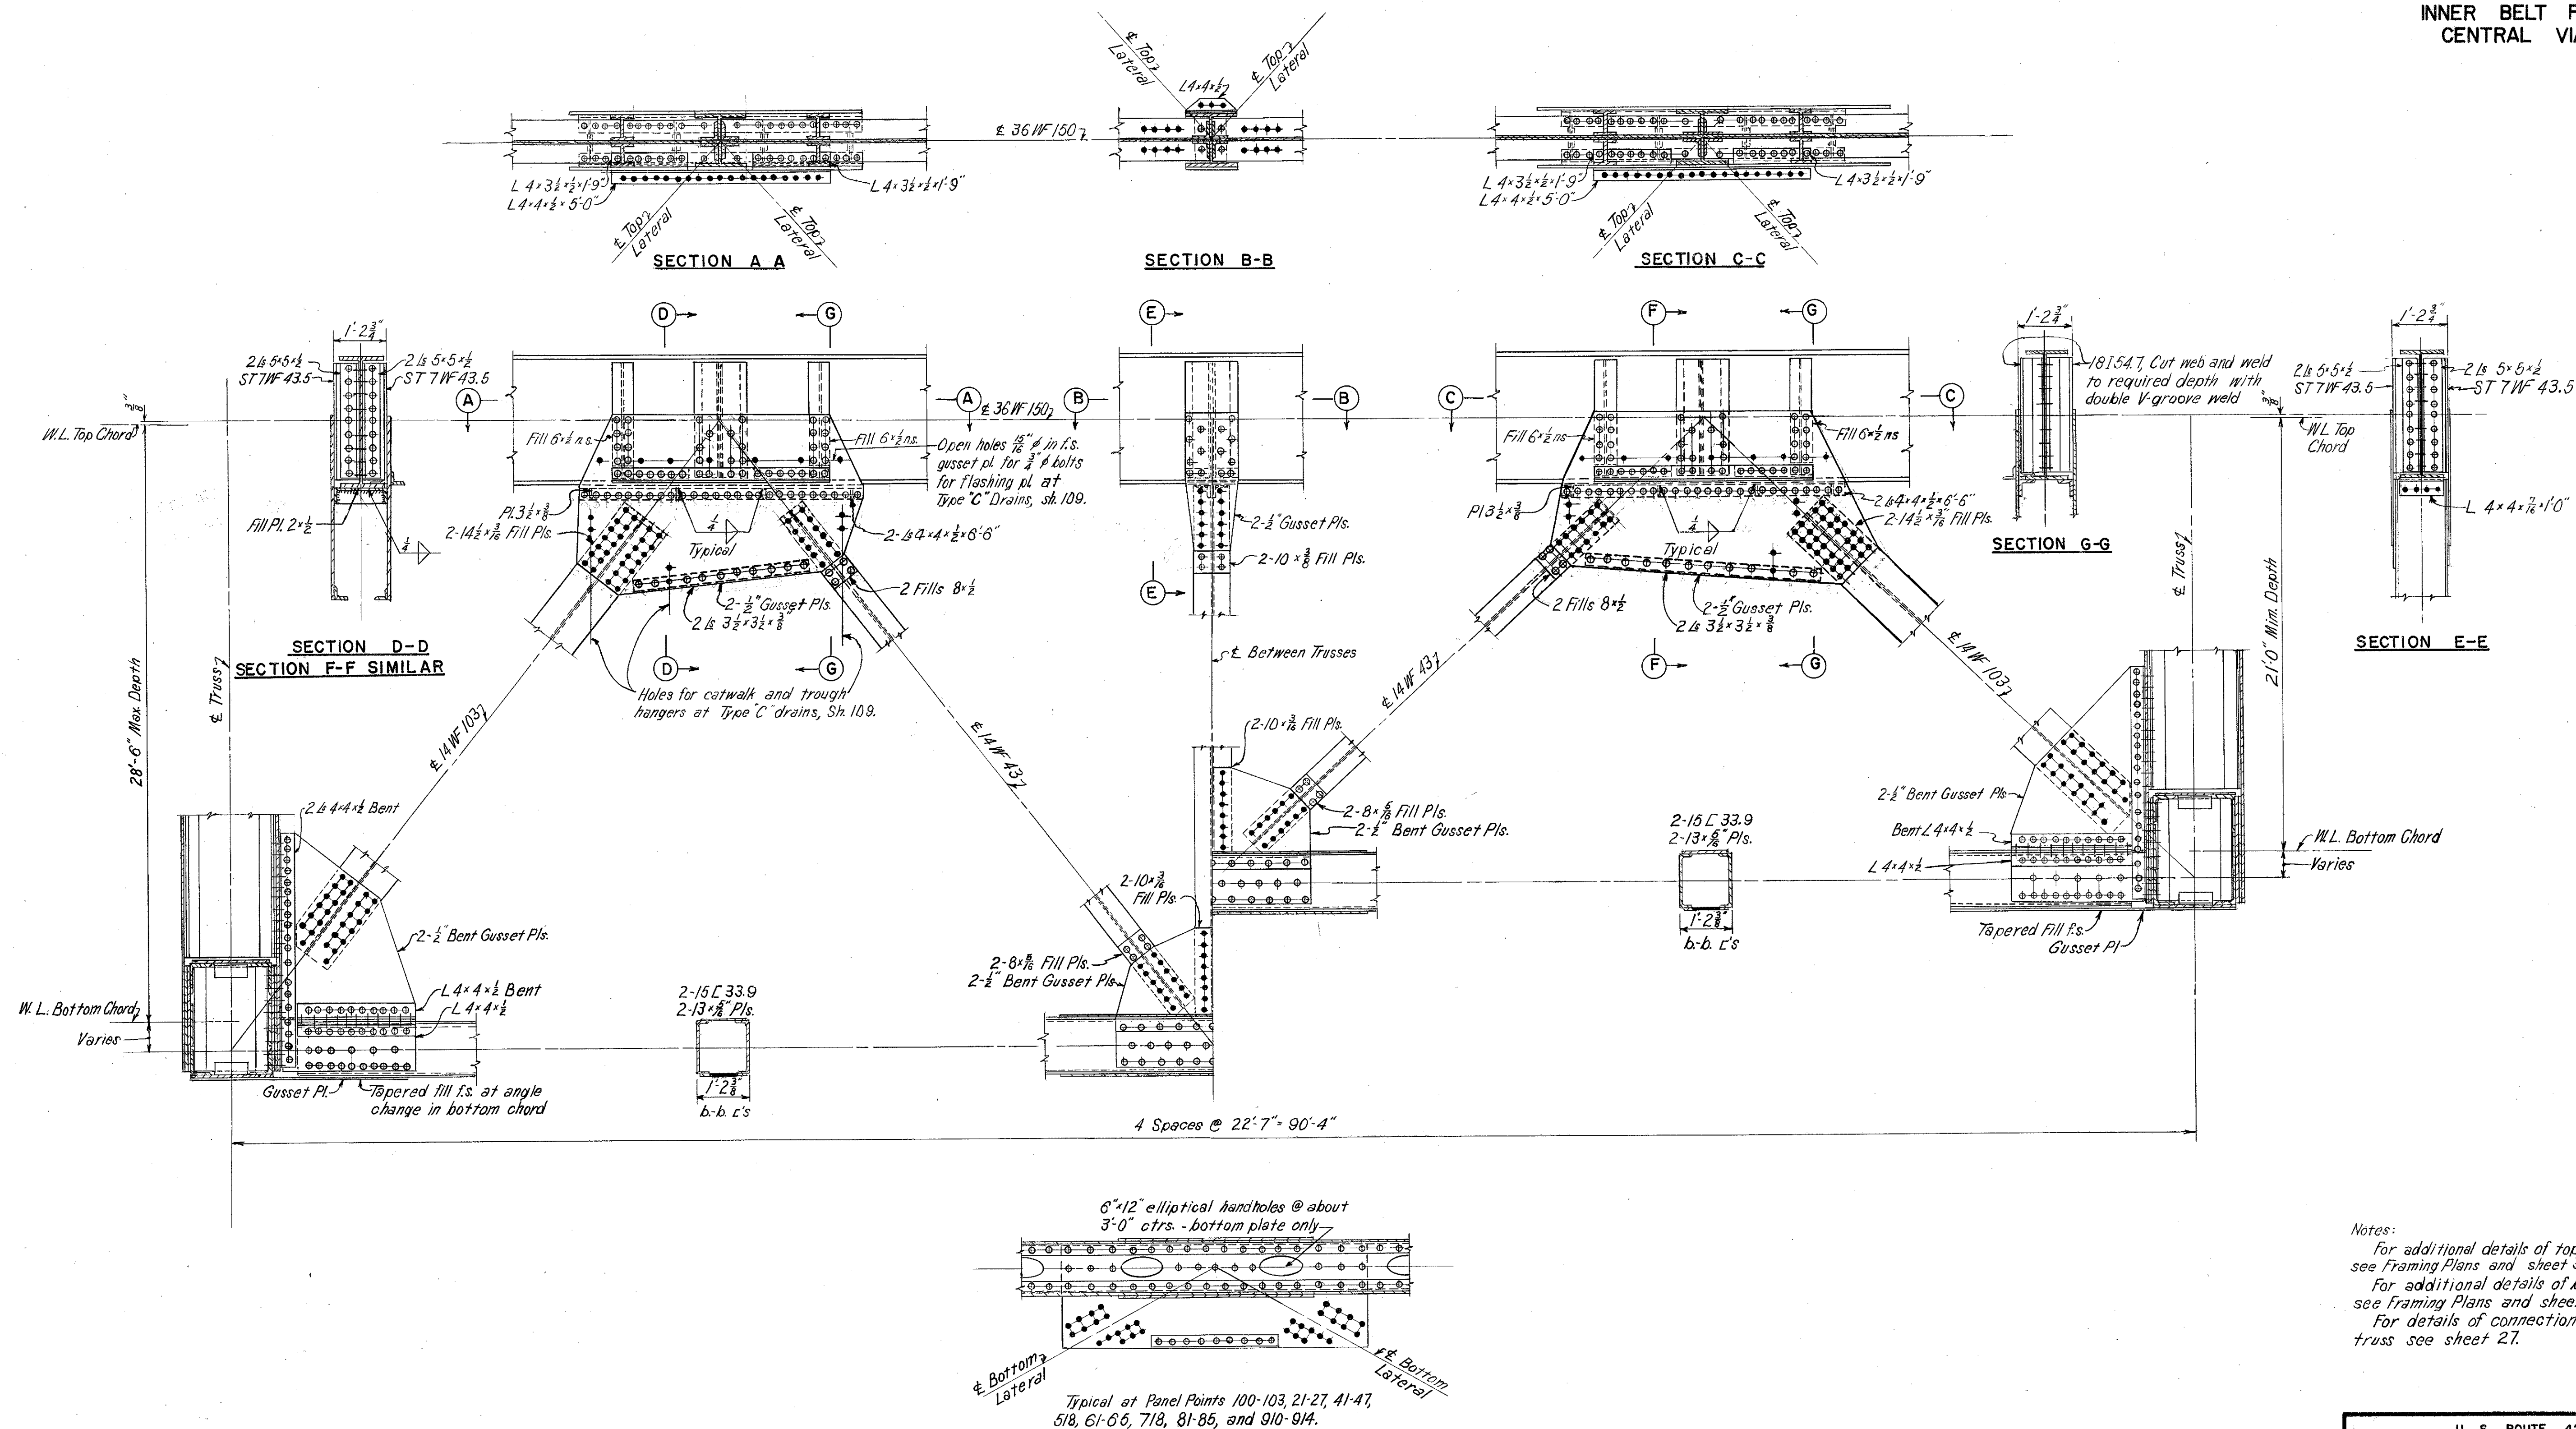

PART 3

U. S. ROUTE 42 RELOCATION
INNER BELT FREEWAY - CENTRAL VIADUCT
BR. NO. CU - 42R-175

FLOORBEAM TRUSS F1 DETAILS

CLEVELAND CUYAHOGA COUNTY OHIO

SCALE 1/2" = 1'-0"
MADE F.K.D. DATE 3-30-54
TRCD. W.E.L. DATE 11-9-54
CKD. DMD. DATE 11-11-54

HOWARD, NEEDLES, TAMMEN & BERGENDOFF
CONSULTING ENGINEERS
KANSAS CITY CLEVELAND NEW YORK


914-1A SHEET 2.29

MICROFILMED
FEB 15 1983



FED. ROAD DIV. NO.	STATE	FEDERAL AID PROJECT NO.	TYPE FUNDS
2	OHIO		

28
122

CUYAHOGA COUNTY
CITY OF CLEVELAND
INNER BELT FREEWAY
CENTRAL VIADUCT

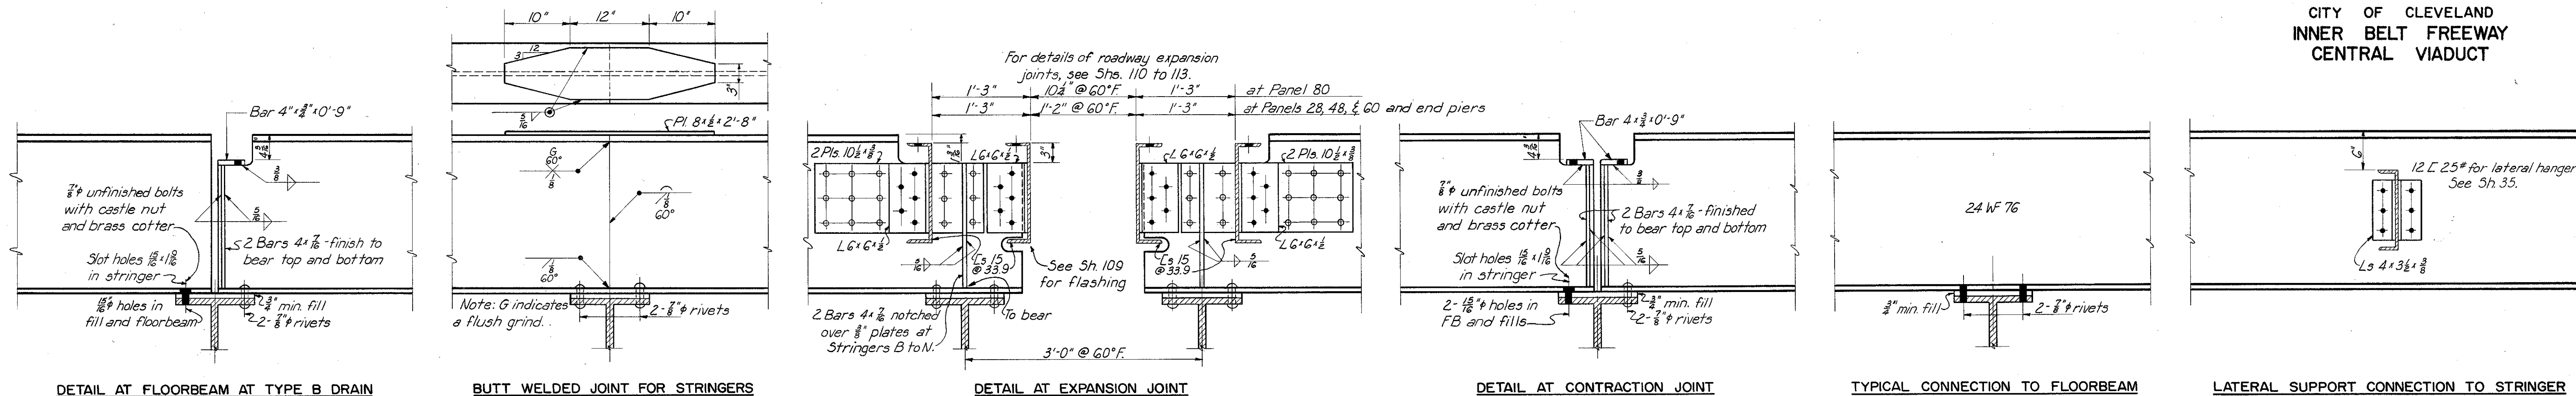

TYPICAL STRINGERS
Scale: 1"=1'-0"
All Stringers 24 W F 76"

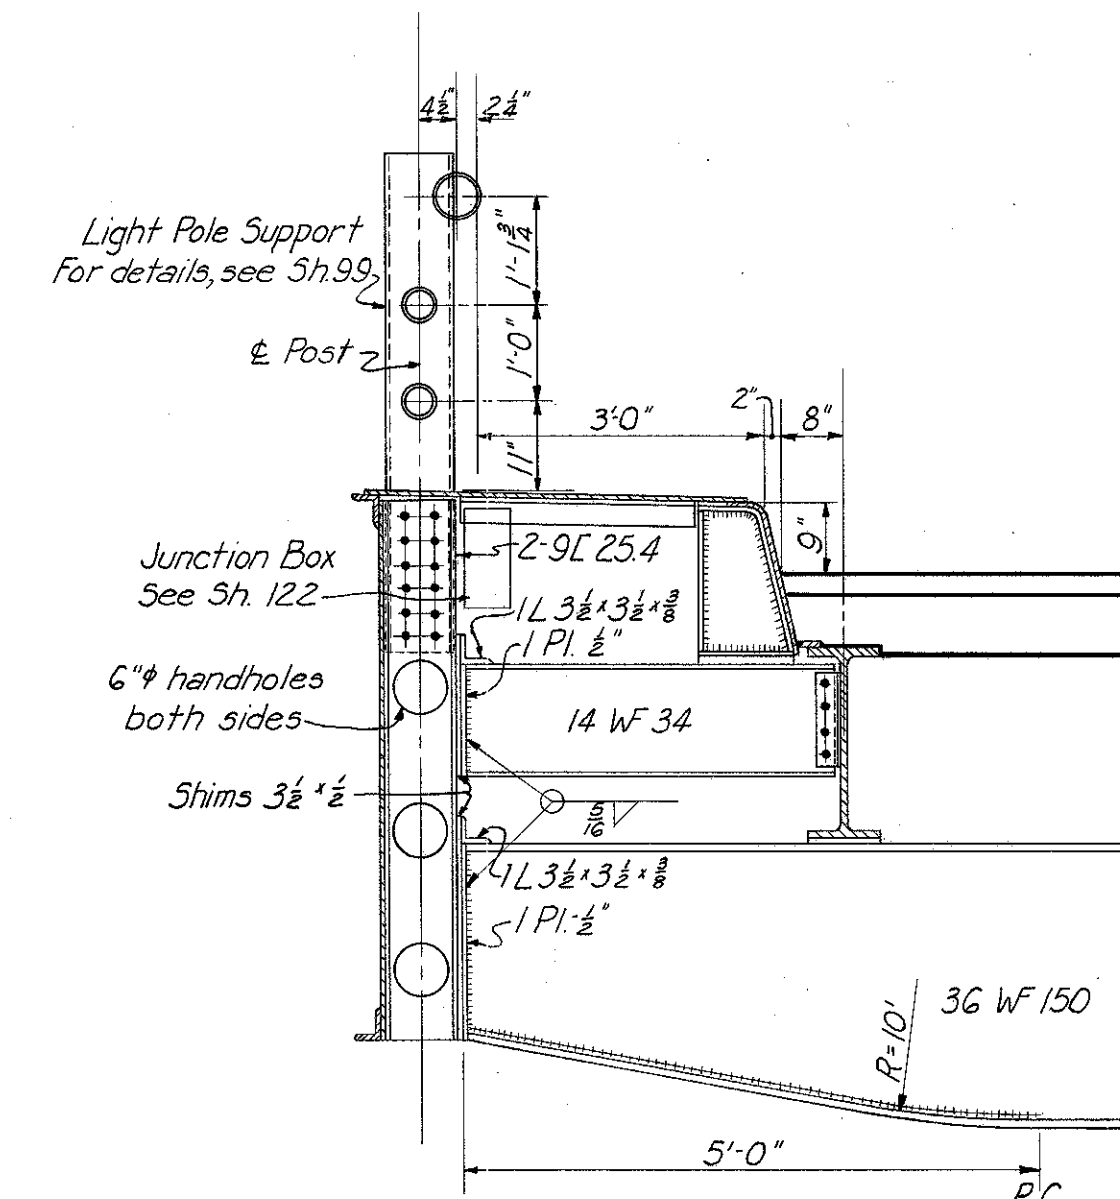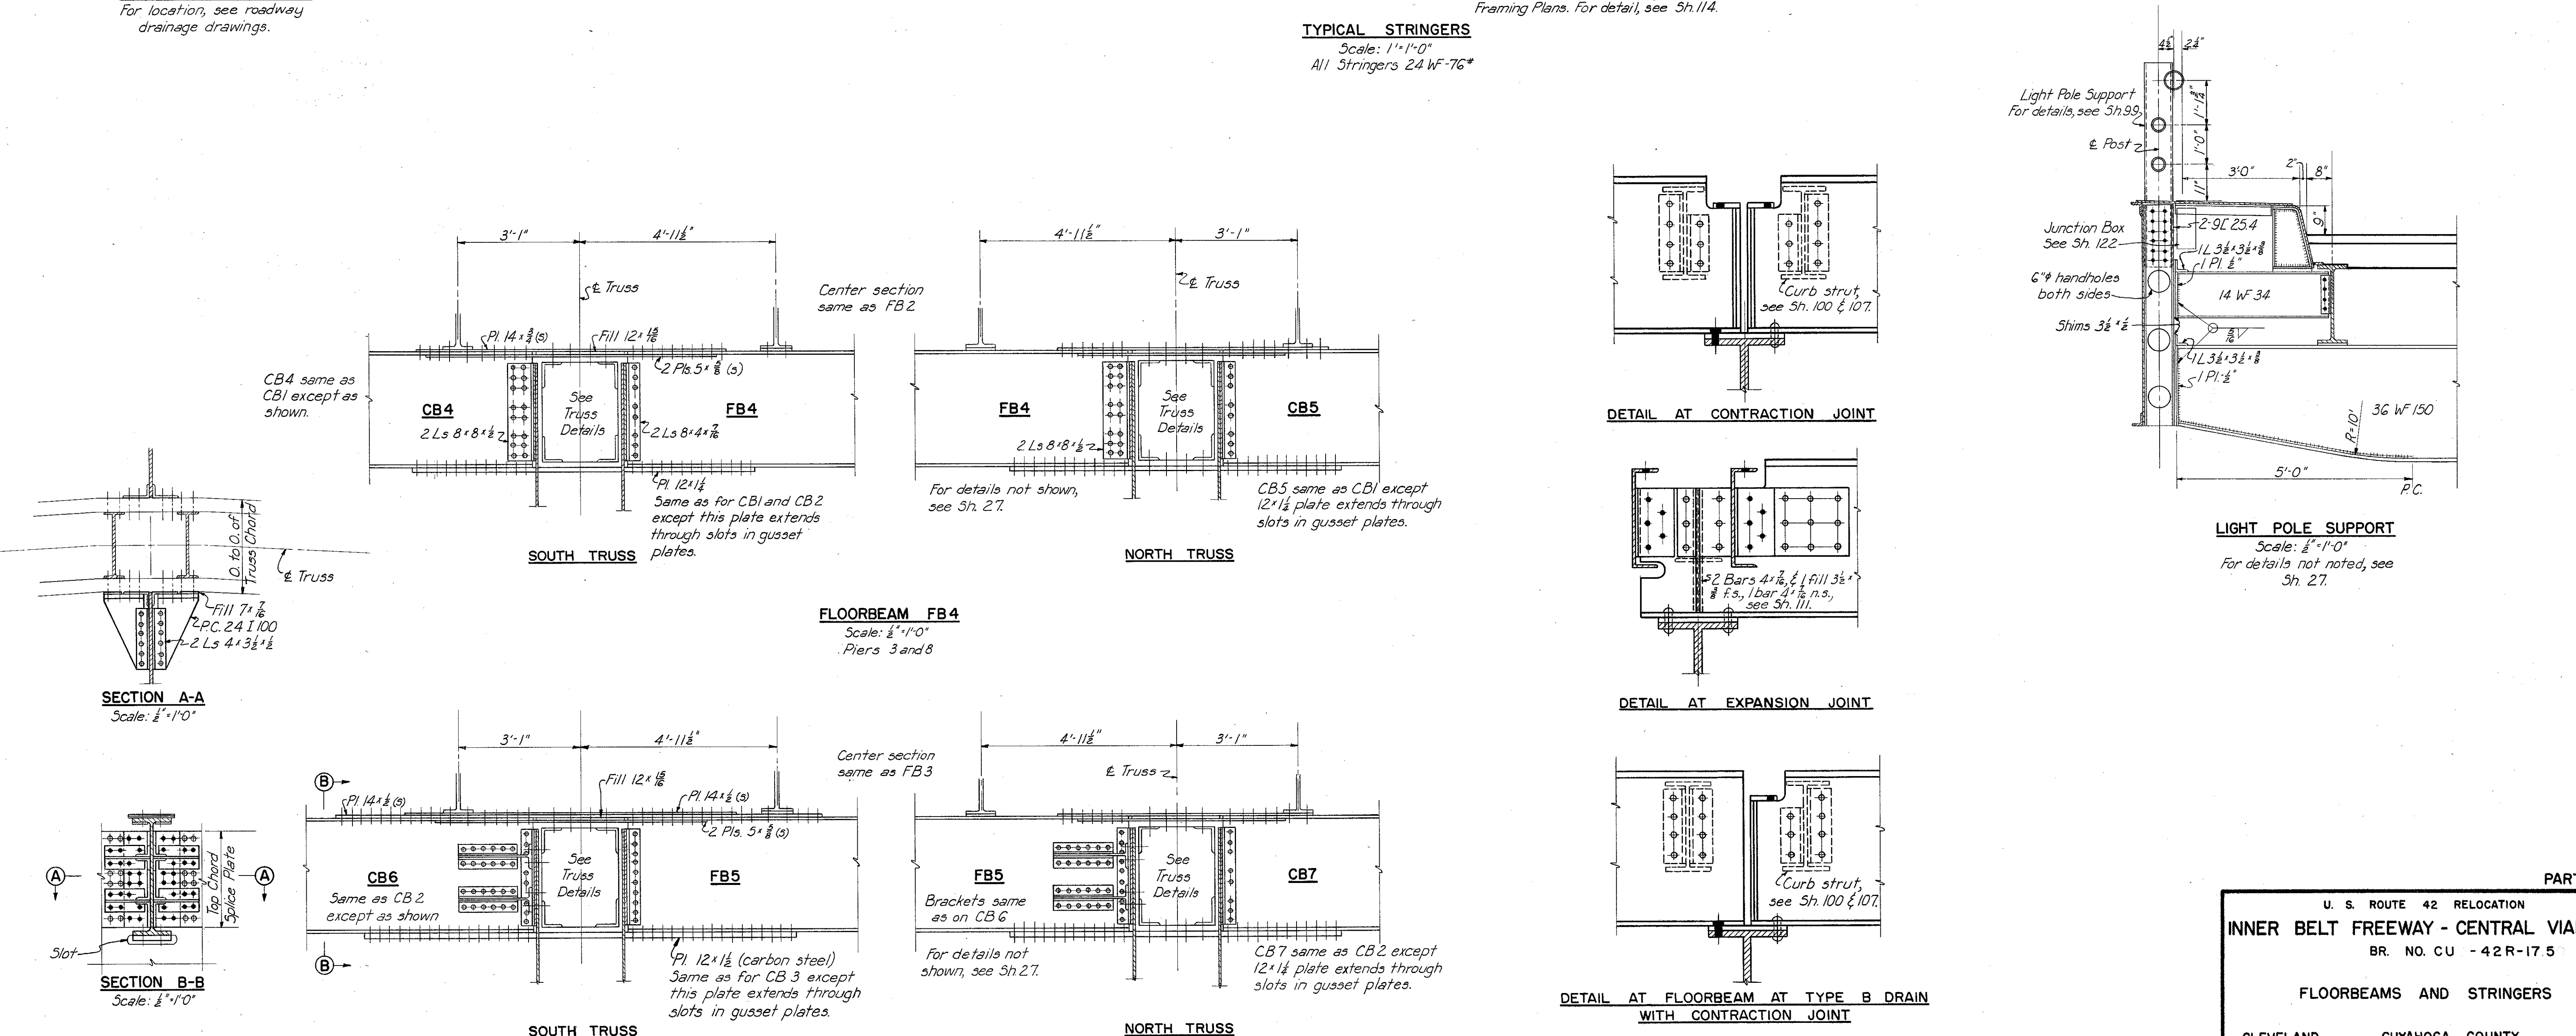

LIGHT POLE SUPPORT
Scale: 1/2"=1'-0"
For details not noted, see Sh. 27.

PART 3			
U. S. ROUTE 42 RELOCATION			
INNER BELT FREEWAY - CENTRAL VIADUCT			
BR. NO. CU - 42R-17.5			
FLOORBEAMS AND STRINGERS			
CLEVELAND	CUYAHOGA COUNTY	OHIO	
SCALE: <i>As shown</i>			
MADE <i>N.H.H.</i> DATE <i>7-28-54</i>			
TRCD <i>N.A.M.</i> DATE <i>9-24-54</i>			
CKD <i>D.M.O.</i> DATE <i>9-25-54</i>			
HOWARD, NEEDLES, TAMMEN & BERGENDOFF		CONSULTING ENGINEERS	
KANSAS CITY		CLEVELAND	NEW YORK
914-1A		SHEET	2.28

FEB 15 1983

26
122

CUYAHOGA COUNTY
CITY OF CLEVELAND
INNER BELT FREEWAY
CENTRAL VIADUCT



Scale: 1" = 16'-0"



Scale : 1" = 30' 0"



Scale: 1" = 30'-0"



Scale : 1"=30'-0"

Top laterals $\frac{1}{2}$ of 12 BP 53 #, carbon Steel unless noted.
Bottom laterals 4 bulb $1\frac{1}{2}$ 8 x $\frac{3}{4}$ x 16.0 # and web $1\frac{1}{2}$ 15 x $\frac{3}{8}$
Stringers 24 WF 76 #
Floorbeams 36 WF 150 #
Bottom lateral struts 2 $\frac{1}{2}$ 15 x 33.9 - 2 $\frac{1}{2}$ s. 13 x $\frac{5}{8}$ unless noted.
For the distance from the roadway surface to the working
line of the truss top chord, see the Table of Grades and Elevations Sheet 12.
For truss sections and details, see Sheets 89 to 94 inclusive.
Posts at piers and at ends of unit are vertical; other posts are normal
to top chord.
For typical top lateral hanger, see Sheets 28 and 35.

PART 3

U. S. ROUTE 42 RELOCATION
INNER BELT FREEWAY - CENTRAL VIADUCT
BR. NO. CU - 42 R-17.5

FRAMING PLAN - UNIT 9

CLEVELAND CUYAHOGA COUNTY OHIO

SCALE As shown
MADE JFG DATE 1-21-54
JDB
TRCD g.A.H. DATE 8-17-54
CKD D.M.D. DATE 9-29-54


HOWARD, NEEDLES, TAMMEN & BERGENDOFF
CONSULTING ENGINEERS
KANSAS CITY CLEVELAND NEW YORK
914-1A SHEET 226

MICROFILMED
FEB 15 1983

FED. ROAD DIV. NO.	STATE	FEDERAL AID PROJECT NO.	TYPE FUNDS
2	OHIO		


25
122

CUYAHOGA COUNTY
CITY OF CLEVELAND
INNER BELT FREEWAY
CENTRAL VIADUCT

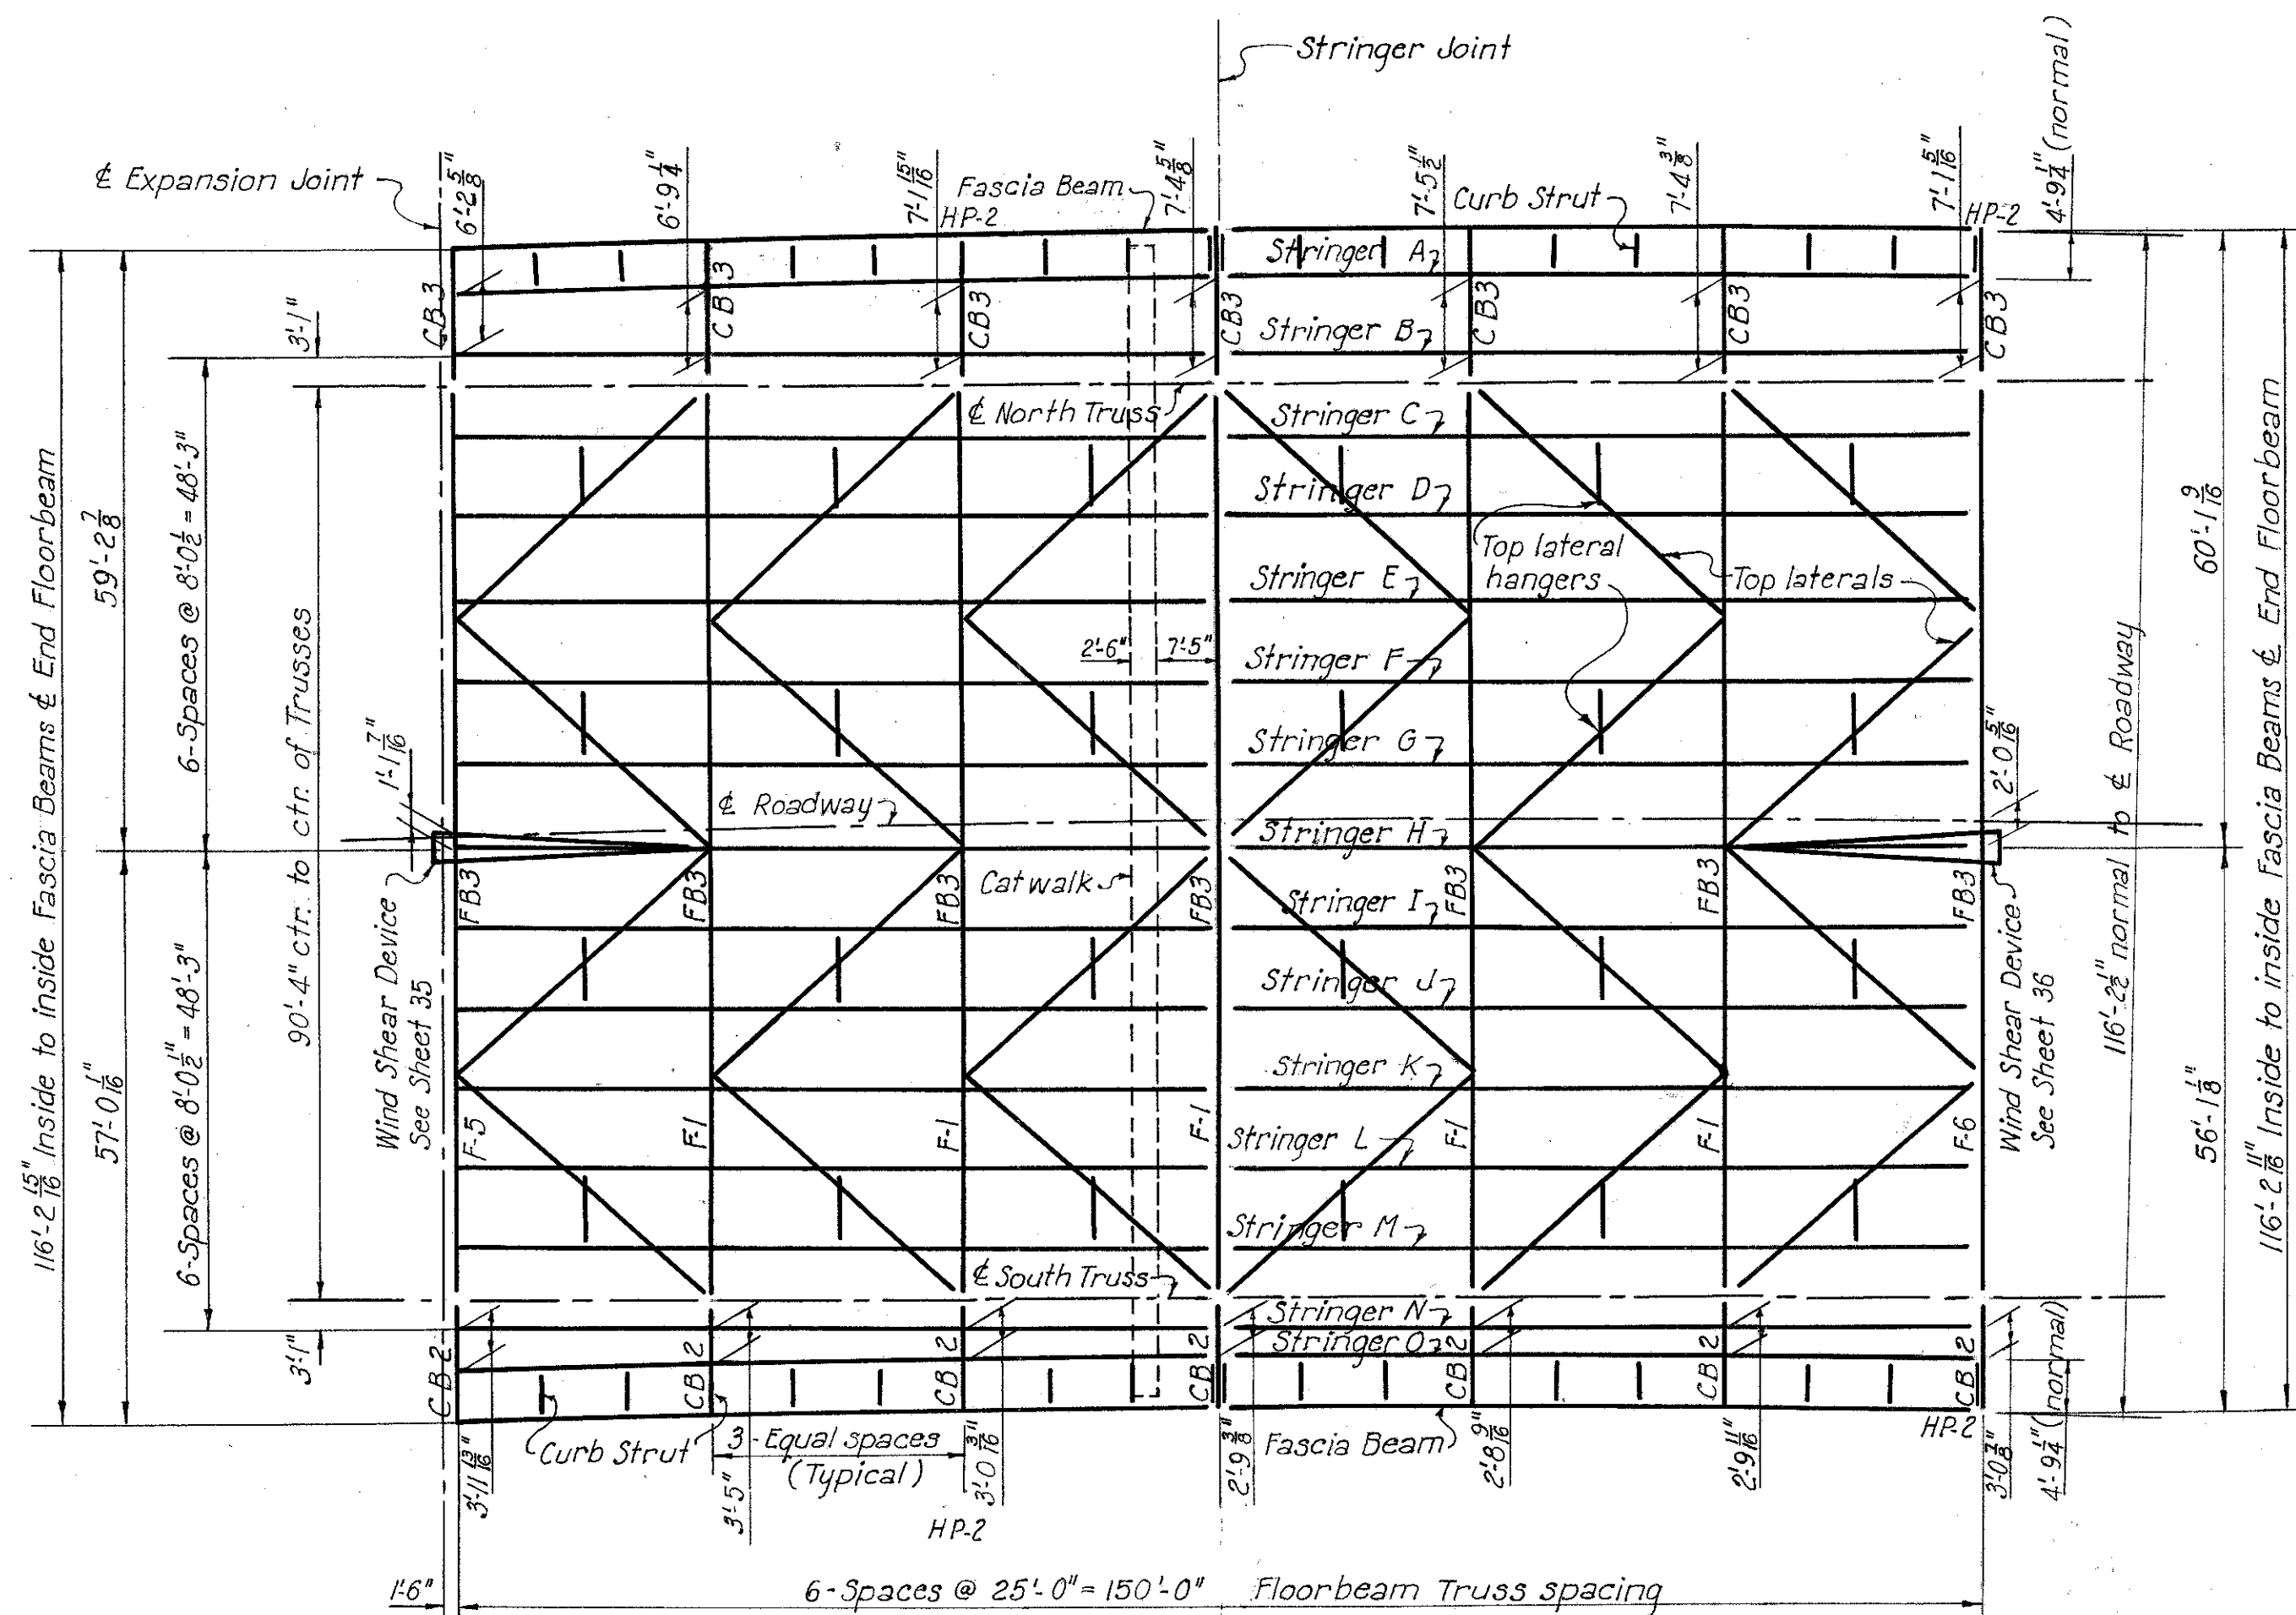


DECK PLAN

Scale: 1"=16'-0"

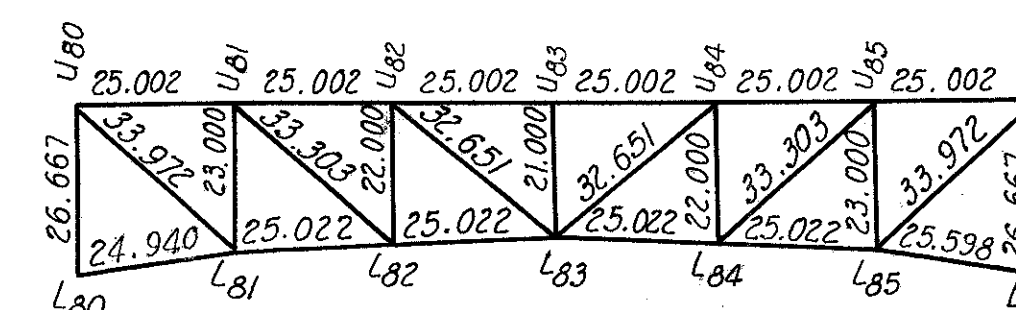

TRUSSES

Scale: 1"=30'

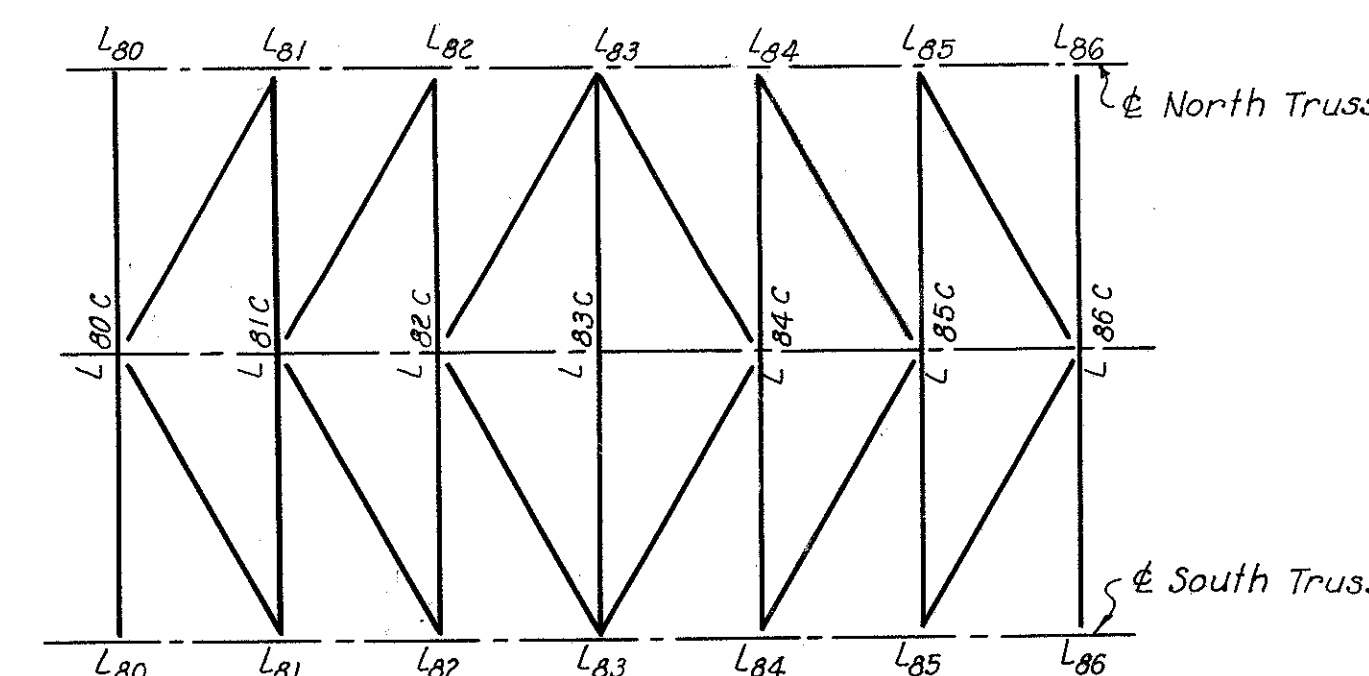

BOTTOM CHORD LATERAL BRACING

Scale: 1"=30'-0"

Top laterals $\frac{1}{2}$ of 12 BP 53 #
Bottom laterals 4 bulb 13 8 x 3 $\frac{1}{2}$ x 16.0 # - Web 15 x $\frac{3}{8}$
Stringers 24 WF 76 #
Floorbeams 36 WF 150 #
Bottom lateral struts 2 C 15 x 33.9 # - 2 fls. 13 x $\frac{5}{8}$
For details of north truss, see Sheet 78 for Unit 6.
For details of south truss, see Sheet 79 for Unit 6.
Sections are identical to trusses of Unit 6, and details will be similar except as modified by lengths of members in end panels, and vertical bend points in trusses of Unit 6 at U62 and U64.
For the distance from the roadway surface to the working line of the truss top chord, see the table of Grades and Elevations, Sheet 12.
For truss sections and stresses, see the Stress sheet for Unit 8, Sheet 88.
Posts at ends of units are vertical; other posts are normal to the top chord.
For typical top lateral hanger, see Sheets 28 and 35.

PART 3

U. S. ROUTE 42 RELOCATION
INNER BELT FREEWAY - CENTRAL VIADUCT
BR. NO. CU - 42R-17.5

FRAMING PLAN - UNIT 8

CLEVELAND CUYAHOGA COUNTY OHIO


SCALE As shown
MADE 1/6/54 DATE 1-14-54
TRC 6/1/54 DATE 6-17-54
CKD 0/1/54 DATE 2-29-54
HOWARD, NEEDLES, TAMMEN & BERGENDORFF
CONSULTING ENGINEERS
KANSAS CITY CLEVELAND NEW YORK
914-1A SHEET 2.25

MICROFILMED
FEB 15 1993

FED. ROAD DIV. NO.	STATE	FEDERAL AID PROJECT NO.	TYPE FUNDS
2	OHIO		


24
122

CUYAHOGA COUNTY
CITY OF CLEVELAND
INNER BELT FREEWAY
CENTRAL VIADUCT

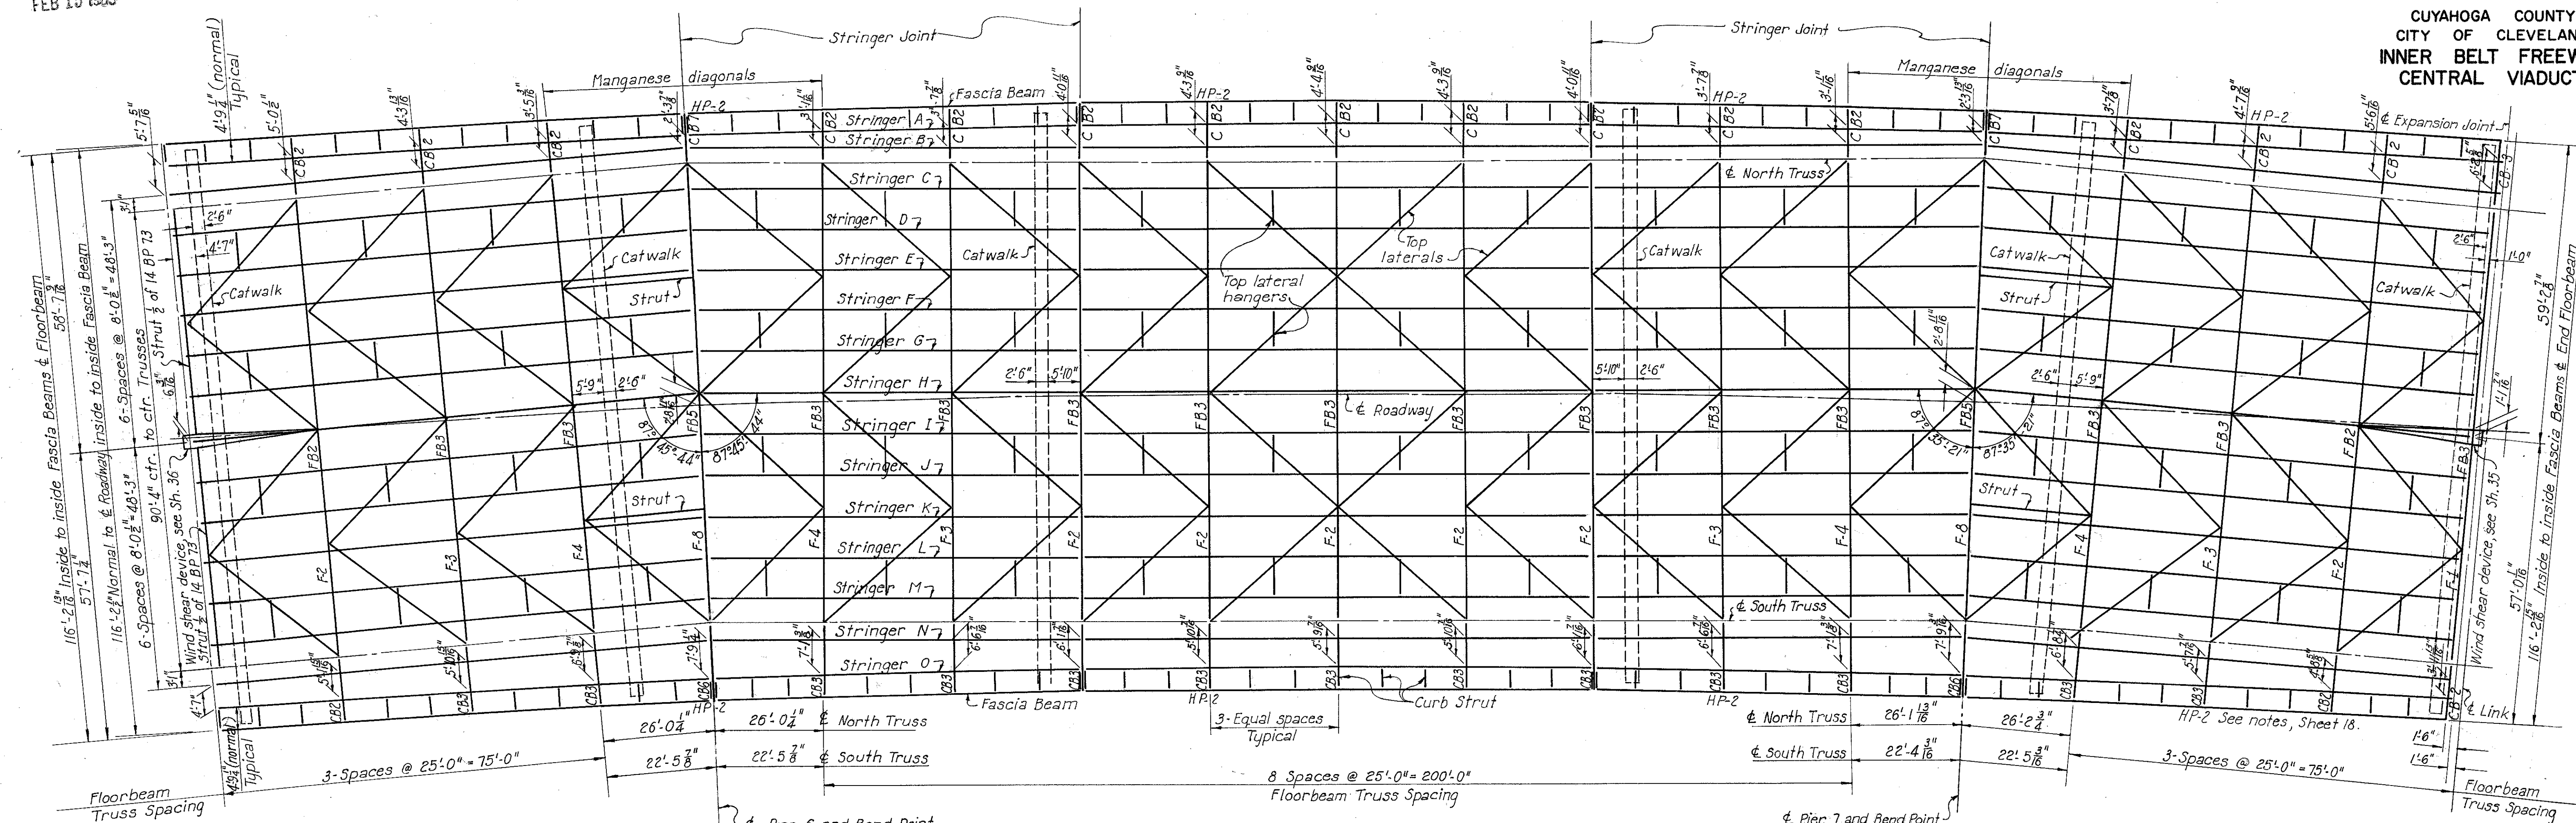


DECK PLAN

Scale: 1"=16'-0"

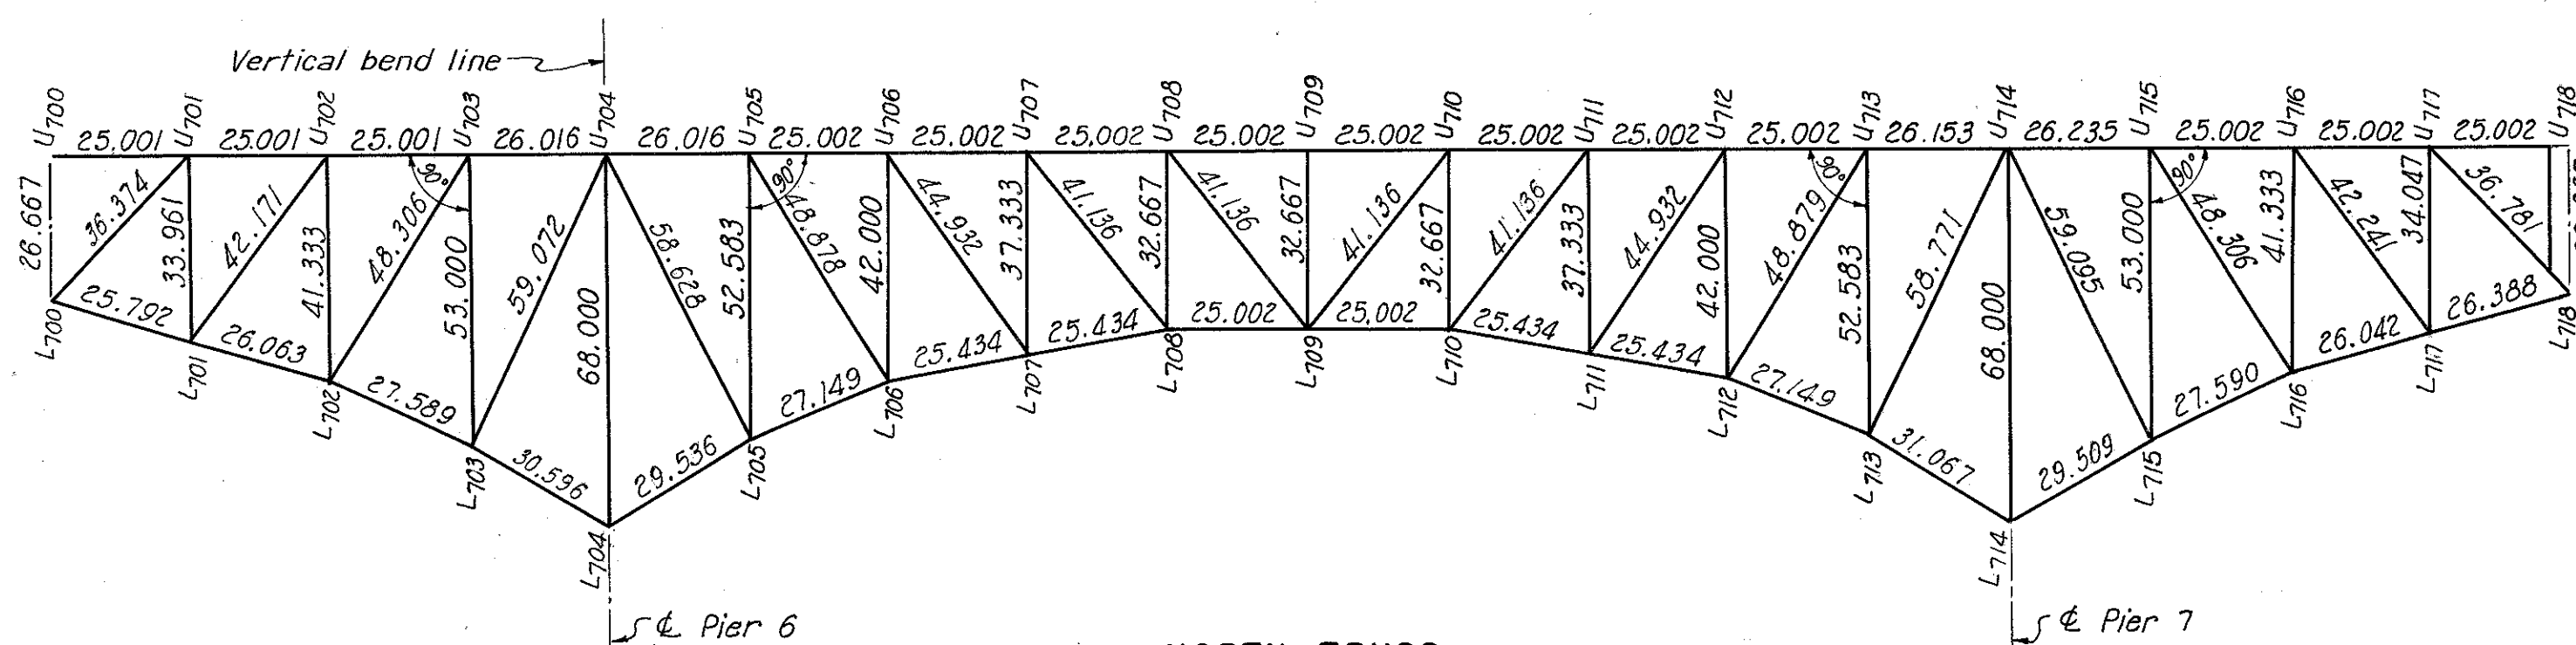


NORTH TRUSS

Scale: 1"=30'-0"

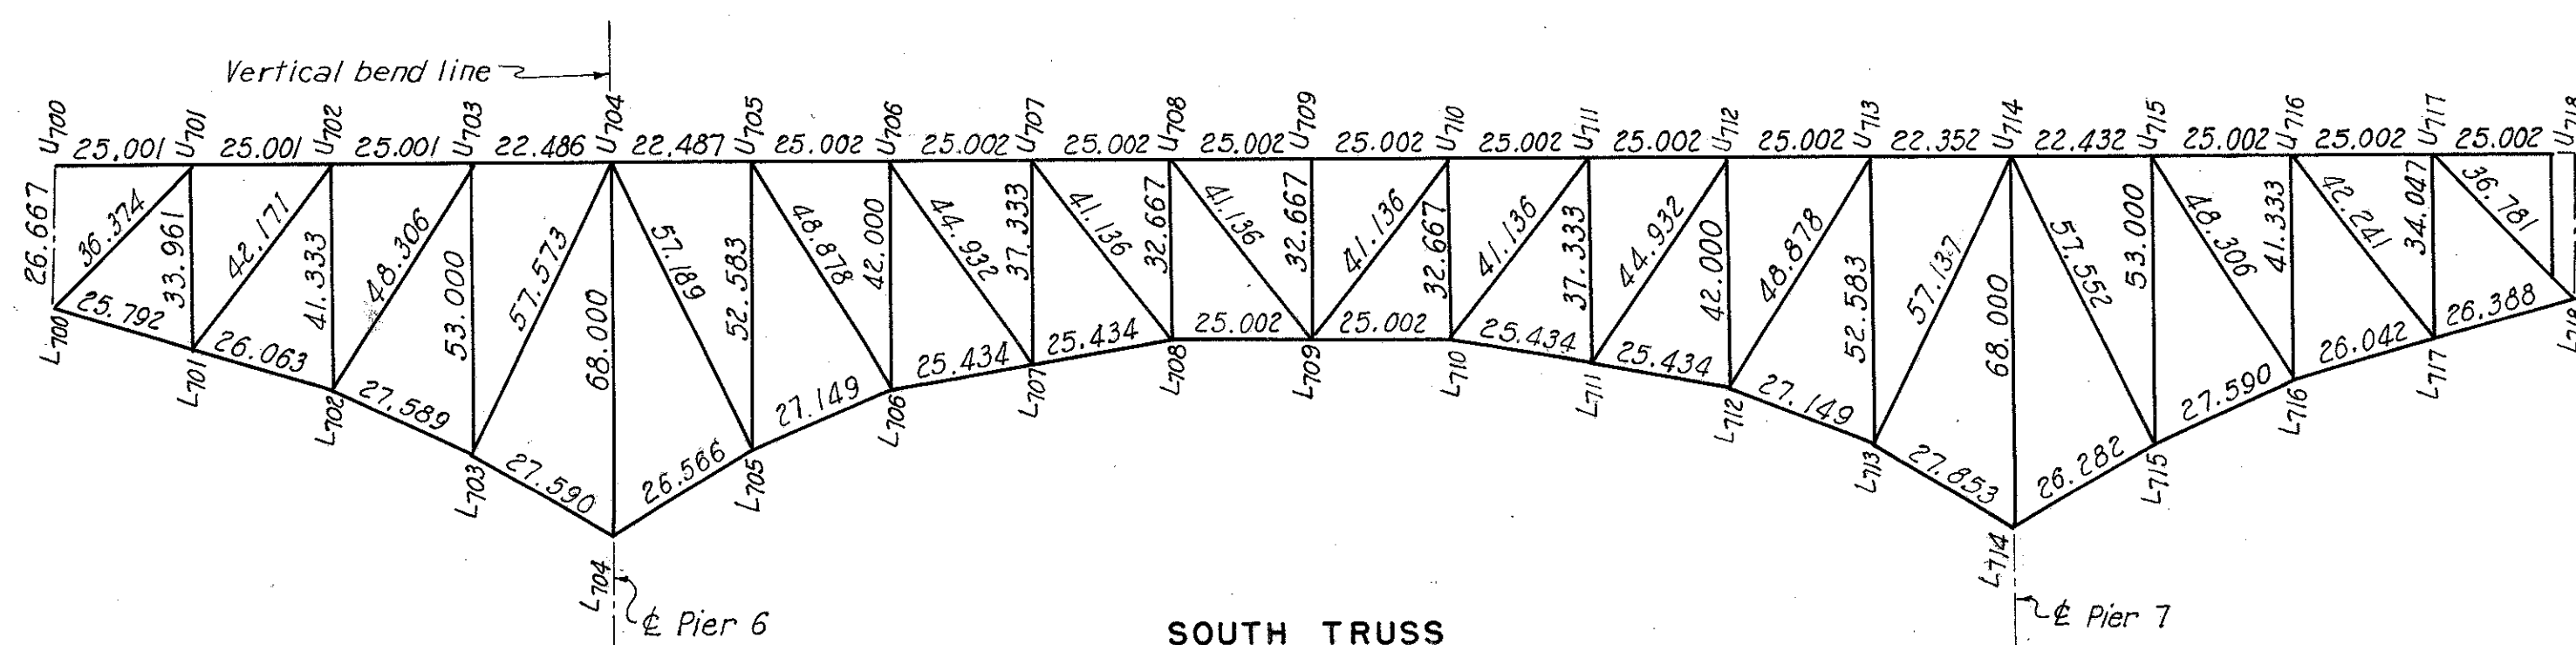

SOUTH TRUSS

Scale: 1"=30'-0"

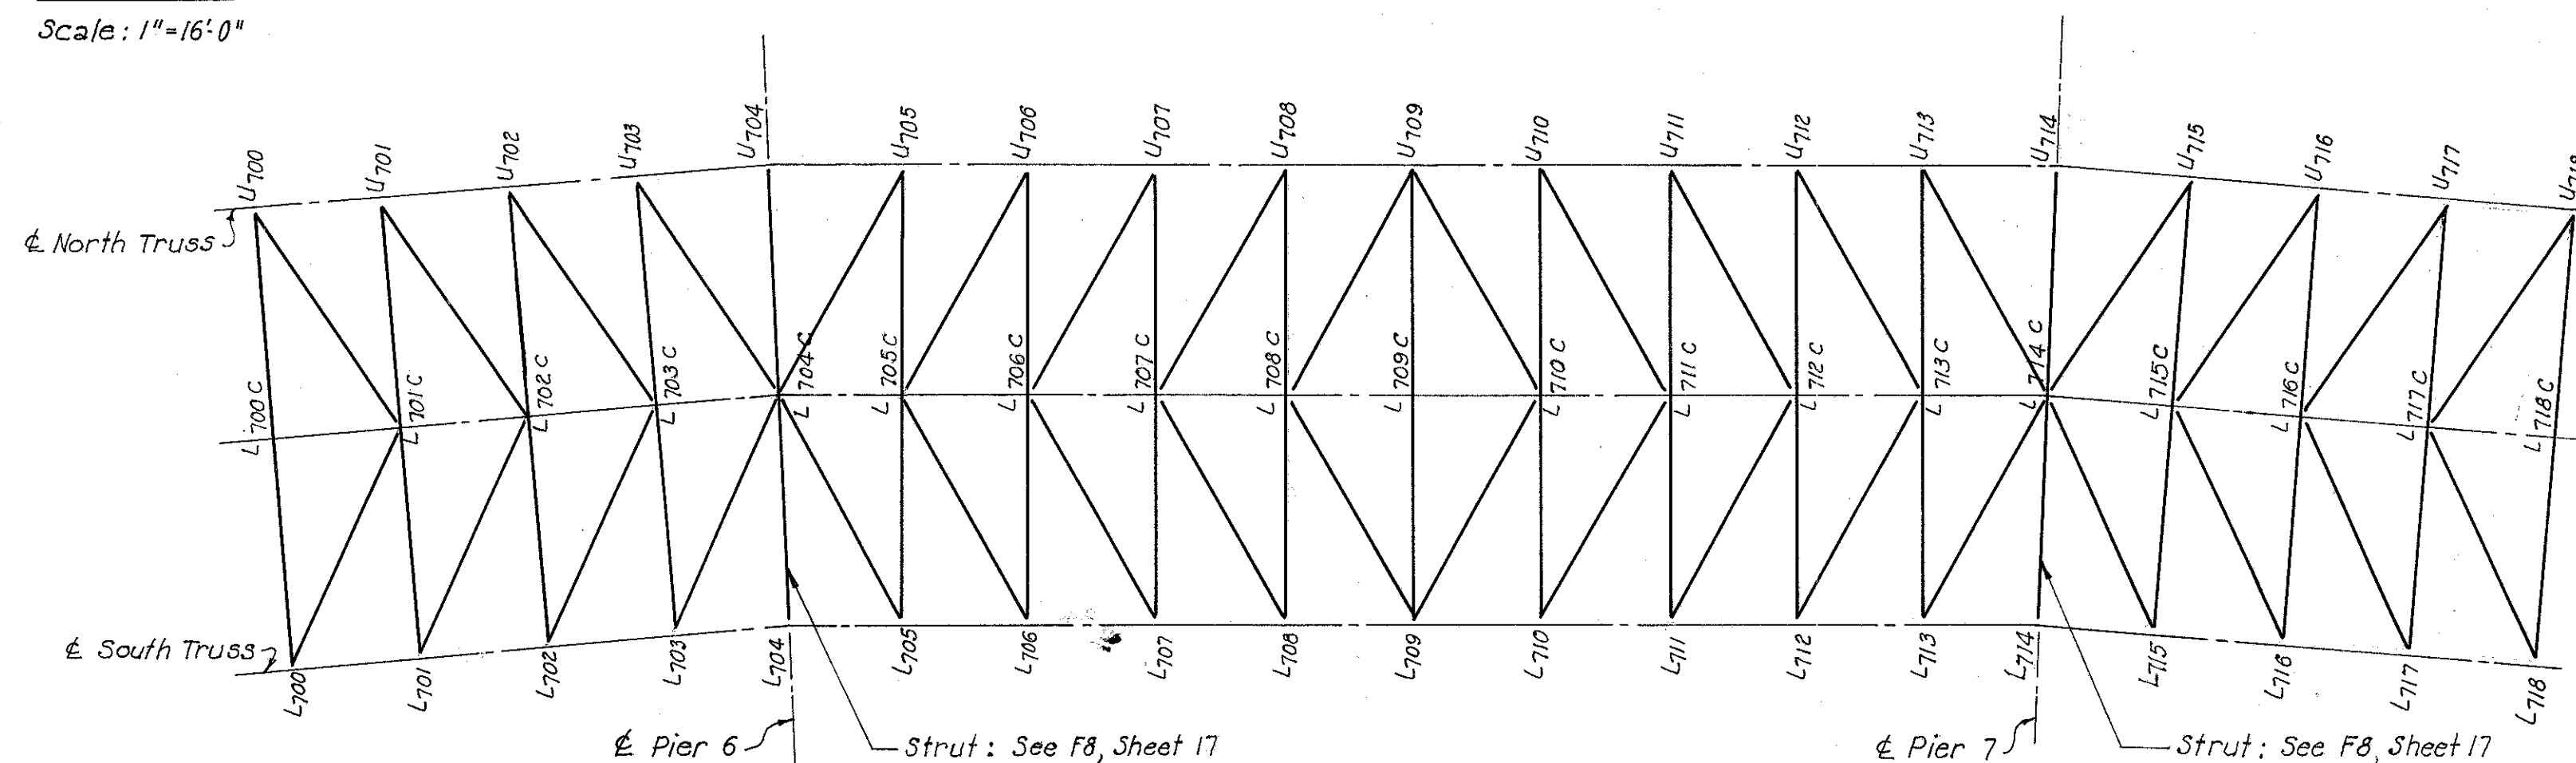

BOTTOM CHORD LATERAL BRACING

Scale: 1"=30'-0"

Top laterals and struts $\frac{1}{2}$ of 12 BP 53 # carbon steel unless noted.
Bottom laterals 4 bulb $\frac{1}{2}$ 8 x $3\frac{1}{2}$ x 16.0 # - web R 15 x $\frac{3}{8}$
Stringers 24 WF 76 #
Floorbeams 36 WF 150 #
Bottom lateral struts 2 C 15 x 33.9 # - 2 R 13 x $\frac{5}{8}$ unless noted.
For the distance from the roadway surface to the working line of the truss top chords at each panel point, see the table of Grades and Elevations on Sheet 12.
For truss sections and details see Sheets 80 to 87 inclusive.
Posts at piers and at ends of unit are vertical; other posts are normal to top chord.
For typical top lateral hanger, see Sheets 28 and 35.

PART 3


U. S. ROUTE 42 RELOCATION		
INNER BELT FREEWAY - CENTRAL VIADUCT		
BR. NO. CU - 42R-175		
FRAMING PLAN - UNIT 7		
CLEVELAND	CUYAHOGA COUNTY	OHIO
SCALE: As shown		
MADE N.A.M. DATE		
TRCD. A.H. DATE 7-26-54		
CKD. D.M.D. DATE 9-27-54		
HOWARD, NEEDLES, TAMMEN & BERGENDOFF CONSULTING ENGINEERS KANSAS CITY CLEVELAND NEW YORK		
914-1A SHEET 2.24		

MICROFILMED
FEB 15 1983


FED. ROAD DIV. NO.	STATE	FEDERAL AID PROJECT NO.	TYPE FUNDS
2	OHIO		

22
122


CUYAHOGA COUNTY
CITY OF CLEVELAND
INNER BELT FREEWAY
CENTRAL VIADUCT

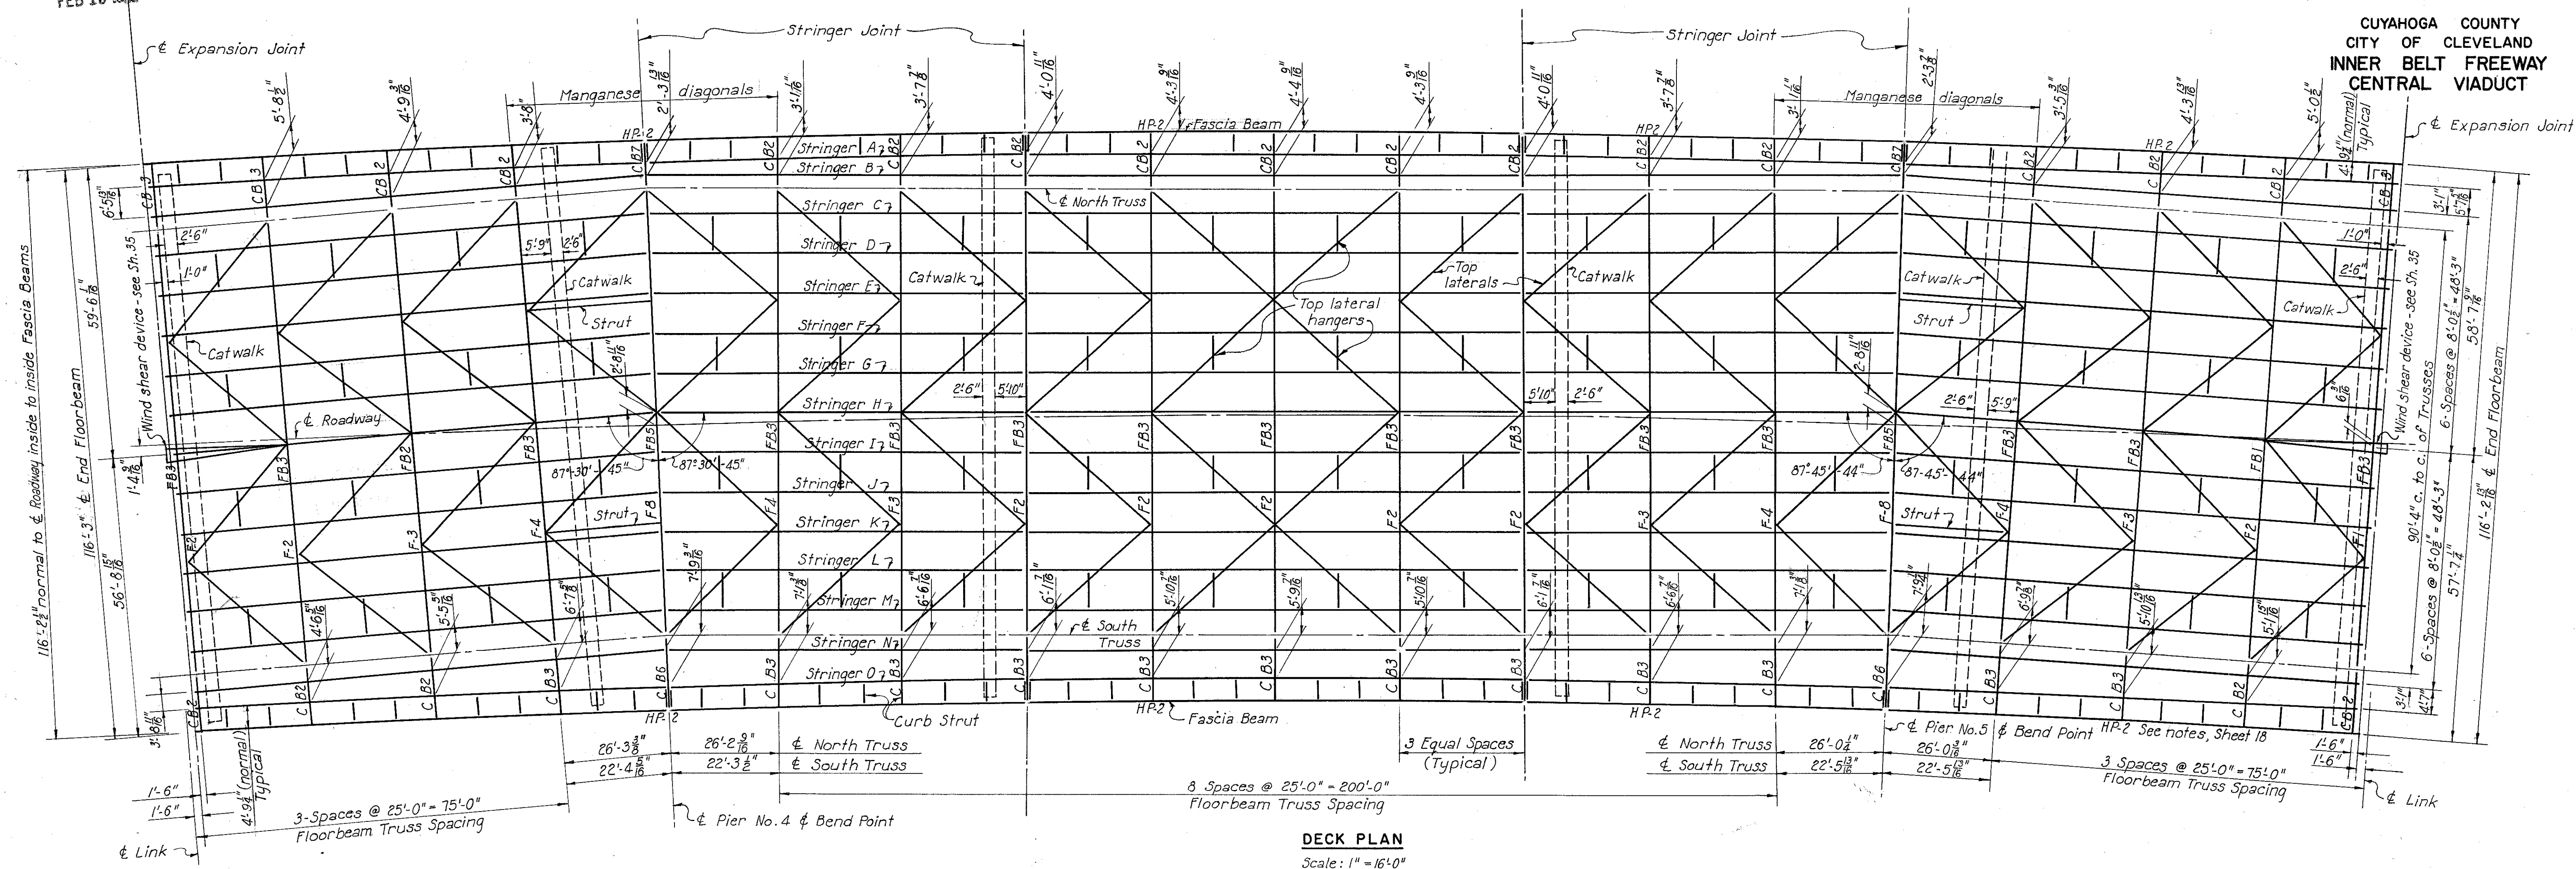


DECK PLAN
Scale: 1" = 16'-0"

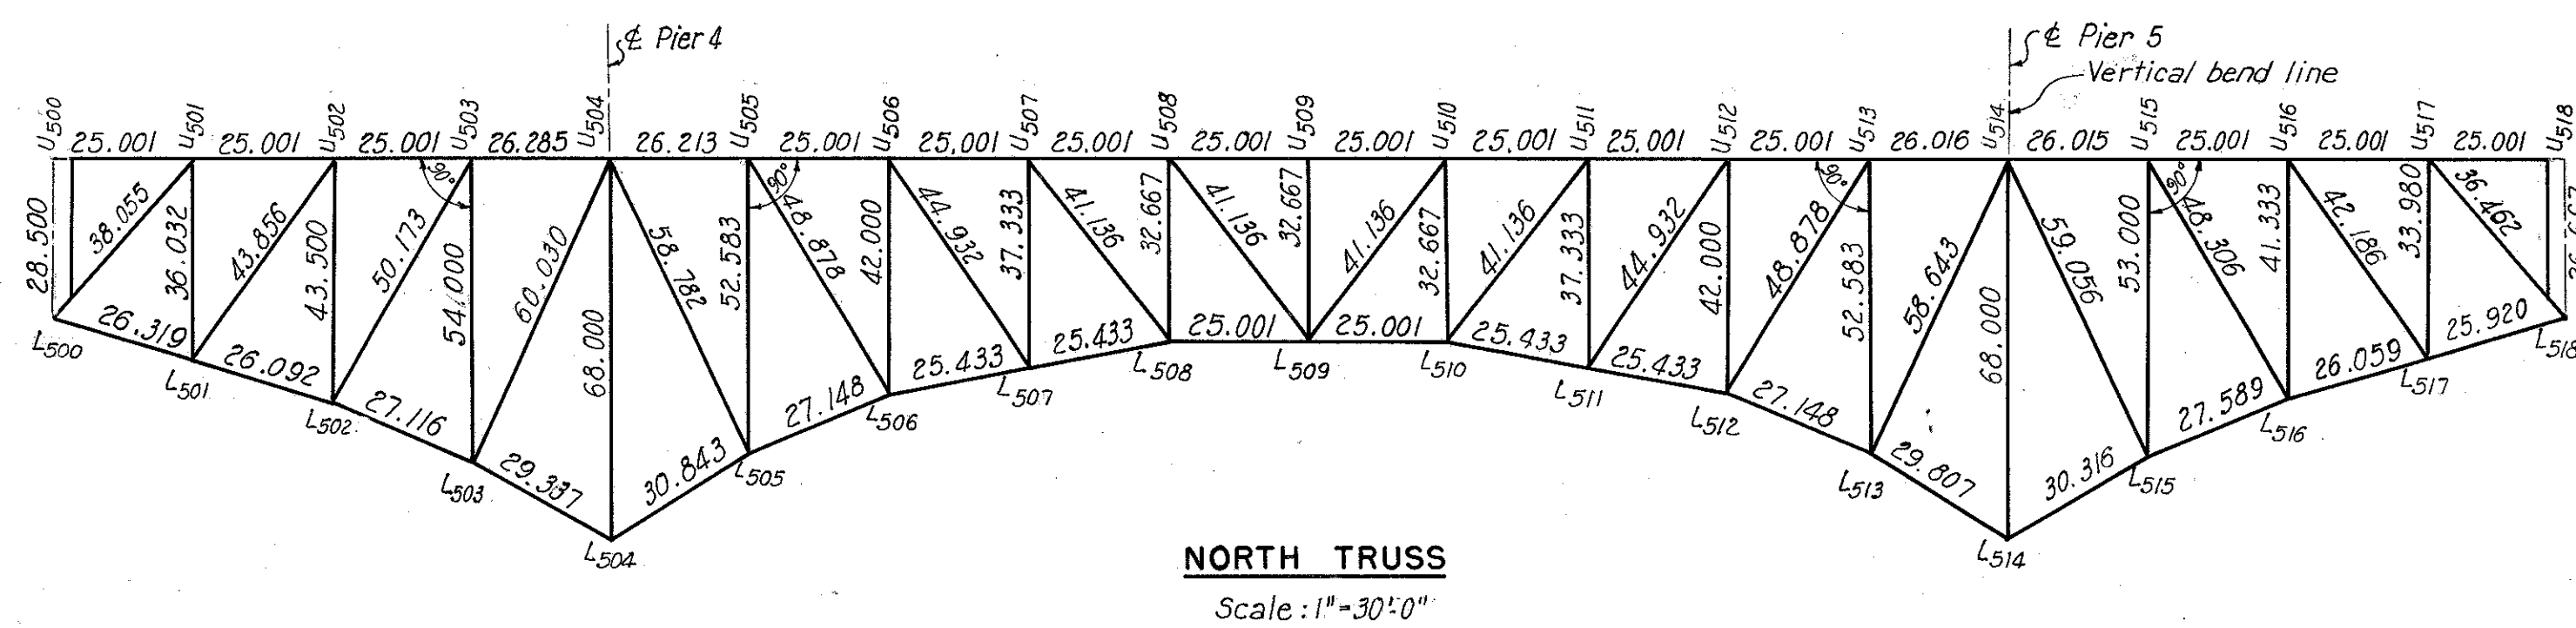

NORTH TRUSS
Scale: 1" = 30'-0"

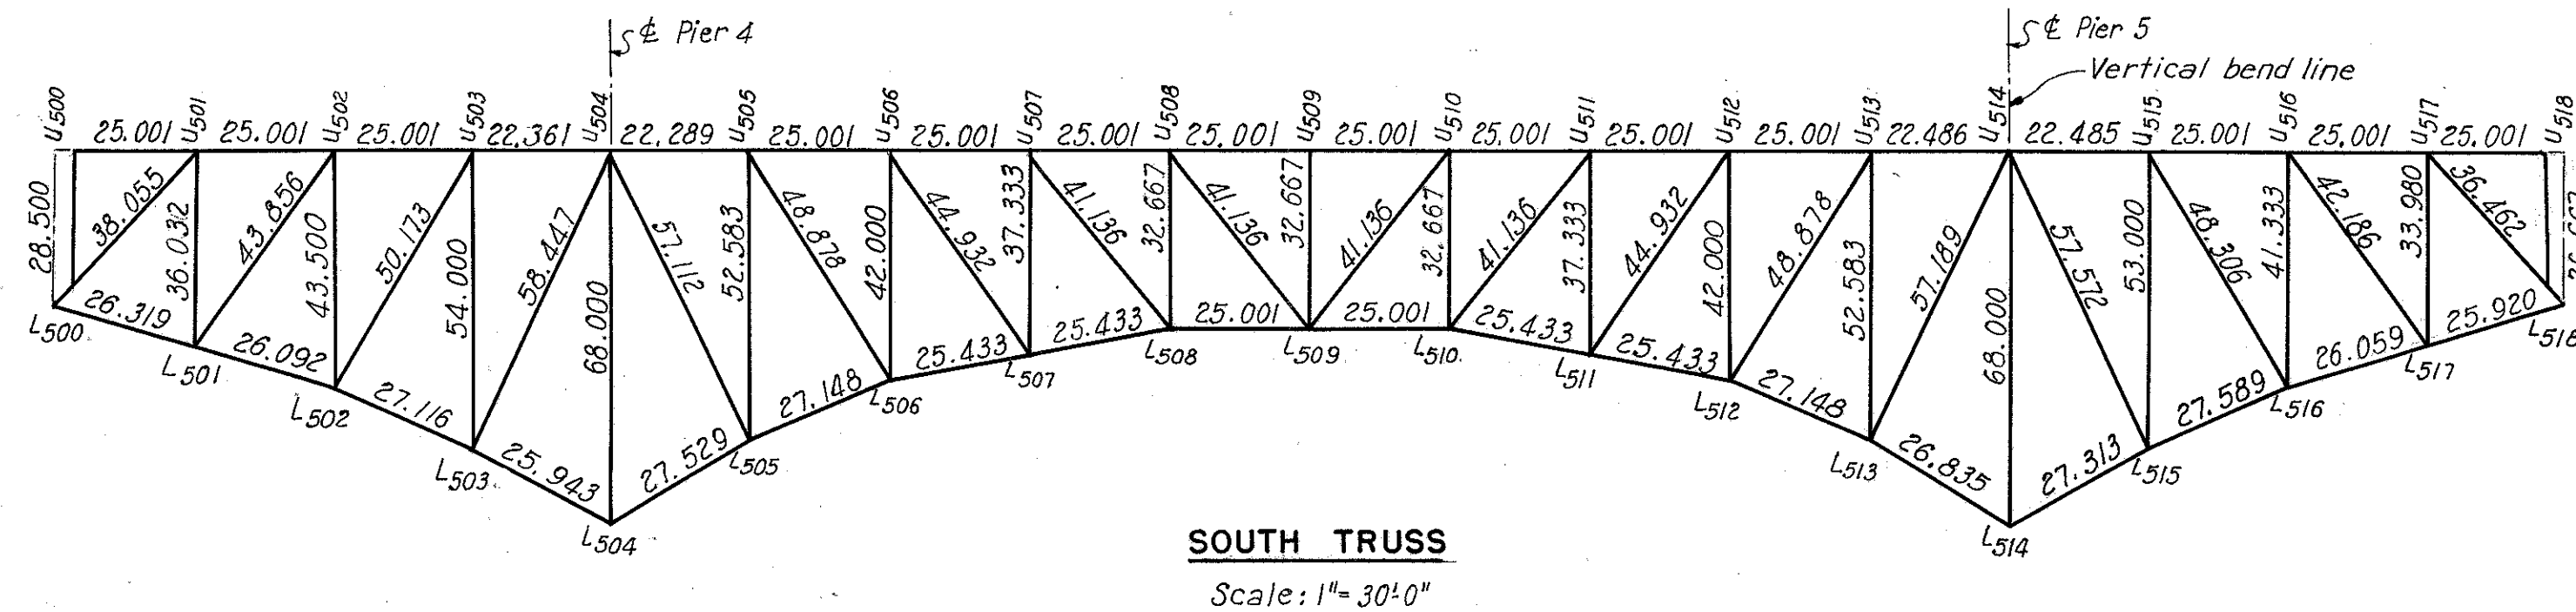

SOUTH TRUSS
Scale: 1" = 30'-0"

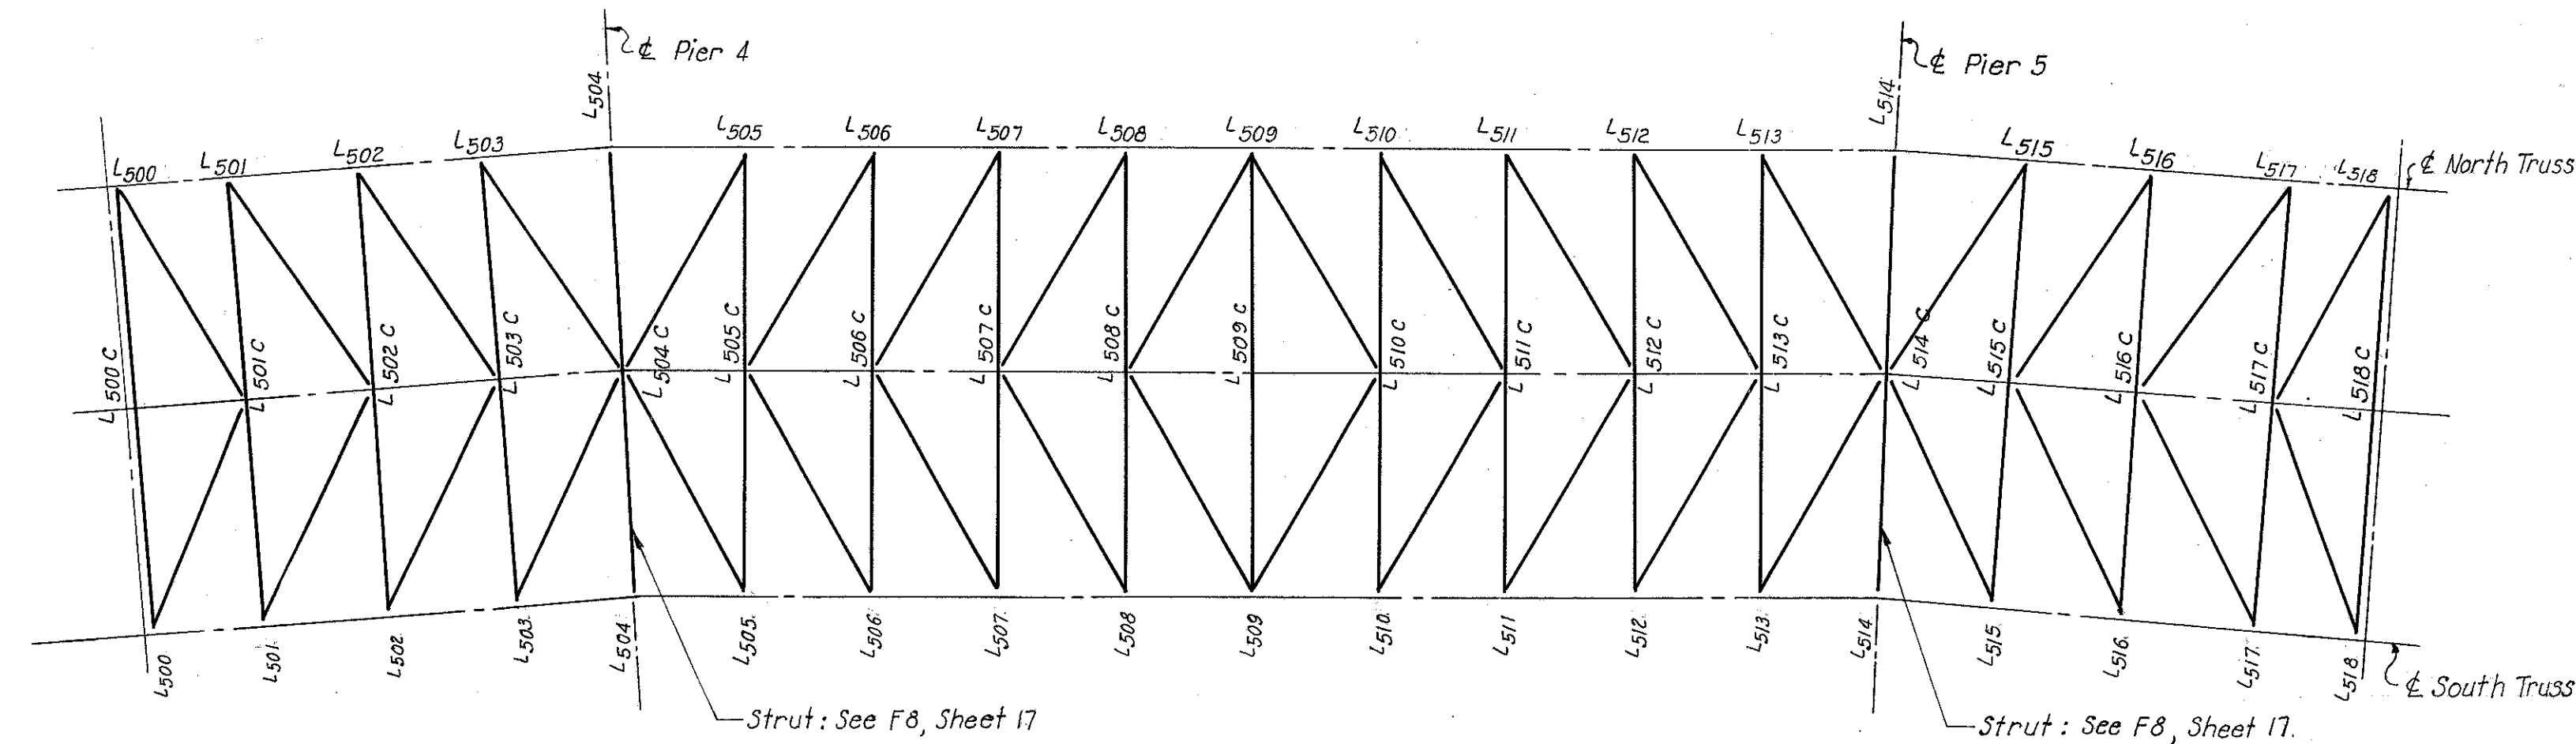

BOTTOM CHORD LATERAL BRACING
Scale: 1" = 30'-0"

Top laterals 1/2 of 12 BP 53 # - carbon steel unless noted.
Top lateral struts 1/2 of 12 BP 53 # - c
except wind shear devices.
Bottom laterals 4 Bulb 13 8 x 3 1/2 x 16 # - Web R 15 x 3
Stringers 24 WF 76 #
Floorbeams 36 WF 150 #
Bottom lateral struts: 2 B 15 x 33.9 - 2 R 13 x 16 unless noted.
For the distance from the roadway surface to the working
line of the truss top chord at each panel point, see the table
of Grades and Elevations, Sheet 12.
For truss sections and details see Sheets 63 to 76 inclusive.
Posts at piers and at ends of unit are vertical; other posts
are normal to top chord.
For typical top lateral hanger, see Sheets 28 and 35.

PART 3

U. S. ROUTE 42 RELOCATION
INNER BELT FREEWAY - CENTRAL VIADUCT
BR. NO. CU - 42R-175

FRAMING PLAN - UNIT 5


CLEVELAND	CUYAHOGA COUNTY	OHIO
SCALE: As shown	HOWARD, NEEDLES, TAMMEN & BERGENDOFF	CONSULTING ENGINEERS
MADE: L.B. DATE: 1-19-54	KANSAS CITY	CLEVELAND NEW YORK
TRCD: A.H. DATE: 7-22-54		
CKD: D.M.D. DATE: 9-27-54		
	914-1A	SHEET: 2.22

MICROFILMED
FEB 15 1983



FED. ROAD DIV. NO.	STATE	FEDERAL AID PROJECT NO.	TYPE FUNDS
2	OHIO		

21
122

CUYAHOGA COUNTY
CITY OF CLEVELAND
INNER BELT FREEWAY
CENTRAL VIADUCT

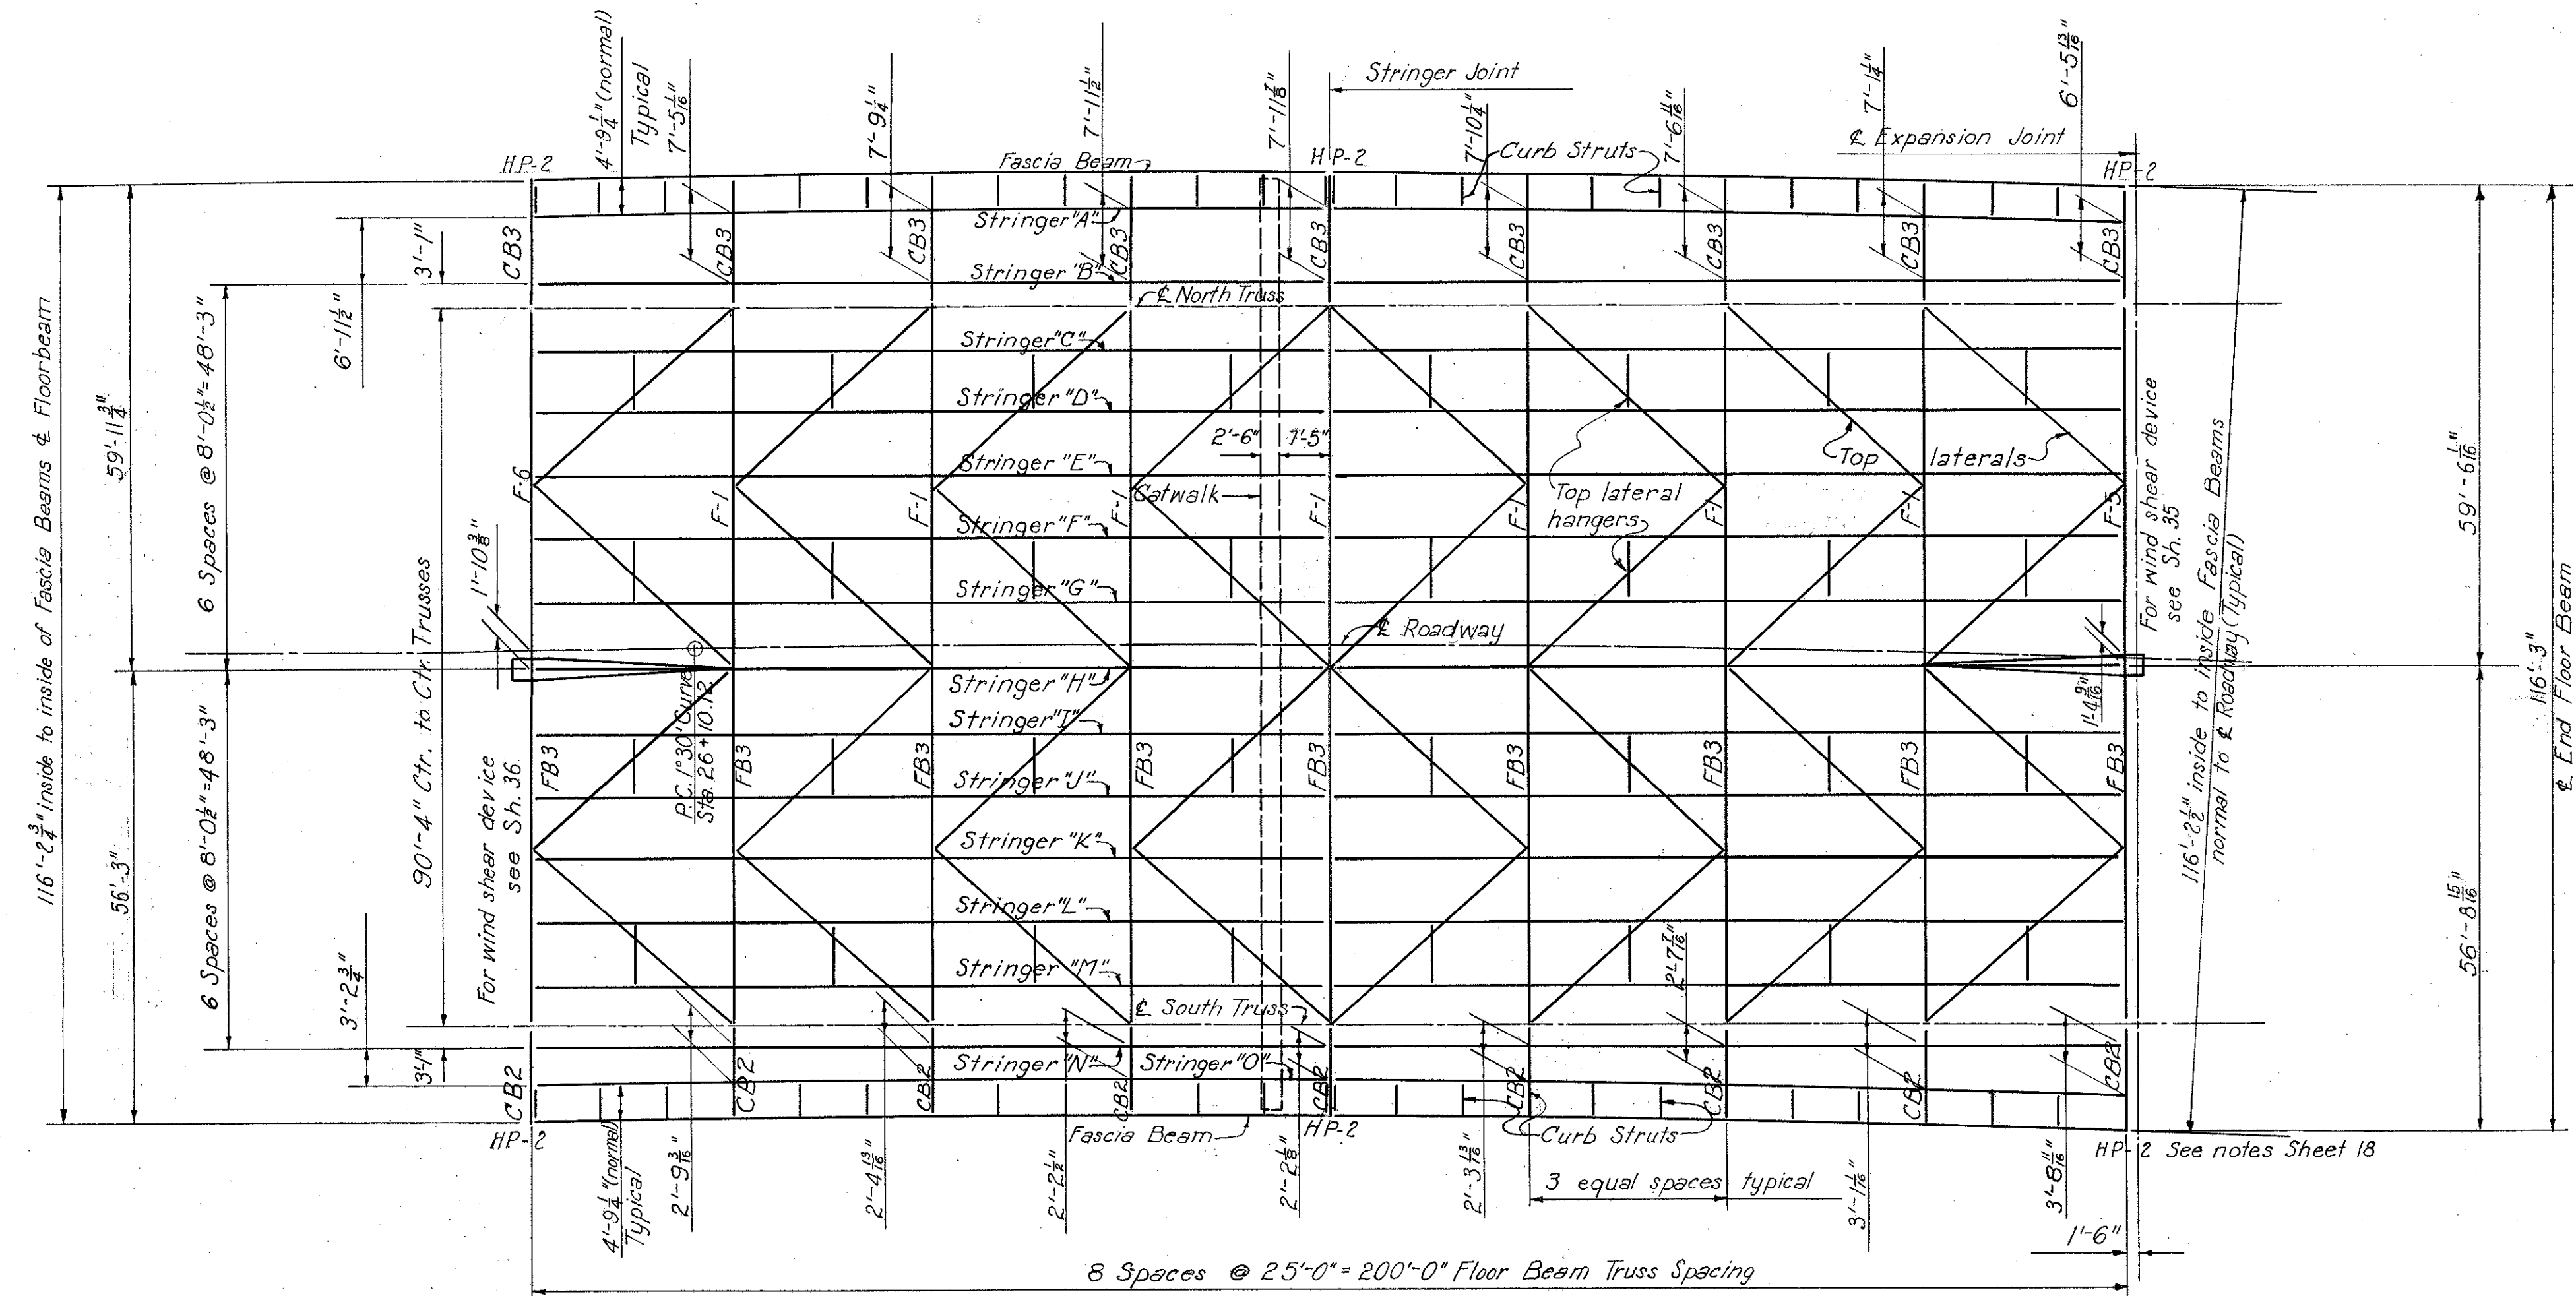

8 Spaces @ 25'-0" = 200'-0" Floor Beam Truss Spacing

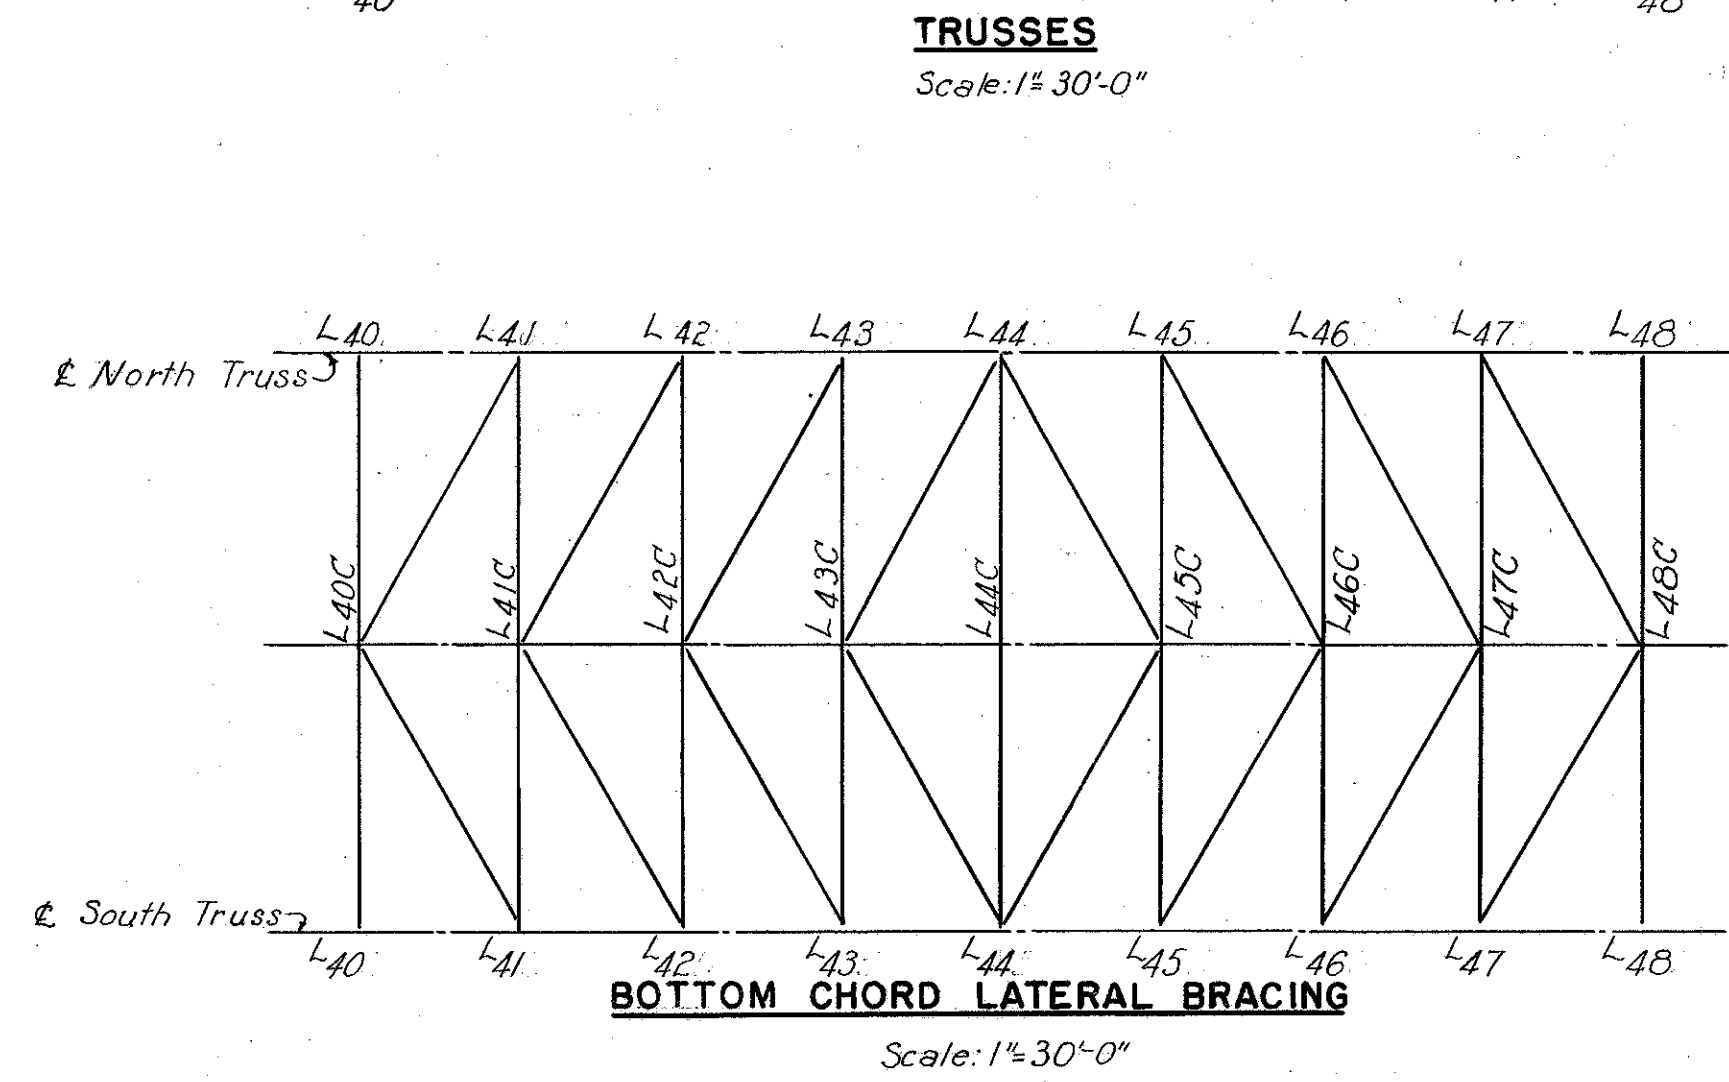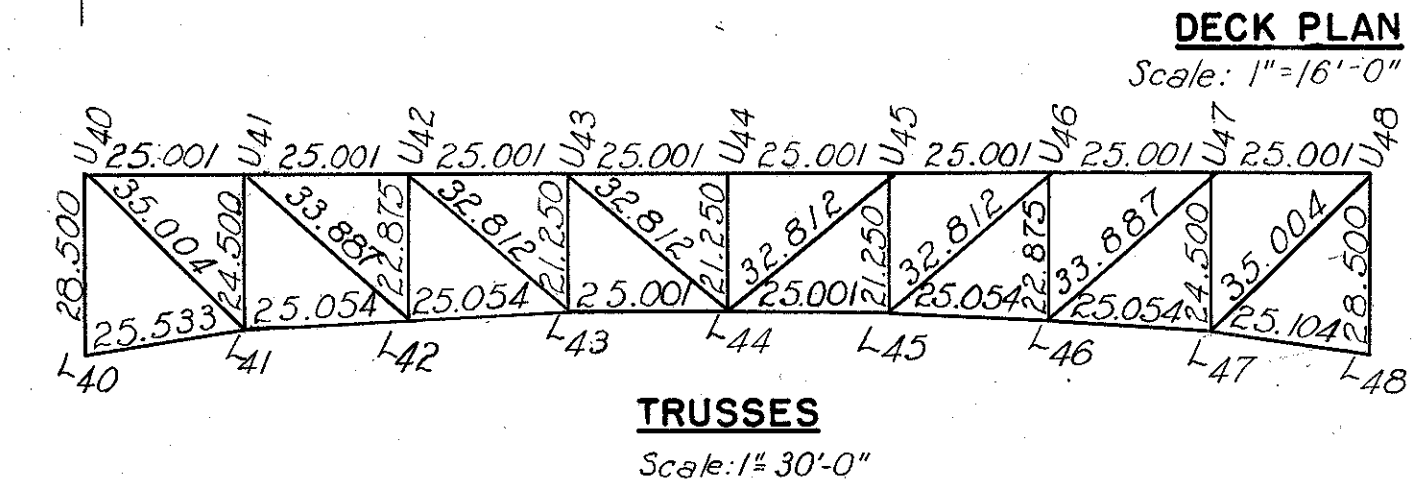

BOTTOM CHORD LATERAL BRACING
Scale: 1/2" = 30'-0"

All top laterals 1/2 of 12BP53#
Bottom laterals 4bulb 1/8 8x3 1/2 x 16.0#-Web Pl. 15 x 8#
Stringers 24WF76#
Floorbeams 36WF150#
Bottom lateral struts: 2 @ 15x33.9-2 Pls. 13x7 1/2
For the distance from the roadway surface to the working line of the truss top chord at each panel point, see the table of Grades and Elevations, Sh. 12.
For truss sections and details see Sheets 58 to 62 inclusive.
Posts at ends of unit are vertical; other posts are normal to top chord.
For typical top lateral hanger, see Sheets 28 and 35.

PART 3

U. S. ROUTE 42 RELOCATION
INNER BELT FREEWAY - CENTRAL VIADUCT
BR. NO. CU - 42R-17.5

FRAMING PLAN-UNIT 4

CLEVELAND CUYAHOGA COUNTY OHIO

SCALE: AS SHOWN
MADE: L.L.D. DATE 6-8-54
TRCD: BULB DATE 6-8-54
CKD: D.M.D. DATE 9-30-54

HOWARD, NEEDLES, TAMMEN & BERGENDOFF
CONSULTING ENGINEERS
KANSAS CITY CLEVELAND NEW YORK

914-1A SHEET 2.21


SCALE As shown
MADE LWL DATE 1-18-54
TRCD. AH DATE 7-19-54
CKD. DMD DATE 9-28-54

HOWARD, NEEDLES, TAMMEN & BERGENDOFF
CONSULTING ENGINEERS
KANSAS CITY CLEVELAND NEW YORK
914-1A SHEET- 2 20

MICROFILMED
FEB 15 1983


FED. ROAD DIV. NO.	STATE	FEDERAL AID PROJECT NO.	TYPE FUNDS
2	OHIO		

CUYAHOGA COUNTY
CITY OF CLEVELAND
INNER BELT FREEWAY
CENTRAL VIADUCT

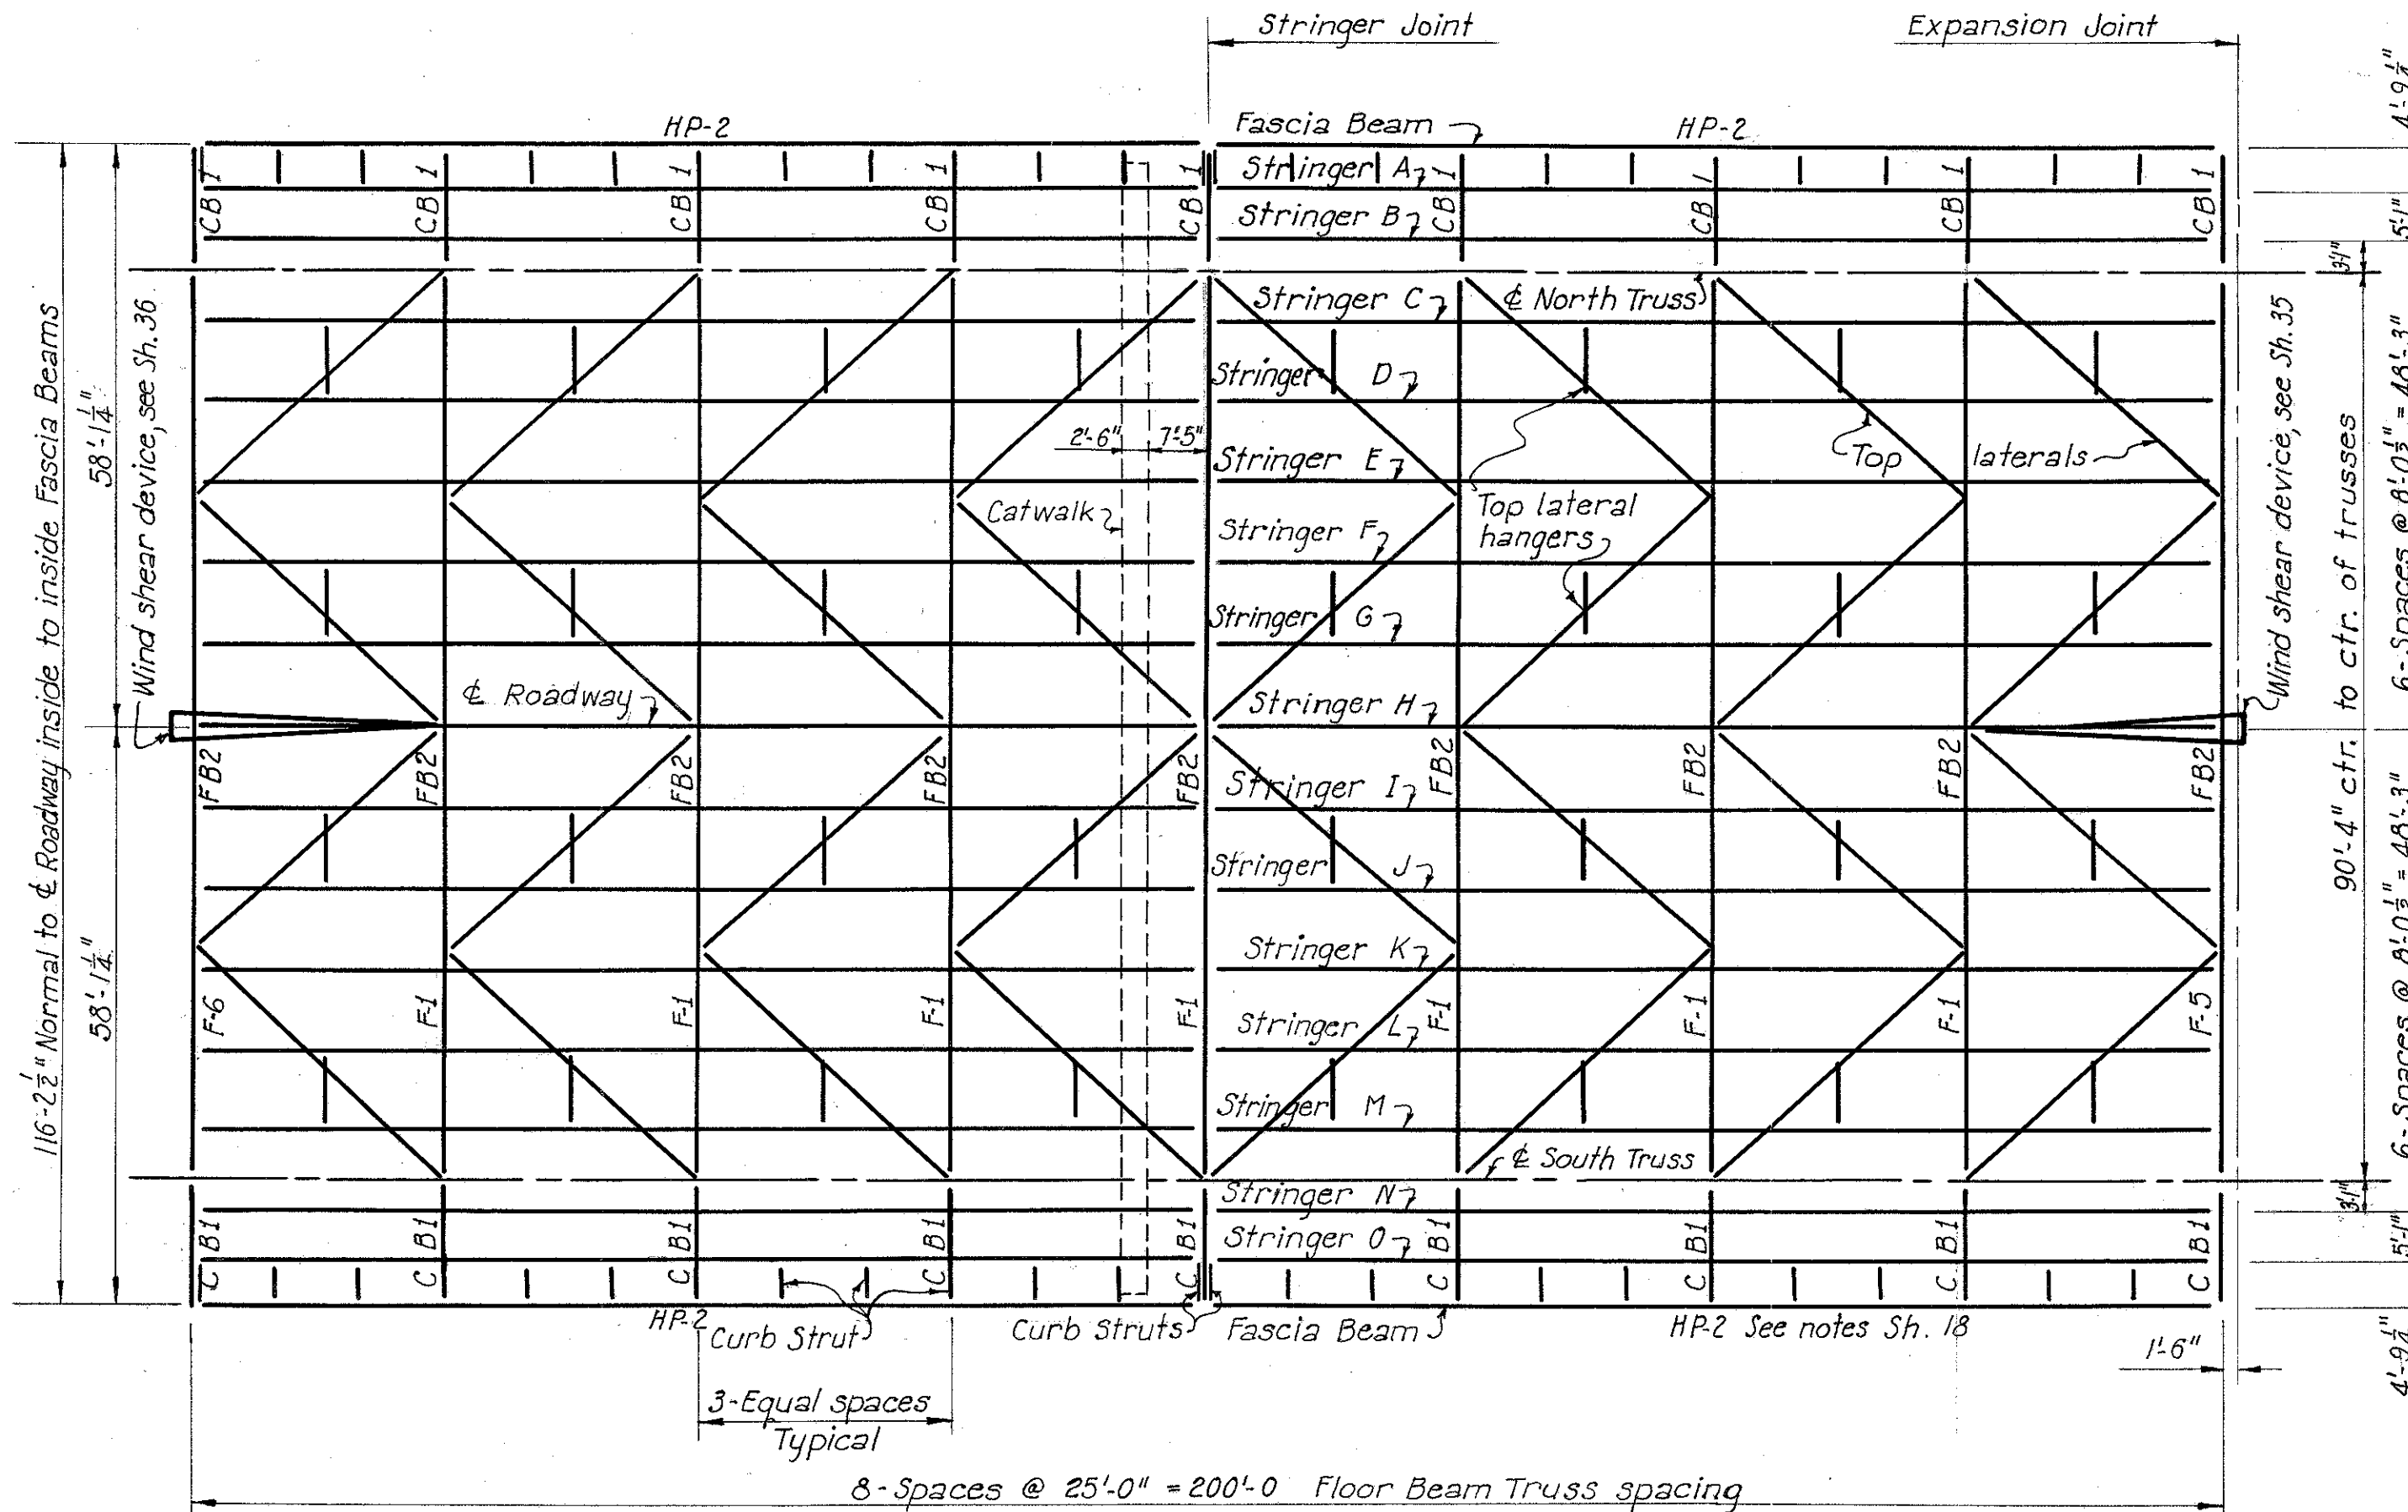

DECK PLAN


Scale: $\frac{1}{16}'' = 1'-0$

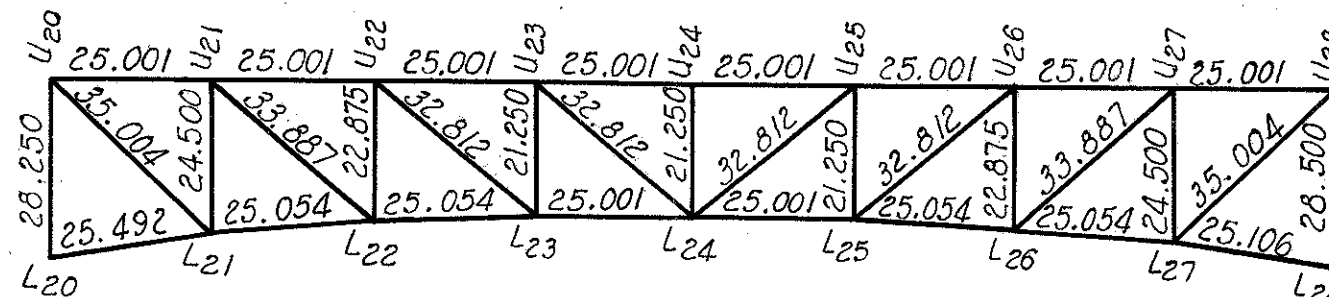

TRUSSE

Scale: 1" = 30'

Top laterals $\frac{1}{2}$ of 12 BP 53 #
Bottom laterals 4 bulb $\frac{1}{8}$ 8 x $3\frac{1}{2}$ x 16.0 # - web $\frac{1}{8}$ 15 x $\frac{3}{8}$
Stringers 24 WF 76 #
Floorbeams 36 WF 150 #
Bottom lateral struts 2 $\frac{1}{8}$ 15 x 33.9 - 2 $\frac{1}{8}$ s, 13 x $\frac{5}{16}$.
Working line of truss top chord is 4'-4 $\frac{1}{2}$ " below roadway surface. See the table of grades and Elevations, Sheet 12.
For truss sections and details, see Sheets 44 to 46
Posts at ends of unit are vertical; other posts are normal to top chord.
For typical top lateral hanger, see Sheets 28 and 35.

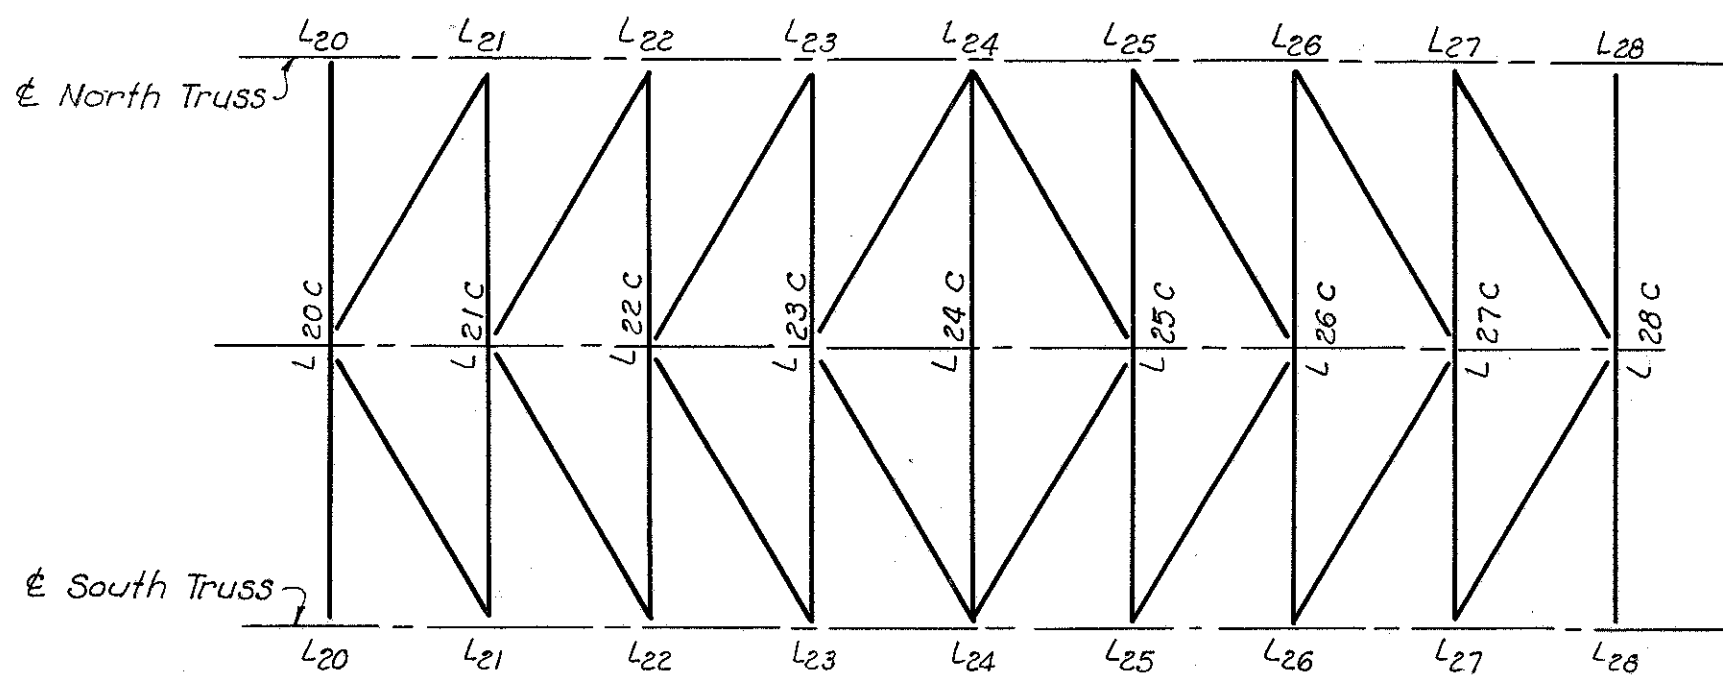

BOTTOM CHORD LATERAL BRACING

Scale: 1" = 30'-0"

PART 3

U. S. ROUTE 42 RELOCATION
INNER BELT FREEWAY - CENTRAL VIADUCT
BR. NO. CU - 42 R-17.5

FRAMING PLAN - UNIT 2

CLEVELAND CUYAHOGA COUNTY OH


SCALE As shown
MADE FG DATE 1-14-54
TRCD GK#AH DATE 7-27-54
CKD D.M.D. DATE 9-30-54

HOWARD, NEEDLES, TAMMEN & BERGENDORF
CONSULTING ENGINEERS
KANSAS CITY CLEVELAND NEW YORK
914-1A SHEET 219

[illegible]

Diagram of a truss structure with 12 panels. The top chord is labeled with vertical loads U_{00} to U_{12} . The bottom chord is labeled with horizontal loads L_{100} to L_{112} . The truss is supported by a pier at the right end. The diagram shows the distribution of loads and the structure of the truss members.

For 15" channel framing at expansion joints
see Roadway Expansion Joints.
For 13" channel framing at contraction joints.
see Roadway Drains Type B and Slab Plans.

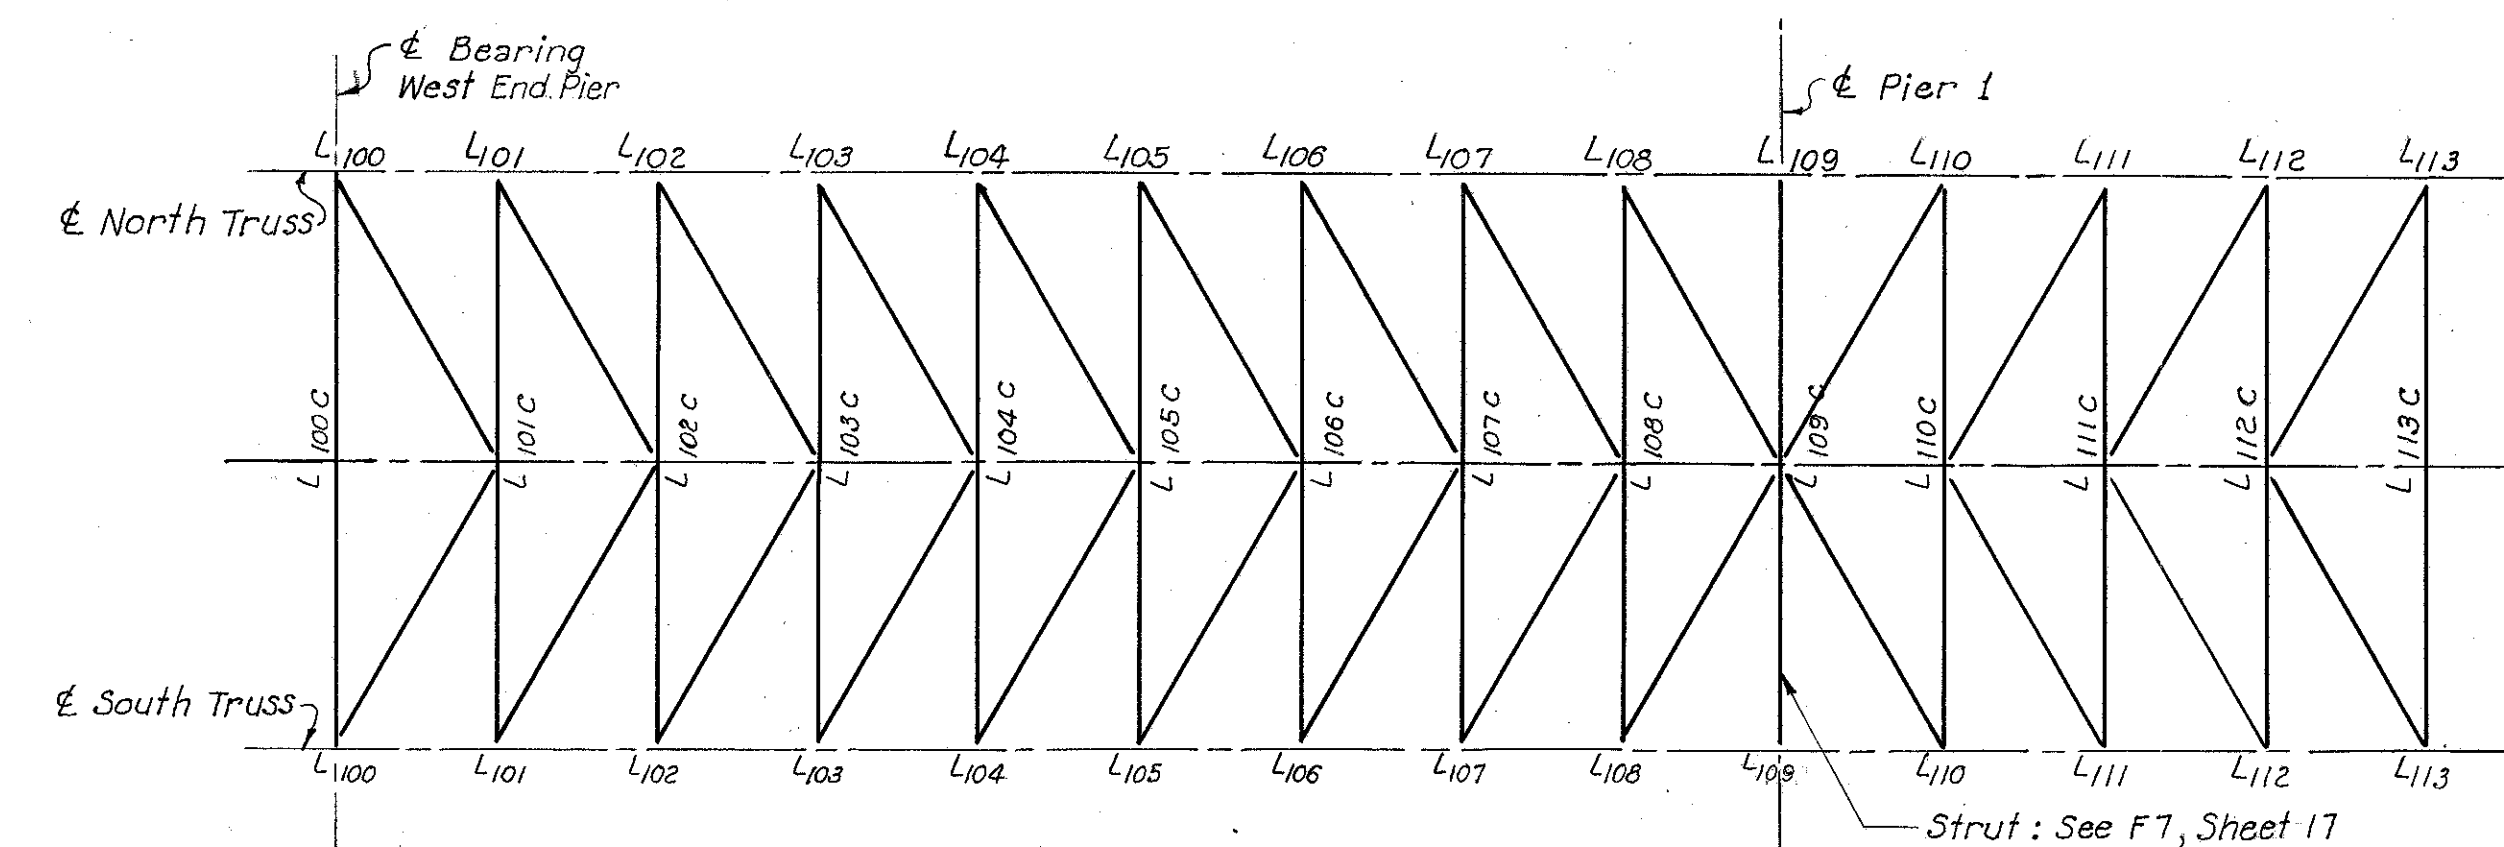

Top laterals $\frac{1}{2}$ of 12 BP 53 #, carbon steel unless noted.
Bottom laterals 4 bulb L^S 8 x $3\frac{1}{2}$ x 16.0 # - Web fl. 15 x $\frac{3}{8}$
Stringers 24 WF 76 #
Floorbeams 36 WF 150 #
Bottom lateral struts 2 B 15 x 33.9 - 2 fls. 13 x $\frac{5}{8}$ unless noted.
The working line of the truss top chord is 4'-4 $\frac{1}{2}$ " below the roadway surface. See the table of Grades and Elevations, Sheet 12.
For truss sections and details, see Sheets 38 to 43 inclusive.
Posts at piers and at ends of unit are vertical; other posts are normal to top chord.
Handrail posts to be located at floorbeams and at third points between floorbeams. Posts not marked HP-2 (light pole support) will be HP-1. See Sheet 99.
For typical top lateral hanger, see Sheets 28 and 35.

CLEVELAND GUYAHOGA COUNTY OHIO

SCALE As shown
MADE WFG DATE 1-19-54
TRCD. ^{UDB} 2 AH DATE 7-28-54
CKD D.M.D. DATE 9-24-54


HOWARD, NEEDLES, TAMMEN & BERGENDOFF
CONSULTING ENGINEERS
KANSAS CITY CLEVELAND NEW YORK
914-1A SHEET 2.18

MICROFILMED
FEB 15 1983

FED. ROAD DIV. NO.	STATE	FEDERAL AID PROJECT NO.	TYPE FUNDS
2	OHIO		

17
122

CUYAHOGA COUNTY
CITY OF CLEVELAND
INNER BELT FREEWAY
CENTRAL VIADUCT

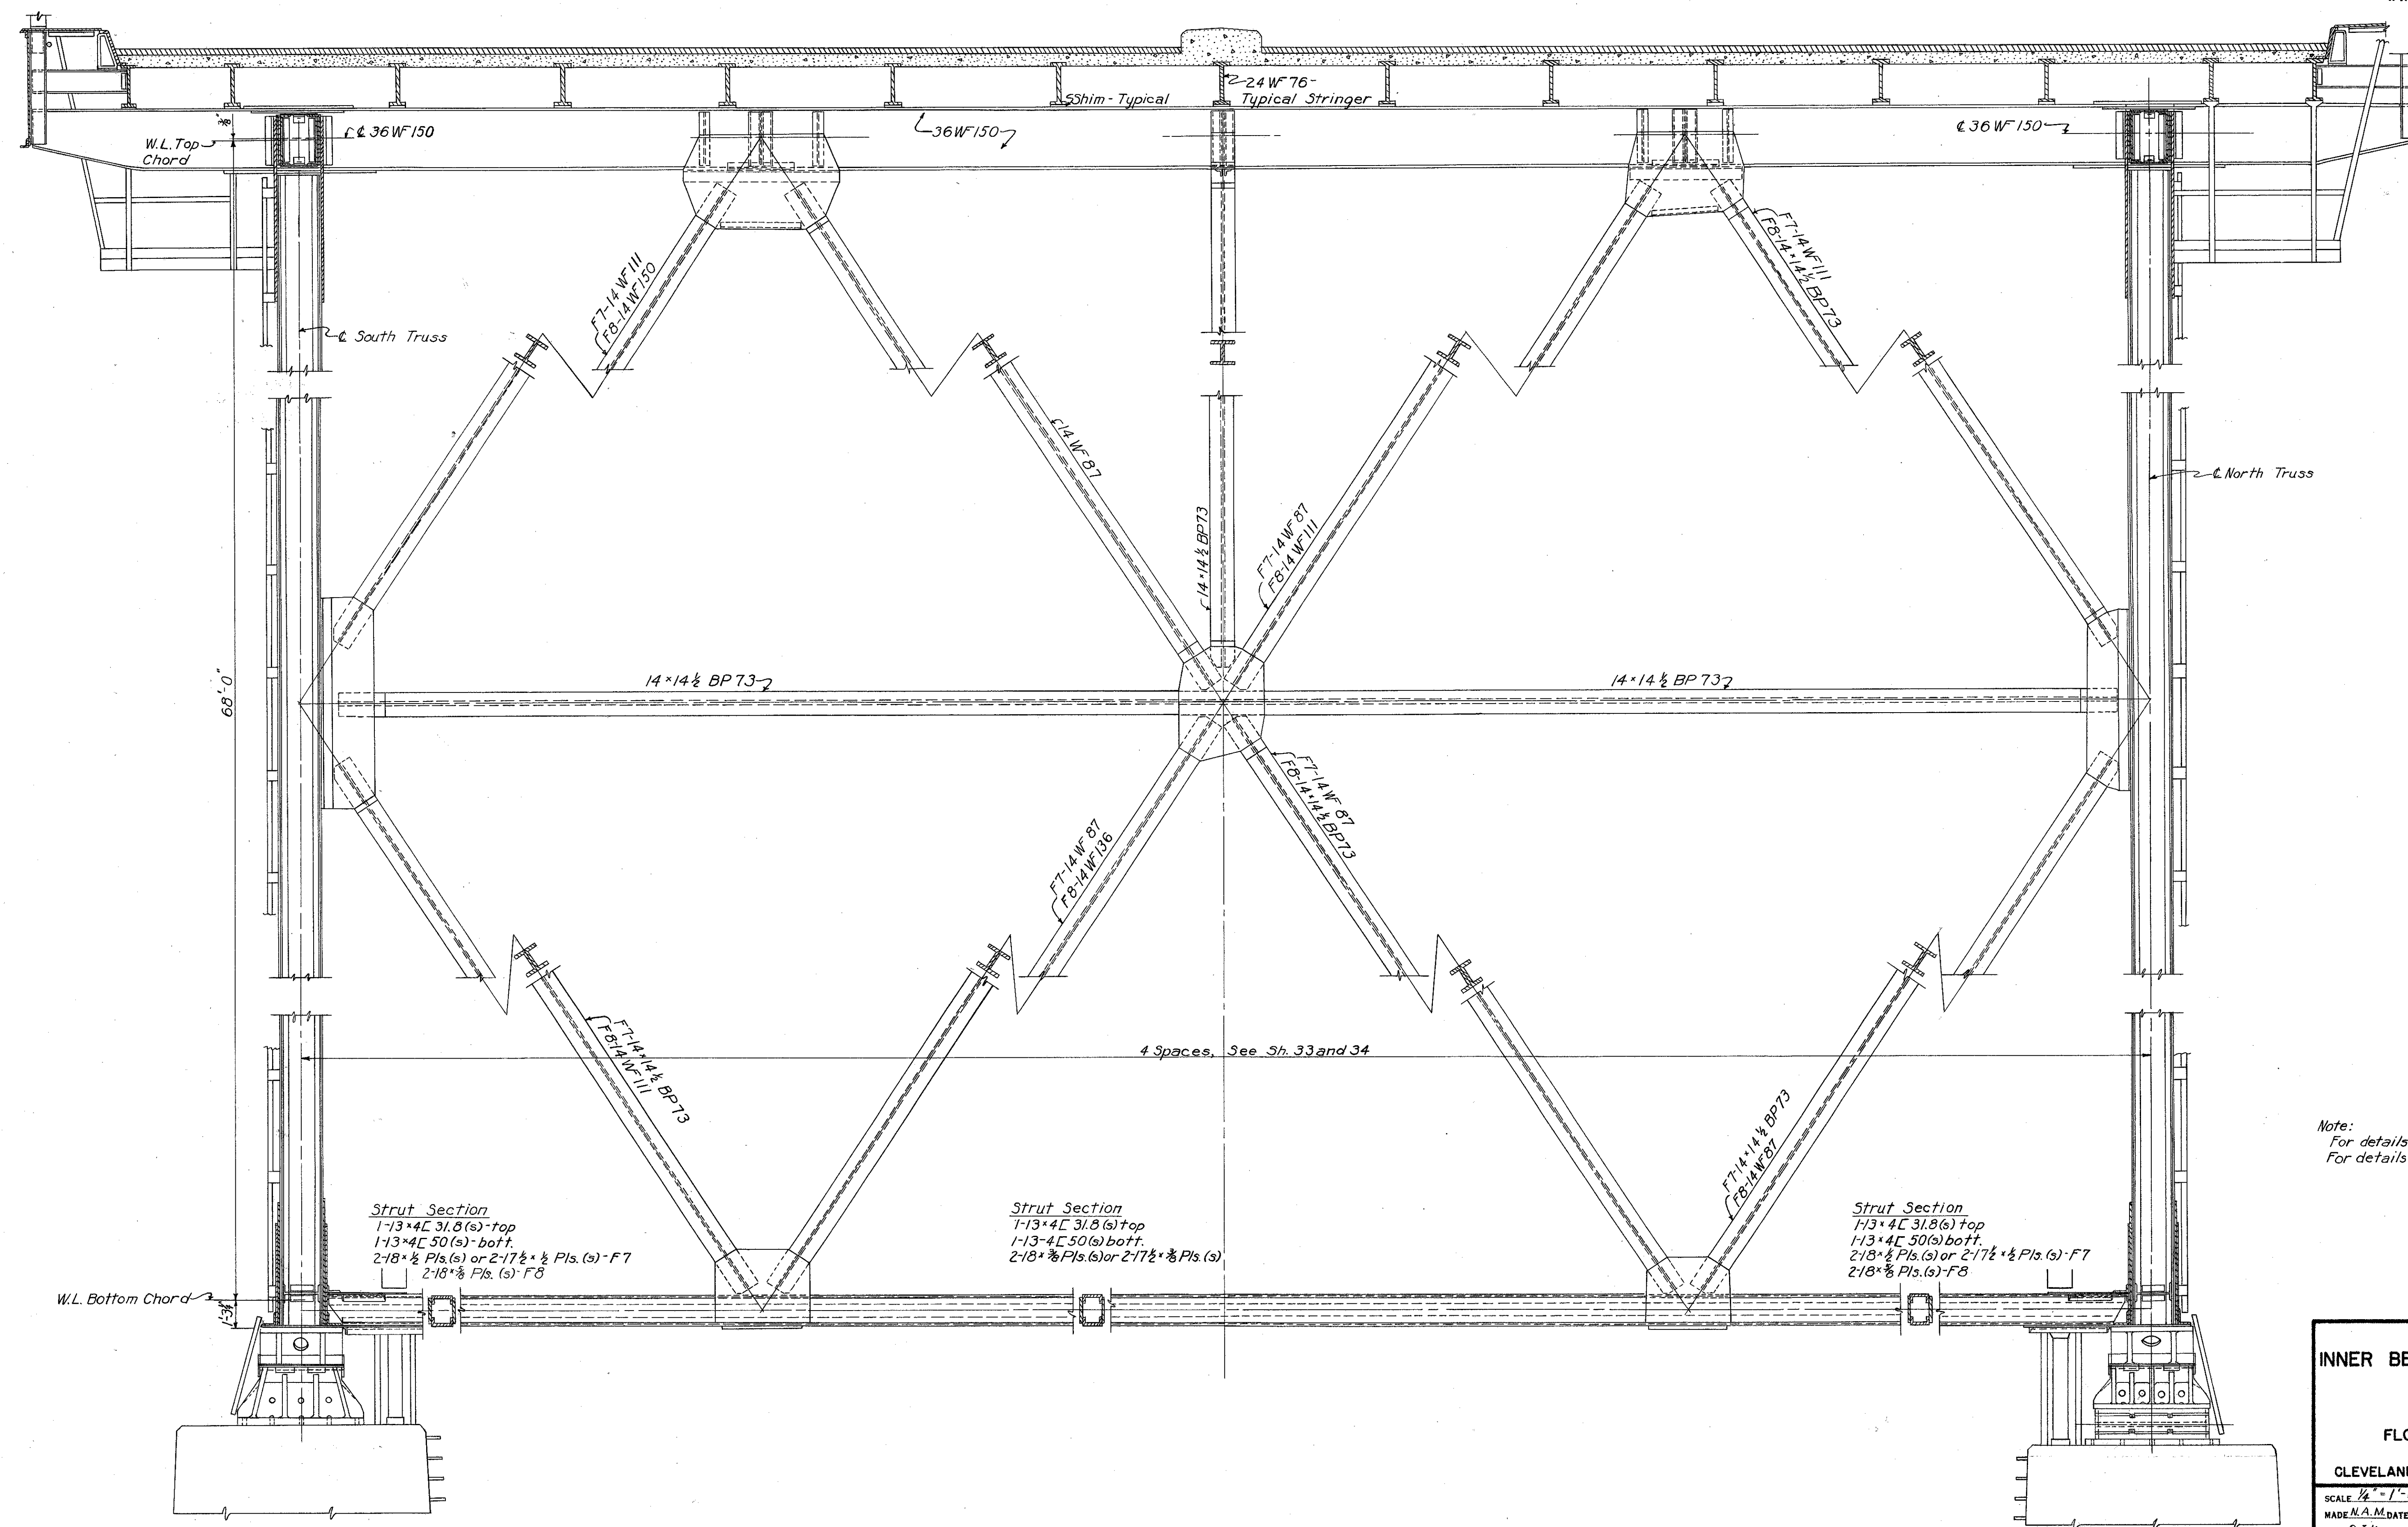

Note:
For details of Floorbeam Truss F7 see Sh. 33.
For details of Floorbeam Truss F8 see Sh. 36.

PART 3

U. S. ROUTE 42 RELOCATION		
INNER BELT FREEWAY - CENTRAL VIADUCT		
BR. NO. CU - 42R-17.5		
GENERAL CROSS SECTION		
FLOOR BEAM TRUSSES F7 & F8		
CLEVELAND	CUYAHOGA COUNTY	OHIO
SCALE 1/4" = 1'-0"		
MADE N.A.M. DATE		
TRCD. S.J.K. DATE 10-18-54		
CKD. D.M.D. DATE 9-2-54		
HOWARD, NEEDLES, TAMMEN & BERGENDOFF		
CONSULTING ENGINEERS		
KANSAS CITY	CLEVELAND	NEW YORK
914-1A SHEET 2.17		

FED. ROAD DIV. NO.	STATE	FEDERAL AID PROJECT NO.	TYPE FUNDS
2	OHIO		

16

122

[illegible]

HALF SECTION F6


PART 3

CLEVELAND CUYAHOGA COUNTY OHIO

SCALE $\frac{1}{4}'' = 1'-0''$
 MADE NAM DATE _____
 TRCD GJK DATE 10-9-54
 CKD DMD DATE 9-2-54

HOWARD, NEEDLES, TAMMEN & BERGENDORFF
 CONSULTING ENGINEERS
 KANSAS CITY CLEVELAND NEW YORK
 914-1A SHEET-2.16

FED. ROAD DIV. NO.	STATE	FEDERAL AID PROJECT NO.	TYPE FUNDS
2	OHIO		



[illegible]

Note:
For details of Floorbeam Trusses F3 & F4
See Sh. 31.
For location of Floorbeam Trusses see
Framing Plans.

PART 3

U. S. ROUTE 42 RELOCATION
INNER BELT FREEWAY - CENTRAL VIADUCT
BR. NO. CU 42 R 1750

GENERAL CROSS SECTION

FLOOR BEAM TRUSSES F3 & F4

CLEVELAND CUYAHOGA COUNTY OHIO

SCALE $\frac{1}{4}" = 1'-0"$
MADE LIB DATE 2-1-54
TRCD SWK DATE 9-30-54
CKD DMD DATE 9-2-54


HOWARD, NEEDLES, TAMMEN & BERGENDOFF
CONSULTING ENGINEERS
KANSAS CITY CLEVELAND NEW YORK
914-1A SHEET 215

MICROFILMED
FEB 15 1983

FED. ROAD DIV. NO.	STATE	FEDERAL AID PROJECT NO.	TYPE FUNDS
2	OHIO		

14
122

CUYAHOGA COUNTY
CITY OF CLEVELAND
INNER BELT FREEWAY
CENTRAL VIADUCT

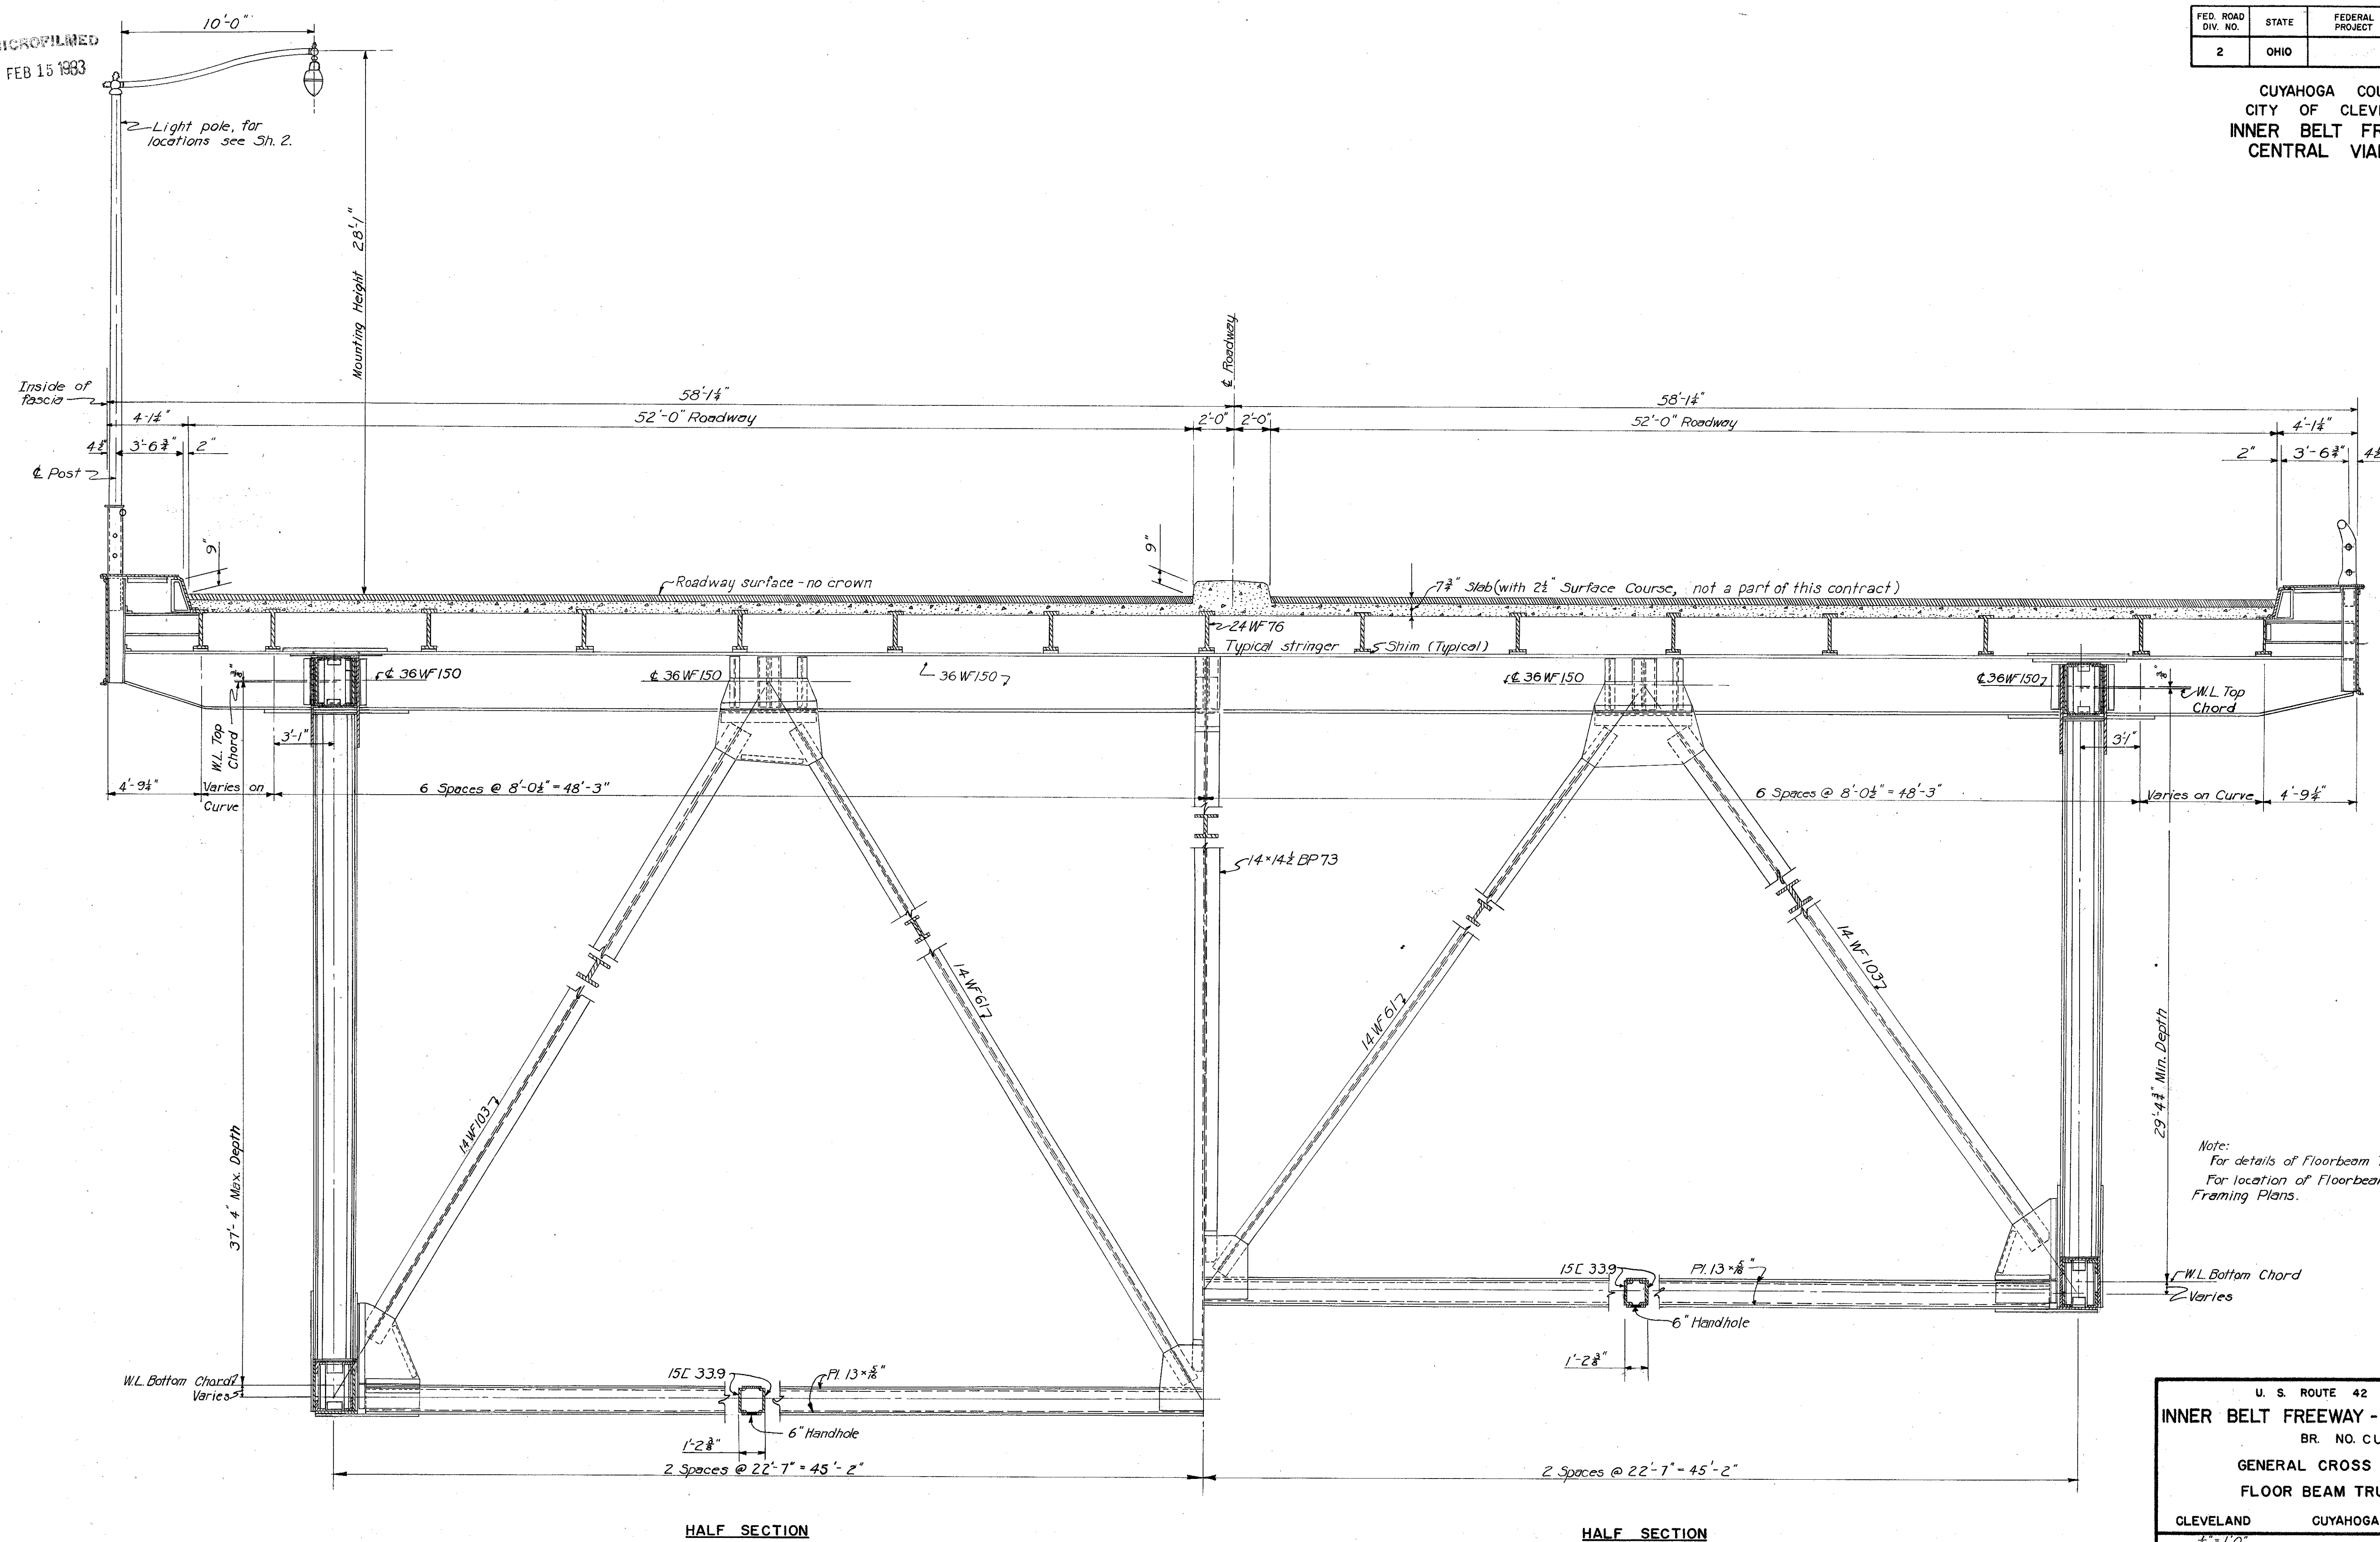

PART 3


U. S. ROUTE 42 RELOCATION			
INNER BELT FREEWAY - CENTRAL VIADUCT			
BR. NO. CU - 42 R-17.5			
GENERAL CROSS SECTION			
FLOOR BEAM TRUSSES F2			
CLEVELAND	CUYAHOGA COUNTY		OHIO
SCALE 1/4" = 1'-0"			
MADE WEG	DATE 1-29-54	HOWARD, NEEDLES, TAMMEN & BERGENDOFF	
TRCD. GUK	DATE 9-2-54	CONSULTING ENGINEERS	
CRD. DMD	DATE 9-22-54	KANSAS CITY	CLEVELAND NEW YORK
		914-1A	SHEET 2.14

MICROFILMED
FEB 15 1983

FED. ROAD DIV. NO.	STATE	FEDERAL AID PROJECT NO.	TYPE FUNDS
2	OHIO		

13
122

CUYAHOGA COUNTY
CITY OF CLEVELAND
INNER BELT FREEWAY
CENTRAL VIADUCT

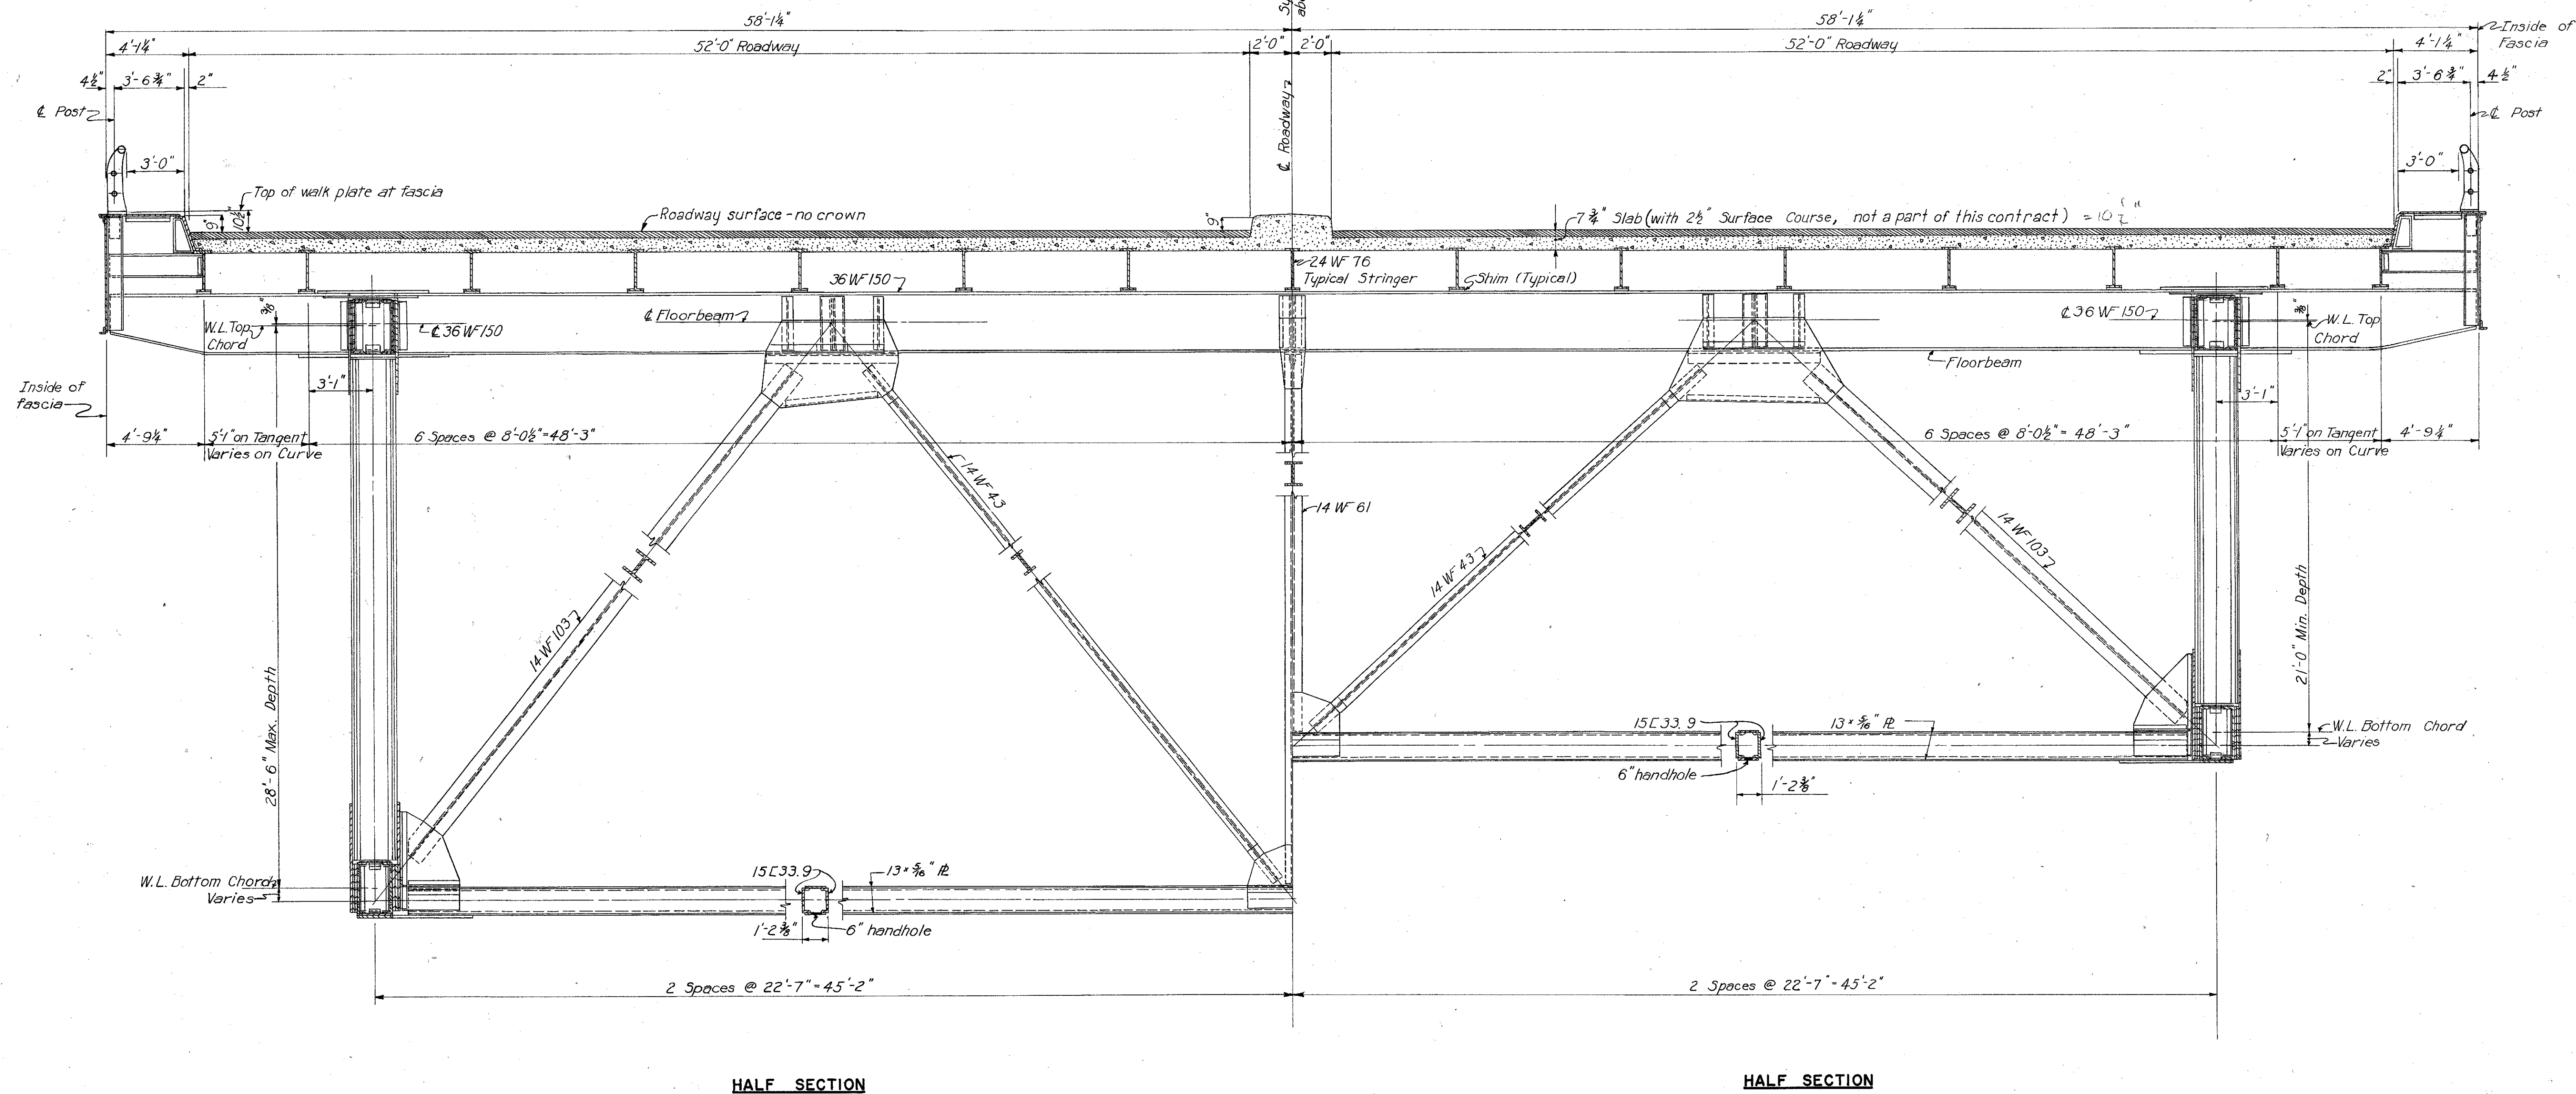

Note:
For details of Floorbeam Truss FI see Sheet 29
For location of Floorbeam Trusses see Framing Plans.

PART 3


U. S. ROUTE 42 RELOCATION		
INNER BELT FREEWAY - CENTRAL VIADUCT		
BR. NO. CU - 42 R-17 5		
GENERAL CROSS SECTION		
FLOOR BEAM TRUSSES FI		
CLEVELAND	CUYAHOGA COUNTY	OHIO
SCALE 1/4" = 1'-0"		
MADE WEG	DATE 1-27-54	HOWARD, NEEDLES, TAMMEN & BERGENDOFF
TRCD GJK	DATE 11-8-54	CONSULTING ENGINEERS
CKD DMD	DATE 11-11-54	KANSAS CITY CLEVELAND NEW YORK
914-1A SHEET 2.13		

MICROFILMED
FEB 15 1983

FED. ROAD DIV. NO.	STATE	FEDERAL AID PROJECT NO.	TYPE FUNDS
2	OHIO		

12
122

CUYAHOGA COUNTY
CITY OF CLEVELAND
INNER BELT FREEWAY
CENTRAL VIADUCT

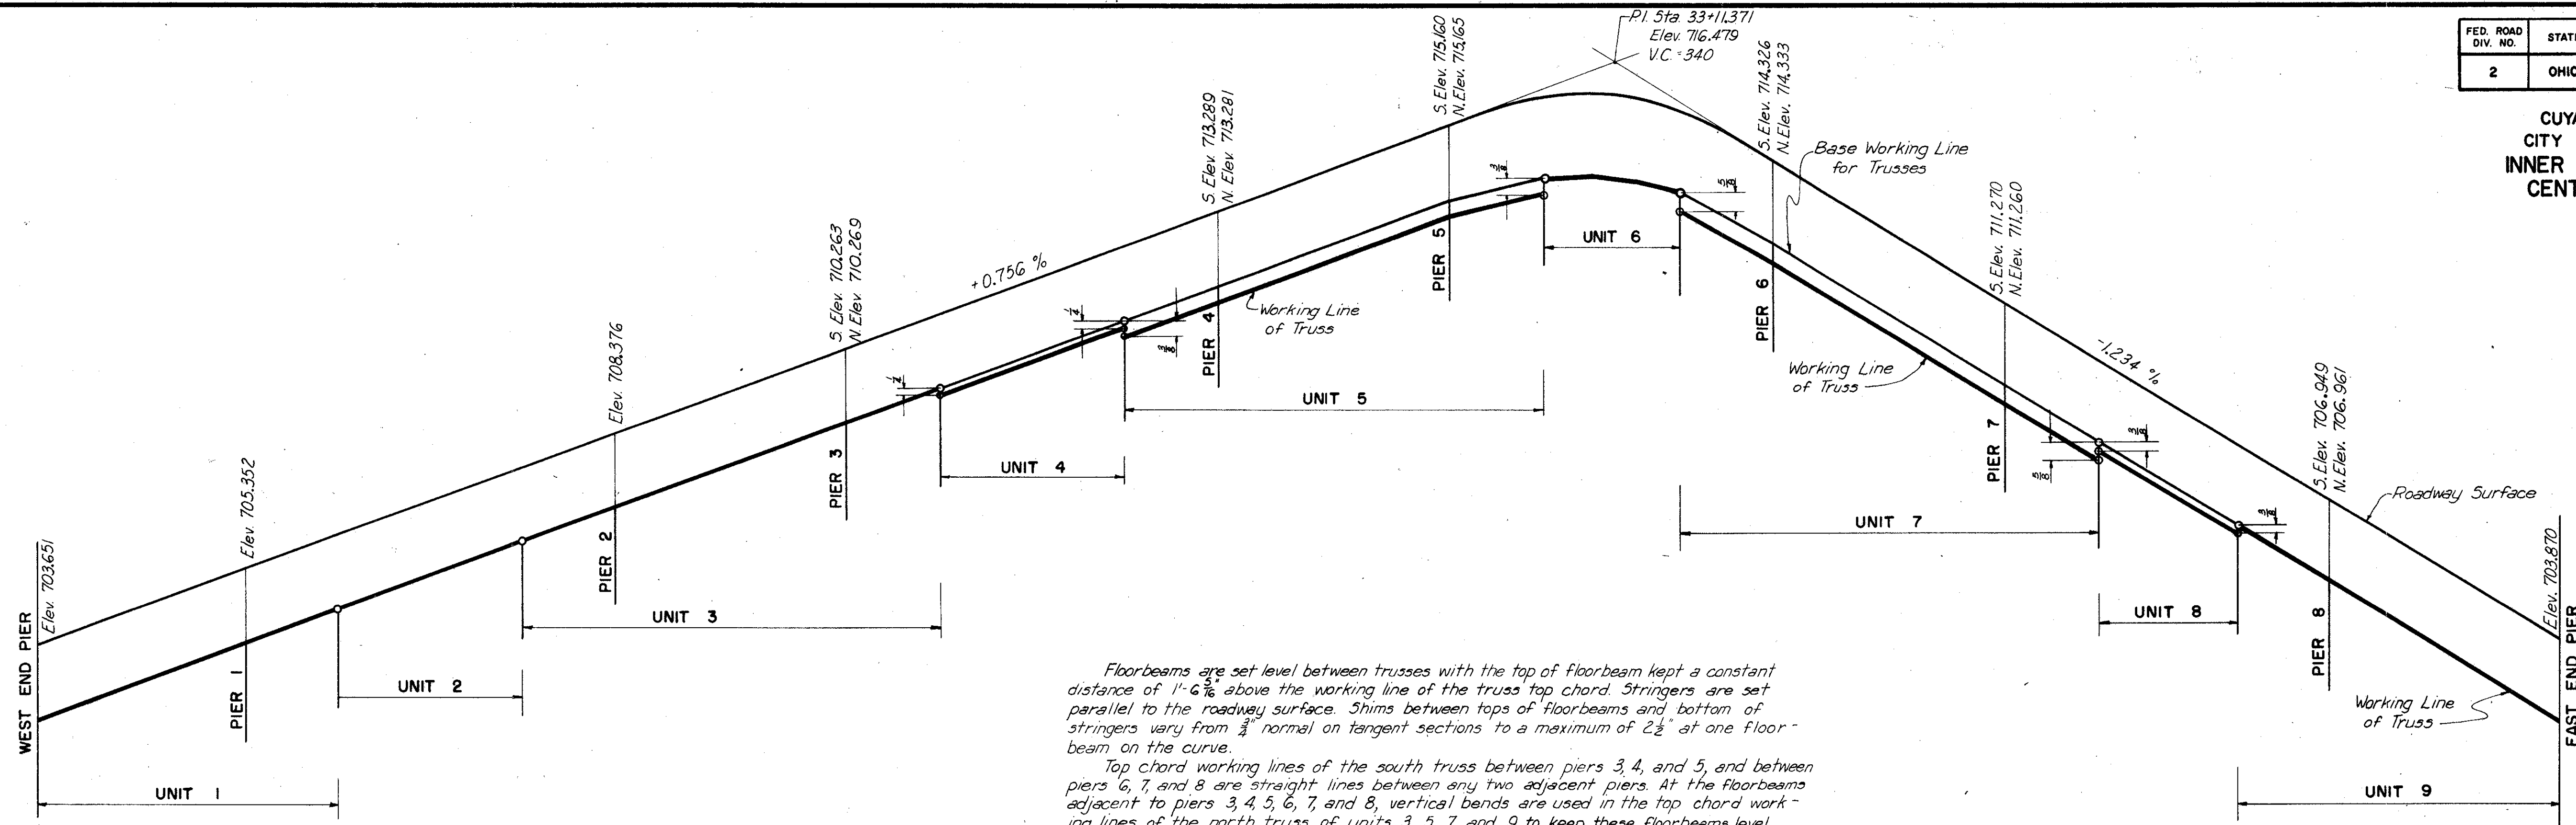

Floorbeams are set level between trusses with the top of floorbeam kept a constant distance of 1'-6" above the working line of the truss top chord. Stringers are set parallel to the roadway surface. Shims between tops of floorbeams and bottom of stringers vary from $\frac{3}{4}$ " normal on tangent sections to a maximum of 2" at one floorbeam on the curve.

Top chord working lines of the south truss between piers 3, 4, and 5, and between piers 6, 7, and 8 are straight lines between any two adjacent piers. At the floorbeams adjacent to piers 3, 4, 5, 6, 7, and 8, vertical bends are used in the top chord working lines of the north truss of units 3, 5, 7, and 9 to keep these floorbeams level.

Additional vertical bend points are provided in the top chord working line of both trusses between piers 5 and 6 to allow for the vertical curve. See framing plans, units 5, 6, and 7.

In general, end posts and posts over piers are vertical; other posts are normal to truss top chords.

PIER	PANEL POINT	ELEVATION W.L. OF TRUSS	ELEVATION ROADWAY SURFACE NORTH TRUSS	DISTANCE R.S. TO W.L. OF NORTH TRUSS	ELEVATION ROADWAY SURFACE SOUTH TRUSS	DISTANCE R.S. TO W.L. OF SOUTH TRUSS
W. End Pier	100	699.274	703.651	4.377	703.651	4.377
	101	699.463	703.840	4.377	703.840	4.377
	102	699.652	704.029	4.377	704.029	4.377
	103	699.841	704.218	4.377	704.218	4.377
	104	700.030	704.407	4.377	704.407	4.377
	105	700.219	704.596	4.377	704.596	4.377
	106	700.408	704.785	4.377	704.785	4.377
	107	700.597	704.974	4.377	704.974	4.377
	108	700.786	705.163	4.377	705.163	4.377
	109	700.975	705.352	4.377	705.352	4.377
	110	701.164	705.541	4.377	705.541	4.377
	111	701.353	705.730	4.377	705.730	4.377
Pier 1	112	701.542	705.919	4.377	705.919	4.377
	20	701.731	706.108	4.377	706.108	4.377
	21	701.920	706.297	4.377	706.297	4.377
	22	702.109	706.486	4.377	706.486	4.377
	23	702.298	706.675	4.377	706.675	4.377
	24	702.487	706.864	4.377	706.864	4.377
	25	702.676	707.053	4.377	707.053	4.377
	26	702.865	707.242	4.377	707.242	4.377
	27	703.054	707.431	4.377	707.431	4.377
	28	703.243	707.620	4.377	707.620	4.377
	300	703.266	707.643	4.377	707.643	4.377
	301	703.432	707.809	4.377	707.809	4.377
Pier 2	302	703.621	707.998	4.377	707.998	4.377
	303	703.810	708.187	4.377	708.187	4.377
	304	703.999	708.376	4.377	708.376	4.377
	305	704.188	708.565	4.377	708.565	4.377
	306	704.377	708.754	4.377	708.754	4.377
	307	704.566	708.943	4.377	708.943	4.377
	308	704.755	709.132	4.377	709.132	4.377
	309	704.944	709.321	4.377	709.321	4.377
	310	705.133	709.510	4.377	709.510	4.377

PIER	PANEL POINT	ELEVATION W.L. OF TRUSS	ELEVATION ROADWAY SURFACE NORTH TRUSS	DISTANCE R.S. TO W.L. OF NORTH TRUSS	ELEVATION ROADWAY SURFACE SOUTH TRUSS	DISTANCE R.S. TO W.L. OF SOUTH TRUSS
Pier 3	311	705.322	709.699	4.377	709.699	4.377
	312	705.511	709.888	4.377	709.888	4.377
	313	705.700	710.077	4.377	710.077	4.377
	314	705.886	710.269	4.383	710.269	4.377
	315	706.073	710.462	4.389	710.449	4.376
	316	706.264	710.650	4.386	710.638	4.374
	317	706.454	710.839	4.385	710.827	4.373
	40	706.624	711.028	4.404	711.016	4.392
	41	706.815	711.217	4.402	711.205	4.390
	42	707.005	711.404	4.399	711.396	4.391
	43	707.196	711.591	4.395	711.588	4.392
	44	707.386	711.778	4.392	711.779	4.393
Pier 4	45	707.577	711.965	4.388	711.971	4.394
	46	707.767	712.152	4.385	712.162	4.395
	47	707.958	712.338	4.380	712.353	4.395
	48	708.148	712.525	4.377	712.545	4.397
	500	708.161	712.547	4.386	712.568	4.407
	501	708.329	712.712	4.383	712.736	4.407
	502	708.519	712.899	4.380	712.927	4.408
	503	708.710	713.085	4.375	713.118	4.408
	504	708.881	713.281	4.400	713.289	4.408
	505	709.051	713.477	4.426	713.459	4.408
	506	709.242	713.664	4.422	713.650	4.408
	507	709.433	713.850	4.417	713.841	4.408
Pier 5	508	709.624	714.037	4.413	714.032	4.408
	509	709.815	714.224	4.409	714.224	4.409
	510	710.006	714.410	4.404	714.415	4.409
	511	710.198	714.597	4.399	714.606	4.408
	512	710.389	714.784	4.395	714.797	4.408
	513	710.580	714.971	4.391	714.988	4.408
	514	710.752	715.165	4.413	715.160	4.408
	515	710.865	715.345	4.480	715.322	4.457
	516	710.990	715.482	4.492	715.467	4.477

PIER	PANEL POINT	ELEVATION W.L. OF TRUSS	ELEVATION ROADWAY SURFACE NORTH TRUSS	DISTANCE R.S. TO W.L. OF NORTH TRUSS	ELEVATION ROADWAY SURFACE SOUTH TRUSS	DISTANCE R.S. TO W.L. OF SOUTH TRUSS
Pier 6	517	711.115	715.584	4.469	715.575	4.460
	518	711.225	715.642	4.417	715.636	4.411
	60	711.271	715.650	4.379	715.646	4.375
	61	711.284	715.680	4.396	715.679	4.395
	62	711.298	715.674	4.376	715.675	4.377
	63	711.239	715.633	4.394	715.633	4.394
	64	711.179	715.556	4.377	715.554	4.375
	65	711.046	715.444	4.398	715.437	4.391
	66	710.913	715.295	4.382	715.283	4.370
	701	710.614	715.111	4.497	715.092	4.478
	702	710.367	714.891	4.524	714.863	4.496
	703	710.119	714.636	4.517	714.597	4.478
	704	709.897	714.333	4.436	714.326	4.429
Pier 7	705	709.616	714.017	4.401	714.046	4.430
	706	709.304	713.712	4.408	713.734	4.430
	707	708.992	713.407	4.415	713.422	4.430
	708	708.680	713.102	4.422	713.110	4.430
	709	708.368	712.798	4.430	712.798	4.430
	710	708.056	712.493	4.437	712.485	4.429
	711	707.744	712.188	4.444	712.173	4.429
	712	707.432	711.883	4.451	711.861	4.429
	713	707.120	711.578	4.458	711.549	4.429
	714	706.841	711.260	4.419	711.270	4.429
	715	706.562	710.940	4.378	710.991	4.429
	716	706.250	710.636	4.386	710.679	4.429
Pier 8	717	705.939	710.331	4.392	710.367	4.428
	718	705.665	710.063	4.398	710.092	4.427
	80	705.649	710.026	4.377	710.055	4.406
	81	705.337	709.721	4.384	709.743	4.406
	82	705.026	709.416	4.390	709.430	4.404
	83	704.714	709.111	4.397	709.118	4.404
	84	704.403	708.806	4.403	708.806	4.403

PIER	PANEL POINT	ELEVATION W.L. OF TRUSS	ELEVATION ROADWAY SURFACE NORTH TRUSS	DISTANCE R.S. TO W.L. OF NORTH TRUSS	ELEVATION ROADWAY SURFACE SOUTH TRUSS	DISTANCE R.S. TO W.L. OF SOUTH TRUSS
Pier 8	85	704.092	708.501	4.409	708.493	4.401
	86	703.780	708.196	4.416	708.181	4.401
	901	703.500	707.891	4.391	707.869	4.369
	902	703.188	707.584	4.396	707.560	4.372
	903	702.877	707.275	4.398	707.251	4.374
	904	702.572	706.961	4.389	706.949	4.377
	905	702.269	706.646	4.377	706.646	4.377
	906	701.961	706.338	4.377	706.338	4.377
	907	701.652	706.029	4.377	706.029	4.377
	908	701.344	705.721	4.377	705.721	4.377
	909	701.035	705.412	4.377	705.412	4.377
	910	700.727	705.104	4.377	705.104	4.377
E. End Pier	911	700.418	704.795	4.377	704.795	4.377
	912	700.110	704.487	4.377	704.487	4.377
	913	699.801	704.178	4.377	704.178	4.377
	914	699.493	703.870	4.377	703.870	4.377

PART 3

U. S. ROUTE 42 RELOCATION
INNER BELT FREEWAY - CENTRAL VIADUCT
BR. NO. CU - 42R-175

GRADES AND ELEVATIONS

CLEVELAND CUYAHOGA COUNTY OHIO

SCALE: None
MADE: 1/16/54 DATE: 1-15-54
TRCD: DATE: 1-15-54
CKD: C.W.C. DATE: 2-2-54

HOWARD, NEEDLES, TAMMEN & BERGENDOFF
CONSULTING ENGINEERS
KANSAS CITY CLEVELAND NEW YORK




914-1A SHEET 2.12

MICROFILMED
FEB 15 1983

FED. ROAD DIV. NO.	STATE	FEDERAL AID PROJECT NO.	TYPE FUNDS
2	OHIO		

11
122

CUYAHOGA COUNTY
CITY OF CLEVELAND
INNER BELT FREEWAY
CENTRAL VIADUCT
CUY - 42 R - 17.50

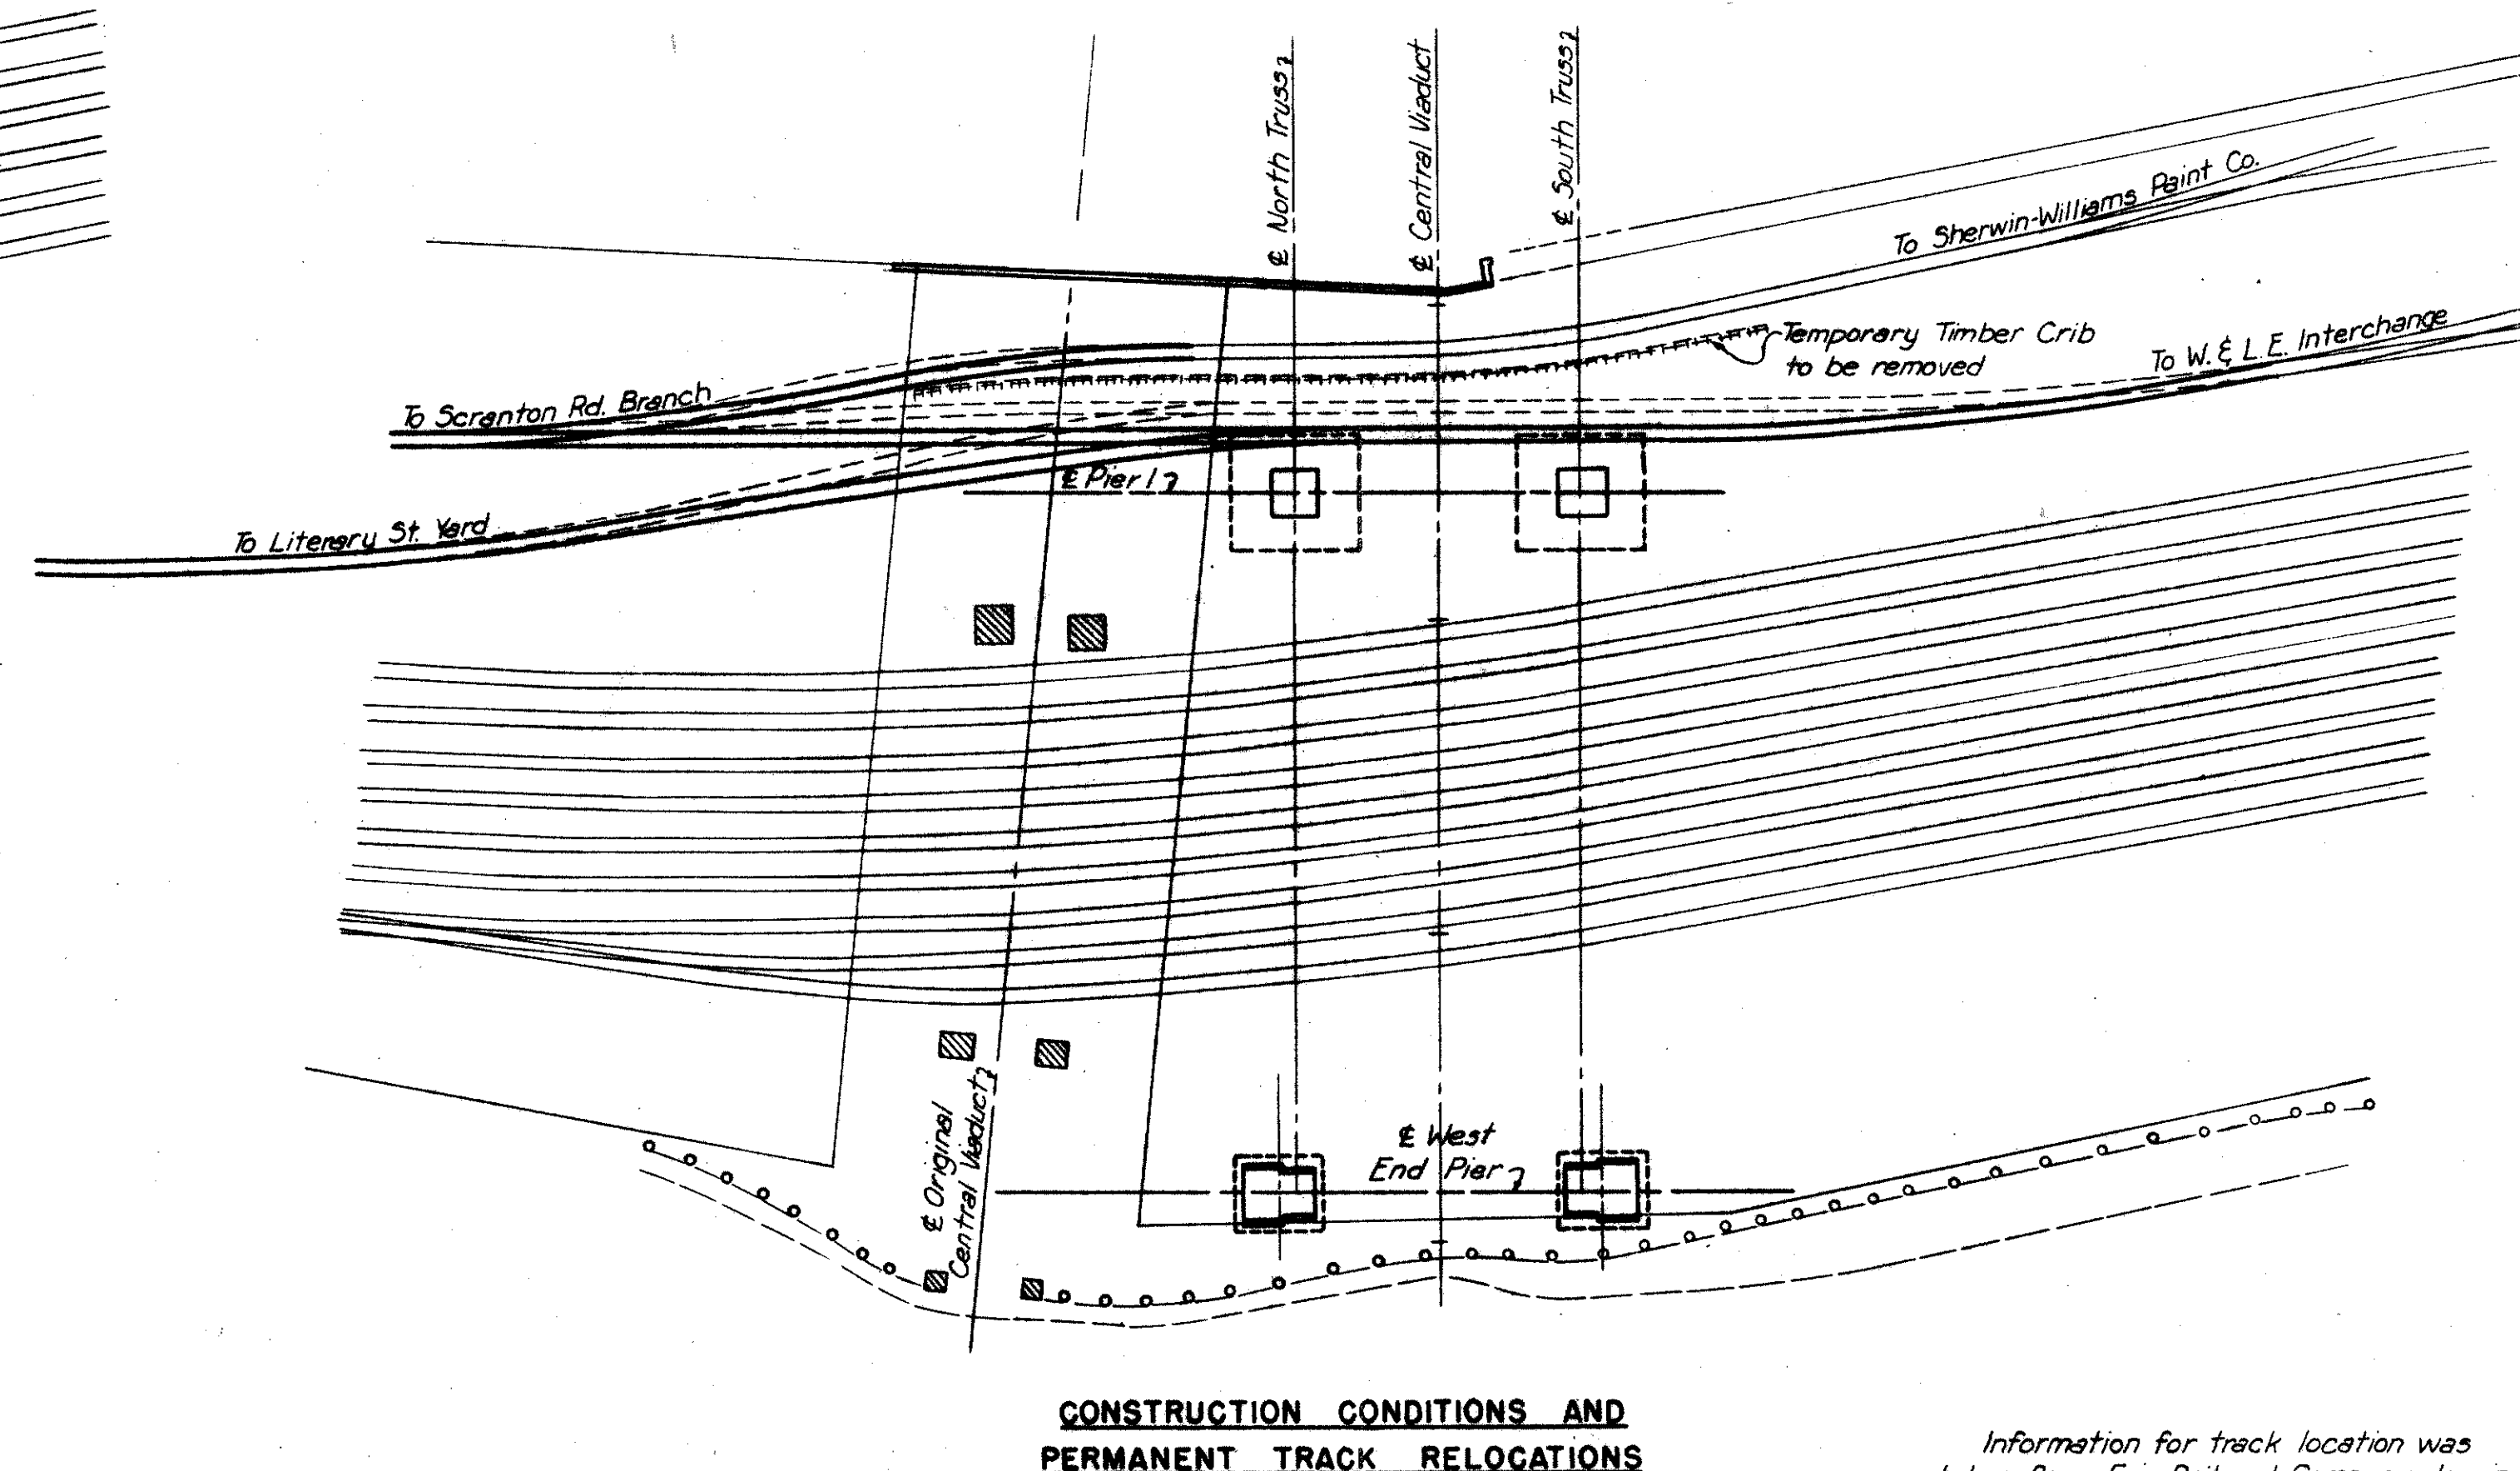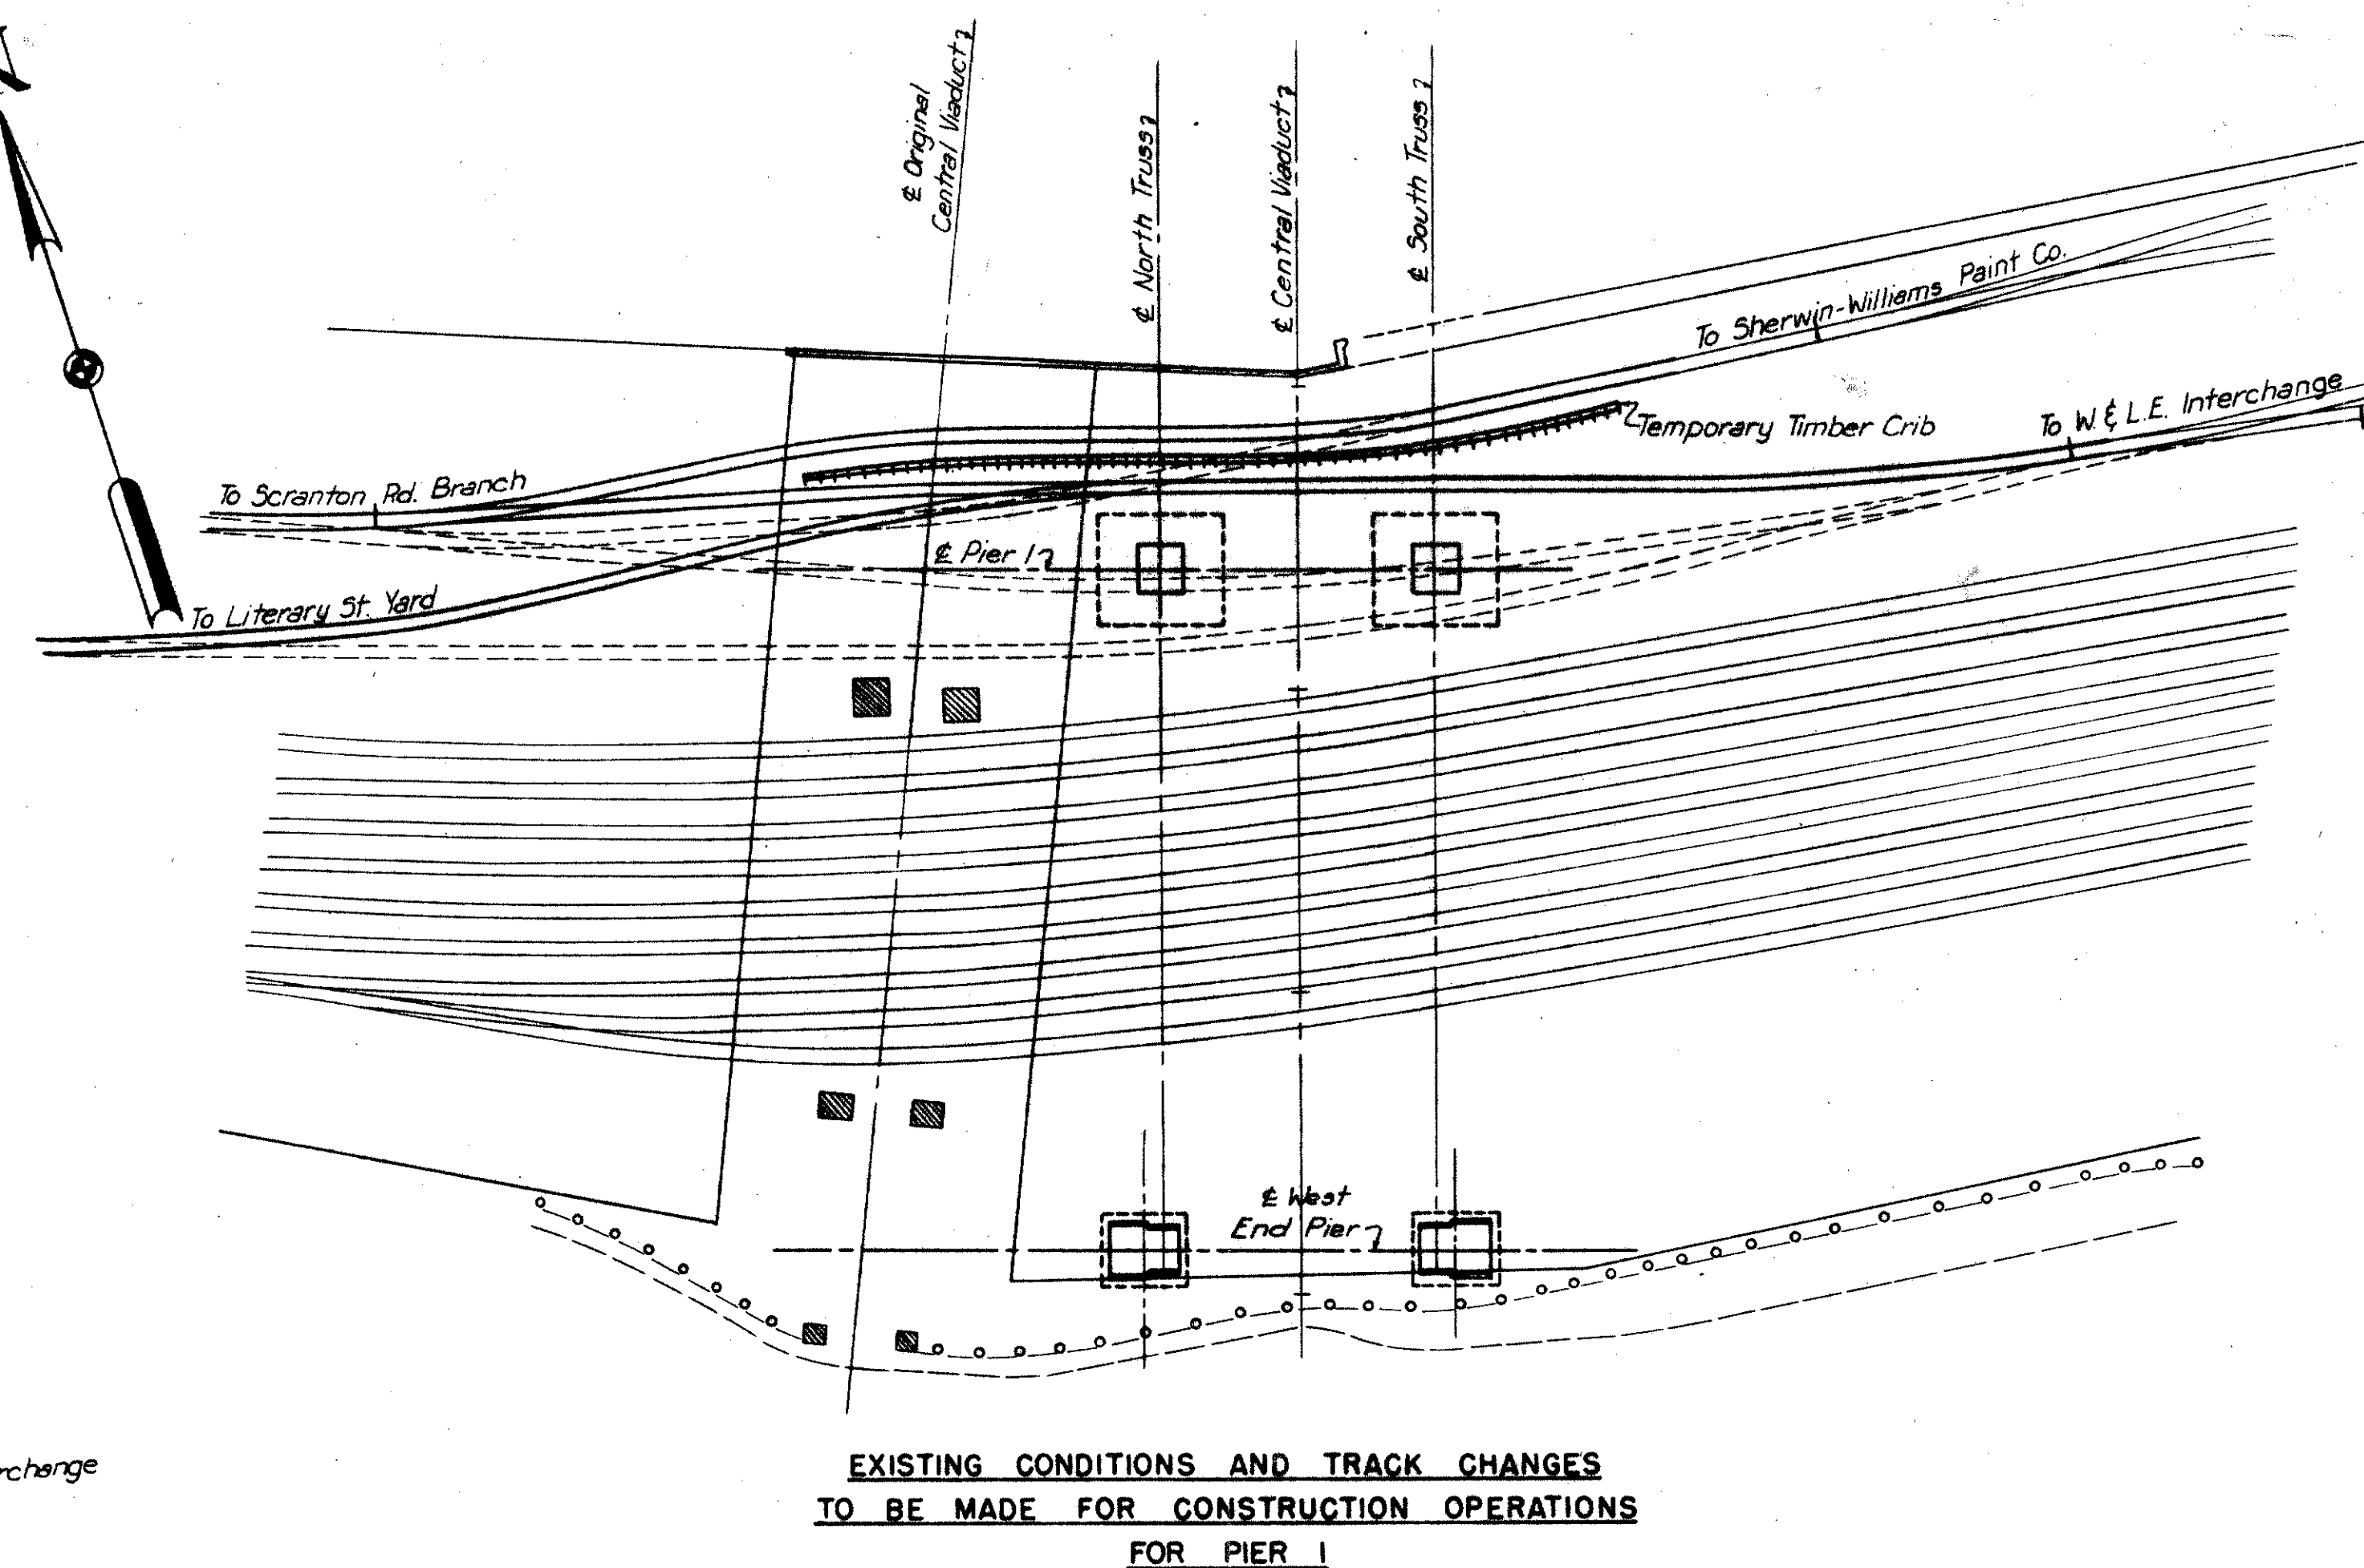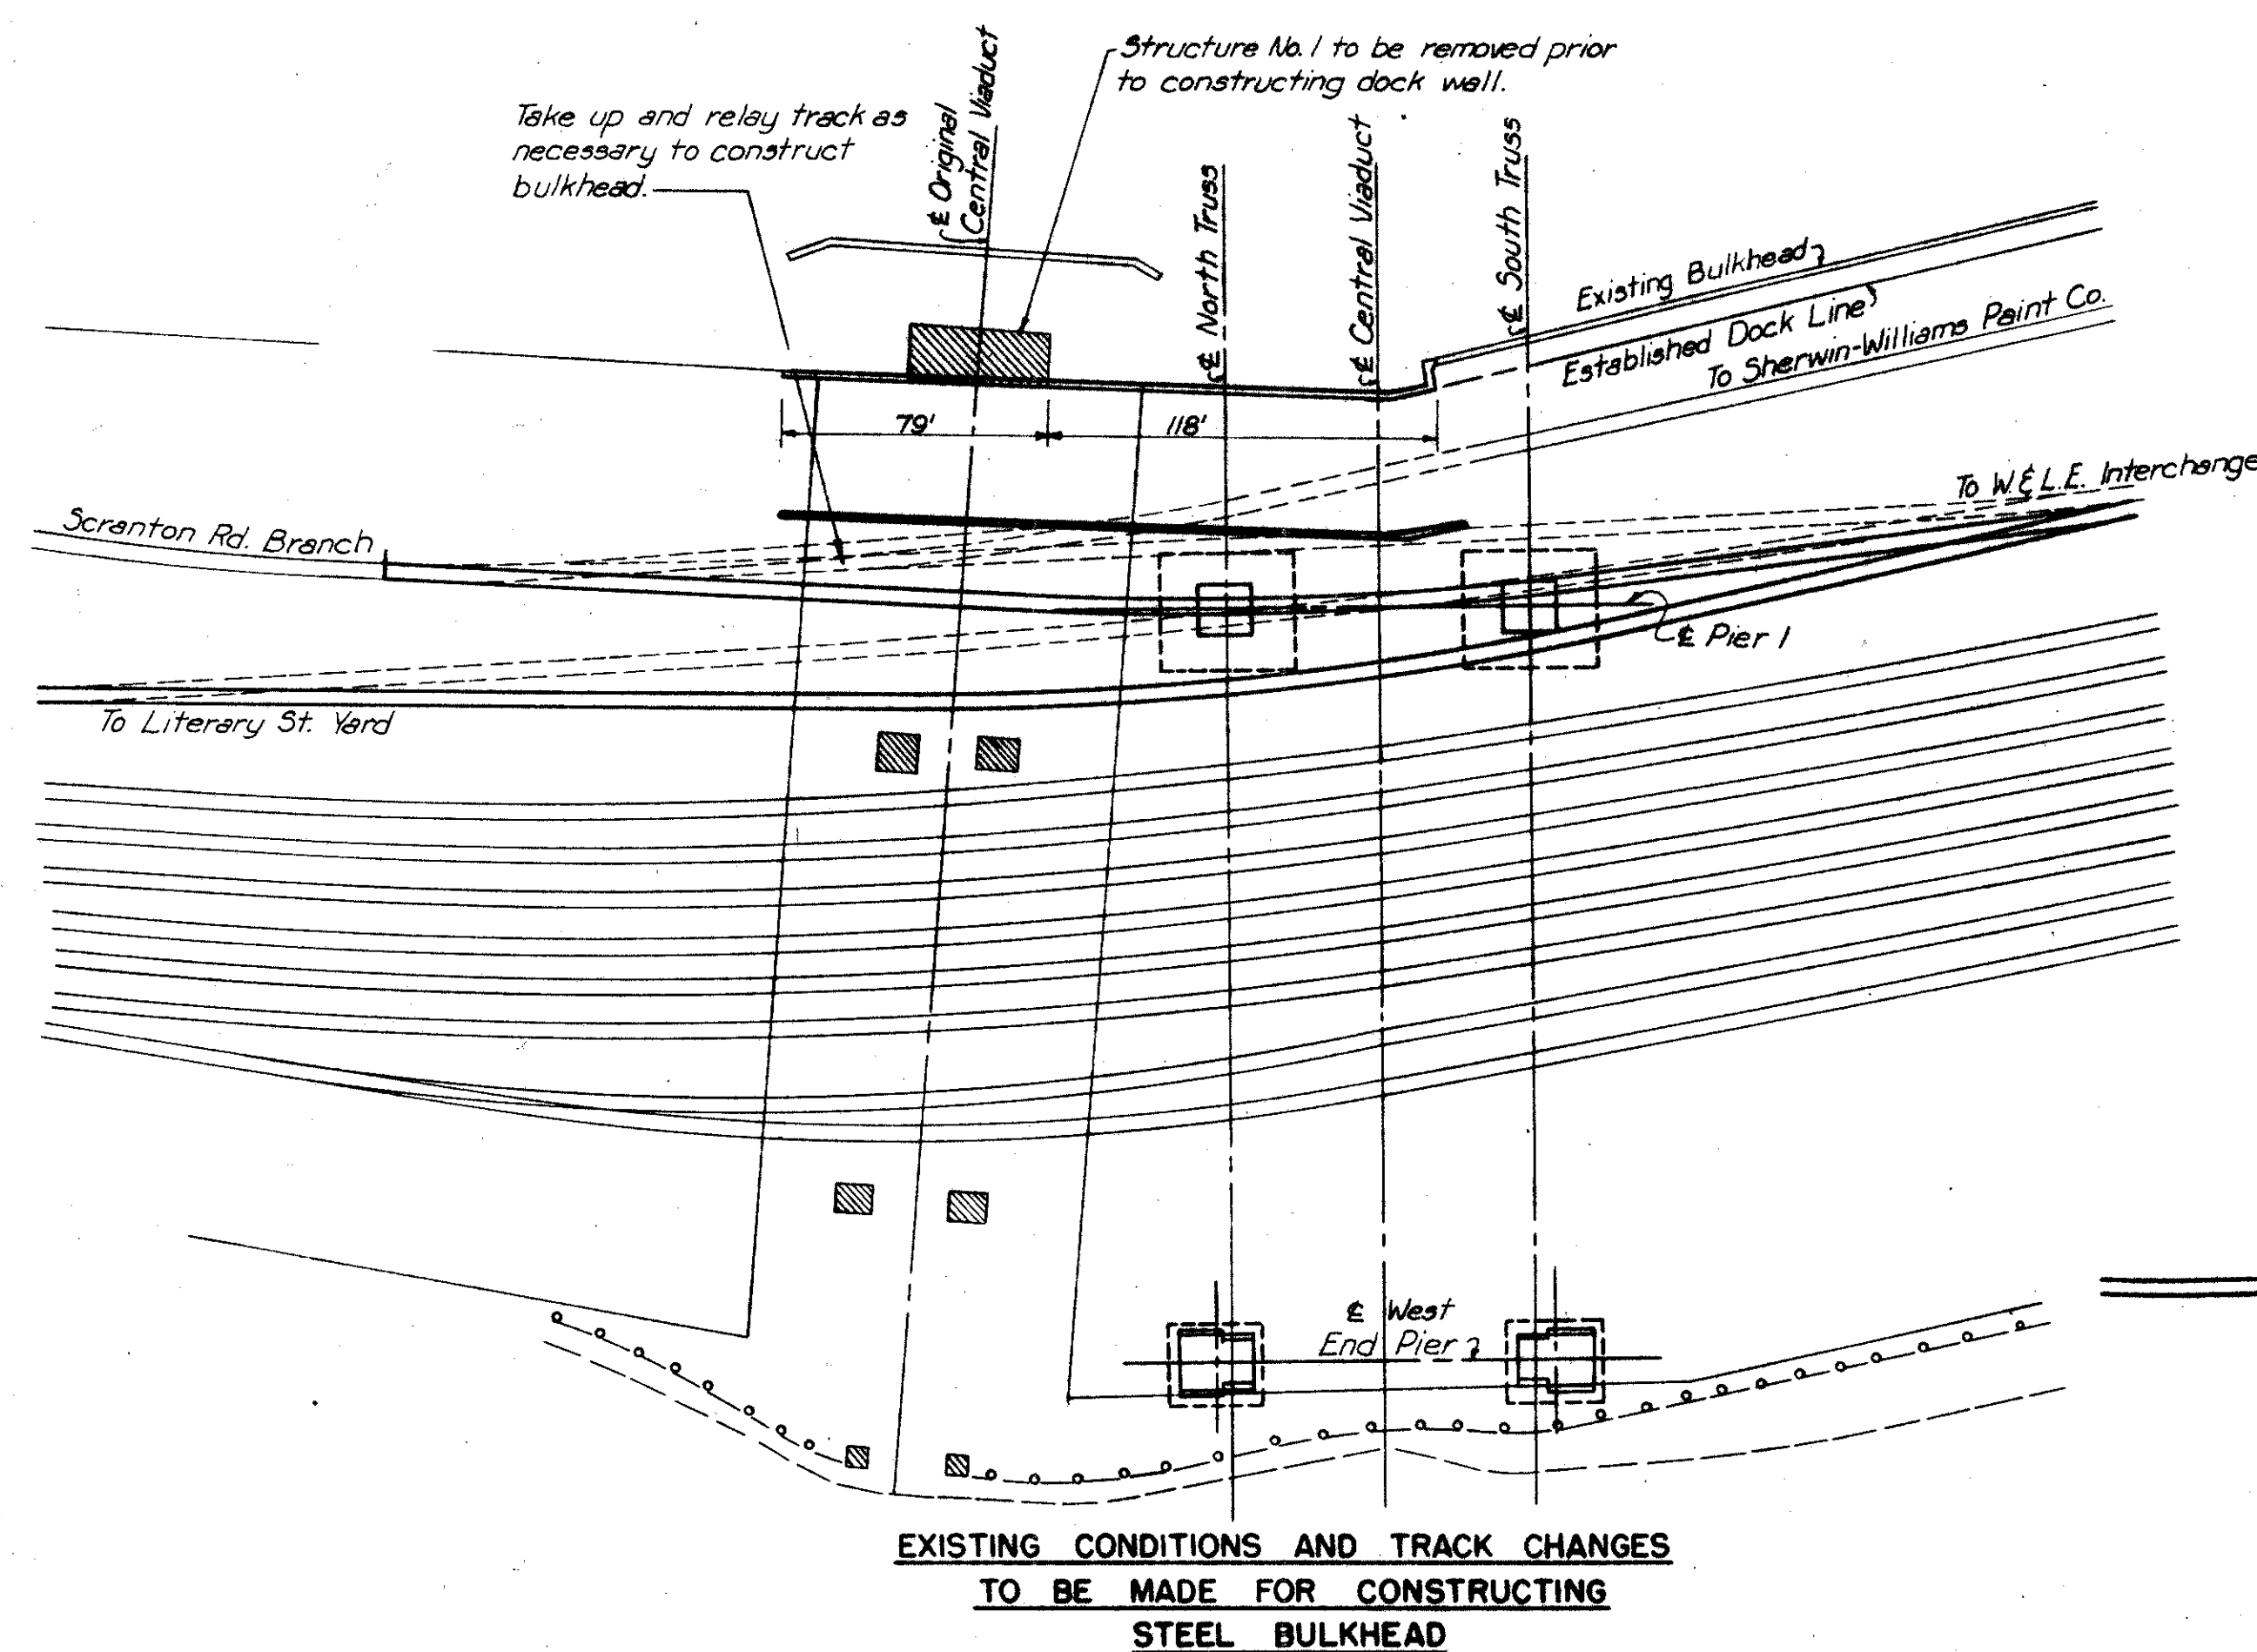

- LEGEND
- Present tracks to be undisturbed.
 - Present tracks to be removed.
 - Track relocations.

Information for track location was
taken from Erie Railroad Company drawings
D-194, D-195, and D-196. Revised Aug. 13, 1954

PART 3

U. S. ROUTE 42 RELOCATION
INNER BELT FREEWAY - CENTRAL VIADUCT
BR. NO. CU - 42 R - 17.5

ERIE RAILROAD TRACK MODIFICATIONS

CLEVELAND CUYAHOGA COUNTY OHIO

SCALE 1" = 50.0'
MADE N.A.M. DATE 4-16-54
TRCD N.A.M. DATE 4-30-54
CKD G.A. DATE 8-30-54

HOWARD, NEEDLES, TAMMEN & BERGENOFF
CONSULTING ENGINEERS
KANSAS CITY CLEVELAND NEW YORK


914-1A SHEET 2.11

RECORDED
FEB 15 1953


FED. ROAD DIV. NO.	STATE	FEDERAL AID PROJECT NO.	TYPE FUNDS
2	OHIO		

10
122

CUYAHOGA COUNTY
CITY OF CLEVELAND
INNER BELT FREEWAY
CENTRAL VIADUCT
CUY-42R-17.50

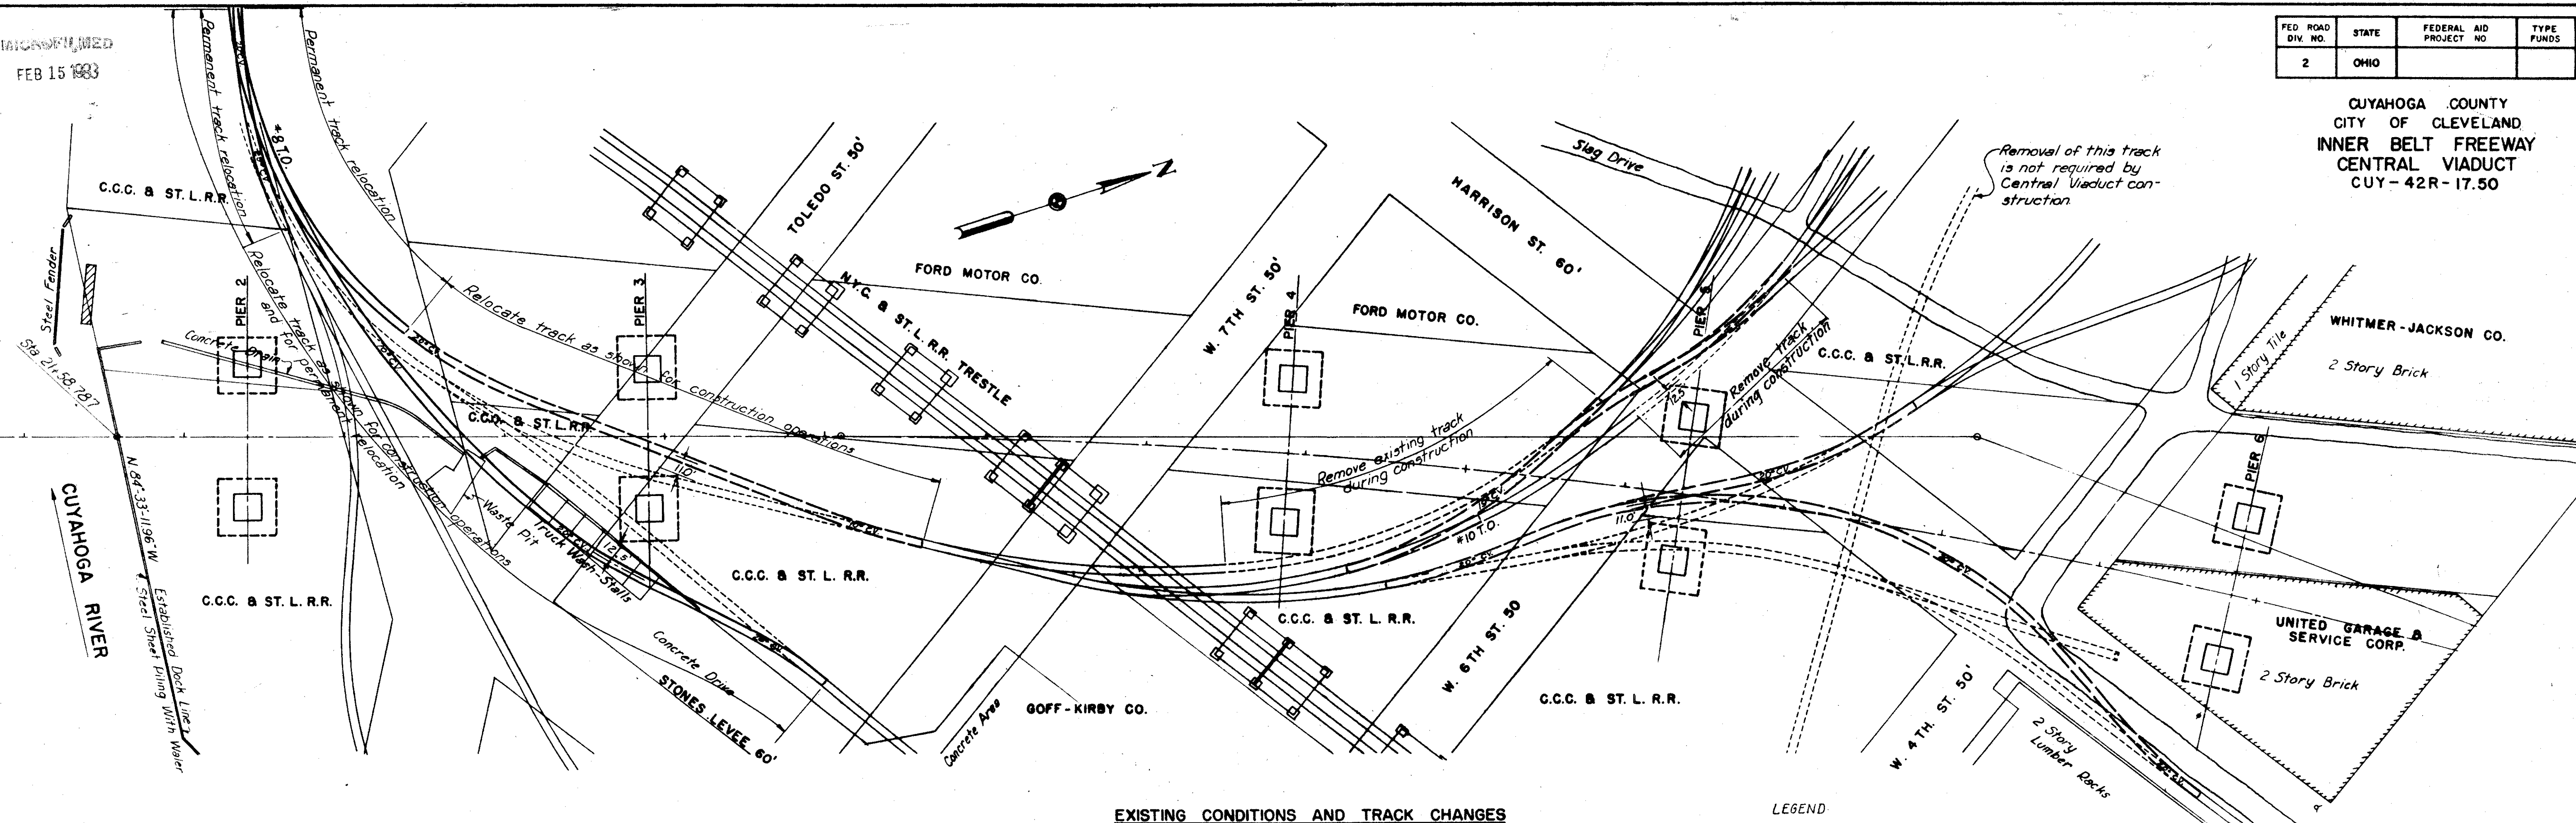

EXISTING CONDITIONS AND TRACK CHANGES
TO BE MADE FOR CONSTRUCTION OPERATIONS

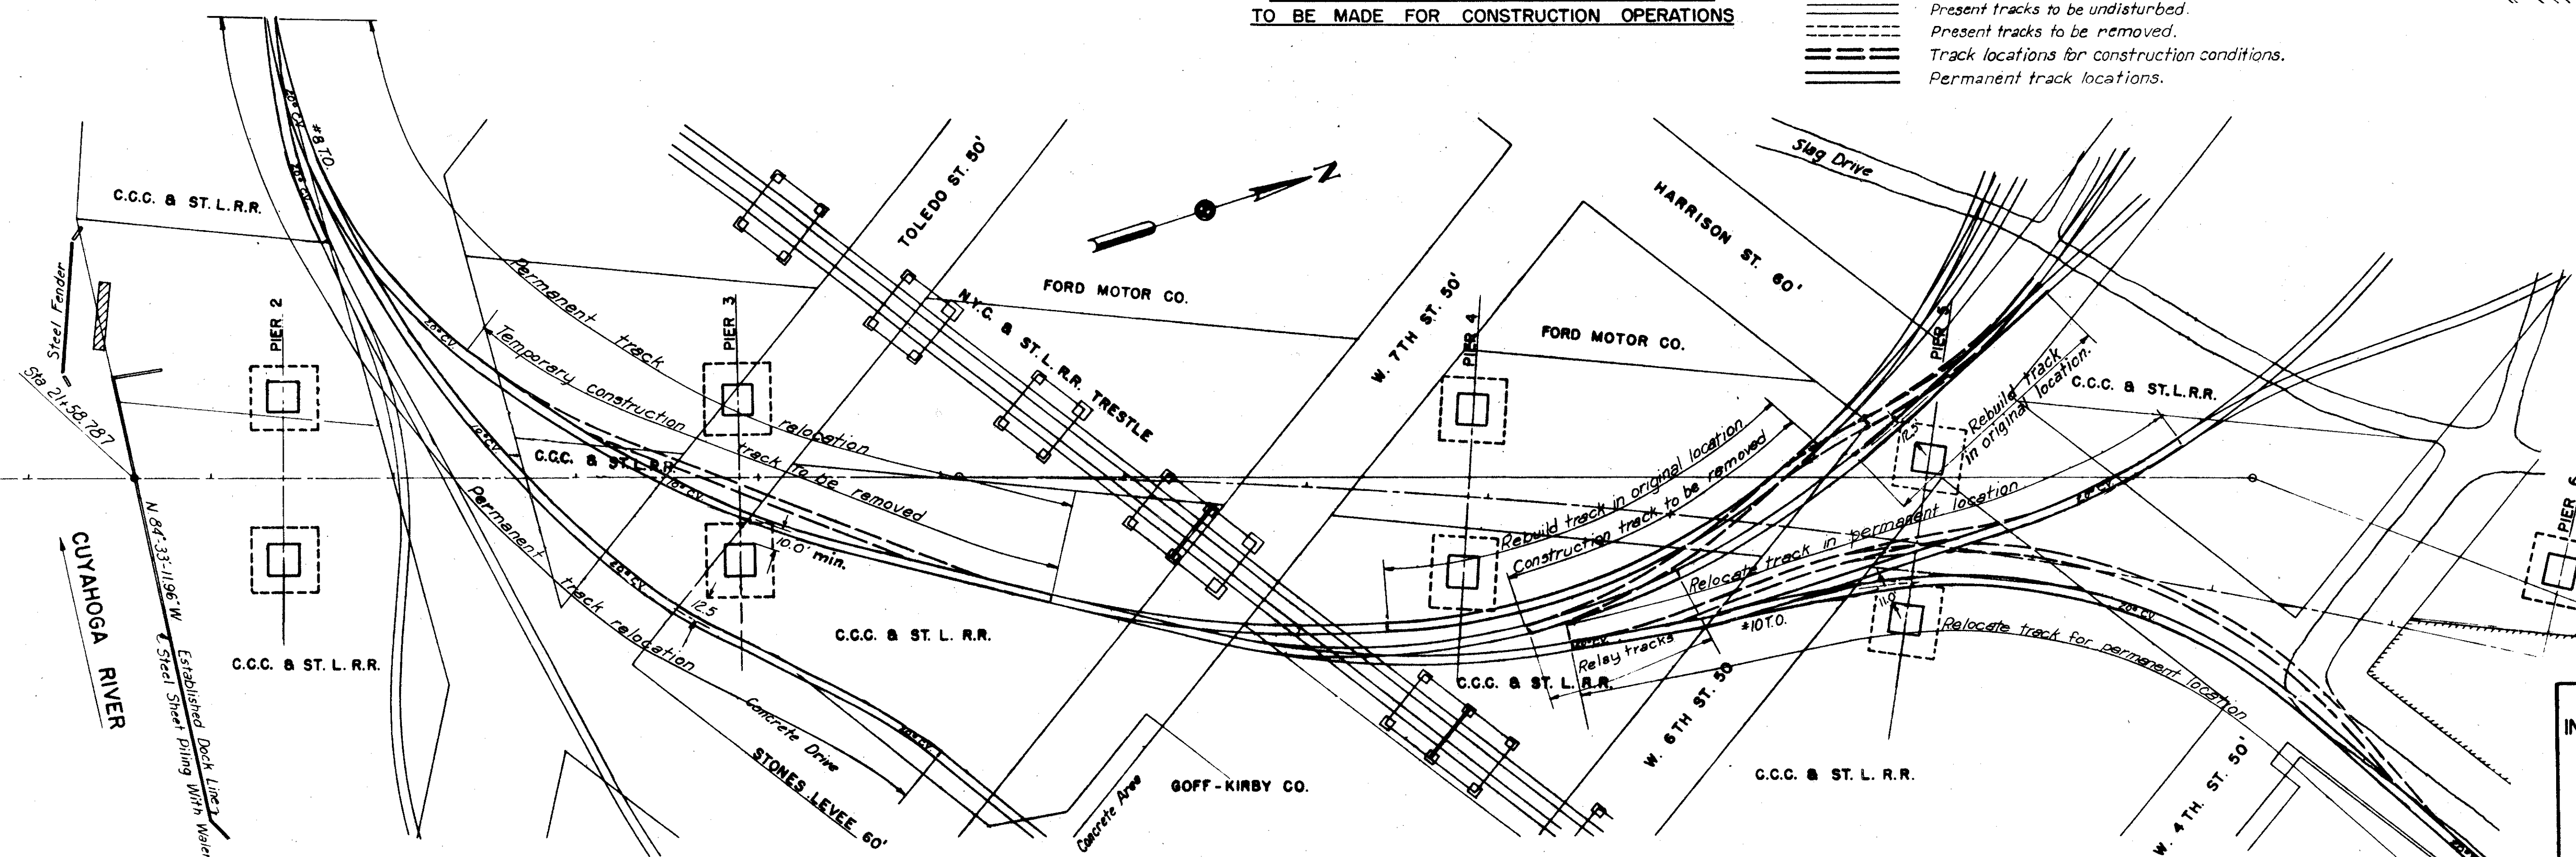

CONSTRUCTION CONDITIONS AND
PERMANENT TRACK RELOCATIONS

PART 3


U. S. ROUTE 42 RELOCATION
INNER BELT FREEWAY - CENTRAL VIADUCT
BR. NO. CU - 42R-17.5
NEW YORK CENTRAL RAILROAD COMPANY
(lessee of the railway and property of the C.C.C.
& ST. L. R.R.) TRACK MODIFICATIONS
CLEVELAND CUYAHOGA COUNTY OHIO

SCALE 1" = 50'
MADE N.A.M. DATE 4-12-54
TRCD N.A.M. DATE 4-13-54
CKD G.A. DATE 4-15-54











HOWARD, NEEDLES, TAMMEN & BERGENDOFF
CONSULTING ENGINEERS
KANSAS CITY CLEVELAND NEW YORK

914-1A SHEET 2.10

CUYAHOGA COUNTY
CITY OF CLEVELAND
INNER BELT FREEWAY
CENTRAL VIADUCT
CUY - 42R - 17.50

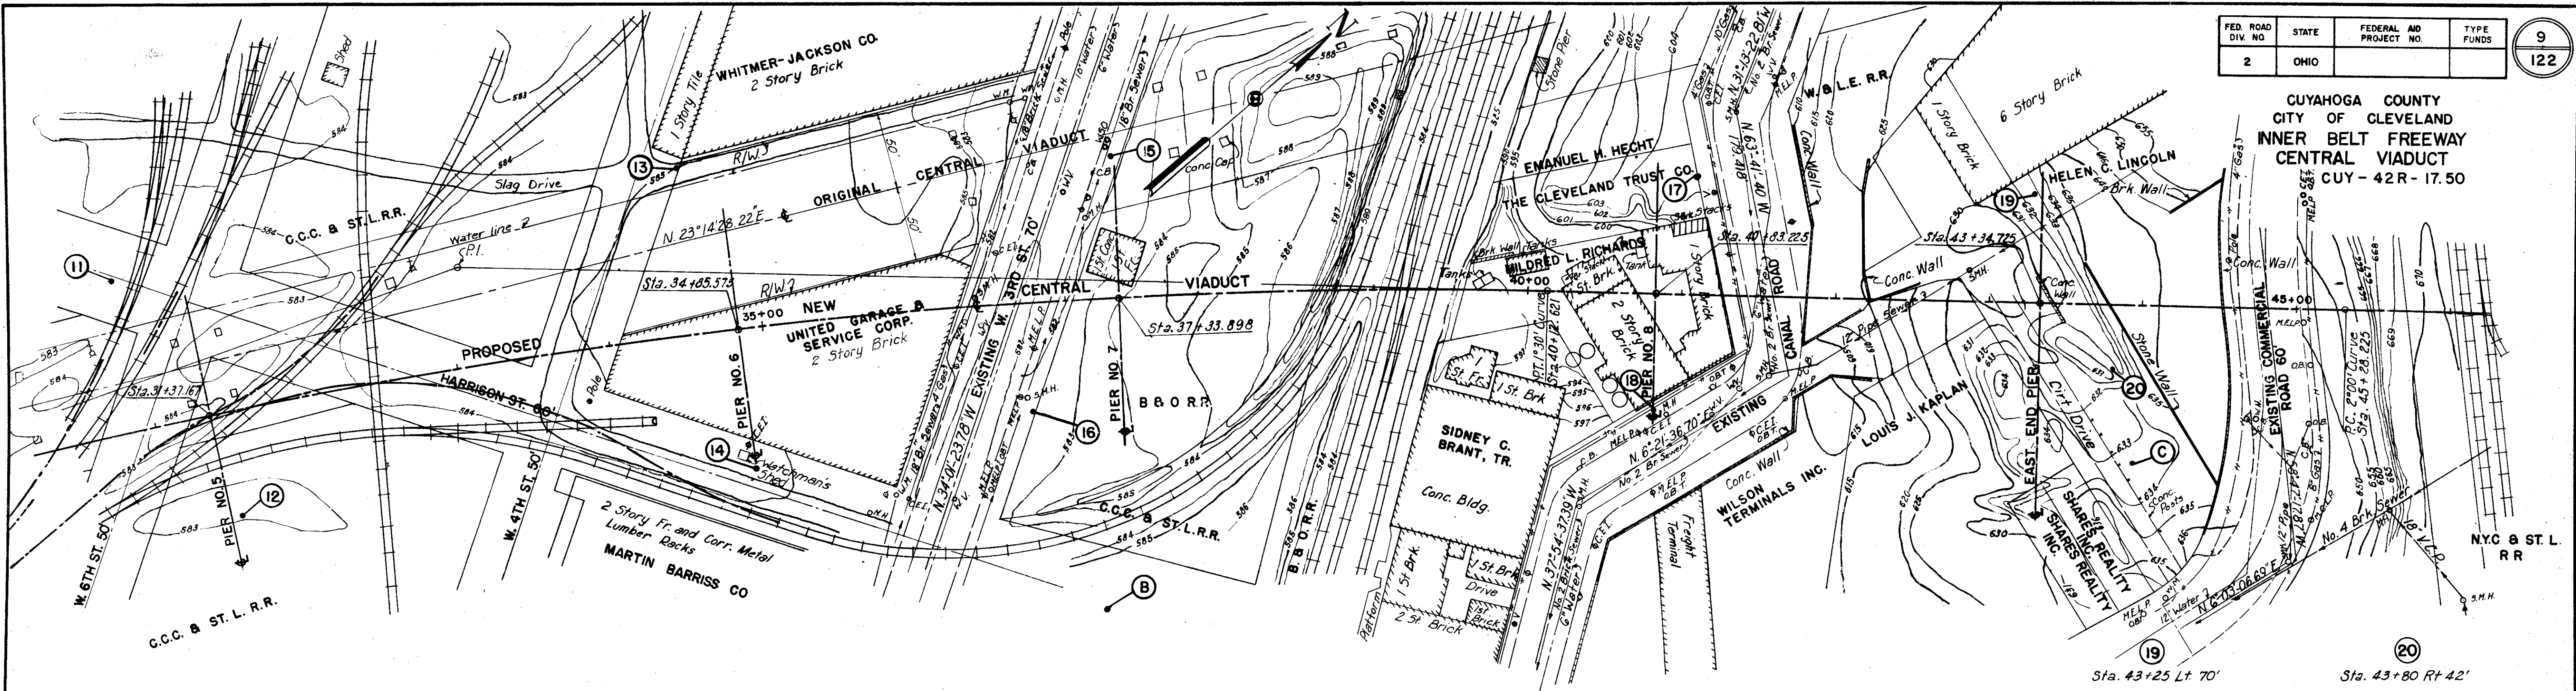

REPRODUCED
FEB 15 1963

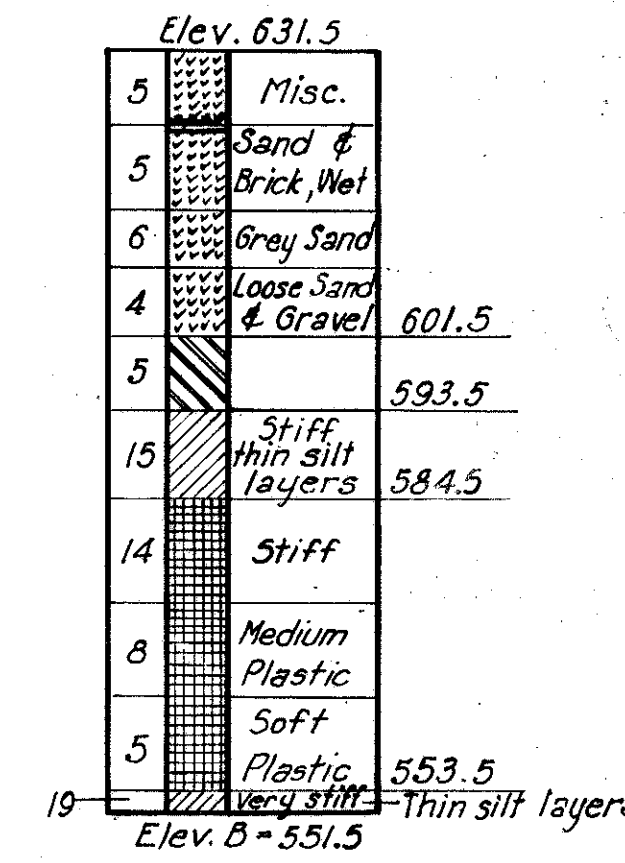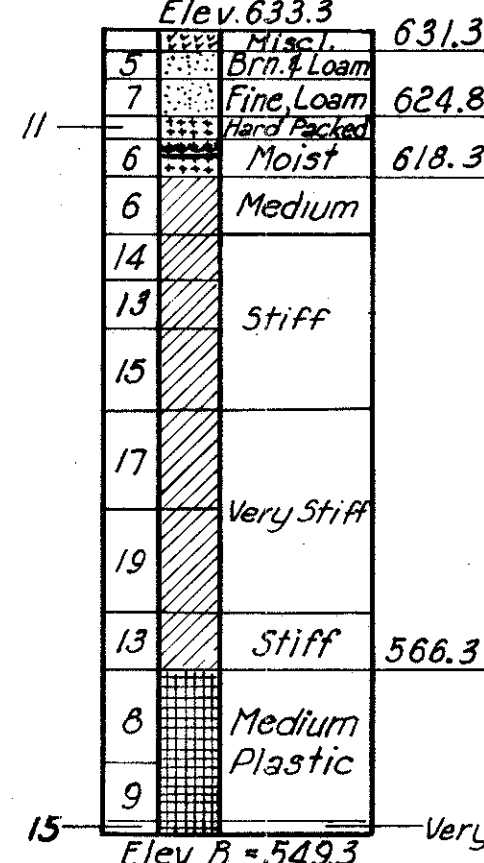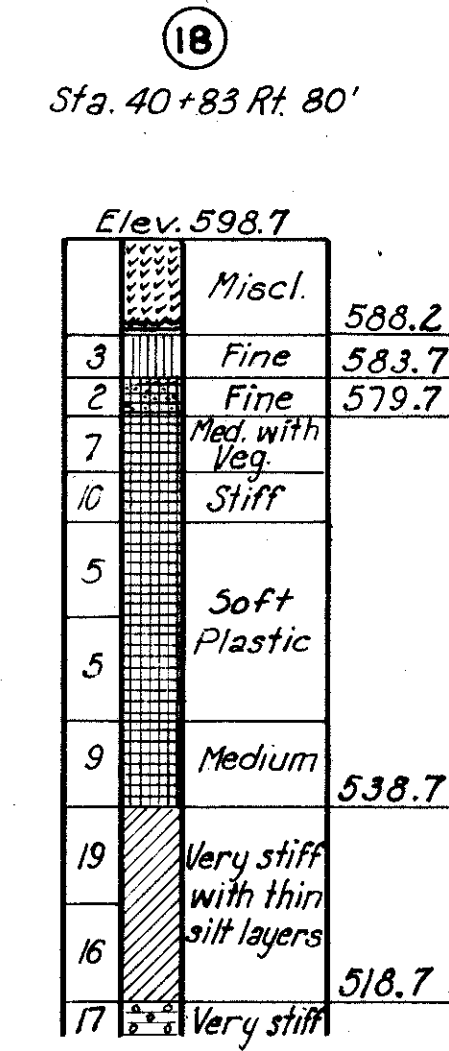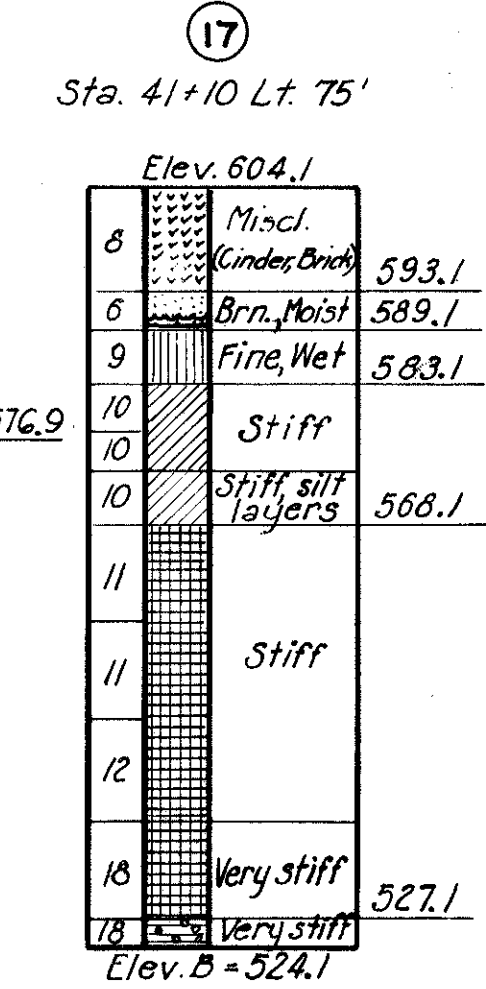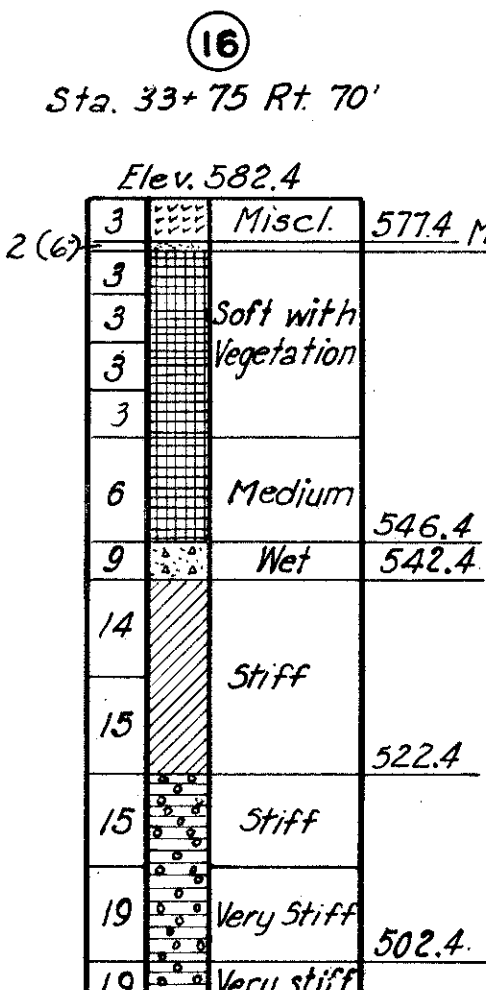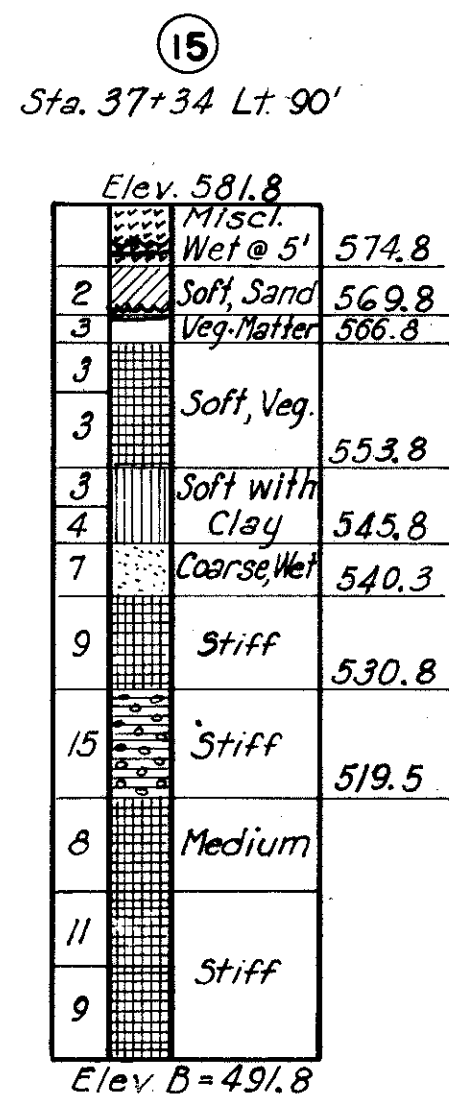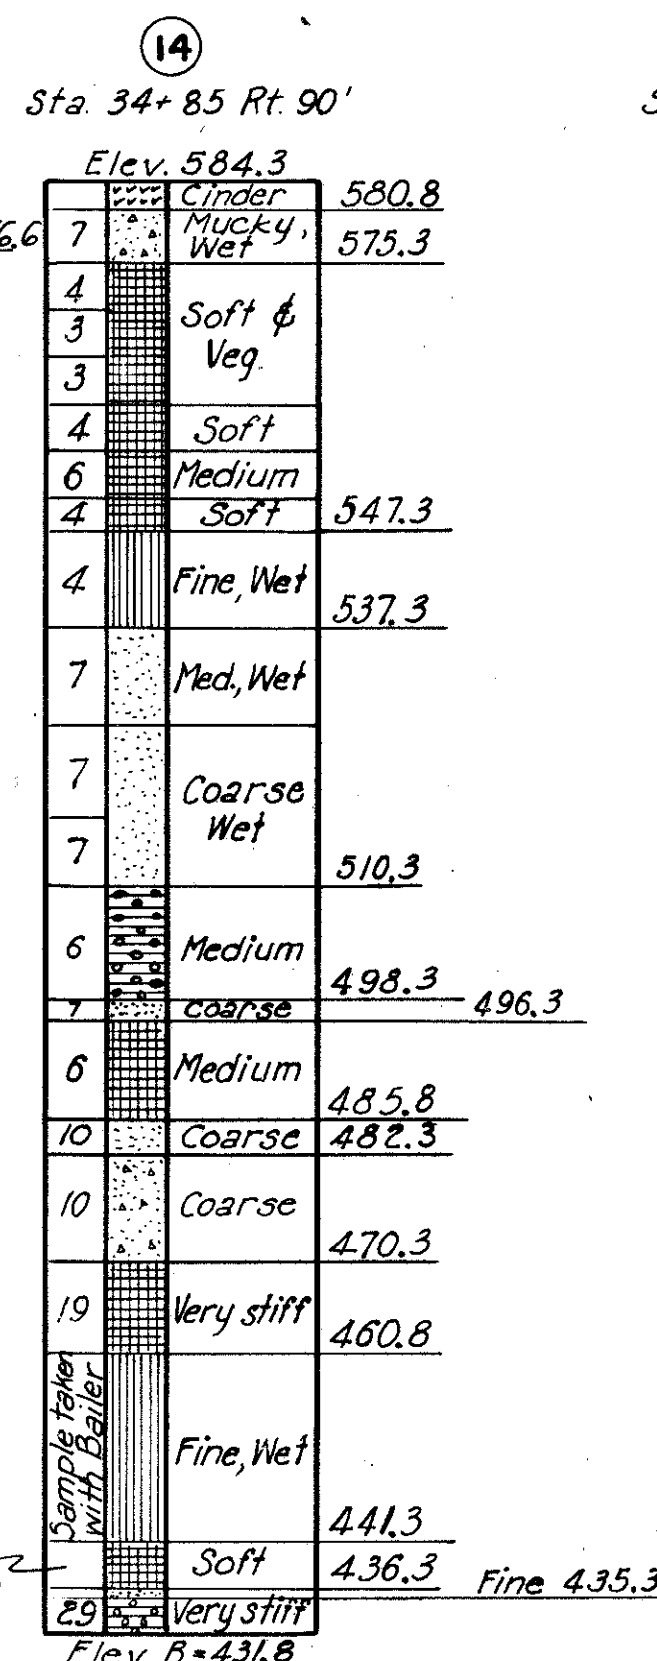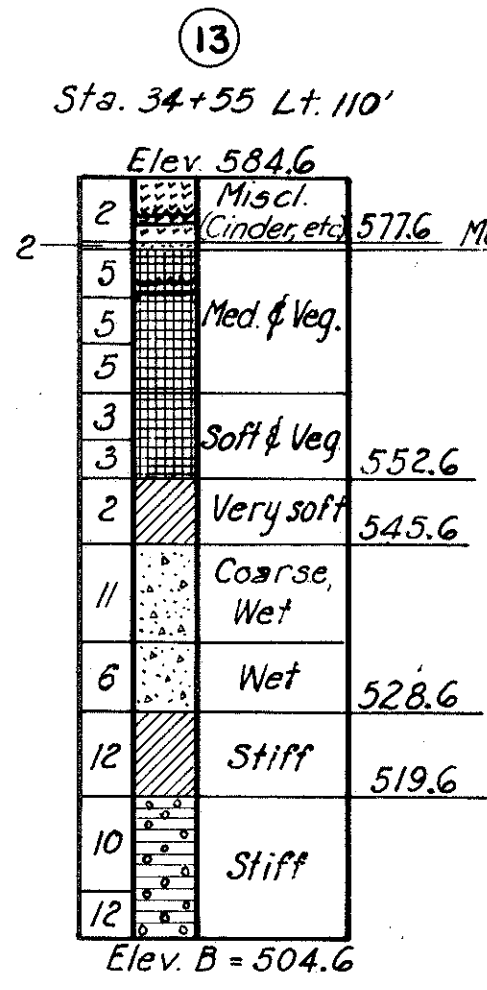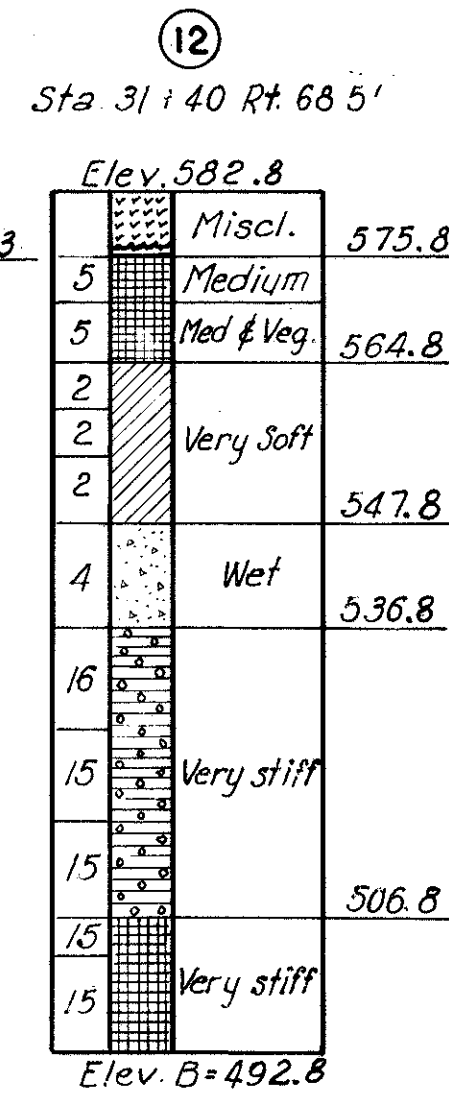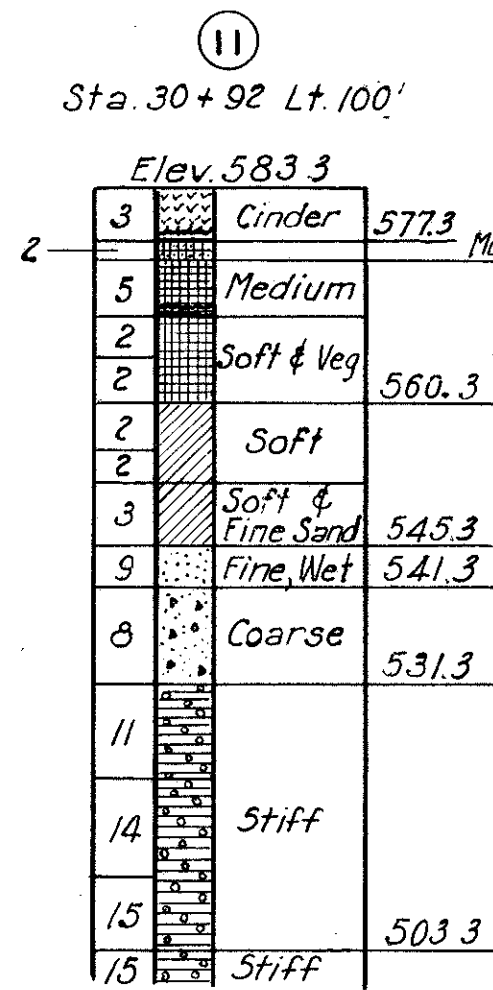

Notes: For general notes on borings and soil and boring legend, see Sheet 7.
Vertical scale for borings: 1" = 20'.
For existing conditions legend, see Sheet 8.

PART 3

U. S. ROUTE 42 RELOCATION
INNER BELT FREEWAY - CENTRAL VIADUCT
BR. NO CU - 42R-17.5

EXISTING CONDITIONS AND
TEST HOLE BORINGS

CLEVELAND	CUYAHOGA COUNTY	OHIO
-----------	-----------------	------












SCALE: 1" = 50', 20'

MADE 6.5 DATE 1.13.54
TRCD R.A.H. DATE 1.19.54
CHK. F.G. DATE 2.26.54

HOWARD, NEEDLES, TAMMEN & BERGENDOFF
CONSULTING ENGINEERS
KANSAS CITY CLEVELAND NEW YORK

914-1A SHEET 2.09

CUYAHOGA COUNTY
 CITY OF CLEVELAND
 INNER BELT FREEWAY
 CENTRAL VIADUCT
 CUY-42 R-17.50

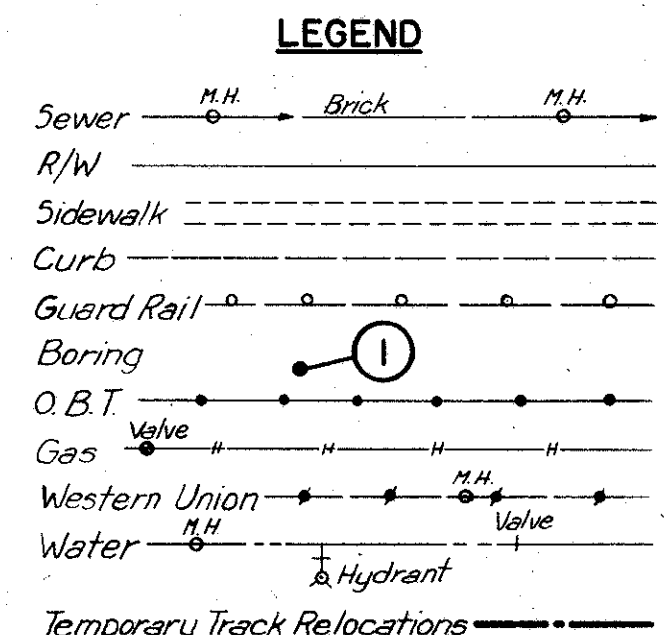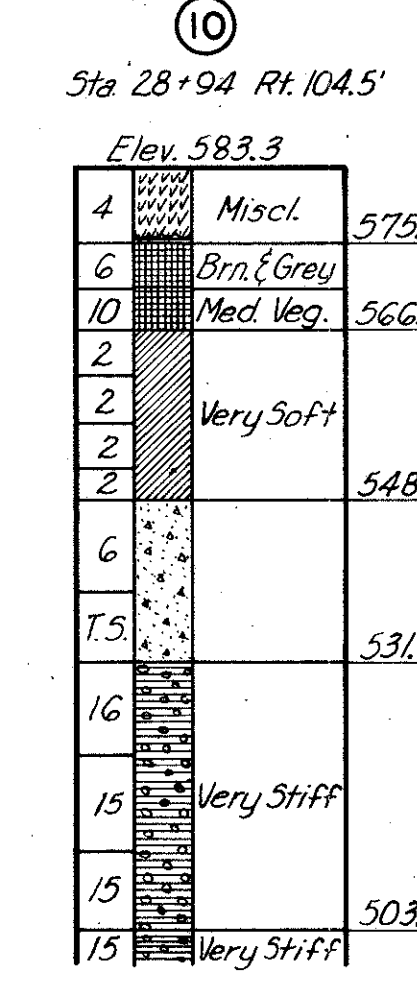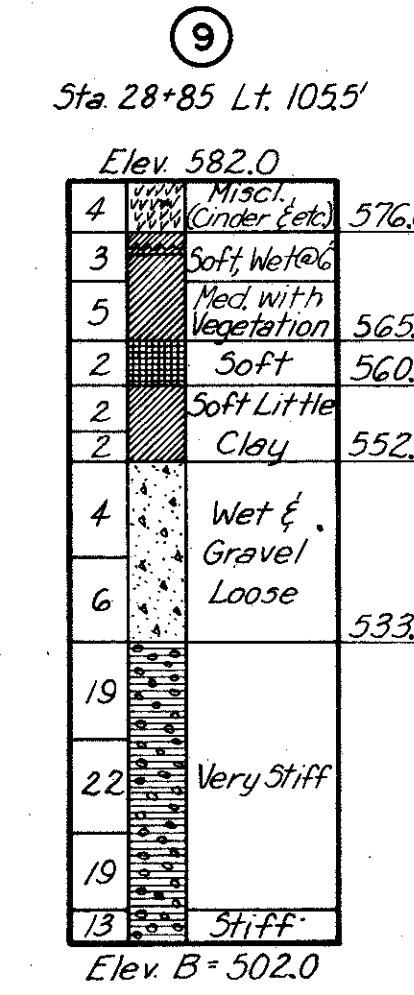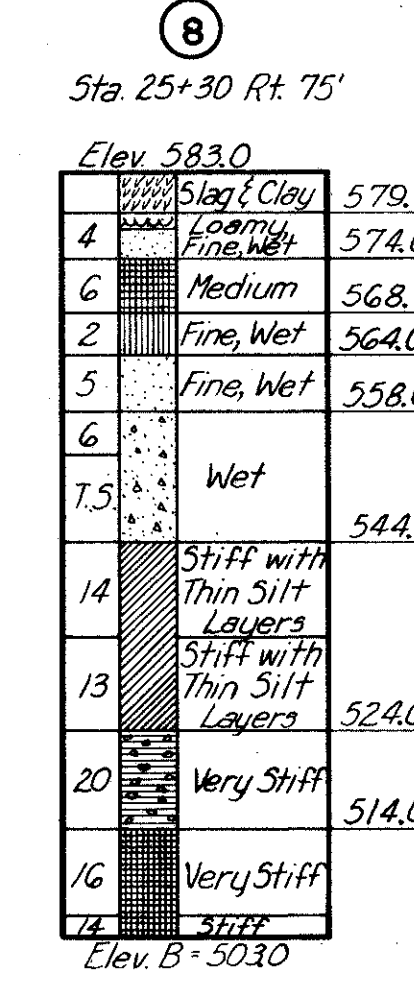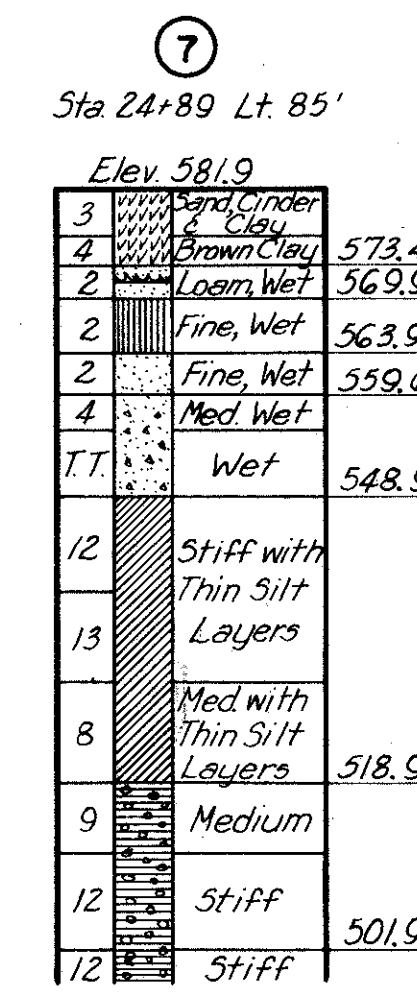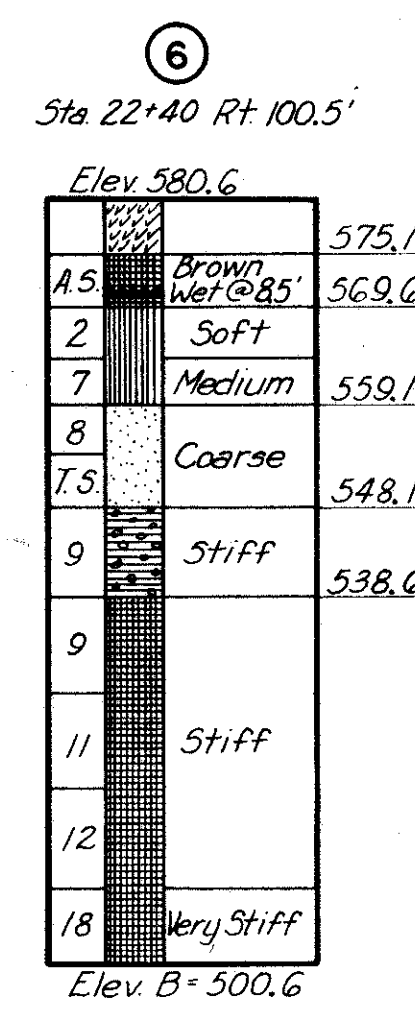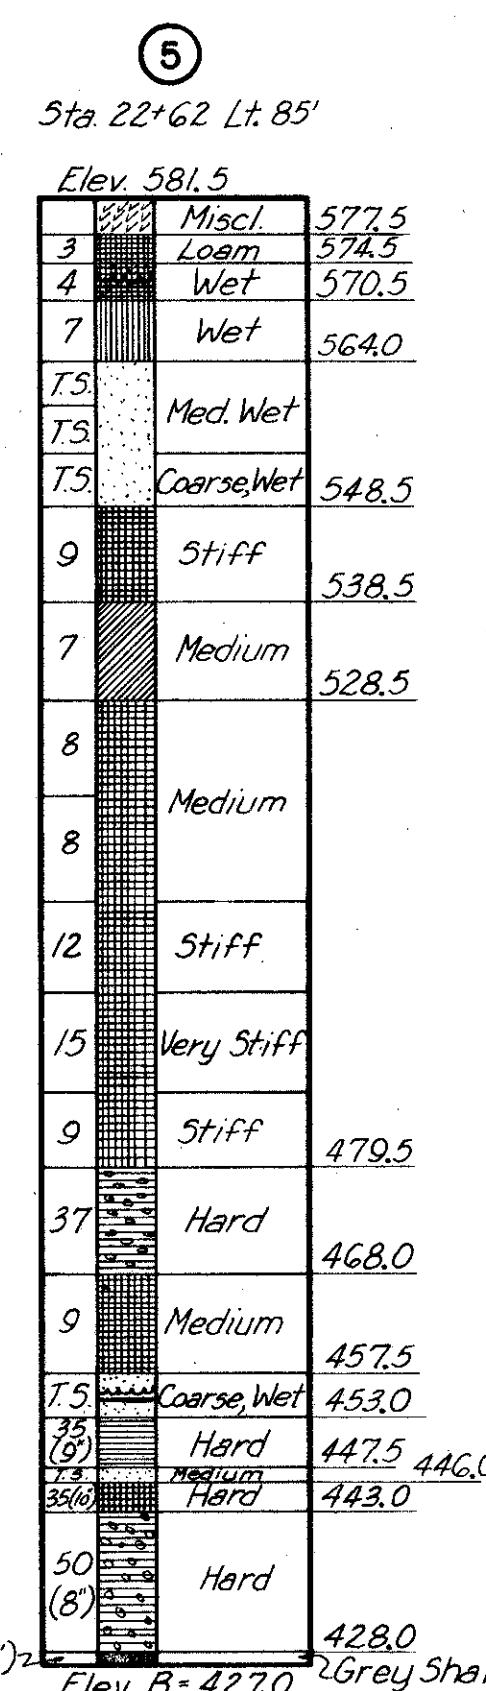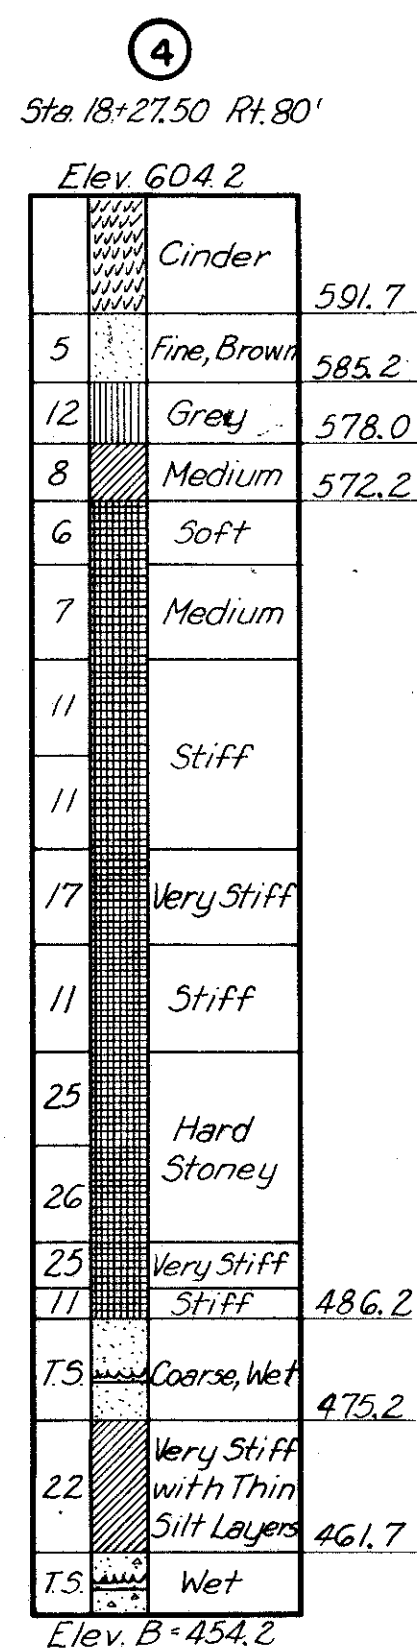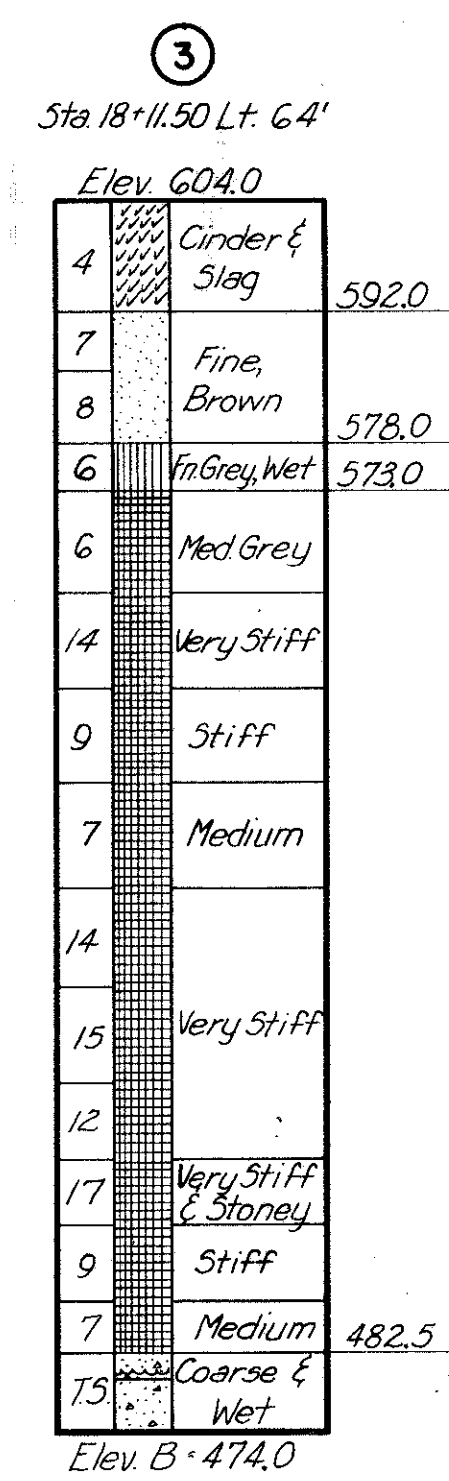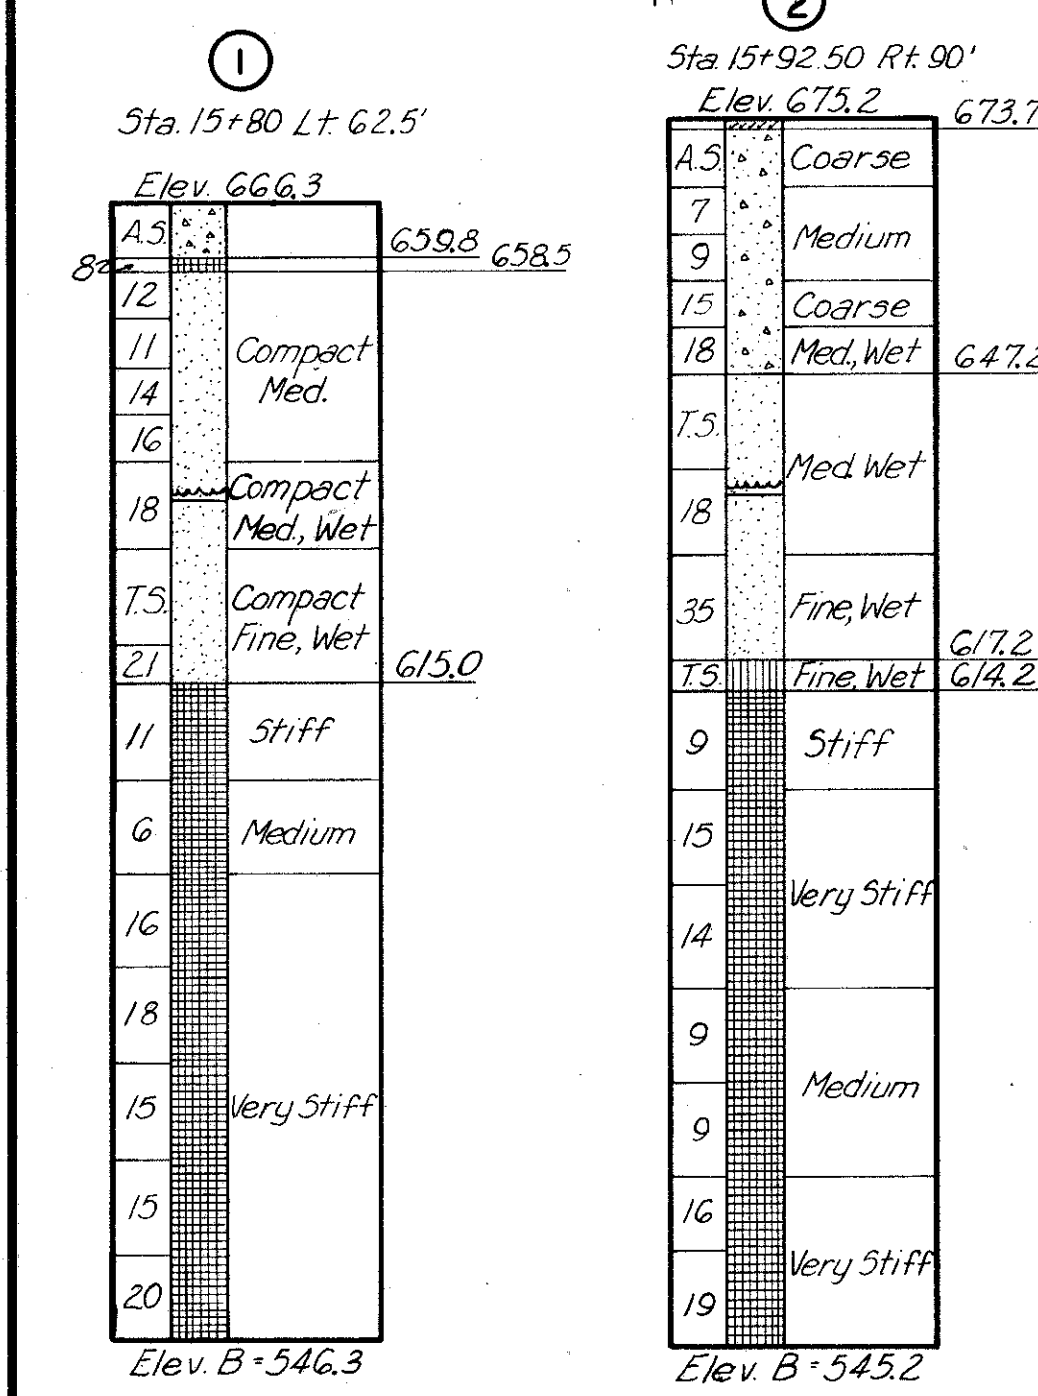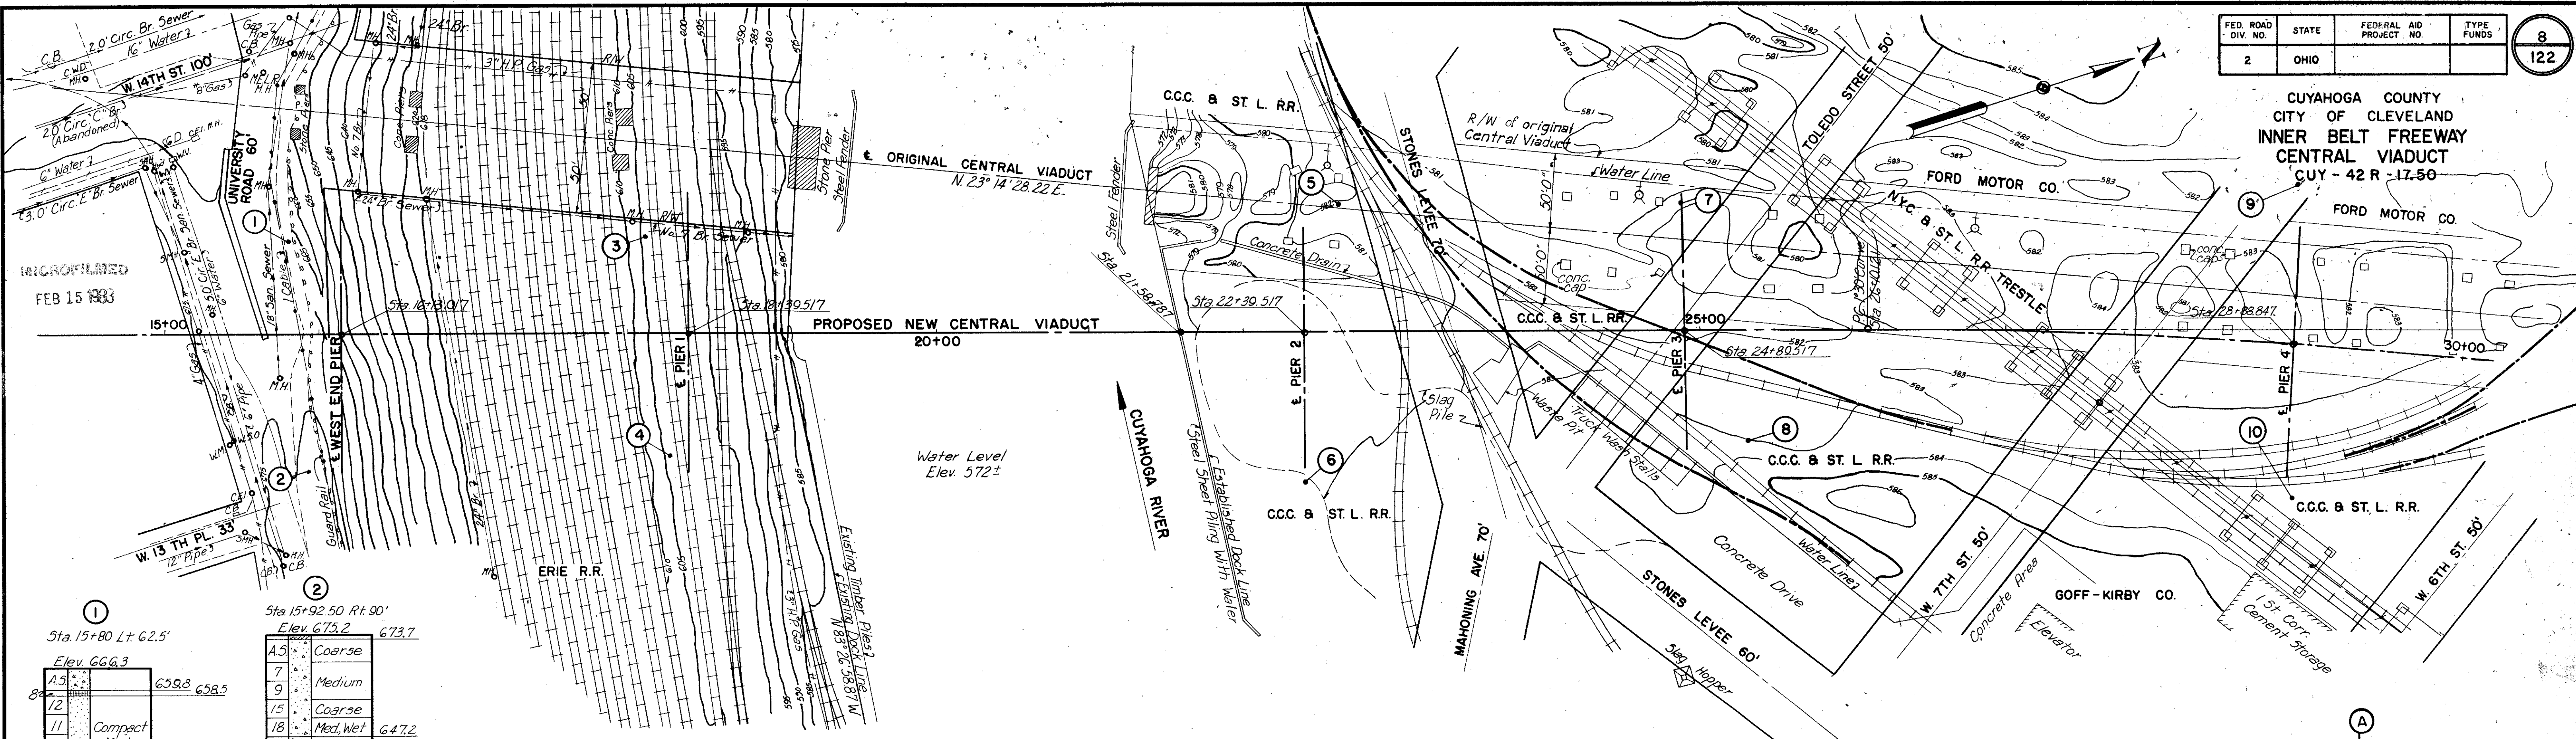

Notes: For general notes on borings and soil and boring legend, see Sheet 7.

PART 3

U. S. ROUTE 42 RELOCATION
 INNER BELT FREEWAY - CENTRAL VIADUCT
 BR. NO. CU-42 R-17.5

EXISTING CONDITIONS AND
 TEST HOLE BORINGS

CLEVELAND	CUYAHOGA COUNTY	OHIO
-----------	-----------------	------

SCALE: 1" = 50', 20'
 MADE: 6.5. DATE: 1-12-54
 TRCD: 11. DATE: 2-11-54
 CKD: C.C. DATE: 2-25-54

HOWARD, NEEDLES, TAMMEN & BERGENDOFF
 CONSULTING ENGINEERS
 KANSAS CITY CLEVELAND NEW YORK
 914-1A SHEET 2.08

106


7
122

U. S. ROUTE 42 RELOCATION
BELT FREEWAY - CENTRAL VIADUCT
BR. NO. CU - 42 R-17.5
GENERAL LAYOUT AND
TEST HOLE BORINGS
AND CUYAHOGA COUNTY OHIO

Scale: 1"=20'
DATE: 1-27-54
DATE: 2-6-54
DATE: 2-28-54

HOWARD, NEEDLES, TAMMEN & BERGENDOFF
CONSULTING ENGINEERS
KANSAS CITY CLEVELAND NEW YORK



914-1A SHEET 2.07

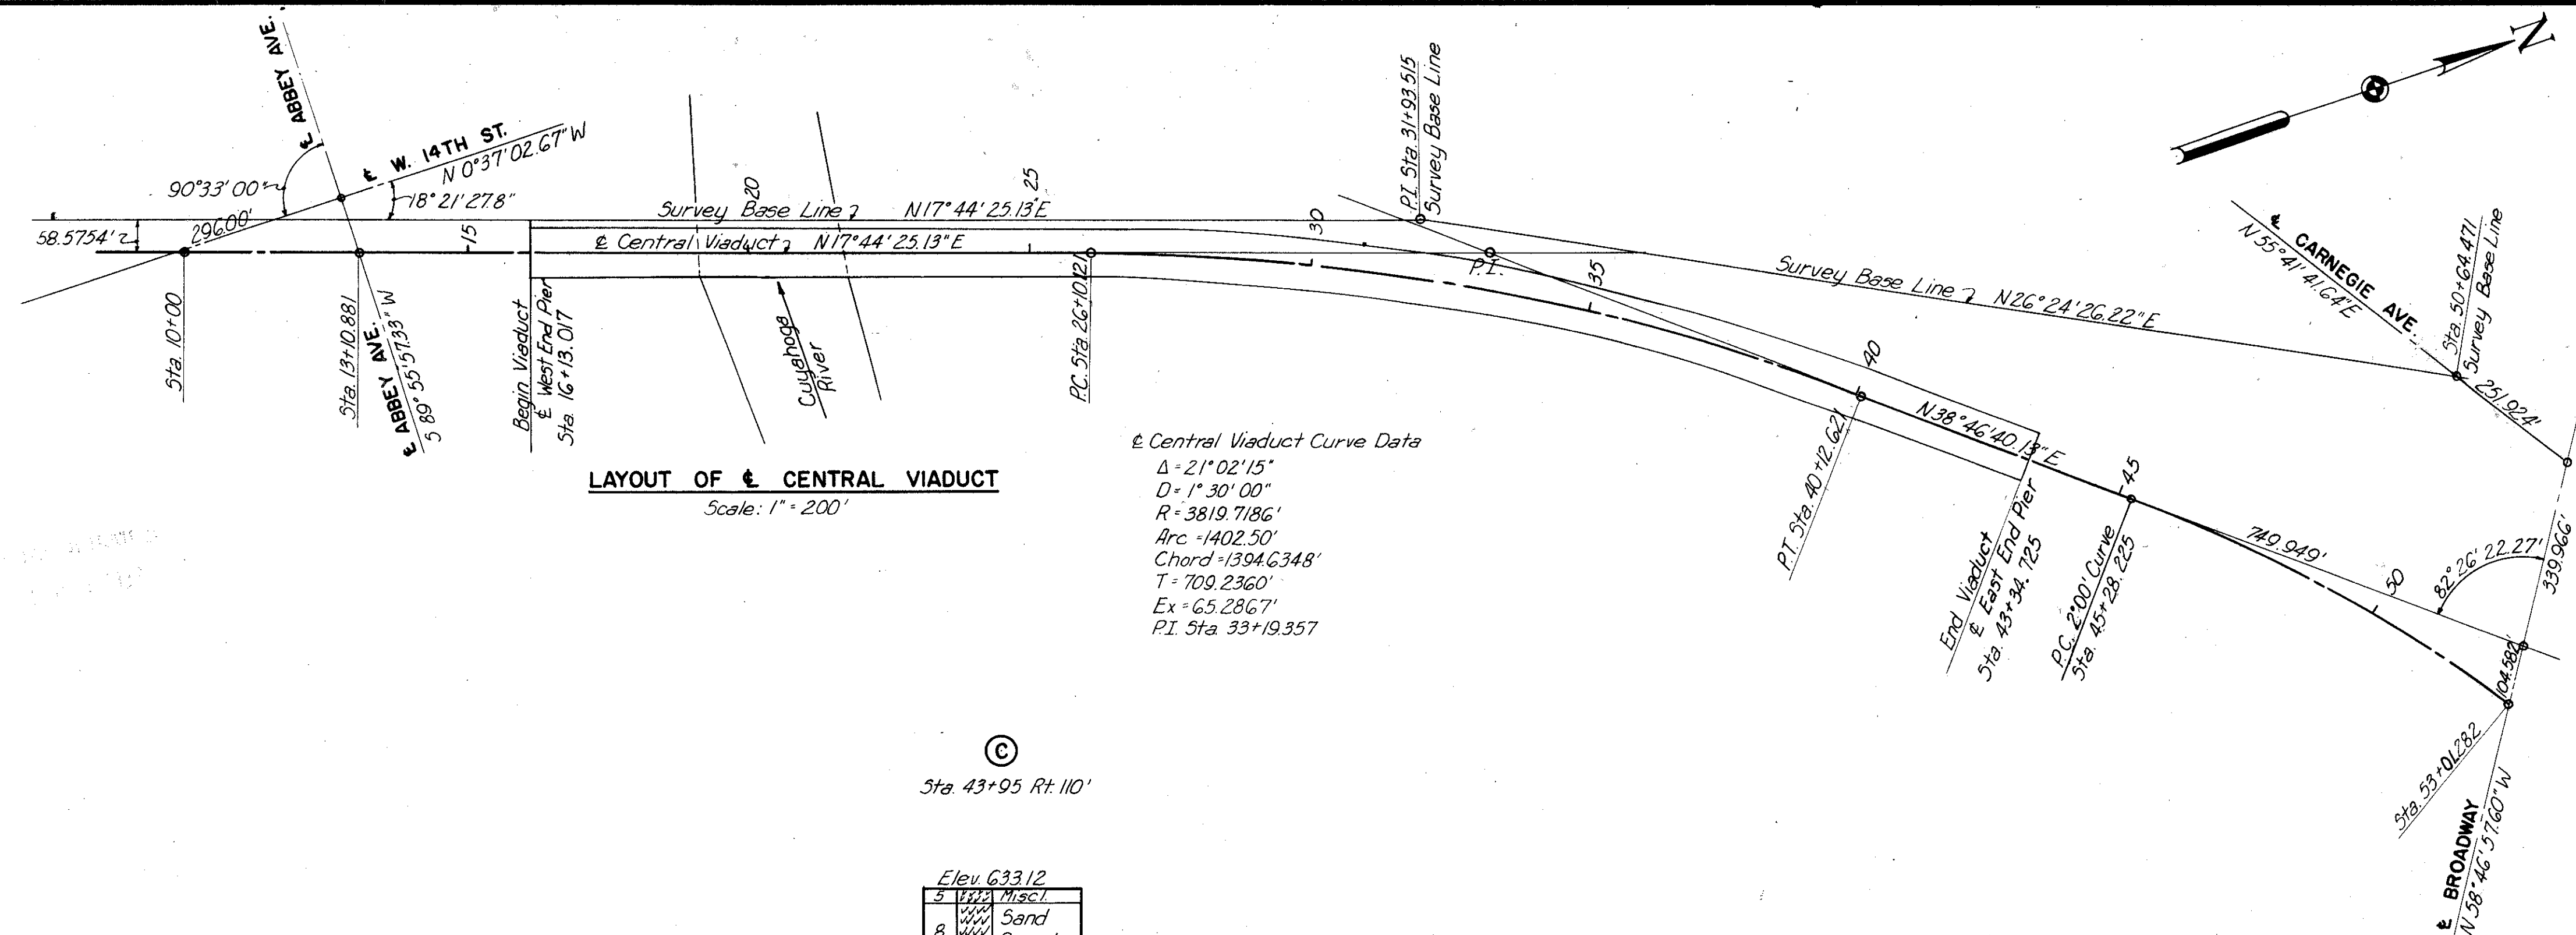


LAYOUT OF CENTRAL VIADUCT
Scale: 1" = 200'

Central Viaduct Curve Data

$\Delta = 21^{\circ} 02' 15''$
 $D = 1^{\circ} 30' 00''$
 $R = 3819.7186'$
 $Arc = 1402.50'$
 $Chord = 1394.6348'$
 $T = 709.2360'$
 $Ex = 65.2867'$
 $P.I. Sta. 33+19.357$

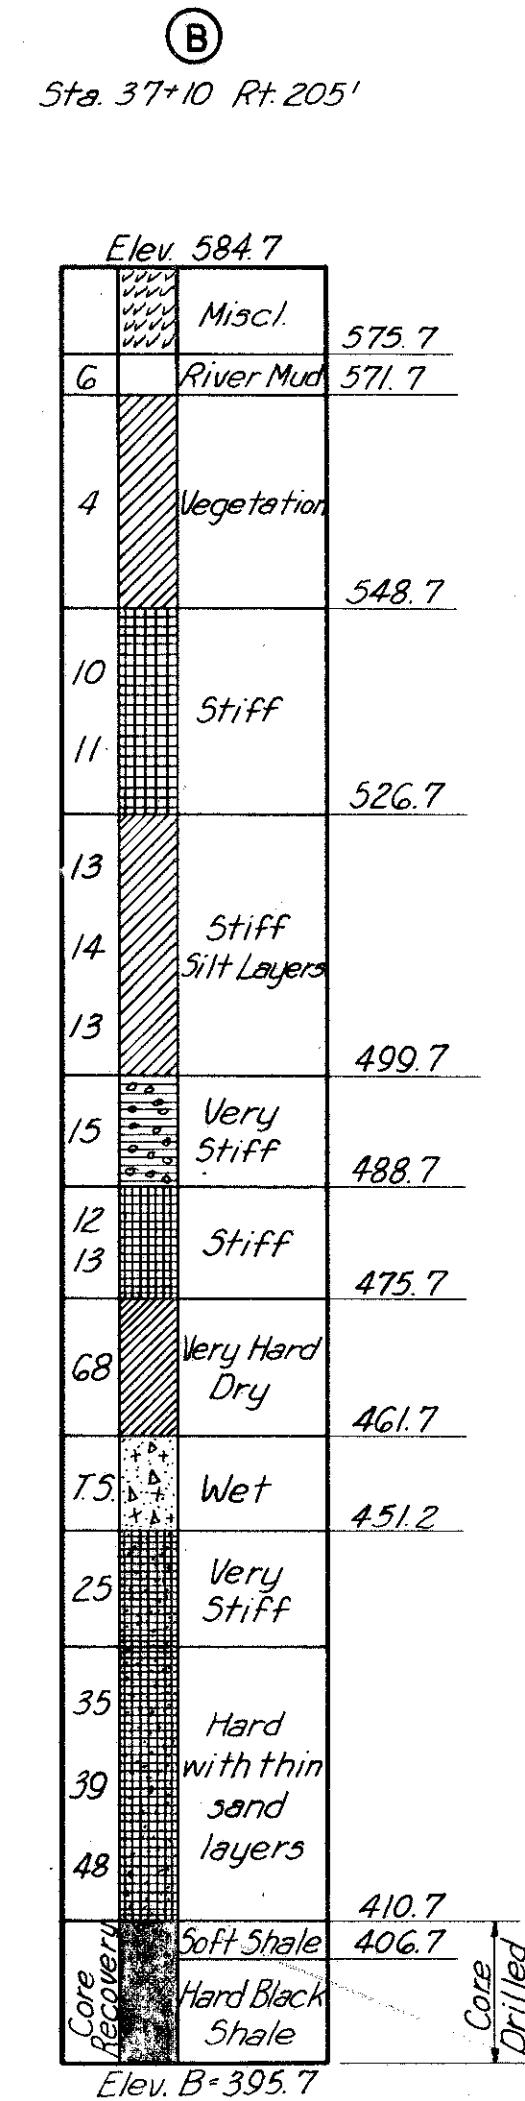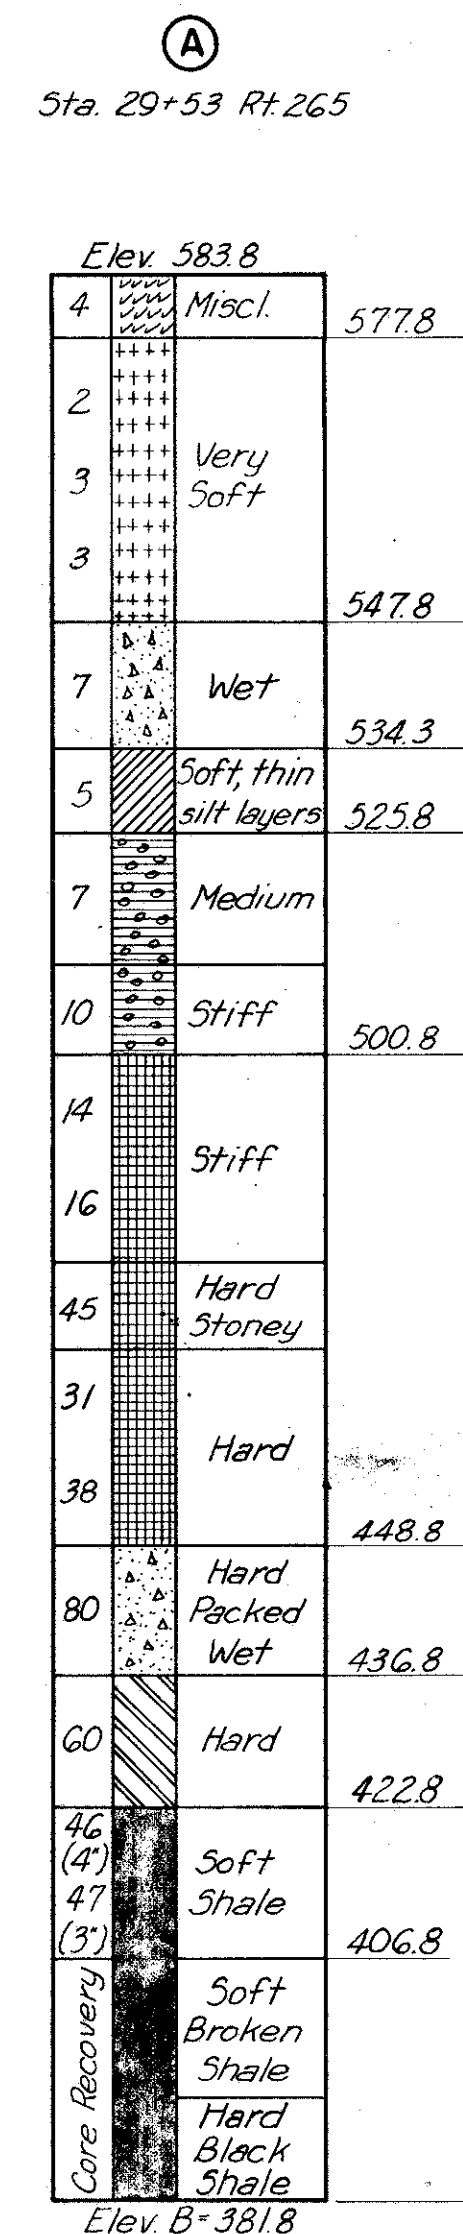



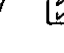



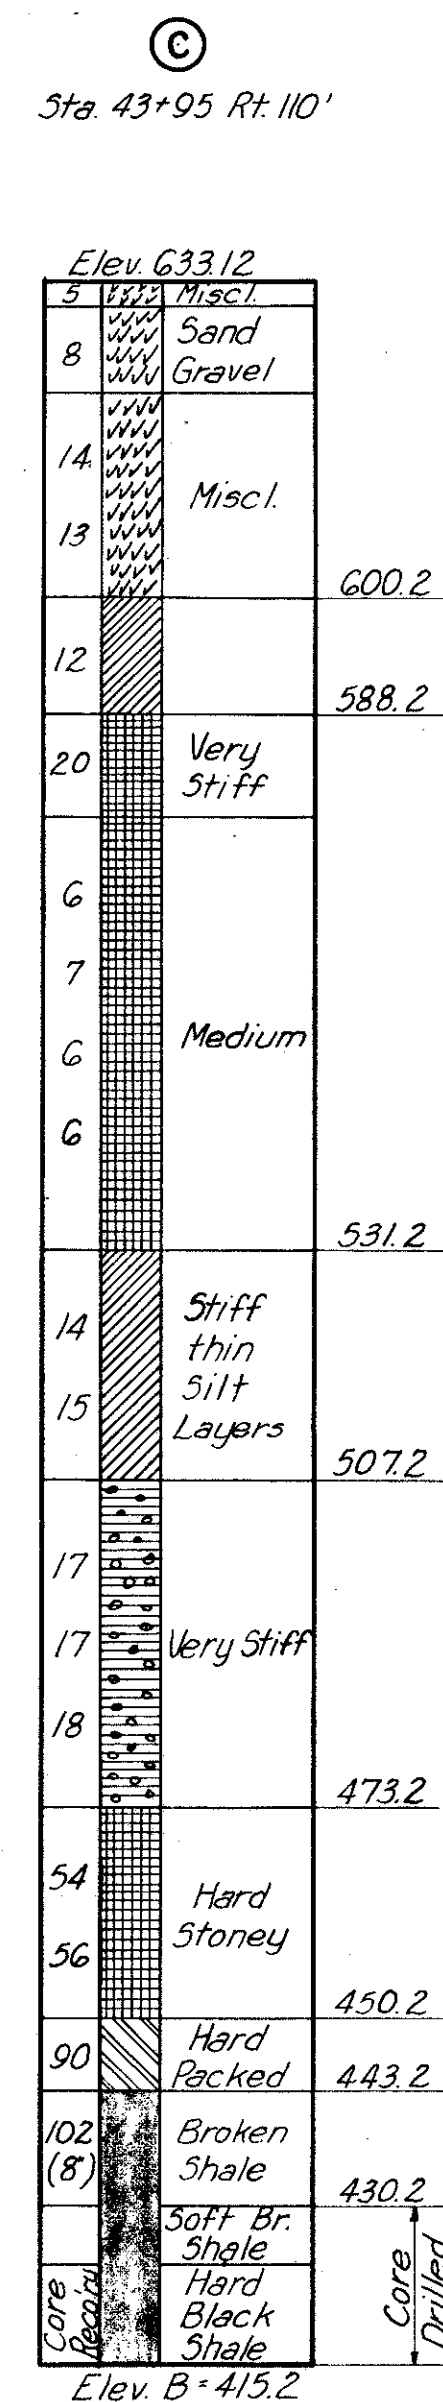






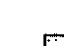
TEST HOLE BORINGS A, B AND C

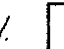

Elev. B = 415.2

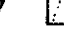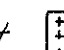GENERAL NOTES

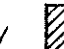SOIL LEGEND

- | | |
|-----------------------|---|
| Misc. |  |
| Fill |  |
| Clay |  |
| Sand |  |
| Silt |  |
| Silty Sand |  |
| Silty Clay |  |
| Sandy Clay |  |
| Pebbly Clay |  |
| Sand and Gravel |  |
| Silt, Sand and Gravel |  |
| Sand, Clay and Gravel |  |
| Rock |  |
| Ground Water |  |
| Trap Sample | T.S. |
| Auger Sample | A.S. |
| Tube Trap | T.T. |

BORING LEGEND

(a) (b) (c) (d)

Elev. 100.0

As	Fill	95.0
3	Soft & Wet	
2		
7.5		
10	Very Stiff	
12		
14		
20		
25	Fine & Wet	60.0
30 (8)	Shale	55.0

Elev. B = 50.0

With reference to above example ;

1. In column (a) the figures 2, 3, etc. are the hammer blows required to advance the casing one foot unless otherwise noted.
2. Column (b) shows the legend of soil types and ground water elevation.
3. Column (c) shows soil classification. Elev. 100.0 is the ground level and Elev. B + 50.0 is the bottom of the boring.
4. Column (d) shows the intermediate elevations of limits of different soil layers.

Misc. Notes: Vertical scale for boring 1" = 20'.
All samples taken with Split Type Tube, 2" O.D. x 1.5" I.D. and 4" steel casing unless otherwise noted.
Hammer w/ 140#. Average fall 30'.

MICROFILMED
FEB 15 1983

FED. ROAD DIV. NO.	STATE	FEDERAL AID PROJECT NO.	TYPE FUNDS
2	OHIO		

6
122

CUYAHOGA COUNTY
CITY OF CLEVELAND
INNER BELT FREEWAY
CENTRAL VIADUCT

ESTIMATED QUANTITIES														
ITEM	DESCRIPTION	TOTAL	UNIT	PROJECT IN GENERAL	UNIT 1	UNIT 2	UNIT 3	UNIT 4	UNIT 5	UNIT 6	UNIT 7	UNIT 8	UNIT 9	AS BUILT
S-1	Class "C" Concrete	7,280.1	Cu. Yds.		869.5	540.1	1,197.9	540.2	1,186.0	409.7	1,189.7	405.8	941.2	
S-4	Reinforcing Steel	2,324,480	Pounds		279,192	170,930	383,408	171,730	378,565	129,320	382,258	128,565	300,512	
* S-7	Structural Carbon Steel	15,011,600 15,011,600	Pounds		1,790,000	1,080,000	2,470,000	1,060,000	2,610,000	840,000	2,460,000	830,000	1,860,000	C-10, 18,520 C-1, 30,120 15,011,600
* S-7 Special	Structural Manganese Steel	9,594,001 9,668,000	Pounds		1,130,000	640,000	1,990,000	620,000	1,770,000	310,000	1,680,000	310,000	1,210,000	C-10, 88,644 C-4, 22,665 9,594,001
S-8	Field Painting Structural Steel and Drainage System	25,646,771 25,733,000	Pounds		3,080,000	1,765,000	4,670,000	1,725,000	4,580,000	1,152,000	4,350,000	1,181,000	3,230,000	C-10, 88,229 25,646,771
S-9	Copper Water Stops including 1" hot poured joint sealer, Sec. M-10.23	2,592	Lin. Ft.		324	108	540	108	432	108	540	108	324	
S-9	1" Preformed Gray Rubber Expansion Joint Filler, Sec. M-10.02	73.2	Sq. Ft.		6.1	6.1	12.2	6.1	12.2	6.1	12.2	6.1	6.1	
S-14	Handrail (Aluminum)	5,404	Lin. Ft.		633.4	403.0	897.0	403.0	887.6	303.0	890.6	303.0	683.4	
SS-24	Walkway grating	8,225	Sq. Ft.		1,275	350	1,610	265	1,600		1,600	265	1,260	
** S-25	Roadway Lighting System, Part A	1	Lump Sum	1										
** (1) S-25	Roadway Lighting System, Part B	1	Lump Sum	1										
** S-25	Navigation Lights	1	Lump Sum	1										
S-25	Electrical Grounds	1	Lump Sum	1										
S-29	Copper Tubes for Sub-drainage Wearing Surface Course	738	Each		108	36	126	36	126	36	126	36	108	
*** S-29	Roadway Drainage System	1,093,955 1,073,000	Pounds		160,000	45,000	210,000	45,000	200,000	2,000	210,000	41,000	160,000	C-10, +22,955 1,093,955

- * See General Notes, Sheet 4, paragraph 8, for items included for payment.
** See General Notes, Sheet 5, paragraph 6, for division of items for payment.
*** See General Notes, Sheet 4, paragraph 7, for items included for payment.
(1) No State participation.

PART 3

U. S. ROUTE 42 RELOCATION
INNER BELT FREEWAY - CENTRAL VIADUCT
BR. NO. CU - 42R-175

ESTIMATED QUANTITIES

CLEVELAND CUYAHOGA COUNTY OHIO

SCALE
MADE NAM DATE 6-1-54
TRCD. AH DATE 4-13-55
CKD. GA DATE 4-20-55
HOWARD, NEEDLES, TAMMEN & BERGENDOFF
CONSULTING ENGINEERS
KANSAS CITY CLEVELAND NEW YORK
914-1A SHEET 2.06

FEB 15 1983

FED. ROAD DIV. NO.	STATE	FEDERAL AID PROJECT NO.	TYPE FUNDS	5 122
2	OHIO			

CUYAHOGA COUNTY
CITY OF CLEVELAND
INNER BELT FREEWAY
CENTRAL VIADUCT

GENERAL NOTES , CONTINUED

ROADWAY AND NAVIGATION LIGHTING

1. GENERAL

This Specification shall govern for the materials used and for the installation of a complete series roadway and navigation lighting system for the viaduct. The type and location of lights, the circuits and the location of cables and conduits shall be as indicated on the plans. The installation for roadway lights shall be in fiber or asbestos-cement conduit. For the roadway lighting, 15,000 lumen incandescent lights are to be installed as indicated on the plans, and are to be operated on a 6.6 amp. series circuit. The navigation lights are to be 50 watt, their branch circuits are to be in rigid conduit, and are to be installed for 115 volt secondary operation through insulating transformers from the 6.6 amp. series circuit.

The Contractor shall cooperate with the Cleveland Division of Light and Power and the Cleveland Electric Illuminating Company, but he will not be required to furnish, install or connect meters, meter mounts, metering equipment or housing for same. The Contractor shall provide proper termination of loop circuits for connection to future adjacent series circuits.

The Contractor shall furnish and install lighting equipment, including all lamps, luminaires, navigation lighting fixtures, wiring, luminaire brackets, poles, expansion couplings, flexible couplings, tops of posts (bases for poles), pole cap screws, cable, all conduit for lighting circuits, and all incidentals necessary for a complete circuit installation, installed and connected for operation. The loops of lighting circuits shall be complete, and the Contractor shall furnish and install all equipment necessary for the satisfactory future operation of the circuits and for the complete operation of the lighting system, (excluding the future adjacent sections, leads, primary transformers, primary fuse cutouts, primary arresters, and primary connections to the power sources) whether specifically mentioned or not.

The lighting installation, when completed shall comply with the applicable provisions of the A.I.E.E. Standards and Practices, American Standards, and National Electric Manufacturers' Association Standards, and shall conform to all local and special laws or ordinances governing such installation, and to the special requirements herein set forth. Should the plans and detail specifications be in conflict with these requirements, through error or omission, the Contractor shall call such conflict to the attention of the Engineer, and the Contractor shall make the necessary corrections in the installation as may be directed by the Engineer.

Insofar as practicable, all major items of electrical equipment such as luminaires, cable, poles, insulating transformers, etc., shall consist of products of the same manufacturer in order to secure single responsibility and most satisfactory service. Unless specifically noted otherwise, all electrical equipment shall be equal to the best grade of that type of equipment as manufactured by the General Electric Company, The Westinghouse Electric Company, or the Line Material Company. Reference to any name, make or manufacturer's number for an article of equipment or material is intended to be descriptive, but not restrictive, and is intended to indicate the materials that will be acceptable.

A layout wiring diagram showing in general the arrangements and location of the equipment is shown on the plans. This shall be considered only as illustrative and, subject to the approval of the Engineer, the Contractor shall modify it as necessary for complete and proper construction and operation. The location of the transformers, services, conduit and luminaires shown on the plans are diagrammatic only, and may be subject to shifting as the Engineer may direct in order to conform to local conditions.

Before commencement of installation of the roadway lighting system, a complete schedule of materials and equipment proposed for installation shall be submitted for the approval of the Engineer. The schedule shall include catalogs, cuts, diagrams, drawings, and other such descriptive data as may be required by the Engineer. In the event any items of material or equipment contained in the schedule fail to comply with specification requirements, such items may be rejected.

2. MATERIALS AND EQUIPMENT

All bolts, nuts, studs, washers, pins, terminals, springs, and similar fastenings and fittings shall be, where practicable, of an approved corrosion-resisting material such as brass or bronze, or of a material treated in an approved manner to render it adequately resistant to corrosion. Hot-dip galvanizing shall be considered such approved treatment. All materials furnished shall be new, shall be of the best quality and workmanship, shall be the best standard product of a manufacturer regularly engaged in the production of this type of equipment and shall be of the manufacturer's latest approved design.

Each roadway lighting unit shall comprise a pole with a 10 ft. bracket and a luminaire similar to General Electric Form 79-AR. Luminaires lighting the roadway shall meet the general requirements of IES, Type IV distribution. Luminaires shall overhang about 6 ft. out from curb.

Light standards shall conform as nearly as possible to the specifications and Drawing M-20.35, of the City of Cleveland as to general design and finish, height, base, mast arm and dimensions. In general, the standards shall consist of a cast steel anchor base to which shall be welded a tapered steel pole. To the steel pole shall be fastened an ornamental pole top to which shall be welded a mast arm for supporting the lighting unit.

A cast steel anchor base of adequate strength and of the shape and size shown on Sheet No. 122 shall be secured to the lower end of the shaft by means of a double electric weld. To obtain this construction, the base shall telescope the shaft, and one weld shall be on the outside of the shaft at the end of the shaft and the other shall be on the inside at the top of the base.

The steel shaft of the lighting standard shall be fabricated from not less than #11 manufacturers' standard gauge. The shaft shall be formed and welded with only one longitudinal, automatically electrically welded joint and shall have no horizontal joints or welds. The weld shall be of full penetration. After forming and welding, the tapered shaft shall be cold rolled or worked under sufficient pressure to flatten out the weld, to increase the elastic limit of the metal in the completed shaft, and to produce a true tapered tube without flat spots and a circular cross-section throughout the length of the shaft. If the shaft is fabricated by means of a brake or other process which does not utilize the cold rolling principle, it shall be fabricated from a steel sheet having a thickness of #7 manufacturers' standard gauge.

Each standard shall have a mast or bracket arm ten feet in length made of standard pipe of the size shown on the plans. The inner end of the bracket shall be welded to a cast steel head block so designed that the block can be bolted through a cast iron neck piece to a plate welded to the top of the pole to permit radial adjustment of the bracket arm. Provisions shall be made to permit passage of the concealed wires to bracket arm. The ornamental casting welded to the outer end of the bracket shall be arranged with a leveling device or "Plumbizer" for adjustment of a pendant lighting fixture and shall be tapped for 1-1/4 inch pipe connection.

Each standard shall have two 9/16 inch holes provided, where shown on Sheet No. 122. Painting shall be as specified under paragraph 20, Sheet 3.

The luminaire shall consist of a supporting hood, and external body or casing, an internal main reflector, and a refractor globe. The hood shall be made of cast aluminum and shall be tapped for 1-1/4" standard pipe. The external body or casing shall be made of cast aluminum and shall be firmly attached to the hood by means of adequate screws or bolts. The main reflector shall be made of heavy gauge aluminum sheet, Alzak finished and polished. The entire reflecting element shall be rigidly attached to the external body by means of screws or bolts.

The globes shall be supplied with a non-rusting metal supporting ring or band with clamps around the rim or flange of the globe. The supporting ring shall be so designed that broken globes can be replaced at the lamp location with the use of simple hand tools. All screws, nuts, washers, etc., which must be removed in order to replace a broken globe shall be non-ferrous and corrosion-proof. The globe supporting ring shall be attached to the reflector by means of a hinge or its equivalent on one side and a latch, thumb screw, or equivalent on the opposite side. These devices shall be so designed that with the globe in place, the latch or thumb screw can be released by hand, the globe swung down and then lifted off the hinge so that the globe can be washed separately from the fixture. The design shall be such that after washing, the globe can be hooked on to the hinge and then pushed up into place against the gasket with one hand while the latch or thumb screw is tightened with the other hand. The best design shall be that which combines simplicity and ease of operation with the most effective seal between the glass globe and the reflector. Fixtures having the reflector permanently attached or "spun on" to the glass globe will not be accepted. A skeleton type mogul multiple socket shall be mounted in the hood and shall be suitable for 10,000 or 15,000 lumen 20 ampere lamps. The fixture shall produce an I.E.S. Type IV light distribution curve equal to the curve produced by the General Electric Form 79AR.

Lamps for navigation fixtures shall be 50 watt, vibration service, and for luminaires shall be 15,000 lumen, PS-40 bulbs, mogul base, as indicated on Sheet No. 122.

For navigation lighting, suspension bridge lamps shall be provided where indicated on the plans. The channel margin suspension bridge lamps shall be galvanized cast iron with 180° red fresnel lens, equipped with shock absorbing sockets, retriever chains, and similar to Western Railroad Supply Company Figure #2. The channel center pivot type suspension bridge lamps with 360° green fresnel lens shall be equipped with retriever chains, and equal to Western Railroad Supply Company Figure #11.

External parts of all luminaires shall be finished aluminum. Gaskets used for sealing the joint between globes and reflectors or casings shall be preformed cork or felt and shall be cemented in place. The fixtures as specified are precision optical devices and in order to deliver the performance required they must have the lamp filament correctly located with reference to the reflecting or refracting elements. The sockets shall preferably be solidly mounted, with the lamp filament at the correct optical center. If the manufacturer's design provides for vertical adjustment of the socket, he shall furnish a drawing showing the proper dimension to some convenient reference point, such as the lower edge of the reflector or casing, so that the purchaser can make a gauge to be used for accurately setting and locking the sockets. Refracting globes shall preferably be keyed to the supporting reflector so that they cannot be placed in any other than the correct angular location. In any event, the globes must be plainly marked to indicate the "street side" and the "house" or "sidewalk side". All lamps used in these fixtures will be standard 20 ampere, base up, Mazda type with mogul bases and 7 inch light center.

Lamp sockets used in enclosed fixtures of the types specified are subjected to high temperatures and the sockets furnished shall be for heavy duty and shall incorporate all the latest design features available such as center spring loaded contacts, plated parts and extra heavy cast terminals, to reduce the possibility of contact troubles and welding of the lamp base to the socket shell. Each fixture shall preferably be completely assembled at the factory and shipped in a single container as a complete unit.

All the street lighting transformers will be connected with their primary windings in a 6.6 ampere 60 cycle regulated circuit, and shall be located in the sidewalk junction boxes. The secondary of the transformer for the navigation lights shall be 60 watt, 120 volt, multiple secondary and shall be equal to Westinghouse No. 348293. The secondary of the 10,000/15,000 lumen transformers will supply 20 amperes to one lamp rated 15,000 lumens. When the lamp wattage varies between 8X above and 20X below normal, the secondary or lamp current shall not vary more than 1X from 20 amperes with 6.6 amperes at 60 cycles supplied to the primary winding. Each transformer shall be given a dielectric test by the manufacturer and shall withstand 22,000 volts between primary winding and all other parts of the transformer and 1,500 volts between the secondary winding and all other parts of the transformer. Both of the above tests shall be applied for one minute, without failure. The street lighting transformers shall be, as nearly as obtainable, like that shown on Drawing No. 3863 of the Division of Light and Power of the City of Cleveland, which is the type preferred by the City and will be the criterion in judging the adequacy of the type proposed by the contractor. Individual transformers shall be furnished for each light.

Each transformer shall be supplied with a noncorrosive name plate showing the following data:

Maker's name and style or catalog number
Rating in Lumens
Primary current
Secondary current
Frequency

Conductor for Roadway lighting shall be #8 AWG solid soft drawn copper of not less than 98% conductivity and shall be coated with lead, tin, or antimony alloy. Insulation shall consist of 10/64 inch of rubber-like compound known commercially as ozone resistant type insulation. The insulating compound shall conform in every respect and shall be tested in accordance with ASTM Designation D574-46T, or the latest revision thereof. The outside jacket or sheath shall be 4/64 inch thick and shall be made of GR-M Polychloroprene (Neo Prene) sheath compound. The sheath compound shall conform in every respect and shall be tested in accordance with ASTM Designation D753-44T, or the latest revision thereof. The cable shall be shipped on reels. Each reel shall be marked "Street Lighting Cable" and marking card shall carry manufacturer's descriptive data for the conductor and insulation.

The junction boxes for branches to lights from 3" longitudinal conduit runs shall be suitably attached under sidewalk where indicated. Brass or monel screws shall hold cover tightly. The finish inside shall be hot-dip galvanizing. Boxes shall be similar to Hopes 1252 size 24 x 12 x 6, with no lugs. See Sheet 122 for an alternate welded sheet metal junction box.

Conductors on truss spans of bridge shall be in asbestos cement conduit conforming to Supplemental Specification No. M - 206.14 or in fiber conduit equivalent to Orangeburg Nocrete. The conduits shall be 3 inch inside diameter and be placed on hangers that are furnished with the structural steel and shown on Sheet 100. All conduits on the bridge shall be supported at not over 6 ft. spaces.

Conduits cross the structure transversely in span 1 and span 9, as shown on Sheets 18, 26 and 122. These four conduits shall be 2 inch diameter asbestos cement conduit conforming to Supplemental Specification No. M - 206.14 or fiber conduit equivalent to Orangeburg Nocrete.

Rigid metal conduit from junction boxes to navigation lights shall be 1 inch, National "Sherarduct" or an approved equivalent. This conduit shall be furnished with tapered threaded fittings as required.

The circuit conductors for the 110 volt multiple circuit lighting cable to the navigation lighting units shall be No. 12 AWG conductors, as specified on Sheet No. 122. The conductors at pivot type fixtures shall be No. 12 AWG, 600 V., extra flexible, ASTM Class D. The conductors shall be continuous from outlet to outlet, and no splices shall be made except within outlet or junction boxes. The conductors shall have 3/64 inch insulation and 3/64 inch Neoprene jacket.

3. CONSTRUCTION METHODS

The installation as a whole shall be carried out in conformance with the requirements herein stated and implied, and upon completion of the work shall present a neat and workmanlike finished appearance. Safe construction and operating practices meeting the requirements of the National Electric Safety Code shall be maintained. All wiring to navigation lights is to be placed in rigid metal conduit fastened by suitable clamps. Longitudinal runs of conduits on the trusses are to be placed on hangers that are furnished with the structural steel and shown on Sheet 122.

Poles shall be carefully set, they shall be vertical, and the luminaires shall be supported with brackets about 28"-1" above pavement as indicated on the plans. The careful aligning and grading of poles is considered to be an essential feature of the installation. The work shall be as nearly perfect as practicable, and no perceptible tolerances will be permitted. In order to accomplish the desired perfection of alignment of the luminaires, the poles shall be carefully aligned and welded in place.

The installation of all luminaires and wiring shall conform to the recommendations of the equipment manufacturers and the practice of the power company.

Cables shall be installed in continuous lengths without splices, from terminal to terminal. At the terminals, cable shall be spliced to the equipment leads in strict conformity with the manufacturer's instructions. Care shall be taken to insure water-tight joints.

Splices shall not be made in conduits. Splices of conductors shall be made mechanically and electrically secure and flooded with solder, and wrapped in accordance with the recommendations of the manufacturer of the cable so that the insulation and the mechanical and electrical qualities of the splices shall be equal to that of the remainder of the conductor.

Conduits shall be firmly clamped to the structures to prevent rattling, shall be run in lines parallel and perpendicular to lines of structures and shall be so placed that dirt will not accumulate around them. Supports shall not be at more than 6 ft. centers. There shall be at least one inch clearance between conduits. If on a horizontal surface for over one foot, they shall clear the surface by at least three inches. Adequate approved provision for the movement of conduits shall be made wherever conduits cross expansion or fixed joints in the supporting structures. Where asbestos cement conduit is on the structures, one expansion coupling with rubber ring shall be used at least every 75 feet. Rigid conduit across expansion joints if used shall have an expansion coupling similar to D-2, Type EX or AX as required, complete with bonding jumper, or be in flexible couplings equal to Crouse Hinds Type EC.

4. TESTS

It is anticipated that the work under this contract will be completed prior to the completion of the adjoining girder spans. The Contractor shall install the series lighting cable in the conduits to the ends of the project and leave pig tails for connection by others to the lighting circuits.

The Contractor shall furnish all equipment and appliances necessary to test the completed cable systems. A burning test will not be necessary for the street lights on the truss spans. The City of Cleveland will make a "megger" test of all circuits. It shall be the Contractor's responsibility to demonstrate to the satisfaction of the Director of Highways, that all lighting circuits are continuous and free from short circuits and unspecified grounds, that all circuits are properly connected in accordance with the applicable wiring diagrams and that the resistance to ground of nongrounded series

circuits is not less than 50,000 OHMS.

In the event that the truss spans are completed ahead of the approach spans which will be in a subsequent contract, it will be necessary to provide power for the navigation lights. If this power is needed, the Bridge Contractor will furnish and install a separate circuit consisting of two number 6 wires or a low voltage cable, on each side of the bridge. Each such circuit would serve the three navigation lights on the respective side of the bridge. These temporary circuits for the navigation lights would extend to the end of the truss spans only and the Contractor would there leave pig tails for connections by others to an existing 120 volt line on University Road near the west end pier. Separate conduits would not be required for these temporary navigation light circuits as the temporary circuits would be carried in the street lighting conduits.

5. GUARANTEE

The Contractor shall be responsible for the proper performance in part and as a whole of the structural, mechanical and electrical equipment provided for the roadway and navigation lighting circuits and related parts for the period of one year after final acceptance of the work, to the extent that he shall correct at his own expense any difficulties with the operation which may arise during this period as the result of defects in material, equipment, manufacture and erection. Responsibility for such correction shall include the repair, readjustment and replacement not only of defective parts, but of other parts which may be damaged thereby. The State of Ohio and City of Cleveland reserve the right to themselves to correct any such defects and the Contractor shall pay the cost thereof. The Contractor shall give a written guarantee satisfactory to the State and City to insure the carrying out of these obligations.

6. PAYMENT FOR ROADWAY AND NAVIGATION LIGHTING

Payment for the three inch diameter conduit under each sidewalk; two inch diameter conduit across the structure in spans 1 and 9; conduit attachments and U bolt hangers; junction boxes; couplings; expansion couplings; standards; base castings; mast arms; ornamental pole tops; plumbizers; and all bolts, nuts, screws, fittings, clamps and other miscellaneous accessories shall be made in a lump sum payment for Item S-25, Roadway Lighting system, Part A.

Payment for cable; flexible cables and connections; wiring; splices; luminaires; globes; sockets; lamps; lighting transformers; ballasts; clamps; tests; removing waste; and all incidentals necessary for completing the Roadway Lighting System in an acceptable operating condition shall be made in a lump sum for Item S-25, Roadway Lighting System, Part B.

Payment for conduit from the navigation lights to the junction boxes of the Roadway Lighting System; pull boxes; splicing boxes; fixtures; globes; lamps; retriever chains; bolts; wiring of the navigation lights from the secondaries of the lighting transformers located in the junction boxes of the Roadway Lighting System; fittings; couplings; splices; attachments; tests; and all incidentals necessary for the installation and satisfactory operation of the six navigation lights, shall be made in a lump sum for Item S-25, Navigation Lights.

Payment for Item S-25 Electrical Grounds, shall include all materials and work described under paragraph 18, Electrical Grounds, on Sheet 3.

PART 3

U. S. ROUTE 42 RELOCATION
INNER BELT FREEWAY - CENTRAL VIADUCT
BR. NO. CU - 42R-17.5

GENERAL NOTES

CLEVELAND	CUYAHOGA COUNTY	OHIO
SCALE MADE 6-4 DATE 10-7-54 9-54 TRCD. DATE CKD. DME. DATE 2-9-55	HOWARD, NEEDLES, TAMMEN & BERGENDOFF CONSULTING ENGINEERS KANSAS CITY CLEVELAND NEW YORK	914-1A SHEET 2.05

CUYAHOGA COUNTY
CITY OF CLEVELAND
INNER BELT FREEWAY
CENTRAL VIADUCT

GENERAL NOTES , CONTINUED

STRUCTURAL STEEL, DRAINAGE SYSTEM, AND ALUMINUM HANDRAIL

1. CHARACTER OF METAL

A. Metal not otherwise specified shall be copper-bearing carbon structural steel. In general, trusses, trussed floorbeam horizontal bottom struts at piers, and top laterals adjacent to piers shall be of a special high strength steel, known hereinafter as manganese structural steel. These special steel parts are identified on the drawings by the suffix "S". Other parts of the spans, including the entire floor system, shall be of copper-bearing carbon structural steel. All rivets and bolts shall be copper-bearing rivet steel. Pins not otherwise specified shall be cold rolled or forged. Castings not otherwise specified shall be steel.

B. Copper-bearing carbon structural and rivet steel shall conform to Sec. M-7.4 (b) of the specifications.

C. Manganese structural steel shall conform to the following specifications:

Chemical Composition - Per Cent				
	Ladle	Check		
Carbon	0.28 Max.	0.32 Max.		
Manganese	1.10 to 1.60	1.65 Max.		
Phosphorous	0.045 Max.	0.055 Max.		
Sulphur	0.05 Max.			
Silicon	0.30 Max.			
Copper	0.20 Min.	0.18 Min.		
Physical Properties				
	1/2" and over 1/2 to 3/4"	over 3/4 to 1"	over 1 to 1-1/2"	
Thickness	incl.	incl.	incl.	
Yield Point	50,000	47,000	46,000	45,000
Tensile Strength	70,000	70,000	67,000	67,000
Elongation in 8"	18% Min.	18% Min.	19% Min.	19% Min.
Bend Test				
(Ratio of Bend Dia. to Thickness of Specimen)	1	1	1-1/2	2

All other requirements shall be in accordance with A.S.T.M. A6 and A7. All parts of manganese structural steel shall be identified by paint marks and stamping at the mill, and these identification marks with some characteristic painting shall be retained throughout the work of fabrication, so that there shall be no mistakes in the use of manganese structural steel parts where required.

D. Steel castings not otherwise specified shall conform to Sec. M-7.7 of the Specifications.

E. Steel forgings shall conform to Sec. M-7.5 of the Specifications, except alloy steel forgings shall conform to A.S.T.M. Specification A237-52T, Class B.

F. Wrought iron, wrought iron plates shall conform to A.S.T.M. Specifications for wrought iron plates, designation A42. Wrought iron rivets shall conform to A.S.T.M. Specifications for wrought iron rivets, designation A152.

G. Cold rolled steel shall conform to Sec. M-7.17 of the Specifications.

H. Soft steel in bent curb plates shall conform to A.S.T.M. Specifications low and intermediate tensile strength carbon steel plates of structural quality, designation A283-52T, Grade A.

I. For materials in fixed and expansion shoes, see Sh. 97.

J. High strength bolts shall conform to Supplemental Specification No. S-207 dated 4-28-55.

K. Lead plates under shoes shall conform to Specification M-7.14.

L. Wrought iron pipe shall be "Standard Weight", conforming to Specification M-6.10.

M. Copper-bearing steel is not required for castings, cold rolled or forged pins, or forgings, or for high-strength bolts.

N. Where wrought iron is specified for flashing, troughs, hoppers and downspouts of the roadway drainage system, Mayari R or Corten steel may be used as an alternate.

2. FABRICATION

A. Shop assemblies and camber. The trusses of the deck truss spans shall be cambered so that when erected and under full dead load they will have their normal outline with all members of the normal length shown on the plans. The lengths of unstressed members shall be so determined. Except as otherwise approved each truss shall be separately completely assembled in the shop. The chord members of each truss shall be assembled in correct geometric pattern conforming to the final outline and the holes for field rivets in the splices of the chords shall be reamed. These splices shall then be fitted with sufficient numbers of tight fitting bolts and pins to prevent any movement of the members at the splices as the chords are adjusted into cambered position. The assembly of each truss in the shop in cambered position shall be completed by addition of the web members, and the holes for field rivets in web member connections shall be reamed or drilled while the truss is so assembled. Care shall be taken to keep the centerlines of all truss members in a plane and to set the web members at their correct geometric angles with the chords.

In lieu of the complete shop assembly of each truss as specified above, alternate procedures will be considered which will provide for the assembly and reaming of truss chords and truss web members according to an approved plan which will insure accuracy of field holes and fitting of parts equivalent to that to be secured by complete assembly. In case the Contractor should desire to use such a method, complete data regarding the method to be used and precautions which will be followed to assure accuracy shall be submitted to the Engineer for approval or modification. Final approval of the exact details of the operations must be secured before the work progresses, and if not approved there shall be complete assembly of the trusses.

B. Holes in all parts of trusses, except diaphragms, and in all metal connected to the trusses through these holes shall be reamed.

All single and double story floorbeam trusses shall be completely assembled in the shop, matchmarked, and all field holes reamed. Connections for lateral bracing shall be reamed to steel templates. Floorbeam cantilevers shall be assembled with the floorbeams and the top chord, and the holes in the tension tie plates reamed.

C. Plates 36 inches wide and under shall have rolled edges. Edges of angles cut to special size shall be finished by machining or grinding. Sheared edges of steel plates in excess of 3/4" shall be planed to a depth of one quarter inch. Sheared edges of irregular shaped truss gusset plates shall be planed to a depth of one-quarter inch.

Wherever there is flame cutting of manganese steel and carbon steel gusset plates 3/4" or more in thickness, the flame cut edges shall be machined off or ground off to a depth not less than 1/4". In lieu of such machining or grinding, the flame cut edges may be flame softened or annealed, provided these operations restore the metal to substantially its original degree of hardness and other physical properties. Flame softening or annealing shall be done with suitable equipment operated by experienced operators and in general shall consist of heating with a gas flame directed at right angles to the cut surface so that the edge of the work is heated 1/8" deep along its entire length to a cherry red color visible in daylight. To demonstrate the efficiency of the flame softening or annealing, the Contractor may be required to prepare samples by flame cutting and flame softening or annealing of portions of the steel cut away, and shall test these for tensile strength, bending and for hardness, and for comparison shall prepare similar samples by machining or other methods not involving flame cutting and shall test these control samples similarly for the same qualities. The numbers of such tests shall depend upon the extent of flame cutting, and shall be made at intervals of time as the work progresses sufficient to demonstrate the efficiency and uniformity of the operations.

Details not covered by the Design Specifications for Highway Structures of the State of Ohio, shall meet the requirements of the American Association of State Highway Officials Standard Specifications for Highway Bridges, 1953.

3. ERECTION OF SUPERSTRUCTURE METALWORK

Unless otherwise required and approved for particular erection conditions, laterals shall not be riveted until after spans are swung and are supporting their own dead load weight of steel. In cantilever erection, laterals may be riveted at any time when the stresses in the chord members adjacent to the specific laterals are approximately the same as the final dead load stresses which will be in these chord members after the span is completed. Prior to riveting, laterals subject to wind loads and other stresses under erection conditions shall be connected with sufficient bolts and drift pins to provide suitably for all such possible stresses.

Should the Contractor elect to provide increased section in certain truss members or in other parts of the superstructure metalwork, for methods of erection which the Contractor may adopt, such increases of sections and parts may be incorporated in the structure, subject to the approval of the Engineer, but shall be paid for by the Contractor and will not be included in final pay quantities.

The contractor may also provide any other additional members or parts to be temporarily attached to but not permanently incorporated in the final structure for any erection purpose. All such parts shall be classed as erection equipment and falsework and shall not be included in the final pay quantities.

Should changes in any members or other portions of the truss spans, made for purposes of erection, increase the weights of the trusses, the Contractor shall calculate the camber of the structure as affected by such modifications, and shall modify the camber of the trusses as the changed conditions make necessary. The Contractor shall have full responsibility to provide the completed structure, adjusted and in correct final position. The strain in each truss member to be used in computing the camber shall be determined from the Formula $S = \frac{SL}{AE}$ Where S = dead load stress in pounds, AE

including the slab L = length of member, c-c panel points, in inches. A = 1.05 x gross area, in sq. inches. E = modulus of elasticity = 29,000,000 lb. per sq. inch.

4. GENERAL

A. Welding shall be class "A".

B. Welds shown as field may, at the Contractor's option, be made in the shop.

C. Rivets shall be 7/8 inch in diameter unless otherwise specified. In the preparation of working drawings, the spacing of rivet holes shall be made to maintain the full net section shown on the plans for all tension members. Where rivet grips exceed 6 diameters specially designed rivets or high strength bolts shall be used.

D. Drain holes of character and locations as approved by the Engineer shall be provided in metal work parts wherever water might collect and have no other means of drainage. Should it become evident after erection that sufficient drain holes have not been provided in fabrication, the Contractor shall provide additional drainage holes of character and locations as may be approved.

E. Bending of steel plates shall conform to A.A.S.H.O. 1953 Specifications; Section 2.10.29.

5. EXPANSION JOINTS

Steel castings for roadway expansion joints shall be machined on bottom surfaces which will contact supporting steel and top surfaces shall be spot faced for nuts. All sections for both sides of each joint (except for end piers) shall be shop assembled with nominal clearance of 3/4 inch between ends and roots of mating projections. While thus assembled the joint shall be checked and corrected to provide not less than 1/8 inch clearance between sides of projections and not less than 5/8 inch clearance between ends and roots of projections. All parts of roadway joints so assembled shall be matchmarked.

Roadway expansion joint castings shall be erected according to the shop matchmarking and shall be set to the longitudinal clearance required for the temperature at the time of setting, to the required grade of roadway, and to provide equal side clearance between mating projections. Holes in the supporting steel shall be drilled in the field after the castings are adjusted in final position.

Sidewalk and curb joints shall be shop assembled, corrected to provide uniform close contact between any two mating parts of each joint, matchmarked and erected to required lines and grades.

6. CURBS, SIDEWALK, FASCIA AND HANDRAIL

A. The edge of pavement and curb lines are defined on the plans. On the horizontal and vertical curves, the curb, sidewalk, fascia and handrail shall be fabricated in straight panels between floorbeams.

B. Curbs shall be formed of soft steel bent plates. The curb units thus formed shall be erected so that after the spans have deflected under the dead load of slab and steel, the curbs shall depart not more than one-eighth inch from the required line and grade shown on the plans and shall show no abrupt kinks. Vertical adjustment of the curb supports shall be accomplished by shimming on the horizontal supporting struts. Holes for rivets attaching the curb supports to the struts shall be sub-punched and field reamed to provide lateral adjustment.

C. The fascia beams supported at the ends of the sidewalk brackets shall be adjusted, before the roadway slab and wearing surface are in place, so as to depart not more than one-eighth inch from the required line and grade shown on the plans, and shall show no abrupt kinks. Adjustments shall be made by reaming the connection holes.

D. The raised pattern floor plate similar and equivalent to Carnegie Multi-grip floor plate, shall be field welded to the fascia, curb and supporting angles. The plates shall be furnished in sections not to exceed one floor beam panel in length. Care shall be exercised in field assembly to maintain a neat line of the edge of the plate along the top of the supporting curb. Joints shall be accurately formed, so that they may be completely filled with weld. The plates shall not be placed and attached until after the roadway slab is in place with the full dead load on the supporting steel work. The floor plate shall be neatly cut and tightly fitting adjacent to steel posts supporting the light pole units. After adjustment of the posts a seal weld shall be run entirely around the post at the surface of the plate, except adjoining access doors to junction boxes.

7. PAYMENT FOR STRUCTURAL STEEL

Item S-7, Structural carbon steel, includes all structural carbon steel, castings, forgings, rivets, bolts, shoes, roadway and curb expansion joints, curbs, walkways, stringers, beams, laterals, trusses, inspection walks (except grating), sidewalk hatches, ladders, wrought iron, lead plates, and every other item of metalwork for which payment is not otherwise provided, including shop painting of all metalwork covered by this item.

8. ROADWAY DRAINAGE SYSTEM

A complete roadway drainage system with inspection walkways and access ladders, is shown on the plans. Access is provided to the drainage collection troughs beneath the roadway surface by hatches in the sidewalk area giving access to ladders and inspection catwalks near the water collection troughs. The inspection catwalks, made up of a light grating floor between channel stringers, are hung from the roadway stringers by angle hangers. The walkway grating for these inspection catwalks and for the walks providing access to the navigation lights, shall be 1 inch grating. The grating shall be securely attached in place by field tack welding. All walkway grating shall conform to Supplemental Specifications No. 24 dated May 28, 1948.

Item S-29, Roadway Drainage System, includes the following: Perforated roadway cross drains with parts shop welded thereto; wrought iron flashing; transverse collection troughs; angle frameworks connected to the inspection walkway but supporting the transverse collection troughs; hoppers; frameworks supporting hoppers; downspouts; split collar connectors and bolts; longitudinal collection troughs; hoppers and their supports on pier tops; and all other angles and plates and miscellaneous parts required solely for the attaching and support of parts of the drainage system.

Painting of the drainage system is included in Item S-8, and shall consist of the two red lead and the two white lead paint coats specified for the structural steel except that the first red lead coat may be applied in the field to those members that require no shop fabrication.

Access ladders and the supporting frameworks of the transverse inspection walkways with the handrail and walkway stringers and bracing are included in Item S-7, Structural Carbon Steel. Walkway grating is paid for under Item S-24.

Item S-7, Manganese structural steel, includes all manganese steel used in trusses, laterals, struts and connecting plates, including shop painting of all metalwork covered by this item.

In accordance with Sec. S-7.28 of the Construction and Material Specifications, the weight of waste material, such as is removed by burning, cutting, coping, clipping, machining, punching, drilling, etc., shall not be considered as pay weight, but material removed to form rivet and bolt holes shall be included in the pay quantity provided that only those portions of the rivets and bolts projecting beyond the holes are included. Furthermore, any thickness and weight of members in excess of that called for on the plans (due to overweight or other cause) shall not be included in determining the weight to be paid for, unless an increase in the size of a member is authorized by the Director.

9. ALUMINUM TUBE HANDRAIL

The handrail for this structure shall consist of aluminum tubes and posts mounted on the attaching brackets extending through the sidewalk plate. The horizontal members of the rail shall consist of three round tubes, with the top tube of 4-1/2 inch outside diameter and a wall thickness of 3/16 inch, and with the center and bottom tubes of 3-1/2 inch outside diameter and a wall thickness of 5/16 inch or 3" Extra Strong Pipe (3-1/2" O.D.). Each post shall be a cast aluminum curved H section with a monolithic recessed base and tubular sockets for insertion of the rails. The horizontal tubes shall be fastened in the post socket with aluminum bolts. Posts shall be attached to the brackets with steel stud bolts welded into the brackets.

Fabrication of aluminum alloy shall in general conform to the practices recommended in Aluminum Company of America's Structural Handbook, and the following specific requirements:

- Material shall be sawed or milled.
- Flame cutting is not permitted.
- Material may be heated to a temperature not exceeding 400° F. for a period not exceeding 15 minutes to facilitate bending.
- Holes in extruded alloys shall be drilled. All holes in castings shall be cored, and rail socket holes shall be reamed.
- Welding shall be done by the inert gas shielded arc method and no flux shall be used. Welding is permitted only where specifically called for on the plans.

In handling aluminum materials in the shop and in the field every precaution shall be taken to avoid scoring or marring of the surfaces, and any such scoring or marring of the surfaces, sufficient in the opinion of the Engineer to give an objectionable appearance, shall be cause for rejection of the material. Cast parts shall have all fins, pipes or other irregularities removed. Tubing shall be seamless and uniform in quality and temper. Exterior and interior surfaces shall be clean, smooth and free from seams, slivers, laminations, grooves, cracks or other defects. End plugs shall be welded and ground smooth.

Aluminum alloy tubing shall conform to A.S.T.M. Tentative Specifications for Aluminum Alloy Extruded Tubes, Designation B235-54T, and shall be alloy GS11A, Temper T6. Aluminum posts shall conform to either A.S.T.M. Tentative Specifications for Aluminum Base Alloy Sand Castings, Designation B26-54T, Alloy SG70A, Condition T6; or A.S.T.M. Tentative Specifications for Aluminum Base Alloy Permanent Mold Castings, Designation B108-54T, Alloy SG70A, Condition T6. Aluminum bolts and nuts shall be produced from rods and bars conforming to A.S.T.M. Tentative Specifications for Aluminum-Alloy Bars, Rods and Wire, Designation B211-54T and shall be alloy CG42A, Temper T4. Aluminum bolts for attaching rails to posts shall be Semi-Finished Regular Carriage Bolts. Aluminum nuts shall be Hexagon Semi-Finished Regular Nuts. Threads shall be American Standard Coarse Thread Series Class 2 free fit. Anchor bolts shall be structural steel, and shall be galvanized. All nuts and washers for anchor bolts shall be galvanized. Aluminum alloy tubing and posts shall have no special finish. The cast aluminum posts shall be given a light sand blast finish. Aluminum materials shall have all fabrication marks and irregularities corrected after all drilling, reaming, welding or other fabrication or erection operations are completed.

Before the posts are set in place the bottoms of the posts shall receive a heavy coating of Aluminastic compound, Consistency "K", or equal, completely filling the recesses in the post base and the space between the sidewalk plate and the post-supporting bracket. Anchor bolt studs and the top of bases of posts under the bolt nuts and washers shall also be coated with aluminastic material of a heavy brushing consistency. Before the nuts are tightened the holes through the base of the post shall be filled with Aluminastic compound, Consistency "K", completely filling the bolt hole which is not occupied by the bolt. Aluminastic compound shall be as manufactured by the Parr Paint and Color Company, Cleveland, Ohio, or approved equivalent.

Erection of rails and posts shall continue successively until all of the handrail of any one unit of the structure is erected. The handrail shall then be aligned by adjustment of the steel tees to which the posts are bolted. The adjustment of the handrail shall be such that the top rail shall not depart more than one-eighth inch from correct line and grade. Handrail on curve shall be aligned in straight panels between floor beams.

The Contractor shall furnish a pattern of the cast aluminum handrail post to the City of Cleveland for use in the future replacement of damaged posts.

Payment for furnishing and placing the aluminum tube handrail complete including rails, aluminum posts, bolts, etc., shall be made at the contract unit price per linear foot of handrail, which payment shall be complete compensation for all materials, equipment, tools, labor and all work incidental to the manufacture, fabrication and erection of the handrail. Payment will be made on the basis of the measured length of handrail between ends of handrail, measured at the top of top rail.

Payment for stud anchor bolts will be included in payment for Item S-7, Structural Carbon Steel.

PART 3

U. S. ROUTE 42 RELOCATION
INNER BELT FREEWAY - CENTRAL VIADUCT
BR. NO. CU - 42R-175

GENERAL NOTES

CLEVELAND	GUYAHOGA COUNTY	OHIO
SCALE: MADE 8A DATE 10-7-54	HOWARD, NEEDLES & BERGENDOFF CONSULTING ENGINEERS	
TRCD. DATE	KANSAS CITY CLEVELAND NEW YORK	
CKD. DME DATE 2-9-55	914-1A SHEET	2.04

FEB 15 1983

GENERAL NOTES

FED. ROAD DIV. NO.	STATE	FEDERAL AID PROJECT NO.	TYPE FUNDS
2	OHIO		

3 122

CUYAHOGA COUNTY
CITY OF CLEVELAND
INNER BELT FREEWAY
CENTRAL VIADUCT

1. DESIGN SPECIFICATIONS

"Design Specifications for Highway Structures", State of Ohio, Department of Highways, dated October 1, 1951, as revised July 15, 1952, April 1, 1954, and February 1, 1955, (with a load frequency rating of CF 1200-51) are used in the design of this structure. The A.A.S.H.O. standard specifications for highway bridges, Article 3.4.8, (structural silicon steel) are used for the allowable unit stresses in manganese structural steel.

2. CONSTRUCTION SPECIFICATIONS

"Construction and Material Specifications", State of Ohio, Department of Highways, dated January 1, 1955, as modified by notes on the plans and in the proposal, shall govern.

3. SCOPE OF CONTRACT

The work included in this contract consists of the following: Furnishing and erecting the entire steel superstructure of the bridge from Sta. 16 + 13.02 to Sta. 43 + 34.72 including lead plates under shoes; shoes; steel superstructure; the bridge drainage system including downspouts, drainage troughs, hoppers, and connection to the downspouts in the pier shafts; the expansion joints; inspection walkways; ladders; the aluminum handrail, steel sidewalk and curbs; the reinforced concrete roadway slab; the navigation lighting system; the bridge roadway lighting system; and any and all other incidentals including painting of metal work, but not including roadway surface course, necessary to complete the work, ready for use.

4. DIMENSIONS

Dimensions given are measured horizontally and at 60° F., unless otherwise noted.

5. DATUM PLANE FOR ELEVATIONS

All elevations are regional geodetic survey datum.

6. FIELD OFFICE

The Contractor shall provide a field office, in accordance with Sec. S-0.01 (b) of the "Construction and Material Specifications" as soon as possible after the award of the contract, having a minimum of 500 square feet of floor space. The office shall be of watertight construction with suitable windows and doors, properly screened, and with interior walls and ceiling finished with celotex or similar insulating board. The floor shall be double thickness. The office shall be provided with heating, lighting, and telephone facilities and shall be equipped with one desk, one camp type plan table, one camp type work table and two chairs. The Contractor shall maintain the office and services until completion of his contract.

7. BORINGS

The log of each of the test hole borings is shown in these plans.

8. TRAFFIC

Portions of this project shall be constructed under traffic and the Contractor, to the satisfaction of the Engineer, shall plan and conduct his operations so that traffic shall be maintained as herein specified.

Local traffic shall be maintained as per Sec. G-4.05, during the entire construction period. If any street is closed to traffic temporarily, work on that particular street shall be prosecuted to the fullest to allow for its reopening as soon as possible. Existing streets adjacent to the project shall remain open as long as possible and feasible.

Construction operations may interfere with traffic on existing railroad tracks. The tracks will in some cases be relocated by the owners, and in other cases will be removed. The Contractor shall coordinate his construction operations so as to interfere the least possible amount with train movements. Flagmen and watchmen shall be supplied as required by the railroads, at the expense of the Contractor.

9. MINIMUM TEMPORARY CONSTRUCTION CLEARANCE FOR RAILROAD TRACKS

The minimum temporary construction clearance for railroad tracks shall be 21' -0" vertically above top of rail and 8' -0" horizontally from centerline of the nearest track.

10. WORK IN NAVIGABLE WATERS

All construction operations in the river shall conform to the requirements or directions of the District Engineer, U. S. Army, and to the requirements of the U. S. Coast Guard. The Contractor shall notify the District Engineer's Office, Corps of Engineers, U. S. Army, seven days in advance of commencement of work in the river so that navigation interests may be notified of the presence of construction equipment and also shall notify the same office when work in the river is completed. The Contractor shall provide and maintain navigation lights and other navigation signals or facilities which may be required on temporary constructions or vessels, and shall provide and maintain navigation lights on partially or entirely completed spans for the duration of his contract, in accordance with the requirements of the U. S. Coast Guard. The Contractor shall apply for and secure all necessary Department of the Army permits for dredging and dumping and for constructing falsework or other temporary constructions in the river. The Contractor shall provide areas for disposal of excavated materials at his own expense.

11. SEWAGE

The Contractor shall so conduct his operations that the flow of all existing sewers will be maintained at all times.

12. SIGNS

In addition to the requirements of Section G-7.07, "Barricades", "Danger" and "Warning" signs, the Contractor shall display one "Please - Men Working on Road" sign, Section G-7.07, furnished by the State at each end of each zone where work is in progress and in such a position as to be visible to the traffic approaching the zone.

The Contractor shall be responsible for the preservation of these signs, shall advance the signs as work progresses and shall return the signs to the state at the completion of work.

In addition to the above, the Item of "Maintaining Traffic" shall include furnishing lights, signs (other than those mentioned above), barricades and watchmen to assure the flow of traffic twenty-four (24) hours daily.

13. CONCRETE

All concrete shall be class "C".

A. The concrete roadway slabs shall be so constructed that, after completion and after removal of forms and any falsework, and after the steelwork has deflected under the weight of the concrete and wearing surface, the top surface of the roadway shall conform as nearly as practicable to the elevations and contour lines shown on the plans.

B. The roadway slabs shall, in general, be of uniform thickness between stringers. The thickness of the slab over the stringers shall vary to compensate for the deflection of the stringer due to dead load.

C. The theoretical deflections for each span are to be computed by the Contractor. The allowances to be made in screed setting to compensate for the deflections due to the dead load weight of the concrete, the asphaltic concrete surface course and the structural steel not yet in place at the time the slab is poured are to be computed; such allowances to be made above the elevations stipulated on the plans for finished pavement surfaces. Screeds may require further adjustment due to irregularities in the fabricated steel.

D. The concrete of the roadway slabs on the steel spans shall be poured in special sequence. There are shown on the plans the sequences, extent and direction of individual pours for each unit. The Contractor may submit for approval by the Engineer, alternate schemes of placing concrete slabs. The sequence of slab construction shown on the plans does not apply to the median strip.

E. Any pouring sequence may be used which adheres to the following general rules:

a. For units with one cantilever arm, pour the adjacent suspended span first, i.e.:

- (1) Pour Unit No. 2 before Unit No. 1.
- (2) Pour Unit No. 8 before Unit No. 9.

b. For units with double cantilever arms, pour both adjacent suspended spans first, i.e.:

- (1) Pour Units No. 2 and No. 4 before Unit No. 3.
- (2) Pour Units No. 4 and No. 6 before Unit No. 5.
- (3) Pour Units No. 6 and No. 8 before Unit No. 7.

c. Pour the adjacent slabs on the cantilever arms of the particular unit.

d. Complete the pouring of the unit by placing the slabs on the anchor arms.

A particular sequence starting at the west end of the viaduct is shown on the plans.

The slab must be placed for the full width of the roadway for a particular pour before proceeding with the next pour. Longitudinal construction joints in the slab will be permitted only over the center stringer. Transverse construction joints through the slab are shown on the plans. The Contractor may provide additional transverse construction joints at other locations, conforming to the details shown on Sheet 114.103. The Contractor's proposed general arrangement of construction joints must be approved by the Director of Highways before any slab concrete is placed.

Concrete base for wearing surface shall be finished according to Section S-1.23.

14. REINFORCING BARS

All laps in reinforcing bars at splices shall be 30 diameters of the bar.

All bars are designated on the plans by bar numbers. The bar size is indicated by the first digit of three-digit numbers and by the first two digits of four-digit numbers.

Clear distance from face of concrete to bars shall be 2 inches, except for slabs the clear distance shall be 1 inch or as shown on the plans.

15. ASPHALTIC CONCRETE SURFACE COURSE AND TYPE "C" WATERPROOFING

The asphaltic concrete wearing surface course and type "C" waterproofing are not a part of this contract.

16. SUB-DRAINAGE FOR WEARING SURFACE COURSE

The copper tubes required on the bridge deck slab, for sub-drainage will be paid for at the contract unit price each bid for Item S-29, "Sub-Drainage for Wearing Surface Course". There shall be a line of copper tubes within one foot of each expansion joint, contraction joint, and roadway drain.

The steel angles will be included in a later contract with the asphaltic concrete wearing surface course and type "C" waterproofing.

17. CLEANING AND REPAIRING SUBSTRUCTURE

The Contractor shall, without additional compensation, clean and repair any portion of the substructure which is soiled or damaged as a result of his operations.

18. ELECTRICAL GROUNDS

All parts of the superstructure steelwork and the entire roadway lighting system shall be thoroughly grounded at pier shafts. The contractor for substructure will embed in the concrete of each of these pier shafts a No. 0 solid copper wire brazed at its lower end to a steel concrete pile casing, or steel pile, and at its upper end extending sufficiently above top of concrete to provide for convenient splicing and extension by the contractor for superstructure. At each such pier shaft the trusses shall be grounded by a No. 6 copper wire bolted or brazed to the bottom chord of the truss and to the bottom casting of the shoe, and carried to connection with the ground wire extending to the foundation pile. Across all roadway expansion joints at both trusses, there shall be provided a No. 6 stranded tinned copper wire suitably looped to allow

for expansion of the steelwork, and connected to each side of the expansion joint by bolting or brazing so as to provide an effective electrical connection for grounding the entire structural steelwork.

Payment will be made under "Item S-25, Electrical grounds".

19. PAINTING

Painting of superstructure metalwork shall be according to Item S-8 of the Construction and Material Specifications except as modified herein.

A. Coats of Paint. The paint shall be applied by brushing in four coats as follows:

a. A first coat of red lead paint applied in the shop on clean metal surfaces prepared for painting as specified in Sec. S-8.03.

b. A second coat of red lead paint applied in the field after erection. For surfaces that will be inaccessible after erection, this second coat may be applied either in the shop or in the field.

c. A third and a fourth coat consisting of white lead paint. The fourth coat shall be tinted a medium shade of gray that meets the approval of the Director of Highways and the City of Cleveland.

d. Light standards and the steel parts of handrails shall be painted with a first and a second coat of red lead paint as specified for the remainder of the structural steel, but the third and fourth coats shall be of aluminum paint.

B. Materials

a. The paint to be used for the first and second red lead coats shall be of the following composition and properties:

Pigment	Red Lead (97% grade)	99.6% (minimum)
	Aluminum Stearate	0.3-0.4%

Vehicle	Raw Linseed Oil	35% to 50%
	*Pale Heat Bodied Linseed Oil (Z ₂)	15% to 30%
	Volatile Mineral Spirits and Drier	35% (maximum)

*The acid number of this oil shall not be over 11, the color not darker than 7 (Gardiner 1933) and shall have a Wijs iodine value of 110-125.

Paint	First Coat	Second Coat
Pigment	73% (minimum)	77% (minimum)
Vehicle	27% (maximum)	23% (maximum)
Weight per gallon	21.0 pounds (minimum)	24.0 pounds (minimum)
Consistency	175 grams to 250 grams	ASTM Method D562-42-T or Federal Specification TT-P-141a, Method 428.11

Fineness of grind 5 (minimum)

Drying Time	
Set to touch	6 Hours (maximum)
Dry through	36 Hours (maximum)

The paint shall be well ground, shall not settle excessively or cake in the container, shall be readily broken up with a paddle to a smooth uniform paint having good brushing properties. The paint when brushed on a clean, smooth steel panel maintained in a vertical position, shall dry to a smooth uniform finish free from roughness, grit, unevenness, streaking, separation, running, curtaining and sagging.

For contrast between the first and second coats, the second coat shall be tinted with lampblack-in-oil to change its color to a chocolate brown.

b. The white lead third and fourth coats of paint shall conform to Sec. M-9.6 (b) of the Construction and Material Specifications.

c. The aluminum third and fourth coats of paint shall conform to Sec. M-9.12 of the Construction and Material Specifications.

20. GRAVEL

If gravel is used as the coarse aggregate it shall meet the requirements of Section M-3.93 of the Construction and Material Specifications

PART 3

U. S. ROUTE 42 RELOCATION
INNER BELT FREEWAY - CENTRAL VIADUCT
BR. NO. CU -42 R-17 5

GENERAL NOTES

CLEVELAND CUYAHOGA COUNTY OHIO

SCALE
MADE 6A DATE 10-6-54
TRCD. DATE
CKD. DATE

HOWARD, NEEDLES, TAMMEN & BERGENDOFF
CONSULTING ENGINEERS
KANSAS CITY CLEVELAND NEW YORK
914-1A SHEET 2.03

MICROFILMED
FEB 15 1983

FED. ROAD DIV. NO.	STATE	FEDERAL AID PROJECT NO.	TYPE FUNDS
2	OHIO		


2
122

CUYAHOGA COUNTY
CITY OF CLEVELAND
INNER BELT FREEWAY
CENTRAL VIADUCT


Begin Project Sta. 16+13.02
& West End Pier

End Project Sta. 43+34.72
& East End Pier



PLAN OF ROADWAY DECK
Scale: 1"=100'

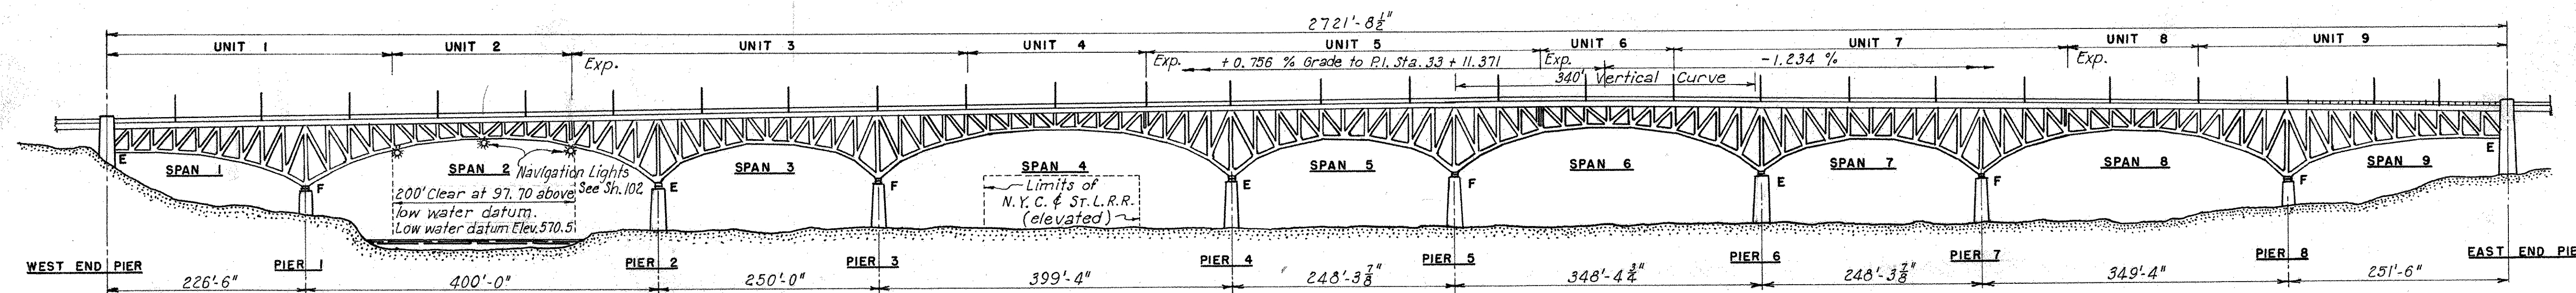

SOUTH ELEVATION
Scale: 1"=100'

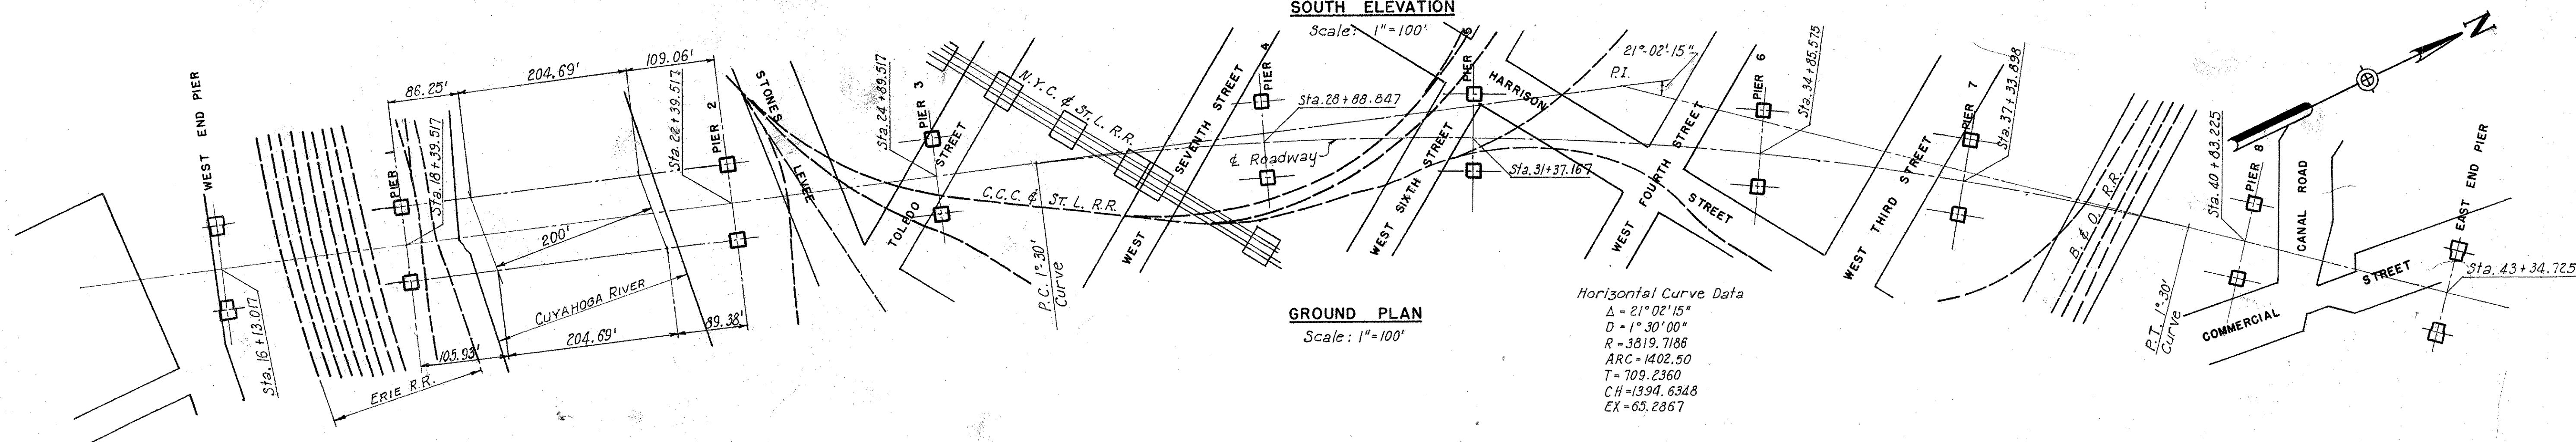

GROUND PLAN
Scale: 1"=100'

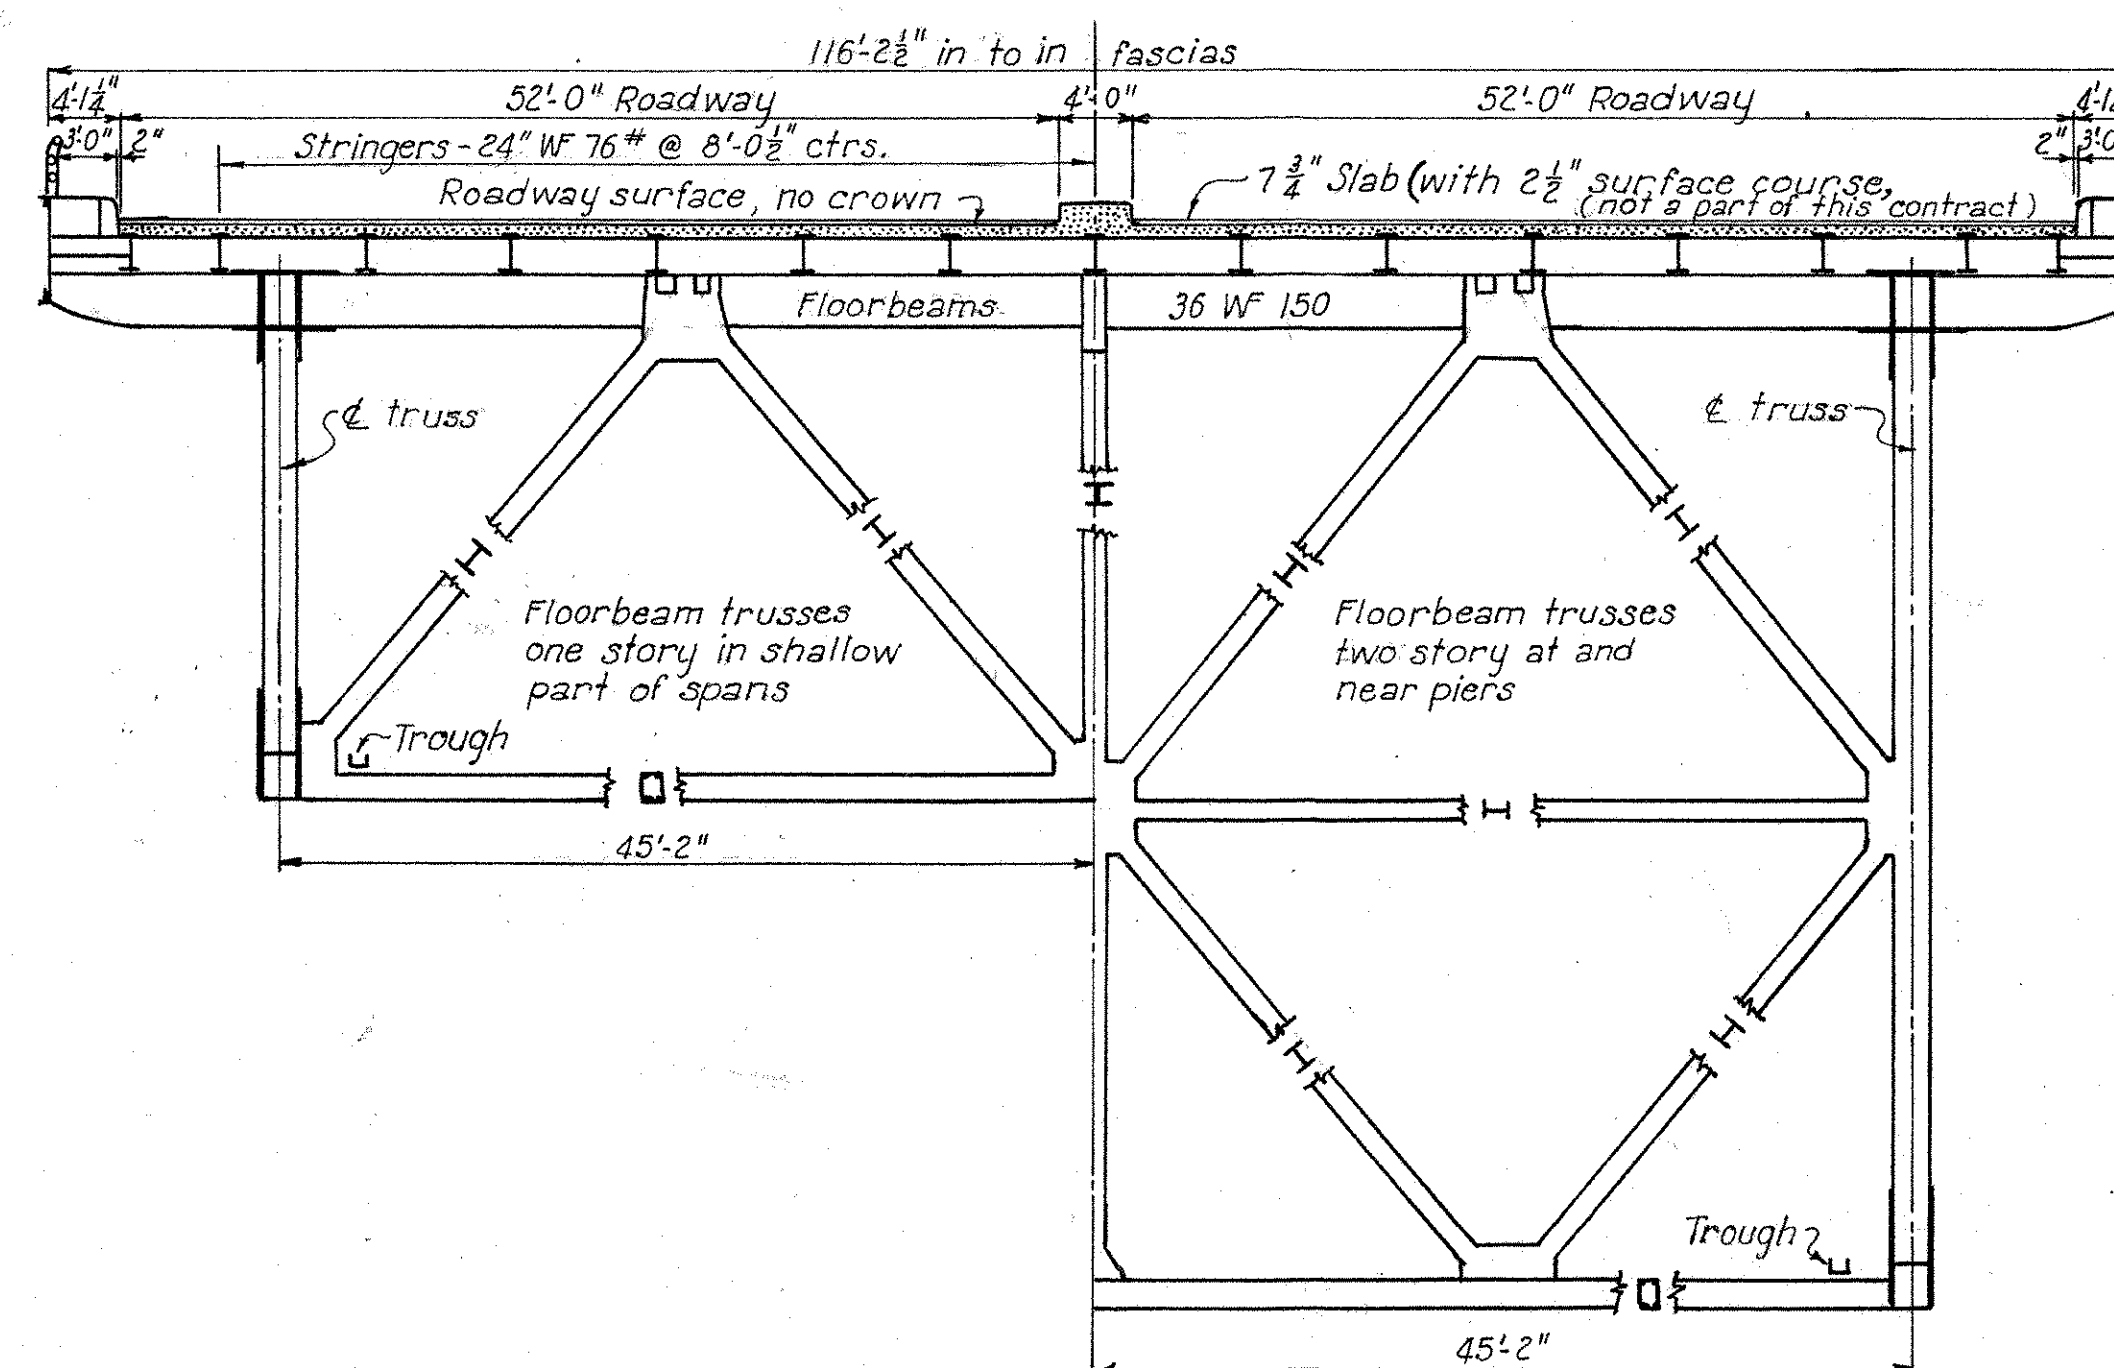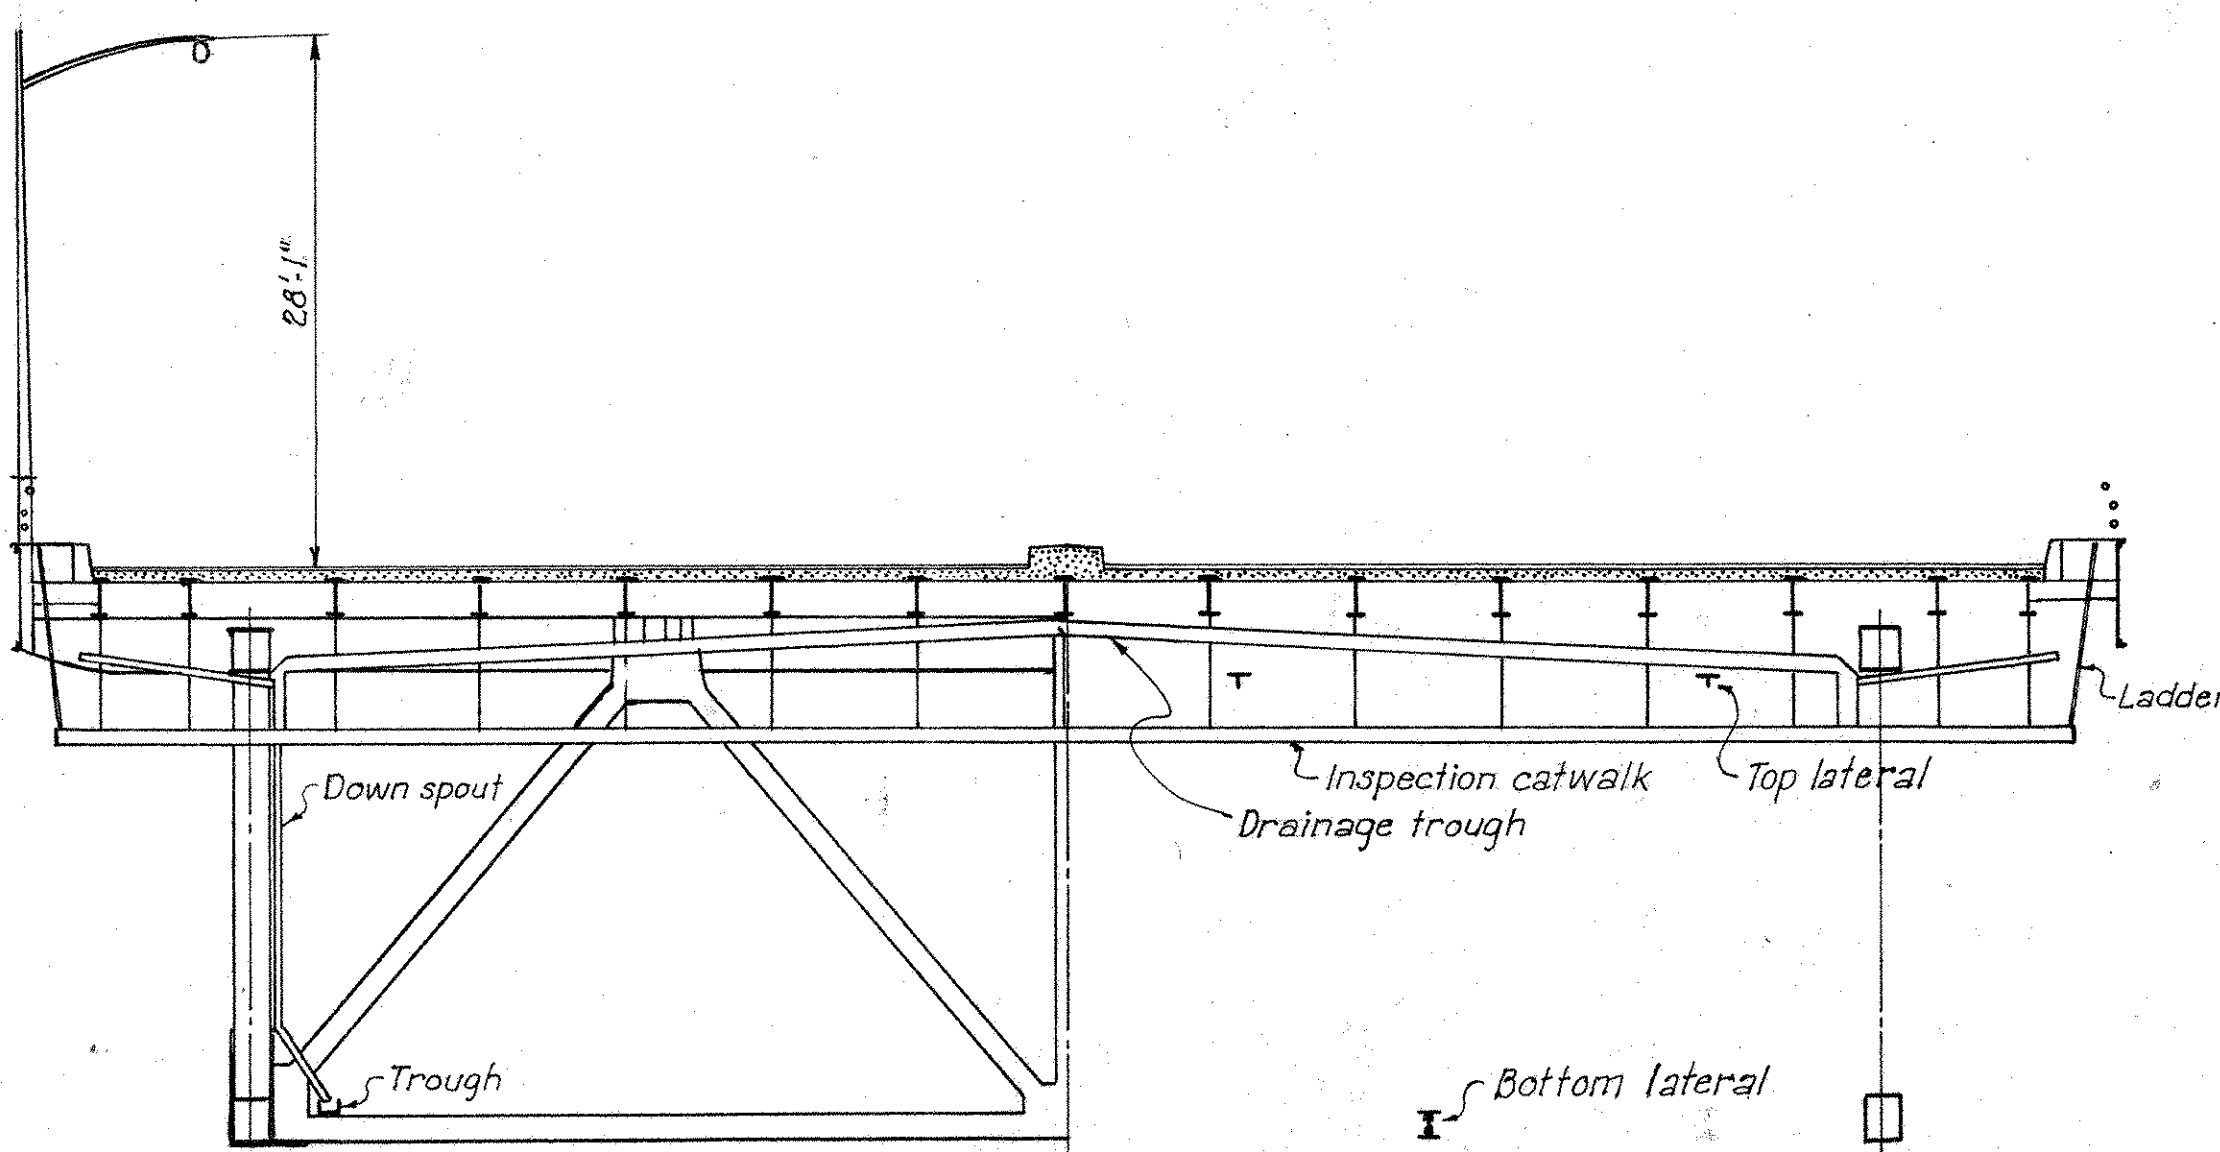

- Work included in this contract:
1. All superstructure above tops of piers.
 2. Roadway lighting system.
 3. Navigation lights.
 4. Roadway drainage system.

PART 3

U. S. ROUTE 42 RELOCATION		
INNER BELT FREEWAY - CENTRAL VIADUCT		
BR. NO. CU - 42 R-17 5		
GENERAL PLAN AND ELEVATION		
CLEVELAND	CUYAHOGA COUNTY	OHIO
SCALE: As shown		
MADE BY: DATE: 1-15-54		
TRCD BY: DATE: 8-13-54		
CKD BY: DATE: 8-22-54		
HOWARD, NEEDLES, TAMMEN & BERGENDOFF CONSULTING ENGINEERS KANSAS CITY CLEVELAND NEW YORK		
914-1A SHEET 2.02		